


ALFALFA LANE
not DRIVE

ALFALFA DRIVE (EXISTING)

PHASING PLAN NOTE

THE PHASE LINES SHOWN ON THIS PLAN REPRESENT THE ORDER OF LOT RECORDATION, INSTALLATION AND ROUTING OF UTILITIES TO BE COORDINATED WITH PROJECT ENGINEER TO MATCH INTENTION OF PHASING PLAN. ACTUAL PHASING LINES FOR UTILITIES MAY DIFFER FROM LOTS.

LOTS BY PHASE		
SF PHASE	LOT #S	# OF LOTS
PHASE 1	94-146	57
PHASE 2	1-6, 217-221, 229-243	26
PHASE 3	7-26, 247-256	30
PHASE 4	75-93, 147	24
PHASE 5	152-170, 204-211	27
PHASE 6	27-47, 212-216, 222-228, 244-246	36
PHASE 7	175-194	20
PHASE 8	62-74, 195-203	22
PHASE 9	48-61, 171-174	18
TOTAL SF LOTS		260
TH PHASE	LOT #S	# OF LOTS
PHASE 1	400-419, 430-479	70
PHASE 2	343-364	22
PHASE 3	325-342, 365-379, 420-429	43
PHASE 4	301-324, 380-399	44
TOTAL TH LOTS		179

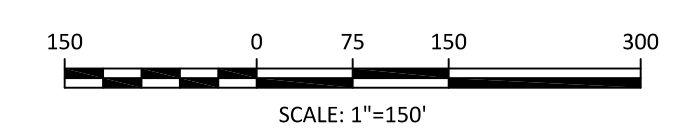


REVISIONS	REVISIONS PER DOT COMMENTS FOR WATER LINE CONNECTIONS
1	2023-03-17 REVISED TOWN HOME PHASES OF 1075-1082 TO TOWN
2	2023-03-23 TOWARDS FIGHTING BULL DRIVE
3	2023-03-24 REVISED PHASE LINES

**PRESERVE AT JONES DAIRY - CENTRAL
CONSTRUCTION DRAWINGS**

ROLESVILLE, NC

PHASING PLAN - OVERALL

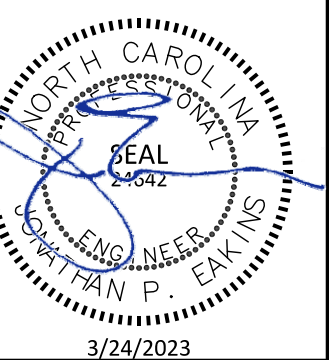

PROJECT NO:	---
DESIGN BY:	JPE
DRAWN BY:	RSF
SCALE:	1"=150'
DATE:	2023-01-27
SHEET NO:	C2.2