


Please email me the public water and sewer permit applications for these proposed extensions. Once received, I will provide the assigned permit numbers for this project.



Please include the Raleigh Standard Utility notes somewhere on these plans.

Please include the Raleigh digital signature block and permit blocks on the cover, utility plan and profile sheets.

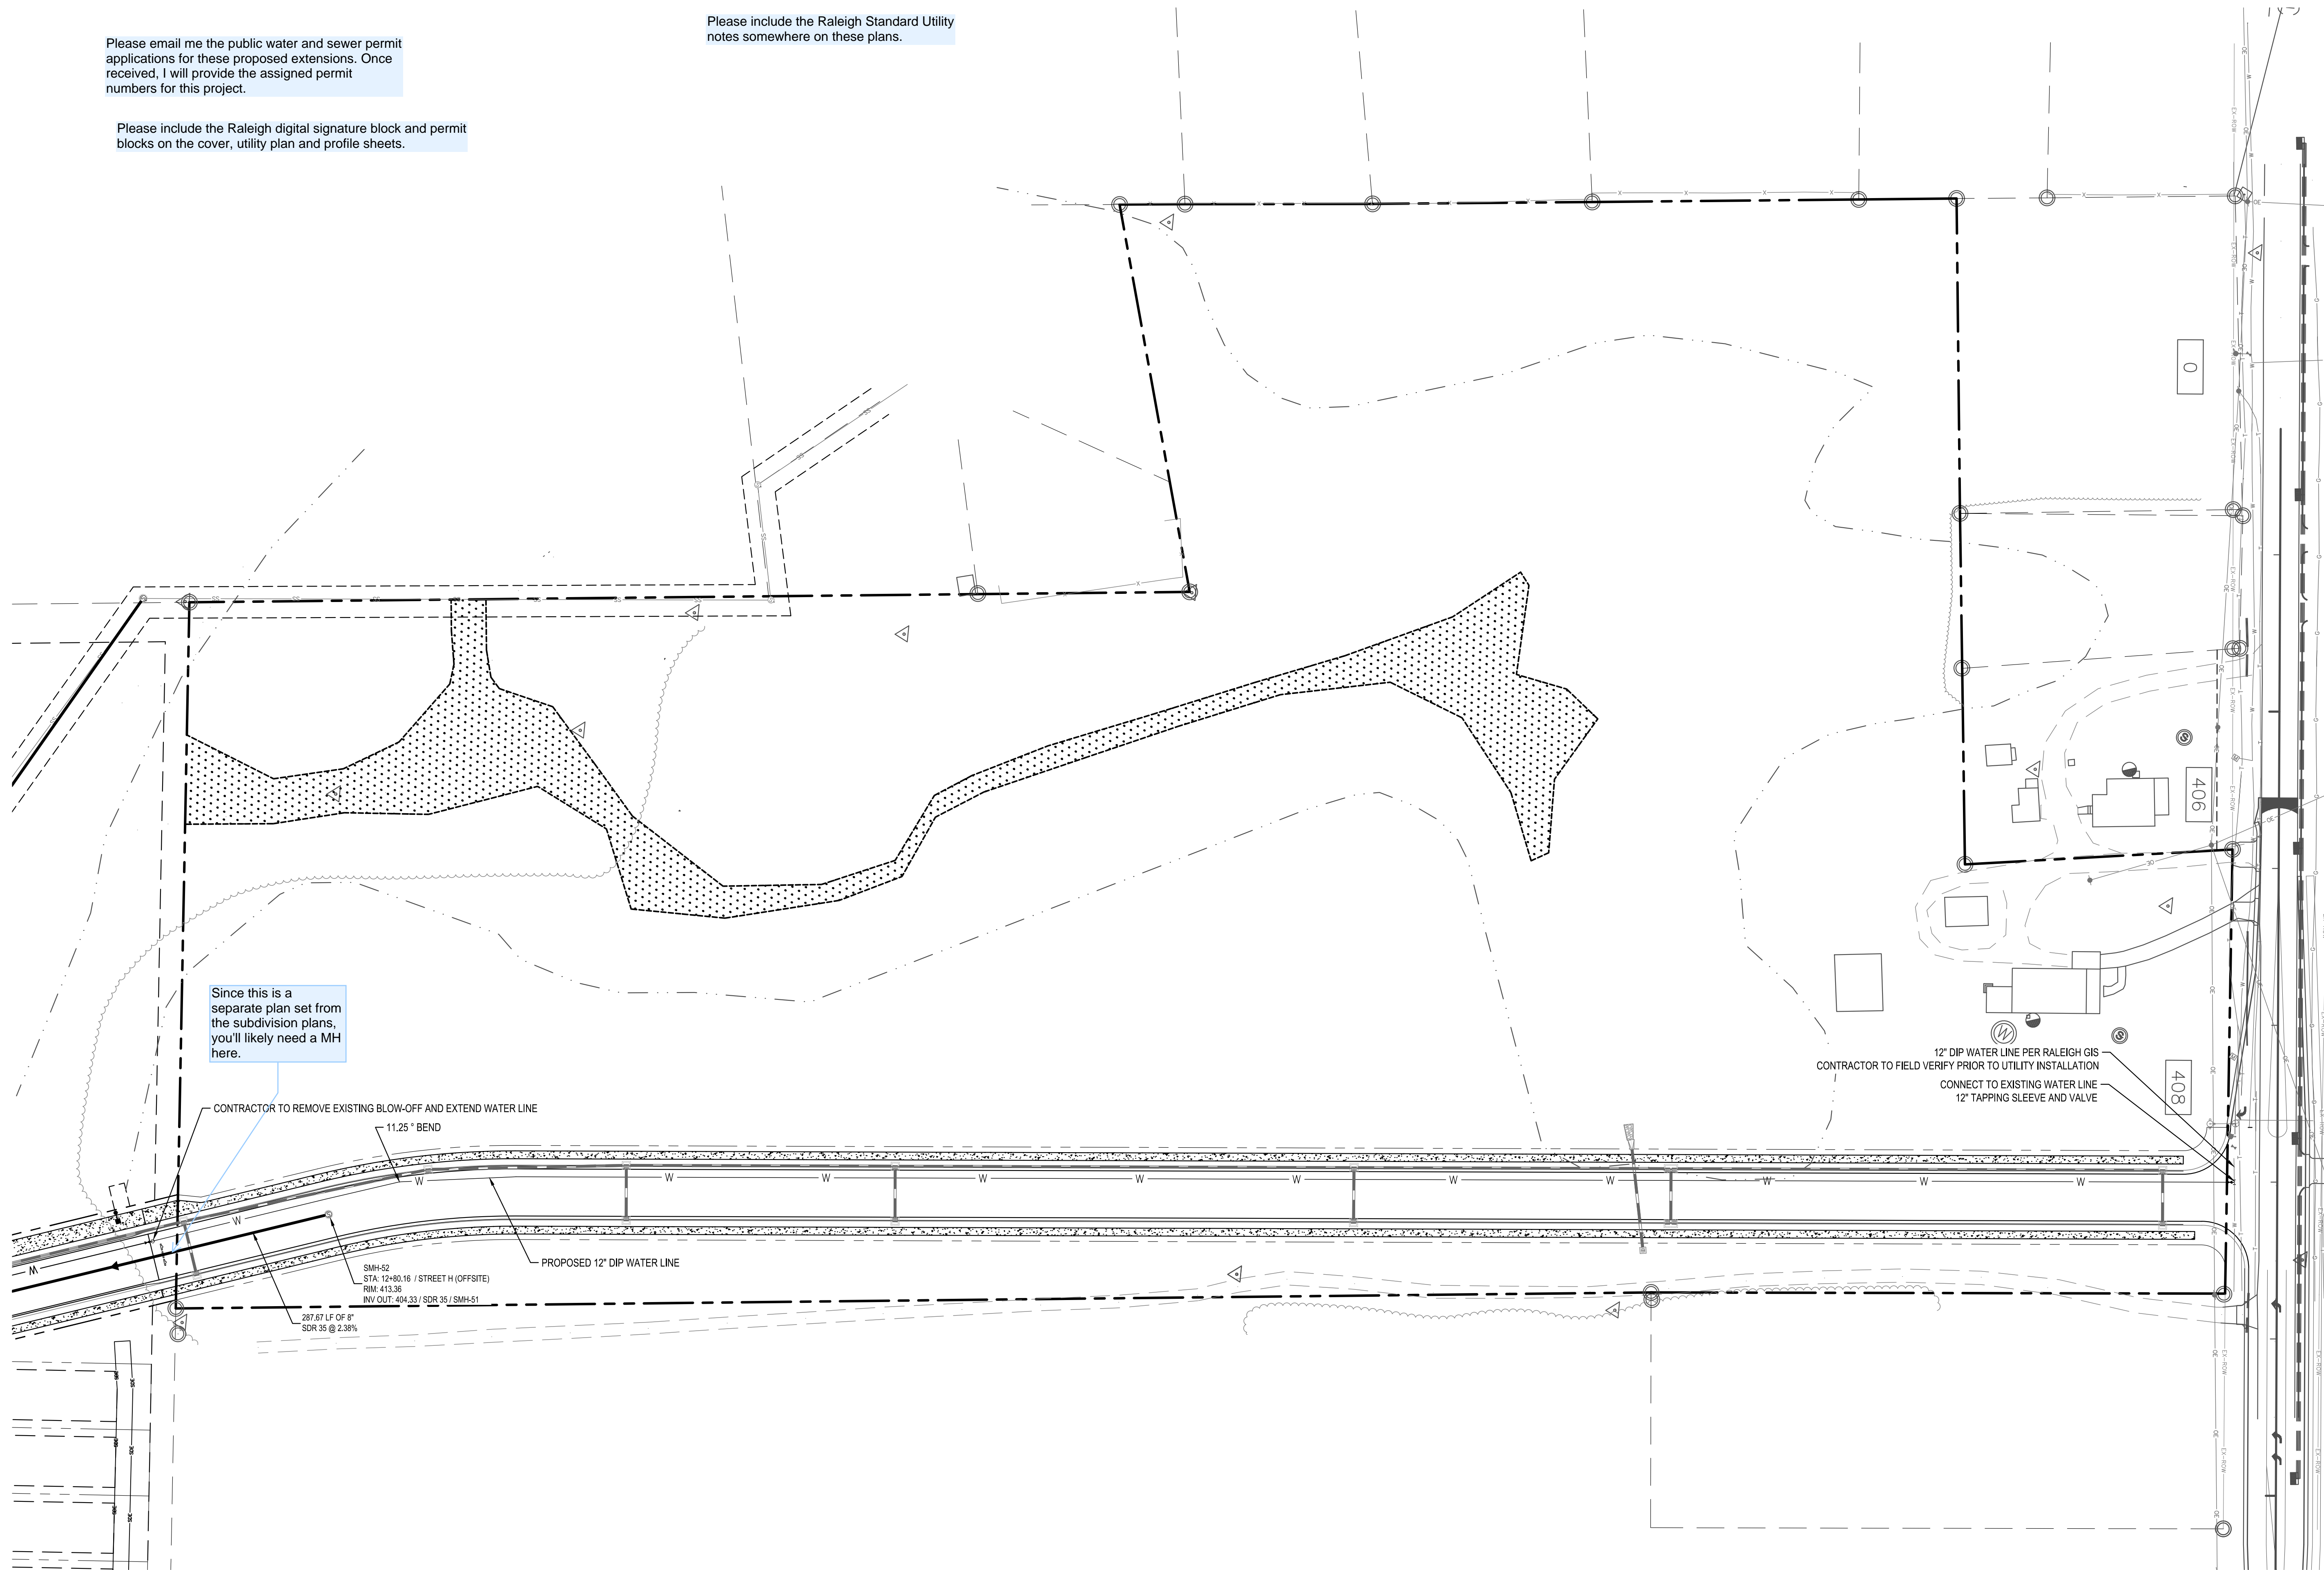

Since this is a separate plan set from the subdivision plans, you'll likely need a MH here.

EAST YOUNG STREET  
S.R. 1003  
60' PUBLIC RW

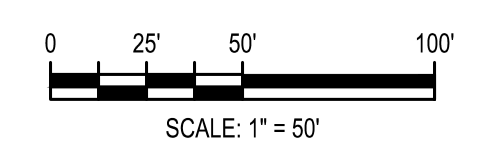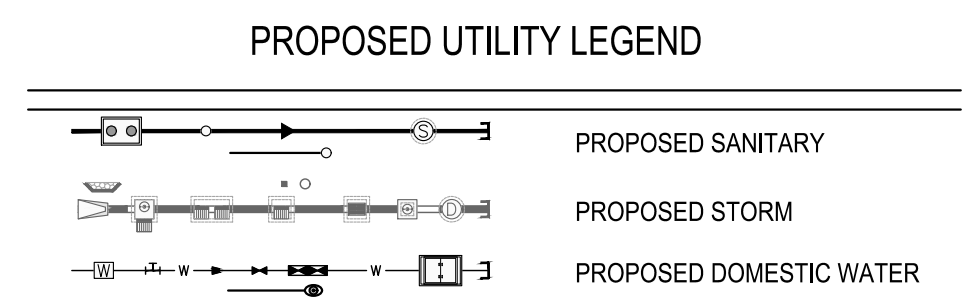

NOT FOR CONSTRUCTION	
FILE NUMBER: 8430-03	
DATE: 10/09/2023	
C3-0	

DESIGNED BY: DF/JWM	DATE	DESCRIPTION
DRAWN BY: JWM	10/09/2023	PER TOWN OF ROLESVILLE COMMENT
REVIEWED BY: DF	REV	

**BCE**  
5440 WADE PARK BLVD, SUITE 102  
RALEIGH NC 27607  
WWW.BCEINC.COM  
NC LICENSE #C-4397 ©2023

**LENNAR CORPORATION**  
1100 PERIMETER PARK DRIVE, SUITE 112  
MORRISVILLE / NORTH CAROLINA / 27560

**YOUNG STREET CONNECTION**  
408 E YOUNG STREET  
ROLESVILLE / NORTH CAROLINA / 27571

G:\NCA\Projects\Lenmar\8430-03 - Lenmar - School Street - Rolesville\03 - DWG\PlanSheets\Off-Site\C3-0 - UTIL-PLAN.dwg Layout: C3-0 UTILITY PLAN Plotted: 10/9/2023 9:13:49 AM