

CITY OF RALEIGH - PLANS AUTHORIZED FOR CONSTRUCTION

Electronic Approval: This approval is being issued electronically. This approval is valid only upon the signature of a City of Raleigh Review Officer below. The City will retain a copy of the approved plans. Any work authorized by this approval must proceed in accordance with the plans kept on file with the City. This electronic approval may not be added prior issued. Any modification to this approval once issued will invalidate this approval.

City of Raleigh Development Approval _____
Raleigh Water Review Officer _____

06/27/22



BASS, NIXON & KENNEDY, INC.
CONSULTING ENGINEERS
8310 CHAPEL HILL ROAD, SUITE 200, RALEIGH, NC 27607
CERTIFICATION NUMBERS: NCEBES (C-110), NCEBOLA (C-0987)









DATE	DESCRIPTION	NO.	DATE	DESCRIPTION	NO.	DATE	DESCRIPTION
03/18/17	PROGRESS	MM					
	DRAWN BY						
	CHECKED BY						
	DATE						
	SCALE: N.T.S.						

COBLESTONE VILLAGE
MIXED USE DEVELOPMENT
TOWN OF ROLESVILLE, WAKE COUNTY, NORTH CAROLINA

SHEET C5.5

RD1010110117 - Information from Center/Civil/USA Communications - 10117_PlanSet.dwg, 04/18/2022 10:26:46 PM, mmmccormack

2022, BASS, NIXON & KENNEDY, INC. EXPRESSLY RESERVES ITS COMMON LAW COPYRIGHT AND OTHER PROPERTY RIGHTS IN THESE PLANS. THESE PLANS ARE NOT TO BE REPRODUCED, CHANGED OR COPIED IN ANY FORM OR MANNER WHATSOEVER, NOR ARE THEY TO BE ASSIGNED TO ANY OTHER PARTY WITHOUT FIRST OBTAINING THE EXPRESS WRITTEN PERMISSION AND CONSENT OF BASS, NIXON & KENNEDY, INC.

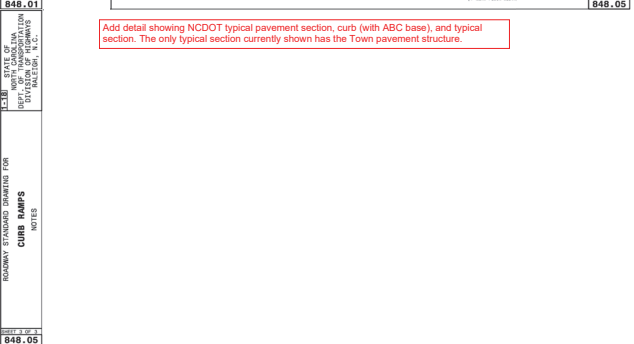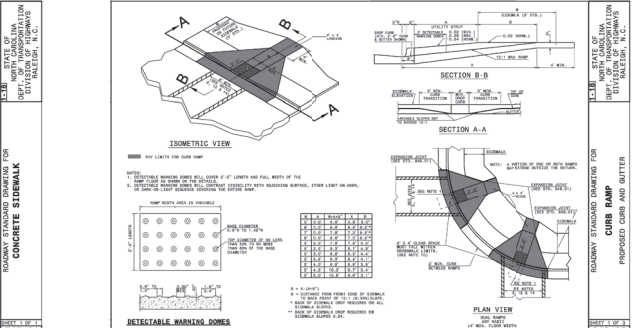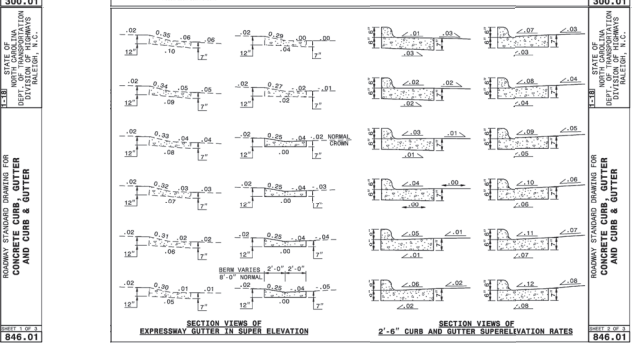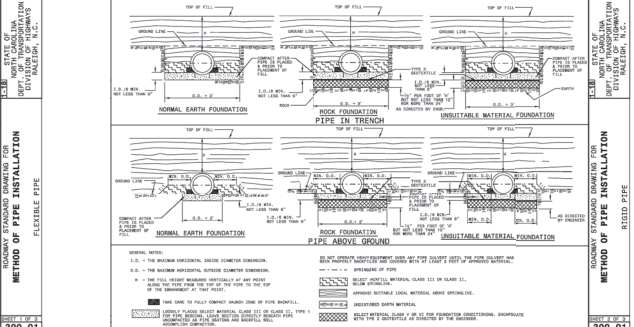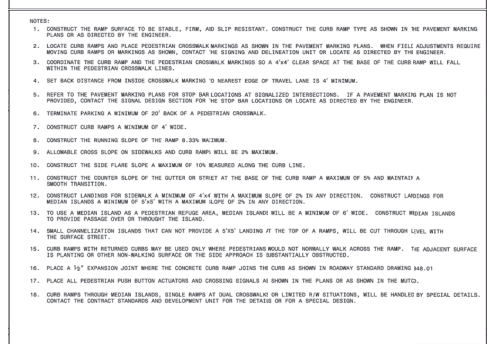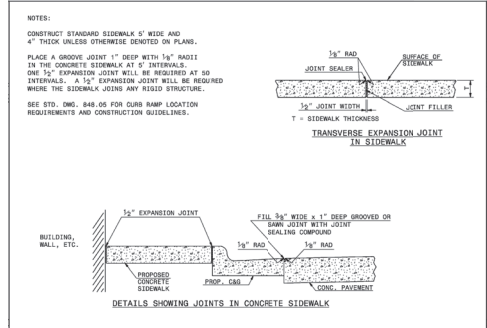
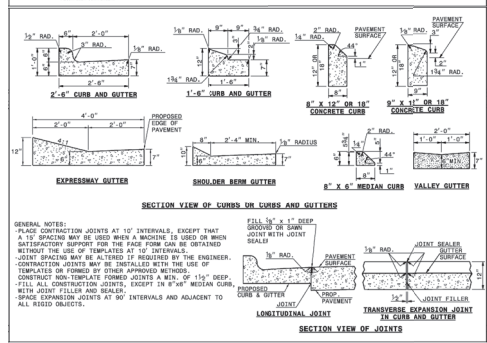
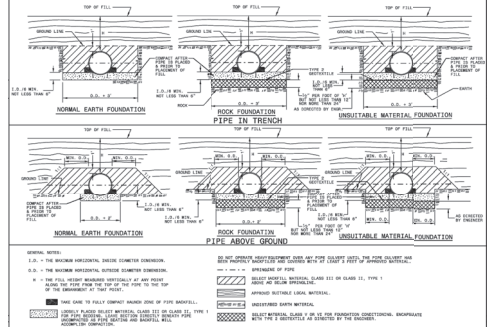


Add detail showing NCDOT typical pavement section, curb (with ABC base), and typical section. The only typical section currently shown has the Town pavement structure.

FLEXIBLE PIPE

Standard Reinforced Steel Pipe 2.0 x 36 Corrugation		Standard Reinforced Aluminum Pipe 2.0 x 36 Corrugation	
LENGTH (FEET)	WEIGHT (LBS)	LENGTH (FEET)	WEIGHT (LBS)
10	120	10	100
12	144	12	120
14	168	14	140
100	1200	100	1000

300.01

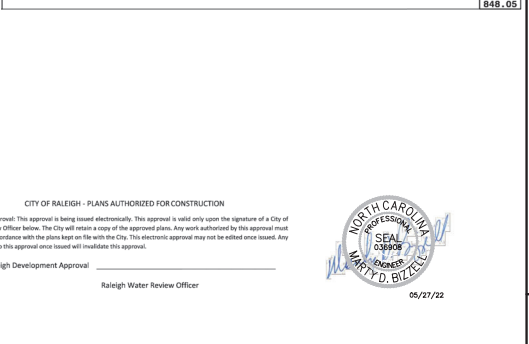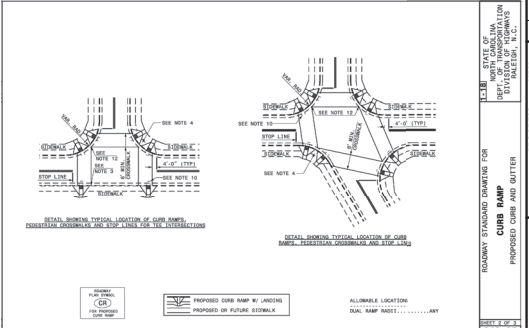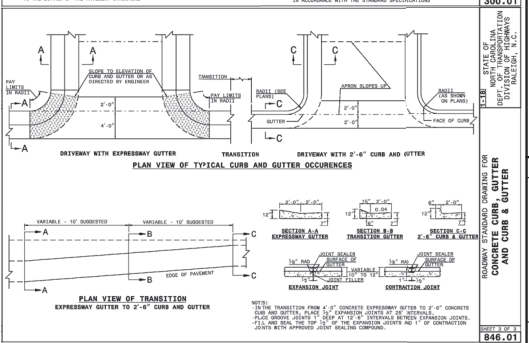

CITY OF RALEIGH - PLANS AUTHORIZED FOR CONSTRUCTION

Electronic Approval: This approval is being issued electronically. This approval is valid only upon the signature of a City of Raleigh Review Officer below. The City will retain a copy of the approved plans. Any work authorized by this approval must proceed in accordance with the plans kept on file with the City. This electronic approval may not be added once issued. Any modification to the approval once issued will invalidate this approval.

City of Raleigh Development Approval

Raleigh Water Review Officer

06/27/22



BANK

BASS, NIXON & KENNEDY, INC.
CONSULTING ENGINEERS
8310 CHAPEL HILL ROAD, SUITE 200, RALEIGH, NC 27607
CERTIFICATION NUMBERS: INCEES (C-110), INCEQA (C-0267)

COBLESTONE VILLAGE MIXED USE DEVELOPMENT
TOWN OF ROLESVILLE, WAKE COUNTY, NORTH CAROLINA

SHEET C5.6

NOT RELEASED FOR CONSTRUCTION OR BID SOLICITATION