

ALL CONSTRUCTION SHALL BE IN ACCORDANCE WITH CURRENT TOWN OF ROLESVILLE STANDARDS AND SPECIFICATIONS


SYMBOLS AND ABBREVIATIONS

ABC	AGGREGATE BASE COURSE		EXISTING CURB INLET
ALUM	ALUMINUM		EXISTING GRATE INLET/YARD INLET
AST2	ALUMINIZED STEEL – TYPE 2		EXISTING FLARED END SECTION
B-B	BACK TO BACK		EXISTING FIRE HYDRANT
BOA	BLOW-OFF ASSEMBLY		EXISTING BLOW-OFF ASSEMBLY
C&G	CURB AND GUTTER		EXISTING GATE VALVE
CFS	CUBIC FEET PER SECOND		EXISTING REDUCER
CI	CURB INLET		EXISTING WATER METER
CL	CENTER LINE		EXISTING SAN SEWER MANHOLE
CMP	CORRUGATED METAL PIPE		EXISTING CLEAN OUT
CO	CLEAN OUT		EXISTING POWER POLE
COM	COMMUNICATION		EXISTING TELEPHONE PEDESTAL
CONC	CONCRETE		EXISTING AREA LIGHT
DCV	DOUBLE CHECK VALVE		EXISTING SIGN
DCDV	DOUBLE DETECTOR CHECK VALVE		NEW CURB INLET
DI	DROP INLET		NEW GRATE INLET/YARD INLET
DIP	DUCTILE IRON PIPE		NEW FLARED END SECTION
EASE	EASEMENT		NEW FIRE HYDRANT
ELEC	ELECTRIC		NEW BLOW-OFF ASSEMBLY
EX	EXISTING		NEW GATE VALVE
FES	FLARED END SECTION		NEW REDUCER
FH	FIRE HYDRANT		NEW WATER METER
FM	FORCE MAIN		NEW TEE
FT	FEET		NEW PLUG
FT/SEC	FEET PER SEC		NEW MANHOLE
GALV	GALVANIZED		NEW CLEAN OUT
GV	GATE VALVE		NEW SIGN
HDPE	HIGH DENSITY POLYETHYLENE		IRON PIPE
L	LENGTH		BENCHMARK
LF	LINEAR FEET		
MH	MANHOLE		
PAVE	PAVEMENT		
PE	FINISHED PAD ELEVATION		
PP	POWER POLE		
PVC	POLYVINYL CHLORIDE		
R	RADIUS		
R/W	RIGHT-OF-WAY		
RED	REDUCER		
RCP	REINFORCED CONCRETE PIPE		
RPZ	REDUCED PRESSURE ZONE		
SS	SANITARY SEWER		
STA	STATION		
TDD	TEMPORARY DIVERSION DITCH		
TELE	TELEPHONE		
TSB	TEMPORARY SEDIMENT BASIN		
UG	UNDERGROUND		
WOR	WHEELCHAIR RAMP		
W/L	WATER LINE		
WM	WATER METER		
YI	YARD INLET		

NOTE: ALL CONSTRUCTION ACTIVITY MUST BE IN ACCORDANCE WITH THE ACCEPTED POLICIES OF THE TOWN OF ROLESVILLE AND NCDOT

COBBLESTONE VILLAGE MIXED USE DEVELOPMENT

TOWN OF ROLESVILLE, WAKE COUNTY, NORTH CAROLINA
CONSTRUCTION DRAWINGS
TOWN OF ROLESVILLE PROJECT NO.
SITE PLAN APPLICATION NO. CUP-SB-21-01

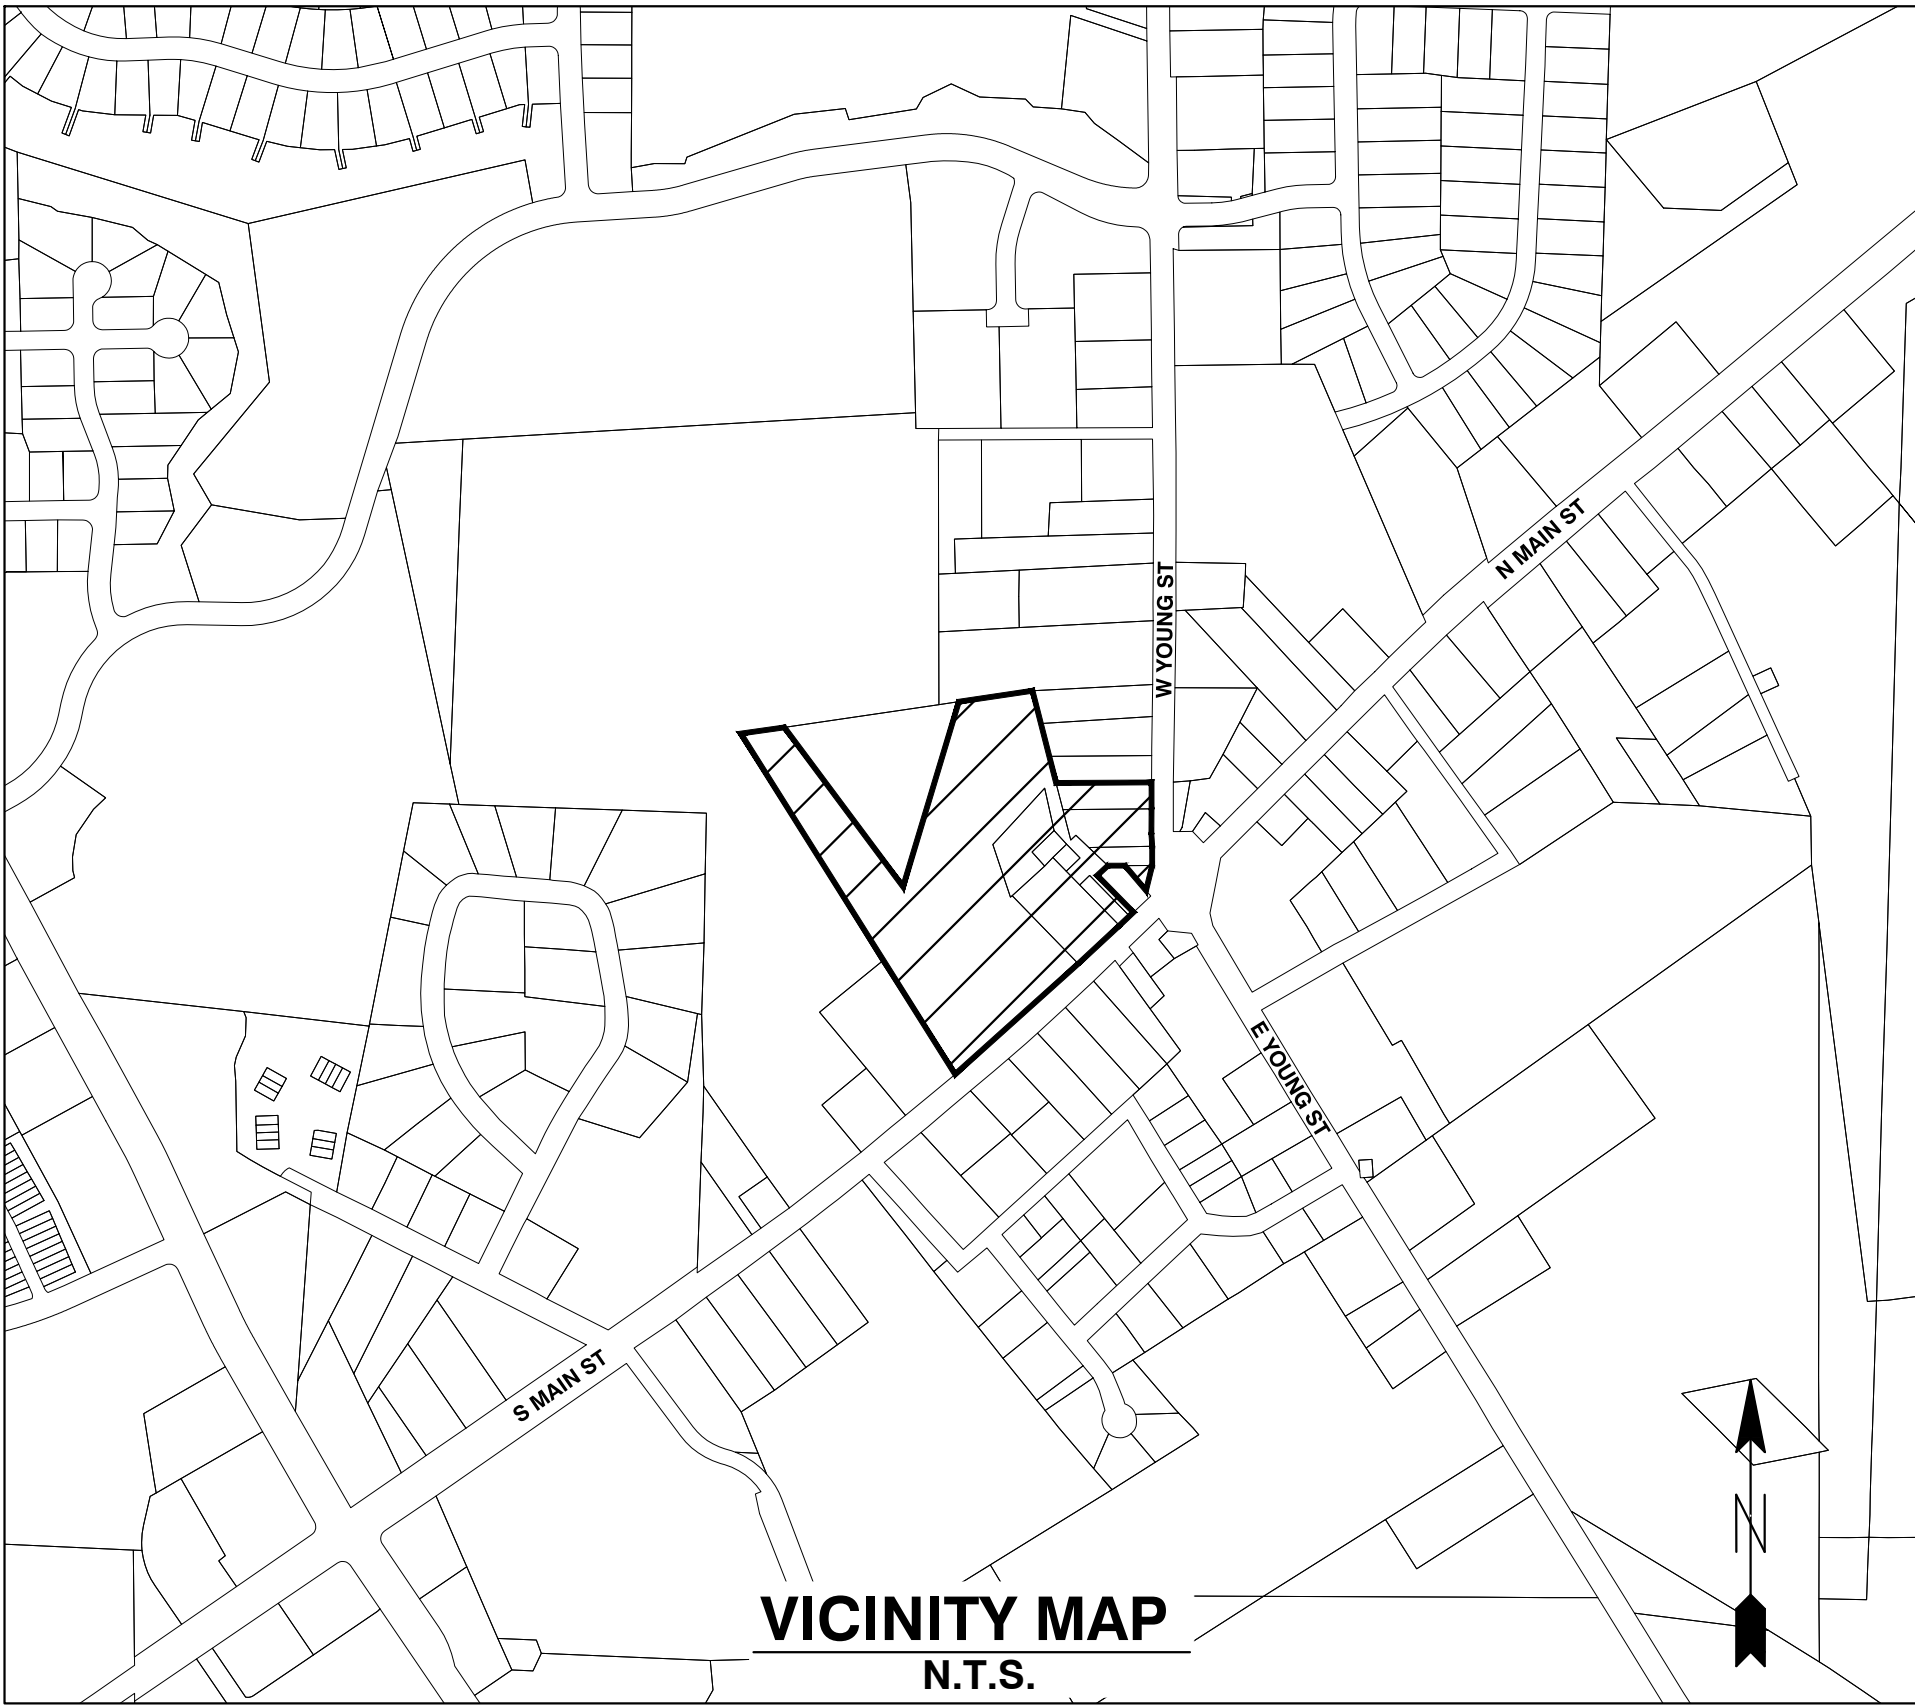

Public
Water Distribution / Extension System
The City of Raleigh consents to the connection and extension of the City's public water system as shown on this plan. The material and construction methods used for this project shall conform to the standards and specifications of the City's Public Utilities Handbook.

City of Raleigh
Public Utilities Department Permit # W-3879

Authorization to Construct See digital signature

Private
Sewer Collection / Extension System
The City of Raleigh consents to the connection to its public sewer system and extension of the private sewer collection system as shown on this plan. The material and constructions methods used for this project shall conform to the standards and specifications of the City's Public Utilities Handbook.

City of Raleigh
Public Utilities Department Permit # S-4962 (P)

Authorization to Construct See digital signature

SITE PERMITTING APPROVAL

Water and Sewer Permits (if applicable)
The City of Raleigh consents to the connection and extension of the City's **Public Sewer System** as shown on this plan. The material and construction methods used for this project shall conform to the standards and specifications of the City's Public Utilities Handbook. **City of Raleigh Public Utilities Department Permit #** W-3879

The City of Raleigh consents to the connection and extension of the City's **Public Water System** as shown on this plan. The material and construction methods used for this project shall conform to the standards and specifications of the City's Public Utilities Handbook. **City of Raleigh Public Utilities Department Permit #** S-4962 (P)

The City of Raleigh consents to the connection to its public sewer system and extension of the private **sewer** collection system as shown on this plan. The material and construction methods used for this project shall conform to the standards and specifications of the City's Public Utilities Handbook.

City of Raleigh Public Utilities Department Permit # _____

CITY OF RALEIGH - PLANS AUTHORIZED FOR CONSTRUCTION
Electronic Approval: This approval is being issued electronically. This approval is valid only upon the signature of a City of Raleigh Review Officer below. The City will retain a copy of the approved plans. Any work authorized by this approval must proceed in accordance with the plans kept on file with the City. This electronic approval may not be edited once issued. Any modification to this approval once issued will invalidate this approval.

City of Raleigh Development Approval _____
Raleigh Water Review Officer _____

OWNER:
TOWN OF ROLESVILLE
P.O. BOX 250
ROLESVILLE, NC 27571-0250

DEVELOPER:
KDM DEVELOPMENT CORPORATION
1080 PITTSFORD VICTOR RD, STE 202
PITTSFORD NY 14534-3805

CONTACT: KENYON BURHNAM
PHONE: 585-465-0099
EMAIL: KBURNHA2@U.ROCHESTER.EDU

SHEET INDEX

COVER	
C0.1	EXISTING CONDITIONS & DEMOLITION PLAN
C1.1	SITE PLAN
C2.1	UTILITY PLAN
C3.1	GRADING AND DRAINAGE PLAN
C3.2	BMP DETAILS
C3.3	EROSION CONTROL PLAN - STAGE 1
C3.4	EROSION CONTROL PLAN - STAGE 2
C3.5	EROSION CONTROL DETAILS
C3.6	EROSION CONTROL DETAILS
C3.7	NCG01 PLAN
C3.8	STORM DRAINAGE PIPE & STRUCTURE TABLE
C4.1	PUBLIC WATERLINE PROFILE
C4.2	SANITARY SEWER PROFILE
L1.1	LANDSCAPE PLAN
SL-101	LIGHTING PLAN
C5.1	DETAILS
C5.2	DETAILS
C5.3	DETAILS
C5.4	DETAILS
C5.5	DETAILS
C5.6	DETAILS
A2.21	EXTERIOR ELEVATIONS - BLDG 2
A2.22	EXTERIOR ELEVATIONS - BLDG 2
A2.31	EXTERIOR ELEVATIONS - BLDG 3
A2.32	EXTERIOR ELEVATIONS - BLDG 3
A2.51	EXTERIOR ELEVATIONS - BLDG 5
A2.61	EXTERIOR ELEVATIONS - BLDG 6
A2.62	EXTERIOR ELEVATIONS - BLDG 6
A2.71	EXTERIOR ELEVATIONS - BLDGS 1& 7
A2.72	EXTERIOR ELEVATIONS - BLDGS 1& 7
A2.81	EXTERIOR ELEVATIONS - BLDG 8

NCDOT Driveway permit - Not Approved, resubmitted 4/22
NCDOT 16.1B Encroachment - Not Applied For
NCDOT 16.6 Encroachment - Not Approved
S. Sewer Encroachment - Not Applied For

Provide:
- Profile Views of Driveway Stems and Roadway Widening
- Cross Sections of Widening
- Typical Sections
- Pavement Sections
- Drainage Calculations
- Cost Estimate for Work in ROW

I have included the relevant pages from the LAPP project in this area. These plans have been put out for build, and should not change going forward. Please include roadway drawings for all changes to NCDOT roadways that are not accounted for in the U-6241 plans.

CONSTRUCTION NOTES

- ALL CONSTRUCTION SHALL BE IN ACCORDANCE WITH APPLICABLE MUNICIPALITY STANDARDS, SPECIFICATIONS, AND DETAILS. WORK IN THIS PROJECT SHALL ALSO CONFORM TO THESE PLANS, THE LATEST EDITIONS OF THE NORTH CAROLINA DEPARTMENT OF TRANSPORTATION (NCDOT) ROAD AND BRIDGE SPECIFICATIONS, THE ROAD AND BRIDGE STANDARDS, THE NORTH CAROLINA EROSION AND SEDIMENT CONTROL HANDBOOK, THE NORTH CAROLINA EROSION AND SEDIMENT CONTROL REGULATIONS, THE FINAL GEOTECHNICAL REPORT, AND GENERAL DESIGN STANDARDS. IN THE EVENT OF CONFLICT BETWEEN ANY OF THESE STANDARDS, SPECIFICATIONS, OR PLANS, THE MOST STRINGENT SHALL GOVERN.
- THE CONTRACTOR SHALL BE SOLELY RESPONSIBLE FOR TRENCH SAFETY DURING ALL PHASES OF CONSTRUCTION.
- THE LOCATION AND SIZE OF EXISTING UTILITIES AS SHOWN IS APPROXIMATE ONLY. THE CONTRACTOR IS RESPONSIBLE FOR HORIZONTALLY AND VERTICALLY LOCATING AND PROTECTING ALL PUBLIC OR PRIVATE UTILITIES WHICH LIE IN OR ADJACENT TO THE CONSTRUCTION SITE. AT LEAST 48 HOURS PRIOR TO ANY DEMOLITION, GRADING, OR CONSTRUCTION ACTIVITY, THE CONTRACTOR SHALL NOTIFY THE NORTH CAROLINA ONE-CALL UTILITIES LOCATION SERVICE (U-1000) AT 1-800-632-4949 FOR PROPER IDENTIFICATION OF EXISTING UTILITIES WITHIN THE SITE.
- THE CONTRACTOR SHALL SALVAGE AND PROTECT ALL EXISTING POWER POLES, SIGNS, MANHOLES, TELEPHONE RISERS, WATER VALVES, ETC. DURING ALL CONSTRUCTION PHASES. THE CONTRACTOR SHALL REPAIR, AT HIS OWN EXPENSE, ANY EXISTING UTILITIES DAMAGED DURING CONSTRUCTION.
- TRAFFIC CONTROL ON PUBLIC STREETS SHALL BE IN CONFORMANCE WITH THE TRAFFIC CONTROL PLAN, THE MANUAL OF UNIFORM TRAFFIC CONTROL DEVICES, AND AS FURTHER DIRECTED BY CITY AND STATE INSPECTORS.
- ANY DISCREPANCIES FOUND BETWEEN THE DRAWINGS AND SPECIFICATIONS AND SITE CONDITIONS OR ANY INCONSISTENCIES OR AMBIGUITIES IN DRAWINGS OR SPECIFICATIONS SHALL BE IMMEDIATELY REPORTED TO THE ENGINEER, IN WRITING, WHO SHALL PROMPTLY ADDRESS SUCH INCONSISTENCIES OR AMBIGUITIES. WORK DONE BY THE CONTRACTOR AFTER HIS DISCOVERY OF SUCH DISCREPANCIES, INCONSISTENCIES, OR AMBIGUITIES SHALL BE DONE AT THE CONTRACTOR'S RISK.
- A PRE-CONSTRUCTION CONFERENCE SHALL BE HELD PRIOR TO THE START OF CONSTRUCTION. THE CONTRACTOR SHALL AFFRANGE THE MEETING WITH THE CITY ENGINEERING DIVISION.
- CONTRACTOR IS RESPONSIBLE FOR VERIFYING ALL REQUIRED PERMITS AND APPROVALS PRIOR TO COMMENCING CONSTRUCTION.
- ALL AREAS SHALL BE GRADED FOR POSITIVE DRAINAGE, AND AS SHOWN ON THESE PLANS, THE CONTRACTOR SHALL MAINTAIN ADEQUATE SITE DRAINAGE DURING ALL PHASES OF CONSTRUCTION. THE CONTRACTOR SHALL USE SILT FENCES (OR OTHER METHODS APPROVED BY THE ENGINEER AND APPLICABLE MUNICIPALITY) AS REQUIRED TO PREVENT SILT AND CONSTRUCTION DEBRIS FROM FLOWING ONTO ADJACENT PROPERTIES. CONTRACTOR SHALL COMPLY WITH ALL APPLICABLE FEDERAL, STATE, OR LOCAL EROSION, CONSERVATION, AND SILTATION ORDINANCES. CONTRACTOR SHALL REMOVE ALL TEMPORARY EROSION CONTROL DEVICES UPON COMPLETION OF PERMANENT DRAINAGE FACILITIES AND THE ESTABLISHMENT OF A STAND OF GRASS OR OTHER GROWTH TO PREVENT EROSION.
- THE CONTRACTOR SHALL CLEAR AND GRUB THE SITE AND PLACE, COMPACT, AND MOISTURE CONDITION ALL FILL PER THE PROJECT GEOTECHNICAL ENGINEER'S SPECIFICATIONS. THE FILL MATERIAL TO BE USED SHALL BE APPROVED BY THE GEOTECHNICAL ENGINEER PRIOR TO PLACEMENT.
- MATERIALS USED TO CONSTRUCT EMBANKMENTS FOR ANY PURPOSE, BACKFILL AROUND DRAINAGE STRUCTURES, OR IN UTILITY TRENCHES FOR ANY OTHER DEPRESSION REQUIRING FILL OR BACKFILL SHALL BE COMPACTED TO 95% OF MAXIMUM DENSITY AS DETERMINED BY THE STANDARD PROCTOR TEST AS SET OUT IN ASTM STANDARD D698. STONE BACKFILL SHALL BE COMPACTED TO 95% MAXIMUM DENSITY AS DETERMINED BY THE MODIFIED PROCTOR TEST AS SET OUT IN ASTM STANDARD D1557. THE CONTRACTOR SHALL, PRIOR TO ANY OPERATIONS INVOLVING FILLING OR BACKFILLING, SUBMIT THE RESULTS OF THE PROCTOR TEST TOGETHER WITH A CERTIFICATION THAT THE SOIL TESTED IS REPRESENTATIVE OF THE MATERIALS TO BE USED ON THE PROJECT. TESTS SHALL BE CONDUCTED BY A CERTIFIED MATERIALS TESTING LABORATORY AND THE CERTIFICATIONS MADE BY A LICENSED PROFESSIONAL ENGINEER REPRESENTING THE LABORATORY.
- PROPOSED CONTOURS AND GUTTER GRADIENTS ARE APPROXIMATE. PROPOSED SPOT ELEVATIONS AND ROADWAY PROFILES/SUPERELEVATIONS ARE TO BE USED IN CASE OF DISCREPANCY.
- THE CONTRACTOR SHALL REVIEW, VERIFY AND COORDINATE ALL DIMENSIONS SHOWN ON PLANS, INCLUDING THE HORIZONTAL AND VERTICAL LOCATION OF CURB INLETS AND GRATE INLETS AND ALL UTILITIES CROSSING THE STORM SEWER PRIOR TO STARTING PROJECT.
- ALL CURB JOINTS SHALL EXTEND THROUGH THE CURB. MINIMUM LENGTH OF OFFSET JOINTS AT RADIUS POINTS IS 1.5 FEET. ALL JOINTS SHALL BE SEALED WITH JOINT SEALANT.
- ALL HANDICAP RAMPING, STRIPING, AND PAVEMENT MARKINGS SHALL CONFORM TO ADA REQUIREMENTS AND THE NORTH CAROLINA STATE BUILDING CODE, VOL. 1-C ACCESSIBILITY CODE.
- OWNER SHALL PROVIDE FENCING AND OTHER SAFETY MEASURES NECESSARY IN AND AROUND ANY PROPOSED STORMWATER MANAGEMENT MEASURES (POND, WETLANDS, ETC.) OBTAINING PROPER PERMITS SHALL BE THE RESPONSIBILITY OF THE OWNER.
- RETAINING WALLS EXCEEDING 30 INCHES IN HEIGHT SHALL INCLUDE FALL PROTECTION IN THE FORM OF A HANDRAIL OR FENCING ON THE HIGH SIDE OF THE RETAINING WALL.
- PROPER COMPACTION OF ALL FILL SOILS PLACED ON SITE SHALL BE THE RESPONSIBILITY OF THE CONTRACTOR. COMPACTION SHALL BE ADEQUATE TO SUPPORT THE PROPOSED USE OF AREAS IN WHICH FILL SOILS ARE PLACED. THE CONTRACTOR SHALL HIRE A GEOTECHNICAL ENGINEER TO TEST AND VERIFY THAT COMPACTION IS ADEQUATE FOR THE PROPOSED USE OF IN THE AREA OF FILL PLACEMENT.
- ALL ASPECTS OF THIS PROJECT SHALL BE IN FULL COMPLIANCE WITH CURRENT ADA STANDARDS. IF THE CONTRACTOR NOTES ANY ASPECTS OF THE PROJECT WHICH ARE NOT IN COMPLIANCE, THE ENGINEER SHALL BE NOTIFIED PRIOR TO ANY FURTHER WORK BEING PERFORMED. ANY WORK PERFORMED AFTER THE CONTRACTOR NOTES SUCH A NON COMPLIANCE IS SUBJECT TO REMOVAL AND REPAIR AT THE CONTRACTOR'S EXPENSE.
- THE CONTRACTOR OR OWNER SHALL EMPLOY A GEOTECHNICAL ENGINEER TO TEST ALL EMBANKMENTS AND FILL PLACEMENT FOR PROPER COMPACTION. PROPER COMPACTION SHALL BE PER THE GEOTECHNICAL ENGINEER'S RECOMMENDATIONS OR THESE PLANS, WHICHEVER IS MORE STRINGENT. EMBANKMENTS FOR POND, SHALL BE PLACED IN 6 INCH LOOSE LAYERS AND SHALL BE COMPACTED TO A DENSITY OF NO LESS THAN 95% OF THE STANDARD PROCTOR MAXIMUM DENSITY AT A MOISTURE CONTENT OF 4% OR TWO PERCENTAGE POINTS OF THE OPTIMUM MOISTURE CONTENT IN ACCORDANCE WITH ASTM D698. THE CONTRACTOR SHALL TAKE PHOTOGRAPHS OF THE OUTLET STRUCTURE AT ALL AT ALL PHASES OF INSTALLATION AND SHALL RETAIN WITH GEOTECHNICAL TESTING DATA. THE CONTRACTOR SHALL ALSO RETAIN ALL SHIPPING RECORDS AND SPECIFICATIONS FOR THE OUTLET STRUCTURE MATERIALS AND STRUCTURES. ALL OF THE ABOVE DATA MAY BE REQUIRED AS PART OF THE MUNICIPALITY AS-BUILT PROCESS AND SHALL BE MADE AVAILABLE TO THE ENGINEER UPON REQUEST. THE CONTRACTOR AND OWNER SHALL HAVE DOCUMENTATION OF THESE TESTS AVAILABLE UPON REQUEST.
- RETAINING WALLS SHOWN HEREIN SHALL BE DESIGNED BY A QUALIFIED PROFESSIONAL ENGINEER WITH EXPERIENCE DESIGNING RETAINING WALLS. AT LEAST 14 DAYS PRIOR TO BEGINNING CONSTRUCTION OF RETAINING WALLS, THE CONTRACTOR SHALL CONTACT THE OWNER'S GEOTECHNICAL ENGINEER TO SCHEDULE AND COORDINATE ALL APPROPRIATE INSPECTIONS, TESTING, AND VERIFICATION NECESSARY DURING RETAINING WALL CONSTRUCTION. THE GEOTECHNICAL ENGINEER SHALL PROVIDE CONTINUOUS INSPECTION, TESTING AND VERIFICATION FOR THE DURATION OF RETAINING WALL CONSTRUCTION. PROPER SCHEDULING, EXECUTION, AND RECORD KEEPING FOR ALL REQUIRED INSPECTIONS, TESTING, AND VERIFICATION SHALL BE THE RESPONSIBILITY OF THE CONTRACTOR. SUCH RECORDS SHALL BE RETAINED AND SHALL BE PROVIDED TO THE OWNER AND BASS, NIXON & KENNEDY, INC. ALL MONITORING, TESTING, AND VERIFICATION SHALL CONFORM TO THE MOST RECENT VERSION OF THE NC BUILDING CODE CHAPTER 18, SECTION 1806 OR THE WALL DESIGN ENGINEER'S SPECIFICATIONS, WHICHEVER IS MORE STRINGENT.



QUANTITY SUMMARY

PHASE NUMBER(S)	1
NUMBER OF LOT(S)	1
LOT NUMBER(S) BY PHASE	N/A
NUMBER OF UNITS	180
LIVABLE BUILDINGS	6
OPEN SPACE (AC)	3.48
NUMBER OF OPEN SPACE LOTS	N/A
PUBLIC WATER (LF)	875
PRIVATE SEWER (LF)	550
PUBLIC STREET (LF)	0
PUBLIC SIDEWALK (LF)	255

ENGINEER:

BNK

BASS, NIXON & KENNEDY, INC.
CONSULTING ENGINEERS

6310 CHAPEL HILL ROAD, SUITE 250
RALEIGH, NORTH CAROLINA 27607
TELEPHONE: (919) 851-4422
FAX: (919) 851-8968

CERTIFICATION NUMBERS: NCBELS (C-0110)
NCBOLA (C-0267)

CONTACT: MARTY D. BIZZELL, PE, CPESC
EMAIL: Marty.Bizzell@BNKinc.com



EROSION CONTROL, STORMWATER AND FLOODPLAIN MANAGEMENT

APPROVED

EROSION CONTROL ☐ S-

STORMWATER MGMT. ☐ S-

FLOOD STUDY ☐ S-

DATE _____




ENVIRONMENTAL CONSULTANT SIGNATURE

CITY OF RALEIGH - PLANS AUTHORIZED FOR CONSTRUCTION

Electronic Approval: This approval is being issued electronically. This approval is valid only upon the signature of a City of Raleigh Review Officer below. The City will retain a copy of the approved plans. Any work authorized by this approval must proceed in accordance with the plans kept on file with the City. This electronic approval may not be edited once issued. Any modification to this approval once issued will invalidate this approval.

City of Raleigh Development Approval _____

Raleigh Water Review Officer _____

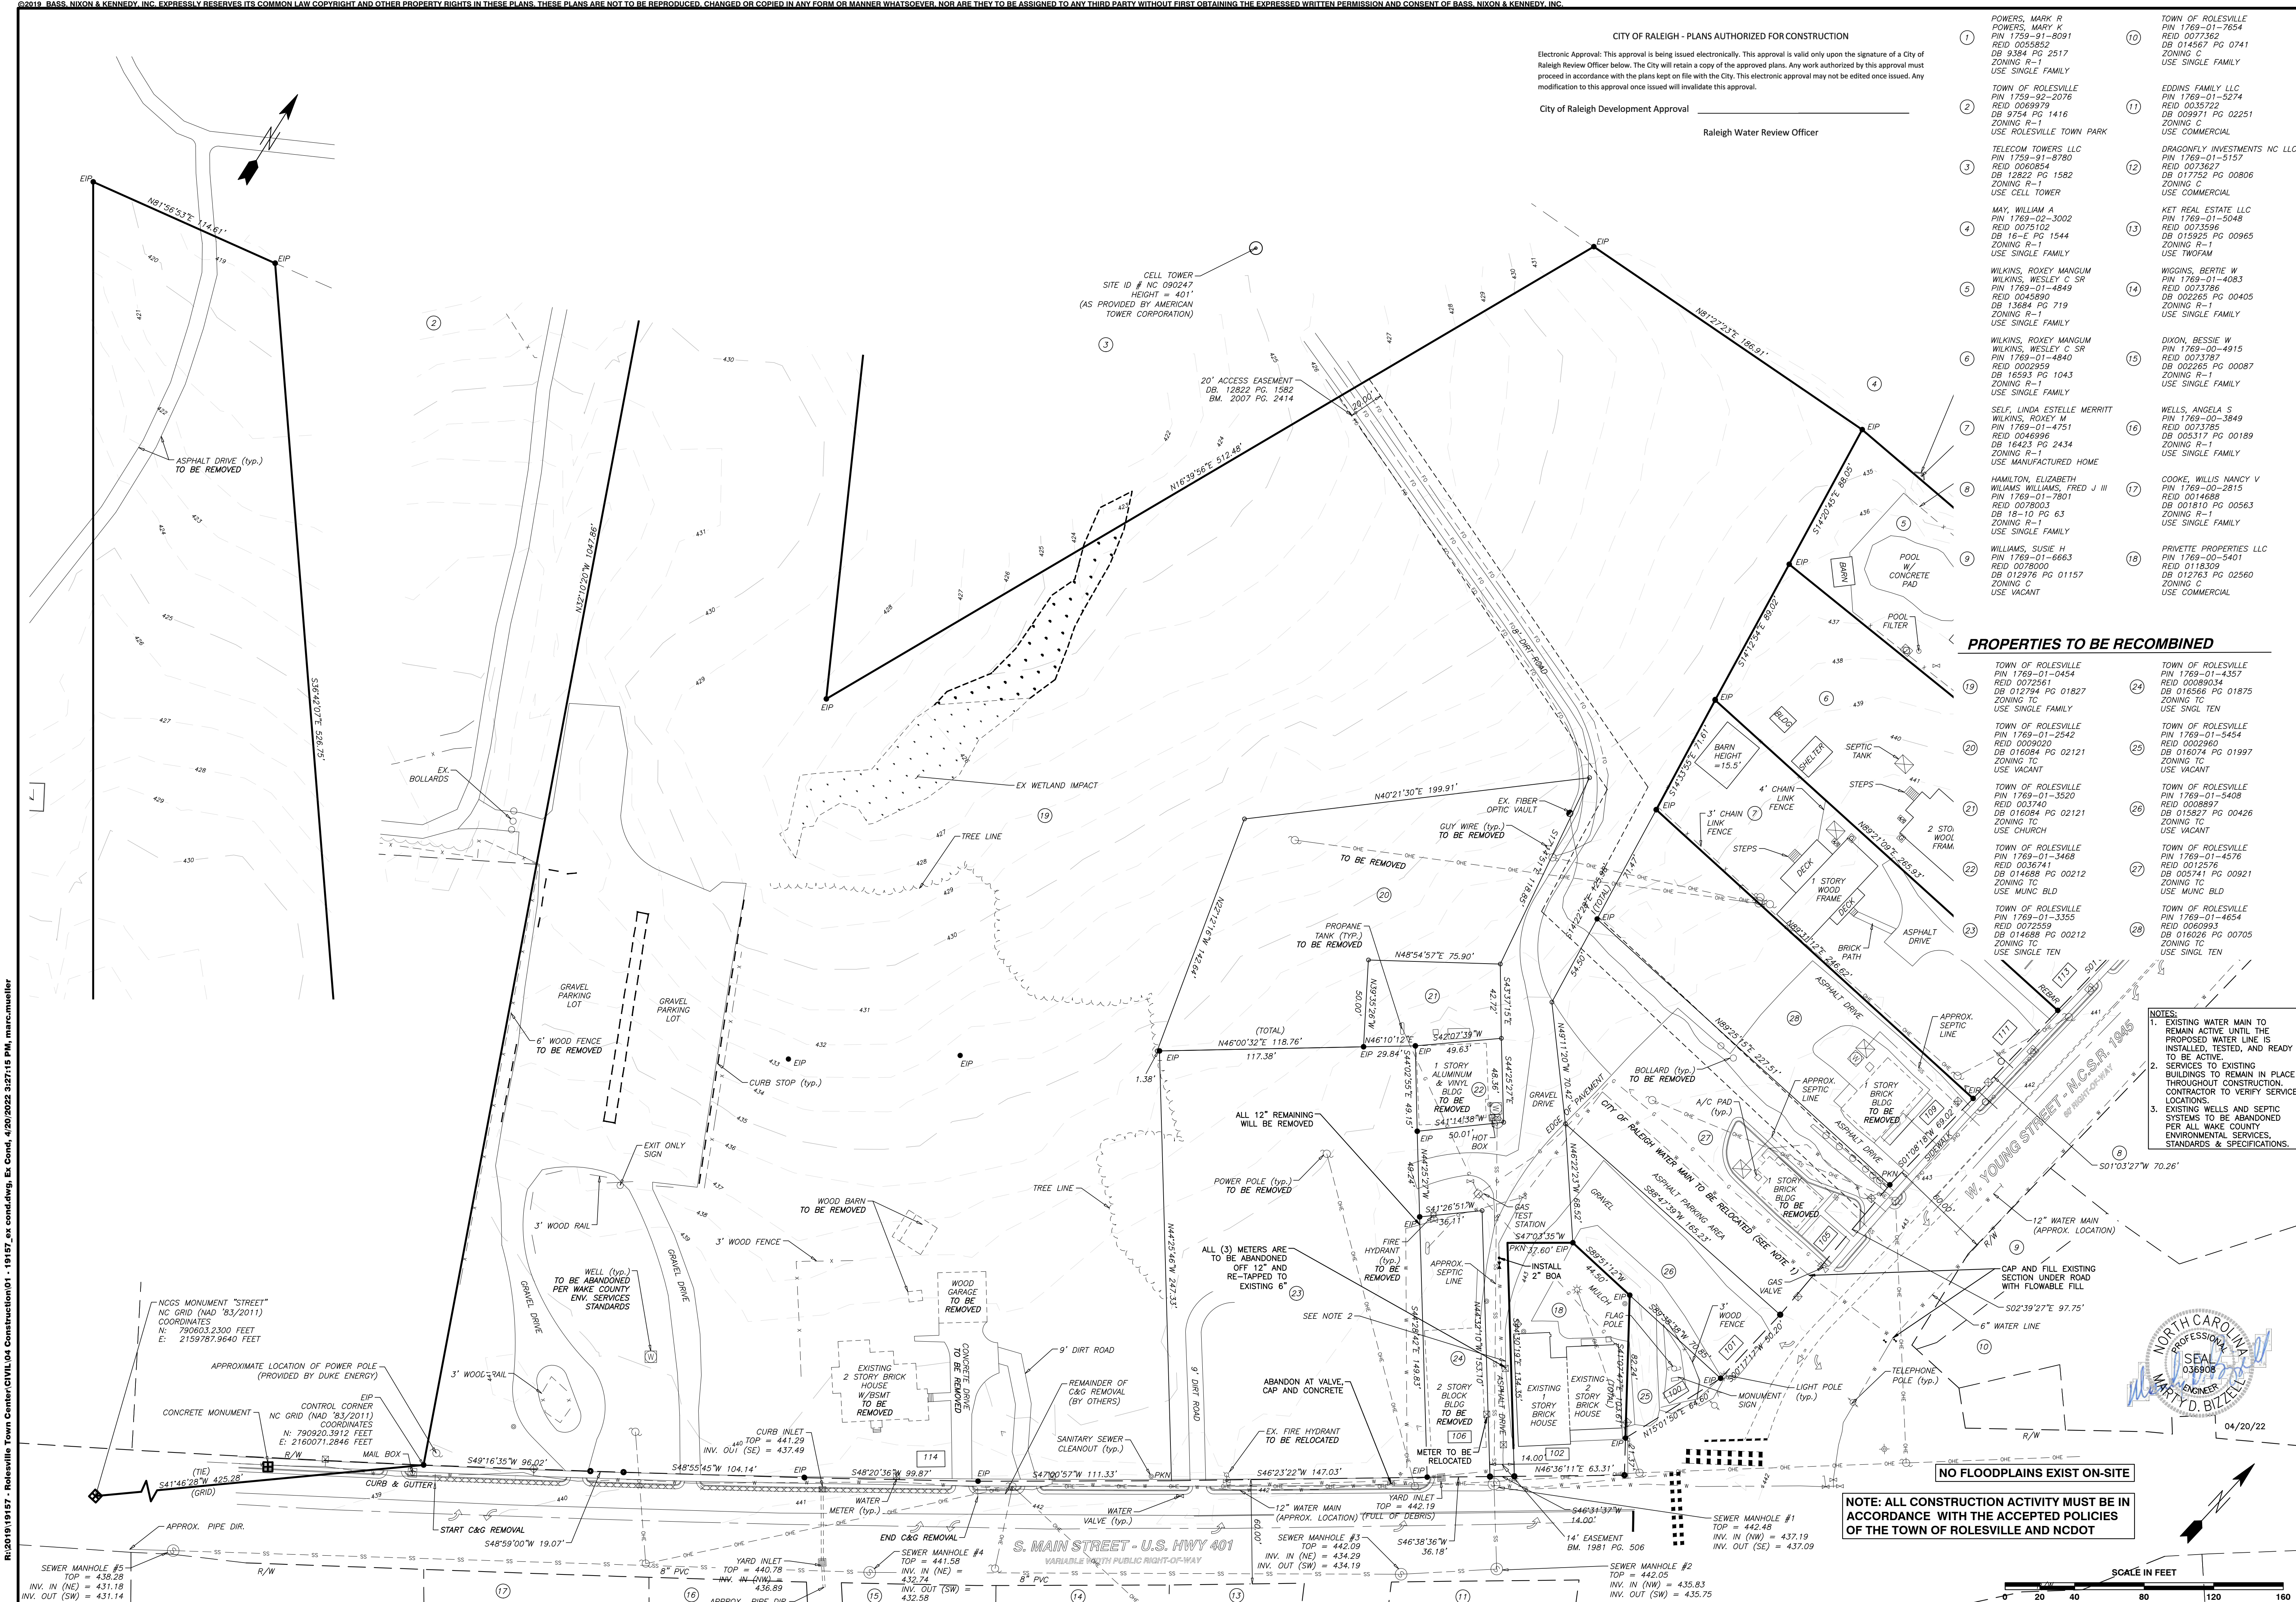


PROPERTIES TO BE RECOMBINED

19	TOWN OF ROLESVILLE PIN 1769-01-0454 REID 0009020 DB 012794 PG 01827 ZONING TC USE SINGLE FAMILY	24	TOWN OF ROLESVILLE PIN 1769-01-2542 REID 0009020 DB 016074 PG 02121 ZONING TC USE VACANT
20	TOWN OF ROLESVILLE PIN 1769-01-3520 REID 003740 DB 016084 PG 02121 ZONING TC USE CHURCH	25	TOWN OF ROLESVILLE PIN 1769-01-5454 REID 0002960 DB 016074 PG 01997 ZONING TC USE VACANT
21	TOWN OF ROLESVILLE PIN 1769-01-3468 REID 0036741 DB 014688 PG 00212 ZONING TC USE MUNC BLD	26	TOWN OF ROLESVILLE PIN 1769-01-5408 REID 0008897 DB 015827 PG 00426 ZONING TC USE VACANT
22	TOWN OF ROLESVILLE PIN 1769-01-3353 REID 0072559 DB 014688 PG 00212 ZONING TC USE SINGLE TEN	27	TOWN OF ROLESVILLE PIN 1769-01-4576 REID 0012576 DB 005741 PG 00921 ZONING TC USE MUNC BLD
23	TOWN OF ROLESVILLE PIN 1769-01-4654 REID 0060993 DB 016026 PG 00705 ZONING TC USE SINGL TEN	28	TOWN OF ROLESVILLE PIN 1769-01-4576 REID 0012576 DB 005741 PG 00921 ZONING TC USE MUNC BLD

- NOTES:
- EXISTING WATER MAIN TO REMAIN ACTIVE UNTIL THE PROPOSED WATER LINE IS INSTALLED, TESTED, AND READY TO BE ACTIVE.
 - SERVICES TO EXISTING BUILDINGS TO REMAIN IN PLACE THROUGHOUT CONSTRUCTION. CONTRACTOR TO VERIFY SERVICE LOCATIONS.
 - EXISTING WELLS AND SEPTIC SYSTEMS TO BE ABANDONED PER ALL WAKE COUNTY ENVIRONMENTAL SERVICES, STANDARDS & SPECIFICATIONS.



NOTE: ALL CONSTRUCTION ACTIVITY MUST BE IN ACCORDANCE WITH THE ACCEPTED POLICIES OF THE TOWN OF ROLESVILLE AND NCDOT

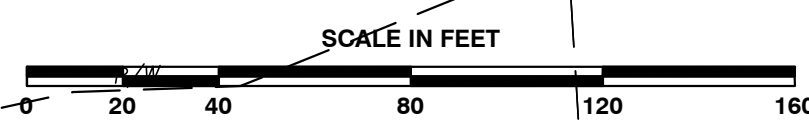

BASS, NIXON & KENNEDY, INC.
CONSULTING ENGINEERS
6310 CHAPEL HILL ROAD, SUITE 250, RALEIGH, NC 27607
TELEPHONE: (919) 881-4422 FAX: (919) 881-6868
CERTIFICATION NUMBERS: NCBELS (C-0110); NCBOLA (C-0267)

PROGRESS	DATE	BY	DESCRIPTION	REVISIONS
03/19/17	03/19/17	MM	EXISTING CONDITIONS & DEMOLITION PLAN	

COBBLESTONE VILLAGE
MIXED USE DEVELOPMENT
TOWN OF ROLESVILLE, WAKE COUNTY, NORTH CAROLINA

SHEET
C0.1

CITY OF RALEIGH - PLANS AUTHORIZED FOR CONSTRUCTION

Electronic Approval: This approval is being issued electronically. This approval is valid only upon the signature of a City of Raleigh Review Officer below. The City will retain a copy of the approved plans. Any work authorized by this approval must proceed in accordance with the plans kept on file with the City. This electronic approval may not be edited once issued. Any modification to this approval once issued will invalidate this approval.


City of Raleigh Development Approval

Raleigh Water Review Officer

OVERALL SITE DATA

SITE AREA	10.96 AC (477,418 SF±)
P.I.N.	1769-01-0454, 1769-01-4357, 1769-01-3355 1769-01-3468, 1769-01-2542, 1769-01-3520 1769-01-4654, 1769-01-5454, 1769-01-5408, 1769-01-4576
ZONING DISTRICT:	TOWN CENTER (TC) RESIDENTIAL, MIXED USE
OPEN SPACE AREA:	3.48 AC
IMPERVIOUS AREA:	7.48 AC
IMPERVIOUS AREA (%):	68%
APARTMENT MIX	112 UNITS
1 BEDROOM	64 UNITS
2 BEDROOM	176 UNITS
TOTAL APARTMENTS	
RESIDENTIAL DENSITY:	16.06 UNITS/ACRE
RETAIL/COMMERCIAL:	49,830 SQUARE FEET
MUNICIPAL FLEX SPACE:	15,900 SQUARE FEET
TOTAL:	65,730 SQUARE FEET
EVENT SPACE:	0.44 ACRES/ 18,976 SQUARE FEET
PARKING REQUIREMENTS PER TC DISTRICT DEVELOPMENT STANDARDS	
MIXED USE RESIDENTIAL: 2.0 SPACES PER UNIT	176 x 2 = 352 SPACES REQUIRED
MIXED USE NON-RESIDENTIAL: 3 SPACES PER 1000 GSF	65,730/1000 x 3 = 197 SPACES REQUIRED
TOTAL PARKING REQUIRED/PROVIDED:	549 SPACES REQUIRED/ 488 PROVIDED
5% OF ON STREET PARKING MAY BE COUNTED AS REQUIRED PARKING (28 ALLOWED/ 24 PROVIDED)	
15% PARKING REDUCTION ALLOWED FOR SHARED PARKING: 549 x .85 = 467 REQUIRED	
BUILDING 1:	51,882 SF APARTMENTS
BUILDING 2:	16,641 SF RETAIL
BUILDING 3:	11,405 SF RETAIL
BUILDING 4:	15,900 SF MUNICIPAL
BUILDING 5:	3,816 FLEX
BUILDING 6:	18,148 SF RETAIL
BUILDING 7:	51,882 SF APARTMENTS
BUILDING 8:	17,453 SF APARTMENTS


- CONDITIONS OF APPROVAL:
1. TECHNICAL REVIEW COMMITTEE APPROVAL AND ISSUANCE OF REQUIRED PERMITS FROM ALL AGENCIES MUST BE ACHIEVED AND SUBMITTED FOR REVIEW AND RECORD RETENTION PRIOR TO FINAL SIGNATURE AND APPROVAL OF THE SITE PLAN.
 2. CROSS-CONNECTION ACCESS TO ONE OF THE THREE ADJACENT PROPERTIES TO THE EAST ALONG W. YOUNG STREET (111, 113, AND 115 W. YOUNG STREET) FOR FUTURE DEVELOPMENT WILL BE PROVIDED.
 3. BEST EFFORTS WILL BE MADE FOR GREENWAY ACCESS ACROSS THE TELECOM TOWERS, LLC SITE FOR PEDESTRIAN TRAFFIC FROM OVERFLOW PARKING SITE LOCATED AT THE TERMINUS OF SCARBORO STREET IN MAIN STREET PARK.
 4. BASED UPON TESTIMONY REGARDING SHARED PARKING IN A MIXED-USE DEVELOPMENT, A 15% PARKING REDUCTION IS GRANTED RESULTING IN 467 REQUIRED SPACES.
 5. A MAXIMUM HEIGHT OF 60 FEET IS APPROVED PER THE BUILDING HEIGHT DESIGN ALTERNATIVE FOR THE SITE AS SHOWN ON THE SITE PLAN, PROVIDED ALL OTHER APPLICABLE STANDARDS ACCORDING TO THE LDO ARE MET.

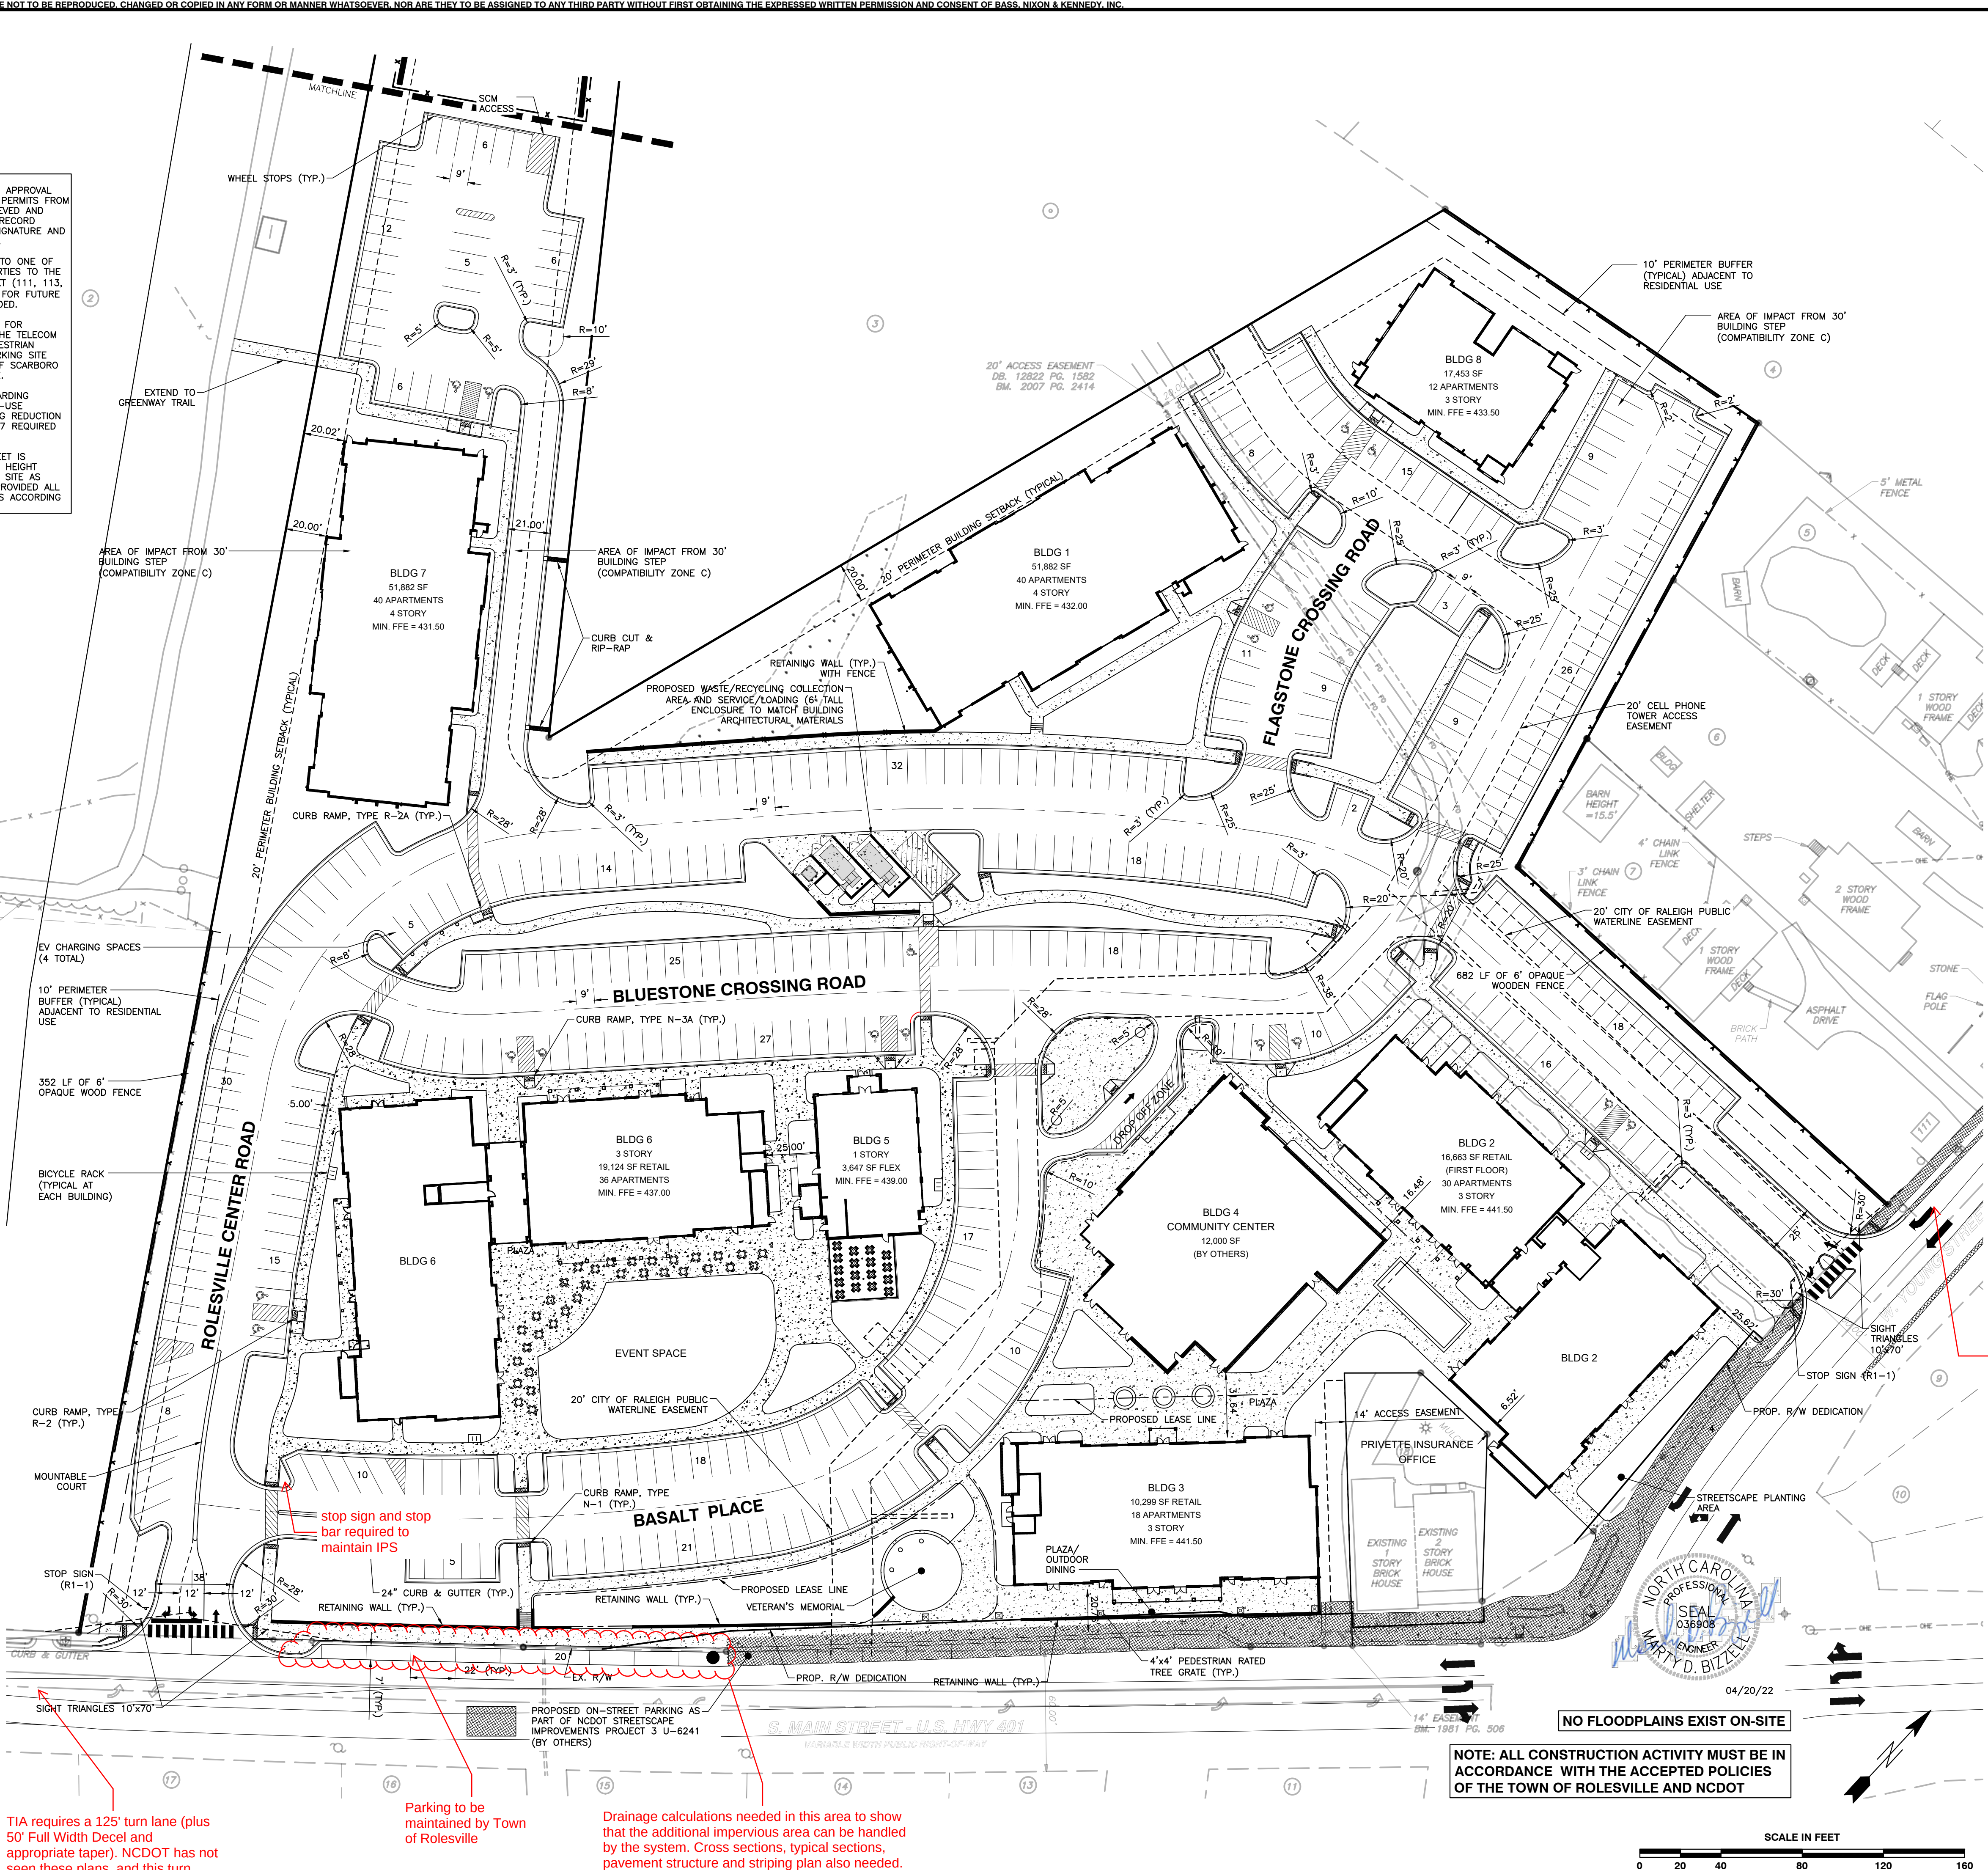

TIA requires a 125' turn lane (plus 50' Full Width Decel and appropriate taper). NCDOT has not seen these plans, and this turn lane is not included in U-6241

Parking to be maintained by Town of Rolesville

Drainage calculations needed in this area to show that the additional impervious area can be handled by the system. Cross sections, typical sections, pavement structure and striping plan also needed.

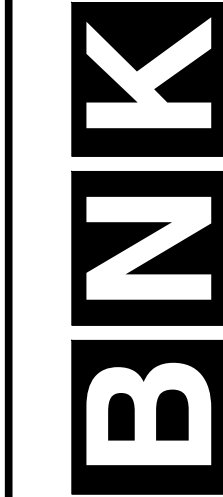

BASS, NIXON & KENNEDY, INC.
CONSULTING ENGINEERS
6310 CHAPEL HILL ROAD, SUITE 250, RALEIGH, NC 27607
TELEPHONE: (919)881-1122 FAX: (919)881-8888
CERTIFICATION NUMBERS: NCBELS (C-0110); NCBOLA (C-0267)

PROGRESS	MM	DATE	BY	DESCRIPTION	REVISIONS
03-19157	DATE				
JOB NO.					
SITE PLAN					
SCALE: 1" = 40'	CHK BY: MDB				

100' turn lane (plus 50' full width decel and appropriate taper) required by TIA. NCDOT has not seen these plans. This turn lane is required in addition to the 2 southbound thru lanes. Striping plan, cross sections, typical section, and pavement structure plans also needed

COBBLESTONE VILLAGE
MIXED USE DEVELOPMENT
TOWN OF ROLESVILLE, WAKE COUNTY

SHEET
C1.1

NOT RELEASED FOR CONSTRUCTION OR

CITY OF RALEIGH - PLANS AUTHORIZED FOR CONSTRUCTION


Electronic Approval: This approval is being issued electronically. This approval is valid only upon the signature of a City of Raleigh Review Officer below. The City will retain a copy of the approved plans. Any work authorized by this approval must proceed in accordance with the plans kept on file with the City. This electronic approval may not be edited once issued. Any modification to this approval once issued will invalidate this approval.

City of Raleigh Development Approval

Raleigh Water Review Officer

Structure	d _s (ft)	Velocity (fps)	Length (ft)	Width (ft)	Depth (in)	Type	d ₅₀
FES 1	2.00	7.4	12	6	22	Class 'B'	6" - 13"
FES 3	3.00	6.5	18	9	22	Class 'B'	6" - 13"

* Per NYDOT Dissipator Schedule Fig.1

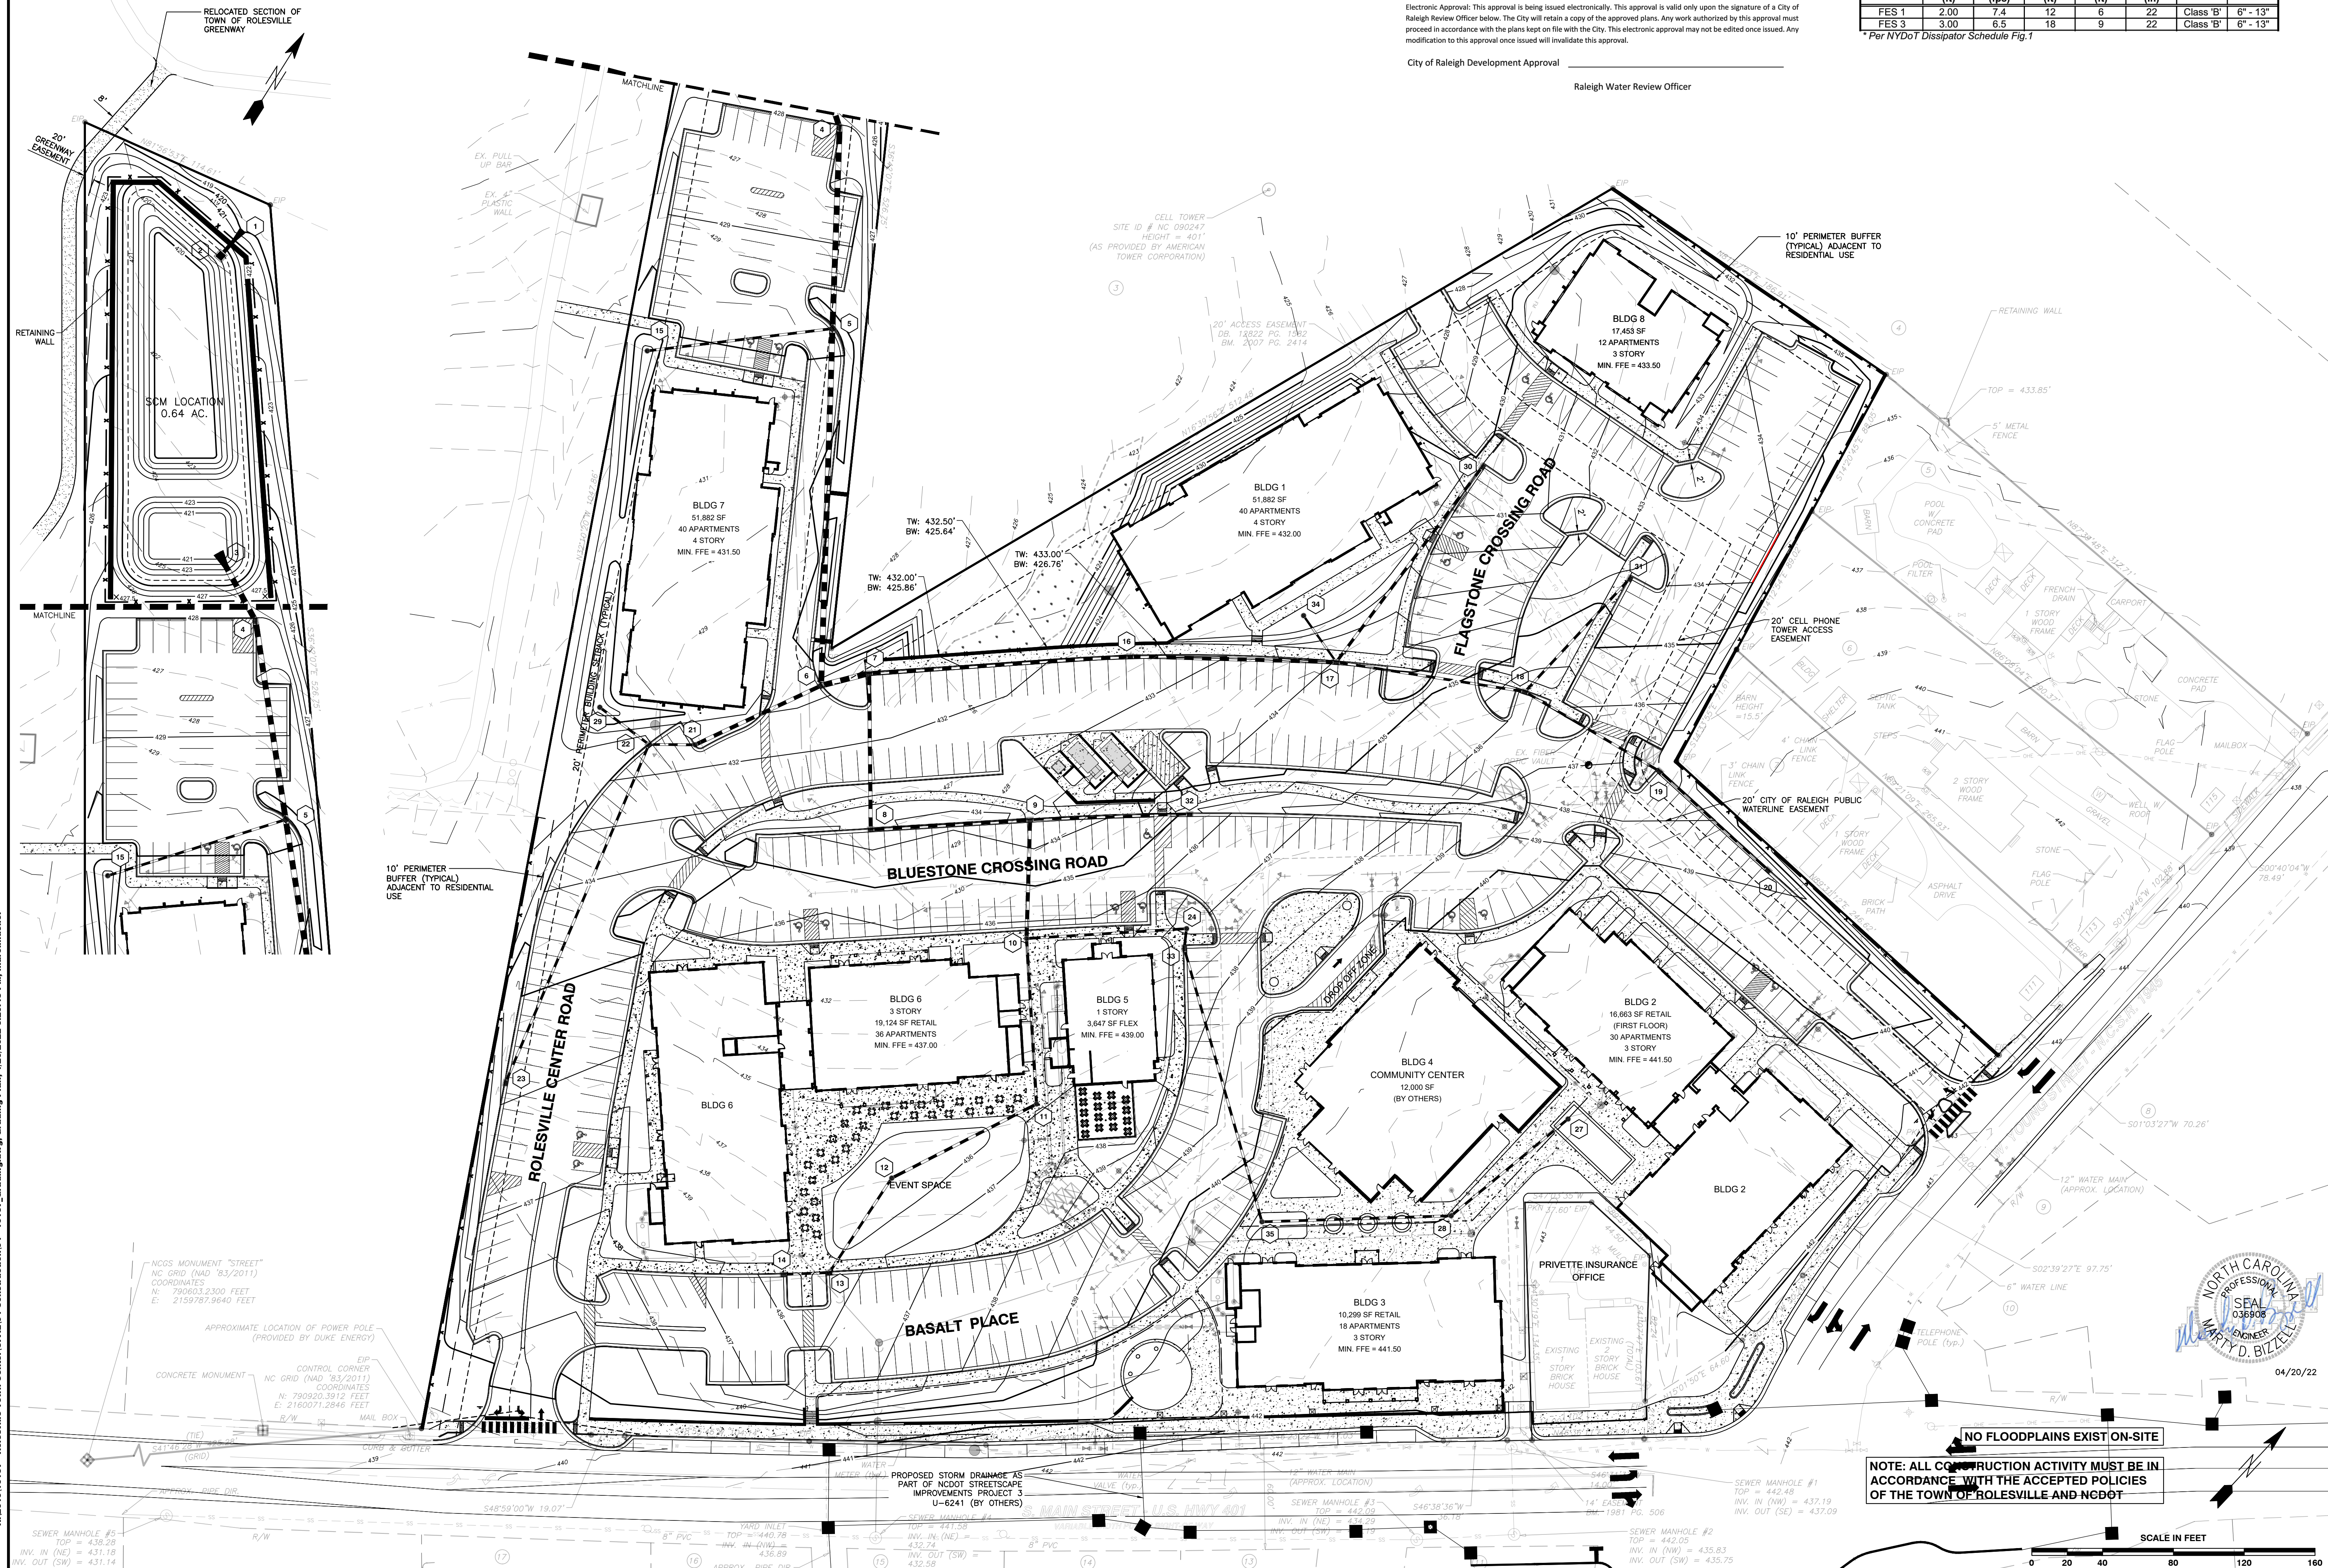

BASS, NIXON & KENNEDY, INC.
CONSULTING ENGINEERS
6310 CHAPEL HILL ROAD, SUITE 250, RALEIGH, NC 27607
TELEPHONE: (919) 851-1122 FAX: (919) 851-6868
CERTIFICATION NUMBERS: NCBELS (C-0110); NCBOLA (C-0267)

GRADING PLAN

COBBLESTONE VILLAGE
MIXED USE DEVELOPMENT
TOWN OF RALEIGH, WAKE COUNTY, NORTH CAROLINA

SHEET C3.1

TOWN OF RALEIGH PROJECT NO.

NOT RELEASED FOR CONSTRUCTION OR BID SOLICITATION



CONSTRUCTION SEQUENCE - STAGE 1

- ONCE THE EROSION AND SEDIMENT CONTROL PLAN APPROVAL AND NCG01 CERTIFICATE OF COVERAGE ARE OBTAINED, SCHEDULE A PRECONSTRUCTION CONFERENCE WITH THE ENVIRONMENTAL CONSULTANT, OBTAIN A LAND-DISTURBING PERMIT.
- INSTALL GRAVEL CONSTRUCTION PAD, TEMPORARY DIVERSIONS, SILT FENCE, SKIMMER SEDIMENT BASINS AND OTHER MEASURES AS SHOWN ON THE APPROVED PLAN. CLEAR ONLY AS NECESSARY TO INSTALL THESE DEVICES. SEED TEMPORARY DIVERSIONS, BERMS AND BASINS IMMEDIATELY AFTER CONSTRUCTION.
- CALL ENVIRONMENTAL CONSULTANT FOR AN ONSITE INSPECTION BY THE ENVIRONMENTAL CONSULTANT TO OBTAIN A CERTIFICATE OF COMPLIANCE. BEGIN CLEARING AND GRUBBING. MAINTAIN DEVICES AS NEEDED. ROUGH GRADE SITE.
- STABILIZE SITE AS AREAS ARE BROUGHT UP TO FINISH GRADE WITH VEGETATION, PAVING, DITCH LININGS, ETC. SEED AND MULCH DENUDED AREAS PER GROUND STABILIZATION TIME FRAMES.
- STABILIZE SITE AS AREAS ARE BROUGHT UP TO FINISH GRADE WITH VEGETATION, ALLEY PAVING, DITCH LININGS, ETC. SEED AND MULCH DENUDED AREAS PER GROUND STABILIZATION TIME FRAMES.
- CALL ENVIRONMENTAL CONSULTANT FOR AN ONSITE INSPECTION BY THE ENVIRONMENTAL CONSULTANT PRIOR TO THE REMOVAL OF SKIMMER SEDIMENT BASIN #1.
- CONTINUE TO SOIL EROSION PLAN STAGE 2 ONCE SKIMMER BASIN #1 HAS BEEN REMOVED.

NOTE: WAKE COUNTY MUST GRANT PERMISSION TO CONVERT THE SEDIMENT BASIN OVER TO THE STORMWATER USE PRIOR TO COMPLETING ANY RELATED WORK.

TOTAL DISTURBED AREA = 11.0 AC

DENUDED AREA = 10.96 AC

REQUIRED WAKE COUNTY BASIN REMOVAL AND/OR CONVERSION SEQUENCE

- SCHEDULE A SITE MEETING WITH THE ENVIRONMENTAL CONSULTANT TO DETERMINE IF A BASIN CAN BE REMOVED OR CONVERTED TO A PERMANENT STORMWATER POND, INSTALL SILT FENCING OR OTHER TEMPORARY EROSION CONTROL MEASURES AS NEEDED PRIOR TO REMOVAL OF THE BASIN.
- UTILIZE OUTLET STRUCTURES THAT WITHDRAW WATER FROM THE SEDIMENT BASIN SURFACE FOR DRAW DOWN OF WATER IN BASIN FOR MAINTENANCE OR CLOSE OUT UNLESS INFEASIBLE. SEE REQUIREMENTS OF NCG01 PERMIT PART I, SECTION G, ITEM (4) ENTITLED "DRAW DOWN OF SEDIMENT BASINS FOR MAINTENANCE OR CLOSE OUT" AND REFER TO WAKE COUNTY "FILTER BAG FOR DEWATERING ACTIVITIES" CONSTRUCTION DETAIL.
- REMOVE BASIN(S) AND ASSOCIATED TEMPORARY DIVERSION DITCHES, IF CULVERT PIPES NEED TO BE EXTENDED, PERFORM THIS OPERATION AT THIS TIME. FINE GRADE AREA IN PREPARATION FOR SEEDING.
- PERFORM SEEDBED PREPARATION, SEED, MULCH AND ASPHALT TACK ANY RESULTING BARE AREAS IMMEDIATELY.
- INSTALL VELOCITY DISSIPATORS AND/OR LEVEL SPREADERS AS REQUIRED ON THE EROSION CONTROL PLAN.
- WHEN SITE IS FULLY STABILIZED, CALL ENVIRONMENTAL CONSULTANT FOR APPROVAL OF REMOVING REMAINING TEMPORARY EROSION CONTROL MEASURES AND ADVICE ON WHEN SITE CAN BE ISSUED A CERTIFICATE OF COMPLETION. NOTE: A MEETING SHOULD ALSO BE SCHEDULED WITH THE ENVIRONMENTAL CONSULTANT TO DETERMINE WHEN A BASIN MAY BE CONVERTED FOR STORMWATER USE. SOME MUNICIPALITIES MAY ALSO REQUIRE THIS.

SEDIMENT BASIN SUMMARY CHART

Sediment Basin Number	1	2	3
Drainage Area (acres)	3.42	4.61	0.6
Orifice (in)	(0.5)(7.22)(3.42)=12.35	(0.5)(7.22)(4.61)=16.64	(0.5)(7.22)(0.60)=2.17
Weir Size (ft)	10 x 1.5	10 x 1.5	10 x 1.5
Surface Area Required (SF)	(435)(12.35)=5,372	(435)(16.64)=7,238	(435)(2.17)=944
Volume Required (CF)	(1800)(3.42)= 6,156	(1800)(4.61)= 8,298	(1800)(0.60)= 1,080
Dimensions (ft)	see plans	see plans	see plans
Surface Area Provided (SF)	5,400	10,640	1,584
Volume Provided (CF)	13,572	27,636	2,563
Skimmer Size	4"	4"	3
Orifice Radius	0.5"	0.63"	0.25
Orifice Diameter	1.0"	1.25"	0.5
Drawdown Time (days)	4.62	3.98	3.74
Number of Baffles	3	3	3

Structure	d ₅₀ (ft)	Velocity (fps)	Length (ft)	Width (ft)	Depth (ft)	Type
FES 1	2.00	7.4	12	6	22	Class B'
FES 2	3.00	6.5	18	9	22	Class B'
DV DITCH 1"	1.25	5.3	5	4	9	Class A'
DV DITCH 2"	1.25	5.3	5	4	9	Class A'
DV DITCH 3"	1.25	5.3	5	4	9	Class A'
DV DITCH 4"	1.25	5.3	5	4	9	Class A'
PIPE 1"	1.25	5.3	5	4	9	Class A'
PIPE 2"	1.25	5.3	5	4	9	Class A'


*Per NCDOT Dissipator Schedule Fig.1

CITY OF RALEIGH - PLANS AUTHORIZED FOR CONSTRUCTION

Electronic Approval: This approval is being issued electronically. This approval is valid only upon the signature of a City of Raleigh Review Officer below. The City will retain a copy of the approved plans. Any work authorized by this approval must proceed in accordance with the plans kept on file with the City. This electronic approval may not be edited once issued. Any modification to this approval once issued will invalidate this approval.

City of Raleigh Development Approval

Raleigh Water Review Officer

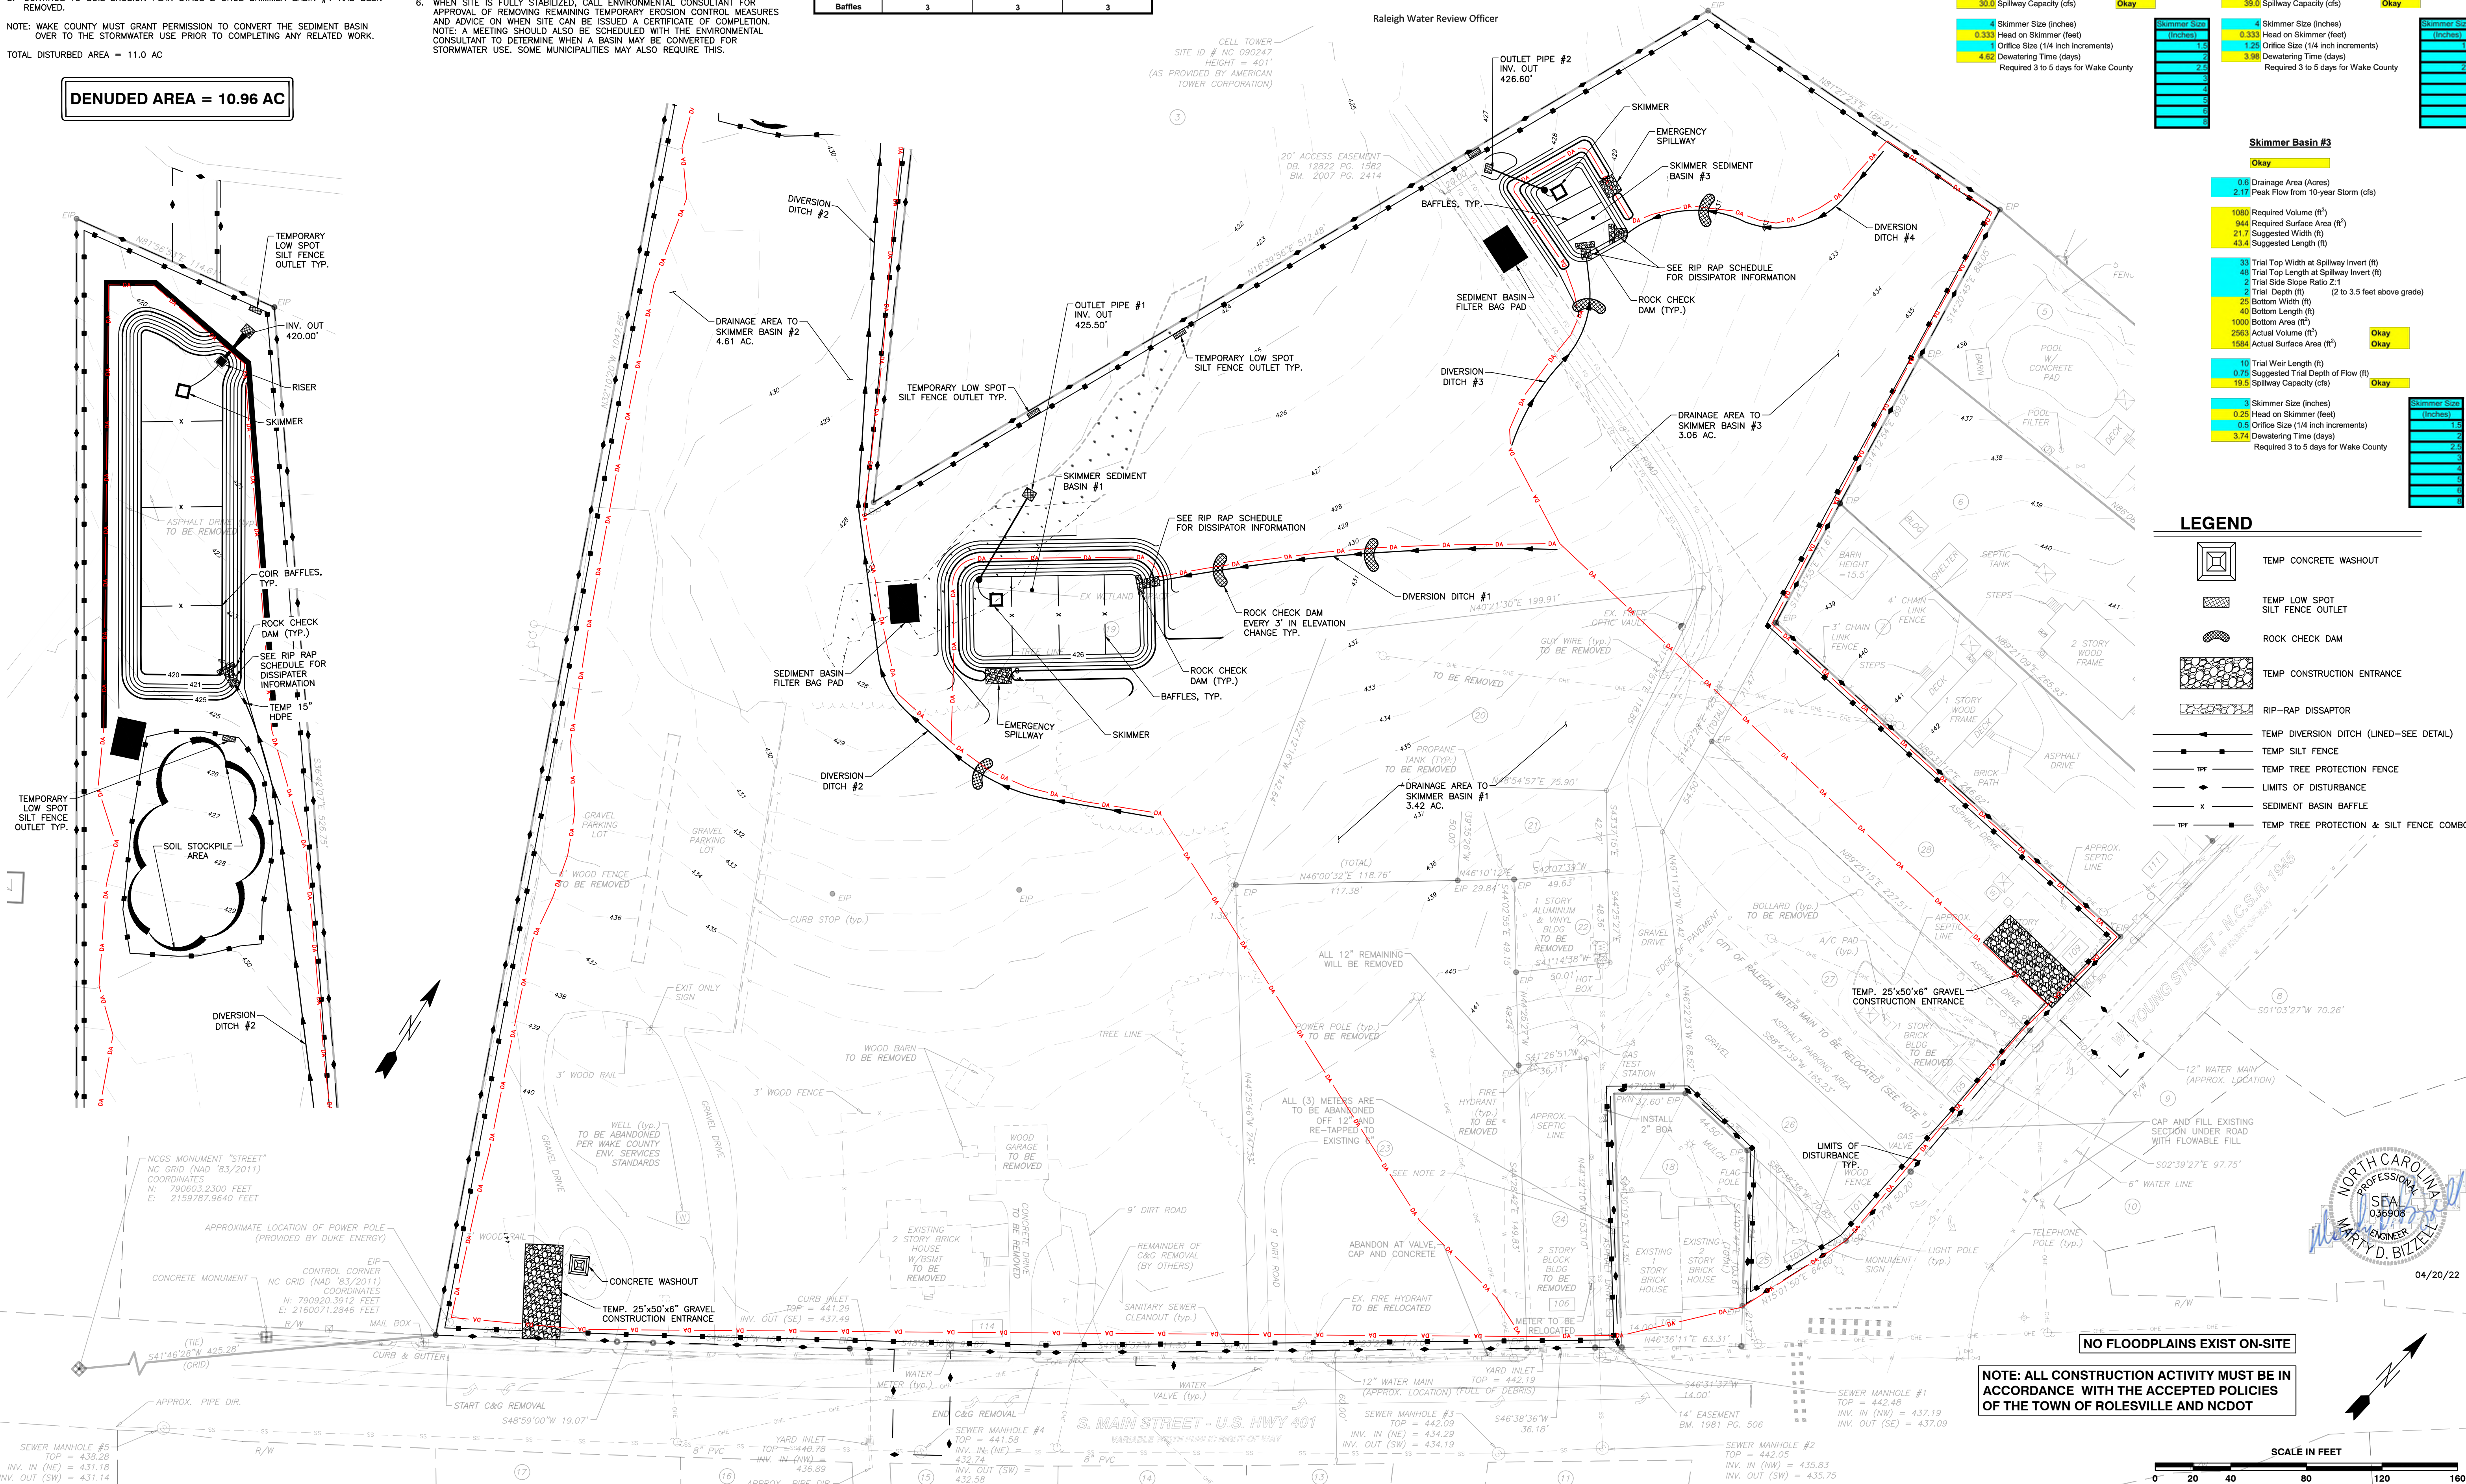

DITCH/CHANNEL CALCULATIONS								
DIVERSION DITCH ID	LENGTH (LF)	DA (AC)	Q10 (CFS)	SLOPE (%)	V10 (FPS)	LINER * SHEAR STRESS (PSF)	PERMISSIBLE SHEAR STRESS (PSF)	CALCULATED SHEAR STRESS (PSF)
DV-1	296	1.02	2.34	2.00	2.01	SC150	2.00	0.78
DV-2	495	1.00	2.30	2.60	2.29	SC150	2.00	0.84
DV-3	442	0.52	1.19	1.80	0.92	SC150	1.80	0.29
DV-4	167	0.08	0.13	2.90	0.96	SC150	1.80	0.38

* NAG = NORTH AMERICAN GREEN OR EQUIVALENT

* NAG = NORTH AMERICAN GREEN OR EQUIVALENT

Skimmer Basin #1

Okay

- 3.42 Drainage Area (Acres)
- 12.35 Peak Flow from 10-year Storm (cfs)
- 6198 Required Volume (ft³)
- 5372 Required Surface Area (ft²)
- 60.2 Suggested Width (ft)
- 103.3 Suggested Length (ft)
- 54 Trial Top Width at Spillway Invert (ft)
- 100 Trial Top Length at Spillway Invert (ft)
- 2 Trial Side Slope Ratio 2:1
- 3 Trial Depth (ft) (2 to 3.5 feet above grade)
- 44 Bottom Width (ft)
- 178 Bottom Length (ft)
- 3693 Bottom Area (ft²)
- 13572 Actual Volume (ft³)
- 5408 Actual Surface Area (ft²)
- 10 Trial Weir Length (ft)
- 0.75 Suggested Trial Depth of Flow (ft)
- 30.6 Spillway Capacity (cfs)
- 4 Skimmer Size (inches)
- 0.333 Head on Skimmer (feet)
- 1.25 Orifice Size (1/4 inch increments)
- 4.62 Dewatering Time (days)
- Required 3 to 5 days for Wake County

Skimmer Basin #2

Okay

- 4.61 Drainage Area (Acres)
- 16.64 Peak Flow from 10-year Storm (cfs)
- 8298 Required Volume (ft³)
- 7238 Required Surface Area (ft²)
- 60.2 Suggested Width (ft)
- 120.3 Suggested Length (ft)
- 56 Trial Top Width at Spillway Invert (ft)
- 190 Trial Top Length at Spillway Invert (ft)
- 2 Trial Side Slope Ratio 2:1
- 3 Trial Depth (ft) (2 to 3.5 feet above grade)
- 44 Bottom Width (ft)
- 178 Bottom Length (ft)
- 7832 Bottom Area (ft²)
- 27636 Actual Volume (ft³)
- 10640 Actual Surface Area (ft²)
- 20 Trial Weir Length (ft)
- 0.75 Suggested Trial Depth of Flow (ft)
- 39.6 Spillway Capacity (cfs)
- 4 Skimmer Size (inches)
- 0.333 Head on Skimmer (feet)
- 1.25 Orifice Size (1/4 inch increments)
- 3.98 Dewatering Time (days)
- Required 3 to 5 days for Wake County

Skimmer Basin #3

Okay

- 0.6 Drainage Area (Acres)
- 2.17 Peak Flow from 10-year Storm (cfs)
- 1080 Required Volume (ft³)
- 944 Required Surface Area (ft²)
- 21.7 Suggested Width (ft)
- 43.4 Suggested Length (ft)
- 33 Trial Top Width at Spillway Invert (ft)
- 40 Trial Top Length at Spillway Invert (ft)
- 2 Trial Side Slope Ratio 2:1
- 2 Trial Depth (ft) (2 to 3.5 feet above grade)
- 23 Bottom Width (ft)
- 40 Bottom Length (ft)
- 1000 Bottom Area (ft²)
- 2563 Actual Volume (ft³)
- 1584 Actual Surface Area (ft²)
- 10 Trial Weir Length (ft)
- 0.75 Suggested Trial Depth of Flow (ft)
- 19.3 Spillway Capacity (cfs)
- Skimmer Size (inches)
- 0.333 Head on Skimmer (feet)
- 0.5 Orifice Size (1/4 inch increments)
- 3.74 Dewatering Time (days)
- Required 3 to 5 days for Wake County

LEGEND

- TEMP CONCRETE WASHOUT
- TEMP LOW SPOT SILT FENCE OUTLET
- ROCK CHECK DAM
- TEMP CONSTRUCTION ENTRANCE
- RIP-RAP DISSIPATOR
- TEMP DIVERSION DITCH (LINED-SEE DETAIL)
- TEMP SILT FENCE
- TEMP TREE PROTECTION FENCE
- LIMITS OF DISTURBANCE
- SEDIMENT BASIN BAFFLE
- TEMP TREE PROTECTION & SILT FENCE COMBO



NO FLOODPLAINS EXIST ON-SITE

NOTE: ALL CONSTRUCTION ACTIVITY MUST BE IN ACCORDANCE WITH THE ACCEPTED POLICIES OF THE TOWN OF ROLESVILLE AND NCDOT



BASS, NIXON & KENNEDY, INC.
CONSULTING ENGINEERS
6310 CHAPEL HILL ROAD, SUITE 250, RALEIGH, NC 27607
TELEPHONE: (919) 881-4422 FAX: (919) 881-8866
CERTIFICATION NUMBERS: NCBELS (C-0110); NCBOLA (C-0267)

COBBLESTONE VILLAGE
MIXED USE DEVELOPMENT

TOWN OF ROLESVILLE, WAKE COUNTY, NORTH CAROLINA

PROGRESS
DATE
JOB NO.

MRM
DRAWN BY
CHK BY: MDB

03-19157
19157

EROSION CONTROL
PLAN - STAGE 1

NO. DATE DESCRIPTION REVISIONS

SHEET
C3.3

TOWN OF ROLESVILLE PROJECT NO.

NOT RELEASED FOR CONSTRUCTION OR BID SOLICITATION

1. BEGIN CONSTRUCTION OF ALL BUILDINGS.
2. STABILIZE SITE AS NEW DISTURBED AREAS ARE BROUGHT UP TO FINISH GRADE WITH VEGETATION, PAVING, DITCH LININGS, ETC. SEED AND MULCH DENuded AREAS PER GROUND STABILIZATION TIME FRAMES.
3. WHEN CONSTRUCTION OF PARKING LOTS ARE COMPLETE AND ALL AREAS ARE STABILIZED COMPLETELY, CALL ENVIRONMENTAL CONSULTANT FOR AN INSPECTION.
4. IF THE SITE IS APPROVED, REMOVE TEMPORARY DIVERSIONS, SILT FENCE, SEDIMENT BASINS, ETC. AND SEED OUT OR STABILIZE ANY RESULTING BARE AREAS. ALL REMAINING PERMANENT EROSION CONTROL DEVICES, SUCH AS VELOCITY DISSIPATORS, SHOULD NOW BE INSTALLED.
5. WHEN VEGETATION HAS BECOME ESTABLISHED, CALL FOR A FINAL SITE INSPECTION BY THE ENVIRONMENTAL CONSULTANT. OBTAIN A CERTIFICATE OF COMPLETION.

NOTE: WAKE COUNTY MUST GRANT PERMISSION TO CONVERT THE SEDIMENT BASIN OVER TO THE STORMWATER USE PRIOR TO COMPLETING ANY RELATED WORK.

TOTAL DISTURBED AREA = 10.96 AC

ENVIRONMENTAL CONSULTANT: JEEVAN NEUPANE (919-819-8907)

REQUIRED WAKE COUNTY BASIN REMOVAL AND/OR CONVERSION SEQUENCE

1. SCHEDULE A SITE MEETING WITH THE ENVIRONMENTAL CONSULTANT TO DETERMINE IF A BASIN CAN BE REMOVED OR CONVERTED TO A PERMANENT STORMWATER POND. INSTALL SILT FENCING OR OTHER TEMPORARY EROSION CONTROL MEASURES AS NECESSARY TO PREVENT EROSION.
2. UTILIZE OUTLET STRUCTURES THAT WITHDRAW WATER FROM THE SEDIMENT BASIN SURFACE FOR FLOW DOWN OF WATER IN BASIN FOR MAINTENANCE OR CLOSE OUT IF UNLESS INFEASIBLE. SEE REQUIREMENTS OF NCGM1 PERMIT PART II, SECTION 6, ITEM (4) ENTITLED "DRAW DOWN OF SEDIMENT-BASINS FOR MAINTENANCE OR CLOSURE". OUTLET BASIN WAKE COUNTY "FILTER BAG FOR Dewatering ACTIVITIES" CONSTRUCTION DETAIL.
3. REMOVE BASIN(S) AND ASSOCIATED TEMPORARY DEPRESSION DITCHES. IF CULVERT PIPES NEED TO BE EXTENDED, PERFORM THIS OPERATION AT THIS TIME. FINE GRADE AREA IN PREPARATION FOR SEEDING.
4. PERFORM SEEDBED PREPARATION, SEED, MULCH AND ASPHALT TACK ANY RESULTING BARE AREAS IMMEDIATELY.
5. INSTALL VELOCITY DISSIPATORS AND/OR LEVEL SPREADERS AS REQUIRED ON THE EROSION CONTROL PLAN.
6. WHEN SITE IS FULLY STABILIZED, CALL ENVIRONMENTAL CONSULTANT FOR REVIEW OF REMAINING TEMPORARY EROSION CONTROL MEASURES AND ADVICE ON WHEN SITE CAN BE ISSUED A CERTIFICATE OF COMPLETION. NOTE: A MEETING SHOULD ALSO BE SCHEDULED WITH THE ENVIRONMENTAL CONSULTANT TO DETERMINE IF THE BASIN MAY BE CONVERTED FOR STORMWATER USE. SOME MUNICIPALITIES MAY ALSO REQUIRE THIS.

Skimmer Basin #2	
Okay	
5.99	Drainage Area (Acres)
25.23	Peak Flow from 10-year Storm (cfs)
12582	Required Volume (ft ³)
10975	Required Surface Area (ft ²)
74	Suggested Width (ft)
4.2	Suggested Length (ft)
58	Total Top Width at Spillway Invert (ft)
2	Total Top Length at Spillway Invert (ft)
2	Trade Side Slope Ratio: Z1
3	Trade Depth (ft)
40	Bottom Width (ft)
178	Bottom Length (ft)
8768	Bottom Area (ft ²)
2802	Actual Volume (ft ³)
11020	Actual Surface Area (ft ²)
26	Total Weir Length (ft)
0.75	Suggested Total Depth of Flow (ft)
39.0	Skimmer Capacity (cfs)
Okay	
4	Skimmer Size (inches)
0.333	Head on Skimmer (feet)
116	Office Size (1/4 inch increments)
2.20	Waiting Time (seconds)
Required 3 to 5 days for Wake County	

SEDIMENT BASIN SUMMARY CHART		
Sediment Basin	1	2
Drainage Area (acres)	1.74	6.99
Q10(cfs)	(0.57)(221.71)=6.28	(0.57)(226.99)=25.23
Wet Silt (ft)	10 x 1.5	10 x 1.5
Surface Area Required (SF)	(435)(6.28)=2,732	(435)(25.23)=10,975
Volume Provided (CF)	(1800)(1.74)= 3,132	(1800)(6.99)= 12,582
Dimensions (ft)	see plans	see plans
Area Provided (SF)	2,800	11,000
Volume Provided	5,640	27,500
Skimmer Size	4"	4
Orifice Radius	0.4"	0.75
Orifice Diameter	0.75"	1.5
Drainage Time (Days)	4.18	4.2
Number of Baffles	3	3

DITCH/CHANNEL CALCULATIONS								
DIVERSION DITCH ID	LENGTH (LF)	DA (Ac)	Q10 (CFS)	SLOPE (%)	V10 (FPS)	LINER *	PERMISSIBLE SHEAR STRESS (PSF)	CALCULATED SHEAR STRESS (PSF)
DV-1	296	1.02	2.34	2.00	2.01	SC150	2.00	0.78
DV-2	495	1.00	2.30	2.00	2.29	SC150	2.00	0.94
DV-3	442	0.52	1.19	1.80	0.92	SC150	1.80	0.29
DV-4	167	0.06	0.13	2.90	0.96	SC150	1.80	0.38
* NAG = NORTH AMERICAN GREEN OR EQUIVALENT								

* NAG = NORTH AMERICAN GREEN OR EQUIVALENT


	TEMP CONSTRUCTION ENTRANCE
	TEMP LOW SPOT SILT FENCE OUTLET
	TEMP INLET PROTECTION
	RIP-RAP DISSIPATOR
	TEMP SILT FENCE
	TEMP TREE PROTECTION FENCE
	LIMITS OF DISTURBANCE
	SEDIMENT BASIN BAFFLE
	TEMP TREE PROTECTION & SILT FENCE COMBO

CITY OF RALEIGH - PLANS AUTHORIZED FOR CONSTRUCTION

Electronic Approval: This approval is being issued electronically. This approval is valid only upon the signature of a City of Raleigh Review Officer below. The City will retain a copy of the approved plans. Any work authorized by this approval must proceed in accordance with the plans kept on file with the City. This electronic approval may not be edited once issued. Any modification to this approval once issued will invalidate this approval.

City of Raleigh Development Approval

Raleigh Water Review Officer

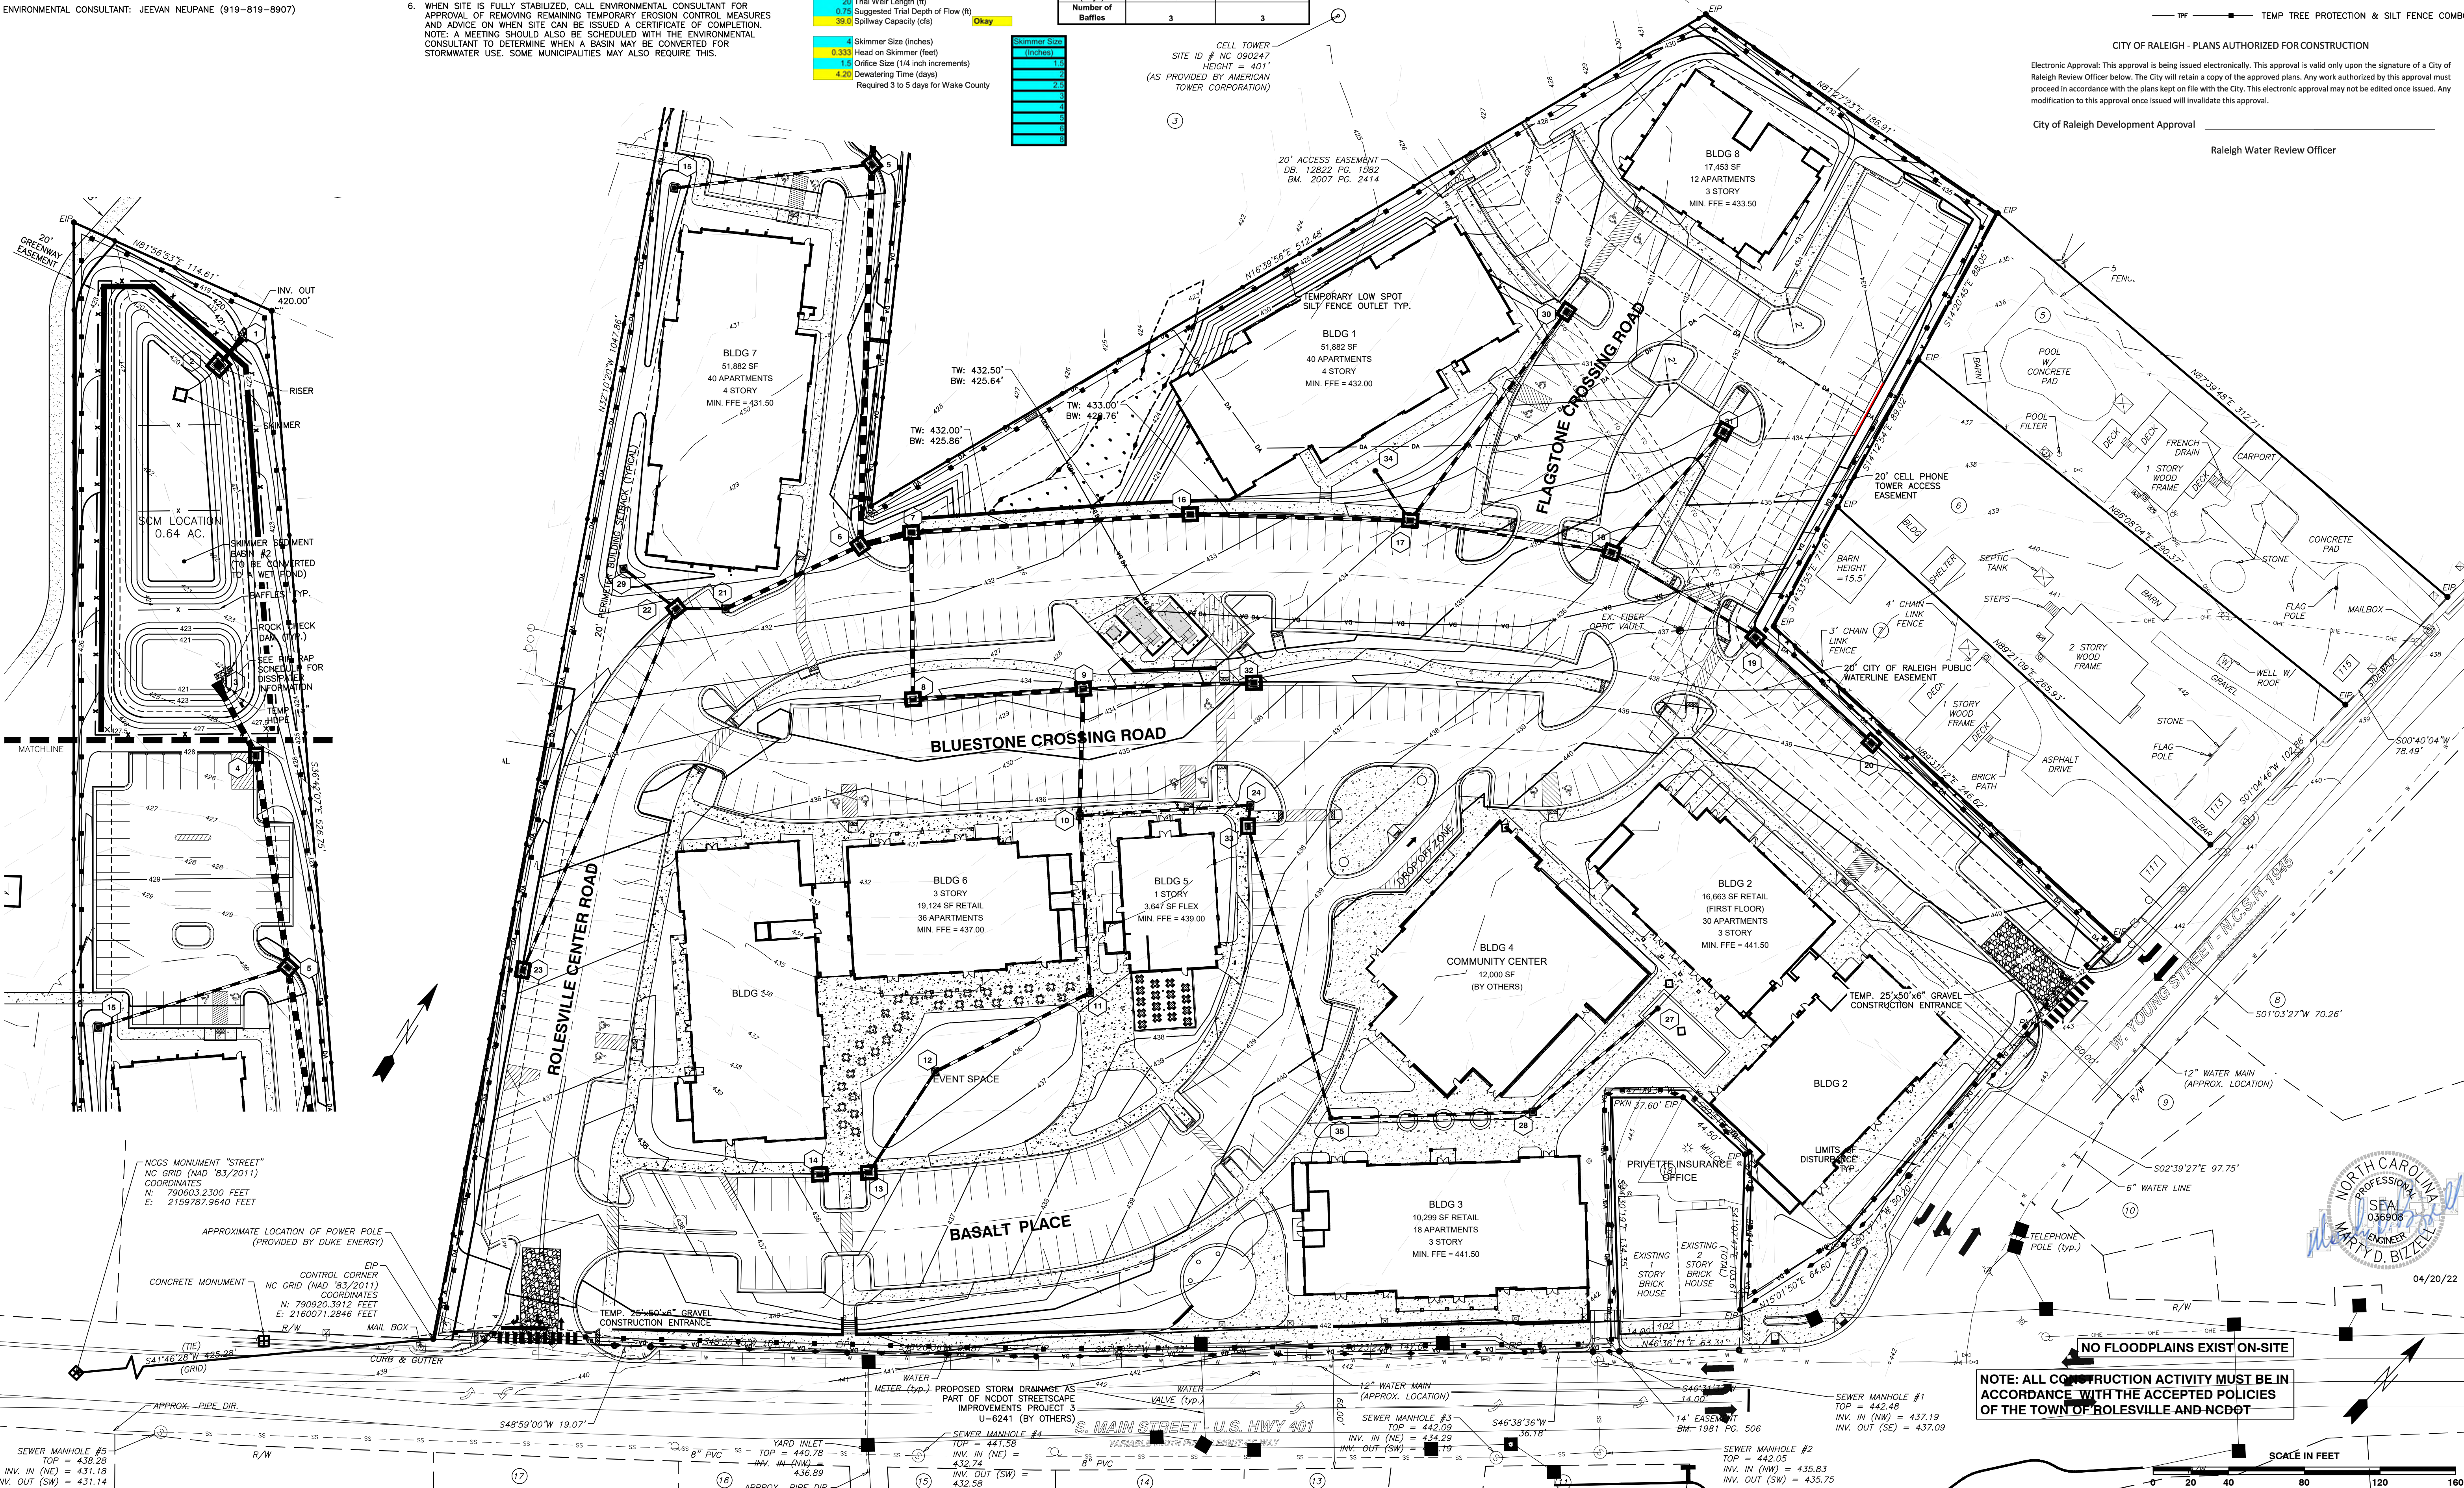










BASS, NIXON & KENNEDY, INC.
CONSULTING ENGINEERS
6310 CHAPEL HILL ROAD, SUITE 250, RALEIGH, NC 27607
TELEPHONE: (919)851-4422 FAX: (919)851-4968
CERTIFICATION NUMBERS: NCBELS (C-0110); NCBOLA (C-0267)

03-19157	PROGRESS	MRM
JOB NO.	DATE	DRAWN BY
EROSION CONTROL PLAN - STAGE 2		
SCALE: 1" = 40'		
		CHK BY: MDB

**COBBLESTONE
VILLAGE
MIXED USE DEVELOPMENT**
TOWN OF ROLESVILLE, WAKE COUNTY, NORTH CAROLINA

SHEET
C3.4

NOT RELEASED FOR CONSTRUCTION OR BID SOLICITATION

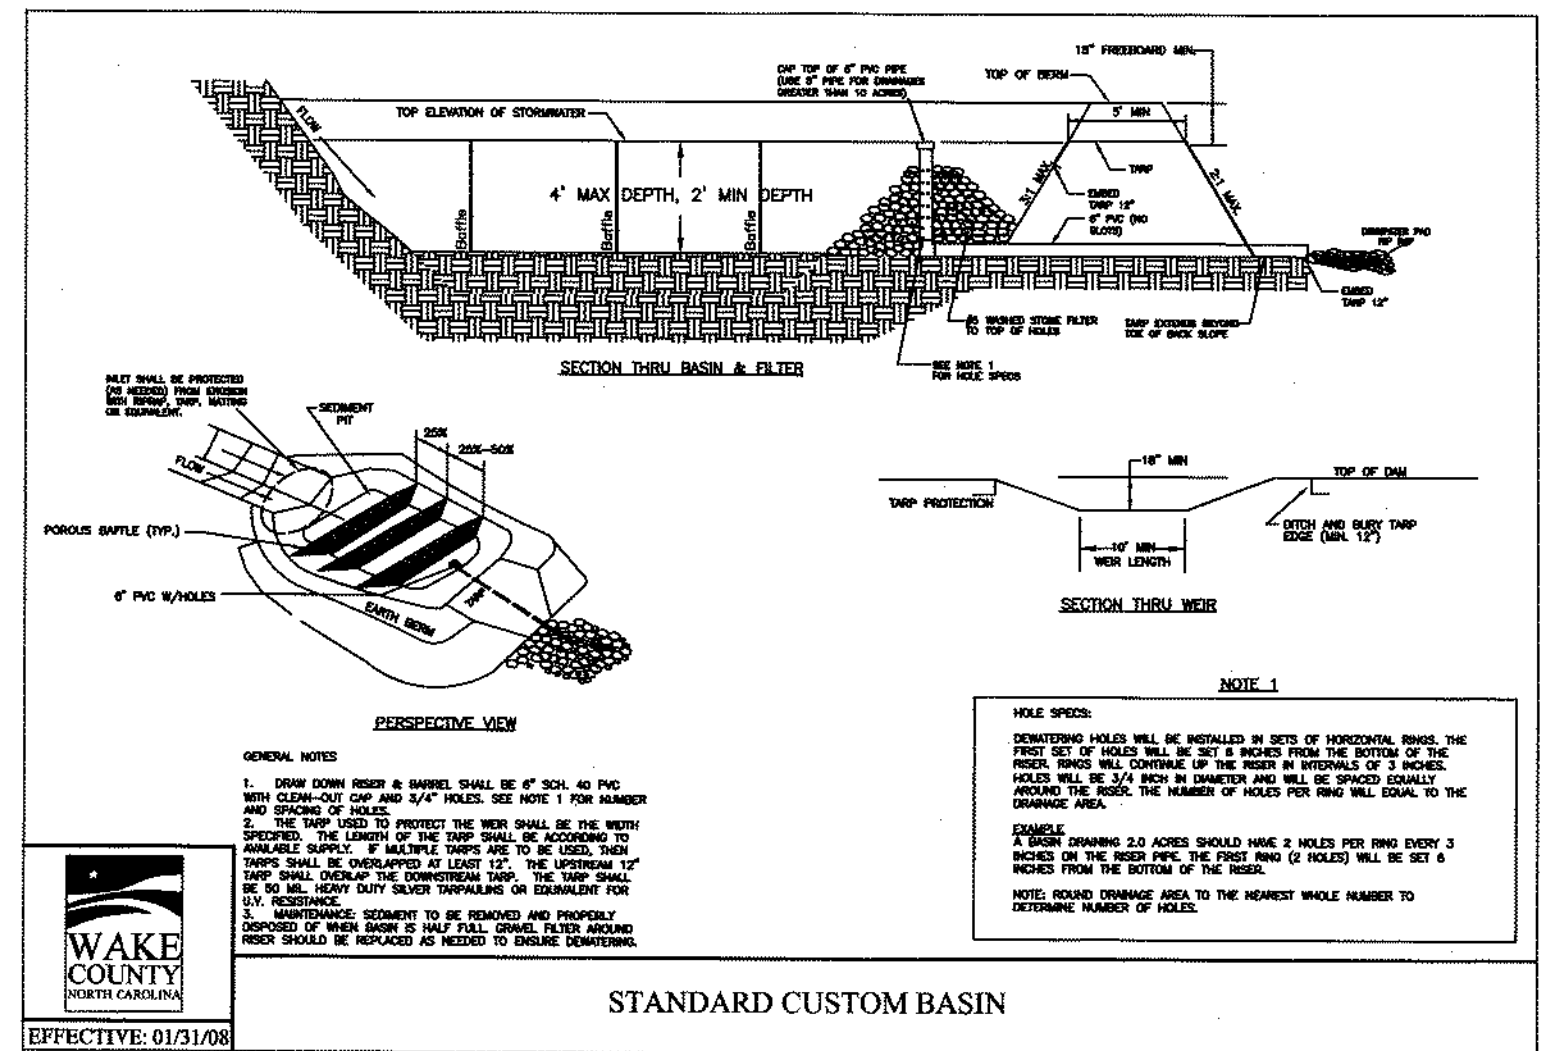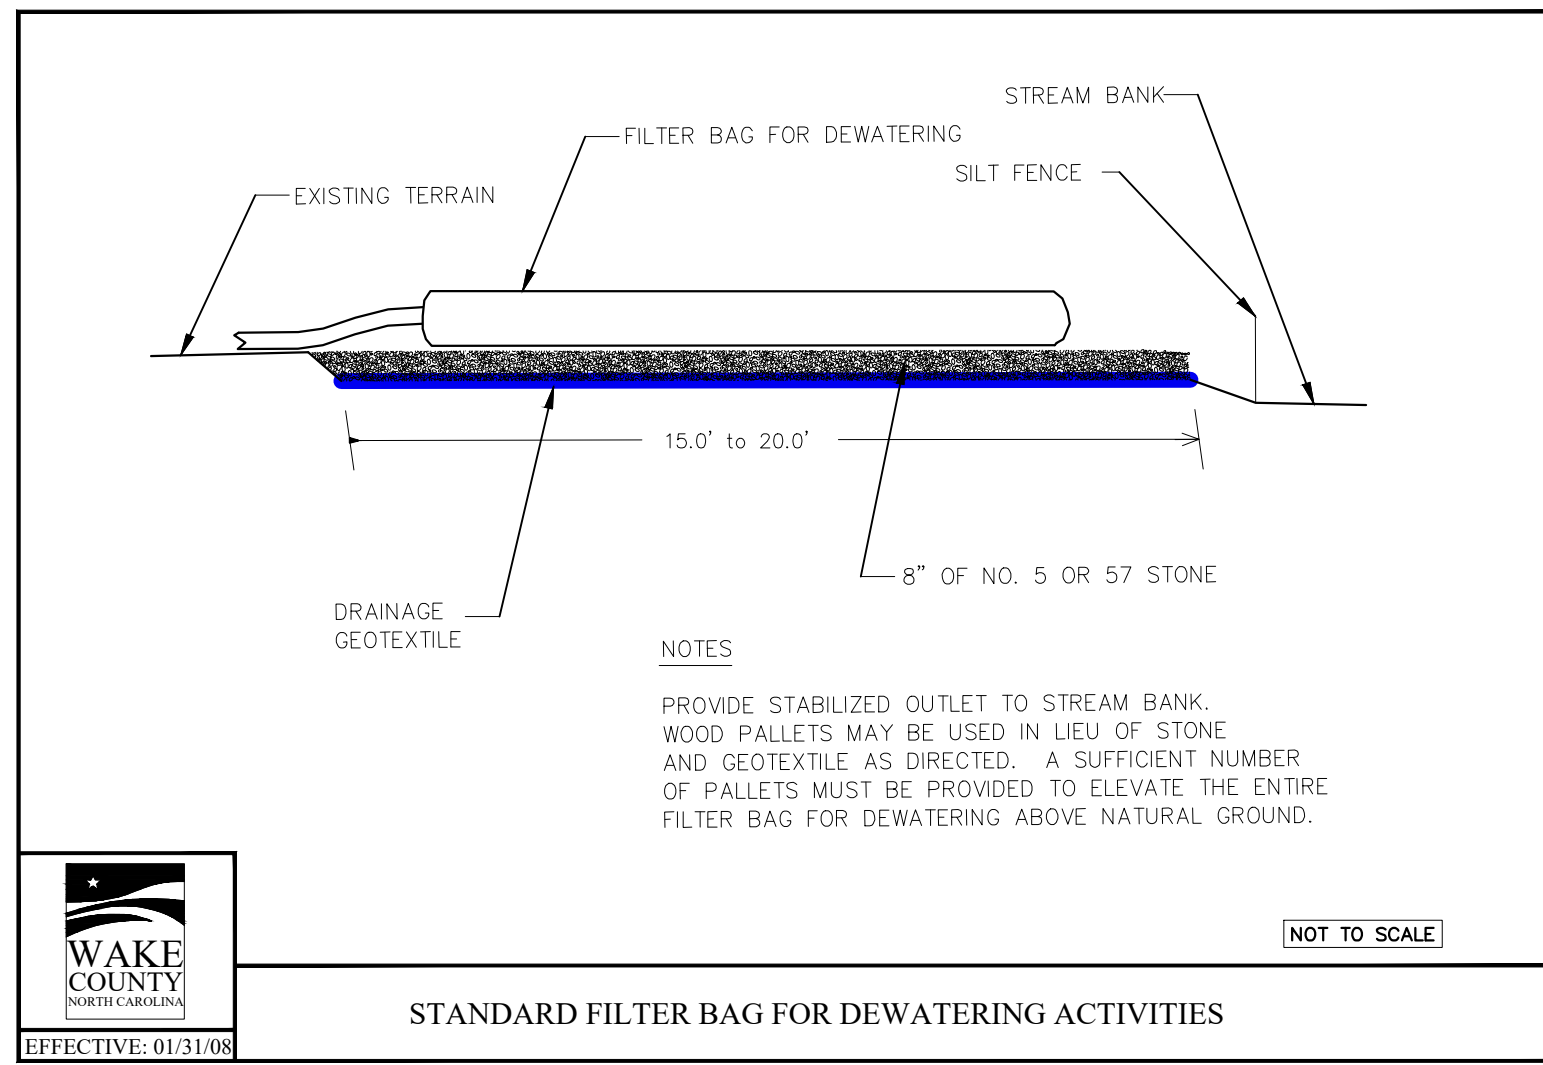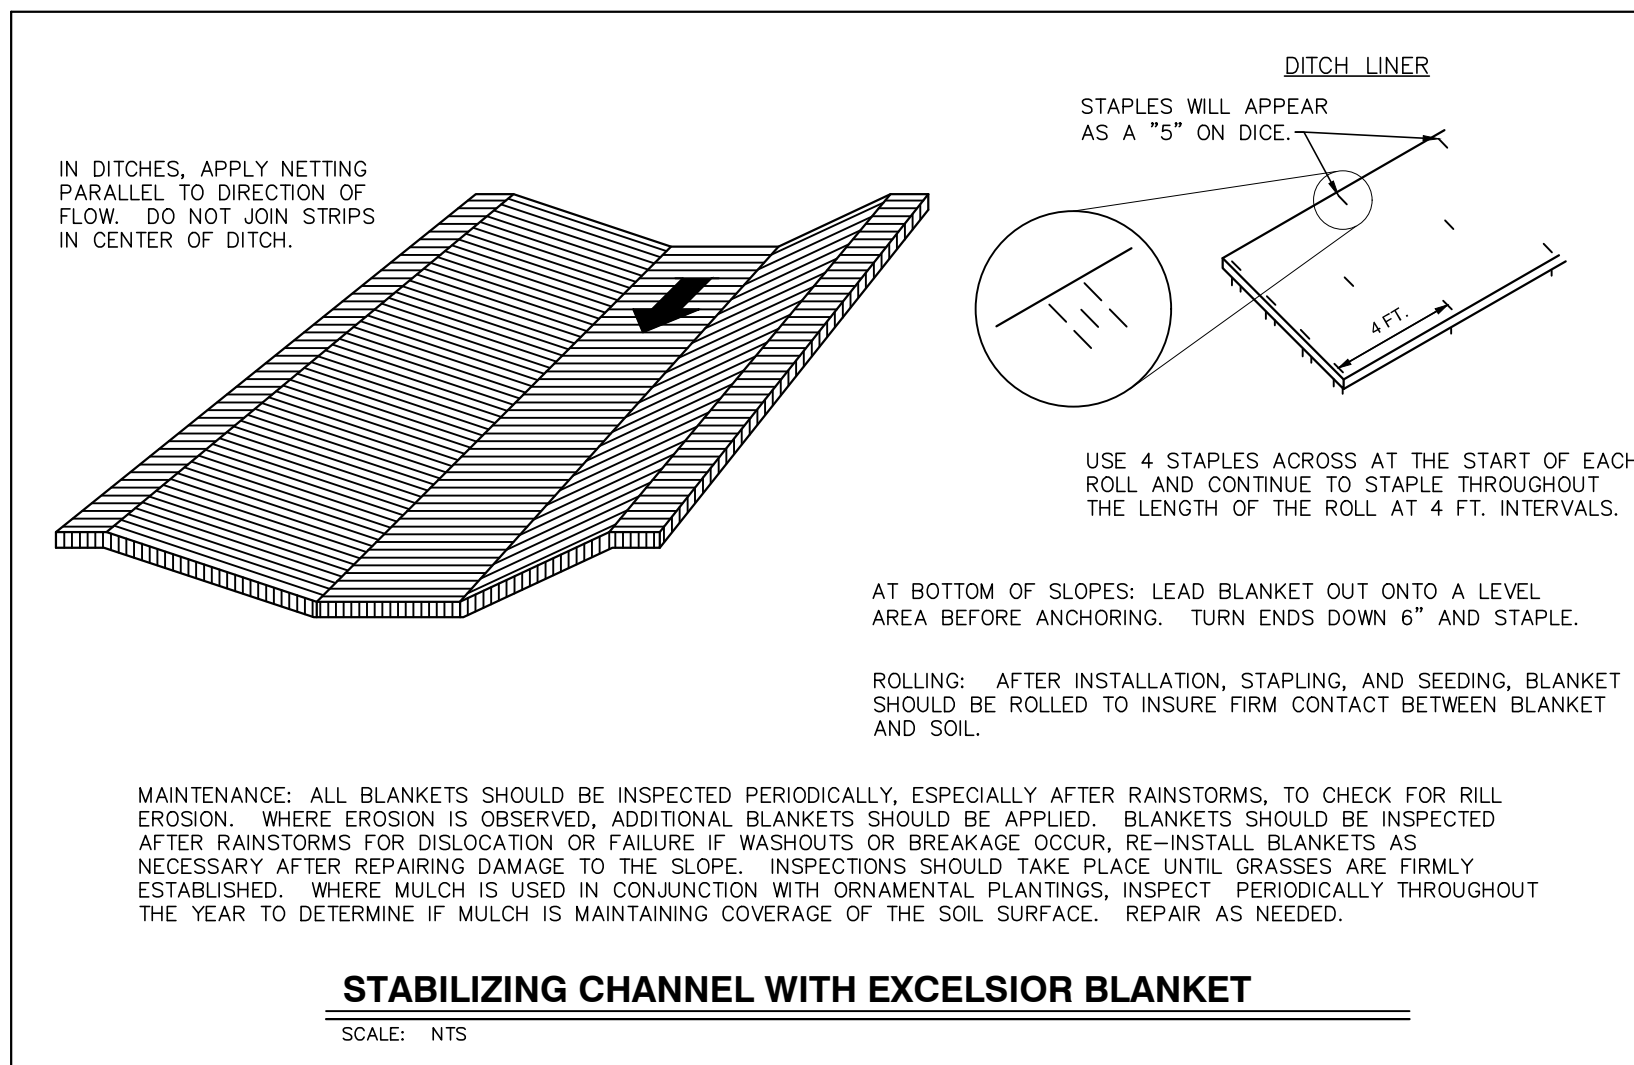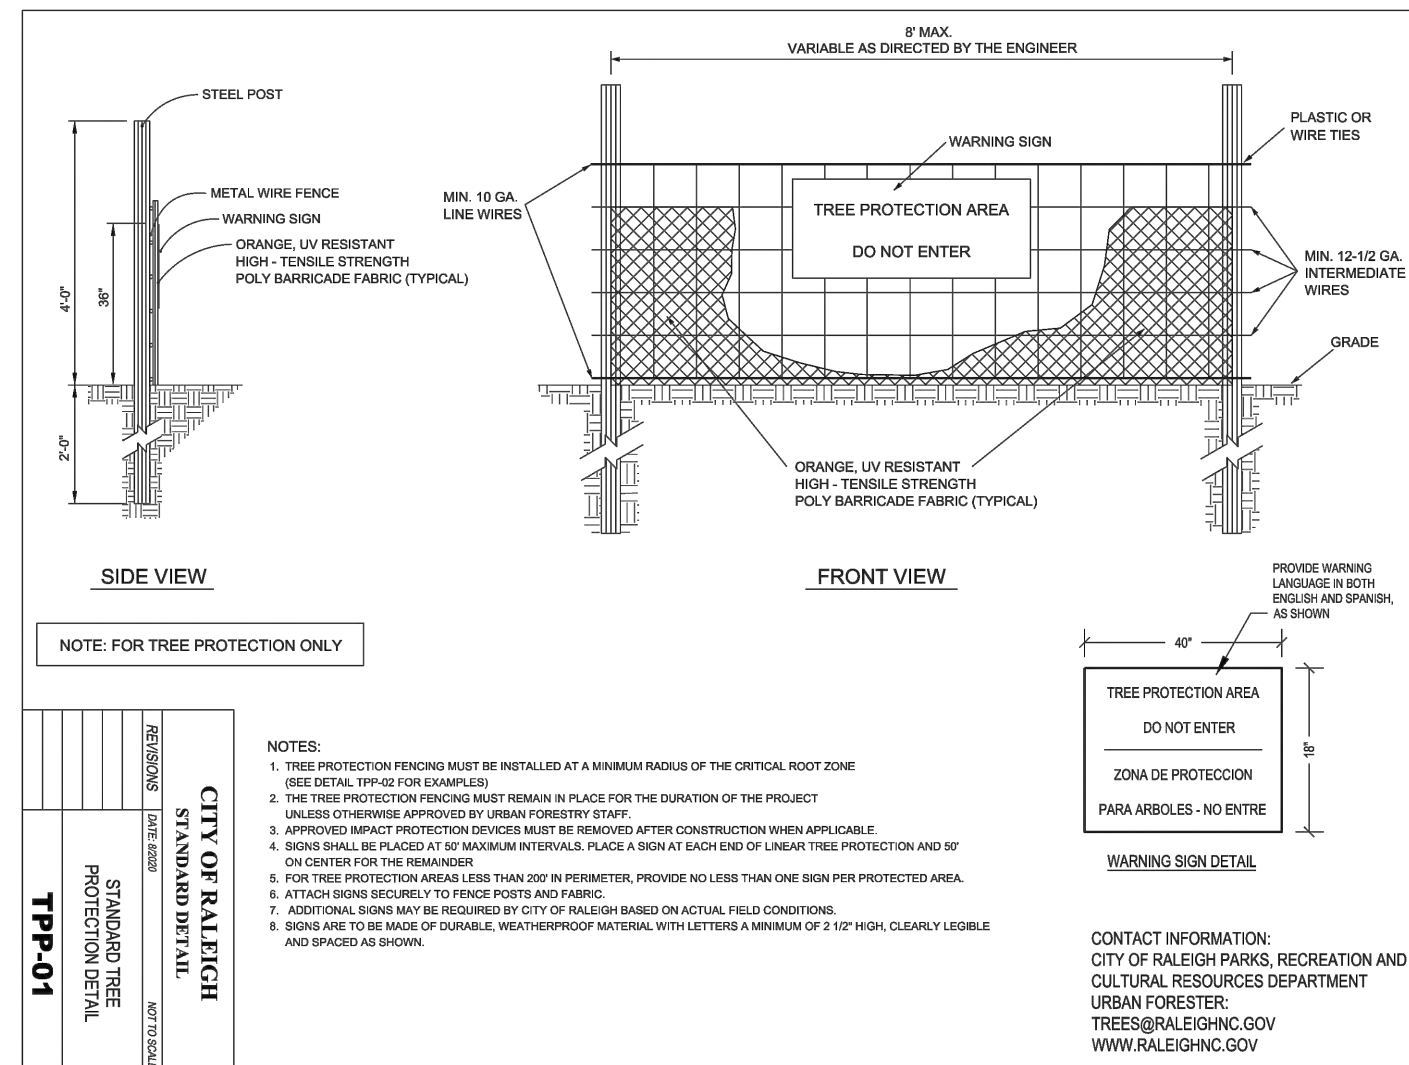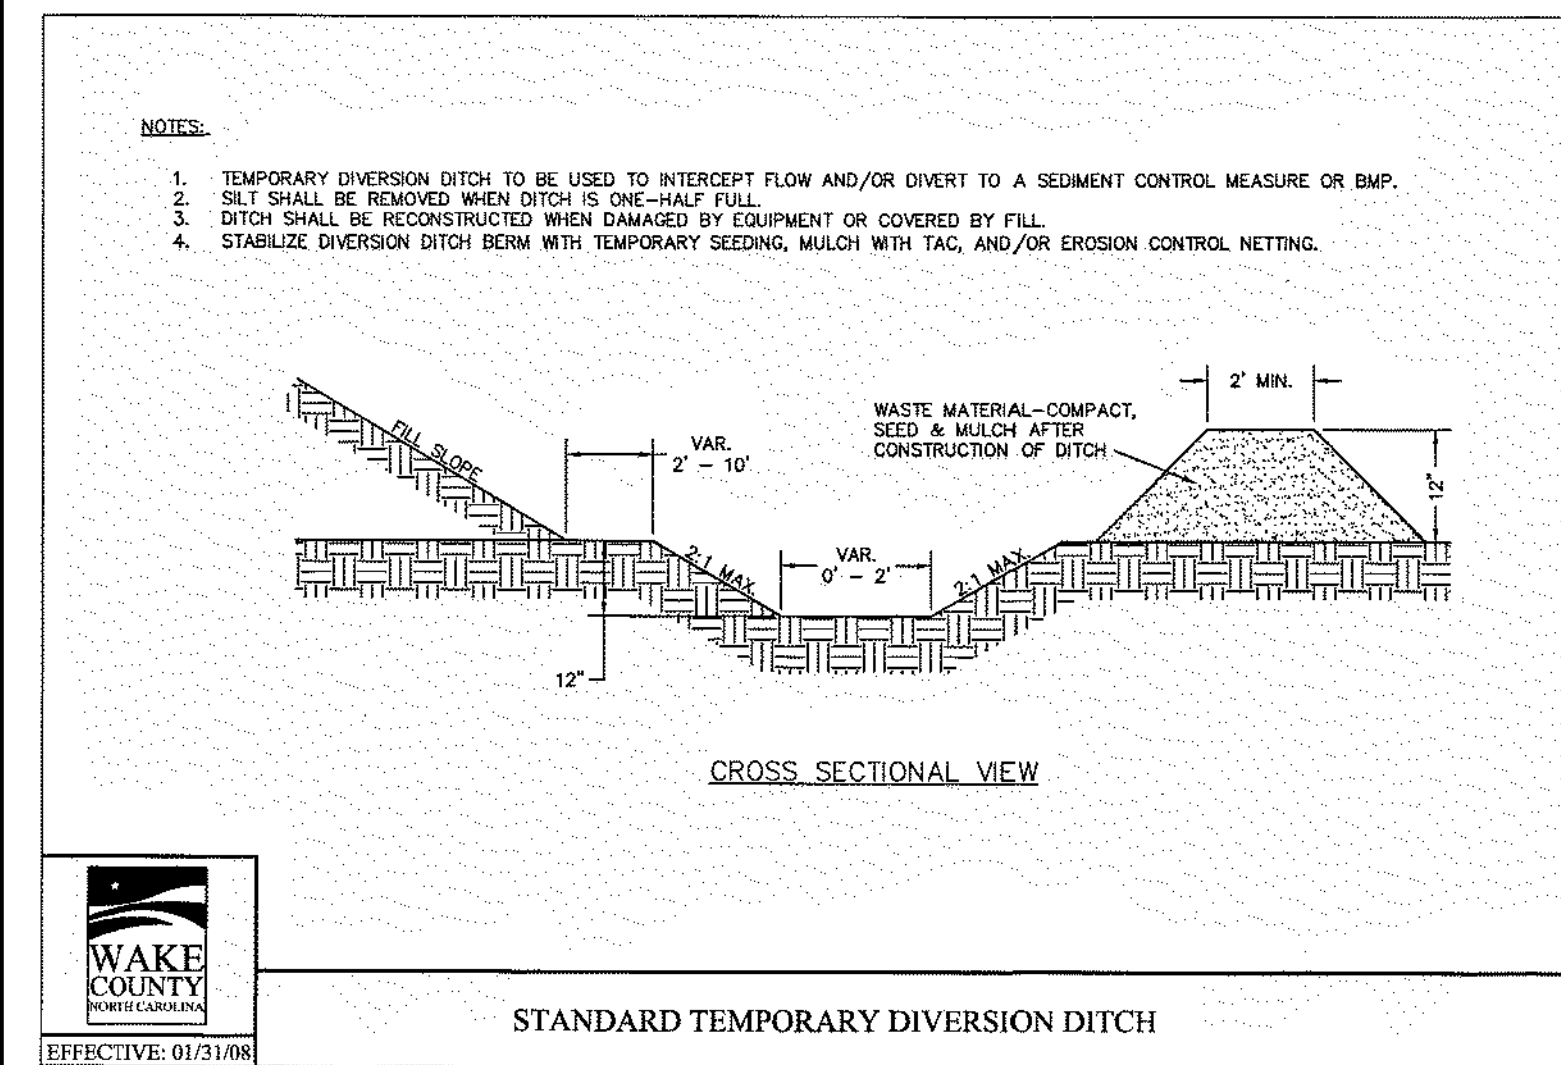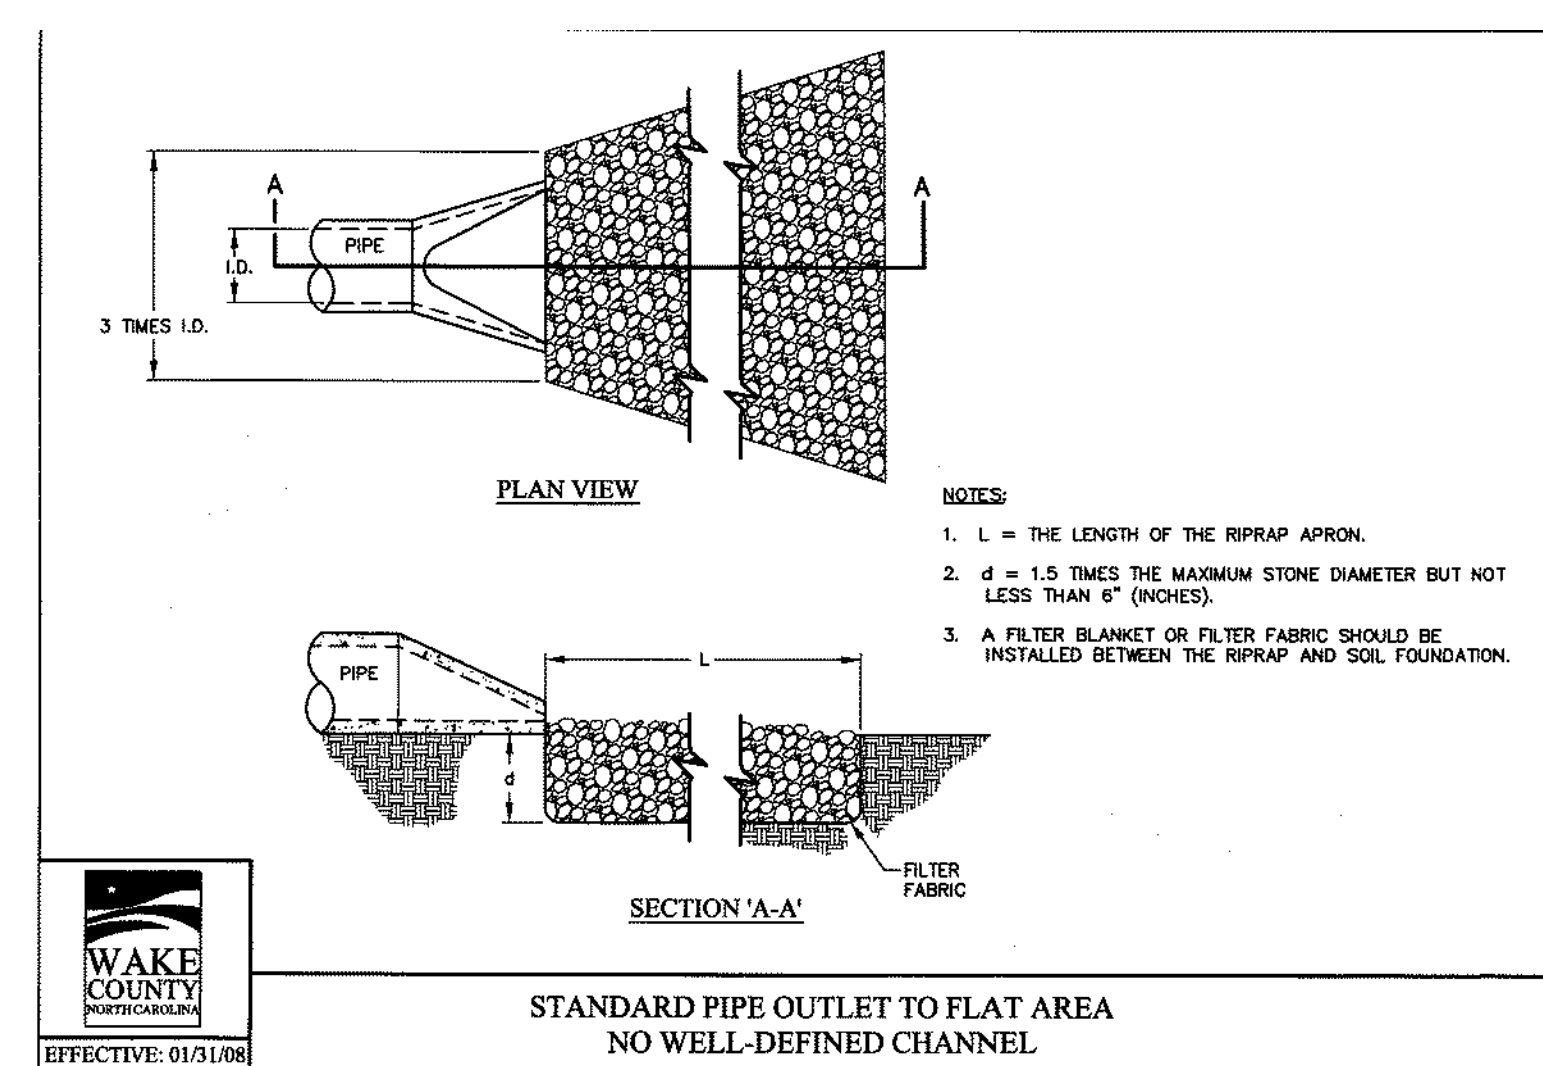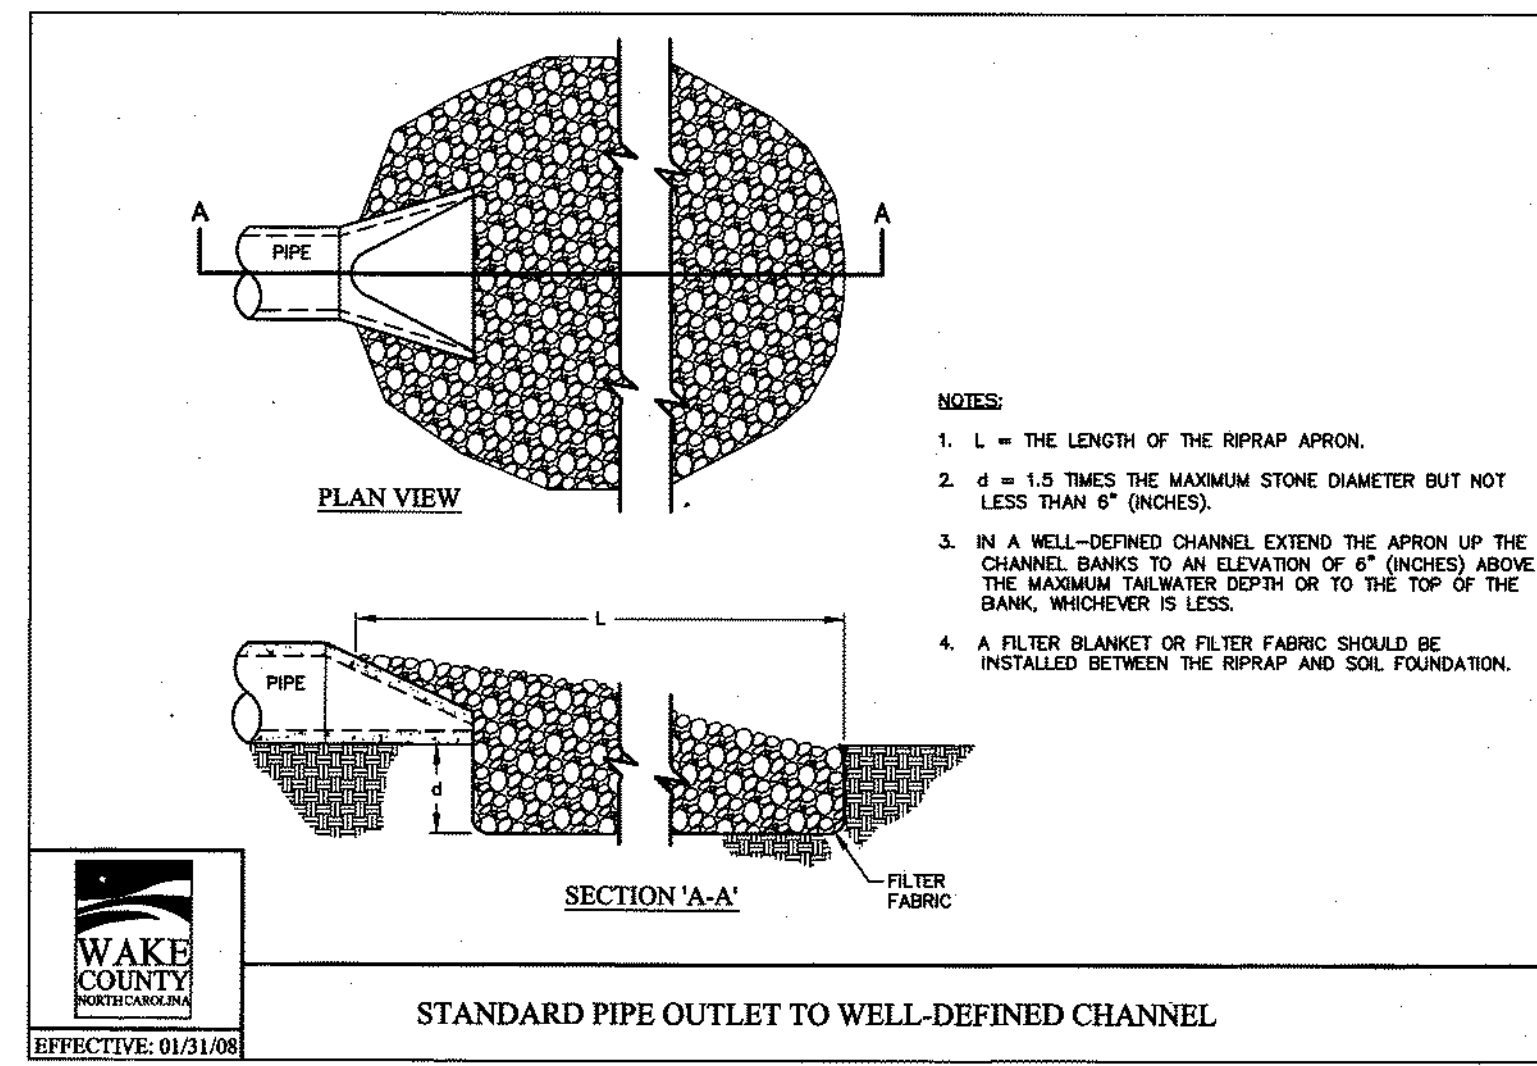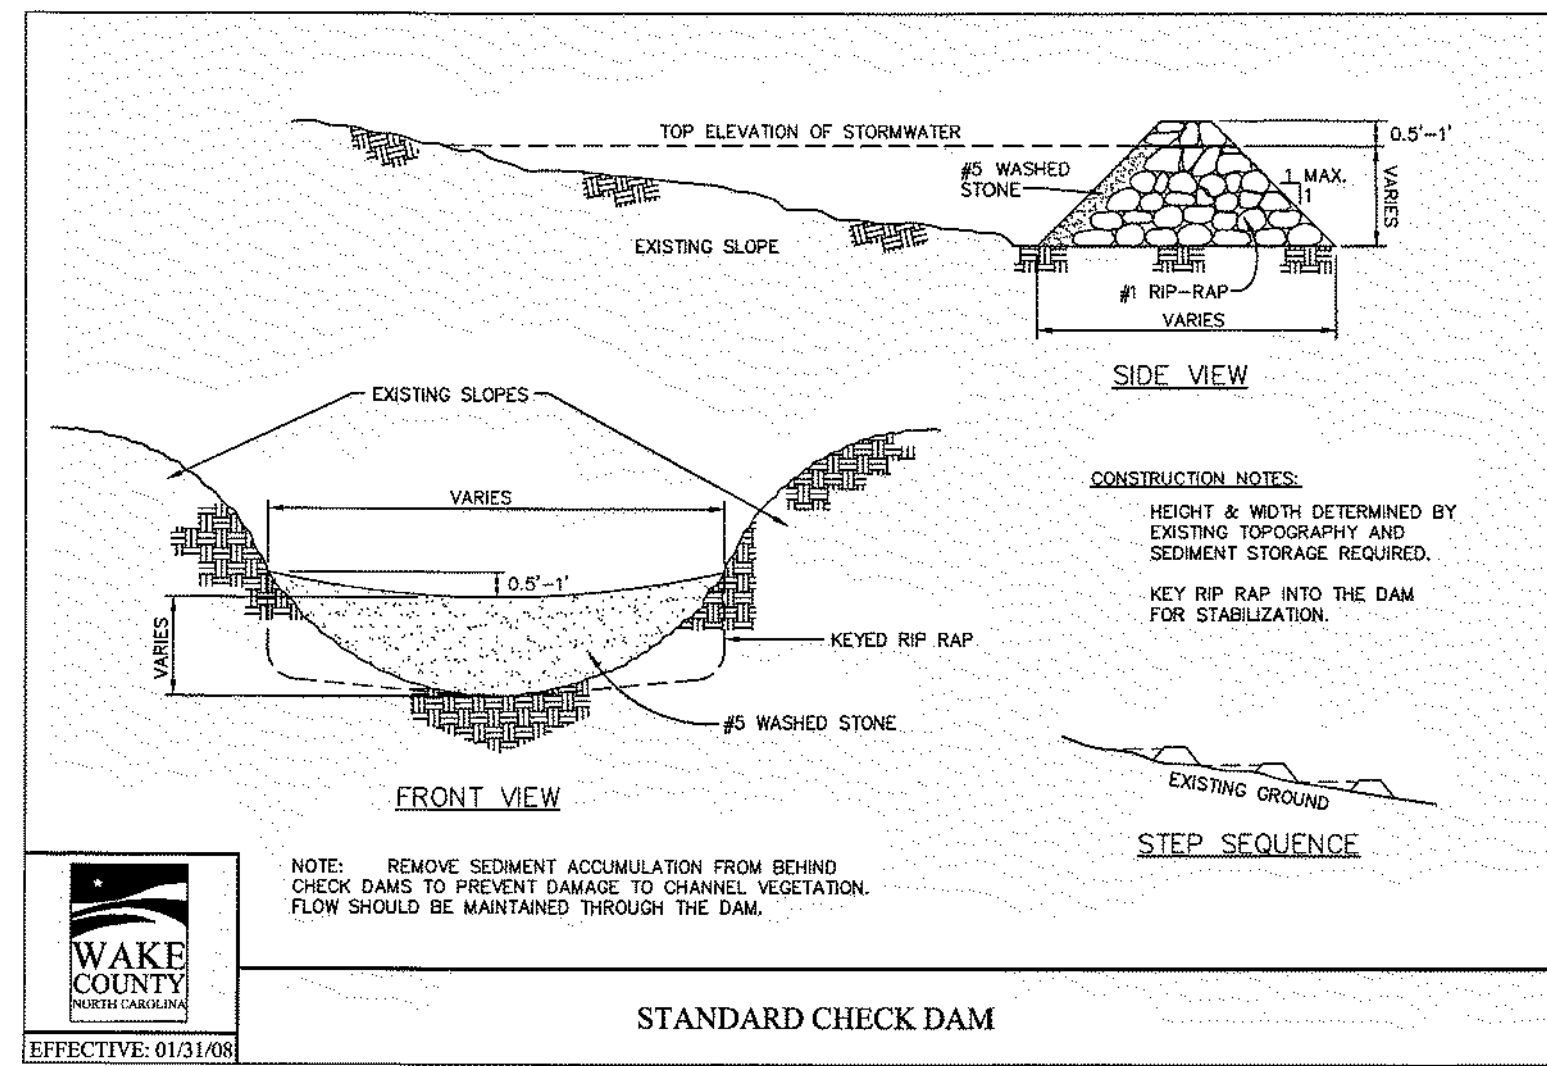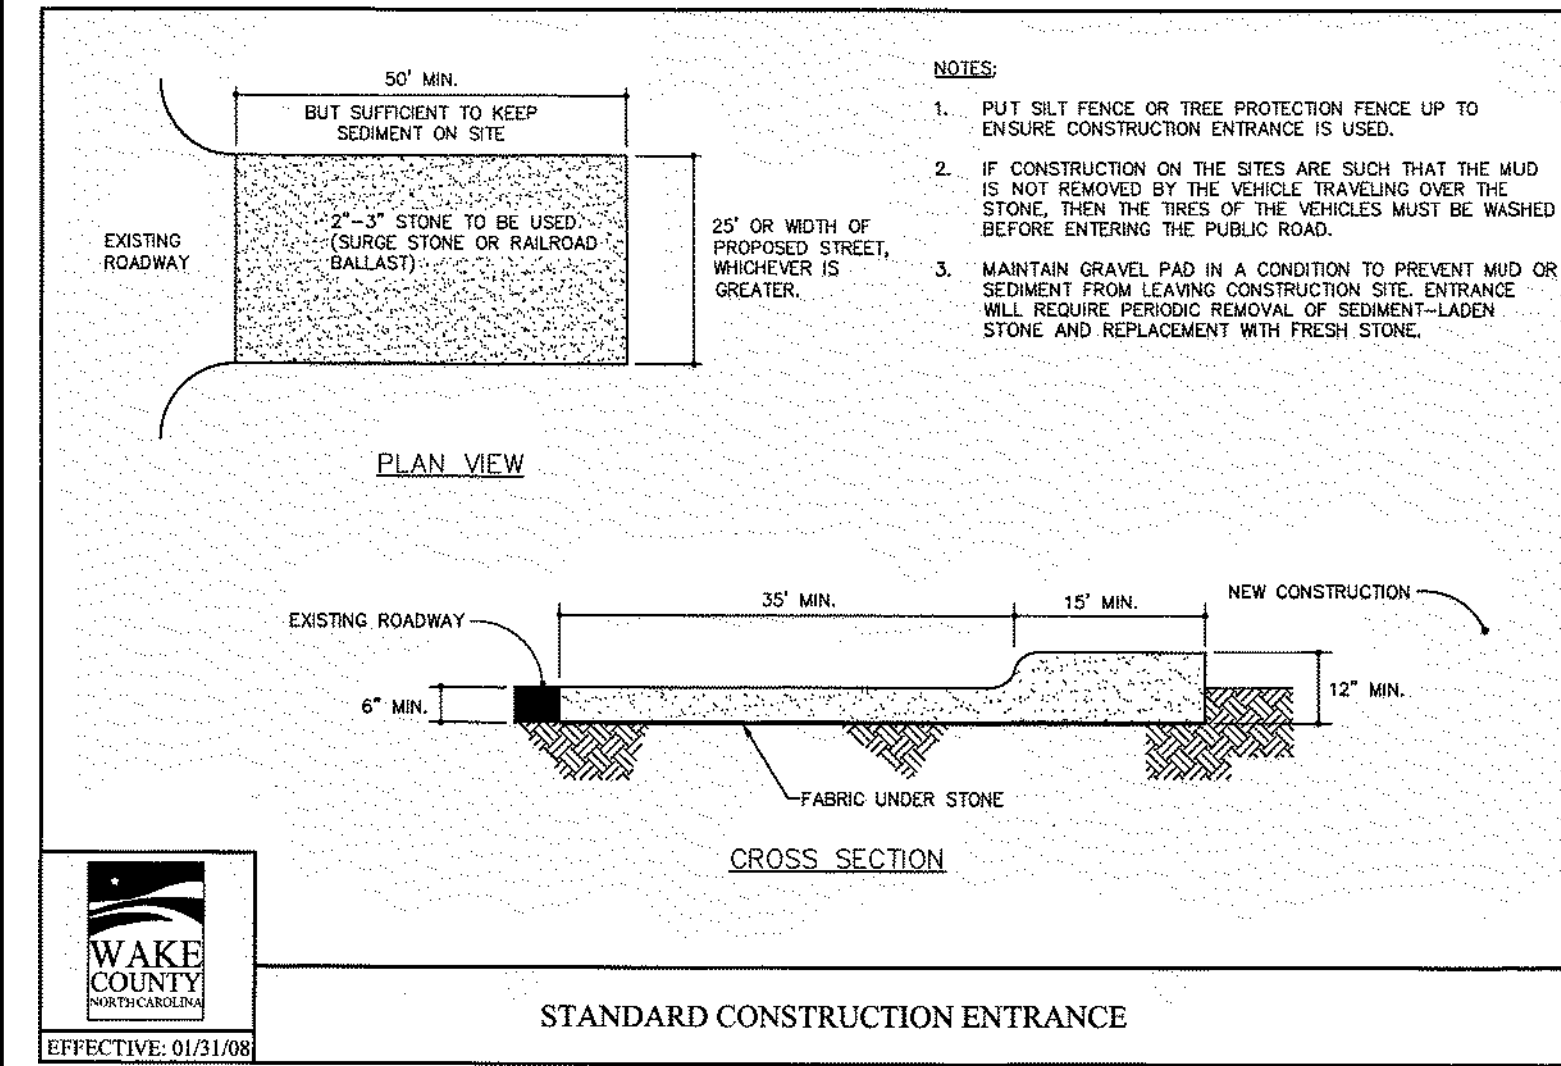

CITY OF RALEIGH - PLANS AUTHORIZED FOR CONSTRUCTION

Electronic Approval: This approval is being issued electronically. This approval is valid only upon the signature of a City of Raleigh Review Officer below. The City will retain a copy of the approved plans. Any work authorized by this approval must proceed in accordance with the plans kept on file with the City. This electronic approval may not be edited once issued. Any modification to this approval once issued will invalidate this approval.

City of Raleigh Development Approval

Raleigh Water Review Officer



04/20/22

**COBBLESTONE
VILLAGE
MIXED USE DEVELOPMENT**
TOWN OF ROLESVILLE, WAKE COUNTY, NORTH CAROLINA

TOWN OF ROLESVILLE, WAKE COUNTY, NORTH CAROLINA

03-19157	PROGRESS	MRM
JOB NO.	DATE	DRAWN BY
EROSION CONTROL DETAILS		
SCALE: N.T.S.		CHK BY: MDB







CHK BY:MDB

REVISIONS			
NO.	DATE	DESCRIPTION	BY

REVISIONS	BY
-----------	----



BASS, NIXON & KENNEDY, INC.
CONSULTING ENGINEERS
6310 CHAPEL HILL ROAD, SUITE 250, RALEIGH, NC 27607
TELEPHONE: (919)851-1422 FAX: (919)851-8968
CERTIFICATION NUMBERS: NCBELS (C-0110); NCBOLA (C-0267)

CERTIFICATION NUMBERS: NCBELS (C-0110); NCBOLA (C-0267)

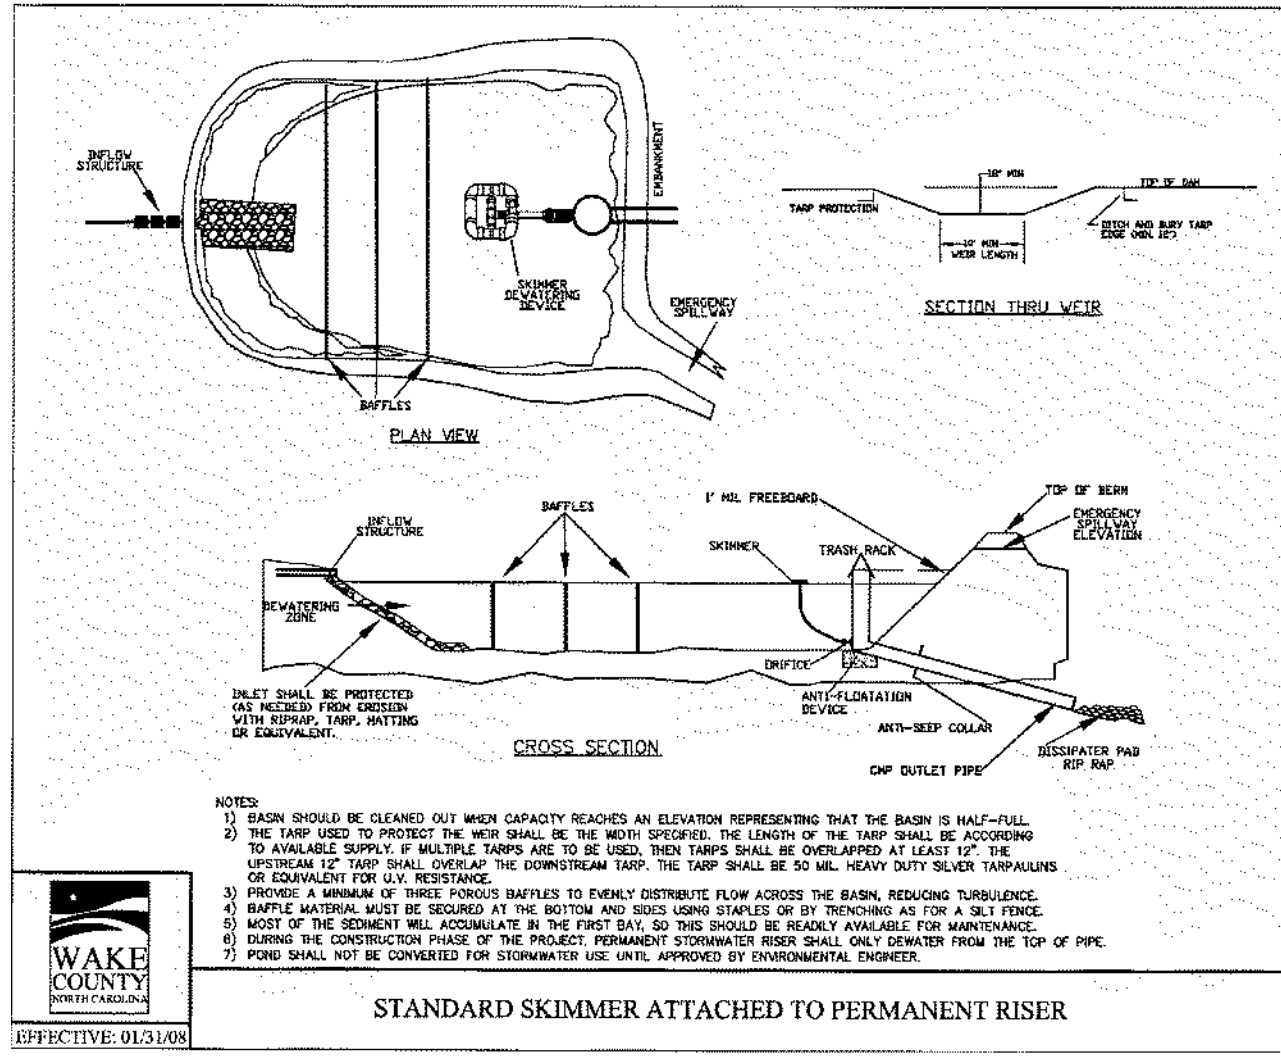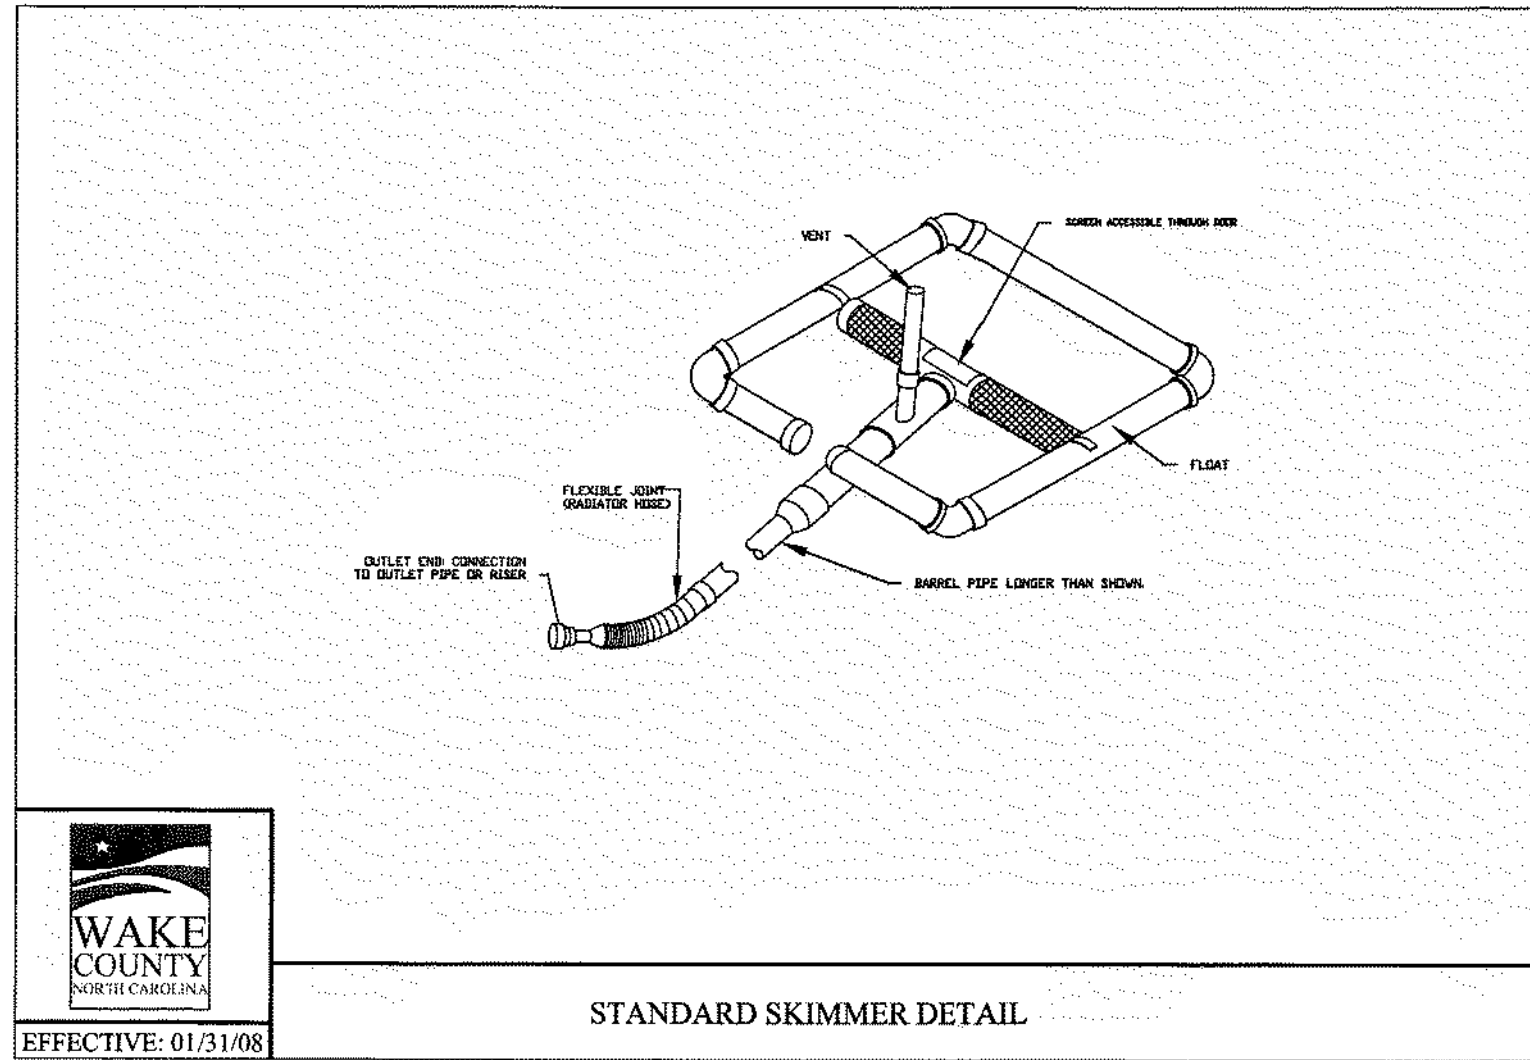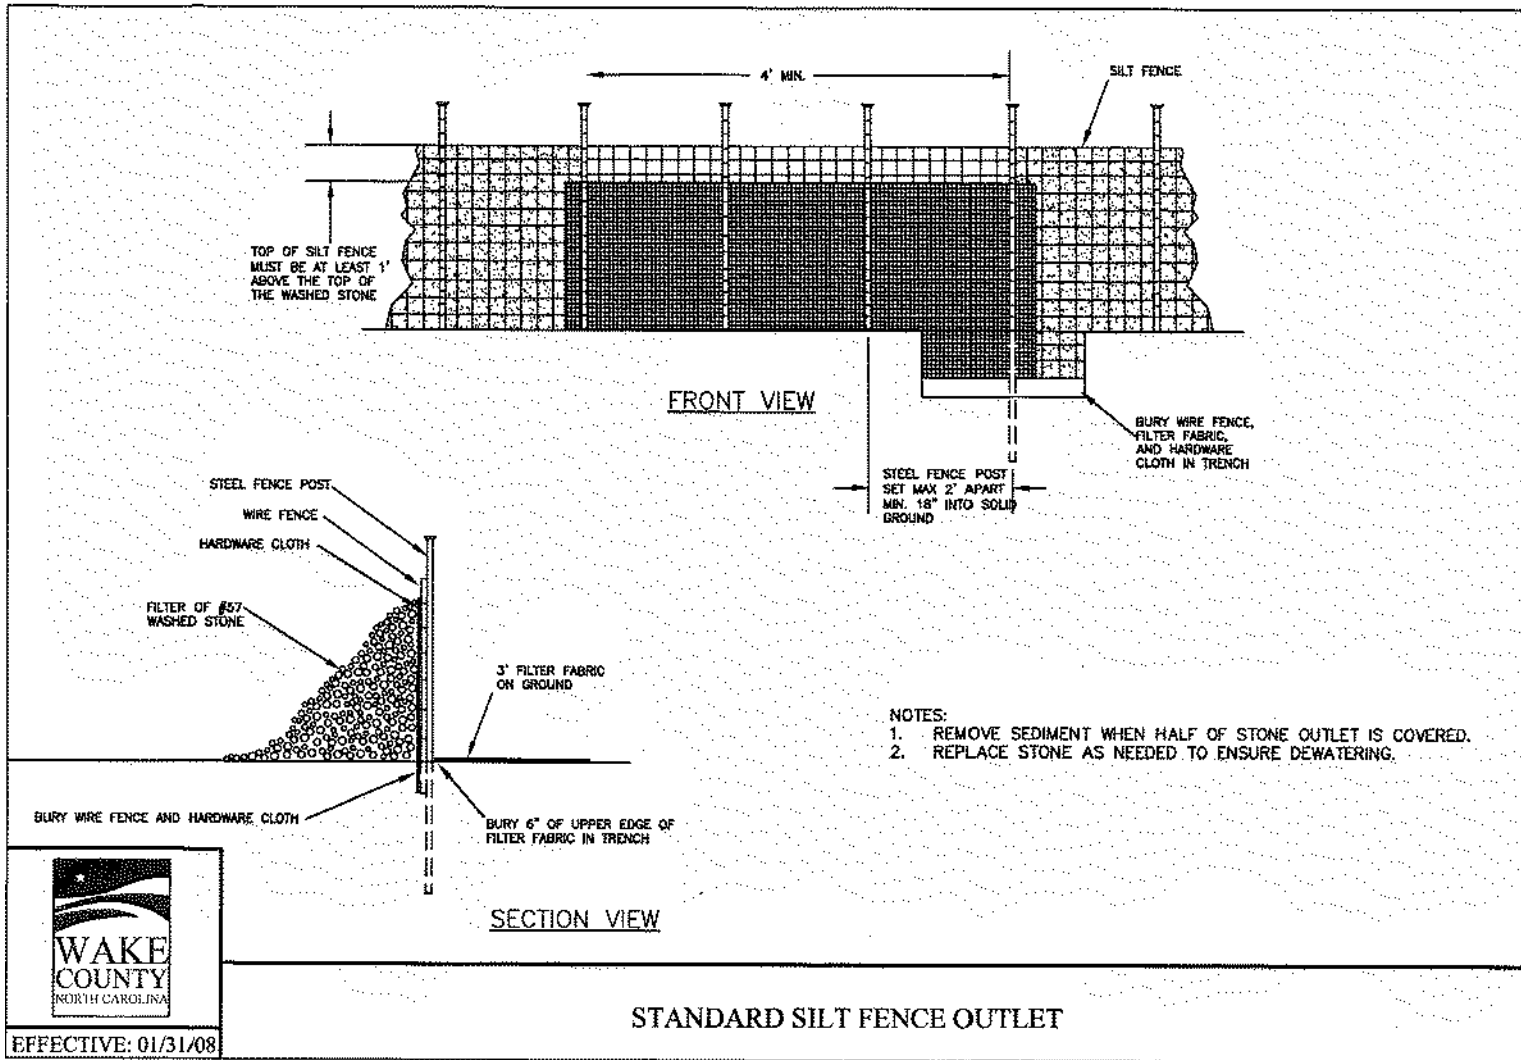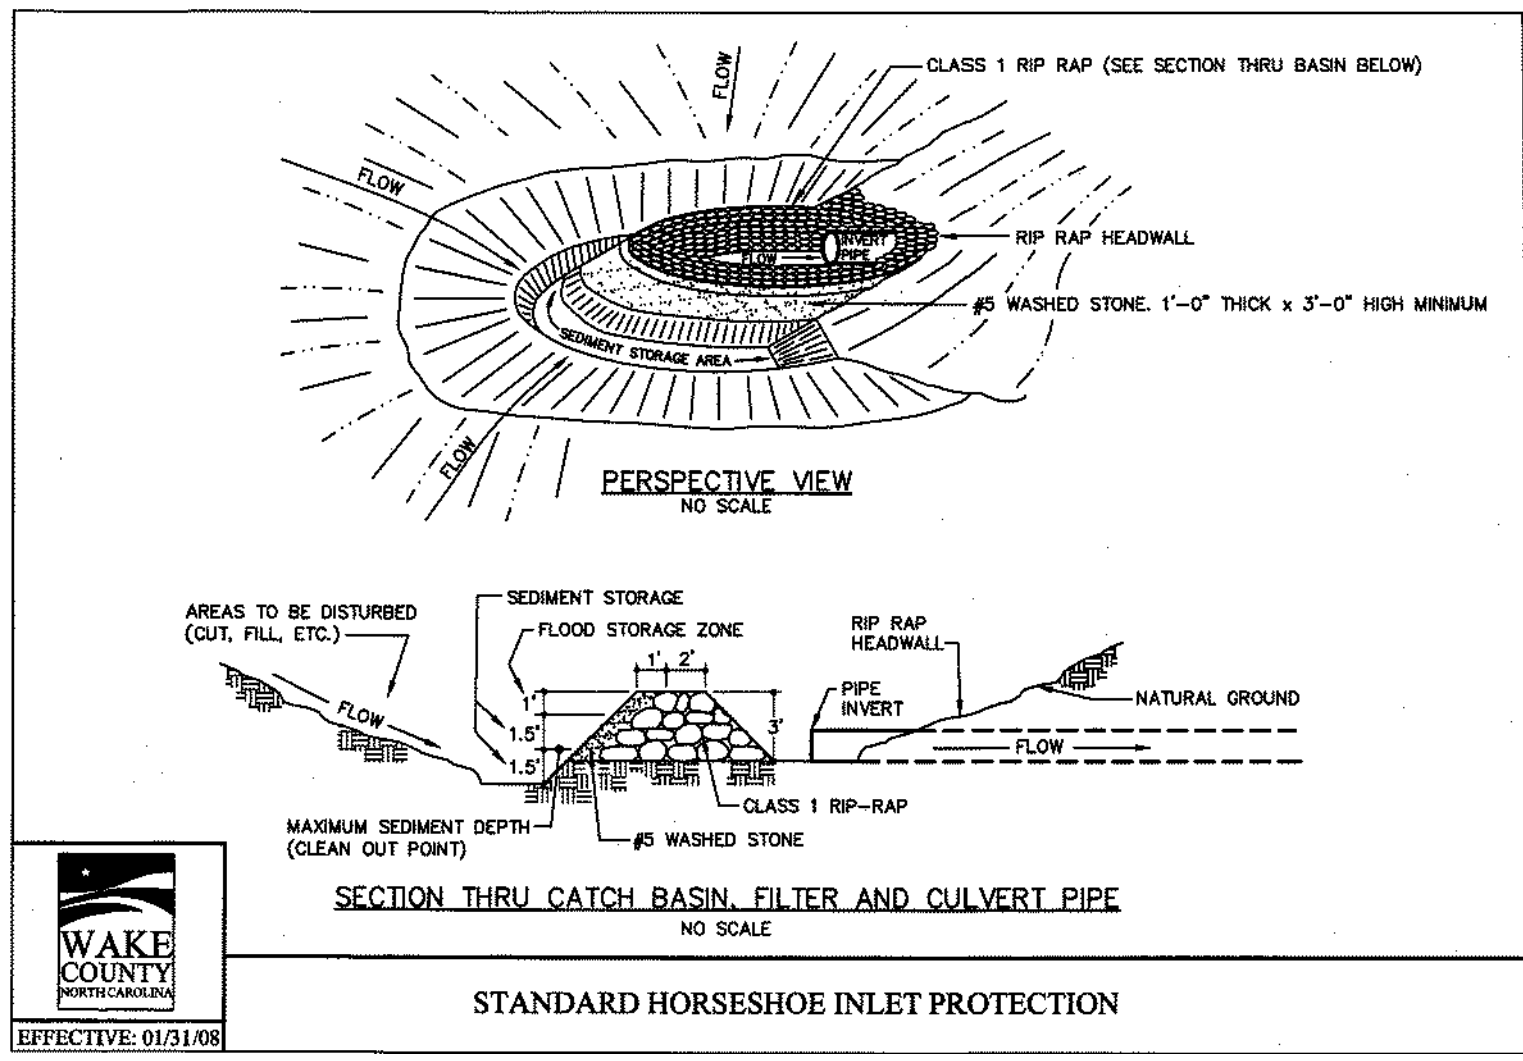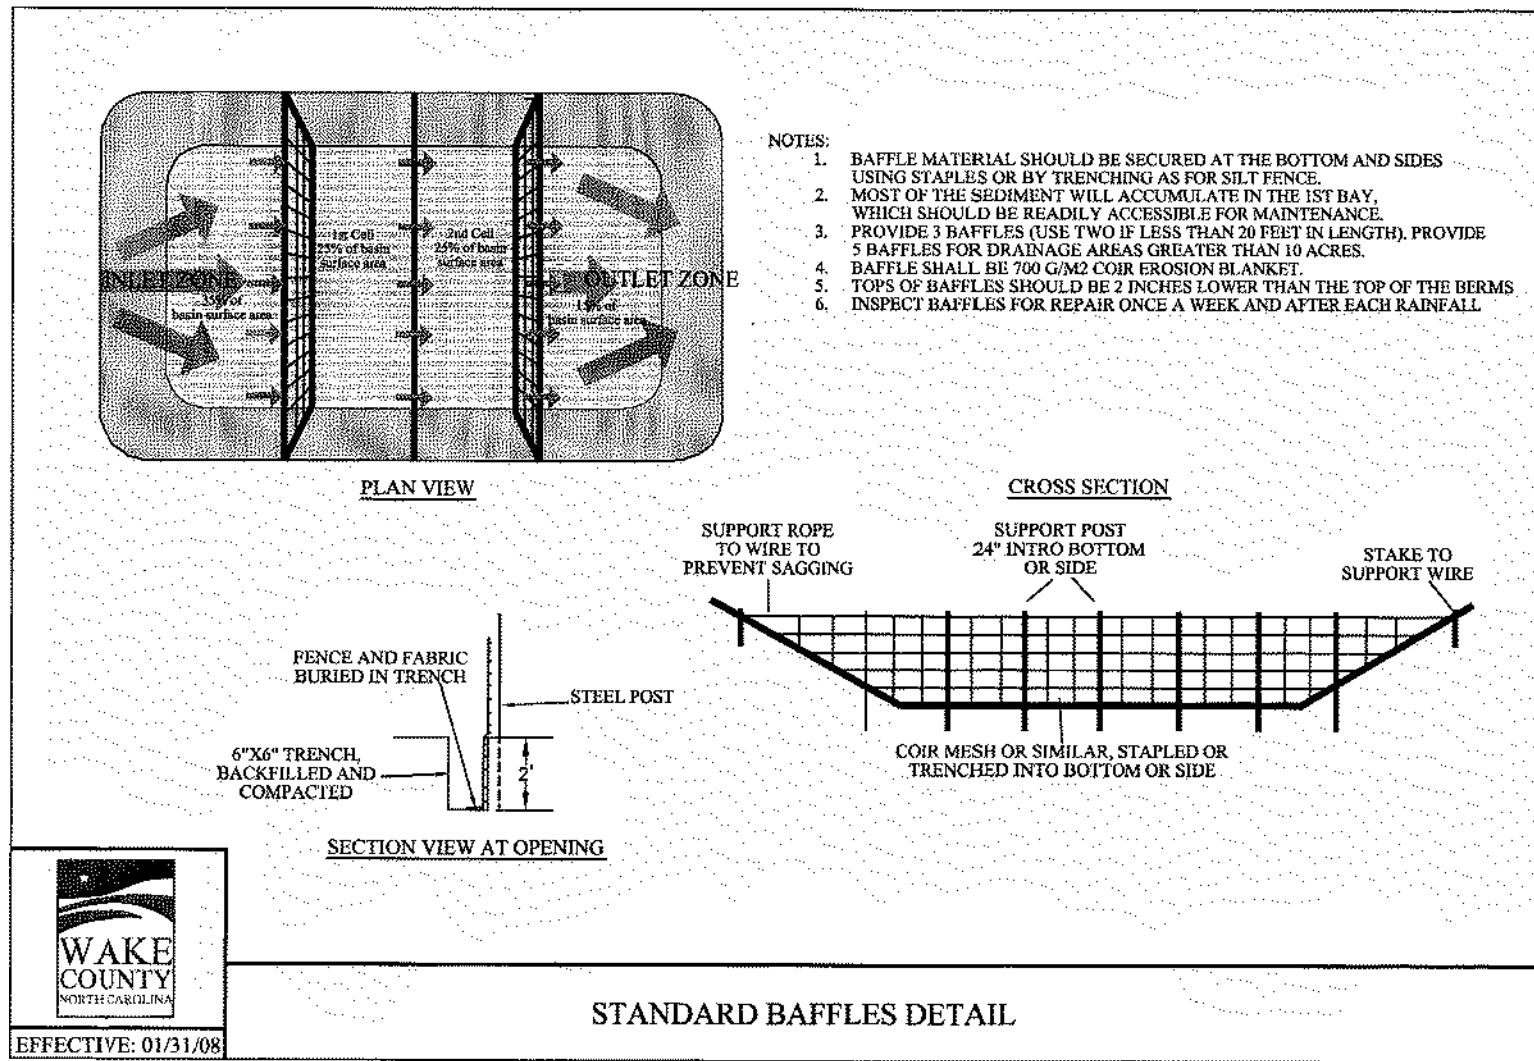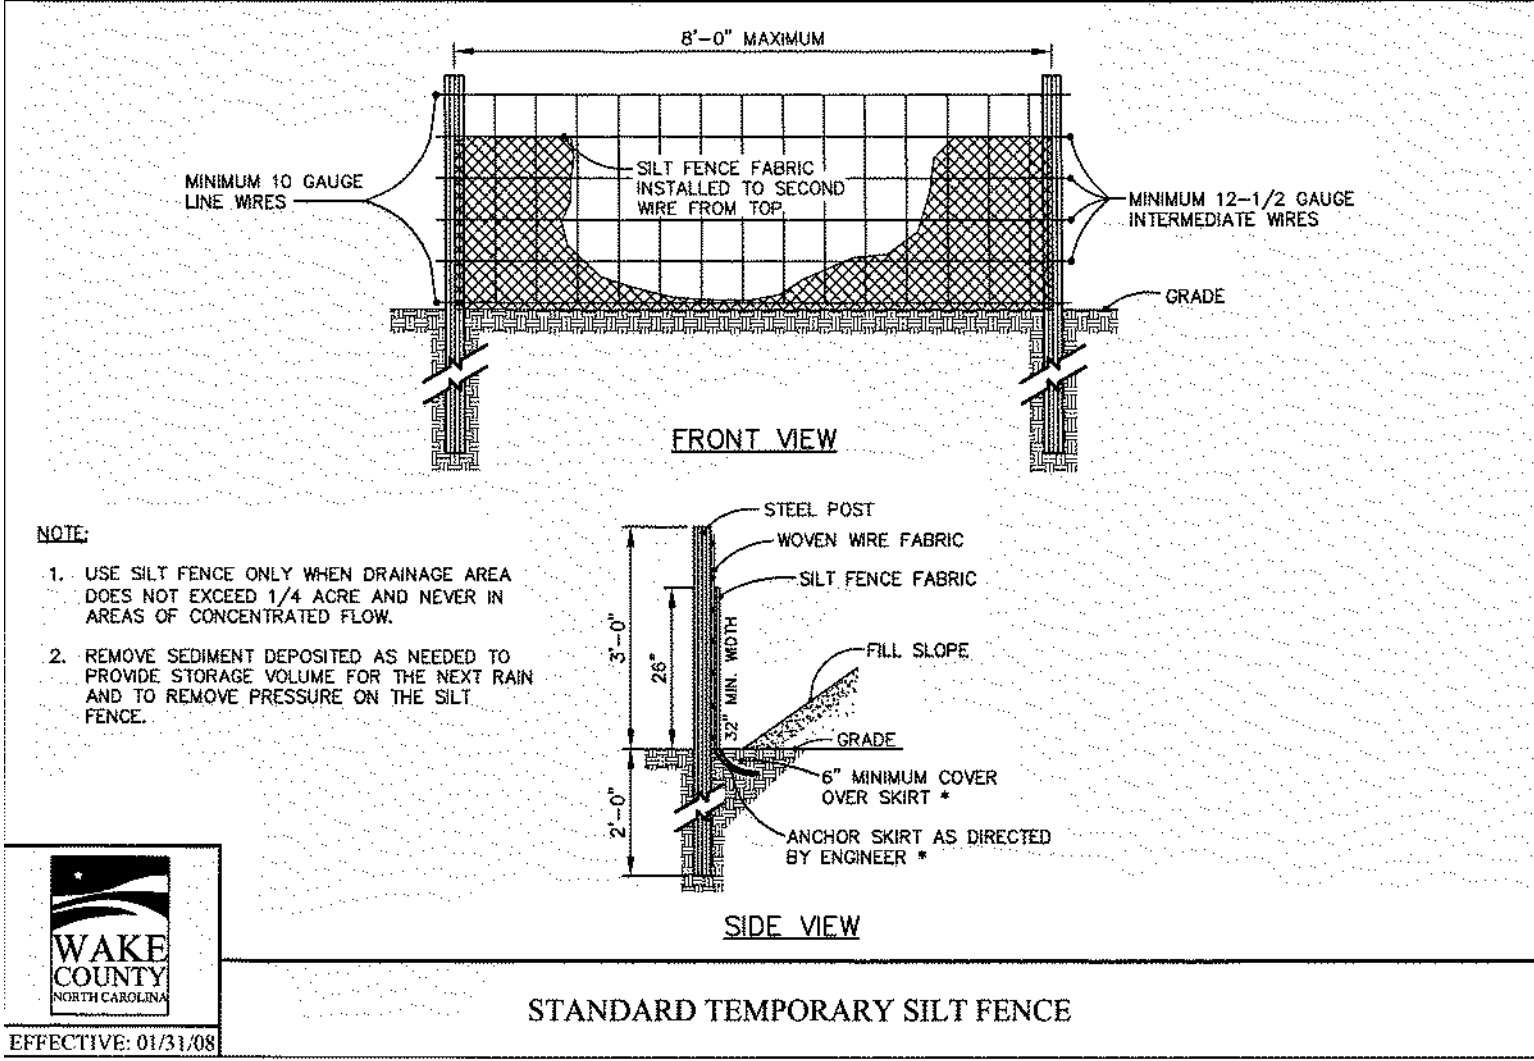

SEEDING INFORMATION:

SEEDBED PREPARATION				SEEDING SCHEDULE			
1.	CHISEL	COMPACTED AREAS AND SPREAD TOPSOIL 3 INCHES DEEP OVER ADVERSE SOIL CONDITIONS, IF AVAILABLE.		PERMANENT SEEDING - SHOULDERS, SIDE DITCHES, SLOPES (MAX. 3:1)			
2.	RIP	THE ENTIRE AREA TO 6 INCHES DEPTH.		DATE	TYPE	PLANTING RATE	
3.	REMOVE	ALL LOOSE ROCK, ROOTS, AND OTHER OBSTRUCTIONS LEAVING SURFACE REASONABLY SMOOTH AND UNIFORM.		AUG. 15 - NOV. 1	TALL FESCUE	200 LBS./ACRE	
4.	APPLY	AGRICULTURAL LIME, FERTILIZER, AND SUPER PHOSPHATE UNIFORMLY AND MIX WITH SOIL (SEE BELOW*). F STAND SHOULD BE OVER 80% DAMAGED. REESTABLISH FOLLOWING ORIGINAL LIME, FERTILIZER AND SEEDING RATES.		NOV. 1 - MAR. 1	TALL FESCUE AND ABRUZZI RYE (NURSE CROP)	200 LBS./ACRE	
5.	CONTINUE	TILLAGE UNTIL A WELL PULVERIZED FIRM, REASONABLY UNIFORM SEEDBED IS PREPARED 4 TO 6 INCHES DEEP.		MAR. 1 - APR. 15	TALL FESCUE	200 LBS./ACRE	
6.	SEED	ON A FRESHLY PREPARED SEEDBED AND COVER LIGHTLY WITH SEEDING EQUIPMENT OR CULTIPACK AFTER SEEDING.		APR. 15 - JUN. 30	HULLED COMMON BERMUDAGRASS	15 LBS./ACRE	
7.	MULCH	IMMEDIATELY AFTER SEEDING AND ANCHOR MULCH.		PERMANENT SEEDING - SLOPES (3:1 TO 2:1)			
8.	INSPECT	ALL SEEDED AREAS AND MAKE NECESSARY REPAIRS OR RESEEDINGS WITHIN THE PLANTING SEASON, IF POSSIBLE. F STAND SHOULD BE OVER 80% DAMAGED. REESTABLISH FOLLOWING ORIGINAL LIME, FERTILIZER AND SEEDING RATES.		AUG. 15 - NOV. 1	TALL FESCUE AND SERICEA LESPEDEZA (UNHULLED, UNSCARIFIED)	200 LBS./ACRE	
9.	CONSULT	CONSERVATION ENGINEER OR SOIL CONSERVATION SERVICE FOR ADDITIONAL INFORMATION CONCERNING OTHER ALTERNATIVES FOR VEGETATION OF DENUDED AREAS. THE ABOVE VEGETATION RATES ARE THOSE WHICH DO WELL UNDER LOCAL CONDITIONS; OTHER SEEDING RATE COMBINATIONS ARE POSSIBLE.		NOV. 1 - MAR. 1	TALL FESCUE AND SERICEA LESPEDEZA (UNHULLED, UNSCARIFIED)	200 LBS./ACRE	
	APPLY	AGRICULTURAL LIMESTONE - 2 TONS/ACRE FERTILIZER - 10-10-10 ANALYSIS AT 800-1,000 LBS./ACRE		MAR. 1 - JUN. 1	TALL FESCUE AND SERICEA LESPEDEZA (SCARIFIED)	200 LBS./ACRE	
	SUPER	PHOSPHATE - 800 LBS./ACRE OF 20% ANALYSIS SUPER PHOSPHATE		MAR. 15 - JUN. 30	WEEDING LOVEGRASS AND SERICEA LESPEDEZA (SCARIFIED)	10 LBS./ACRE	
	MULCH	- 2 TONS (APPROX. 80 BALES) SMALL SMALL GRAIN STRAW/ACRE		MAR. 15 - JUN. 30	HULLED COMMON BERMUDAGRASS AND SERICEA LESPEDEZA (SCARIFIED)	15 LBS./ACRE	
	ANCHOR	- TACK WITH LIQUID ASPHALT AT 400 GAL./ACRE OR EMULSIFIED ASPHALT AT 300 GALLONS/ACRE					

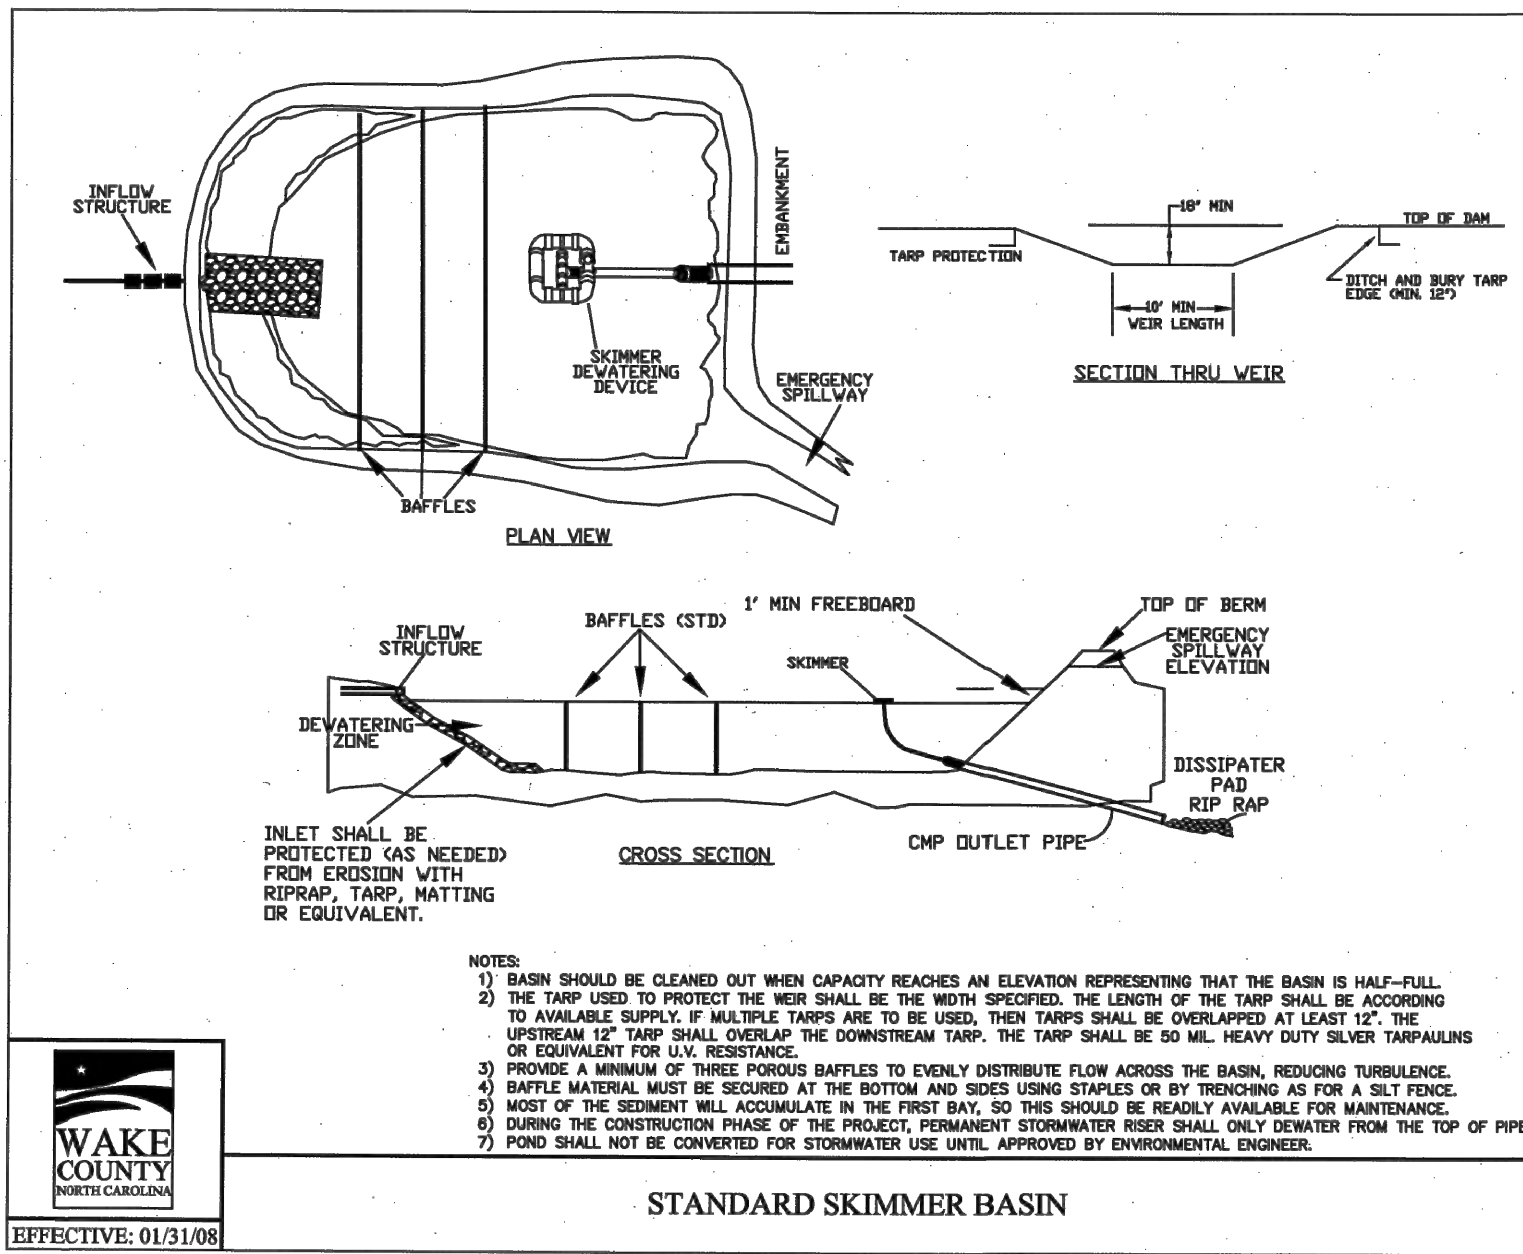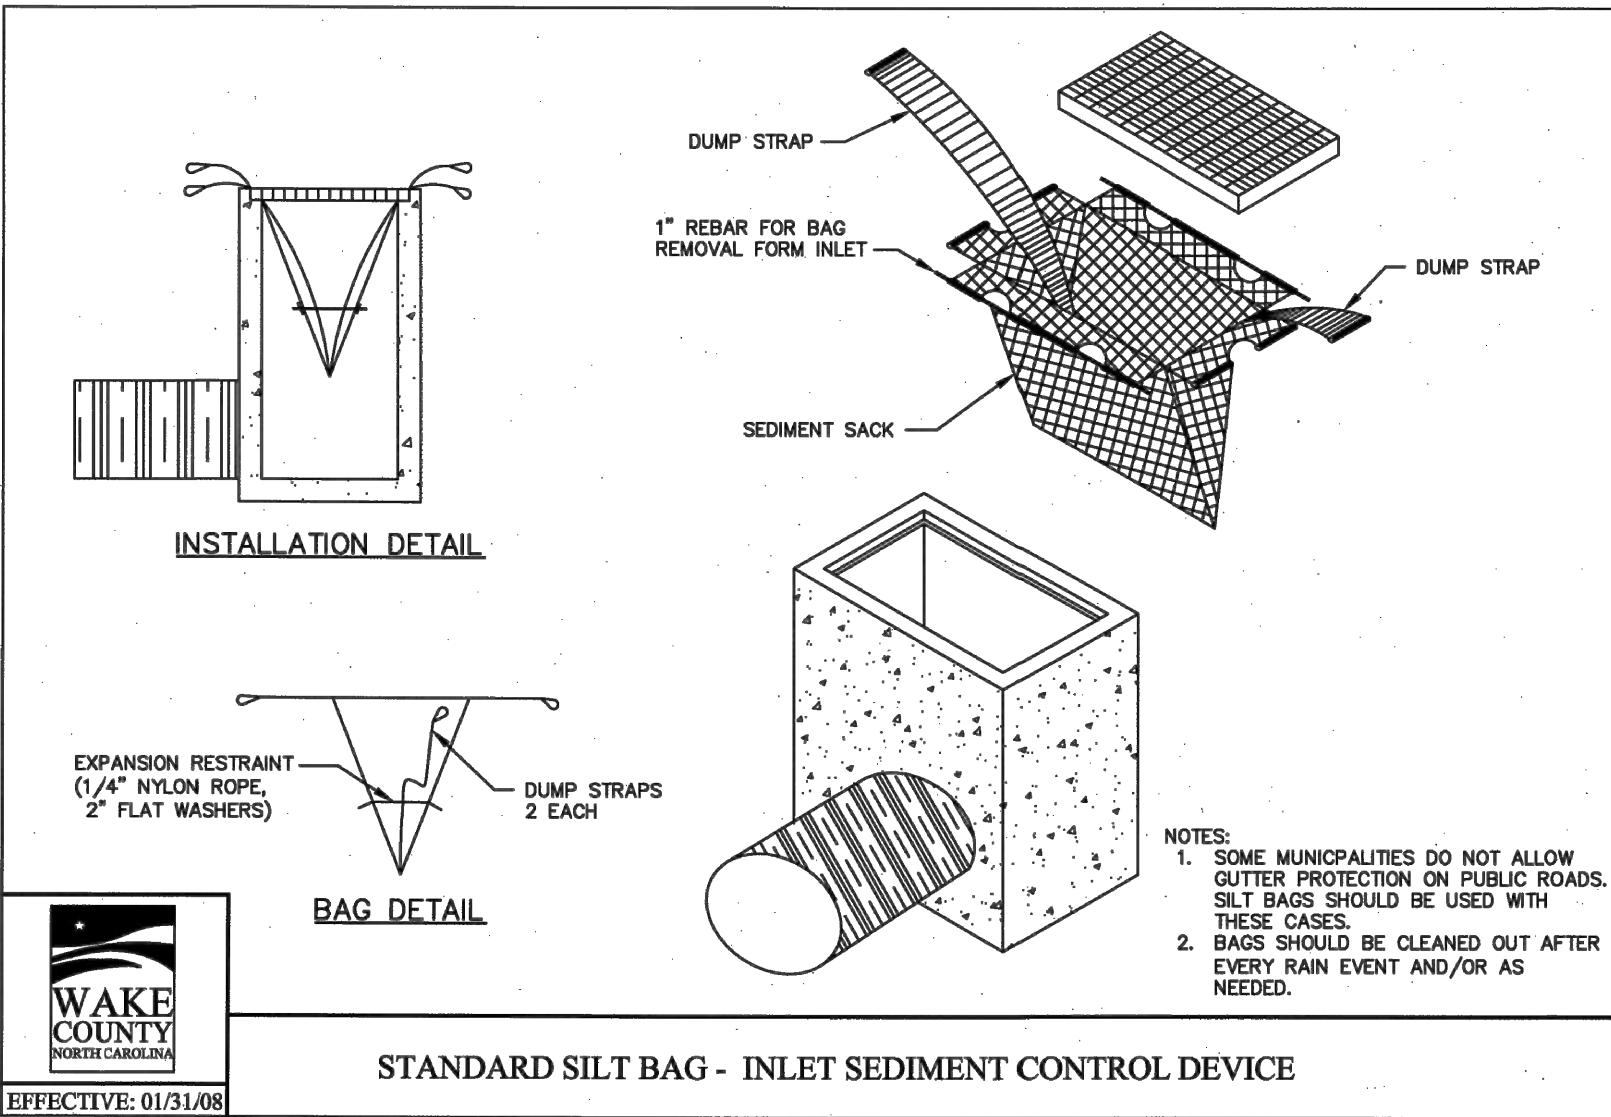

CITY OF RALEIGH - PLANS AUTHORIZED FOR CONSTRUCTION

Electronic Approval: This approval is being issued electronically. This approval is valid only upon the signature of a City of Raleigh Review Officer below. The City will retain a copy of the approved plans. Any work authorized by this approval must proceed in accordance with the plans kept on file with the City. This electronic approval may not be edited once issued. Any modification to this approval once issued will invalidate this approval.

City of Raleigh Development Approval _____

Raleigh Water Review Officer



04/20/22

BNK

BASS, NIXON & KENNEDY, INC.
CONSULTING ENGINEERS
6310 CHAPEL HILL ROAD, SUITE 250, RALEIGH, NC 27607
TELEPHONE: (919) 881-4422 FAX: (919) 881-6888
CERTIFICATION NUMBERS: NCBELS (C-0110); NCBOLA (C-0267)

NO.	DATE	DESCRIPTION	BY

PROGRESS	DATE	DRAWN BY	DATE	DESCRIPTION	BY
03-19157					
JOB NO.					

EROSION CONTROL DETAILS

COBBLESTONE VILLAGE

MIXED USE DEVELOPMENT

TOWN OF ROLESVILLE, WAKE COUNTY, NORTH CAROLINA

NOT RELEASED FOR CONSTRUCTION OR BID SOLICITATION

SHEET C3.6


TOWN OF ROLESVILLE PROJECT NO.

CITY OF RALEIGH - PLANS AUTHORIZED FOR CONSTRUCTION

Electronic Approval: This approval is being issued electronically. This approval is valid only upon the signature of a City of Raleigh Review Officer below. The City will retain a copy of the approved plans. Any work authorized by this approval must proceed in accordance with the plans kept on file with the City. This electronic approval may not be edited once issued. Any modification to this approval once issued will invalidate this approval.

City of Raleigh Development Approval _____

Raleigh Water Review Officer

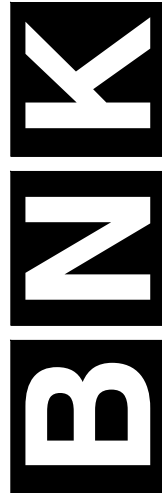

BASS, NIXON & KENNEDY, INC.
CONSULTING ENGINEERS
6310 CHAPEL HILL ROAD, SUITE 250, RALEIGH, NC 27607
TELEPHONE: (919)851-4422 FAX: (919)851-6988
CERTIFICATION NUMBERS: NCBELS (C-0110); NCBOLA (C-0267)

STORMDRAINAGE PIPE TABLE							
U.S. STRUCTURE	D.S. STRUCTURE	U.S. INVERT	D.S. INVERT	LENGTH	DIAMETER	MATERIAL	SLOPE
2	1	420.00	419.80	18.80	24	HDPE	1.06%
4	3	421.26	421.00	43.91	36	HDPE	0.60%
5	4	422.04	421.36	113.45	36	HDPE	0.60%
6	5	423.35	422.14	201.82	36	HDPE	0.60%
7	6	423.62	423.45	28.04	36	HDPE	0.60%
8	7	425.82	424.94	88.24	24	HDPE	1.00%
9	8	426.82	425.92	90.21	24	HDPE	1.00%
10	9	427.59	426.92	67.14	24	HDPE	1.00%
11	10	428.63	427.69	93.66	18	HDPE	1.00%
12	11	429.65	428.73	91.93	18	HDPE	1.00%
13	12	430.39	429.75	63.96	15	HDPE	1.00%

STORMDRAINAGE PIPE TABLE							
U.S. STRUCTURE	D.S. STRUCTURE	U.S. INVERT	D.S. INVERT	LENGTH	DIAMETER	MATERIAL	SLOPE
14	13	430.75	430.49	25.95	15	HDPE	1.00%
15	5	424.10	423.05	105.41	15	HDPE	1.00%
16	7	424.61	423.72	147.77	24	HDPE	0.60%
17	16	425.41	424.71	116.44	24	HDPE	0.60%
18	17	428.85	427.77	107.92	15	HDPE	1.00%
19	18	431.57	430.69	88.39	15	HDPE	1.00%
20	19	432.50	431.67	83.01	15	HDPE	1.00%
21	6	424.24	423.45	78.65	24	HDPE	1.00%
22	21	424.60	424.34	26.08	15	HDPE	1.00%
23	22	426.78	424.70	207.76	15	HDPE	1.00%
24	10	432.22	430.86	90.55	15	HDPE	1.50%

STORMDRAINAGE PIPE TABLE							
U.S. STRUCTURE	D.S. STRUCTURE	U.S. INVERT	D.S. INVERT	LENGTH	DIAMETER	MATERIAL	SLOPE
27	28	436.27	435.41	85.76	15	HDPE	1.00%
28	35	435.31	434.24	106.92	15	HDPE	1.00%
29	22	425.05	424.70	34.83	15	HDPE	1.00%
30	17	426.34	425.51	137.91	18	HDPE	0.60%
31	18	429.82	428.95	87.08	15	HDPE	1.00%
32	9	429.50	428.60	90.23	15	HDPE	1.00%
33	24	432.43	432.32	11.23	15	HDPE	1.00%
34	17	428.09	427.77	32.09	12	HDPE	1.00%
35	33	434.14	432.53	160.60	15	HDPE	1.00%

STORMDRAINAGE STRUCTURE TABLE		
STRUCTURE NAME	INSERTION RIM ELEVATION (FLOWLINE)	STRUCTURE TYPE
1	422.45 INV. IN= 419.80 (2)	24" FES
2	425.18 INV. OUT= 420.00 (1)	RISER
3	424.83 INV. IN= 421.00 (4)	36" FES
4	428.06 INV. IN= 421.36 (5) INV. OUT= 421.26 (3)	NCDOT CURB INLET
5	429.08 INV. IN= 422.14 (6) INV. IN= 423.05 (15) INV. OUT= 422.04 (4)	NCDOT CURB INLET
6	430.99 INV. IN= 423.45 (7) INV. IN= 423.45 (21) INV. OUT= 423.35 (5)	NCDOT CURB INLET
7	431.15 INV. IN= 424.94 (8) INV. IN= 423.72 (16) INV. OUT= 423.62 (6)	NCDOT CURB INLET
8	433.95 INV. IN= 425.92 (9) INV. OUT= 425.82 (7)	NCDOT CURB INLET
9	433.95 INV. IN= 426.92 (10) INV. IN= 428.60 (32) INV. OUT= 426.82 (8)	NCDOT CURB INLET

STORMDRAINAGE STRUCTURE TABLE		
STRUCTURE NAME	INSERTION RIM ELEVATION (FLOWLINE)	STRUCTURE TYPE
10	436.44 INV. IN= 427.69 (11) INV. IN= 430.86 (24) INV. OUT= 427.59 (9)	HDPE YARD INLET
11	437.44 INV. IN= 428.73 (12) INV. OUT= 428.63 (10)	HDPE YARD INLET
12	435.50 INV. IN= 429.75 (13) INV. OUT= 429.65 (11)	HDPE YARD INLET
13	436.00 INV. IN= 430.49 (14) INV. OUT= 430.39 (12)	NCDOT CURB INLET
14	436.00 INV. OUT= 430.75 (13)	NCDOT CURB INLET
15	428.50 INV. OUT= 424.10 (5)	HDPE YARD INLET
16	429.68 INV. IN= 424.71 (17) INV. OUT= 424.61 (7)	NCDOT CURB INLET
17	434.01 INV. IN= 427.77 (18) INV. IN= 425.51 (30) INV. IN= 427.77 (34) INV. OUT= 425.41 (16)	NCDOT CURB INLET
18	436.04 INV. IN= 430.69 (19) INV. IN= 428.95 (31) INV. OUT= 428.85 (17)	NCDOT CURB INLET

STORMDRAINAGE STRUCTURE TABLE		
STRUCTURE NAME	INSERTION RIM ELEVATION (FLOWLINE)	STRUCTURE TYPE
19	437.52 INV. IN= 431.67 (20) INV. OUT= 431.57 (18)	NCDOT CURB INLET
20	438.65 INV. OUT= 432.50 (19)	NCDOT CURB INLET
21	431.60 INV. IN= 424.34 (22) INV. OUT= 424.24 (6)	HDPE YARD INLET
22	432.00 INV. IN= 424.70 (23) INV. IN= 424.70 (29) INV. OUT= 424.60 (21)	NCDOT CURB INLET
23	435.99 INV. OUT= 426.78 (22)	NCDOT CURB INLET
24	437.18 INV. IN= 432.32 (33) INV. OUT= 432.22 (10)	HDPE YARD INLET
27	441.00 INV. OUT= 436.27 (28)	HDPE YARD INLET
28	441.00 INV. IN= 435.41 (27) INV. OUT= 435.31 (35)	HDPE YARD INLET
29	428.50 INV. OUT= 425.05 (22)	HDPE YARD INLET

STORMDRAINAGE STRUCTURE TABLE		
STRUCTURE NAME	INSERTION RIM ELEVATION (FLOWLINE)	STRUCTURE TYPE
30	430.12 INV. OUT= 426.34 (17)	NCDOT CURB INLET
31	434.05 INV. OUT= 429.82 (18)	NCDOT CURB INLET
32	435.72 INV. OUT= 429.50 (9)	NCDOT CURB INLET
33	437.87 INV. IN= 432.53 (35) INV. OUT= 432.43 (24)	NCDOT CURB INLET
34	430.03 INV. OUT= 428.09 (17)	HDPE YARD INLET
35	441.08 INV. IN= 434.24 (28) INV. OUT= 434.14 (33)	HDPE YARD INLET



04/20/22



COBBLESTONE VILLAGE

MIXED USE DEVELOPMENT

TOWN OF ROLESVILLE, WAKE COUNTY, NORTH CAROLINA

SHEET C3.8

03-19157	PROGRESS	MRM	DATE	DRAWN BY
STORM DRAINAGE PIPE & STRUCTURE TABLE				
SCALE:	CHK BY: MDB	NO.	DATE	DESCRIPTION
REVISIONS				
				BY

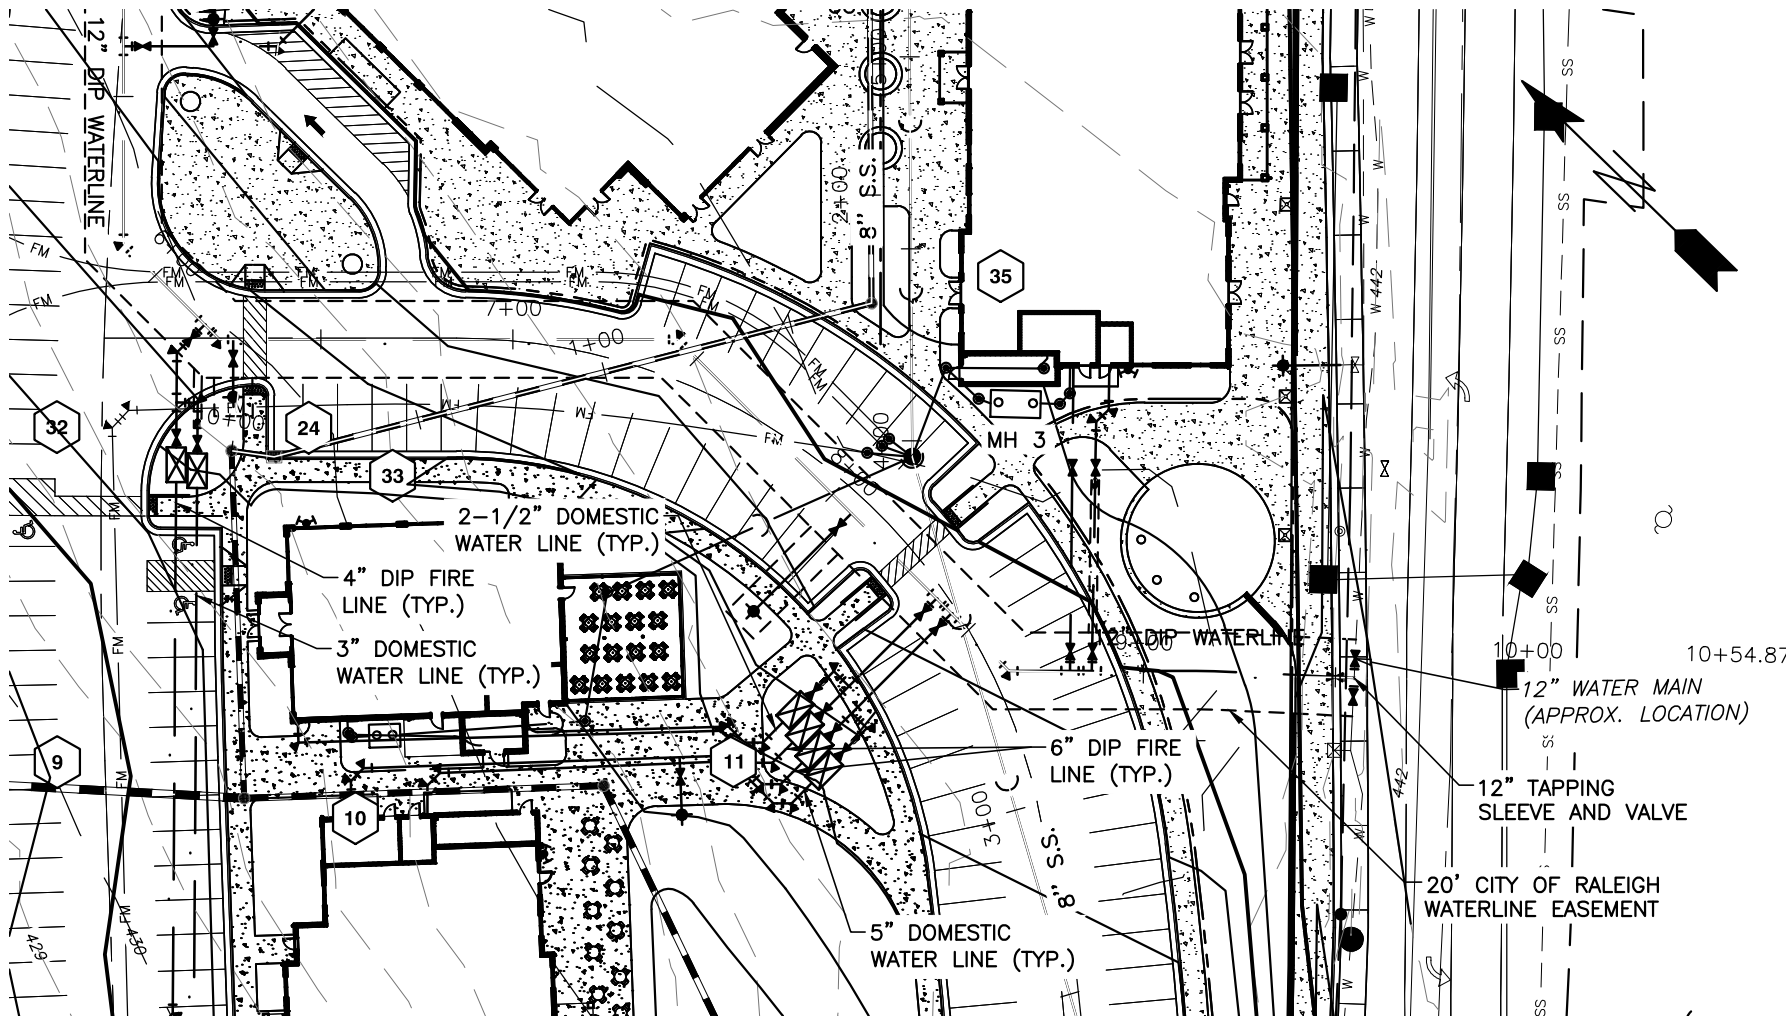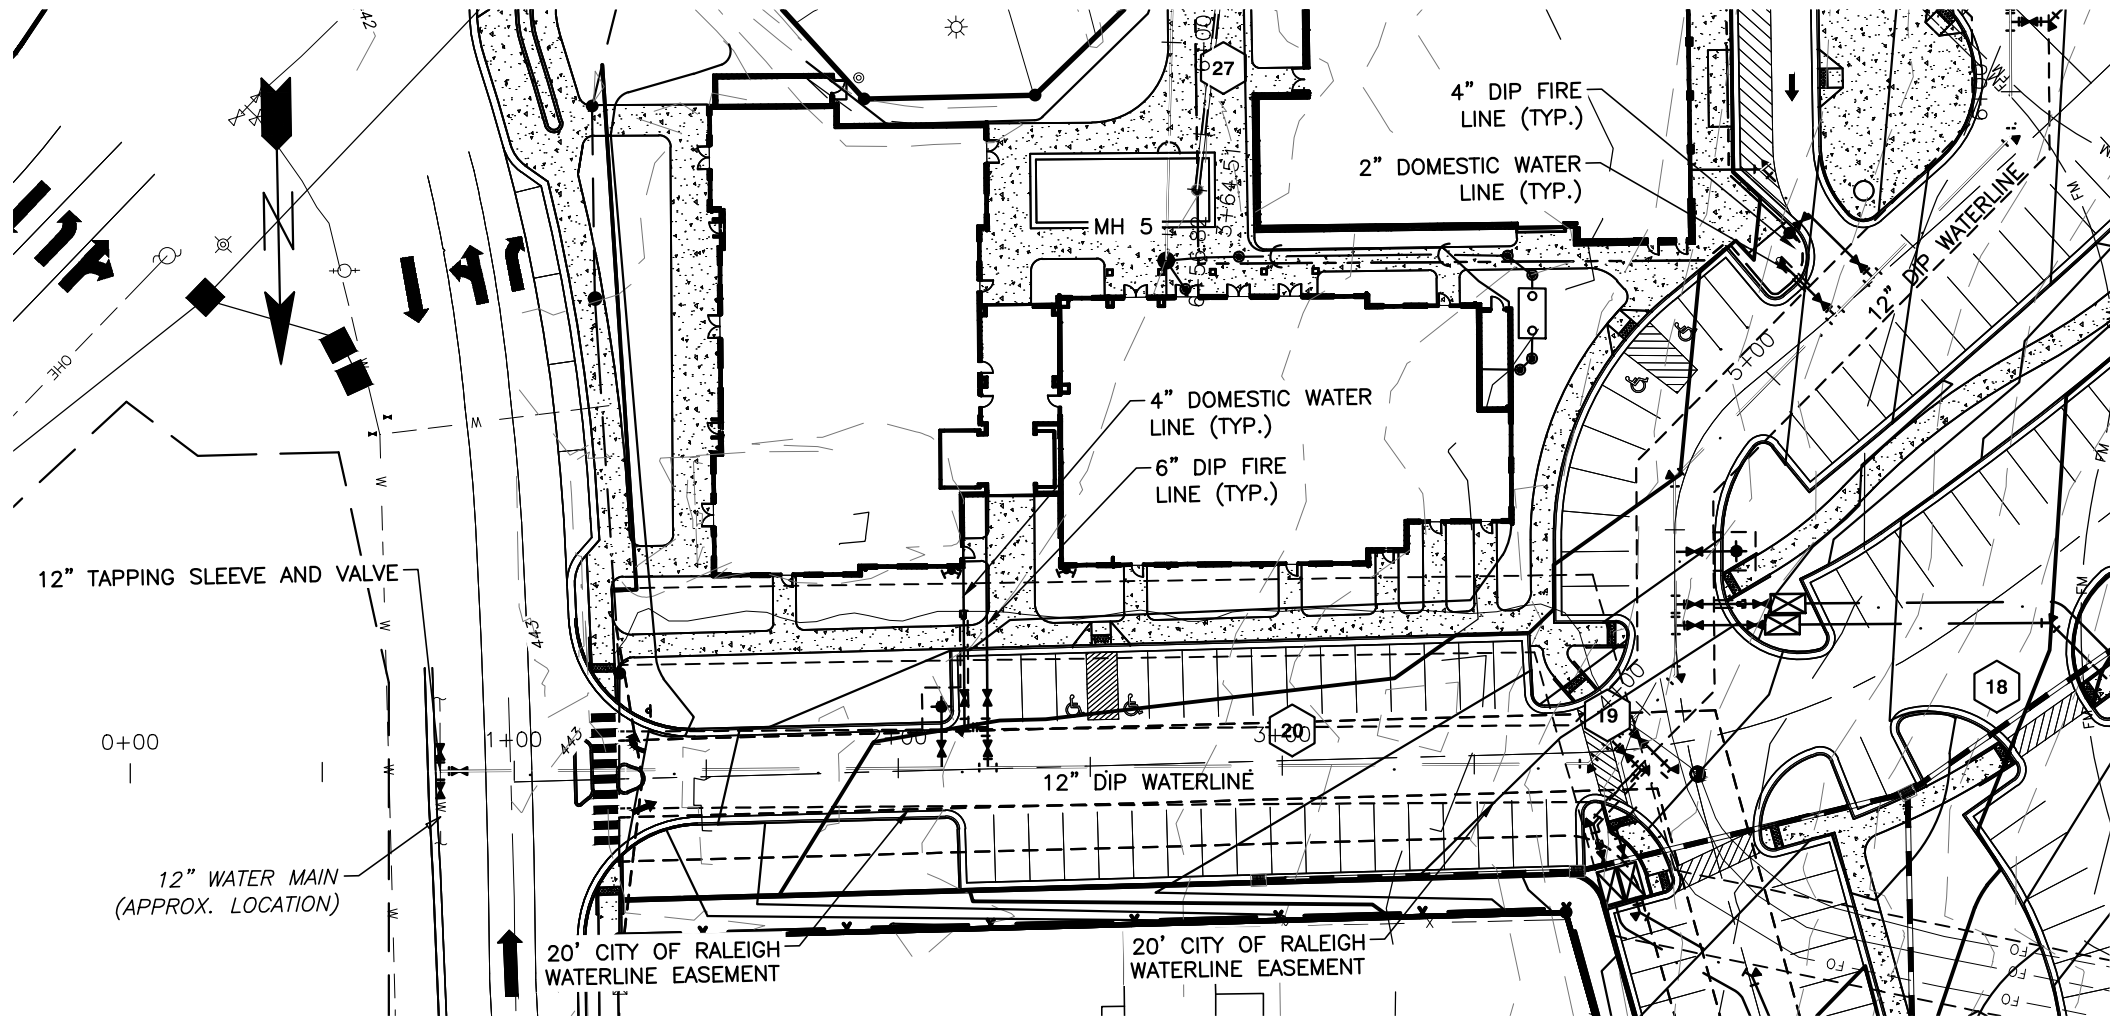

Public
Water Distribution / Extension System
The City of Raleigh consents to the connection and extension of the City's public water system as shown on this plan. The material and construction methods used for this project shall conform to the standards and specifications of the City's Public Utilities Handbook.

City of Raleigh
Public Utilities Department Permit # W-3879
Authorization to Construct See digital signature


CITY OF RALEIGH - PLANS AUTHORIZED FOR CONSTRUCTION

Electronic Approval: This approval is being issued electronically. This approval is valid only upon the signature of a City of Raleigh Review Officer below. The City will retain a copy of the approved plans. Any work authorized by this approval must proceed in accordance with the plans kept on file with the City. This electronic approval may not be edited once issued. Any modification to this approval once issued will invalidate this approval.

City of Raleigh Development Approval _____

Raleigh Water Review Officer _____

PUBLIC WATERLINE PROFILE

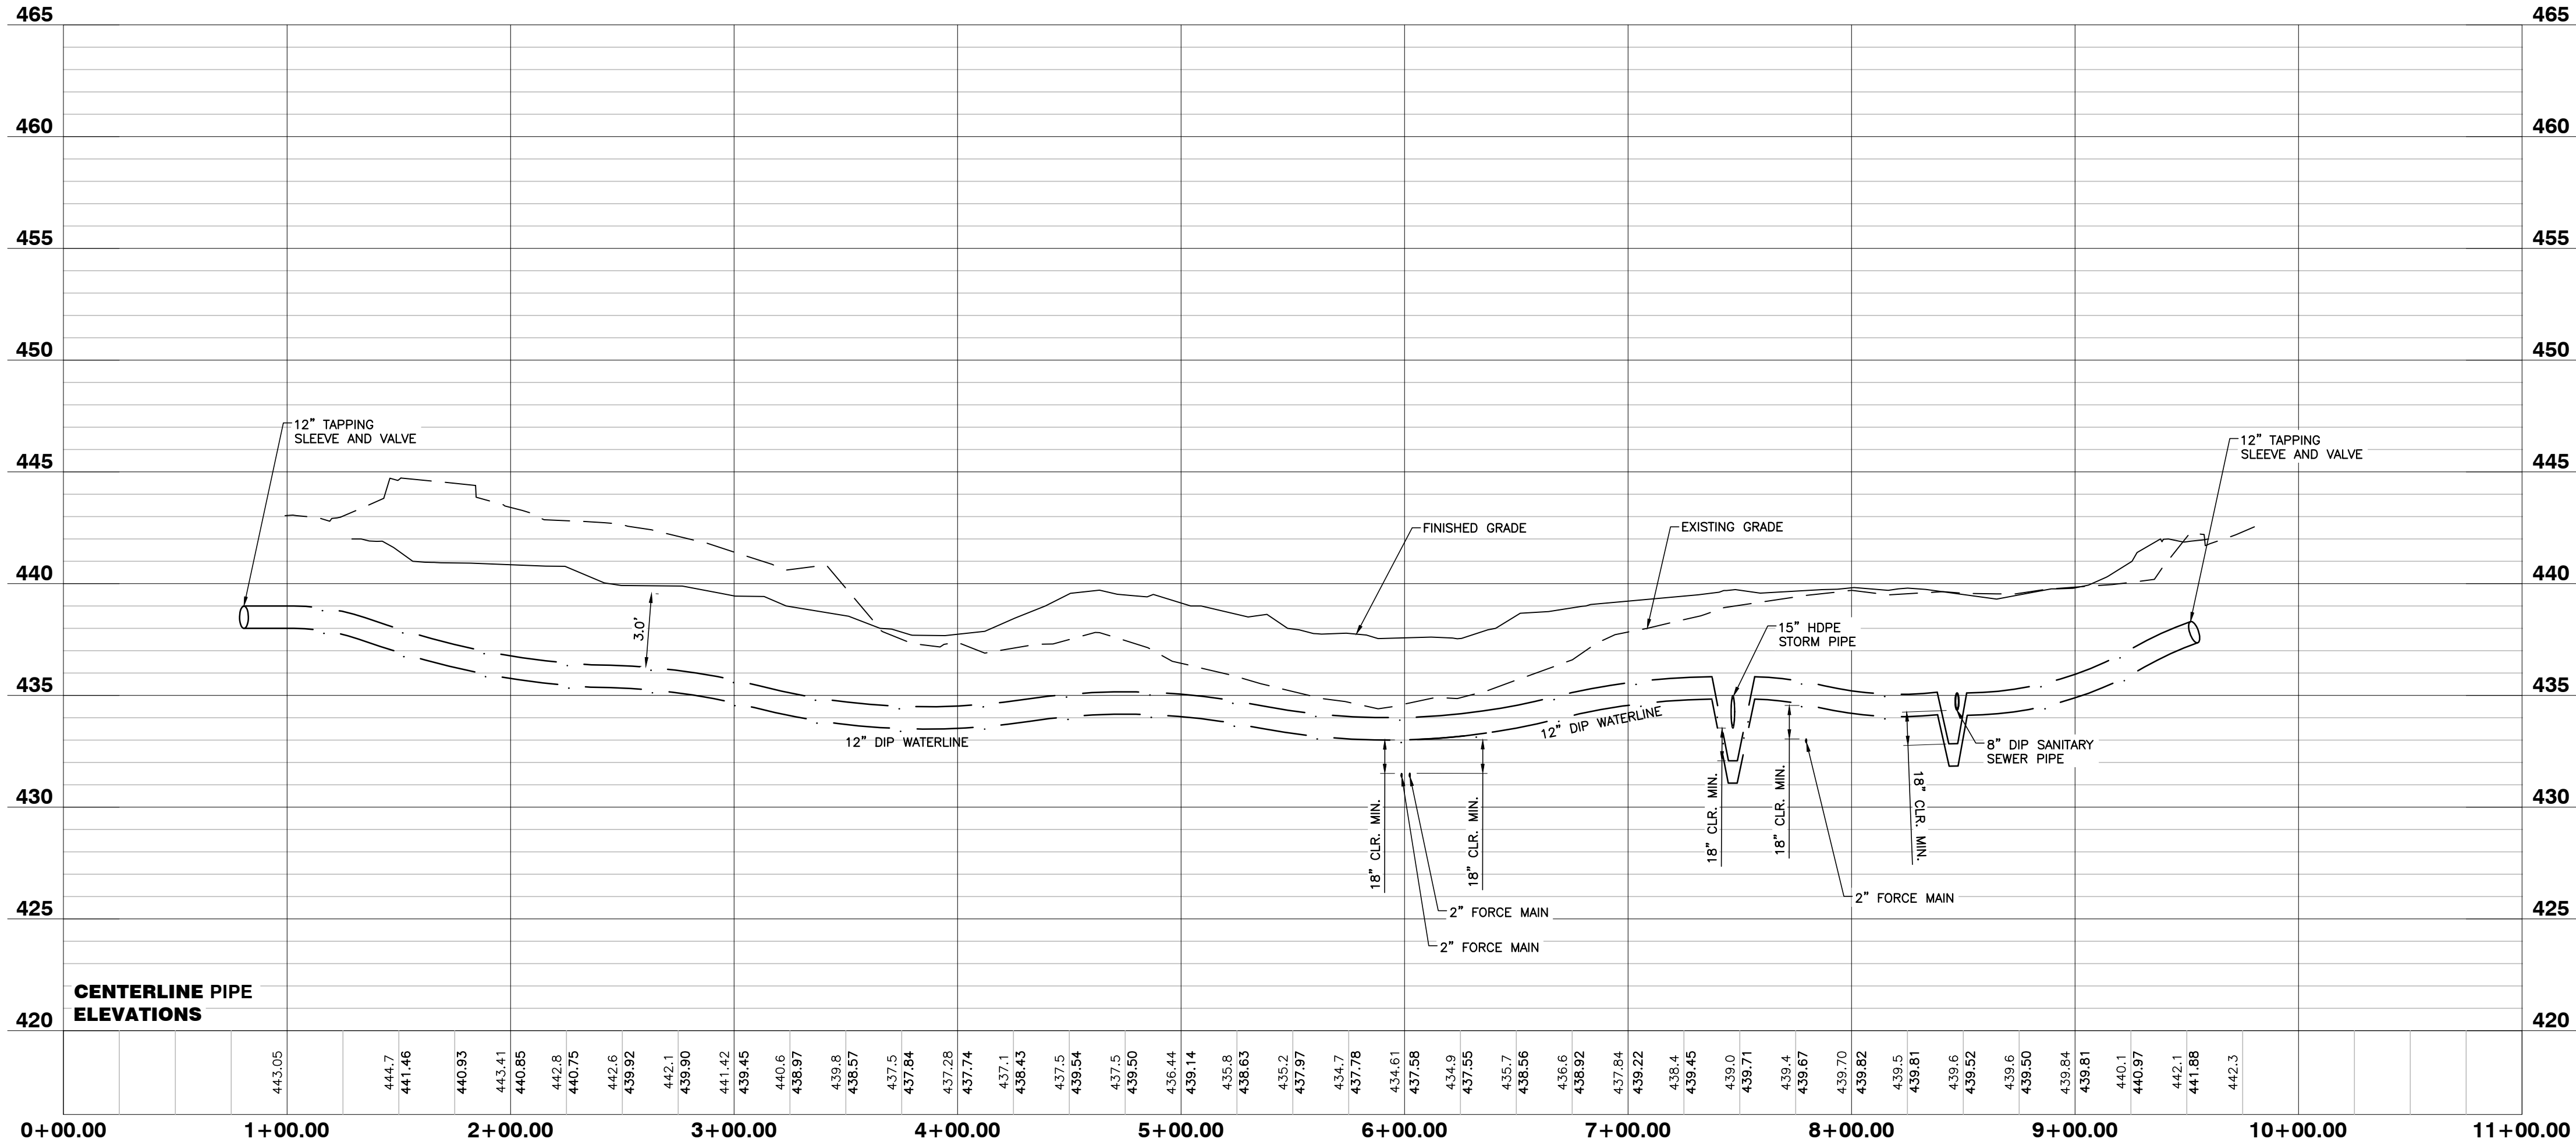

04/20/22

NO FLOODPLAINS EXIST ON-SITE

NOTE: ALL CONSTRUCTION ACTIVITY MUST BE IN ACCORDANCE WITH THE ACCEPTED POLICIES OF THE TOWN OF ROLESVILLE AND NCDOT




BASS, NIXON & KENNEDY, INC.
CONSULTING ENGINEERS
6310 CHAPEL HILL ROAD, SUITE 250, RALEIGH, NC 27607
TELEPHONE: (919) 881-1422 FAX: (919) 881-8888
CERTIFICATION NUMBERS: NCBELS (C-0110); NCBOLA (C-0287)

NO.	DATE	DESCRIPTION	BY

03-19157	PROGRESS	MRM
JOB NO.	DATE	DRAWN BY
PUBLIC WATERLINE PROFILE		
SCALE: 1" = 50' H/ 1" = 5' V CHK BY: MDB		

COBBLESTONE VILLAGE
MIXED USE DEVELOPMENT
TOWN OF ROLESVILLE, WAKE COUNTY, NORTH CAROLINA

SHEET
C4.1

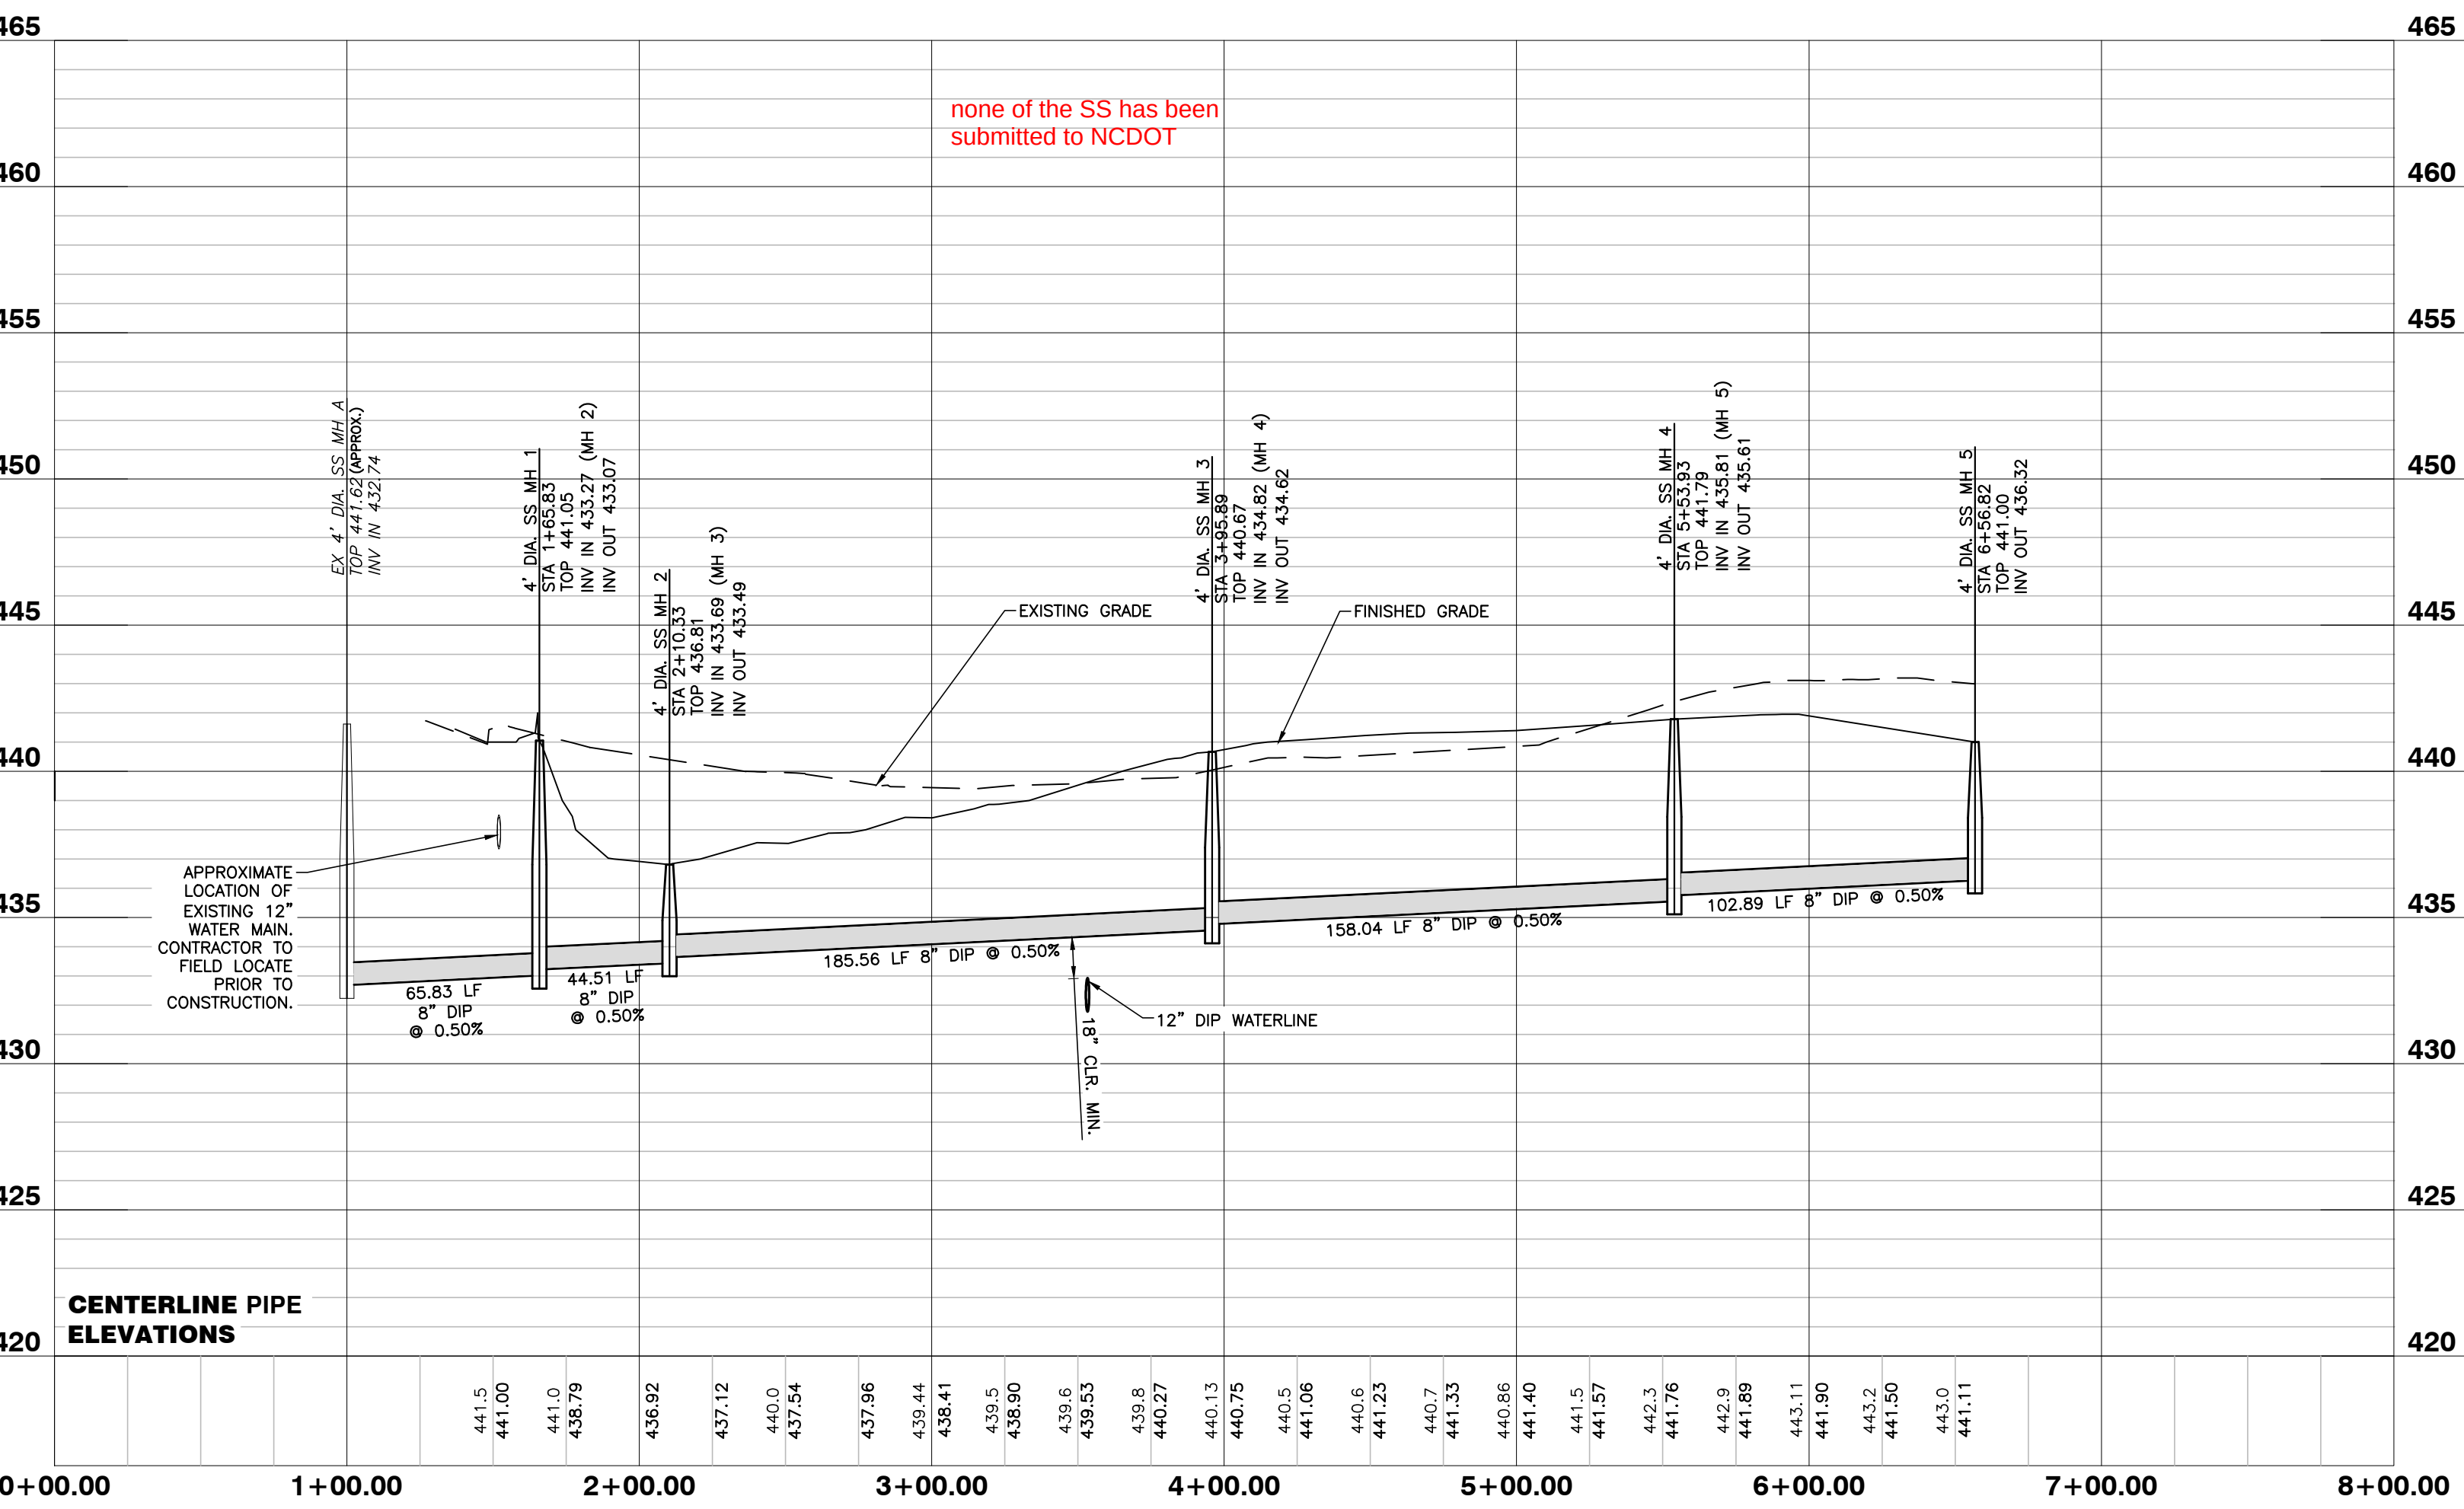

CITY OF RALEIGH - PLANS AUTHORIZED FOR CONSTRUCTION

Electronic Approval: This approval is being issued electronically. This approval is valid only upon the signature of a City of Raleigh Review Officer below. The City will retain a copy of the approved plans. Any person authorized by this approval must proceed in accordance with the plans kept on file with the City. This electronic approval may not be edited once issued. Any modification to this approval once issued will invalidate this approval.

City of Raleigh Development Approval _____

Raleigh Water Review Officer

Raleigh Water Review Officer

NOTE: ALL CONSTRUCTION ACTIVITY MUST BE IN ACCORDANCE WITH THE ACCEPTED POLICIES OF THE TOWN OF ROLESVILLE AND NCDOT

NO FLOODPLAINS EXIST ON-SITE

04/20/22

SHEET
C4.2

GENERAL NOTES

- A/C UNITS, TRANSFORMERS AND OTHER MECHANICAL OR UTILITY EQUIPMENT, NOT SHOWN ON THE PLAN, SHALL BE SCREENED FROM VIEW EITHER BY ADJUSTING PLANTINGS SHOWN IN CLOSE PROXIMITY TO EQUIPMENT OR BY THE ADDITION OF WAX MYRTLES @ 24" HT. 5' OC (SEE GENERAL NOTES FOR EQUIPMENT ACCESSIBILITY AND PLANTING PROXIMITY, ETC.). DUMPSTER IS SCREENED FROM OFF-SITE VIEWS.
- CONTRACTOR SHALL VERIFY LOCATION OF ALL UTILITIES PRIOR TO PLANTING.
- MULCH SHALL BE 3" DEEP MULCH UNLESS OTHERWISE NOTED.
- VERIFICATION OF TOTAL QUANTITIES AS SHOWN IN THE PLANT LIST AND ON THE PLAN SHALL BE THE RESPONSIBILITY OF THE LANDSCAPE CONTRACTOR. ANY DISCREPANCIES BETWEEN PLANT LIST AND PLANTING PLAN SHALL BE BROUGHT TO THE ATTENTION OF THE LANDSCAPE ARCHITECT FOR CLARIFICATION.
- ALL TREES, SHRUBS, GROUNDCOVER, ETC. SHALL CONFORM TO ACCEPTED STANDARDS ESTABLISHED BY THE AMERICAN ASSOCIATION OF NURSERMEN.
- ALL ROOTBALLS REMOVED FROM CONTAINERS SHALL BE SCARIFIED PRIOR TO PLANTING.
- B&B AS LISTED UNDER "ROOT" IN THE PLANT LIST INDICATES BALLED & BURLAPPED.
- ALL PLANTS/PLANTINGS SHALL BE MULCHED IMMEDIATELY AFTER PLANTING AND WATERED.
- ALL PLANTS SHALL BEAR THE SAME RELATIONSHIP TO FINISHED GRADE AS THEY BORE TO PREVIOUS EXISTING GRADE (UNLESS OTHERWISE NOTED).
- ALL TREES AND SHRUBS SHALL REQUIRE MULCH RINGS AT THEIR BASE IF LEFT WITHIN LAWN AREAS.
- MULCH EDGES AND PROPOSED PLANTINGS SHALL NOT DISTURB ANY EXISTING GROUPS OF TREES TO REMAIN. EDGES ARE SHOWN FOR APPROXIMATION ONLY, BUT ARE TO INDICATE SMOOTH, CLEAN CURVES.
- CULVERTS, RIP-RAP STRUCTURES, AND OTHER STORMWATER DEVICES SHALL BE SCREENED WITH EVERGREEN SHRUBS. IF STRUCTURES ARE NOT SHOWN ON THE PLAN, INSTALL WAX MYRTLES @ 24" HT. = 5' OC.
- A 2' BUMPER OVERHANG, FROM THE BACK OF CURB, SHALL BE ALLOTTED FOR MATURE SHRUBS.
- TREE PROTECTION FENCING SHALL BE MAINTAINED UNTIL ALL SITE WORK IS COMPLETED. THE FENCING SHALL BE REMOVED PRIOR TO THE FINAL SITE INSPECTION FOR THE CERTIFICATE OF OCCUPANCY (C.O.). THE SITE SHALL BE STABILIZED AND SEEDED PRIOR TO THE ISSUANCE OF A (C.O.).
- UNLESS OTHERWISE NOTED ON THE PLAN, ALL DISTURBED AREAS ARE TO BE SEEDED WITH WARM SEASON GRASS, INCLUDING PARKING LOT PERIMETERS AND PARKING LOT ISLANDS.
- PERIMETER BUFFER AREAS ARE TO BE MULCHED TO A DEPTH OF THREE INCHES.

LANDSCAPE CALCULATIONS

PERIMETER BUFFERS (10' TYPICAL):
WEST (1) - 352 LF = 4 TREES / 100 LF = 14 TREES REQUIRED/PROVIDED
= 40 SHRUBS / 100 LF = 141 SHRUBS REQUIRED/PROVIDED
= 352 LF MIN. 6' TALL FENCE REQUIRED


NORTH (2) - 187 LF = 4 TREES / 100 LF = 8 TREES REQUIRED/PROVIDED
= 40 SHRUBS / 100 LF = 75 SHRUBS REQUIRED/PROVIDED
= 187 LF MIN. 6' TALL FENCE REQUIRED

NORTHEAST (3) - 240 LF = 4 TREES / 100 LF = 10 TREES REQUIRED/PROVIDED
= 40 SHRUBS / 100 LF = 96 SHRUBS REQUIRED/PROVIDED
= 240 LF MIN. 6' TALL FENCE REQUIRED

EAST (4) - 247 LF = 4 TREES / 100 LF = 10 TREES REQUIRED/PROVIDED
= 40 SHRUBS / 100 LF = 100 SHRUBS REQUIRED/PROVIDED
= 247 LF MIN. 6' TALL FENCE REQUIRED

STREET YARDS:
MAIN ST - 595 LF = 1 TREE / 50 LF = 12 TREES REQUIRED/PROVIDED
WEST YOUNG ST - 242 LF = 1 TREE / 50 LF = 5 TREES REQUIRED/PROVIDED

VEHICULAR USE AREA COVERAGE: 1 TREE WITHIN 60' OF EACH PARKING SPACE

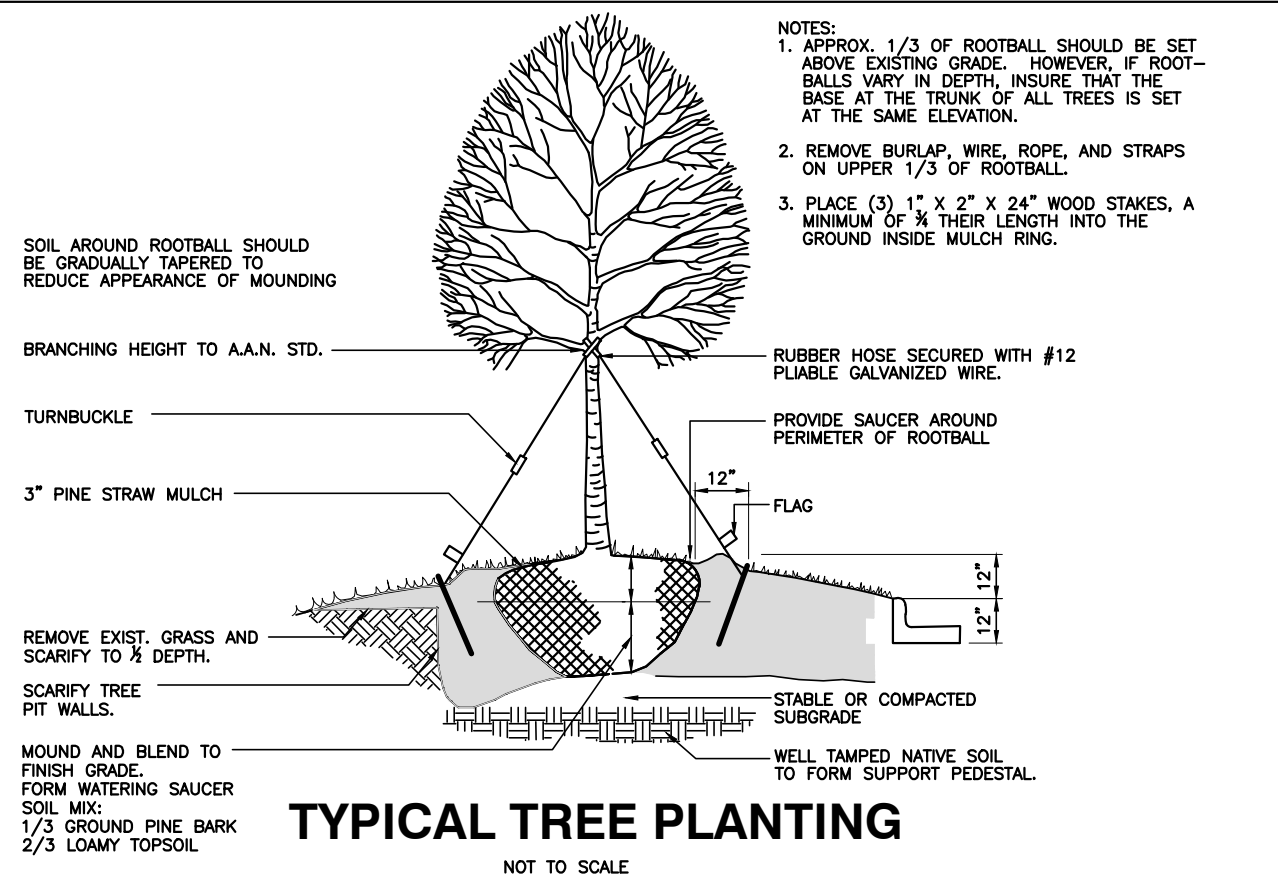


PLANTING NOTES:

LOCATE PLANTS AND PLANTING BEDS BY USING SCALED DIMENSIONS FROM STREET, PROPERTY LINES, BACK OF CURB, BUILDINGS, WALLS, ETC. ALL PLANTS SHALL MEET OR EXCEED THE MINIMUM STANDARDS SET BY THE U.S.D.A. FOR NURSERY STOCK. SPONSORED BY THE AMERICAN ASSOCIATION OF NURSERMEN, INC., WASHINGTON, D.C. NO SUBSTITUTIONS SHALL BE PERMITTED WITHOUT WRITTEN APPROVAL FROM THE OWNER AND/OR THE LANDSCAPE ARCHITECT. SYMBOLS: B&B = BALLED & BURLAPPED; B.R. = BARE ROOT; CONT. = CONTAINER, O.C. = ON-CENTER



STREET TREE PLANTINGS TO BE COORDINATED IN CONCURRENCE WITH NCDOT STREETSCAPE IMPROVEMENT PROJECT ALONG S. MAIN AND YOUNG STREET(S).

PLANT LIST

KEY	SCIENTIFIC NAME	COMMON NAME	QUAN.	CAL	HT	ROOT	USE
CANOPY TREES							
AF	<i>Acer freemanii</i>	Freeman Maple	32	2.5"	8'	B&B	Buffer/VUA
AR	<i>Acer rubrum</i> 'Brandywine'	Brandywine Red Maple	24	2.5"	8'	B&B	VUA
JV	<i>Juniperus virginiana</i>	Eastern Red Cedar	24	2.5"	8'	B&B	Buffer/VUA
QN	<i>Quercus nuttallii</i>	Nuttall Oak	19	2.5"	8'	B&B	Street Tree
UP	<i>Ulmus parvifolia</i> 'Allee'	Allee Elm	6	2.5"	8'	B&B	VUA
SHRUBS							
CJ	<i>Cleyera japonica</i>	Japanese Cleyera	98		24"	CONT.	Buffer
DG	<i>Distylium</i> 'Green Wave'	Green Wave Distylium	30		24"	CONT.	VUA
JV	<i>Ilex crenata</i> 'Sky Pencil'	Sky Pencil Holly	6		36"	CONT.	Dumpster
ICG	<i>Ilex crenata</i> 'Chesapeake'	Chesapeake Holly	10		24"	CONT.	VUA Screen
ICG	<i>Ilex crenata</i> 'Green Lustre'	Green Lustre Japanese Holl	119		24"	CONT.	Buffer
JC	<i>Juniperus chinensis</i> 'Sawbrook Gold'	Sawbrook Gold Juniper	44		24"	CONT.	VUA Screen
LC	<i>Loropetalum chinense</i> 'Daruma'	Daruma Loropetalum	36		24"	CONT.	VUA Screen
LJ	<i>Ligustrum japonicum</i>	Wax Ligustrum	98		24"	CONT.	Buffer
OF	<i>Osmanthus fragrans</i>	Fragrant Tea Olive	51		24"	CONT.	Buffer/Screen
VML	<i>Viburnum</i> x 'Moonlit Lace'	Moonlit Lace Viburnum	158		24"	CONT.	Buffer

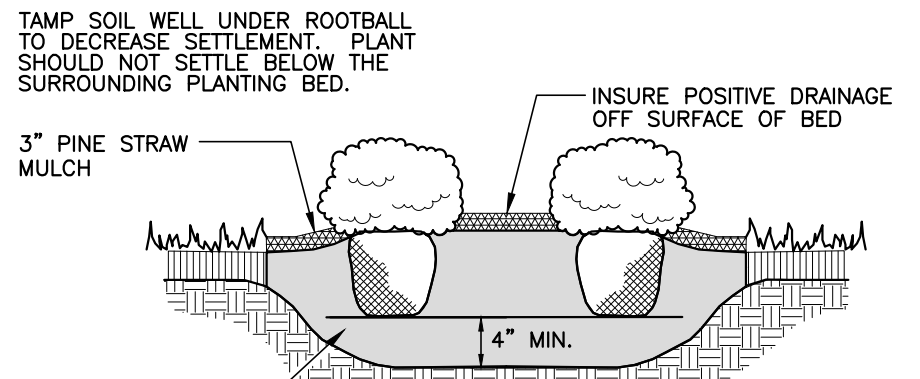

PLANT SYMBOLS

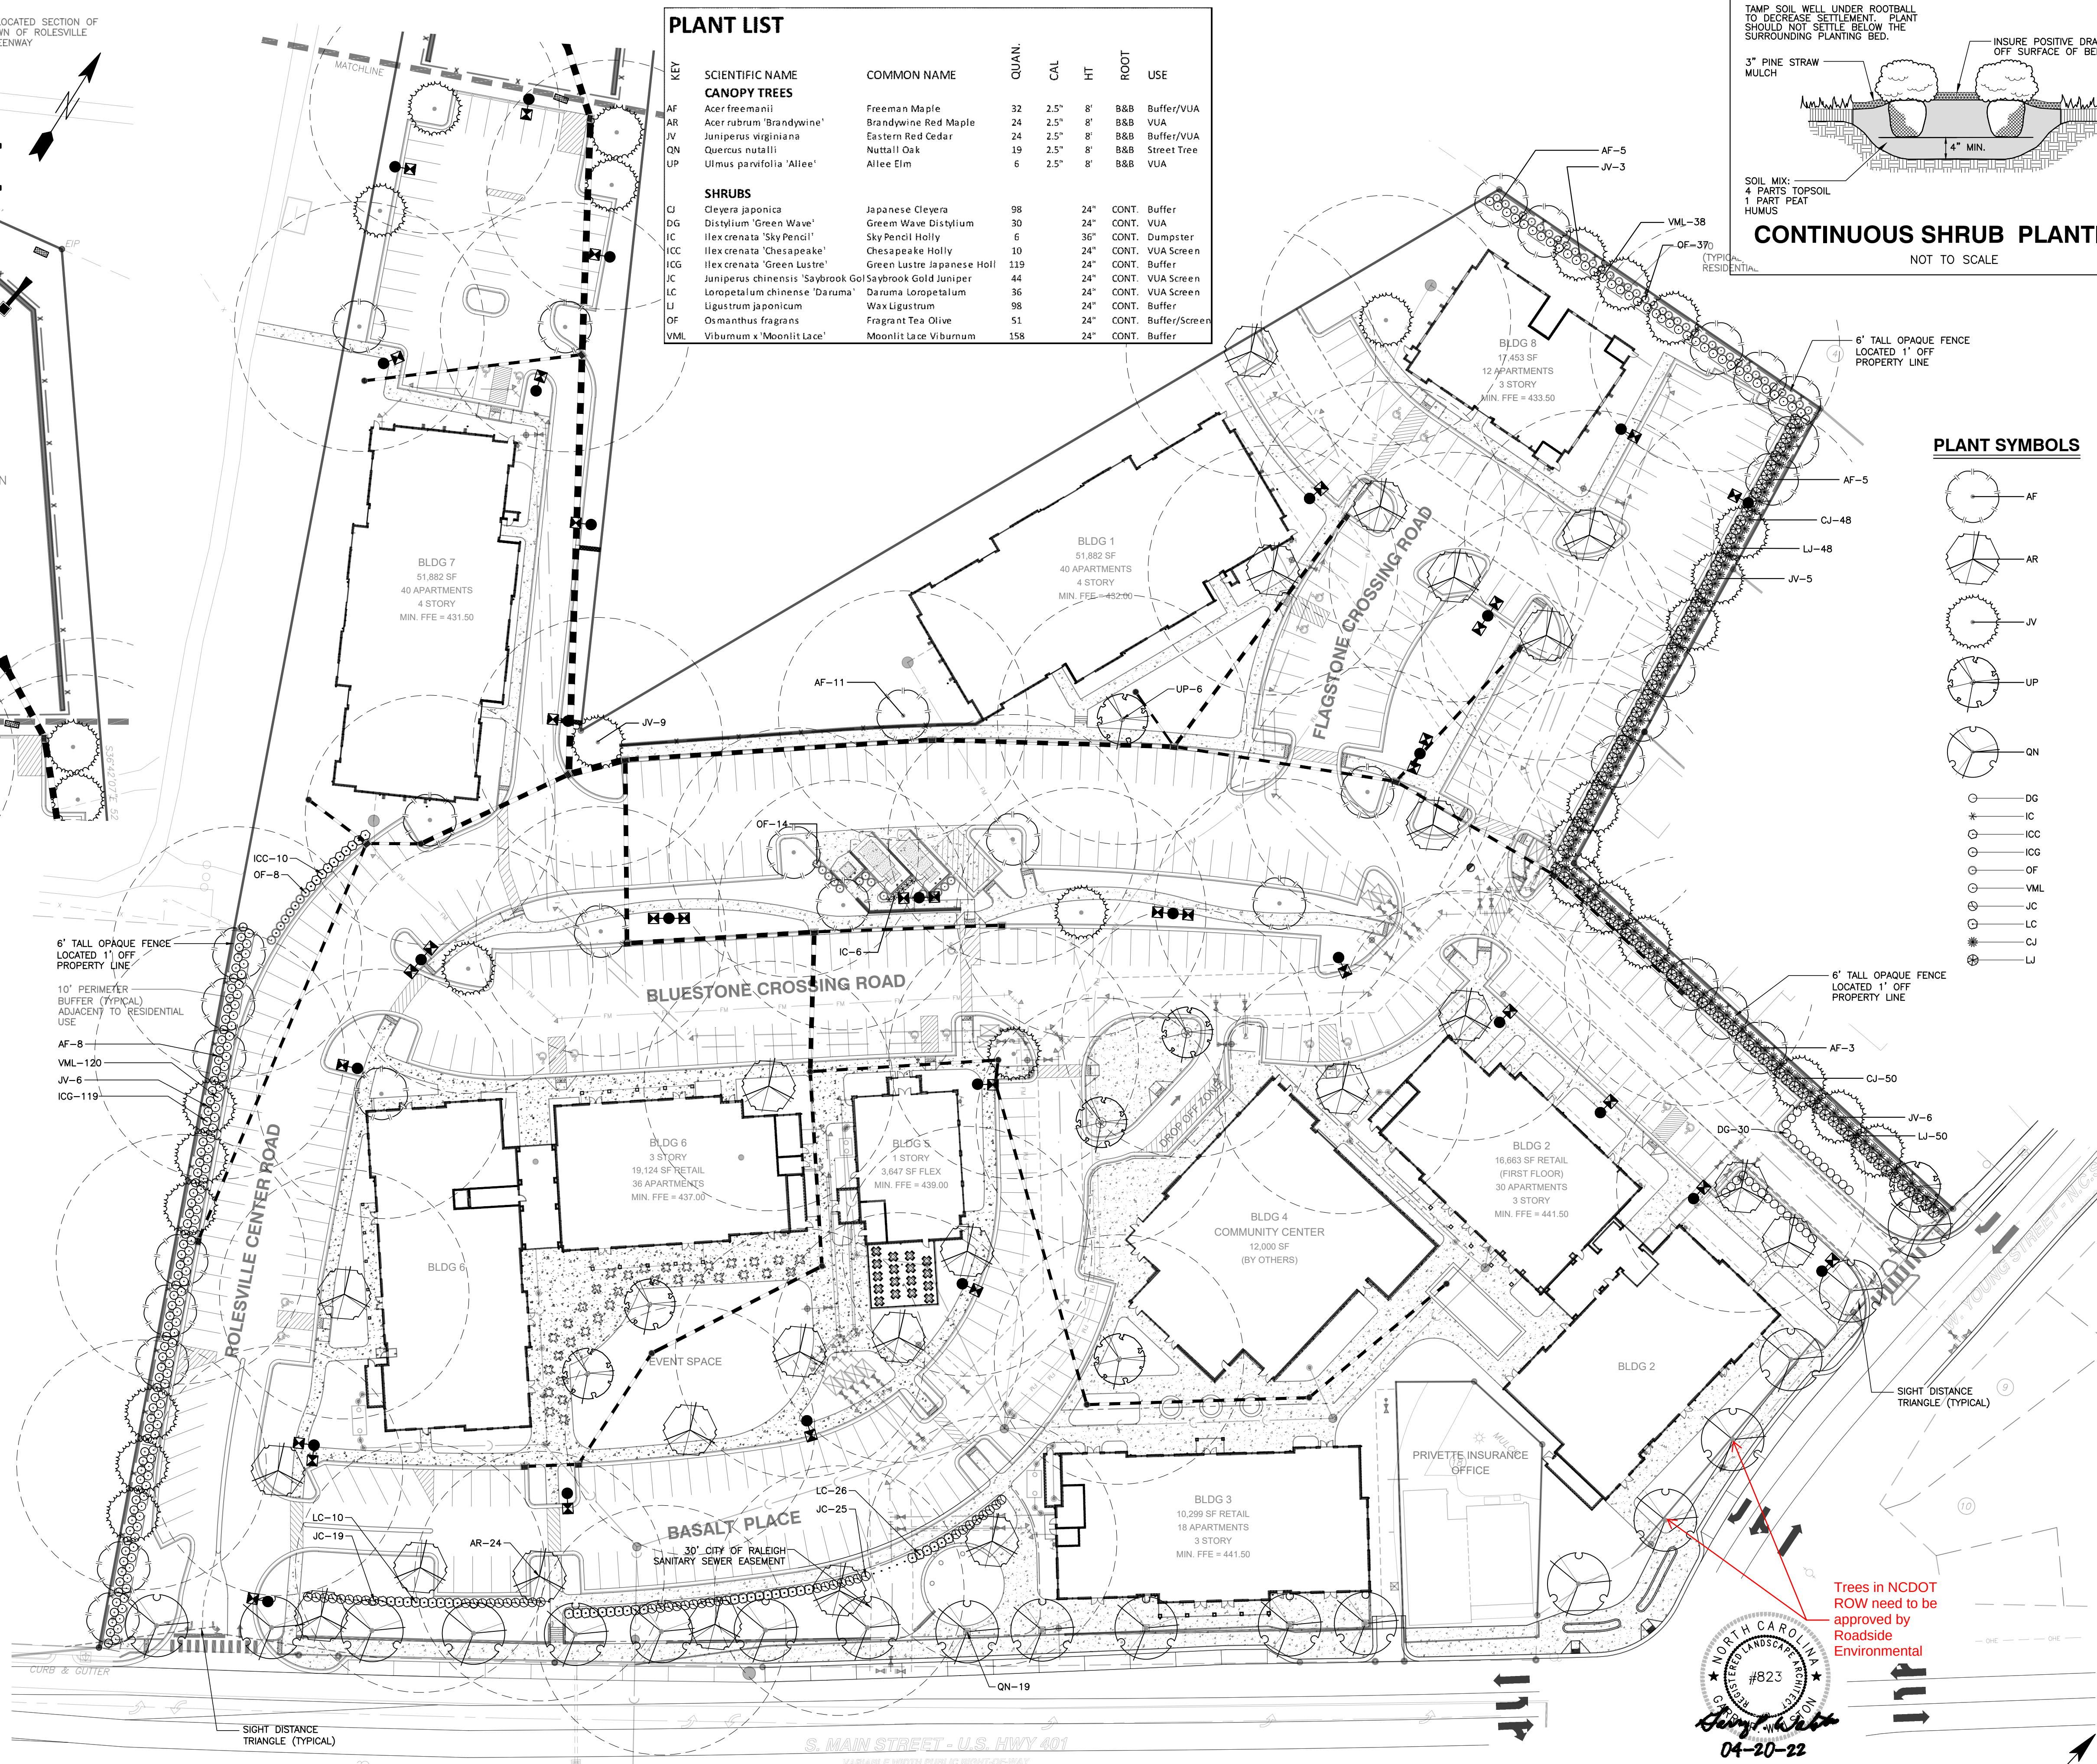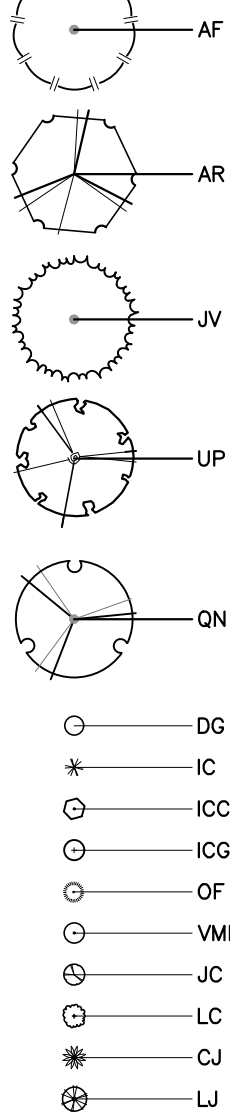

CITY OF RALEIGH - PLANS AUTHORIZED FOR CONSTRUCTION


Electronic Approval: This approval is being issued electronically. This approval is valid only upon the signature of a City of Raleigh Review Officer below. The City will retain a copy of the approved plans. Any work authorized by this approval must proceed in accordance with the plans kept on file with the City. This electronic approval may not be edited once issued. Any modification to this approval once issued will invalidate this approval.

City of Raleigh Development Approval _____

Raleigh Water Review Officer _____

NO FLOODPLAINS EXIST ON-SITE

NOTE: ALL CONSTRUCTION ACTIVITY MUST BE IN ACCORDANCE WITH THE ACCEPTED POLICIES OF THE TOWN OF ROLESVILLE AND NCDOT

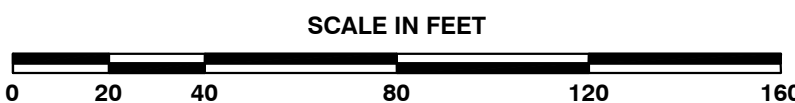

BASS, NIXON & KENNEDY, INC.

CONSULTING ENGINEERS

6310 CHAPEL HILL ROAD, SUITE 250, RALEIGH, NC 27607

TELEPHONE: (919) 881-4444 FAX: (919) 881-6888

CERTIFICATION NUMBERS: NCBELS (C-0110); NCBOLA (C-0267)

PROGRESS

DATE

DRAWN BY

03-19-17

JOB NO.

LANDSCAPE PLAN

2

PER TOR COMMENTS

PER TOR COMMENTS

04-20-22

5-28-21

DATE

NO.

DESCRIPTION

REVISIONS

CHK BY: GPW

SCALE: 1" = 40'

COBBLESTONE VILLAGE

MIXED USE DEVELOPMENT


TOWN OF ROLESVILLE, WAKE COUNTY, NORTH CAROLINA

SHEET

L1.1

TOWN OF ROLESVILLE PROJECT NO.

Outdoor Lighting
Shoebox LED

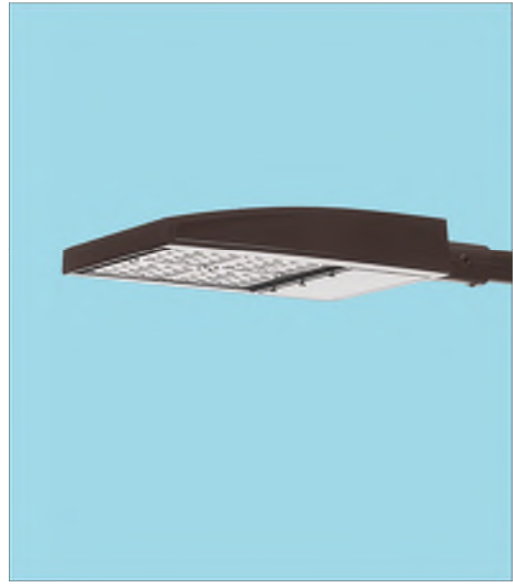

The energy-efficient Shoebox LED combines a decorative, contemporary style with versatility and ample lighting effect that is perfect for streets, parking lots, commercial buildings and residential communities. The Shoebox LED provides excellent color rendition along with a controlled light pattern that reduces glare and keeps the light directed only where you want it. Available in black, dark bronze, gray or white with one to four fixtures per pole.

LED	(150, 220, 420, 530 watts
(Light Emitting Diode)	
Mounting heights	(25', 30', 35'
Colors	(Black Bronze Gray White
Poles	(Fiberglass (1 or 2 fixtures per pole) Decorative tapered metal Decorative square metal

Note: 35' pole available in black or bronze only.

For additional information, visit us at
duke-energy.com/OutdoorLighting
or call us toll free at 866.769.6417.



Outdoor Lighting
Shoebox LED

Light source: LED (white)
Replacement for* LED Wattage 150 – 250-watt HPS and metal halide;
LED Wattage 205 – up to 400-watt metal halide;
LED Wattage 530 – 1,000-watt metal halide

Warm-up and restrike time: Instant on (no warm-up or restrike time)

Wattage	BUG Rating	Light Pattern	Lumens	Color Temp
LED 150	B5-UO-G3	IESNA Type V (circular)	19580	4,000K
LED 150	B3-UO-G4	IESNA Type IV (forward throw)	18459	
LED 150	B2-UO-G3	IESNA Type III (oval)	19006	
LED 220	B5-UO-G3	IESNA Type V (circular)	25870	
LED 220	B3-UO-G4	IESNA Type IV (forward throw)	24390	
LED 220	B2-UO-G4	IESNA Type III (oval)	25114	
LED 420	B5-UO-G5	IESNA Type V (circular)	48514	
LED 420	B3-UO-G5	IESNA Type IV (forward throw)	43765	
LED 530	B5-UO-G5	IESNA Type V (circular)	60296	
LED 530	B3-UO-G5	IESNA Type IV (forward throw)	54395	




* These are approximate replacement suggestions; actual conditions could be different.

Poles available:	Mounting height	Color
Name		
Round tapered decorative metal*	35'	Black Bronze
Decorative square metal*	(25' and 30'	Black Bronze Gray White
Fiberglass	30'	(Black (1 or 2 fixtures per pole) Gray (1 or 2 fixtures per pole)

Features	Benefits
Little or no installation cost	Frees up capital for other projects
Design services by lighting professionals included	Meets industry standards and lighting ordinances
Maintenance included	Eliminates high and unexpected repair bills
Electricity included	Less expensive than metered service
Warranty included	Worry-free
One low monthly cost on your electric bill	Convenience and savings for you
Turnkey operation	Provides hassle-free installation and service
Backed by over 40 years of experience	A name you can trust today ... and tomorrow

*2" raised foundation available when required on metal poles only.

©2019 Duke Energy Corporation 150519 12/19

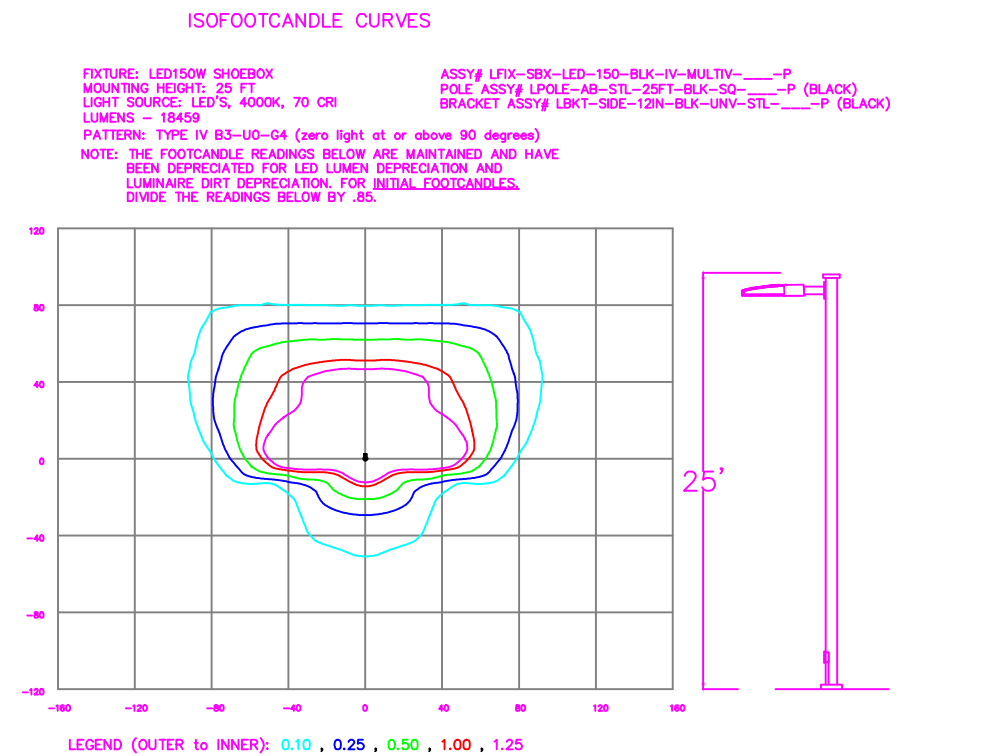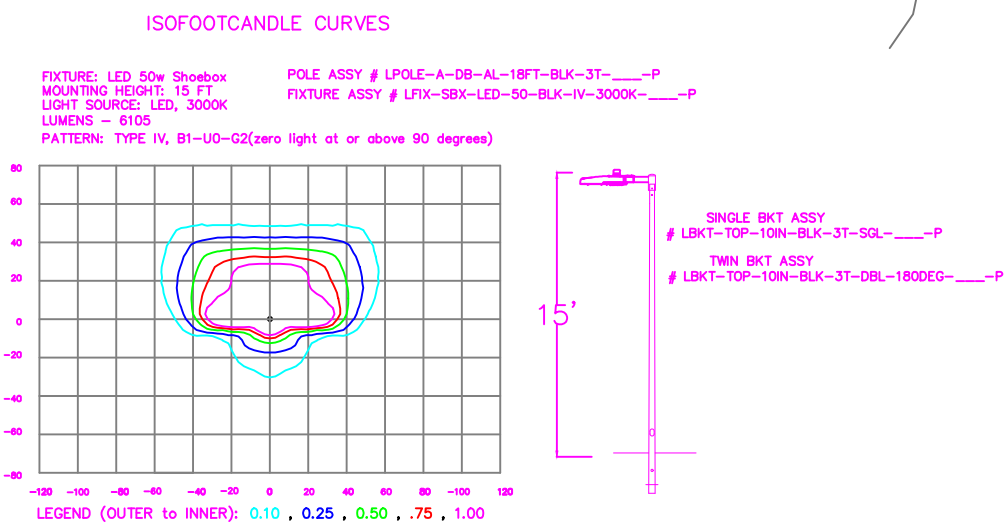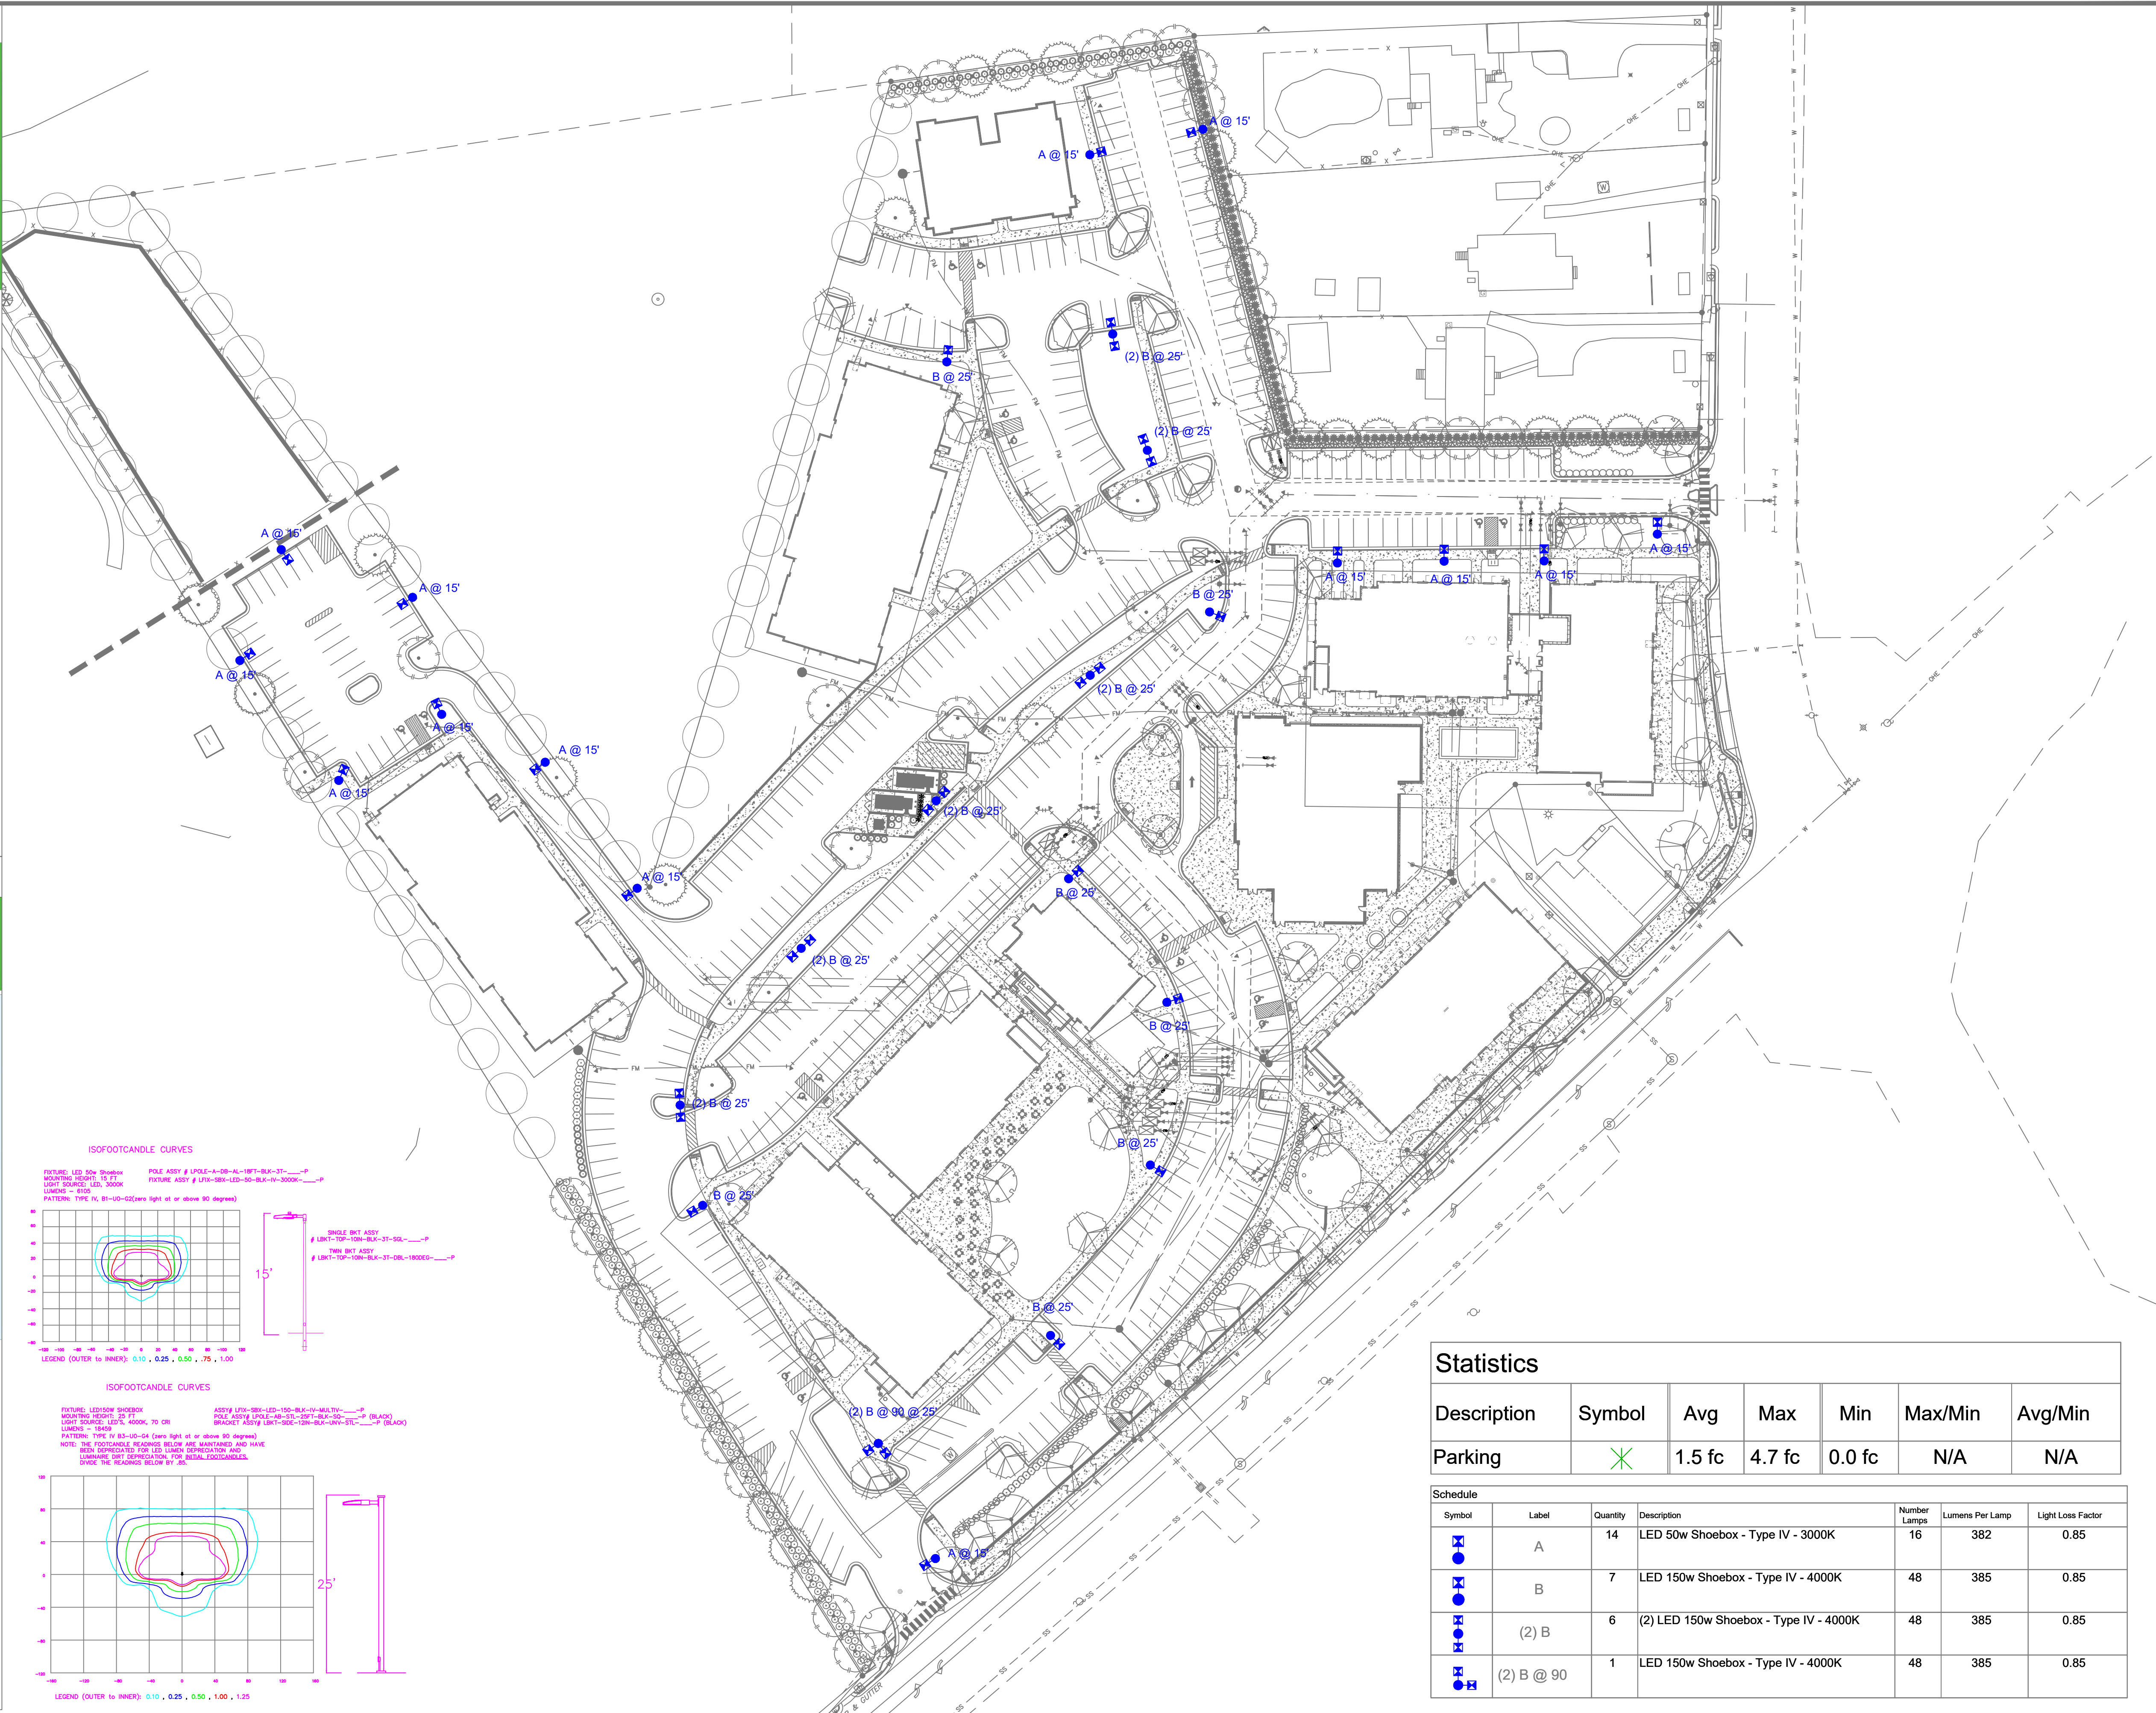

Statistics

Description	Symbol	Avg	Max	Min	Max/Min	Avg/Min
Parking	X	1.5 fc	4.7 fc	0.0 fc	N/A	N/A

Schedule						
Symbol	Label	Quantity	Description	Number Lamps	Lumens Per Lamp	Light Loss Factor
A	A	14	LED 50w Shoebox - Type IV - 3000K	16	382	0.85
B	B	7	LED 150w Shoebox - Type IV - 4000K	48	385	0.85
(2) B	(2) B	6	(2) LED 150w Shoebox - Type IV - 4000K	48	385	0.85
(2) B @ 90	(2) B @ 90	1	LED 150w Shoebox - Type IV - 4000K	48	385	0.85

LIGHTING DESIGN TOLERANCE

The calculated footcandle light levels in this lighting design are predicted values and are based on specific information that has been supplied to Duke Energy. Any inaccuracies in the supplied information, differences in luminaire installation, lighted area geometry including elevation differences, reflective properties of surrounding surfaces, obstructions (foliage or otherwise) in the lighted area, or lighting from sources other than listed in this design may produce different results from the predicted values. Normal tolerances of voltage, lamp output, and ballast and luminaire manufacture will also affect results.




PROPRIETARY & CONFIDENTIAL











This document together with the concepts and designs presented herein, presented as an instrument of service, is the sole property of Duke Energy, and is intended only for the specific purpose and prospective client as stated in the title block of this drawing. Any use, copying, reproduction or disclosure of the drawing, design or any information contained herein by the prospective customer or other entities, including without limitation, architects, engineers, or equipment manufacturers is hereby expressly prohibited and shall not be permitted absent prior written consent from, and payment of compensation to Duke Energy. Duke Energy disclaims any liability or responsibility for any unauthorized use of or reliance on this document.

COBBLESTONE VILLAGE

Rolesville, NC
SITE LIGHTING PLAN
Designed by DEP LIGHTING SOLUTIONS
Reviewed by T. Ferguson Scale 1" = 50'
Date 02/14/2022 Size "Arch D"
Description LED Shoebox
Drawing No. 22-0047A Sht. 1 OF 1

Rev A	02/14/22	LED Shoebox	NJ
REV#	DATE	REVISION	BY

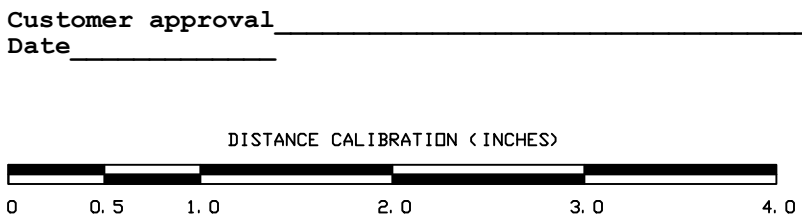

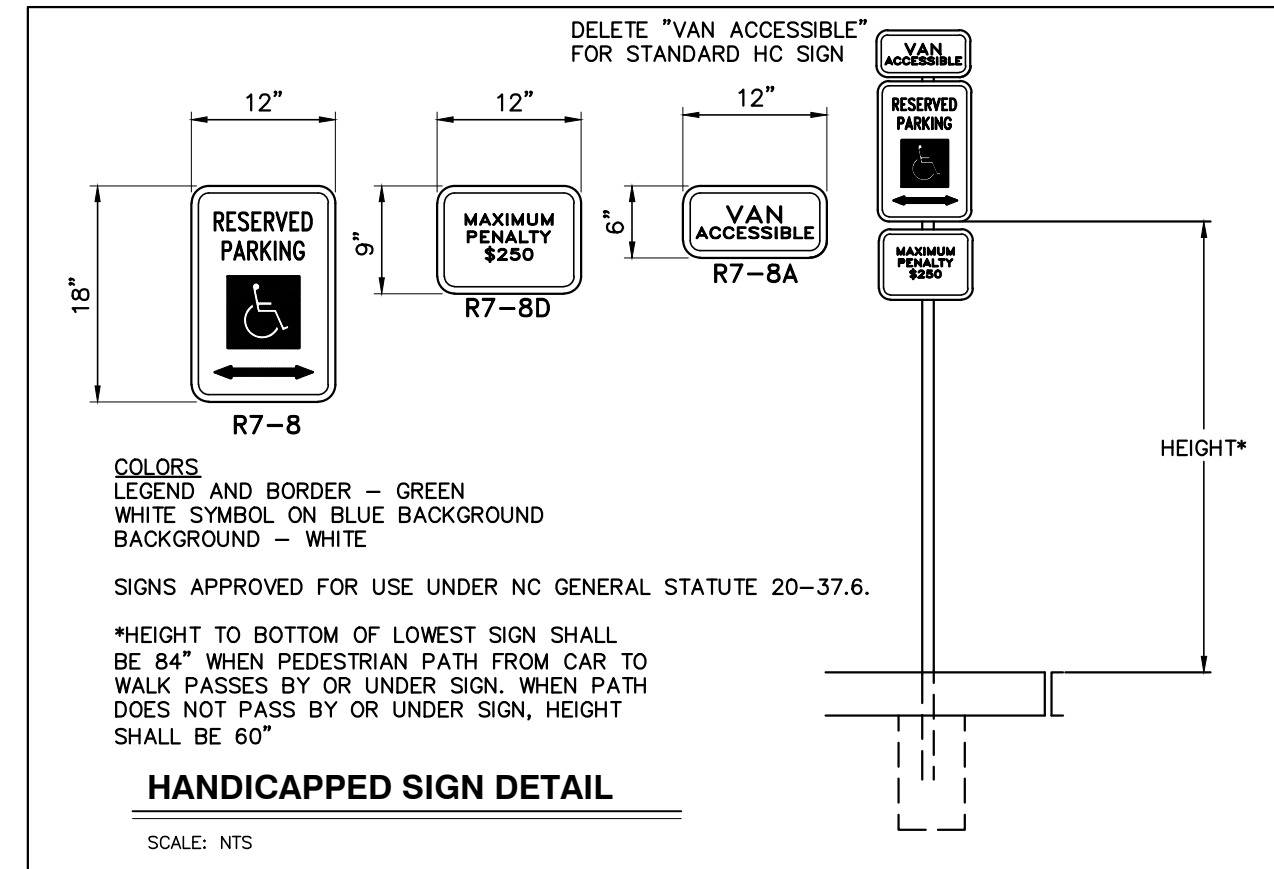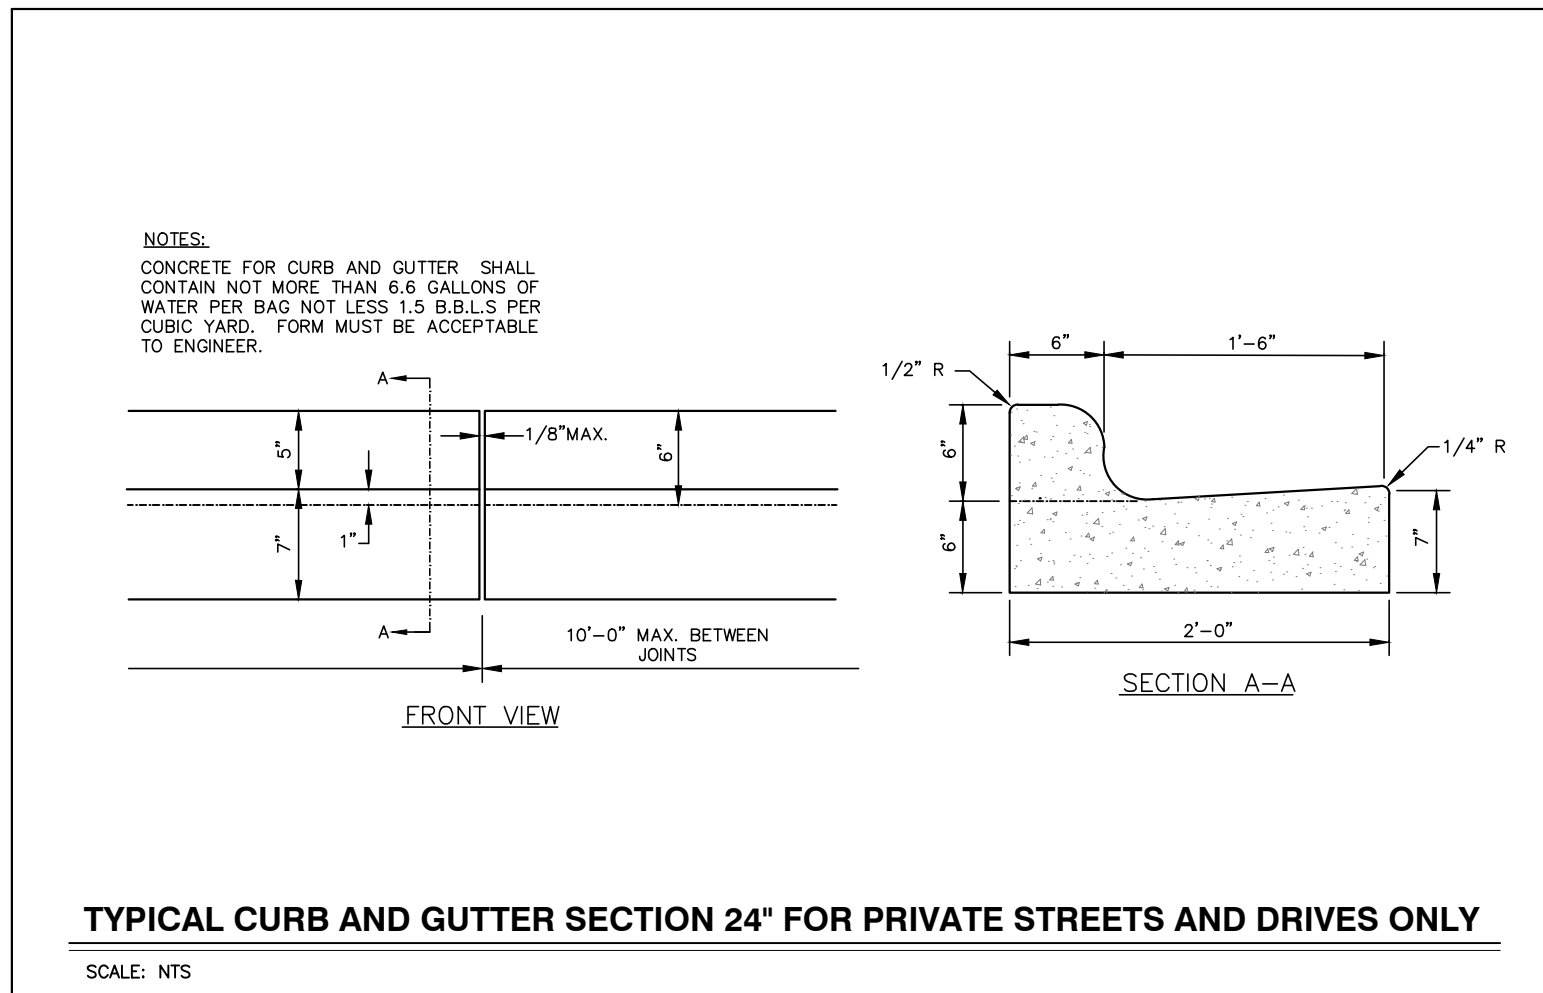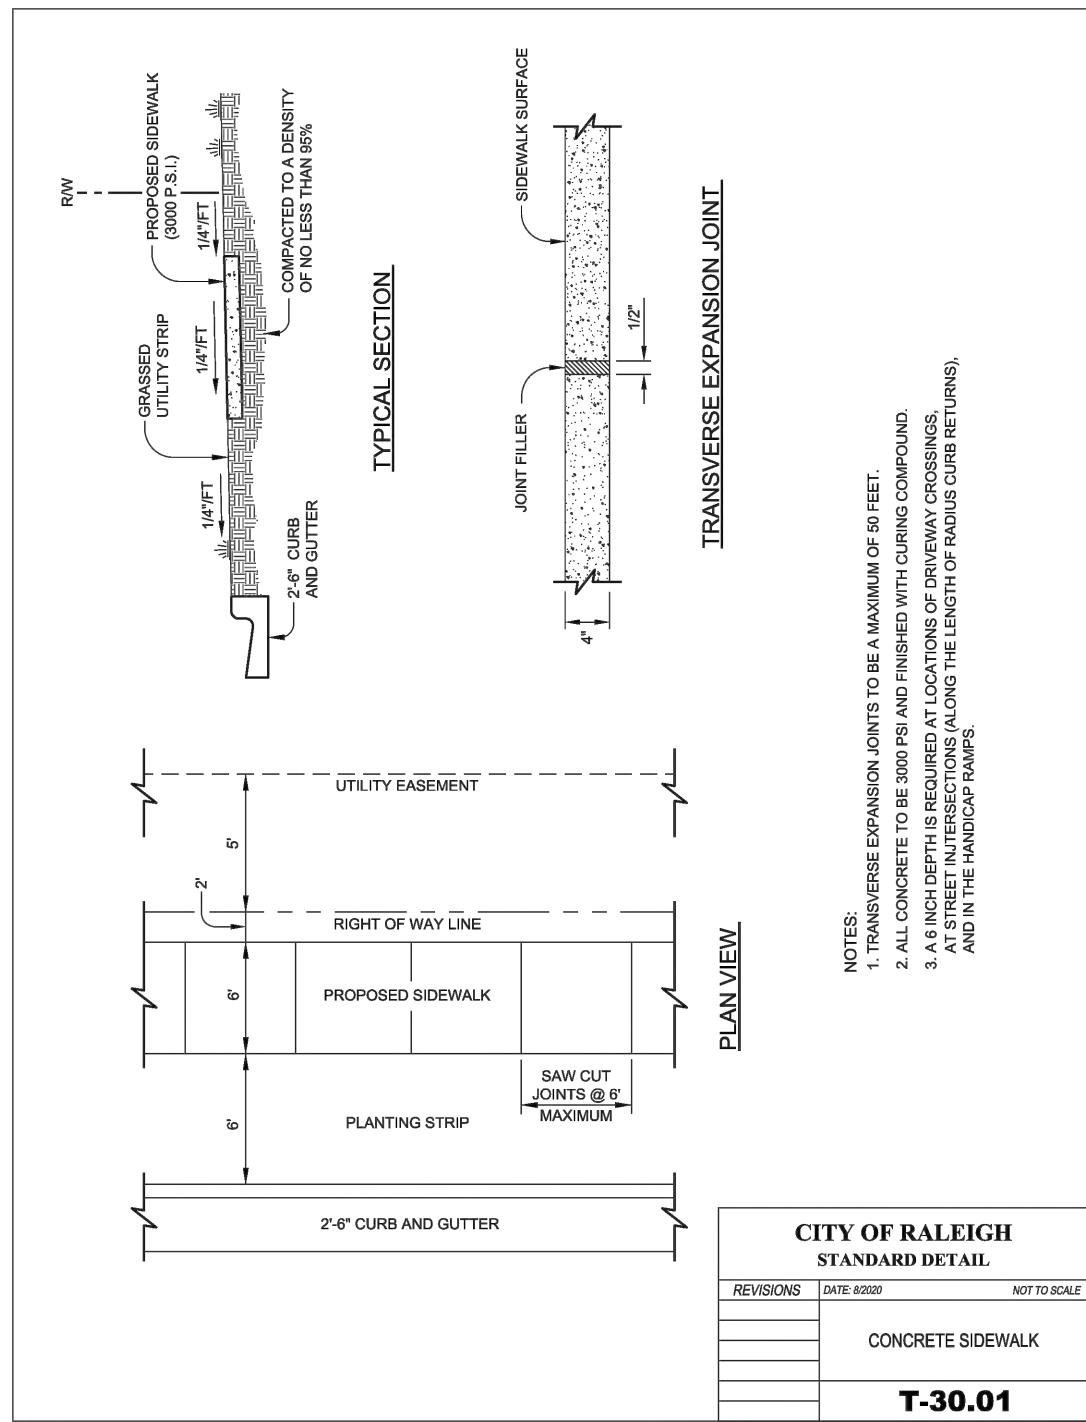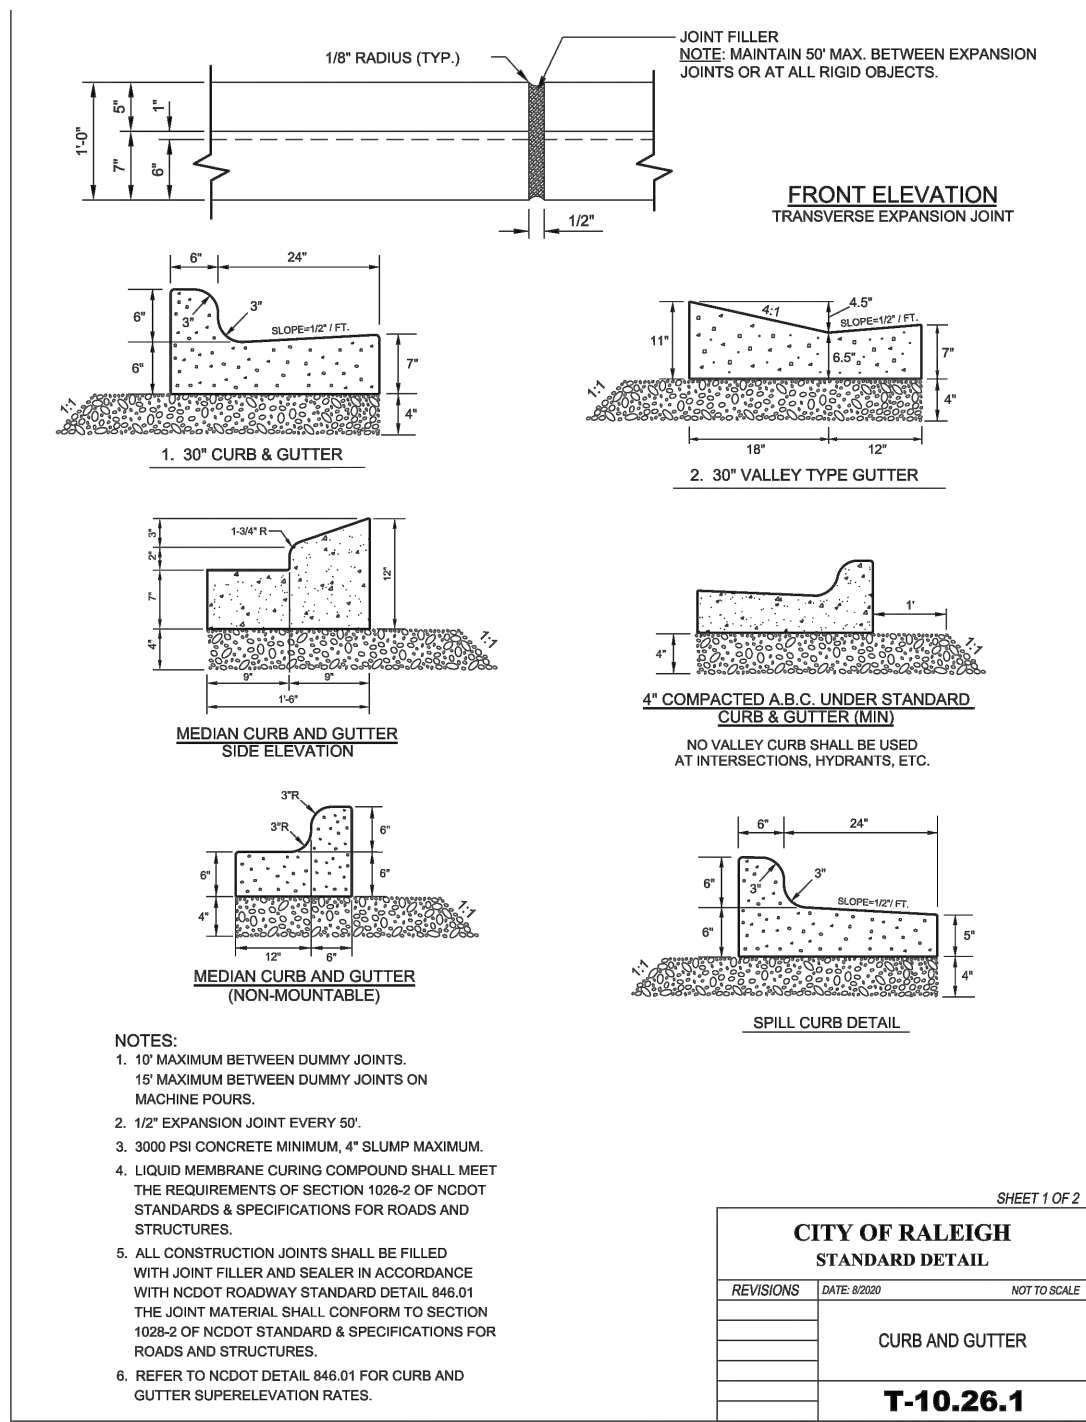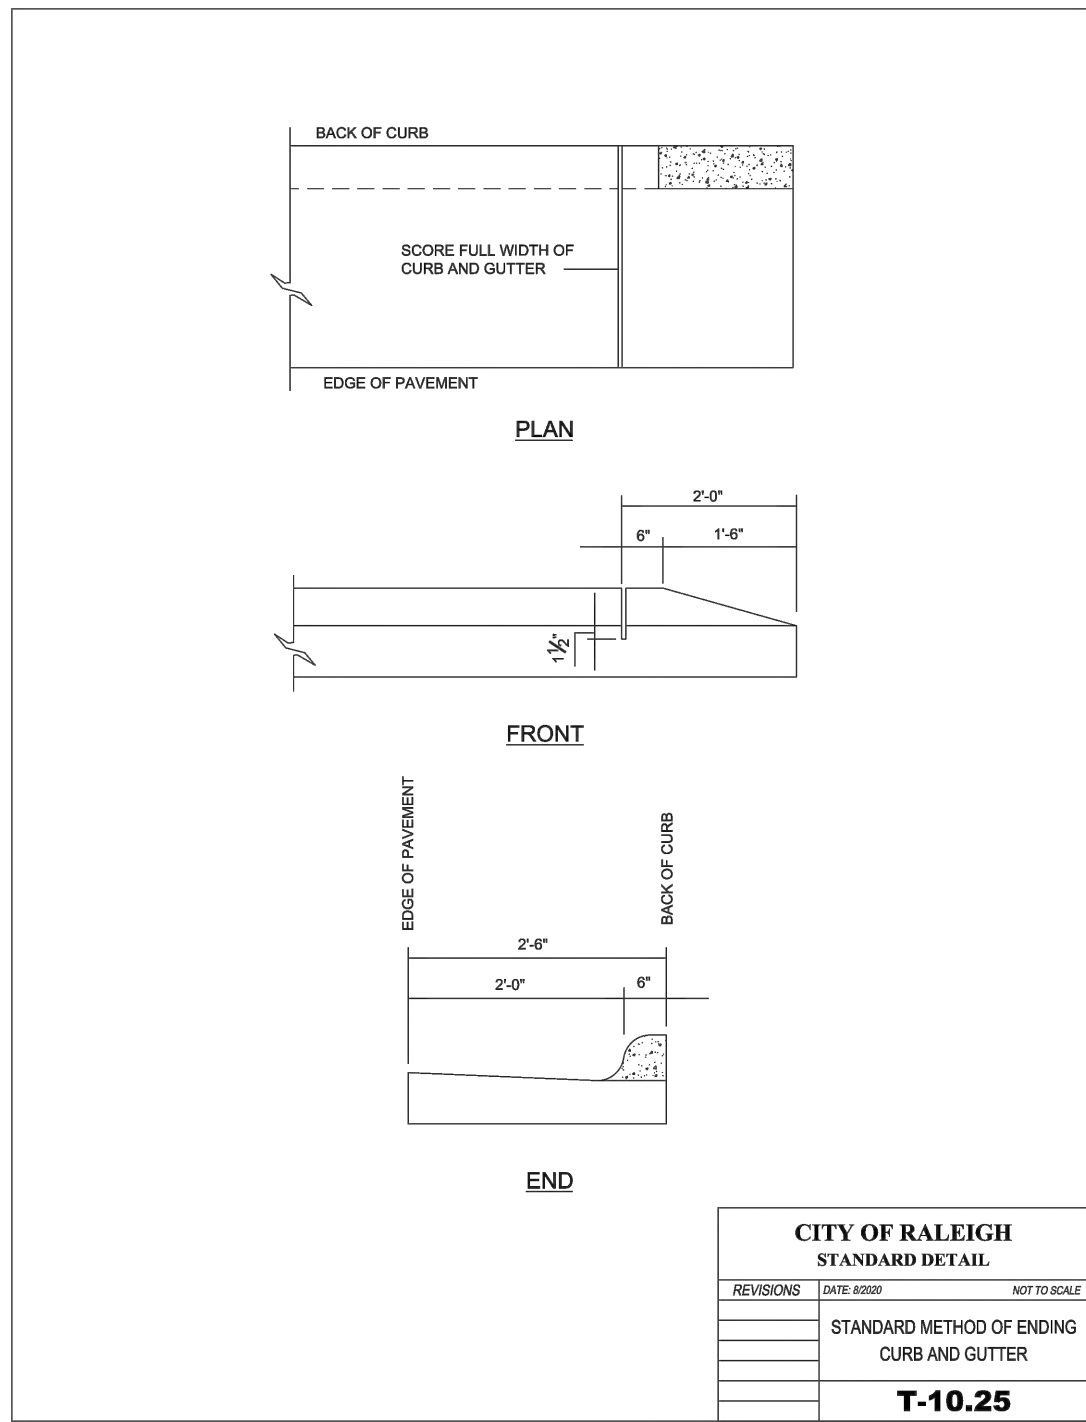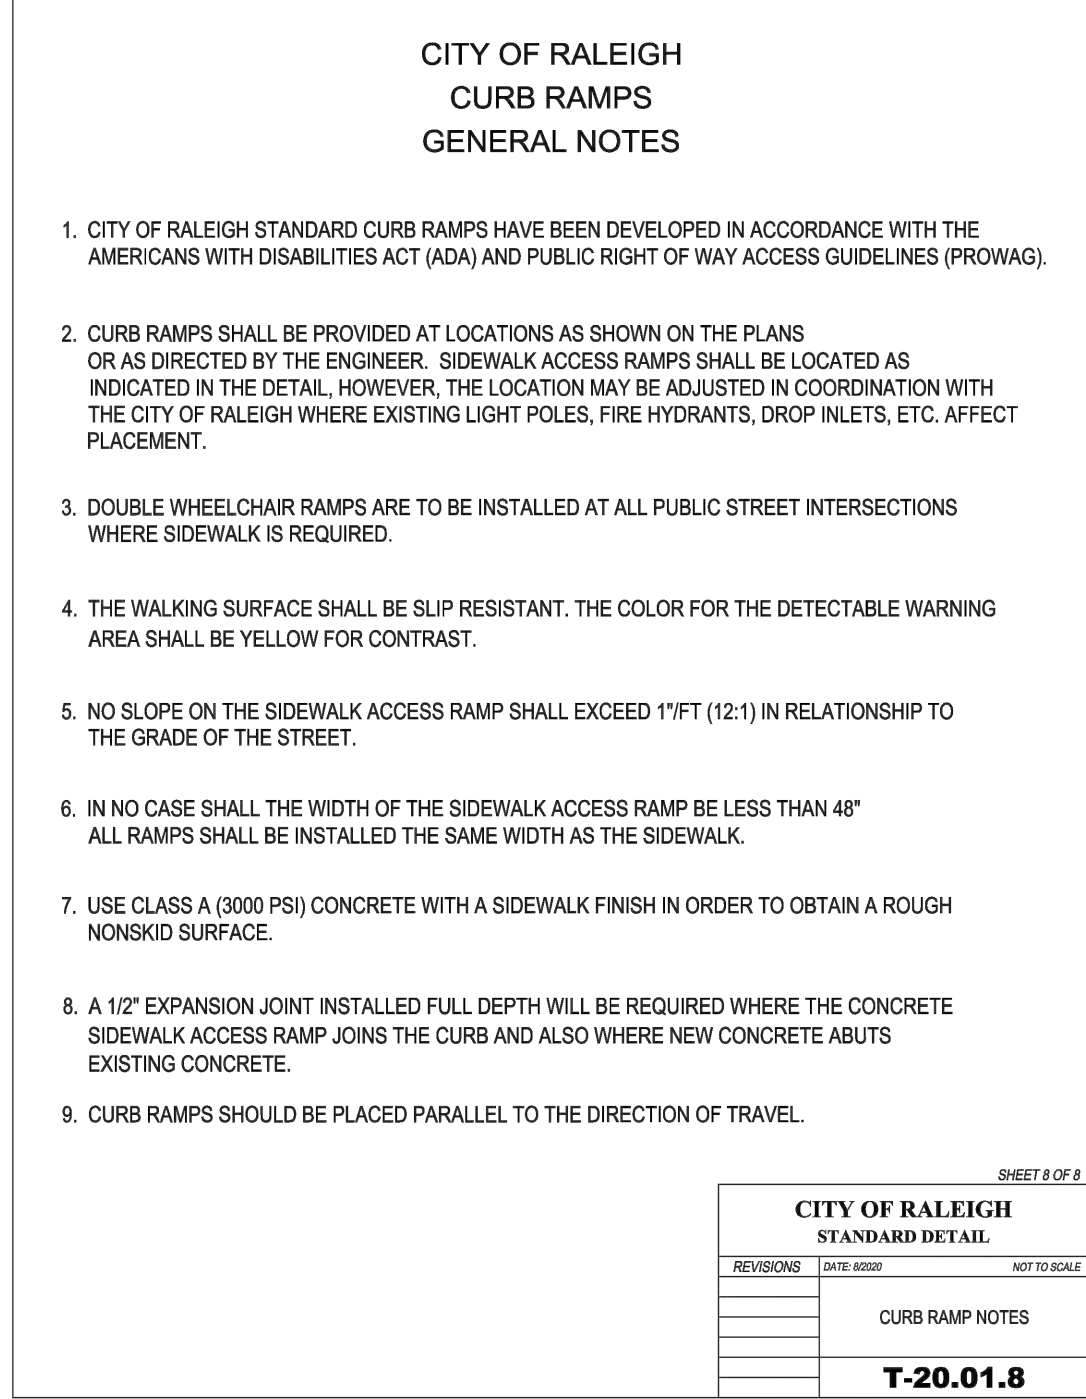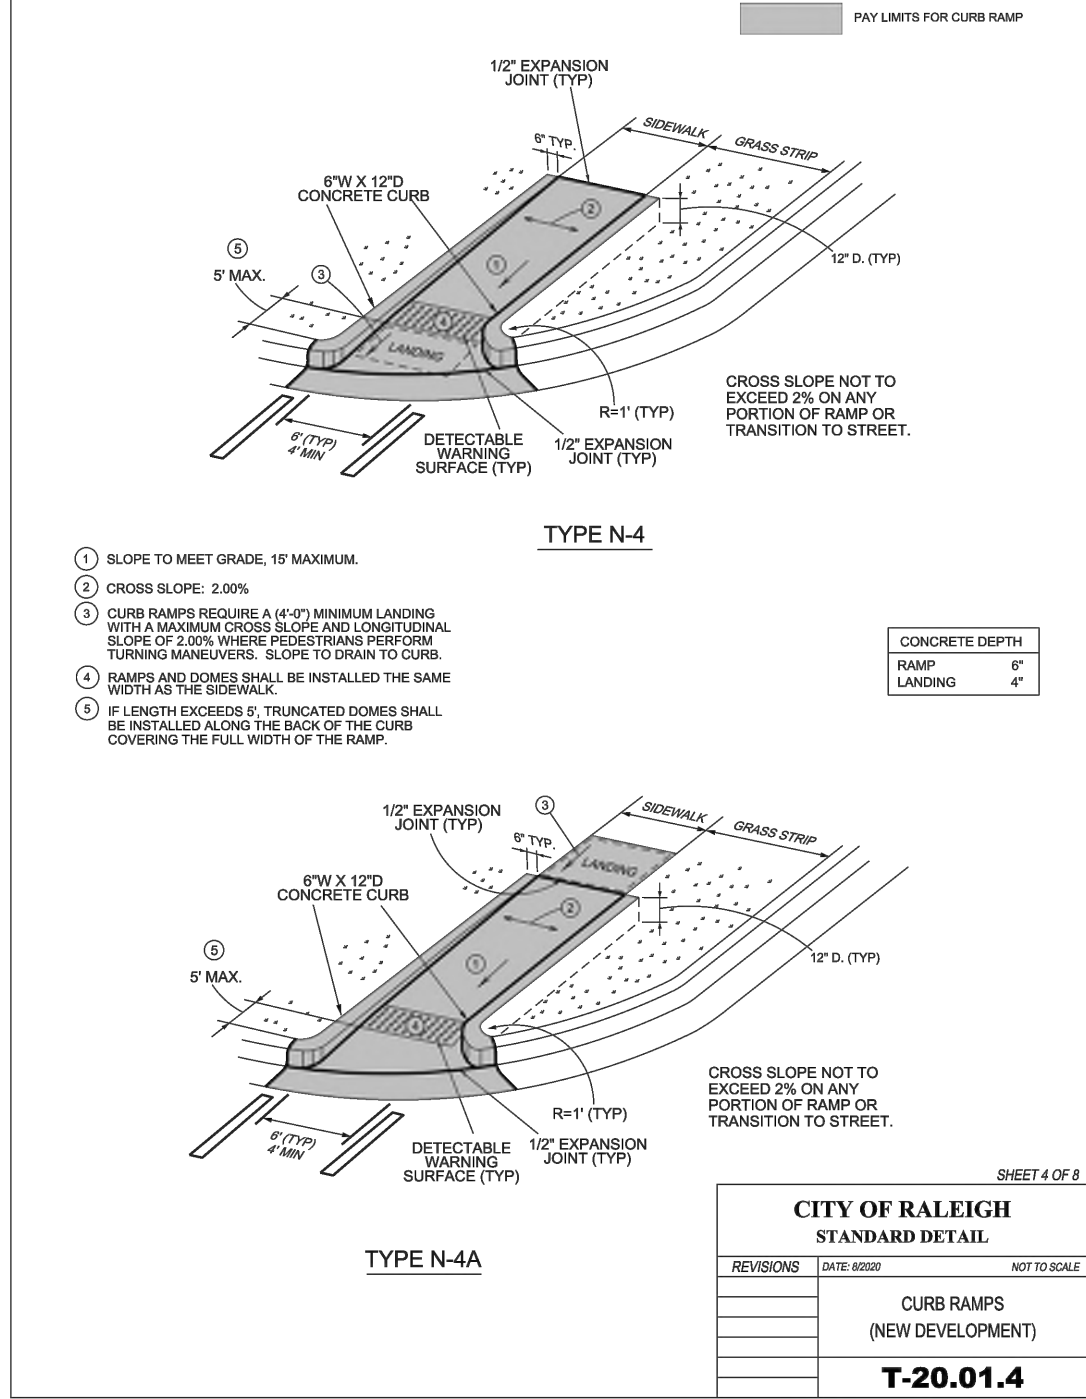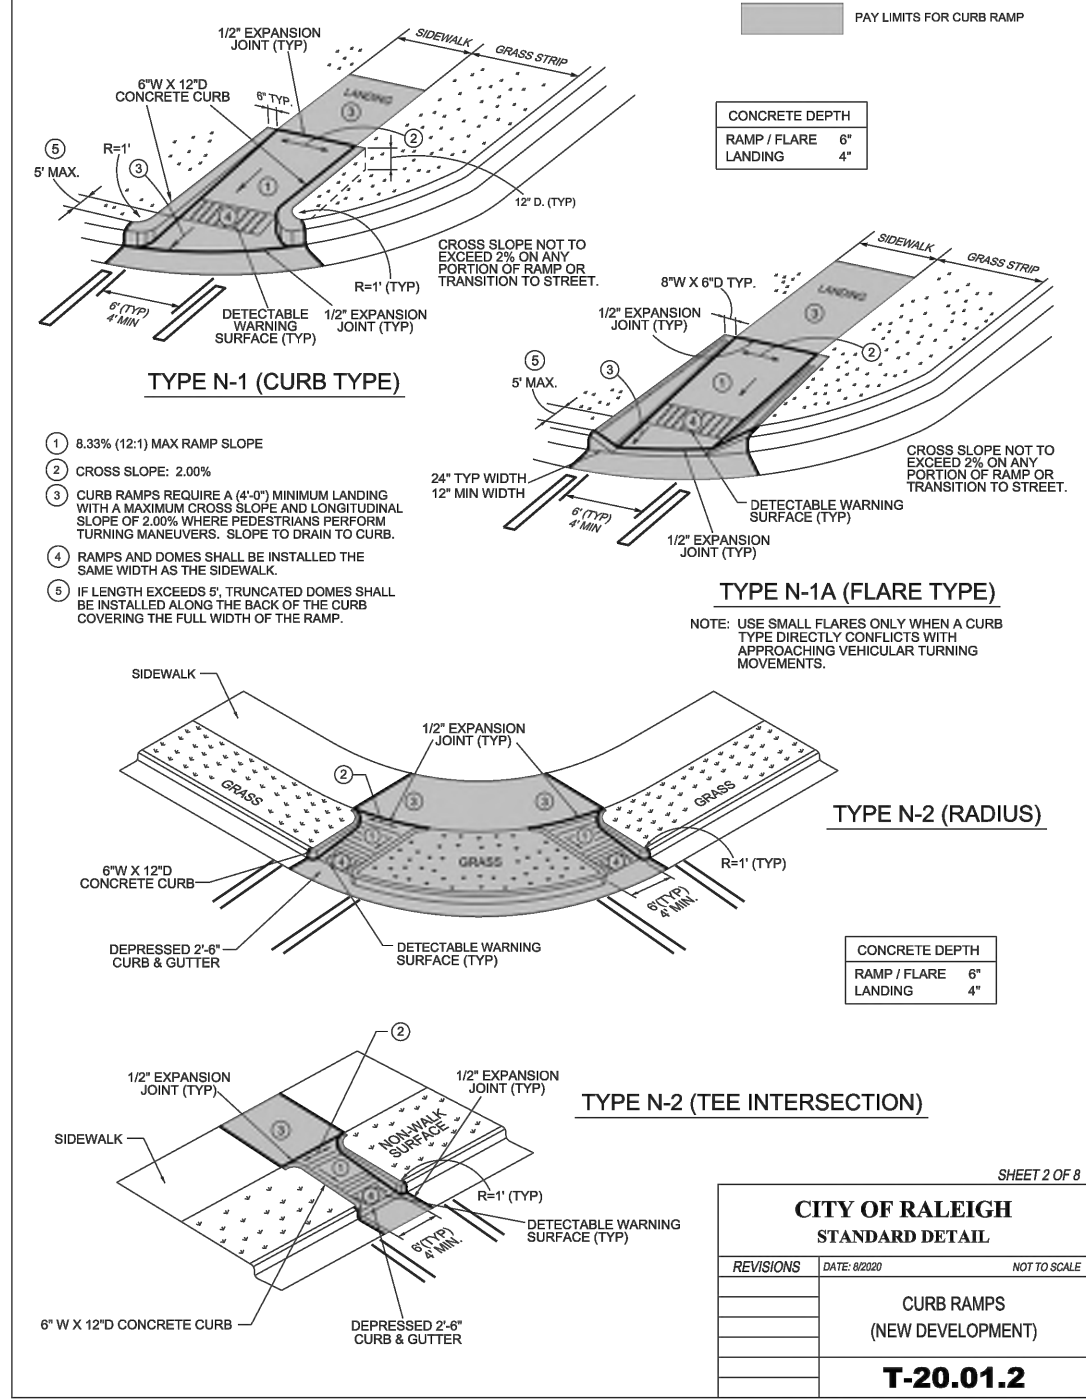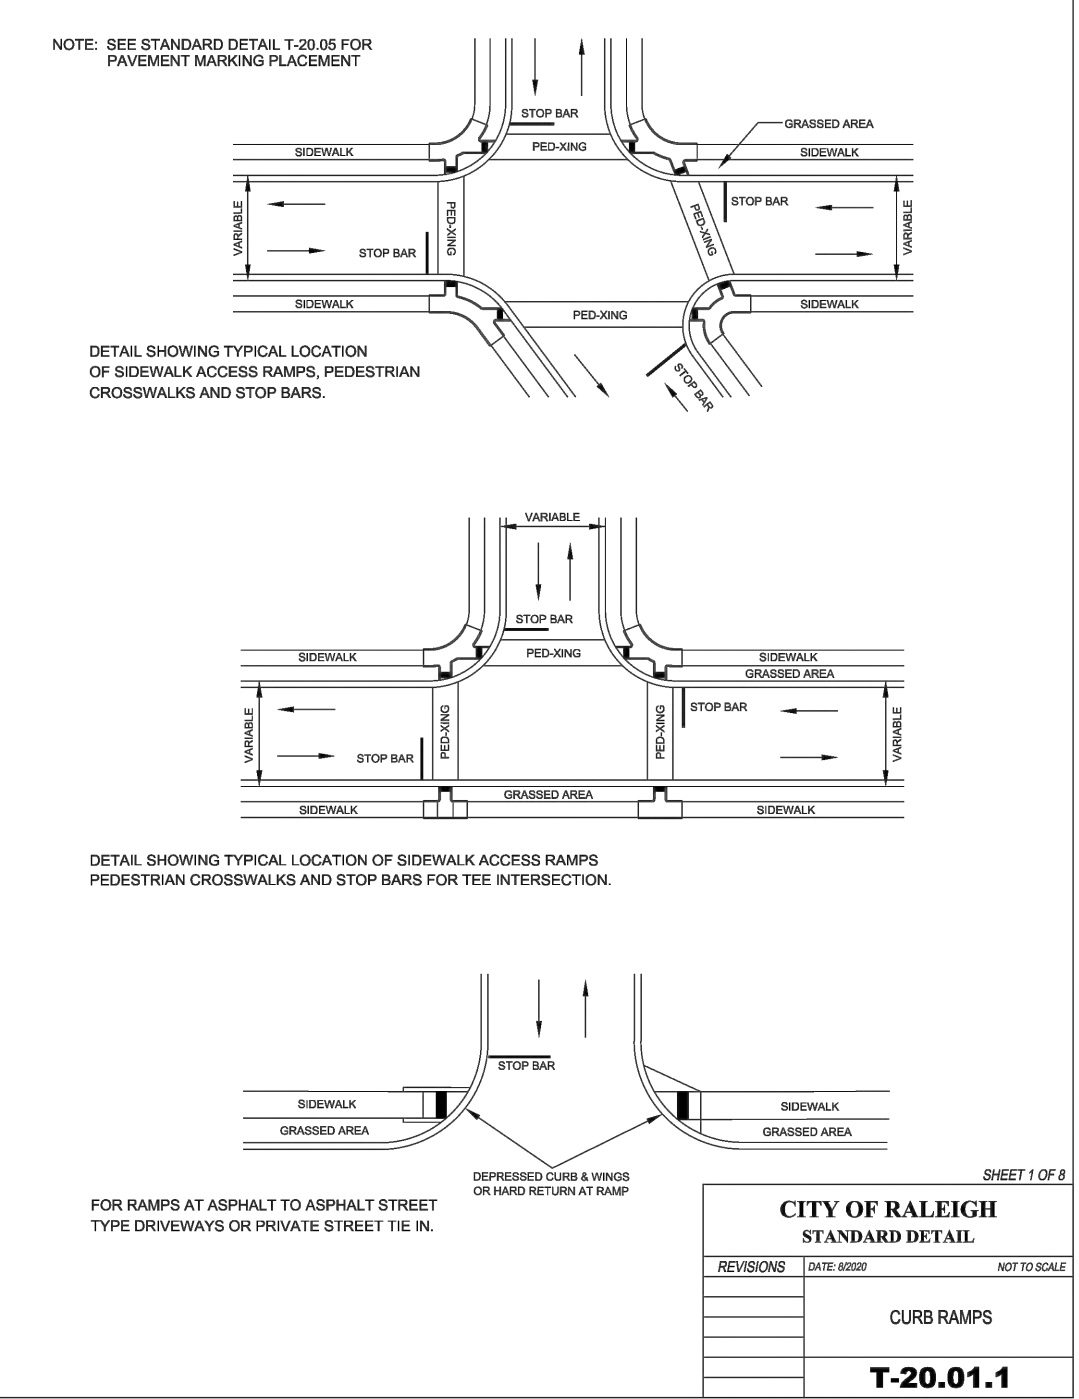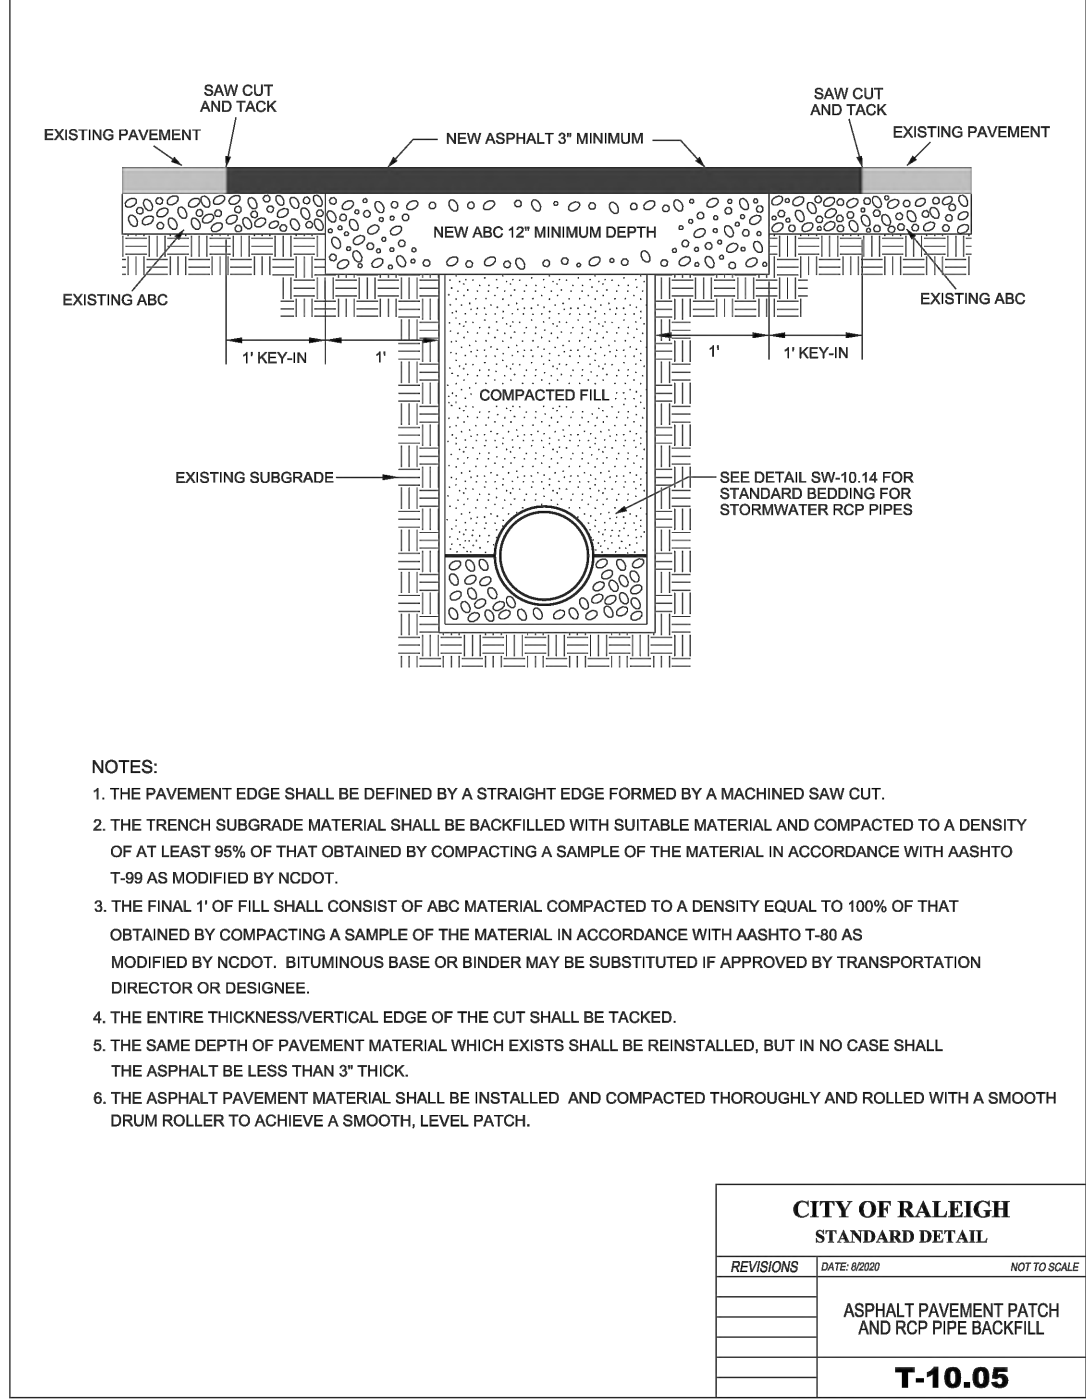

CITY OF RALEIGH - PLANS AUTHORIZED FOR CONSTRUCTION

Electronic Approval: This approval is being issued electronically. This approval is valid only upon the signature of a City of Raleigh Review Officer below. The City will retain a copy of the approved plans. Any work authorized by this approval must proceed in accordance with the plans kept on file with the City. This electronic approval may not be edited once issued. Any modification to this approval once issued will invalidate this approval.

City of Raleigh Development Approval _____

Raleigh Water Review Officer _____



04/20/22

03-19157

PROGRESS

MM

DATE

DRAWN BY

DATE

03-19157

JOB NO.

DATE

DATE

REVISIONS

DATE

DETAILS

NO.

DATE

DESCRIPTION

BY

SCALE: N.T.S.

CHK BY: MDB

COBBLESTONE

VILLAGE

MIXED USE DEVELOPMENT

TOWN OF ROLESVILLE, WAKE COUNTY, NORTH CAROLINA

SHEET

C5.1

BASS, NIXON & KENNEDY, INC.

CONSULTING ENGINEERS






6310 CHASE HILL ROAD, SUITE 250, RALEIGH, NC 27607

TELEPHONE: (919) 881-1122 FAX: (919) 881-8888


CERTIFICATION NUMBERS: NCBELS (C-0110); NCBELA (C-0267)

R:\2019\19157 - Rolesville Town Center CIVIL\04 Construction\07 - 19157_Details.dwg, C5.1, 4/20/2022 3:40:48 PM, marc.mueller

TOWN OF ROLESVILLE PROJECT NO.

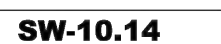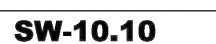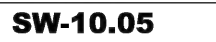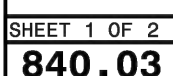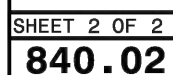

PIPE SIZE (in)	CLEARANCE DISTANCE (ft)
15	2.4
18	2.7
24	3.3
30	3.6
36	4.4
42	4.9
48	5.4
54	6.0
60	6.5
66	7.0
72	7.6

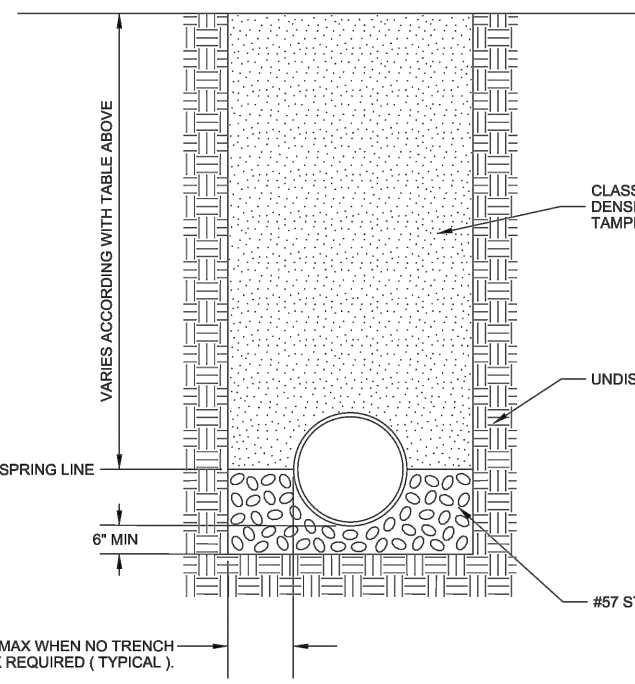

CITY OF RALEIGH		
STANDARD DETAIL		
REVISIONS	DATE: 8/20/22	NOT TO SCALE
	BEDDING FOR STORMWATER RCP PIPES	
	SW-10.14	

BASS, NIXON & KENNEDY, INC.
CONSULTING ENGINEERS
6310 CHAPEL HILL ROAD, SUITE 250, RALEIGH, NC 27607
TELEPHONE: (919) 851-4422 FAX: (919) 851-4366
CERTIFICATION NUMBERS: NCBELLS (C-0110); NCBOILA (C-0267)

REVISIONS		
NO.	DATE	DESCRIPTION
BY		

03-19157	PROGRESS	MRM
JOB NO.	DATE	DRAWN BY
DETAILS		
SCALE: N.T.S.		CHK BY: MDB

SHEET

C5.2

COBLESTONE

VILLAGE

MIXED USE DEVELOPMENT




 












TOWN OF ROLESVILLE, WAKE COUNTY, NORTH CAROLINA




NOT RELEASED FOR CONSTRUCTION OR BID SOLICITATION

04/20/22




TOWN OF ROLESVILLE PROJECT NO



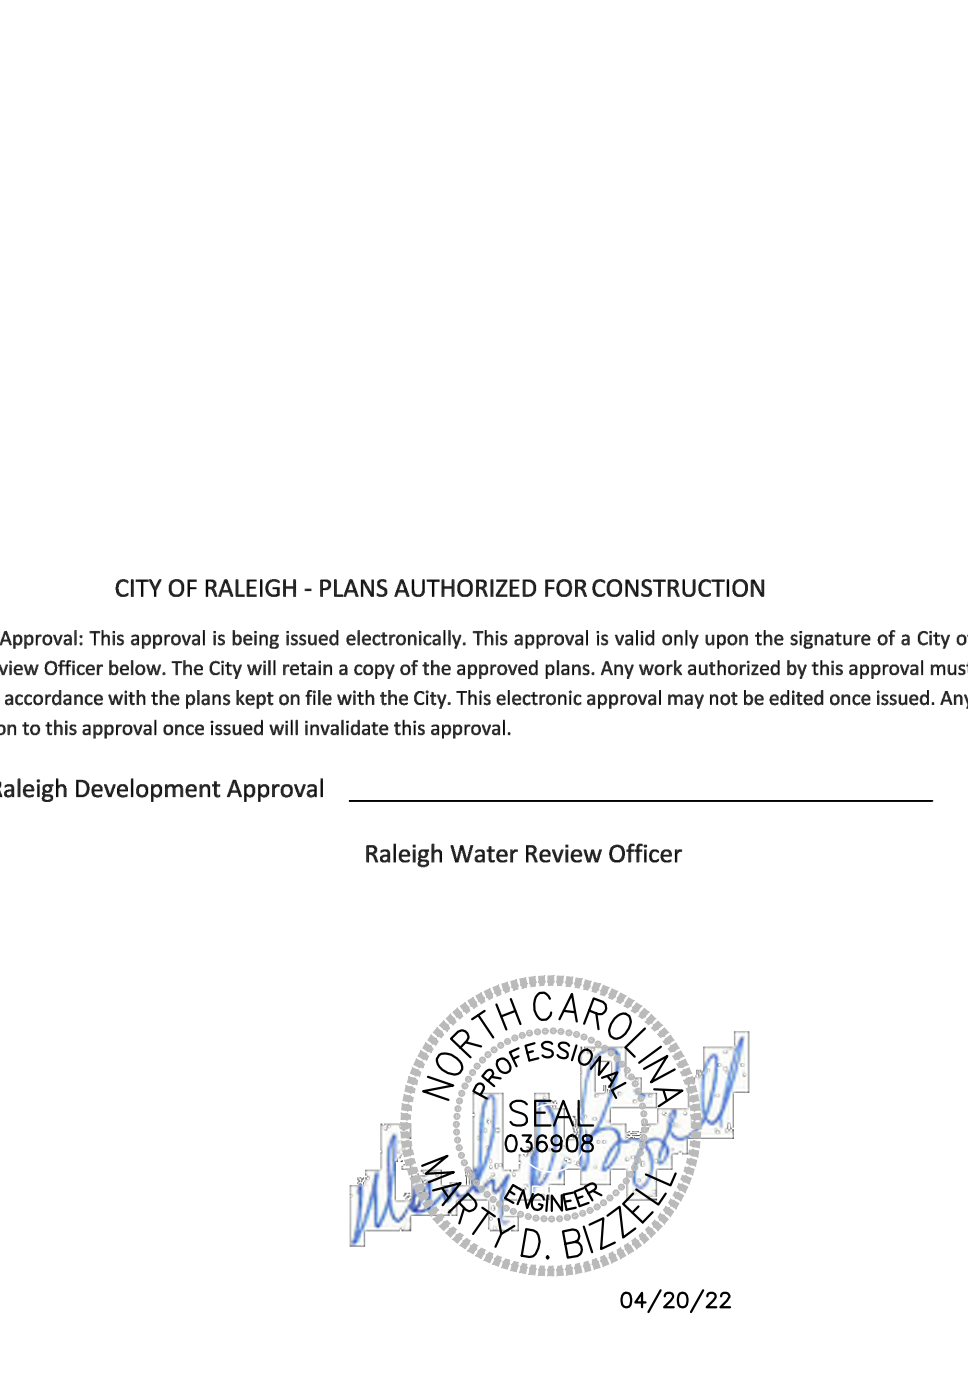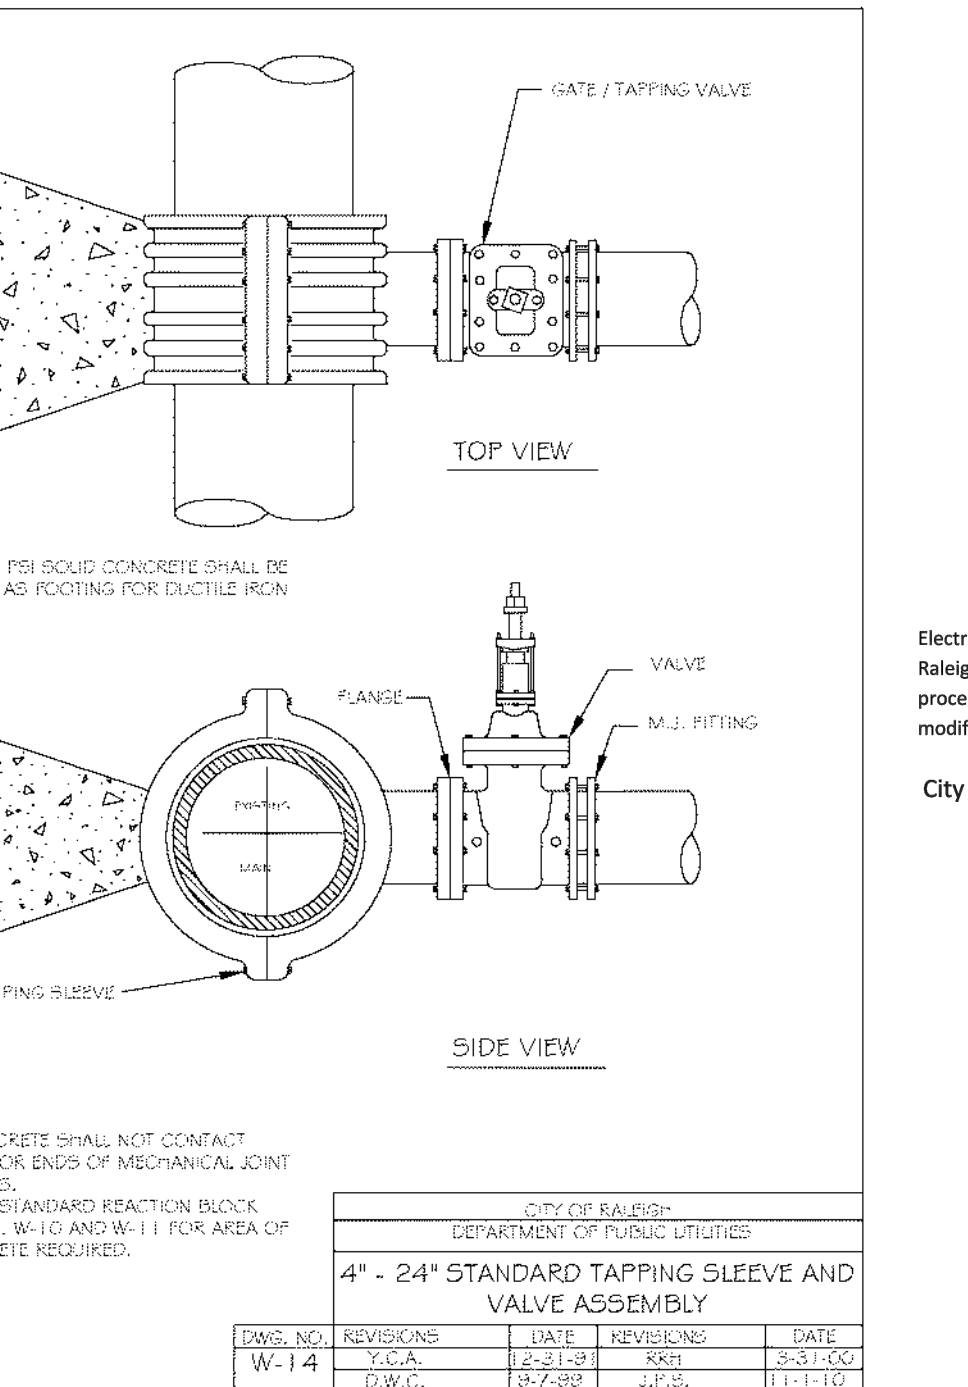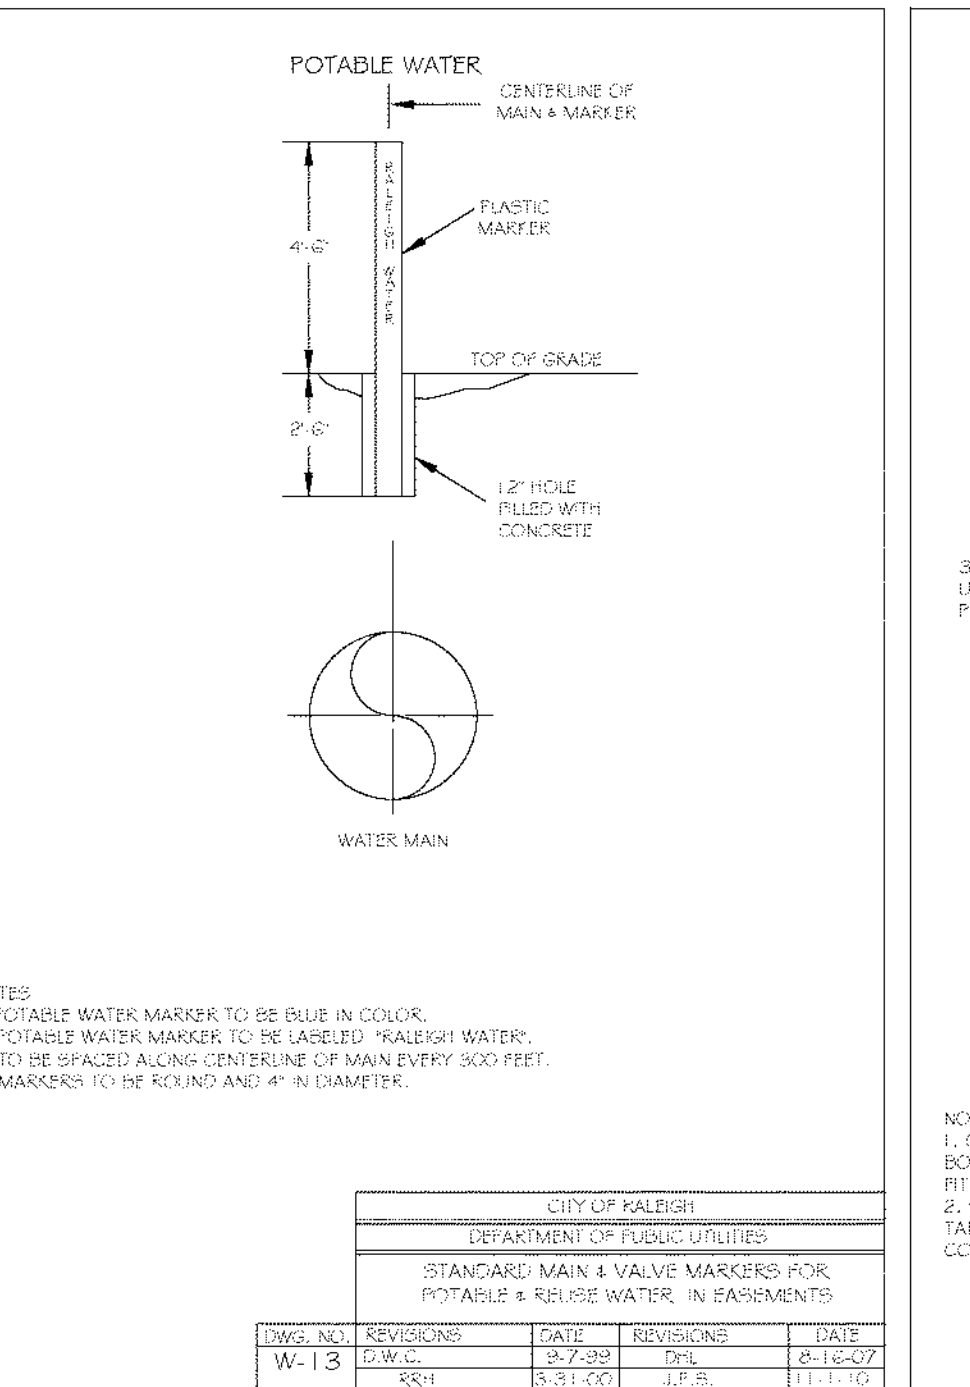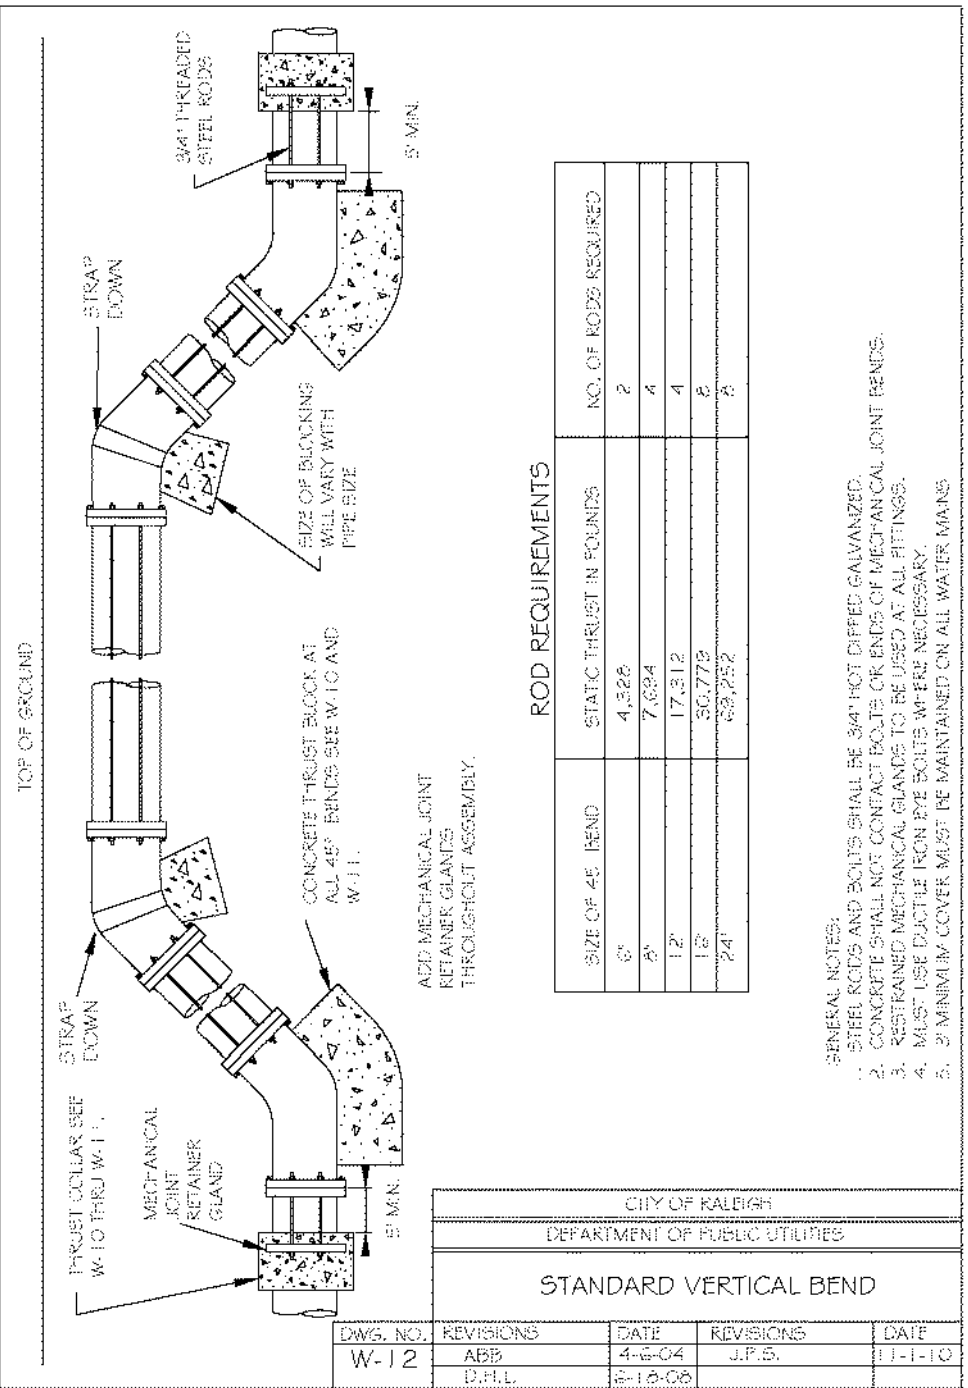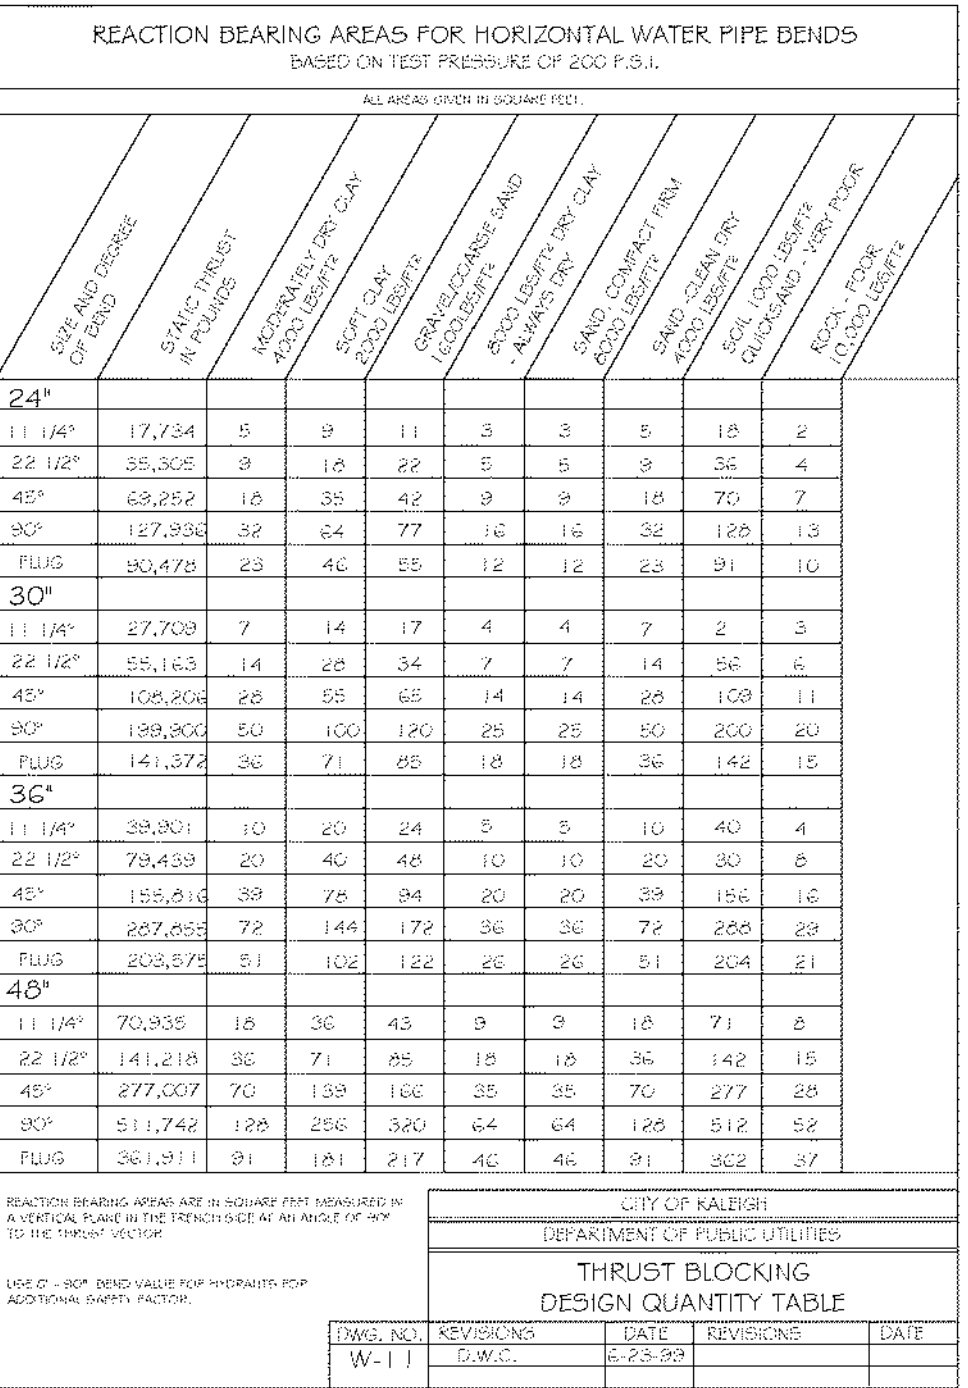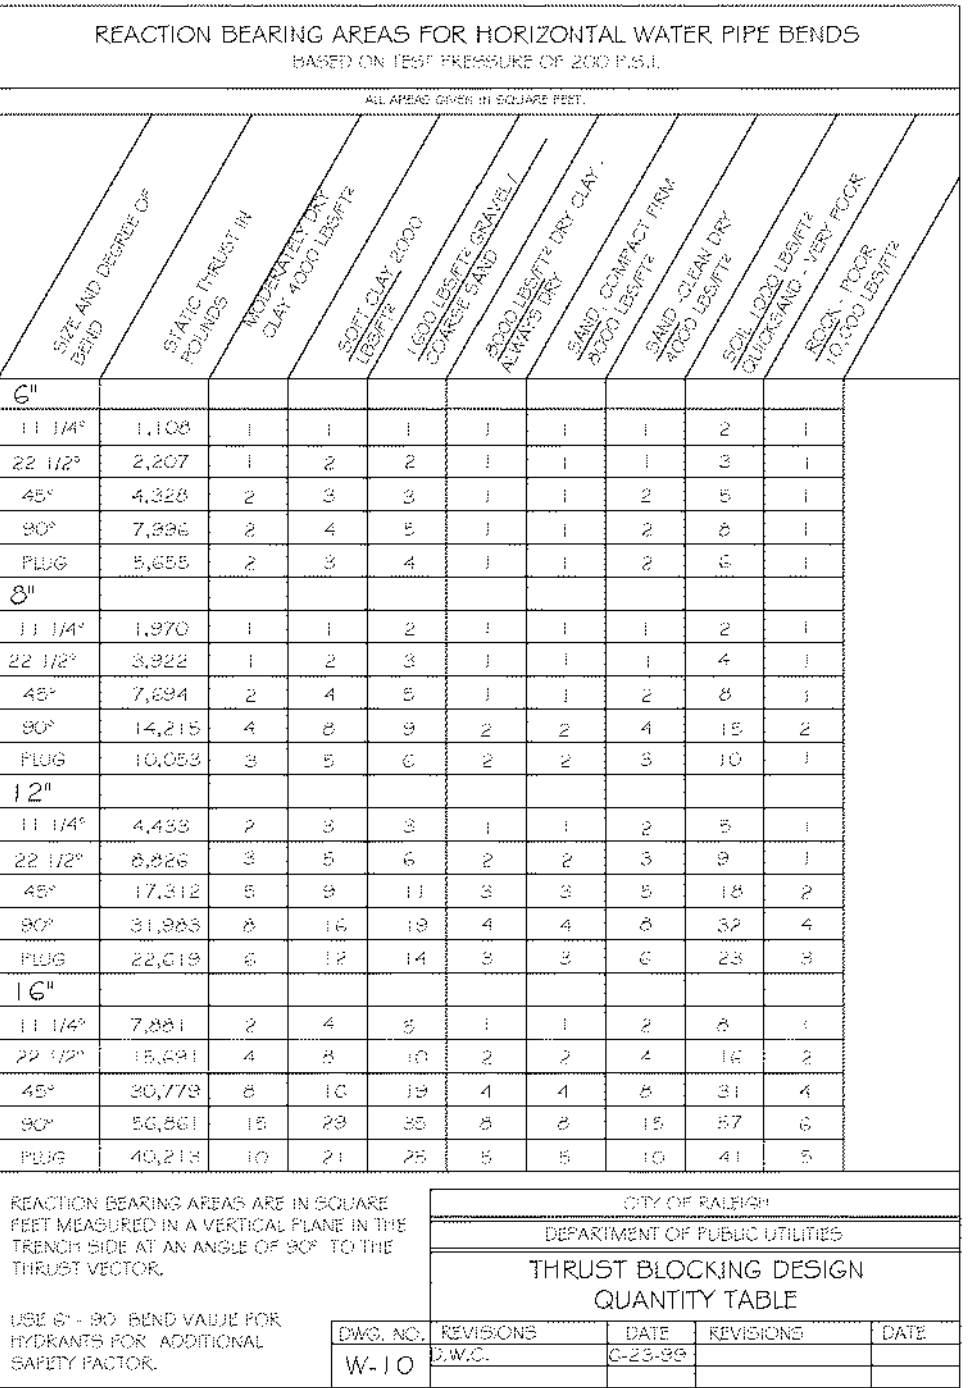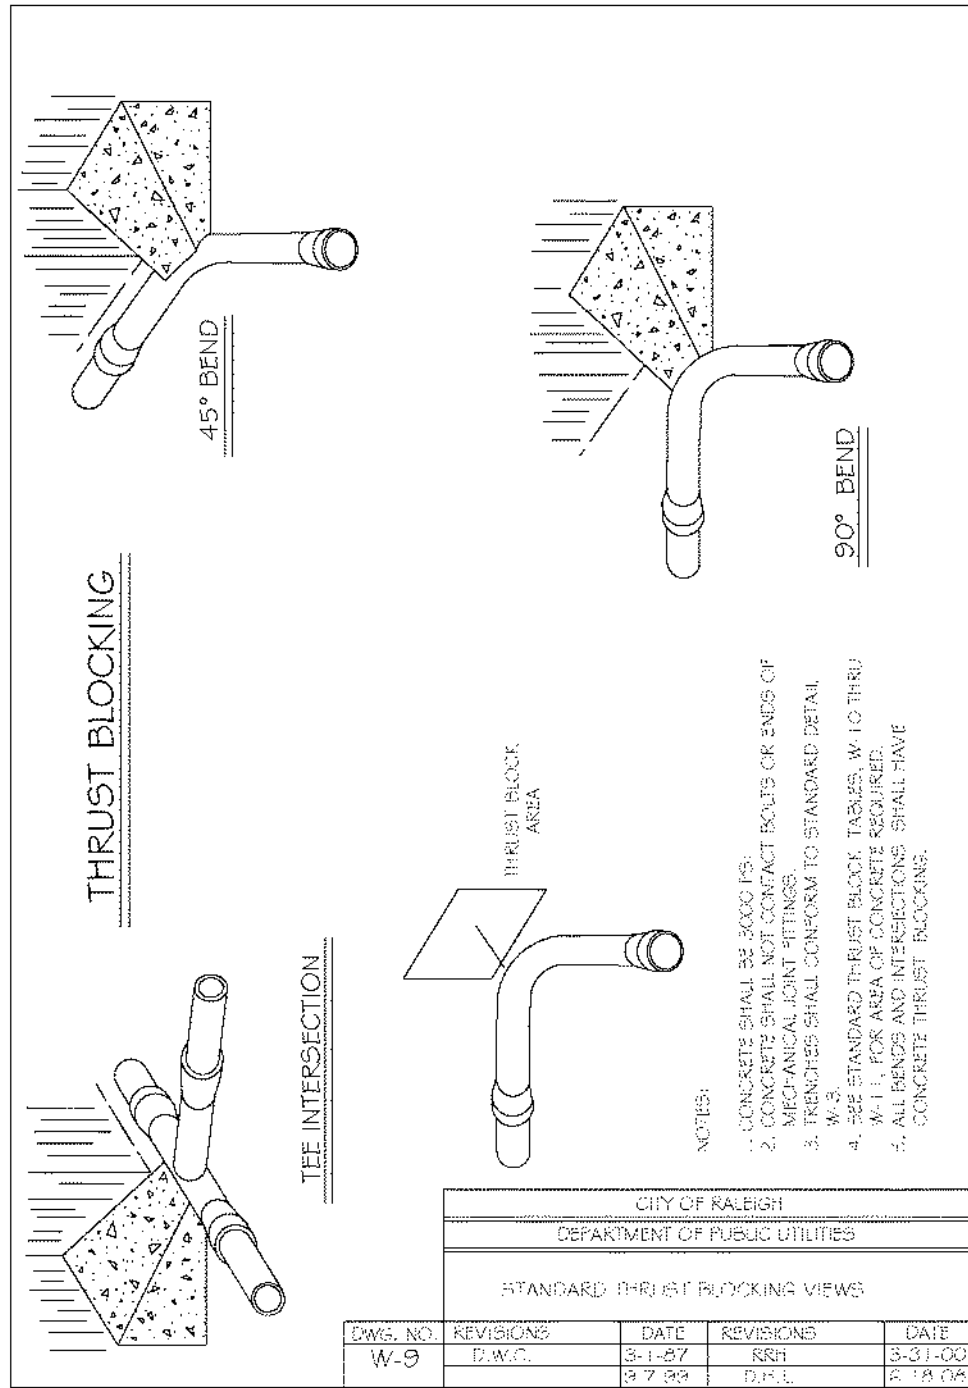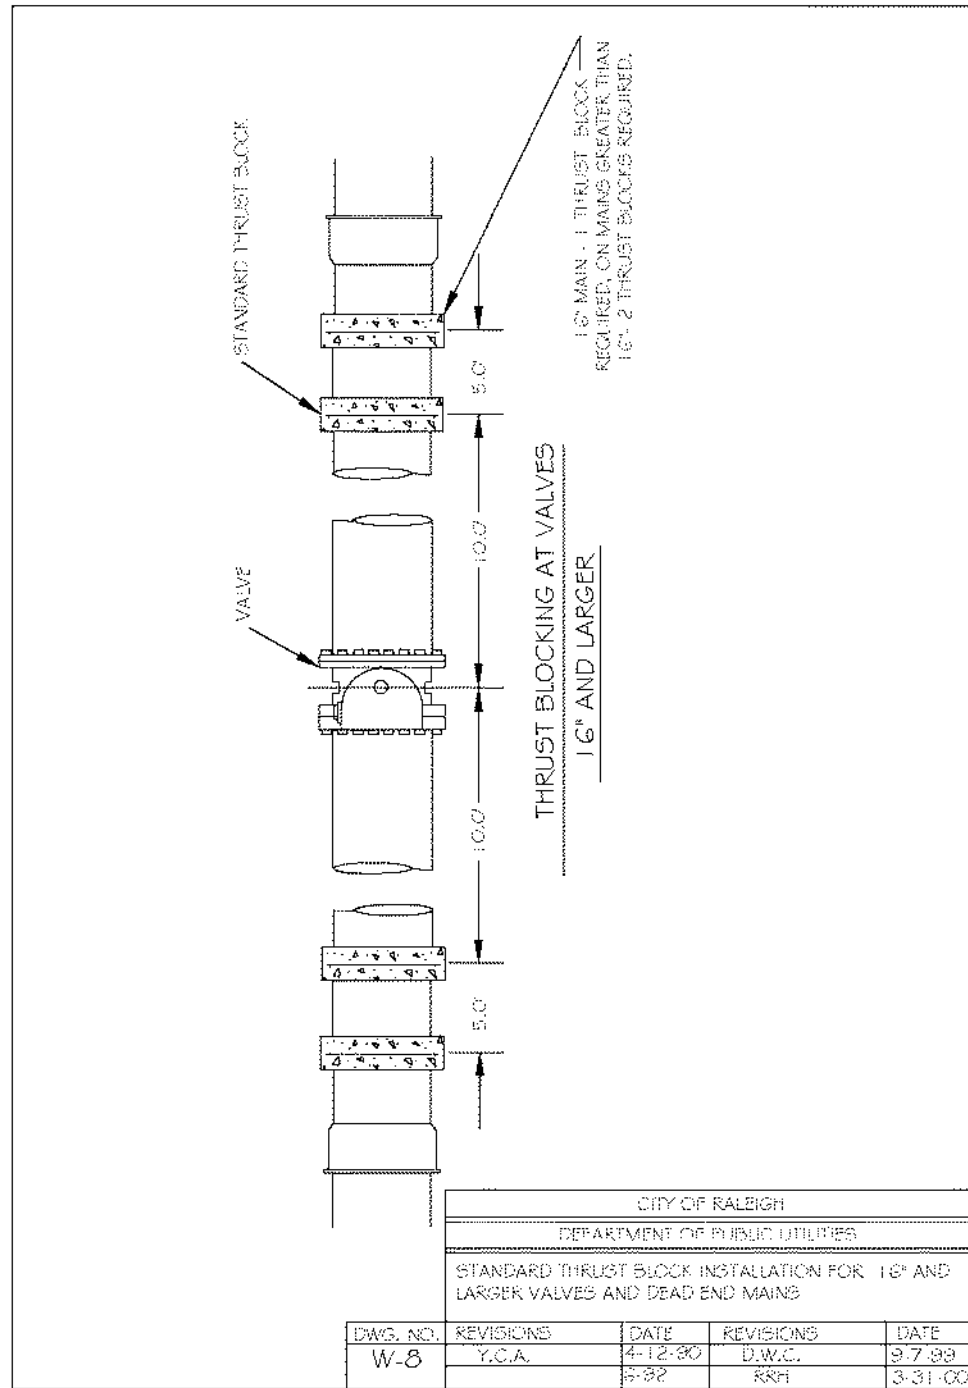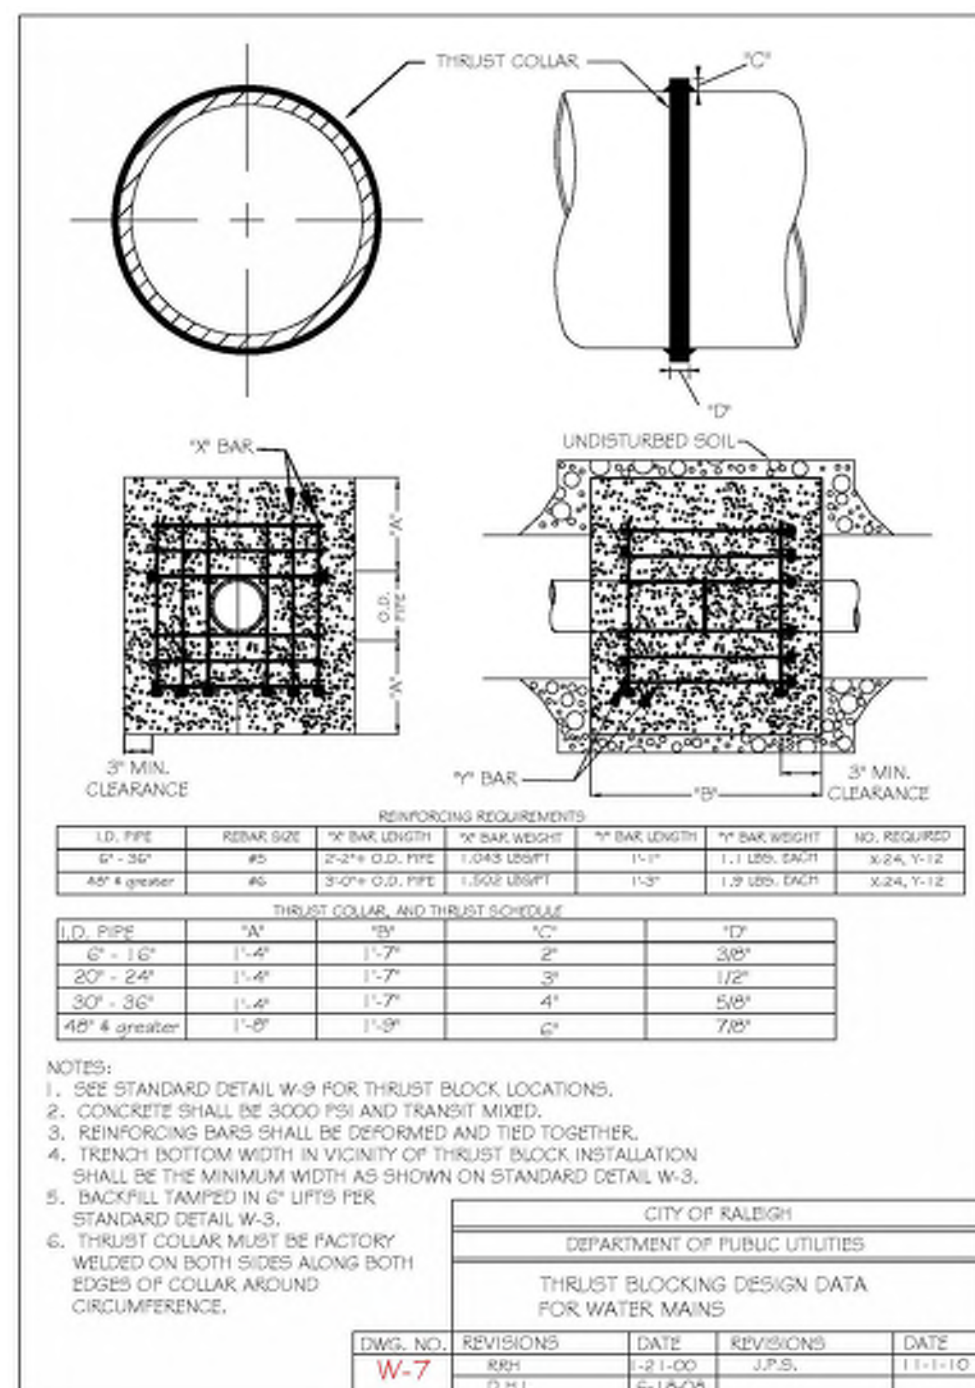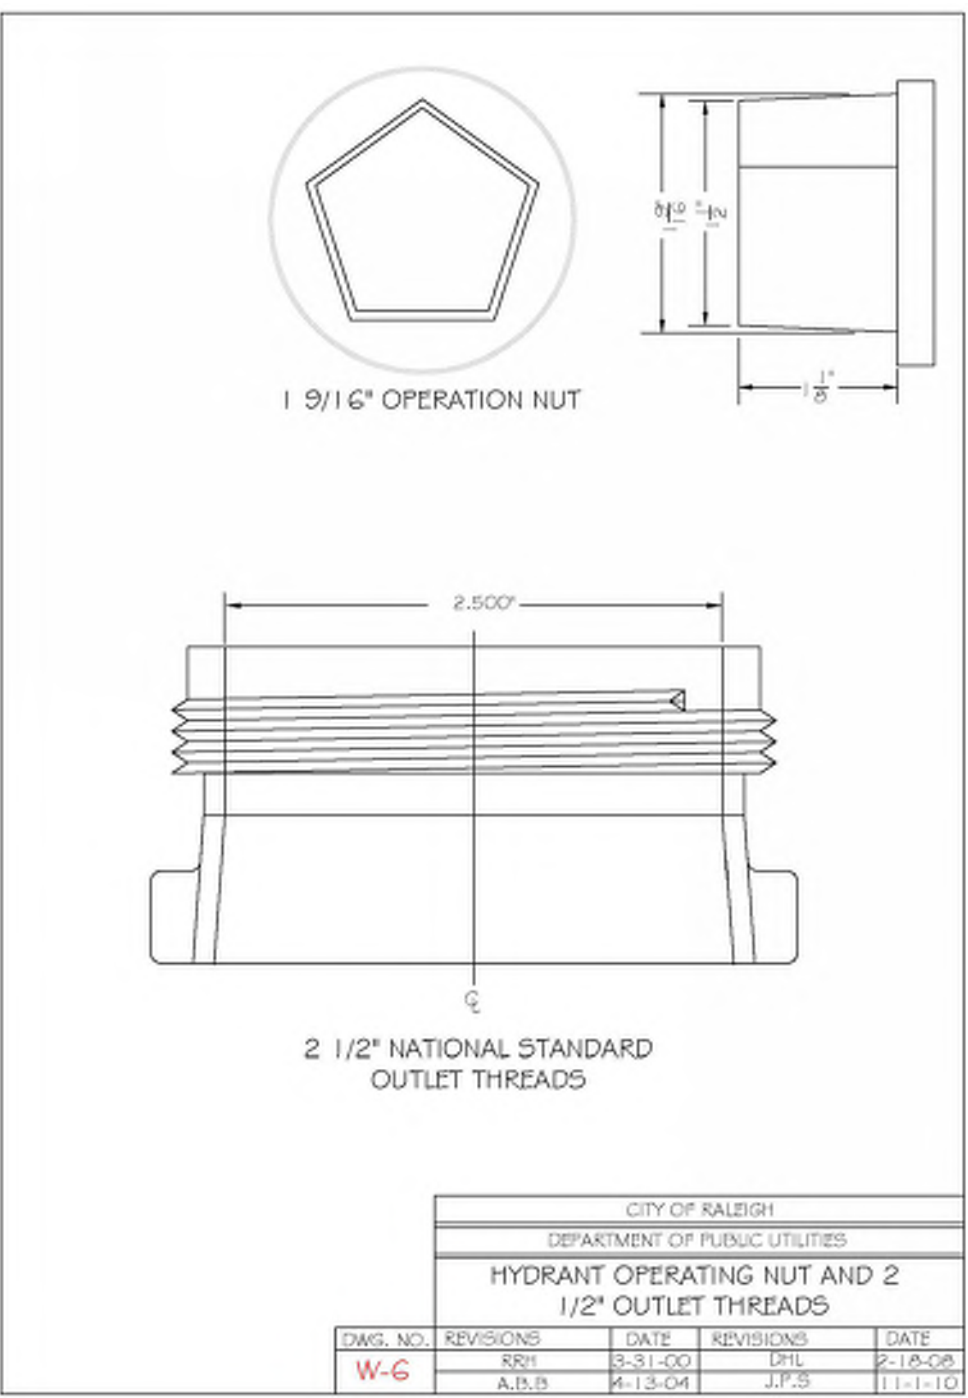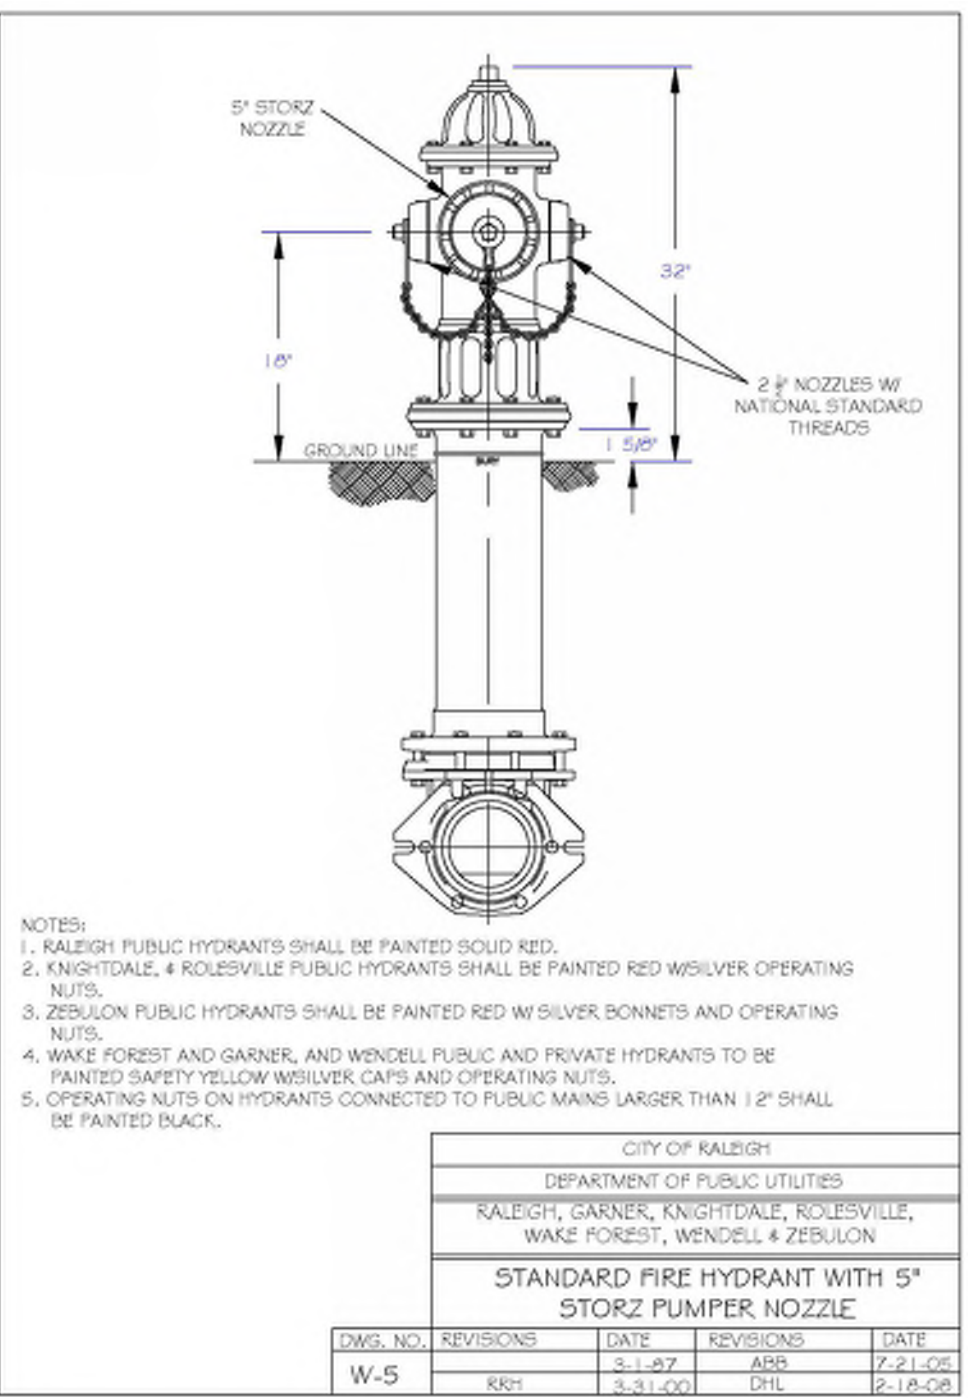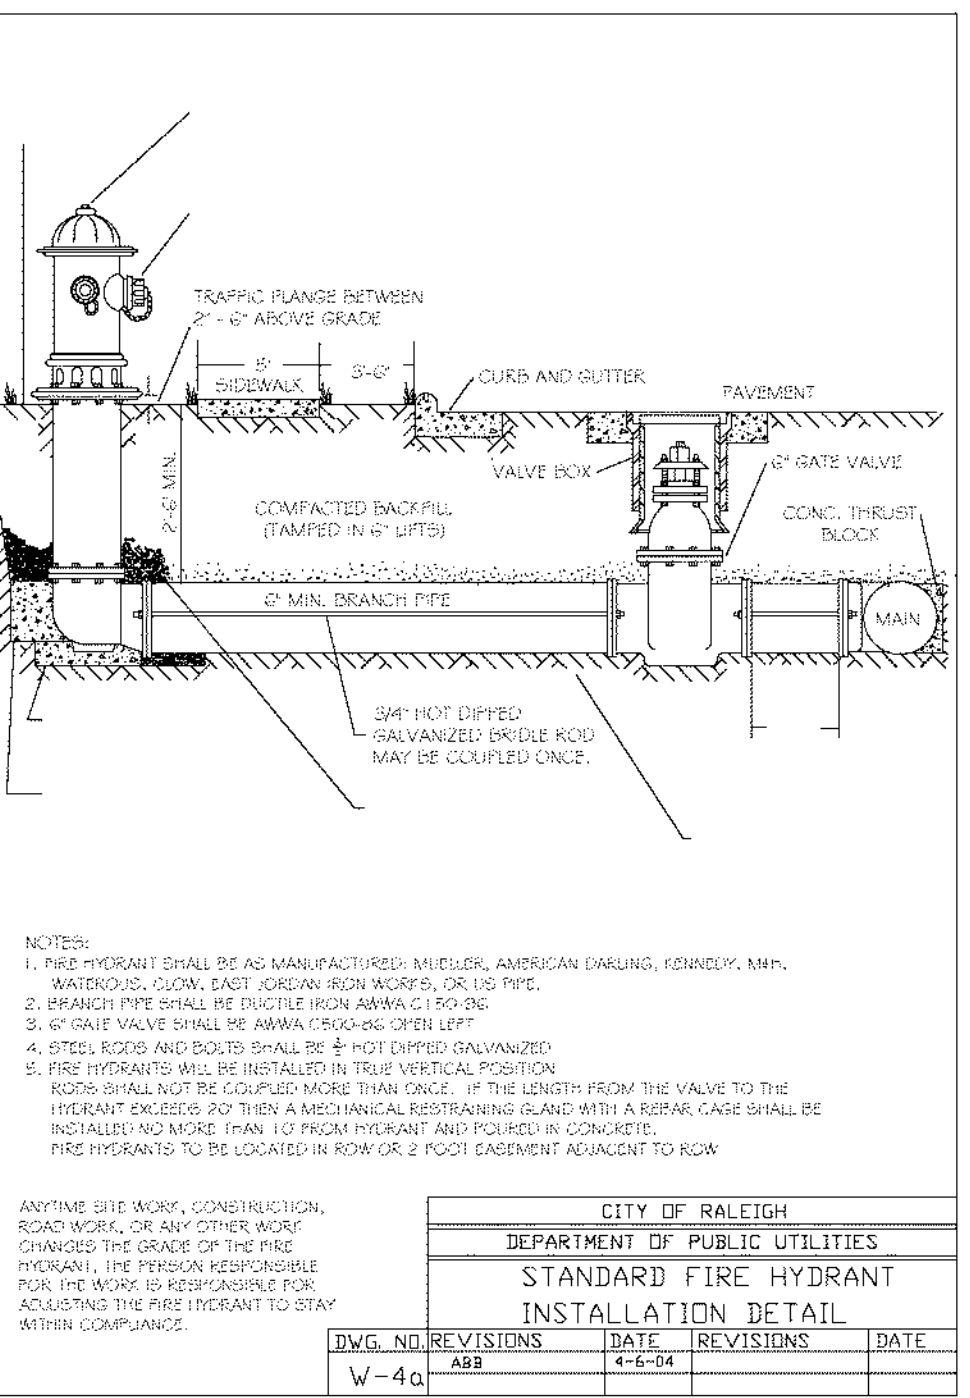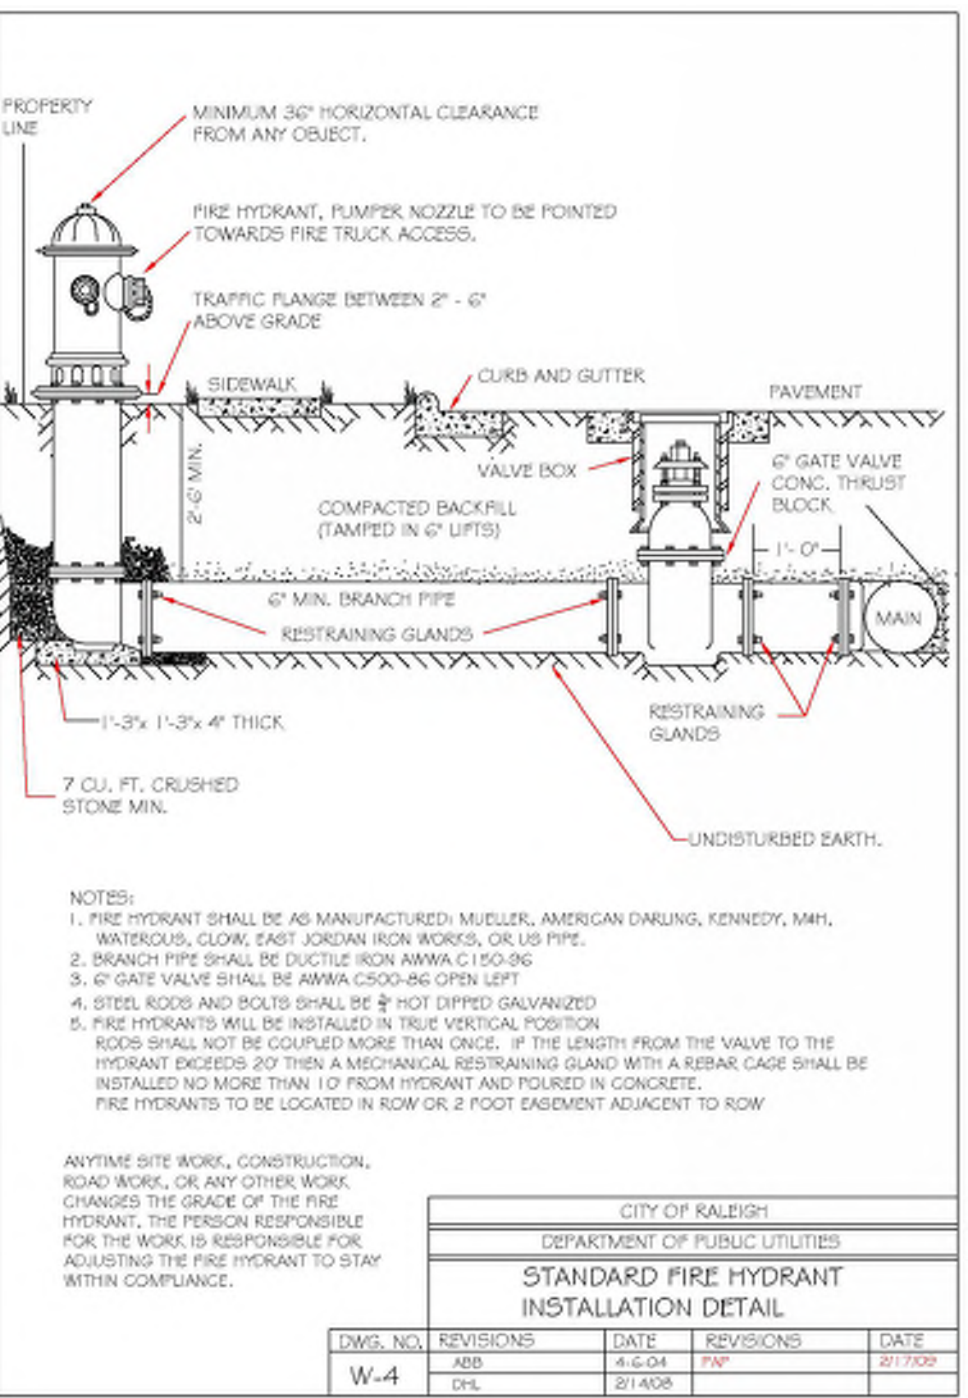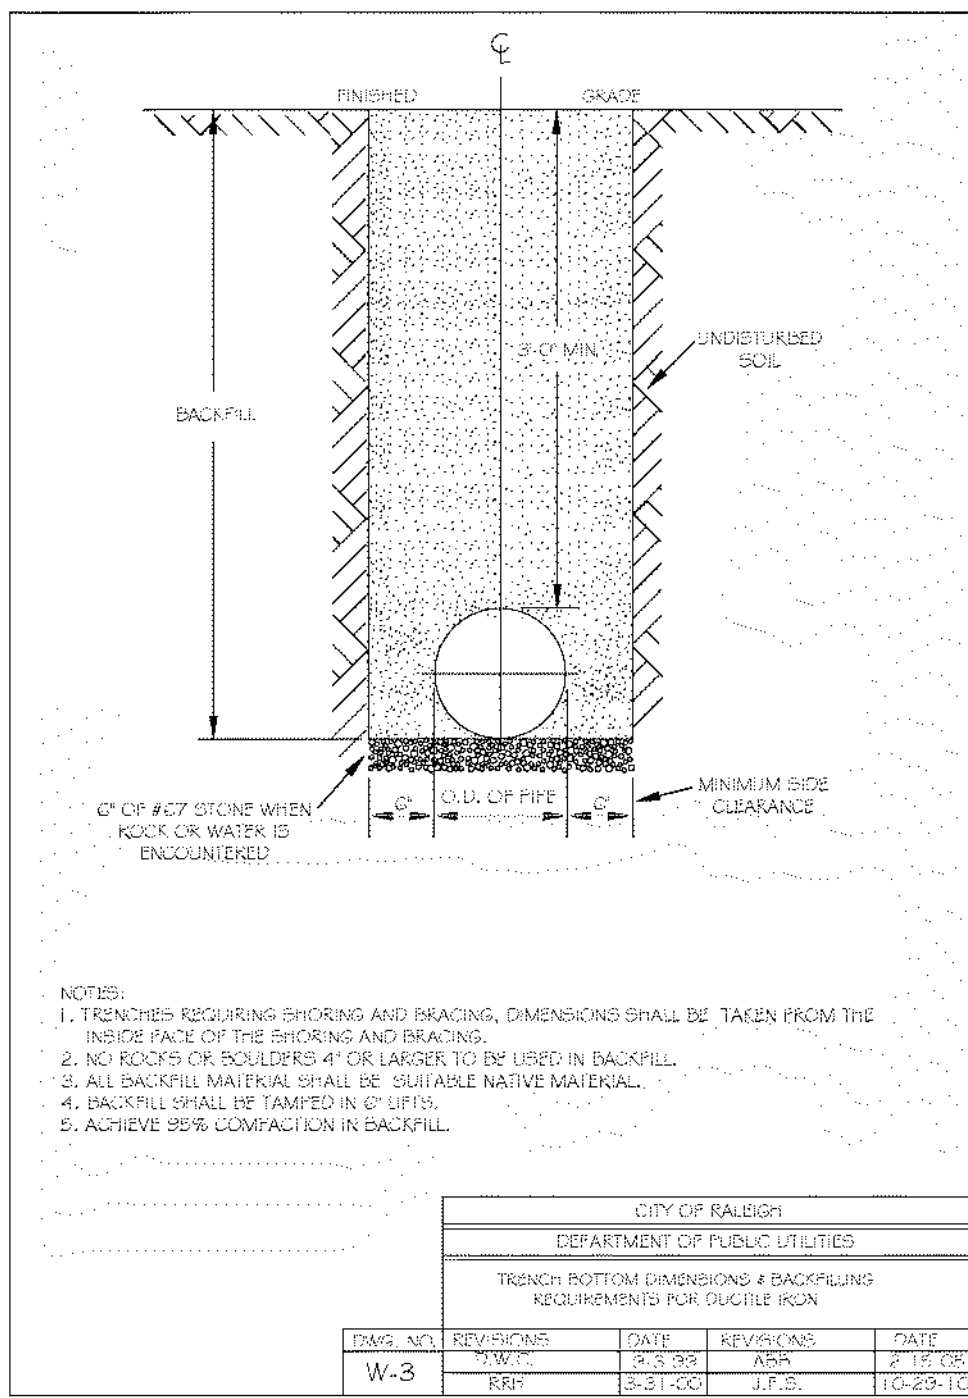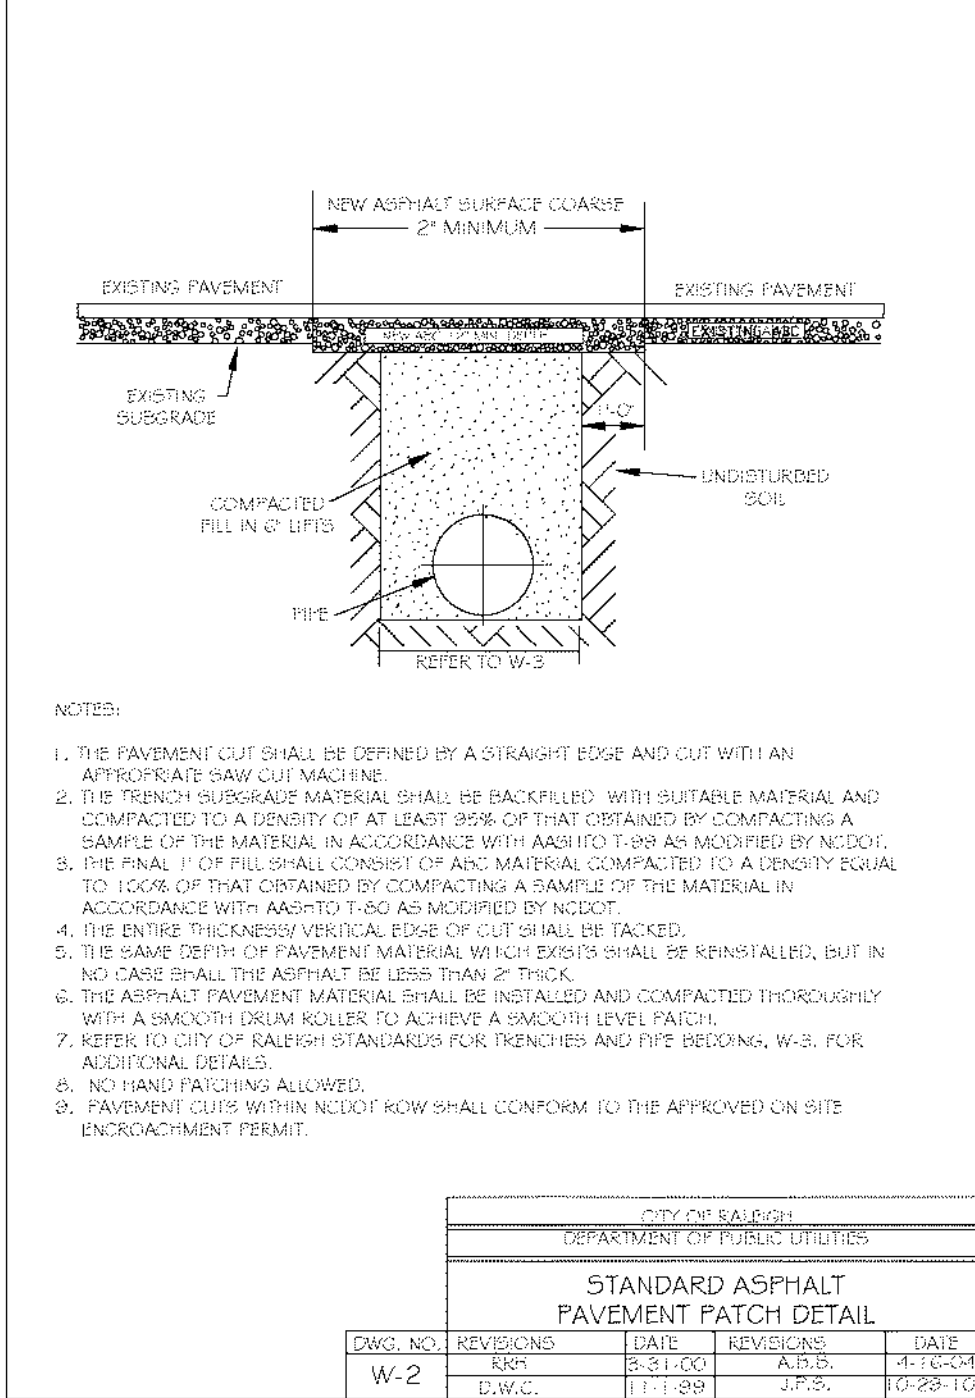

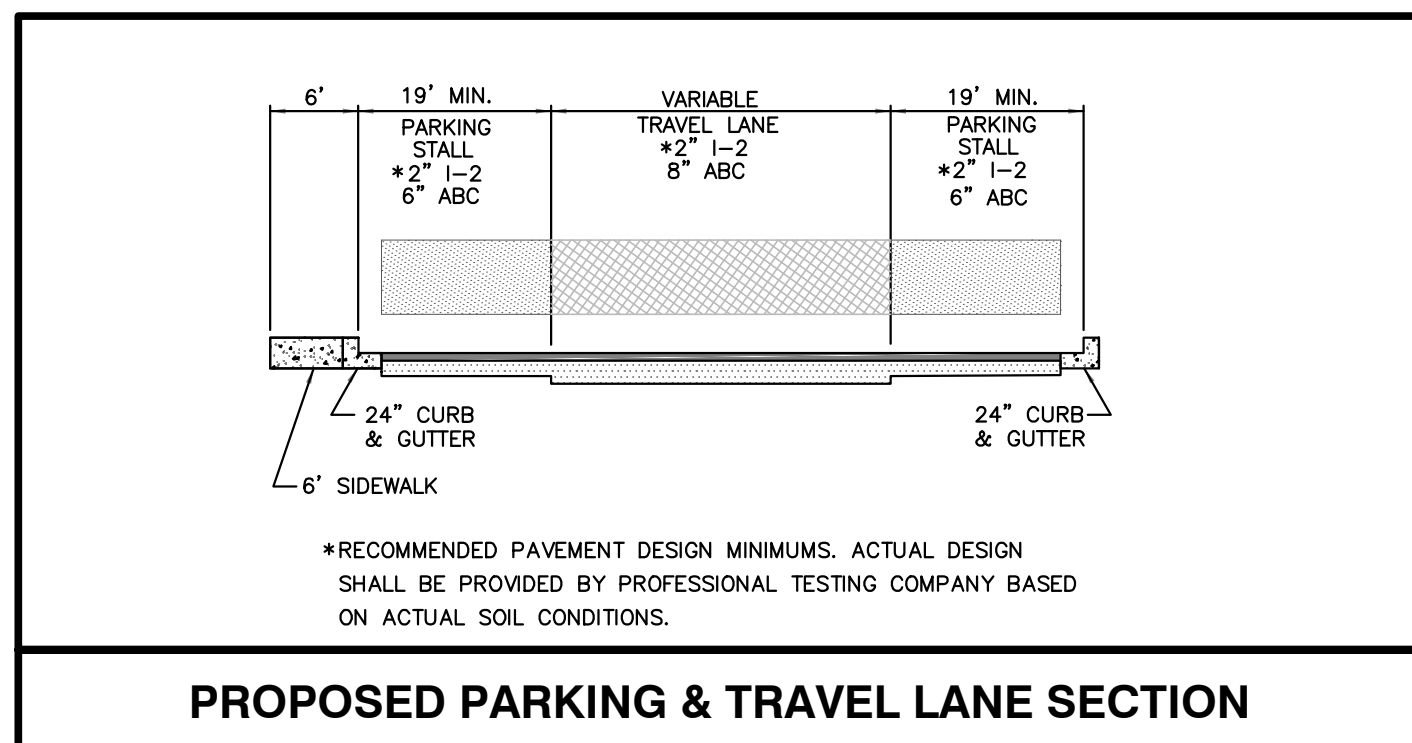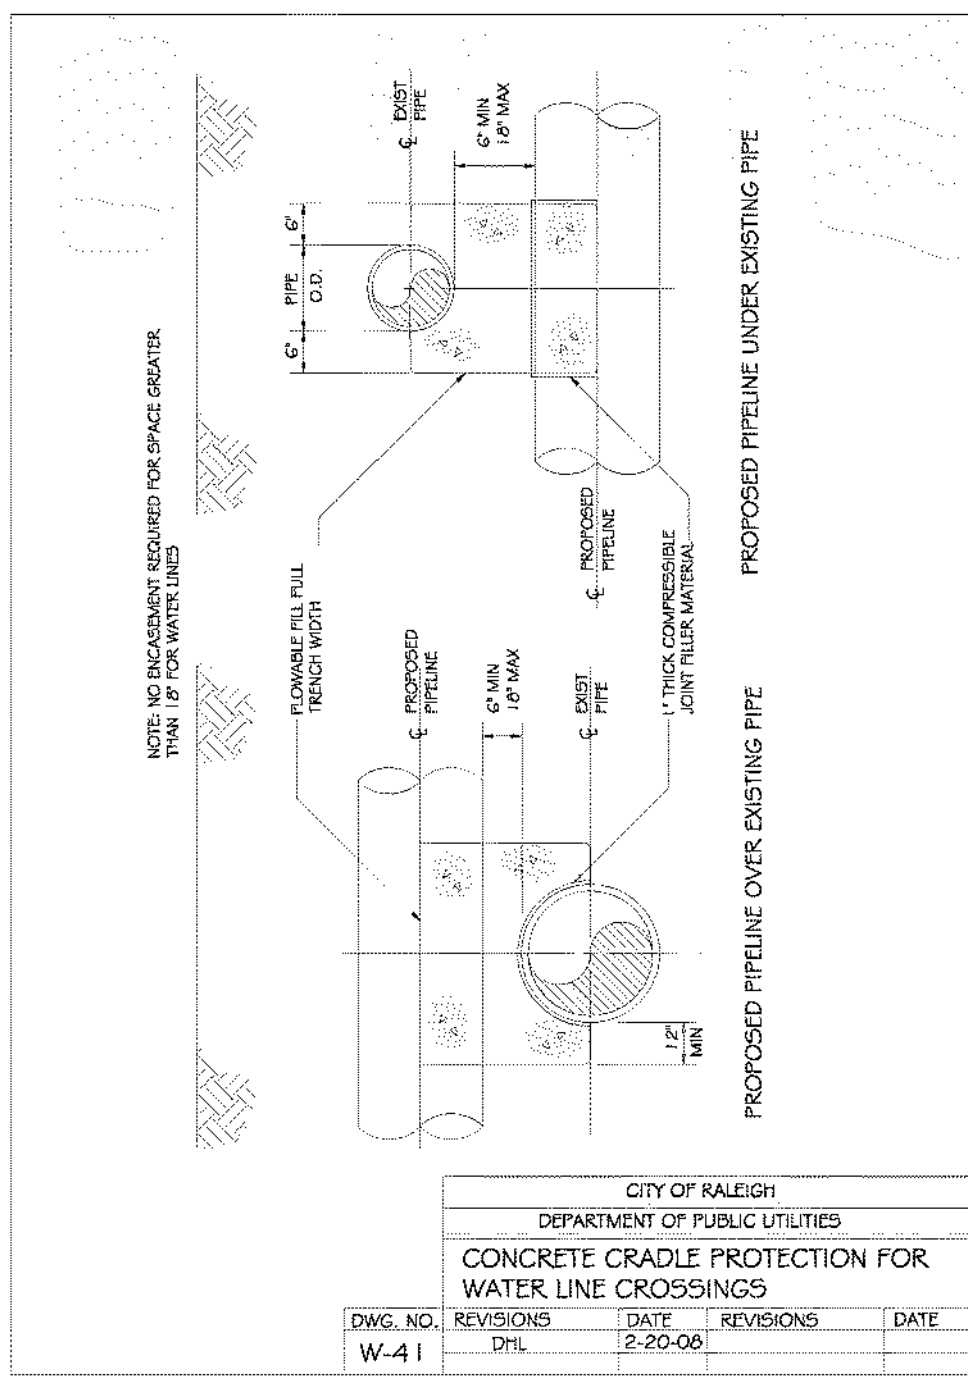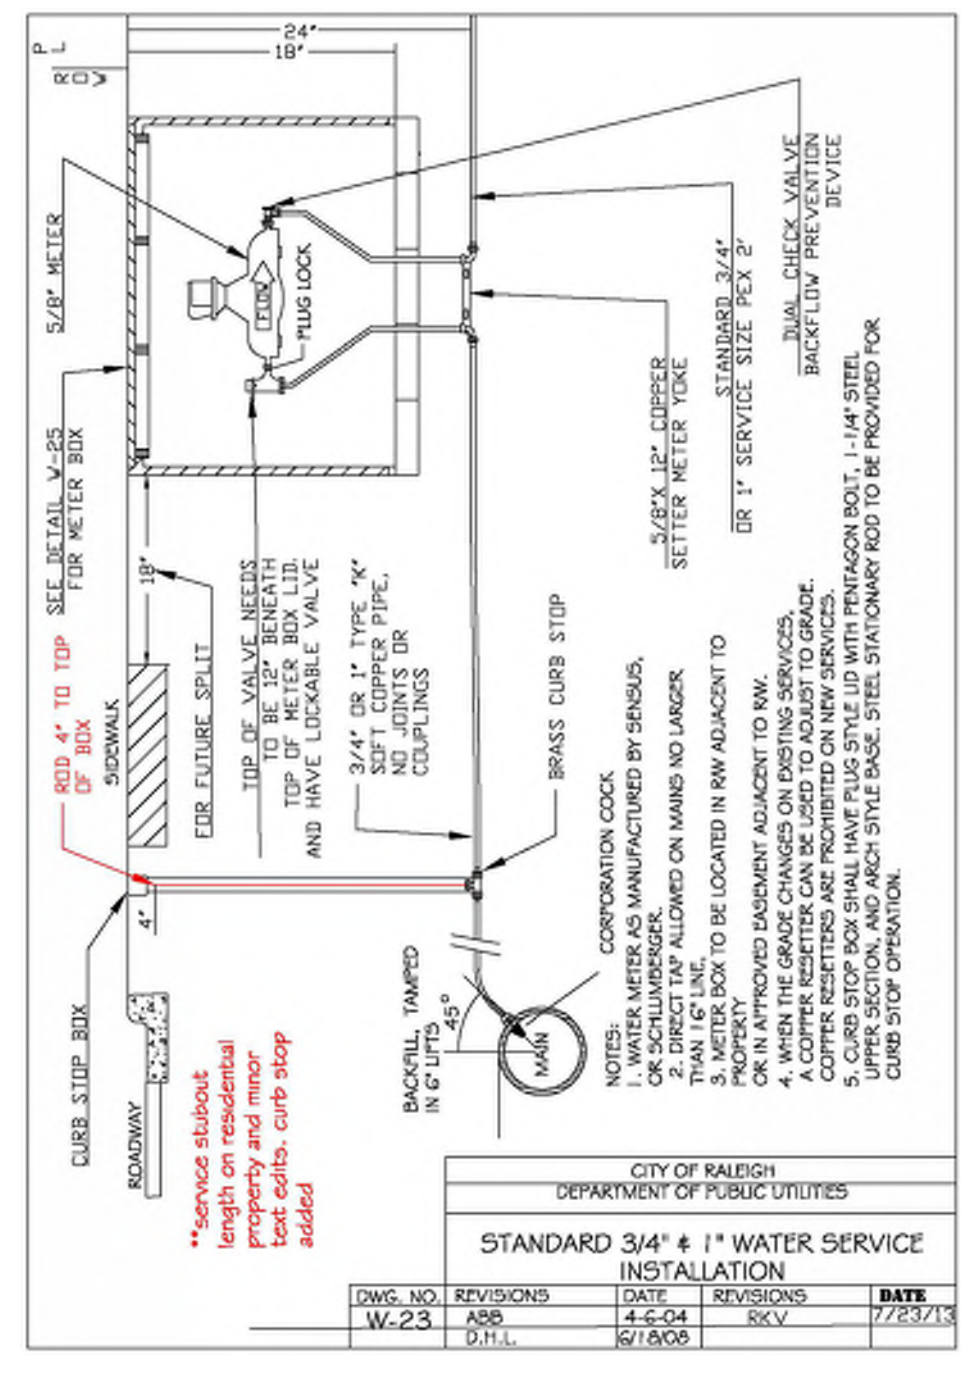

04/20/22

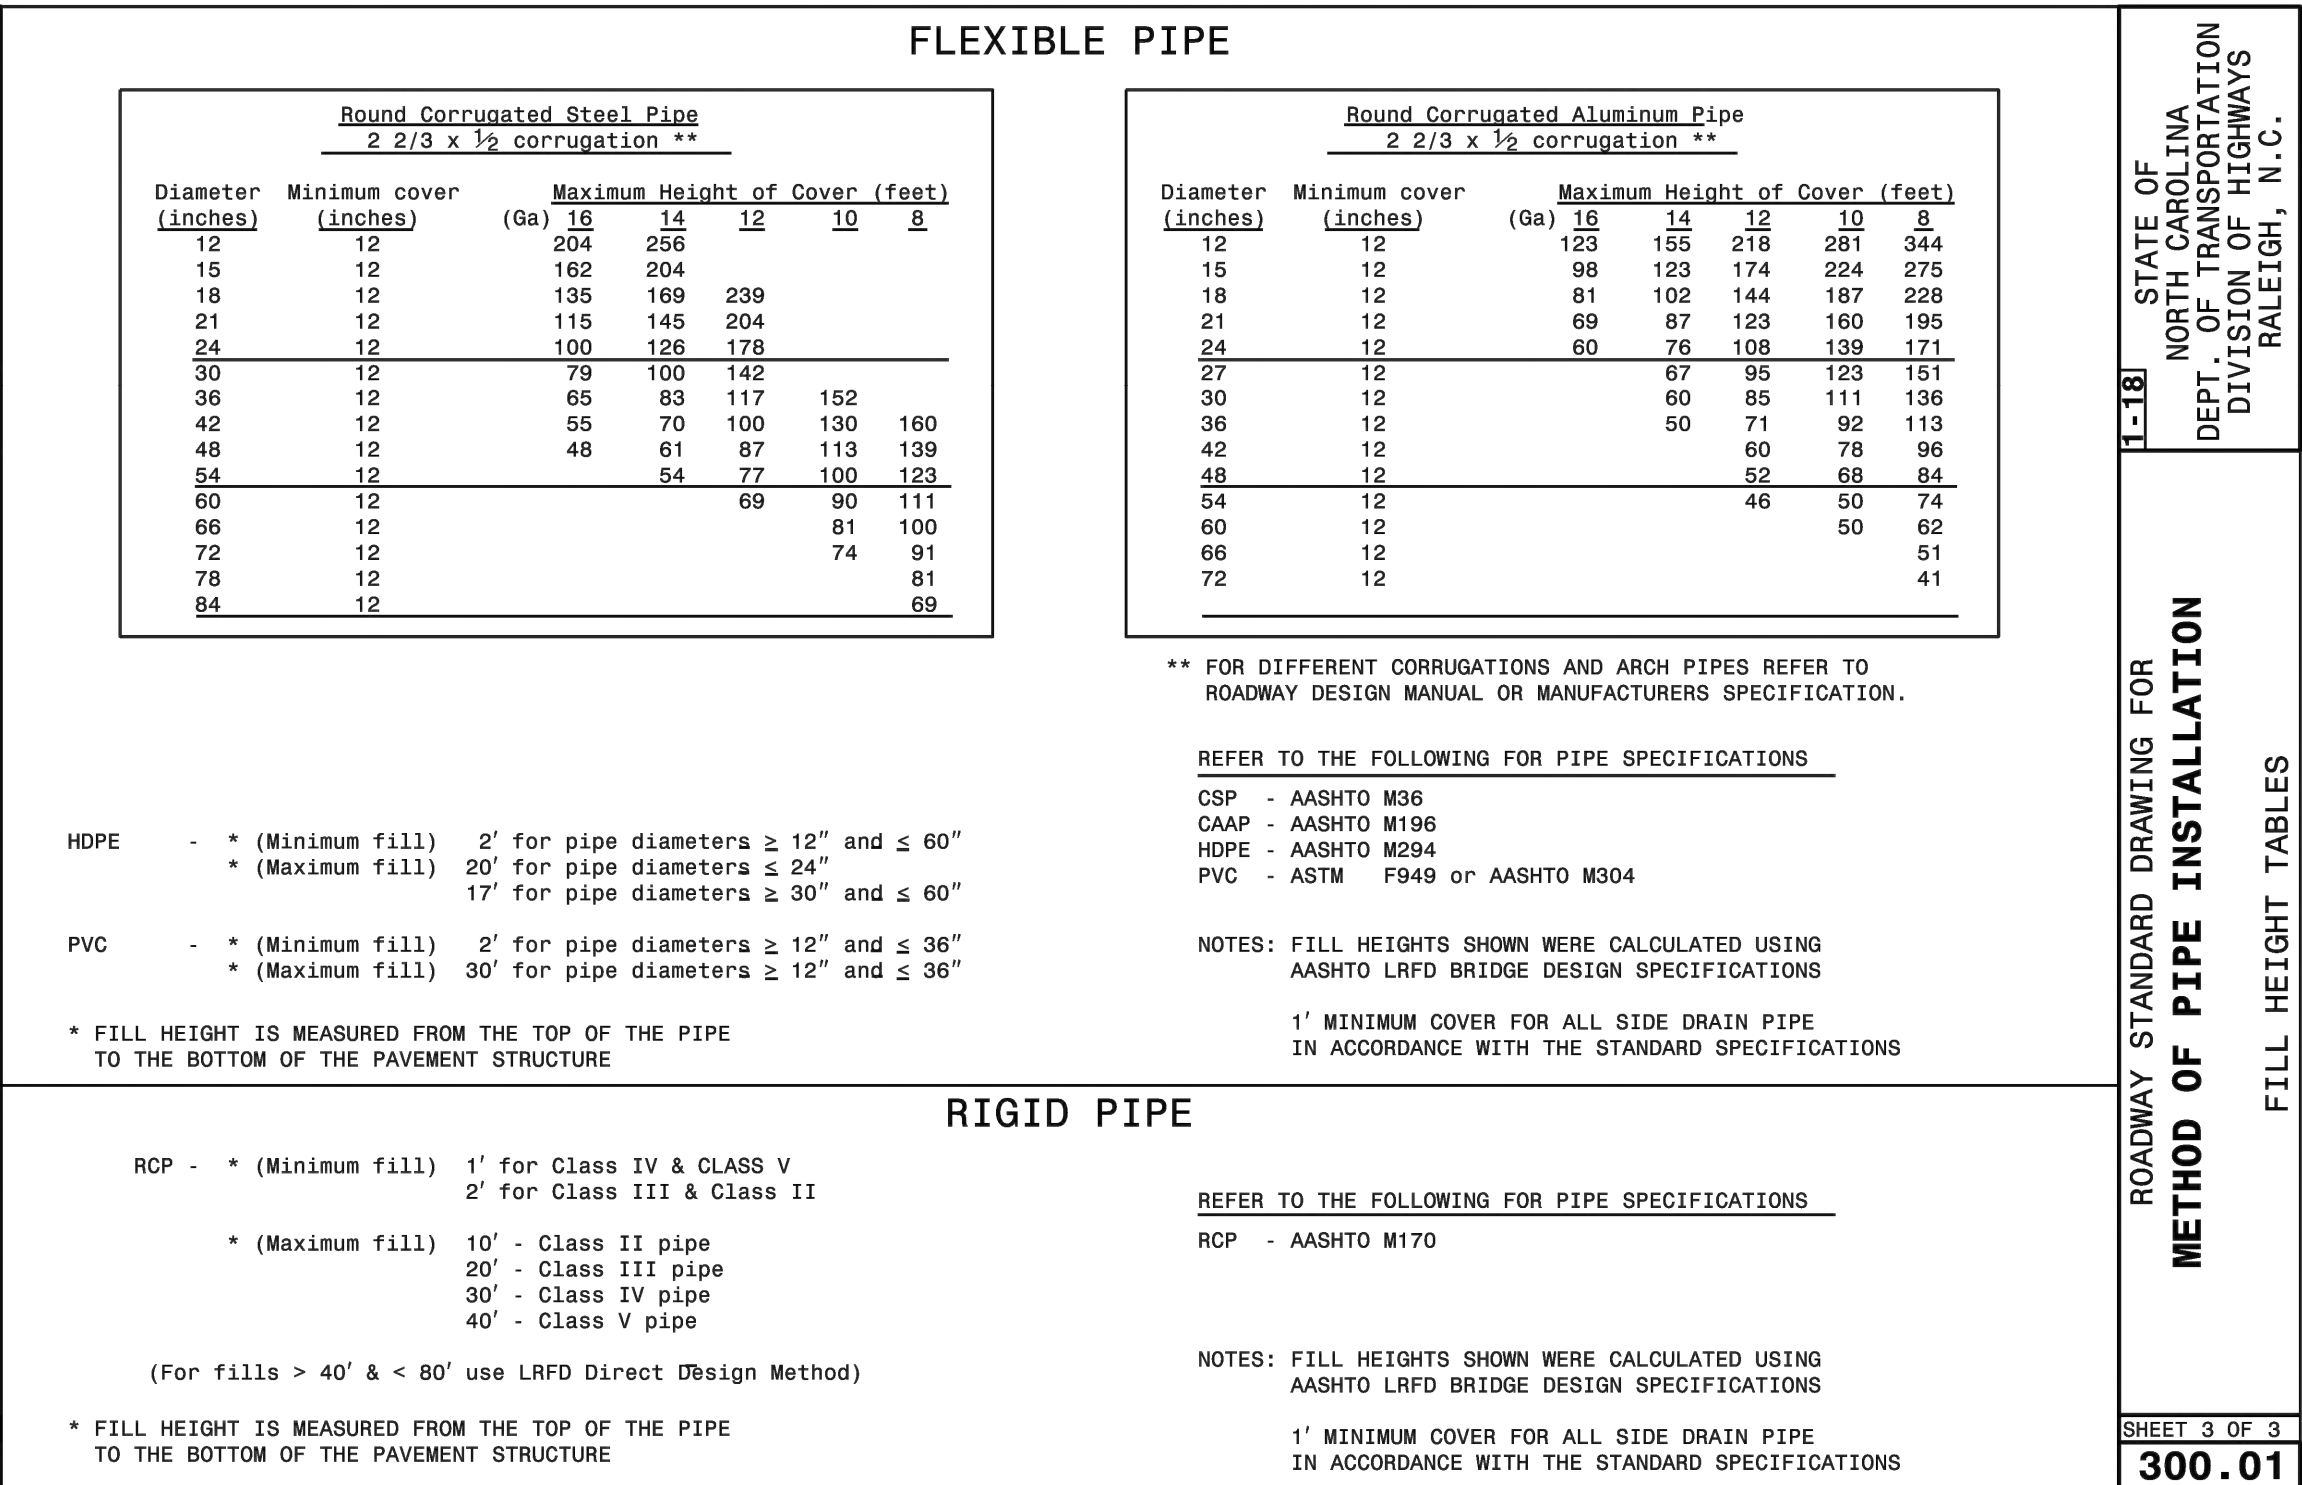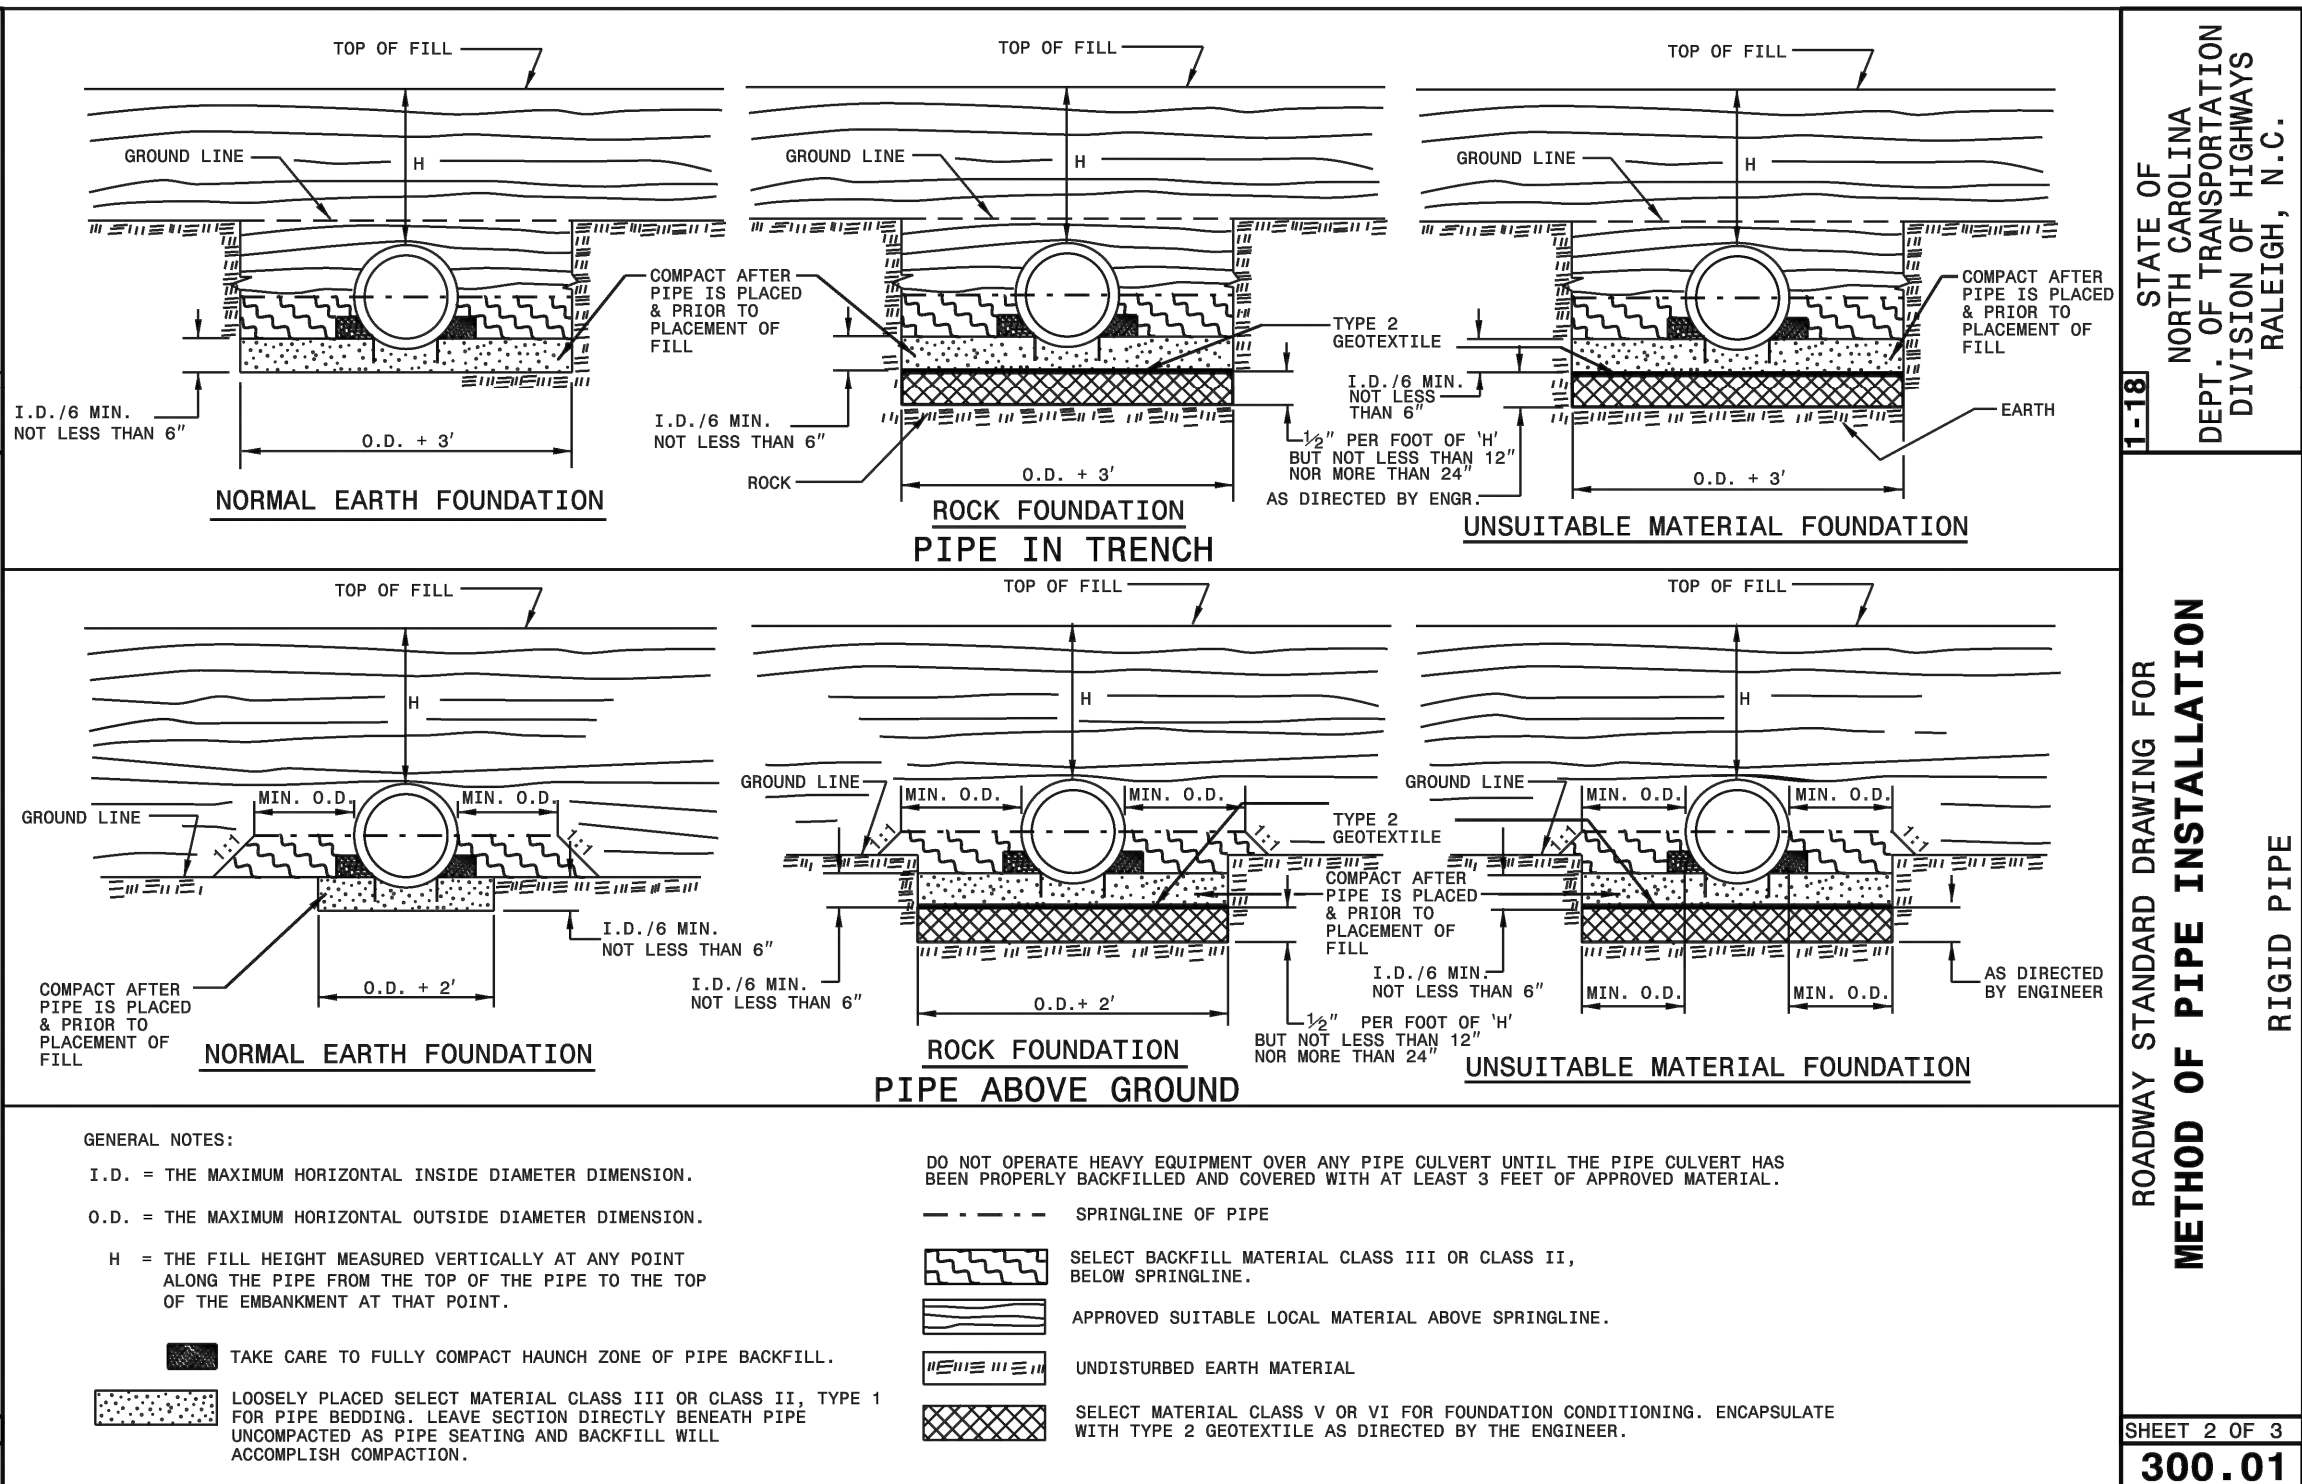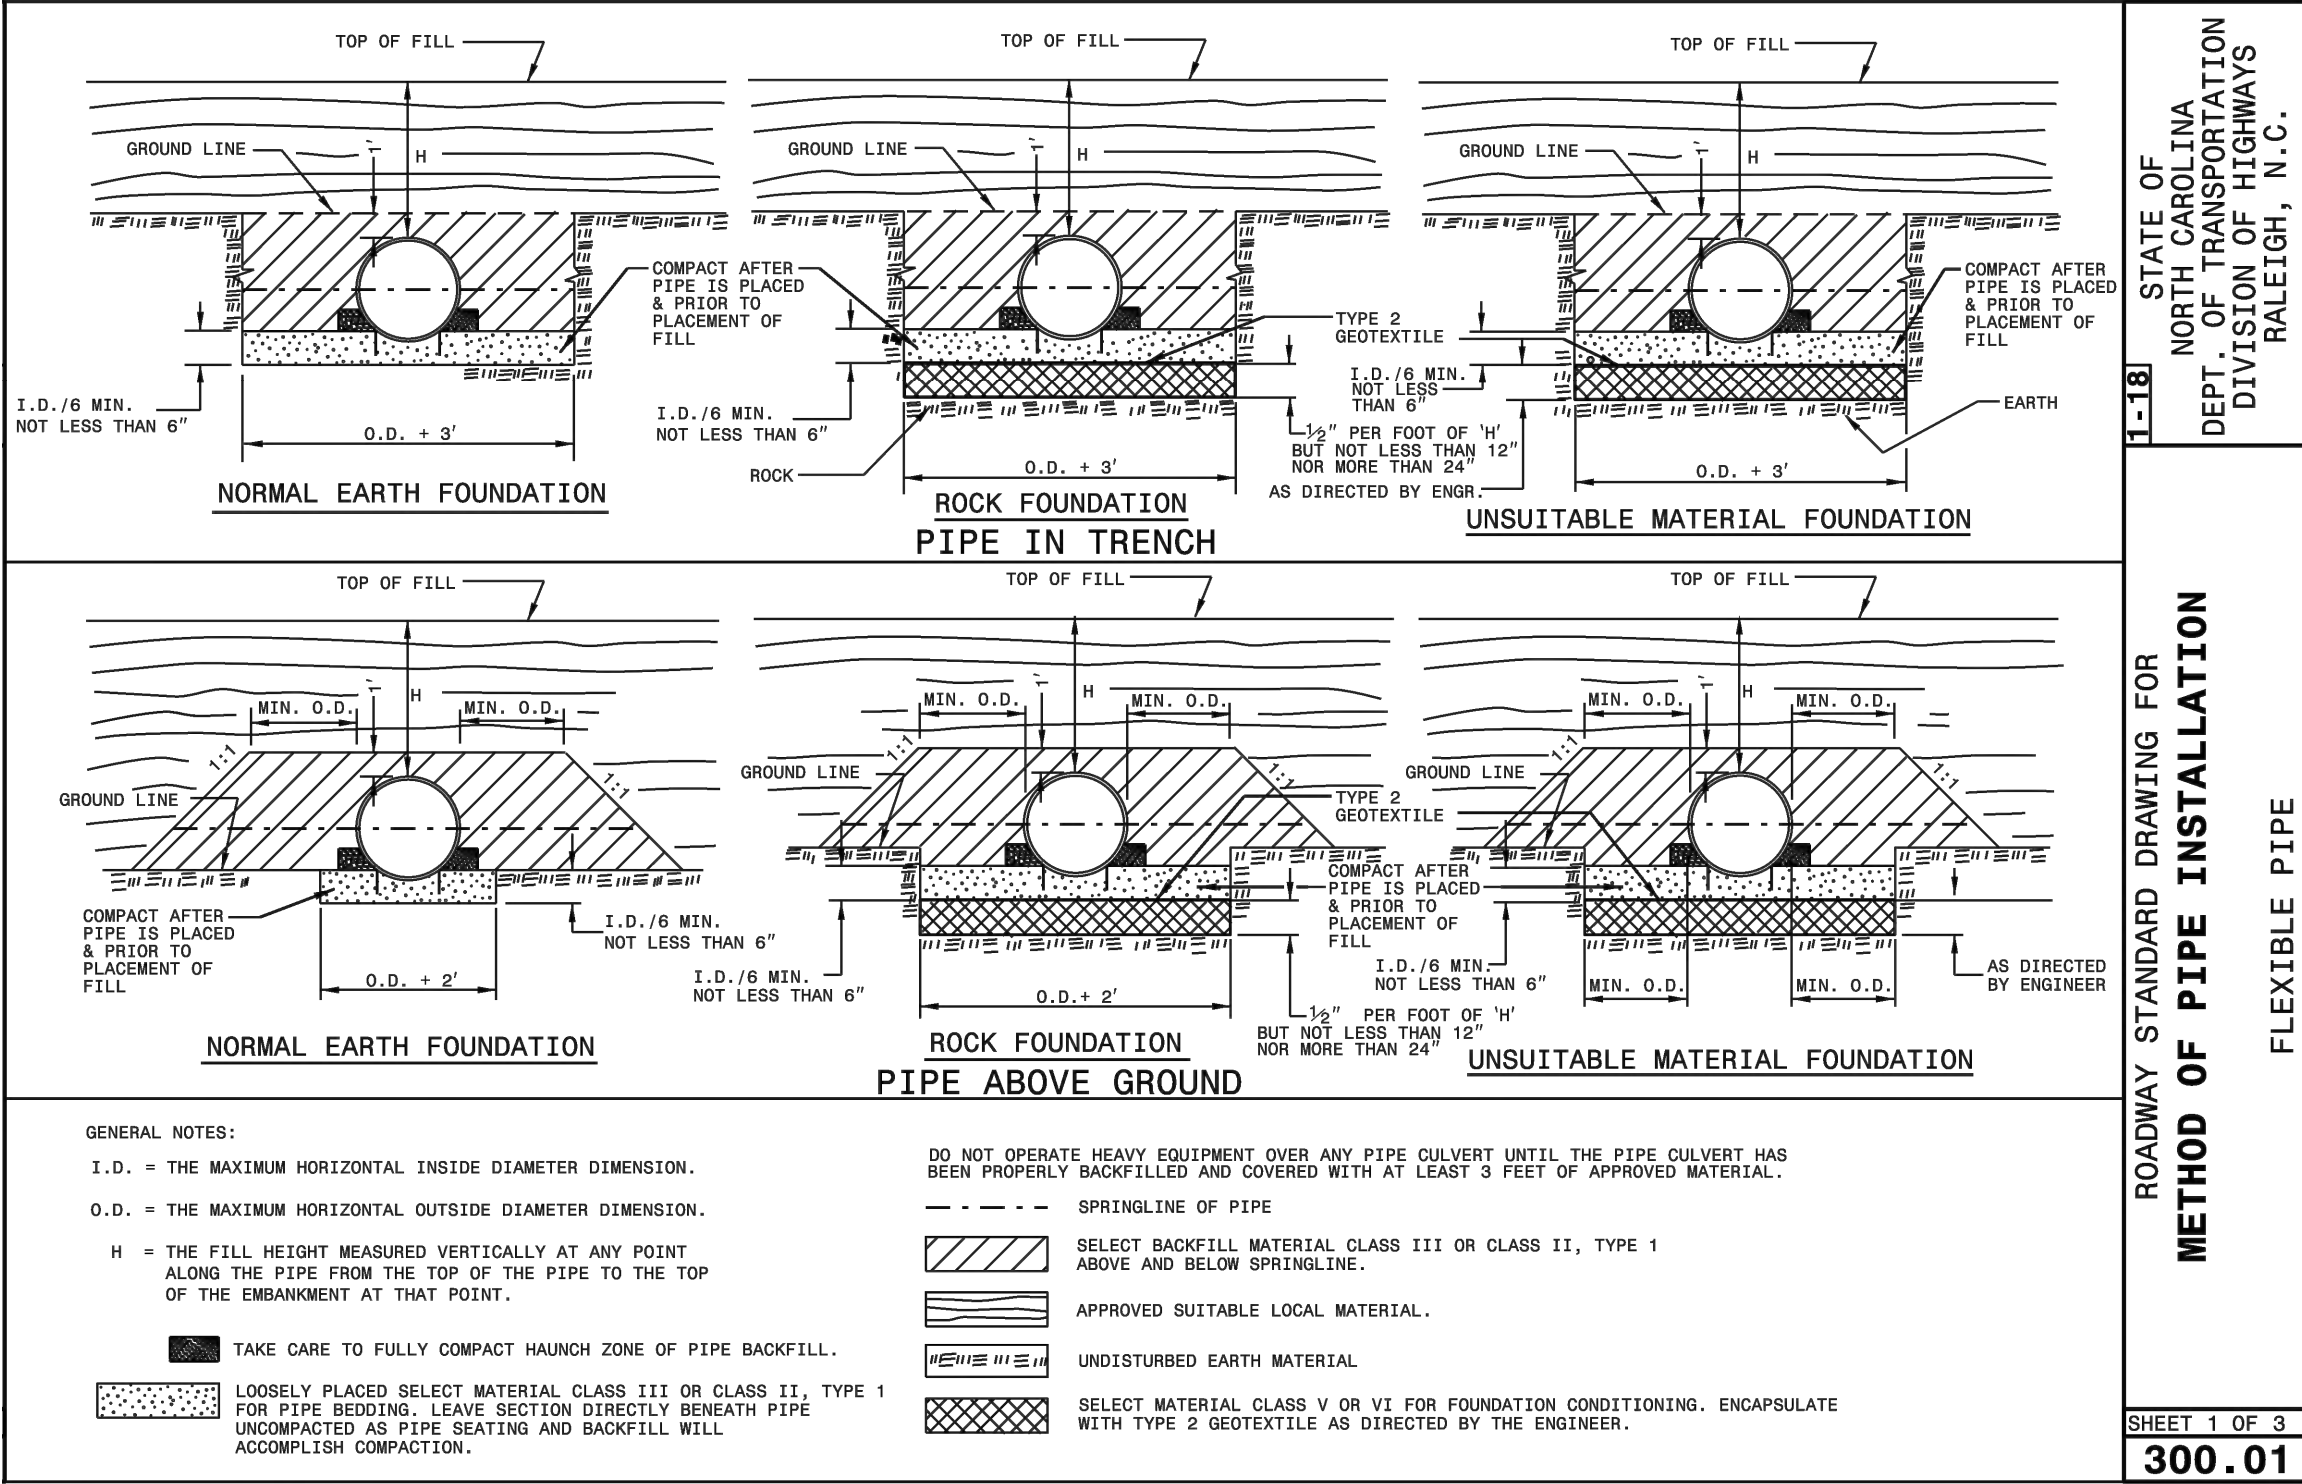


CITY OF RALEIGH - PLANS AUTHORIZED FOR CONSTRUCTION


Electronic Approval: This approval is being issued electronically. This approval is valid only upon the signature of a City of Raleigh Review Officer below. The City will retain a copy of the approved plans. Any work authorized by this approval must proceed in accordance with the plans kept on file with the City. This electronic approval may not be edited once issued. Any modification to this approval once issued will invalidate this approval.

City of Raleigh Development Approval _____

Raleigh Water Review Officer

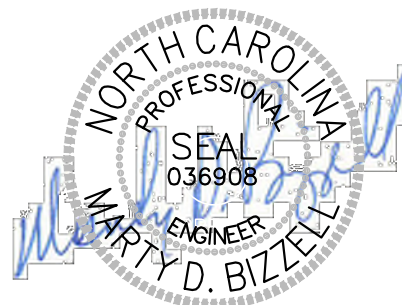

04/20/22

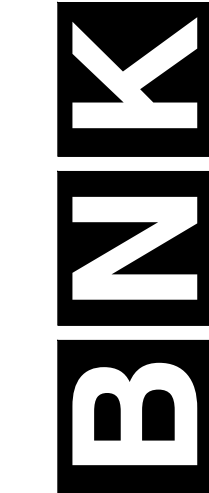

BASS, NIXON & KENNEDY, INC.
CONSULTING ENGINEERS
6310 COBBLE HILL ROAD, SUITE 250, RALEIGH, NC 27607
TELEPHONE: (919) 881-4422 FAX: (919) 881-6868
CERTIFICATION NUMBERS: NCBELS (C-0110); NCBOLA (C-0267)

NO.	DATE	DESCRIPTION	BY


PROGRESS	MM	DATE	DRAWN BY
03-19157			
JOB NO.			

COBBLESTONE VILLAGE
MIXED USE DEVELOPMENT
TOWN OF ROLESVILLE, WAKE COUNTY, NORTH CAROLINA

SHEET
C5.6

8/17/99

2/7/2022
U:\Roadway\Proj\U-6241_Rdu_psh10.dgn
thope

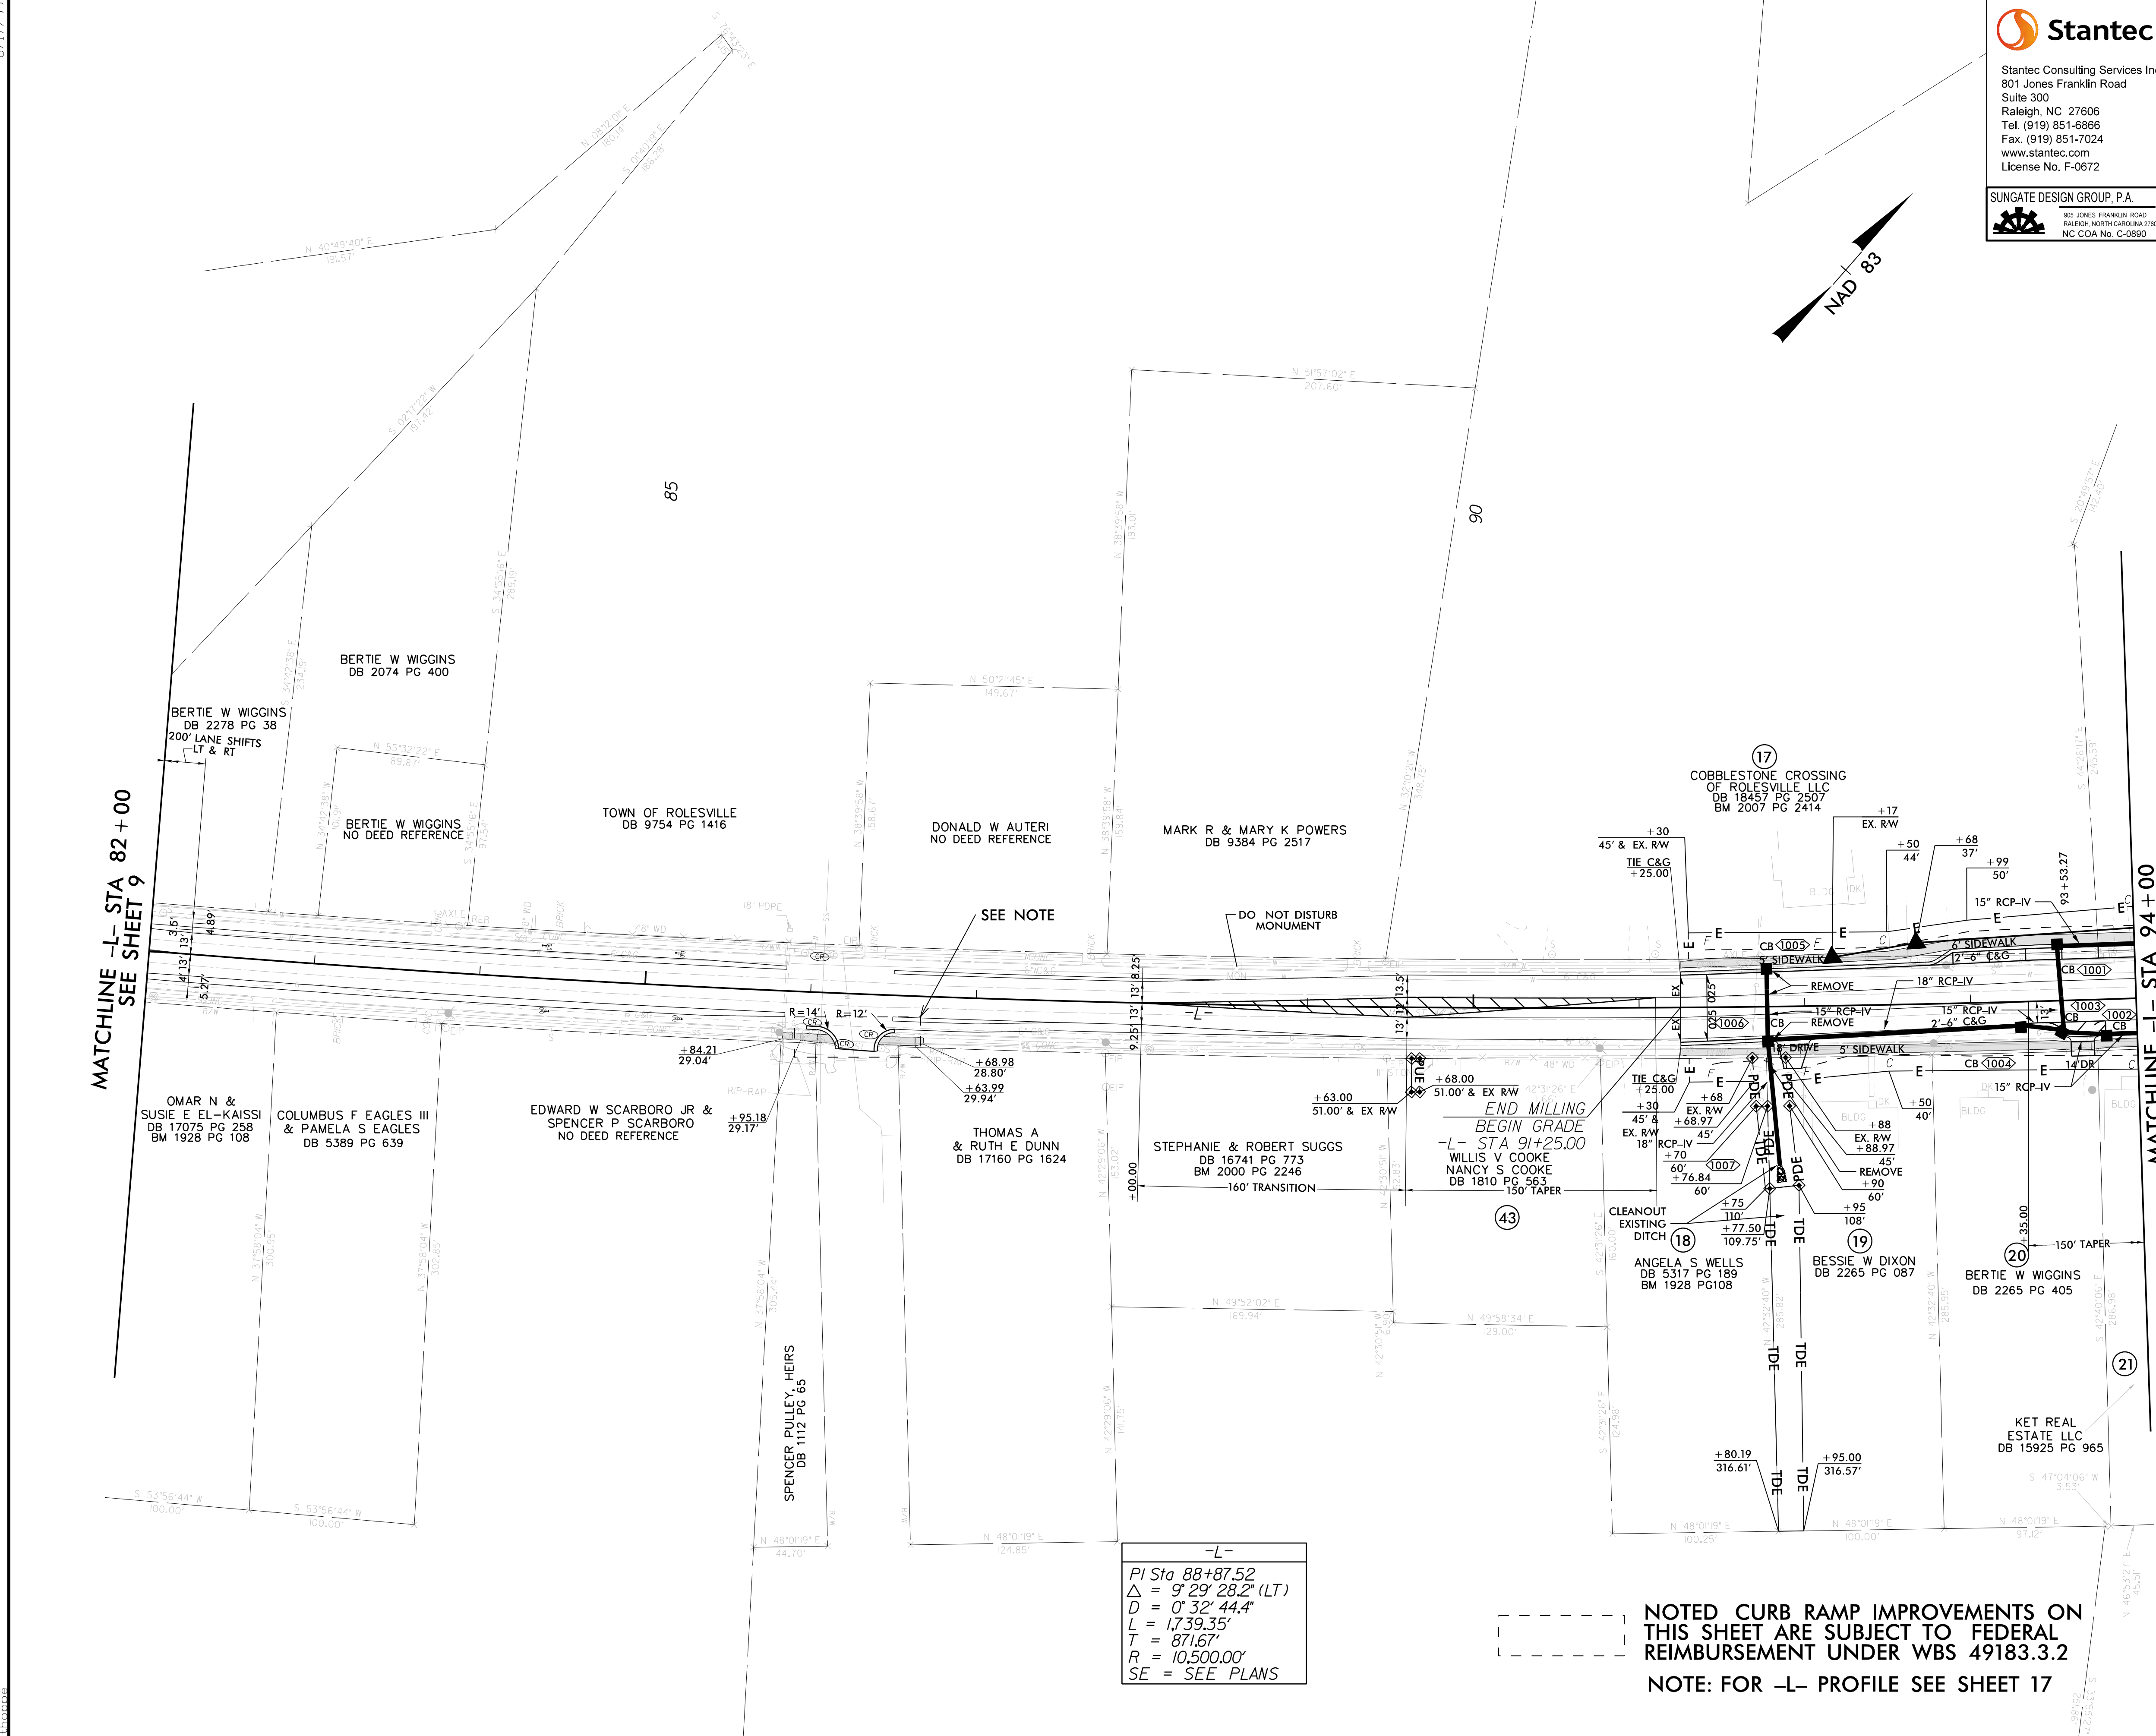

Stantec

Stantec Consulting Services Inc.
801 Jones Franklin Road
Suite 300
Raleigh, NC 27606
Tel. (919) 851-6866
Fax. (919) 851-7024
www.stantec.com
License No. F-0672

SUNGATE DESIGN GROUP, P.A.
805 JONES FRANKLIN ROAD
RALEIGH, NORTH CAROLINA 27605
NC COA No. C-0890


PROJECT REFERENCE NO. <i>U-6241</i>		SHEET NO. <i>10</i>	
RW SHEET NO.		HYDRAULICS ENGINEER	
ROADWAY DESIGN ENGINEER		HYDRAULICS ENGINEER	
2/10/2022		2/10/2022	
DOCUMENT NOT CONSIDERED FINAL UNLESS ALL SIGNATURES COMPLETED			

-L-
PI Sta 88+87.52
Δ = 9' 29" 28.2" (LT)
D = 0' 32" 44.4"
L = 1,739.35'
T = 871.67'
R = 10,500.00'
SE = SEE PLANS

NOTED CURB RAMP IMPROVEMENTS ON
THIS SHEET ARE SUBJECT TO FEDERAL
REIMBURSEMENT UNDER WBS 49183.3.2
NOTE: FOR -L- PROFILE SEE SHEET 17

8/17/99

2/8/2022
L:\Projects\2022\U-6241\Roadway\Pro\U-6241_Rd\U-6241.dgn

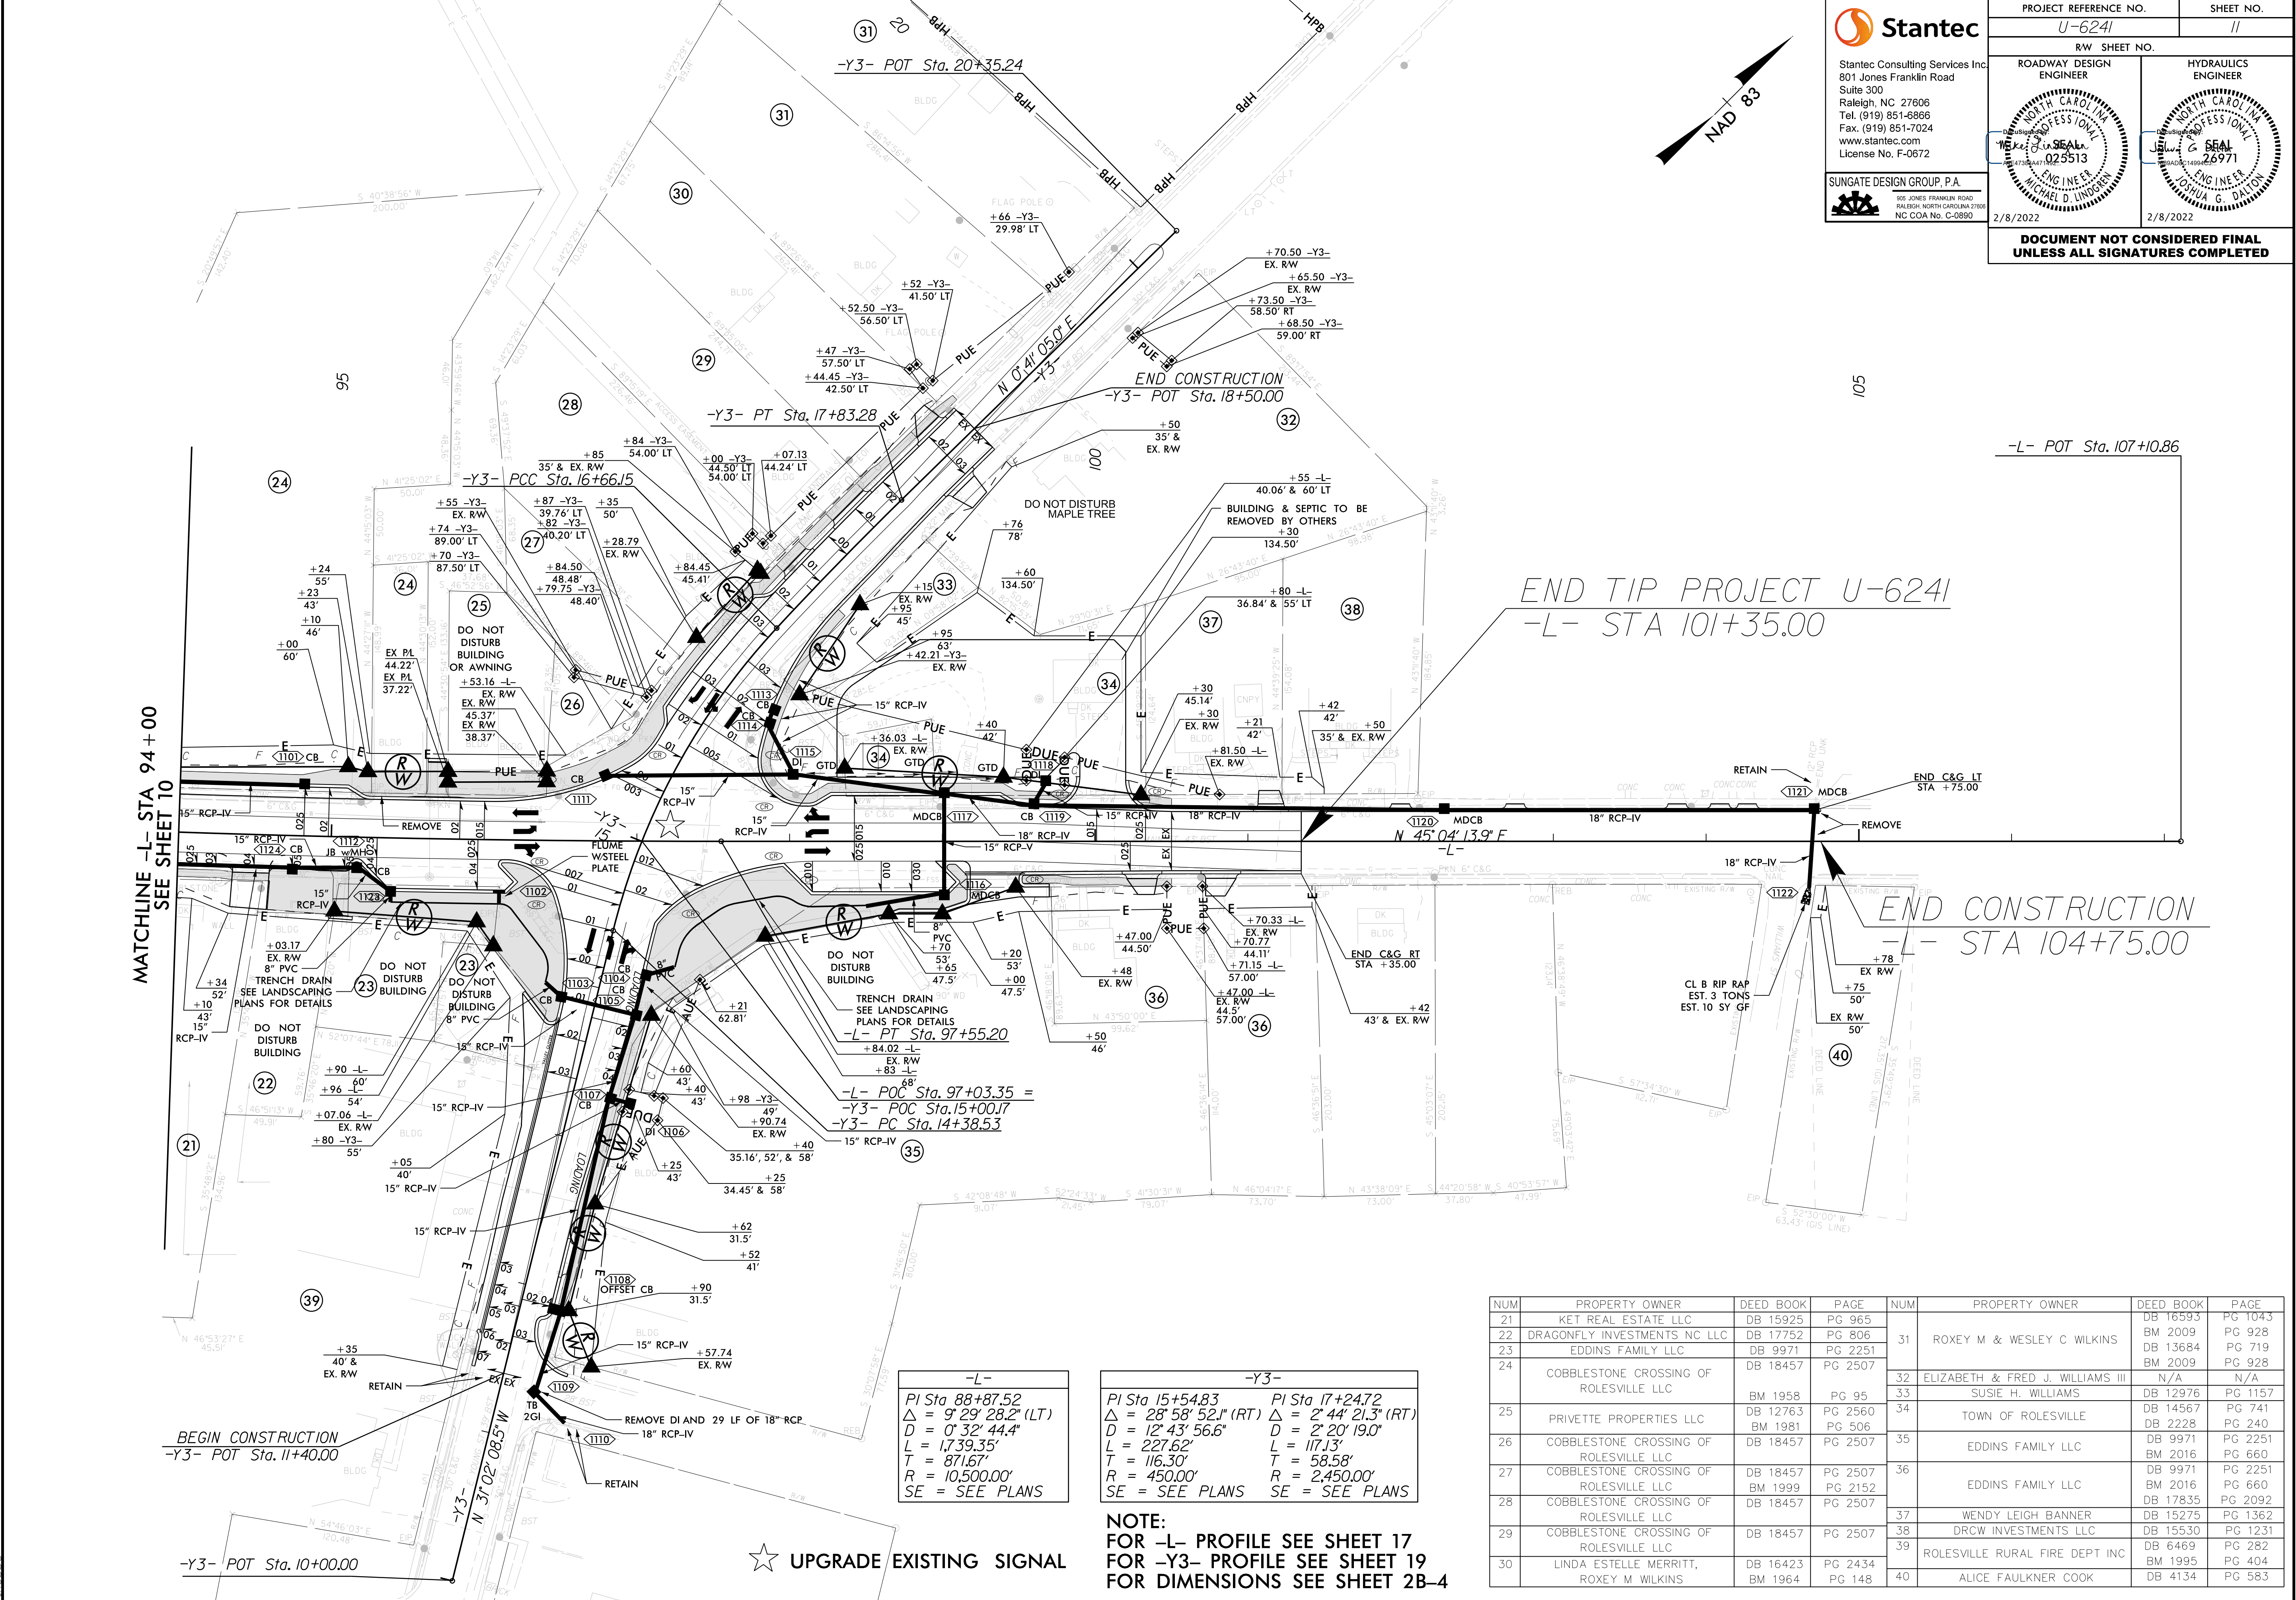

Stantec

Stantec Consulting Services Inc.
801 Jones Franklin Road
Suite 300
Raleigh, NC 27606
Tel. (919) 851-6866
Fax. (919) 851-7024
www.stantec.com
License No. F-0672

SUNGATE DESIGN GROUP, P.A.
805 JONES FRANKLIN ROAD
RALEIGH, NORTH CAROLINA 27606
NC COA No. C-0890

PROJECT REFERENCE NO. U-6241		SHEET NO. 11	
RW SHEET NO.		HYDRAULICS ENGINEER	
ROADWAY DESIGN ENGINEER		ENGINEER	
2/8/2022		2/8/2022	
DOCUMENT NOT CONSIDERED FINAL UNLESS ALL SIGNATURES COMPLETED			

NUM	PROPERTY OWNER	DEED BOOK	PAGE	NUM	PROPERTY OWNER	DEED BOOK	PAGE
21	KET REAL ESTATE LLC	DB 15925	PG 965	31	ROXEY M & WESLEY C WILKINS	DB 16593	PG 1043
22	DRAGONFLY INVESTMENTS NC LLC	DB 17752	PG 806			BM 2009	PG 928
23	EDDINS FAMILY LLC	DB 9971	PG 2251			DB 13684	PG 719
24	COBBLESTONE CROSSING OF ROLESVILLE LLC	DB 18457	PG 2507	32	ELIZABETH & FRED J. WILLIAMS III	DB 2009	PG 928
		BM 1958	PG 95			N/A	N/A
				33	SUSIE H. WILLIAMS	DB 12976	PG 1157
25	PRIVETTE PROPERTIES LLC	DB 12763	PG 2560	34	TOWN OF ROLESVILLE	DB 14567	PG 741
		BM 1981	PG 506			BM 2009	PG 240
26	COBBLESTONE CROSSING OF ROLESVILLE LLC	DB 18457	PG 2507	35	EDDINS FAMILY LLC	DB 9971	PG 2251
27	COBBLESTONE CROSSING OF ROLESVILLE LLC	DB 18457	PG 2507			BM 2016	PG 660
28	COBBLESTONE CROSSING OF ROLESVILLE LLC	BM 1999	PG 2152	36	EDDINS FAMILY LLC	DB 9971	PG 2251
29	COBBLESTONE CROSSING OF ROLESVILLE LLC	DB 18457	PG 2507			BM 2016	PG 660
						DB 17835	PG 2092
				37	WENDY LEIGH BANNER	DB 15275	PG 1362
				38	DRWC INVESTMENTS LLC	DB 15530	PG 1231
30	LINDA ESTELLE MERRITT, ROXEY M WILKINS	DB 16423	PG 2434	39	ROLESVILLE RURAL FIRE DEPT INC	DB 6469	PG 282
		BM 1964	PG 148			BM 1995	PG 404
				40	ALICE FAULKNER COOK	DB 4134	PG 583

NOTE:
FOR -L- PROFILE SEE SHEET 17
FOR -Y3- PROFILE SEE SHEET 19
FOR DIMENSIONS SEE SHEET 28-4