

G:\NCA\Projects\Lennar\8430-03 - lennar - school street - rolesville03 - DWG\plansheets\On-Site\CO-0 - COVR.dwg Layout: CO-0 Plotted: 6/1/2023 4:40:28 PM

SITE DATA TABLE		
OWNER	W. HAROLD PARKER JR./ ROLESVILLE DEVELOPMENT, LLC	
DEVELOPER	LENNAR OF CAROLINAS, LLC	
PIN #	AREA (SF)	AREA (AC)
1758988411	2,592,300	59.51
1758983710	17,121	0.39
1758884270 E	310,215	7.12
1758884270 W	865,243	19.86
GROSS AREA	3,784,879	86.89
PARCEL A - PARK EXPANSION AREA	65,340	1.50
NET AREA	3,719,539	85.39
PREVIOUS ZONING	RL	
USE	VACANT / AG	
FUTURE LAND USE DESIGNATION (ROLESVILLE COMP PLAN)	HDR	
CURRENT ZONING	RH/RM CLUSTER CONDITIONAL	
PROPOSED USE	RESIDENTIAL	
SETBACKS MINIMUM RM (CLUSTER) SINGLE-FAMILY DETACHED		
FRONT	20'	
SIDE	5'	
CORNER SIDE	10'	
REAR	20'	
MIN FRONT LOT WIDTH	40'	
MIN LOT AREA	5,000 SF	
MIN LOT AREA PROPOSED:	5,021 SF	
RM-CZ CLUSTER (SINGLE FAMILY DETACHED)		
	AREA (SF)	AREA (AC)
FINAL TRACT AREA	2,521,614	57.89
TOTAL UNITS	161	
PROPOSED DENSITY (DU/AC)	2.8	
MAXIMUM DENSITY (DU/AC)	5	
PUBLIC GREENWAY (EST. 30' ESTM WIDTH)	150,754	3.46
CLUSTER OPEN SPACE PROVIDED 12%	252,161	5.79
PROVIDED OPEN SPACE	1,431,382	32.86
SETBACKS MINIMUM RH - CZ (TOWNHOMES)		
FRONT	15'	
PARKING SETBACK FOR TOWNHOMES*	19'	
BUILDING SEPARATION	30'	
SIDE	10'	
CORNER SIDE	15'	
REAR	15'	
MIN FRONT LOT WIDTH	20'	
MIN LOT AREA	2,000 SF	
MIN LOT AREA PROPOSED:	2,054 SF	
RH-CZ (TOWNHOMES)		
	AREA (SF)	AREA (AC)
FINAL TRACT AREA	1,197,925	27.50
LOT AREA	330,922	7.60
TOTAL UNITS	114	
PROPOSED DENSITY (DU/AC)	4.1	

OPEN SPACE

RM ZONING DISTRICT (SINGLE-FAMILY DETACHED)

TOTAL AREA = 57.8 AC

REQUIRED OPEN SPACE (12%) = 6.94 AC

REQUIRED ACTIVE OPEN SPACE (50% OF TOTAL OPEN SPACE) = 3.47 AC

RH ZONING DISTRICT (TOWNHOMES)

TOTAL AREA = 27.47 AC

REQUIRED OPEN SPACE (15%) = 4.12 AC

REQUIRED ACTIVE OPEN SPACE (50% OF TOTAL OPEN SPACE) = 2.06 AC

	REQUIRED	PROPOSED
TOTAL OPEN SPACE:	9.90 AC	32.86 AC
ACTIVE OPEN SPACE (50%):	4.95 AC	5.30 AC

*NOTE: PASSIVE OPEN SPACE INCLUDES ALL LAND OUTSIDE OF LOTS AND ROADS OTHER THAN ACTIVE OPEN SPACE

PARKING CALCULATIONS									
WEST SIDE	# UNITS	SINGLE DW	DOUBLE DW	DRIVEWAY TOTAL SF	GUEST	TOTAL REQD	OFFSITE REQD	TOTAL PROVIDED	
STREET	38	24	14	52	10	86	34	91	
ALLEY 2	8	0	8	16	2	18	2	18	
ALLEY 3	9	0	9	18	3	21	3	21	
EAST SIDE									
A	13	7	6	19	4	30	11		
ALLEY 4	12	0	12	24	3	27	3		
ALLEY 1	20	0	20	40	5	45	5		
C	14	8	6	20	4	32	12		
FUTURE CLUBHOUSE*						6			
TOTAL				103		140	37	140	

PARKING REQUIRED IS 2/DU + 0.25 GUEST SPACES /DU

*PROPOSED CLUBHOUSE IS 1,000 SF & MINIMUM PARKING IS 5 + 1/1000 SF FOR OUTDOOR RECREATION ROUNDED UP.


PARKER RIDGE SUBDIVISION ZONING CONDITIONS

- DEVELOPMENT OF THE PROPERTY SHALL BE IN SUBSTANTIAL CONFORMANCE WITH THE ACCOMPANYING EXHIBIT C CONCEPT PLAN. LOCATIONS SHOWN FOR COMMITTED ELEMENTS INCLUDING, BUT NOT LIMITED TO GREENWAYS, STREETS, AND OPEN AREAS SHOWN ON EXHIBIT C, ARE CONCEPTUAL AND PROVIDED FOR ILLUSTRATION AND CONTEXT ONLY. FINAL LOCATIONS OF ELEMENTS SHALL BE DETERMINED AT SUBSEQUENT STAGES OF APPROVAL. DEVELOPER SHALL BE ENTITLED TO A CREDIT AGAINST THE PROJECT'S PARKS AND RECREATION FEES FOR THE COSTS TO CONSTRUCT PUBLIC GREENWAYS.
- THE FOLLOWING USES SHALL BE PROHIBITED ON THE PORTION OF THE PROPERTY ZONED RESIDENTIAL HIGH DENSITY (THE "RH PARCEL"):
 - LIVE-WORK UNIT
 - RESIDENTIAL CARE (A.F., I.F., C.F.)
 - TELECOMMUNICATIONS TOWER
- THE RH PARCEL SHALL HAVE A MAXIMUM OF 120 TOWNHOUSE DWELLINGS.
- THE FOLLOWING USES SHALL BE PROHIBITED ON THE PORTION OF THE PROPERTY ZONED RESIDENTIAL MEDIUM DENSITY (THE "RM PARCEL"):
 - TELECOMMUNICATIONS TOWER
- THE RM PARCEL SHALL HAVE A MAXIMUM OF 170 SINGLE-FAMILY DETACHED DWELLINGS.
- A SINGLE FAMILY DETACHED HOME SHALL BE DEVELOPED AND DONATED AS PART OF WOUNDED WARRIOR HOMES. OPERATION COMING HOME, OPERATION FINALLY HOME, OR SIMILAR ORGANIZATION PROVIDING HOMES TO VETERANS. DEVELOPER SHALL BE ENTITLED TO A WAIVER OF ALL TOWN OF ROLESVILLE PERMIT FEES FOR THIS HOME.
- THE DEVELOPMENT SHALL INCLUDE AT LEAST ONE POLLINATOR GARDEN. THE POLLINATOR GARDEN SHALL BE A LANDSCAPED GARDEN IN WHICH AT LEAST SEVENTY FIVE PERCENT (75%) OF ALL PLANTS, EXCLUDING GRASSES, ARE NATIVE MILKWEEDS AND OTHER NECTAR-RICH FLOWERS.
- PERMITTER BUFFERS SHALL BE PROVIDED AS SHOWN ON THE CONCEPT PLAN. TYPE 3 AND TYPE 4 PERMITTER BUFFERS MAY INCLUDE 6' FENCES INSTEAD OF WALLS.
- ALL SINGLE FAMILY DETACHED DWELLINGS SHALL HAVE THE FOLLOWING FEATURES:
 - A 2 CAR GARAGE;
 - ALL GARAGE DOORS SHALL HAVE WINDOWS;
 - GROUND FLOOR ELEVATION AT THE FRONT DOOR SHALL BE A MINIMUM OF 12" ABOVE AVERAGE GRADE ACROSS THE FRONT FACADE OF THE HOUSE;
 - A MINIMUM 24" STONE OR MASONRY WATER TABLE ALONG THE FRONT ELEVATION;
 - IF MASONRY IS NOT THE PREDOMINANT FIRST FLOOR FINISH, THEN THE FRONT ELEVATION SHALL HAVE 2 TYPES OF SIDING. FOR EXAMPLE, HORIZONTAL SIDING MAY BE COMBINED WITH SHAKEBOARD AND BATTEN;
 - ROOF PITCHES ON THE MAIN ROOF WILL HAVE A PITCH BETWEEN 5 ON 12 AND 12 ON 12;
 - ROOF MATERIALS SHALL BE ASPHALT SHINGLES, METAL, COPPER OR WOOD;
 - A MINIMUM 12" FRONT OVERHANG;
 - A COVERED STOOP OR PORCH AT LEAST 20 SF AND 5 FT DEEP;
 - ALL WINDOWS ON FRONT FACADES SHALL HAVE SHUTTERS OR WINDOW TRIM;
 - A MINIMUM 64 SF REAR PATIO;
 - AT LEAST ONE WINDOW ON EACH SIDE ELEVATION;
- M. NO SINGLE FAMILY DETACHED HOME SHALL BE CONSTRUCTED WITH A FRONT ELEVATION OR COLOR PALETTE THAT IS IDENTICAL TO THE HOME ON EITHER SIDE OF IT OR DIRECTLY ACROSS FROM IT; AND N. A VARIED COLOR PALETTE SHALL BE USED THROUGHOUT THE SUBDIVISION. ALL TOWNHOUSE DWELLINGS SHALL HAVE THE FOLLOWING FEATURES:
 - A 1 OR 2 CAR GARAGE;
 - A MINIMUM 24" STONE OR MASONRY WATER TABLE ALONG THE FRONT ELEVATION;
 - C.F. MASONRY IS NOT THE PREDOMINANT FIRST FLOOR FINISH, THEN THE FRONT ELEVATION SHALL HAVE 2 TYPES OF SIDING. FOR EXAMPLE, HORIZONTAL SIDING MAY BE COMBINED WITH SHAKEBOARD AND BATTEN;
 - ROOF MATERIALS SHALL BE ASPHALT SHINGLES, METAL, COPPER OR WOOD;
 - A MINIMUM 12" FRONT OVERHANG;
 - F. A COVERED STOOP OR PORCH AT LEAST 20 SF AND 5 FT DEEP;
 - G. SHUTTERS OR WINDOW TRIM SHALL BE ON FRONT FACADE WINDOWS;
 - H. A MINIMUM 64 SF REAR PATIO SHALL BE PROVIDED ON FRONT LOADED TOWNHOMES;
 - I. AT LEAST ONE WINDOW ON EACH SIDE ELEVATION (EXCLUDING INTERIOR UNITS);
 - J. NO TOWNHOUSE SHALL BE PAINTED A COLOR THAT IS IDENTICAL TO THE HOME ADJACENT ON EITHER SIDE OF IT; AND
 - K. A VARIED COLOR PALETTE SHALL BE USED THROUGHOUT THE SUBDIVISION.
- THE DEVELOPER SHALL OFFER TO DEDICATE THE SECTION OF LAND LABELED AS "PARCEL - A - TOWN OF ROLESVILLE PARK EXPANSION" ON THE CONCEPT PLAN FOR USE AS A PUBLIC PARK. THIS LAND SHALL COUNT TOWARD OPEN SPACE REQUIREMENTS FOR THE OVERALL DEVELOPMENT.
- THE PROJECT SHALL HAVE A PUBLIC GREENWAY SUBBED TO THE 307 S. MAIN STREET PROPERTY LINE NEAR "ACCESS C" AS SHOWN ON THE "PARKER RIDGE TRAFFIC IMPACT ANALYSIS" PREPARED BY STANTEC CONSULTING SERVICES, INC., DATED FEBRUARY 2, 2023 (THE "TIA"). NOTWITHSTANDING THE FOREGOING, THE PROJECT SHALL NOT HAVE A PUBLIC STREET ACCESS TO SCHOOL STREET.
- DEVELOPER SHALL DESIGN AND CONSTRUCT: (1) THE PUBLIC COLLECTOR STREET IDENTIFIED AS ACCESS D IN THE TIA THAT EXTENDS THE STREET NETWORK WITHIN THE DEVELOPMENT THROUGH WAKE COUNTY PIN 1768-08-8727 (THE "CAMPUS SITE") TO E YOUNG STREET ("ACCESS D ROUTE"); AND (2) A NORTHBOUND LEFT TURN LANE WITH 75 FEET OF FULL-WIDTH STORAGE AND APPROPRIATE TAPER FROM YOUNG STREET TO ACCESS D AS RECOMMENDED BY THE TIA ("TURN LANE"). ACCESS D ROUTE AND TURN LANE ARE COLLECTIVELY REFERRED TO AS THE "YOUNG STREET CONNECTION". THE YOUNG STREET CONNECTION SHALL BE DESIGNED AND CONSTRUCTED TO TOWN OF ROLESVILLE AND NCODT STANDARDS AND ACCESS D SHALL BE LOCATED IN SUBSTANTIAL CONFORMANCE WITH THE CORRIDOR SHOWN IN THE ATTACHED EXHIBIT E. THE STREET SECTION FOR ACCESS D SHALL BE CONSTRUCTED AS SHOWN IN THE ATTACHED EXHIBIT F. DEVELOPER SHALL BE RESPONSIBLE FOR ALL COSTS TO DESIGN AND CONSTRUCT THE YOUNG STREET CONNECTION (THE "COSTS") AND DEVELOPER SHALL BE ENTITLED TO A CREDIT AGAINST THE PROJECT'S TRANSPORTATION IMPACT FEES FOR THE COSTS. CONSTRUCTION OF THE YOUNG STREET CONNECTION SHALL COMMENCE PRIOR TO APPROVAL OF THE 10TH DWELLING UNIT BUILDING PERMIT FOR THE PROJECT AND SHALL BE COMPLETE NOT LATER THAN APPROVAL OF THE 18TH DWELLING UNIT BUILDING PERMIT FOR THE PROJECT.

WHILE IT IS ANTICIPATED THAT THIS CONDITION WILL BE CLARIFIED BY A FORMAL DEVELOPMENT AGREEMENT, REIMBURSEMENT AGREEMENT, OR OTHER WRITTEN AGREEMENT BETWEEN THE DEVELOPER AND THE TOWN, THE ABSENCE OF SUCH A SUBSEQUENT WRITTEN AGREEMENT SHALL NOT BE DEEMED TO INVALIDATE THIS CONDITION. THIS CONDITION IS SUBJECT TO THE FOLLOWING CAVEATS:

- IN THE EVENT THE CAMPUS SITE, AN APPROVED ALIGNMENT WITHIN THE EXHIBIT E CORRIDOR, OR NECESSARY RIGHTS-OF-WAY, EASEMENTS, OR OTHER PROPERTY RIGHTS ARE MADE UNAVAILABLE TO THE PROJECT, THIS CONDITION SHALL BE DEEMED EXTINGUISHED.
- IN THE EVENT THE TOWN COMMENCES DESIGN AND/OR DEVELOPMENT OF ANY PART OF THE YOUNG STREET CONNECTION, THE DEVELOPER'S OBLIGATIONS FOR DESIGN AND/OR DEVELOPMENT, AS APPROPRIATE, FOR THOSE PORTIONS OF THE YOUNG STREET CONNECTION SHALL BE DEEMED EXTINGUISHED. FOR PURPOSES OF CLARITY, DEVELOPER SHALL REMAIN ENTITLED TO A CREDIT AGAINST THE PROJECT'S TRANSPORTATION IMPACT FEES FOR REMAINING COSTS.
- "PROJECT" SHALL MEAN "PARKER RIDGE" AS DESCRIBED BY MA 22-03 AND ANX 22-06.
- "DEVELOPER" SHALL MEAN LENNAR CAROLINAS LLC, AND ITS SUCCESSORS AND ASSIGNS.

SITE LOCATION MAP NOT TO SCALE

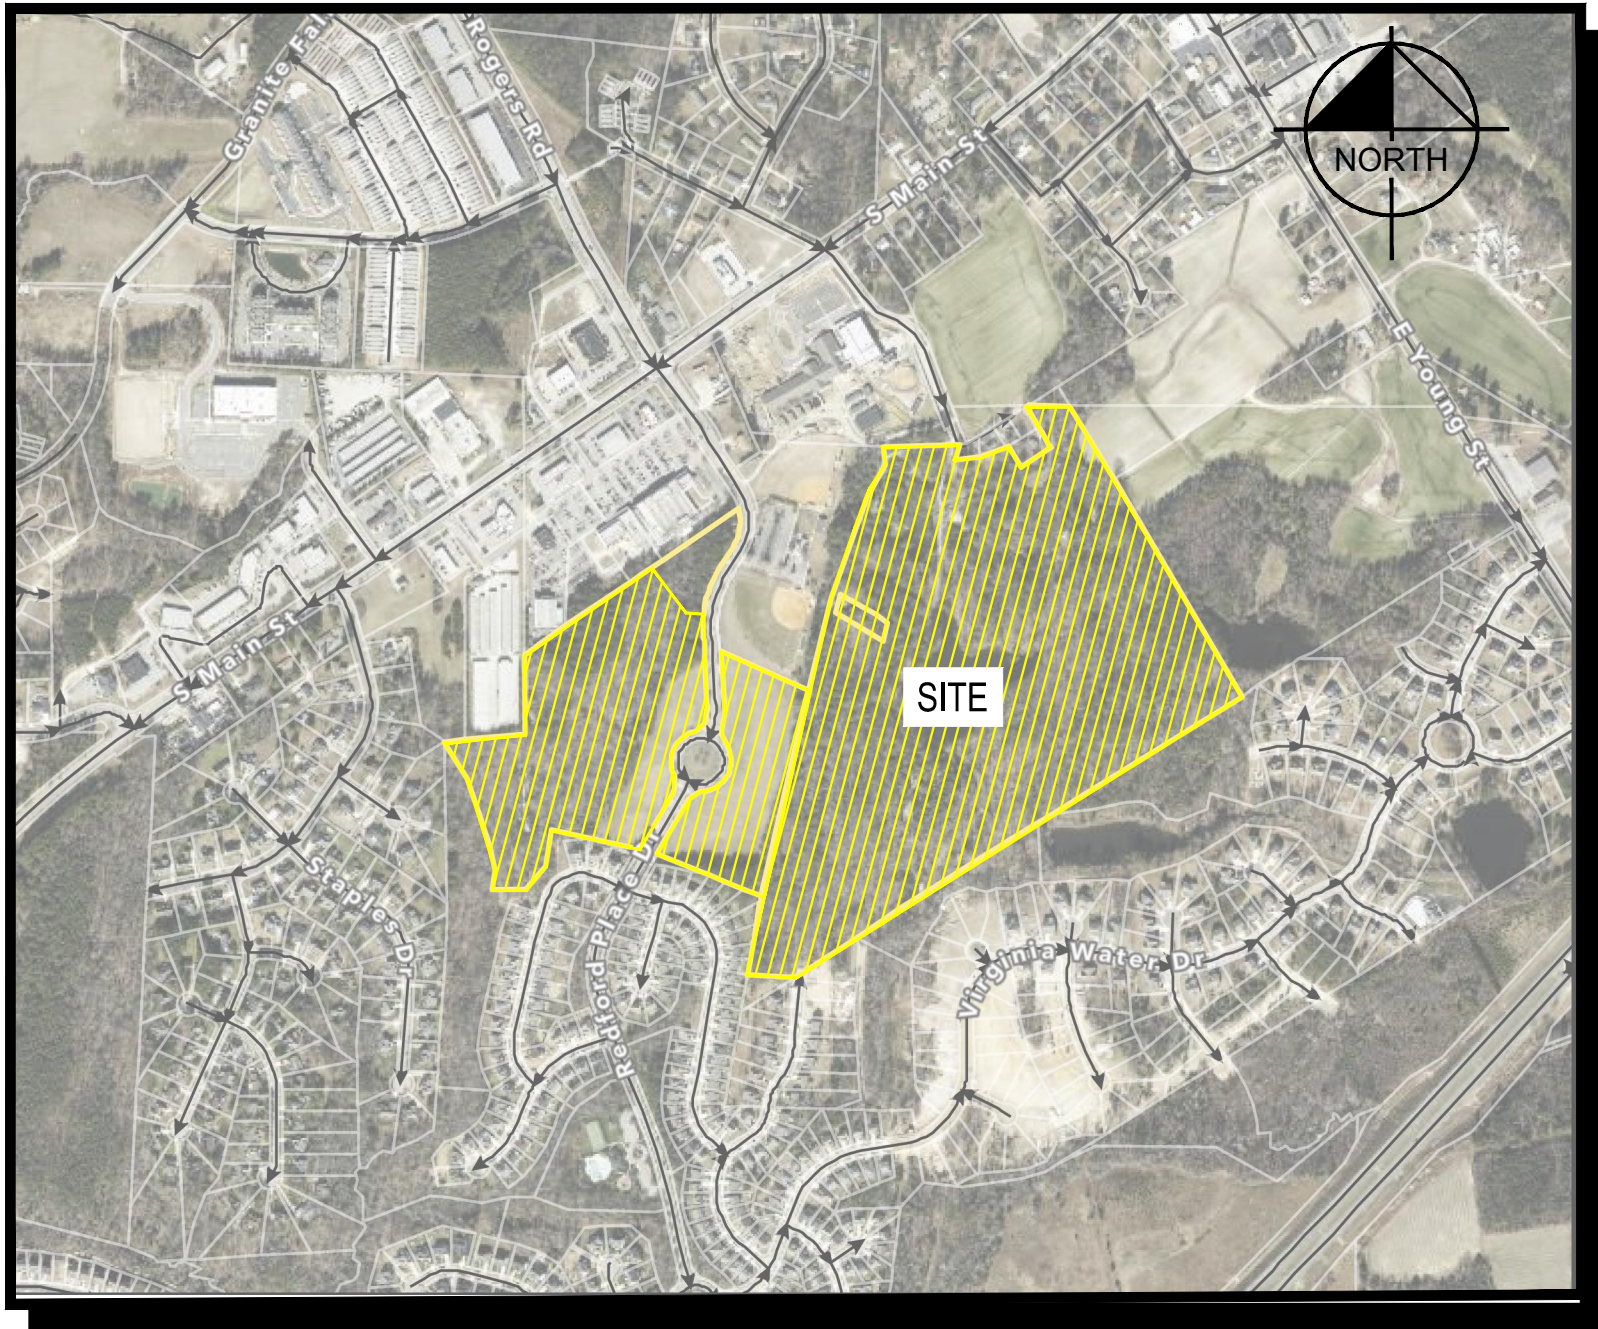

#3- A lighting plan will need to be included with this submittal.

CONSTRUCTION PLANS FOR PARKER RIDGE 82 SCHOOL STREET ROLESVILLE, NORTH CAROLINA 27571

1ST SUBMITTAL: APRIL 3, 2023

2ND SUBMITTAL: JUNE 1, 2023

TOWN OF ROLESVILLE CASE NUMBER: PSP23-02

PREVIOUS REZONING APPLICATION: MA22-03

PSP-23-02

#2- verify this is correct, this is the first CID submittal

#1- Is there a reason why the enlarged demolition plan sheets were taken out? It would be beneficial to show them like they were shown in the PSP 23-02 submittal. If they are not to be included, more demolition information will be needed on other sheets.

SHEET LIST TABLE	
SHEET NUMBER	SHEET TITLE
C0-0	COVER SHEET
C0-1	GENERAL NOTES
C1-0	EXISTING CONDITIONS (1 OF 4)
C1-1	EXISTING CONDITIONS (2 OF 4)
C1-2	EXISTING CONDITIONS (3 OF 4)
C1-3	EXISTING CONDITIONS (4 OF 4)
C1-4	OVERALL DEMOLITION PLAN
C2-0	OVERALL SITE PLAN
C2-1	ENLARGED SITE PLAN (1 OF 6)
C2-2	ENLARGED SITE PLAN (2 OF 6)
C2-3	ENLARGED SITE PLAN (3 OF 6)
C2-4	ENLARGED SITE PLAN (4 OF 6)
C2-5	ENLARGED SITE PLAN (5 OF 6)
C2-6	ENLARGED SITE PLAN (6 OF 6)
C2-7	PHASING PLAN
C3-0	OVERALL UTILITY PLAN
C3-1	ENLARGED UTILITY PLAN (1 OF 6)
C3-2	ENLARGED UTILITY PLAN (2 OF 6)
C3-3	ENLARGED UTILITY PLAN (3 OF 6)
C3-4	ENLARGED UTILITY PLAN (4 OF 6)
C3-5	ENLARGED UTILITY PLAN (5 OF 6)
C3-6	ENLARGED UTILITY PLAN (6 OF 6)
C4-0	OVERALL GRADING PLAN
C4-1	ENLARGED GRADING PLAN (1 OF 6)
C4-2	ENLARGED GRADING PLAN (2 OF 6)
C4-3	ENLARGED GRADING PLAN (3 OF 6)
C4-4	ENLARGED GRADING PLAN (4 OF 6)
C4-5	ENLARGED GRADING PLAN (5 OF 6)
C4-6	ENLARGED GRADING PLAN (6 OF 6)
C5-0	OVERALL PHASE 1 EROSION CONTROL PLAN
C5-1	ENLARGED PHASE 1 EROSION CONTROL PLAN (1 OF 6)
C5-2	ENLARGED PHASE 1 EROSION CONTROL PLAN (2 OF 6)
C5-3	ENLARGED PHASE 1 EROSION CONTROL PLAN (3 OF 6)
C5-4	ENLARGED PHASE 1 EROSION CONTROL PLAN (4 OF 6)
C5-5	ENLARGED PHASE 1 EROSION CONTROL PLAN (5 OF 6)
C5-6	ENLARGED PHASE 1 EROSION CONTROL PLAN (6 OF 6)
C5-7	OVERALL PHASE 2 EROSION CONTROL PLAN
C5-8	ENLARGED PHASE 2 EROSION CONTROL PLAN (1 OF 6)
C5-9	ENLARGED PHASE 2 EROSION CONTROL PLAN (2 OF 6)
C5-10	ENLARGED PHASE 2 EROSION CONTROL PLAN (3 OF 6)
C5-11	ENLARGED PHASE 2 EROSION CONTROL PLAN (4 OF 6)
C5-12	ENLARGED PHASE 2 EROSION CONTROL PLAN (5 OF 6)
C5-13	ENLARGED PHASE 2 EROSION CONTROL PLAN (6 OF 6)
C6-0	STREET A PLAN AND PROFILE

C6-1	STREET B PLAN AND PROFILE
C6-2	STREET C PLAN AND PROFILE (1 OF 2)
C6-3	STREET C PLAN AND PROFILE (2 OF 2)
C6-4	STREET D PLAN AND PROFILE
C6-5	STREET E PLAN AND PROFILE
C6-6	STREET F PLAN AND PROFILE
C6-7	STREET G PLAN AND PROFILE
C6-8	STREET H PLAN AND PROFILE
C6-9	LONG MELFORD DRIVE PLAN AND PROFILE (1 OF 5)
C6-10	LONG MELFORD DRIVE PLAN AND PROFILE (2 OF 5)
C6-11	LONG MELFORD DRIVE PLAN AND PROFILE (3 OF 5)
C6-12	LONG MELFORD DRIVE PLAN AND PROFILE (4 OF 5)
C6-13	LONG MELFORD DRIVE PLAN AND PROFILE (5 OF 5)
C6-14	ALLEY 1 PLAN AND PROFILE
C6-15	ALLEY 2 PLAN AND PROFILE
C6-16	ALLEY 3 PLAN AND PROFILE
C6-17	ALLEY 4 PLAN AND PROFILE
C6-18	GW1A GREENWAY PLAN AND PROFILE (1 OF 2)
C6-19	GW1A GREENWAY PLAN AND PROFILE (2 OF 2)
C6-20	GW1B GREENWAY PLAN AND PROFILE (1 OF 2)
C6-21	GW1B GREENWAY PLAN AND PROFILE (2 OF 2)
C6-22	GW2 GREENWAY PLAN AND PROFILE (1 OF 2)
C6-23	GW2 GREENWAY PLAN AND PROFILE (2 OF 2)
C6-24	GW3 GREENWAY PLAN AND PROFILE (1 OF 1)
C6-25	GW4 GREENWAY PLAN AND PROFILE (1 OF 2)
C6-26	GW4 GREENWAY PLAN AND PROFILE (2 OF 2)
C7-0	SCM 1 PLAN AND PROFILE
C7-1	SCM 2 PLAN AND PROFILE
C7-2	SCM 3 PLAN AND PROFILE
C7-3	SCM 4 PLAN AND PROFILE
C8-2	EROSION CONTROL DETAILS (1 OF 2)
C8-3	EROSION CONTROL DETAILS (2 OF 2)
C8-4	SEWER DETAIL
C8-5	STORM-DETAIL
C8-6	WATER DETAIL (1 OF 2)
C8-7	WATER DETAIL (2 OF 2)
C9-0	OPEN SPACE PLAN
L1-0	OVERALL LANDSCAPE PLAN
L1-1	ENLARGED LANDSCAPE PLAN (1 OF 6)
L1-2	ENLARGED LANDSCAPE PLAN (2 OF 6)
L1-3	ENLARGED LANDSCAPE PLAN (3 OF 6)
L1-4	ENLARGED LANDSCAPE PLAN (4 OF 6)
L1-5	ENLARGED LANDSCAPE PLAN (5 OF 6)
L1-6	ENLARGED LANDSCAPE PLAN (6 OF 6)
L1-7	SCM PLANTINGS
L1-8	LANDSCAPE DETAILS

Public
Water Distribution / Extension System
The City of Raleigh consents to the correction and extension of the City's public water system as shown on this plan. The material and construction methods used for this project shall conform to the standards and specifications of the City's Public Utilities Handbook.
City of Raleigh
Public Utilities Department Permit # _____
Authorization to Construct: _____
Date: _____

Public
Sewer Collection / Extension System
The City of Raleigh consents to the correction and extension of the City's public sewer system as shown on this plan. The material and construction methods used for this project shall conform to the standards and specifications of the City's Public Utilities Handbook.
City of Raleigh
Public Utilities Department Permit # _____
Authorization to Construct: _____
Date: _____

EROSION CONTROL, STORMWATER AND FLOODPLAIN MANAGEMENT
APPROVED
EROSION CONTROL ☐ S-
STORMWATER MGMT. ☐ S-
FLOOD STUDY ☐ S-
DATE: _____
ENVIRONMENTAL CONSULTANT SIGNATURE

ATTENTION CONTRACTORS
The Construction Contractor responsible for the extension of water, sewer, and/or reuse, as approved in these plans, is responsible for contacting the **Public Utilities Department** at (919) 996-4540 at least **twenty four hours** prior to beginning any of their construction.
Failure to notify both City Departments in advance of beginning construction, will result in the issuance of **monetary fines**, and require reinstallation of any water or sewer facilities not inspected as a result of this notification failure.

Failure to call for **Inspection. Install a Downstream Plug**, have **Permitted Plans** on the **Jobite**, or any other **Violation of City of Raleigh Standards** will result in a **Fine and Possible Exclusion** from future work in the **City of Raleigh**.

EROSION AND SEDIMENT CONTROL

APPROVED PLAN
DATE _____
PERMIT NO. S- _____
Wake County Environmental Services
Sedimentation & Erosion Control
919-856-7400
ENVIRONMENTAL CONSULTANT SIGNATURE

ENVIRONMENTAL CONSULTANT SIGNATURE



DESIGNED BY: DF/CD

DRAWN BY: DF/JWM

REVIEWED BY: DF

5440 WADE PARK BLVD, SUITE 102
RALEIGH NC 27607
WWW.BGEINC.COM
NC LICENSE #C-4397

LENNAR
CORPORAION

1100 PERIMETER PARK DRIVE, SUITE 112
MORRISVILLE / NORTH CAROLINA / 27560

PARKER RIDGE
82 SCHOOL STREET
ROLESVILLE / NORTH CAROLINA / 27571

COVER SHEET


PRELIMINARY

NOT FOR CONSTRUCTION

FILE NUMBER:
8430-03

DATE: 06/01/2023

C0-0

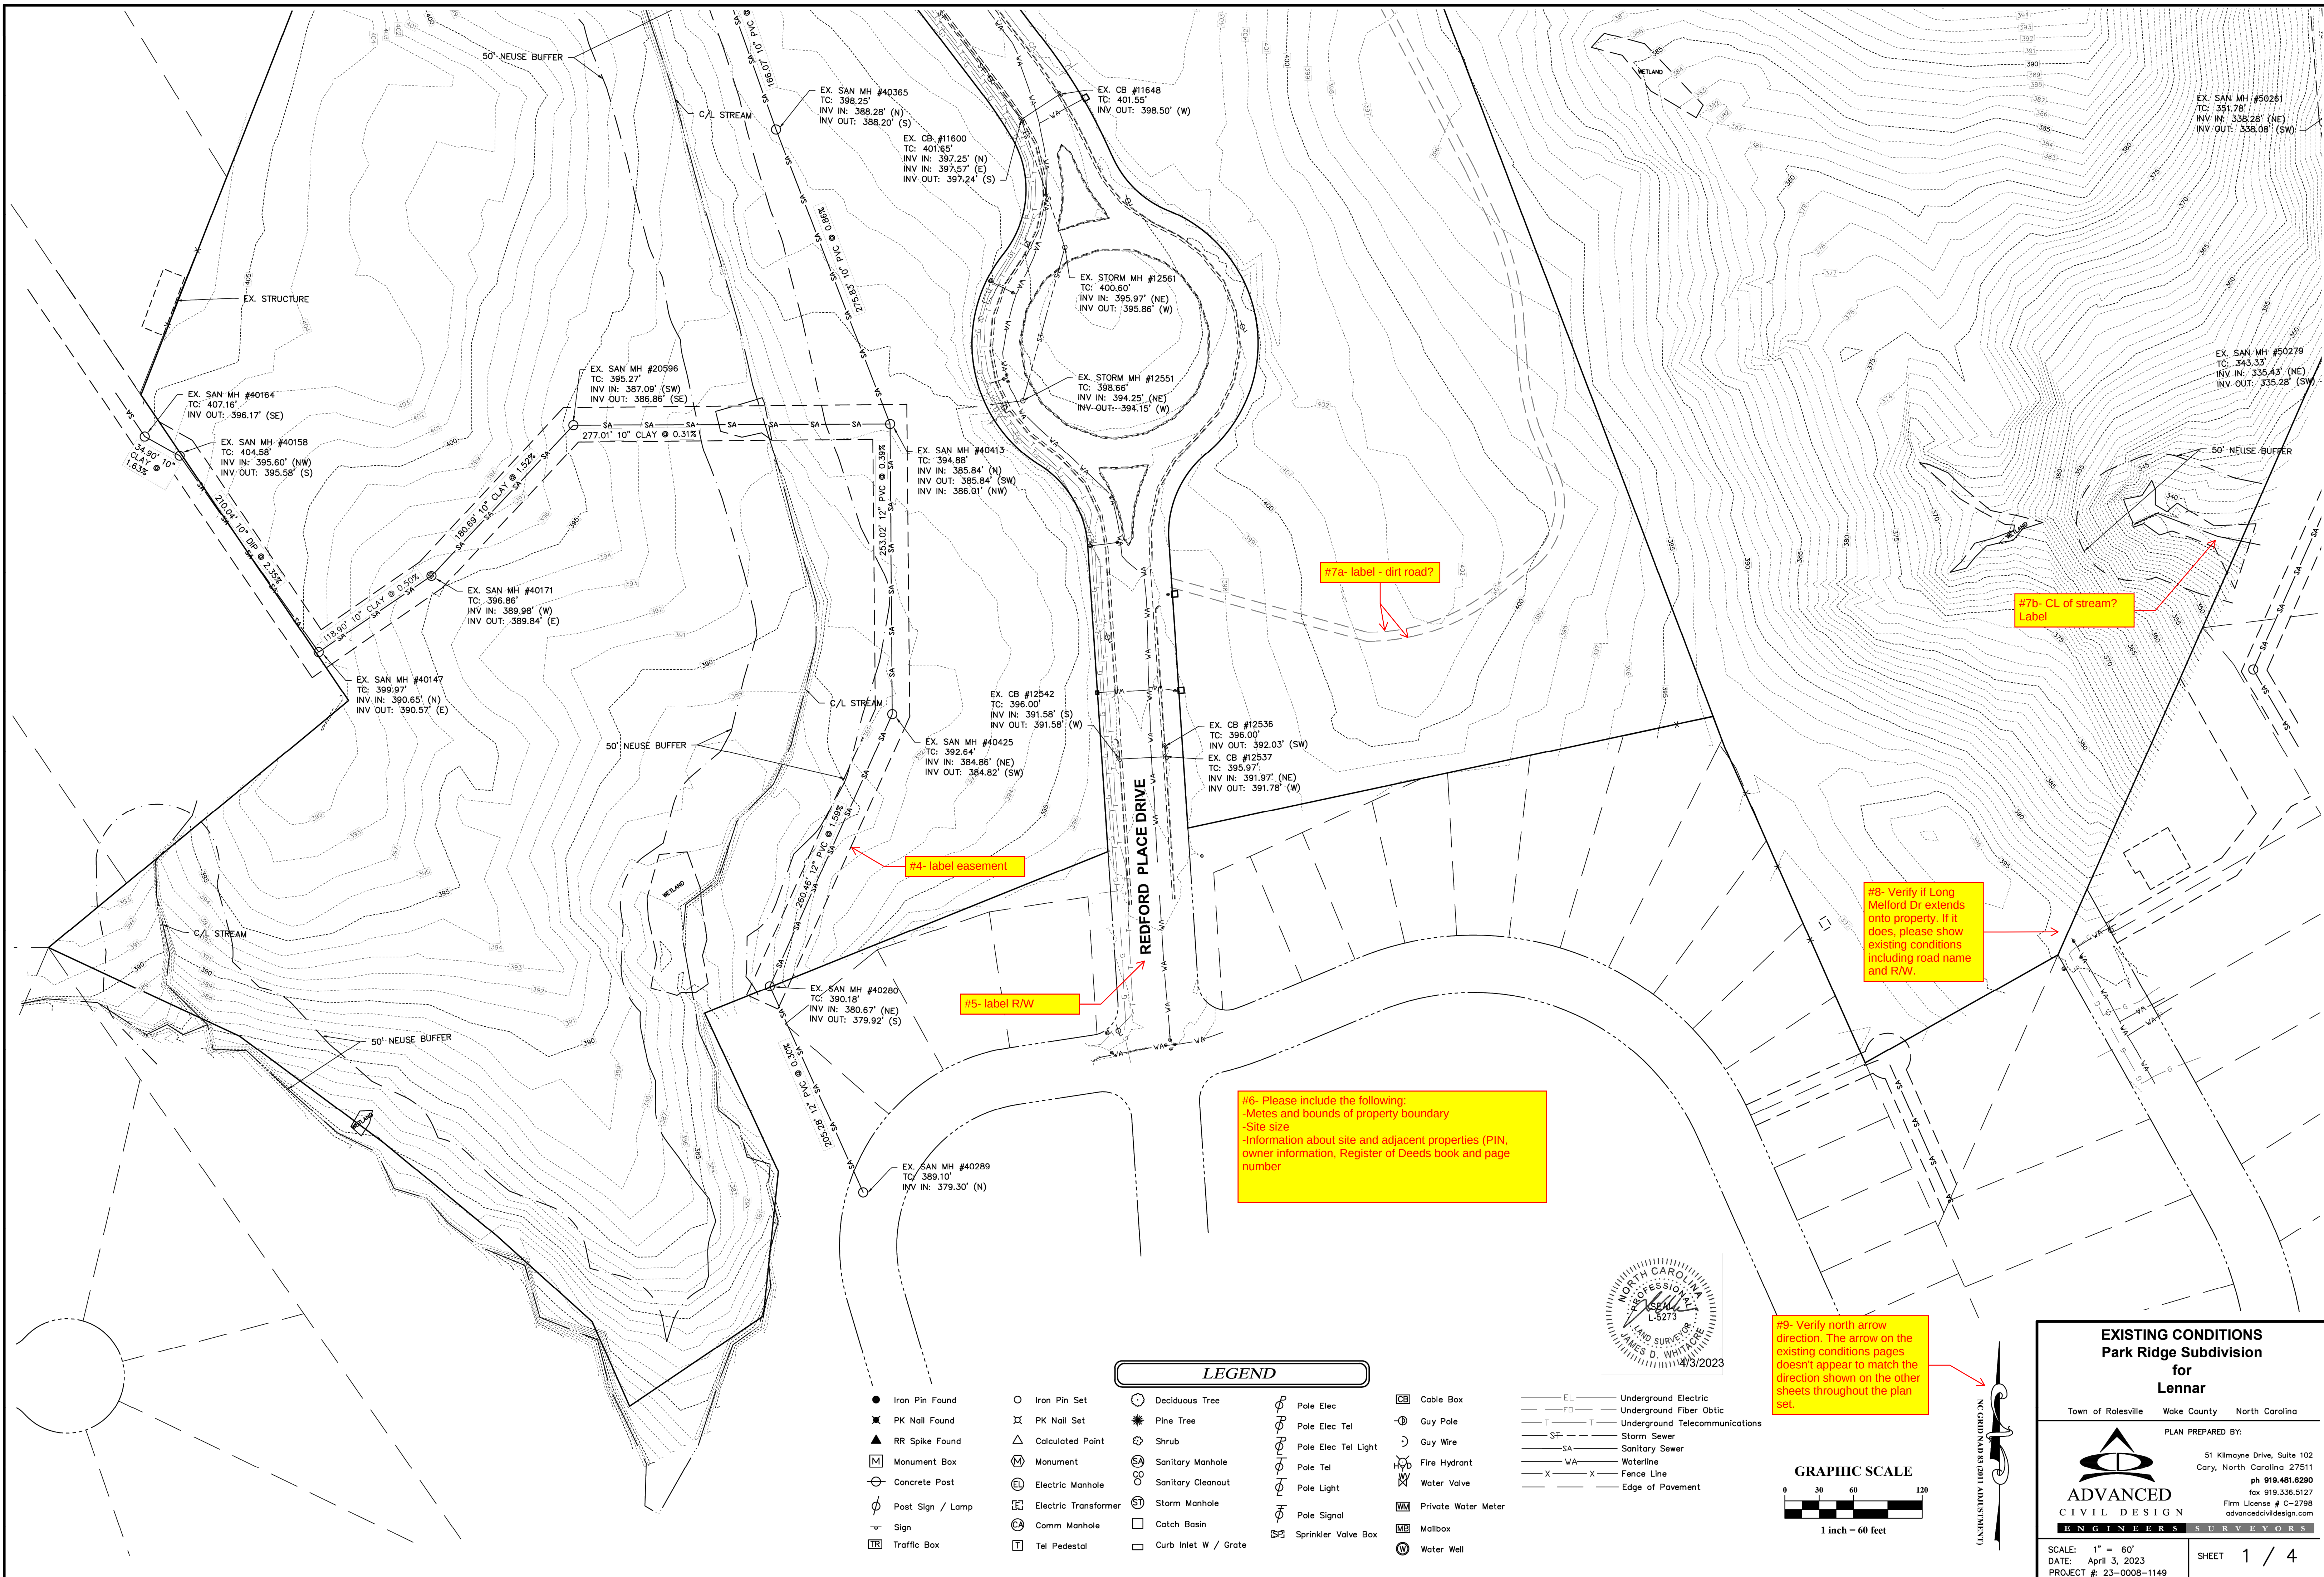

#6- Please include the following:
-Metes and bounds of property boundary
-Site size
-Information about site and adjacent properties (PIN, owner information, Register of Deeds book and page number)

#7a- label - dirt road?

#7b- CL of stream?
Label

#4- label easement



#5- label R/W

#8- Verify if Long Melford Dr extends onto property. If it does, please show existing conditions including road name and R/W.

#9- Verify north arrow direction. The arrow on the existing conditions pages doesn't appear to match the direction shown on the other sheets throughout the plan set.

LEGEND

- | | | | | | |
|--------------------|------------------------|------------------------|-----------------------|-----------------------|--------------------------------|
| ● Iron Pin Found | ○ Iron Pin Set | ○ Deciduous Tree | ○ Pole Elec | □ Cable Box | — EL — Underground Electric |
| ✕ PK Nail Found | ✕ PK Nail Set | ⌘ Pine Tree | ○ Pole Elec Tel | — GUY — Guy Pole | — FO — Underground Fiber Optic |
| ▲ RR Spike Found | △ Calculated Point | ⌘ Shrub | ○ Pole Elec Tel Light | ○ Guy Wire | — T — T |
| □ Monument Box | □ Monument | ○ Sanitary Manhole | ○ Pole Tel | ○ Fire Hydrant | — ST — Storm Sewer |
| ○ Concrete Post | ○ Electric Manhole | ○ Sanitary Cleanout | ○ Pole Light | ○ Water Valve | — SA — Sanitary Sewer |
| ○ Post Sign / Lamp | ○ Electric Transformer | ○ Storm Manhole | ○ Pole Signal | ○ Private Water Meter | — WA — Waterline |
| ○ Sign | ○ Comm Manhole | □ Catch Basin | ○ Sprinkler Valve Box | ○ Mailbox | — X — Fence Line |
| □ Traffic Box | ○ Tel Pedestal | □ Curb Inlet W / Grate | | ○ Water Well | — — Edge of Pavement |

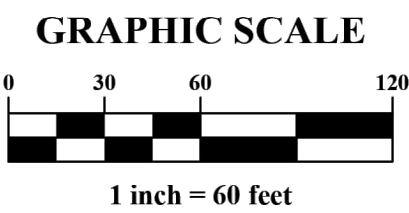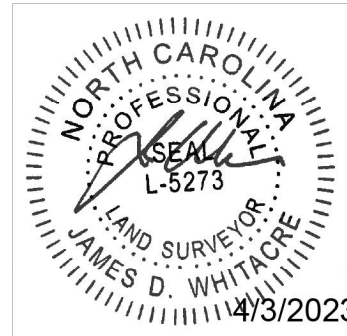

EXISTING CONDITIONS
Park Ridge Subdivision
for
Lennar

Town of Rolesville Wake County North Carolina


PLAN PREPARED BY:

51 Kilmoyne Drive, Suite 102
Cory, North Carolina 27511
ph 919.481.6290
fax 919.336.5127
Firm License # C-2798
advancedcivilsurveyors.com

ADVANCED
CIVIL DESIGN
ENGINEERS SURVEYORS


SCALE: 1" = 60'
DATE: April 3, 2023
PROJECT #: 23-0008-1149

SHEET 1 / 4

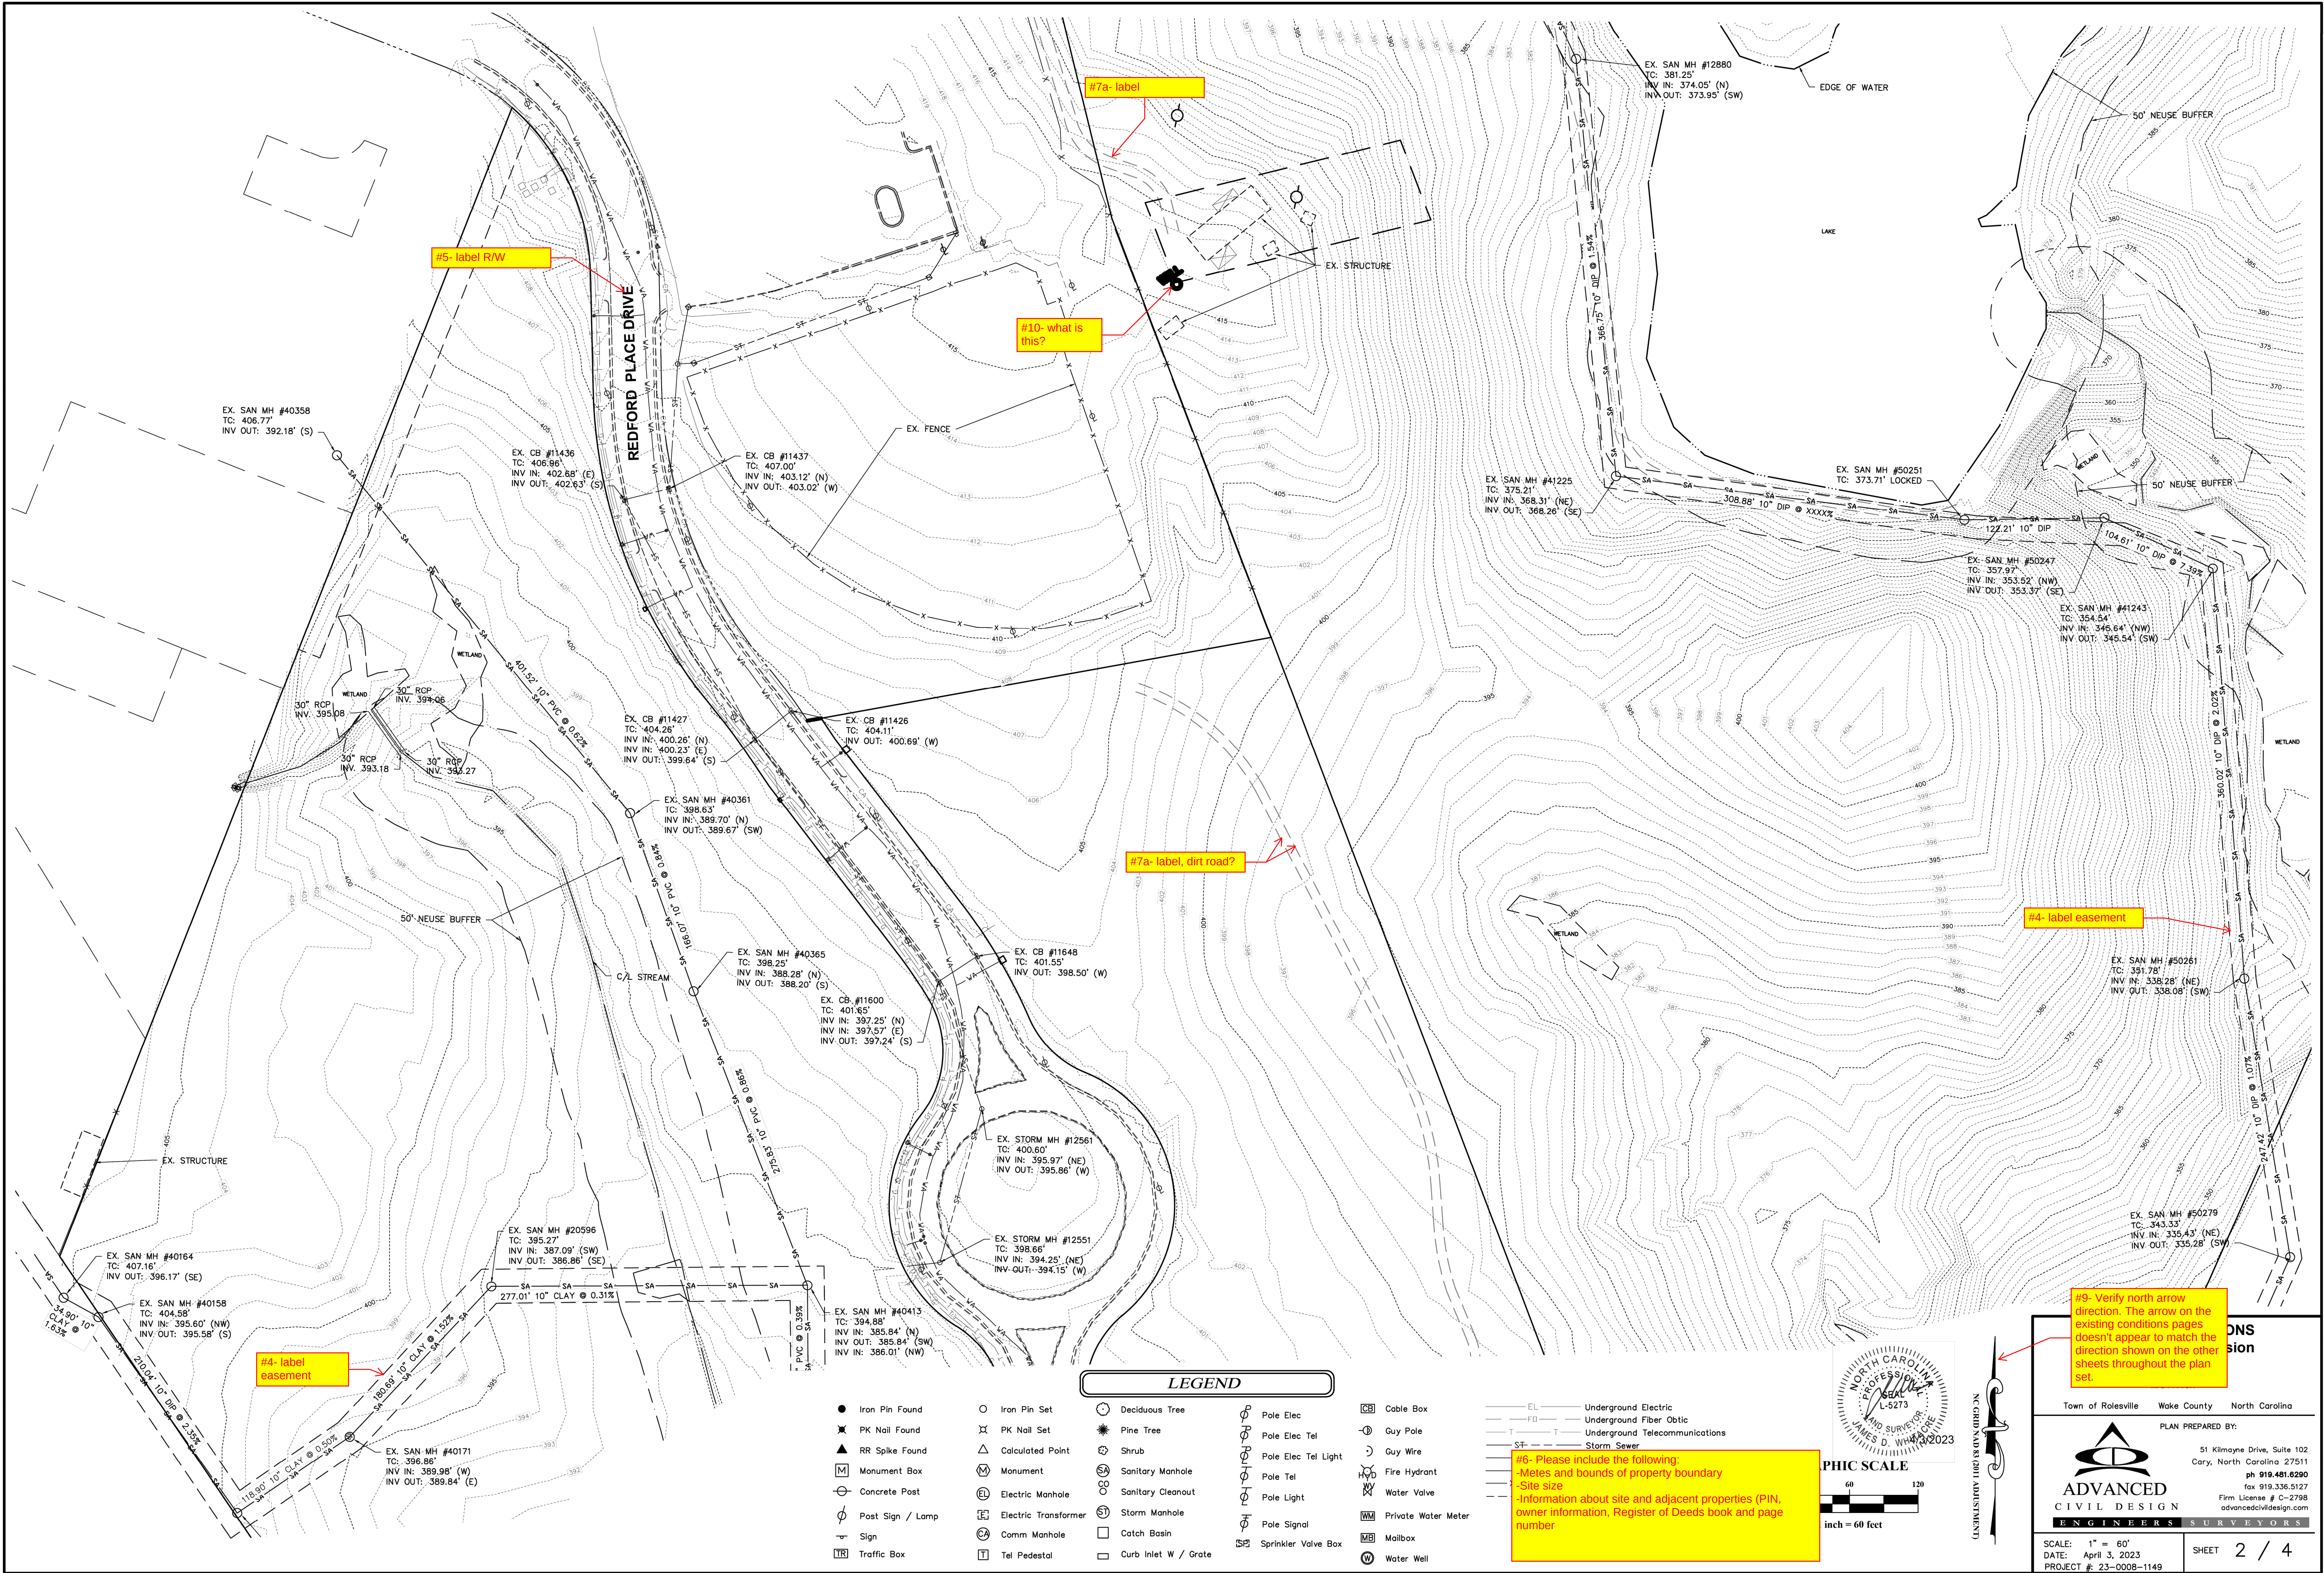

LEGEND

#6- Please include the following:
-Metes and bounds of property boundary
-Site size
-Information about site and adjacent properties (PIN, owner information, Register of Deeds book and page number)

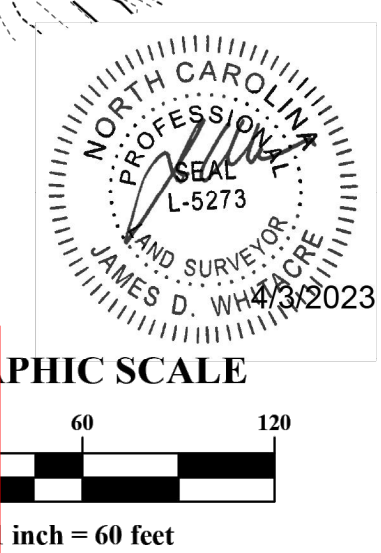

Town of Rolesville Wake County North Carolina


PLAN PREPARED BY:

ADVANCED CIVIL DESIGN ENGINEERS SURVEYORS

51 Kilmoyne Drive, Suite 102
Cory, North Carolina 27511
ph 919.481.6290
fax 919.336.5127
Firm License # C-2798
advancedcivildesign.com

SCALE: 1" = 60'
DATE: April 3, 2023
PROJECT #: 23-0008-1149

SHEET 2 / 4

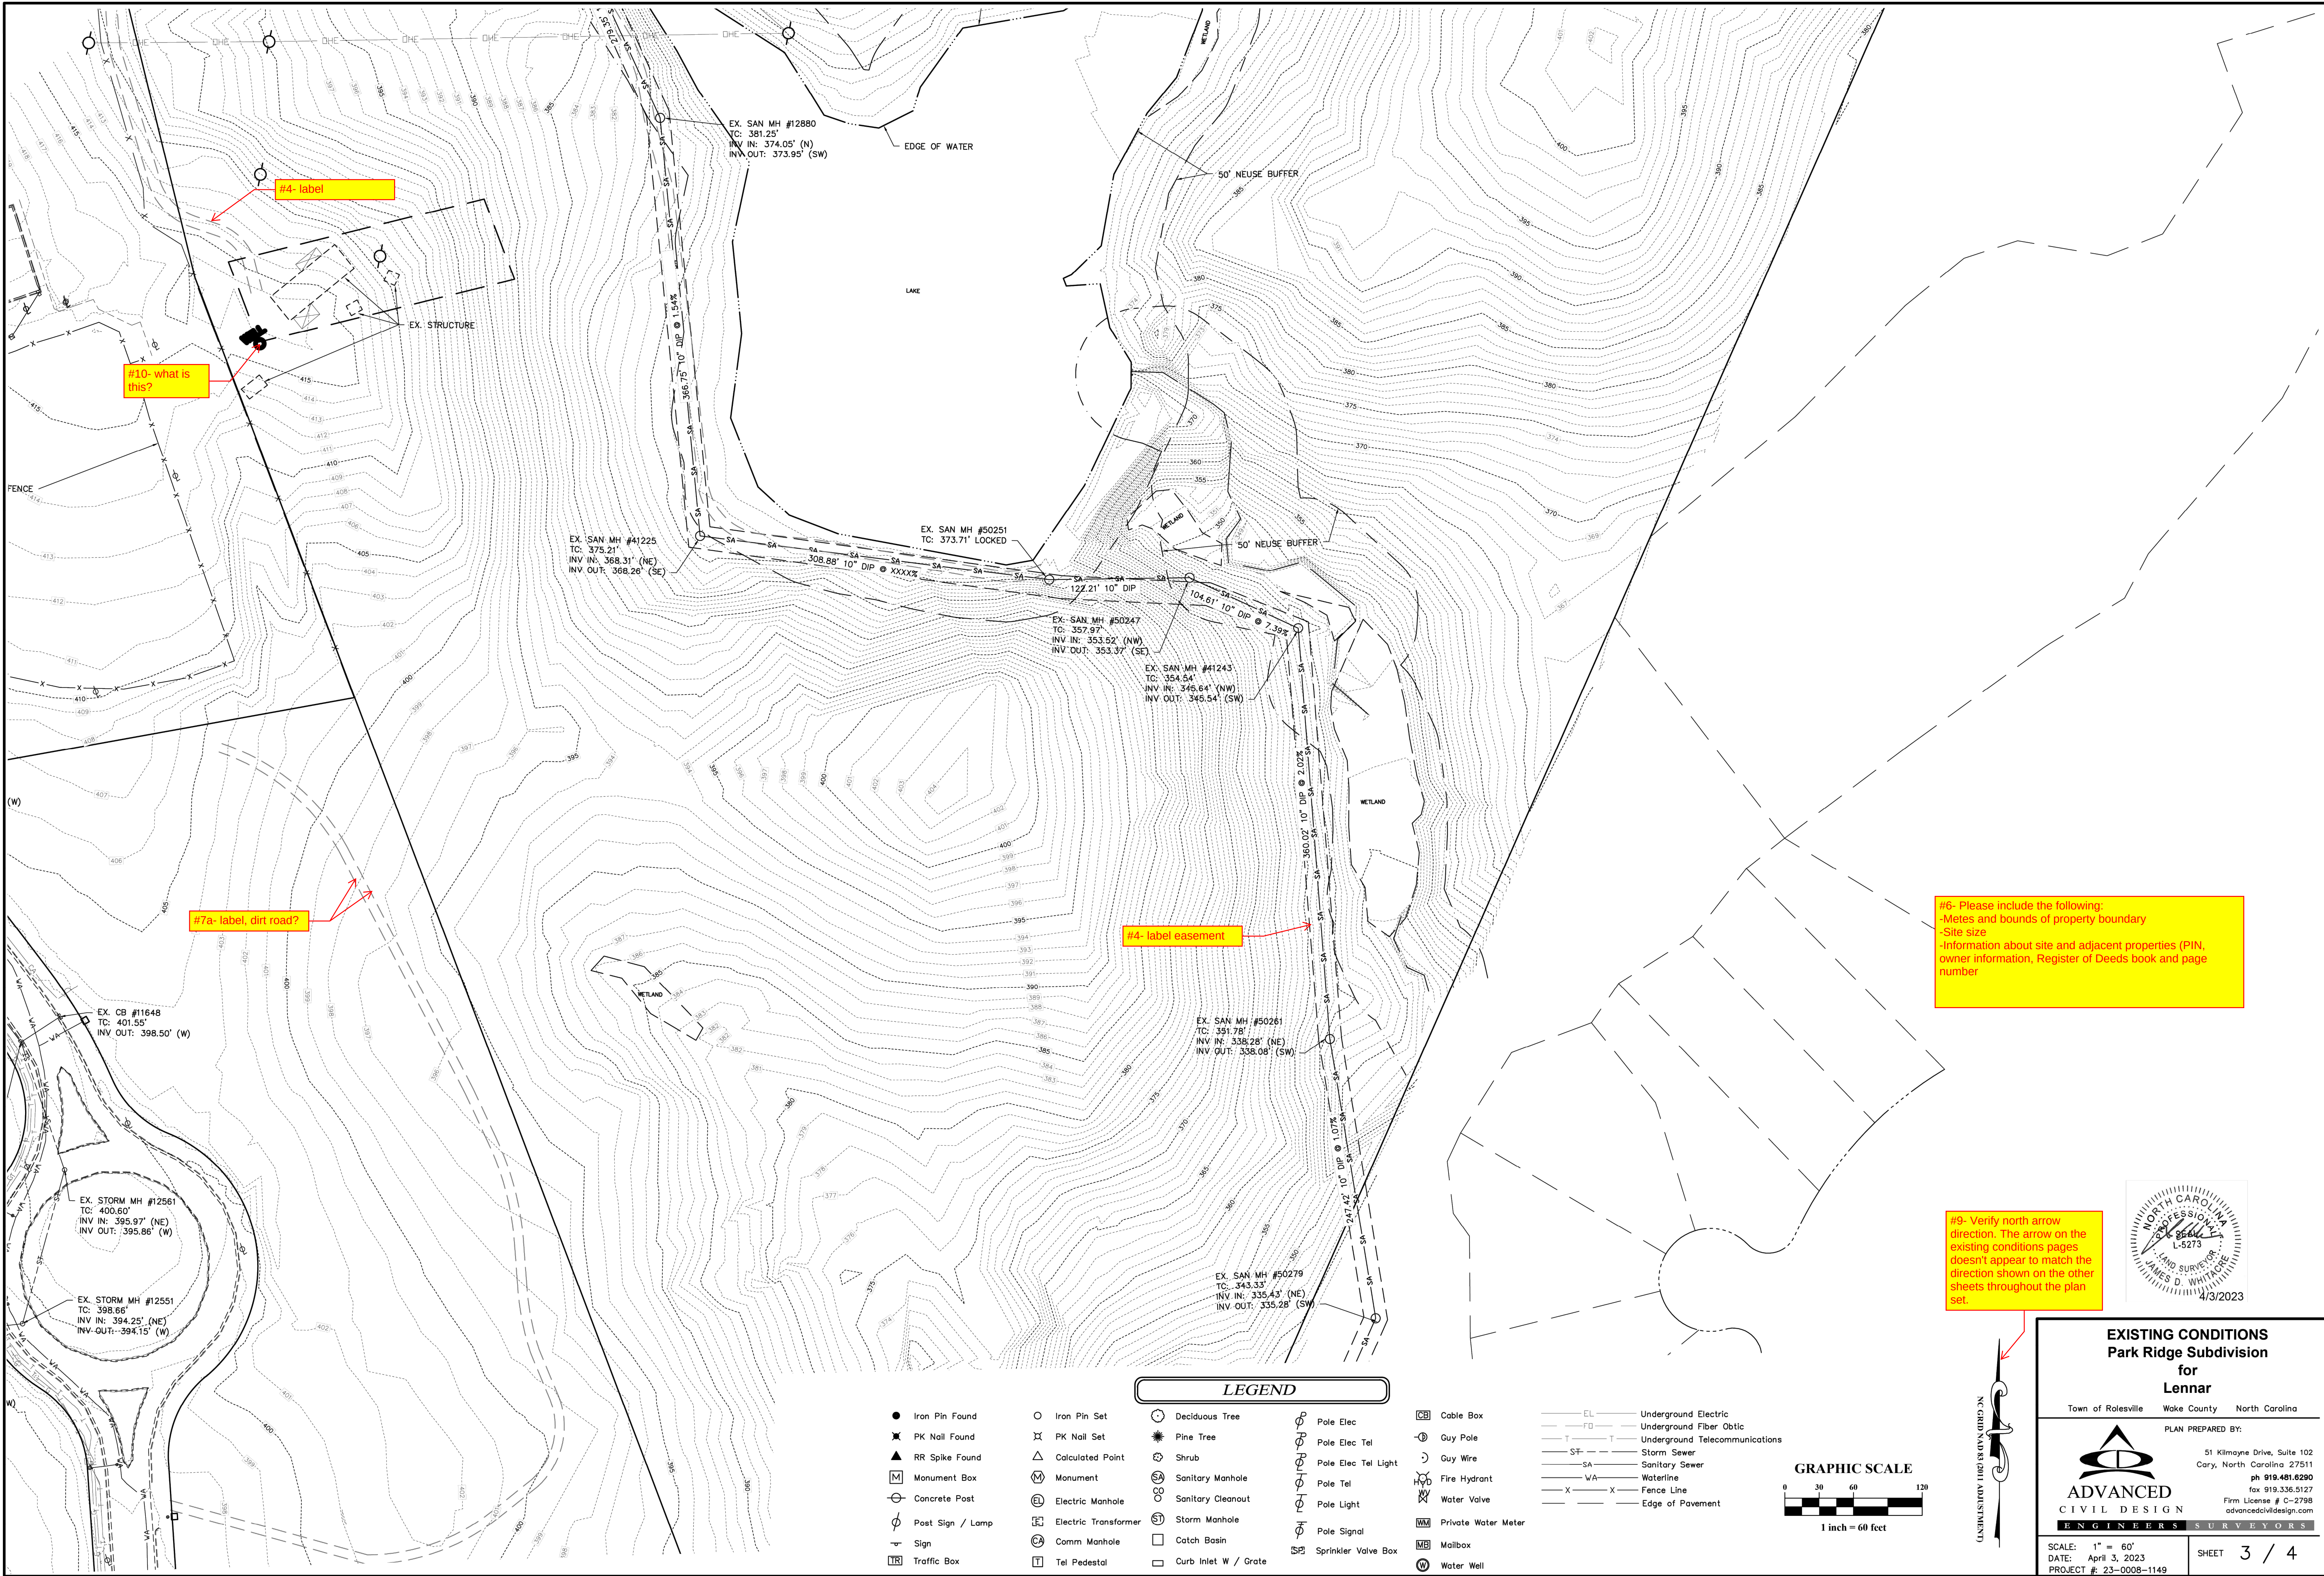

#10- what is this?

#4- label

#7a- label, dirt road?

#4- label easement


#6- Please include the following:
-Metes and bounds of property boundary
-Site size
-Information about site and adjacent properties (PIN, owner information, Register of Deeds book and page number)

#9- Verify north arrow direction. The arrow on the existing conditions pages doesn't appear to match the direction shown on the other sheets throughout the plan set.



LEGEND

- | | | | | | |
|--------------------|------------------------|------------------------|-----------------------|------------------------|------------------------------------|
| ● Iron Pin Found | ○ Iron Pin Set | ○ Deciduous Tree | ○ Pole Elec | CB Cable Box | EL Underground Electric |
| ✕ PK Nail Found | ✕ PK Nail Set | ✱ Pine Tree | ○ Pole Elec Tel | GP Guy Pole | FO Underground Fiber Optic |
| ▲ RR Spike Found | △ Calculated Point | ✱ Shrub | ○ Pole Elec Tel Light | GW Guy Wire | T T Underground Telecommunications |
| ■ Monument Box | △ Monument | ○ Sanitary Manhole | ○ Pole Tel | HW Fire Hydrant | SF Storm Sewer |
| ○ Concrete Post | ○ Electric Manhole | ○ Sanitary Cleanout | ○ Pole Light | WV Water Valve | SA Sanitary Sewer |
| ○ Post Sign / Lamp | ○ Electric Transformer | ○ Storm Manhole | ○ Pole Signal | WM Private Water Meter | WA Waterline |
| ○ Sign | ○ Comm Manhole | ○ Catch Basin | ○ Sprinkler Valve Box | MB Mailbox | X X Fence Line |
| TR Traffic Box | ○ Tel Pedestal | ○ Curb Inlet W / Grate | | W Water Well | — Edge of Pavement |

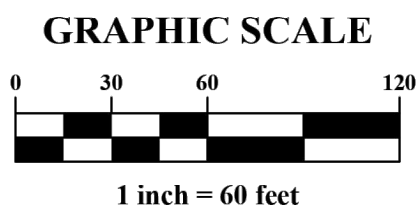

EXISTING CONDITIONS
Park Ridge Subdivision
for
Lennar

Town of Rolesville Wake County North Carolina

PLAN PREPARED BY:


ADVANCED
CIVIL DESIGN
ENGINEERS SURVEYORS

51 Kilmoyne Drive, Suite 102
Cory, North Carolina 27511
ph 919.481.8290
fax 919.336.5127
Firm License # C-2798
advancedcivildesign.com

SCALE: 1" = 60'
DATE: April 3, 2023
PROJECT #: 23-0008-1149

SHEET 3 / 4

#9- Verify north arrow direction. The arrow on the existing conditions pages doesn't appear to match the direction shown on the other sheets throughout the plan set.

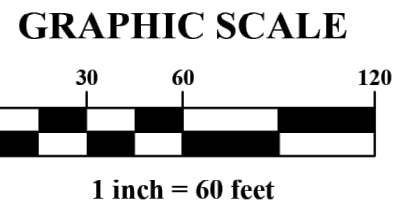

EX. SAN MH #13254
TC: 413.91'
INV IN: 406.91' (NE)
INV OUT: 406.81' (S)

EX. SAN MH #13315
TC: 410.03'
INV IN: 405.35' (N)
INV OUT: 405.30' (W)

EX. SAN MH #40466
TC: 417.96'
INV IN: 411.91' (N)
INV OUT: 411.86' (S)

EX. SAN MH #13329
TC: 407.26'
INV IN: 400.56' (N)
INV IN: 400.76' (E)
INV OUT: 400.16' (S)

EX. SAN MH #13372
TC: 384.02'
INV IN: 376.67' (N)
INV OUT: 376.62' (S)

EX. SAN MH #12880
TC: 381.25'
INV IN: 374.05' (N)
INV OUT: 373.95' (SW)

LEGEND

● Iron Pin Found
✕ PK Nail Found
▲ RR Spike Found
[M] Monument Box
○ Concrete Post
⊕ Post Sign / Lamp
⊖ Sign
[TR] Traffic Box

○ Iron Pin Set
✕ PK Nail Set
△ Calculated Point
[M] Monument
[EL] Electric Manhole
[E] Electric Transformer
[CA] Comm Manhole
[T] Tel Pedestal

○ Deciduous Tree
* Pine Tree
⊗ Shrub
[SA] Sanitary Manhole
[SC] Sanitary Cleanout
[SM] Storm Manhole
[CB] Catch Basin
[C] Curb Inlet W / Grate

⊕ Pole Elec
⊖ Pole Elec Tel
⊗ Pole Elec Tel Light
⊕ Pole Tel
⊖ Pole Light
⊕ Pole Signal
⊖ Sprinkler Valve Box

[CB] Cable Box
⊕ Guy Pole
⊖ Guy Wire
[HYD] Fire Hydrant
⊖ Water Valve
[WM] Private Water Meter
[MB] Mailbox
⊖ Water Well

— EL — Underground Electric
— FD — Underground Fiber Optic
— T — T
— SF — Storm Sewer
— SA — Sanitary Sewer
— WA — Waterline
— X — X
— — Fence Line
— — Edge of Pavement

#6- Please include the following:
-Metes and bounds of property boundary
-Site size
-Information about site and adjacent properties (PIN, owner information, Register of Deeds book and page number)

#7a- add label

#4- label easement

#11- what are these thick dashes? Is the linetype correct?

#10- what is this?



EXISTING CONDITIONS Park Ridge Subdivision for Lennar

Town of Rolesville Wake County North Carolina

PLAN PREPARED BY:



ADVANCED
CIVIL DESIGN
ENGINEERS & SURVEYORS

51 Kilmoyne Drive, Suite 102
Cory, North Carolina 27511
ph 919.481.8290
fax 919.336.5127
Firm License # C-2798
advancedcivildesign.com

SCALE: 1" = 60'
DATE: April 3, 2023
PROJECT #: 23-0008-1149

SHEET 4 / 4

THE CONTRACTOR SHALL FIELD VERIFY AND LOCATE ALL EXISTING UTILITIES ON SITE PRIOR TO DEMOLITION. INSTALL EROSION AND SEDIMENT CONTROL DEVICES AND TREE PROTECTION PER THE SEQUENCE PRIOR TO BEGINNING DEMOLITION ACTIVITIES.

THE CONTRACTOR IS RESPONSIBLE FOR THE DEMOLITION, REMOVAL, AND DISPOSAL OF (IN A LOCATION APPROVED BY ALL GOVERNING AUTHORITIES) ALL STRUCTURES, PADS, WALLS, FLUMES, FOUNDATIONS, PARKING, DRIVES, DRAINAGE, STRUCTURES, UTILITIES, ETC., SUCH THAT THE IMPROVEMENTS SHOWN ON THE REMAINING PLANS CAN BE CONSTRUCTED. ALL FACILITIES TO BE REMOVED SHALL BE UNDERCUT TO SUITABLE DEPTHS AND BROUGHT TO GRADE WITH SUITABLE COMPACTED FILL MATERIAL PER THE SPECIFICATIONS. THE CONTRACTOR SHALL PERFORM DEMOLITION ACTIVITIES AS NOTED AND SHOWN ON THESE PLANS AND AS DIRECTED BY THE OWNER.

IT WILL BE THE CONTRACTORS RESPONSIBILITY TO OBTAIN ANY AND ALL PERMITS AND PAY FEES REQUIRED FOR DEMOLITION AND HAUL-OFF FROM THE APPROPRIATE AUTHORITIES. THESE FEES SHALL BE INCLUDED WITH THE BID. THE CONTRACTOR SHALL PREPARE ALL DOCUMENTS AND ACQUIRE APPROPRIATE PERMITS AS REQUIRED PRIOR TO BEGINNING DEMOLITION ACTIVITIES.

DEMOLITION IS DEPICTED IN THE DEMOLITION PLAN AND IS INTENDED TO DESCRIBE GENERAL DEMOLITION AND UTILITY WORK. IT IS NOT INTENDED TO IDENTIFY EACH ELEMENT OF DEMOLITION OR RELOCATION. CONTRACTOR SHALL COORDINATE WITH THE OWNER AND APPROPRIATE UTILITY COMPANY PRIOR TO WORK. CONTRACTOR TO COMPLETELY DEMOLISH AND DISPOSE OFFSITE IN A LAWFUL MANNER EXISTING BUILDINGS, INCLUDING FOUNDATIONS AND ALL APPURTENANCES LOCATED OFF SITE. EXISTING PAVEMENT INCLUDING BUT NOT LIMITED TO DRIVEWAYS, SIDEWALKS, AIR CURBS, DRIVEWAYS, SIDEWALKS, CURBS, SIDEWALKS, ELECTRIC METERS, FENCING, STAIRS, WALLS, FOUNDATIONS, CONDUCITS, LIGHT POLE BASES, DEBRIS AND RUBBISH REQUIRING REMOVAL FROM THE WORK AREA, ETC. THE CONTRACTOR IS RESPONSIBLE FOR CONTACTING EACH UTILITY COMPANY TO COORDINATE REMOVAL OF ALL UTILITIES AND FOR DETERMINING HORIZONTAL AND VERTICAL LOCATIONS OF UTILITIES PRIOR TO COMMENCING WORK.

THE CONTRACTOR SHALL BE RESPONSIBLE TO ARRANGE FOR THE APPROPRIATE UTILITY COMPANY TO CUT AND PLUG ALL SERVICE PIPING AT THE STREET LINE OR MAIN, AS REQUIRED, OR AS OTHERWISE NOTED. ALL SERVICES MAY NOT BE SHOWN ON THIS PLAN. THE CONTRACTOR SHALL INVESTIGATE THE SITE PRIOR TO BIDDING TO DETERMINE THE EXTEND OF SERVICE PIPING TO BE REMOVED, CUT OR PLUGGED.

CONTRACTOR SHALL COORDINATE WITH DUKE ENERGY IN THE REMOVAL/RELOCATION OF EXISTING UTILITY SERVICES OVERHEAD POWER LINES.

THE CONTRACTOR SHALL COORDINATE FOR RESETTling OF CURB BOXES, VALVE BOXES AND REMOVAL AND/OR RELOCATION OF OVERHEAD UTILITIES AND UTILITY POLES WITH THE APPROPRIATE UTILITY COMPANY. THE CONTRACTOR IS RESPONSIBLE FOR THE PROTECTION OF ALL UTILITIES TO REMAIN IN PLACE. ALL EXISTING ITEMS TO REMAIN WHICH ARE DAMAGED DURING CONSTRUCTION SHALL BE RESTORED TO ITS ORIGINAL CONDITION AT THE SOLE EXPENSE OF THE CONTRACTOR.

THE CONTRACTOR SHALL TAKE ALL PRECAUTIONS TO AVOID UNNECESSARY DAMAGE TO EXISTING ROAD SURFACES.

FINISHED SURFACES TO BE REMOVED OR DEMOLISHED SHALL BE CUT ALONG LINES OF JOINTS WHICH WILL PERMIT A NEAT SURFACE WHEN RESTORED.

SAW CUT AT INTERFACE OF PAVEMENT OR CURB TO REMAIN. SAW CUT EXISTING PAVEMENT AT THE RIGHT-OF-WAY. SAW CUTS SHALL BE MADE FULL DEPTH THROUGH THE EXISTING PAVEMENT. DISCARDED PAVEMENT SHALL BE REMOVED FROM THE PROJECT AREA.

CONTRACTOR MAY LIMIT SAW-CUT AND PAVEMENT REMOVAL TO THOSE AREAS WHERE IF IT IS REQUIRED AS SHOWN ON THESE CONSTRUCTION PLANS BUT IF ANY DAMAGE IS INCURRED ON ANY OF THE SURROUNDING PAVEMENT, ETC. THE CONTRACTOR SHALL BE RESPONSIBLE FOR ITS REMOVAL AND REPAIR.

THE CONTRACTOR SHALL MAINTAIN ALL UTILITY SERVICES TO THE ADJOINING PROPERTIES THROUGHOUT CONSTRUCTION.

DO NOT INTERRUPT EXISTING UTILITIES SERVING FACILITIES OCCUPIED AND USED BY THE OWNER OR OTHERS DURING OCCUPIED HOURS EXCEPT WHEN SUCH INTERRUPTIONS HAVE BEEN AUTHORIZED IN WRITING BY THE OWNER AND THE LOCAL MUNICIPALITIES. INTERRUPTIONS SHALL ONLY OCCUR AFTER ACCEPTABLE TEMPORARY SERVICE HAS BEEN PROVIDED.

SHOULD ANY UNCHARACTER OR INCORRECTLY CHARTED EXISTING PIPING OR OTHER UTILITY BE UNCOVERED DURING CONSTRUCTION, CONTRACTOR OR CIVIL ENGINEER IMMEDIATELY FOR DIRECTIONS BEFORE PROCEEDING FURTHER WITH WORK IN THIS AREA.

ASBESTOS OR ANY OTHER HAZARDOUS MATERIAL, IF FOUND ON SITE, SHALL BE REMOVED BY A LICENSED HAZARDOUS MATERIAL CONTRACTOR ONLY AFTER NOTIFICATION OF THE CIVIL ENGINEER AND AUTHORIZATION TO PROCEED IS GIVEN BY THE CONSTRUCTION MANAGER.

CONTRACTOR SHALL TAKE THE AUT BURN AND BURNING OF ANY WASTE (IF ANY ARE ENCOUNTERED) AND REMOVE FUEL TO AN APPROVED DISPOSAL AREA BY AN APPROPRIATELY LICENSED WASTE OIL HANDLING CONTRACTOR IN STRICT ACCORDANCE WITH FEDERAL AND STATE REQUIREMENTS ONLY AFTER NOTIFICATION OF THE CIVIL ENGINEER AND AUTHORIZATION TO PROCEED IS GIVEN BY THE CONSTRUCTION MANAGER.

THE CONTRACTOR SHALL COORDINATE WITH RESPECTIVE UTILITY COMPANIES PRIOR TO THE REMOVAL AND/OR RELOCATION OF UTILITIES. THE CONTRACTOR SHALL COORDINATE WITH THE UTILITY COMPANY FOR THE PORTION OF WORK WHERE MAY BE REQUIRED. THE UTILITY COMPANY'S FORCES AND ANY FEES WHICH ARE TO BE PAID TO THE UTILITY COMPANY FOR THEIR SERVICES, THE CONTRACTOR IS RESPONSIBLE FOR PAYING ALL FEES AND CHARGES.

THE LOCATIONS OF ALL EXISTING UTILITIES SHOWN ON THIS PLAN HAVE BEEN DETERMINED FROM THE BEST INFORMATION AVAILABLE AND ARE GIVEN FOR THE CONVENIENCE OF THE CONTRACTOR. THE ENGINEER AND/OR THE CONTRACTOR SHALL BE RESPONSIBLE FOR VERIFYING THE LOCATION OF ALL UTILITIES. THE CONTRACTOR SHALL NOTIFY THE UTILITY COMPANIES FOR ONSITE LOCATIONS OF EXISTING UTILITIES. ALL EXISTING SEWERS, PIPING AND UTILITIES SHOWN ARE NOT TO BE INTERPRETTED AS THE EXACT LOCATION OR AS THE ONLY OBSTACLES THAT MAY OCCUR ON THE SITE. VERIFY EXISTING CONDITIONS AND PROCEED WITH CAUTION AROUND ANY ANTICIPATED FEATURES. GIVE NOTICE TO ALL UTILITY COMPANIES REGARDING DESTRUCTION AND REMOVAL OF ALL SERVICE LINES AND CAP ALL LINES BEFORE PROCEEDING WITH THE WORK. THE PORTION OF WORK WHERE MAY BE REQUIRED. THE UTILITY COMPANY'S FORCES AND ANY FEES WHICH ARE TO BE PAID TO THE UTILITY COMPANY FOR THEIR SERVICES, THE CONTRACTOR IS RESPONSIBLE FOR PAYING ALL FEES AND CHARGES.


ELECTRICAL, TELEPHONE, CABLE, WATER, FIBER OPTIC CABLE AND/OR GAS LINES NEEDING TO BE REMOVED OR RELOCATED SHALL BE COORDINATED WITH THE AFFECTED UTILITY COMPANY. ADEQUATE TIME SHALL BE PROVIDED FOR RELOCATION AND CLOSE COORDINATION WITH THE UTILITY COMPANY IS NECESSARY TO PROVIDE A SMOOTH TRANSITION IN UTILITY SERVICE. CONTRACTOR SHALL PAY CLOSE ATTENTION TO EXISTING UTILITIES WITH THE ANY ROAD OR RAILROADS DURING CONSTRUCTION.

ANY WATER WELLS ENCOUNTERED ARE TO BE BROUGHT TO THE CIVIL ENGINEER'S ATTENTION IMMEDIATELY AND PROPERLY ABANDONED BY A LICENSED WELL DRILLER.

ANY SEPTIC SYSTEMS ENCOUNTERED SHALL BE BROUGHT TO THE CIVIL ENGINEER'S ATTENTION IMMEDIATELY AND SHALL BE PROPERLY DEMOLISHED.

CONTRACTOR MUST PROTECT THE PUBLIC AT ALL TIMES WITH FENCING, BARRICADES, ENCLOSURES, ETC. AND PROVIDE PROPERLY TRAINED PERSONNEL TO MAINTAIN THE FENCING AND CONSTRUCTION MAINTENANCE.

THIS PLAN DOES NOT PURPORT TO SHOW ALL REQUIRED DEMOLITION. CONTRACTOR SHALL FIELD VERIFY PRIOR TO SUBMITTING BID.

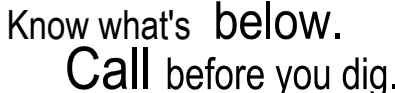

OVERALL DEMOLITION PLAN

PRELIMINARY

NOT FOR CONSTRUCTION

FILE NUMBER:
8430-03

DATE: 06/01/2023

06/01/2023

REV

04/03/2023

PER TOWN OF ROLESVILLE COMMENT

INITIAL SUBMITTAL

DESIGNED BY: DF/CD

DRAWN BY: DF/JWM

REVIEWED BY: DF

06/01/2023

REV

04/03/2023

PER TOWN OF ROLESVILLE COMMENT

INITIAL SUBMITTAL

OVERALL DEMOLITION PLAN

PRELIMINARY

NOT FOR CONSTRUCTION

FILE NUMBER:
8430-03

DATE: 06/01/2023

06/01/2023

REV

04/03/2023

PER TOWN OF ROLESVILLE COMMENT

INITIAL SUBMITTAL

OVERALL DEMOLITION PLAN

PRELIMINARY


NOT FOR CONSTRUCTION

FILE NUMBER:
8430-03

DATE: 06/01/2023

06/01/2023

<

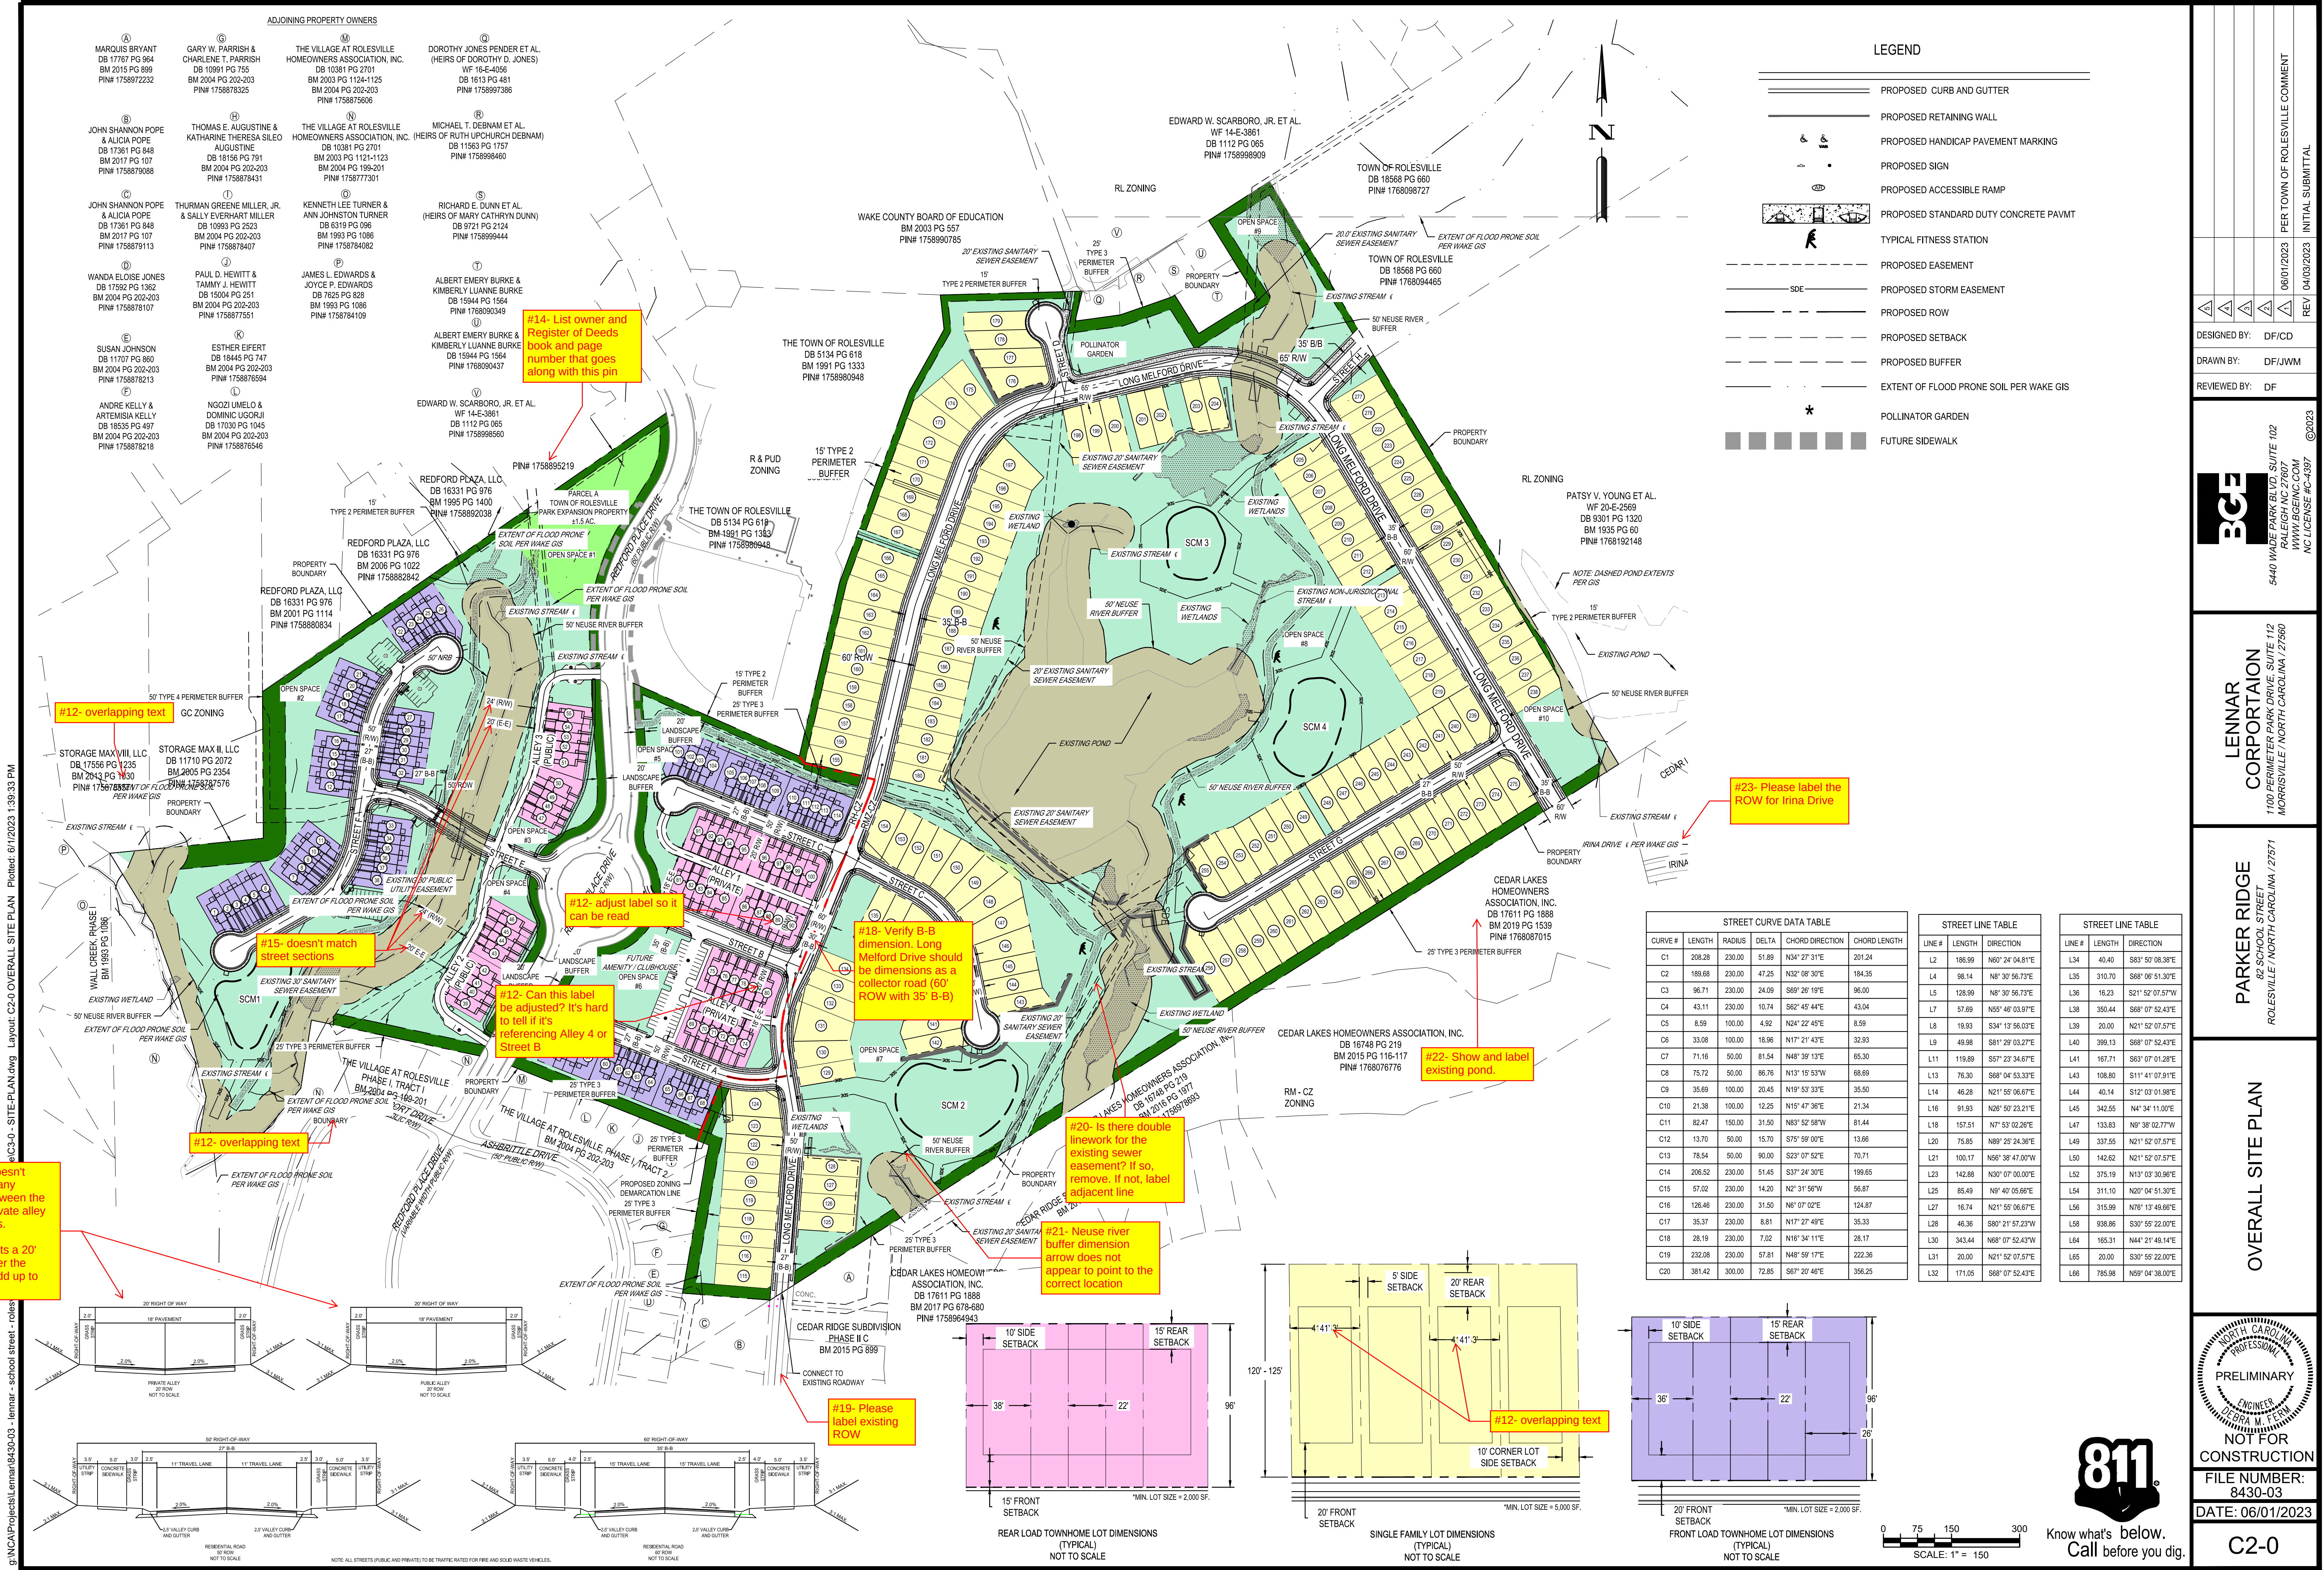

PER TOWN OF ROLESVILLE COMMENT

06/01/2023
REV 04/03/2023
INITIAL SUBMITTAL

DESIGNED BY: DF/CD
DRAWN BY: DF/JWM
REVIEWED BY: DF

BCE
5440 WADE PARK BLVD, SUITE 102
RALEIGH NC 27607
WWW.BCEINC.COM
NC LICENSE #C-4397

LENNAR CORPORAION
1100 PERIMETER PARK DRIVE, SUITE 112
MORRISVILLE / NORTH CAROLINA / 27560

PARKER RIDGE
82 SCHOOL STREET
ROLESVILLE / NORTH CAROLINA / 27571


OVERALL SITE PLAN


PRELIMINARY
NOT FOR CONSTRUCTION




FILE NUMBER: 8430-03
DATE: 06/01/2023

811
Know what's below.
Call before you dig.

C2-0

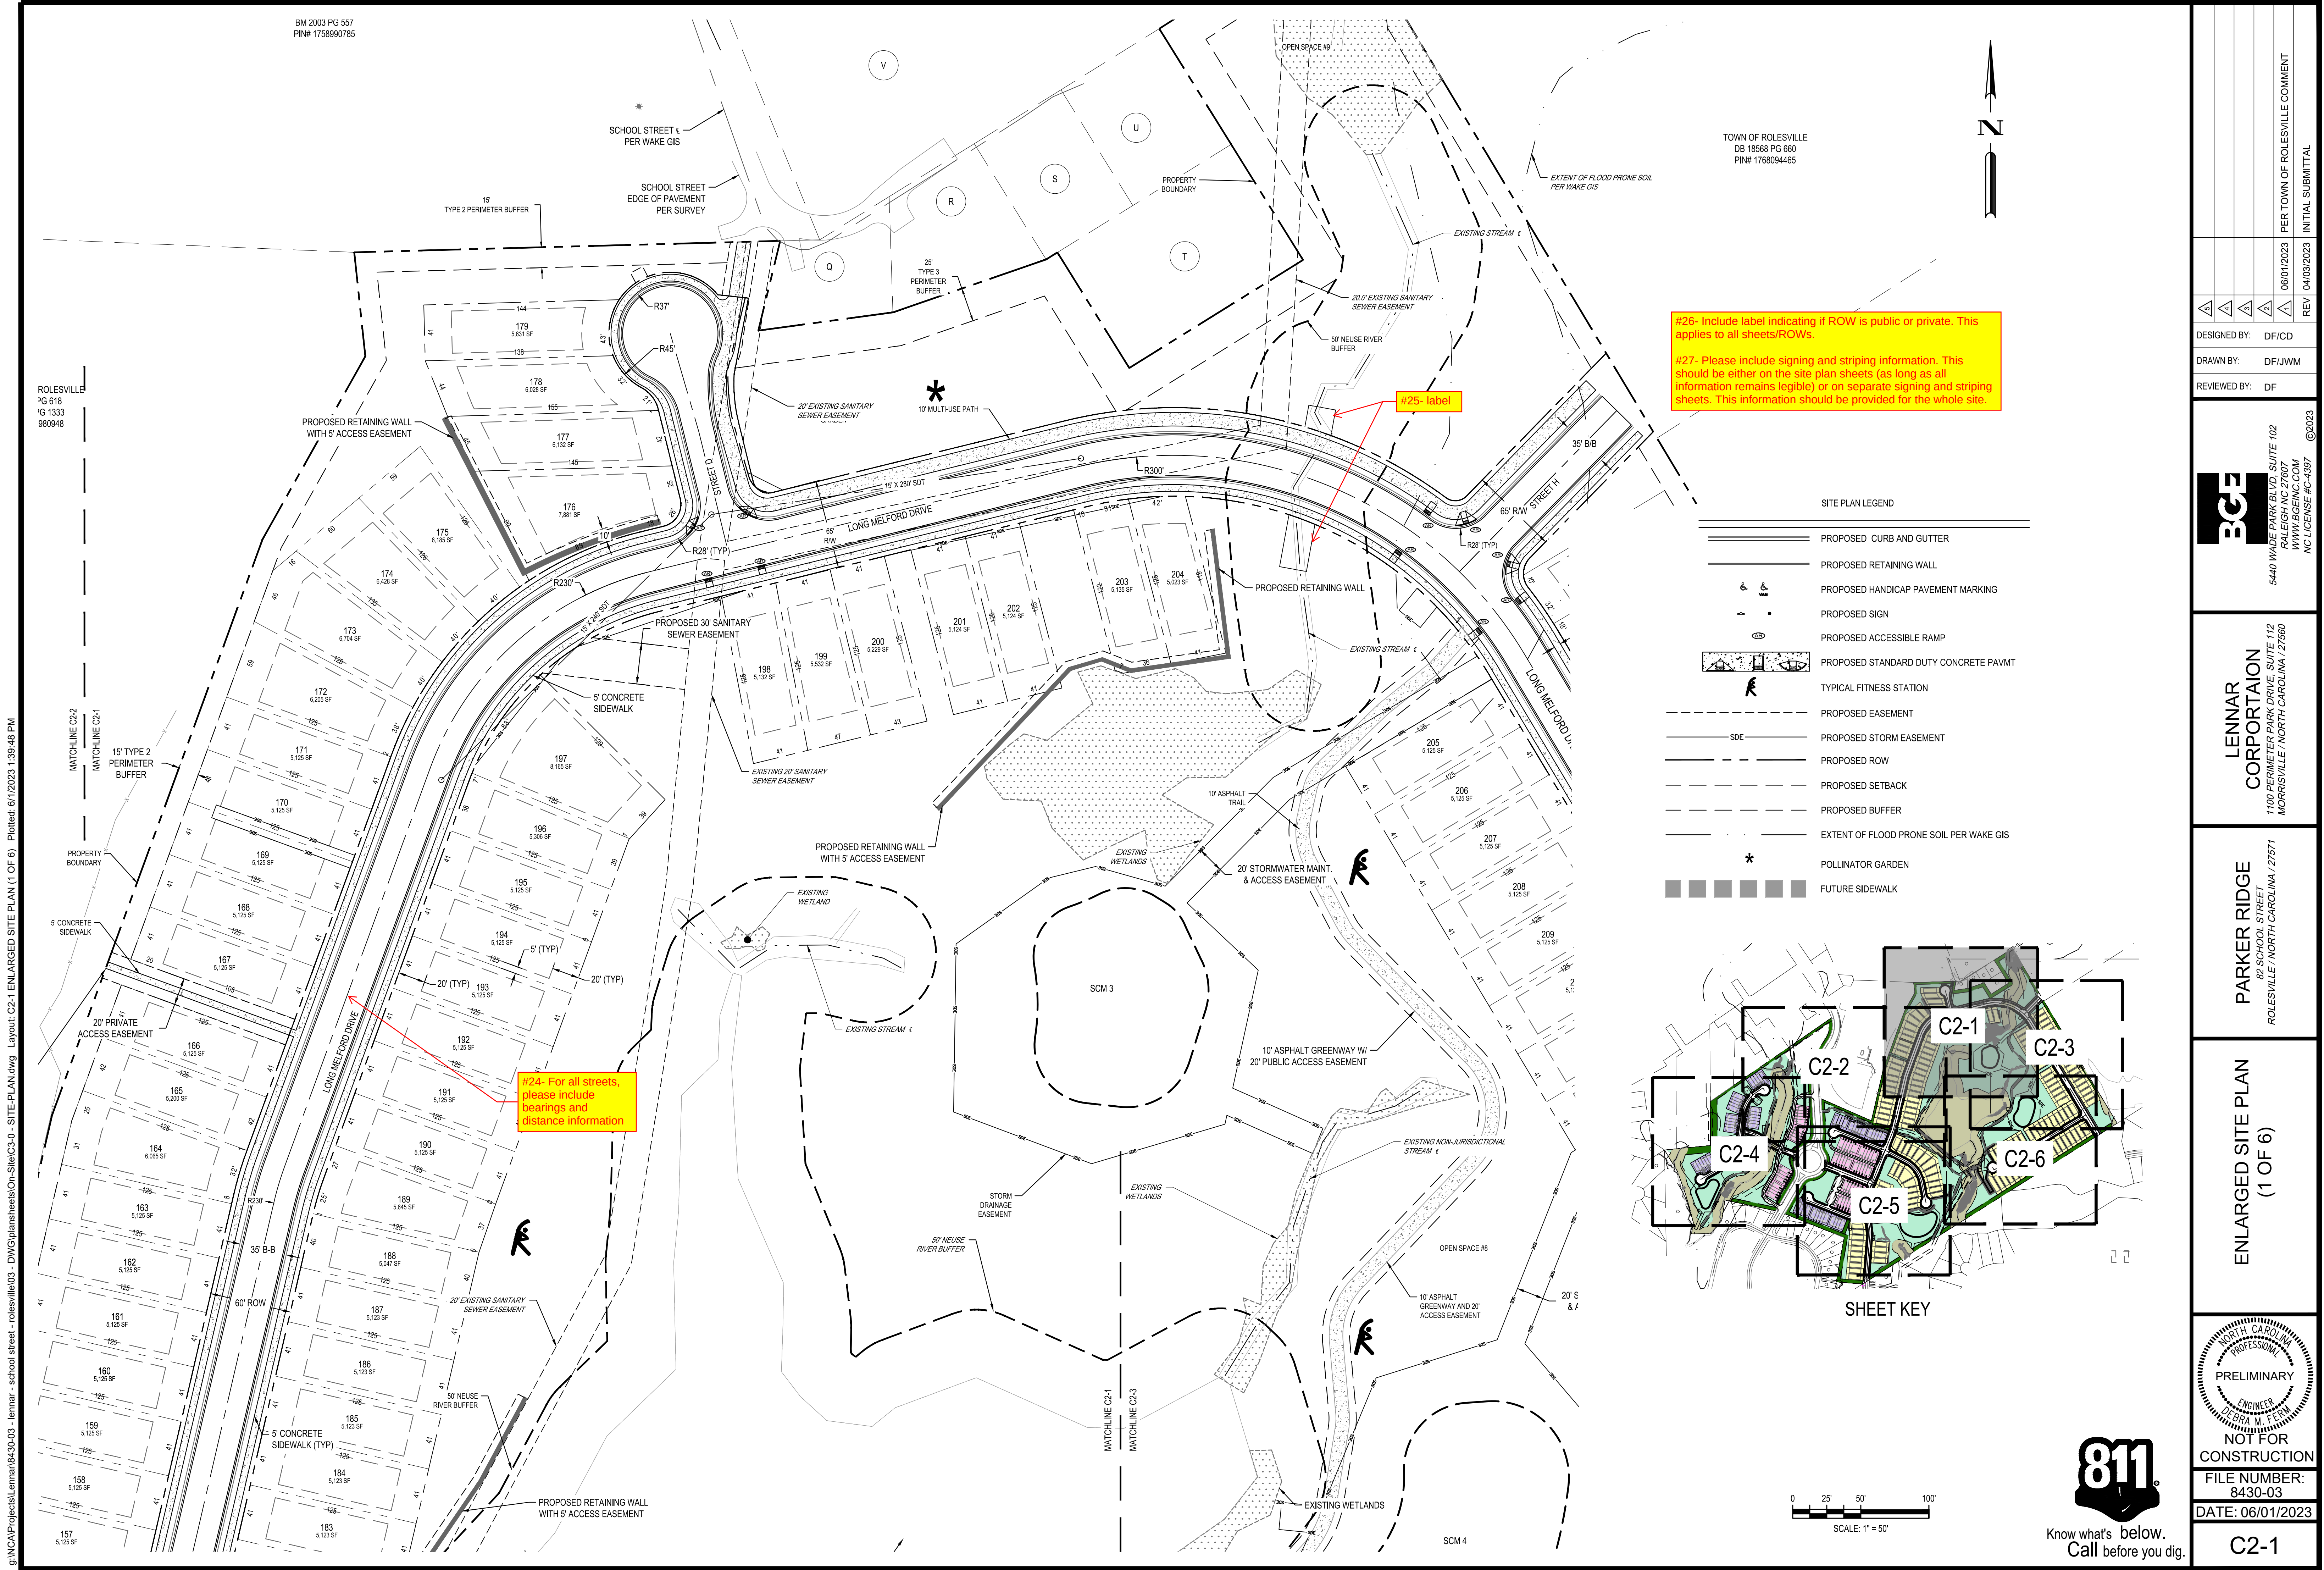

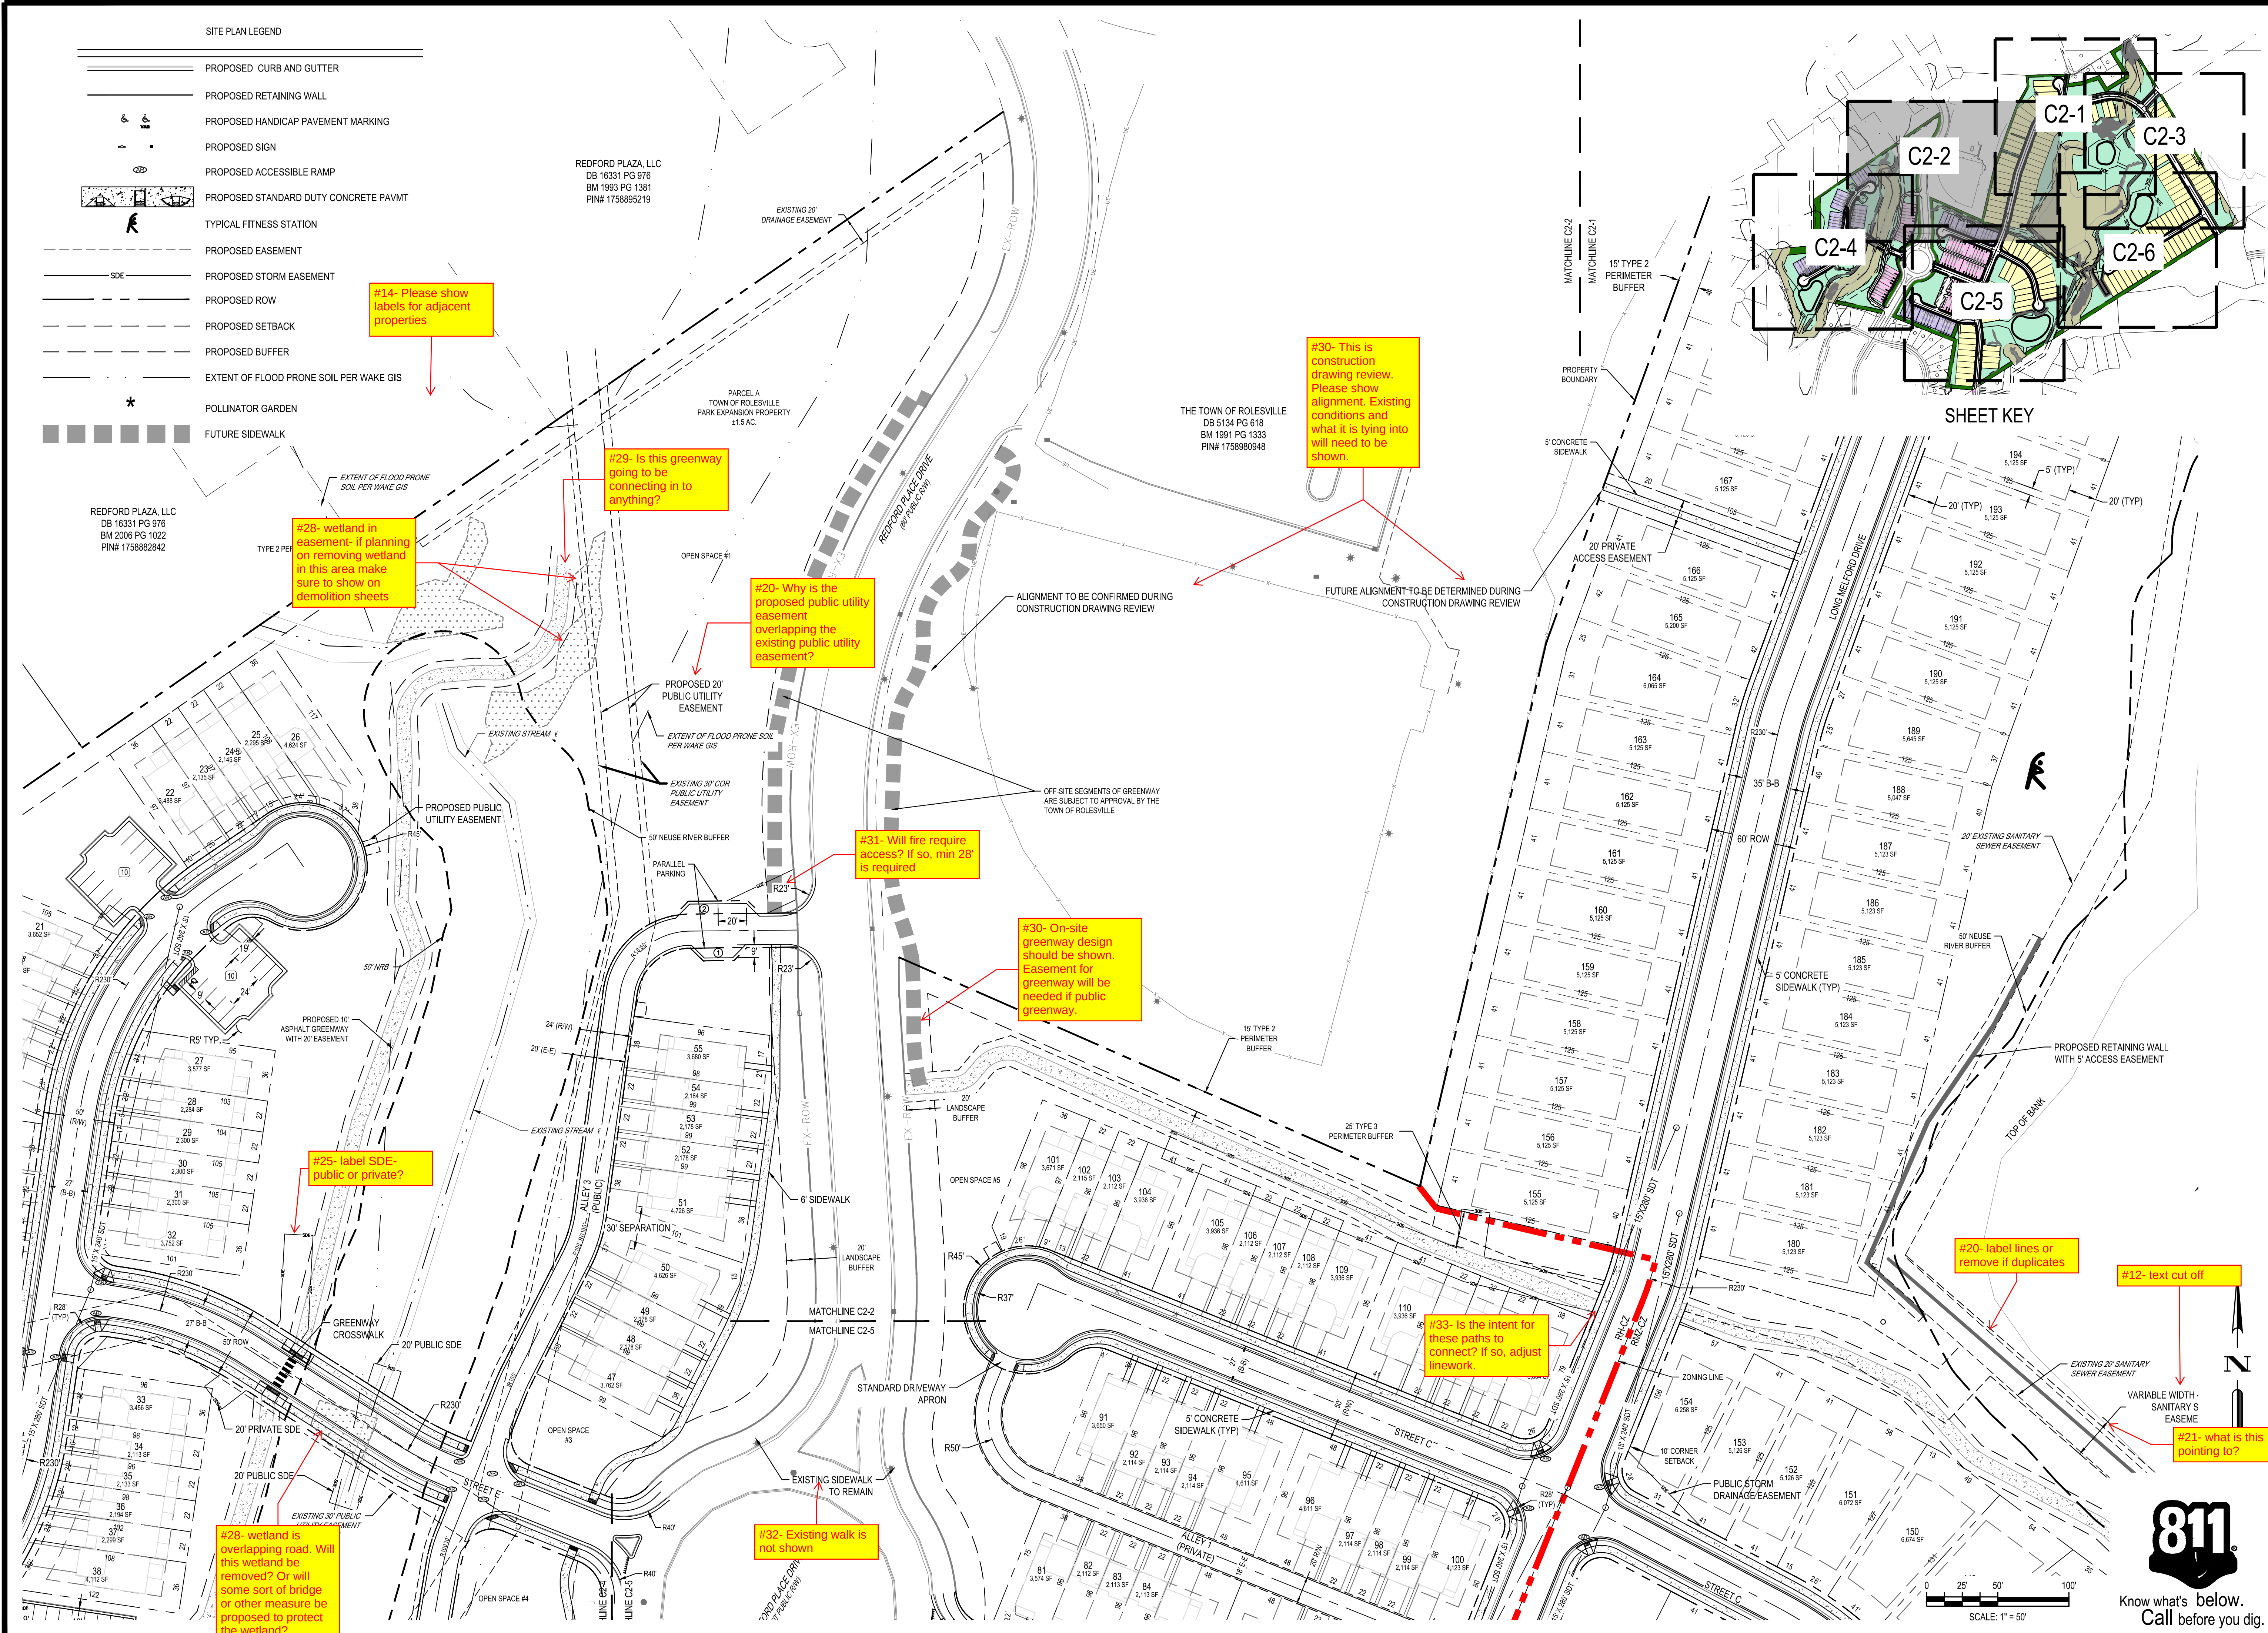

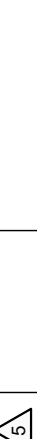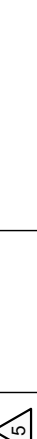
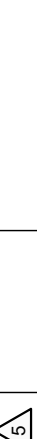
		DESIGNED BY: DF/CD			06/01/2023	PER TOWN OF ROLESVILLE COMMENT
5440 WADE PARK BLVD, SUITE 102 RALEIGH NC 27607 919-876-1100 NC LICENSE #C-4397		DRAWN BY: DF/JWM				
REVIEWED BY: DF				REV	04/03/2023	INITIAL SUBMITTAL
LENNAR CORPORAION 1100 PERIMETER PARK DRIVE, SUITE 112 MORRISVILLE / NORTH CAROLINA / 27560		PARKER RIDGE 82 SCHOOL STREET ROLESVILLE / NORTH CAROLINA / 27571				
ENLARGED SITE PLAN (2 OF 6)						
		PRELIMINARY NOT FOR CONSTRUCTION				
FILE NUMBER: 8430-03						
DATE: 06/01/2023						
C2-2						

g:\ncap\projects\Lennar\8430-03 - lemmar - school street - rolesville\03 - DWG\plansheets\On-Site\C2-0 - SITE-PLAN.dwg Layout: C2-3 ENLARGED SITE PLAN (3 OF 6) Plotted: 6/12/2023 1:40:08 PM



PATSY V. YOUNG ET AL.
WF 20-E-2569
DB 9301 PG 1320
BM 1935 PG 60
PIN# 1768192148

- SITE PLAN LEGEND
- PROPOSED CURB AND GUTTER
 - PROPOSED RETAINING WALL
 - PROPOSED HANDICAP PAVEMENT MARKING
 - PROPOSED SIGN
 - PROPOSED ACCESSIBLE RAMP
 - PROPOSED STANDARD DUTY CONCRETE PAVT
 - TYPICAL FITNESS STATION
 - PROPOSED EASEMENT
 - PROPOSED STORM EASEMENT
 - PROPOSED ROW
 - PROPOSED SETBACK
 - PROPOSED BUFFER
 - EXTENT OF FLOOD PRONE SOIL PER WAKE GIS
 - POLLINATOR GARDEN
 - FUTURE SIDEWALK

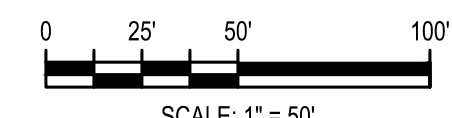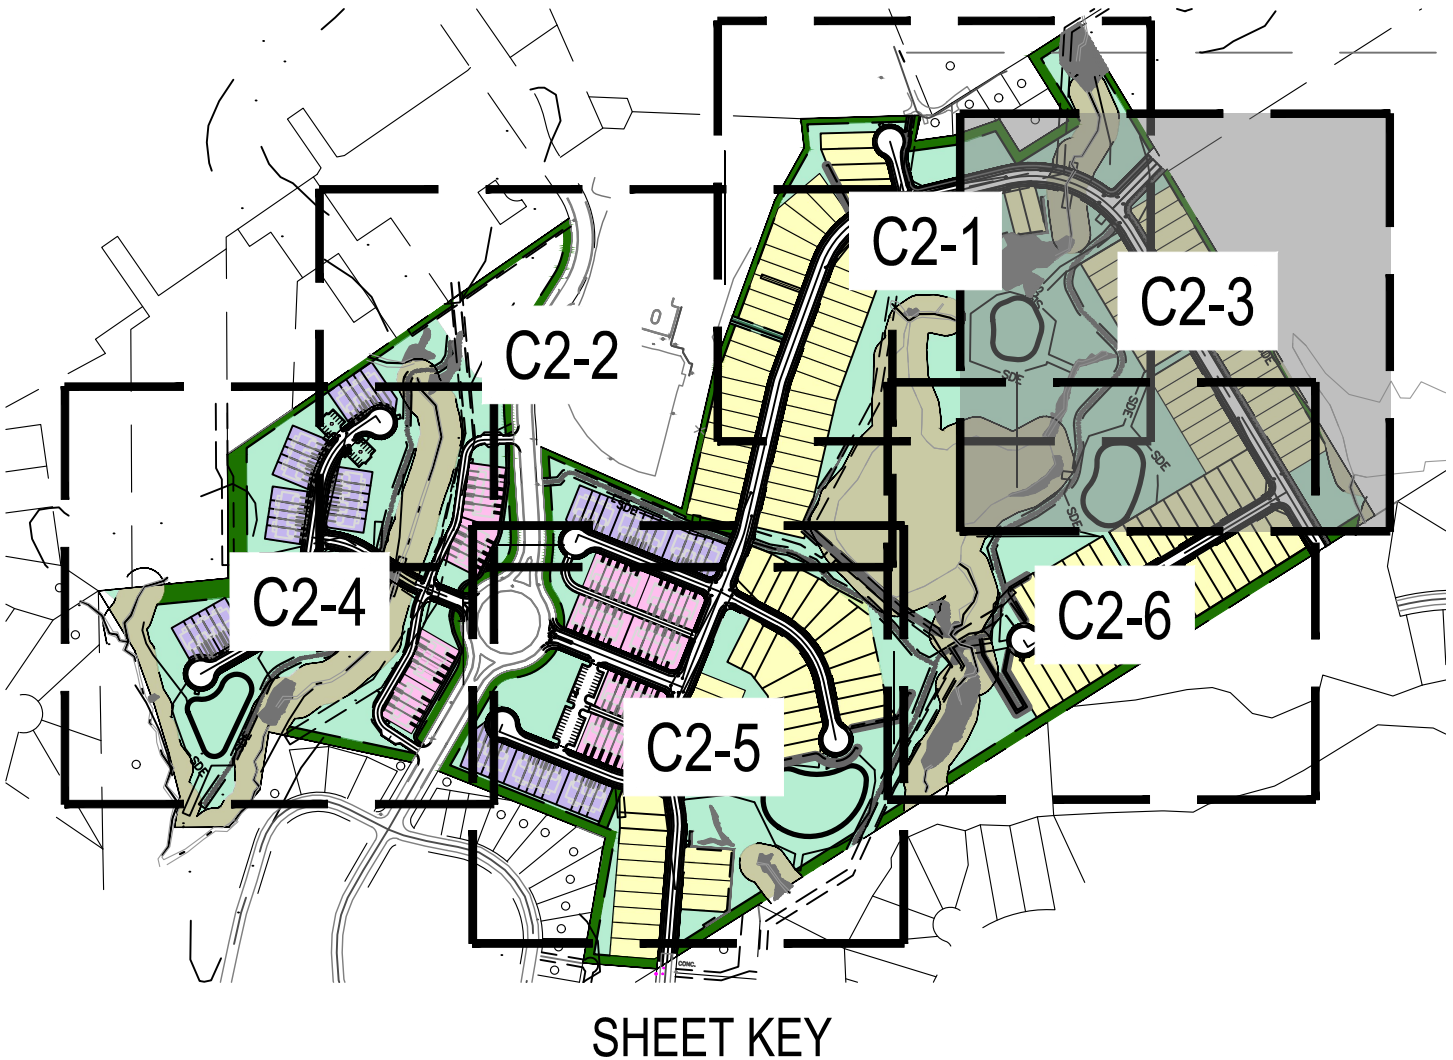

DESIGNED BY: DF/CD	
DRAWN BY: DF/JWM	
REVIEWED BY: DF	
PER TOWN OF ROLESVILLE COMMENT	
06/01/2023	INITIAL SUBMITTAL

5440 WADE PARK BLVD, SUITE 102
RALEIGH NC 27607
WWW.BCEINC.COM
NC LICENSE #C-4397

LENNAR
CORPORAION

1100 PERIMETER PARK DRIVE, SUITE 112
MORRISVILLE / NORTH CAROLINA / 27560

PARKER RIDGE

82 SCHOOL STREET
ROLESVILLE / NORTH CAROLINA / 27571

ENLARGED SITE PLAN
(3 OF 7)

PRELIMINARY
ENGINEER
PEDRO M. FERRERA
NOT FOR
CONSTRUCTION

FILE NUMBER:
8430-03




DATE: 06/01/2023

C2-3


S:\NCAP\Projects\Lennar\8430-03 - Lennar - school street - rolesville\03 - DWG\plansheets\On-Site\C2-0 - SITE-PLAN.dwg Layout: C2-4 ENLARGED SITE PLAN (4 OF 6) Plotted: 6/12/2023 1:40:18 PM

MAX VIII, LLC
56 PG 1235
3 PG 1030
758785571

STORAGE MAX II, LLC
DB 11710 PG 2072
BM 2005 PG 2354
PIN# 1758787576

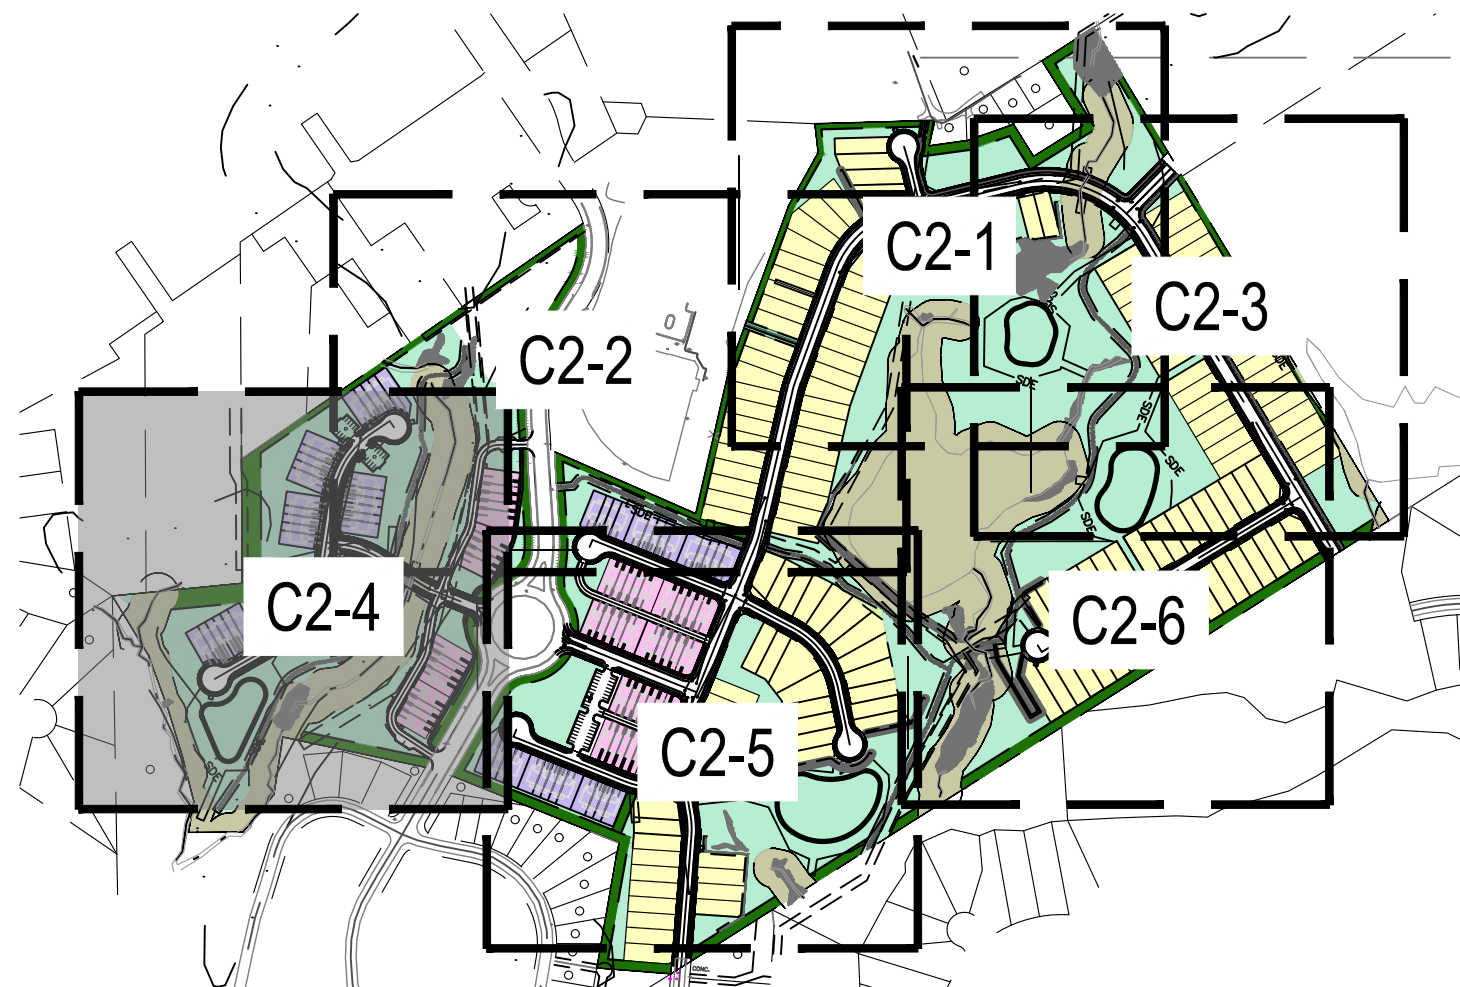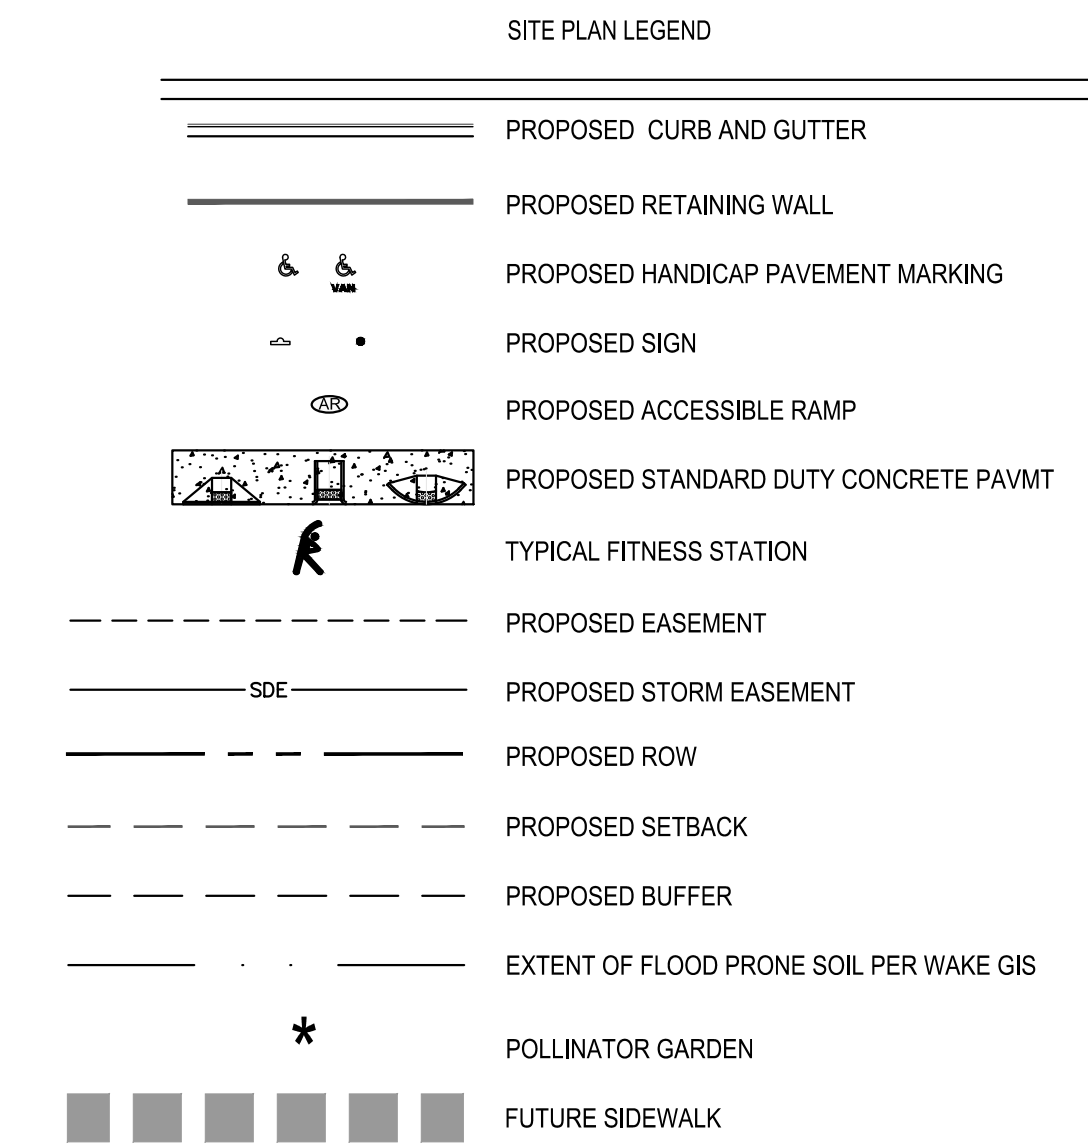
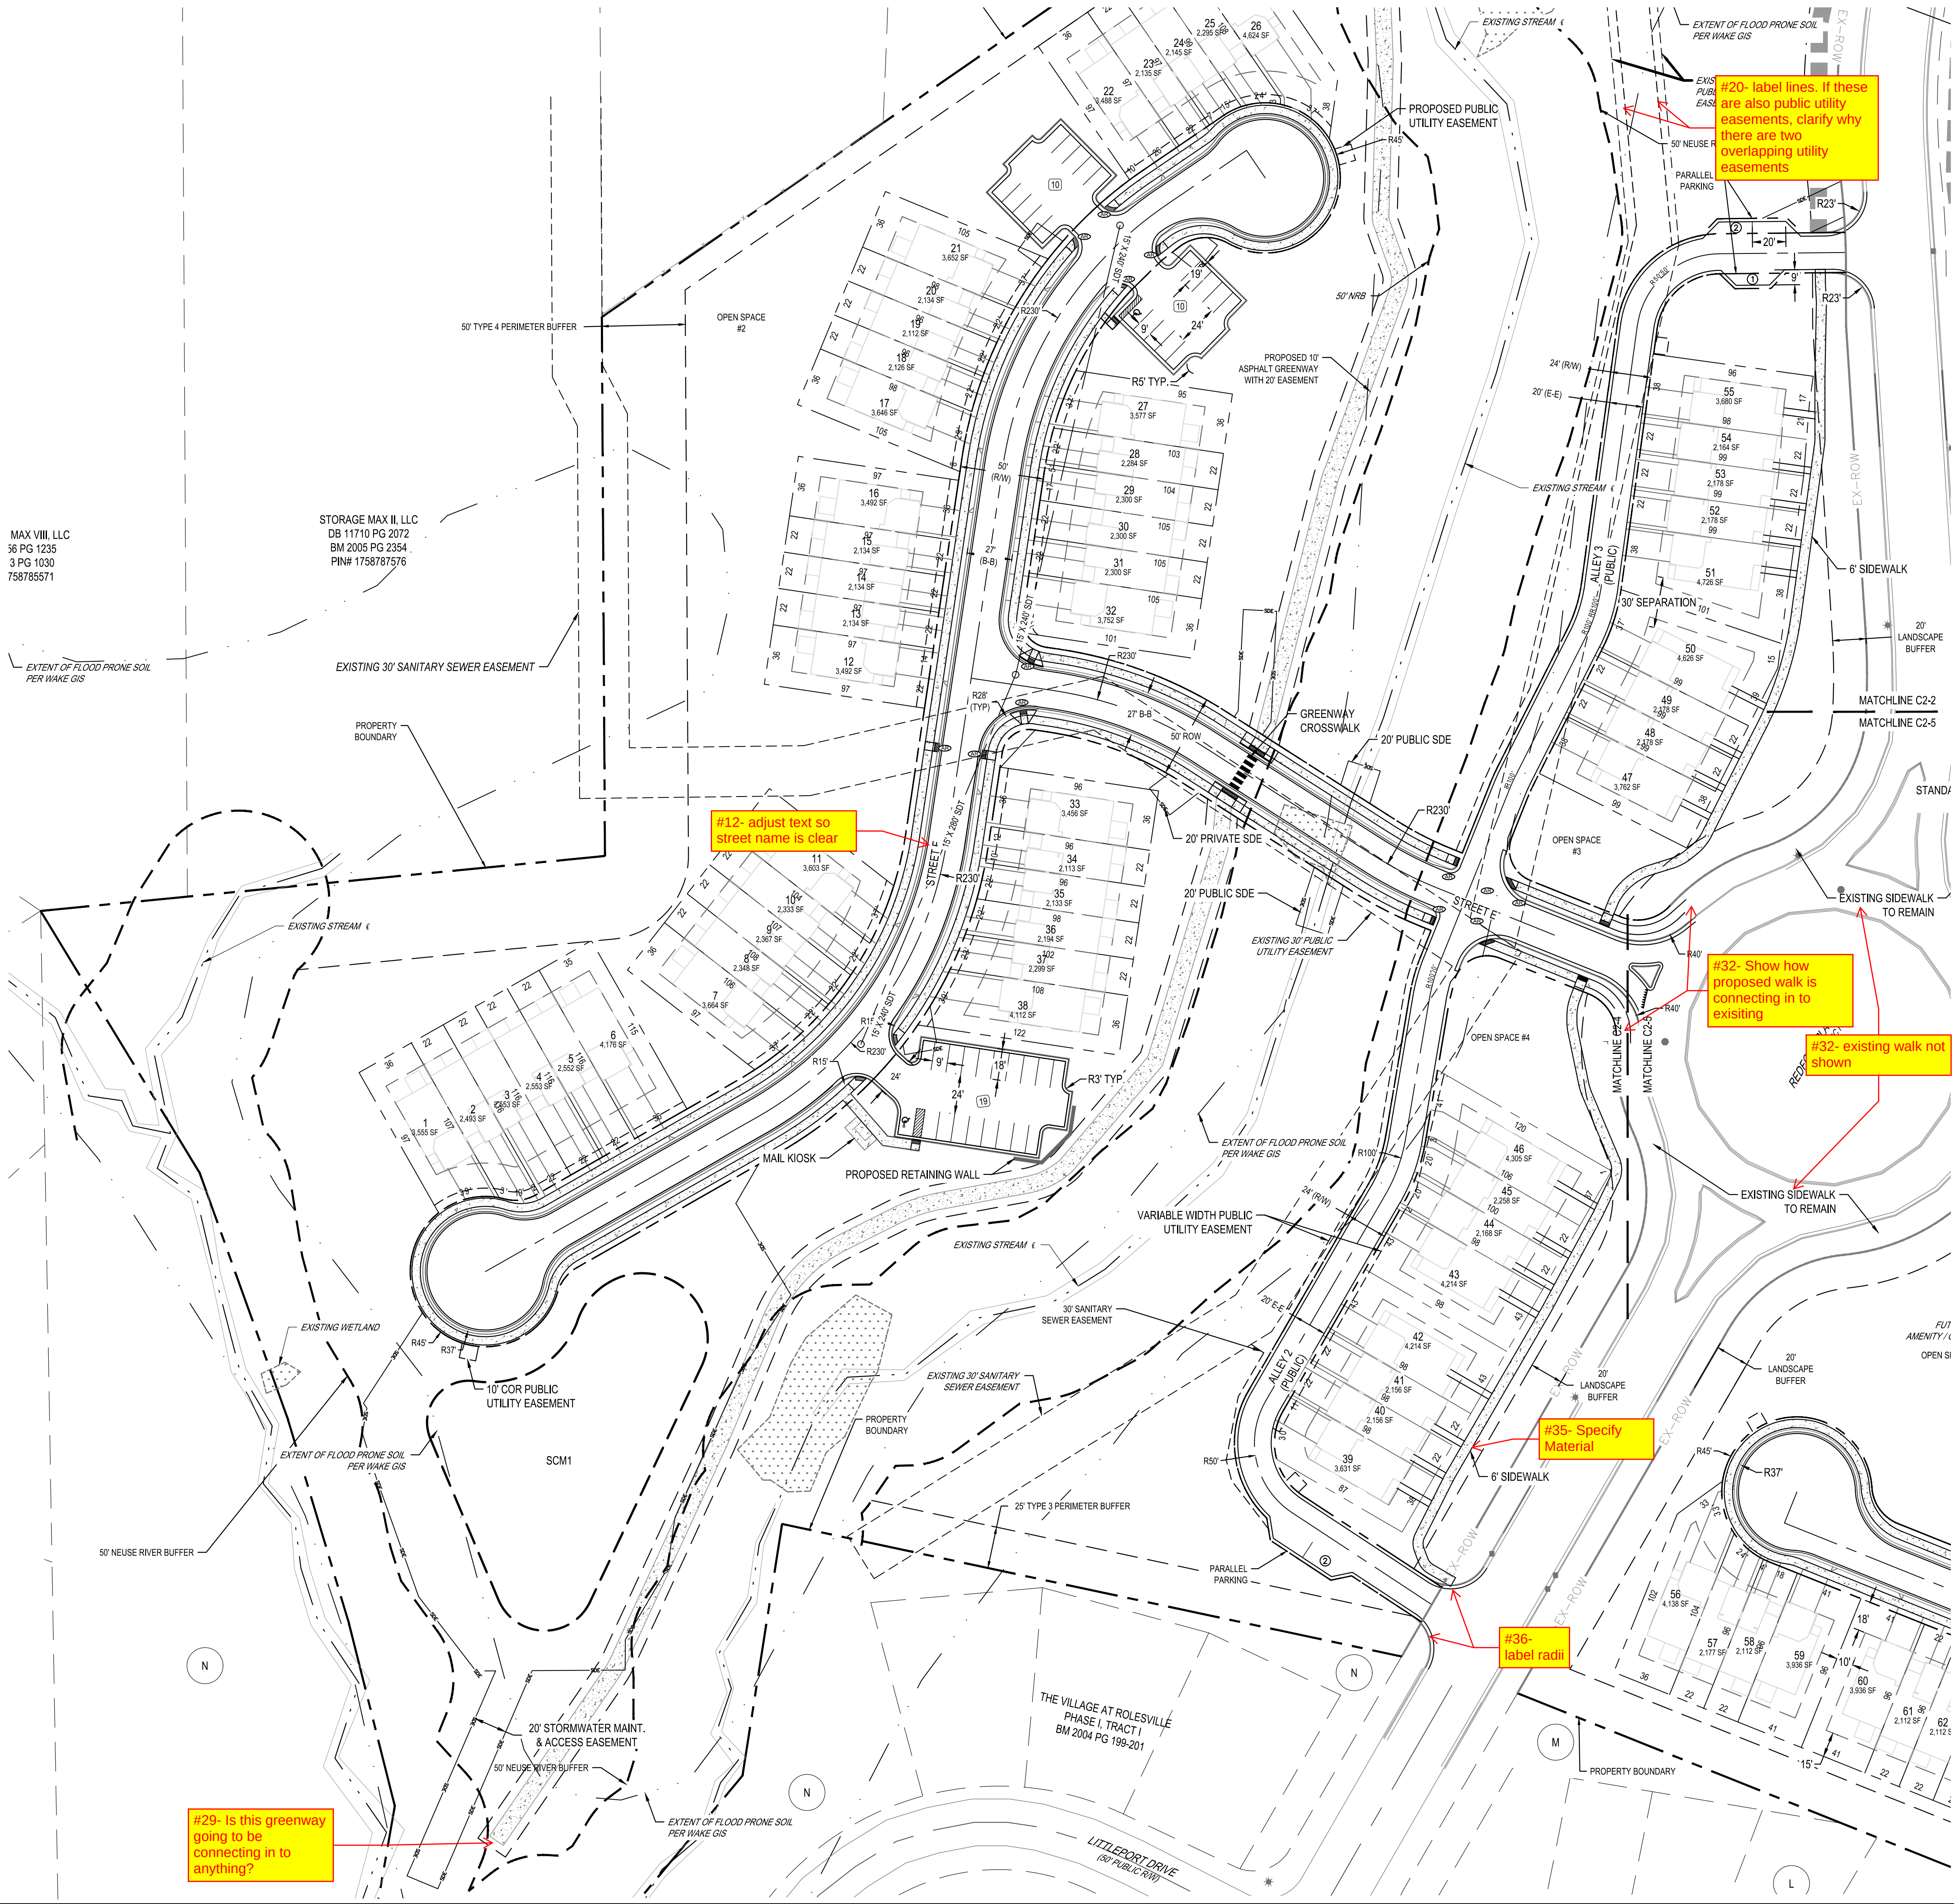


SHEET KEY


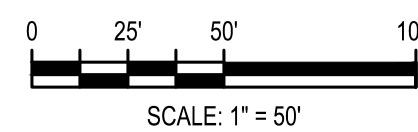


Know what's below.
Call before you dig.

DESIGNED BY: DF/CD		06/01/2023		PER TOWN OF ROLESVILLE COMMENT	
DRAWN BY: DF/JWM		REV		04/03/2023	
REVIEWED BY: DF		REV		04/03/2023	
BCE		5440 WADE PARK BLVD, SUITE 102 RALEIGH NC 27607 WWW.BCEINC.COM NC LICENSE #C-4397		©2023	
LENNAR CORPORAION		1100 PERIMETER PARK DRIVE, SUITE 112 MORRISVILLE / NORTH CAROLINA / 27560			
PARKER RIDGE		82 SCHOOL STREET ROLESVILLE / NORTH CAROLINA / 27571			
ENLARGED SITE PLAN (4 OF 6)					
PRELIMINARY		NORTH CAROLINA PROFESSIONAL ENGINEER FEDRA M. FERNANDEZ		NOT FOR CONSTRUCTION	
FILE NUMBER: 8430-03		DATE: 06/01/2023			
C2-4					

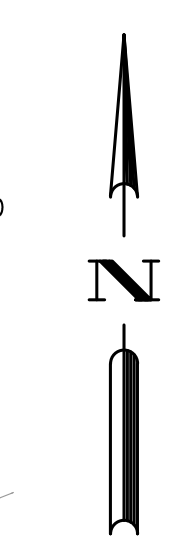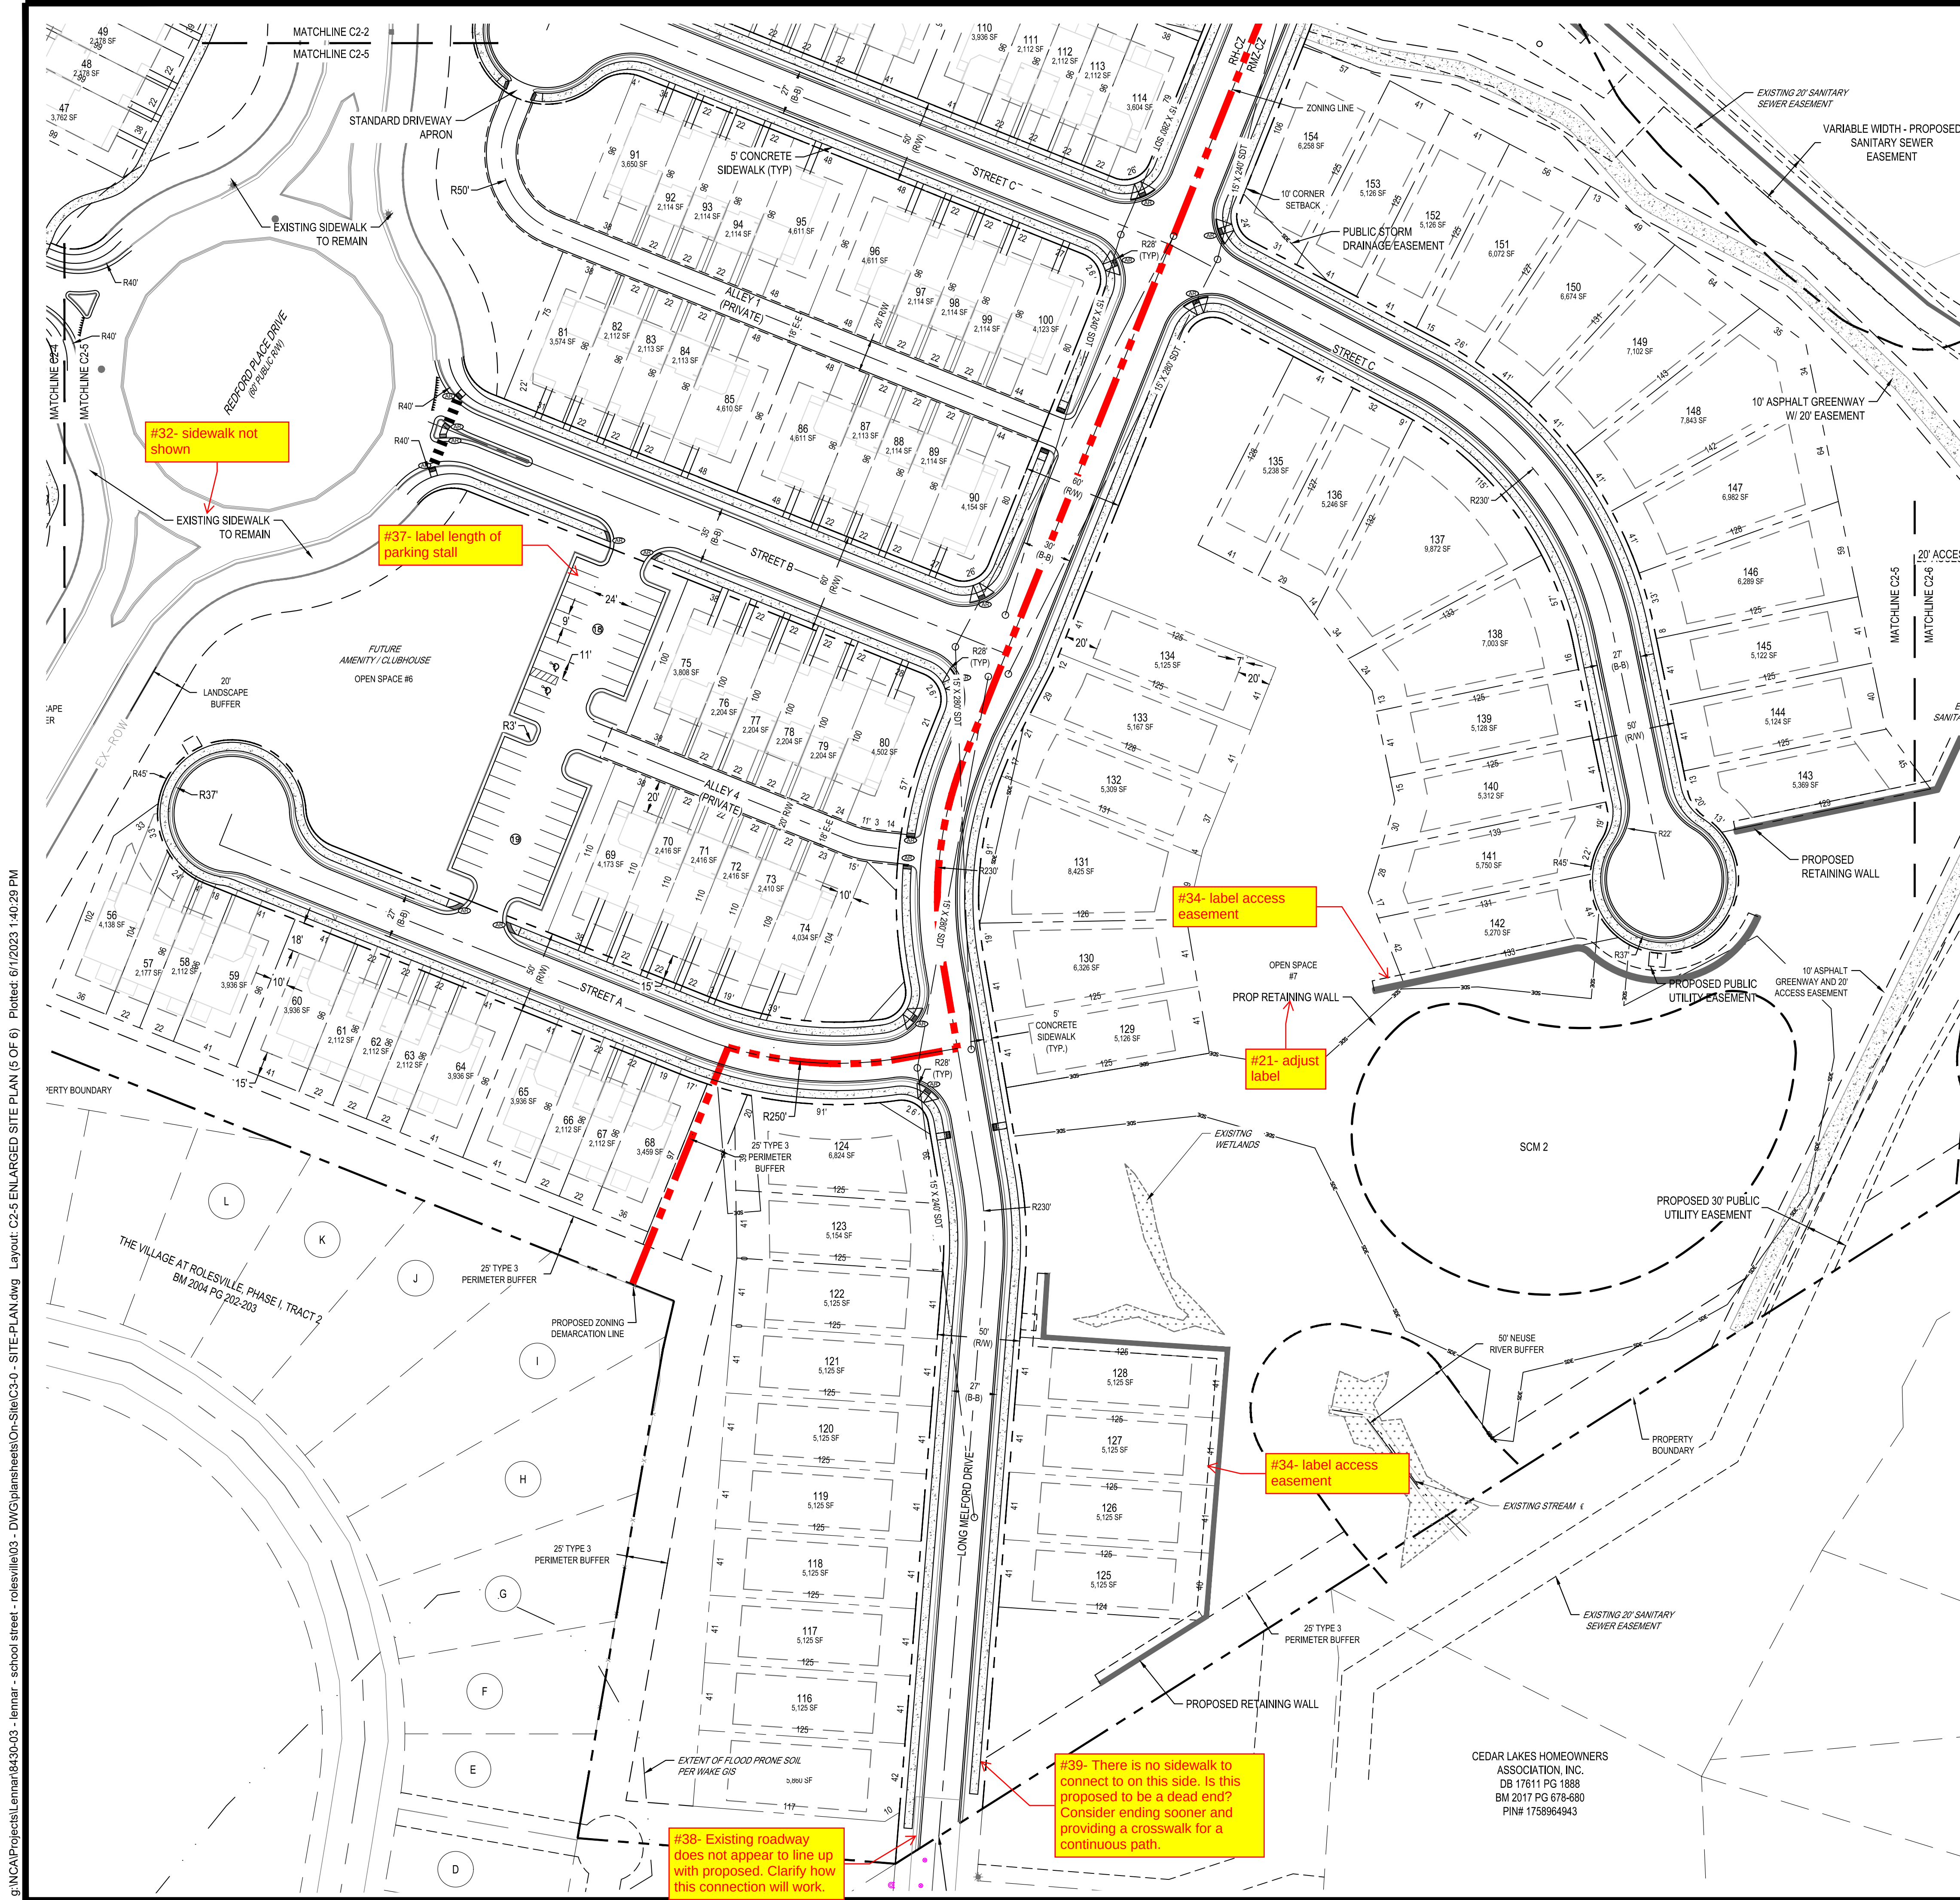

- SITE PLAN LEGEND
- PROPOSED CURB AND GUTTER
 - PROPOSED RETAINING WALL
 - PROPOSED HANDICAP PAVEMENT MARKING
 - PROPOSED SIGN
 - PROPOSED ACCESSIBLE RAMP
 - PROPOSED STANDARD DUTY CONCRETE PAVT
 - TYPICAL FITNESS STATION
 - PROPOSED EASEMENT
 - PROPOSED STORM EASEMENT
 - PROPOSED ROW
 - PROPOSED SETBACK
 - PROPOSED BUFFER
 - EXTENT OF FLOOD PRONE SOIL PER WAKE GIS
 - POLLINATOR GARDEN
 - FUTURE SIDEWALK

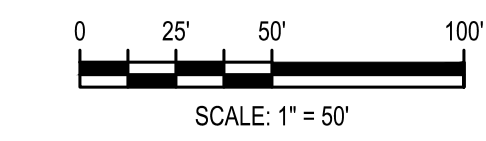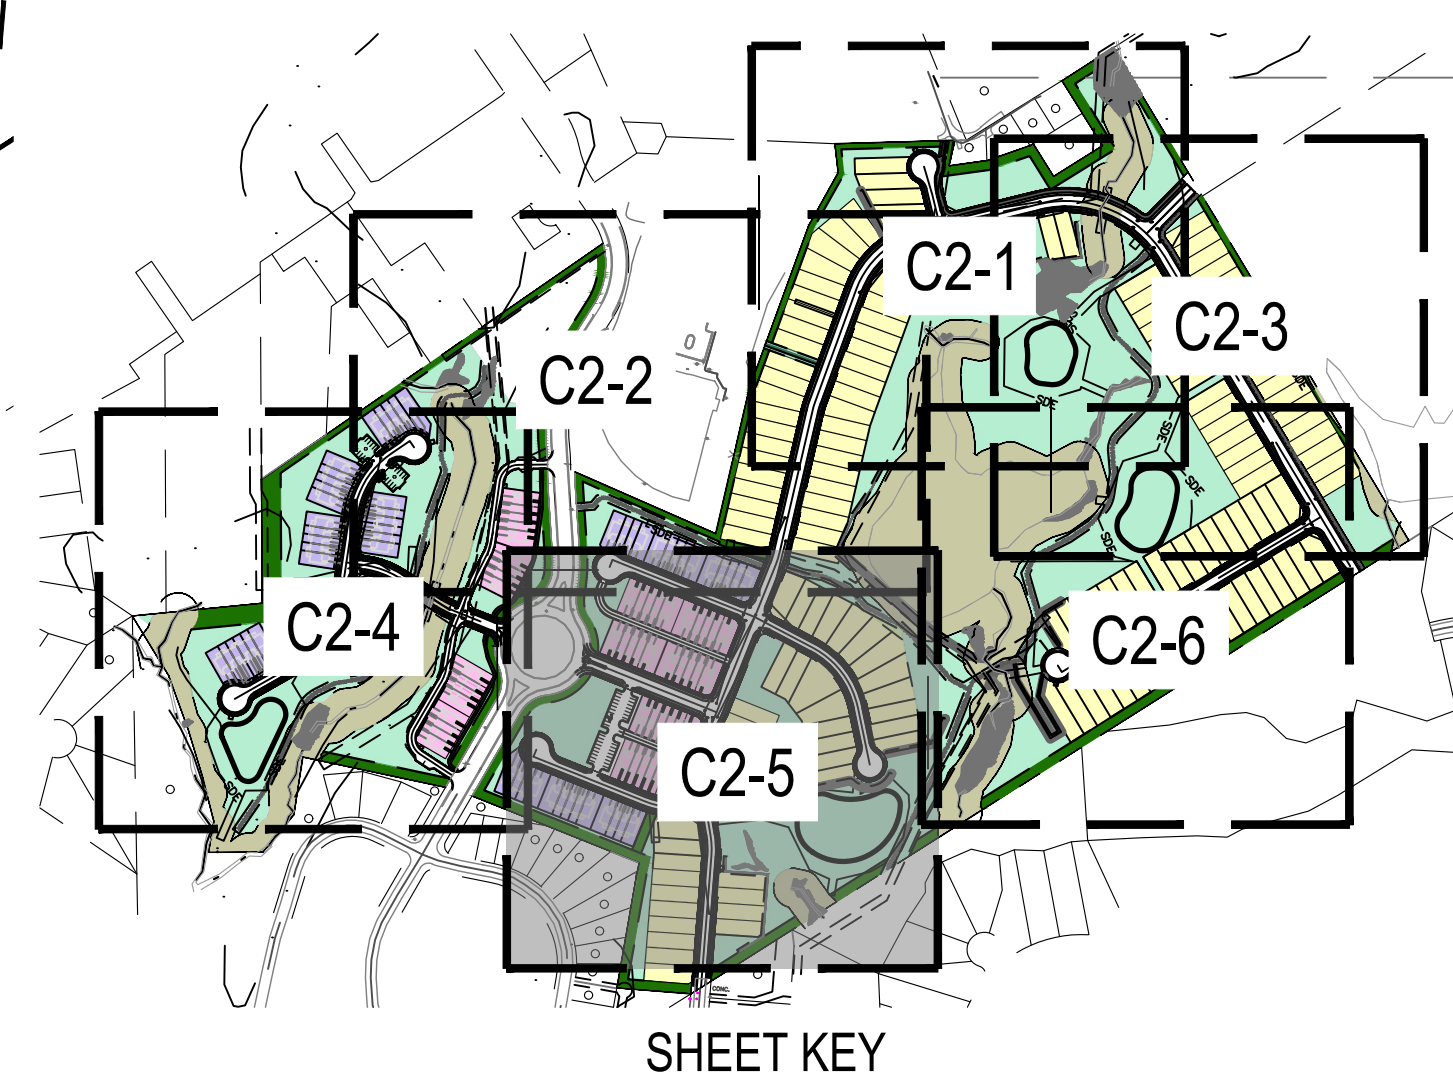

CEDAR LAKES HOMEOWNERS ASSOCIATION, INC.
DB 17611 PG 1888
BM 2017 PG 678-680
PIN# 1758964943


BCE		5440 WADE PARK BLVD, SUITE 102 RALEIGH NC 27607 WWW.BCEINC.COM NC LICENSE #C-4397	
LENNAR CORPORATION		1100 PERIMETER PARK DRIVE, SUITE 112 MORRISVILLE / NORTH CAROLINA / 27560	
PARKER RIDGE		82 SCHOOL STREET ROLESVILLE / NORTH CAROLINA / 27571	
ENLARGED SITE PLAN (5 OF 6)		PRELIMINARY ENGINEER PEDRA M. FERNANDEZ NOT FOR CONSTRUCTION	
FILE NUMBER: 8430-03		DATE: 06/01/2023	
C2-5		PER TOWN OF ROLESVILLE COMMENT 06/01/2023 REV 04/03/2023 INITIAL SUBMITTAL	

out: C2-6 ENLARGED SITE PLAN (6 OF 6) Plotted: 6/12/2023 1:40:38 PM


g:\NCAP\projects\Lennar\8430-03 - lemmar - school street - rolesville\03 - DWG\plansheets\On-Site\C3-0 - SITE

#20- There appear to be two overlapping sanitary sewer easements, please verify if this is the intent.


#12- Correct text

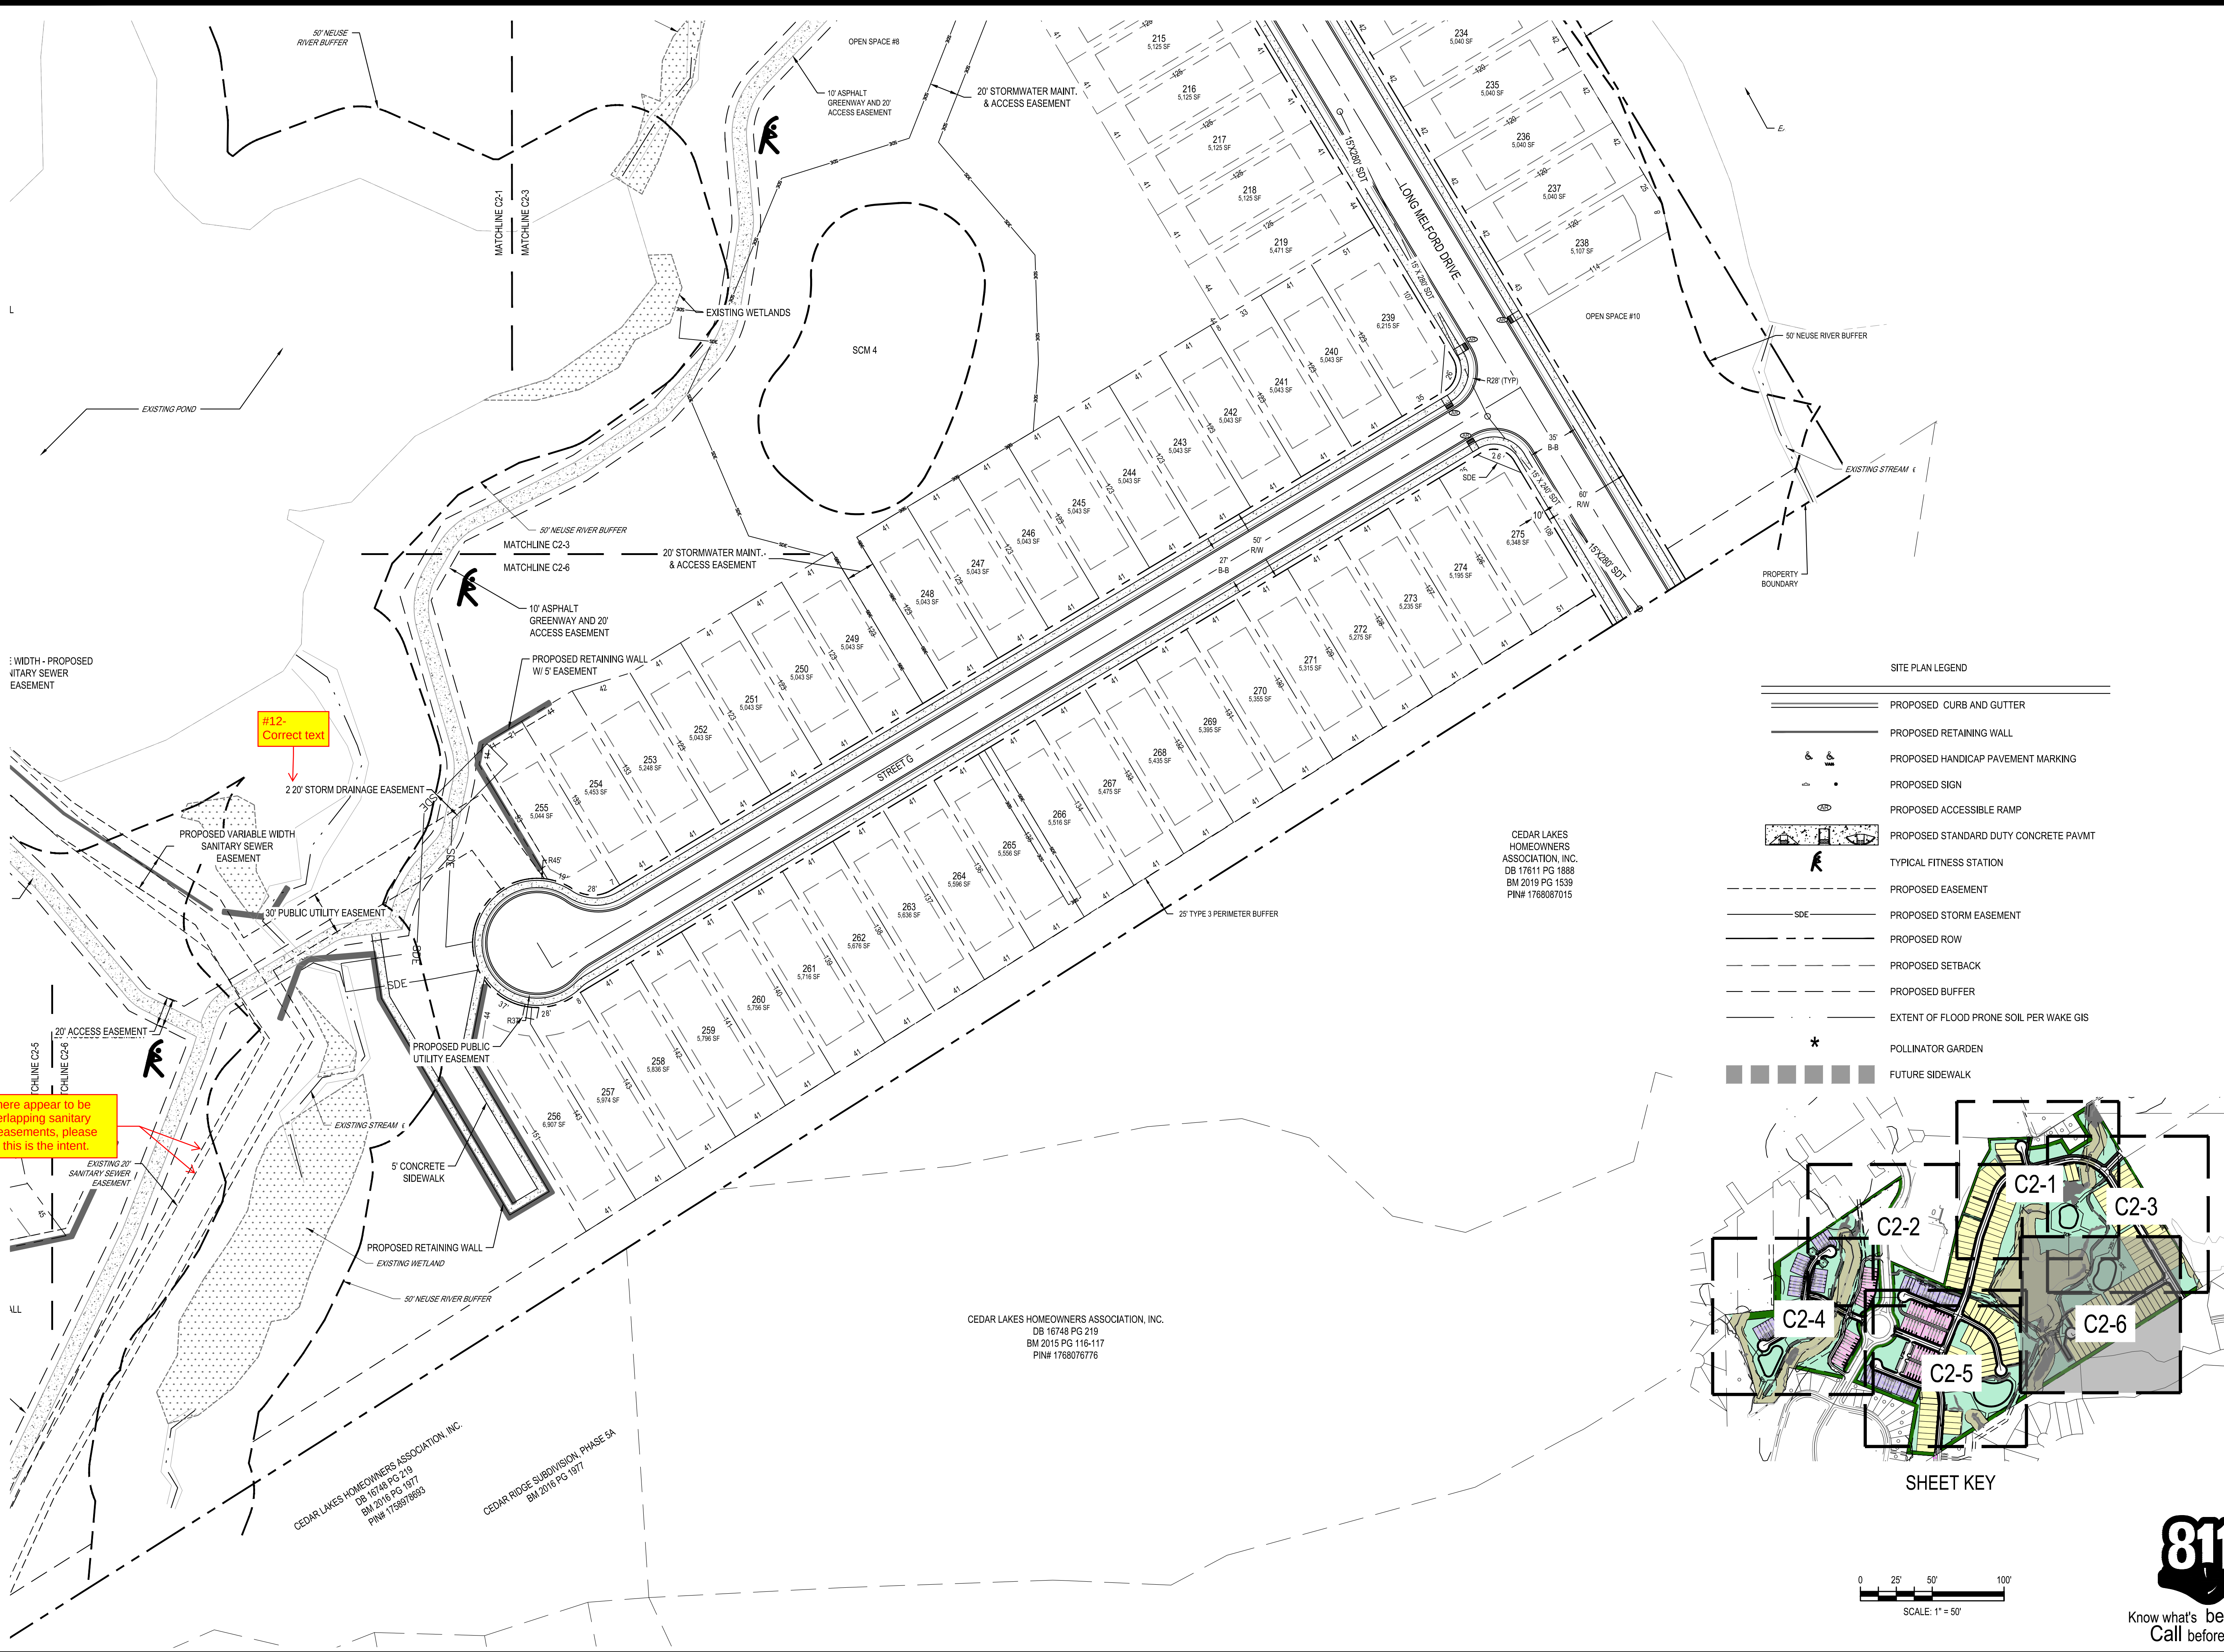

- SITE PLAN LEGEND
- PROPOSED CURB AND GUTTER
 - PROPOSED RETAINING WALL
 - PROPOSED HANDICAP PAVEMENT MARKING
 - PROPOSED SIGN
 - PROPOSED ACCESSIBLE RAMP
 - PROPOSED STANDARD DUTY CONCRETE PAVT
 - TYPICAL FITNESS STATION
 - PROPOSED EASEMENT
 - PROPOSED STORM EASEMENT
 - PROPOSED ROW
 - PROPOSED SETBACK
 - PROPOSED BUFFER
 - EXTENT OF FLOOD PRONE SOIL PER WAKE GIS
 - POLLINATOR GARDEN
 - FUTURE SIDEWALK

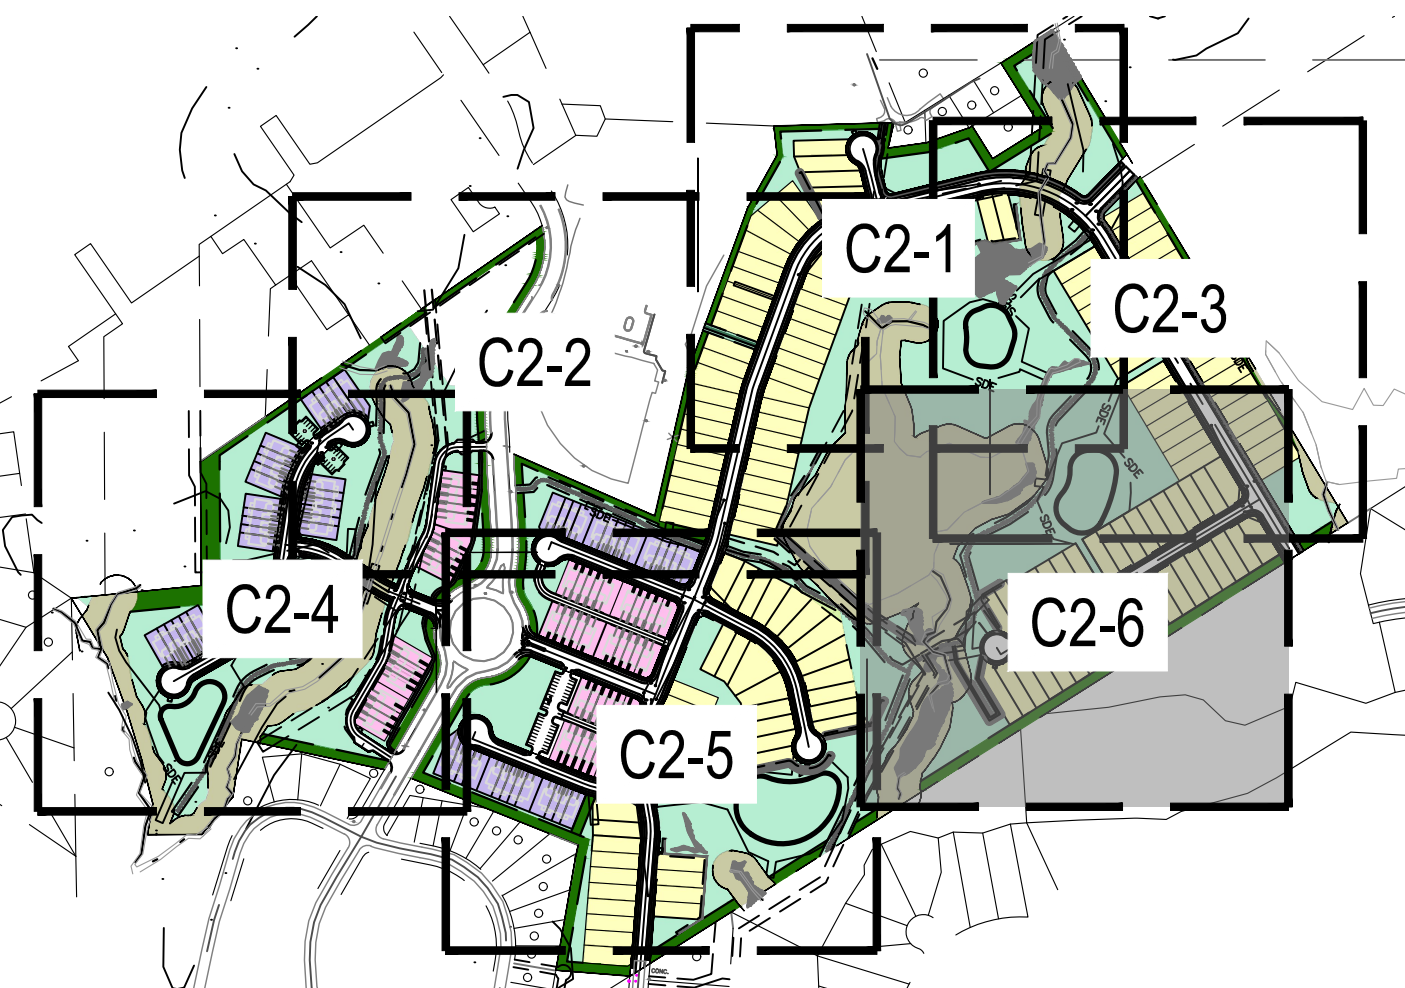

SHEET KEY

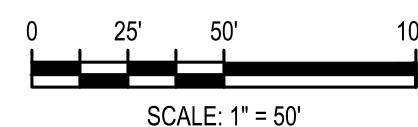

DESIGNED BY: DF/CD	
DRAWN BY: DF/JWM	
REVIEWED BY: DF	
REV 04/03/2023	
PER TOWN OF ROLESVILLE COMMENT	
INITIAL SUBMITTAL	

BCE
5440 WADE PARK BLVD, SUITE 102
RALEIGH NC 27607
WWW.BCEINC.COM
NC LICENSE #C-4397


LENNAR CORPORATION
1100 PERIMETER PARK DRIVE, SUITE 112
MORRISVILLE / NORTH CAROLINA / 27560

PARKER RIDGE
82 SCHOOL STREET
ROLESVILLE / NORTH CAROLINA / 27571

ENLARGED SITE PLAN (6 OF 6)


PRELIMINARY
ENGINEER
CEDRA M. FERNANDEZ
NOT FOR CONSTRUCTION
FILE NUMBER: 8430-03
DATE: 06/01/2023

C2-6

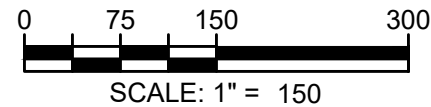

Know what's below.
Call before you dig.

A circular professional seal for the State of North Carolina. The outer ring contains the text "NORTH CAROLINA" at the top and "PROFESSIONAL" at the bottom. Inside this ring, the word "PRELIMINARY" is centered. Below "PRELIMINARY", the name "DEBRA M. FENN" is written in a curved path. At the bottom of the seal, the words "NOT FOR CONSTRUCTION" are printed in a bold, sans-serif font.

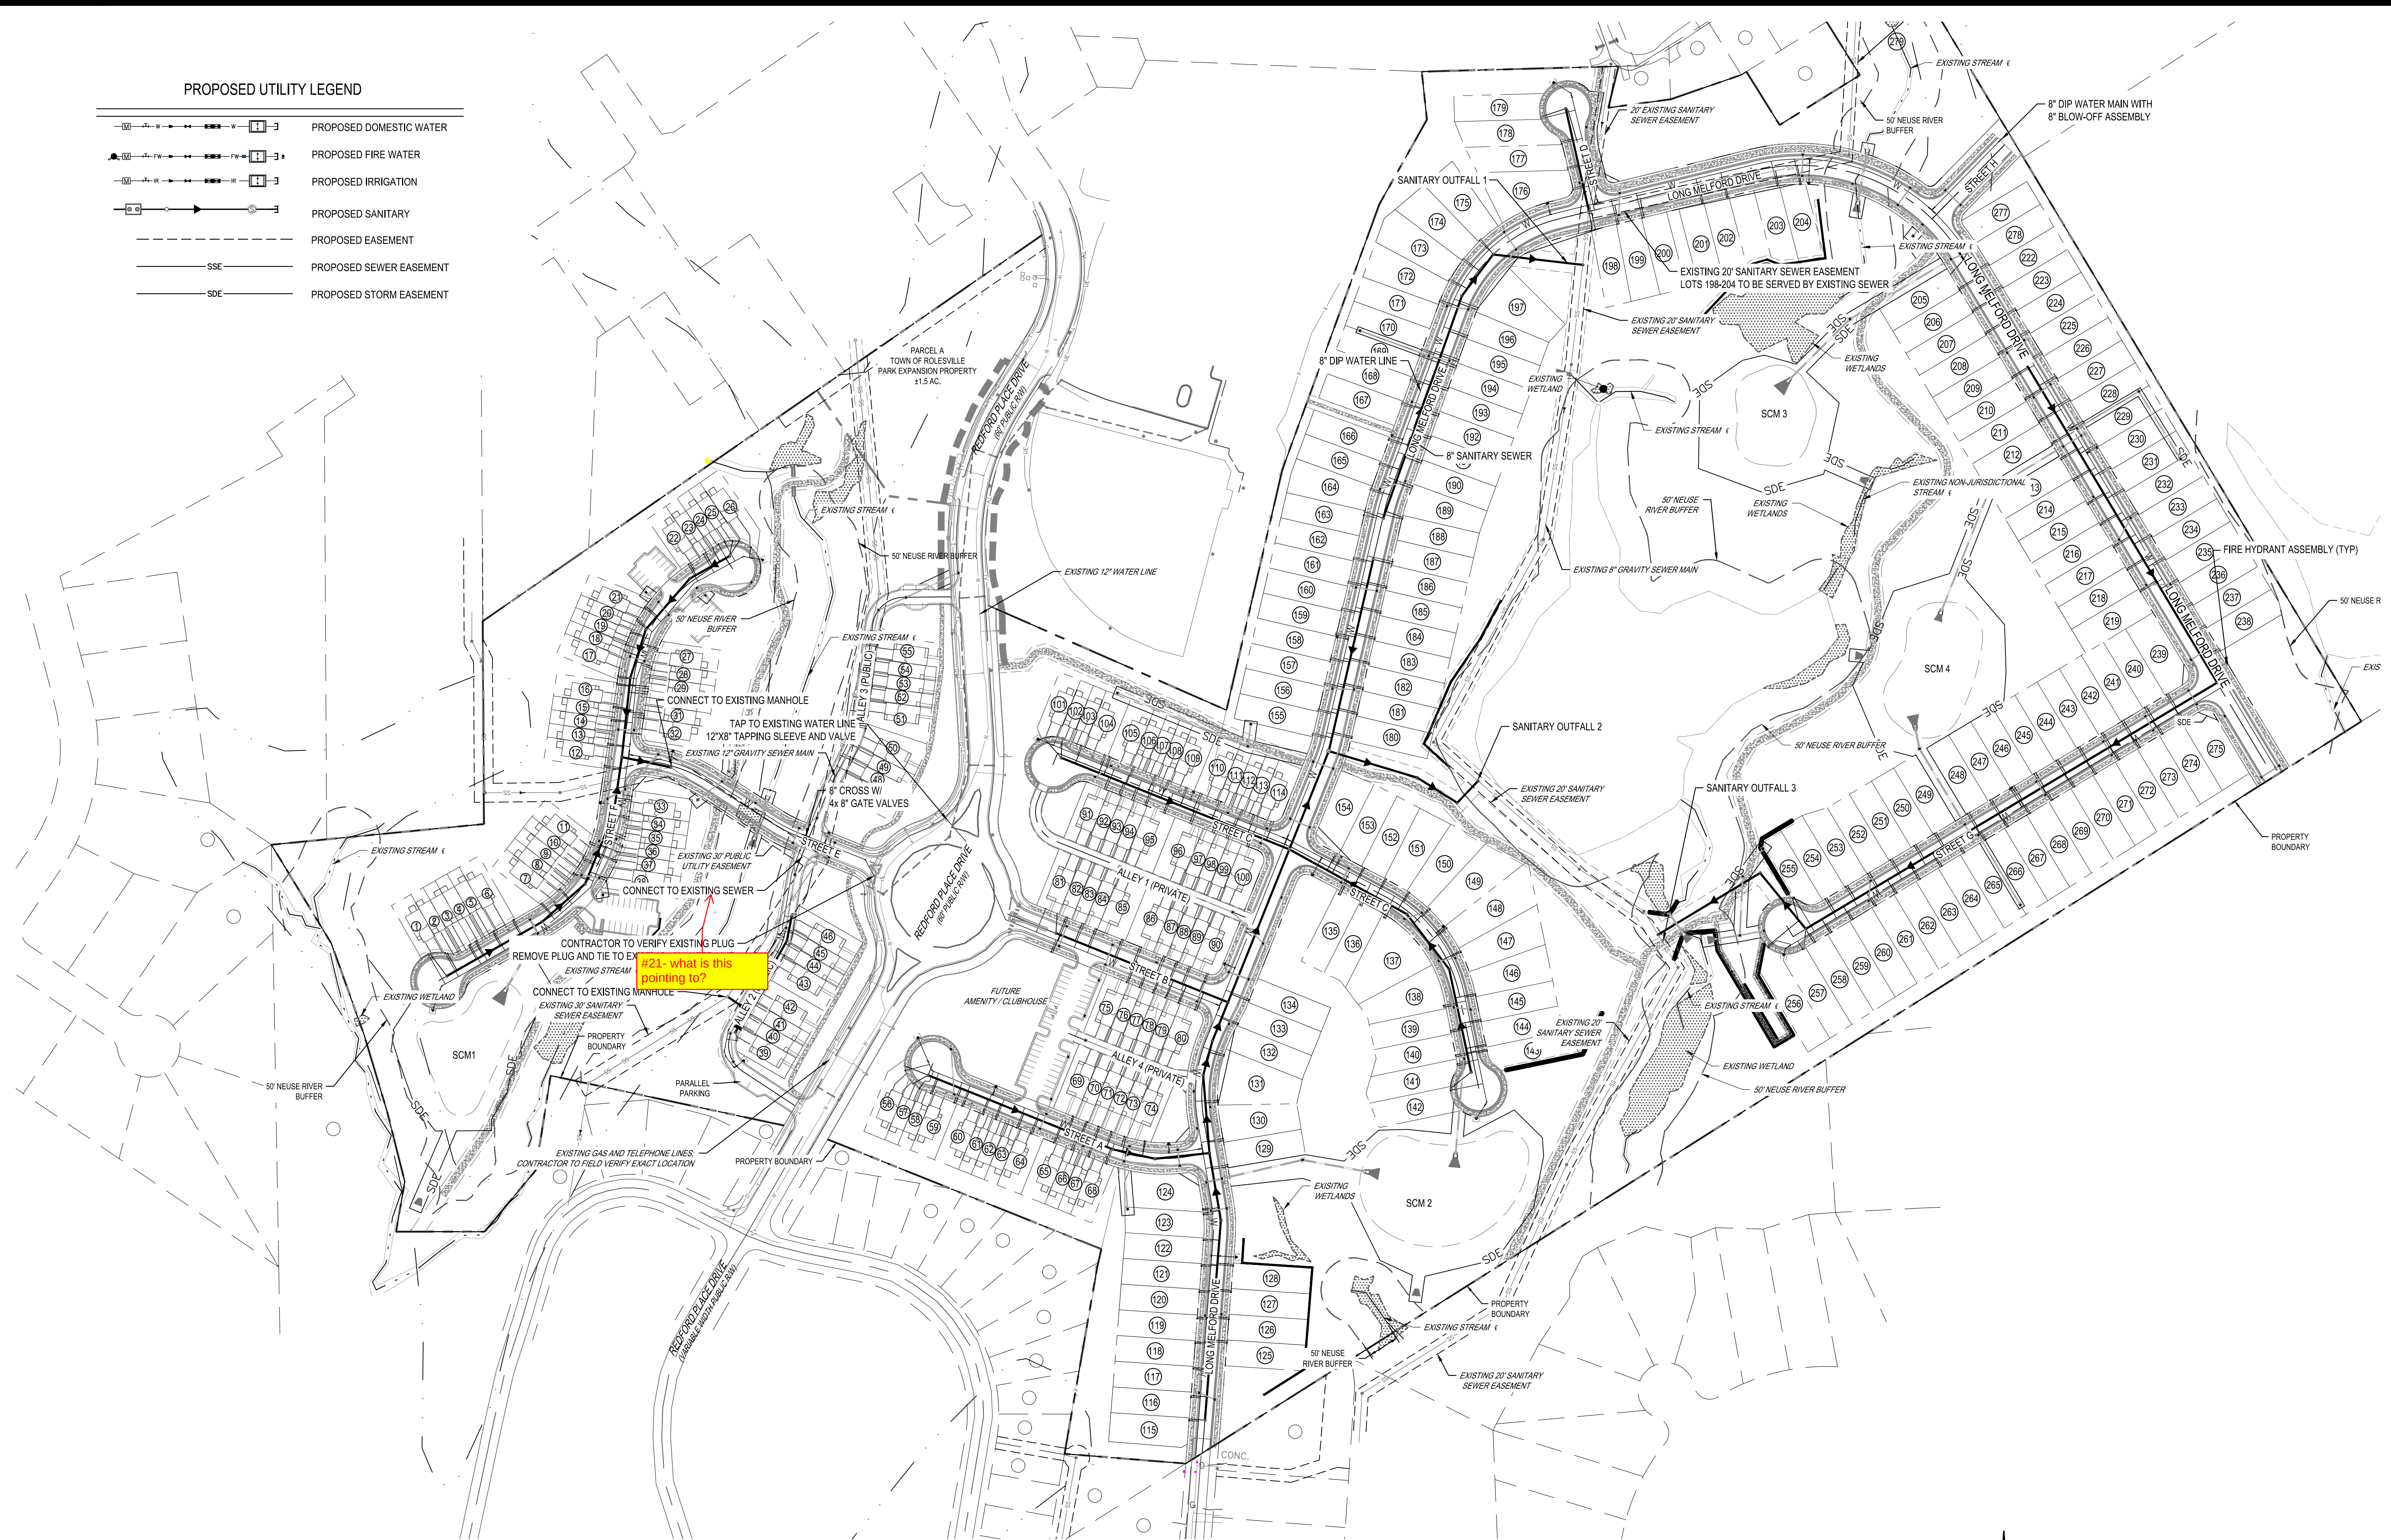

Know what's below.
Call before you dig.

OVERALL UTILITY PLAN

NORTH CAROLINA
REGISTERED
PROFESSIONAL

PRELIMINARY

ENGINEER
JESSICA M. FORD

**NOT FOR
CONSTRUCTION**

FILE NUMBER:
8430-03

DATE: 06/01/2023

C3-0

PARKER RIDGE
92 SCHOOL STREET
ROLESVILLE / NORTH CAROLINA / 27571


**LENNAR
CORPORAION**
1109 PERIMETER PARK DRIVE, SUITE 112
MORRISVILLE / NORTH CAROLINA / 27560

BCE

5440 WILKES PARKWAY, SUITE 102
ROLESVILLE, NC 27571
WWW.BCEINC.COM
NC LICENSE #C-4387 ©2023

DESIGNED BY:	DF/CD	06/01/2023	PER TOWN OF ROLESVILLE COMMENT
DRAWN BY:	DF/JWM	REV	04/03/2023 INITIAL SUBMITTAL
REVIEWED BY:	DF		

g:\NCAP\Projects\Lennar\8430-03 - Lennar - school street - DWG\plansheets\On-Site\U1-0 - UTIL-PLAN.dwg Layout: C3-3 ENLARGED UTILITY PLAN (3 OF 6) Plotted: 5/31/2023 1:09:21 PM

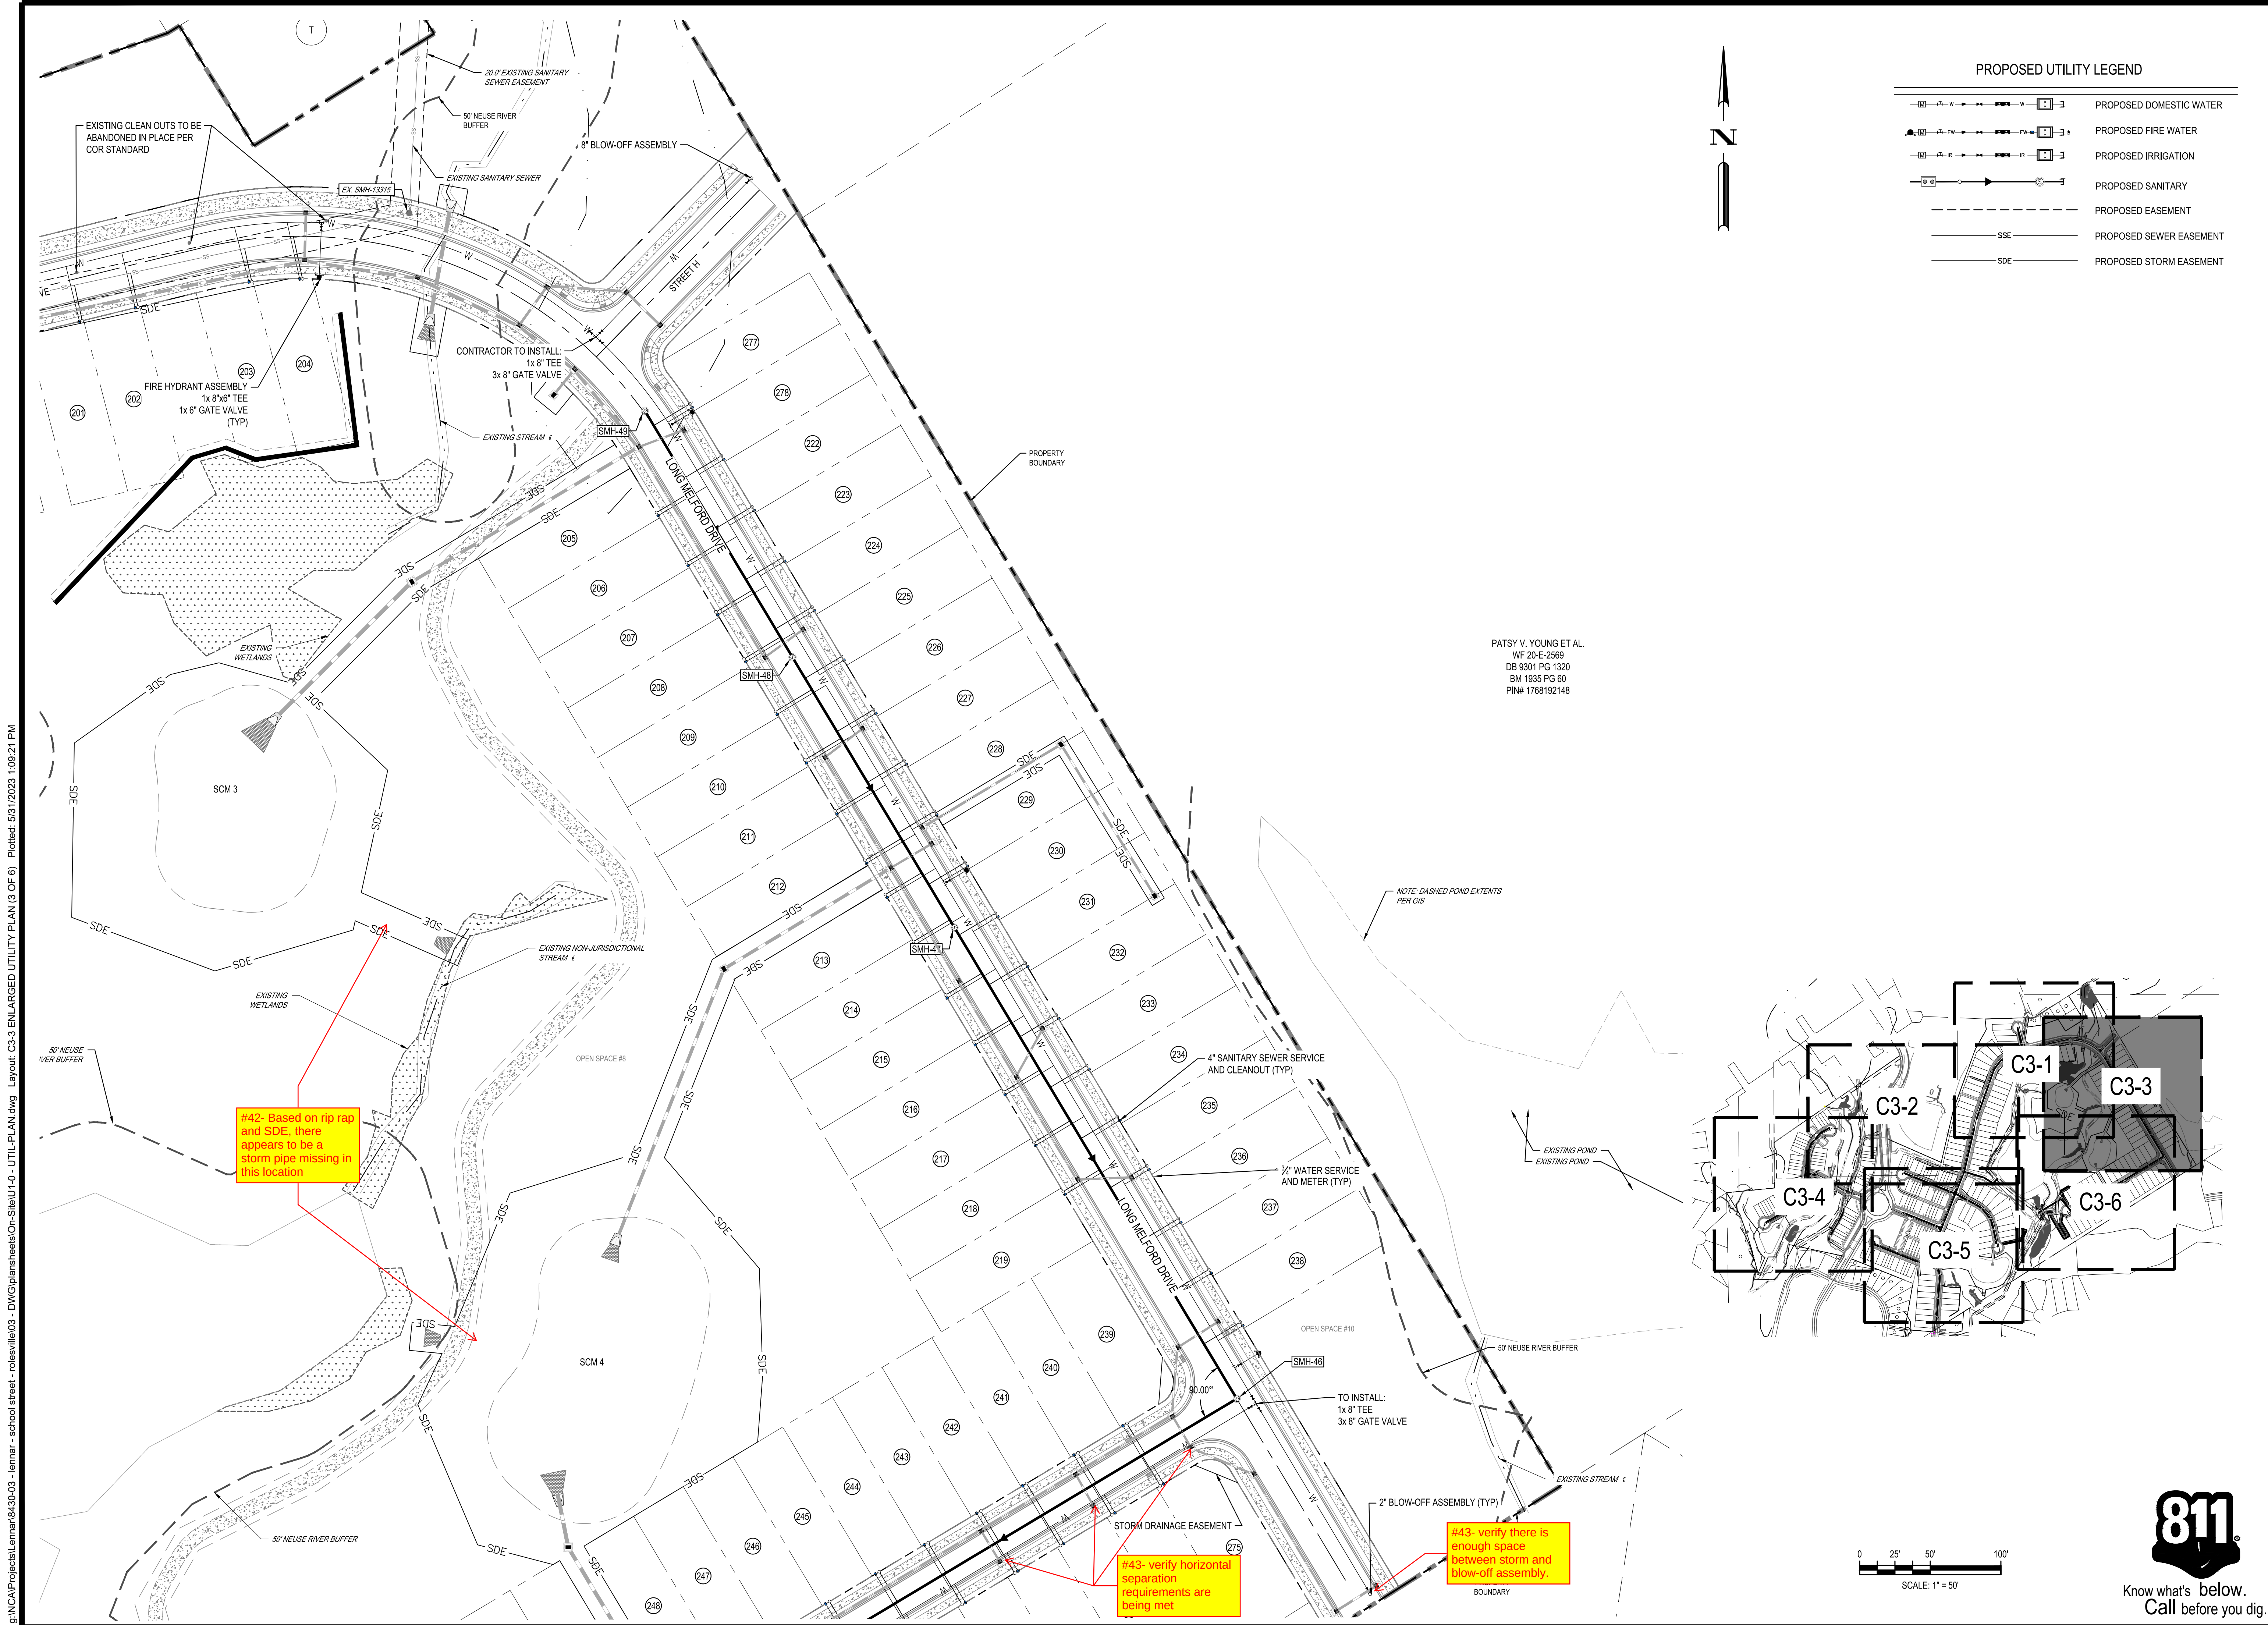

PROPOSED UTILITY LEGEND

- PROPOSED DOMESTIC WATER
- PROPOSED FIRE WATER
- PROPOSED IRRIGATION
- PROPOSED SANITARY
- PROPOSED EASEMENT
- PROPOSED SEWER EASEMENT
- PROPOSED STORM EASEMENT

DESIGNED BY: DF/CD

DRAWN BY: DF/JWM

REVIEWED BY: DF

PER TOWN OF ROLESVILLE COMMENT

06/01/2023

INITIAL SUBMITTAL

04/03/2023

REV

04/03/2023

5440 WADE PARK BLVD, SUITE 102

RALEIGH NC 27607

WWW.BCEINC.COM

NC LICENSE #C-4397

©2023

Lennar

CORPORAION

1100 PERMETER PARK DRIVE, SUITE 112

MORRISVILLE / NORTH CAROLINA / 27560

PARKER RIDGE

82 SCHOOL STREET

ROLESVILLE / NORTH CAROLINA / 27571

ENLARGED UTILITY

PLAN (3 OF 6)

PRELIMINARY

NOT FOR CONSTRUCTION


FILE NUMBER: 8430-03

DATE: 06/01/2023

811

Know what's below.
Call before you dig.

C3-3

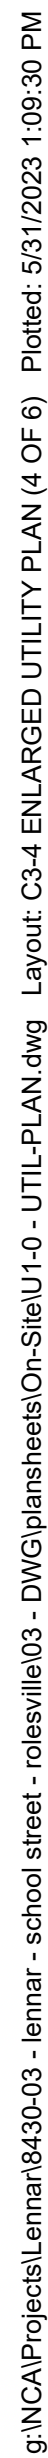



G:\NCA\Projects\Lennar\8430-03 - Lennar - School Street - Rolesville\03 - DWG\PlanSheets\On-Site\C4-0 - GRAD-PLAN.dwg Layout: C4-0 OVERALL GRADING PLAN Plotted: 6/1/2023 1:32:27 PM



DESIGNED BY: DF/CD		06/01/2023	PER TOWN OF ROLESVILLE COMMENT
DRAWN BY: DF/JWM		REV	INITIAL SUBMITTAL
REVIEWED BY: DF		04/03/2023	

5440 WADE PARK BLVD, SUITE 102
RALEIGH NC 27607
WWW.BCEINC.COM
NC LICENSE #C-4397

LENNAR
CORPORAION
1100 PERIMETER PARK DRIVE, SUITE 112
MORRISVILLE / NORTH CAROLINA / 27560

PARKER RIDGE
82 SCHOOL STREET
ROLESVILLE / NORTH CAROLINA / 27571

OVERALL GRADING PLAN

PRELIMINARY
ENGINEER
PEDRO M. FERRERA
NOT FOR CONSTRUCTION
FILE NUMBER: 8430-03
DATE: 06/01/2023

C4-0

G:\NCA\Projects\Lennar\8430-03 - Lennar - School Street - Plan Sheets\On-Site\C4-0 - GRAD-PLAN.dwg Layout: C4-1 ENLARGED GRADING PLAN (1 OF 6) Plotted: 6/1/2023 12:54:32 PM

#49- There are several areas throughout all grading sheets where there aren't many proposed contour labels. Please ensure a sufficient amount of contours are labeled so the grading can be easily followed. This also applies to existing contour labels.

#50- Please label storm pipe size and material type. This applies to all grading and drainage sheets.

KE COUNTY BOARD OF EDUCATION
BM 2003 PG 557
PIN# 1758990785

OLESVILLE
3 618
1 1333
90948

#52- How will this wall be designed? If design is to be by others, please be sure to include a note indicating this. This note applies to all retaining walls.

#53- Proposed drainage easement is required on swales crossing 2 or more lots. This comment applies to all applicable swales.

#51- Proposed contours should tie into existing

#34- label easement

#54- can the Street D label be moved up some so this storm crossing can be seen?

#55- Consider the angle of the pipes and direction of flow for the storm sewer system.

#56- Please show culvert design with plans/storm package. Design for culverts is a 25-yr storm. HGLs will need to be within the pipe. This comment applies to all culverts

#57- Confirm if trees are to be cleared? Trees to be removed should be shown on demo plan

#62- Steep slopes in this area, can they be reduced to 3:1?

#61- How is water draining?

#49- add contour labels in this area

#63- Verify contours are correct. It's hard to tell what's going on in this area and it appears some contours are very close together; ensure slopes aren't too steep

#51- Proposed contours should tie into existing

#58- COR has grading limits in sanitary sewer easements

#60- are these storm pipes? Verify if proposed contours are getting down the the inlet elevation

#59- What elevation is this at? Is it creating any low points that aren't being collected?


#64- Please ensure duplicate names aren't used

PROPOSED GRADING AND DRAINAGE LEGEND	
	PROPOSED BORING
	PROPOSED DETENTION
	PROPOSED GRADING LIMITS
	PROPOSED MAJOR CONTOUR
	PROPOSED MINOR CONTOUR
	PROPOSED SPOT
	PROPOSED GRADING ARROW
	PROPOSED SWALE
	PROPOSED STORM
	PROPOSED STORM SYMBOL
	PROPOSED BUILDING SPOT

0 25' 50' 100'
SCALE: 1" = 50'




Know what's below.
Call before you dig.

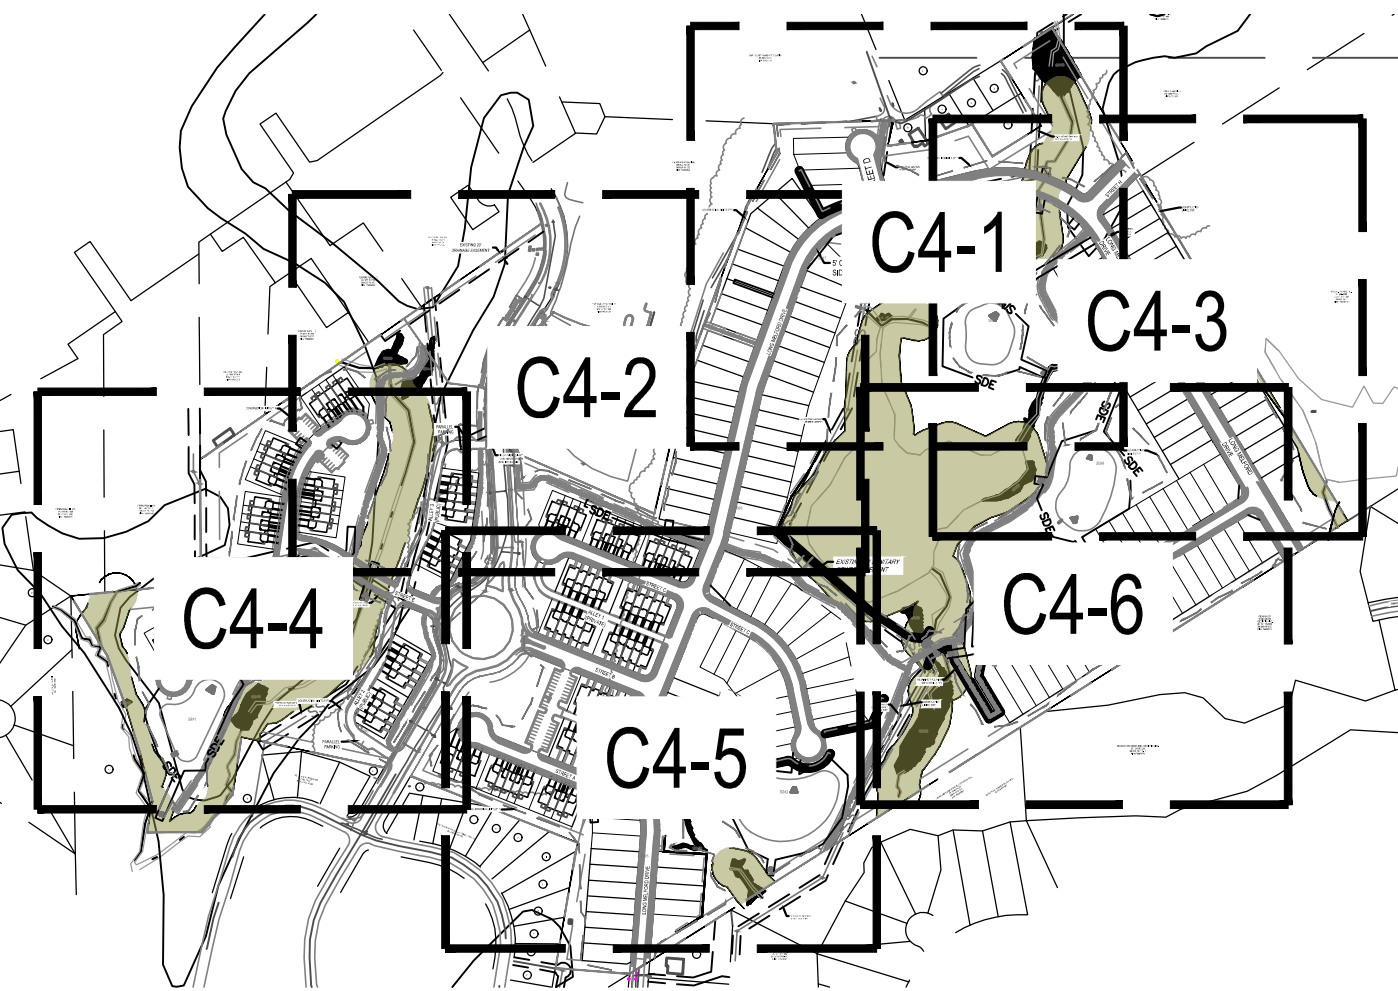

	DESIGNED BY:	DF/CD
	DRAWN BY:	DF/JWM
	REVIEWED BY:	DF
	©2023	
LENNAR CORPORATION	5440 WADE PARK BLVD, SUITE 102 RALEIGH NC 27607 WWW.BCEINC.COM NC LICENSE #C-4397	
	1100 PERIMETER PARK DRIVE, SUITE 112 MORRISVILLE / NORTH CAROLINA / 27560	
PARKER RIDGE	82 SCHOOL STREET ROLESVILLE / NORTH CAROLINA / 27571	
	ENLARGED GRADING PLAN (1 OF 6)	
	NOT FOR CONSTRUCTION	
	FILE NUMBER: 8430-03	
	DATE: 06/01/2023	
	C4-1	

G:\NCA\Projects\Lennar\8430-03 - Lennar - School Street - Rolesville\03 - DWG\PlanSheets\On-Site\C4-0 - GRAD-PLAN.dwg Layout: C4-3 ENLARGED GRADING PLAN (3 OF 6) Plotted: 6/1/2023 12:59:40 PM

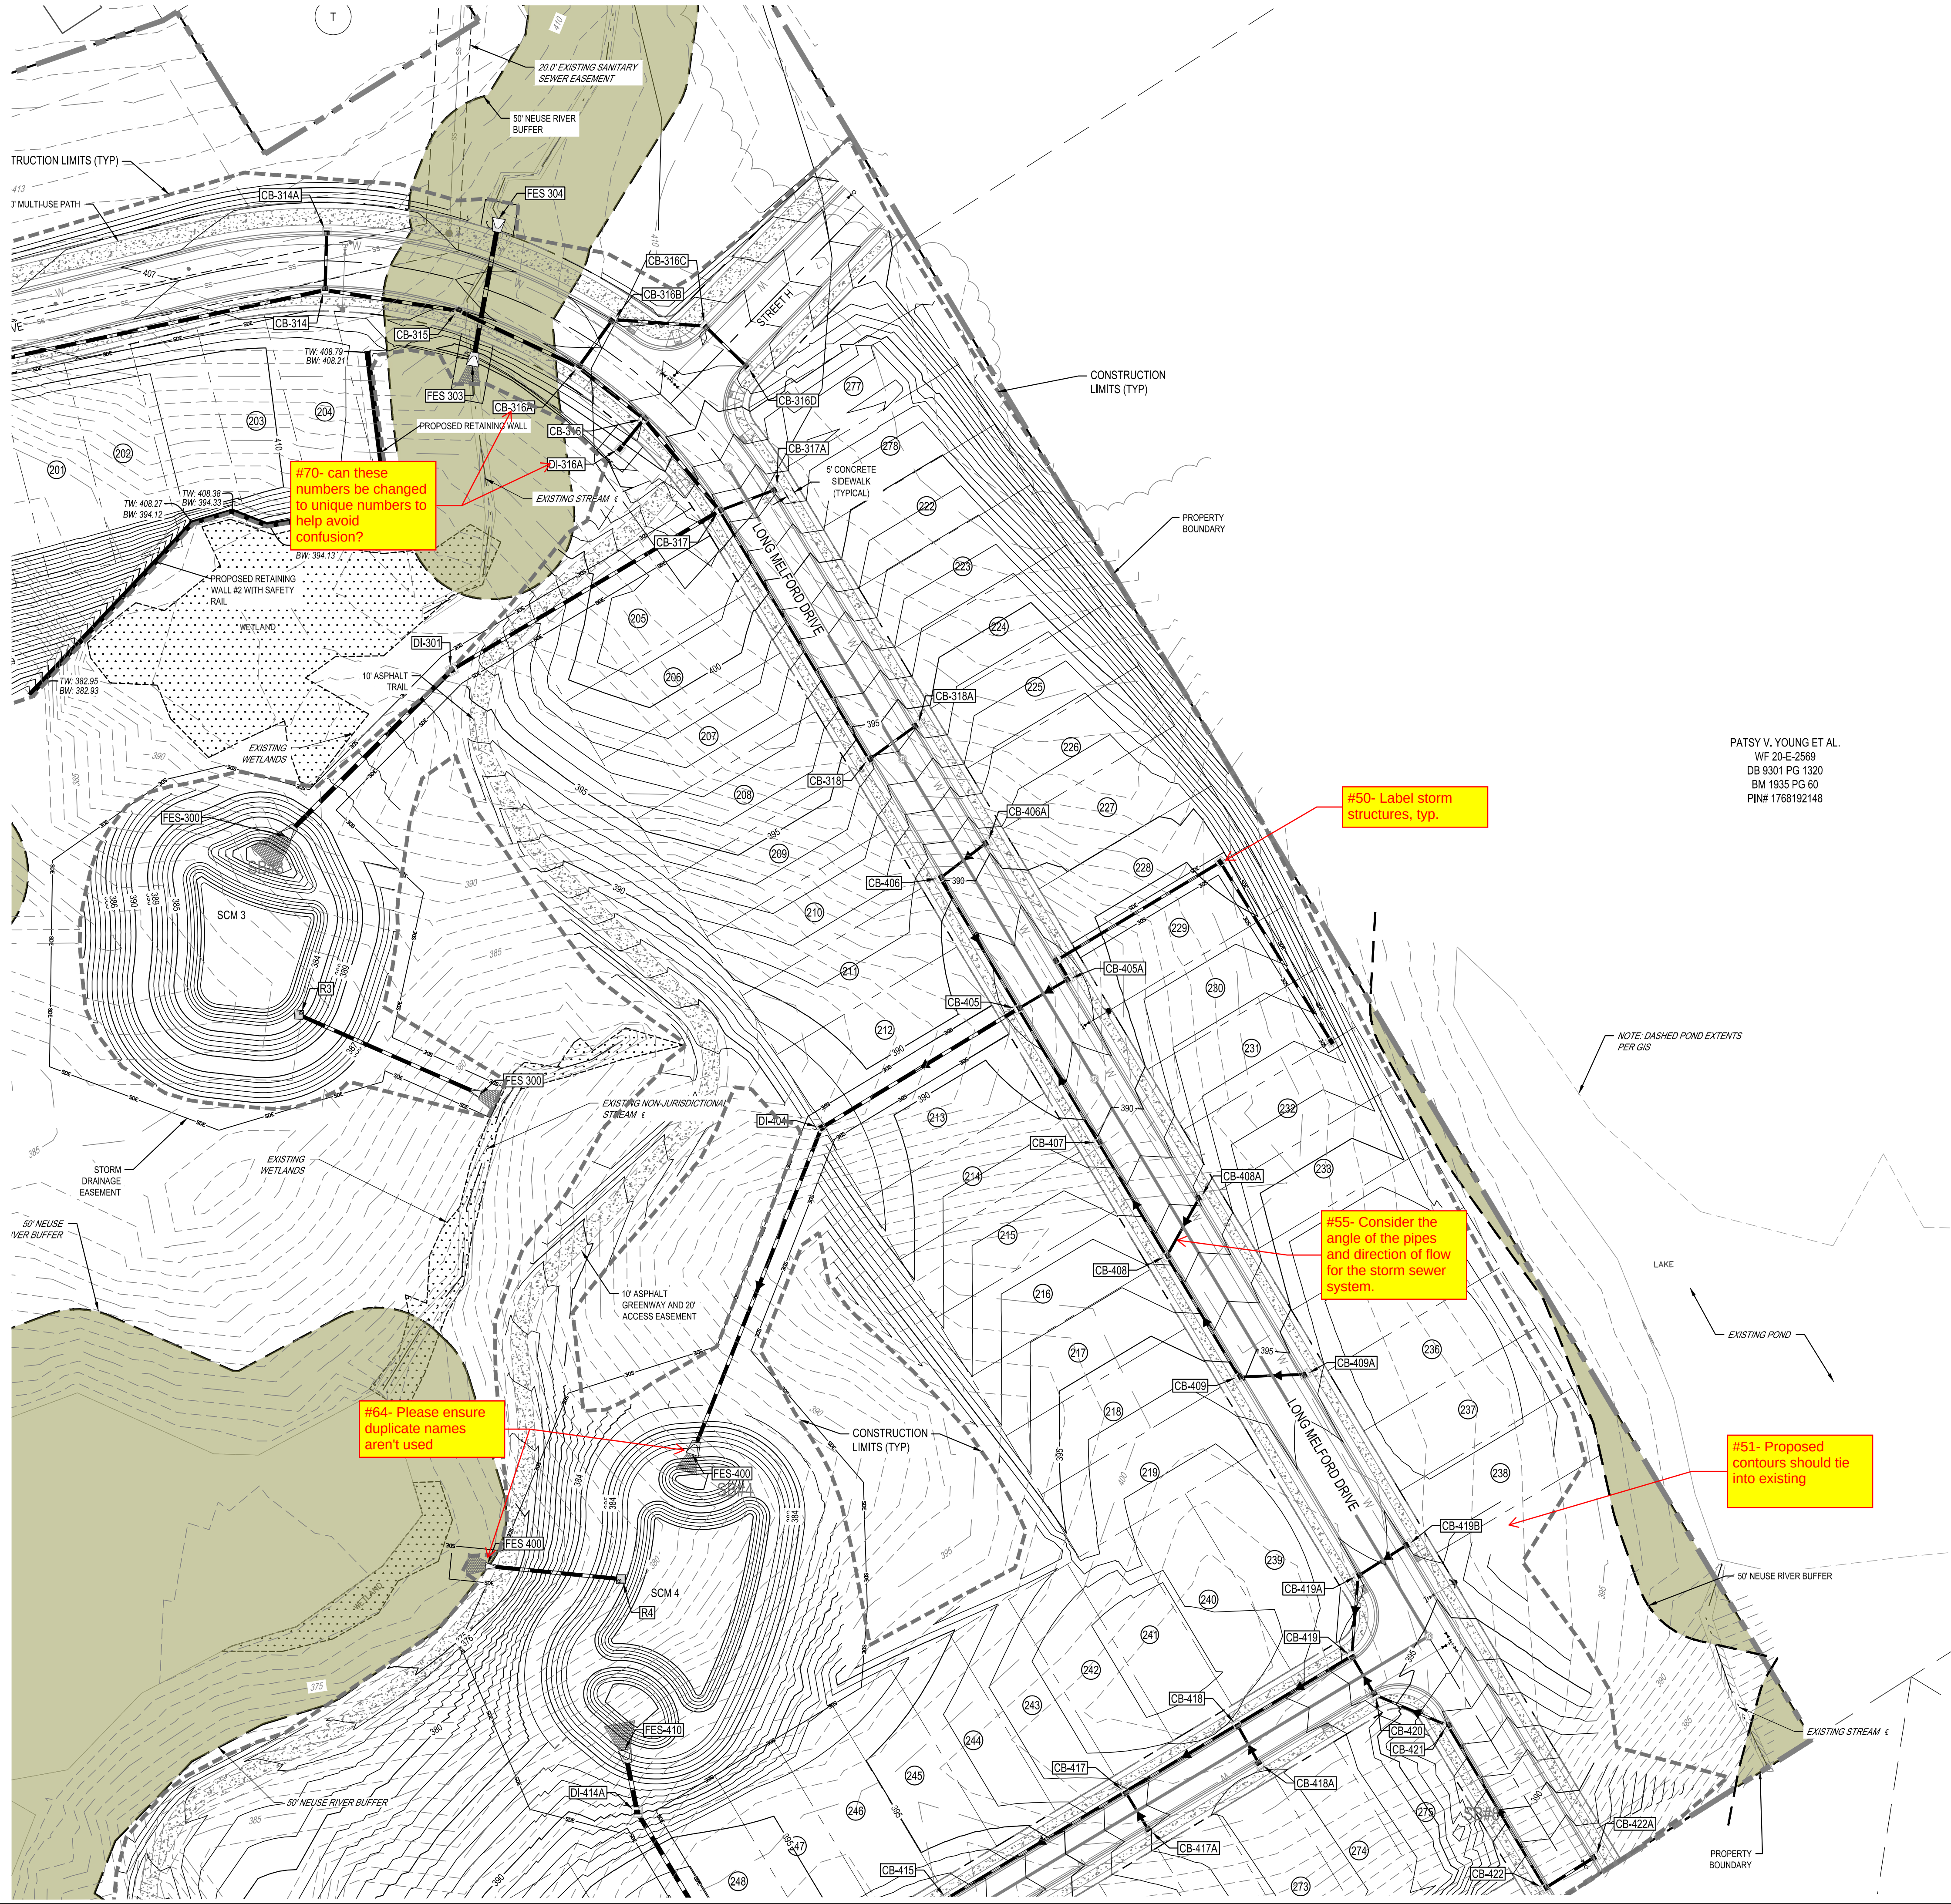

#70- can these numbers be changed to unique numbers to help avoid confusion?

#50- Label storm structures, typ.

#55- Consider the angle of the pipes and direction of flow for the storm sewer system.


#64- Please ensure duplicate names aren't used

#51- Proposed contours should tie into existing




PROPOSED GRADING AND DRAINAGE LEGEND



	PROPOSED BORING
	PROPOSED DETENTION
	PROPOSED GRADING LIMITS
	PROPOSED MAJOR CONTOUR
	PROPOSED MINOR CONTOUR
	PROPOSED SPOT
	PROPOSED GRADING ARROW
	PROPOSED SWALE
	PROPOSED STORM
	PROPOSED STORM SYMBOL
	PROPOSED BUILDING SPOT

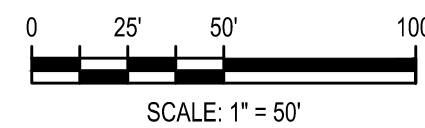



DESIGNED BY: DF/CD		06/01/2023		PER TOWN OF ROLESVILLE COMMENT	
DRAWN BY: DF/JWM		REV		04/03/2023	
REVIEWED BY: DF		REV		04/03/2023	
BCE		5440 WADE PARK BLVD, SUITE 102 RALEIGH NC 27607 WWW.BCEINC.COM NC LICENSE #C-4397		©2023	
LENNAR CORPORATION		1100 PERIMETER PARK DRIVE, SUITE 112 MORRISVILLE / NORTH CAROLINA / 27560			
PARKER RIDGE		82 SCHOOL STREET ROLESVILLE / NORTH CAROLINA / 27571			
ENLARGED GRADING PLAN (3 OF 6)					
PRELIMINARY		NORTH CAROLINA PROFESSIONAL ENGINEER FEDRA M. FERRIS		NOT FOR CONSTRUCTION	
FILE NUMBER: 8430-03		DATE: 06/01/2023			
C4-3					

G:\NCA\Projects\Lennar\8430-03 - DWG\PlanSheets\On-Site\C4-0 - GRAD-PLAN.dwg Layout: C4-4 ENLARGED GRADING PLAN (4 OF 6) Plotted: 6/1/2023 1:04:02 PM

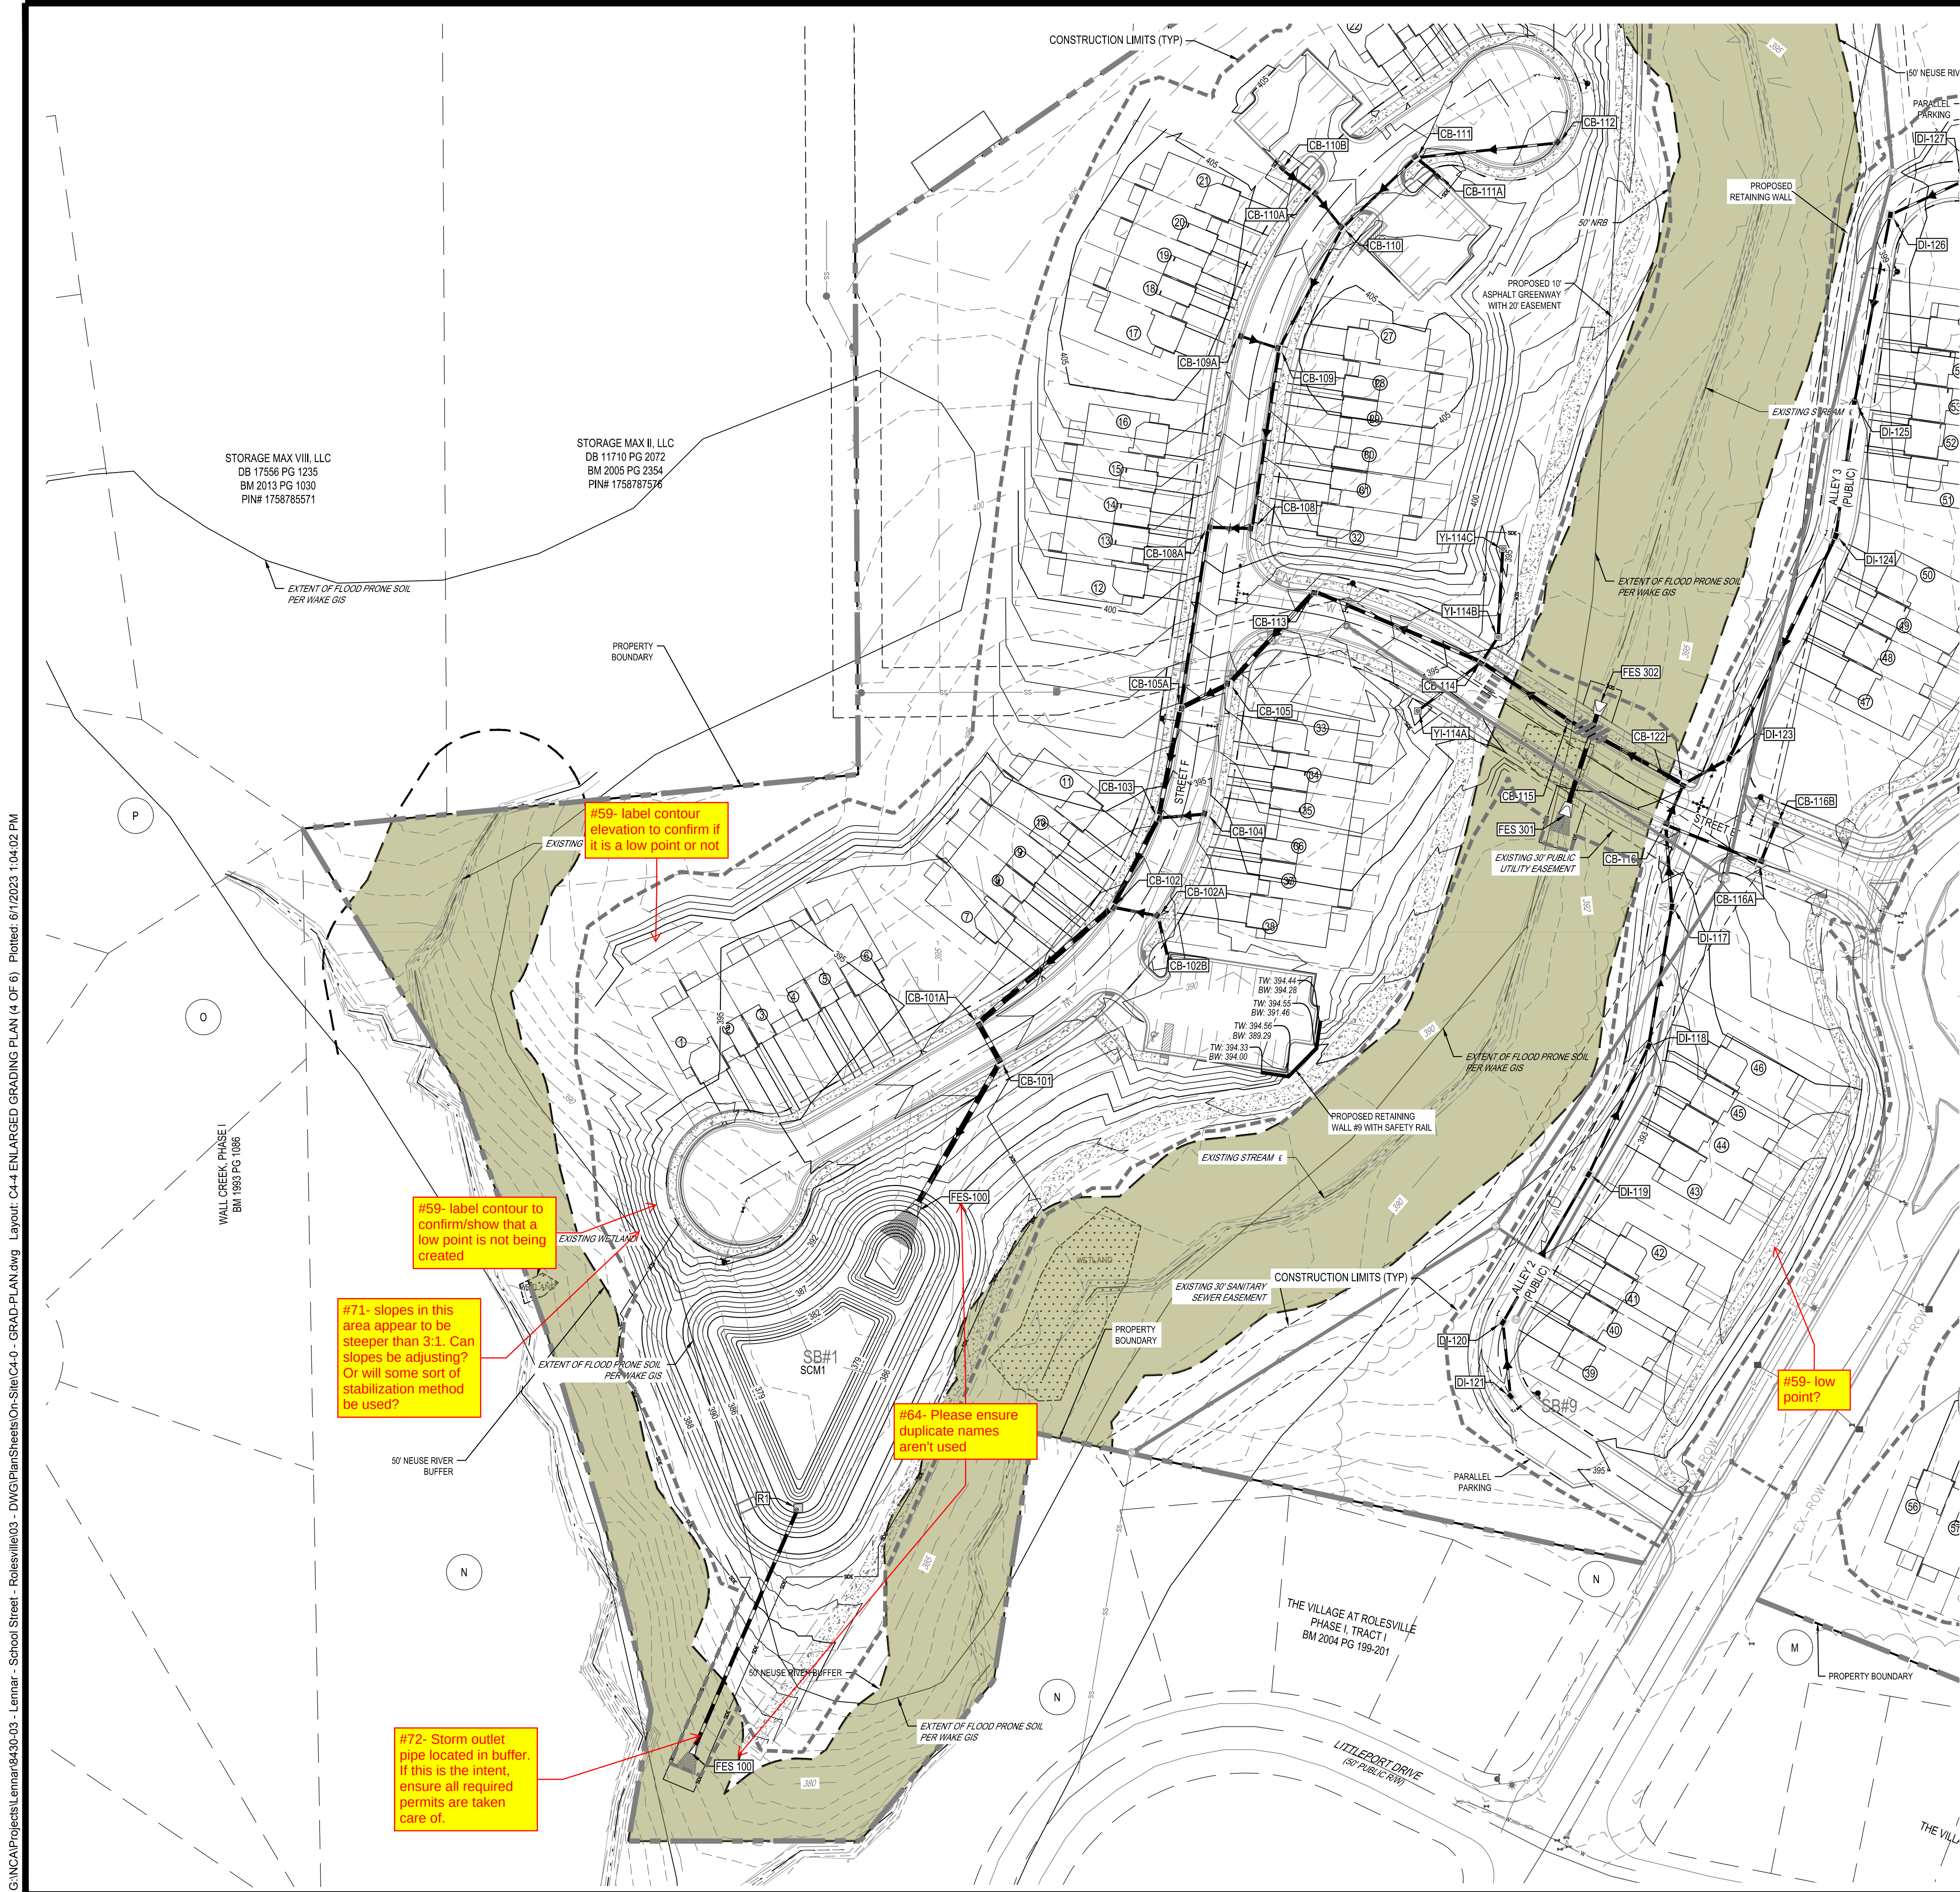


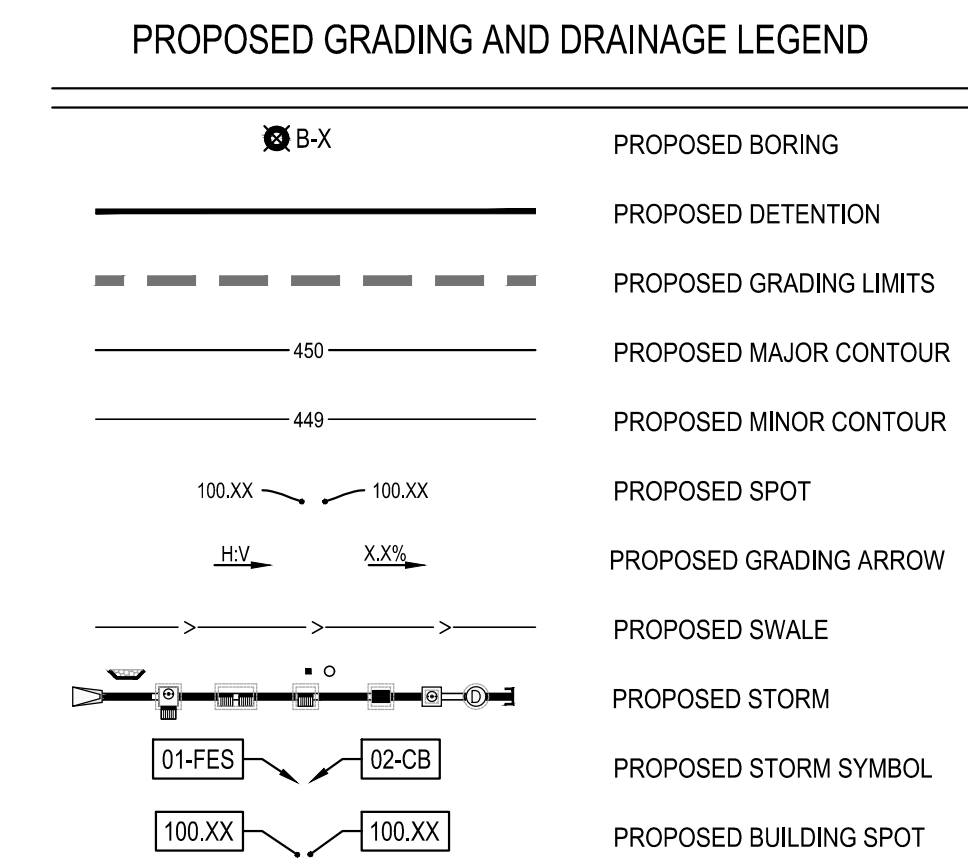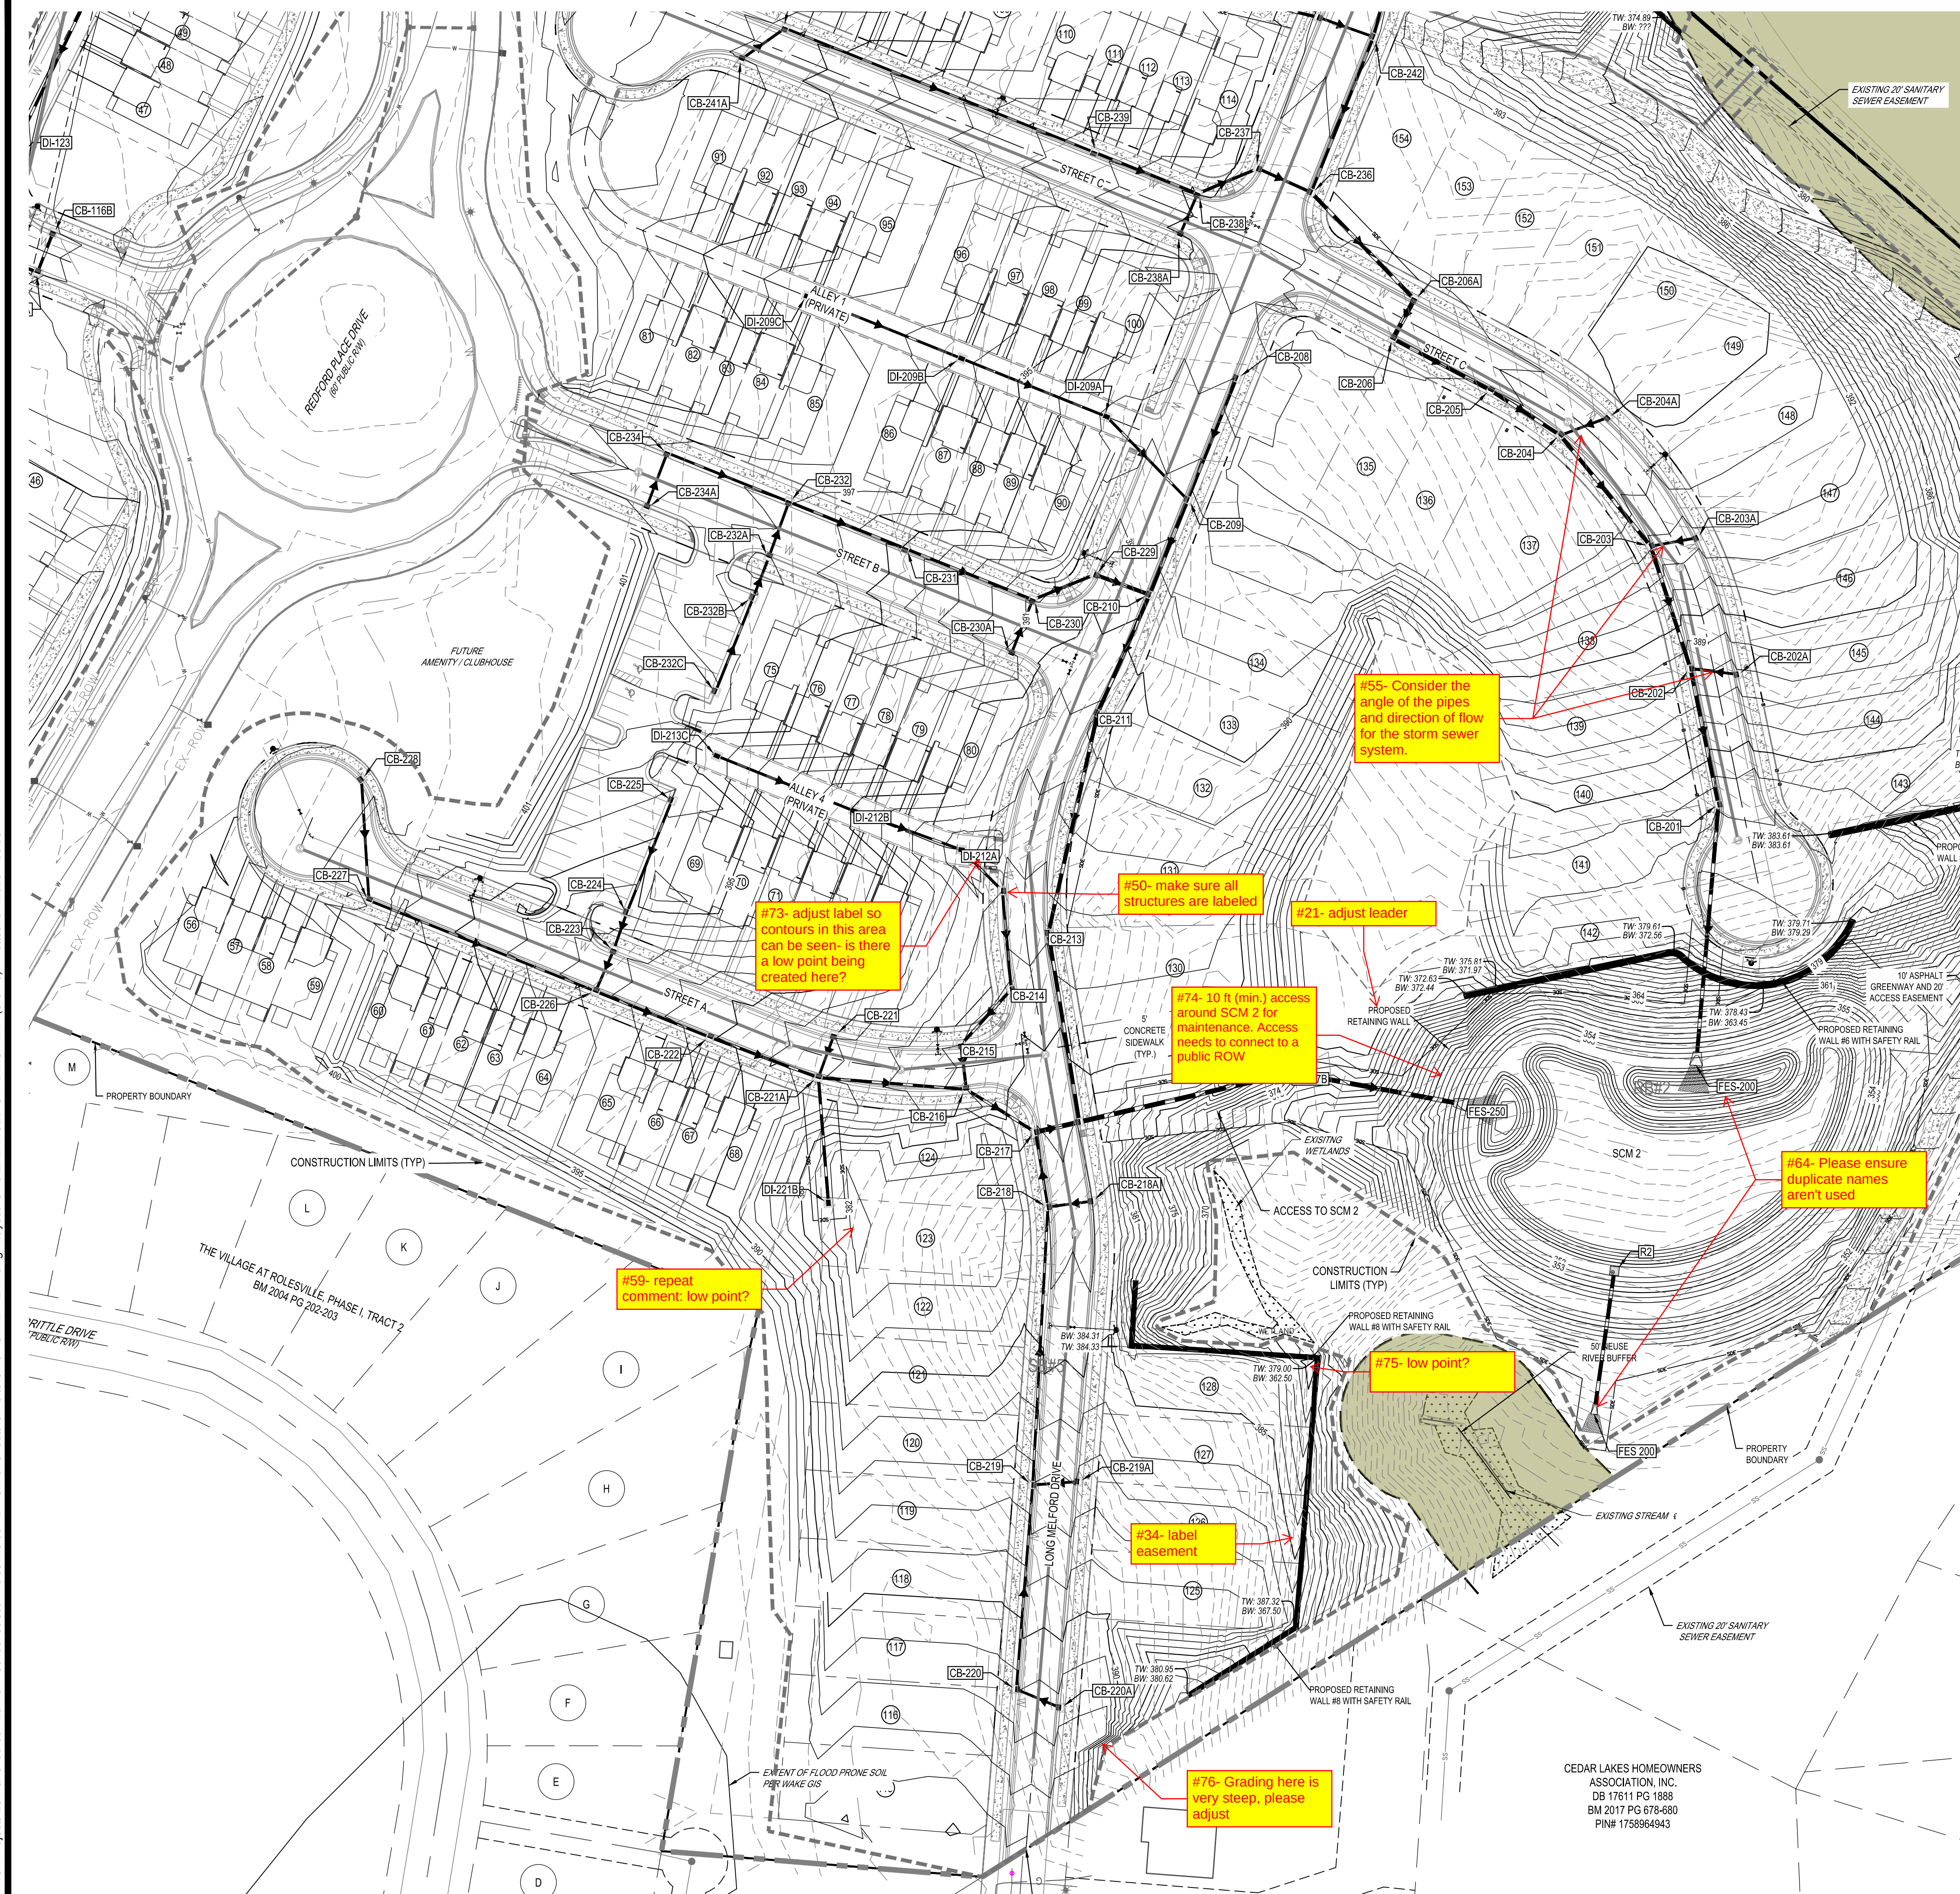


Know what's below.
Call before you dig.

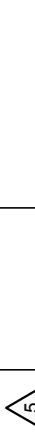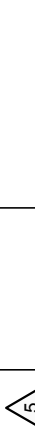 5440 WADE PARK BLVD, SUITE 102 RALEIGH NC 27607 WWW.BCEINC.COM NC LICENSE #C-4397 ©2023	 PRELIMINARY NOT FOR CONSTRUCTION	ENLARGED GRADING PLAN (5 OF 6)	PARKER RIDGE 82 SCHOOL STREET ROLESVILLE / NORTH CAROLINA / 27571	LENNAR CORPORAION 1100 PERIMETER PARK DRIVE, SUITE 112 MORRISVILLE / NORTH CAROLINA / 27560	BCE 5440 WADE PARK BLVD, SUITE 102 RALEIGH NC 27607 WWW.BCEINC.COM NC LICENSE #C-4397 ©2023	
	DESIGNED BY: DF/CD	DRAWN BY: DF/JWM	REVIEWED BY: DF	06/01/2023	PER TOWN OF ROLESVILLE COMMENT	REV 04/03/2023 INITIAL SUBMITTAL
	FILE NUMBER: 8430-03	DATE: 06/01/2023	C4-5	06/01/2023	PER TOWN OF ROLESVILLE COMMENT	REV 04/03/2023 INITIAL SUBMITTAL
	FILE NUMBER: 8430-03	DATE: 06/01/2023	C4-5	06/01/2023	PER TOWN OF ROLESVILLE COMMENT	REV 04/03/2023 INITIAL SUBMITTAL

G:\NCA\Projects\Lennar\8430-03 - Lennar - School Street - Rolesville\03 - DWG\PlanSheets\On-Site\C4-0 - GRAD-PLAN.dwg Layout: C4-6 ENLARGED GRADING PLAN (6 OF 6) Plotted: 6/1/2023 1:09:03 PM

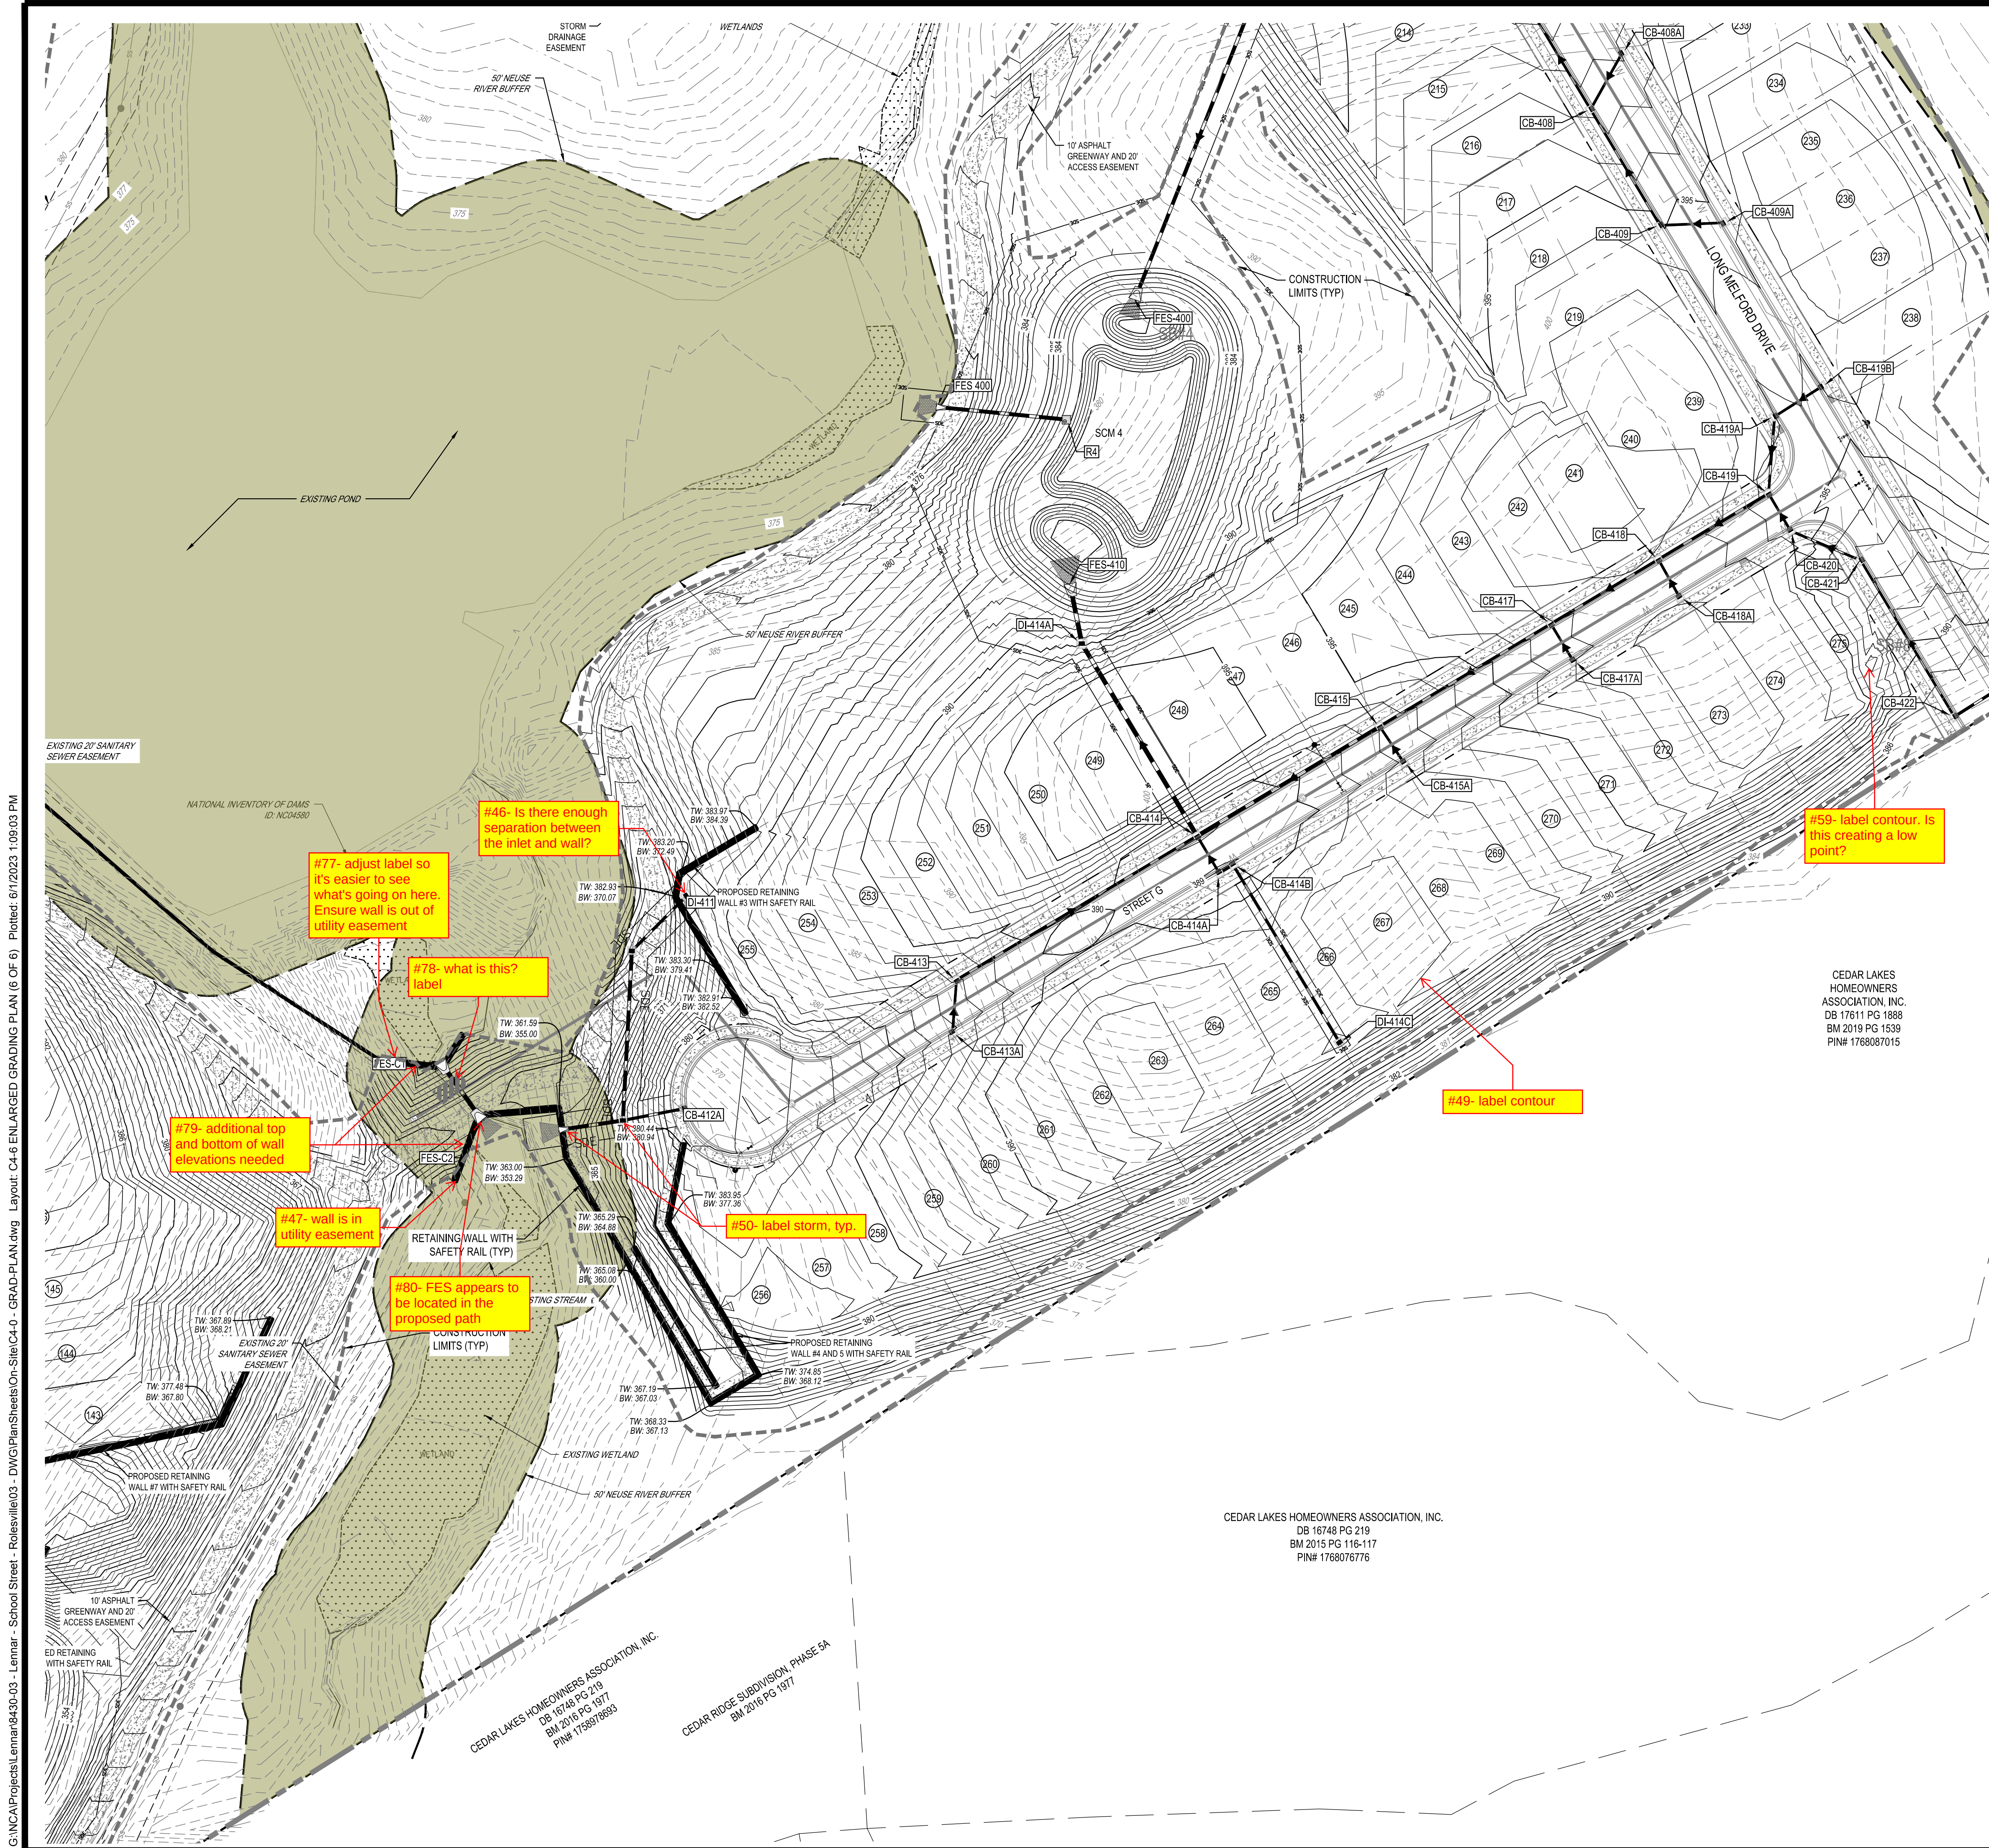

PROPOSED GRADING AND DRAINAGE LEGEND	
	PROPOSED BORING
	PROPOSED DETENTION
	PROPOSED GRADING LIMITS
	PROPOSED MAJOR CONTOUR
	PROPOSED MINOR CONTOUR
	PROPOSED SPOT
	PROPOSED GRADING ARROW
	PROPOSED SWALE
	PROPOSED STORM
	PROPOSED STORM SYMBOL
	PROPOSED BUILDING SPOT

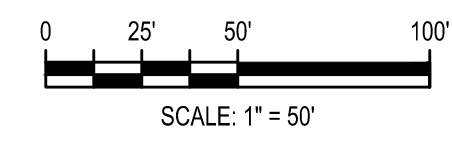

DESIGNED BY: DFI/CD

DRAWN BY: DFI/JWM

REVIEWED BY: DFI

PER TOWN OF ROLESVILLE COMMENT

06/01/2023

REV

04/03/2023

INITIAL SUBMITTAL

BCE

5440 WADE PARK BLVD, SUITE 102
RALEIGH NC 27607
WWW.BCEINC.COM
NC LICENSE #C-4397

LENNAR

CORPORAION

1100 PERIMETER PARK DRIVE, SUITE 112
MORRISVILLE / NORTH CAROLINA / 27560

PARKER RIDGE

82 SCHOOL STREET
ROLESVILLE / NORTH CAROLINA / 27571

ENLARGED GRADING

PLAN (6 OF 6)

NORTH CAROLINA
PROFESSIONAL
ENGINEER
FEDRA M. FERNANDEZ

PRELIMINARY

NOT FOR
CONSTRUCTION

FILE NUMBER:
8430-03

DATE: 06/01/2023

C4-6