

SKIMMER BASIN SUMMARY																	
BASIN NUMBER	DRAINAGE AREA	DENUDED AREA	RUNOFF COEFF.	SYSTEM INTENSITY	25-YEAR PEAK FLOW	BASIN DIMENSIONS			TOP OF DAM EL.	WEIR LENGTH	AREA REQUIRED	AREA PROVIDED	VOLUME REQUIRED	VOLUME PROVIDED	SKIMMER SIZE	SKIMMER ORIFICE DIA.	DEWATER TIME
						DEPTH	LENGTH	WIDTH									
	(AC)	(AC)		(IN/HR)	(CFS)	(FT)	(FT)	(FT)	(FT)	(FT)	(SF)	(SF)	(CF)	(CF)	(IN)	(IN)	(DAYS)
SB #1	5.70	5.70	0.50	7.93	22.6	2.0	112	56	390	6	6,240	6,272	10,260	10,624	4	1.50	3.42
SB #2	10.60	10.60	0.50	7.93	42.0	2.0	156	78	357	18	11,604	12,168	19,080	21,624	4	2.00	3.58
RB #3	3.30	3.30	0.50	7.93	13.1	2.0	100	40	390	6	3,612	4,000	5,940	6,416	4	1.00	4.46
SB #4	4.70	4.70	0.50	7.93	18.6	2.0	104	52	386	10	5,145	5,408	8,460	9,040	4	1.25	4.06
SB #5	6.60	6.60	0.50	7.93	26.2	2.0	124	62	371	18	7,225	7,688	11,880	13,240	4	1.50	3.96
SB #6	3.30	3.30	0.50	7.93	13.1	2.0	88	44	377	10	3,612	3,872	5,940	6,256	3	1.25	3.29
SB #7	7.10	7.10	0.50	7.93	28.2	2.0	128	64	388	18	7,772	8,192	12,780	14,176	4	1.75	3.13
SB #8	4.40	4.40	0.50	7.93	17.4	2.0	100	50	392	10	4,817	5,000	7,920	8,296	4	1.25	3.80
SB #9	3.30	3.30	0.50	7.93	13.1	2.0	88	44	392	6	3,612	3,872	5,940	6,256	4	1.00	4.46

CID-23-06 - V1 - Part
2 of 3 of Plan set

EROSION CONTROL LEGEND

PROPERTY LINE

EXISTING MAJOR CONTOUR

EXISTING MINOR CONTOUR

PROPOSED MAJOR CONTOUR

PROPOSED MINOR CONTOUR

DRAINAGE AREA

DA#

±X.X AC

DRAINAGE AREA LABEL

SOIL

SOIL TYPE

HV

XX%

DIRECTION OF OVERLAND FLOW

100.XX

100.XX

DIRECTION OF OVERLAND FLOW

RIP RAP APRON

CONSTRUCTION EXIT

EROSION CONTROL MATTING (NAG S150)

LIMITS OF DISTURBANCE

TEMPORARY JUTE NETTING BAFFLES (700 GMZ COIR FABRIC OR HEAVIER)

TEMPORARY DIVERSION DITCH (TD)

TEMP SILT FENCE WITH OUTLET

TEMP TREE PROTECTION FENCE

TEMP SILT / TREE PROTECTION FENCE

SILT FENCE OUTLET

CHECK DAM

BERM

SLOPE DRAIN WITH RIP-RAP APRON

SKIMMER

PIPE INLET PROTECTION

INLET PROTECTION


EXCAVATED INLET PROTECTION

- SCHEDULE A PRECONSTRUCTION CONFERENCE WITH THE ENVIRONMENTAL CONSULTANT. OBTAIN A LAND DISTURBING PERMIT.
- INSTALL GRAVEL CONSTRUCTION PAD, TEMPORARY DIVERSIONS, SILT FENCE, SEDIMENT BASINS OR OTHER MEASURES AS SHOWN ON THE APPROVED PLAN. CLEAR ONLY AS NECESSARY TO INSTALL THESE DEVICES. SEED TEMPORARY DIVERSIONS, BERMS AND BASINS IMMEDIATELY AFTER CONSTRUCTION.
- CALL ENVIRONMENTAL CONSULTANT FOR AN ONSITE INSPECTION BY THE ENVIRONMENTAL CONSULTANT TO OBTAIN A CERTIFICATE OF COMPLIANCE.
- BEGIN CLEARING AND GRUBBING. MAINTAIN DEVICES AS NEEDED. ROUGH GRADE SITE.
- INSTALL STORM SEWER, IF SHOWN, AND PROTECT INLETS WITH BLOCK AND GRAVEL INLET CONTROLS. SEDIMENT TRAPS OR OTHER APPROVED MEASURES AS SHOWN ON THE PLAN. BEGIN CONSTRUCTION, BUILDING, ETC.
- STABILIZE SITE AS AREAS ARE BROUGHT UP TO FINISH GRADE WITH VEGETATION, PAVING, DITCH LININGS, ETC. SEED AND MULCH DENUDED AREAS PER GROUND STABILIZATION TIME FRAMES.
- WHEN CONSTRUCTION IS COMPLETE AND ALL AREAS ARE STABILIZED COMPLETELY, CALL ENVIRONMENTAL CONSULTANT FOR AN INSPECTION.
- IF SITE IS APPROVED, REMOVE TEMPORARY DIVERSIONS, SILT FENCE, SEDIMENT BASINS, ETC., AND SEED OUT OR STABILIZE ANY RESULTING BARE AREAS. ALL REMAINING PERMANENT EROSION CONTROL DEVICES, SUCH AS VELOCITY DISSIPATORS, SHOULD NOW BE INSTALLED.
- WHEN VEGETATION HAS BECOME ESTABLISHED, CALL FOR A FINAL SITE INSPECTION BY THE ENVIRONMENTAL CONSULTANT. OBTAIN A CERTIFICATE OF COMPLETION.

TOTAL DISTURBED AREA
±59.6 ACRES



Know what's below.
Call before you dig.

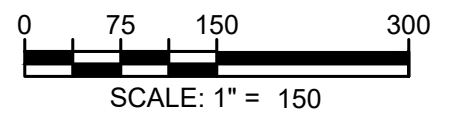

NARRATIVE

PROJECT CONSISTS OF 275 UNITS ON BOTH SIDES OF REDFORD PLACE DRIVE WITH FOUR DETENTION PONDS, AND ASSOCIATED STREETS, AND INFRASTRUCTURE. THE PROJECT ALSO CONSISTS OF APPROXIMATELY 5,200 LF OF PUBLIC GREENWAY. THE PROJECT WILL BE COMPLETED IN 3 PHASES BUT THE EROSION CONTROL AND OVERALL GRADING WILL BE COMPLETED AT ONCE.

g:\NCAP\Projects\Lennar\8430-03 - DWG\plansheets\On-Site\C2-0 - Erosion Control Plan.dwg
Layout: C5-0 OVERALL PHASE 1 EROSION CONTROL PLAN Plotted: 6/1/2023 1:30:40 PM
s:\NCAP\Projects\Lennar\8430-03 - lemmar - school street - rolesville\03 - DWG\plansheets\On-Site\C2-0 - Erosion Control Plan.dwg

DESIGNED BY: DF/CD

DRAWN BY: DF/JWM

REVIEWED BY: DF

06/01/2023

04/03/2023

REV

PER TOWN OF ROLESVILLE COMMENT

INITIAL SUBMITTAL

BCE

5440 WADE PARK BLVD, SUITE 102
RALEIGH NC 27607
WWW.BCEINC.COM
NC LICENSE #C-4397

LENNAR

CORPORAION

1100 PERIMETER PARK DRIVE, SUITE 112
MORRISVILLE / NORTH CAROLINA / 27560

OVERALL PHASE 1 EROSION CONTROL PLAN

82 SCHOOL STREET
ROLESVILLE / NORTH CAROLINA / 27571

PRELIMINARY

ENGINEER


EDWARD M. FERN

NOT FOR CONSTRUCTION



FILE NUMBER: 8430-03

DATE: 06/01/2023

C5-0


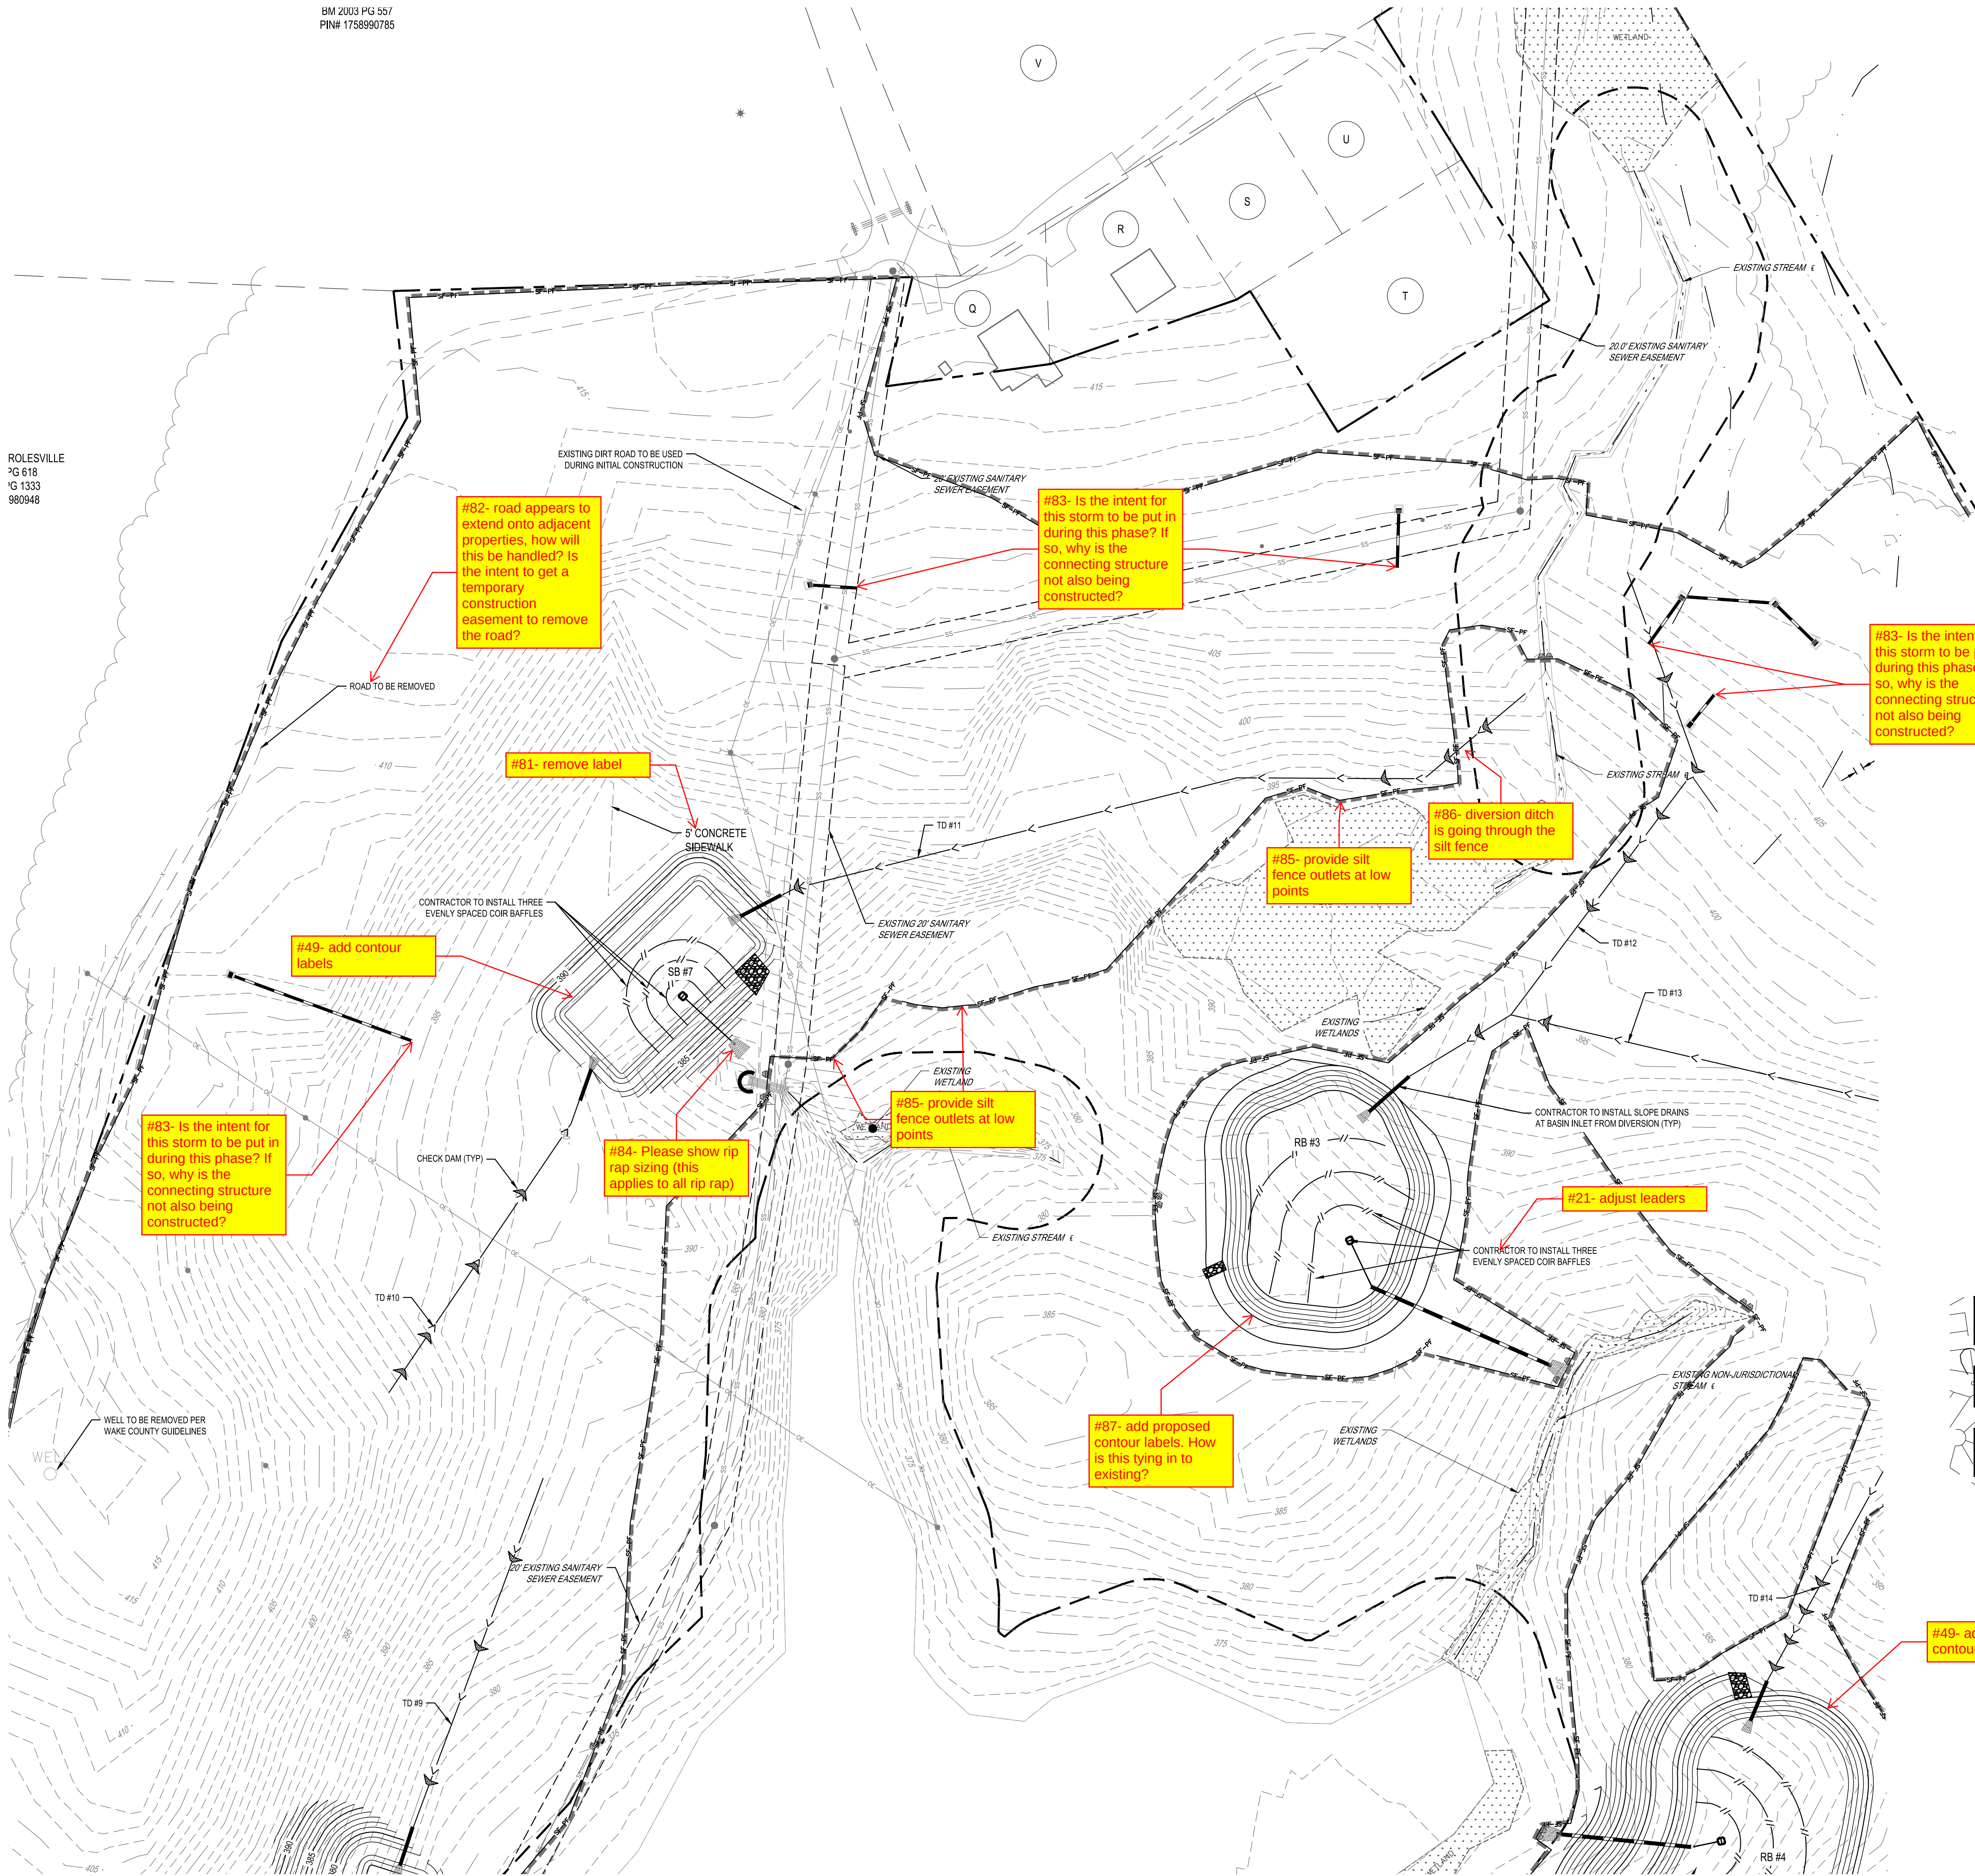


EROSION CONTROL LEGEND	
	PROPERTY LINE
	EXISTING MAJOR CONTOUR
	EXISTING MINOR CONTOUR
	PROPOSED MAJOR CONTOUR
	PROPOSED MINOR CONTOUR
	DRAINAGE AREA
	DRAINAGE AREA LABEL
	SOIL TYPE
	DIRECTION OF OVERLAND FLOW
	DIRECTION OF OVERLAND FLOW
	RIP RAP APRON
	CONSTRUCTION EXIT
	EROSION CONTROL MATTING (NAG S150BN)
	LIMITS OF DISTURBANCE
	TEMPORARY JUTE NETTING BAFFLES (70 GIM2 COIR FABRIC OR HEAVIER)
	TEMPORARY DIVERSION DITCH OR BERM
	TEMP SILT FENCE WITH OUTLET
	TEMP TREE PROTECTION FENCE
	TEMP SILT / TREE PROTECTION FENCE
	TEMP CONSTRUCTION FENCE
	TEMPORARY HIGH HAZARD FENCE
	CHECK DAM
	SEDIMENTATION CHAMBER BERM
	SLOPE DRAIN WITH RIP-RAP APRON
	TEMPORARY RISER SKIMMER SEDIMENT BASIN
	STONE FILTER RING
	SILT FENCE INLET SEDIMENT TRAP
	EXCAVATED INLET SEDIMENT TRAP
	BLOCK INLET SEDIMENT FILTER

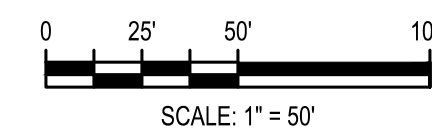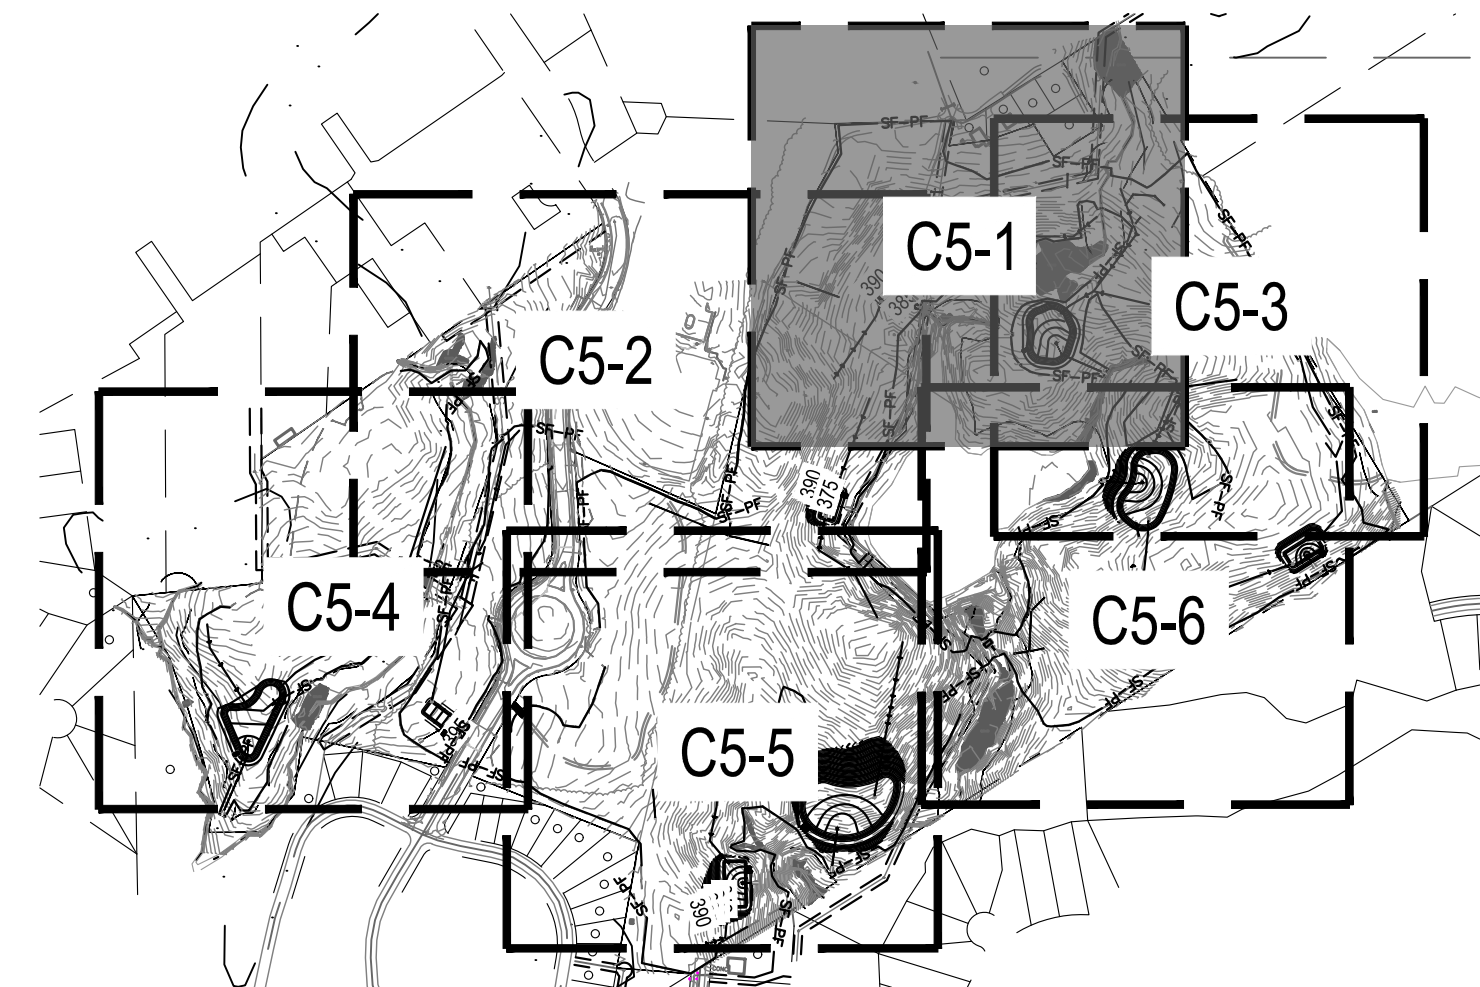

Know what's below.
Call before you dig.

g:\NCAP\Projects\Lennar\8430-03 - lemmar - school street - rolesville\03 - DWG\plansheets\On-Site\EC2-0 - EROS-PH1.dwg Layout: C5-2 ENLARGED PHASE 1 EROSION CONTROL PLAN (2 OF 6) Plotted: 6/12/2023 1:30:58 PM

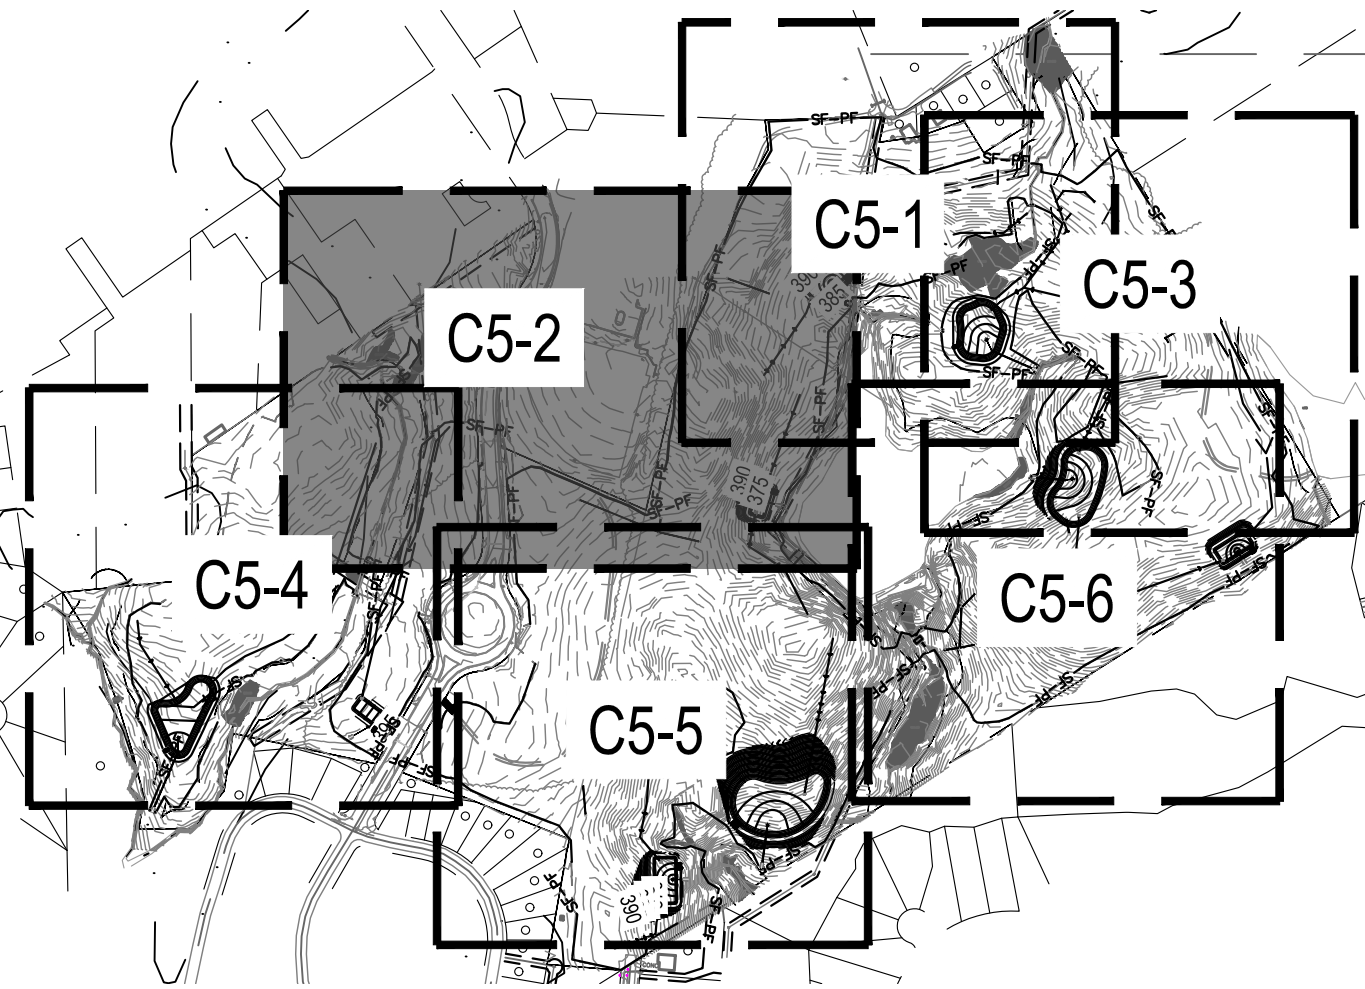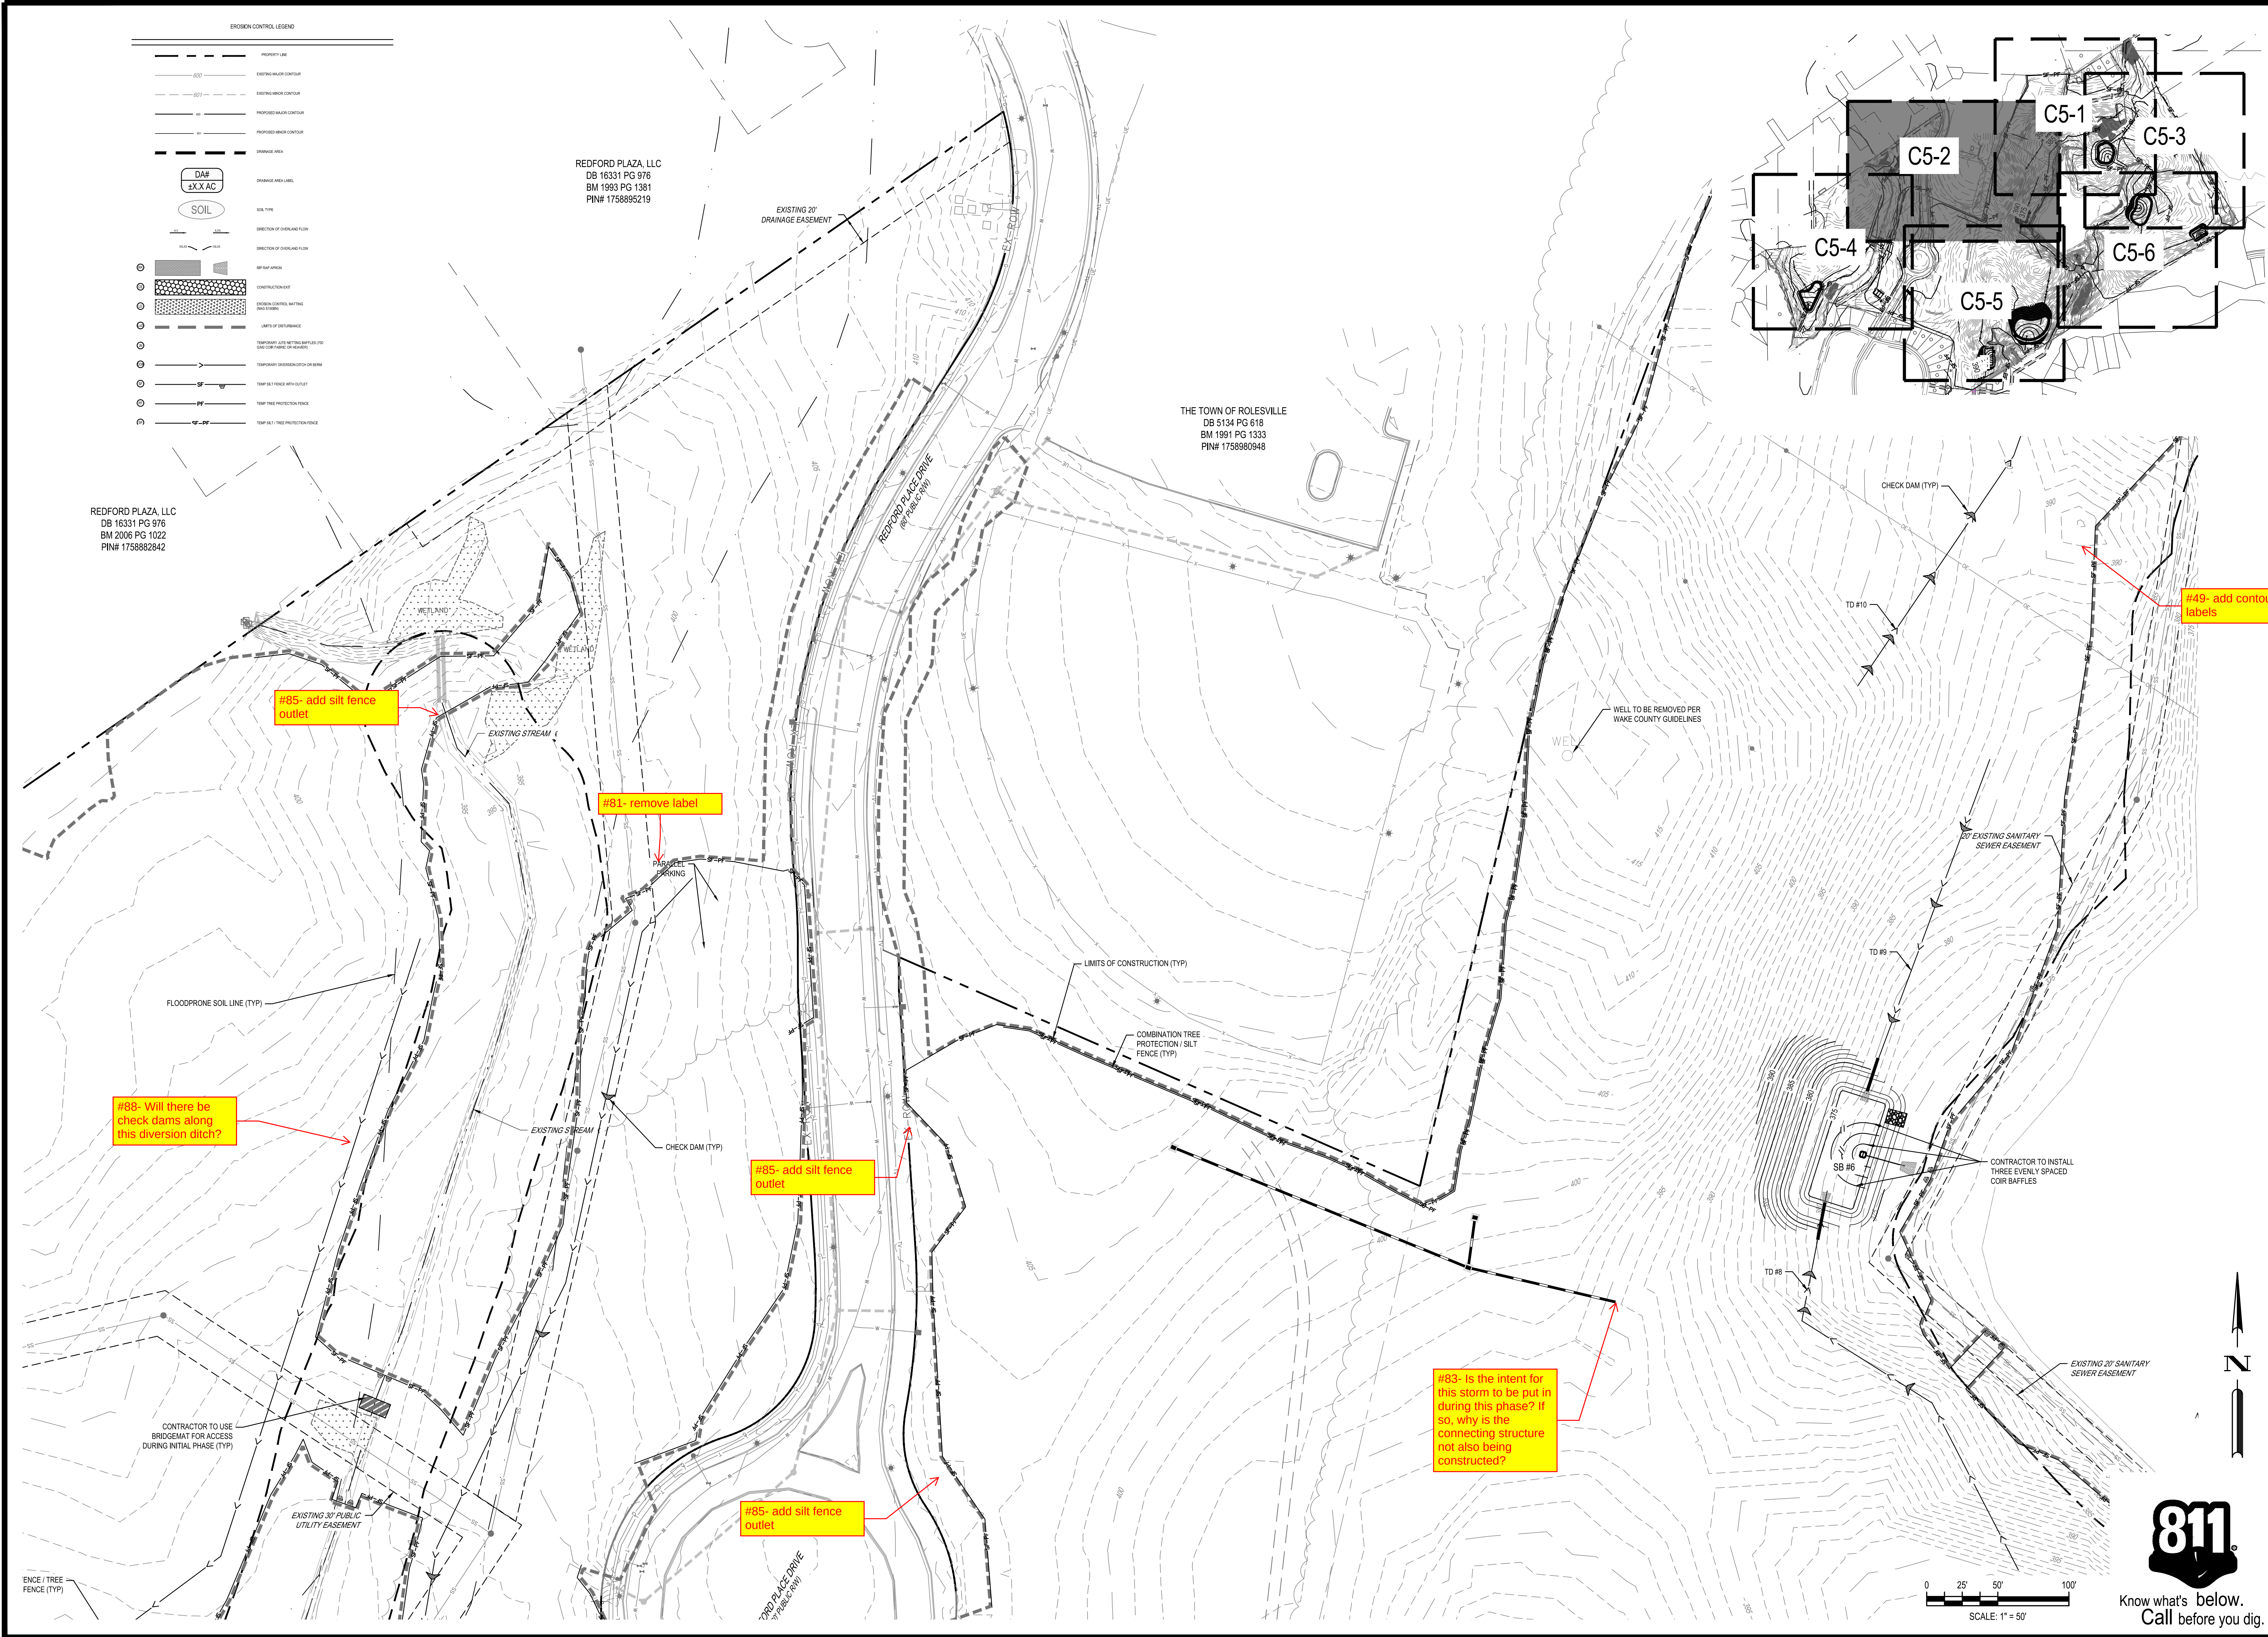

DESIGNED BY:	DF/CD
DRAWN BY:	DF/JWM
REVIEWED BY:	DF

06/01/2023	PER TOWN OF ROLESVILLE COMMENT	INITIAL SUBMITTAL
REV	04/03/2023	

5440 WADE PARK BLVD, SUITE 102
RALEIGH NC 27607
WWW.BCEINC.COM
NC LICENSE #C-4397

LENNAR
CORPORAION
1100 PERIMETER PARK DRIVE, SUITE 112
MORRISVILLE / NORTH CAROLINA / 27560

PARKER RIDGE
82 SCHOOL STREET
ROLESVILLE / NORTH CAROLINA / 27571



ENLARGED PHASE 1
EROSION CONTROL
PLAN (2 OF 6)

NOT FOR
CONSTRUCTION

FILE NUMBER:
8430-03


DATE: 06/01/2023

C5-2

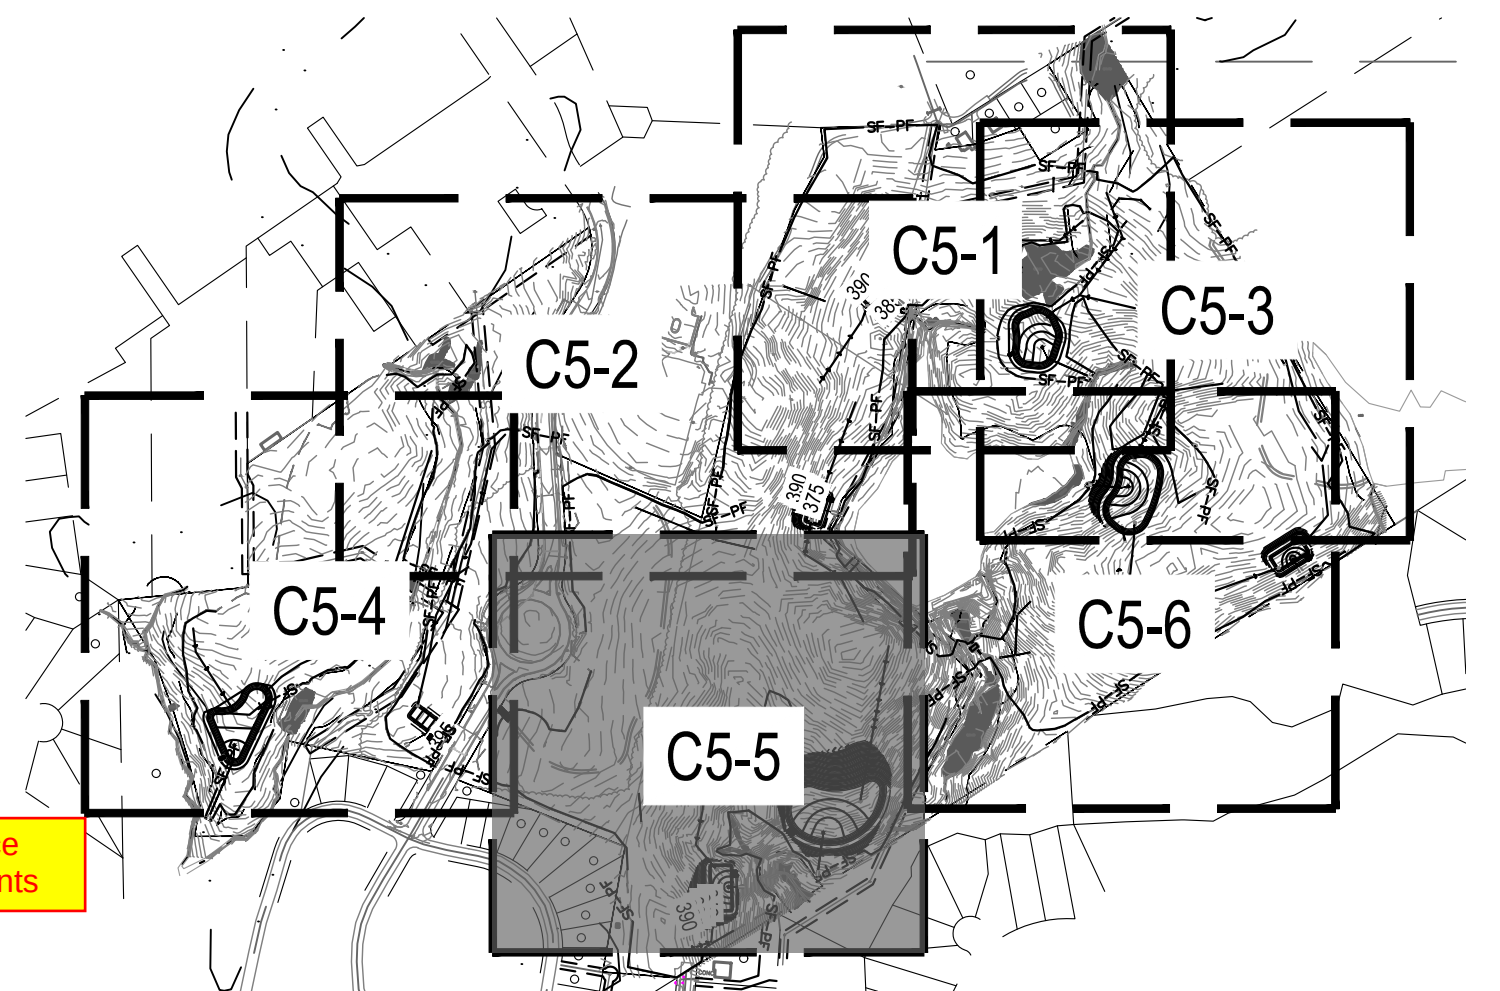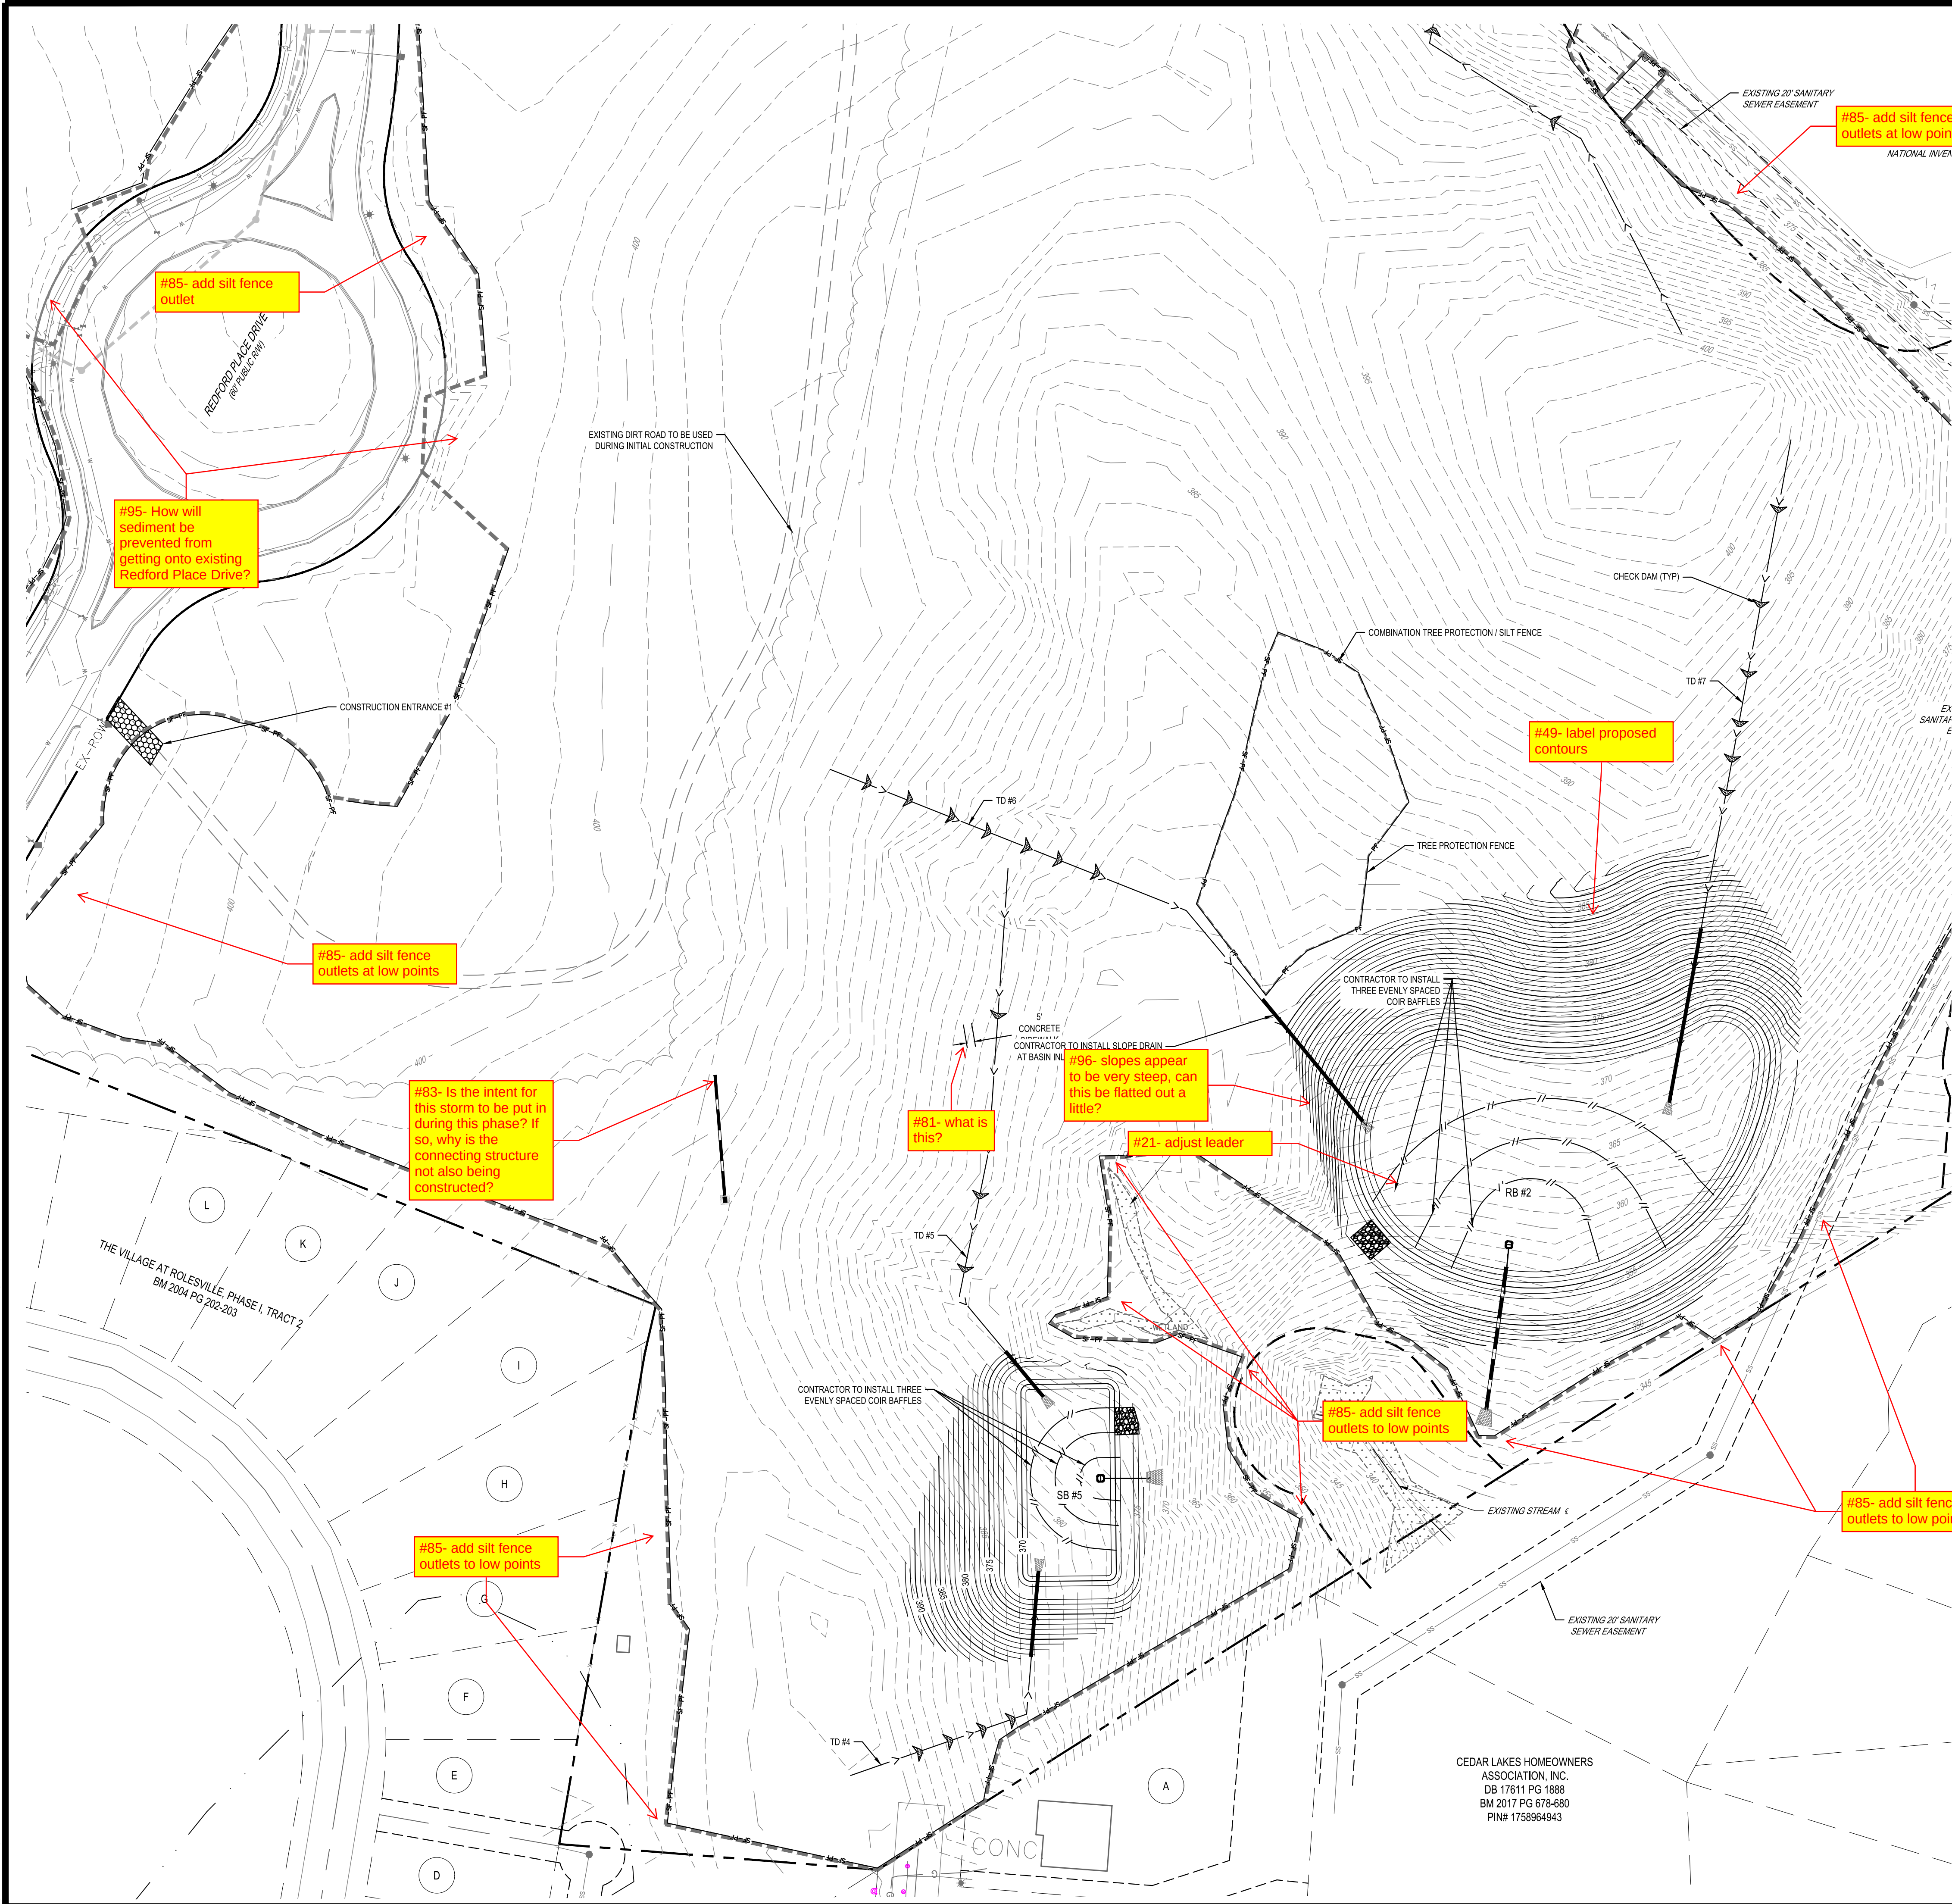

<

#12- There is a lot of overlapping and/or hard to read text that should be adjusted.

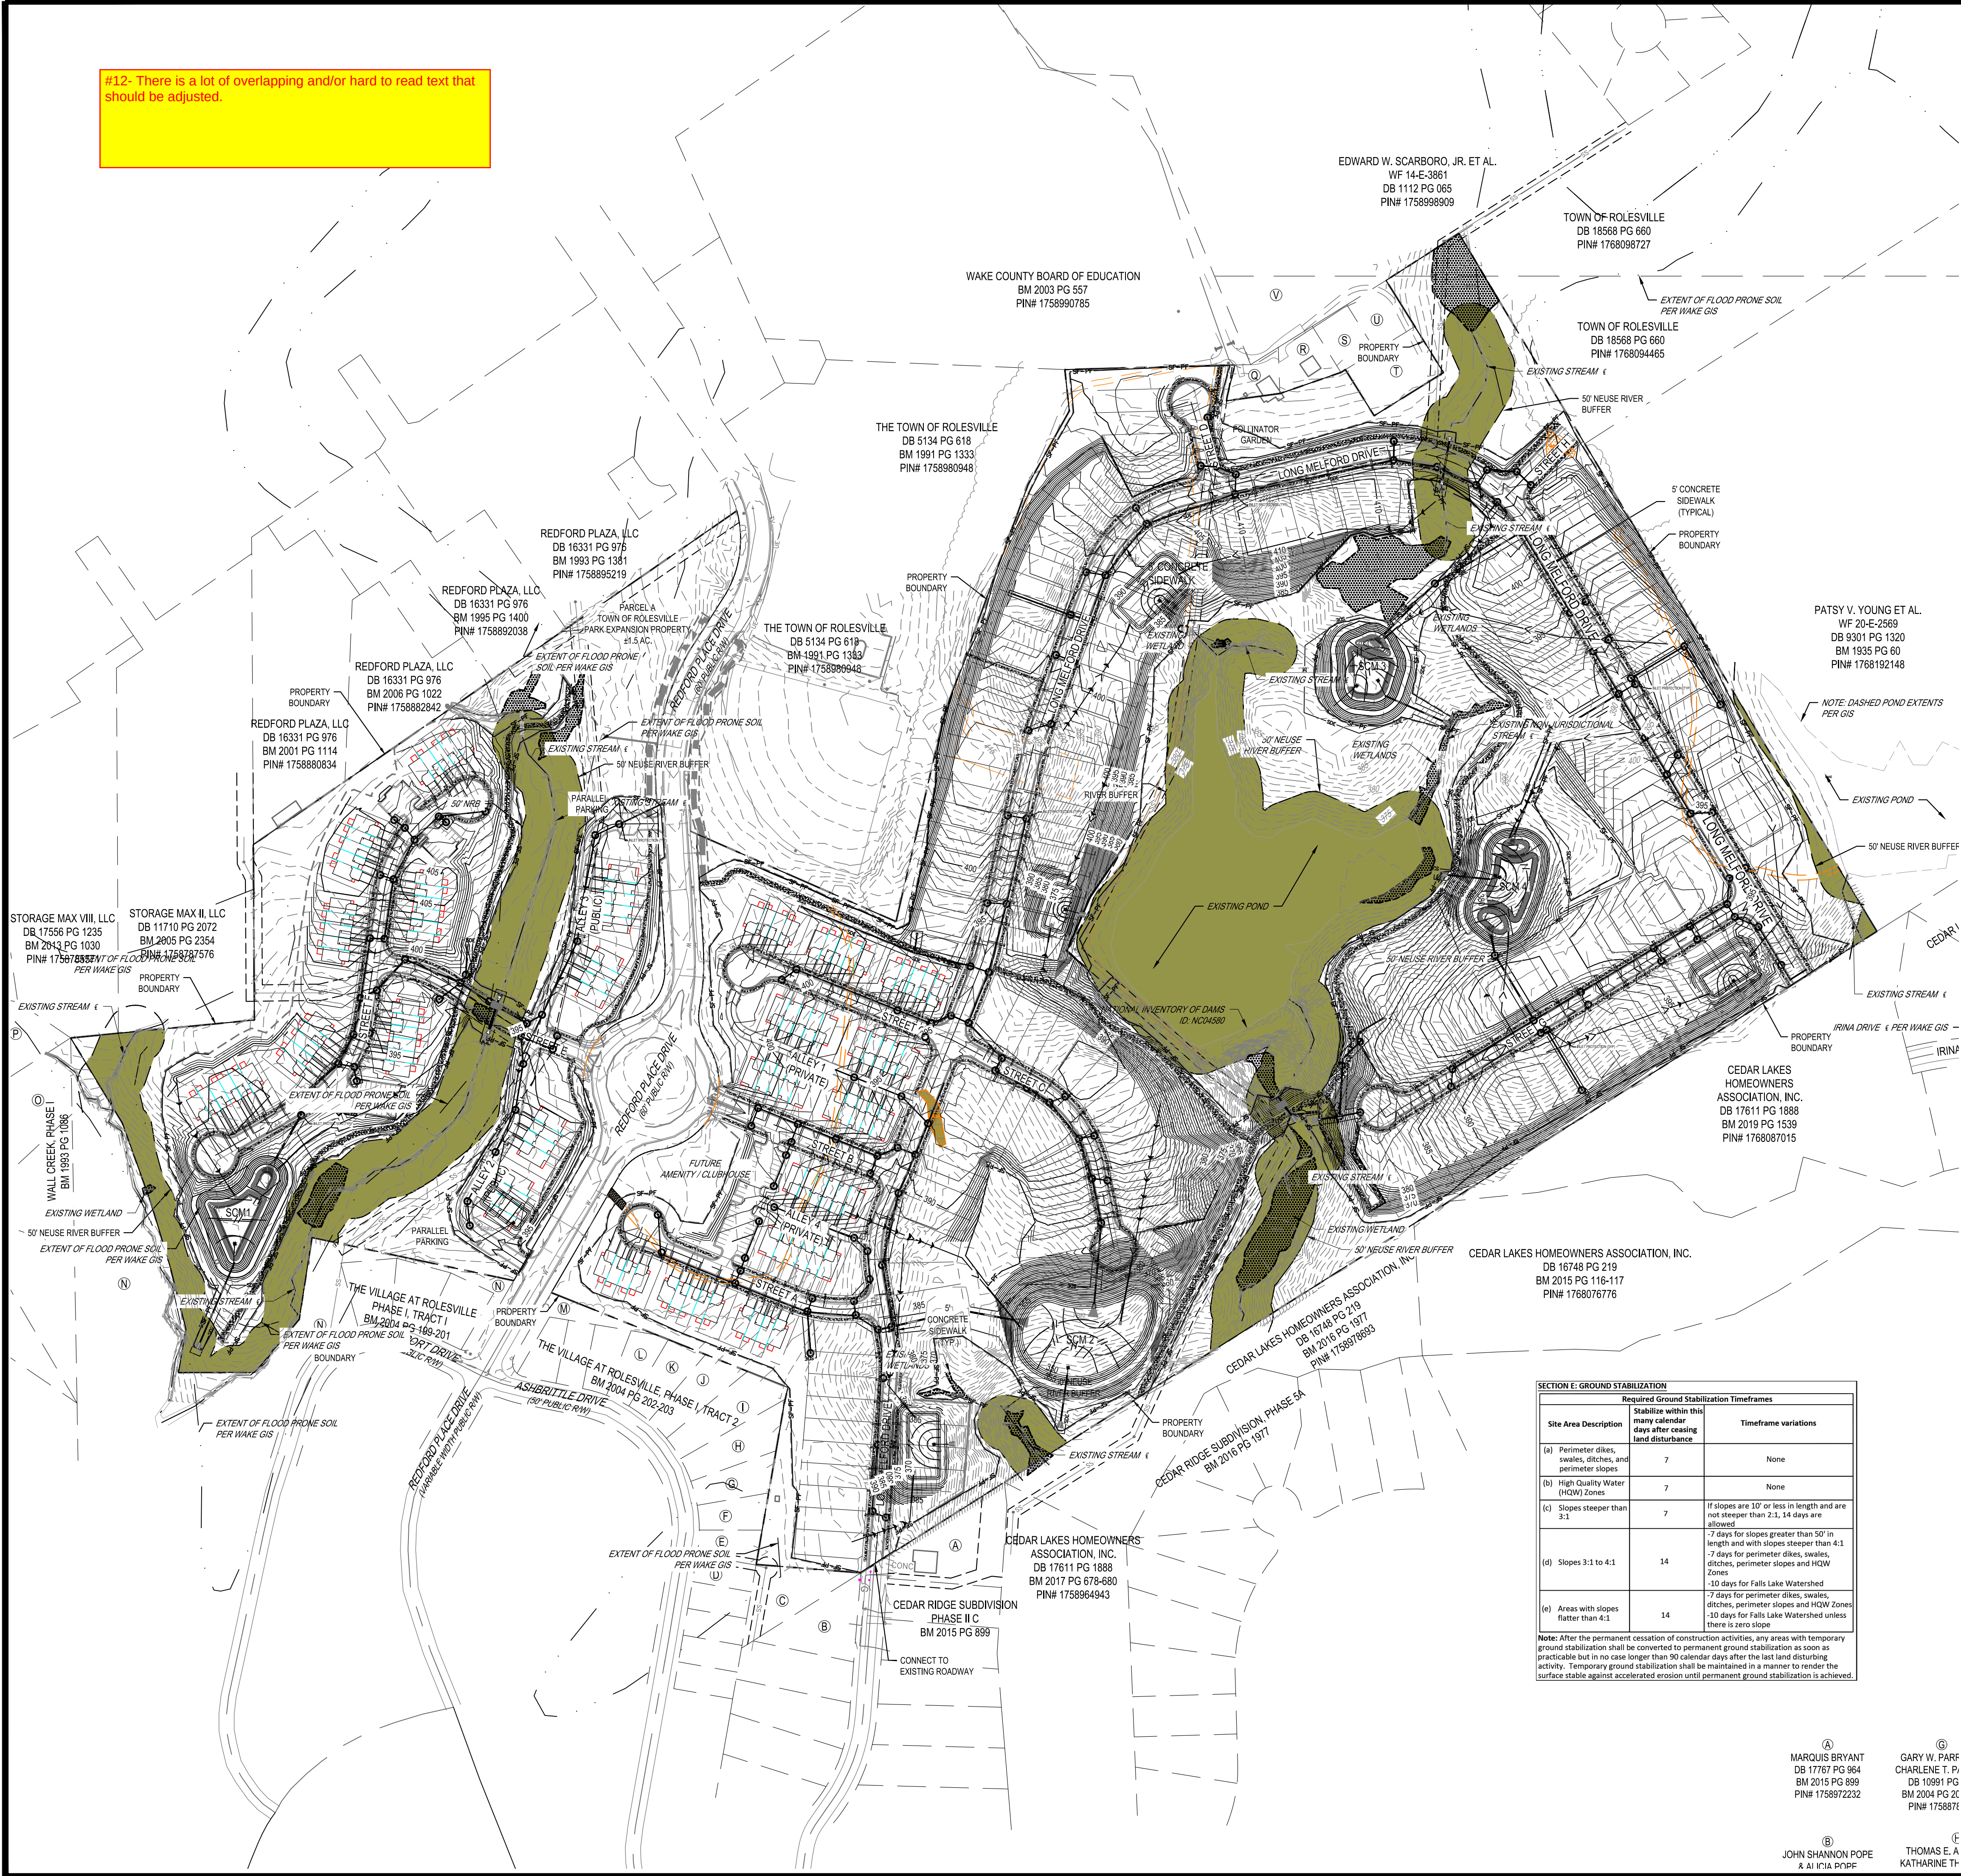

EROSION CONTROL LEGEND

	PROPERTY LINE
	EXISTING MAJOR CONTOUR
	EXISTING MINOR CONTOUR
	PROPOSED MAJOR CONTOUR
	PROPOSED MINOR CONTOUR
	DRAINAGE AREA
	DRAINAGE AREA LABEL
	SOIL TYPE
	DIRECTION OF OVERLAND FLOW
	RIP RAP APRON
	CONSTRUCTION EXIT
	EROSION CONTROL MATTING (NAG S150)
	LIMITS OF DISTURBANCE
	TEMPORARY JUTE NETTING BAFFLES (700 G/M2 COIR FABRIC OR HEAVIER)
	TEMPORARY DIVERSION DITCH OR BERM
	TEMP SILT FENCE WITH OUTLET
	TEMP TREE PROTECTION FENCE
	TEMP SILT / TREE PROTECTION FENCE
	TEMP CONSTRUCTION FENCE
	TEMPORARY HIGH HAZARD FENCE
	CHECK DAM
	SEDIMENTATION CHAMBER BERM
	SLOPE DRAIN WITH RIP-RAP APRON
	TEMPORARY RISER SKIMMER SEDIMENT BASIN
	STONE FILTER RING
	SILT FENCE INLET SEDIMENT TRAP
	EXCAVATED INLET SEDIMENT TRAP
	BLOCK INLET SEDIMENT FILTER

GENERAL EROSION CONTROL CONSTRUCTION SEQUENCE

THE FOLLOWING CONSTRUCTION SEQUENCE IS FURNISHED AS A GENERAL GUIDE FOR PREPARATION OF A SEQUENCE OF CONSTRUCTION EVENTS. ADDITIONS, DELETIONS, AND MODIFICATIONS SHOULD BE MADE AS APPROPRIATE.

PHASE 1:

- OBTAIN GRADING/ EROSION CONTROL PLAN APPROVAL FROM THE CITY OF CHARLOTTE ENGINEERING DEPARTMENT.
- THE CONTRACTOR SHALL SET UP AN ON-SITE PRE-CONSTRUCTION CONFERENCE WITH CITY EROSION CONTROL INSPECTOR TO DISCUSS EROSION CONTROL MEASURES. FAILURE TO SCHEDULE SUCH CONFERENCE 48 HOURS PRIOR TO ANY LAND DISTURBING ACTIVITY IS A VIOLATION AND IS SUBJECT TO FINE.
- INSTALL SWPPP SIGN AND TEMPORARY CONSTRUCTION ENTRANCE.
- CONTRACTOR TO INSTALL CONSTRUCTION ENTRANCE, SILT FENCE AND INLET PROTECTION AS SHOWN ON PLANS, CLEARING ONLY AS NECESSARY TO INSTALL THESE DEVICES.
- SCHEDULE AN ON-SITE INSPECTION BY CITY INSPECTOR. WHEN APPROVED, INSPECTOR ISSUES THE GRADING PERMIT AND CLEARING AND GRUBBING MAY BEGIN.
- THE CONTRACTOR SHALL DILIGENTLY AND CONTINUOUSLY MAINTAIN ALL EROSION CONTROL DEVICES AND STRUCTURES.

PHASE 2:

- BEGIN EARTHWORK/GRADING ACTIVITIES. MAINTAIN AND VERTICALLY ADJUST ALL INLET PROTECTION DEVICES, DITCHES, AND SILT FENCE THROUGHOUT GRADING ACTIVITIES TO MAINTAIN DRAINAGE PATTERNS. CONTRACTOR TO ENSURE ALL EROSION CONTROL MEASURES DO NOT ADVERSELY AFFECT CONSTRUCTABILITY OF PROJECT.
- AS EARTHWORK ALLOWS, BEGIN INSTALLING STORM DRAINAGE STRUCTURES AND UTILITIES. AS STORM DRAINAGE IS INSTALLED, CONTRACTOR SHALL PLACE INLET PROTECTION ON ALL STORM STRUCTURES. NO PIPES SHALL BE LEFT EXPOSED AT THE CLOSE OF BUSINESS EACH DAY.
- DILIGENTLY AND CONTINUOUSLY MAINTAIN ALL EROSION CONTROL DEVICES AND STRUCTURES TO MINIMIZE EROSION. THE CONTRACTOR SHALL MAINTAIN CLOSE CONTACT WITH THE CITY INSPECTOR SO THAT PERIODIC INSPECTIONS CAN BE PERFORMED AT APPROPRIATE STAGES OF CONSTRUCTION.
- GRADED SLOPES AND FILLS ARE TO BE PLANTED OR PROVIDED WITH PROTECTIVE COVER SUFFICIENT TO RESTRAIN EROSION WITHIN 7 CALENDAR DAYS AFTER THE COMPLETION OF ANY PHASE OF GRADING. ALL AREAS UPON WHICH NO FURTHER LAND DISTURBING ACTIVITY WILL BE UNDERTAKEN ARE TO BE PLANTED OR PROVIDED WITH PROTECTIVE COVER WITHIN 14 CALENDAR DAYS.
- ALL EROSION CONTROL MEASURES SHALL BE CONSTRUCTED IN ACCORDANCE WITH THE N.C. EROSION AND SEDIMENT CONTROL PLANNING AND DESIGN MANUAL, U.S. DEPT. OF AGRICULTURE, CITY OF CHARLOTTE EROSION CONTROL ORDINANCE, AND THE CHARLOTTE LAND DEVELOPMENT STANDARDS MANUAL.
- AS AREAS ARE BROUGHT TO FINISHED GRADE, CONTRACTOR TO INSTALL FINAL GRASSING AND STABILIZE ALL SLOPES PER THE EROSION CONTROL NOTES AND DETAILS AND LANDSCAPE PLAN AND DETAILS.
- CONTRACTOR SHALL COORDINATE WITH THE EROSION CONTROL INSPECTOR PRIOR TO REMOVAL OF EROSION CONTROL MEASURES.

TOTAL DISTURBED AREA
±59.6 ACRES

0 75' 150' 300'
SCALE: 1" = 150'



Know what's below.
Call before you dig.

DESIGNED BY: DF/CD
DRAWN BY: DF/JWM
REVIEWED BY: DF


PER TOWN OF ROLESVILLE COMMENT
06/01/2023
REV 04/03/2023
INITIAL SUBMITTAL

5440 WADE PARK BLVD, SUITE 102
RALEIGH NC 27607
WWW.BGEINC.COM
NC LICENSE #C-4397


LENNAR
CORPORAION
1100 PERIMETER PARK DRIVE, SUITE 112
MORRISVILLE / NORTH CAROLINA / 27560

OVERALL PHASE 2 EROSION
CONTROL PLAN

PRELIMINARY
NOT FOR
CONSTRUCTION
FILE NUMBER:
8430-03
DATE: 06/01/2023
C5-7

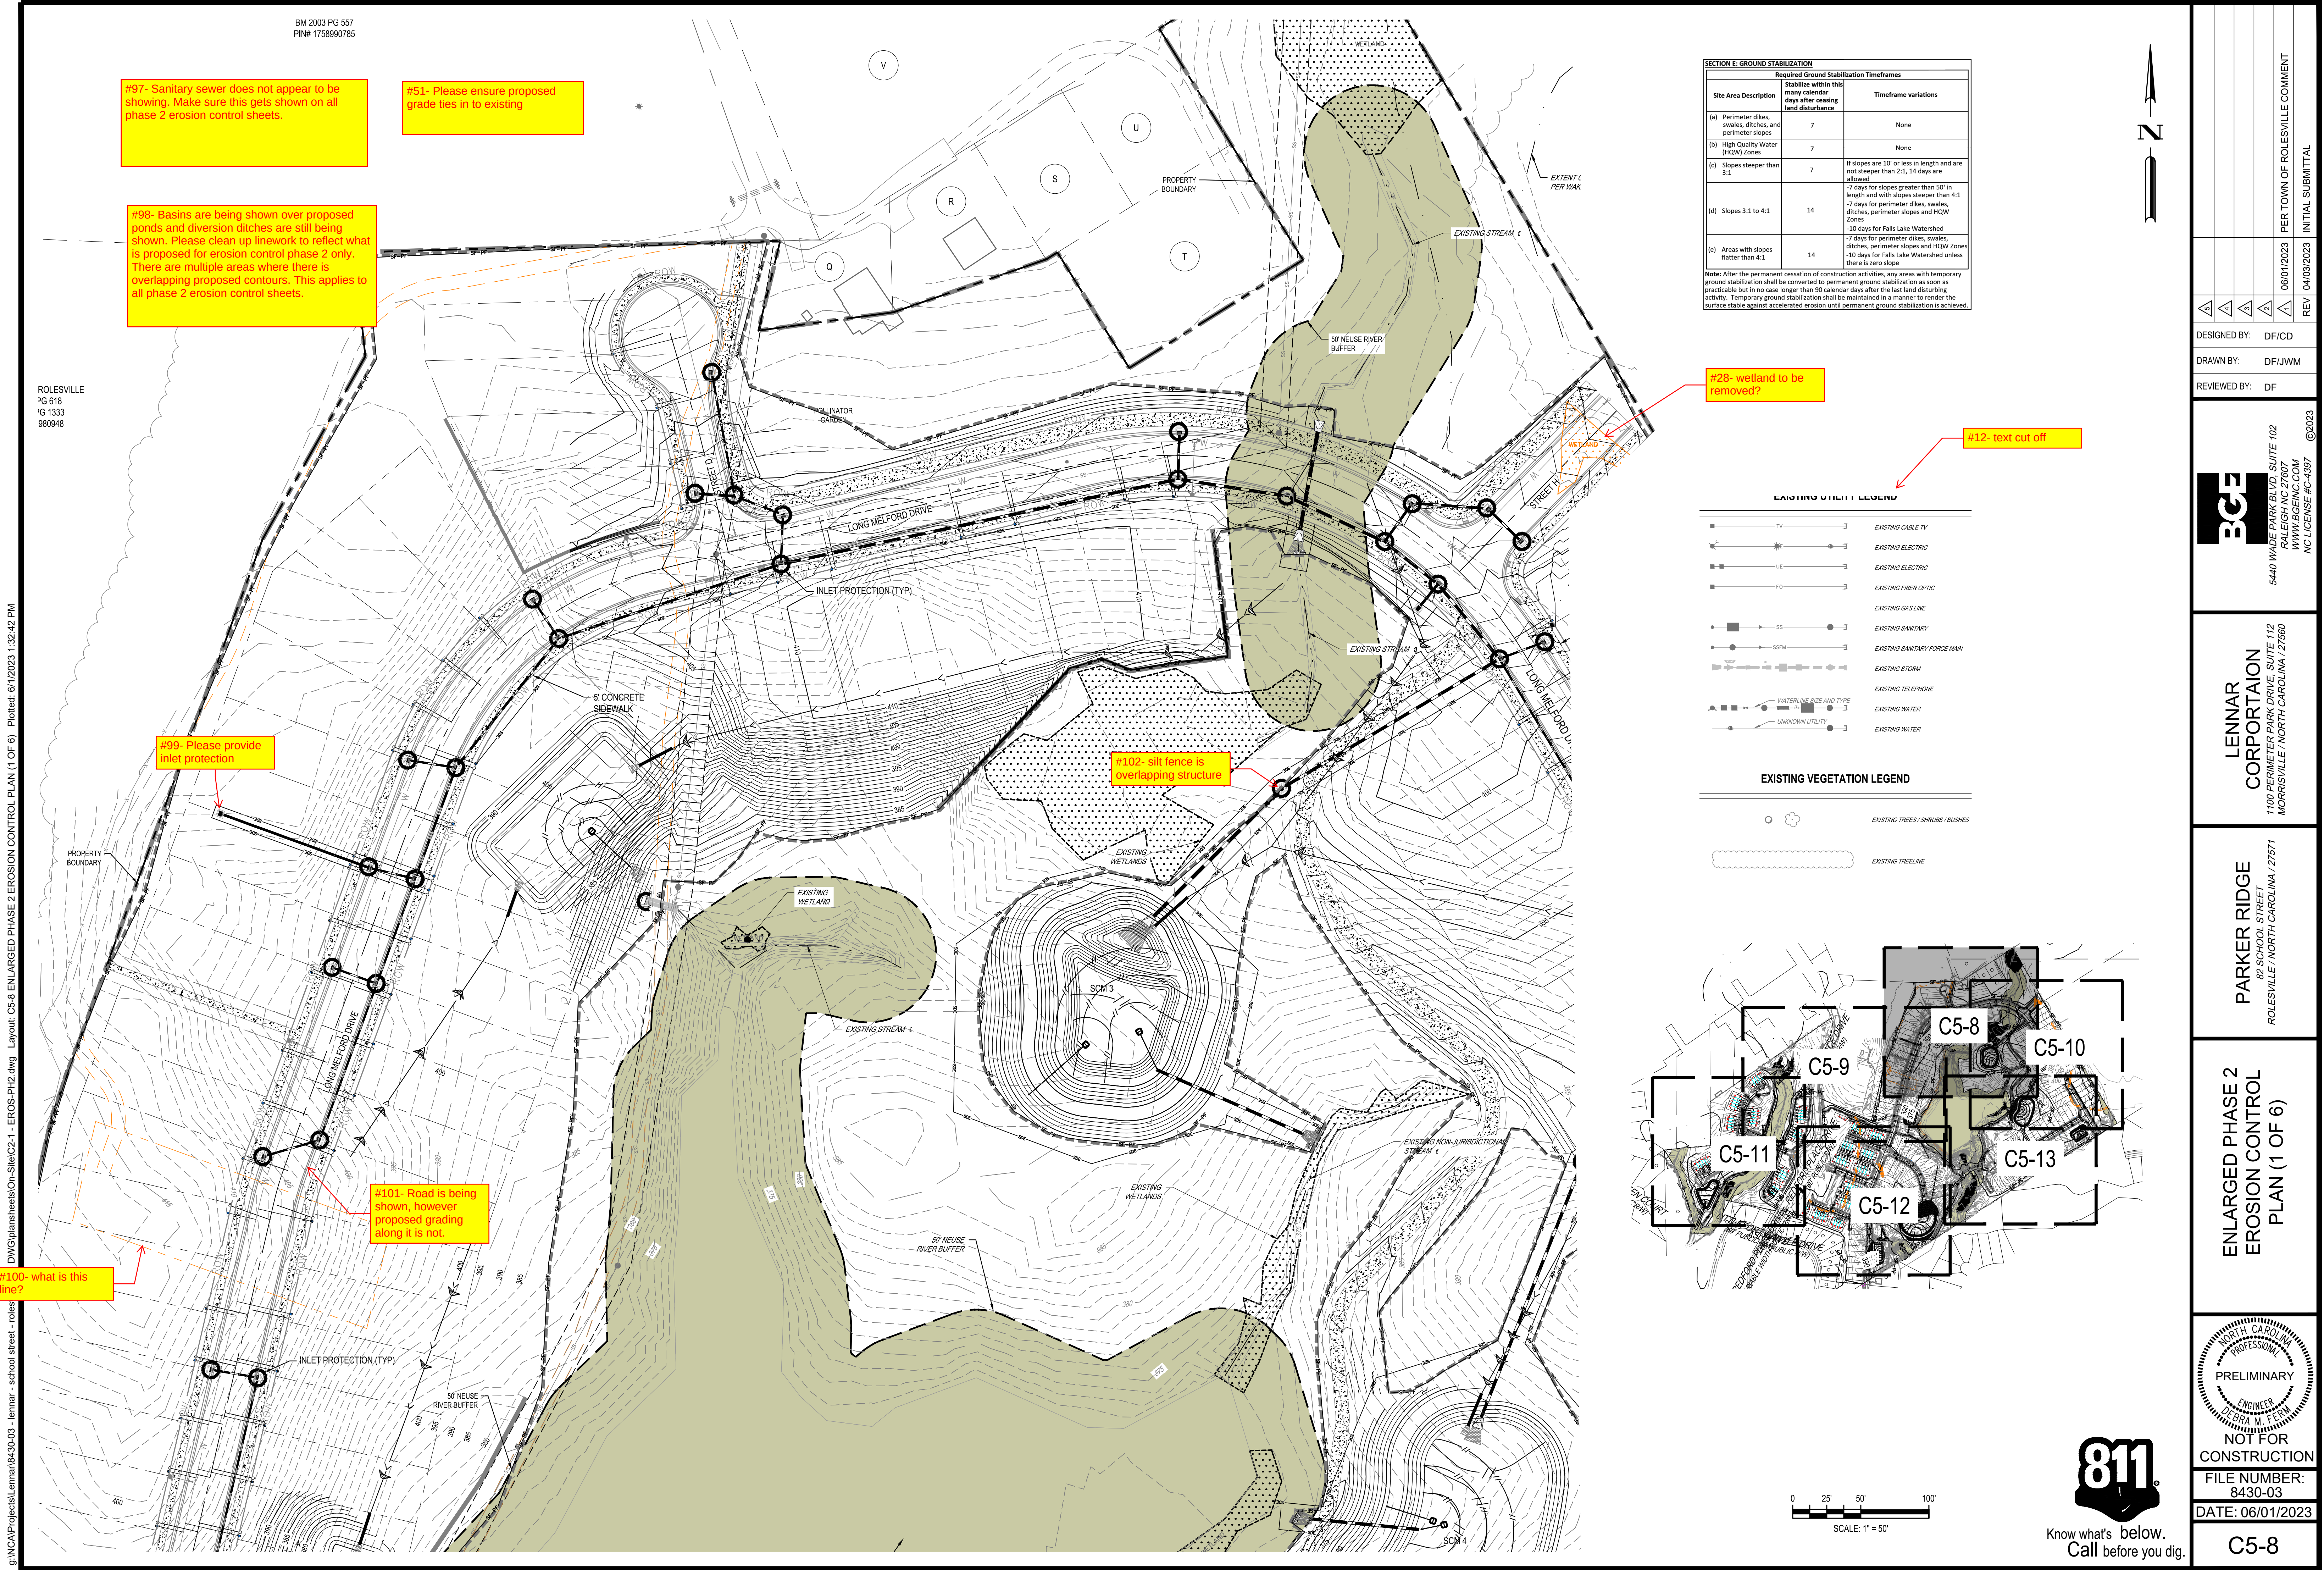


g:\NCAP\Projects\Lennar\8430-03 - Lennar - school street - rolesville\03 - DWG\plansheets\On-Site\EC2-1 - EROS-PH2.dwg Layout: C5-9 ENLARGED PHASE 2 EROSION CONTROL PLAN (2 OF 6) Plotted: 6/12/2023 1:32:58 PM

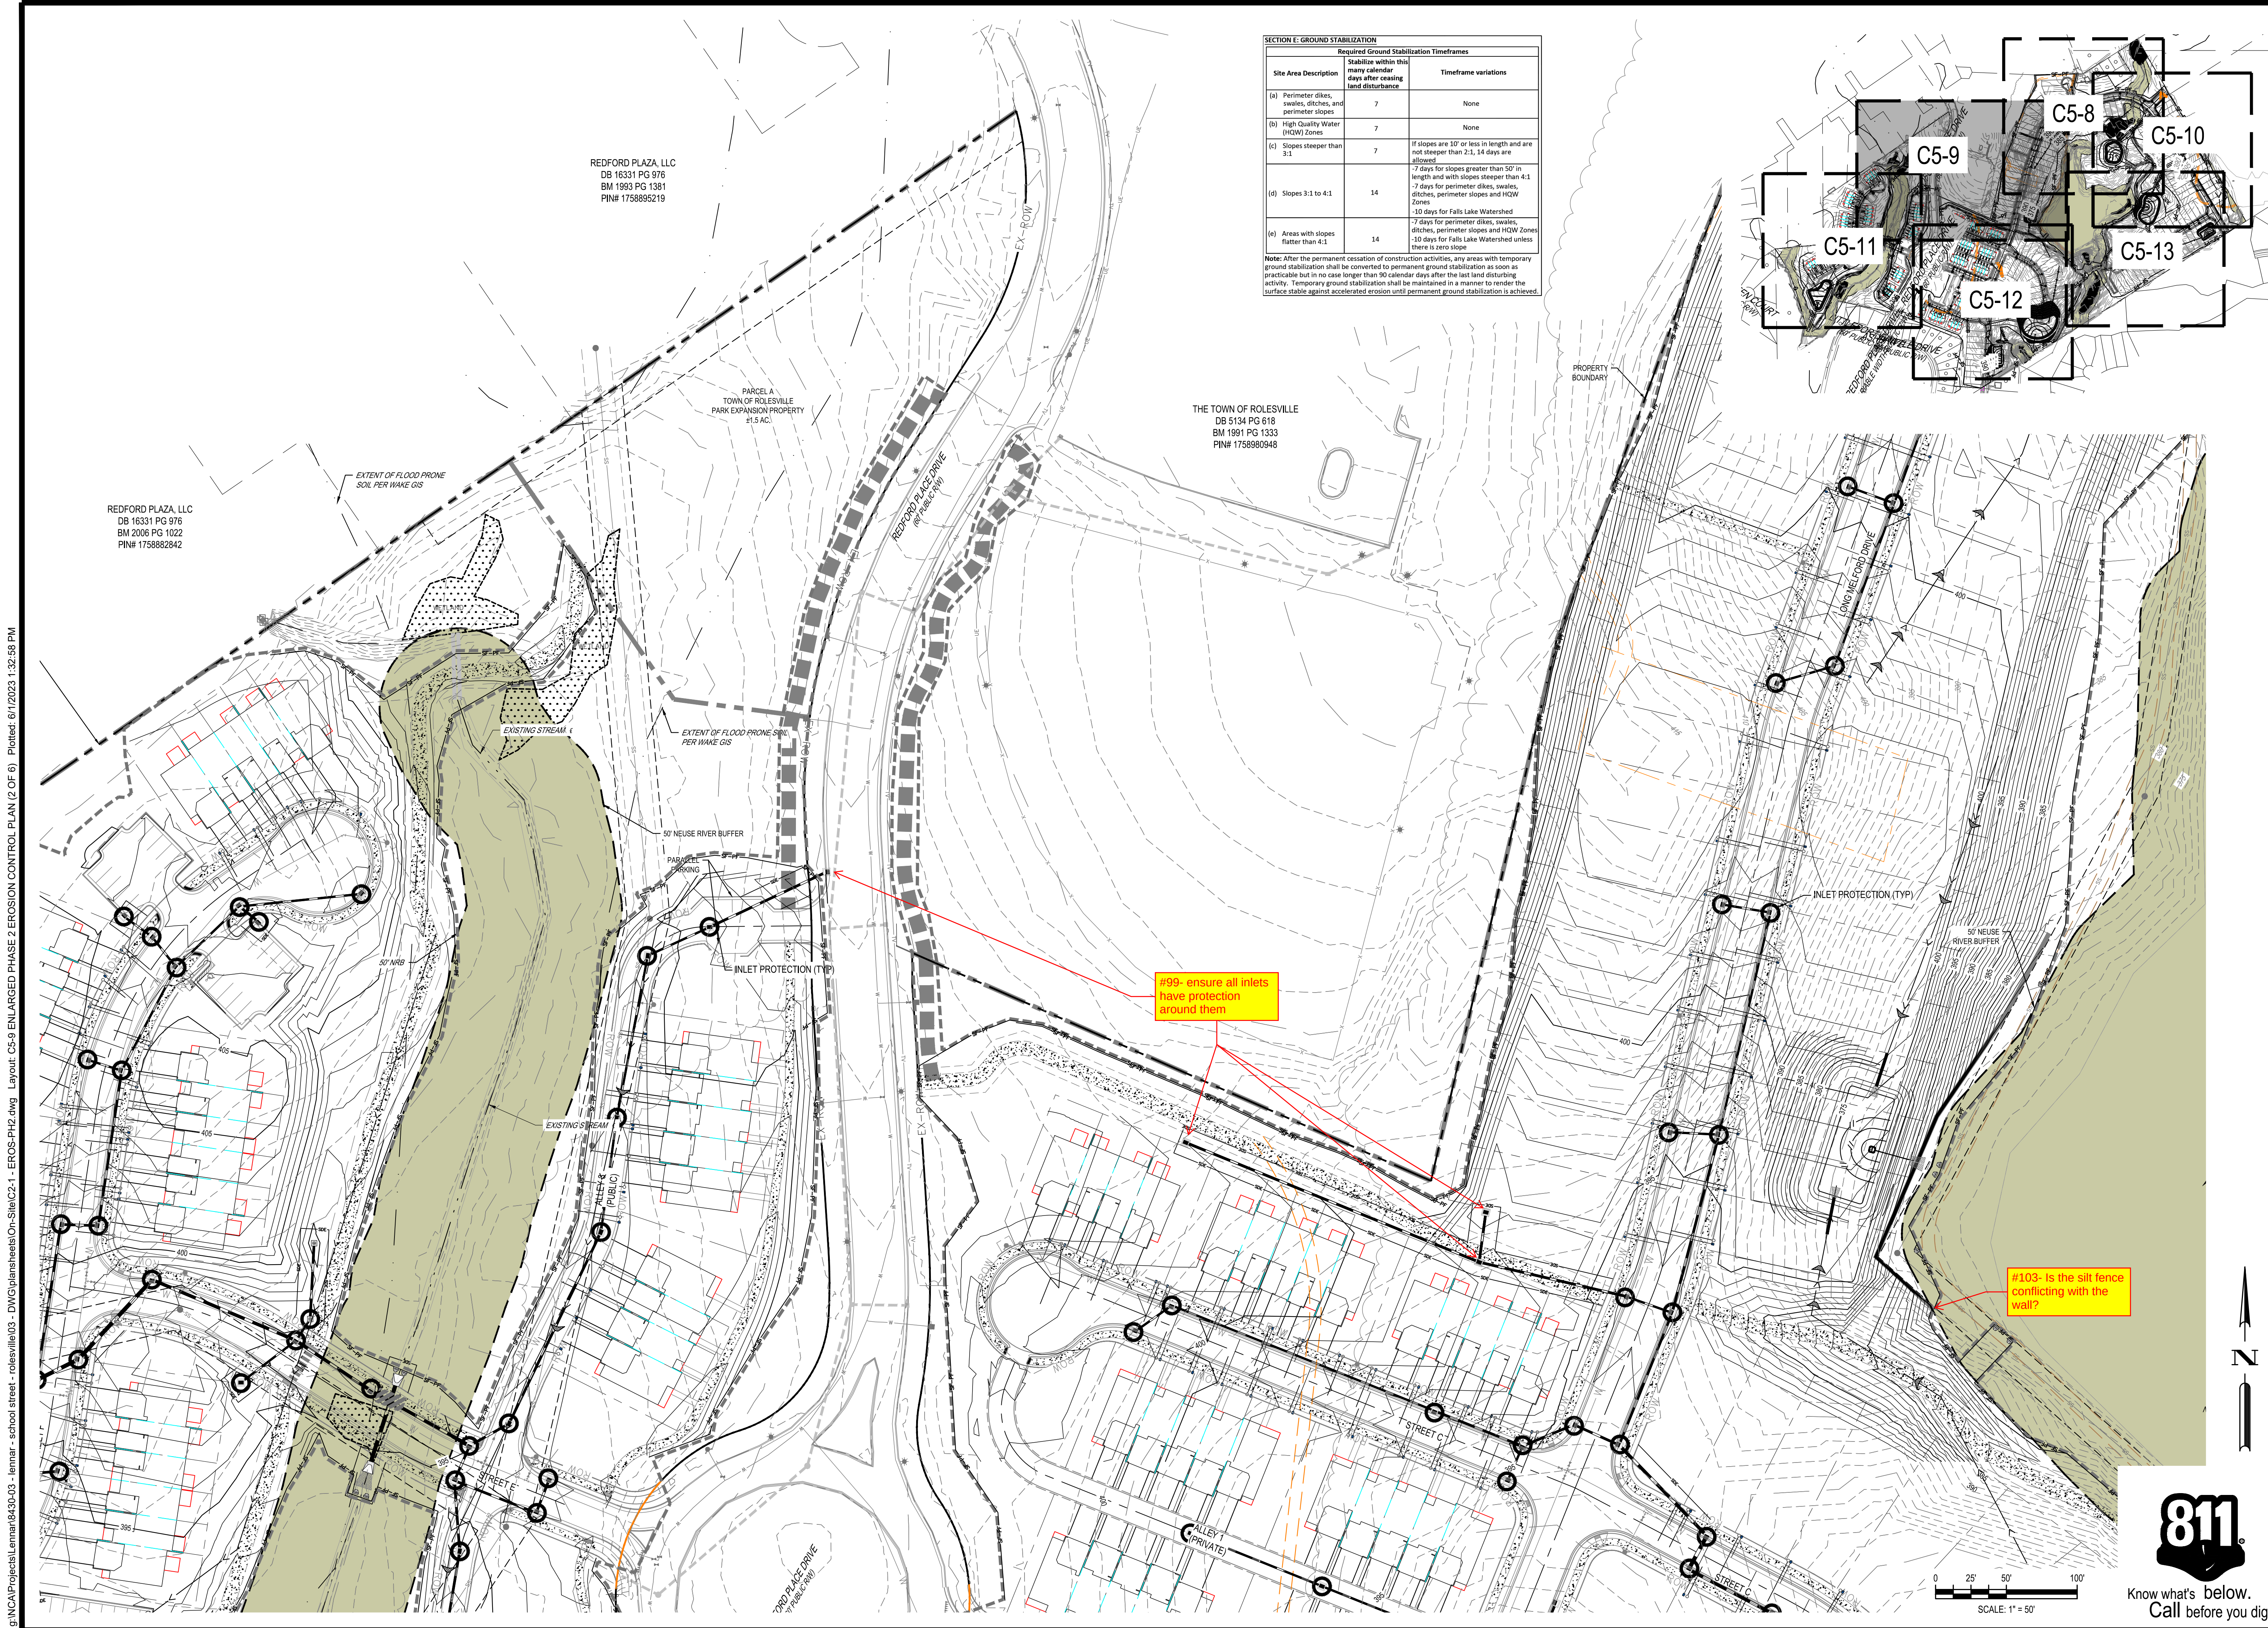

SECTION E: GROUND STABILIZATION		
Site Area Description	Required Ground Stabilization Timeframes	Timeframe variations
	Stabilize within this many calendar days after ceasing land disturbance	
(a) Perimeter dikes, swales, ditches, and perimeter slopes	7	None
(b) High Quality Water (HQW) Zones	7	None
(c) Slopes steeper than 3:1	7	If slopes are 10' or less in length and are not steeper than 2:1, 14 days are allowed
(d) Slopes 3:1 to 4:1	14	- 7 days for slopes greater than 50' in length and with slopes steeper than 4:1 - 7 days for perimeter dikes, swales, ditches, perimeter slopes and HQW Zones - 10 days for Falls Lake Watershed
(e) Areas with slopes flatter than 4:1	14	- 7 days for perimeter dikes, swales, ditches, perimeter slopes and HQW Zones - 10 days for Falls Lake Watershed unless there is zero slope

Note: After the permanent cessation of construction activities, any areas with temporary ground stabilization shall be converted to permanent ground stabilization as soon as practicable but in no case longer than 90 calendar days after the last land disturbing activity. Temporary ground stabilization shall be maintained in a manner to render the surface stable against accelerated erosion until permanent ground stabilization is achieved.

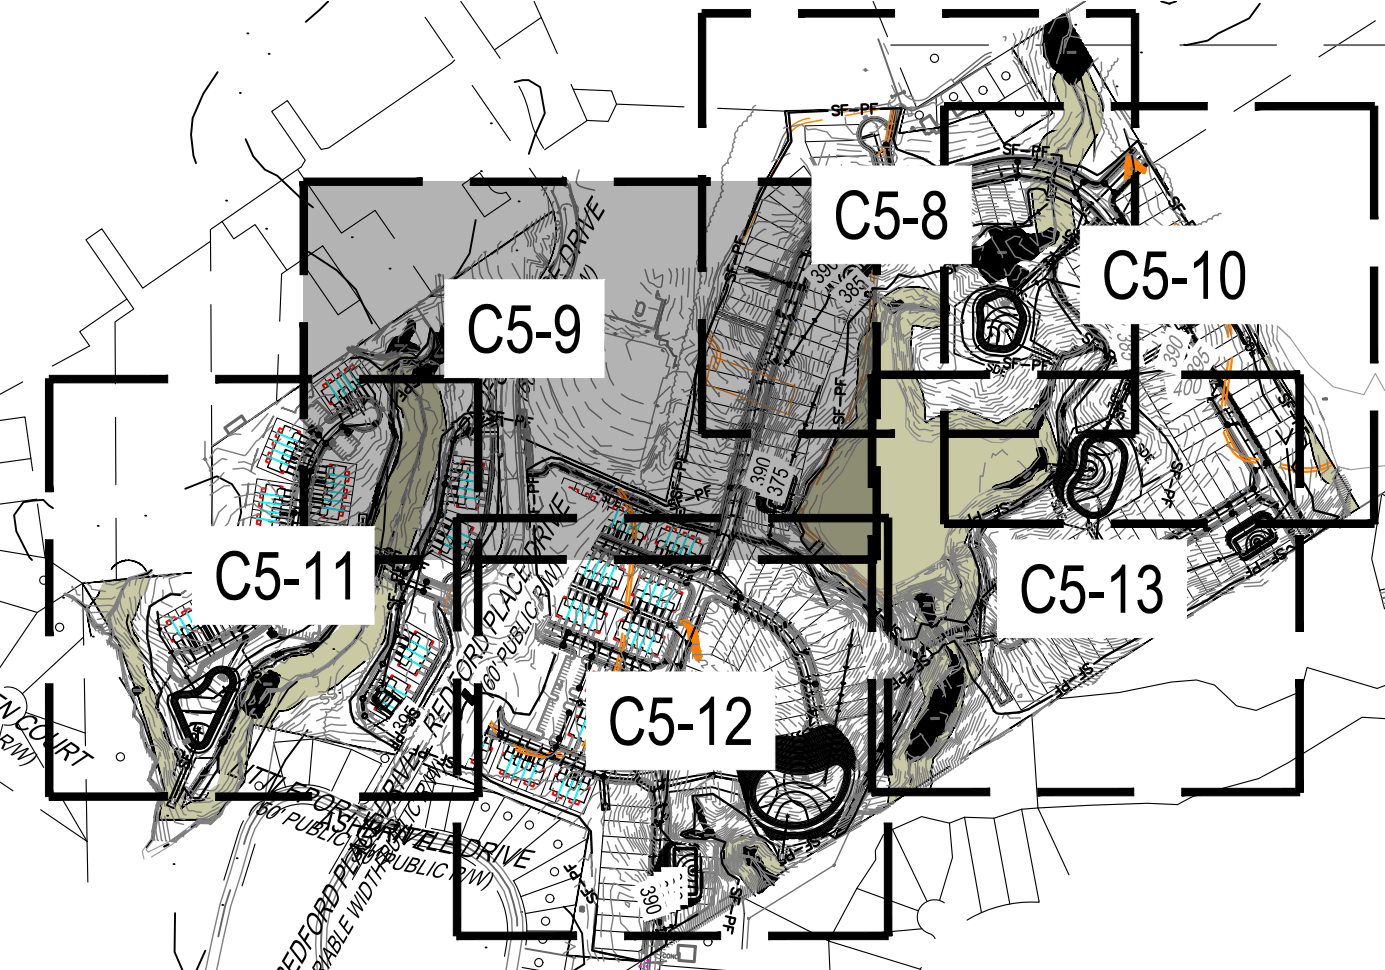

REDFORD PLAZA, LLC
DB 16331 PG 976
BM 2006 PG 1022
PIN# 1758882842

REDFORD PLAZA, LLC
DB 16331 PG 976
BM 1993 PG 1381
PIN# 1758895219

PARCEL A
TOWN OF ROLESVILLE
PARK EXPANSION PROPERTY
±1.5 AC.

THE TOWN OF ROLESVILLE
DB 5134 PG 618
BM 1991 PG 1333
PIN# 1758909948

DESIGNED BY: DF/CD

DRAWN BY: DF/JWM

REVIEWED BY: DF

811

Know what's below.
Call before you dig.

SCALE: 1" = 50'

0 25 50 100'

SCALE: 1" = 50'

ENLARGED PHASE 2
EROSION CONTROL
PLAN (2 OF 6)

FILE NUMBER:
8430-03

DATE: 06/01/2023

NOT FOR
CONSTRUCTION

PRELIMINARY

ENGINEER
FEDRA M. FERNANDEZ

PROFESSIONAL
NORTH CAROLINA

PARKER RIDGE
82 SCHOOL STREET
ROLESVILLE / NORTH CAROLINA / 27571

LENNAR
CORPORAION
1100 PERIMETER PARK DRIVE, SUITE 112
MORRISVILLE / NORTH CAROLINA / 27560

BCE

5440 WADE PARK BLVD, SUITE 102
RALEIGH NC 27607
WWW.BCEINC.COM
NC LICENSE #C-4397

06/01/2023

04/03/2023


REV

PER TOWN OF ROLESVILLE COMMENT

INITIAL SUBMITTAL


C5-9

g:\NCAP\Projects\Lennar\8430-03 - DWG\plansheets\On-Site\C2.1 - EROS-PHZ.dwg Layout: C5-10 ENLARGED PHASE 2 EROSION CONTROL PLAN (3 OF 6) Plotted: 6/1/2023 1:33:12 PM

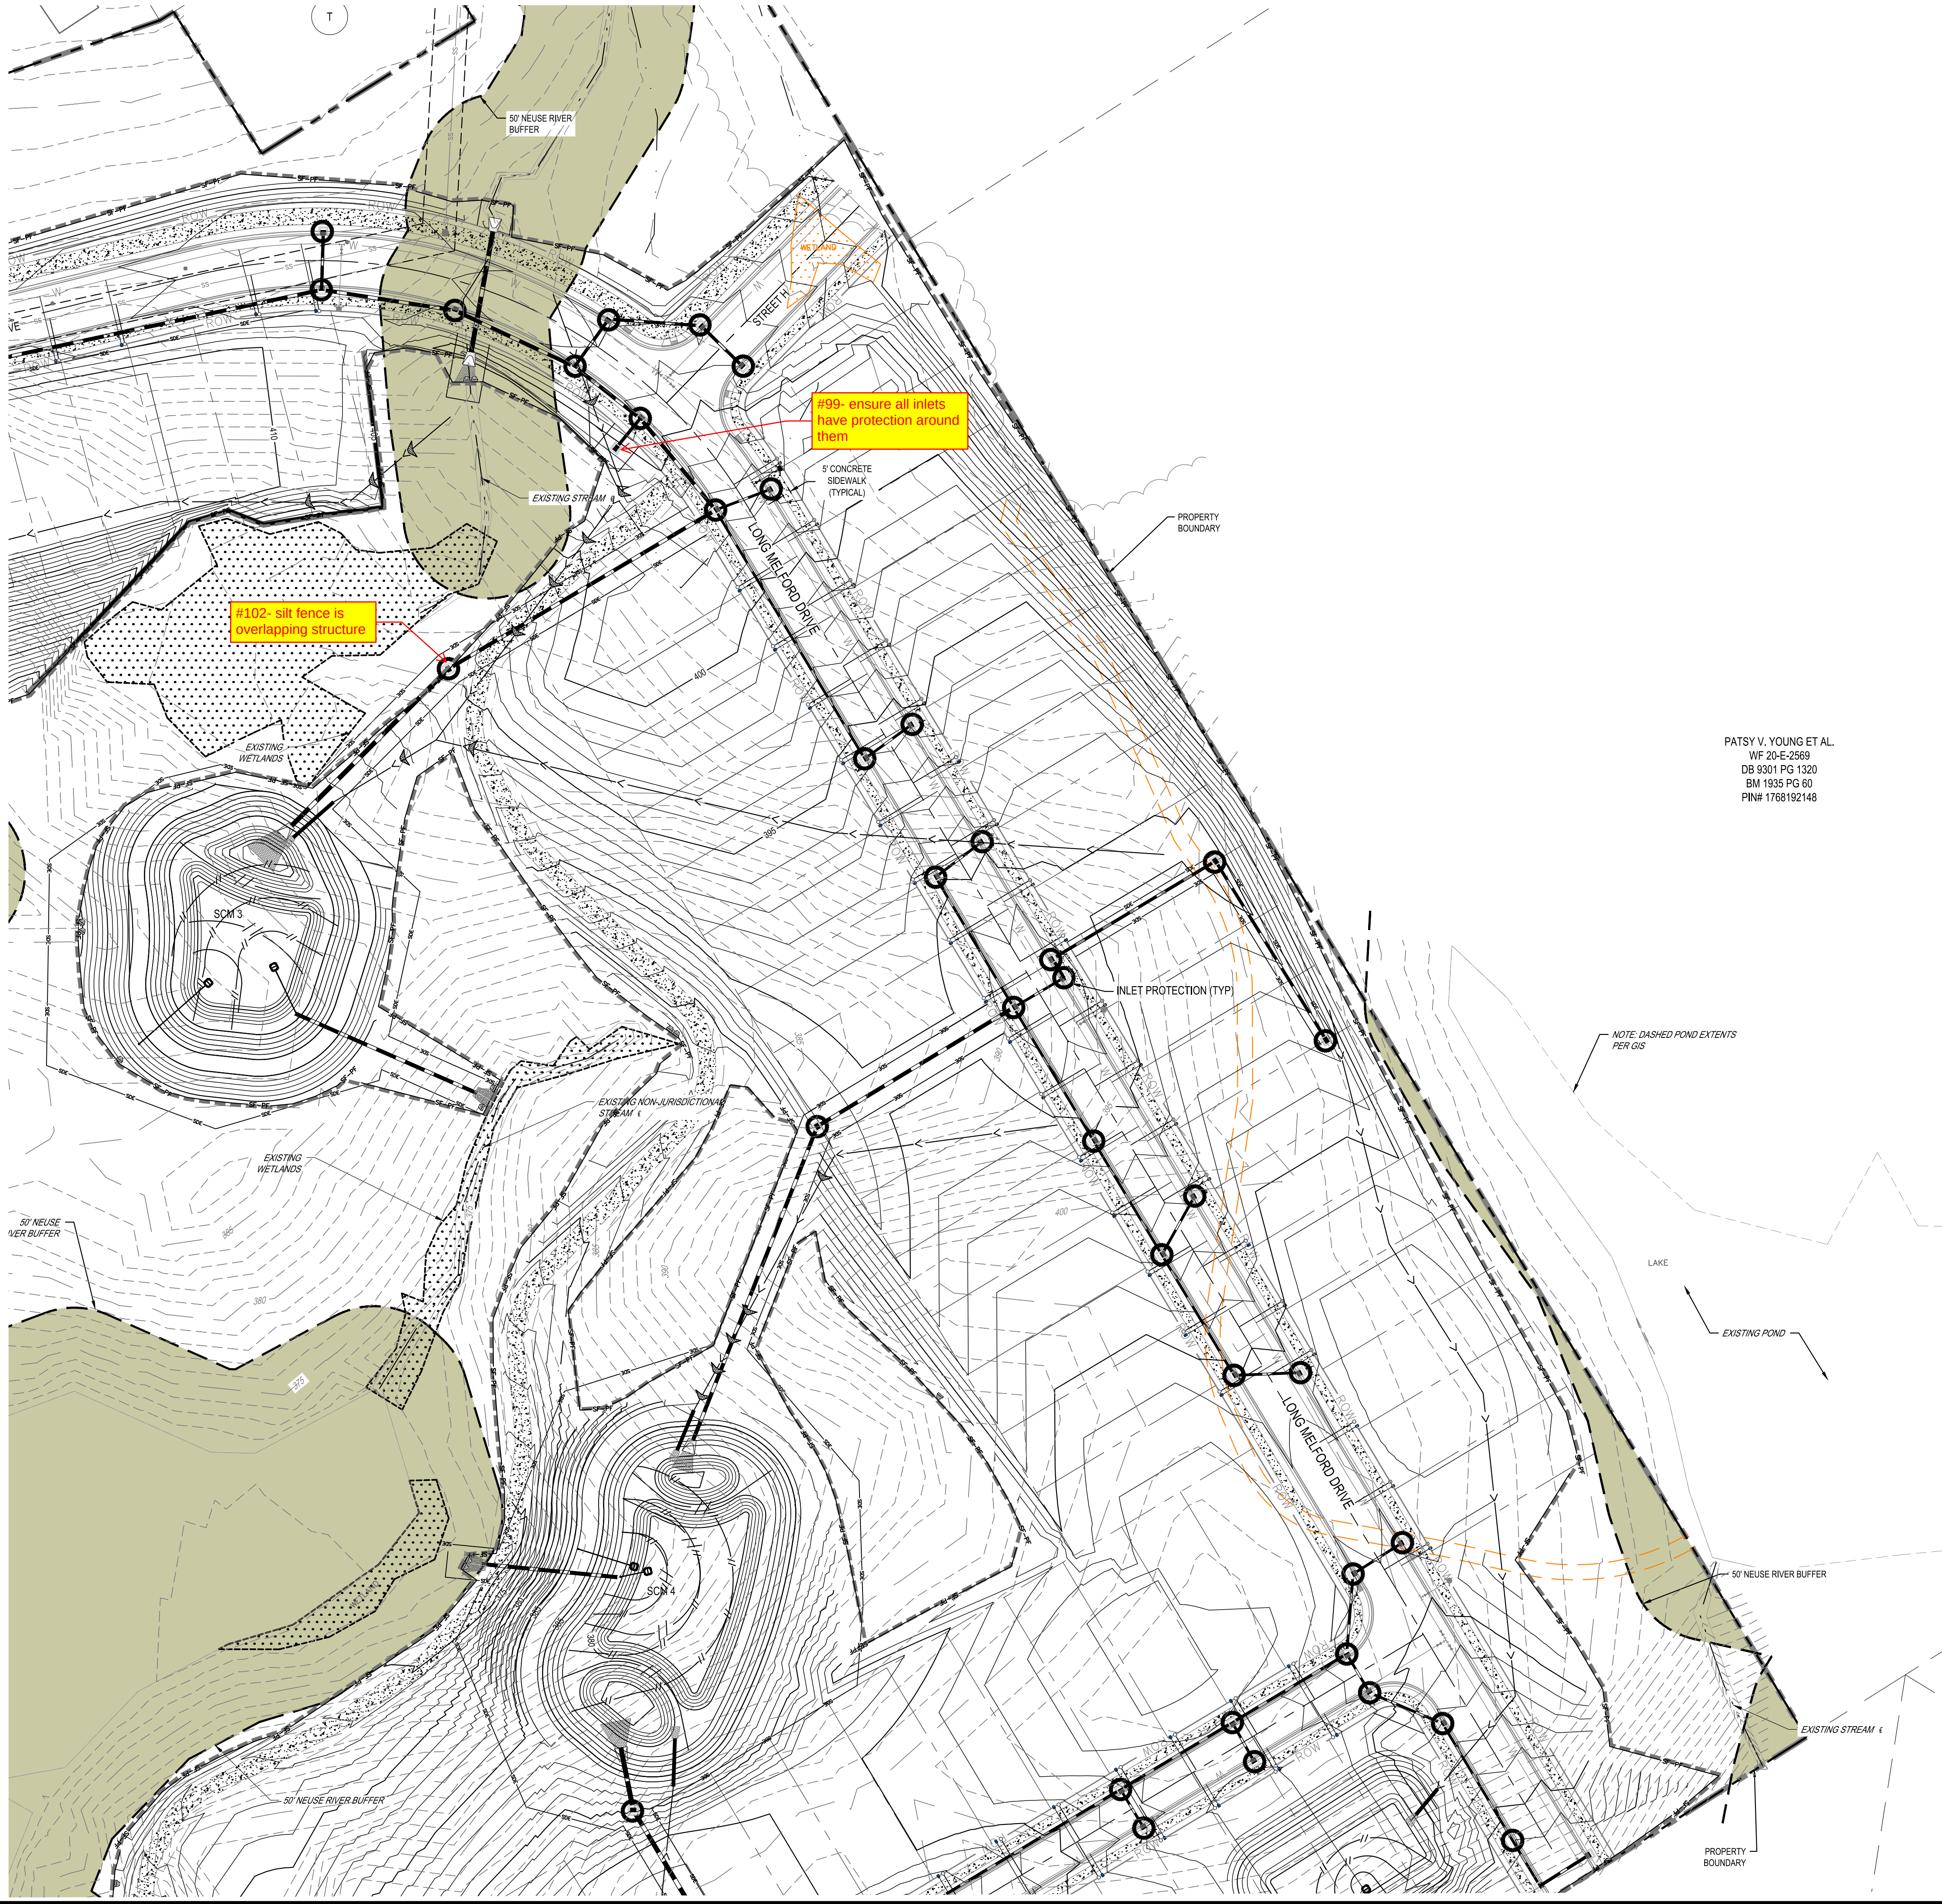

SECTION E: GROUND STABILIZATION		
Site Area Description	Required Ground Stabilization Timeframes	
	Stabilize within this many calendar days after ceasing land disturbance	Timeframe variations
(a) Perimeter dikes, swales, ditches, and perimeter slopes	7	None
(b) High Quality Water (HQP) Zones	7	None
(c) Slopes steeper than 3:1	7	If slopes are 10' or less in length and are not steeper than 2:1, 14 days are allowed
(d) Slopes 3:1 to 4:1	14	-7 days for slopes greater than 50' in length and with slopes steeper than 4:1 -7 days for perimeter dikes, swales, ditches, perimeter slopes and HQW Zones -10 days for Falls Lake Watershed
(e) Areas with slopes flatter than 4:1	14	-7 days for perimeter dikes, swales, ditches, perimeter slopes and HQW Zones -10 days for Falls Lake Watershed unless there is zero slope

Note: After the permanent cessation of construction activities, any areas with temporary ground stabilization shall be converted to permanent ground stabilization as soon as practicable but in no case longer than 90 calendar days after the last land disturbing activity. Temporary ground stabilization shall be maintained in a manner to render the surface stable against accelerated erosion until permanent ground stabilization is achieved.

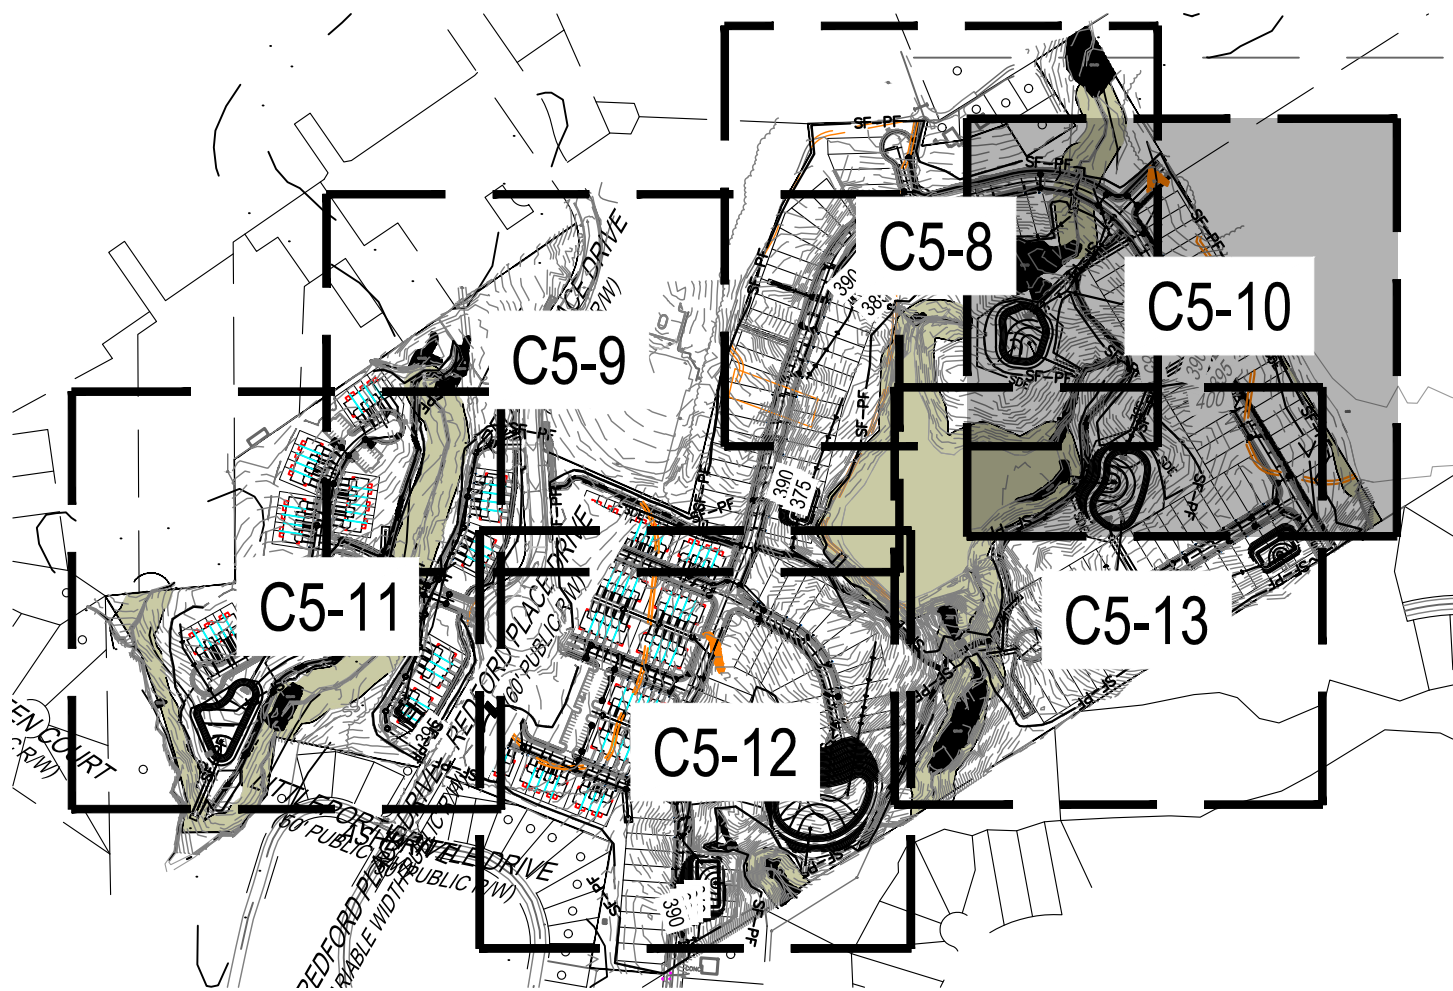

PRELIMINARY
ENGINEER
FEDRA M. FERNANDEZ
NOT FOR CONSTRUCTION
FILE NUMBER:
8430-03
DATE: 06/01/2023
C5-10

PARKER RIDGE
82 SCHOOL STREET
ROLESVILLE / NORTH CAROLINA / 27571


LENNAR
CORPORAION
1100 PERIMETER PARK DRIVE, SUITE 112
MORRISVILLE / NORTH CAROLINA / 27560

BCE
5440 WADE PARK BLVD, SUITE 102
RALEIGH NC 27607
WWW.BCEINC.COM
NC LICENSE #C-4397

DESIGNED BY: DF/CD
DRAWN BY: DF/JWM
REVIEWED BY: DF

06/01/2023	PER TOWN OF ROLESVILLE COMMENT	INITIAL SUBMITTAL
REV	04/03/2023	

g:\NCA\Projects\Lennar\8430-03 - lemmar - school street - eros-phz.dwg Layout: C5-11 ENLARGED PHASE 2 EROSION CONTROL PLAN (4 OF 6) Plotted: 6/1/2023 1:33:29 PM

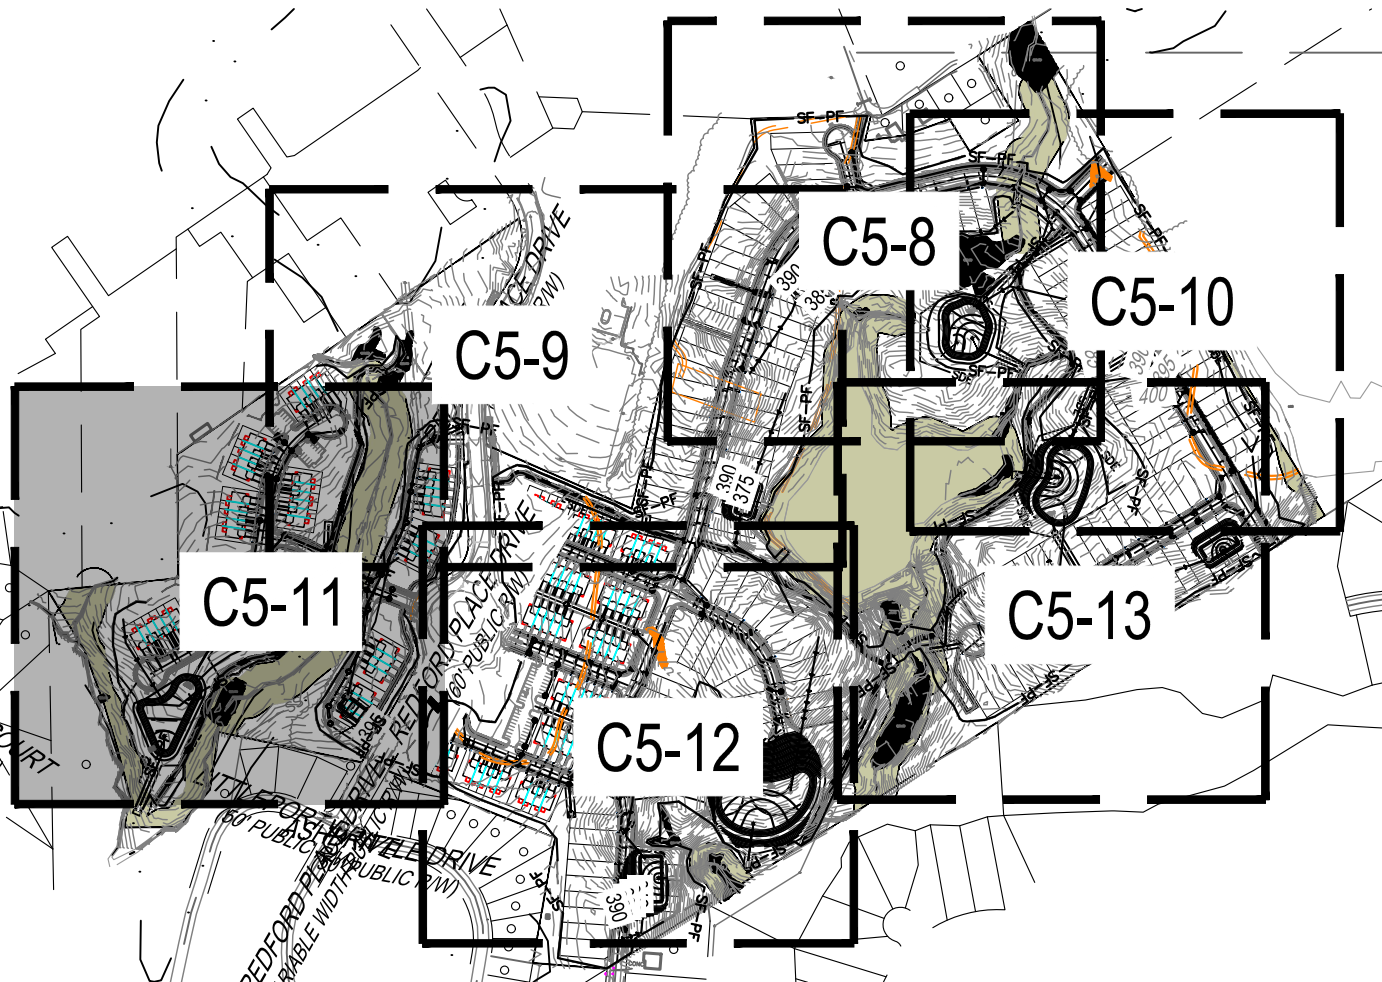

SECTION E: GROUND STABILIZATION		
Site Area Description	Required Ground Stabilization Timeframes	
	Stabilize within this many calendar days after ceasing land disturbance	Timeframe variations
(a) Slopes steeper than 3:1	7	None
(b) Slopes steeper than 3:1	7	None
(c) Slopes steeper than 3:1	7	If slopes are 10' or less in length and are not steeper than 2:1, 14 days are allowed. -7 days for slopes greater than 50' in length and with slopes steeper than 4:1 -7 days for perimeter dikes, swales, ditches, perimeter slopes and HQW Zones -10 days for Falls Lake Watershed
(d) Slopes 3:1 to 4:1	14	-7 days for perimeter dikes, swales, ditches, perimeter slopes and HQW Zones -10 days for Falls Lake Watershed unless there is zero slope
(e) Areas with slopes flatter than 4:1	14	-7 days for perimeter dikes, swales, ditches, perimeter slopes and HQW Zones -10 days for Falls Lake Watershed unless there is zero slope

Note: After the permanent cessation of construction activities, any areas with temporary ground stabilization shall be converted to permanent ground stabilization as soon as practicable but in no case longer than 90 calendar days after the last land disturbing activity. Temporary ground stabilization shall be maintained in a manner to render the surface stable against accelerated erosion until permanent ground stabilization is achieved.



Know what's below.
Call before you dig.



ENLARGED PHASE 2
EROSION CONTROL
PLAN (4 OF 6)

PARKER RIDGE
82 SCHOOL STREET
ROLESVILLE / NORTH CAROLINA / 27571

LENNAR
CORPORAION
1100 PERIMETER PARK DRIVE, SUITE 112
MORRISVILLE / NORTH CAROLINA / 27560


BCE
5440 WADE PARK BLVD, SUITE 102
RALEIGH NC 27607
WWW.BCEINC.COM
NC LICENSE #C-4397

DESIGNED BY: DF/CD
DRAWN BY: DF/JWM
REVIEWED BY: DF

06/01/2023
REV 04/03/2023
PER TOWN OF ROLESVILLE COMMENT
INITIAL SUBMITTAL



FILE NUMBER:
8430-03
DATE: 06/01/2023
C5-11

g:\NCAP\Projects\Lennar\8430-03 - DWG\plansheets\On-Site\C2-1 - EROS-PH2.dwg Layout: C5-12 ENLARGED PHASE 2 EROSION CONTROL PLAN (5 OF 6) Plotted: 6/1/2023 1:33:42 PM

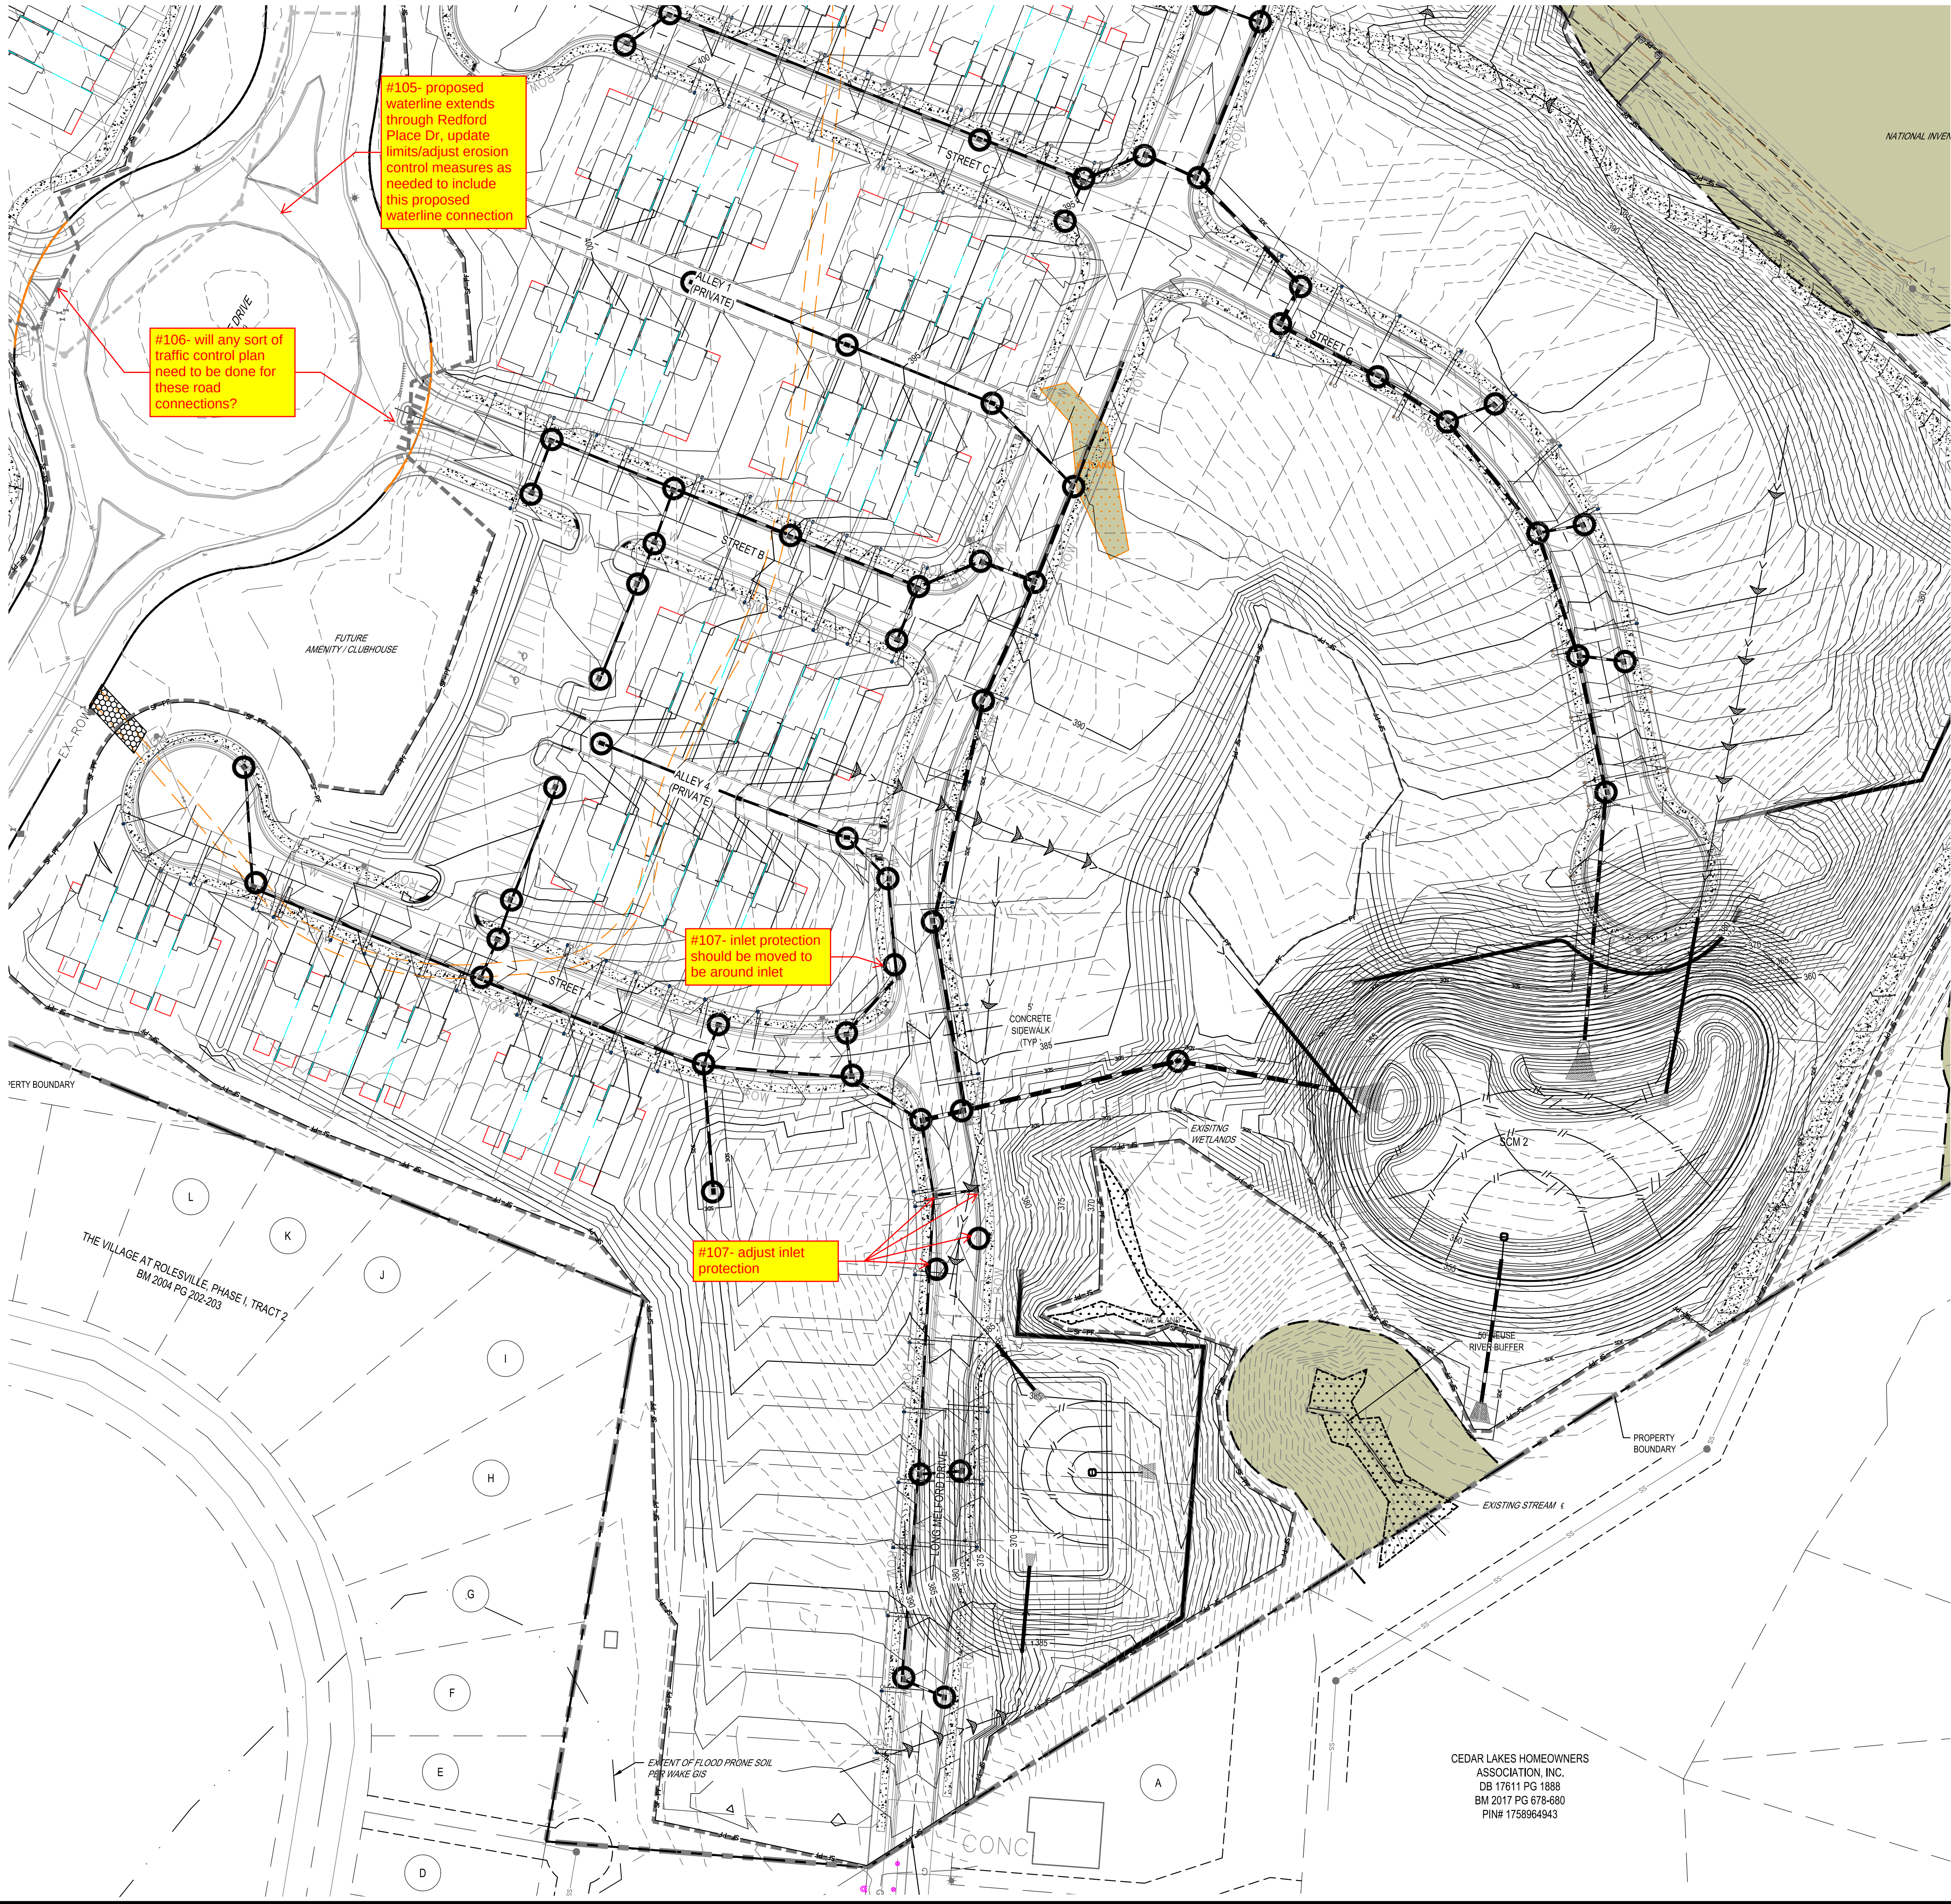

SECTION E: GROUND STABILIZATION		
Site Area Description	Required Ground Stabilization Timeframes	
	Stabilize within this many calendar days after ceasing land disturbance	Timeframe variations
(a) Perimeter dikes, swales, ditches, and perimeter slopes	7	None
(b) High Quality Water (HQP) Zones	7	None
(c) Slopes steeper than 3:1	7	If slopes are 10' or less in length and are not steeper than 2:1, 14 days are allowed -7 days for slopes greater than 50' in length and with slopes steeper than 4:1 -7 days for perimeter dikes, swales, ditches, perimeter slopes and HQW Zones -10 days for Falls Lake Watershed
(d) Slopes 3:1 to 4:1	14	-7 days for perimeter dikes, swales, ditches, perimeter slopes and HQW Zones -10 days for Falls Lake Watershed unless there is zero slope
(e) Areas with slopes flatter than 4:1	14	-7 days for perimeter dikes, swales, ditches, perimeter slopes and HQW Zones -10 days for Falls Lake Watershed unless there is zero slope

Note: After the permanent cessation of construction activities, any areas with temporary ground stabilization shall be converted to permanent ground stabilization as soon as practicable but in no case longer than 90 calendar days after the last land disturbing activity. Temporary ground stabilization shall be maintained in a manner to render the surface stable against accelerated erosion until permanent ground stabilization is achieved.

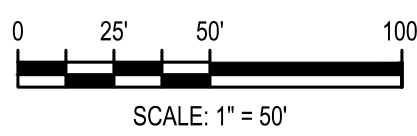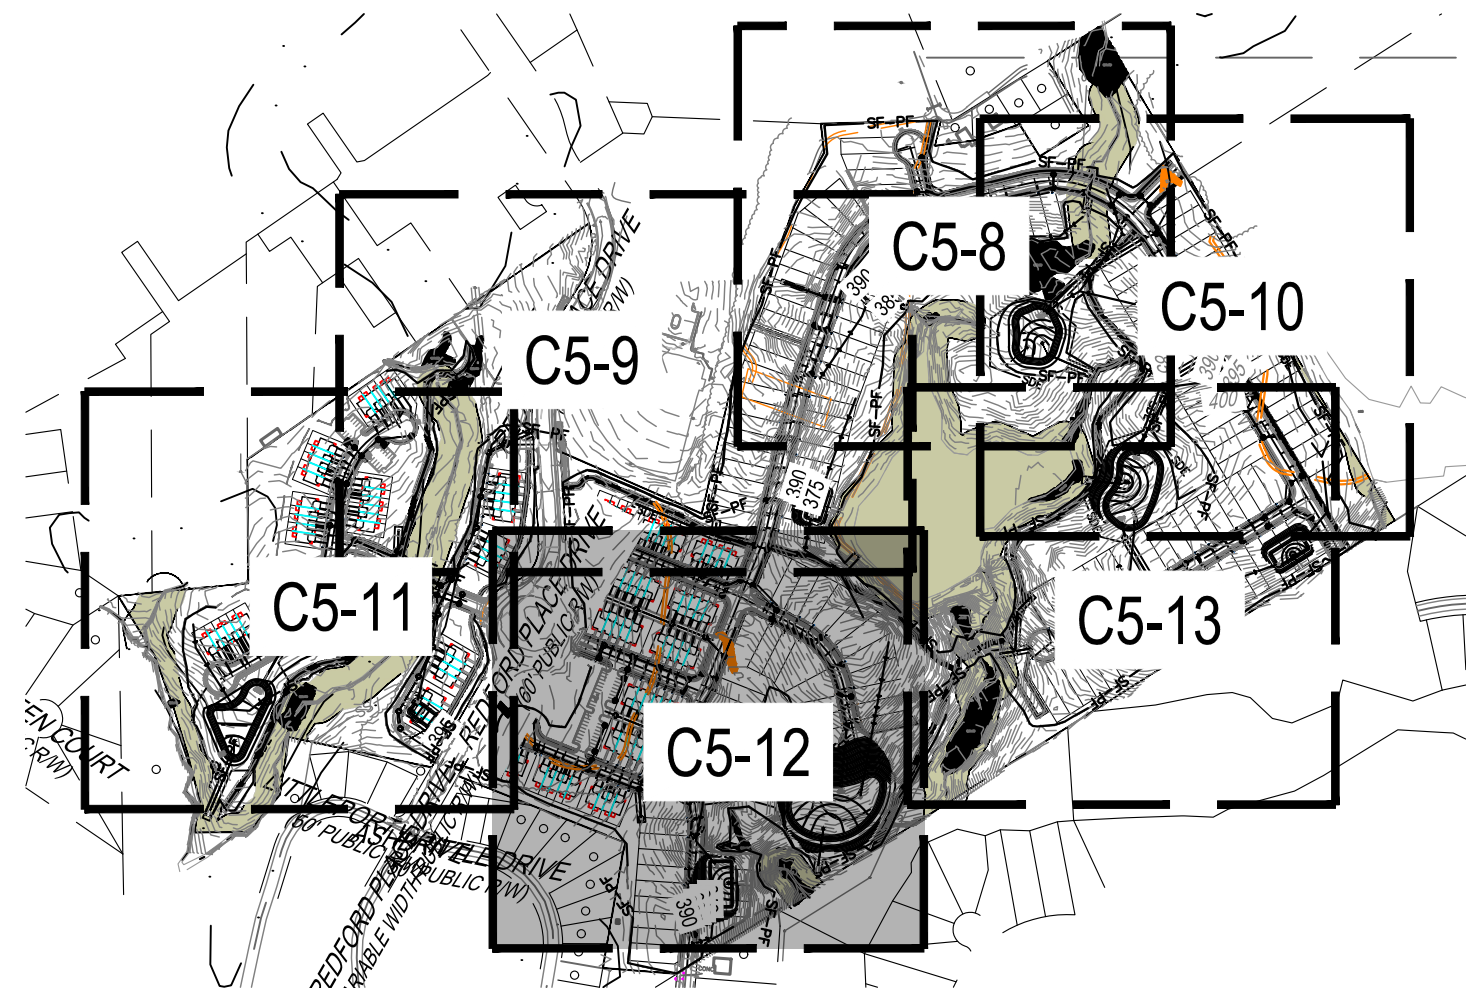

DESIGNED BY: DF/CD

DRAWN BY: DF/JWM

REVIEWED BY: DF

BCE

5440 WADE PARK BLVD, SUITE 102
RALEIGH NC 27607
WWW.BCEINC.COM
NC LICENSE #C-4397

LENNAR
CORPORAION
1100 PERIMETER PARK DRIVE, SUITE 112
MORRISVILLE / NORTH CAROLINA / 27560

PARKER RIDGE
82 SCHOOL STREET
ROLESVILLE / NORTH CAROLINA / 27571

ENLARGED PHASE 2
EROSION CONTROL
PLAN (5 OF 6)

NORTH CAROLINA
PROFESSIONAL
ENGINEER
FEDRA M. FERNANDEZ

PRELIMINARY

NOT FOR
CONSTRUCTION


FILE NUMBER:
8430-03

DATE: 06/01/2023

C5-12

06/01/2023
04/03/2023
REV
INITIAL SUBMITTAL
PER TOWN OF ROLESVILLE COMMENT

g:\NCAP\Projects\Lennar\8430-03 - lennar - school street - rolesville\03 - DWG\plansheets\On-Site\C2-1 - EROS-PH2.dwg Layout: C5-13 ENLARGED PHASE 2 EROSION CONTROL PLAN (6 OF 6) Plotted: 6/1/2023 1:39:57 PM

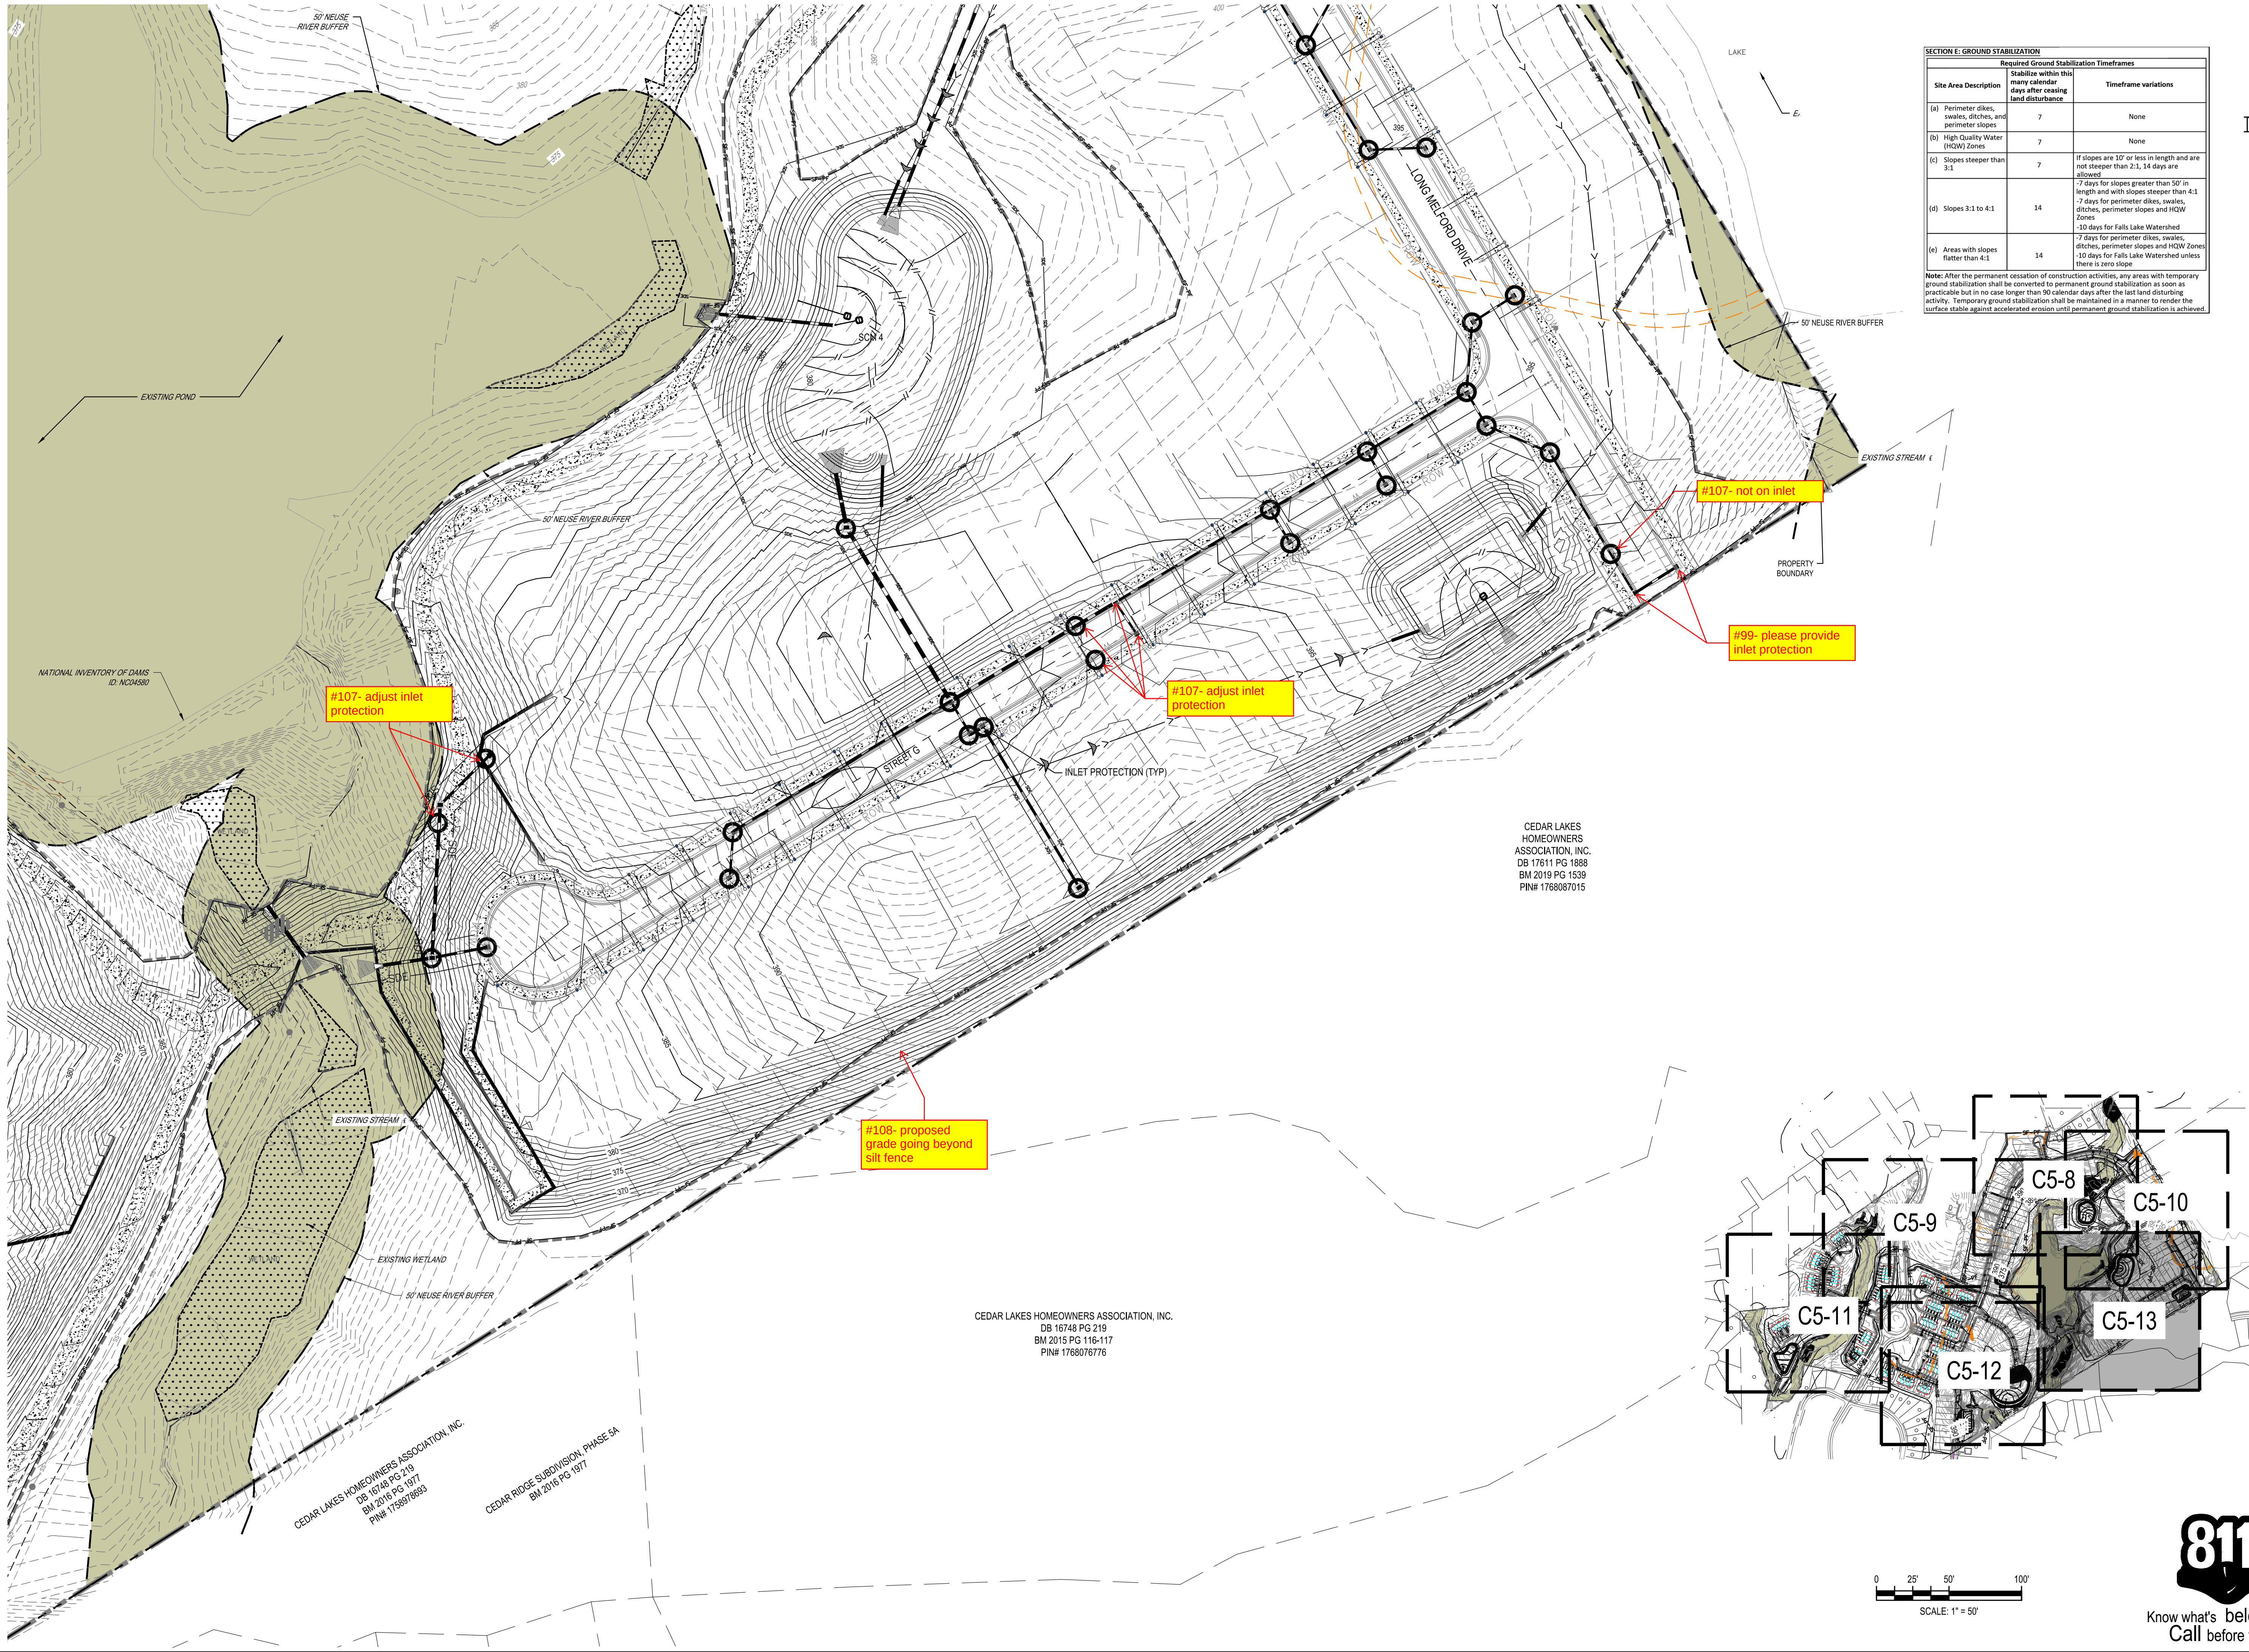

SECTION E: GROUND STABILIZATION		
Site Area Description	Required Ground Stabilization Timeframes	
	Stabilize within this many calendar days after ceasing land disturbance	Timeframe variations
(a) Perimeter dikes, swales, ditches, and perimeter slopes	7	None
(b) High Quality Water (HCW) Zones	7	None
(c) Slopes steeper than 3:1	7	If slopes are 10' or less in length and are not steeper than 2:1, 14 days are allowed
(d) Slopes 3:1 to 4:1	14	- 7 days for slopes greater than 50' in length and with slopes steeper than 4:1 - 7 days for perimeter dikes, swales, ditches, perimeter slopes and HCW Zones - 10 days for Falls Lake Watershed
(e) Areas with slopes flatter than 4:1	14	- 7 days for perimeter dikes, swales, ditches, perimeter slopes and HCW Zones - 10 days for Falls Lake Watershed unless there is zero slope

Note: After the permanent cessation of construction activities, any areas with temporary ground stabilization shall be converted to permanent ground stabilization as soon as practicable but in no case longer than 90 calendar days after the last land disturbing activity. Temporary ground stabilization shall be maintained in a manner to render the surface stable against accelerated erosion until permanent ground stabilization is achieved.



DESIGNED BY: DF/CD

DRAWN BY: DF/JWM

REVIEWED BY: DF

▲

▲

REVISIONS

06/01/2023

04/03/2023

REV

PER TOWN OF ROLESVILLE COMMENT

INITIAL SUBMITTAL

BCE

5440 WADE PARK BLVD, SUITE 102

RALEIGH NC 27607

WWW.BCEINC.COM

NC LICENSE #C-4397

LENNAR

CORPORAION

1100 PERIMETER PARK DRIVE, SUITE 112

MORRISVILLE / NORTH CAROLINA / 27560

PARKER RIDGE

82 SCHOOL STREET

ROLESVILLE / NORTH CAROLINA / 27571

ENLARGED PHASE 2

EROSION CONTROL

PLAN (6 OF 6)

PRELIMINARY

ENGINEER

DEBRA M. FERN

NOT FOR CONSTRUCTION

FILE NUMBER:

8430-03

DATE:

06/01/2023

C5-13