




\\browngay.net\panzura\Regions\NCA\Projects\Lennar\8430-03 - Lennar - School Street - Rolesville\03 - DWG\PlanSheets\On-Site\C6-0 ROAD PLAN AND PROFILE.dwg Layout: C6-0 STREET A PLAN AND PROFILE Plotted: 6/1/2023 3:28:12 PM

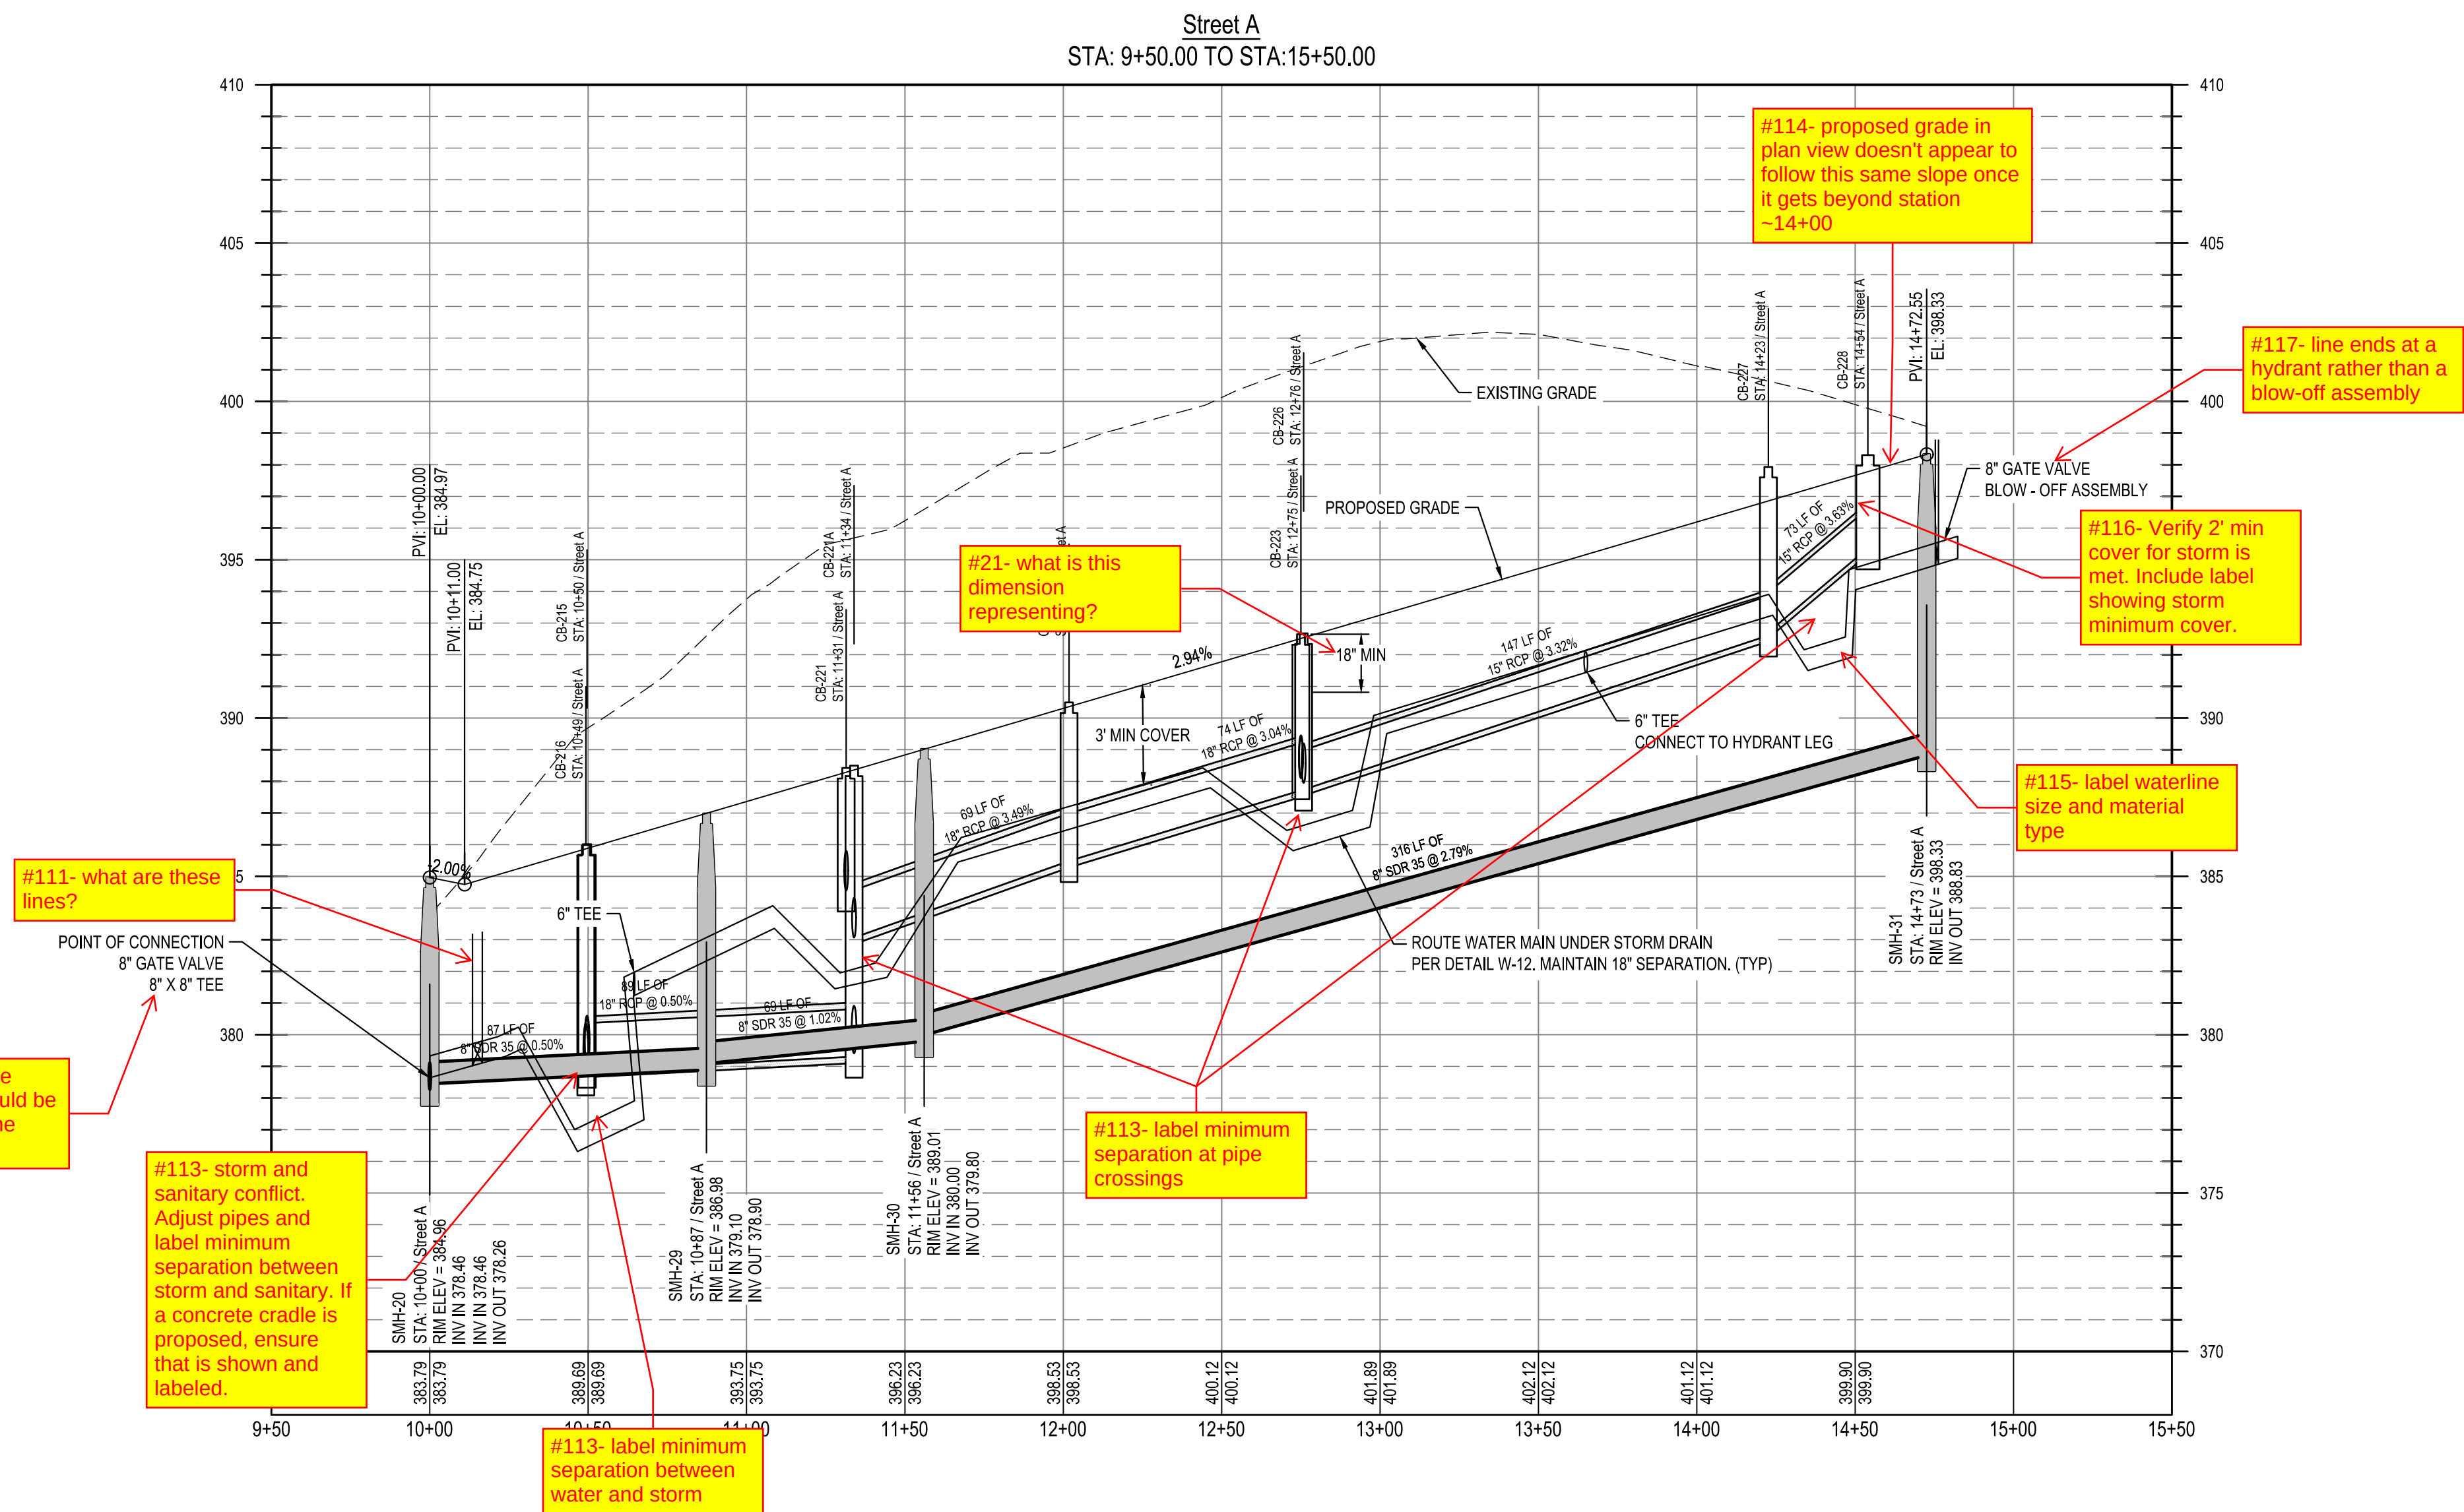

CID-23-06 - V1 -
Part 3 of 3 of plan
set

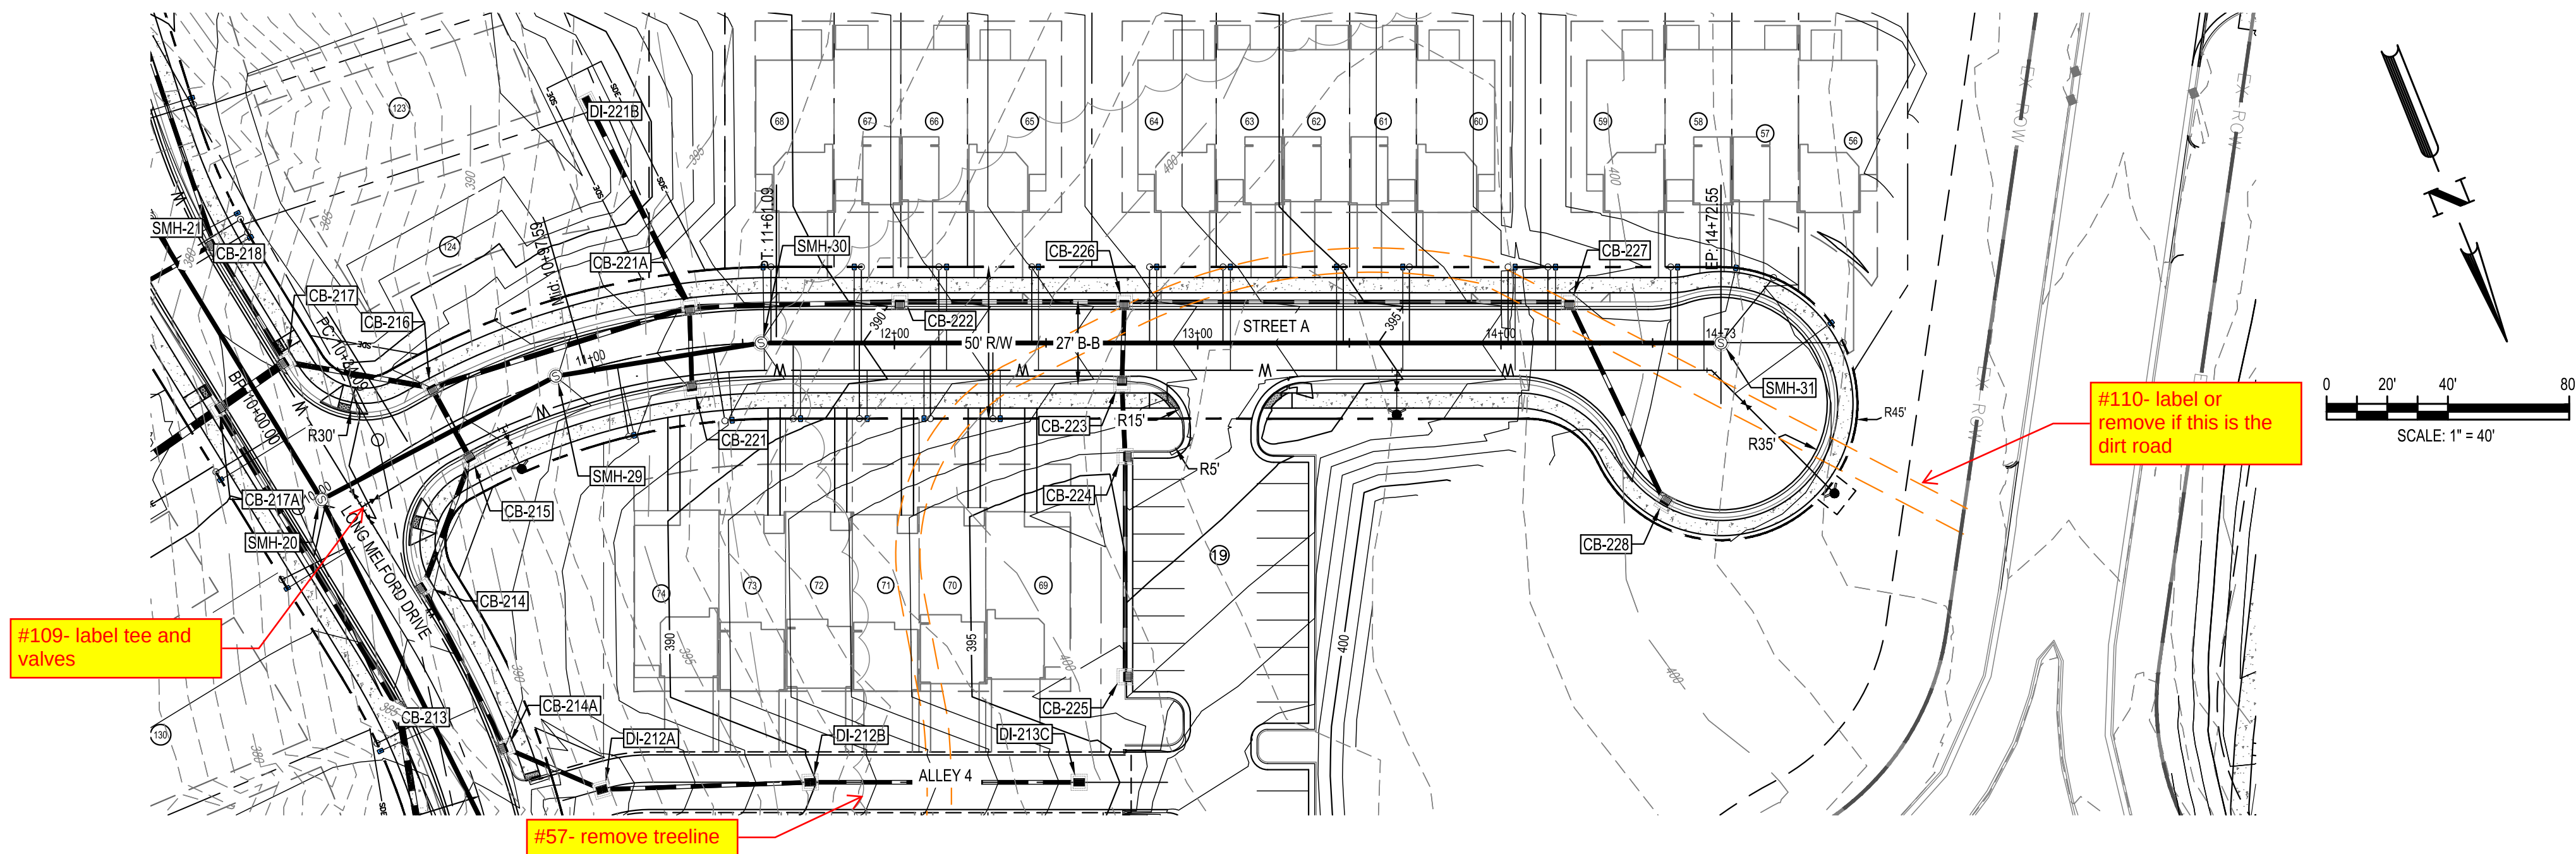

Know what's below.
Call before you dig.

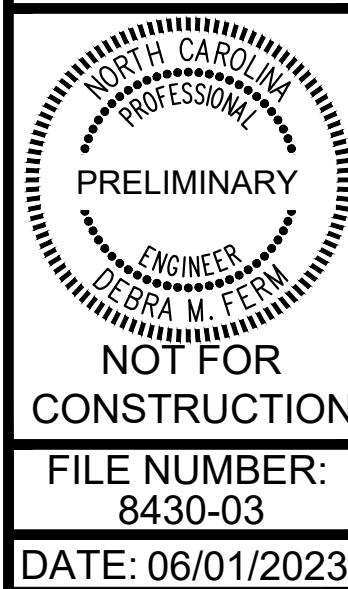

STREET A PLAN AND
PROFILE

PARKER RIDGE
82 SCHOOL STREET
ROLESVILLE / NORTH CAROLINA / 27571

LENNAR
CORPORAION
1100 PERIMETER PARK DRIVE, SUITE 112
MORRISVILLE / NORTH CAROLINA / 27560






DESIGNED BY: DF/CD
DRAWN BY: DF/JWM
REVIEWED BY: DF


REV 04/03/2023

06/01/2023 PER TOWN OF ROLESVILLE COMMENT
INITIAL SUBMITTAL

\\browngay.net\panzura\Regions\NCA\Projects\Lennar\8430-03 - Lennar - School Street - Rolesville\03 - DWG\PlanSheets\On-Site\C6-0 ROAD PLAN AND PROFILE.dwg Layout C6-1 STREET B PLAN AND PROFILE Plotted: 6/1/2023 3:28:22 PM

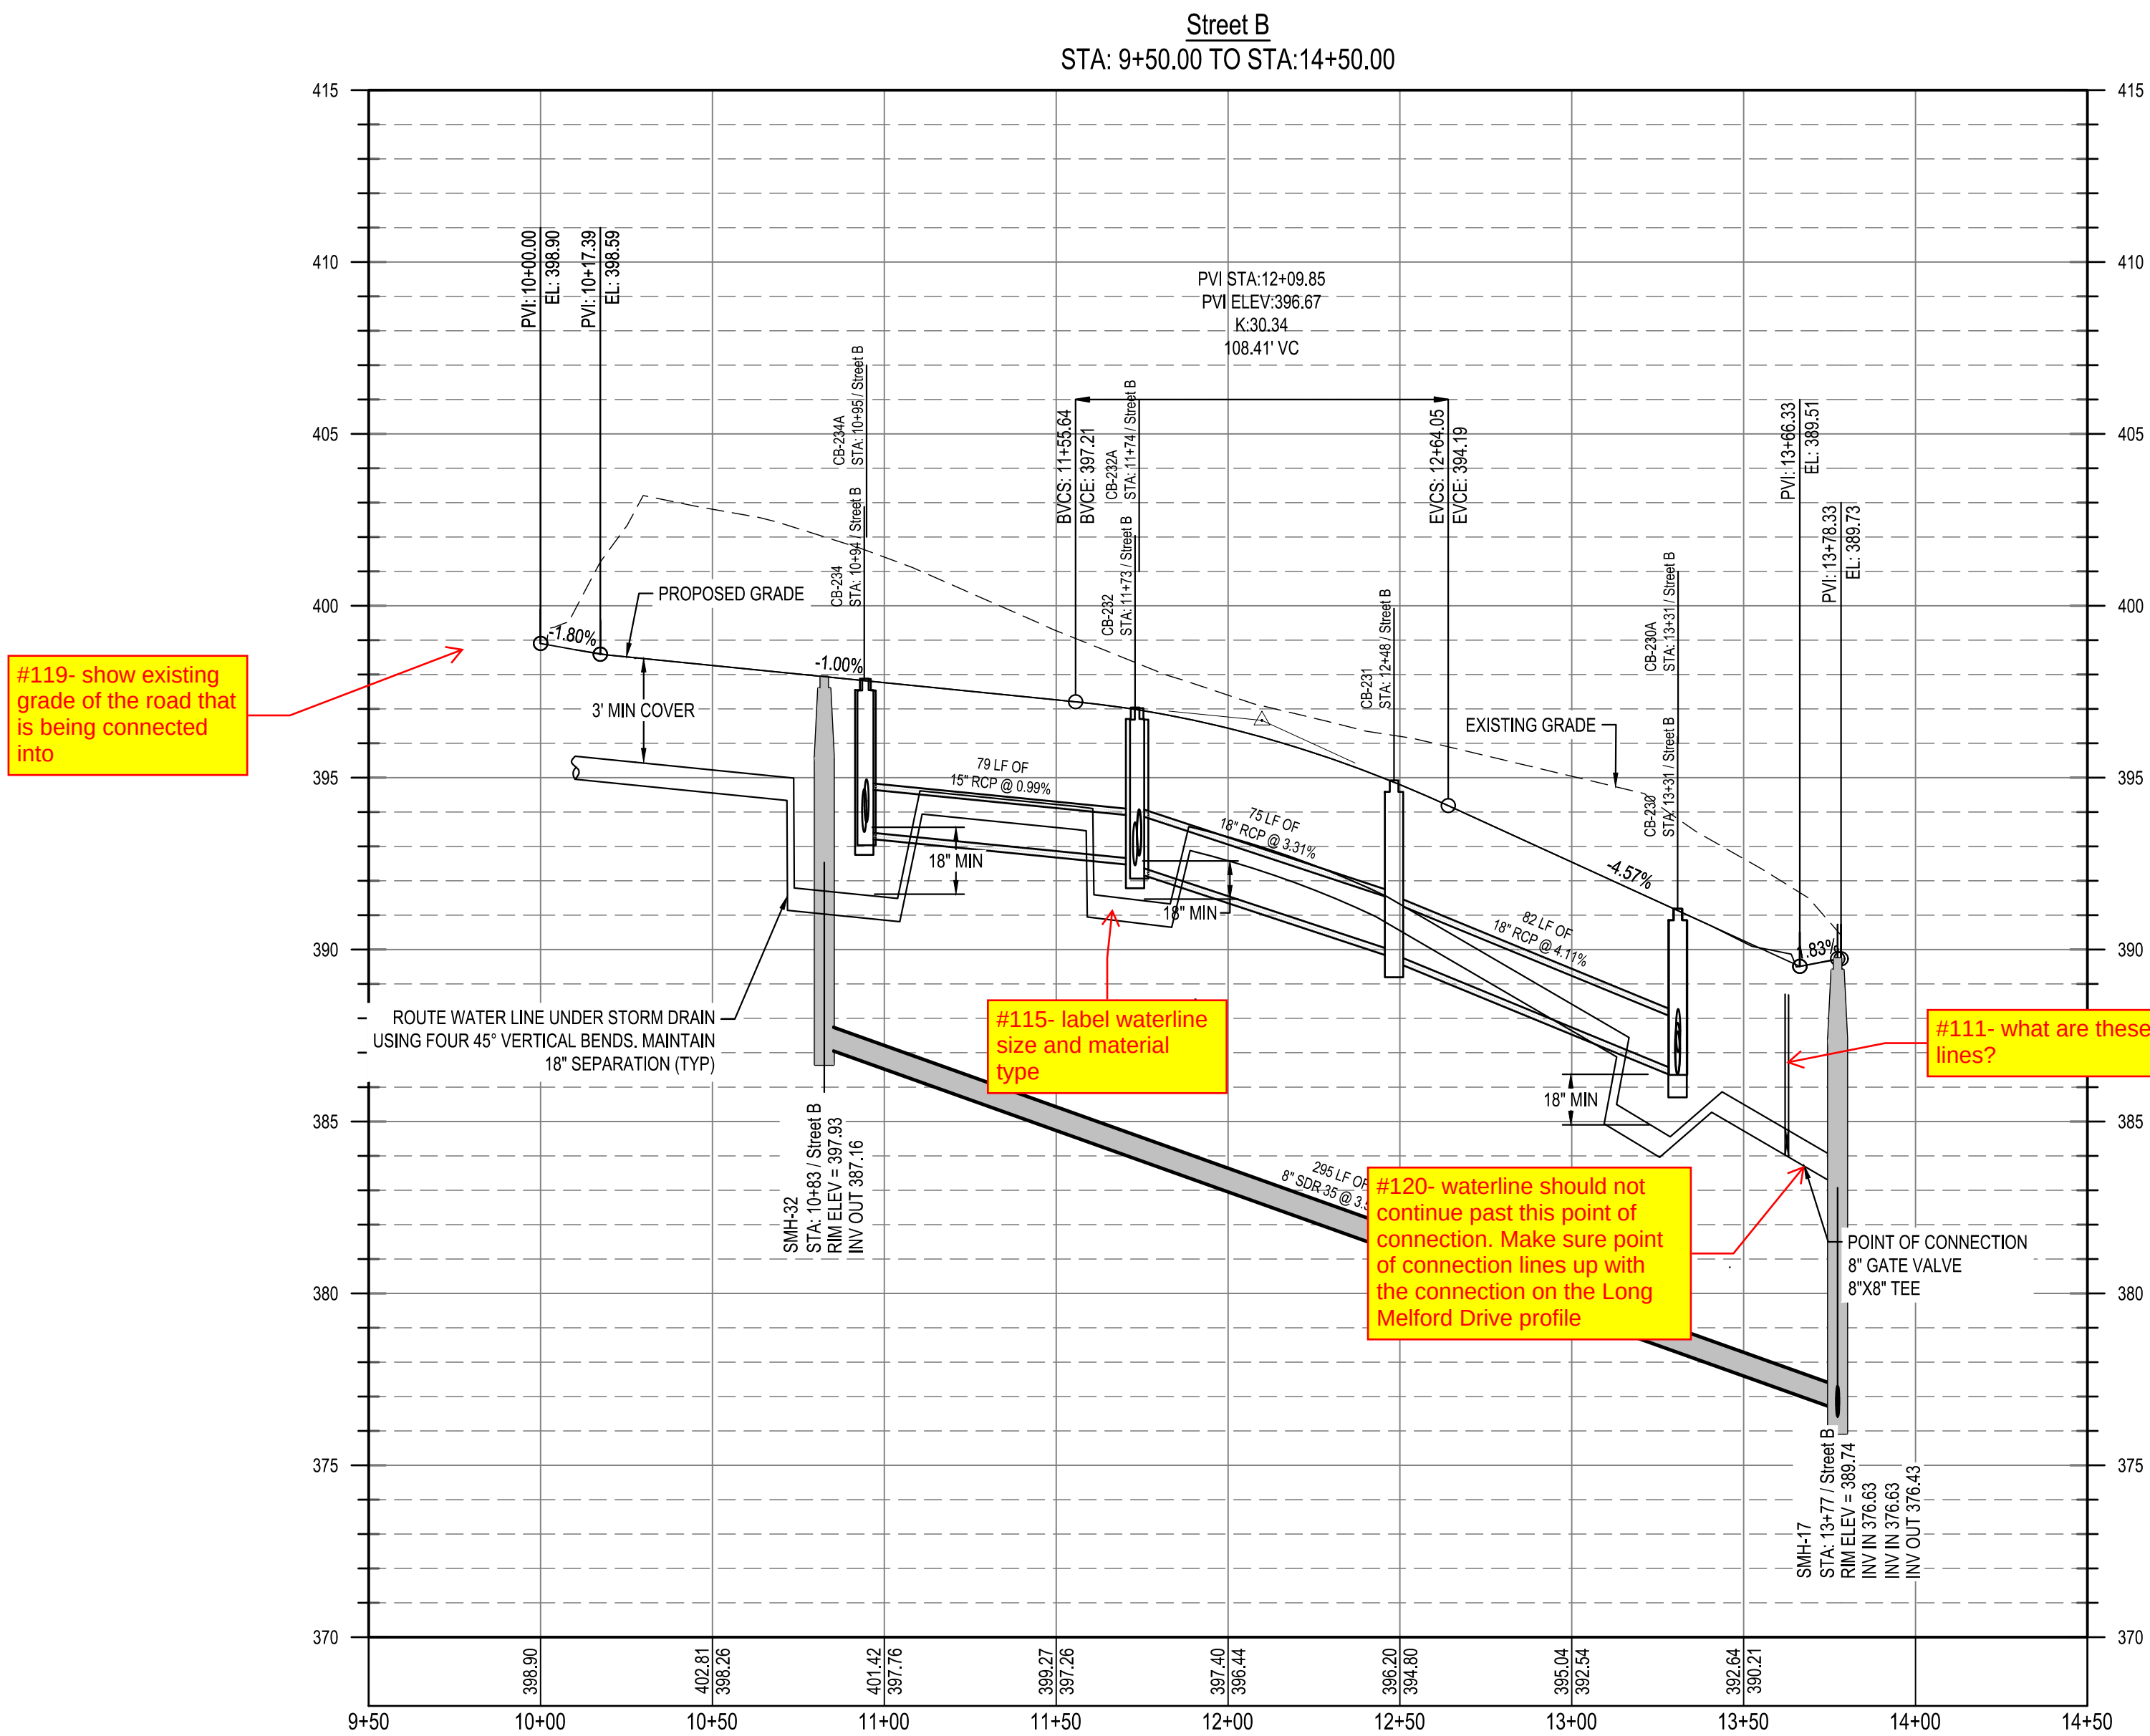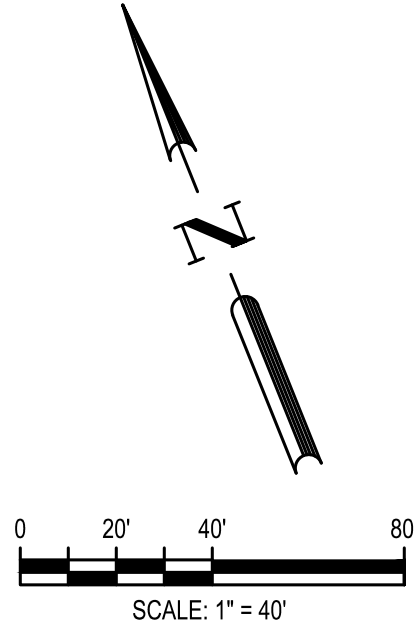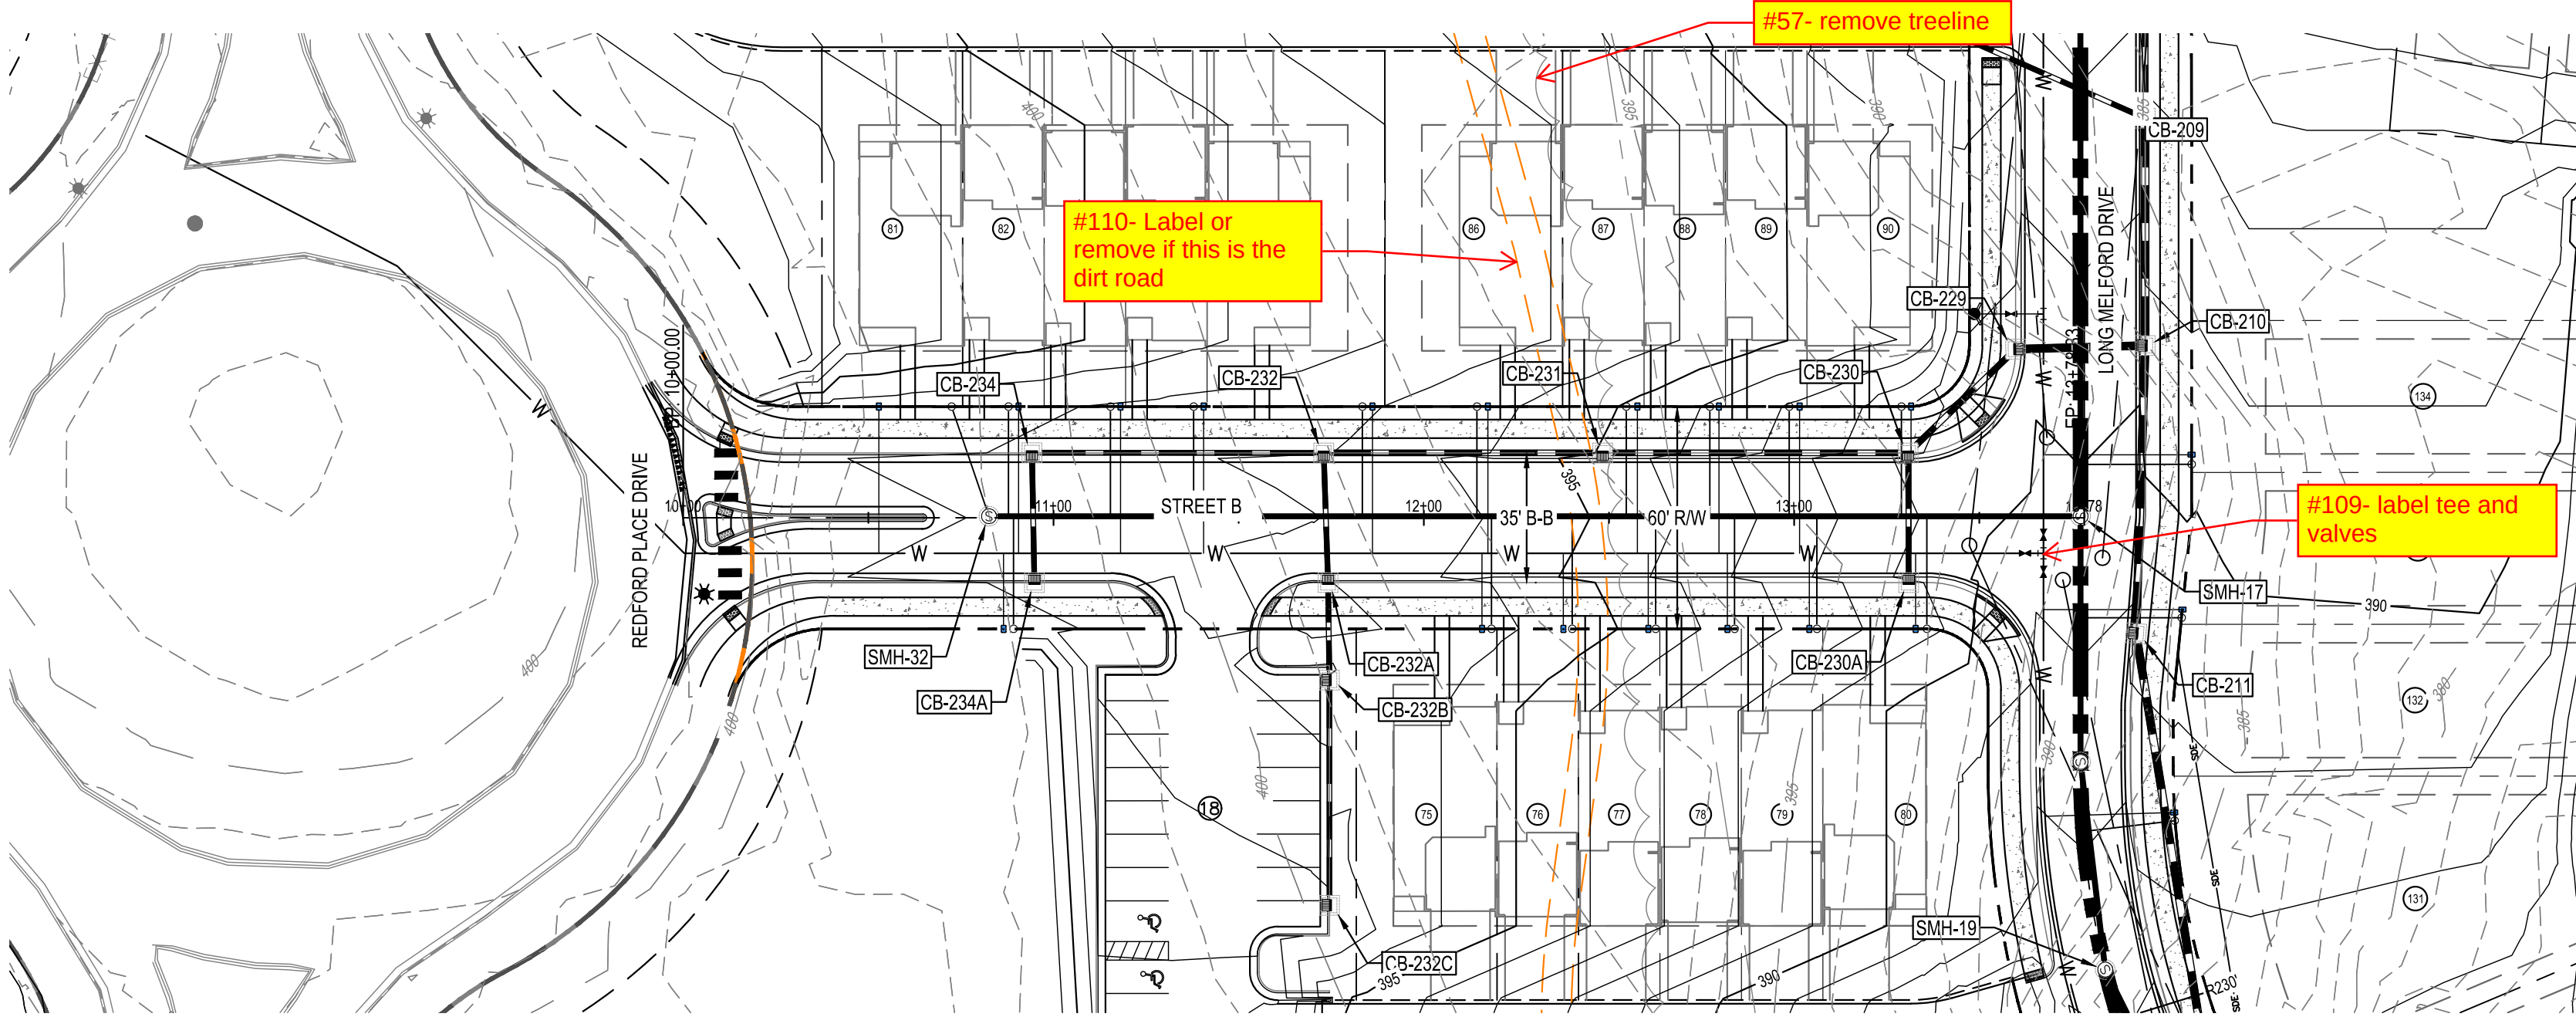

Know what's below.
Call before you dig.

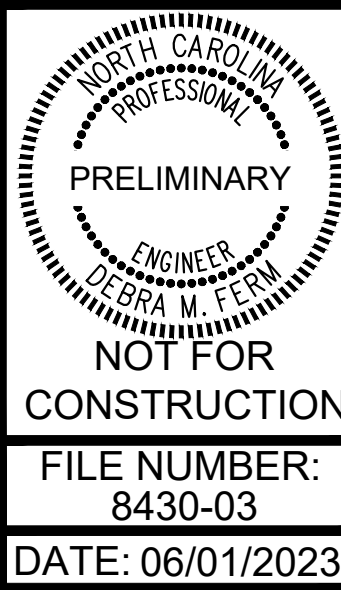

NOT FOR
CONSTRUCTION
FILE NUMBER:
8430-03
DATE: 06/01/2023

C6-1

STREET B PLAN AND
PROFILE




PARKER RIDGE
82 SCHOOL STREET
ROLESVILLE / NORTH CAROLINA / 27571

LENNAR
CORPORAION
1100 PERIMETER PARK DRIVE, SUITE 112
MORRISVILLE / NORTH CAROLINA / 27560




DESIGNED BY: DF/CD
DRAWN BY: DF/JWM
REVIEWED BY: DF

REV	DATE	DESCRIPTION
06/01/2023	06/01/2023	PER TOWN OF ROLESVILLE COMMENT
04/03/2023	04/03/2023	INITIAL SUBMITTAL

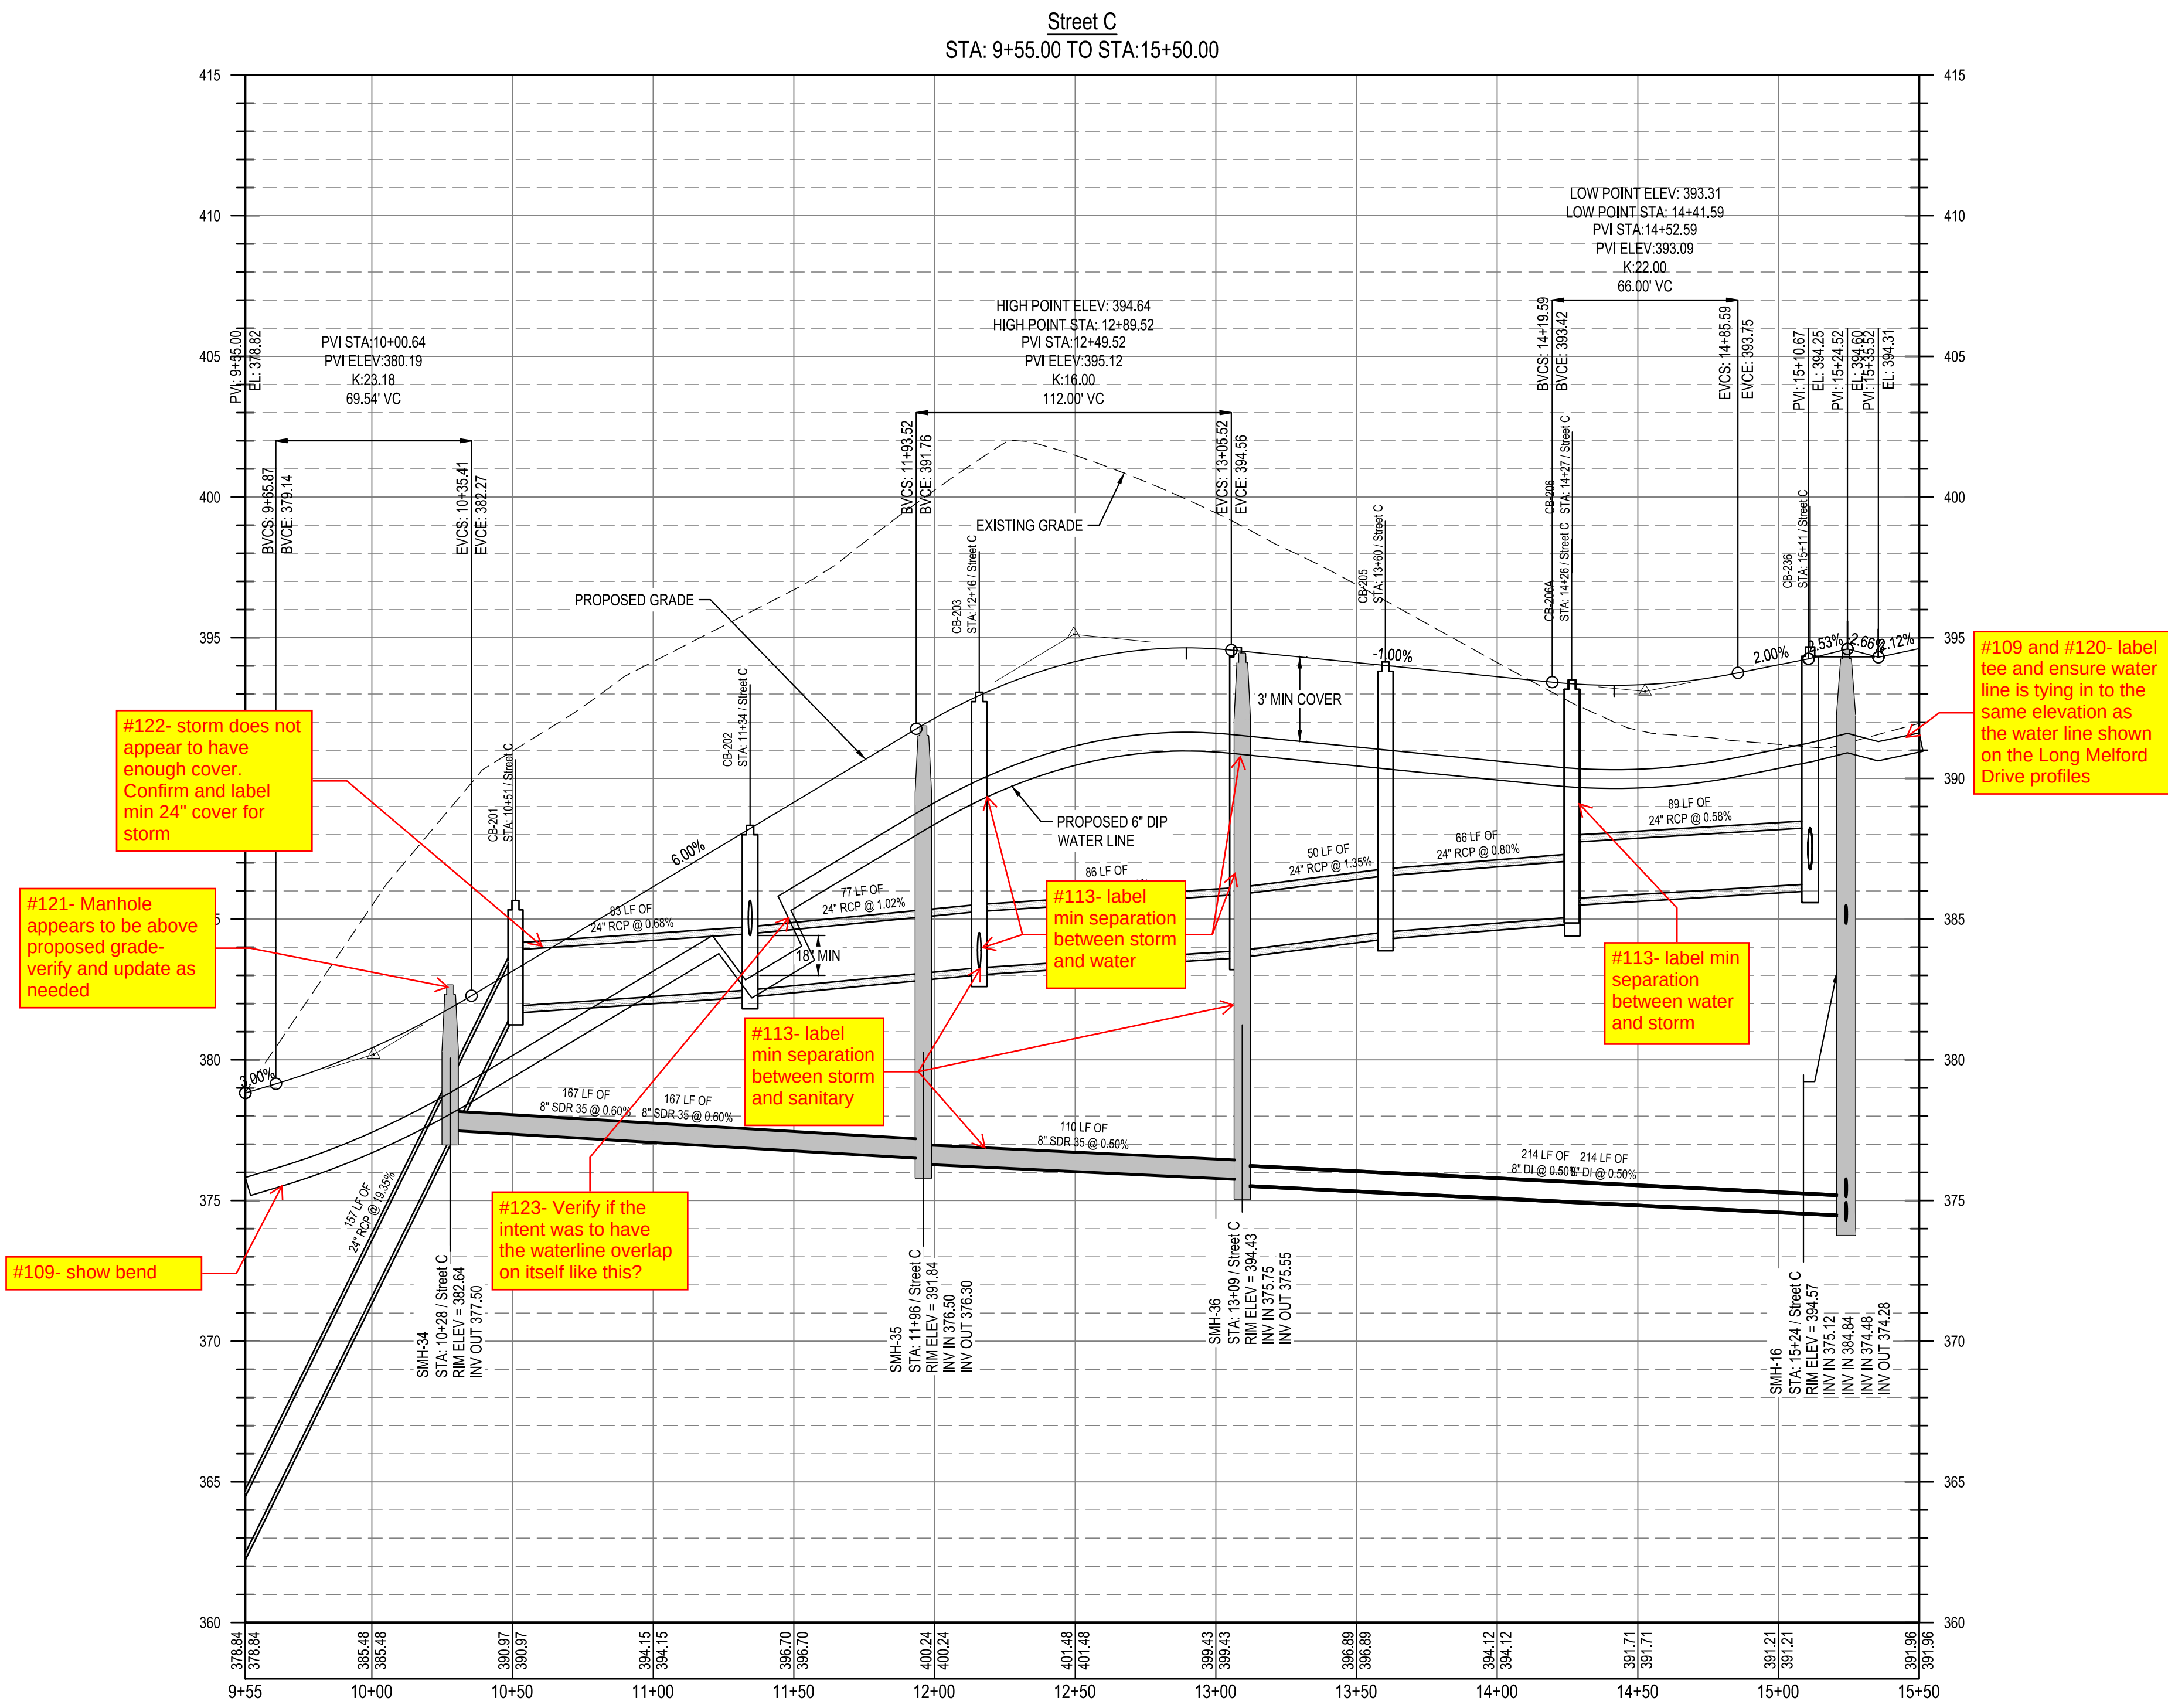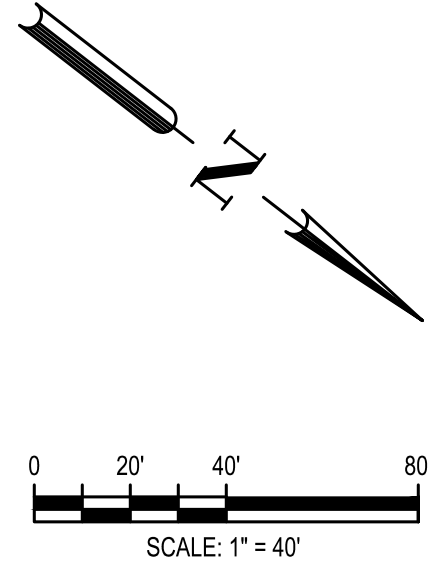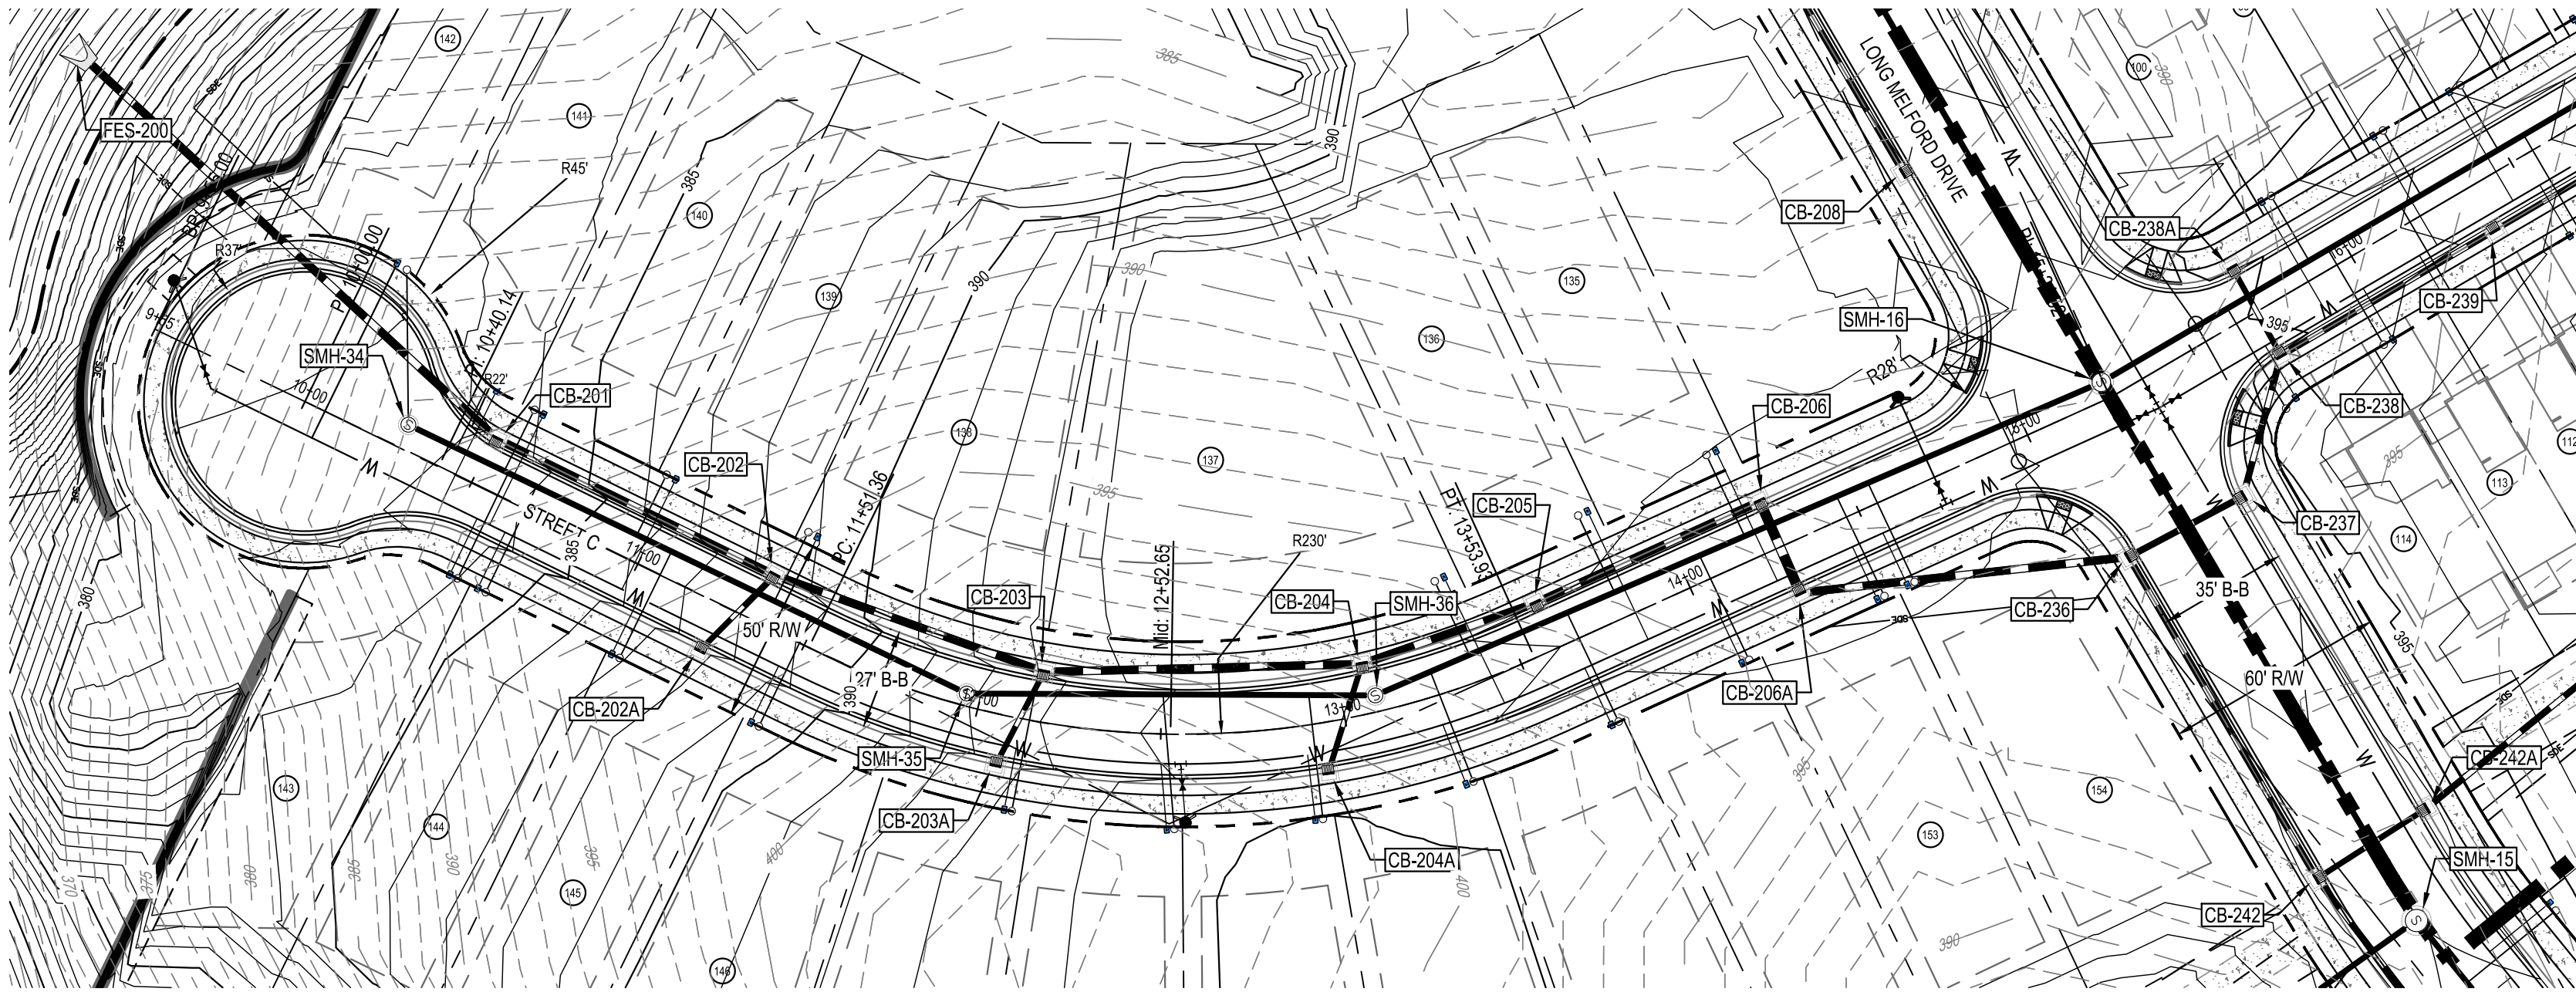

Know what's below.
Call before you dig.

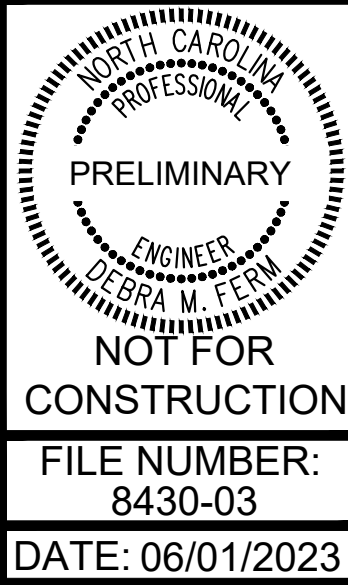




STREET C PLAN AND
PROFILE (1 OF 2)

PARKER RIDGE
82 SCHOOL STREET
ROLESVILLE / NORTH CAROLINA / 27571

LENNAR
CORPORAION
1100 PERIMETER PARK DRIVE, SUITE 112
MORRISVILLE / NORTH CAROLINA / 27560

BCE
5440 WADE PARK BLVD, SUITE 102
RALEIGH NC 27607
WWW.BCEINC.COM
NC LICENSE #C-4397

				</	

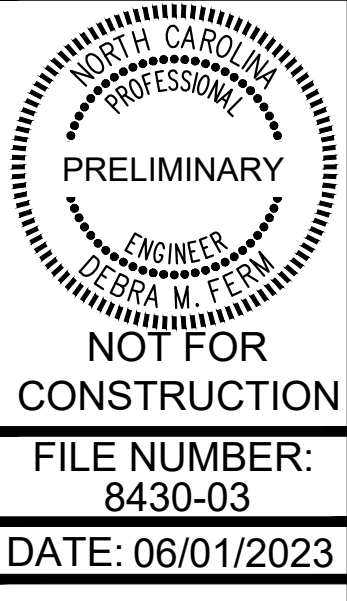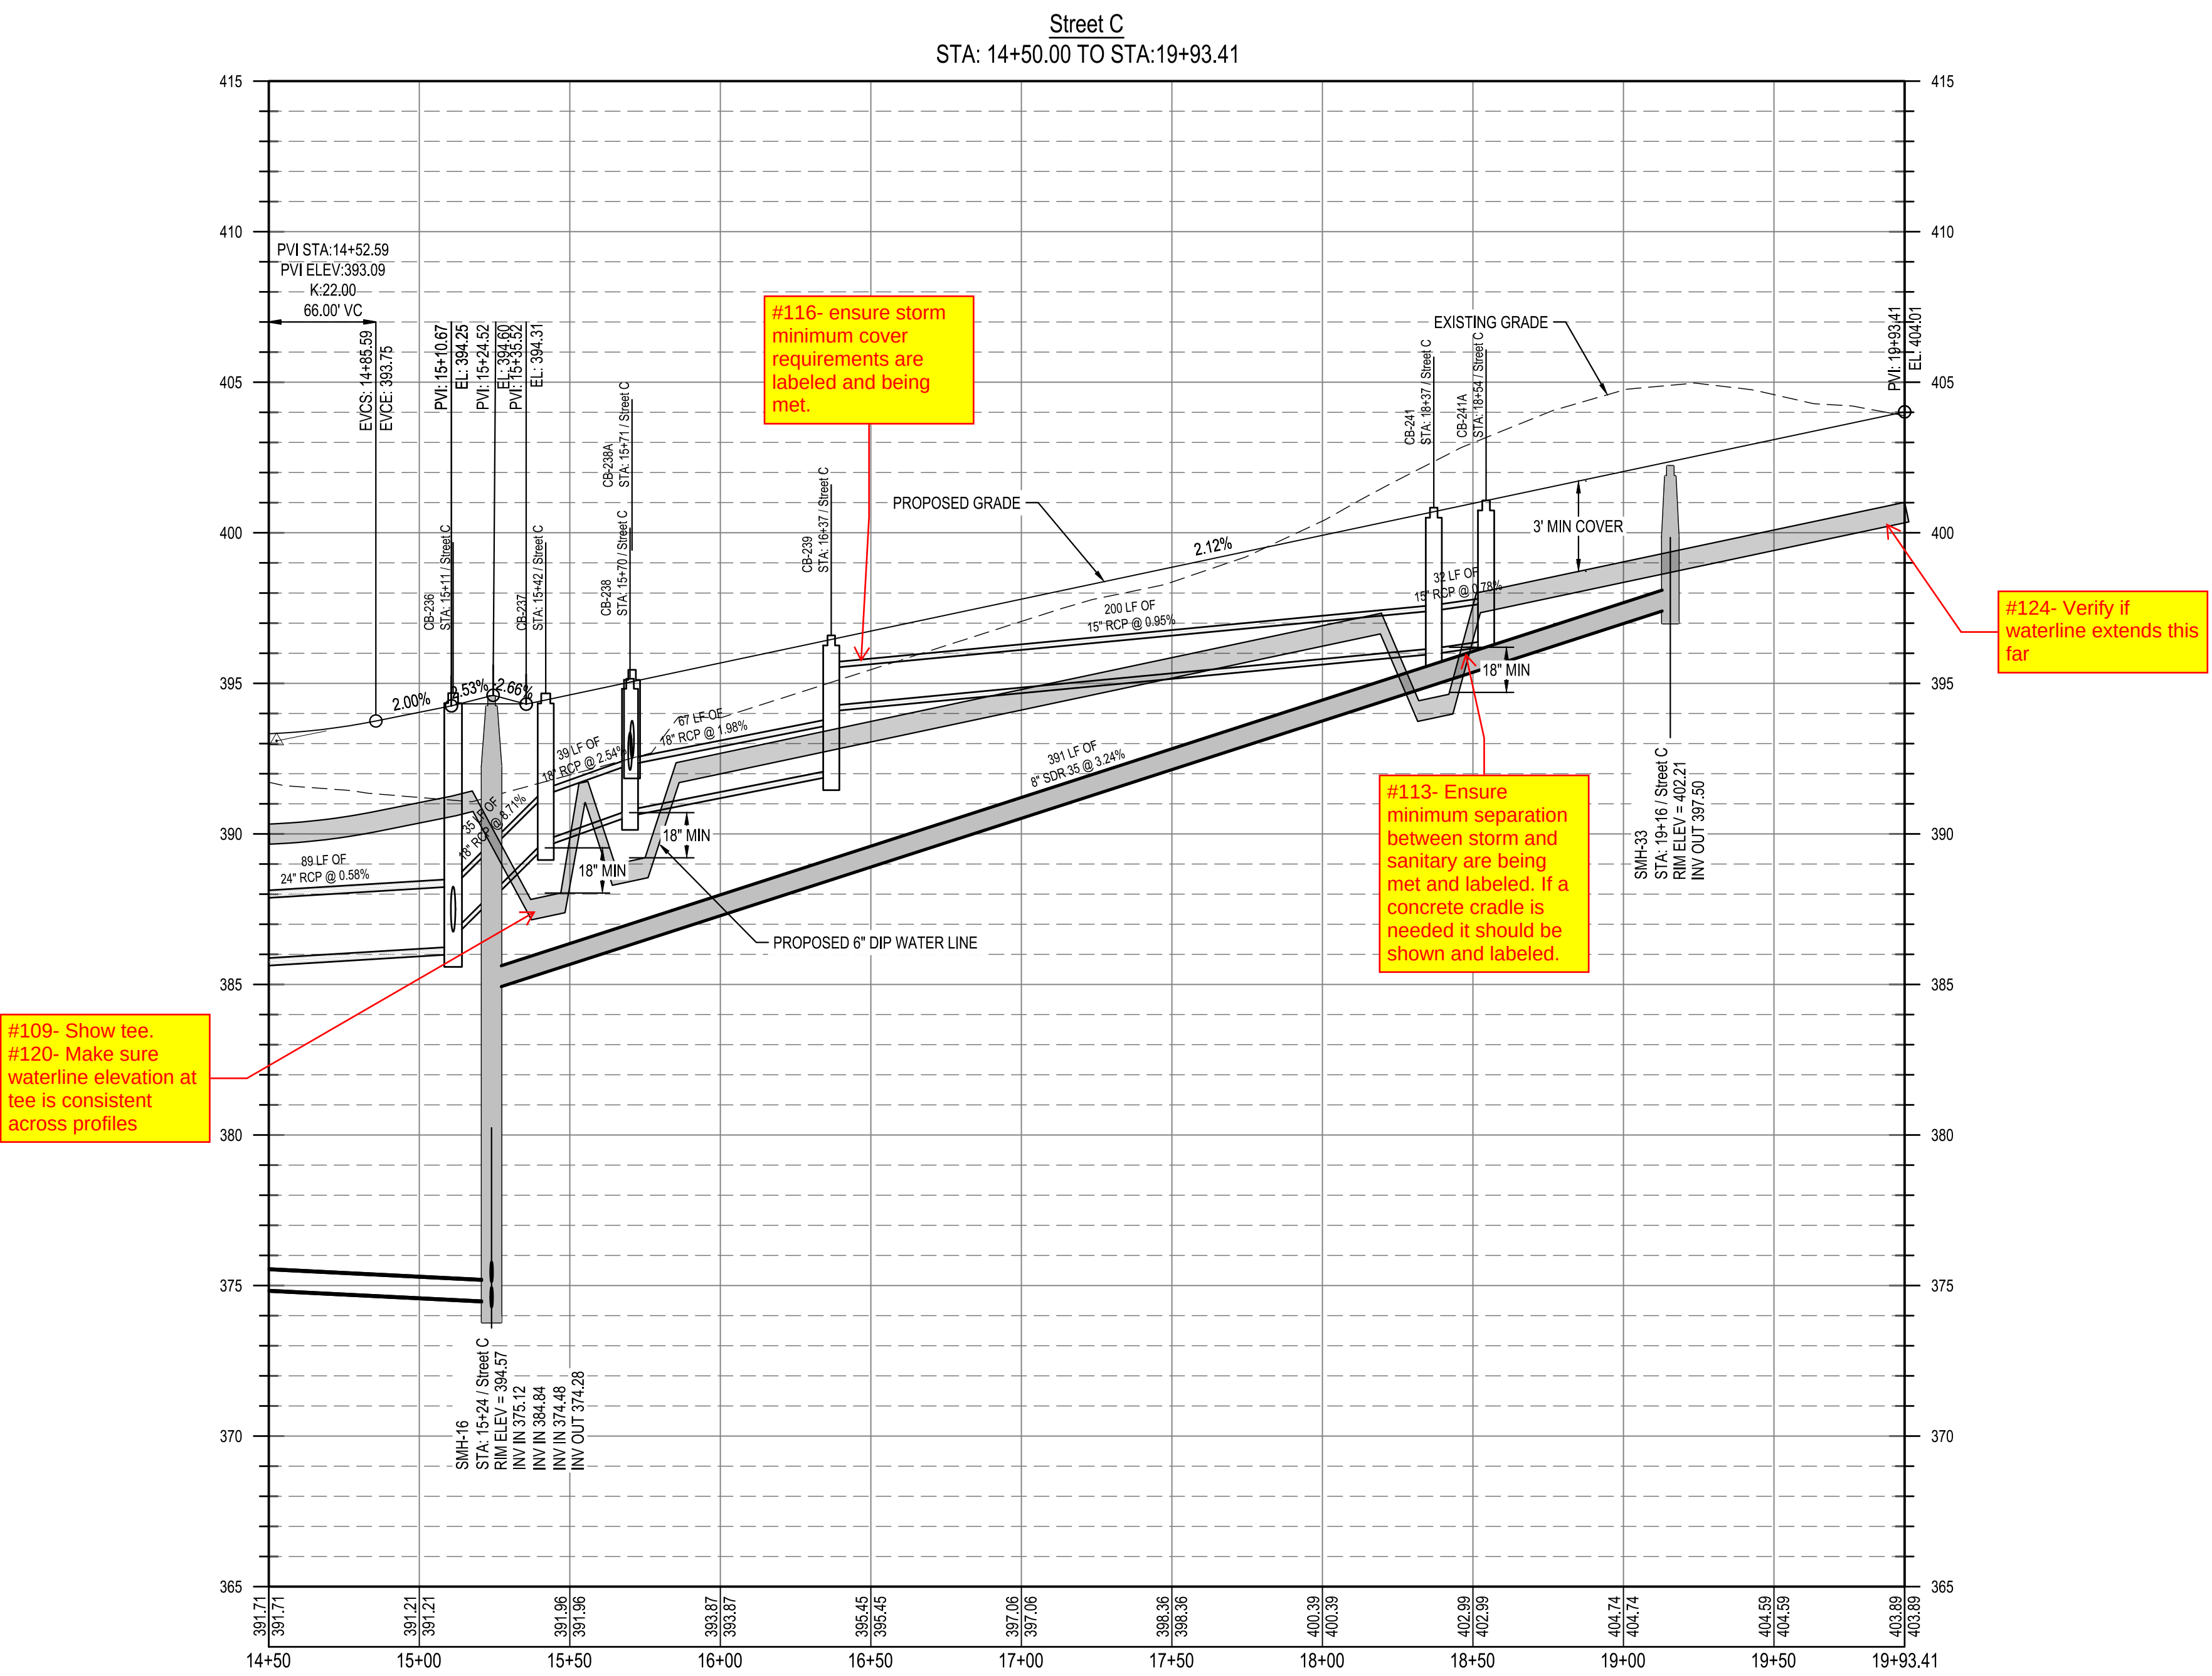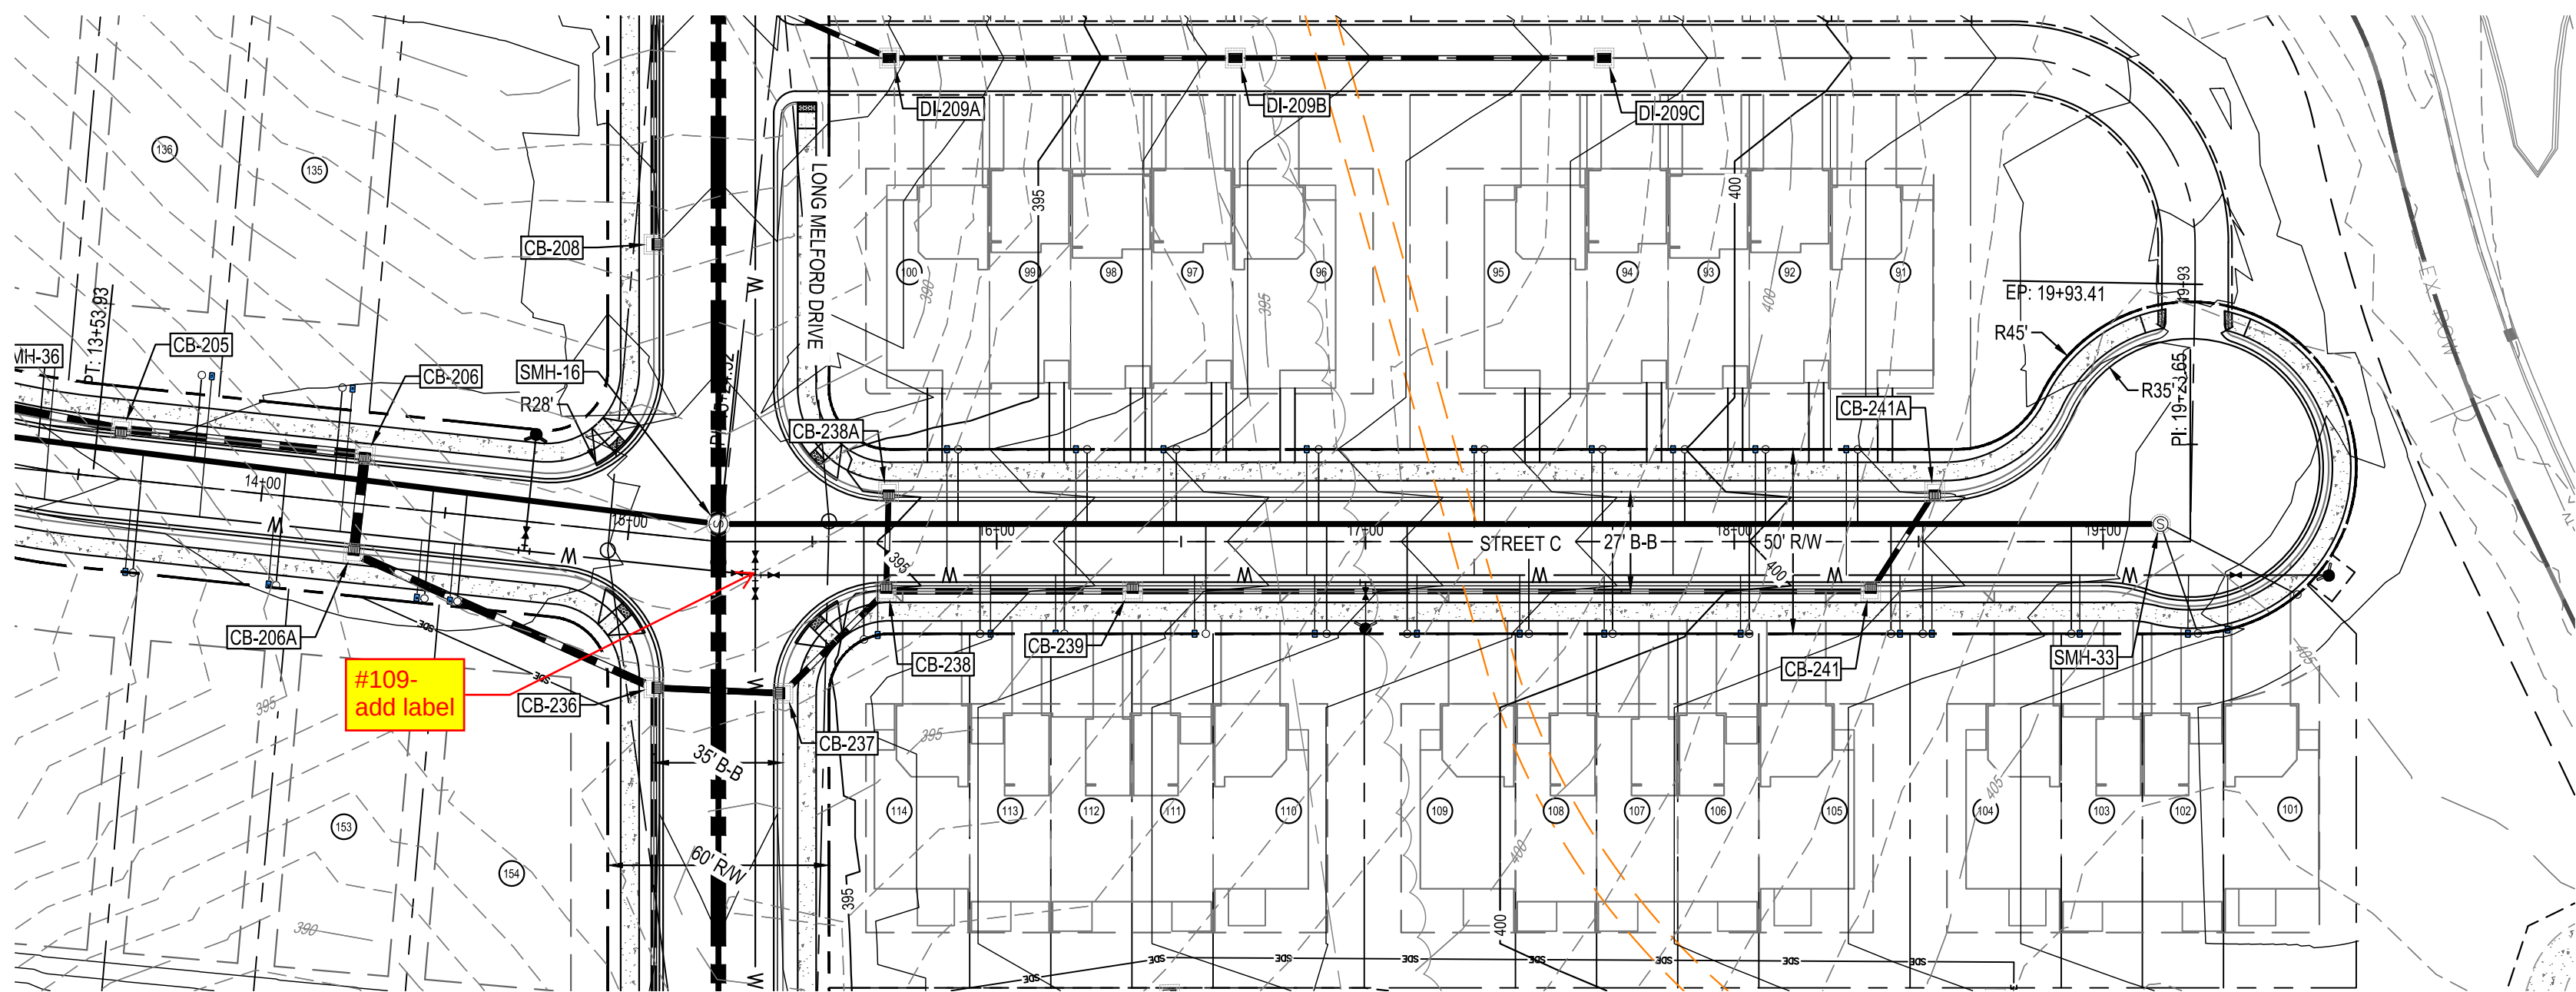



STREET C PLAN AND
PROFILE (2 OF 2)

PARKER RIDGE
82 SCHOOL STREET
ROLESVILLE / NORTH CAROLINA / 27571


LENNAR
CORPORAION
1100 PERIMETER PARK DRIVE, SUITE 112
MORRISVILLE / NORTH CAROLINA / 27560

BCE
5440 WADE PARK BLVD, SUITE 102
RALEIGH NC 27607
WWW.BCEINC.COM
NC LICENSE #C-4397

DESIGNED BY:	DF/CD	06/01/2023	PER TOWN OF ROLESVILLE COMMENT
DRAWN BY:	DF/JWM		
REVIEWED BY:	DF		

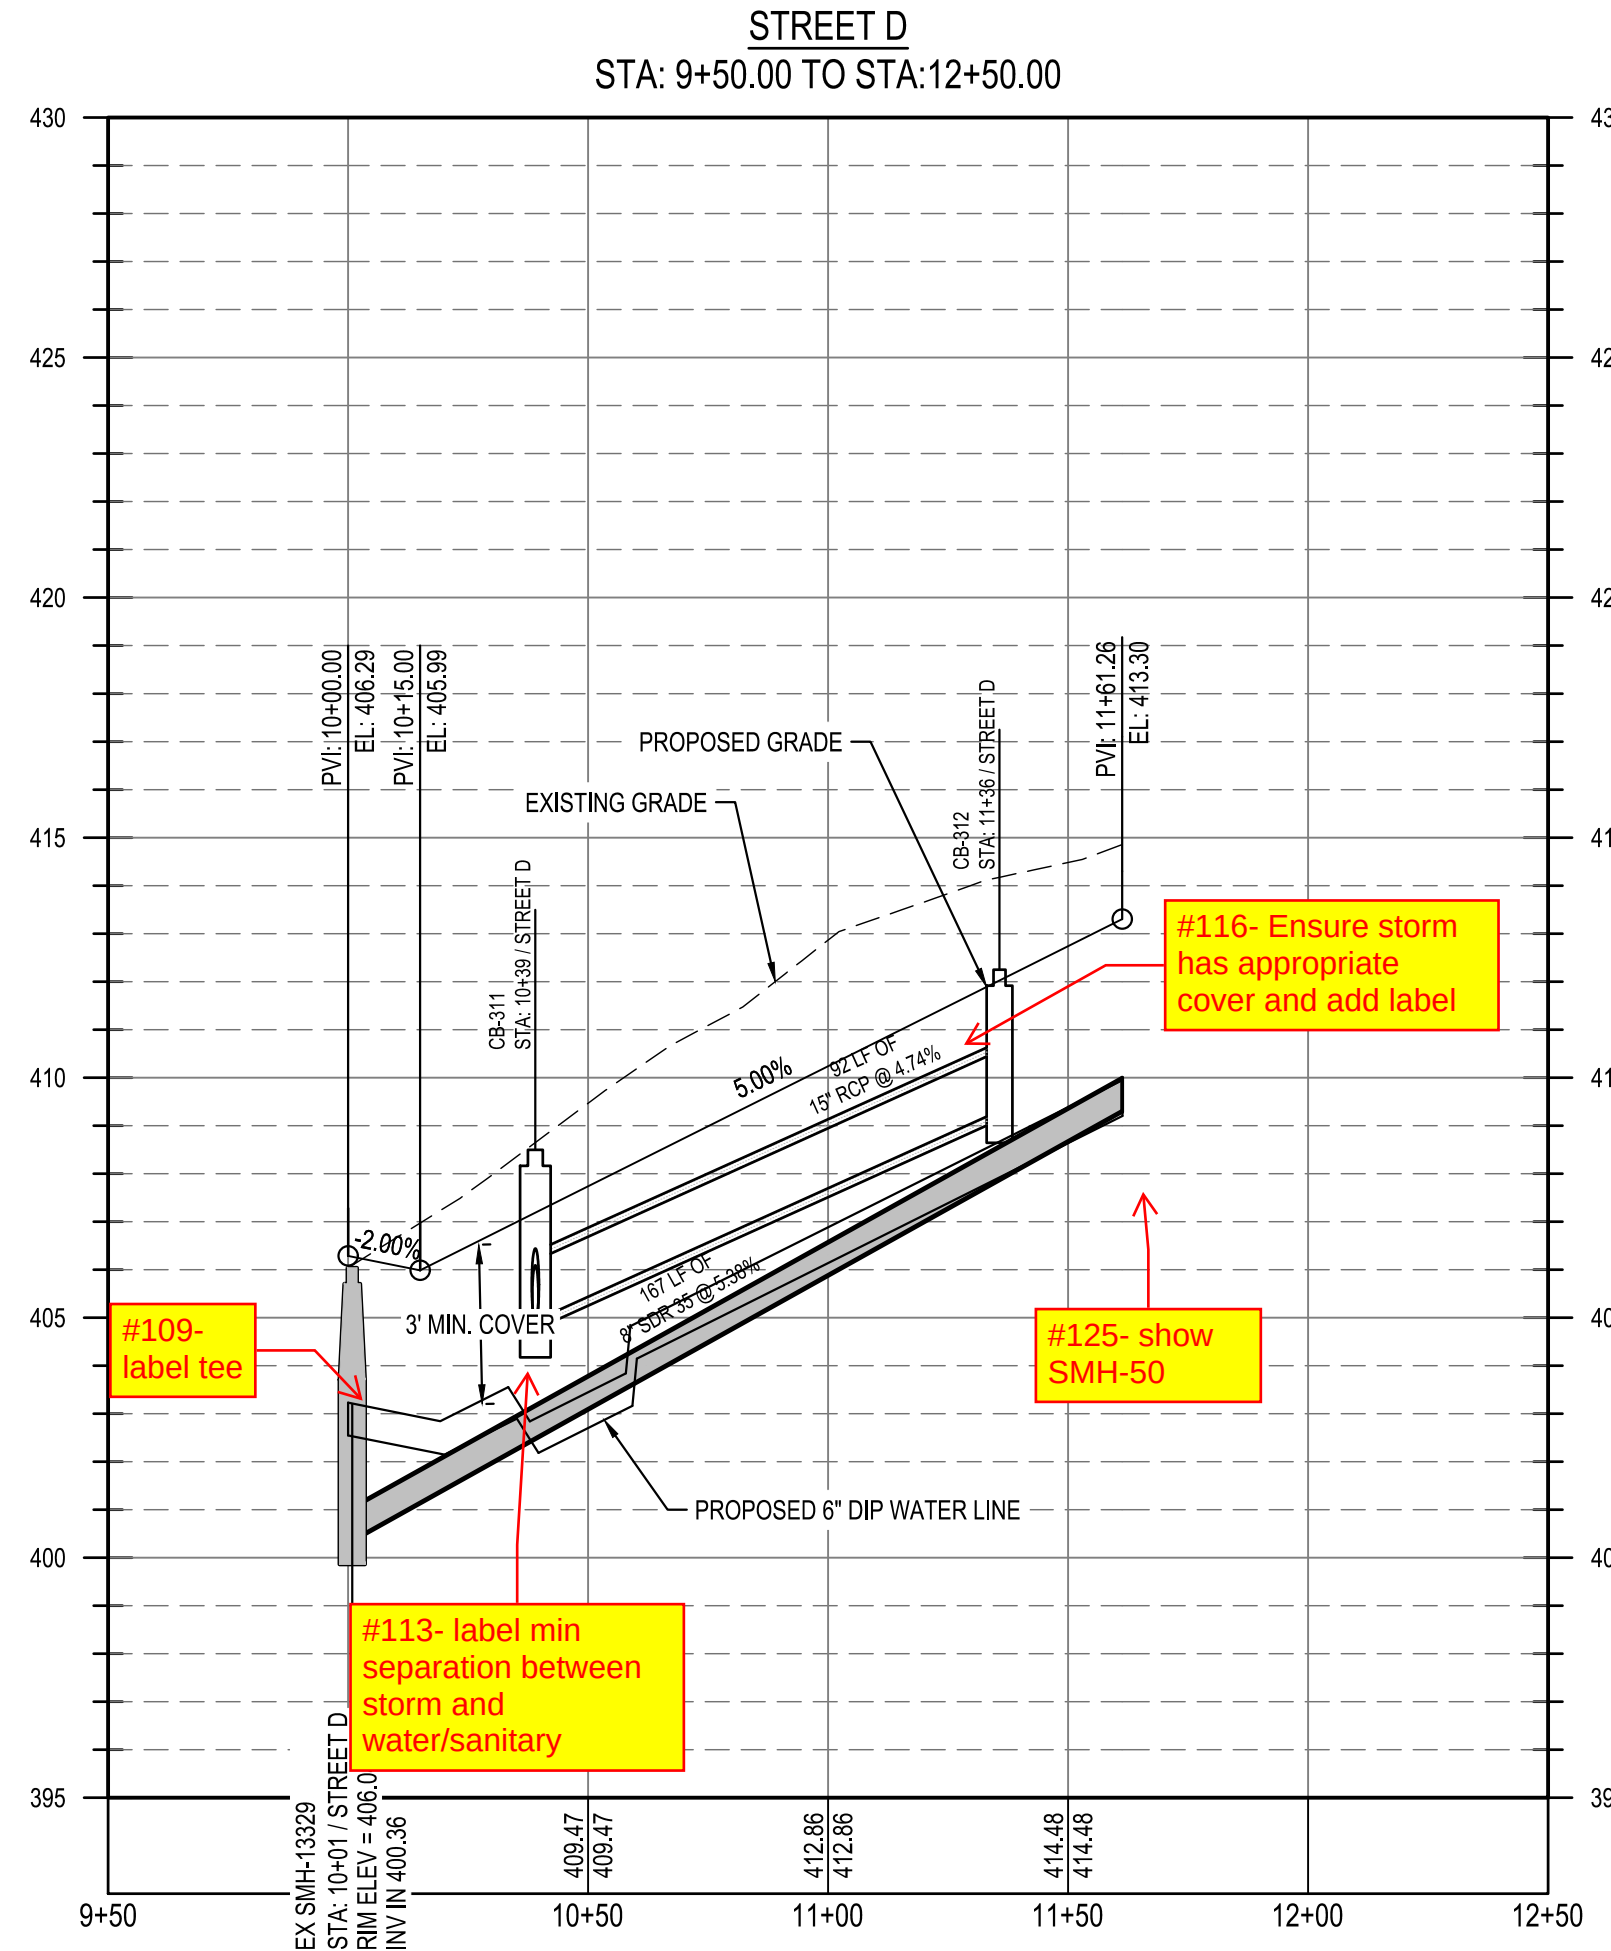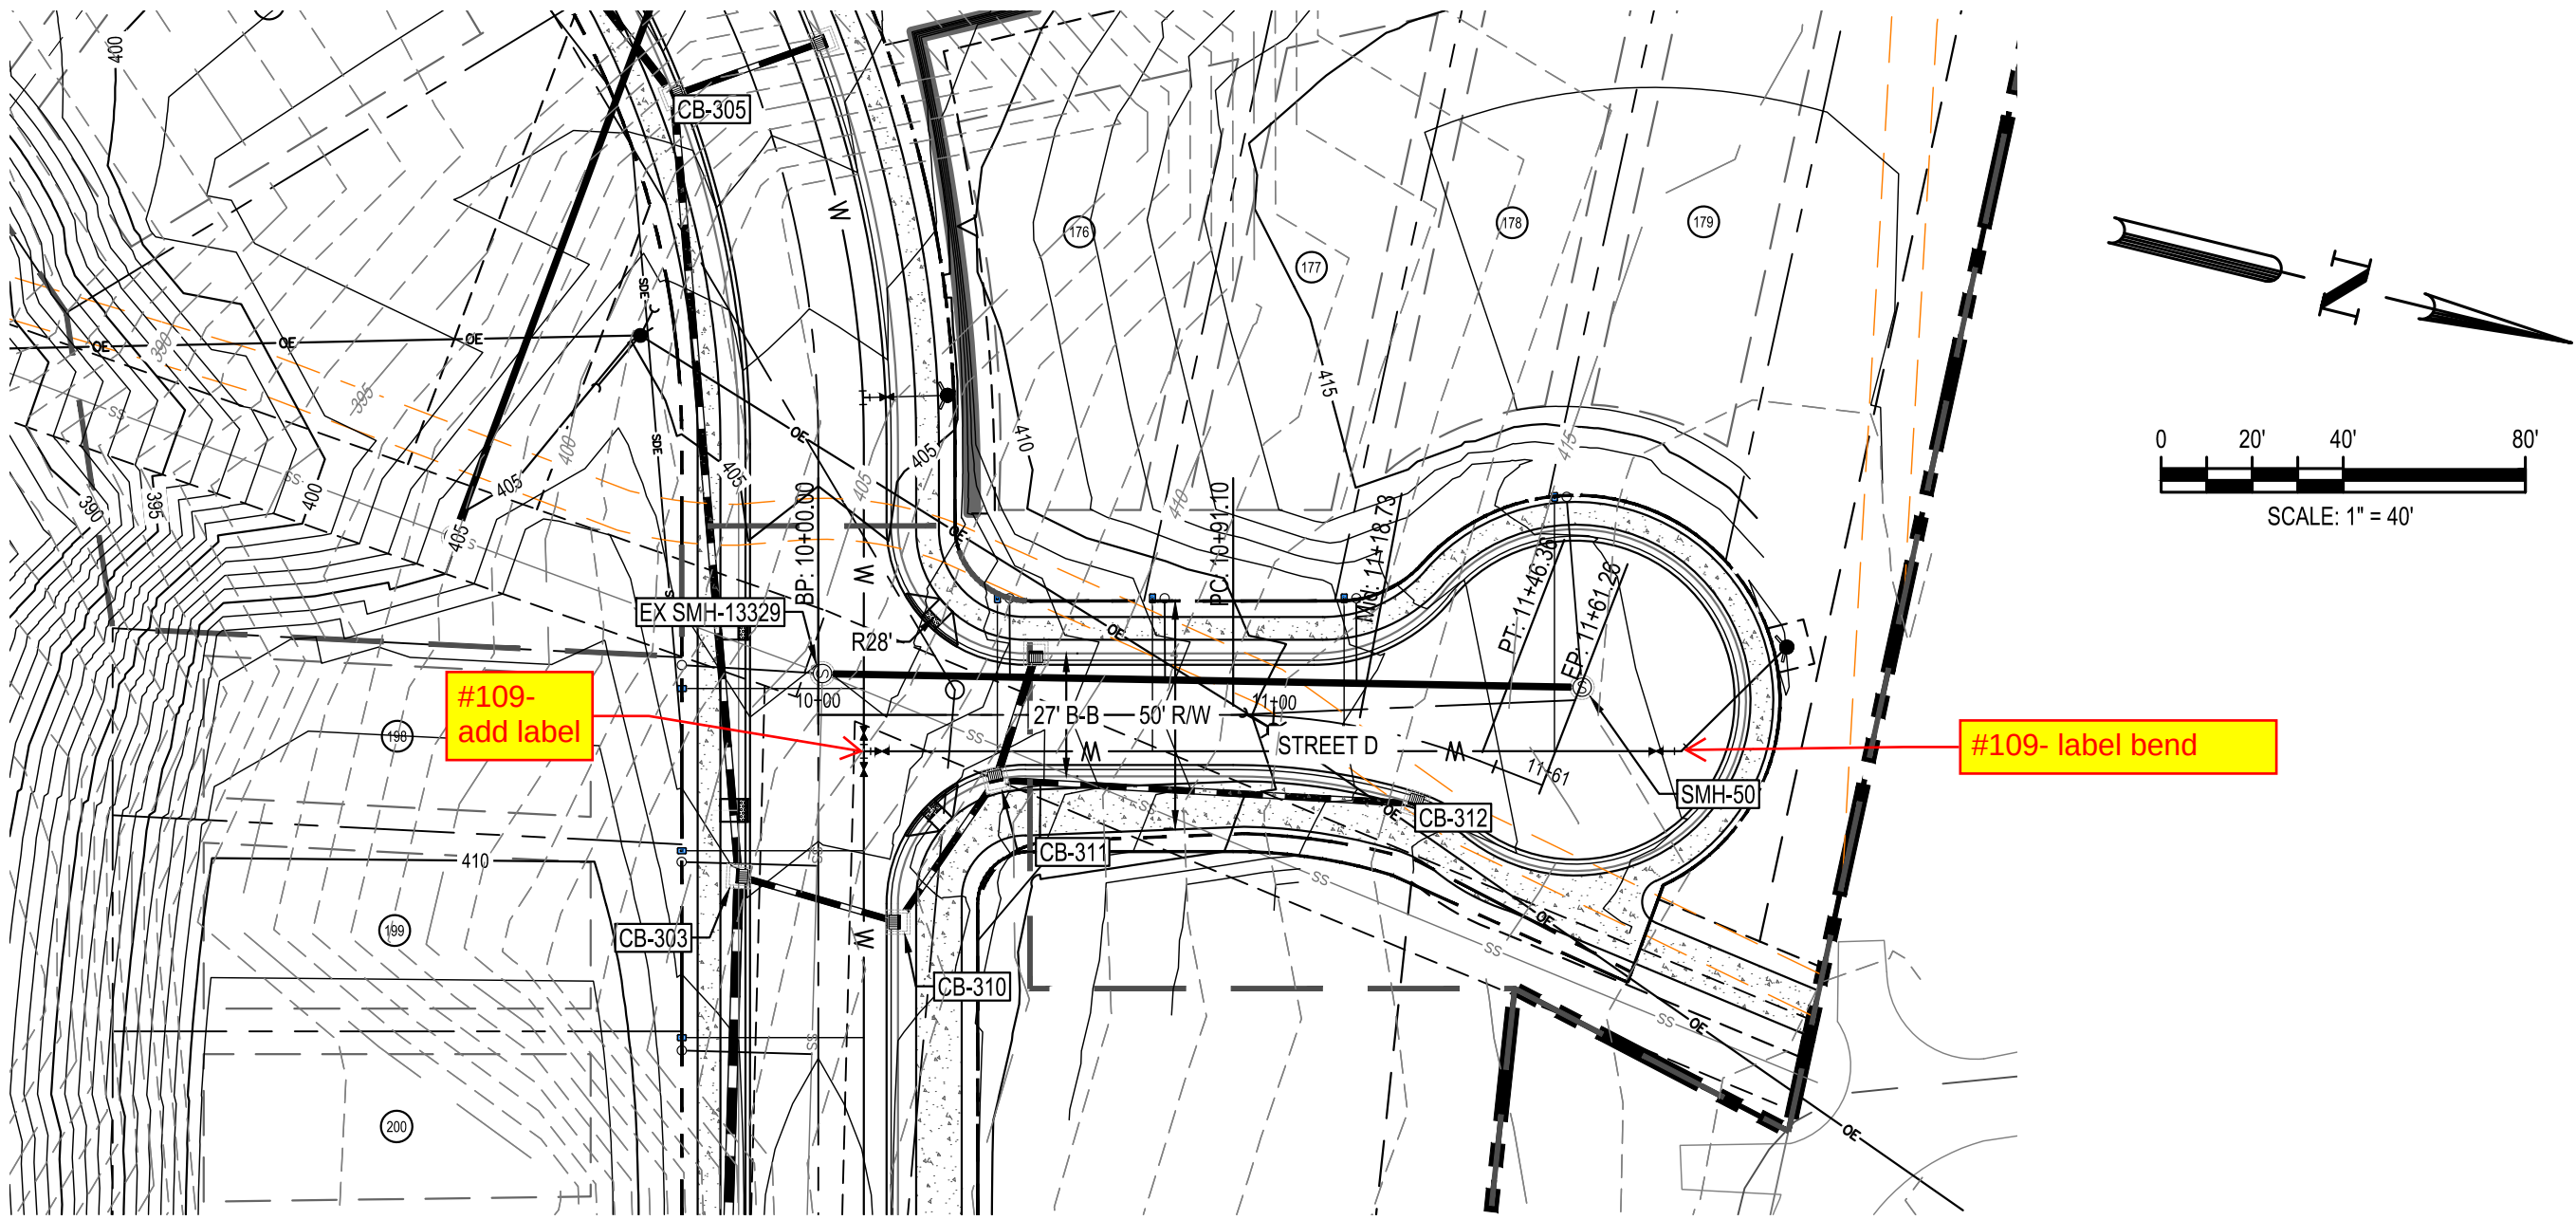

Know what's below.
Call before you dig.

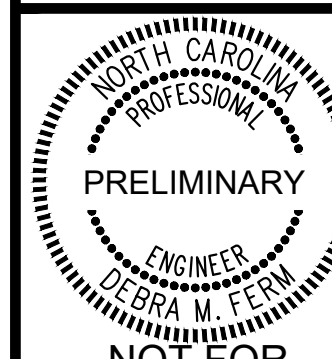

NOT FOR
CONSTRUCTION

FILE NUMBER:
8430-03

DATE: 06/01/202


C6-4

△		
△		
△		
△		
△	06/01/2023	PER TOWN OF ROLESVILLE COMMENT

DESIGNED BY: DF/CD

DRAWN BY: DF/JWM

REVIEWED BY: DF

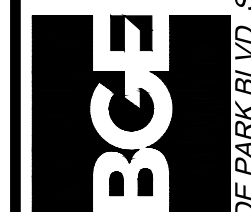

5440 WADE PARK BLVD, SUITE 102
RALEIGH NC 27607
WWW.BGEINC.COM
NC LICENSE #C-4397

LENNAR
CORPORATION



1100 PERIMETER PARK DRIVE, SUITE 112
MORRISVILLE / NORTH CAROLINA / 27560

PARKER RIDGE


82 SCHOOL STREET
ROLESVILLE / NORTH CAROLINA / 27571

STREET D PLAN AND PROFILE

\\browngay.net\panzura\Regions\NCA\Projects\Lennar\8430-03 - Lennar - School Street - DWG\PlanSheets\On-Site\C6-0 ROAD PLAN AND PROFILE.dwg Layout: C6-5 STREET E PLAN AND PROFILE Plotted: 6/1/2023 3:28:02 PM

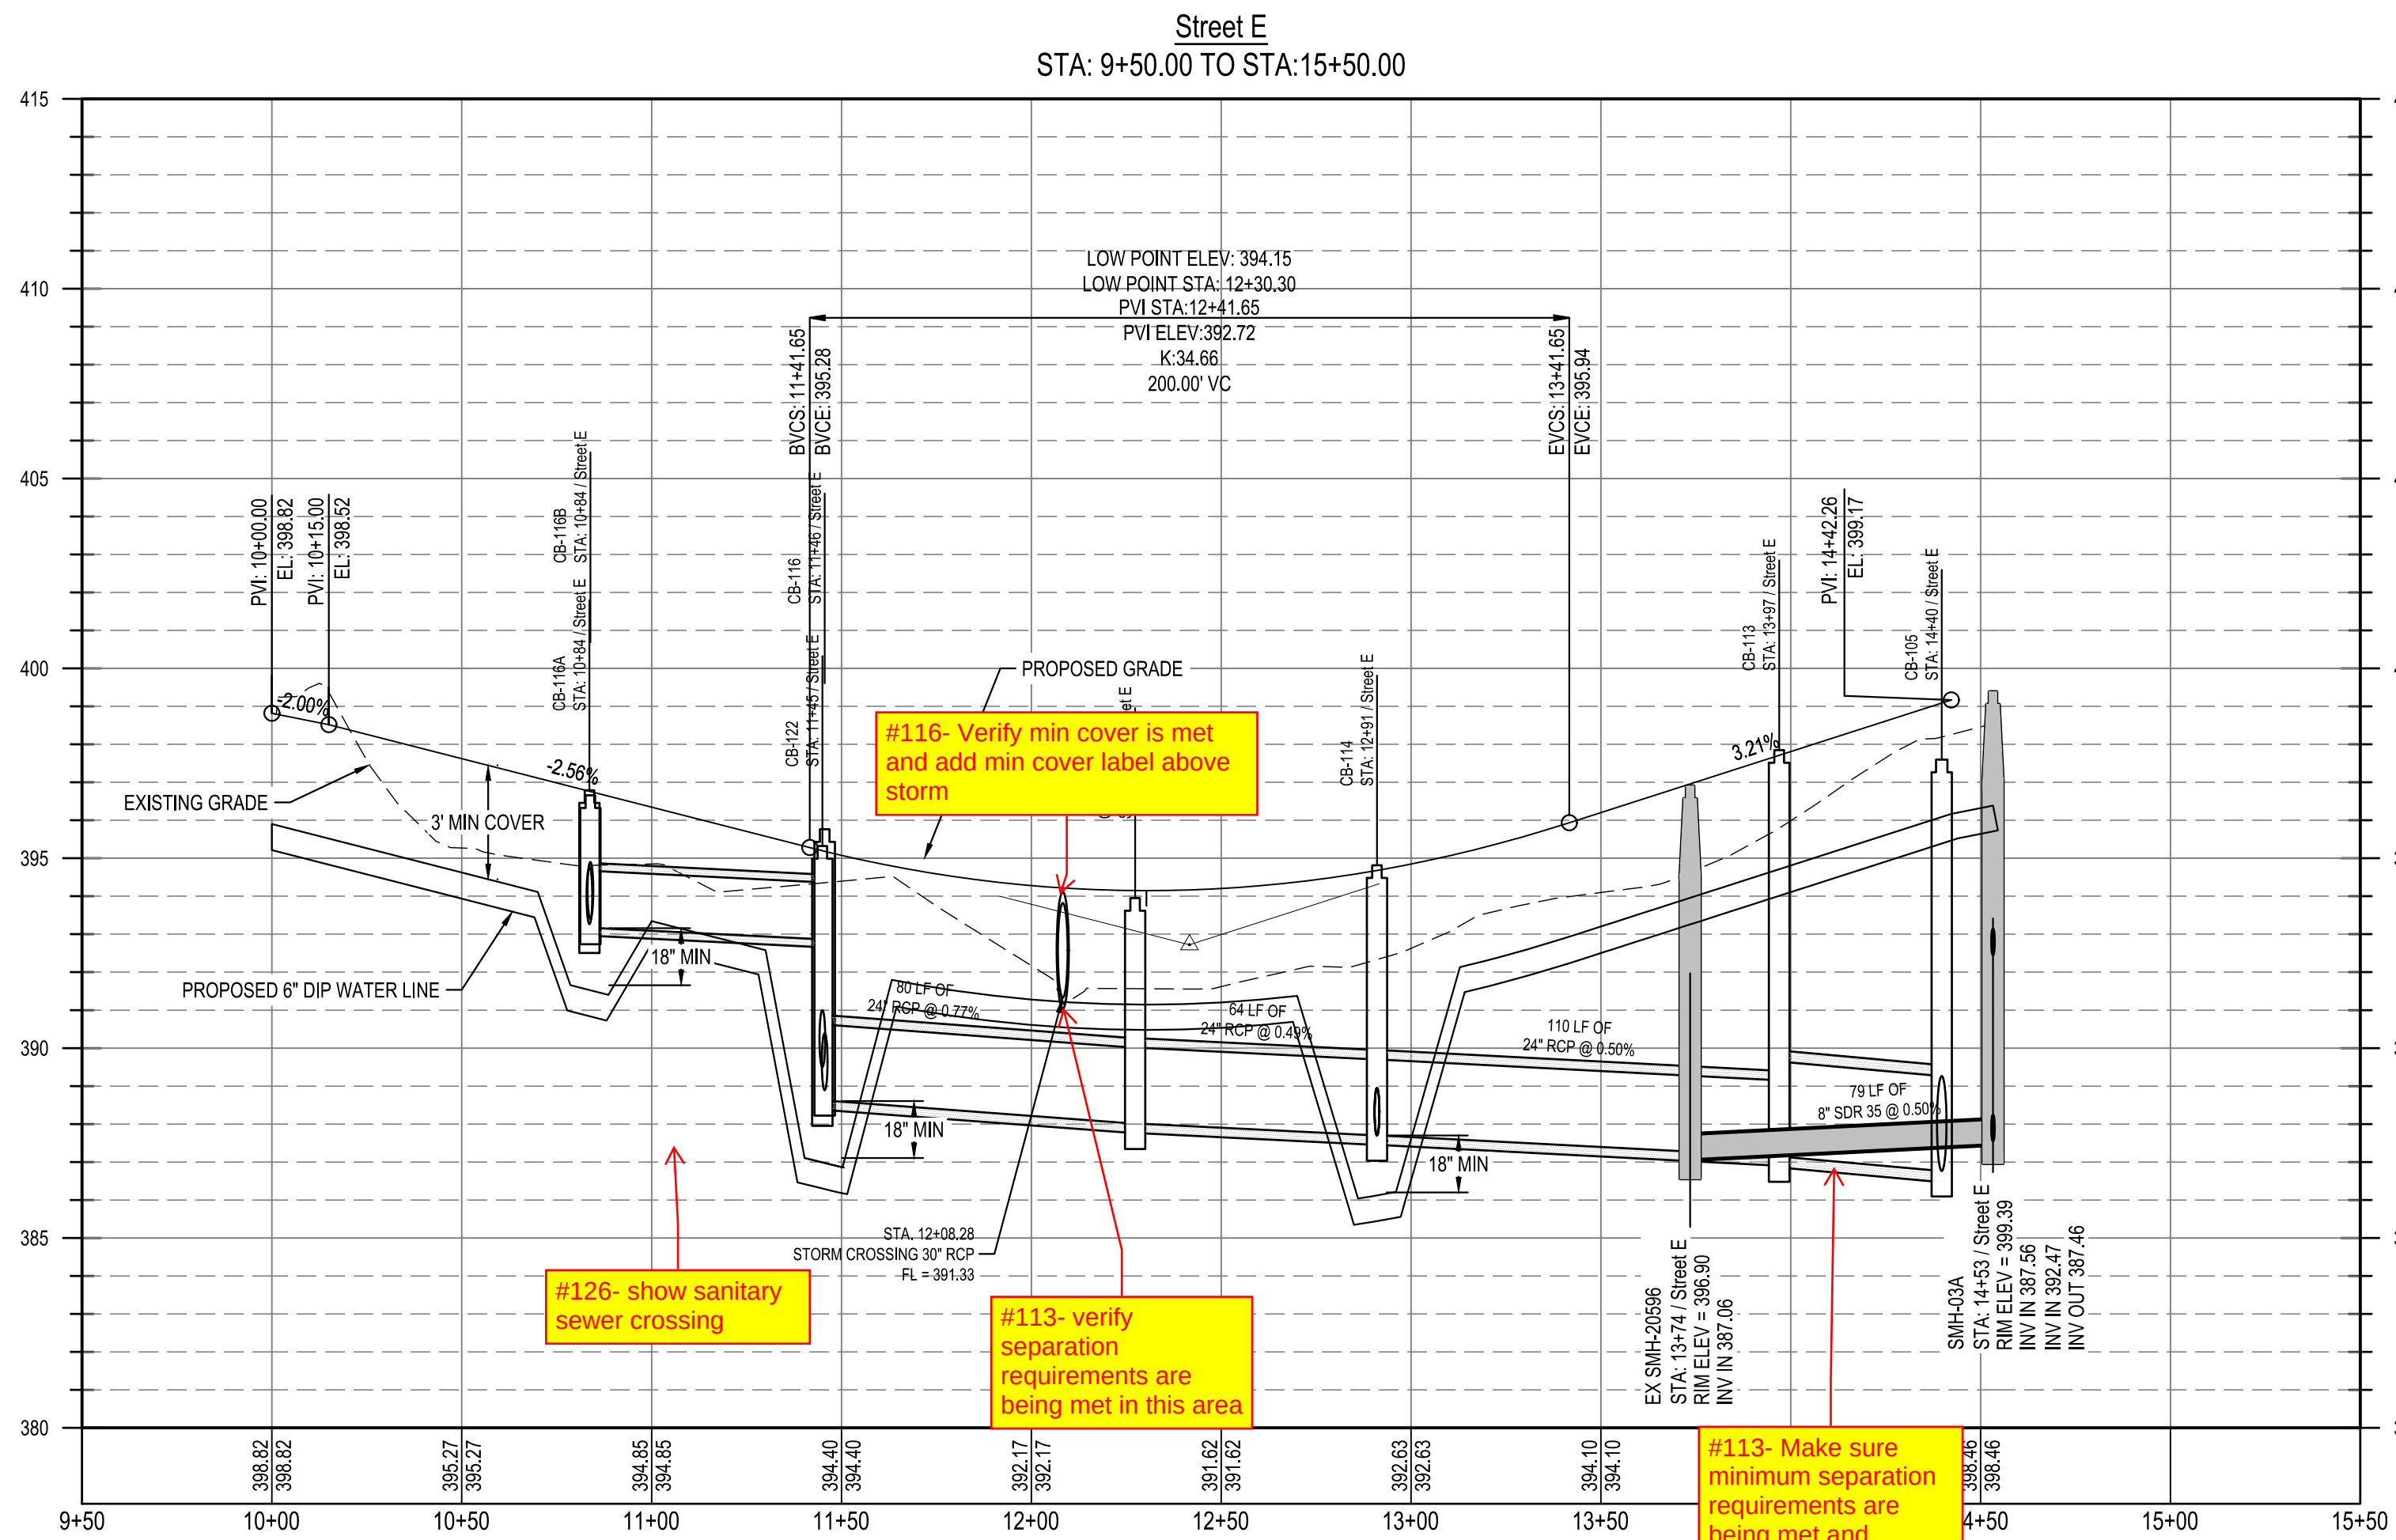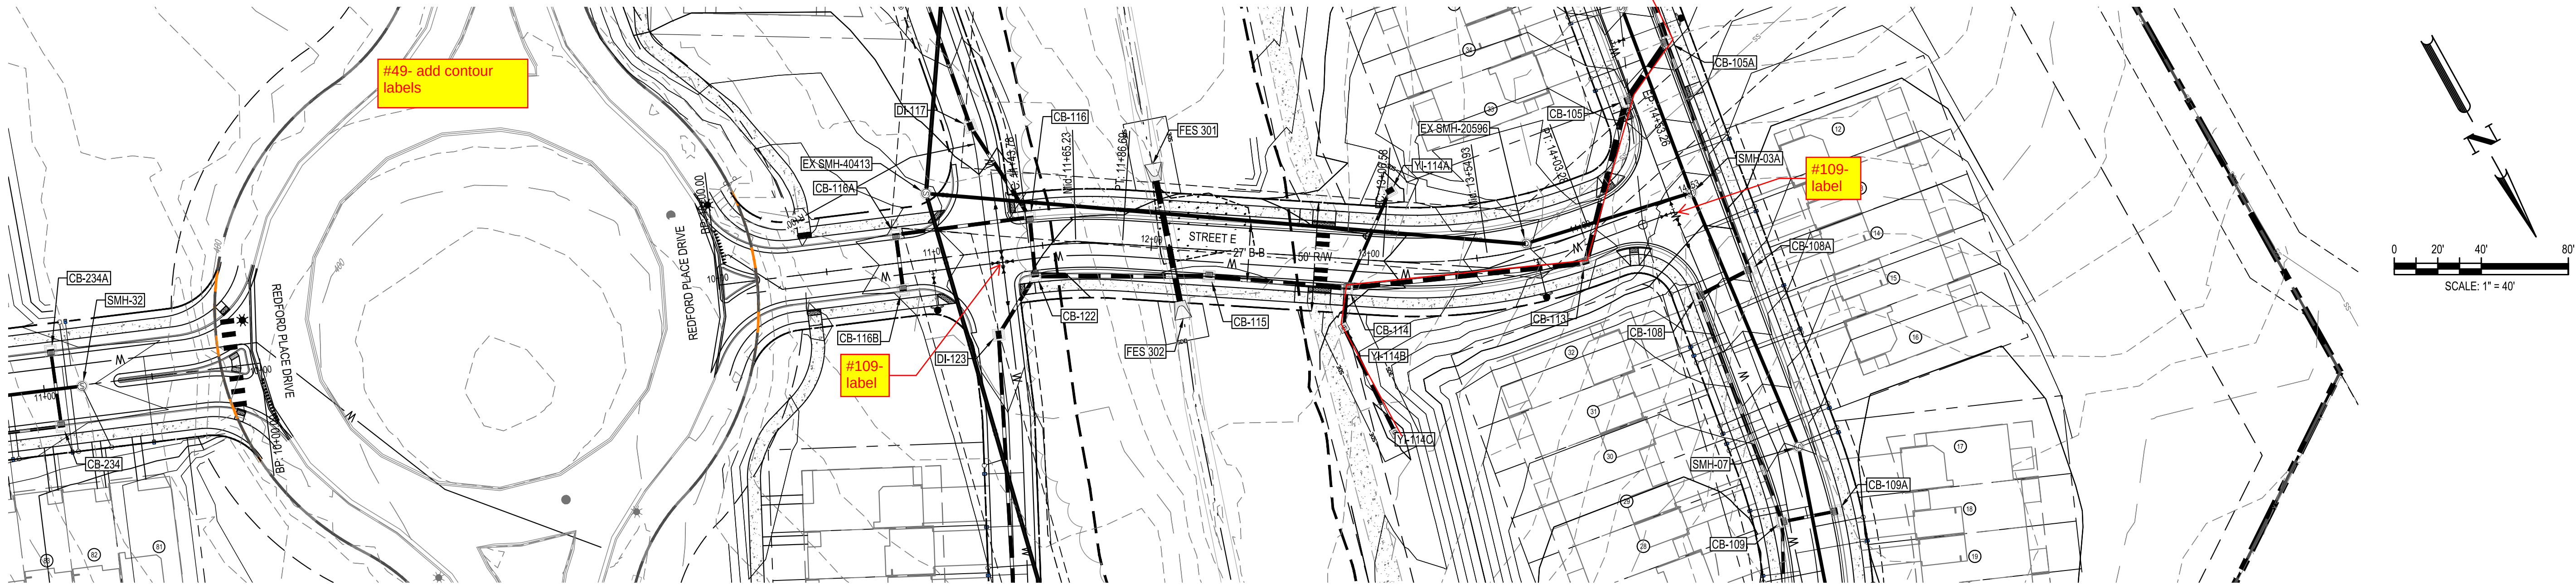

Know what's below.
Call before you dig.

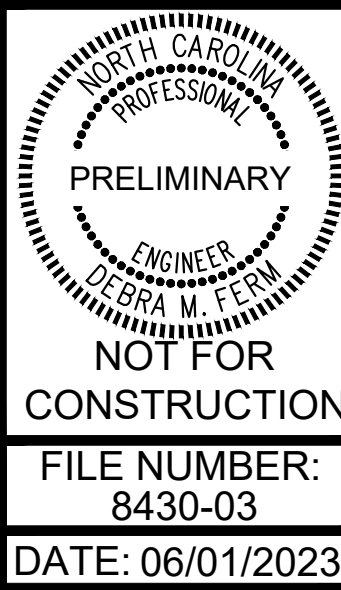


C6-5

STREET E PLAN AND
PROFILE



PARKER RIDGE
82 SCHOOL STREET
ROLESVILLE / NORTH CAROLINA / 27571

LENNAR
CORPORAION
1100 PERIMETER PARK DRIVE, SUITE 112
MORRISVILLE / NORTH CAROLINA / 27560

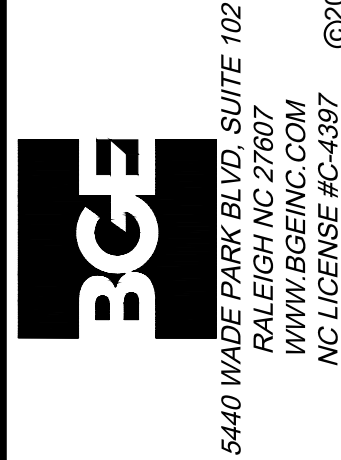


DESIGNED BY: DF/CD
DRAWN BY: DF/JWM
REVIEWED BY: DF


REV	DATE	DESCRIPTION
06/01/2023	06/01/2023	PER TOWN OF ROLESVILLE COMMENT
04/03/2023	04/03/2023	INITIAL SUBMITTAL

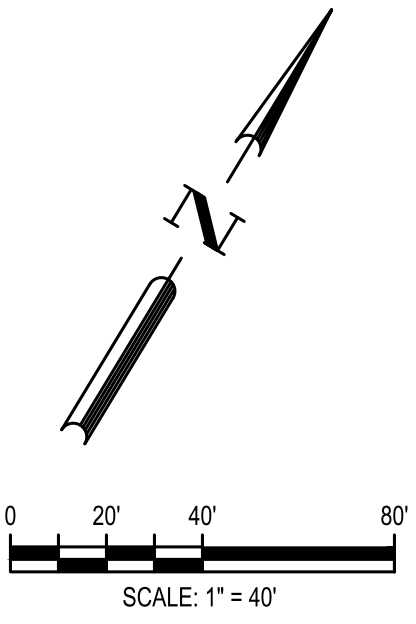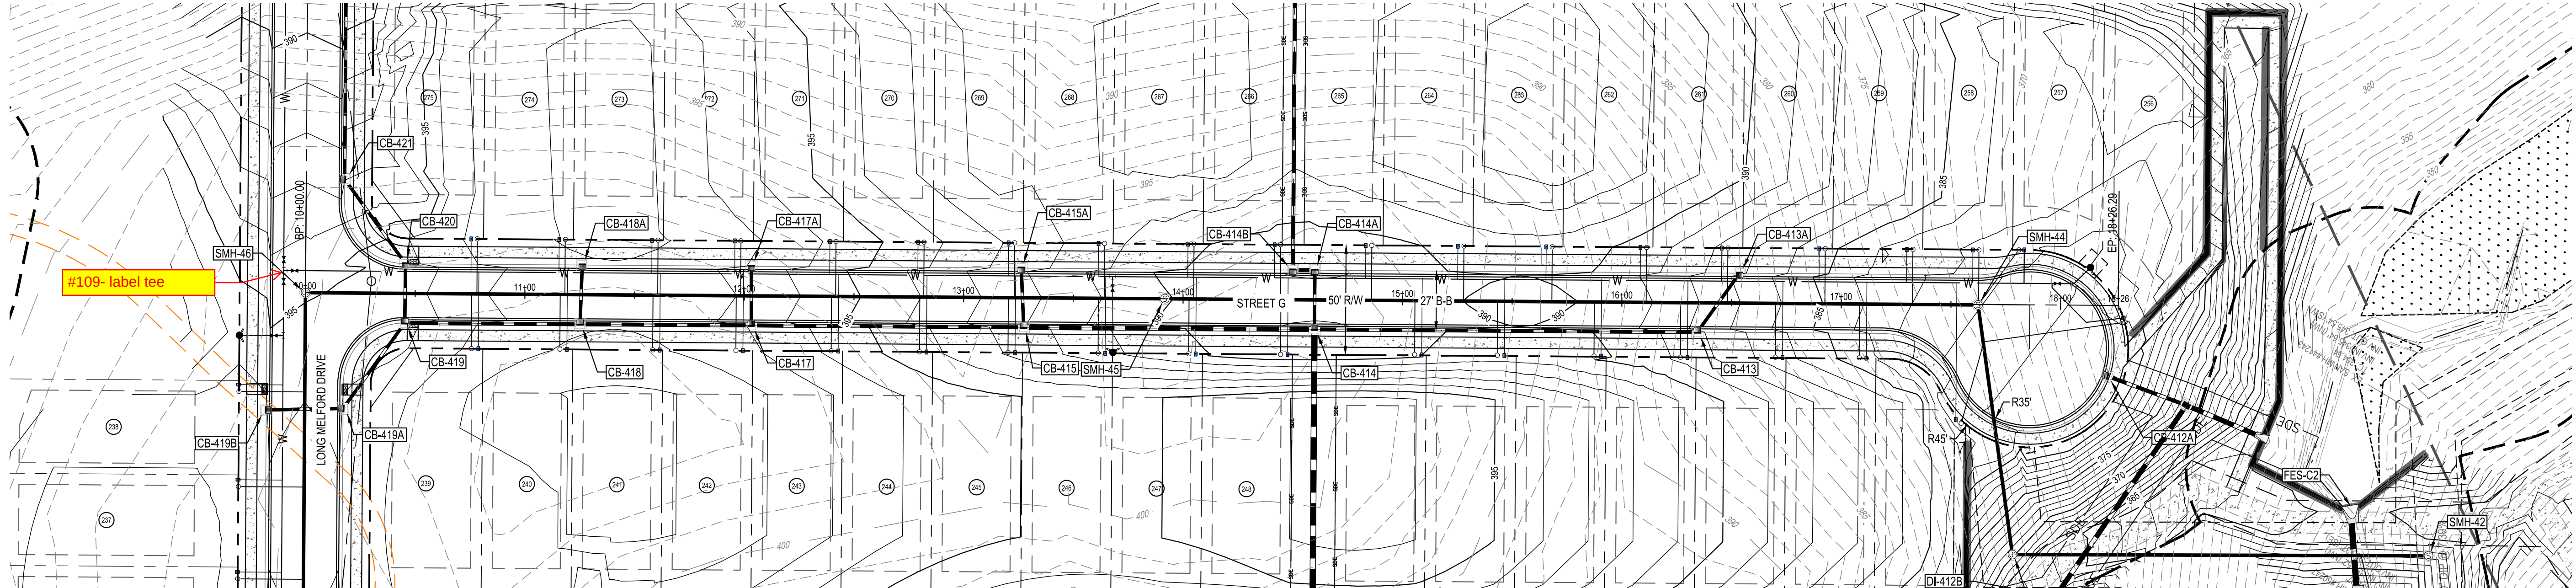

Street G
STA: 9+50.00 TO STA: 19+00.00

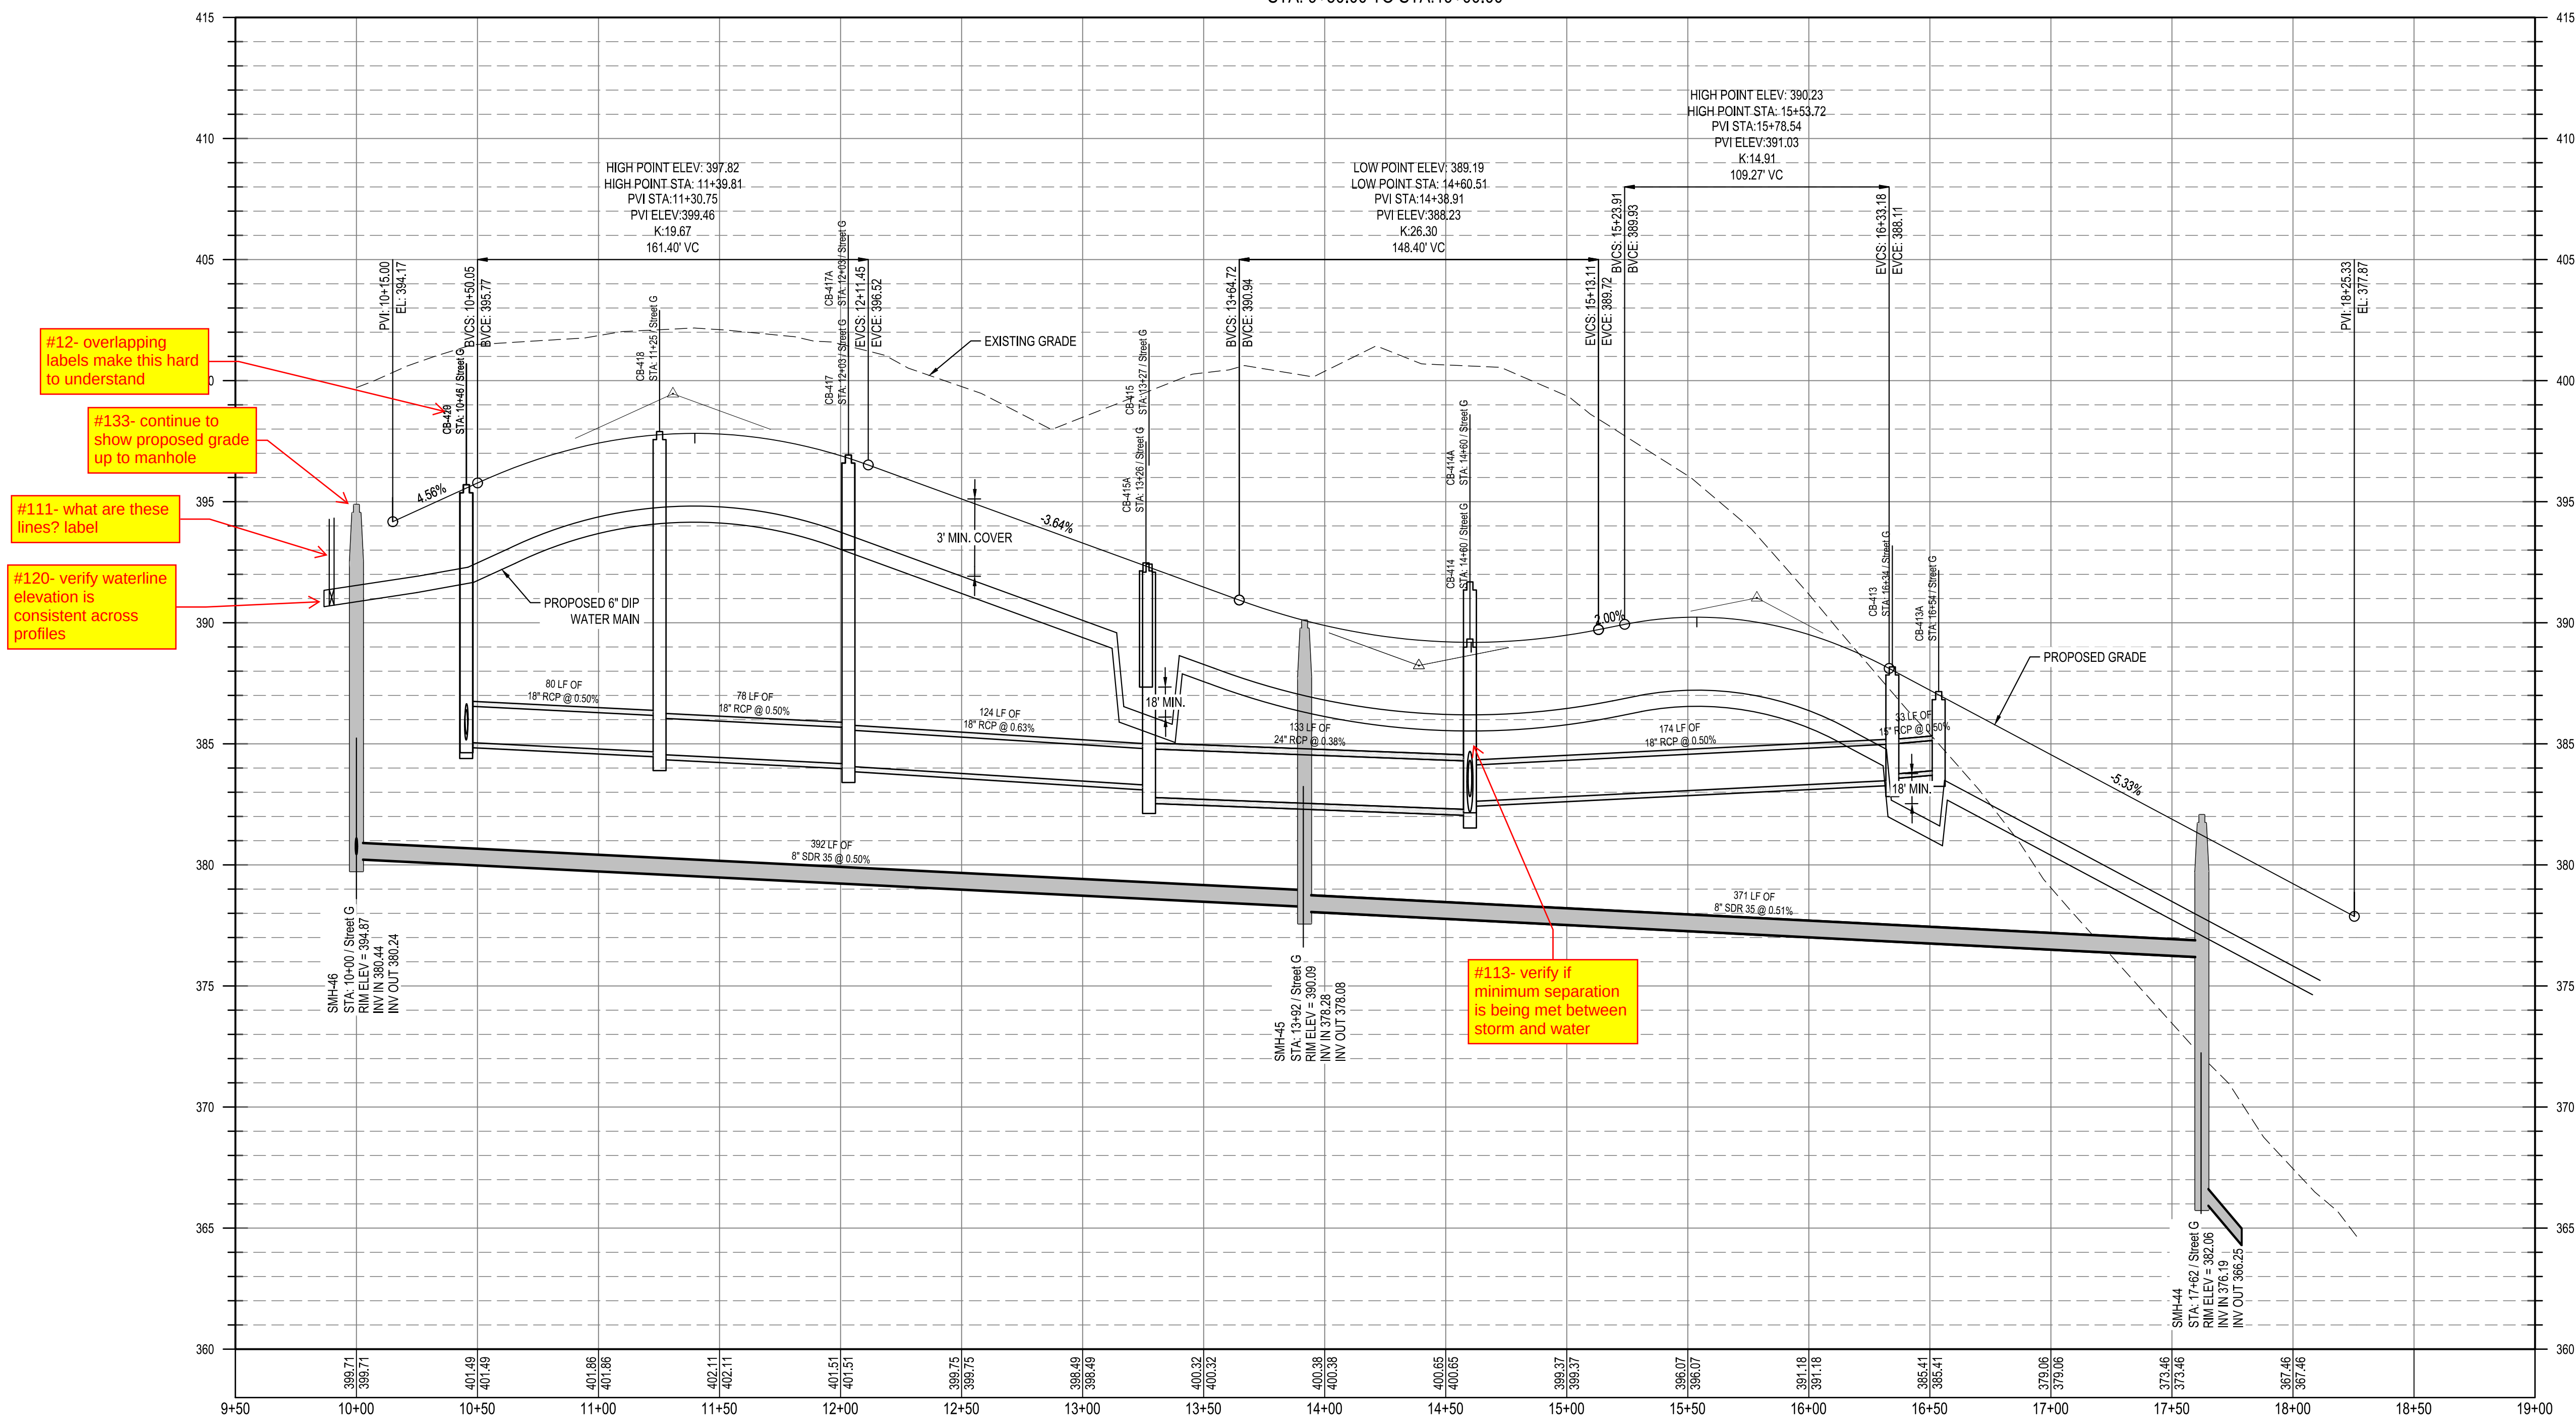

#113- label minimum separation at all crossings

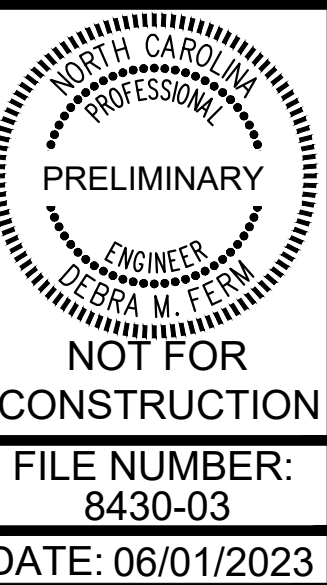

STREET G PLAN AND
PROFILE

PARKER RIDGE
82 SCHOOL STREET
ROLESVILLE / NORTH CAROLINA / 27571





LENNAR
CORPORAION
1100 PERIMETER PARK DRIVE, SUITE 112
MORRISVILLE / NORTH CAROLINA / 27560

BCE
5440 WADE PARK BLVD, SUITE 102
RALEIGH NC 27607
WWW.BCEINC.COM
NC LICENSE #C-4397

DESIGNED BY: DF/CD
DRAWN BY: DF/JWM
REVIEWED BY: DF

06/01/2023 PER TOWN OF ROLESVILLE COMMENT
REV 04/03/2023 INITIAL SUBMITTAL


C6-7

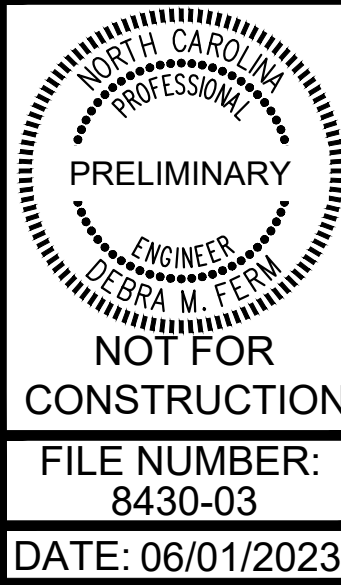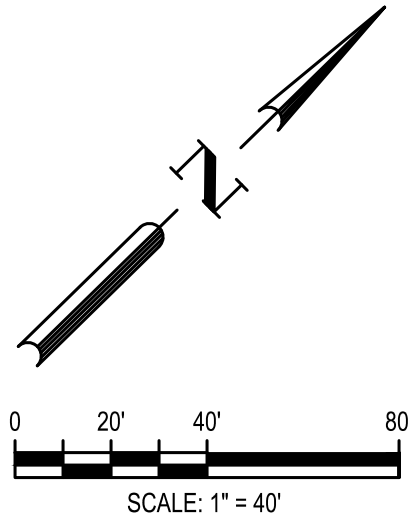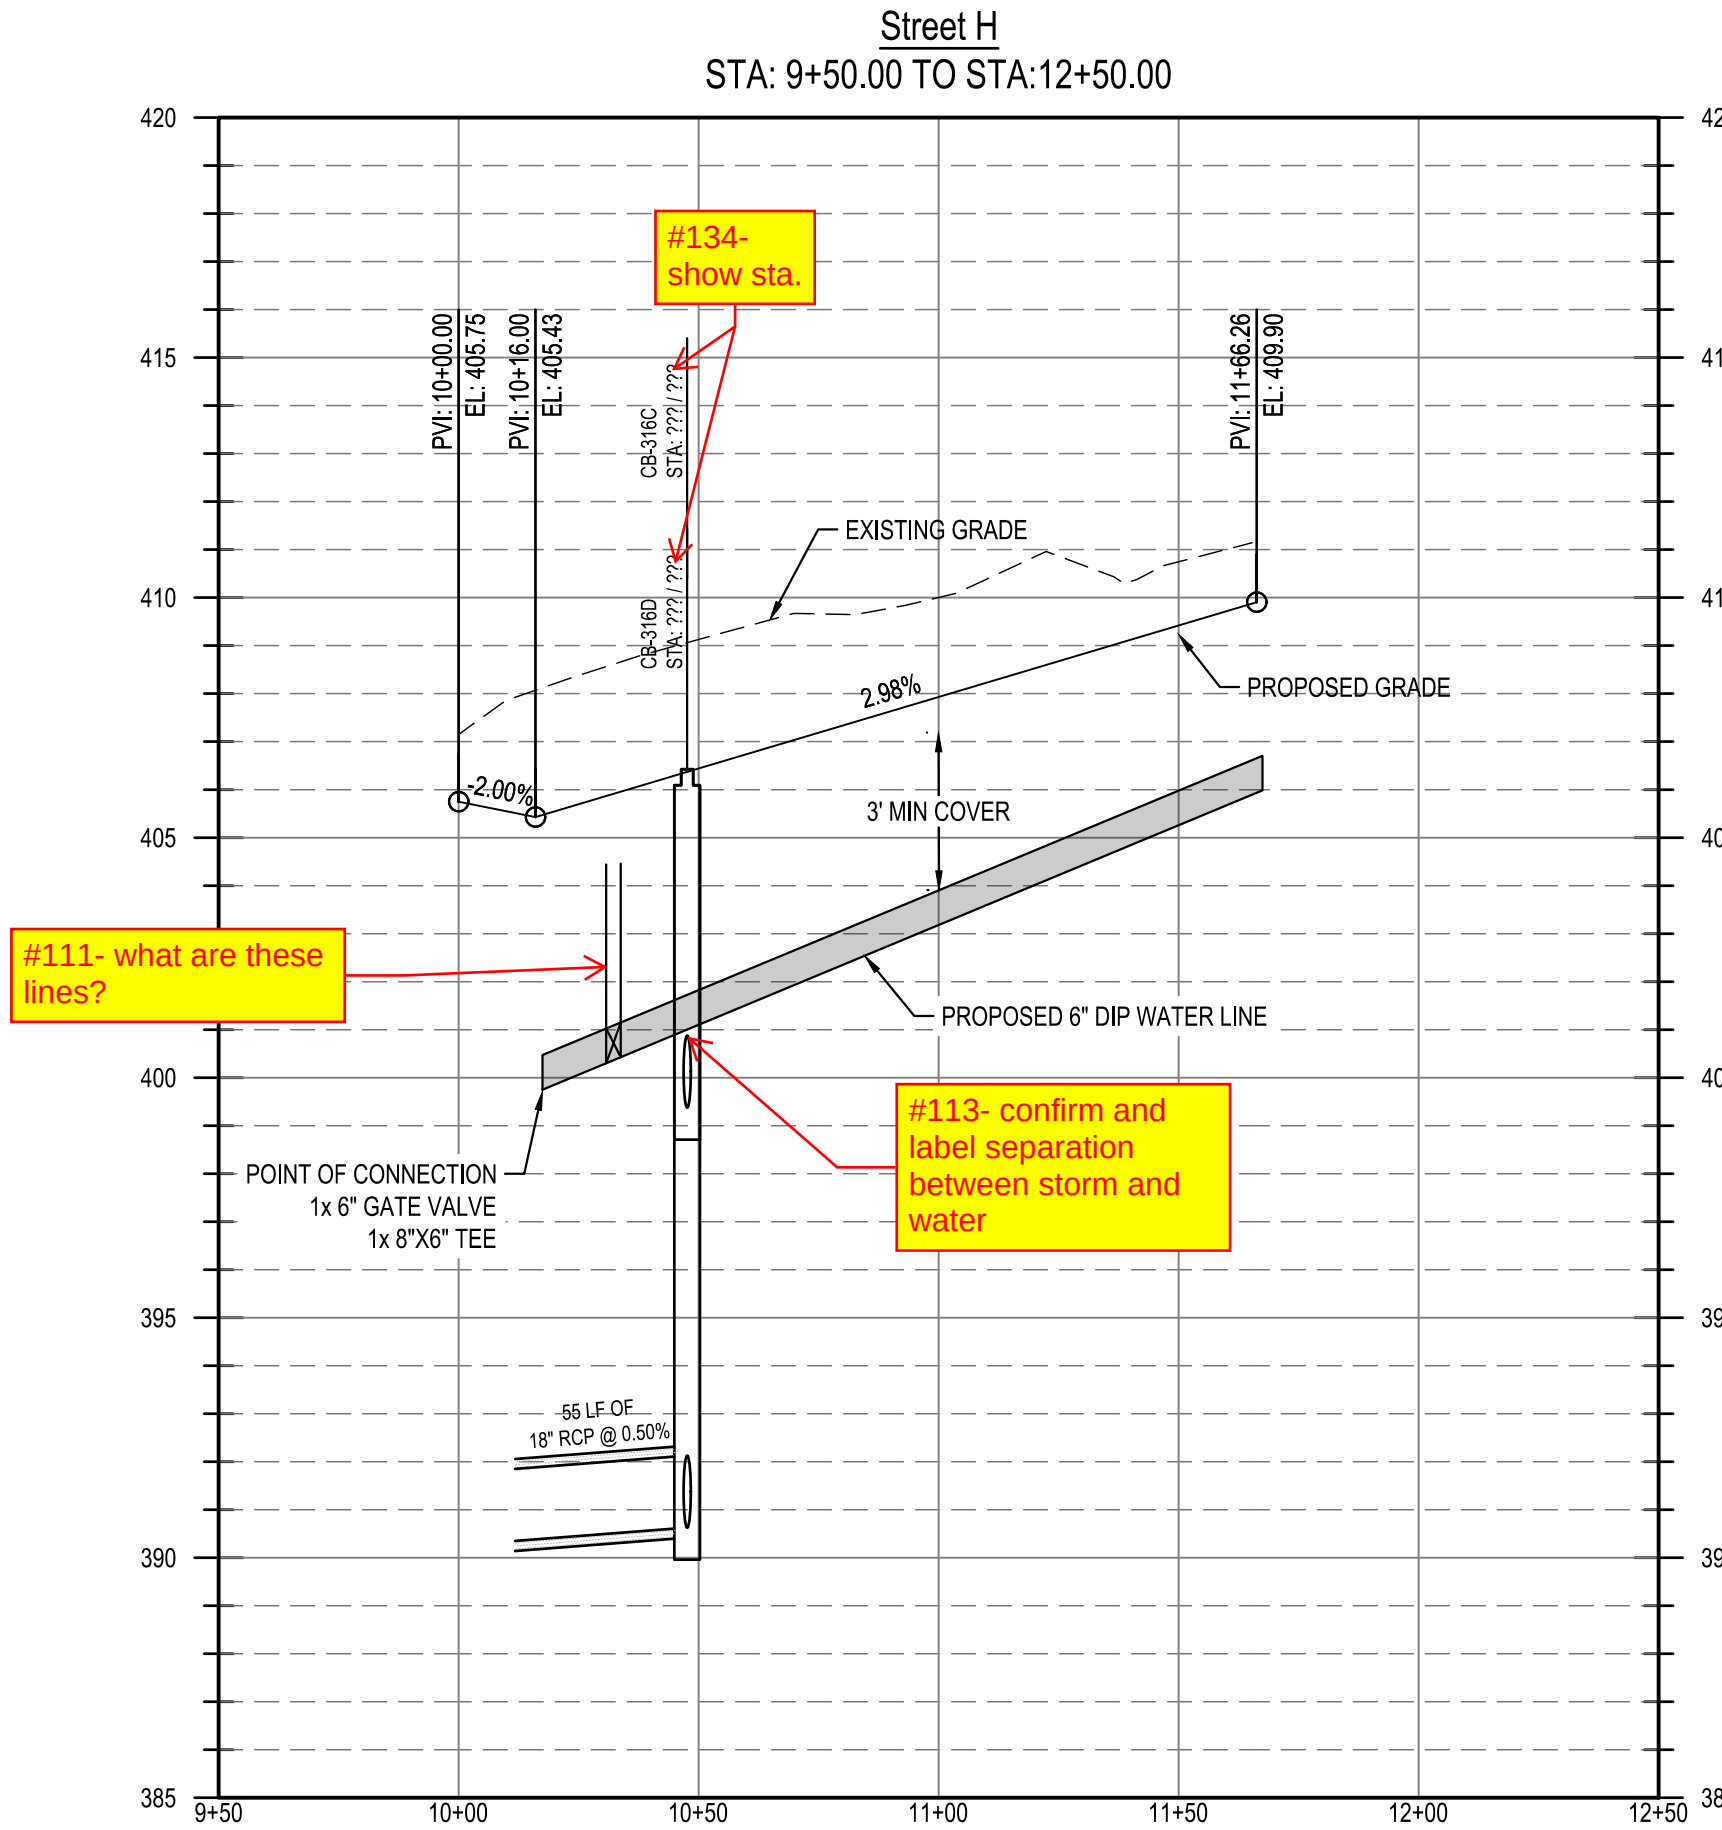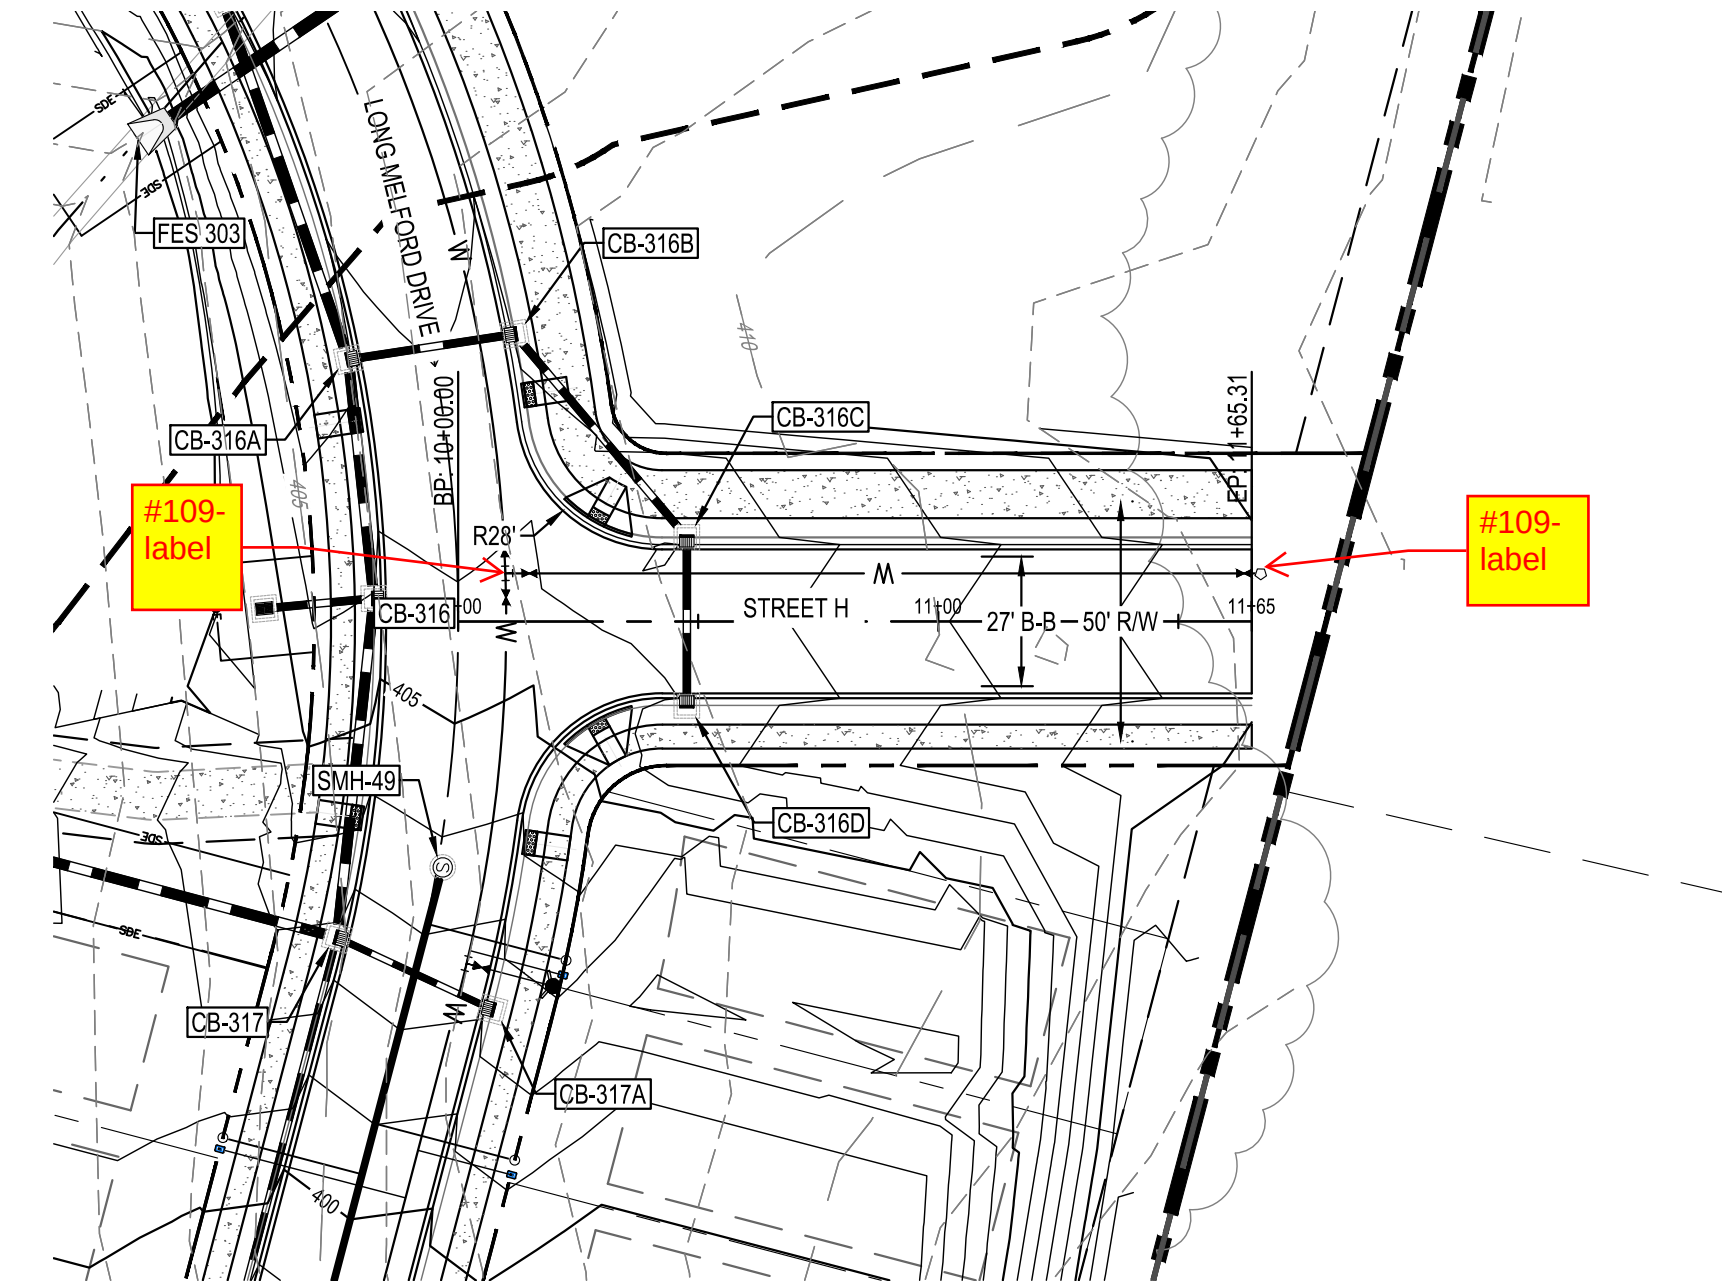

STREET H PLAN AND
PROFILE

PARKER RIDGE
82 SCHOOL STREET
ROLESVILLE / NORTH CAROLINA / 27571

LENNAR
CORPORAION
1100 PERIMETER PARK DRIVE, SUITE 112
MORRISVILLE / NORTH CAROLINA / 27560

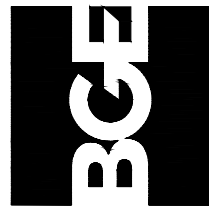


5440 WADE PARK BLVD, SUITE 102
RALEIGH NC 27607
WWW.BCEINC.COM
NC LICENSE #C-4397


DESIGNED BY:	DF/CD
DRAWN BY:	DF/JWM
REVIEWED BY:	DF

REV	04/03/2023	INITIAL SUBMITTAL
06/01/2023	PER TOWN OF ROLESVILLE COMMENT	


\\browngay.net\panzura\Regions\NCA\Projects\Lennar\8430-03 - Lennar - School Street - DWG\PlanSheets\On-Site\C6-9 LONG MELFORD DRIVE PLAN AND PROFILE (1 OF 5) Plotted: 6/7/2023 3:31:01 PM

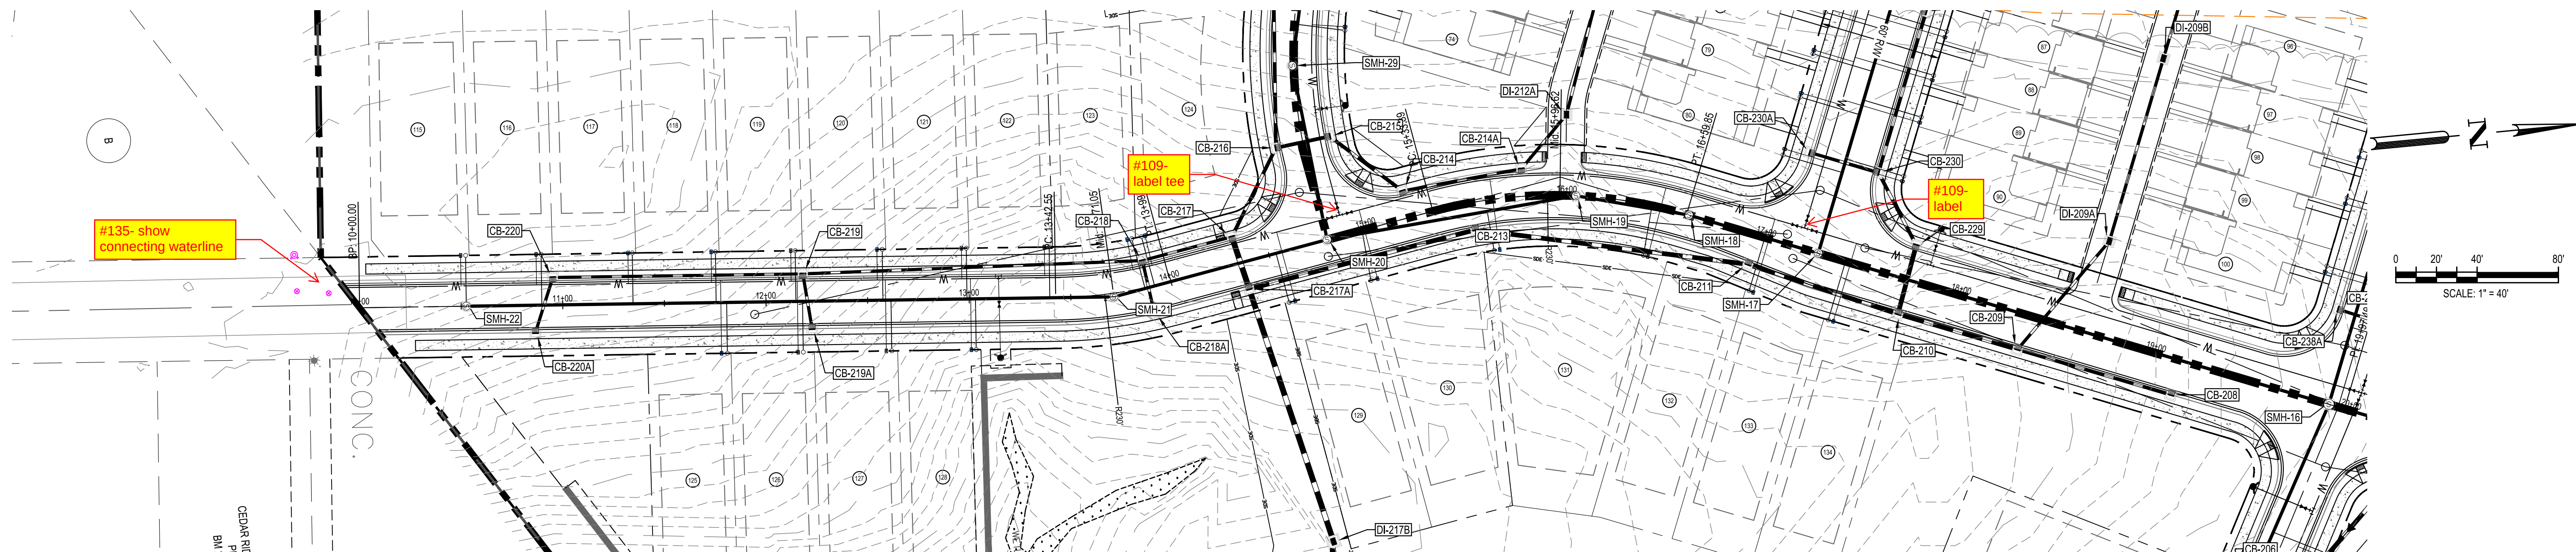

LONG MELFORD DRIVE
STA: 10+00.00 TO STA: 17+50.00

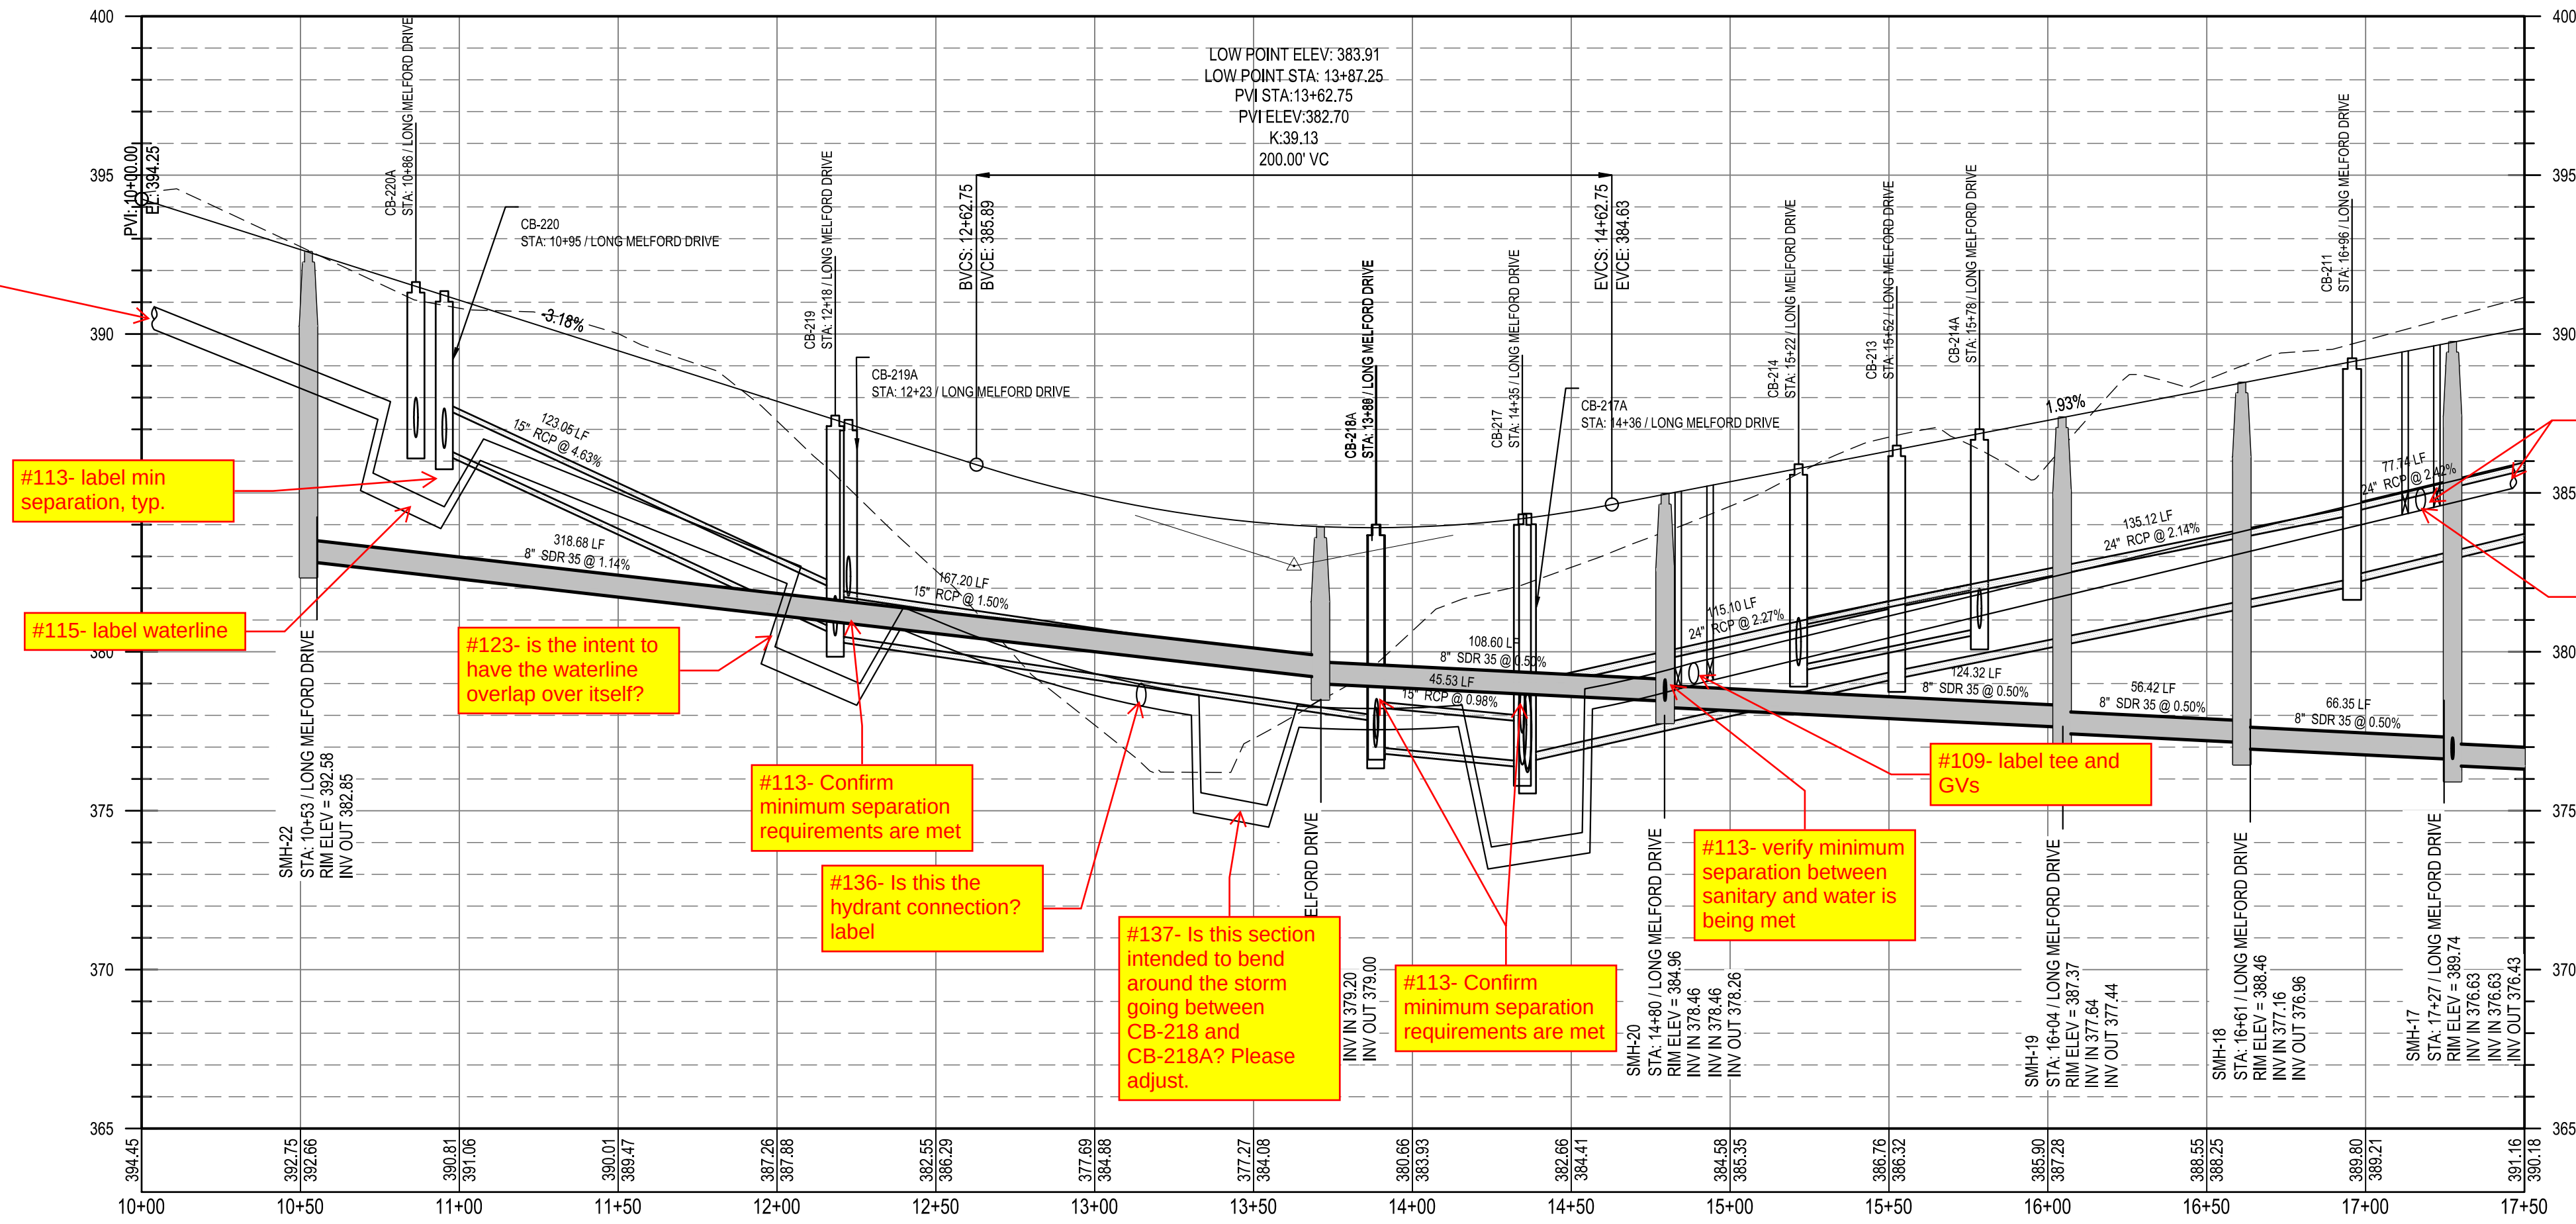

Know what's below.
Call before you dig.

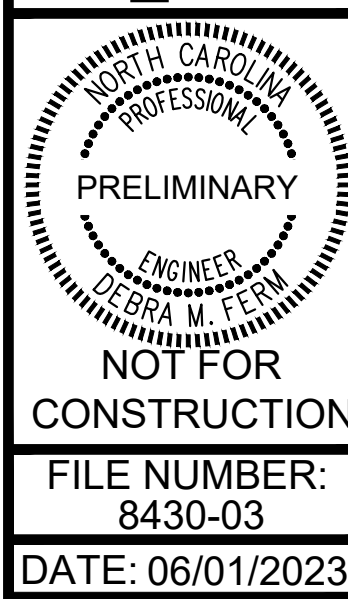

LONG MELFORD DRIVE PLAN
AND PROFILE (1 OF 5)

PARKER RIDGE
82 SCHOOL STREET
ROLESVILLE / NORTH CAROLINA / 27571


LENNAR
CORPORAION
1100 PERIMETER PARK DRIVE, SUITE 112
MORRISVILLE / NORTH CAROLINA / 27560




DESIGNED BY: DF/CD
DRAWN BY: DF/JWM
REVIEWED BY: DF

REV 04/03/2023 INITIAL SUBMITTAL
06/01/2023 PER TOWN OF ROLESVILLE COMMENT

\\browngay.net\panzura\Regions\NCA\Projects\Lennar\8430-03 - DWG\PlanSheets\On-Site\C6-9 LONG MELFORD DRIVE PLAN AND PROFILE (3 OF 5) Plotted: 6/1/2023 3:12:22 PM

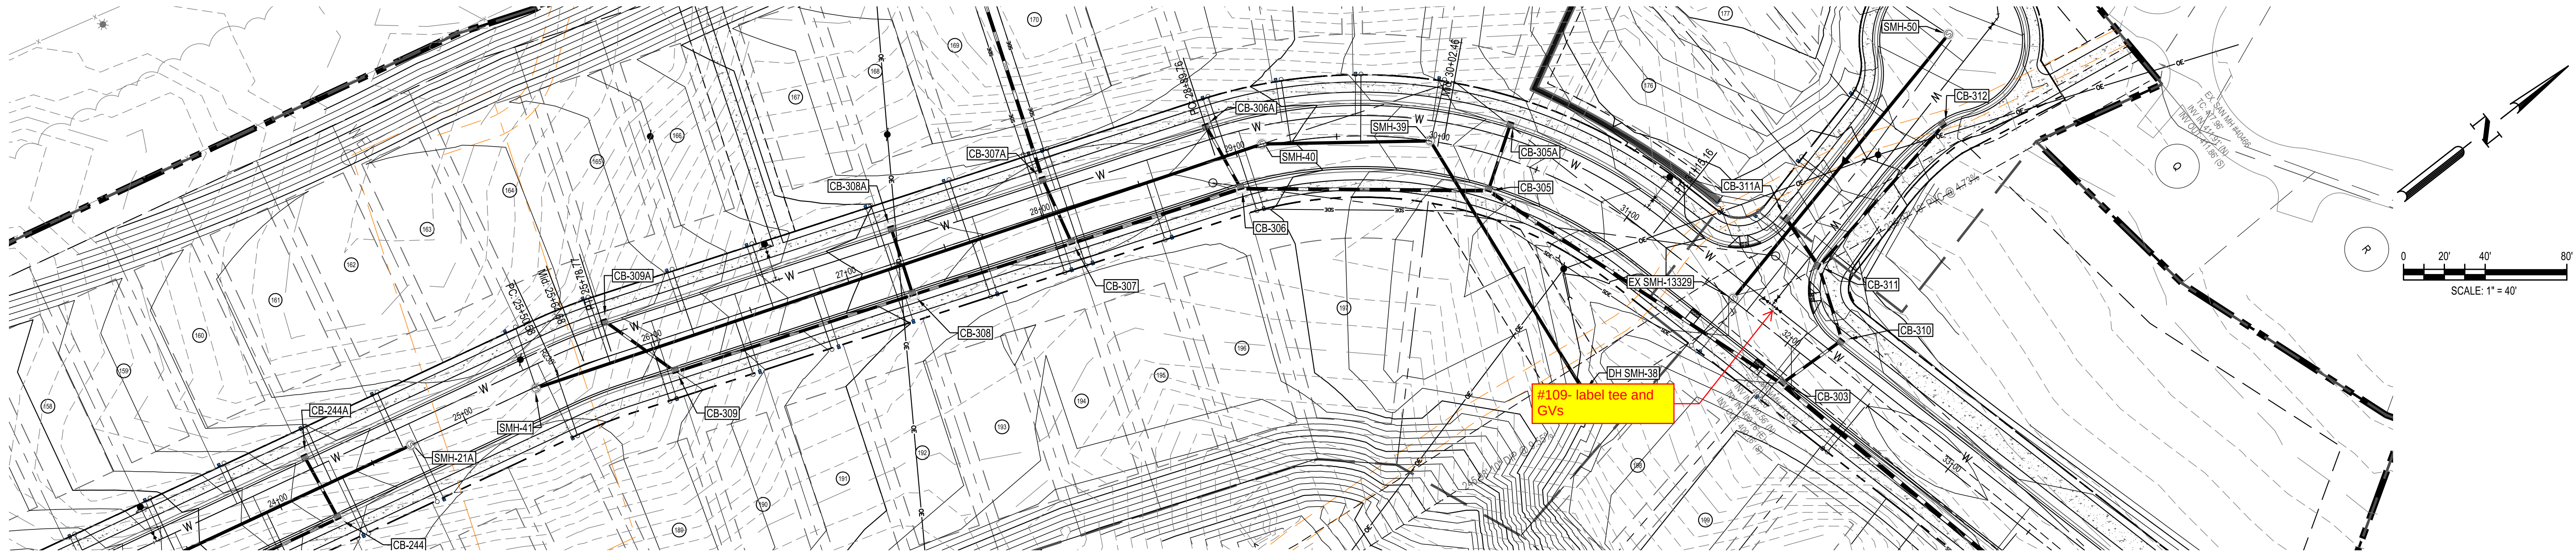

LONG MELFORD DRIVE
STA: 25+00.00 TO STA:32+50.00

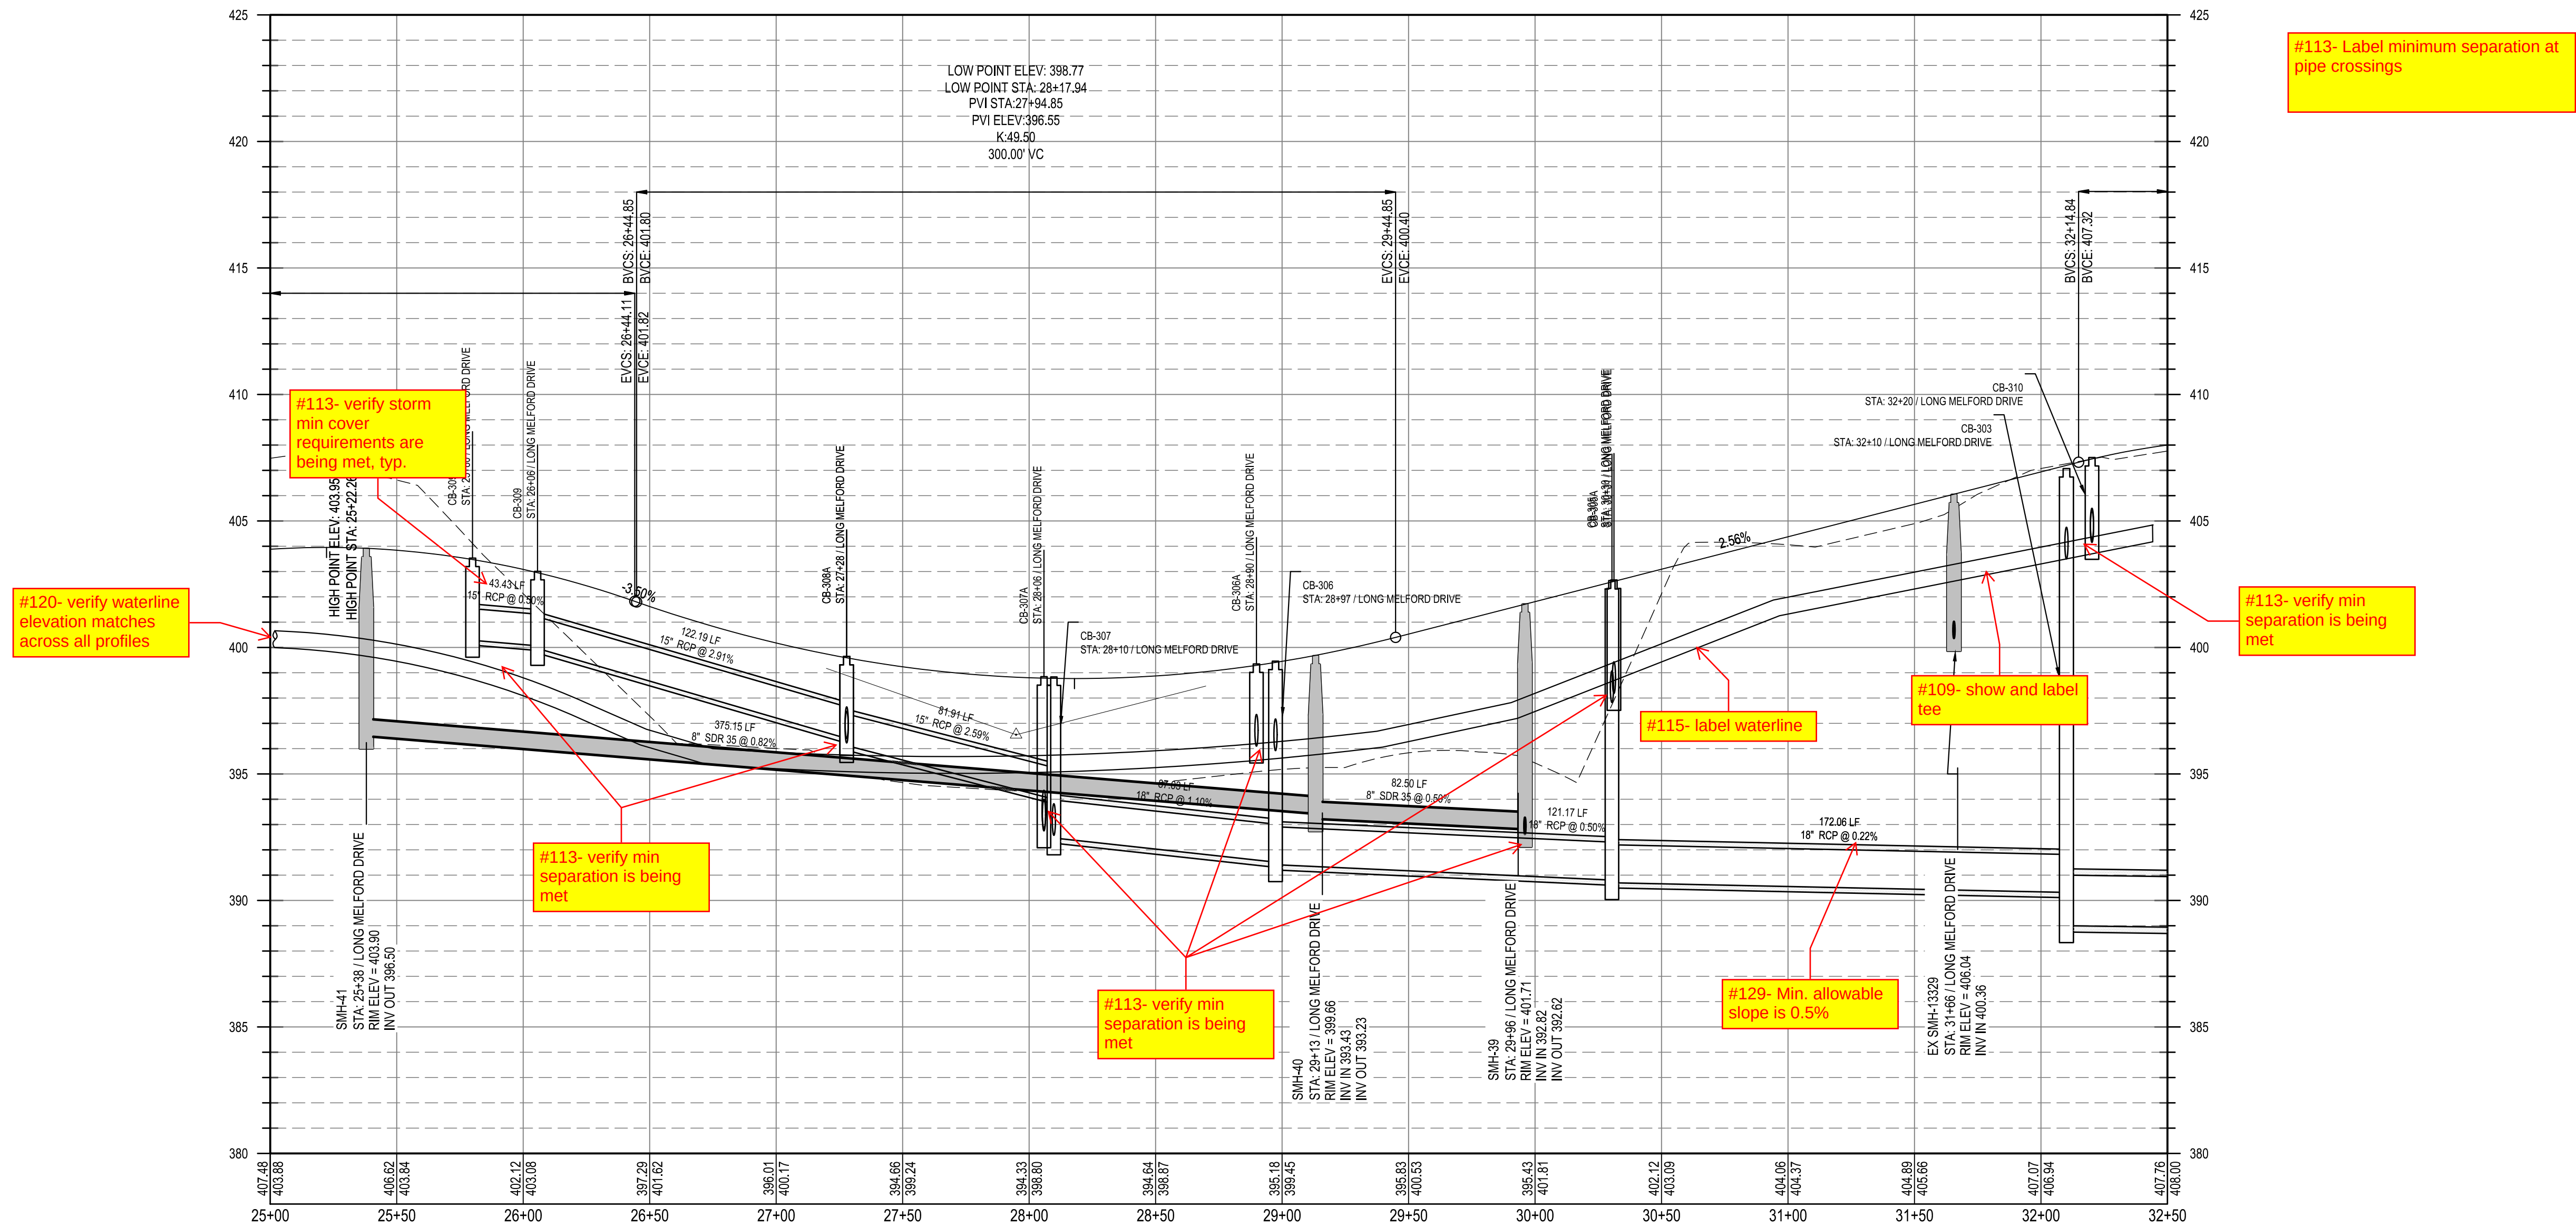

Know what's below.
Call before you dig.

PRELIMINARY
ENGINEER
FEDRA M. FERRIS
NOT FOR
CONSTRUCTION
FILE NUMBER:
8430-03
DATE: 06/01/2023

C6-11

PARKER RIDGE
82 SCHOOL STREET
ROLESVILLE / NORTH CAROLINA / 27571



LENNAR
CORPORAION
1100 PERIMETER PARK DRIVE, SUITE 112
MORRISVILLE / NORTH CAROLINA / 27560

BCE
5440 WADE PARK BLVD, SUITE 102
RALEIGH NC 27607
WWW.BCEINC.COM
NC LICENSE #C-4397
©2023


DESIGNED BY:	DF/CD
DRAWN BY:	DF/JWM
REVIEWED BY:	DF

REV	04/03/2023	INITIAL SUBMITTAL
△	06/01/2023	PER TOWN OF ROLESVILLE COMMENT

\\browgway.net\panzura\Regions\NCA\Projects\Lennar\8430-03 - DWG\PlanSheets\On-Site\CB-9 LONG MELFORD DRIVE PLAN AND PROFILE (4 OF 5) Plotted: 6/1/2023 3:13:32 PM

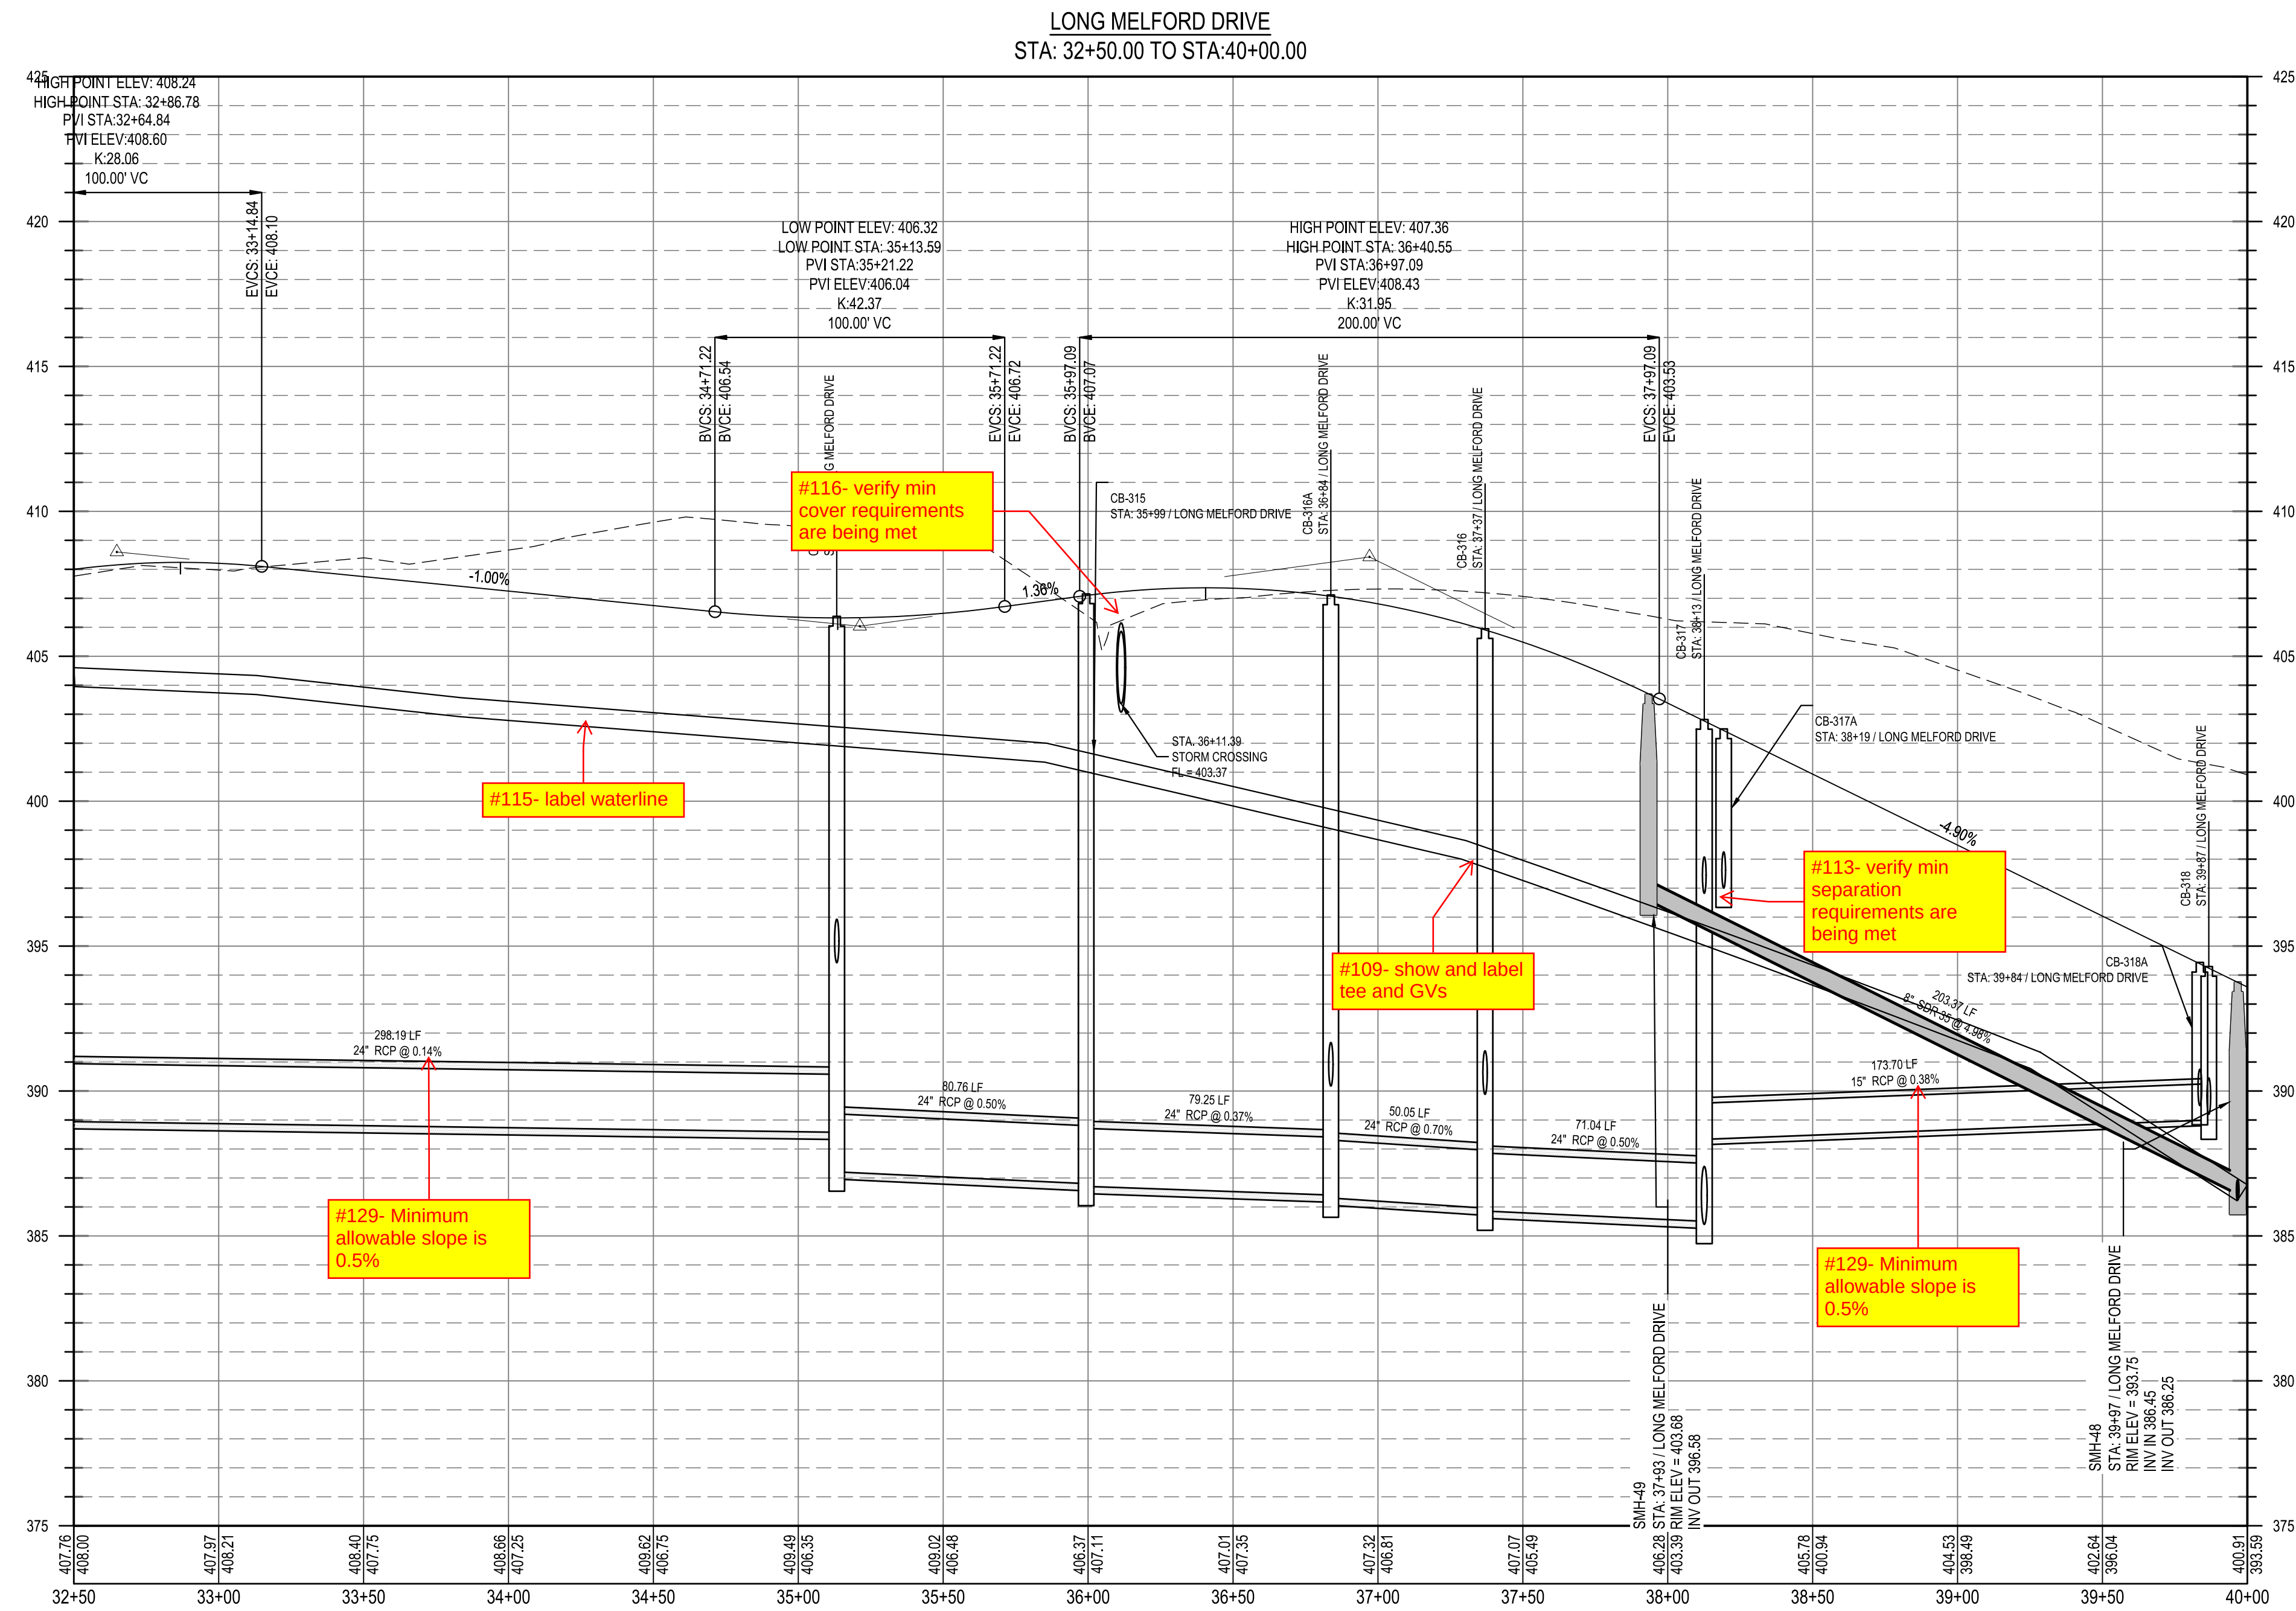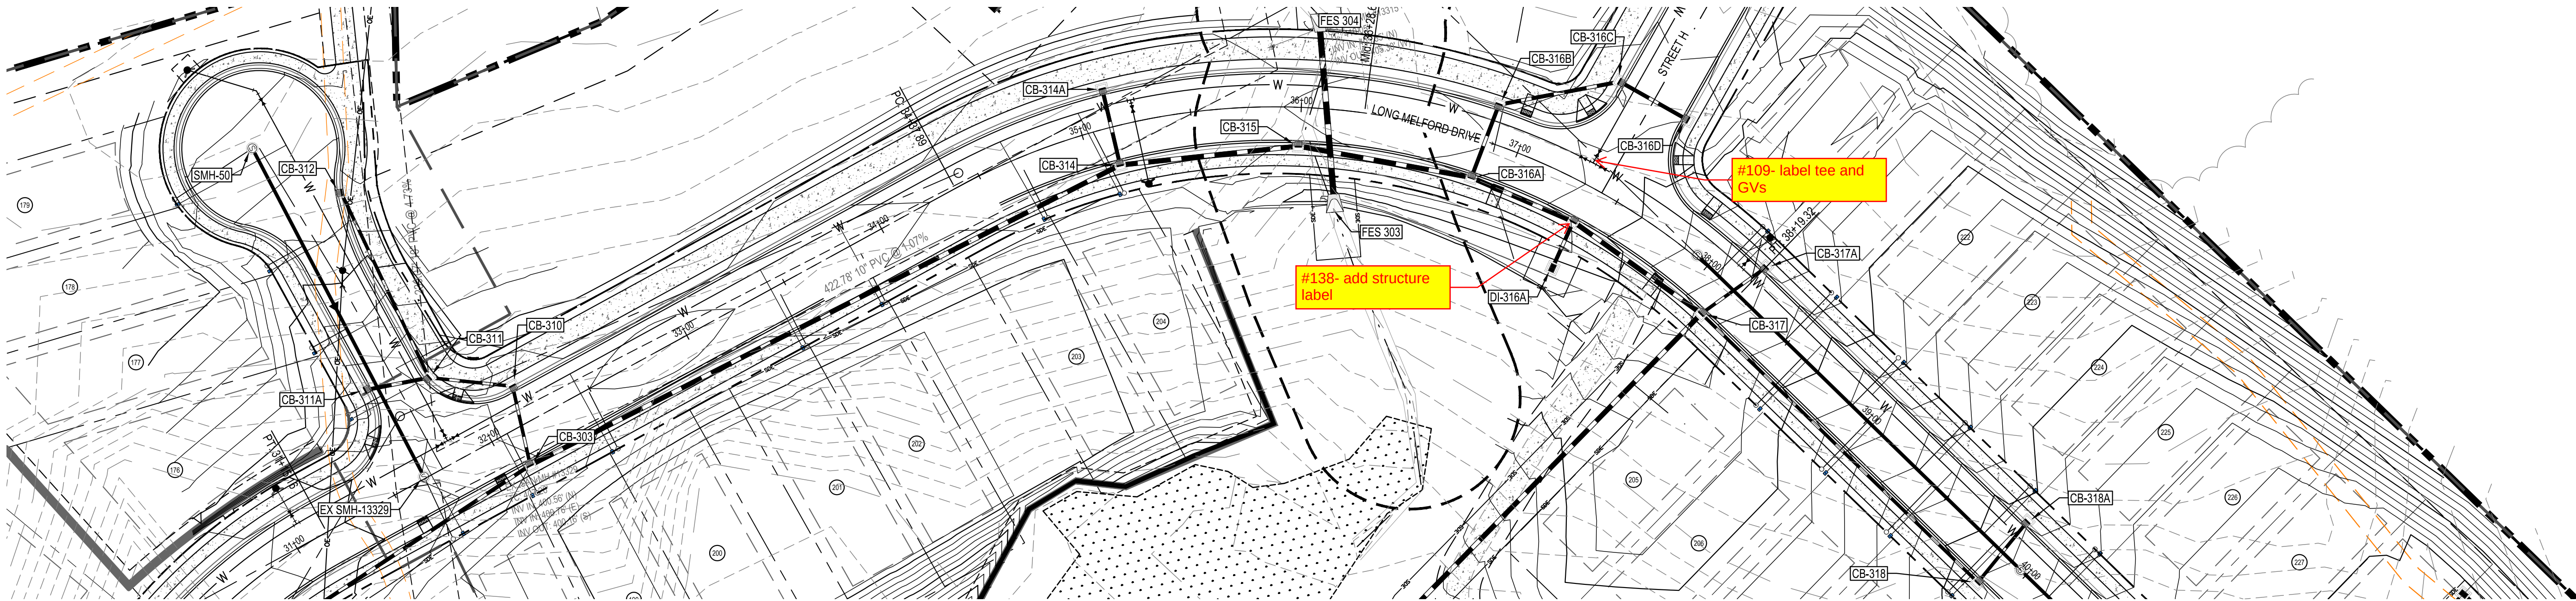

#113- Label minimum separation at pipe crossings

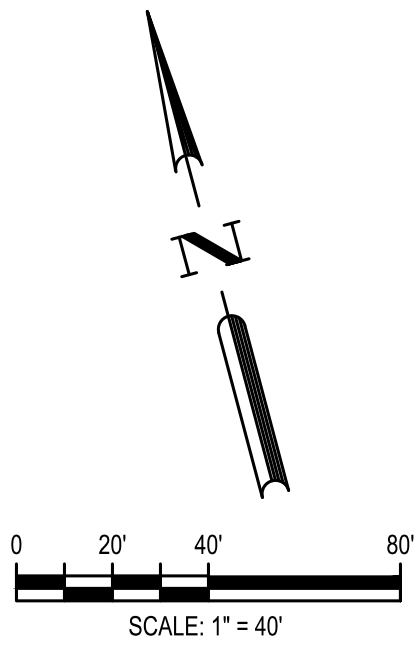

Know what's below.
Call before you dig.

DESIGNED BY: DF/CD		REV: 04/03/2023	
DRAWN BY: DF/JWM		REV: 06/01/2023	
REVIEWED BY: DF		REV: 06/01/2023	
PER TOWN OF ROLESVILLE COMMENT		INITIAL SUBMITTAL	

5440 WADE PARK BLVD, SUITE 102
RALEIGH NC 27607
WWW.BCEINC.COM
NC LICENSE #C-4397

LENNAR
CORPORAION
1100 PERIMETER PARK DRIVE, SUITE 112
MORRISVILLE / NORTH CAROLINA / 27560

PARKER RIDGE
82 SCHOOL STREET
ROLESVILLE / NORTH CAROLINA / 27571



**LONG MELFORD DRIVE PLAN
AND PROFILE (4 OF 5)**

**NOT FOR
CONSTRUCTION**

FILE NUMBER:
8430-03

DATE: 06/01/2023

C6-12

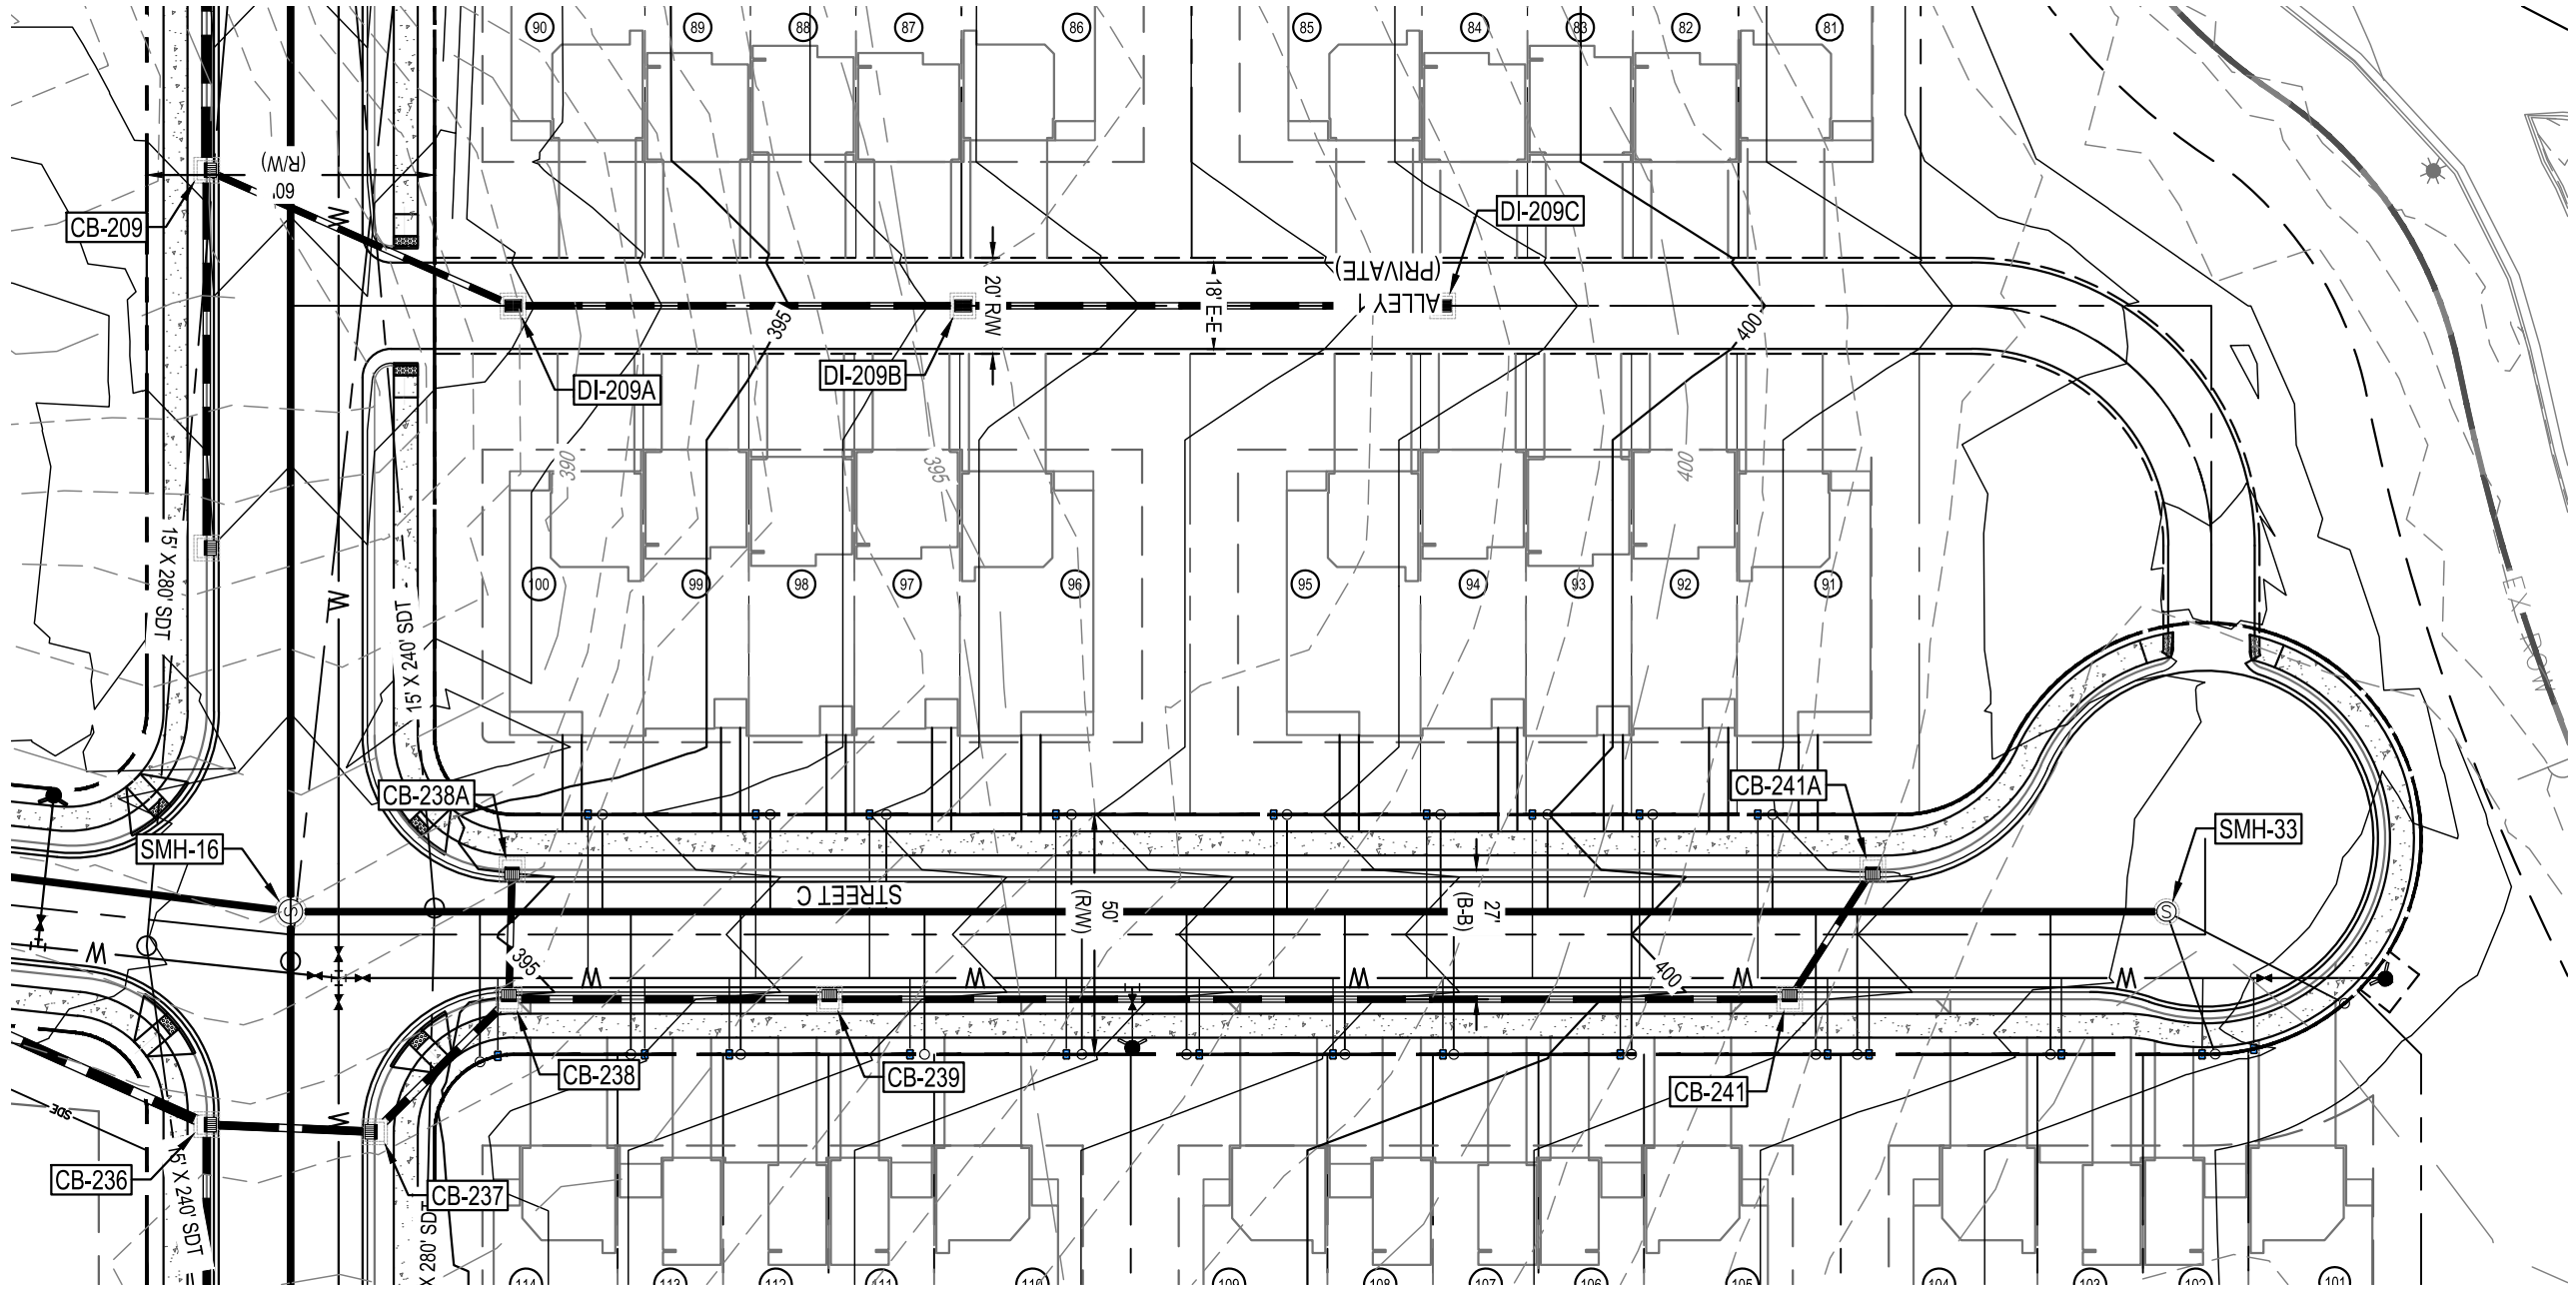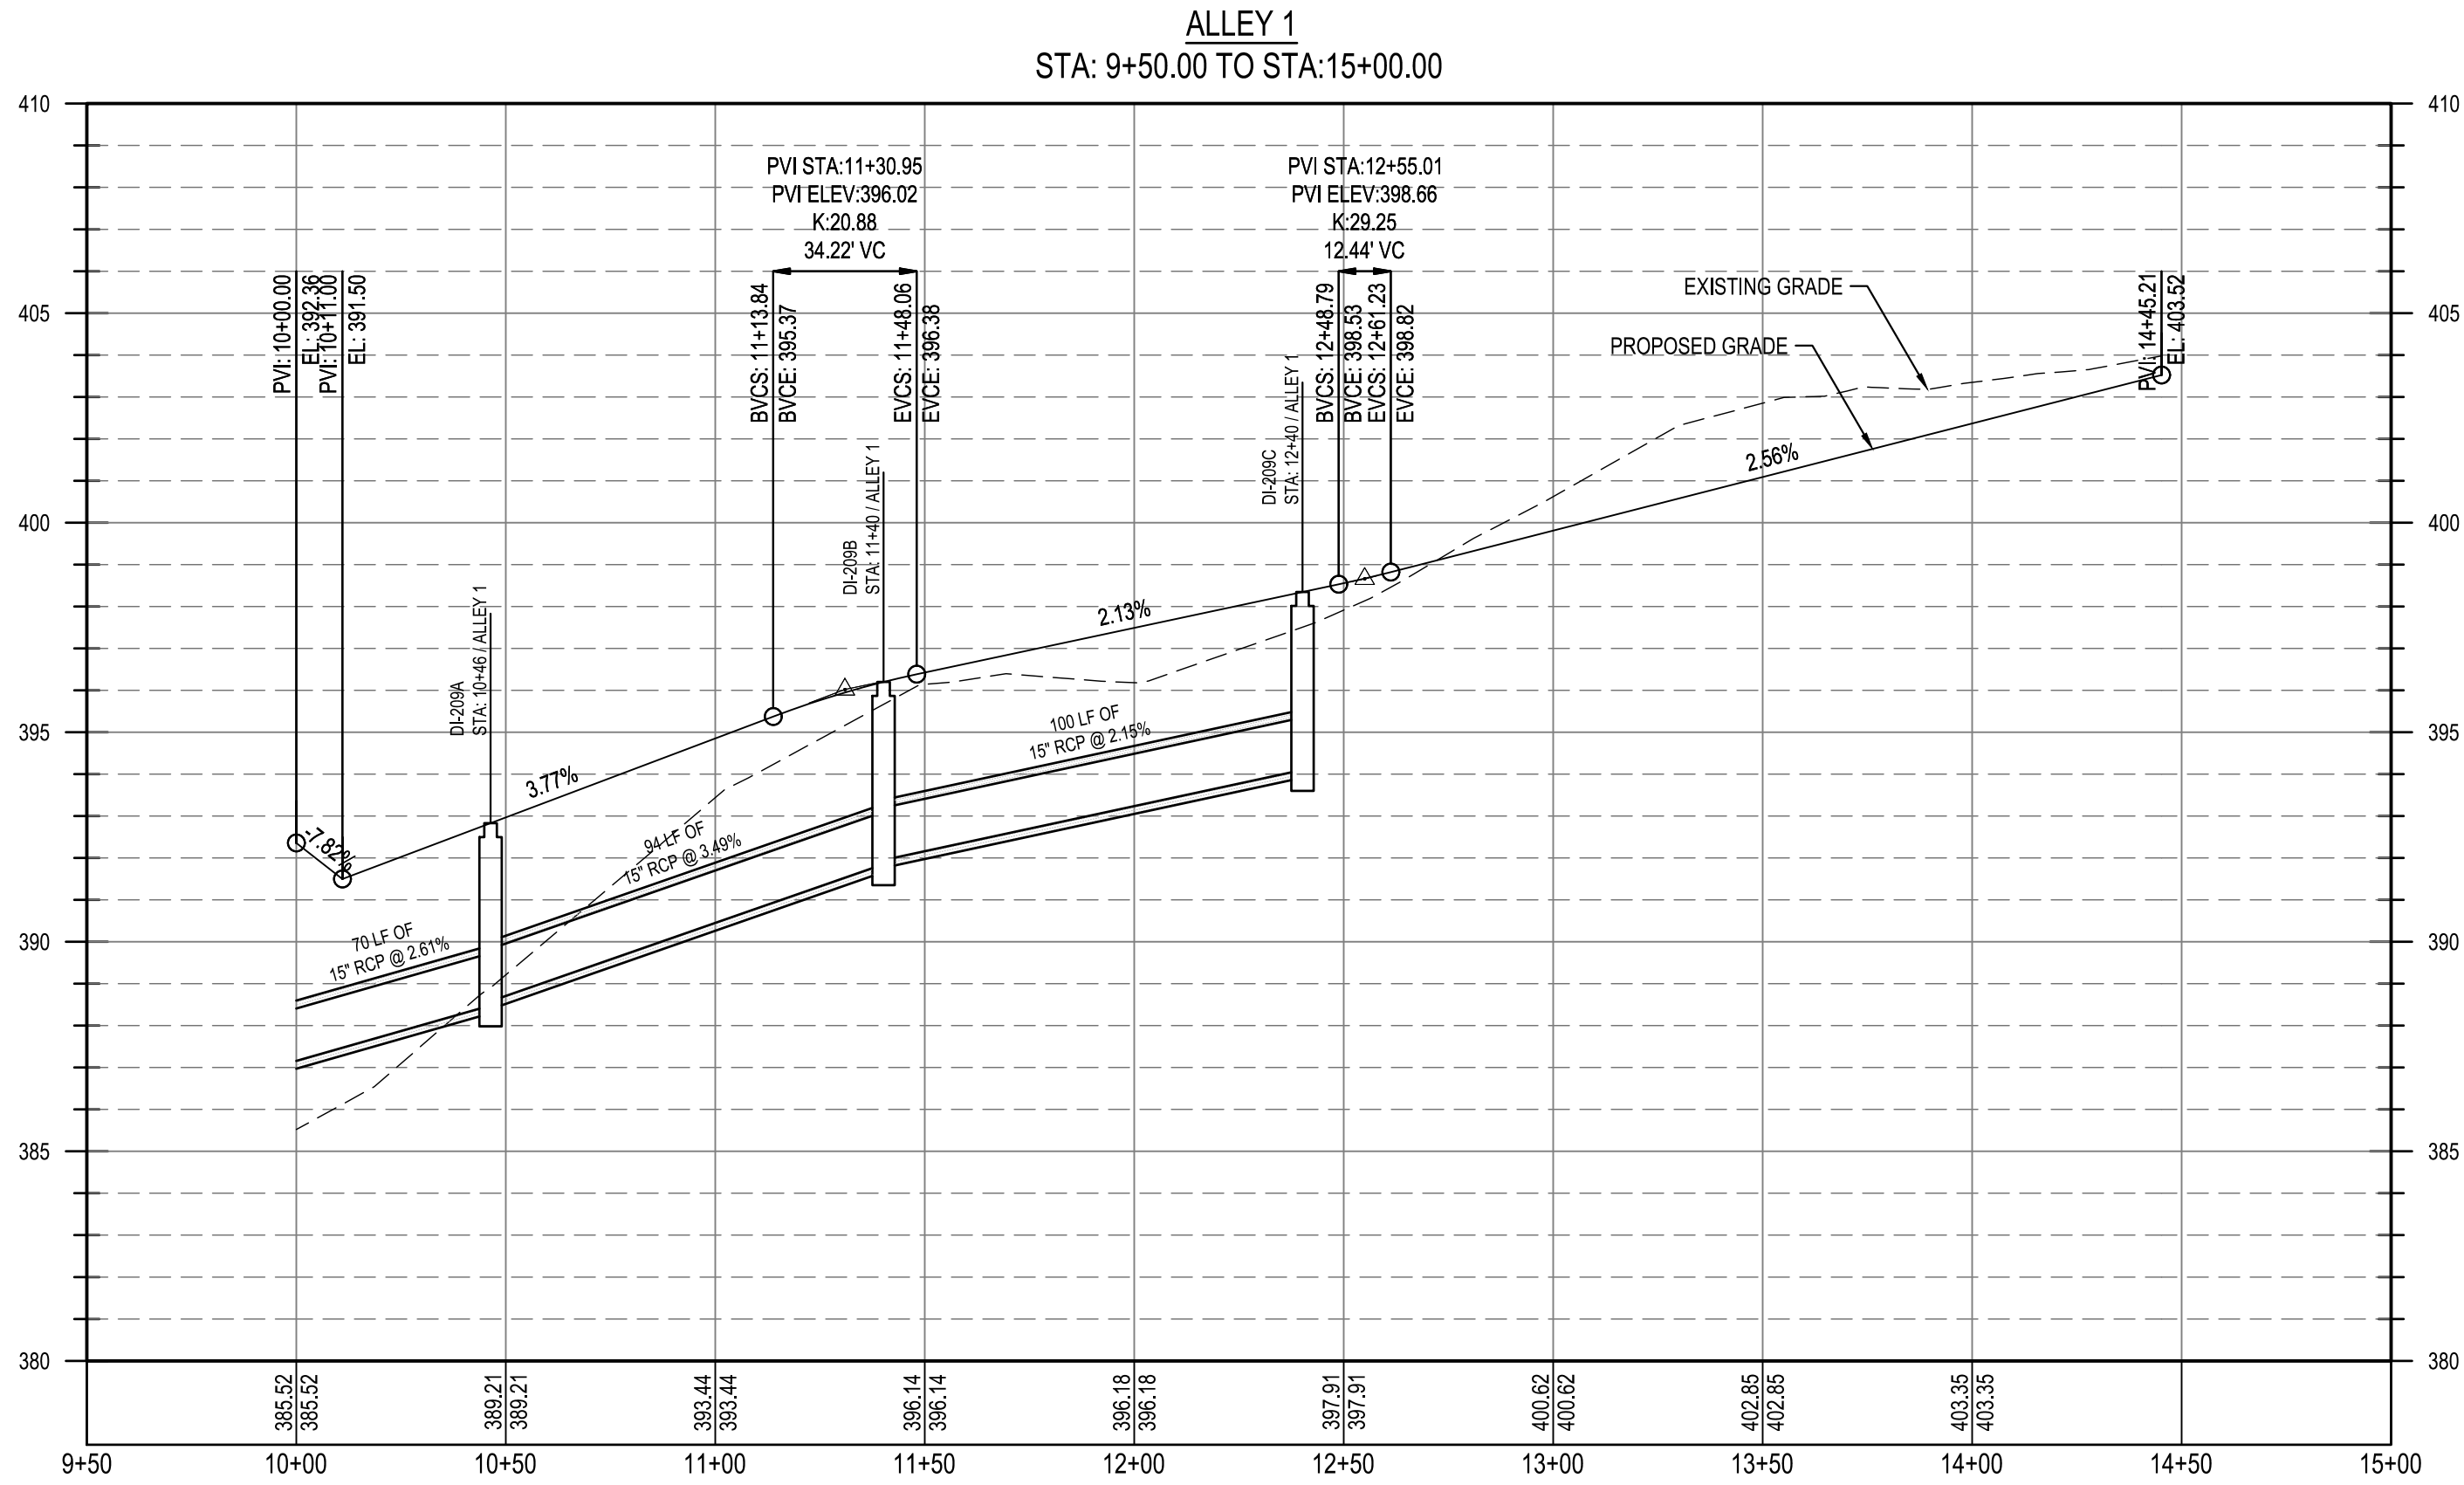


0 20' 40' 80'
SCALE: 1" = 40'

#142- Please show stationing on plan view



Know what's below.
Call before you dig.

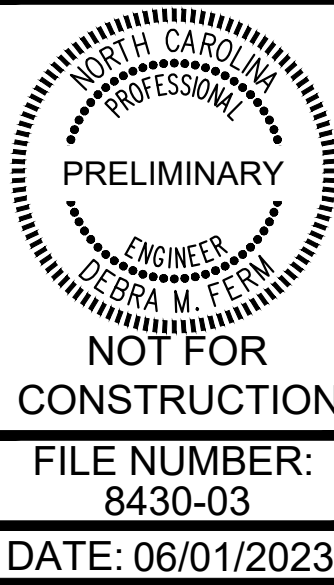

ALLEY 1 PLAN AND PROFILE




PARKER RIDGE
82 SCHOOL STREET
ROLESVILLE / NORTH CAROLINA / 27571

LENNAR
CORPORAION
1100 PERIMETER PARK DRIVE, SUITE 112
MORRISVILLE / NORTH CAROLINA / 27560

BCE
5440 WADE PARK BLVD, SUITE 102
RALEIGH NC 27607
WWW.BCEINC.COM
NC LICENSE #C-4397


DESIGNED BY: DF/CD
DRAWN BY: DF/JWM
REVIEWED BY: DF

REV	DATE	DESCRIPTION
06/01/2023	04/03/2023	PER TOWN OF ROLESVILLE COMMENT
06/01/2023	04/03/2023	INITIAL SUBMITTAL

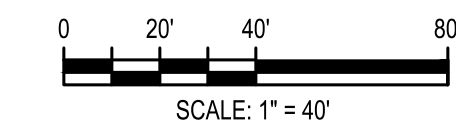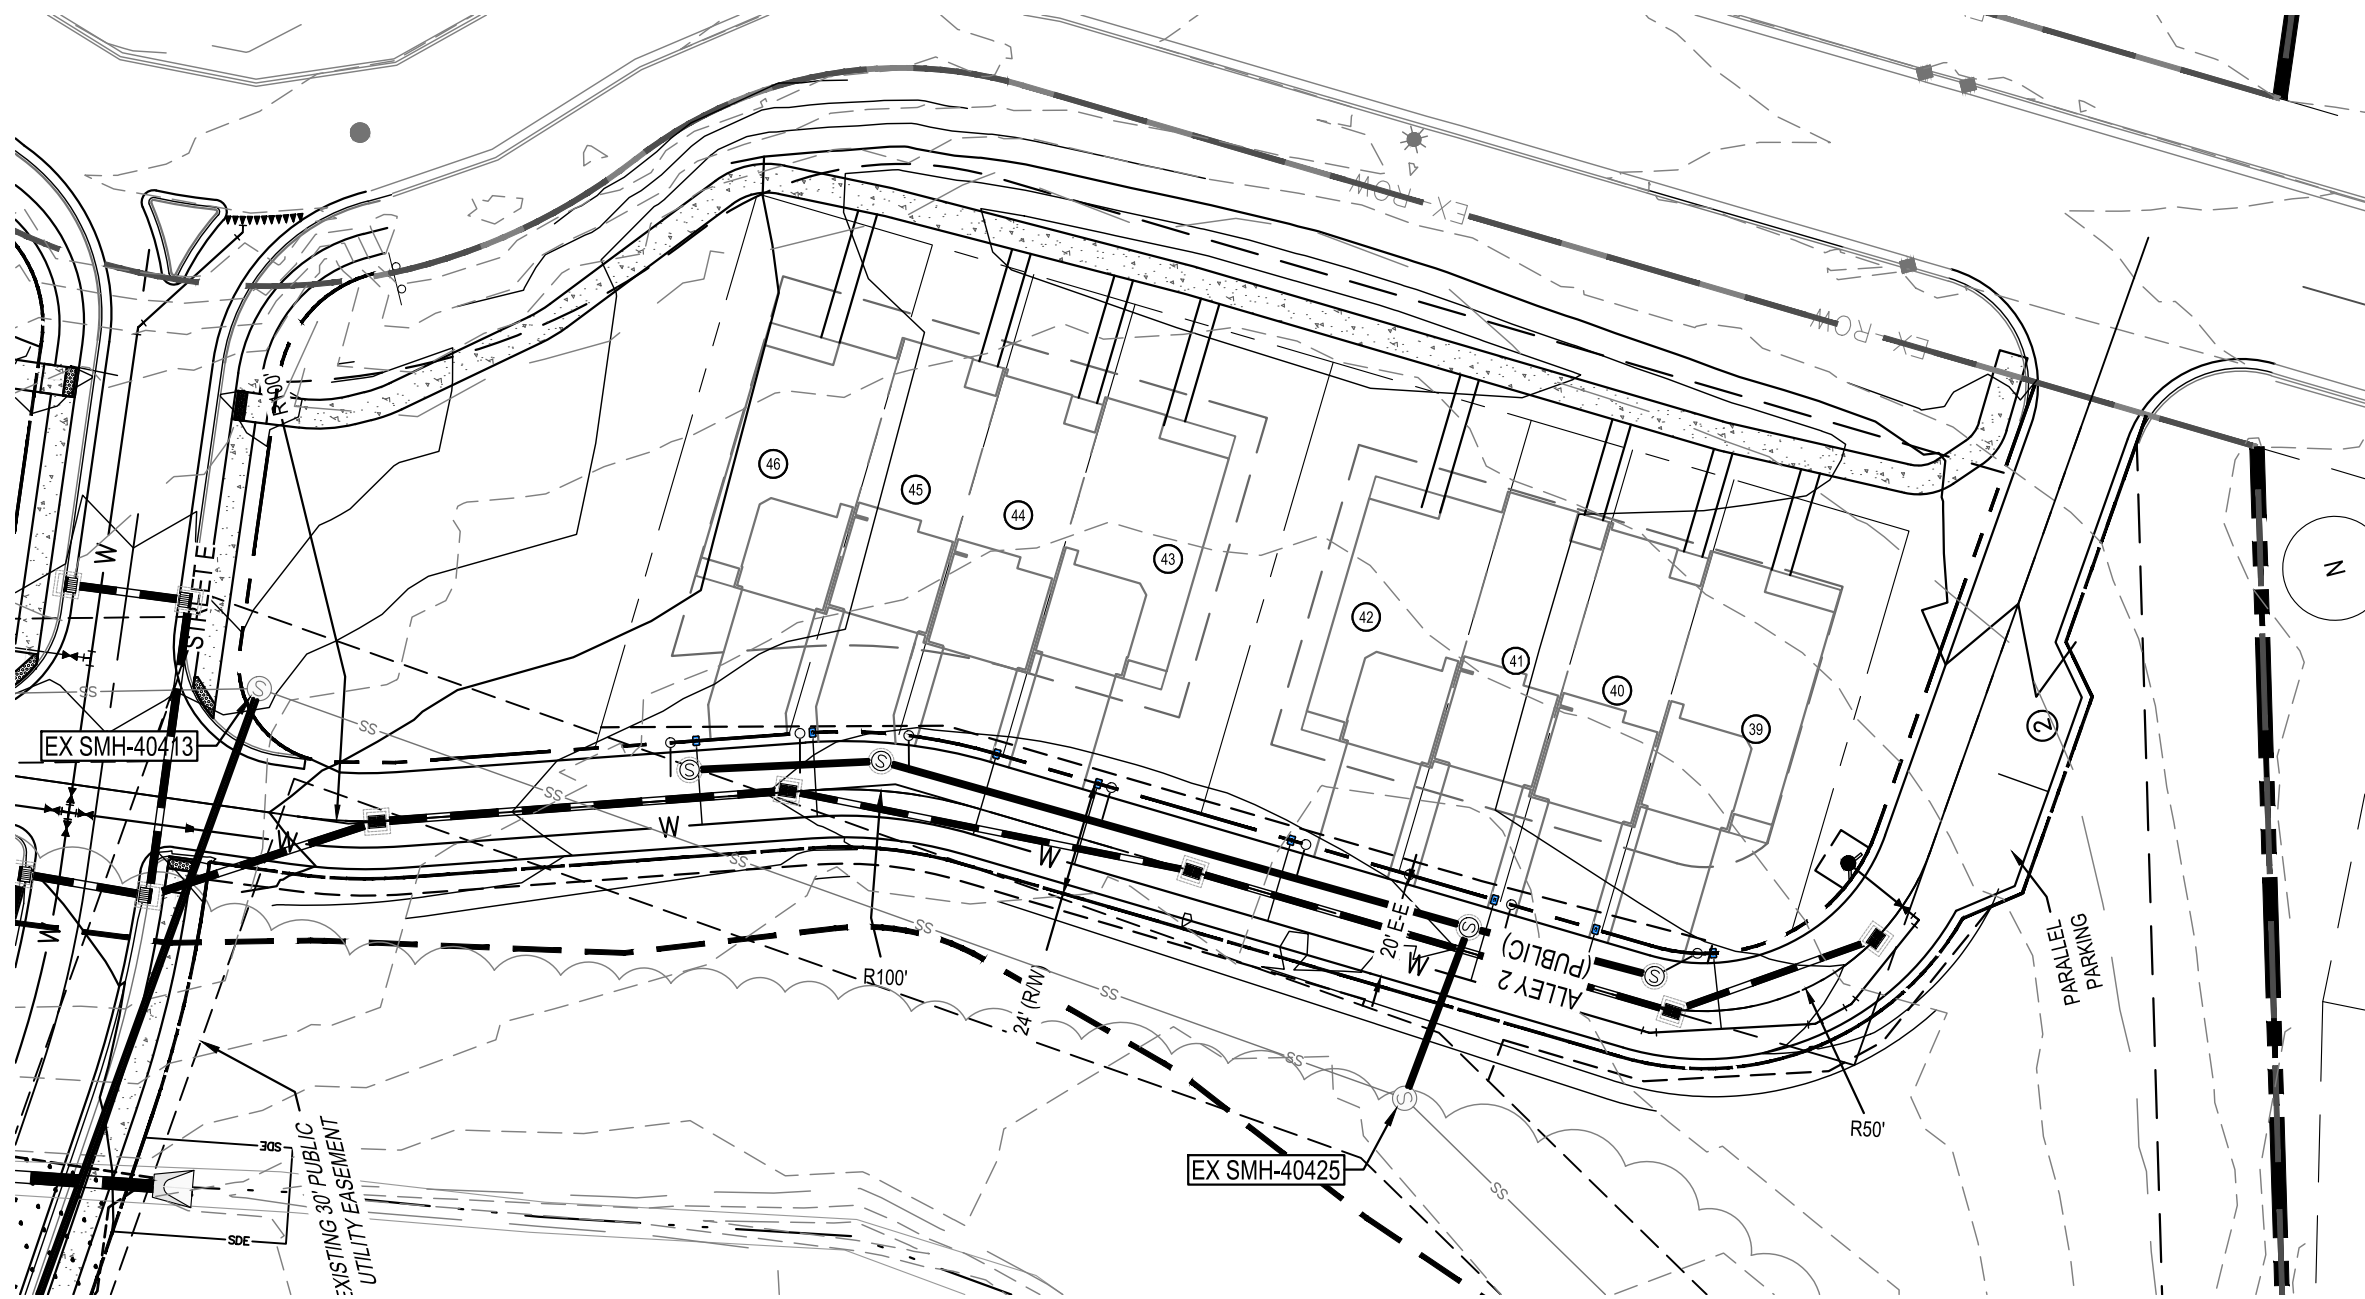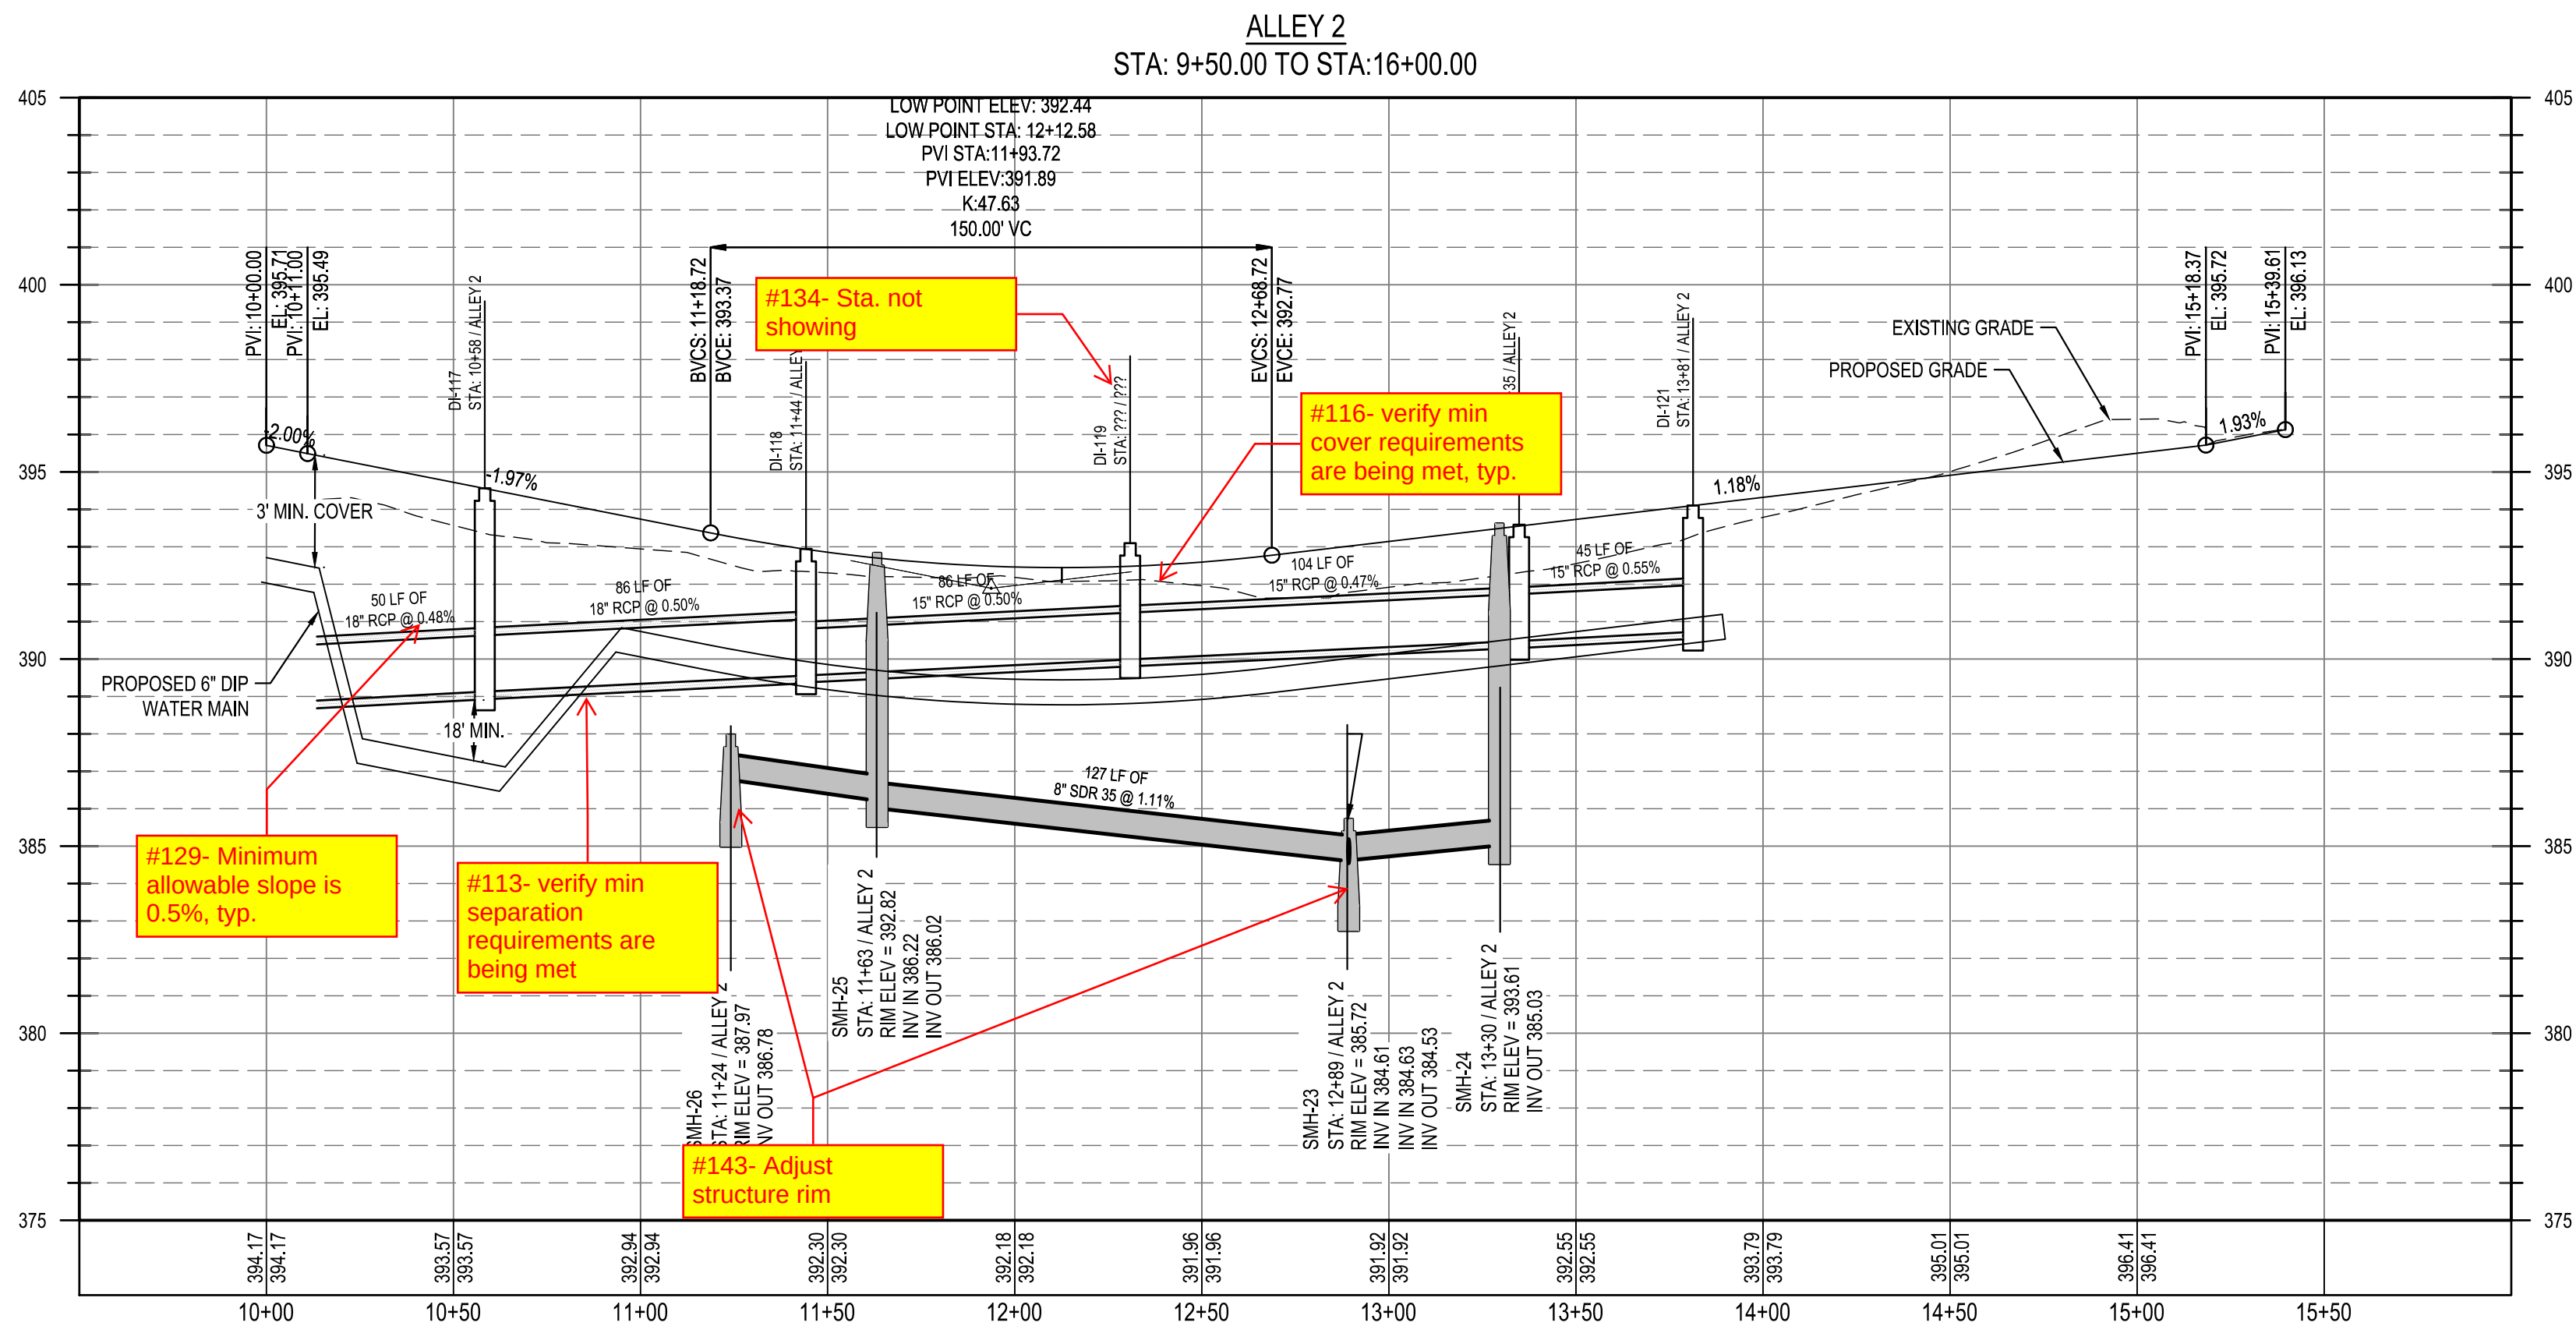

#142- Please show stationing on plan view

#138- Label structures in plan view

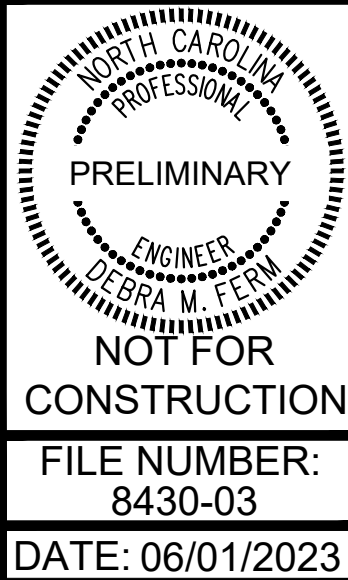

ALLEY 2 PLAN AND PROFILE

PARKER RIDGE
82 SCHOOL STREET
ROLESVILLE / NORTH CAROLINA / 27571

LENNAR
CORPORAION
1100 PERIMETER PARK DRIVE, SUITE 112
MORRISVILLE / NORTH CAROLINA / 27560

BCE
5440 WADE PARK BLVD, SUITE 102
RALEIGH NC 27607
WWW.BCEINC.COM
NC LICENSE #C-4397

DESIGNED BY: DF/CD
DRAWN BY: DF/JWM
REVIEWED BY: DF

REV	DATE	DESCRIPTION
06/01/2023	04/03/2023	PER TOWN OF ROLESVILLE COMMENT
06/01/2023	04/03/2023	INITIAL SUBMITTAL

**NOT FOR
CONSTRUCTION**


FILE NUMBER:
8430-03

DATE: 06/01/2023

ALLEY 3 PLAN AND PROFILE


ROLESVILLE / NORTH CAROLINA / 27571

1100 PERIMETER PARK DRIVE, SUITE 112
MORRISVILLE / NORTH CAROLINA / 27560

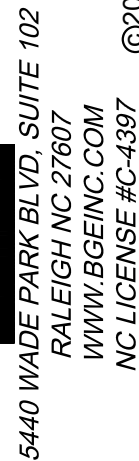




5

06/01/2023	PER TOWN OF ROSELAND
04/03/2023	INITIAL SUBMITTAL

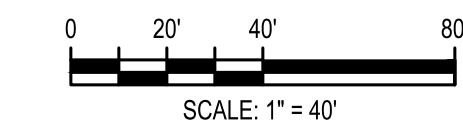

#142- Please show stationing on plan view

#138- Label structures in plan view

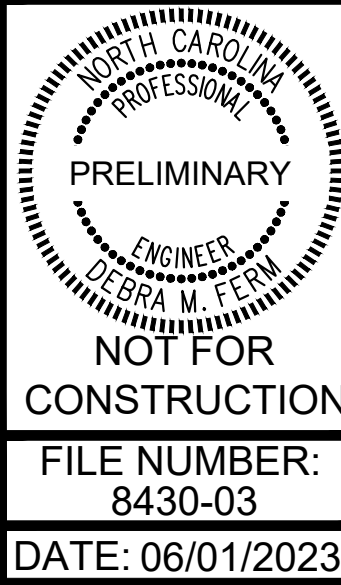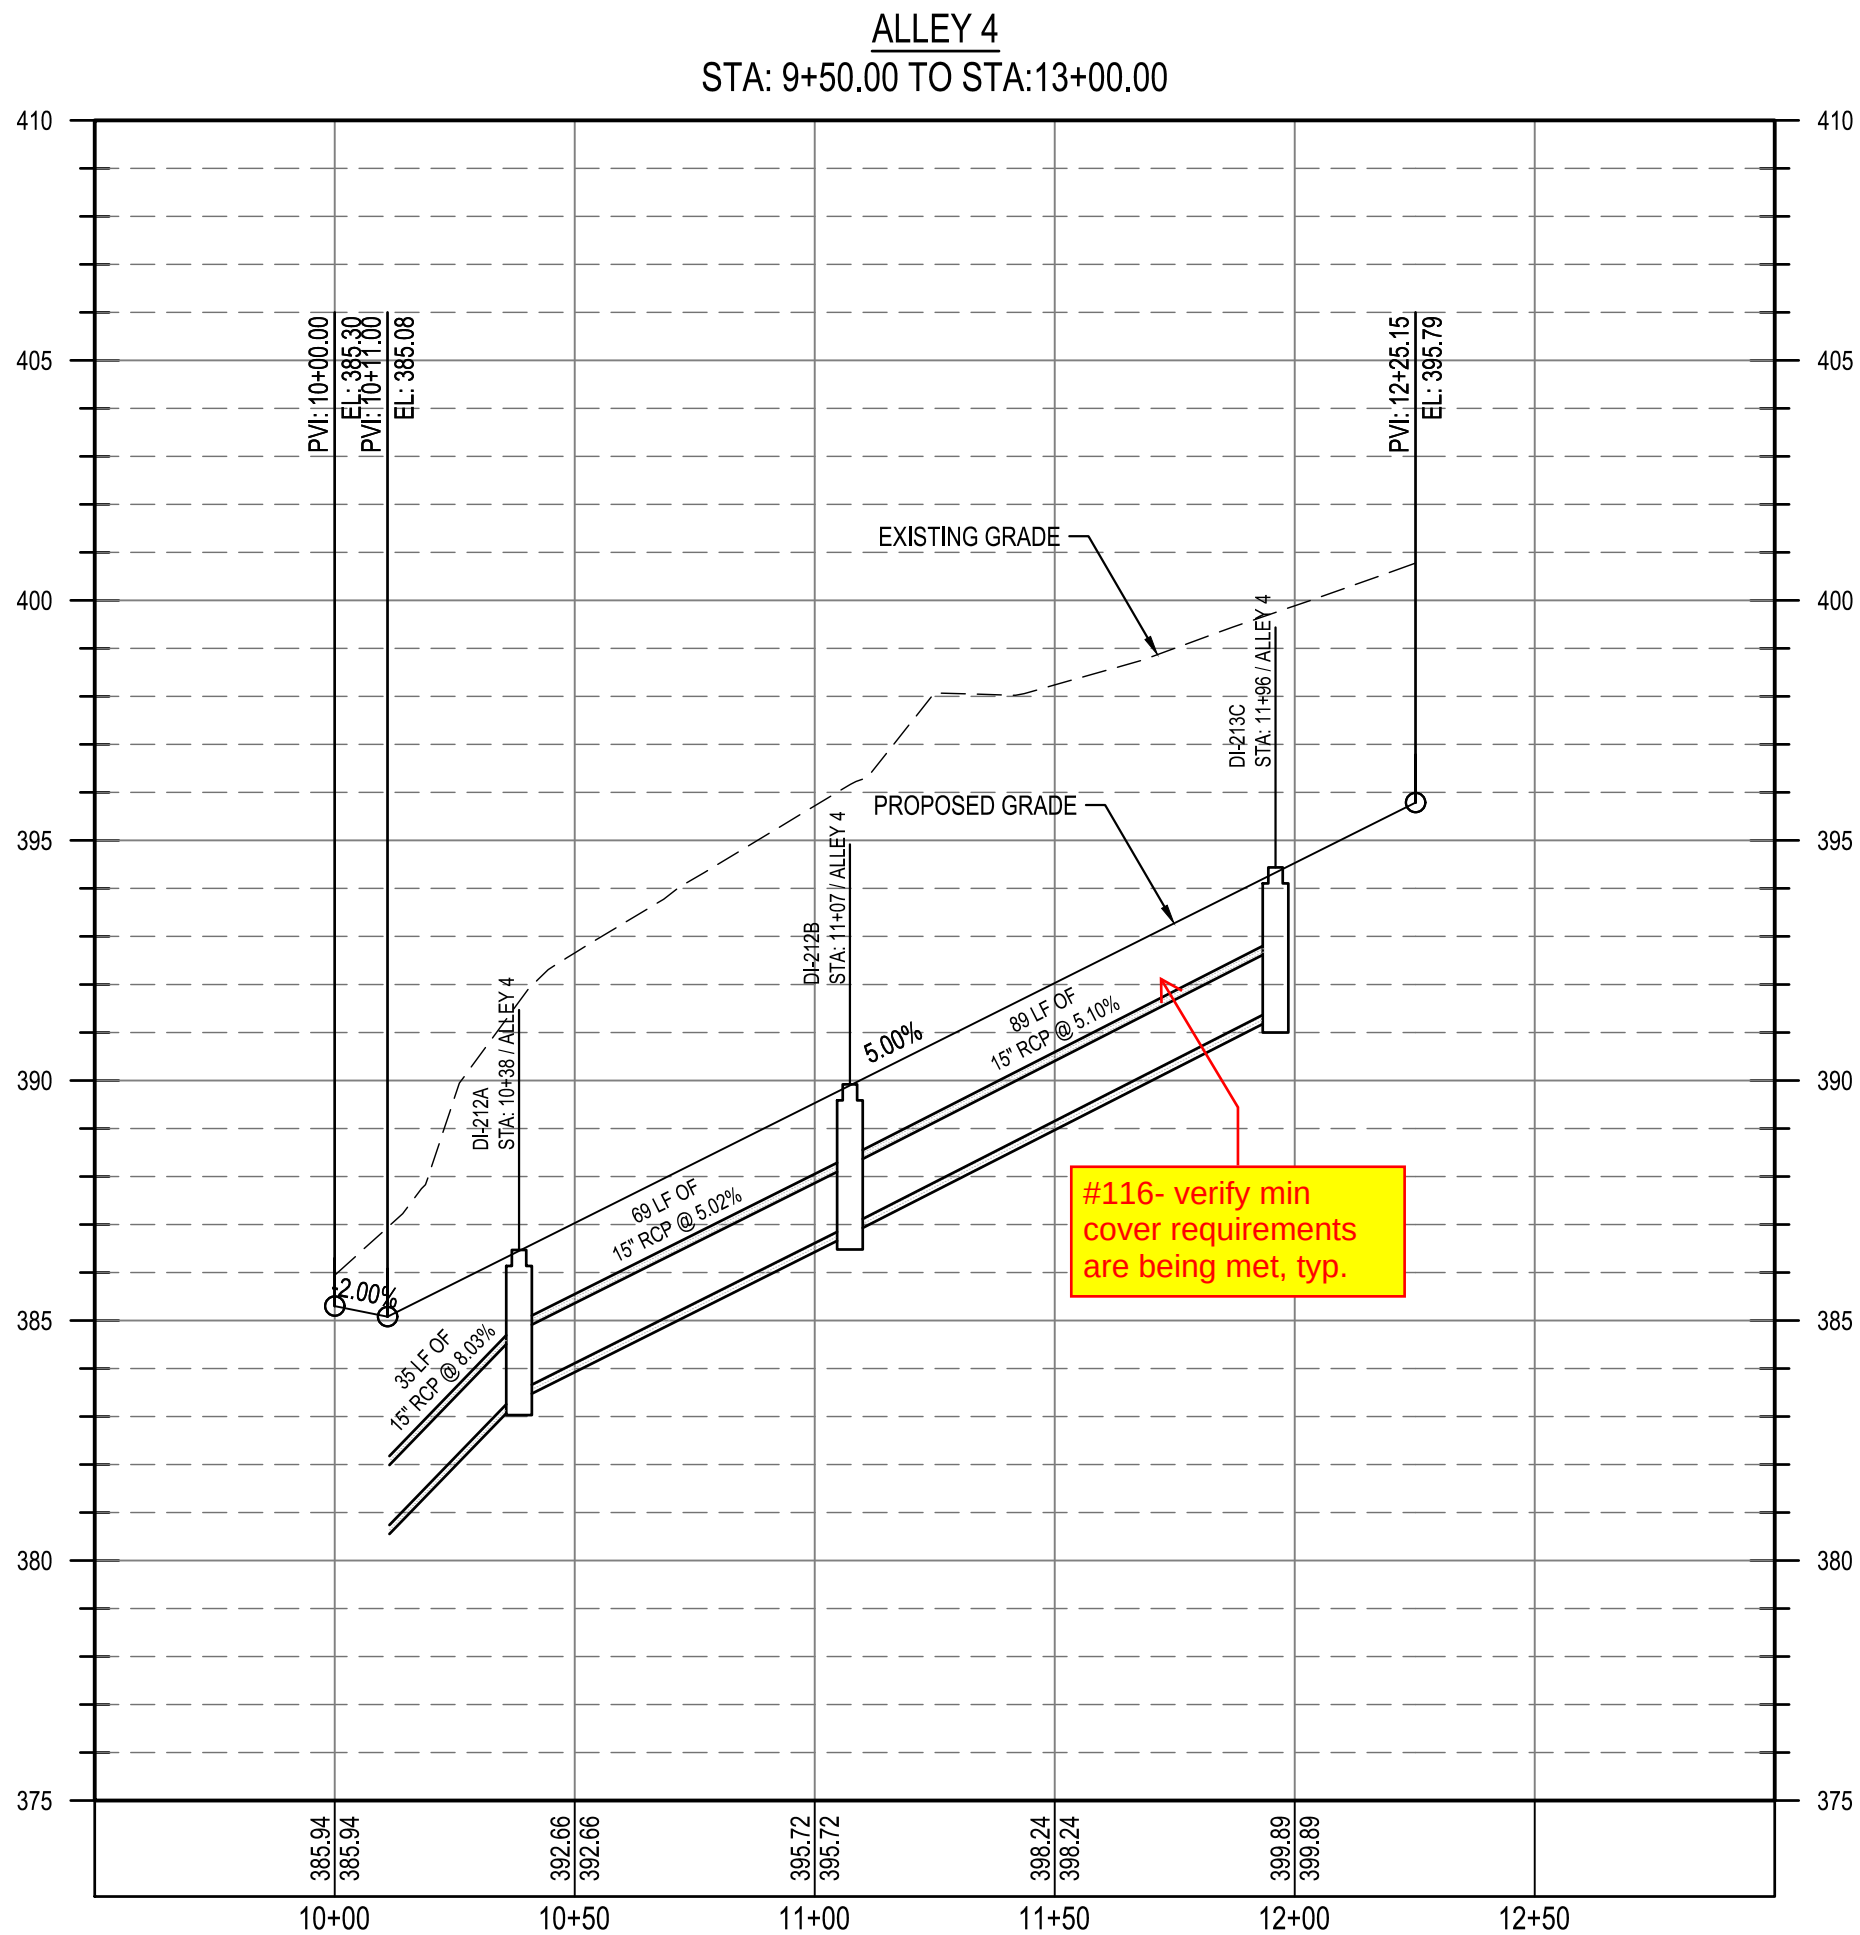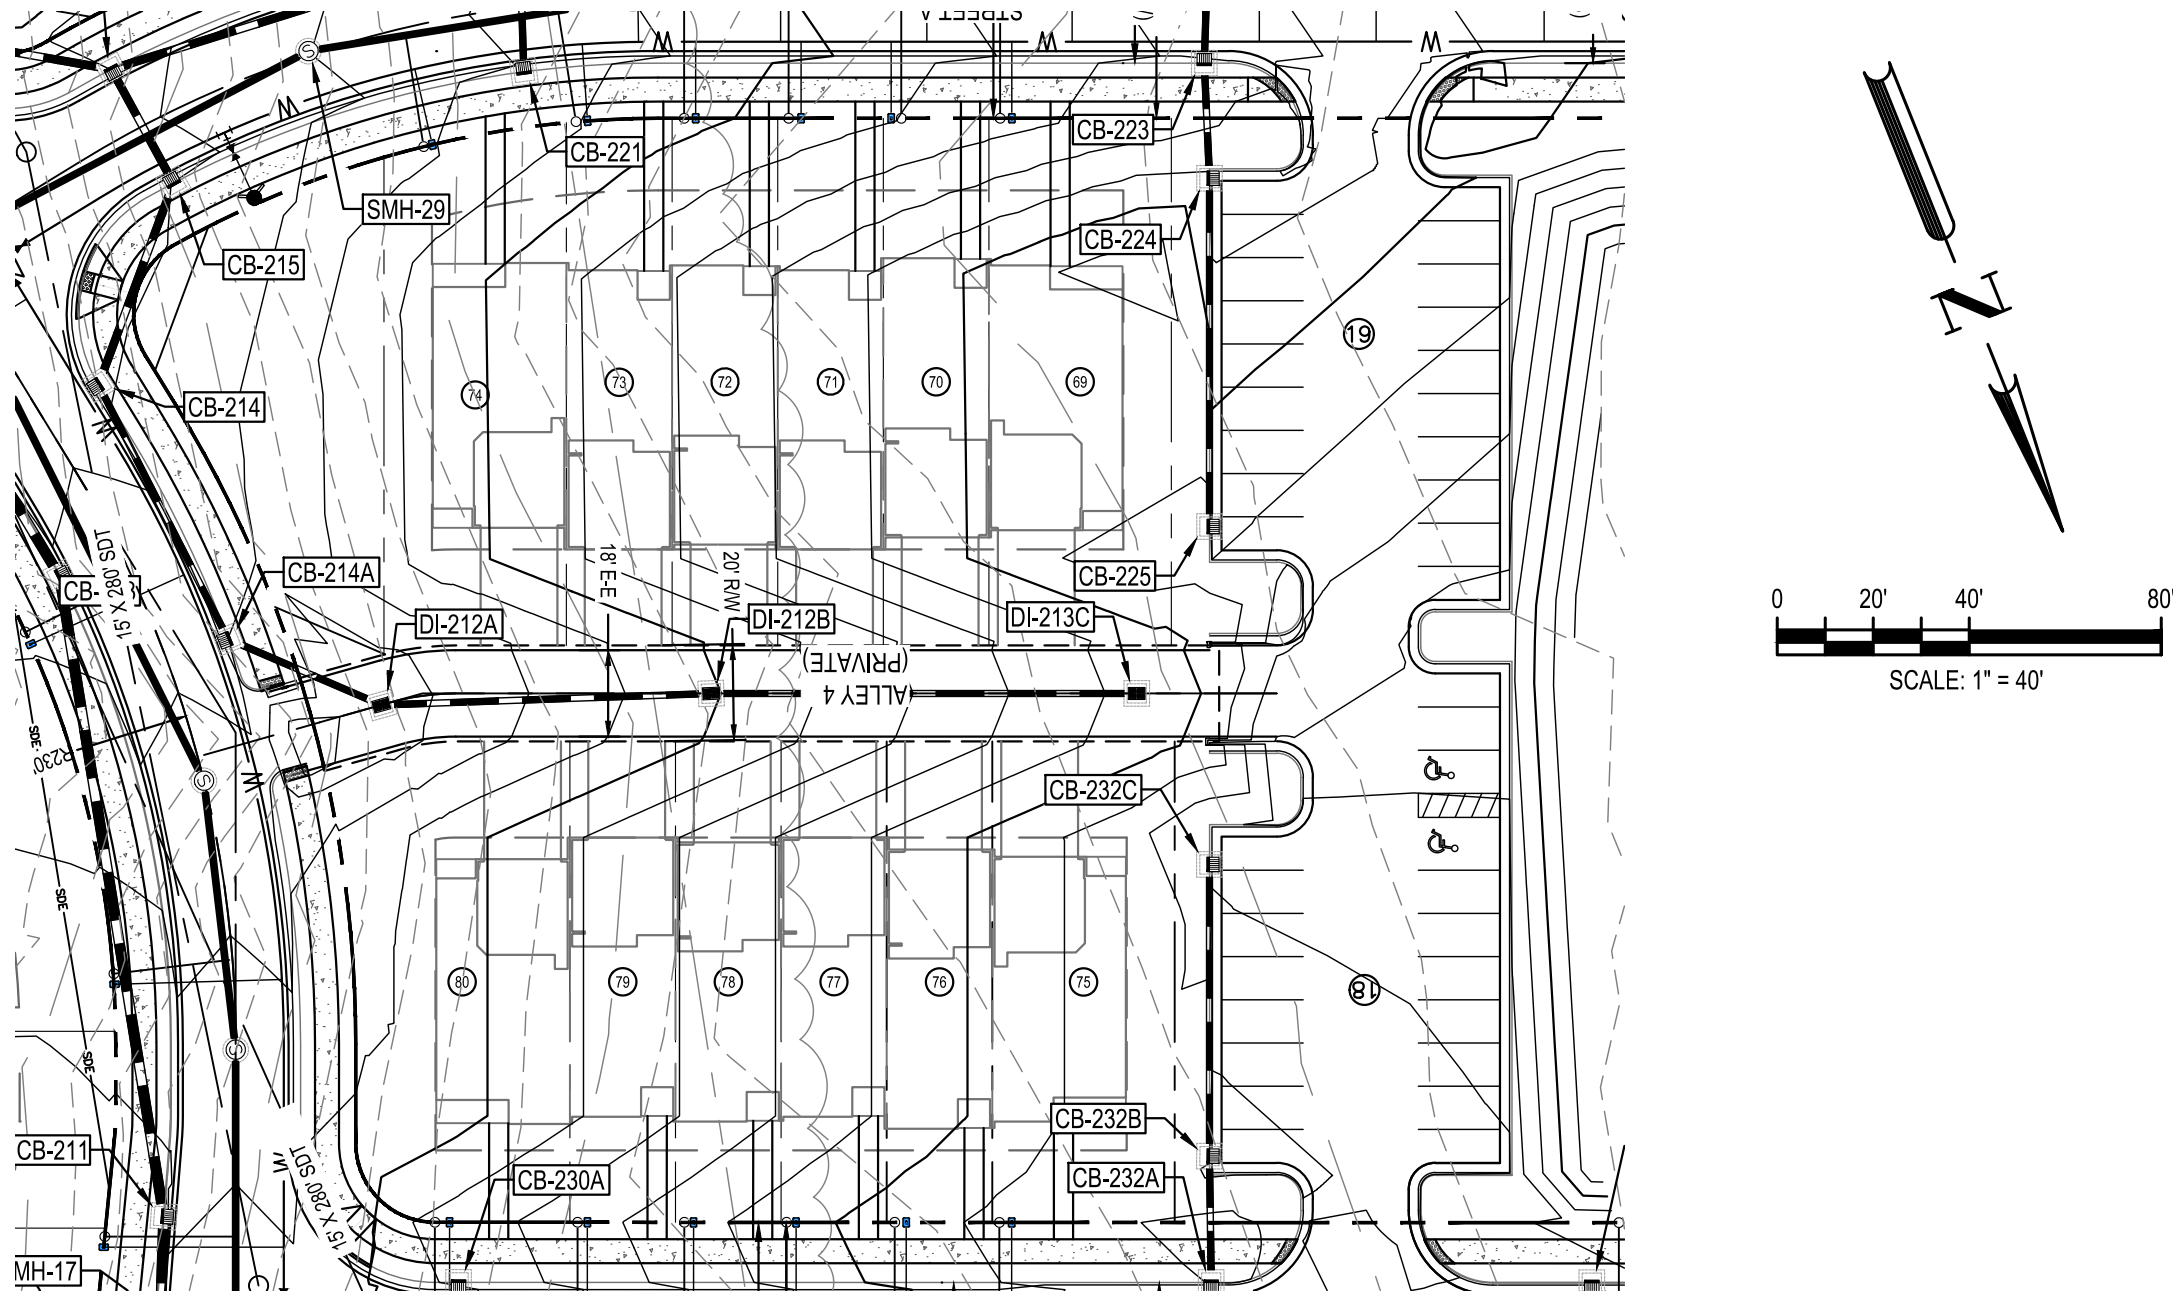

ALLEY 4 PLAN AND PROFILE

PARKER RIDGE
82 SCHOOL STREET
ROLESVILLE / NORTH CAROLINA / 27571

LENNAR
CORPORAION
1100 PERIMETER PARK DRIVE, SUITE 112
MORRISVILLE / NORTH CAROLINA / 27560

BCE
5440 WADE PARK BLVD, SUITE 102
RALEIGH NC 27607
WWW.BCEINC.COM
NC LICENSE #C-4397

DESIGNED BY: DF/CD
DRAWN BY: DF/JWM
REVIEWED BY: DF



REV 04/03/2023

06/01/2023 PER TOWN OF ROLESVILLE COMMENT

INITIAL SUBMITTAL




C6-17

\\browgway.net\panzura\Regions\NCA\Projects\Lennar\8430-03 - Lennar - School Street - Rolesville\03 - DWG\PlanSheets\On-Site\C6-18 GREENWAY PLAN AND PROFILE.dwg Layout: GW1A GREENWAY PLAN AND PROFILE (1 OF 2) Plotted: 6/1/2023 3:33:35 PM

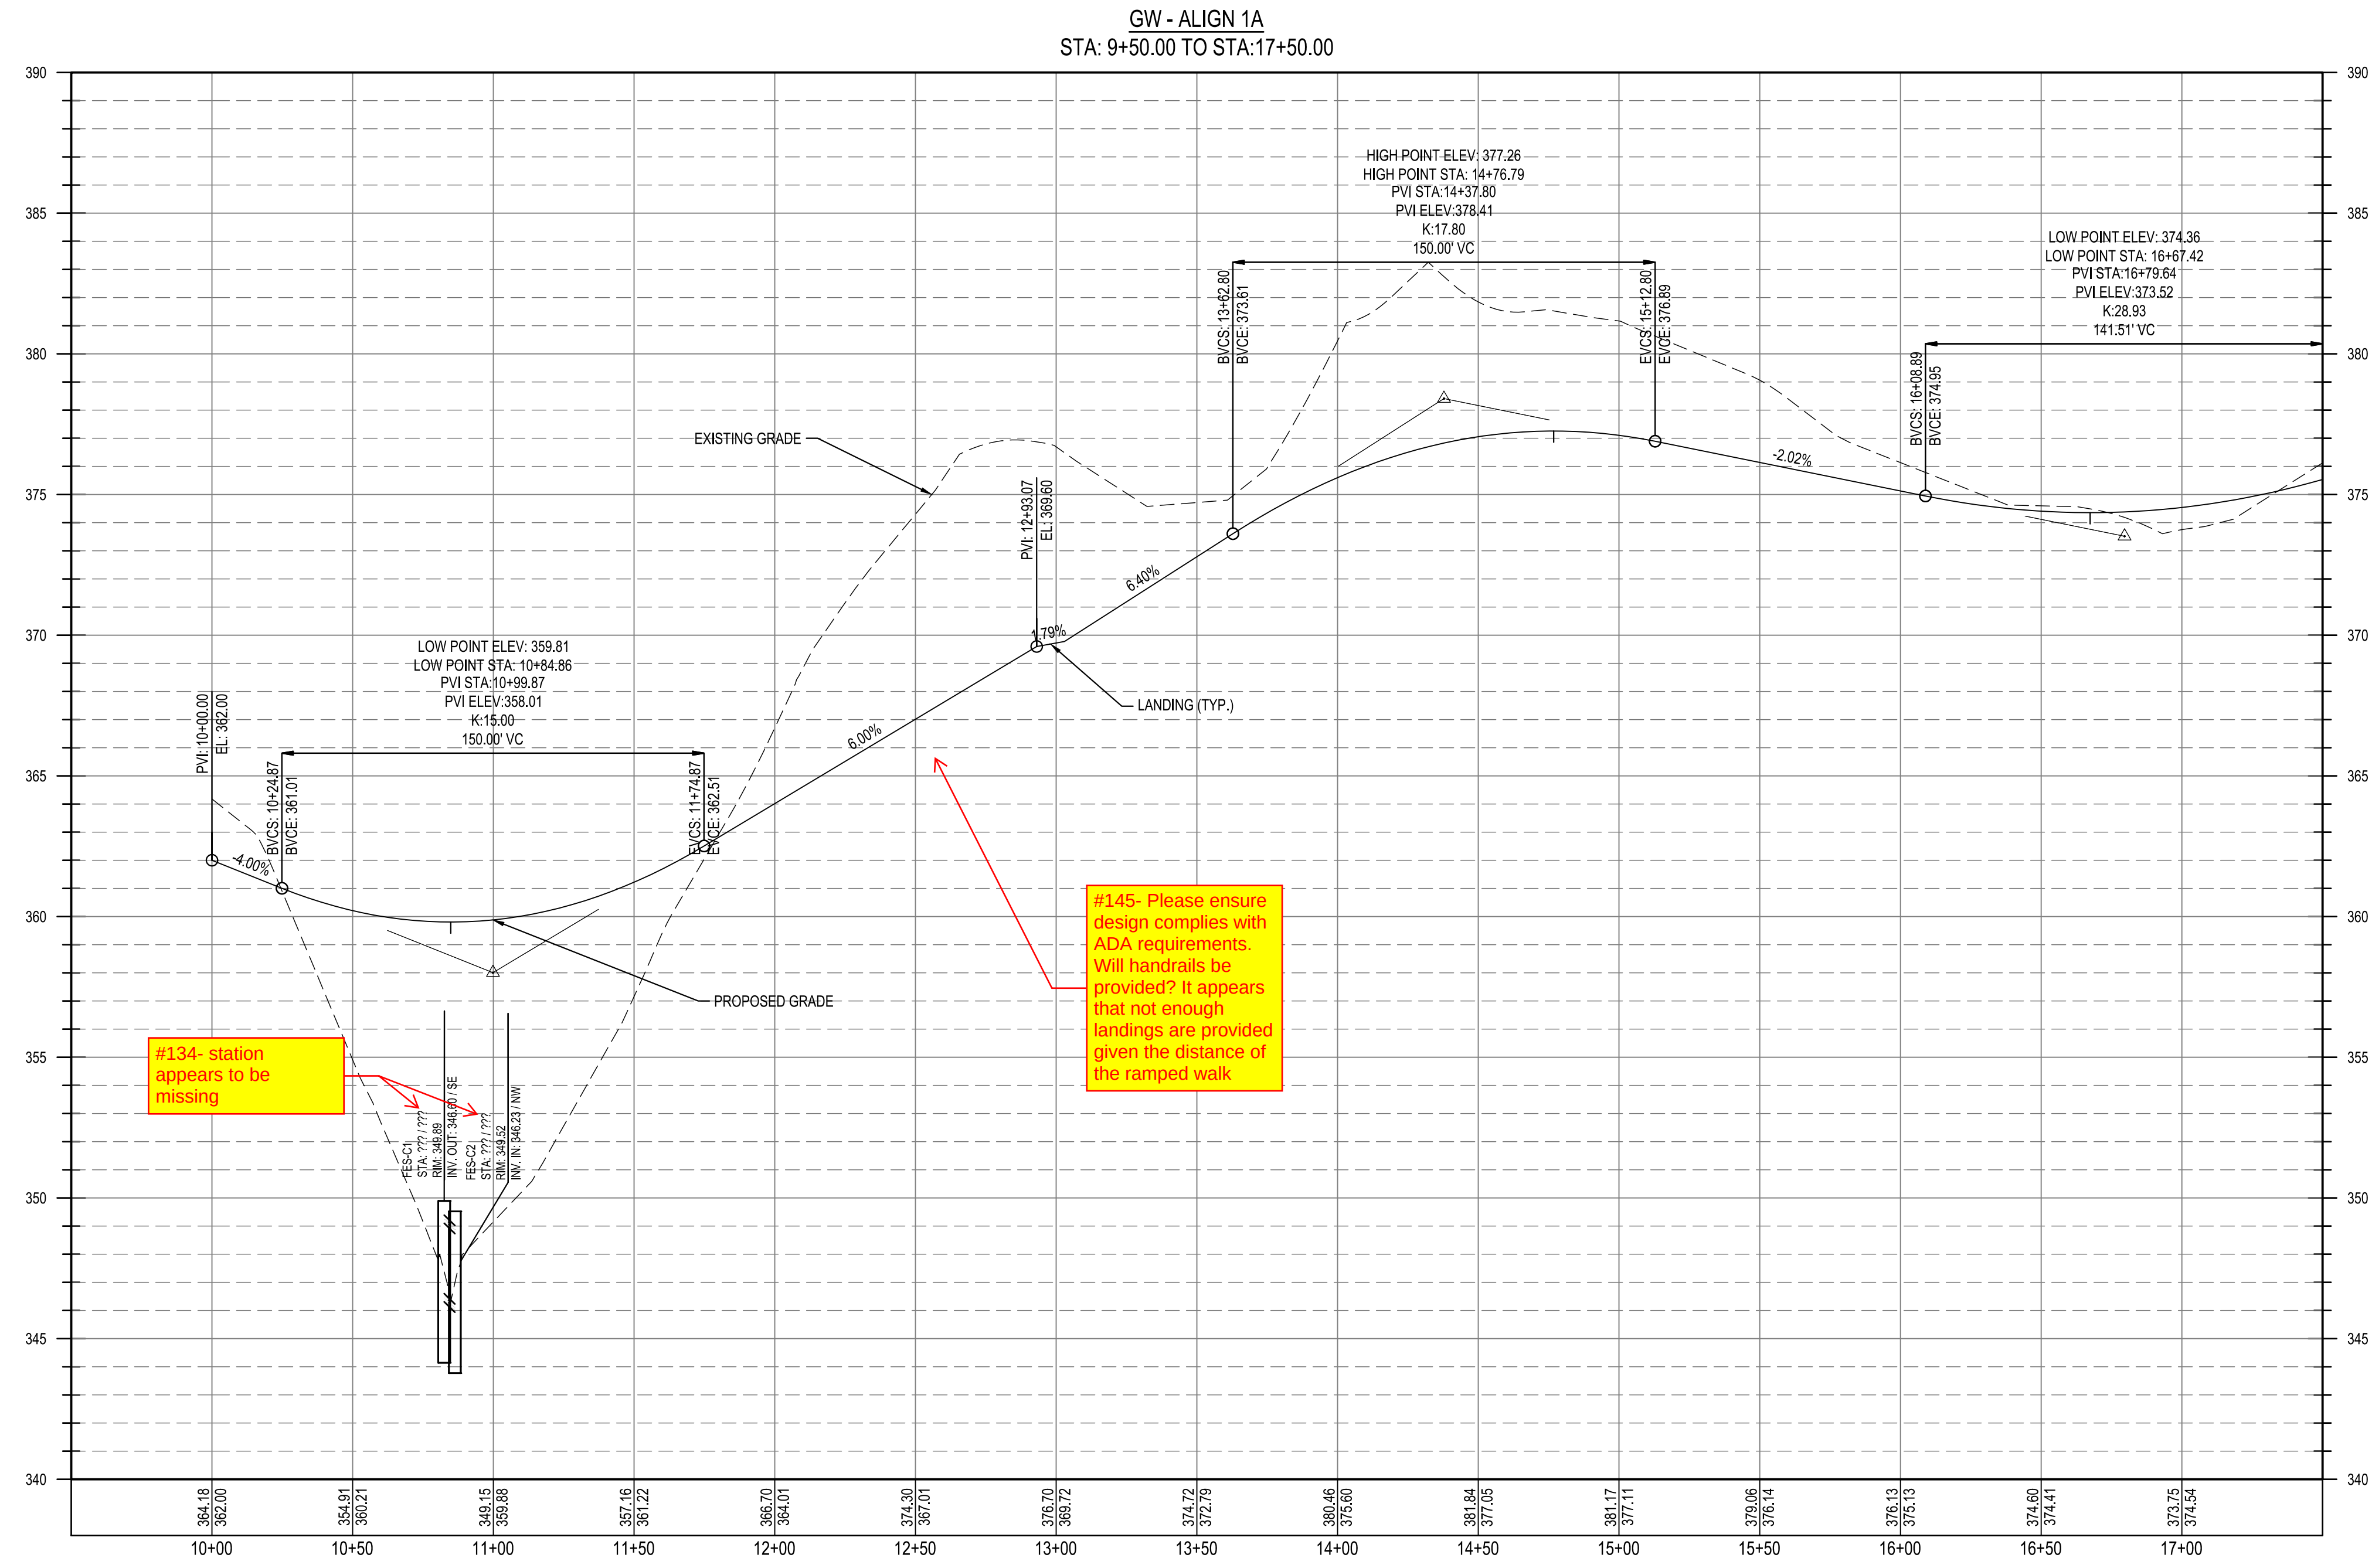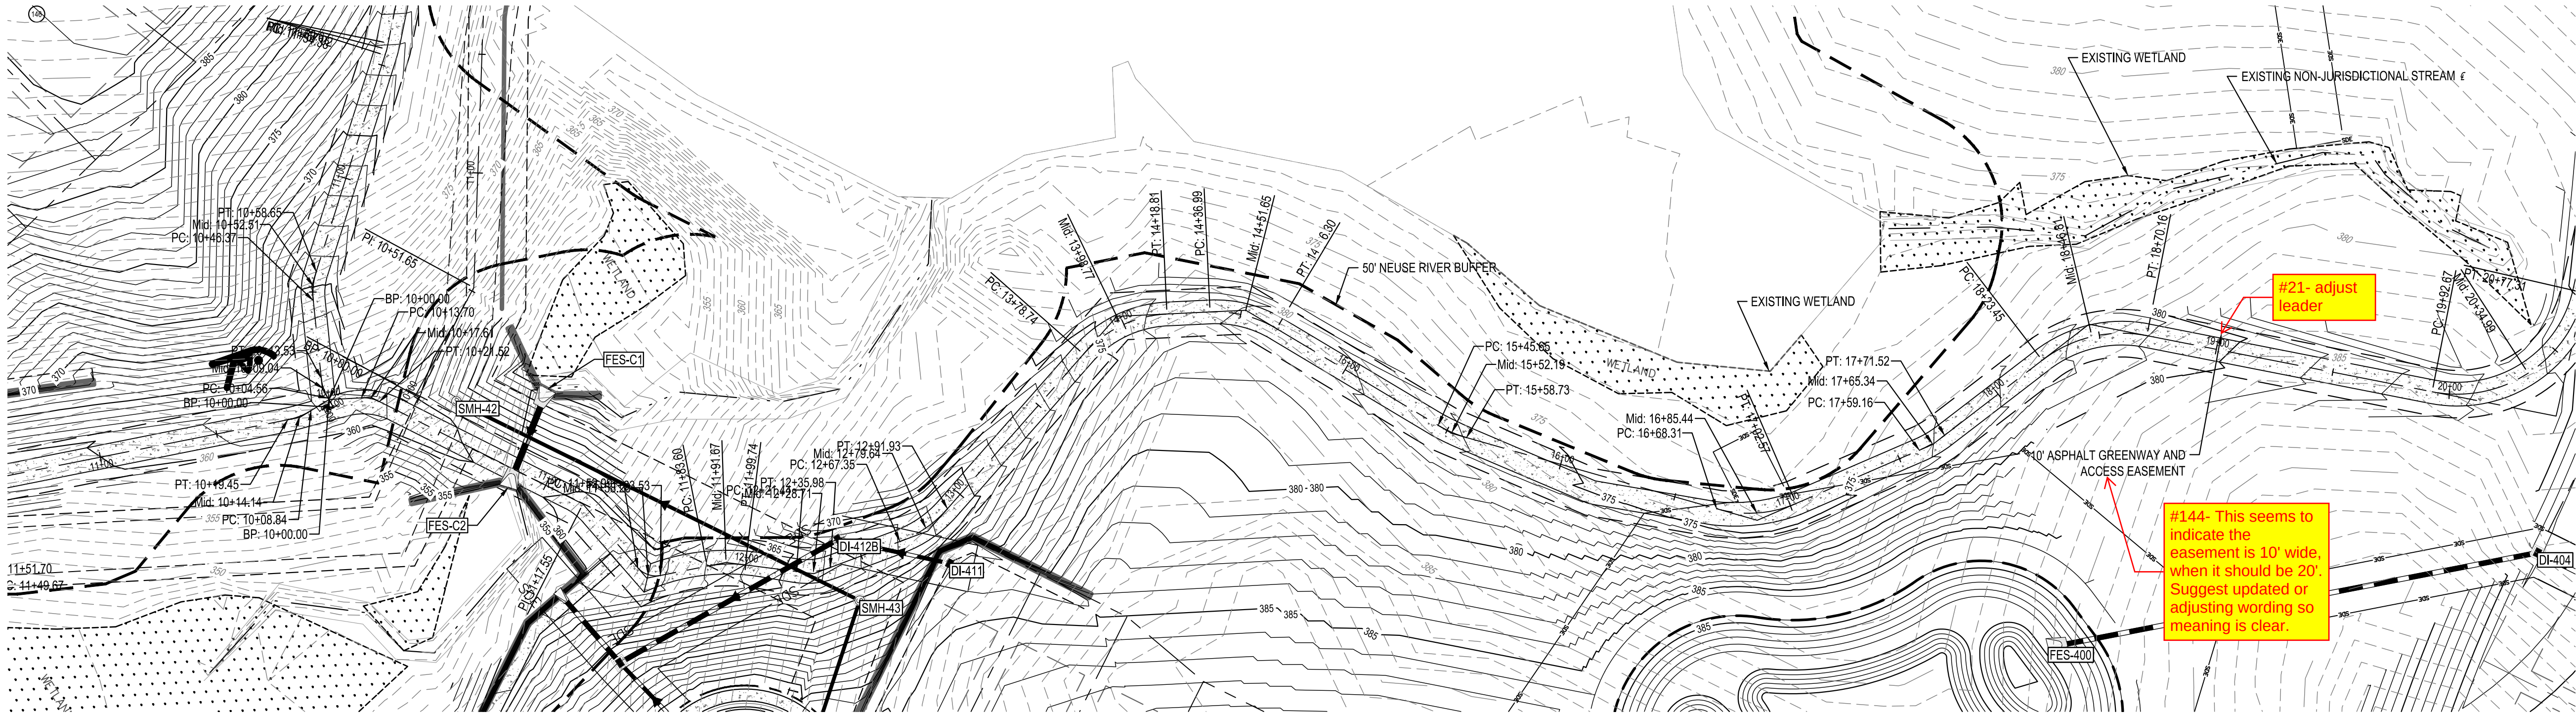

DESIGNED BY: DF/CD		PER TOWN OF ROLESVILLE COMMENT	
DRAWN BY: DF/JWM		INITIAL SUBMITTAL	
REVIEWED BY: DF		REV 04/03/2023	
BCE		06/01/2023	
5440 WADE PARK BLVD, SUITE 102 RALEIGH NC 27607 WWW.BCEINC.COM NC LICENSE #C-4397		REV 04/03/2023	
LENNAR CORPORAION		1100 PERMETER PARK DRIVE, SUITE 112 MORRISVILLE / NORTH CAROLINA / 27560	
PARKER RIDGE		82 SCHOOL STREET ROLESVILLE / NORTH CAROLINA / 27571	
GW1A GREENWAY PLAN AND PROFILE (1 OF 2)		PRELIMINARY	
FILE NUMBER: 8430-03		NOT FOR CONSTRUCTION	
DATE: 06/01/2023		ENGINEER: DEBRA M. FERN	
C6-18		DATE: 06/01/2023	



\\browgway.net\panzura\Regions\NCA\Projects\Lennar\8430-03 - Lennar - School Street - Rolesville\03 - DWG\PlanSheets\On-Site\C6-18 GREENWAY PLAN AND PROFILE.dwg Layout: GW1A GREENWAY PLAN AND PROFILE (2 OF 2) Plotted: 6/1/2023 3:33:43 PM

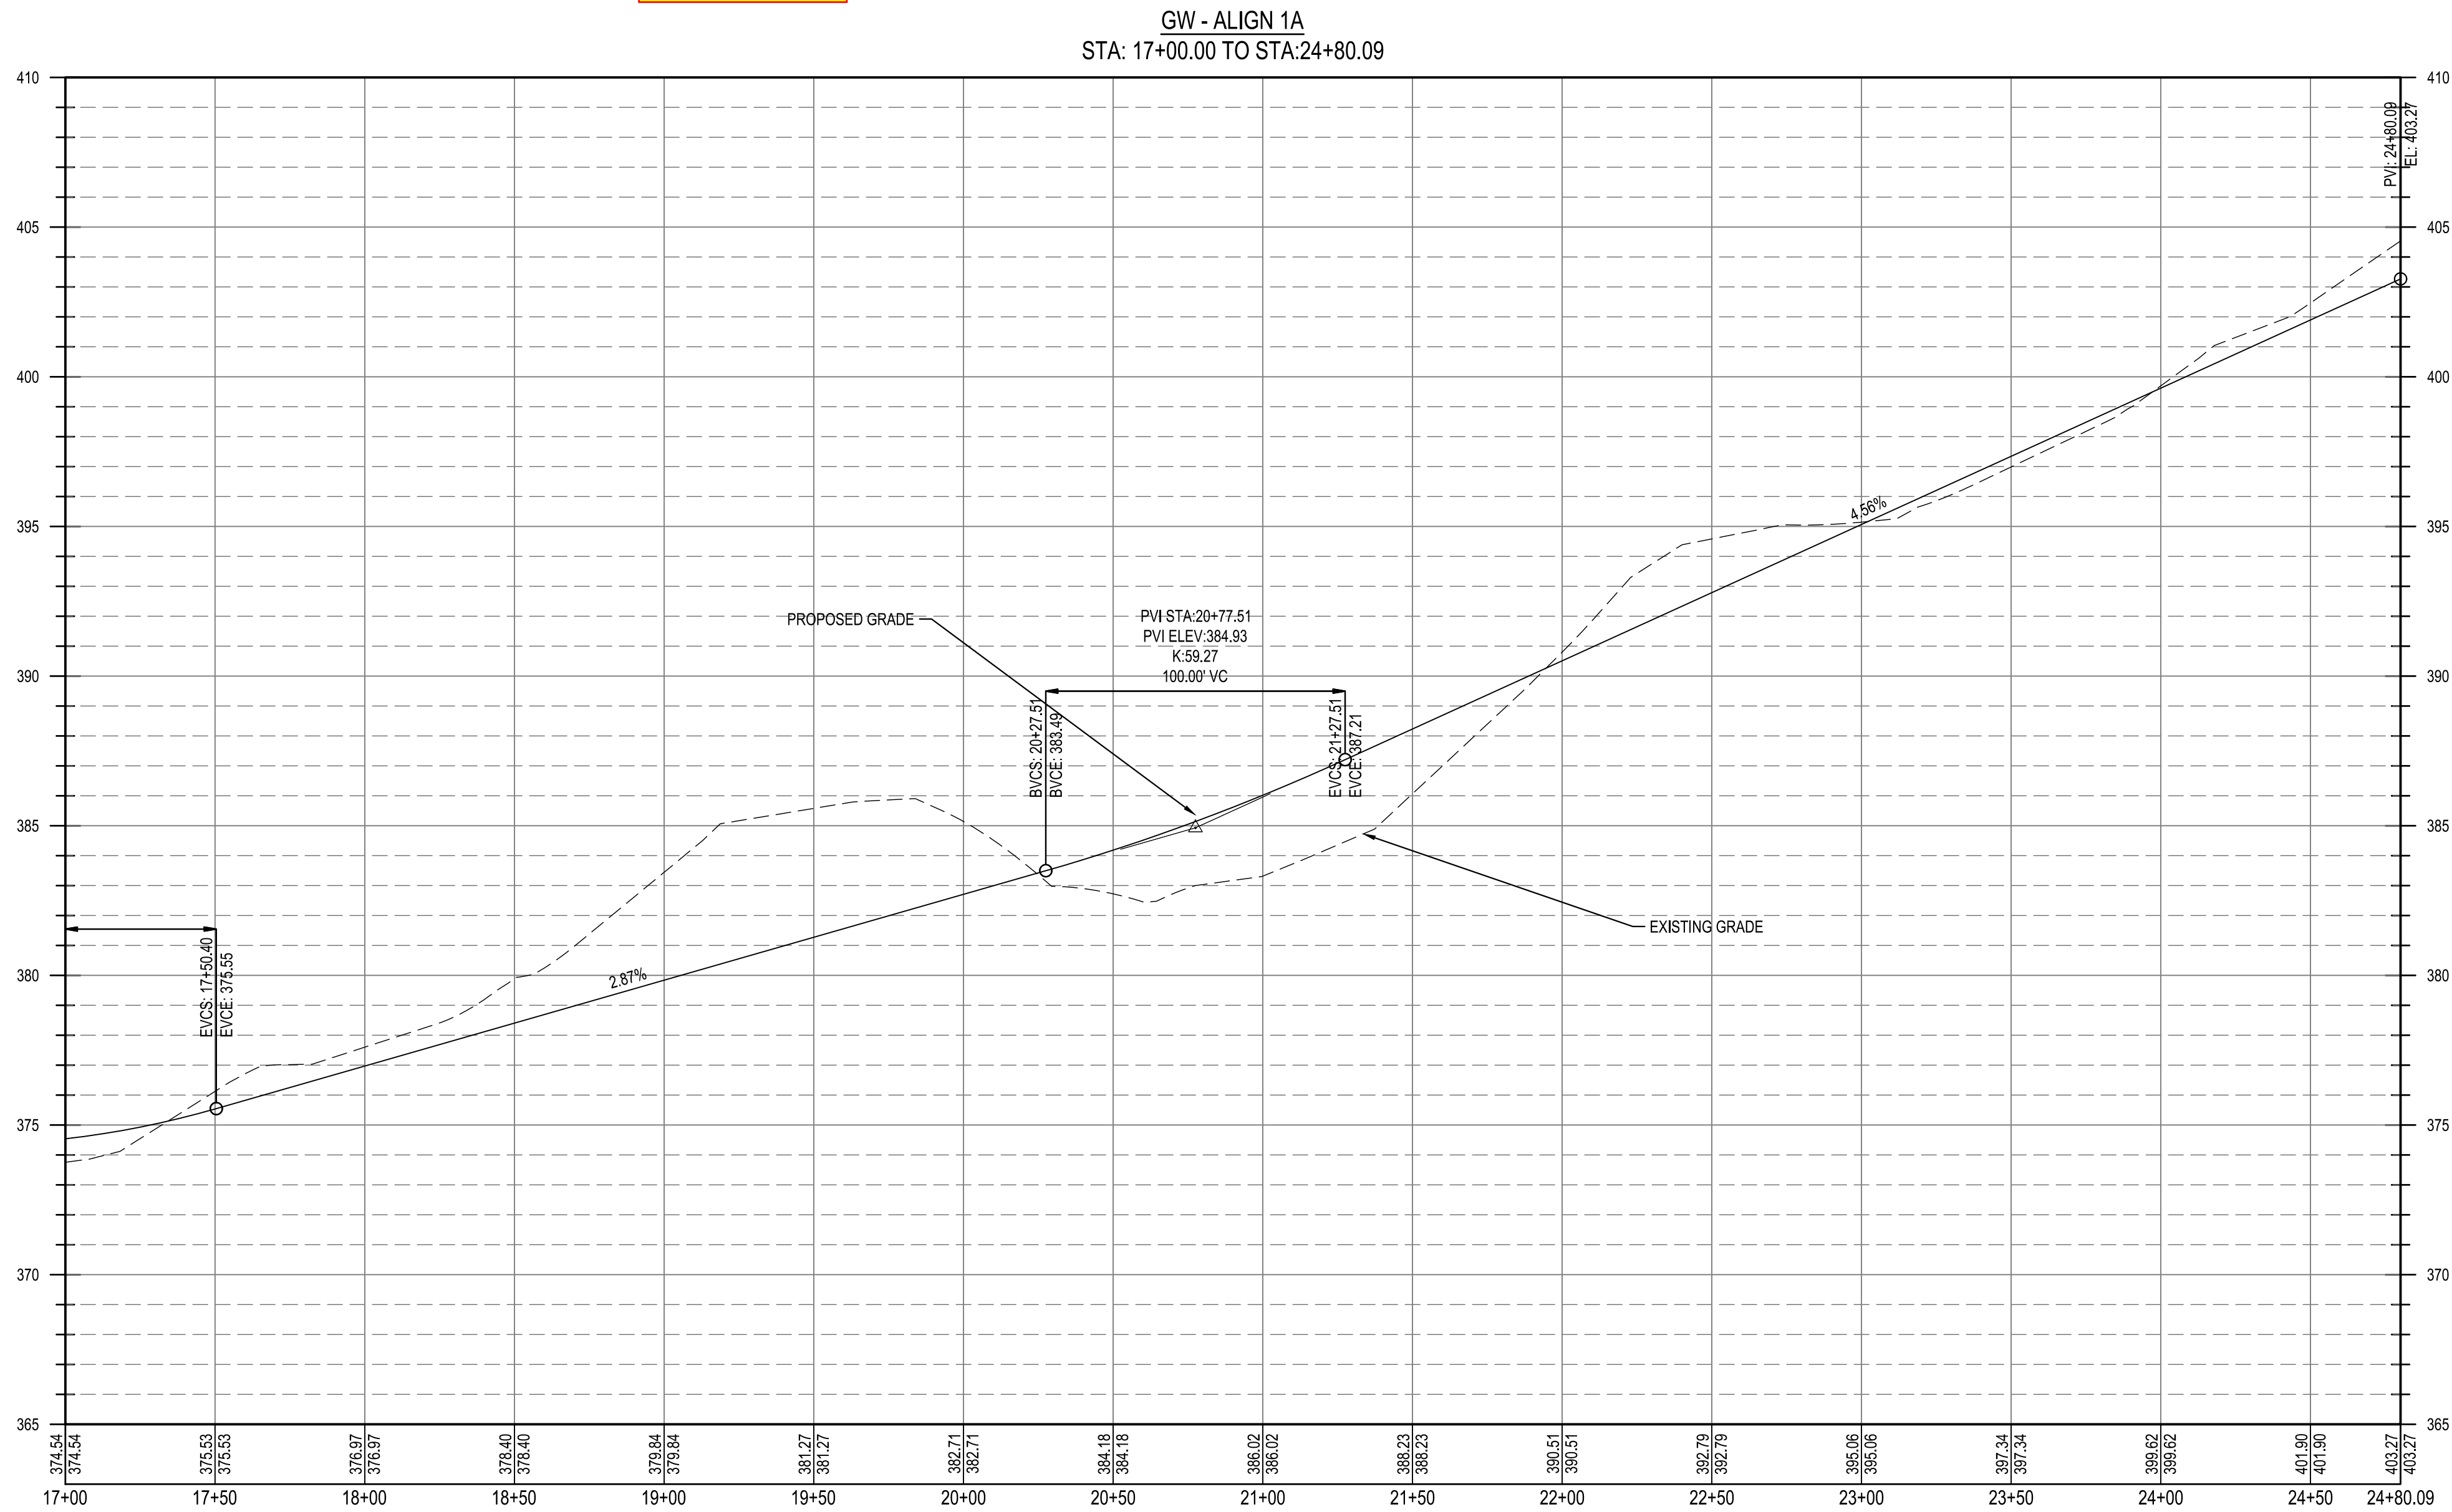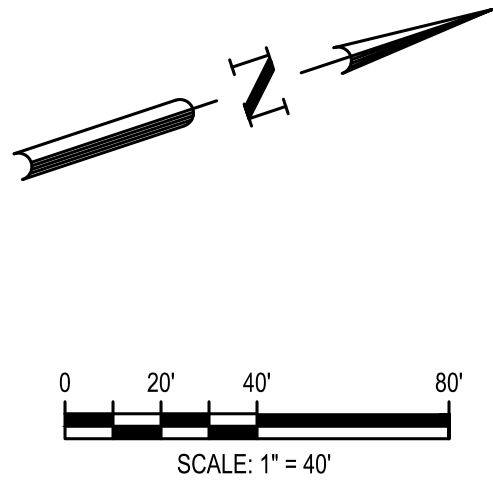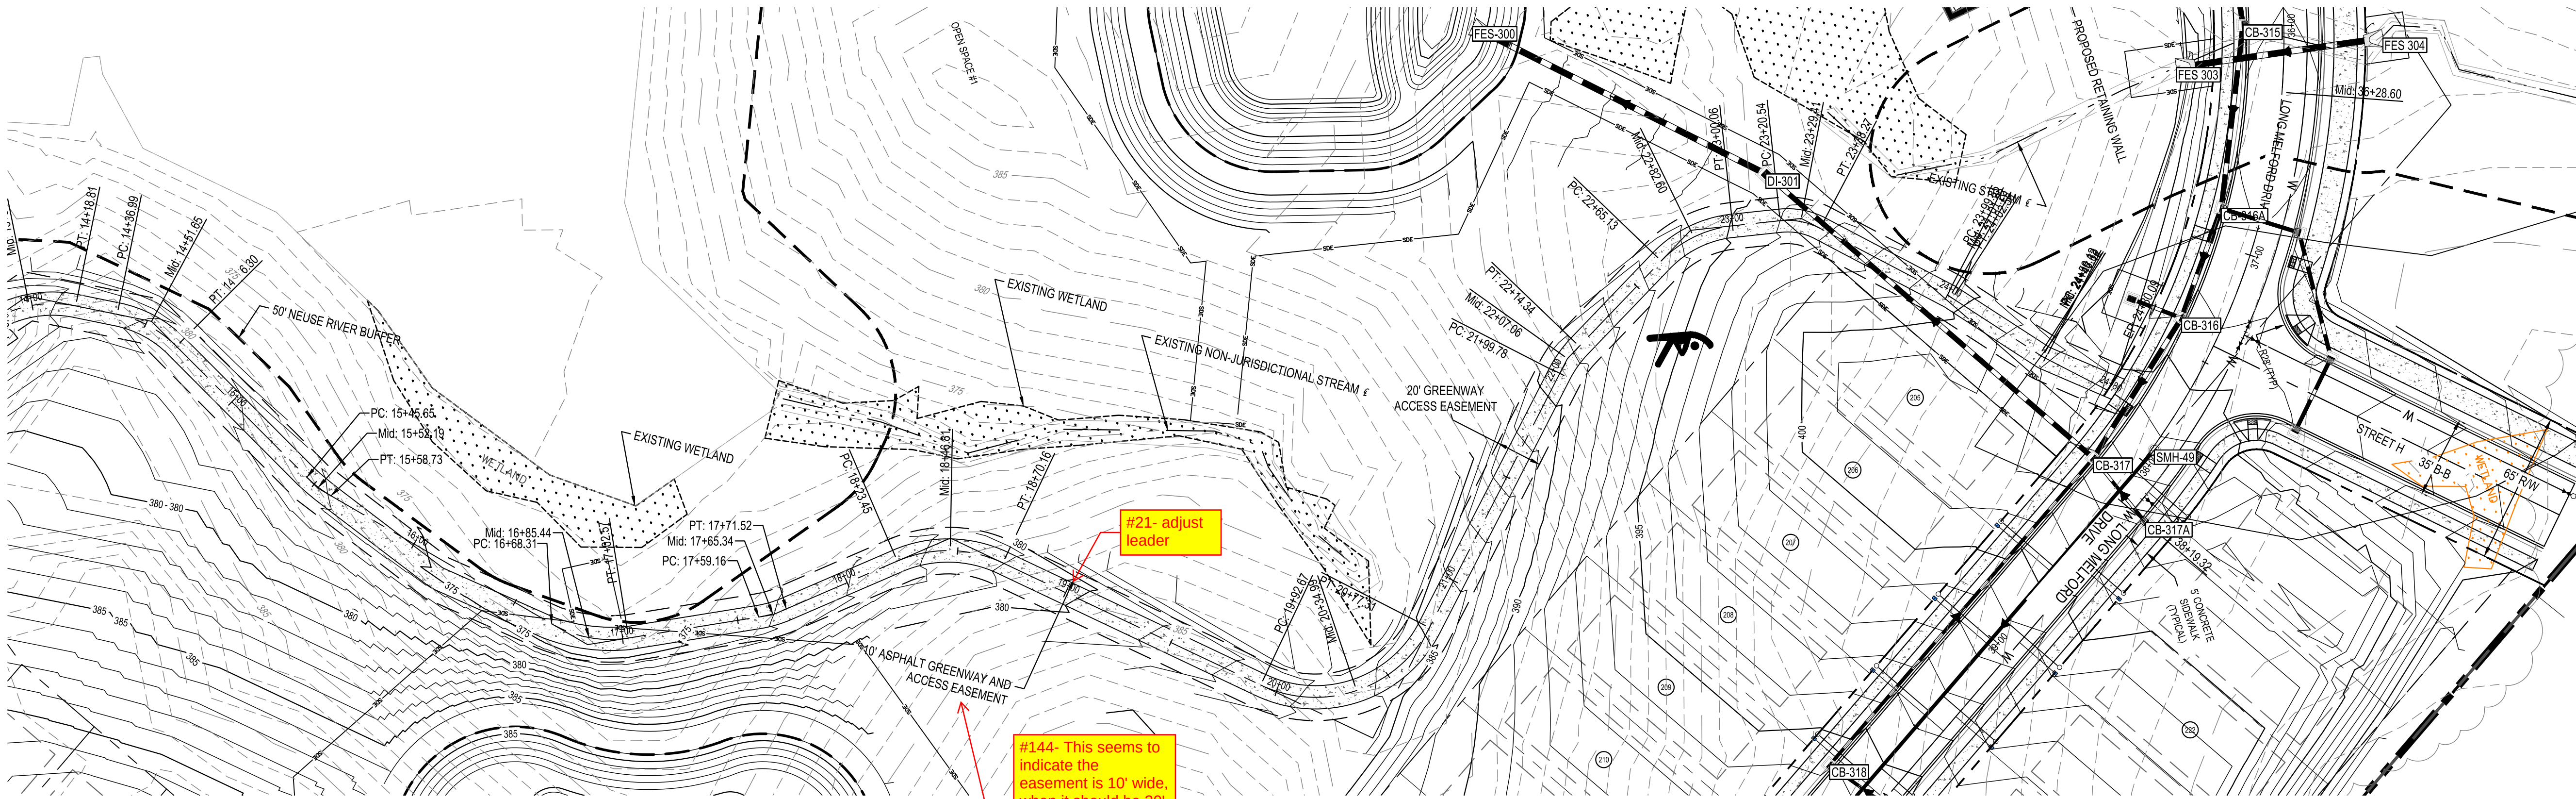


DESIGNED BY: DF/CD		REV	
DRAWN BY: DF/JWM		REV	
REVIEWED BY: DF		REV	
BCE		BCE	
5440 WADE PARK BLVD, SUITE 102 RALEIGH NC 27607 WWW.BCEINC.COM NC LICENSE #C-4397		PER TOWN OF ROLESVILLE COMMENT 06/01/2023 INITIAL SUBMITTAL 04/03/2023	
LENNAR CORPORAION 1100 PERIMETER PARK DRIVE, SUITE 112 MORRISVILLE / NORTH CAROLINA / 27560		PARKER RIDGE 82 SCHOOL STREET ROLESVILLE / NORTH CAROLINA / 27571	
GW1A GREENWAY PLAN AND PROFILE (2 OF 2)		PRELIMINARY ENGINEER PEDRA M. FERRER NOT FOR CONSTRUCTION	
FILE NUMBER: 8430-03		DATE: 06/01/2023	
C6-19		C6-19	




\\browngay.net\panzura\Regions\NCA\Projects\Lennar\8430-03 - Lennar - School Street - Rolesville\On-Site\CB-18 GREENWAY PLAN AND PROFILE.dwg Layout: GW1B GREENWAY PLAN AND PROFILE (1 OF 2) Plotted: 6/1/2023 3:33:53 PM

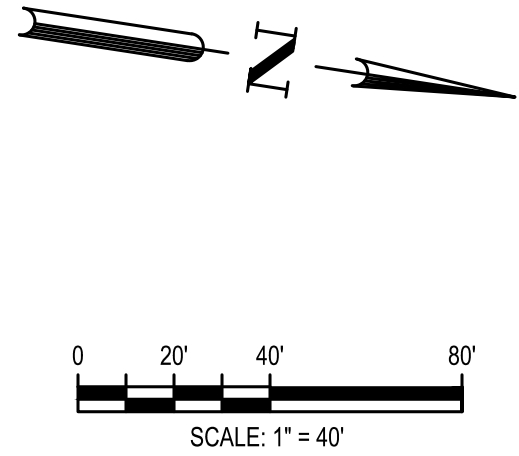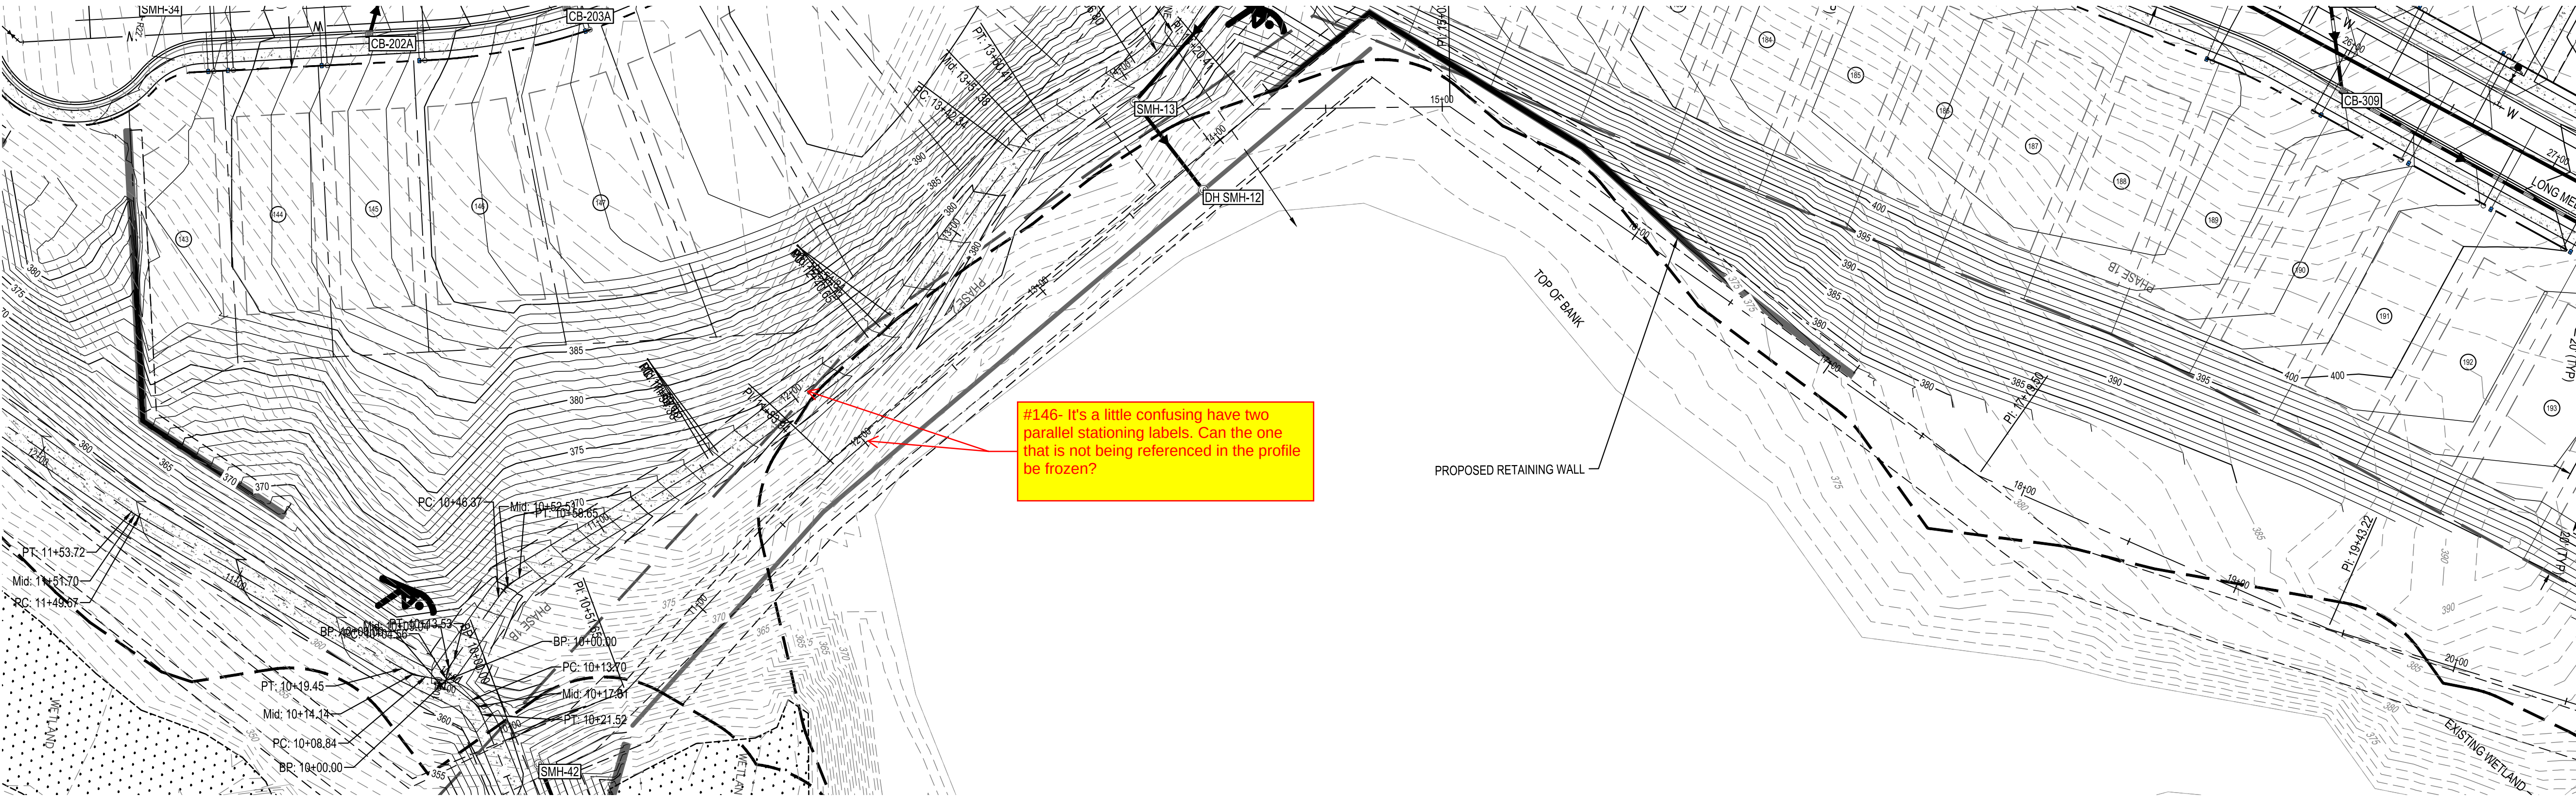

GW - ALIGN 1B
STA: 10+00.00 TO STA:17+50.00

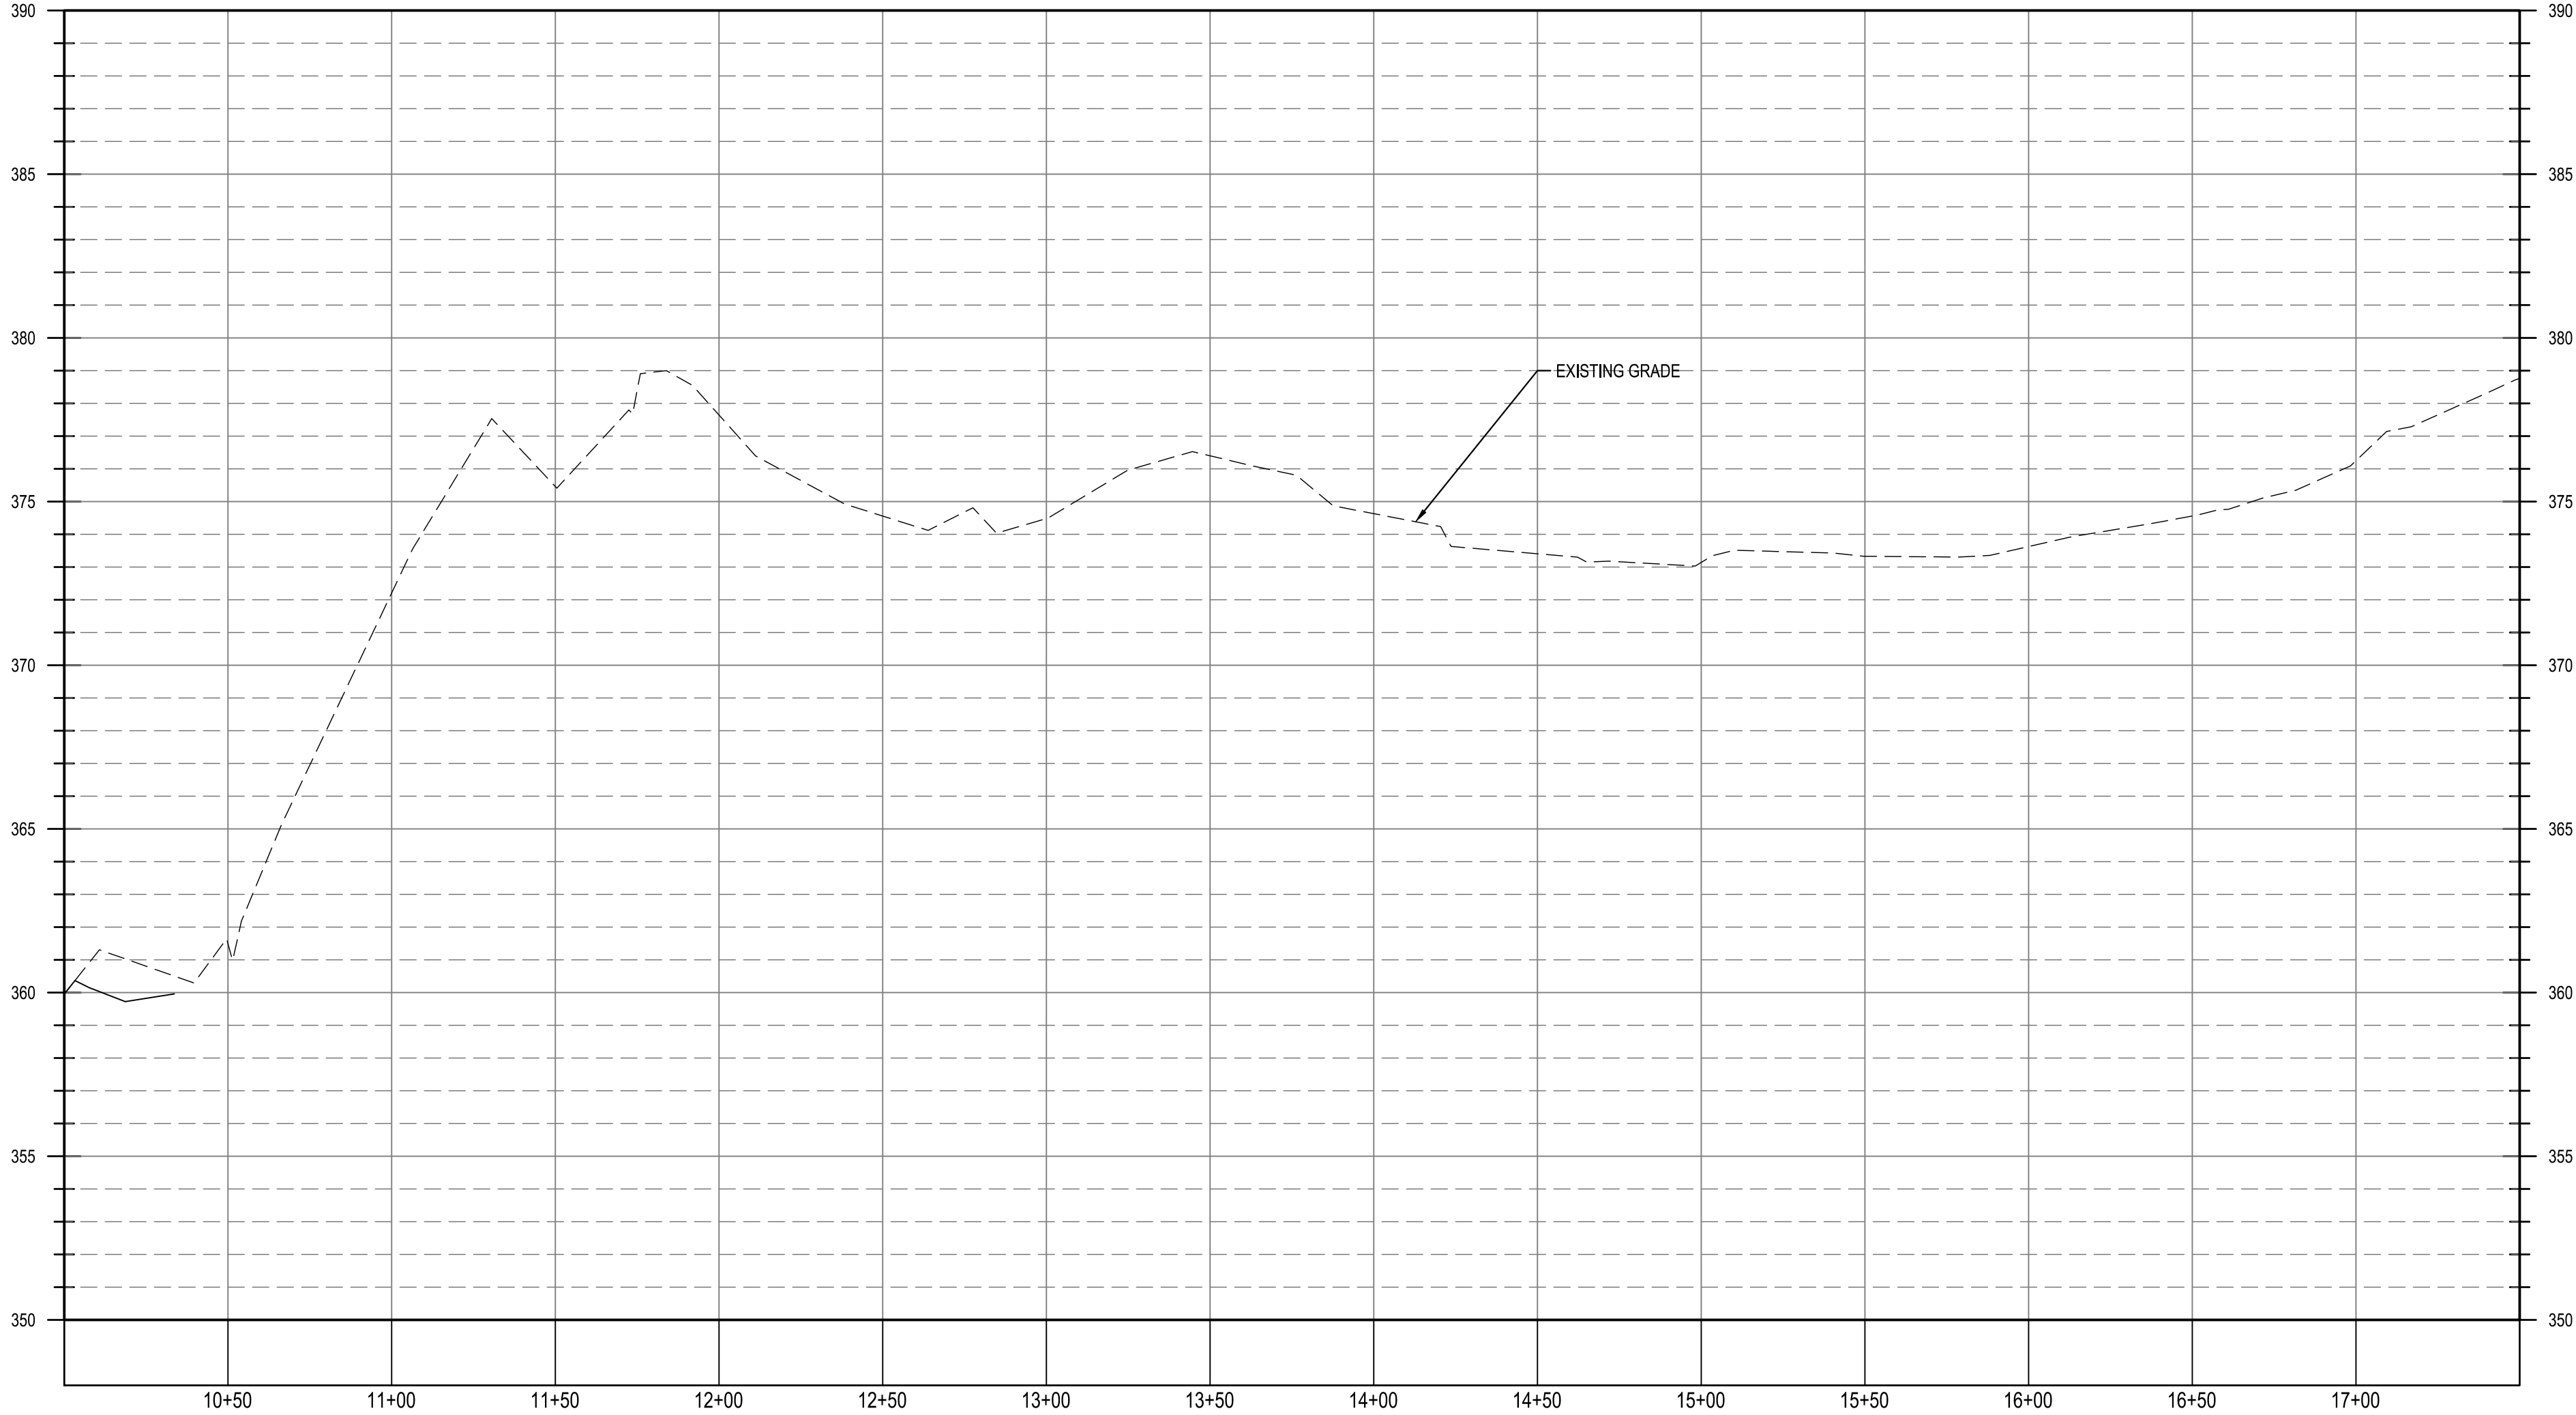

#147- What is the intent of this profile? Is everything that is intended to be shown being shown?

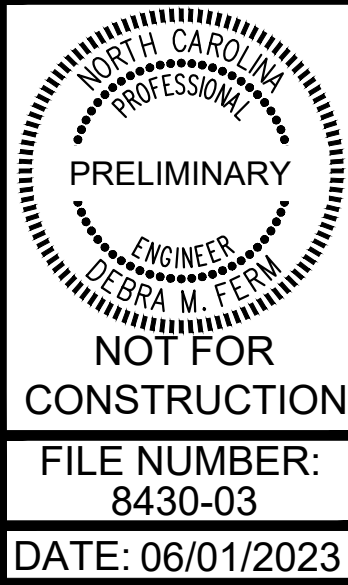



PARKER RIDGE
82 SCHOOL STREET
ROLESVILLE / NORTH CAROLINA / 27571

LENNAR
CORPORAION
1100 PERIMETER PARK DRIVE, SUITE 112
MORRISVILLE / NORTH CAROLINA / 27560

BCE
5440 WADE PARK BLVD, SUITE 102
RALEIGH NC 27607
WWW.BCEINC.COM
NC LICENSE #C-4397
©2023


DESIGNED BY:	DF/CD
DRAWN BY:	DF/JWM
REVIEWED BY:	DF
REV	04/03/2023
06/01/2023	PER TOWN OF ROLESVILLE COMMENT
INITIAL	SUBMITTAL

\\browgny.net\panzura\Regions\NCA\Projects\Lennar\8430-03 - Lennar - School Street - Rolesville\03 - DWG\PlanSheets\On-Site\C6-18 GREENWAY PLAN AND PROFILE.dwg Layout: GW1B GREENWAY PLAN AND PROFILE (2 OF 2) Plotted: 6/1/2023 3:34:03 PM

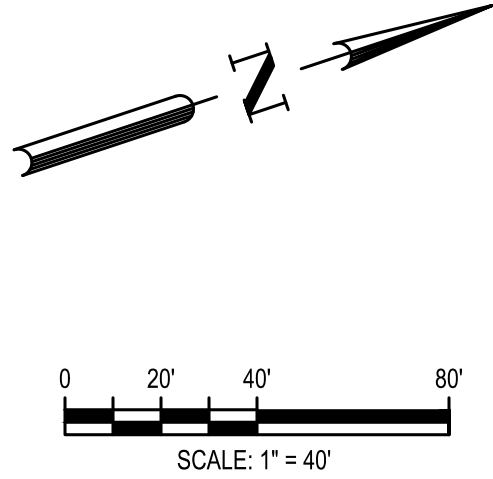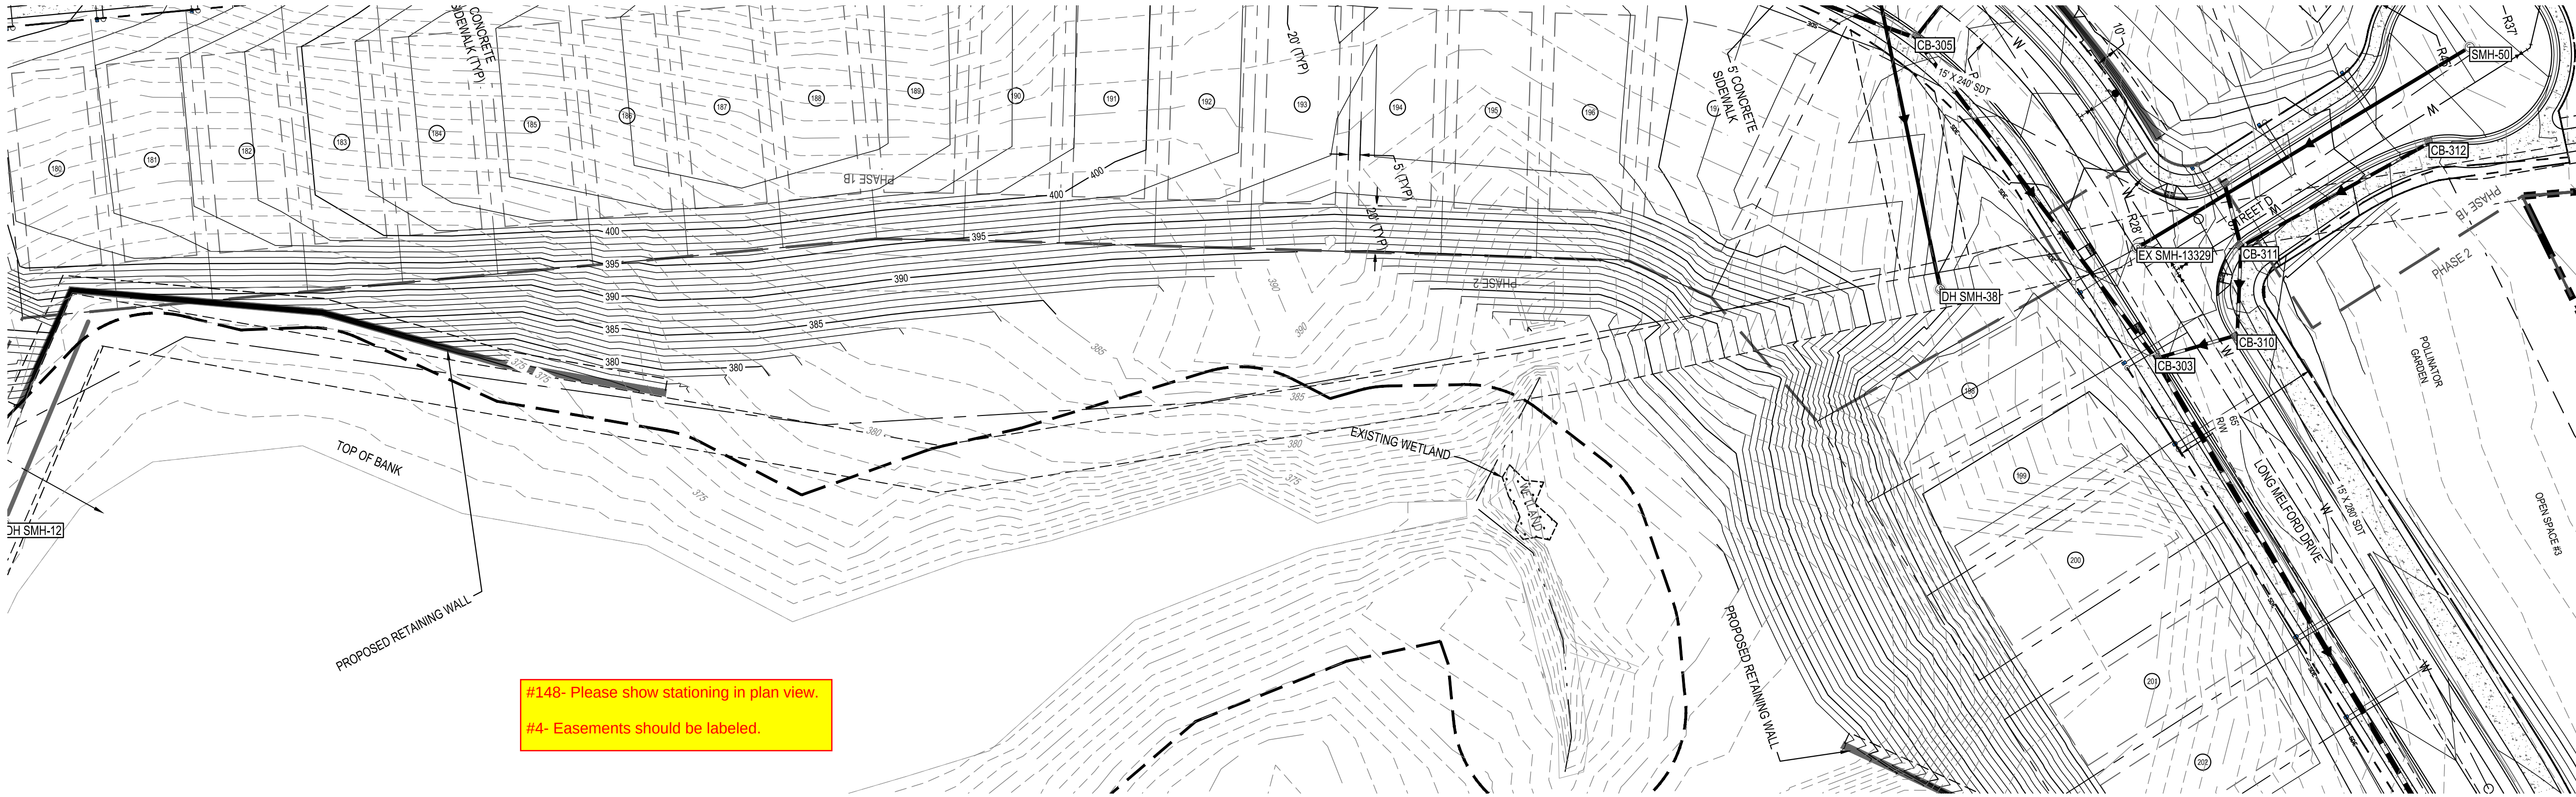


#148- Please show stationing in plan view.
#4- Easements should be labeled.

GW - ALIGN 1B
STA: 17+00.00 TO STA:23+17.35

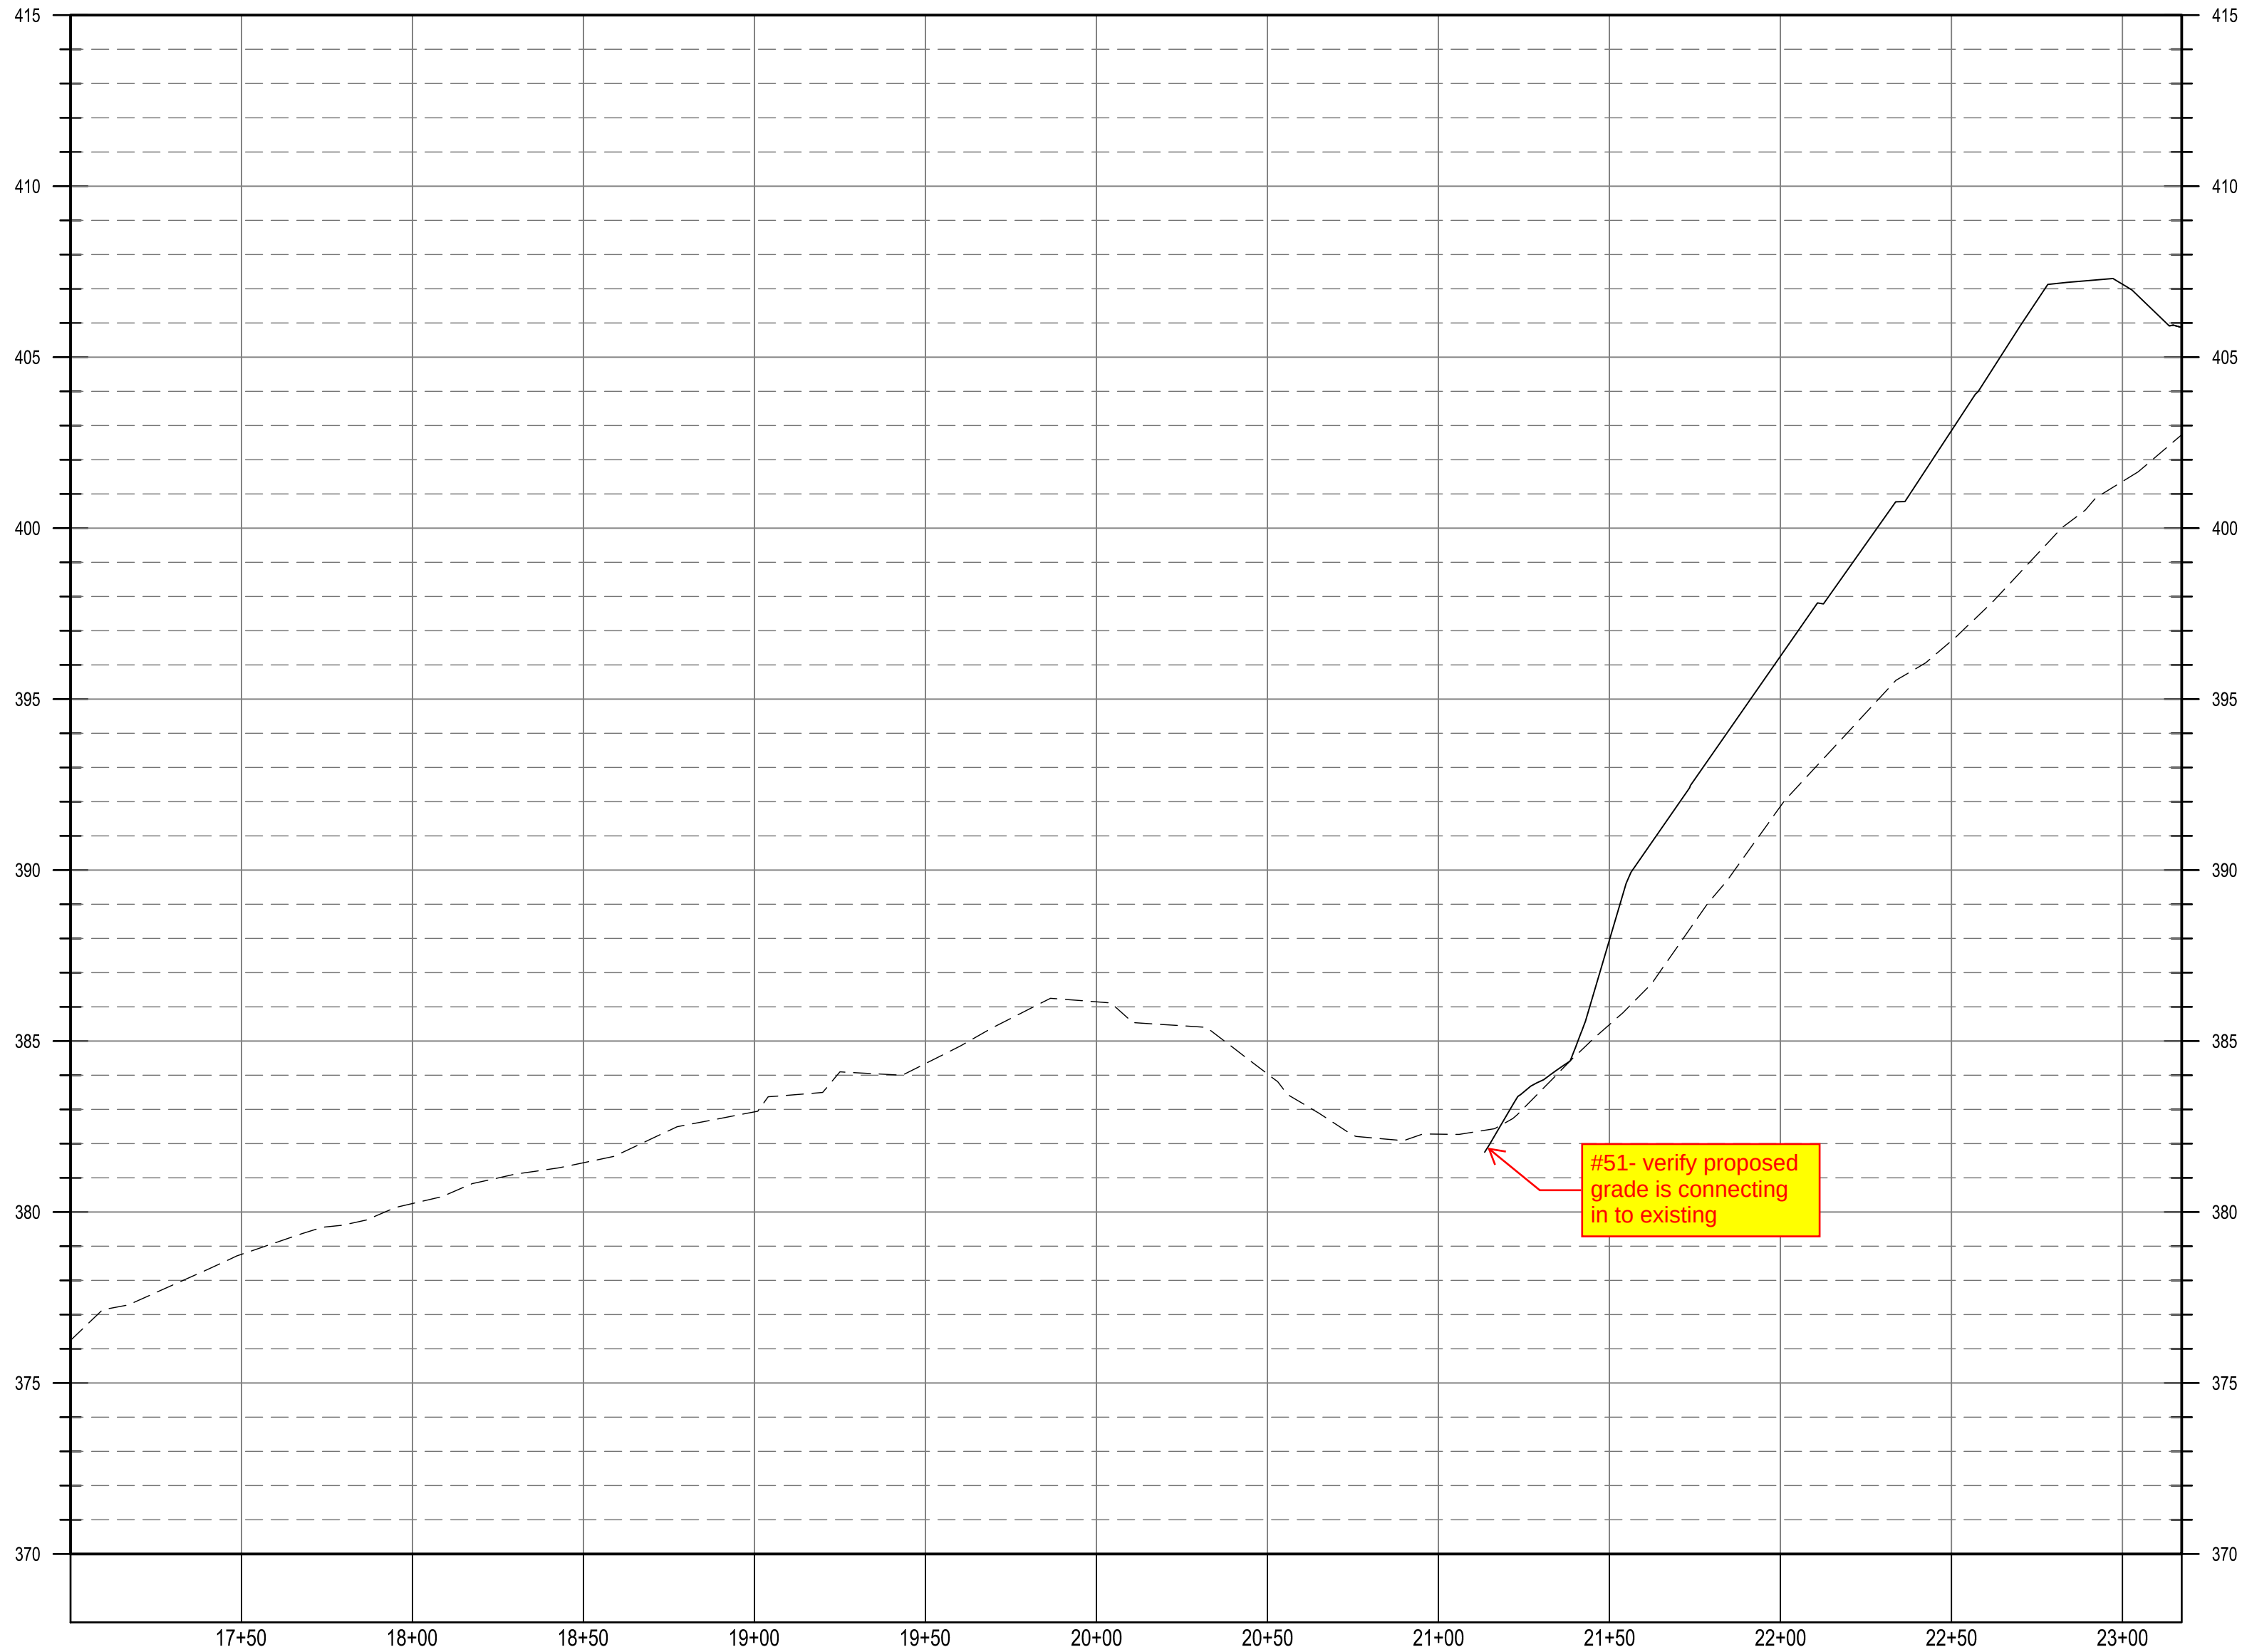

#51- verify proposed grade is connecting in to existing


#149- What is the intent of this profile? Is everything that is intended to be shown being shown?

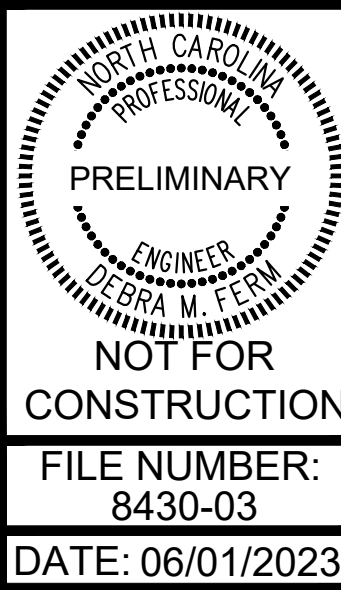

GW1B GREENWAY PLAN
AND PROFILE (2 OF 2)



PARKER RIDGE
82 SCHOOL STREET
ROLESVILLE / NORTH CAROLINA / 27571

LENNAR
CORPORAION
1100 PERIMETER PARK DRIVE, SUITE 112
MORRISVILLE / NORTH CAROLINA / 27560

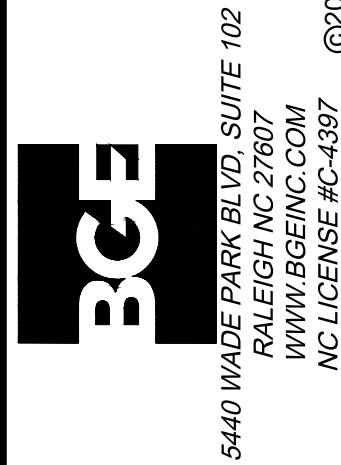


DESIGNED BY:	DF/CD	
DRAWN BY:	DF/JWM	
REVIEWED BY:	DF	
REV	04/03/2023	INITIAL SUBMITTAL
06/01/2023	PER TOWN OF ROLESVILLE COMMENT	

\\browgway.net\panzura\Regions\NCA\Projects\Lennar\8430-03 - Lennar - School Street - Rolesville\On-Site\C6-18 GREENWAY PLAN AND PROFILE.dwg Layout: GW2 GREENWAY PLAN AND PROFILE (1 OF 2) Plotted: 6/1/2023 3:34:14 PM

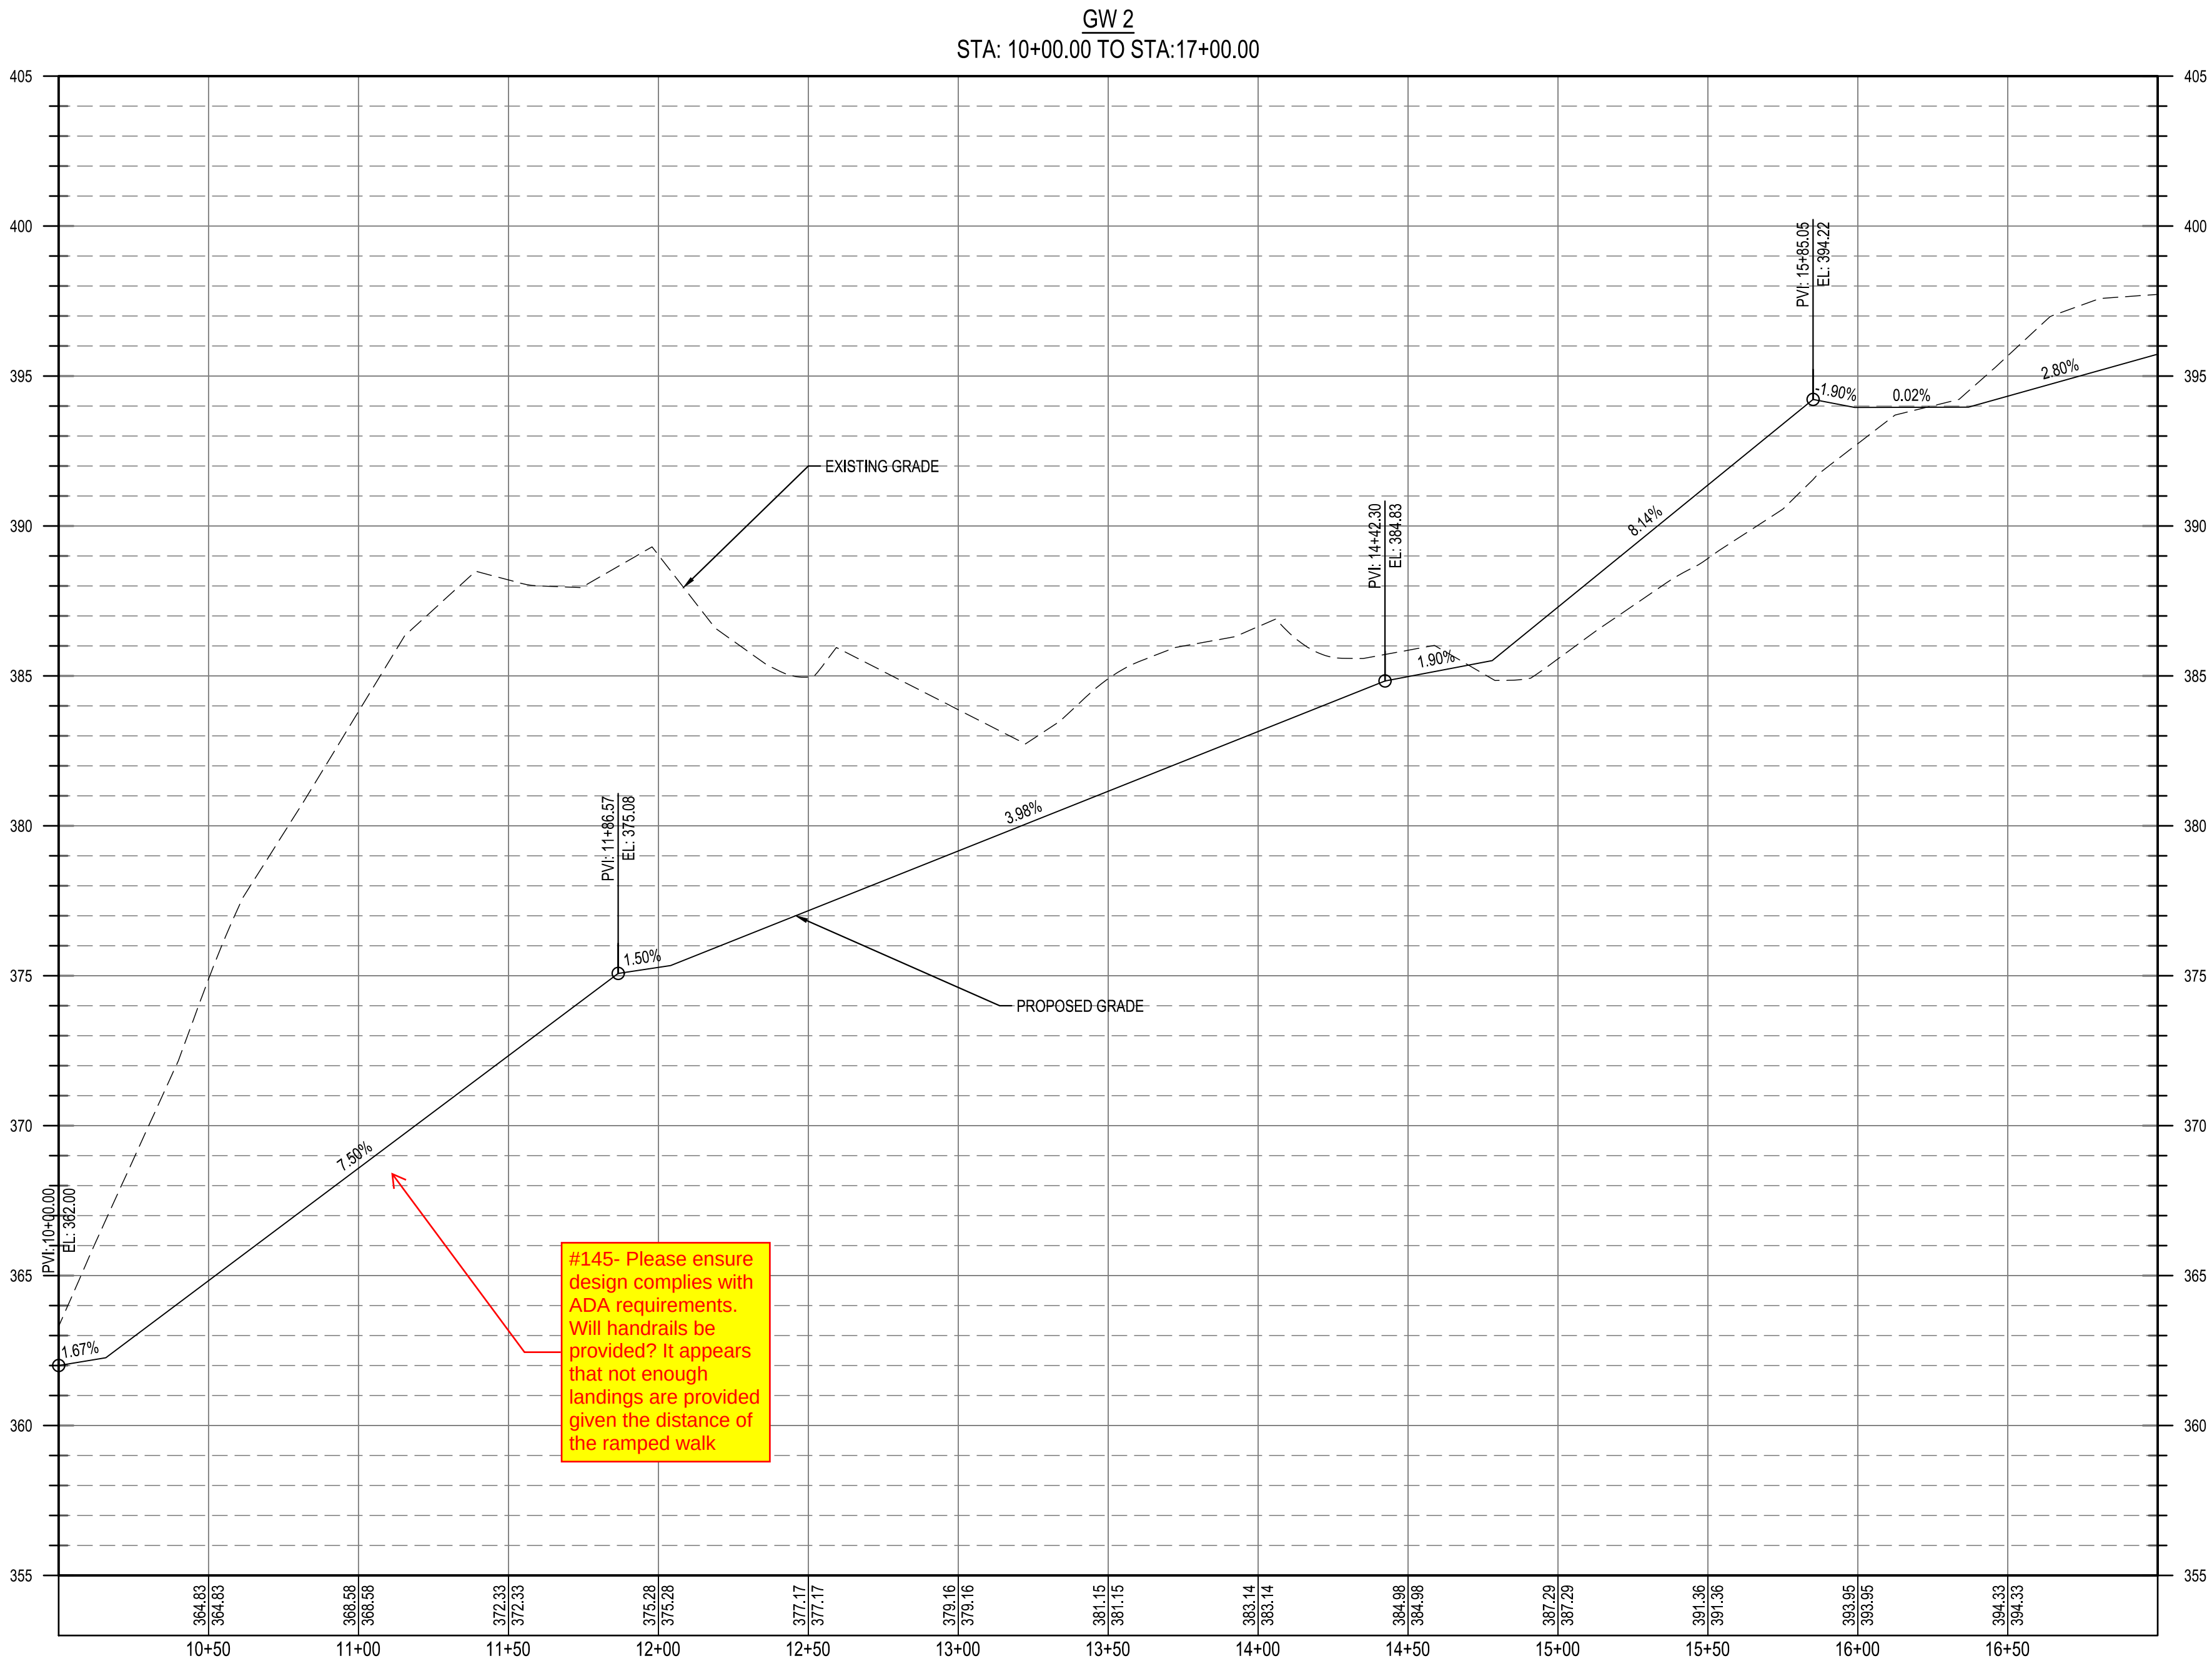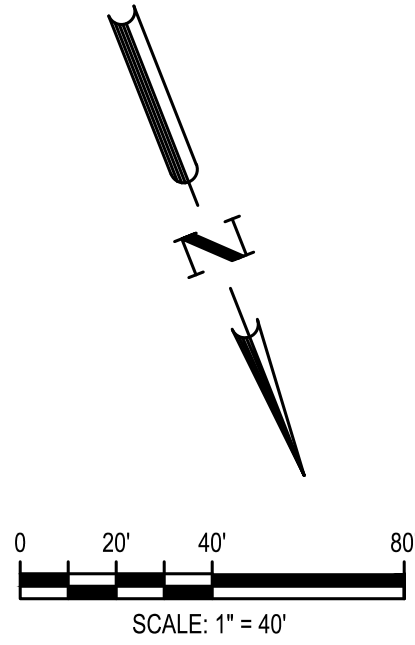

Know what's below.
Call before you dig.

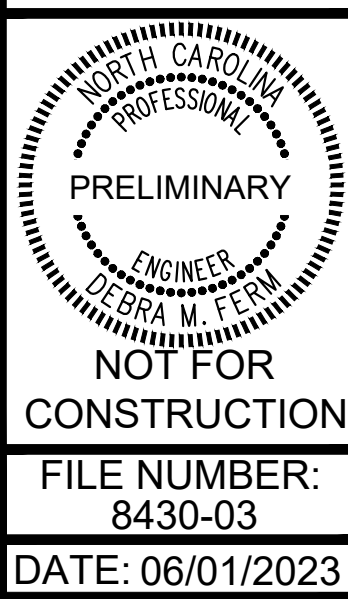

GW2 GREENWAY PLAN AND
PROFILE (1 OF 2)

PARKER RIDGE
82 SCHOOL STREET
ROLESVILLE / NORTH CAROLINA / 27571





LENNAR
CORPORAION
1100 PERIMETER PARK DRIVE, SUITE 112
MORRISVILLE / NORTH CAROLINA / 27560



5440 WADE PARK BLVD, SUITE 102
RALEIGH NC 27607
WWW.BCEINC.COM
NC LICENSE #C-4397

DESIGNED BY:	DF/CD	06/01/2023	PER TOWN OF ROLESVILLE COMMENT
DRAWN BY:	DF/JWM		
REVIEWED BY:	DF		
REV	04/03/2023		INITIAL SUBMITTAL

\\browngay.net\panzura\Regions\NCA\Projects\Lennar\8430-03 - Lennar - School Street - Rolesville\On-Site\CB-18 GREENWAY PLAN AND PROFILE.dwg Layout: GW3 GREENWAY PLAN AND PROFILE (1 OF 1) Plotted: 6/1/2023 3:34:33 PM

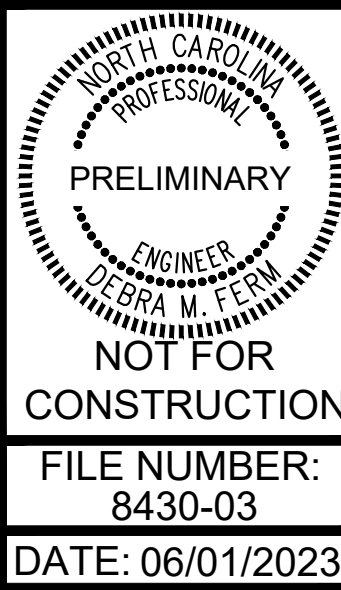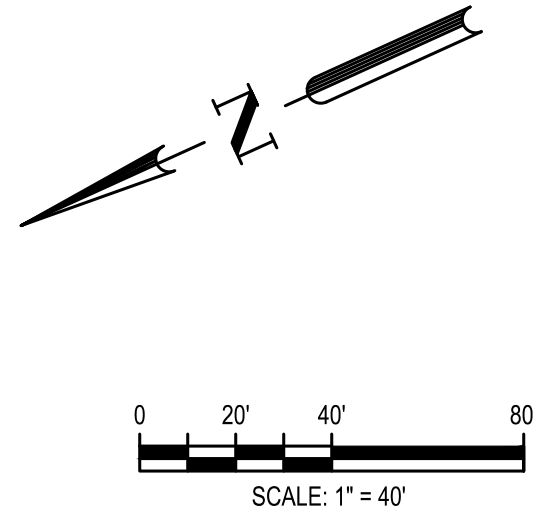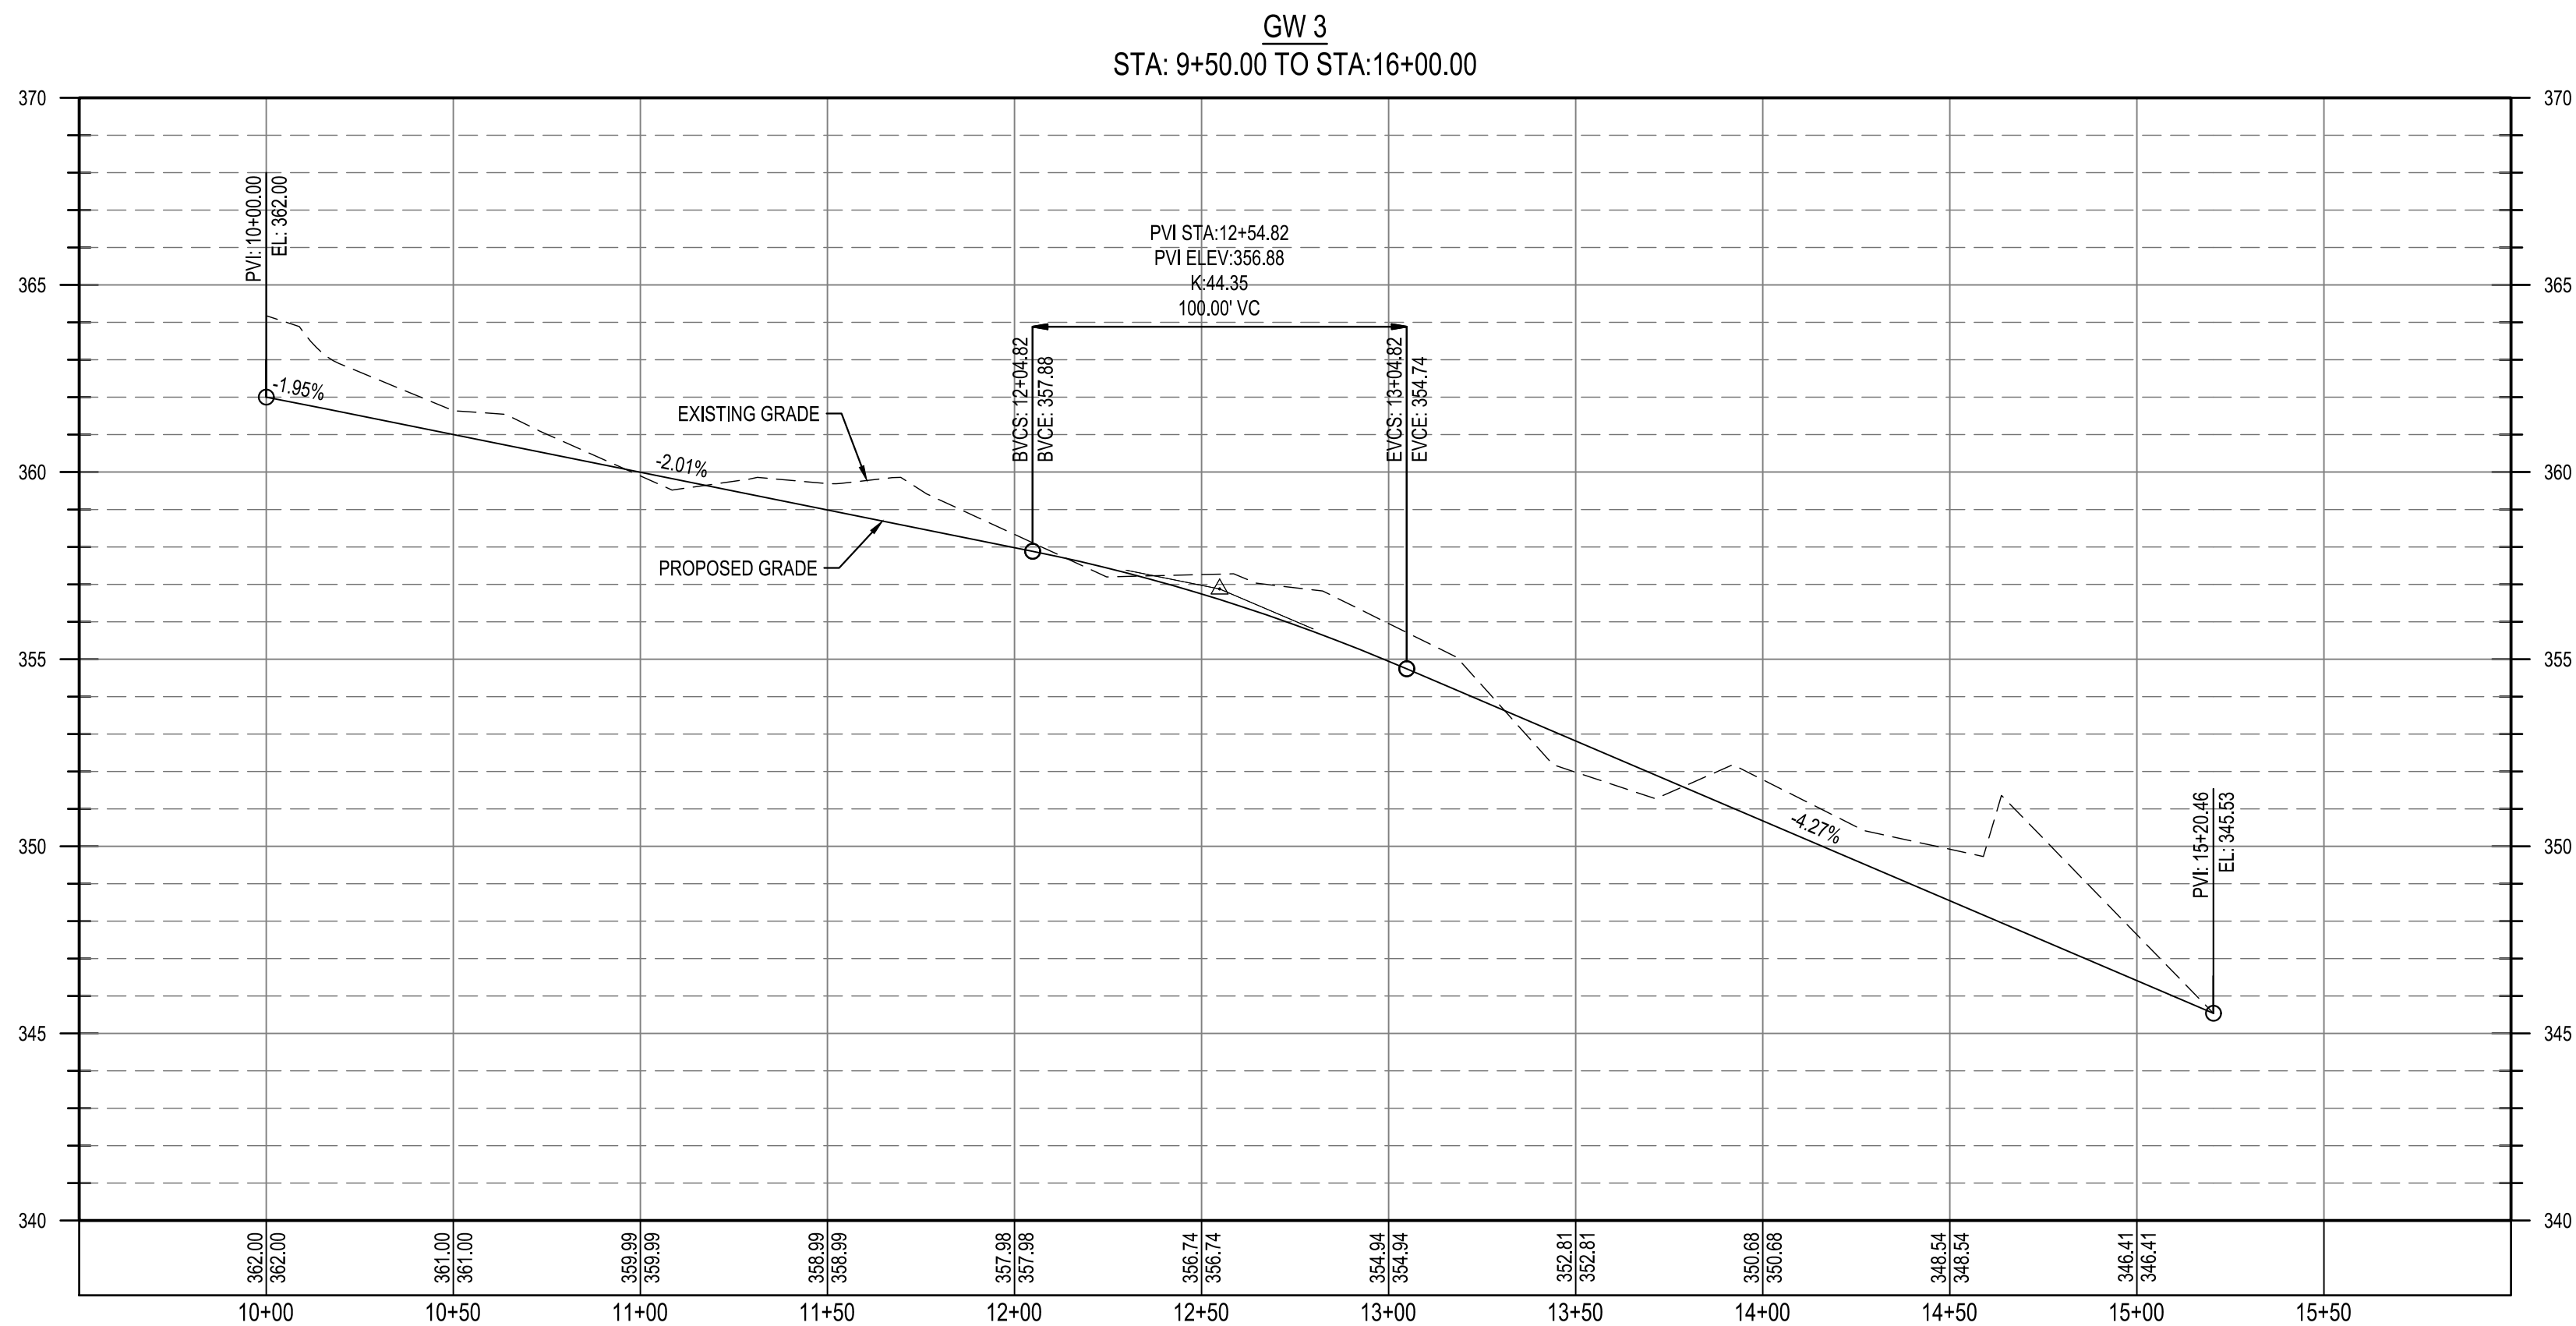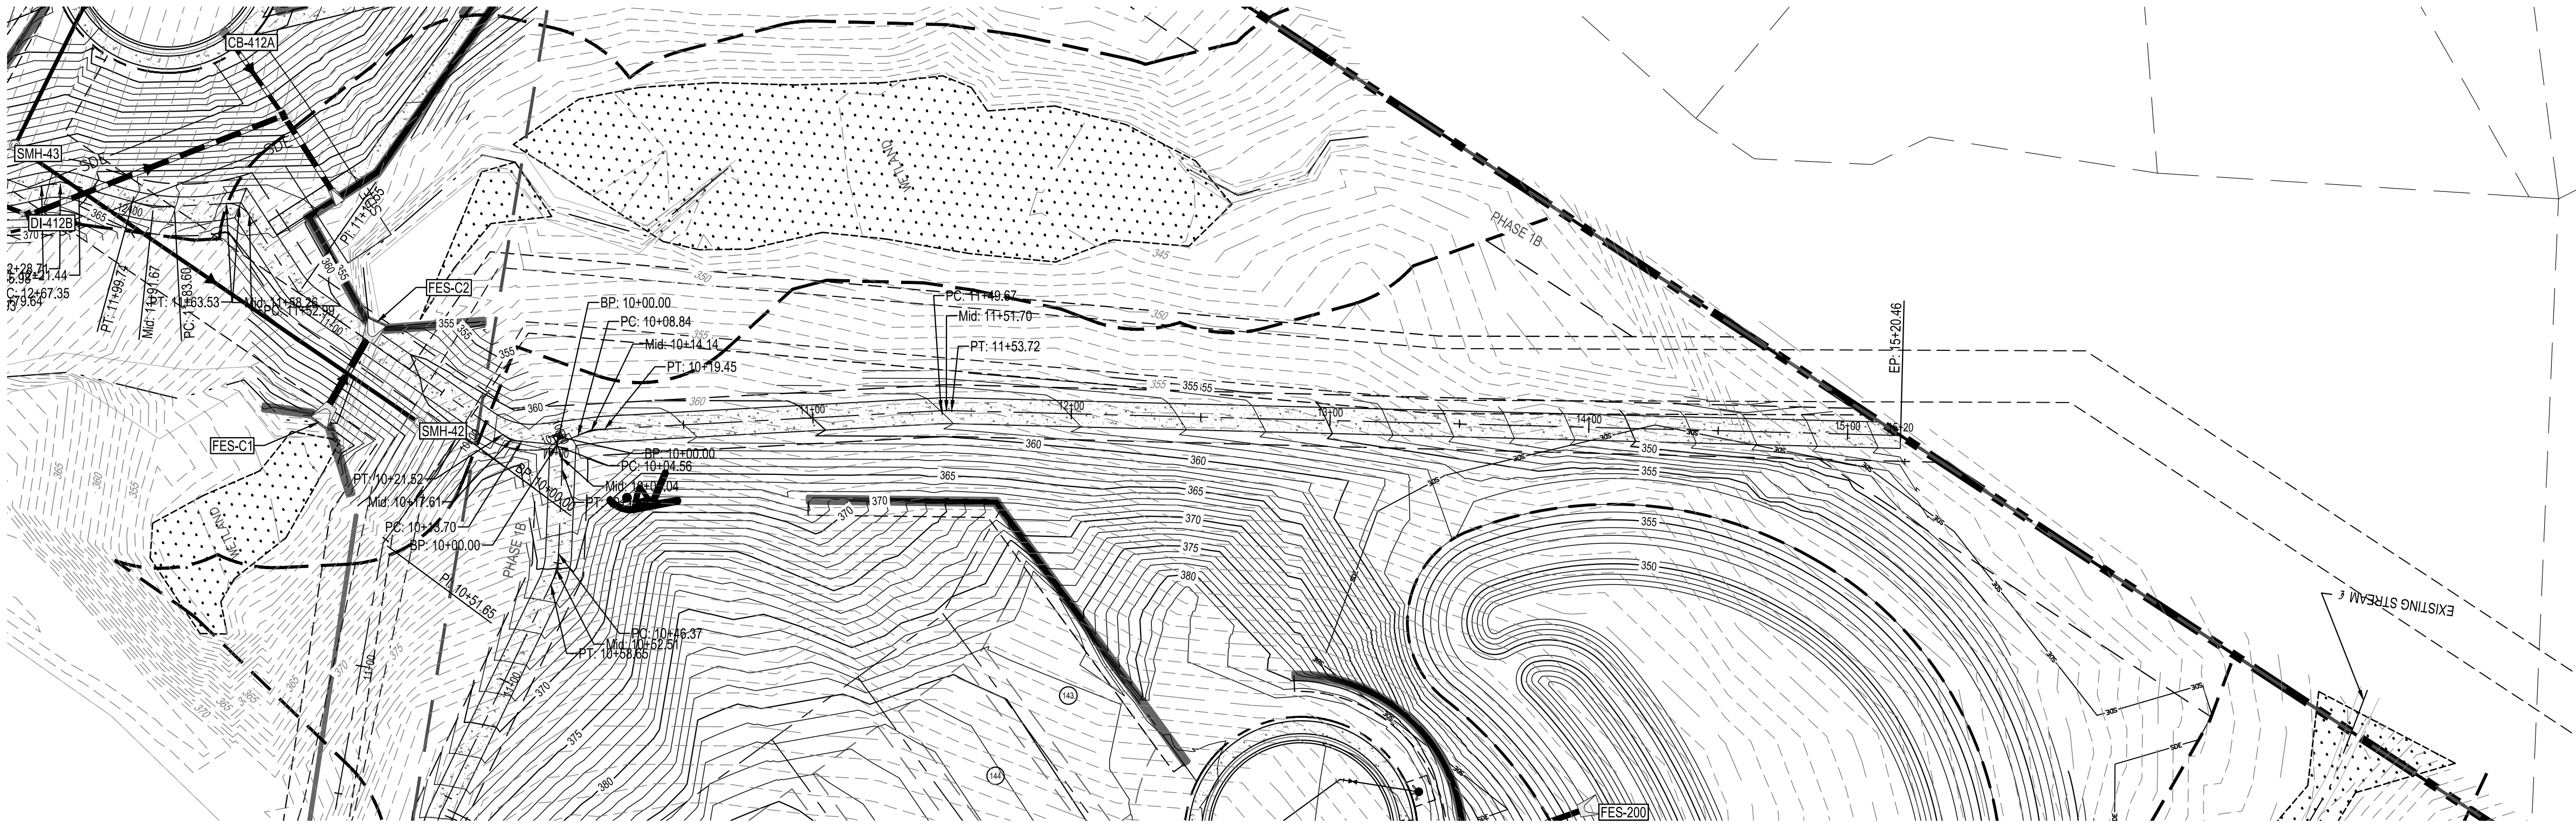

GW3 GREENWAY PLAN AND
PROFILE (1 OF 1)

PARKER RIDGE
82 SCHOOL STREET
ROLESVILLE / NORTH CAROLINA / 27571





LENNAR
CORPORAION
1100 PERIMETER PARK DRIVE, SUITE 112
MORRISVILLE / NORTH CAROLINA / 27560



DESIGNED BY: DF/CD
DRAWN BY: DF/JWM
REVIEWED BY: DF

06/01/2023 PER TOWN OF ROLESVILLE COMMENT
REV 04/03/2023 INITIAL SUBMITTAL

\\browgway.net\panzura\Regions\NCA\Projects\Lennar\8430-03 - Lennar - School Street - Rolesville\03 - DWG\PlanSheets\On-Site\C6-18 GREENWAY PLAN AND PROFILE.dwg Layout: GW4 GREENWAY PLAN AND PROFILE (1 OF 2) Plotted: 6/1/2023 3:34:44 PM

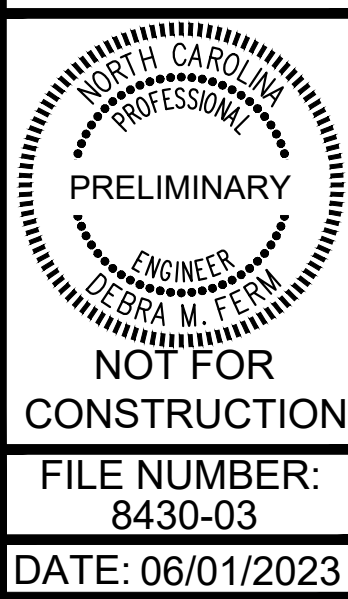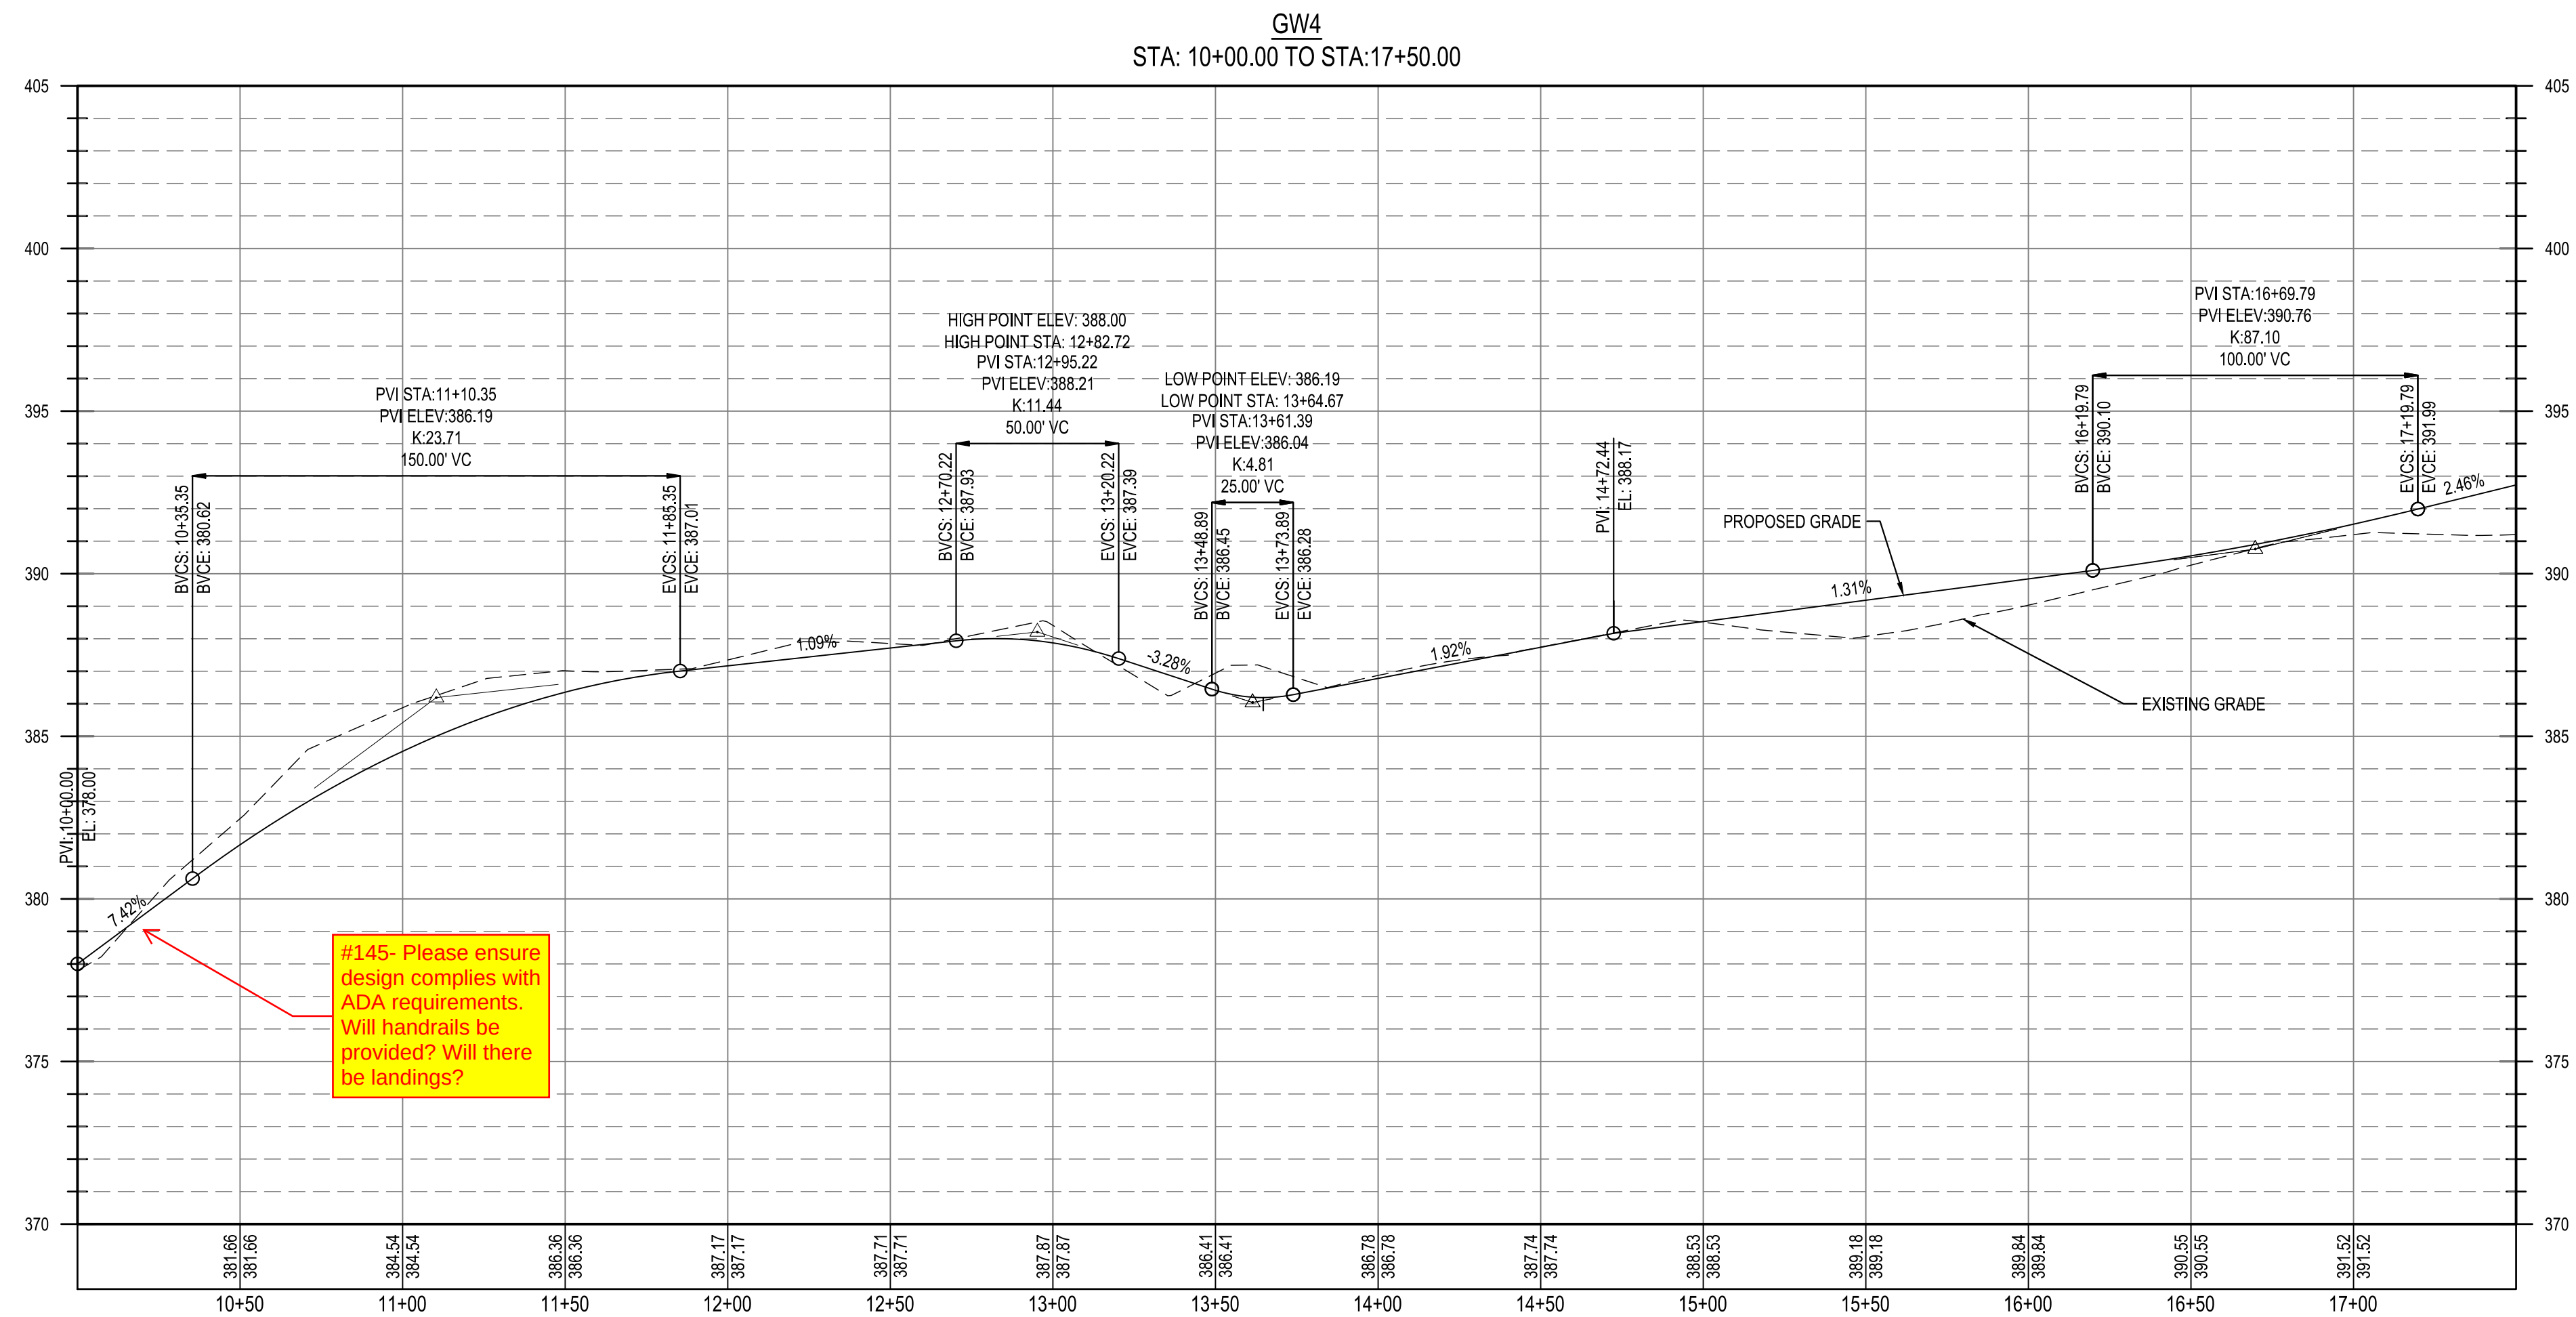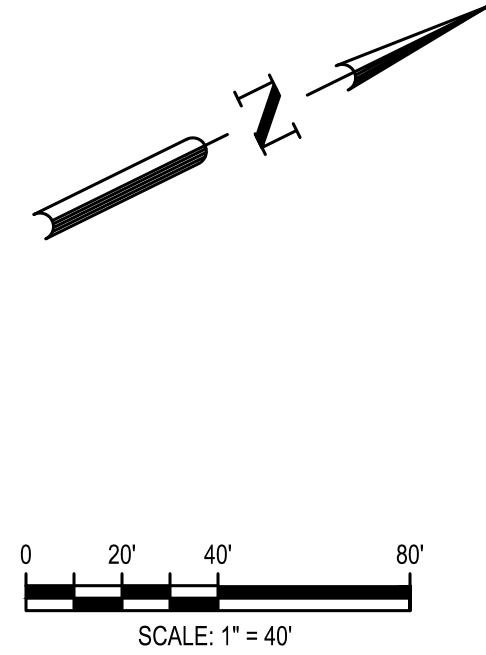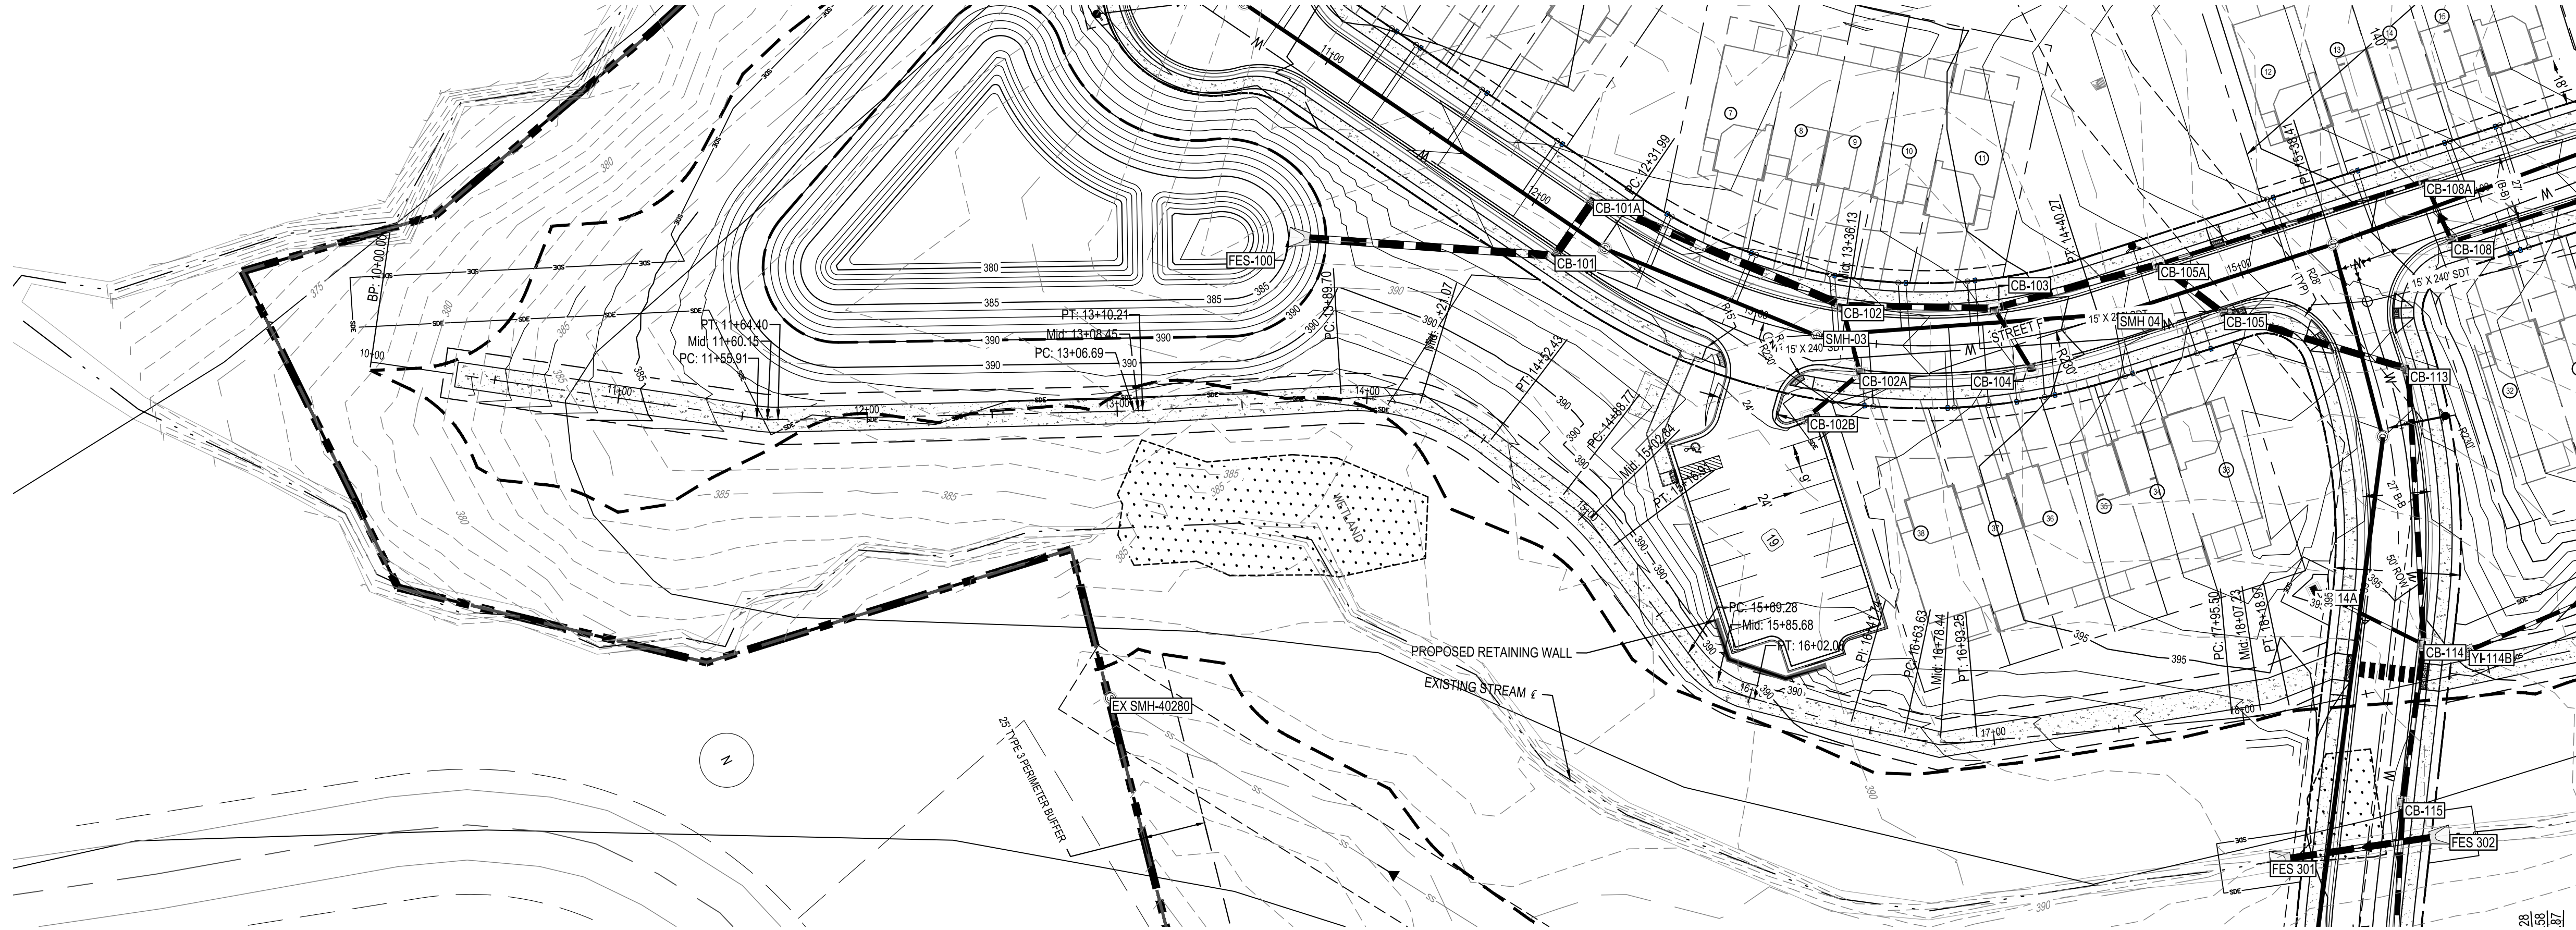

FILE NUMBER:
8430-03
DATE: 06/01/2023

C6-25




PARKER RIDGE
82 SCHOOL STREET
ROLESVILLE / NORTH CAROLINA / 27571

LENNAR
CORPORAION
1100 PERIMETER PARK DRIVE, SUITE 112
MORRISVILLE / NORTH CAROLINA / 27560


BCE
5440 WADE PARK BLVD, SUITE 102
RALEIGH NC 27607
WWW.BCEINC.COM
NC LICENSE #C-4397

DESIGNED BY: DF/CD
DRAWN BY: DF/JWM
REVIEWED BY: DF

06/01/2023 PER TOWN OF ROLESVILLE COMMENT
REV 04/03/2023 INITIAL SUBMITTAL

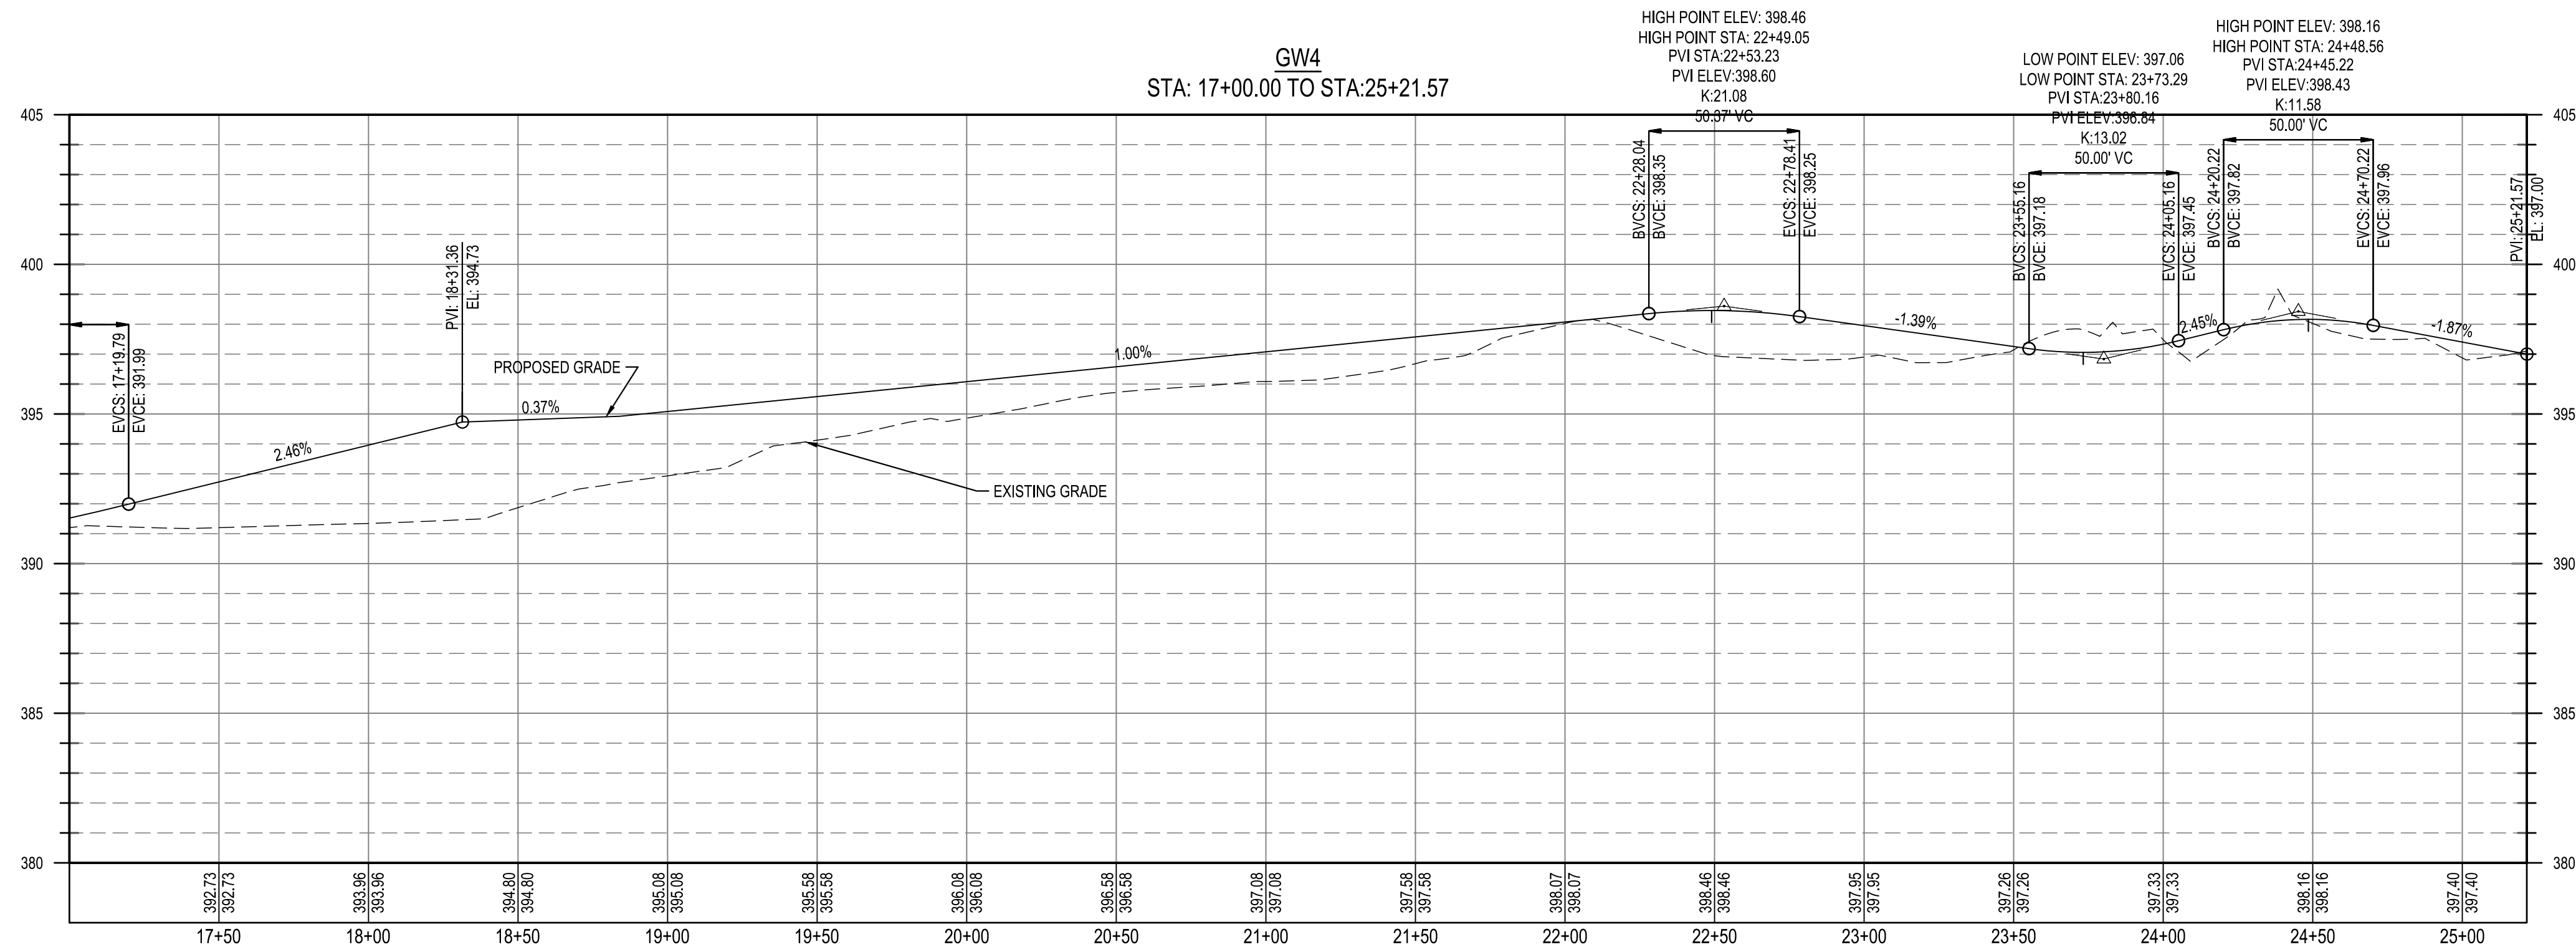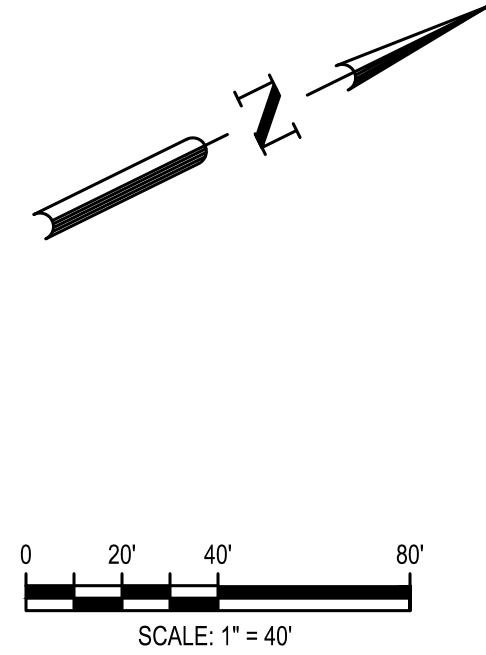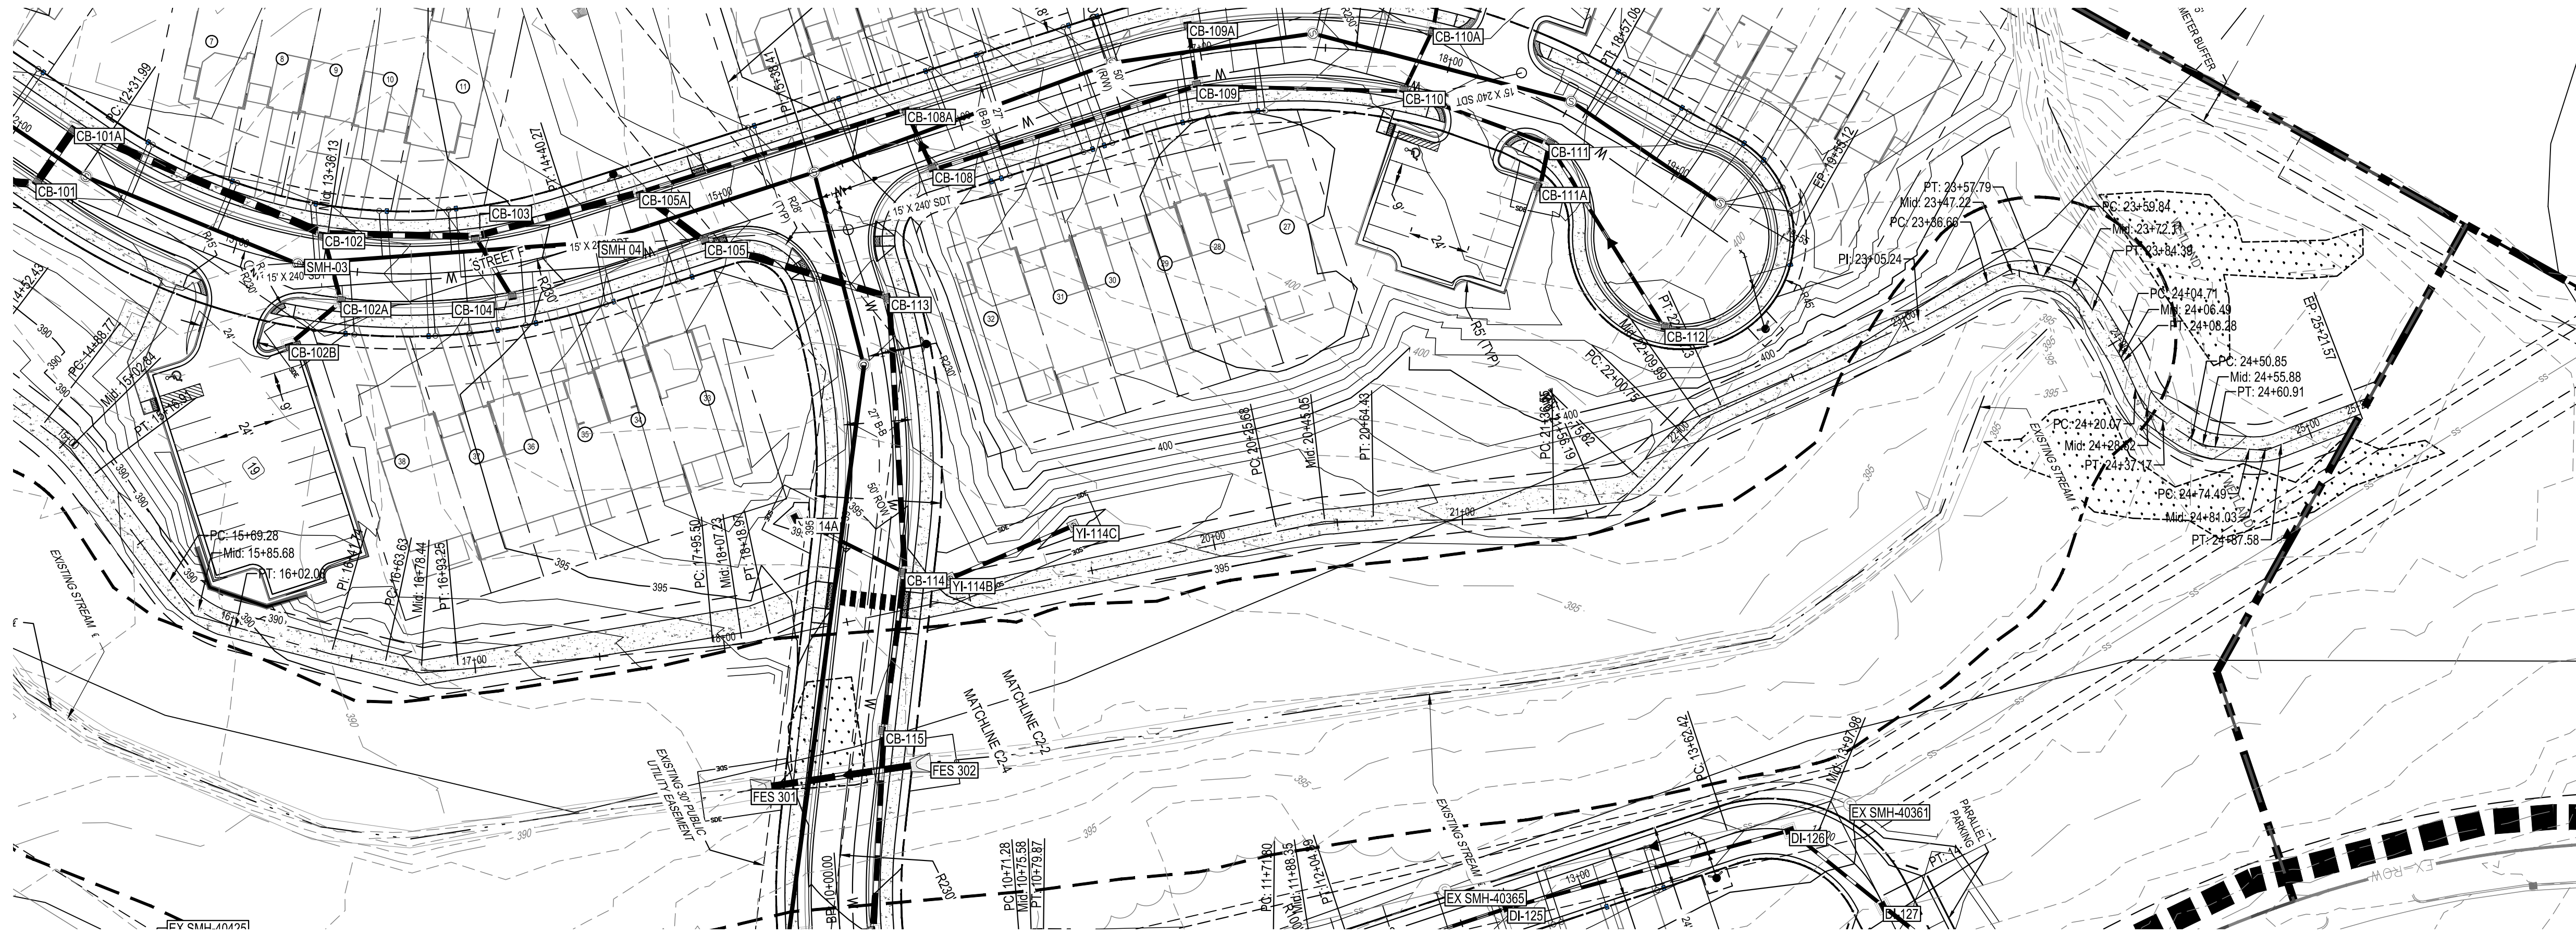

Know what's below.
Call before you dig.

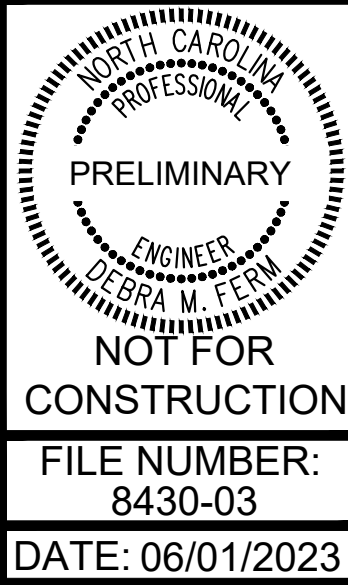


NOT FOR
CONSTRUCTION
FILE NUMBER:
8430-03
DATE: 06/01/2023

C6-26

PARKER RIDGE
82 SCHOOL STREET
ROLESVILLE / NORTH CAROLINA / 27571






LENNAR
CORPORAION
1100 PERIMETER PARK DRIVE, SUITE 112
MORRISVILLE / NORTH CAROLINA / 27560



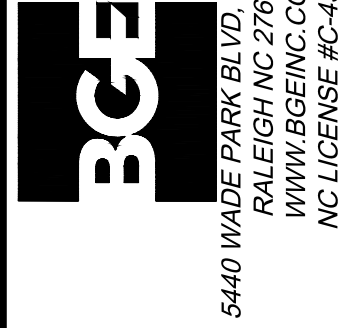





5440 WADE PARK BLVD, SUITE 102
RALEIGH NC 27607
WWW.BCEINC.COM
NC LICENSE #C-4397





DESIGNED BY: DF/CD
DRAWN BY: DF/JWM
REVIEWED BY: DF

REV	DATE	DESCRIPTION
06/01/2023	06/01/2023	PER TOWN OF ROLESVILLE COMMENT
04/03/2023	04/03/2023	INITIAL SUBMITTAL

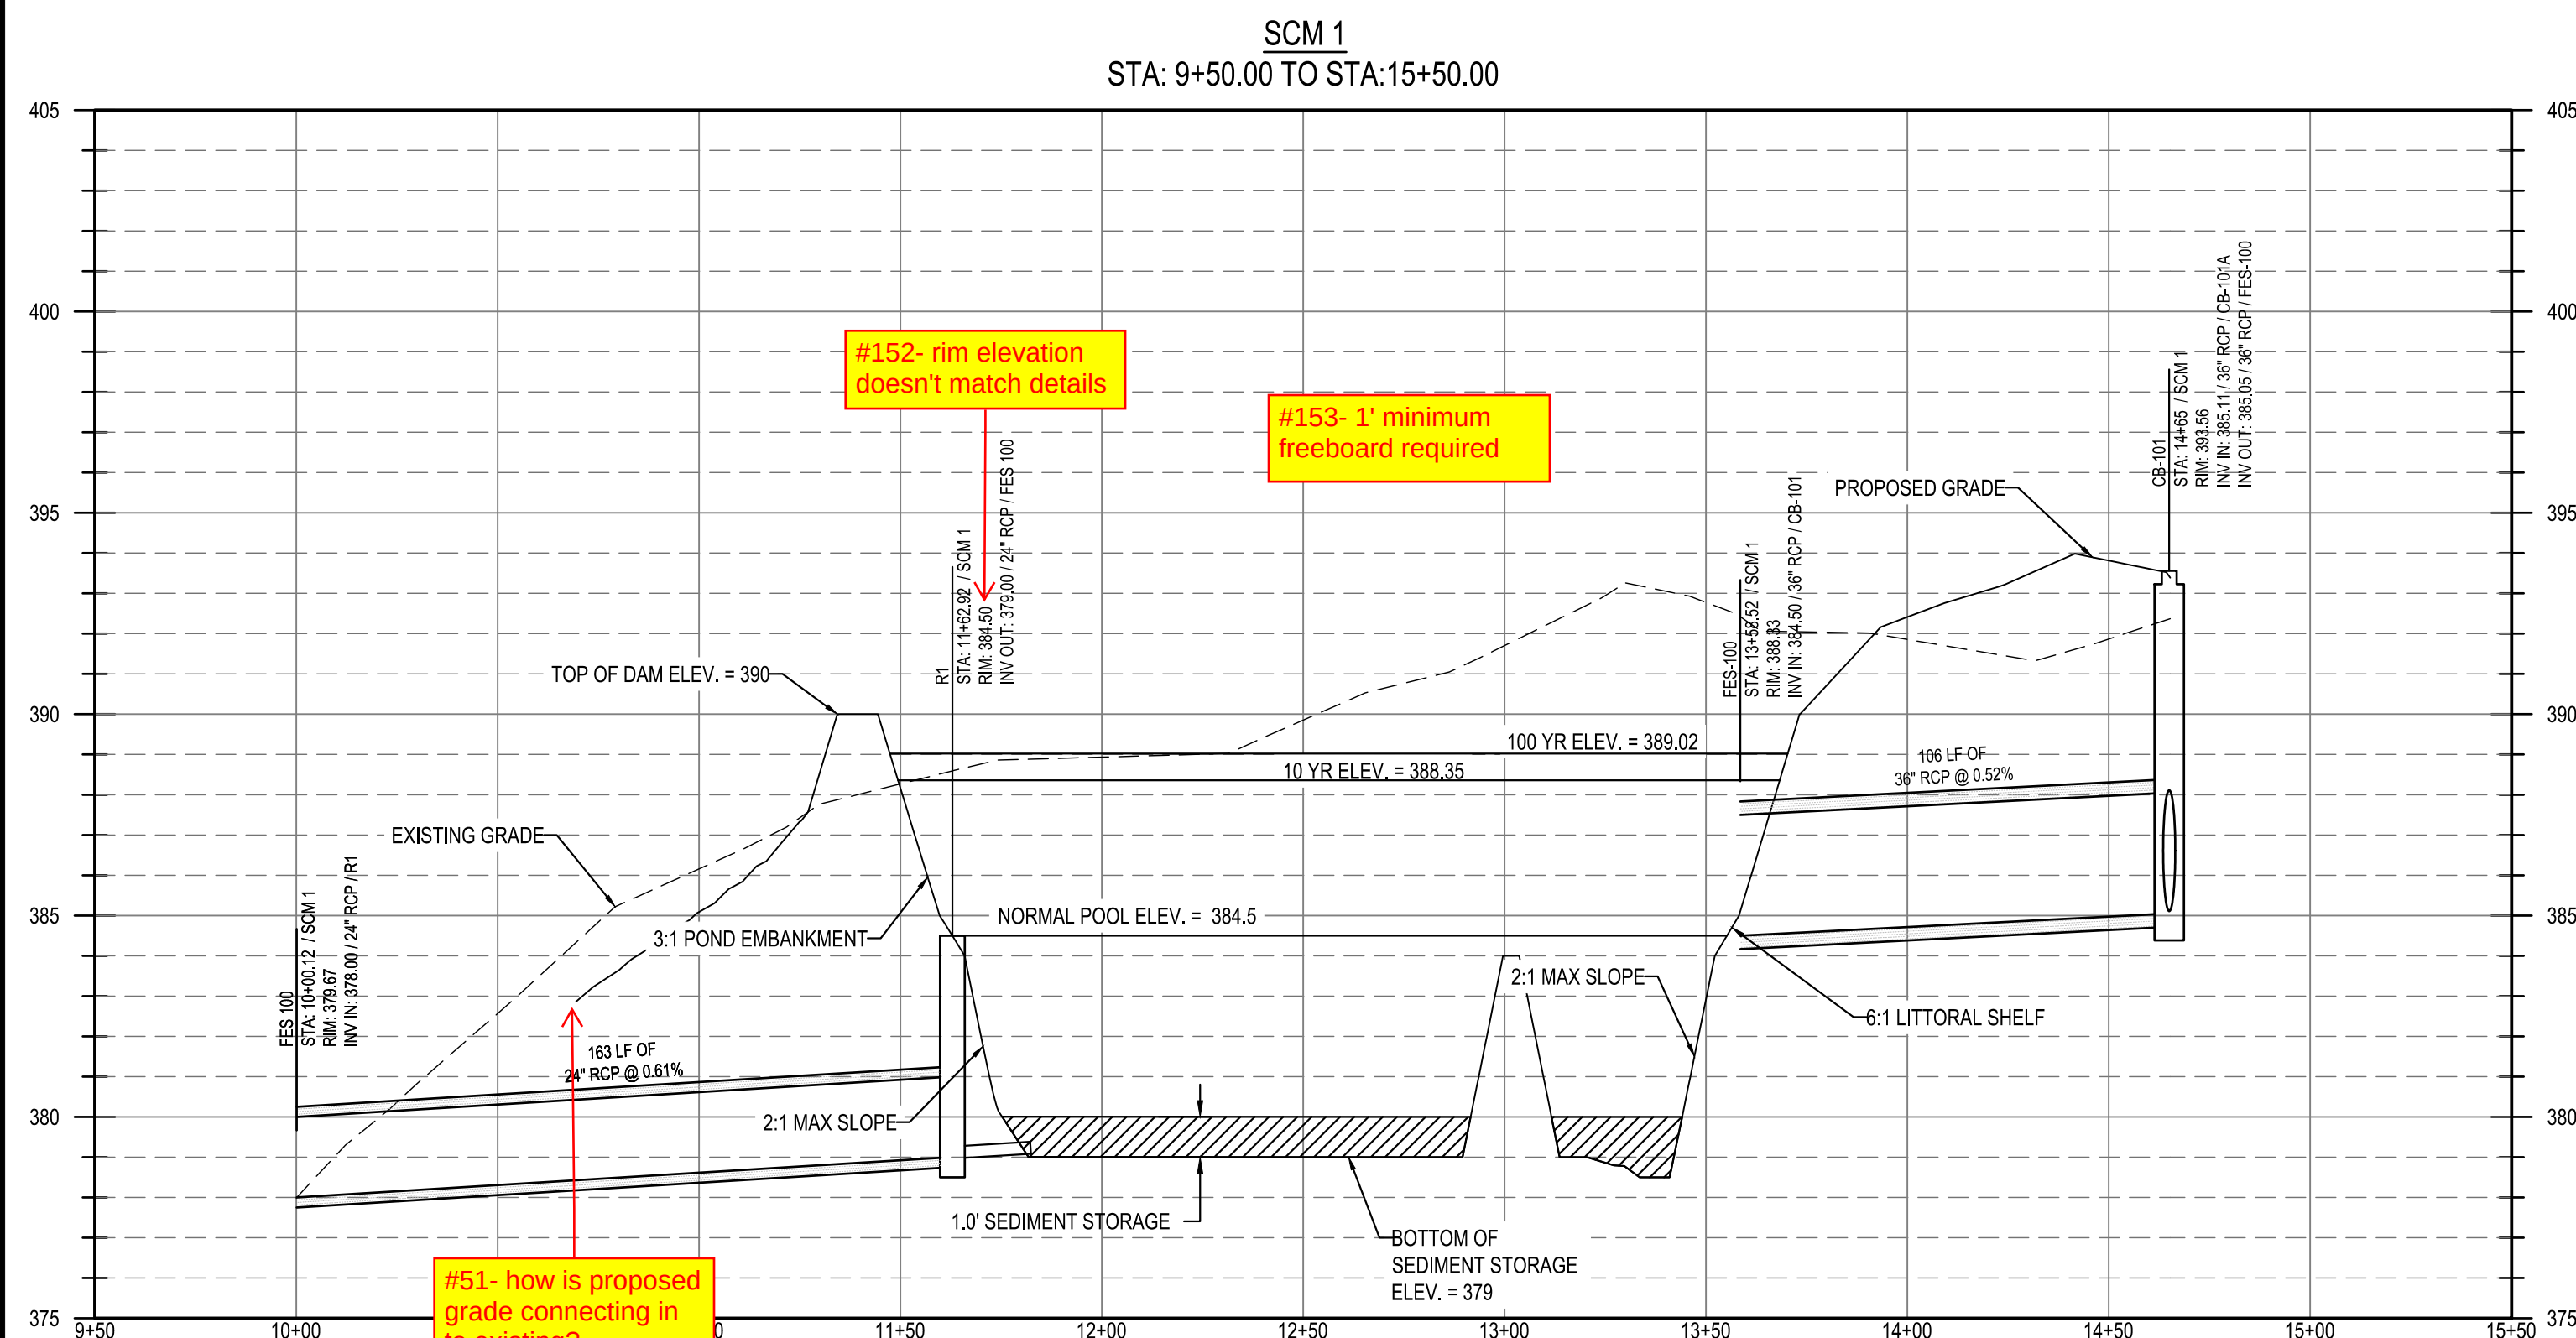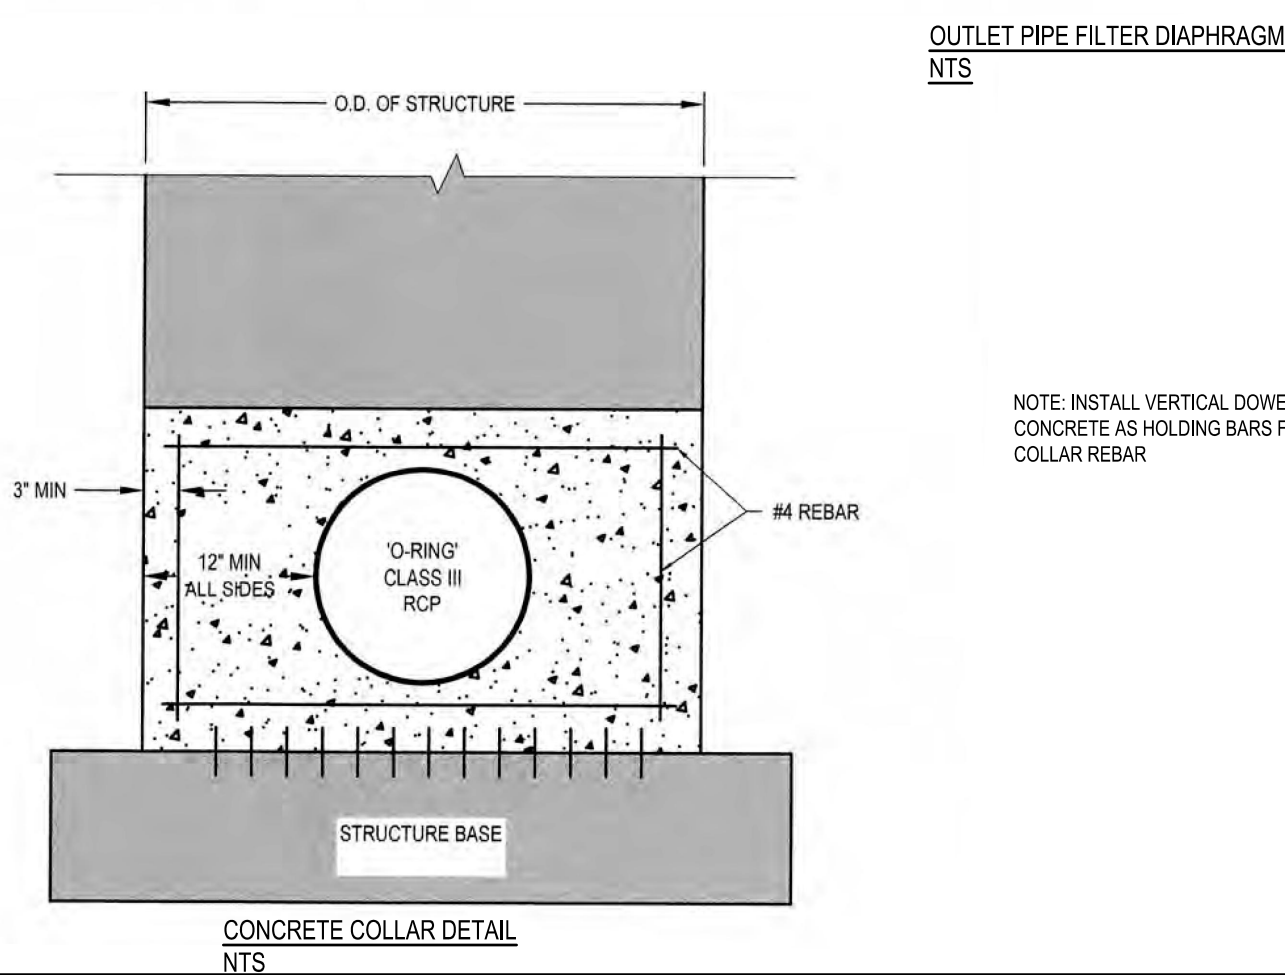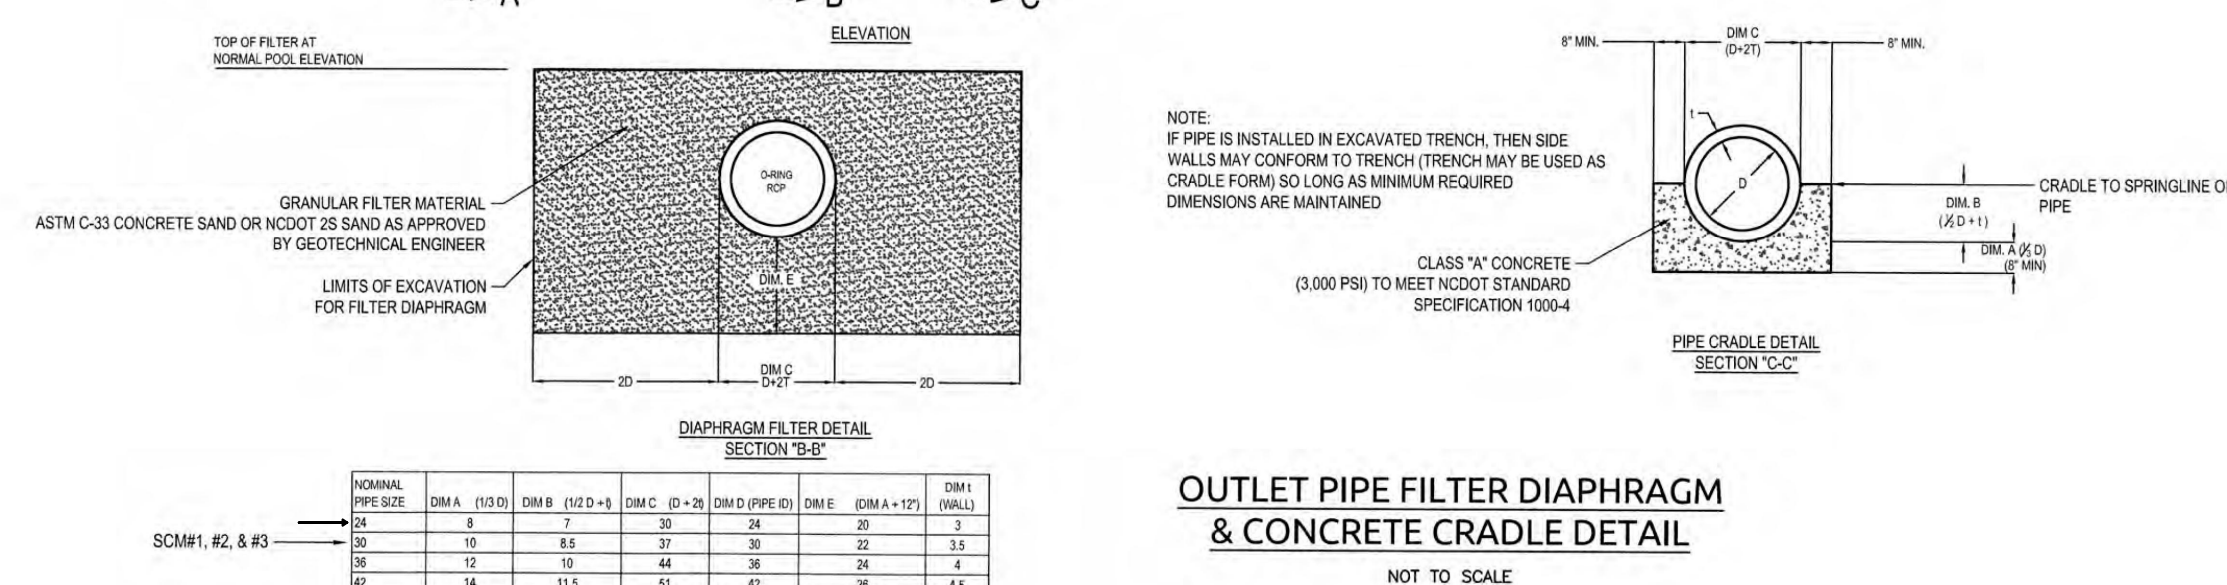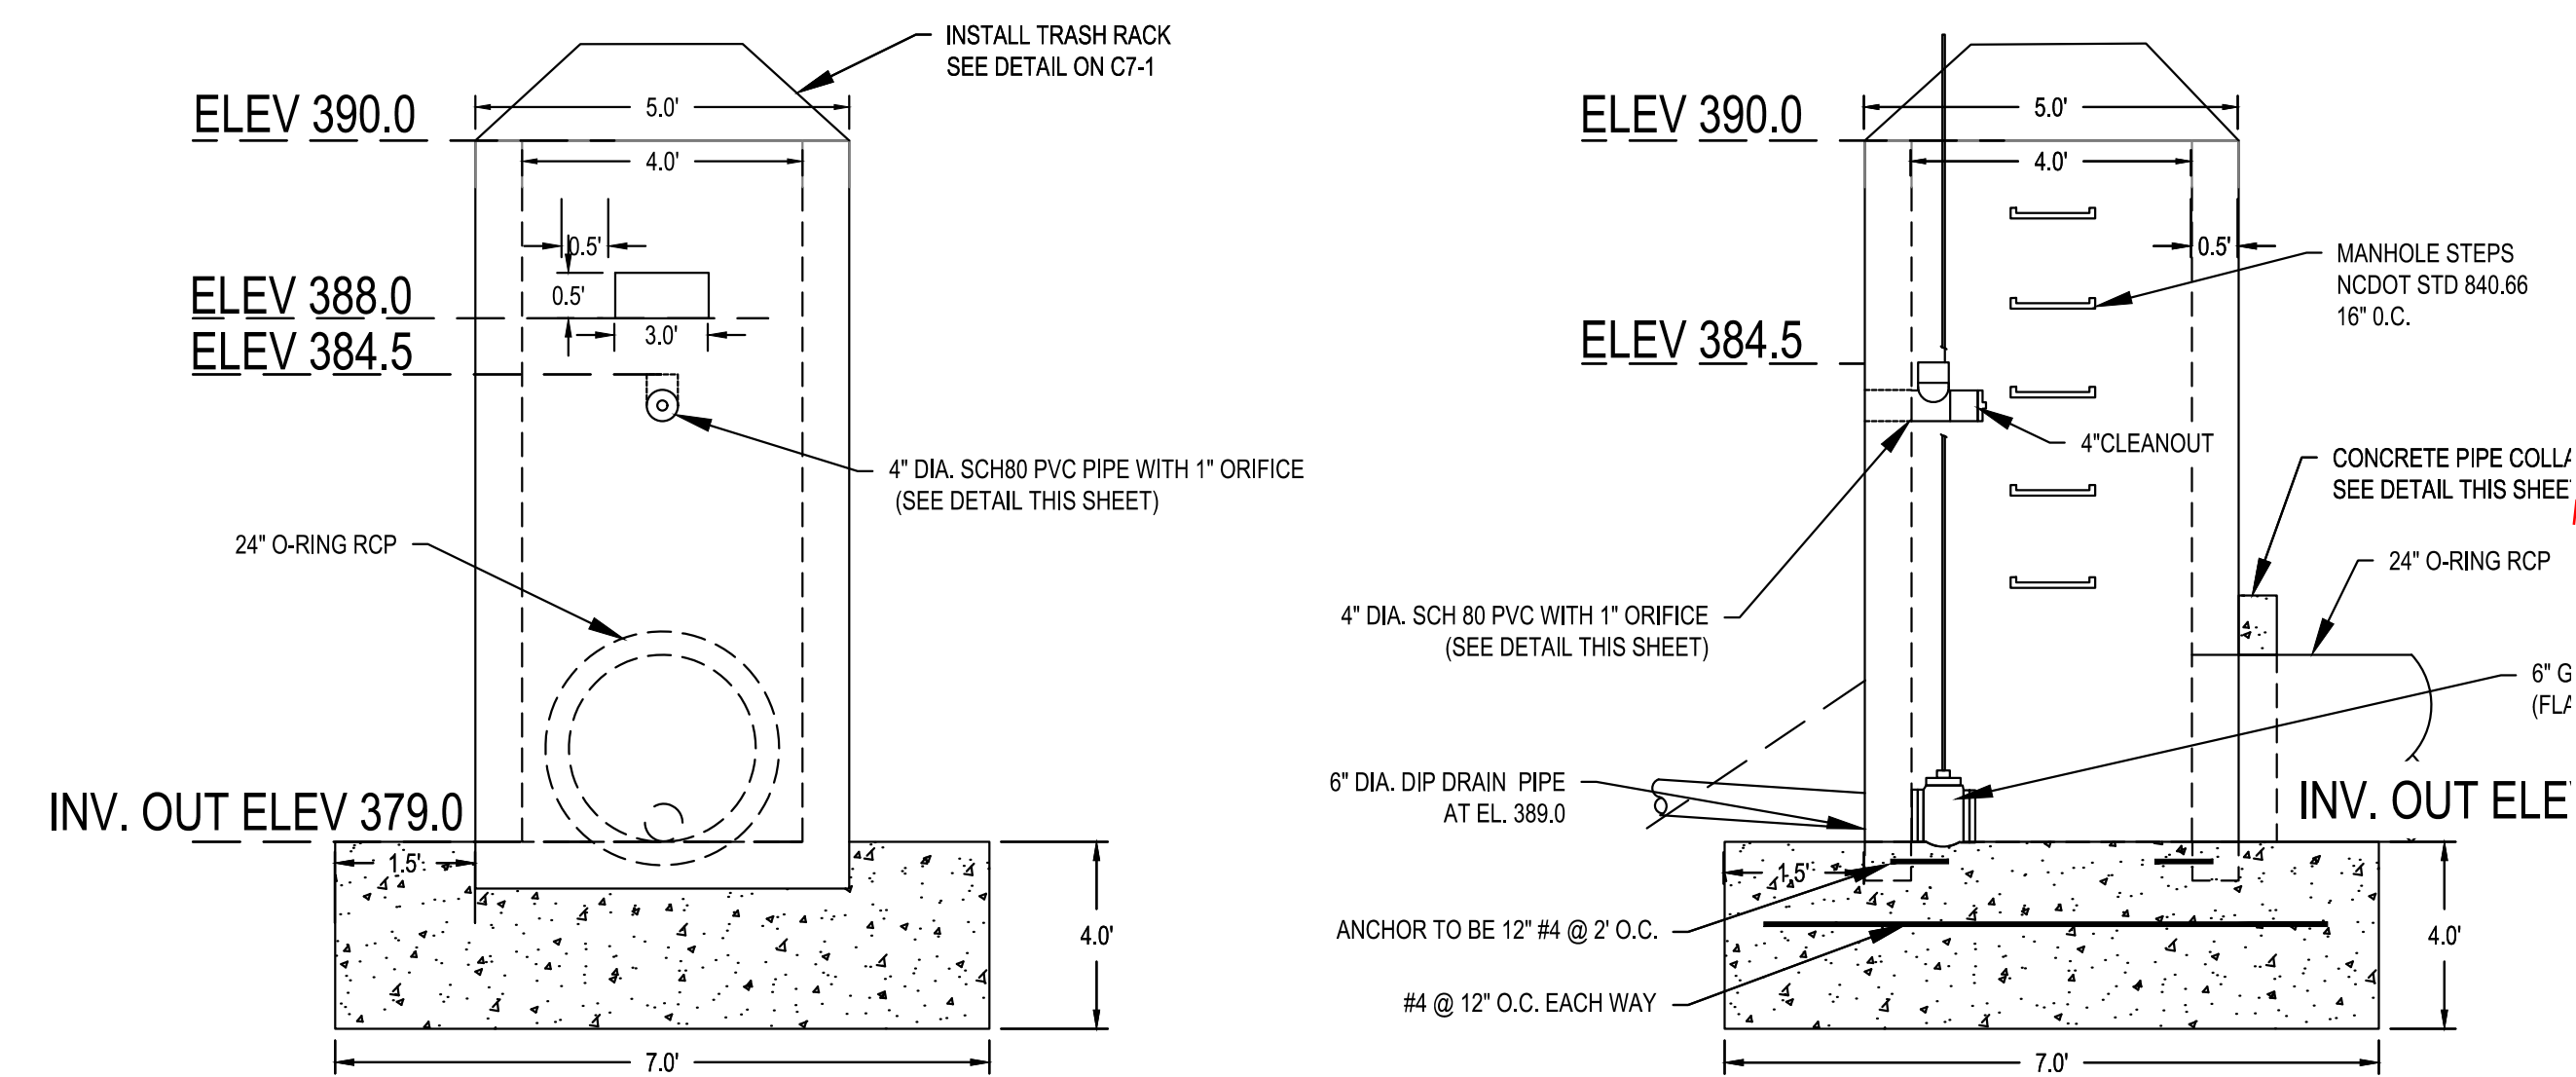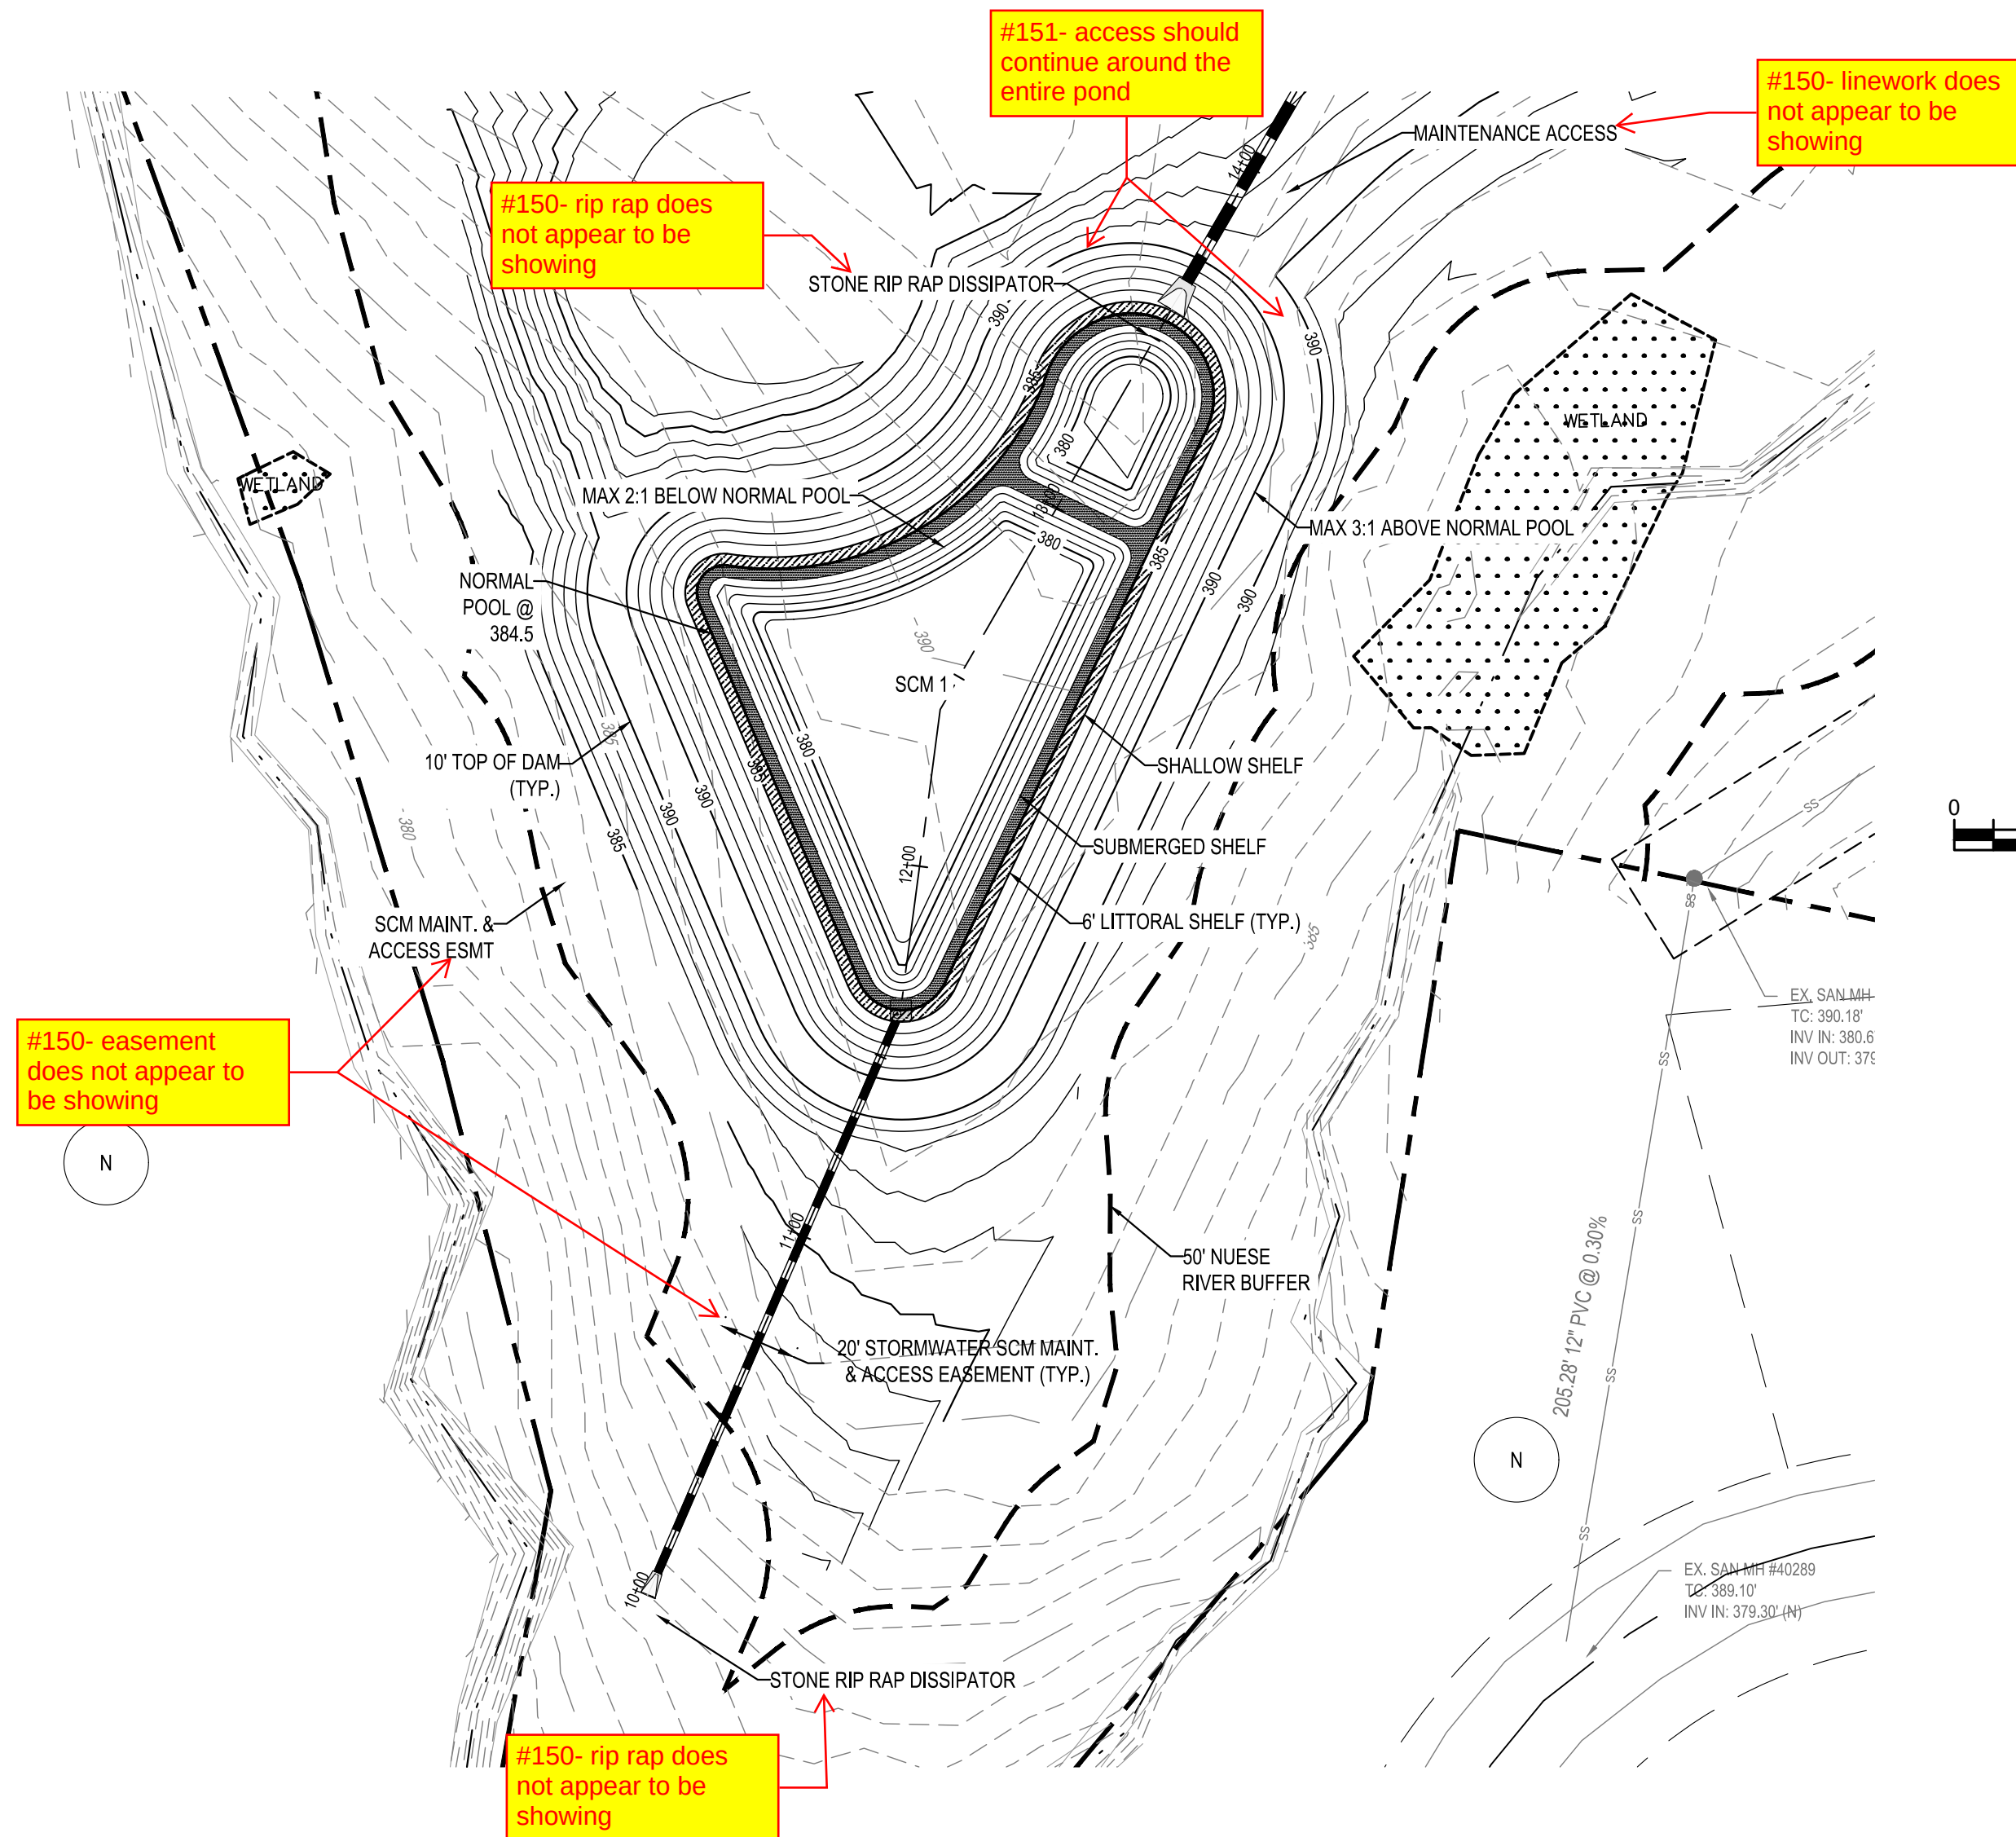


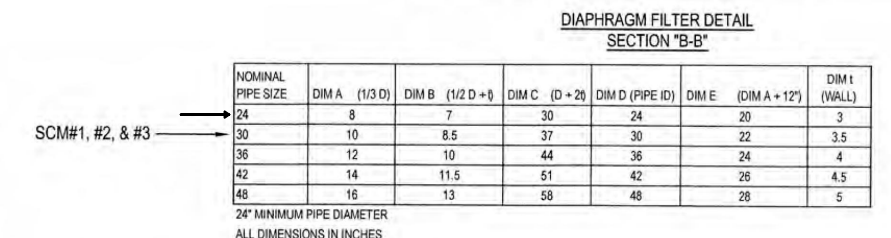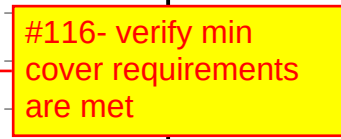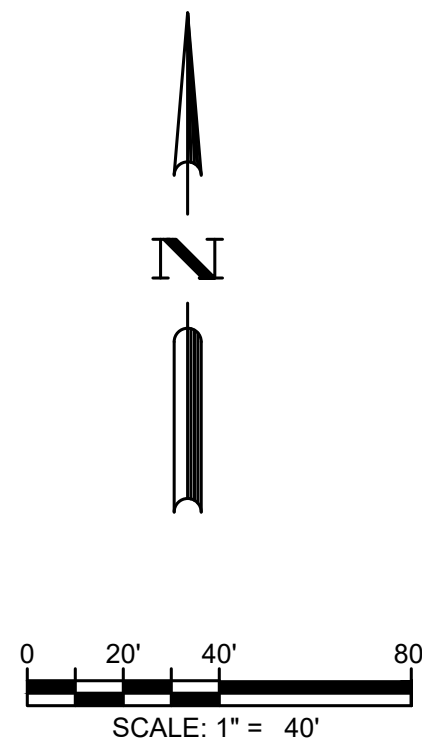

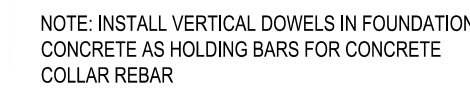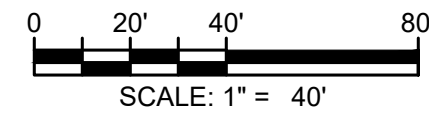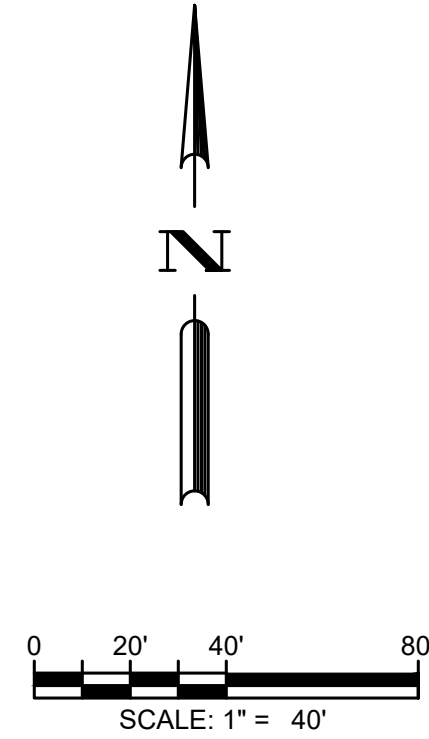


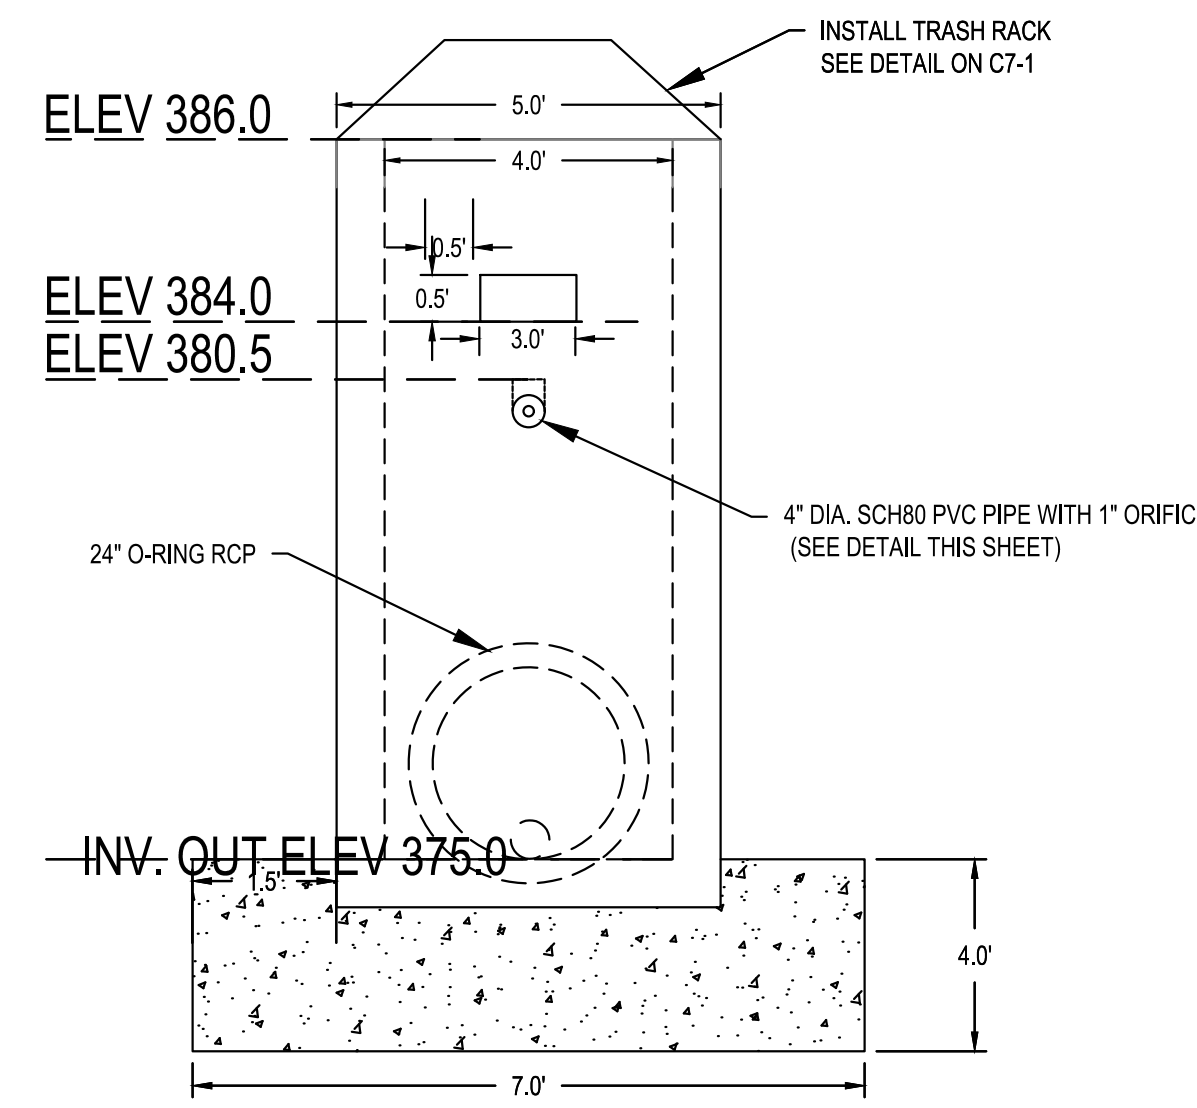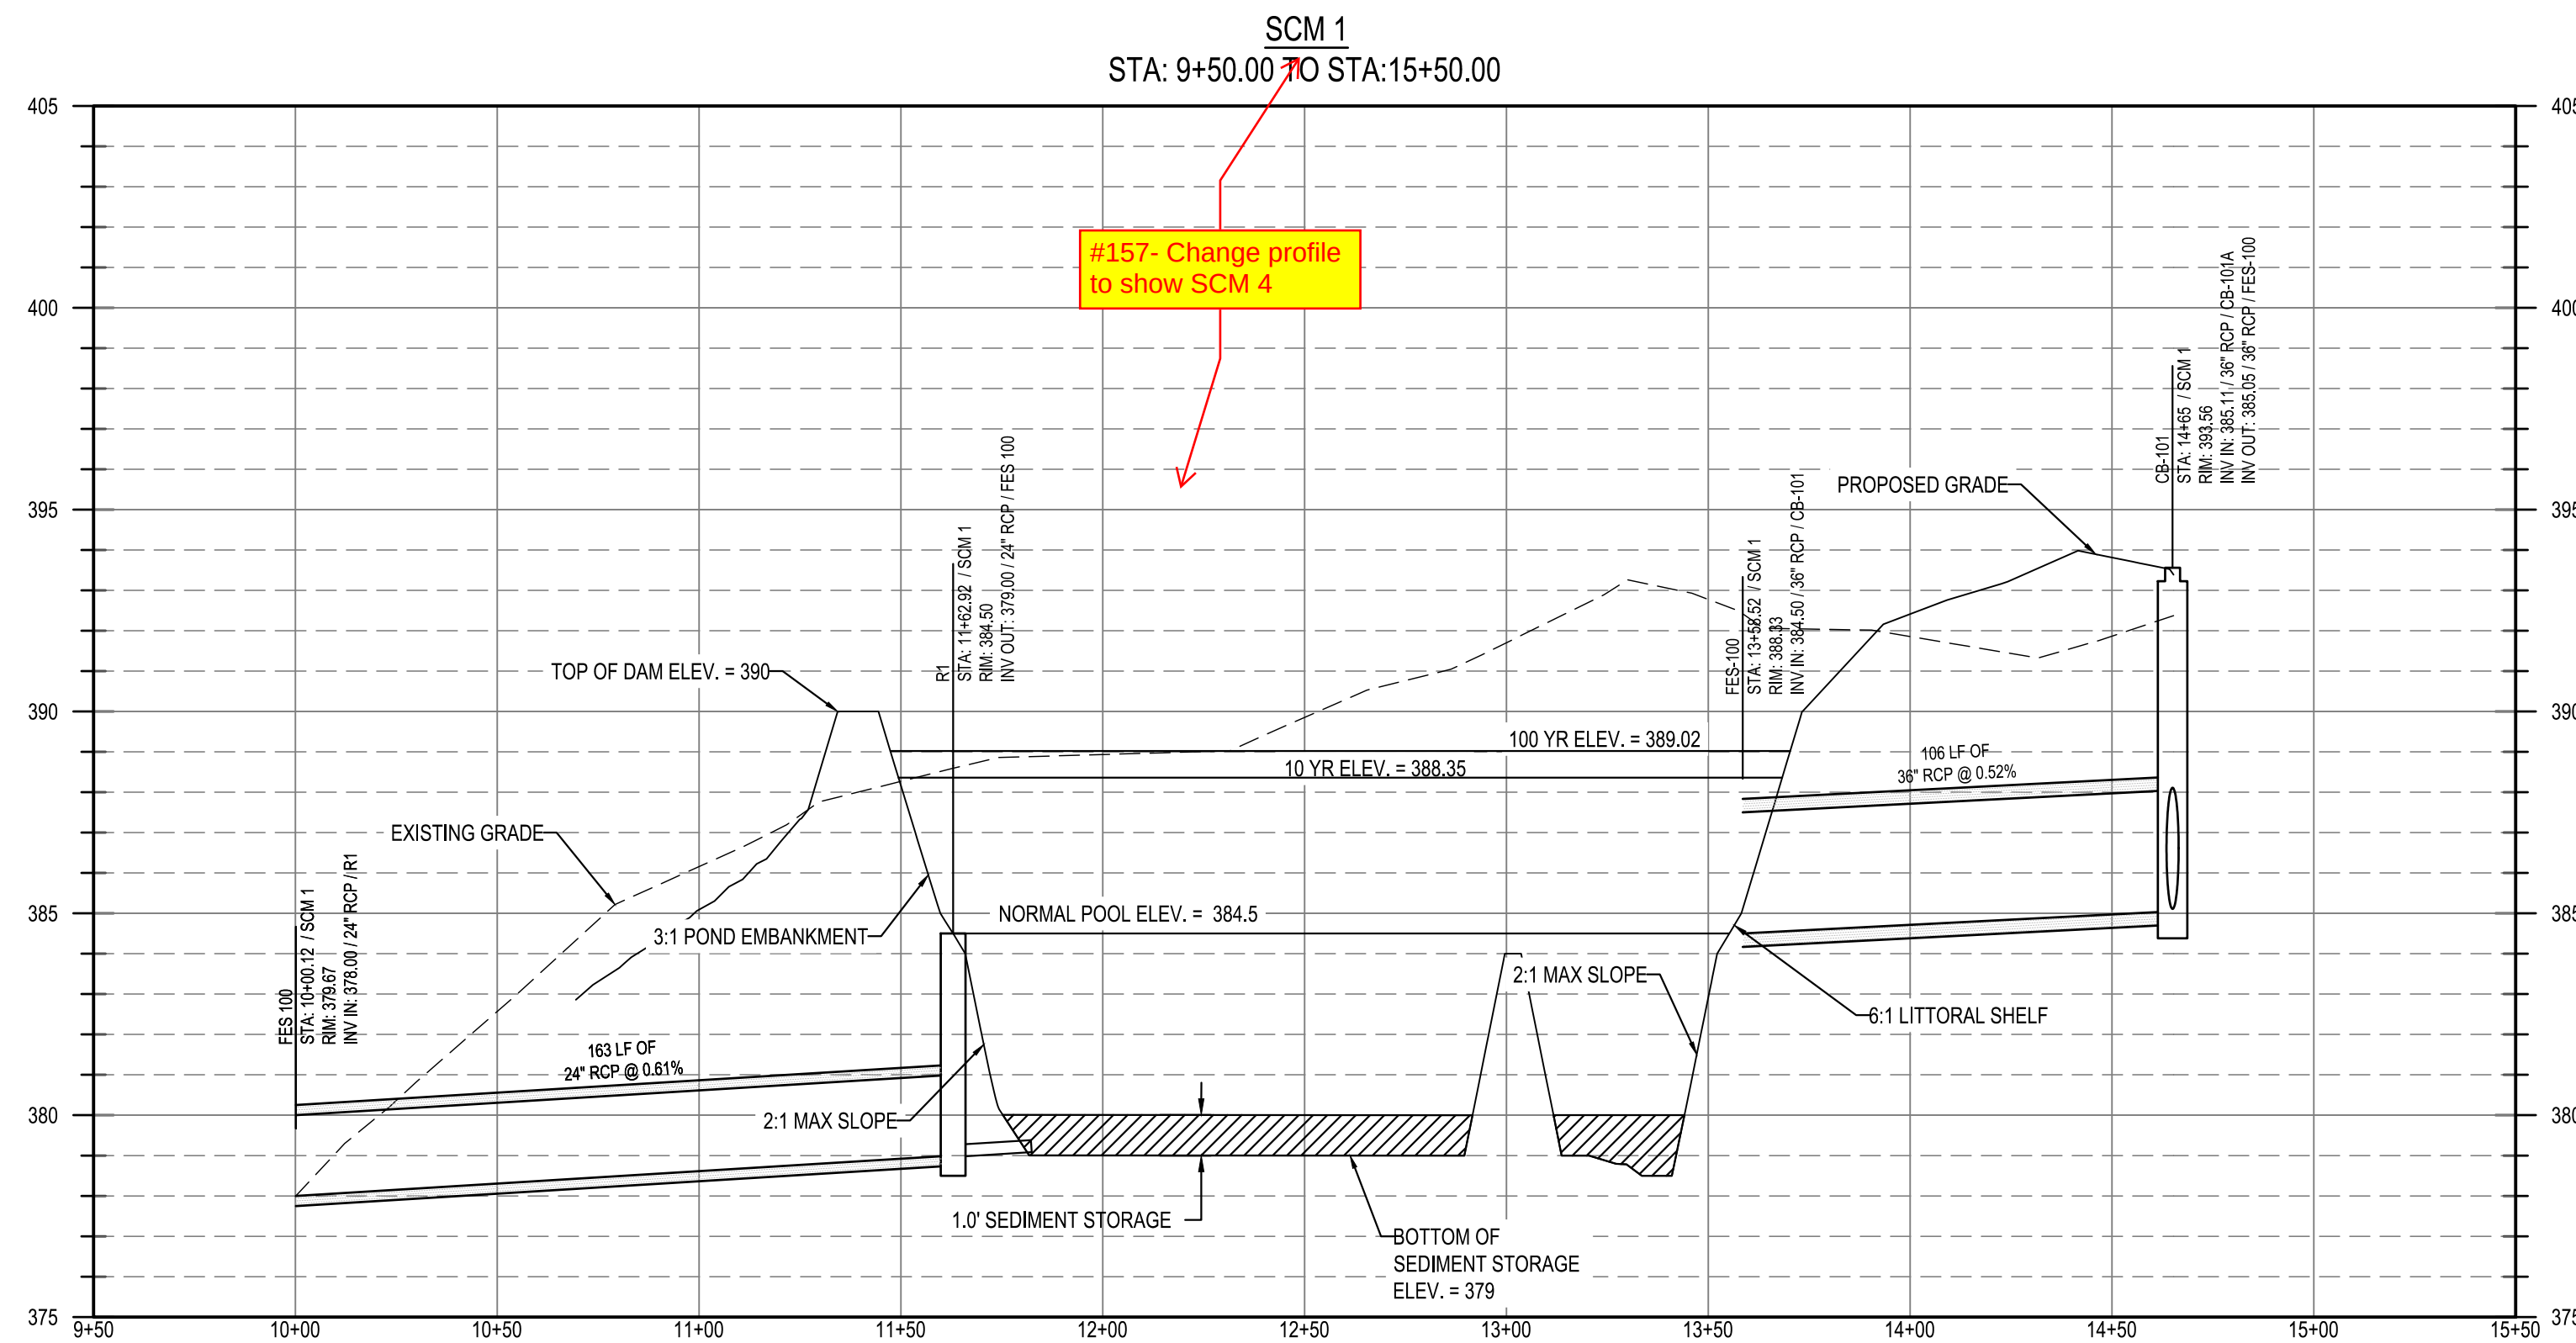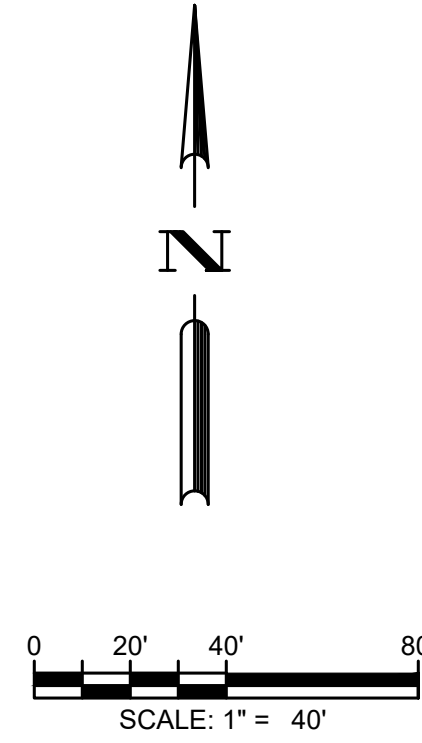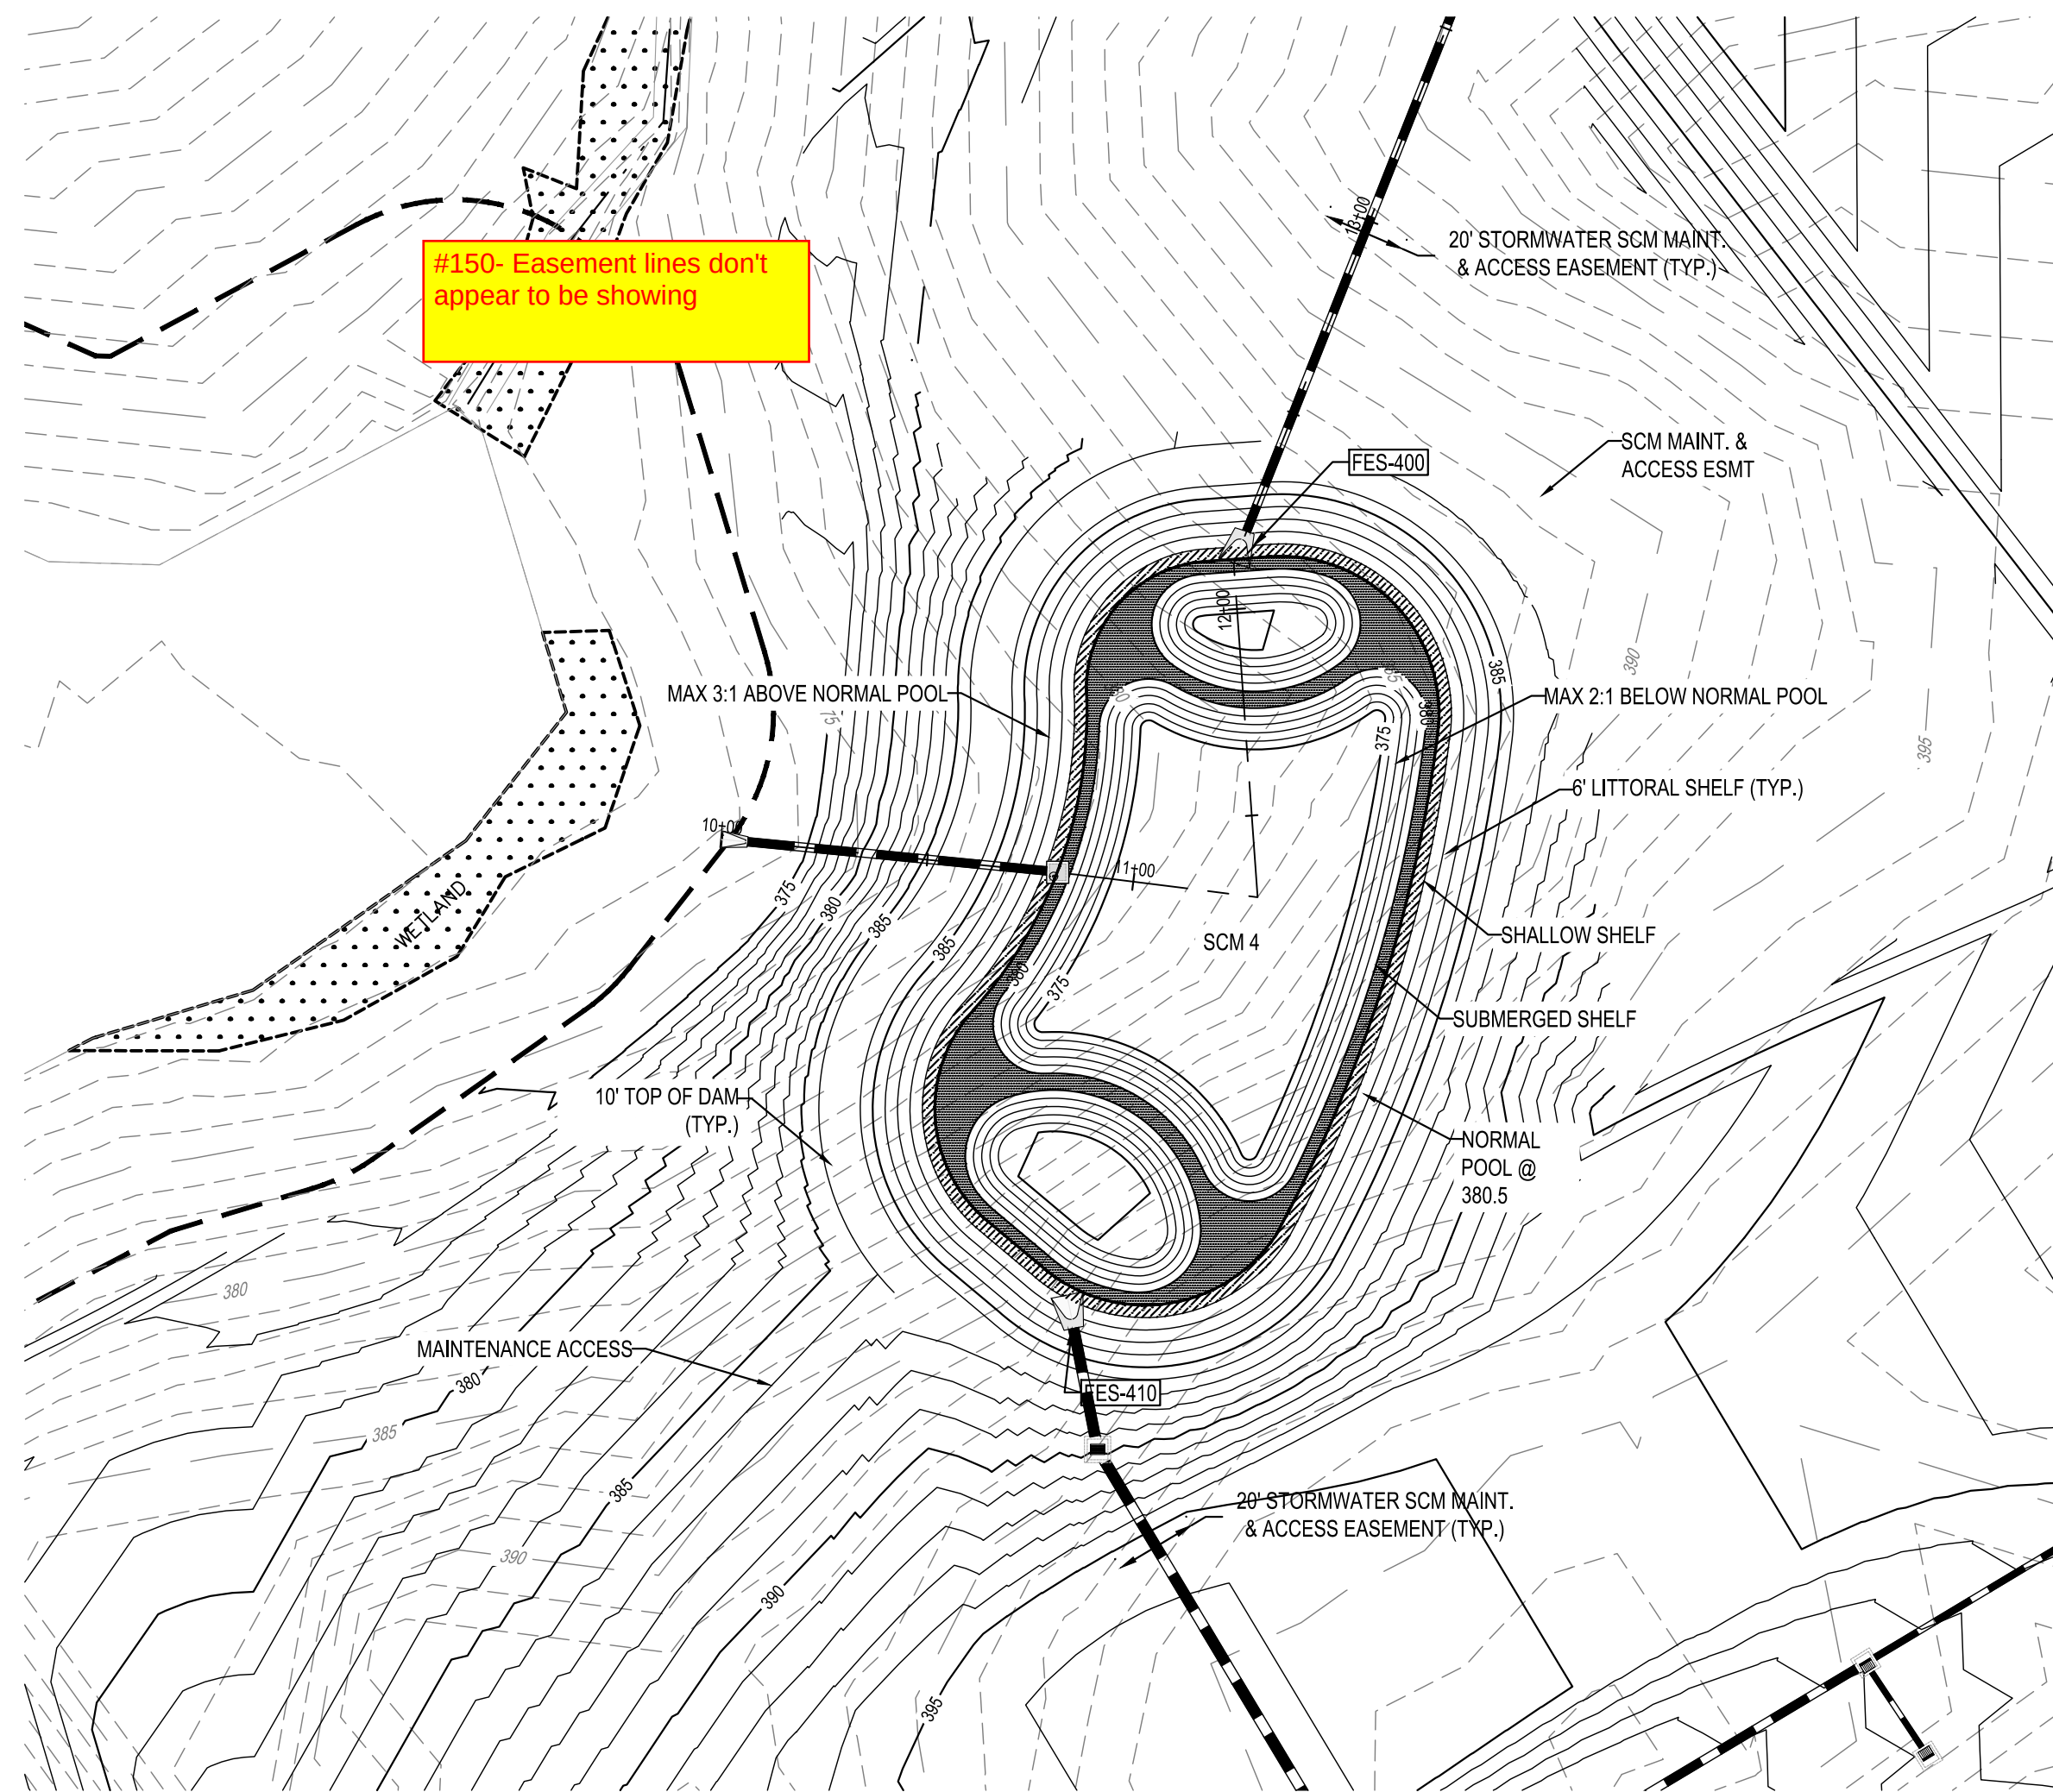


RISER STRUCTURE - WEST
N.T.S.

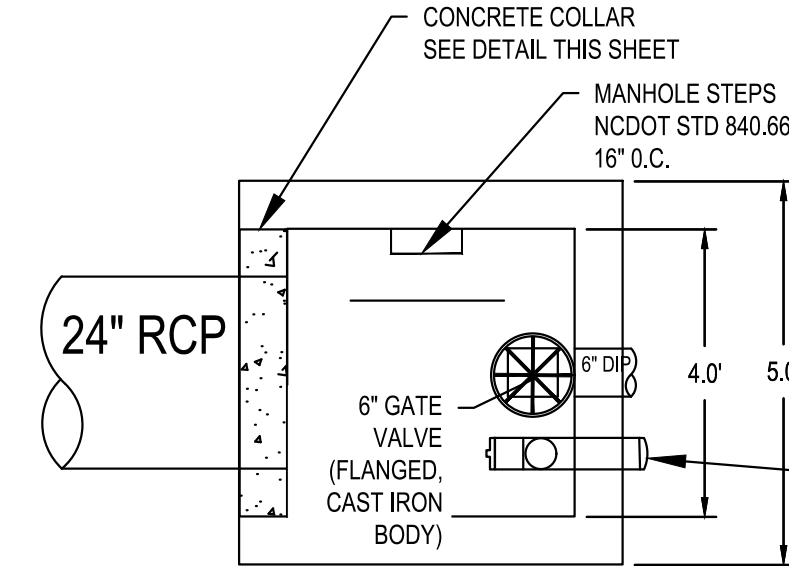





RISER STRUCTURE - TOP
N.T.S.

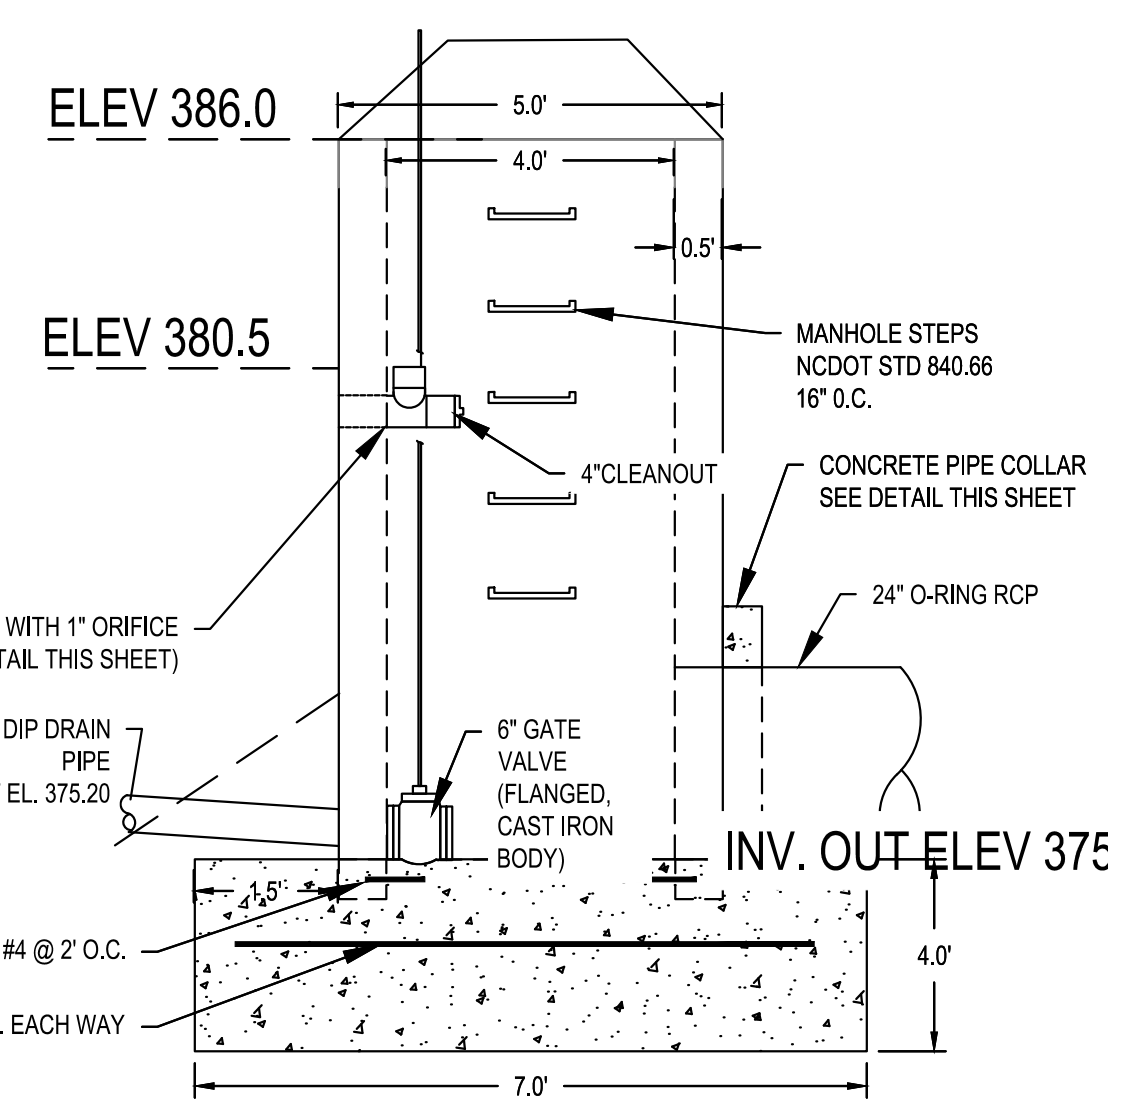

RISER STRUCTURE - SOUTH
N.T.S.

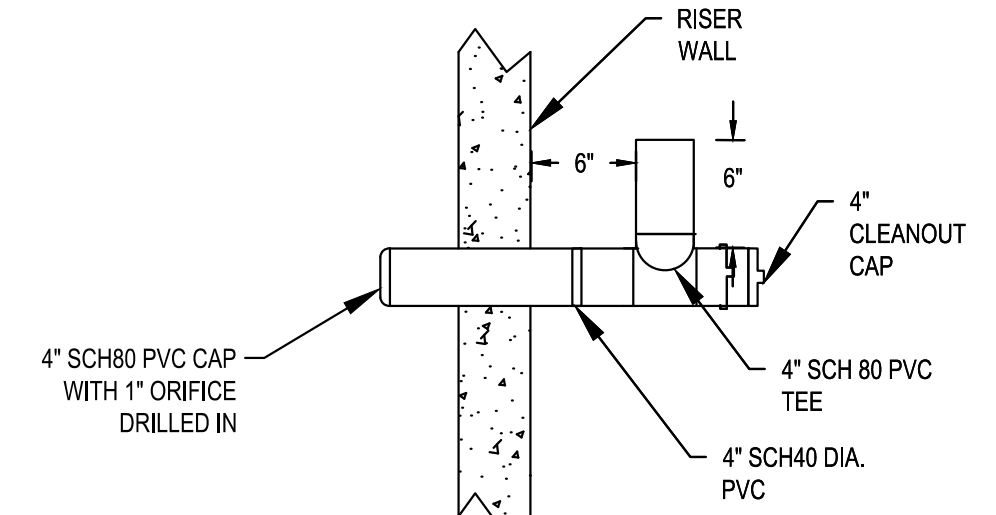

4" ORIFICE UPTURNED PIPE
N.T.S.

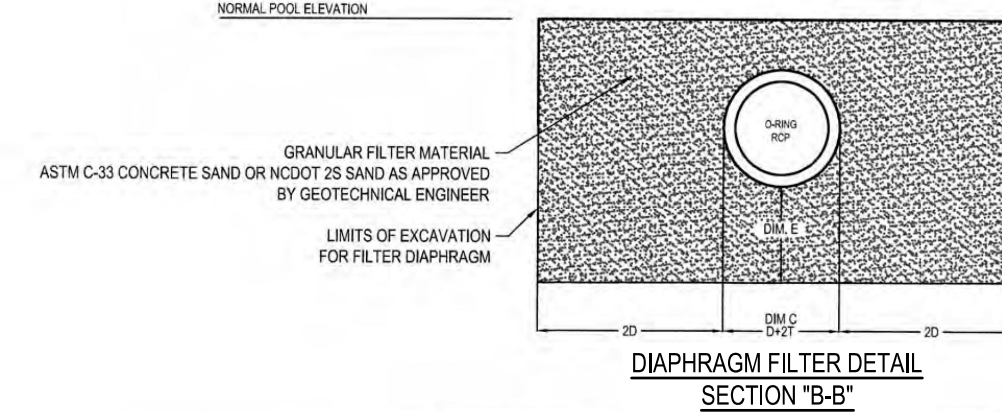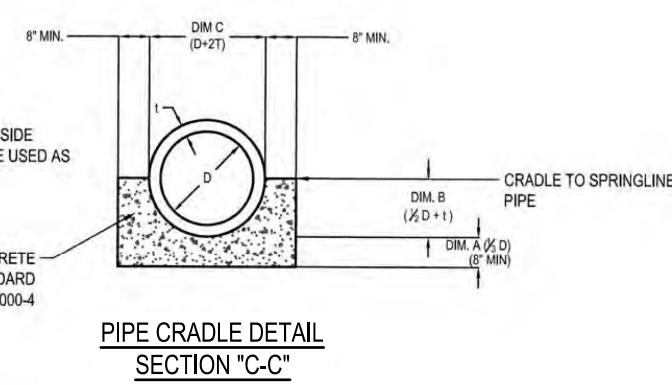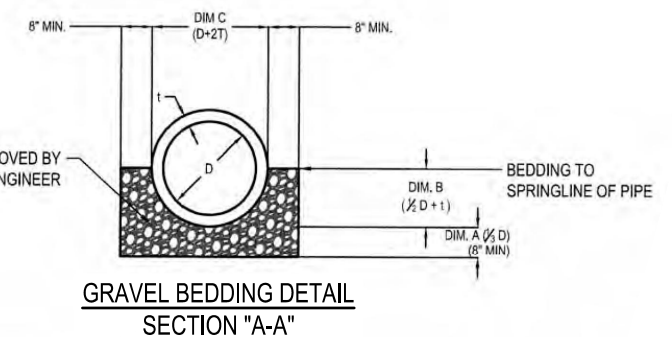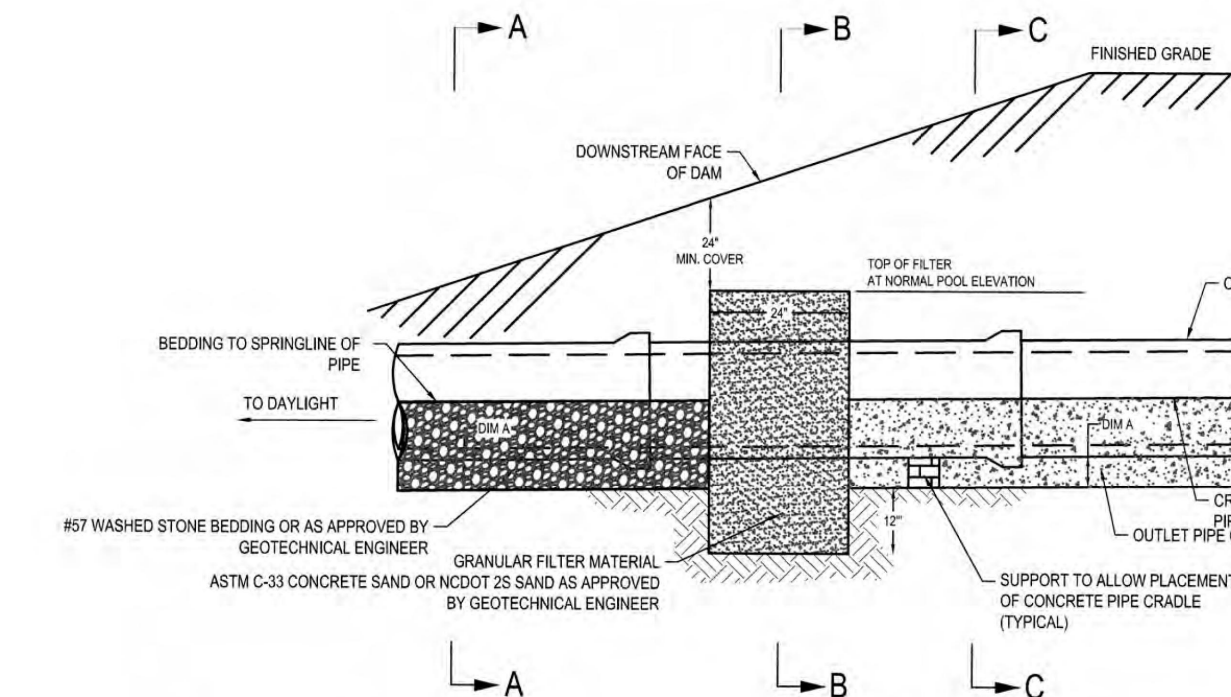


Normal Pipe Size	DM A (10.5)	DM B (10.5)	DM C (10.5)	DM D (10.5)	DM E (10.5)	DM F (10.5)
24"	10.5	10.5	10.5	10.5	10.5	10.5
36"	16.5	16.5	16.5	16.5	16.5	16.5
48"	22.5	22.5	22.5	22.5	22.5	22.5
60"	28.5	28.5	28.5	28.5	28.5	28.5
72"	34.5	34.5	34.5	34.5	34.5	34.5
84"	40.5	40.5	40.5	40.5	40.5	40.5
96"	46.5	46.5	46.5	46.5	46.5	46.5
108"	52.5	52.5	52.5	52.5	52.5	52.5
120"	58.5	58.5	58.5	58.5	58.5	58.5

NOTE:
IF PIPE IS INSTALLED IN EXCAVATED TRENCH, THEN SIDE WALLS MAY CONFORM TO TRENCH (TRENCH MAY BE USED AS CRADLE FORM) SO LONG AS MINIMUM REQUIRED DIMENSIONS ARE MAINTAINED

CLASS "C" CONCRETE
(3,000 PSI) TO MEET NCDOT STANDARD SPECIFICATION 1000.4

OUTLET PIPE FILTER DIAPHRAGM
NTS

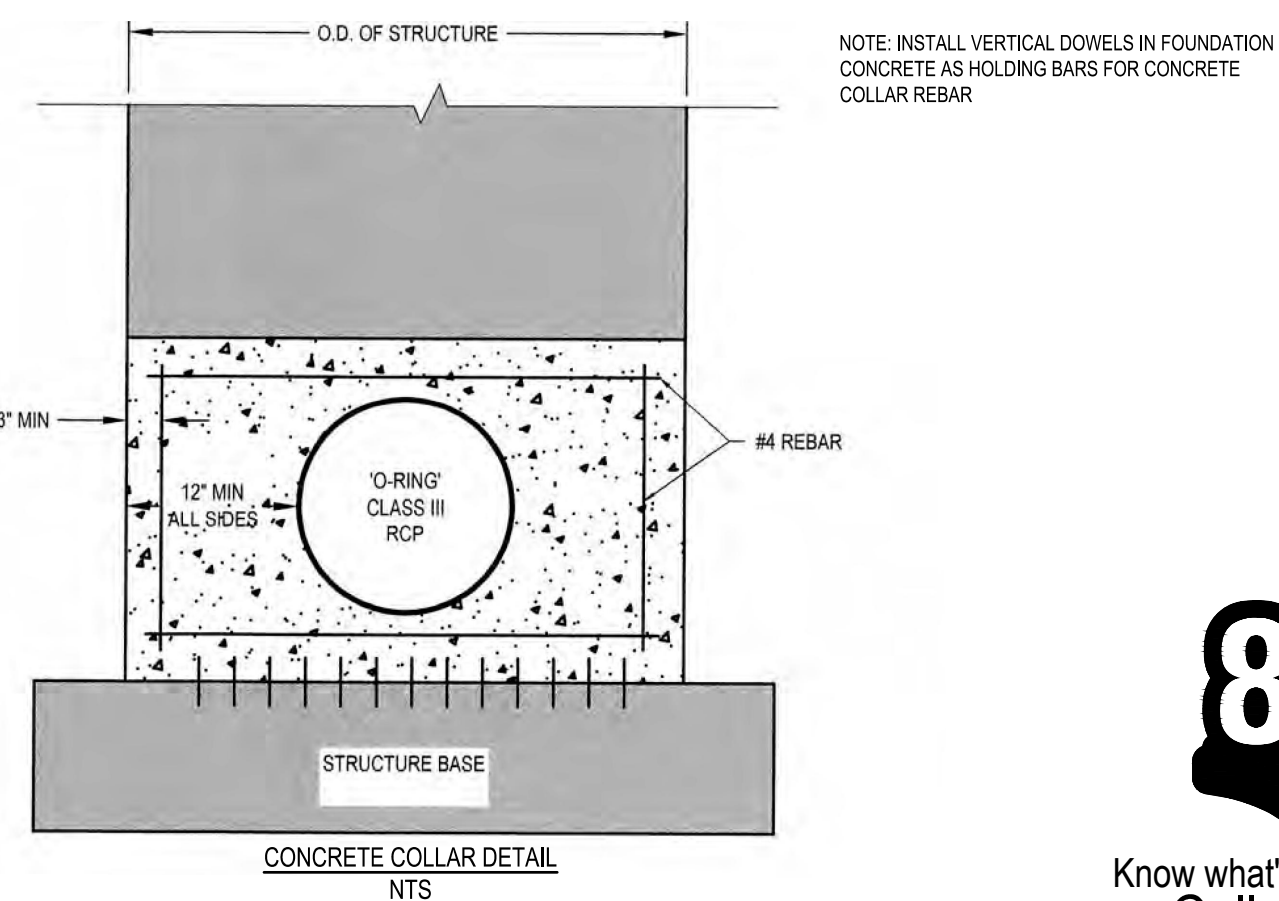

CONCRETE COLLAR DETAIL
NTS



DESIGNED BY: DF/CD

DRAWN BY: DF/JWM

REVIEWED BY: DF

06/01/2023

04/03/2023

PER TOWN OF ROLESVILLE COMMENT

INITIAL SUBMITTAL

5440 WADE PARK BLVD, SUITE 102

RALEIGH NC 27607

WWW.BCEINC.COM

NC LICENSE #C-4397

LENNA

CORPORAION

1100 PERIMETER PARK DRIVE, SUITE 112

MORRISVILLE / NORTH CAROLINA / 27560

PARKER RIDGE

82 SCHOOL STREET

ROLESVILLE / NORTH CAROLINA / 27571

SCM 4 PLAN AND PROFILE

PRELIMINARY










NOT FOR CONSTRUCTION

FILE NUMBER: 8430-03

DATE: 06/01/2023

C7-3









\\browngay.net\panzura\Regions\NCA\Projects\Lennar\8430-03 - DWG\PlanSheets\On-Site\C2-2 - EROS-DET1.dwg Layout: C8-2 EROSION CONTROL DETAILS (1 OF 2) Plotted: 6/1/2023 3:36:06 PM

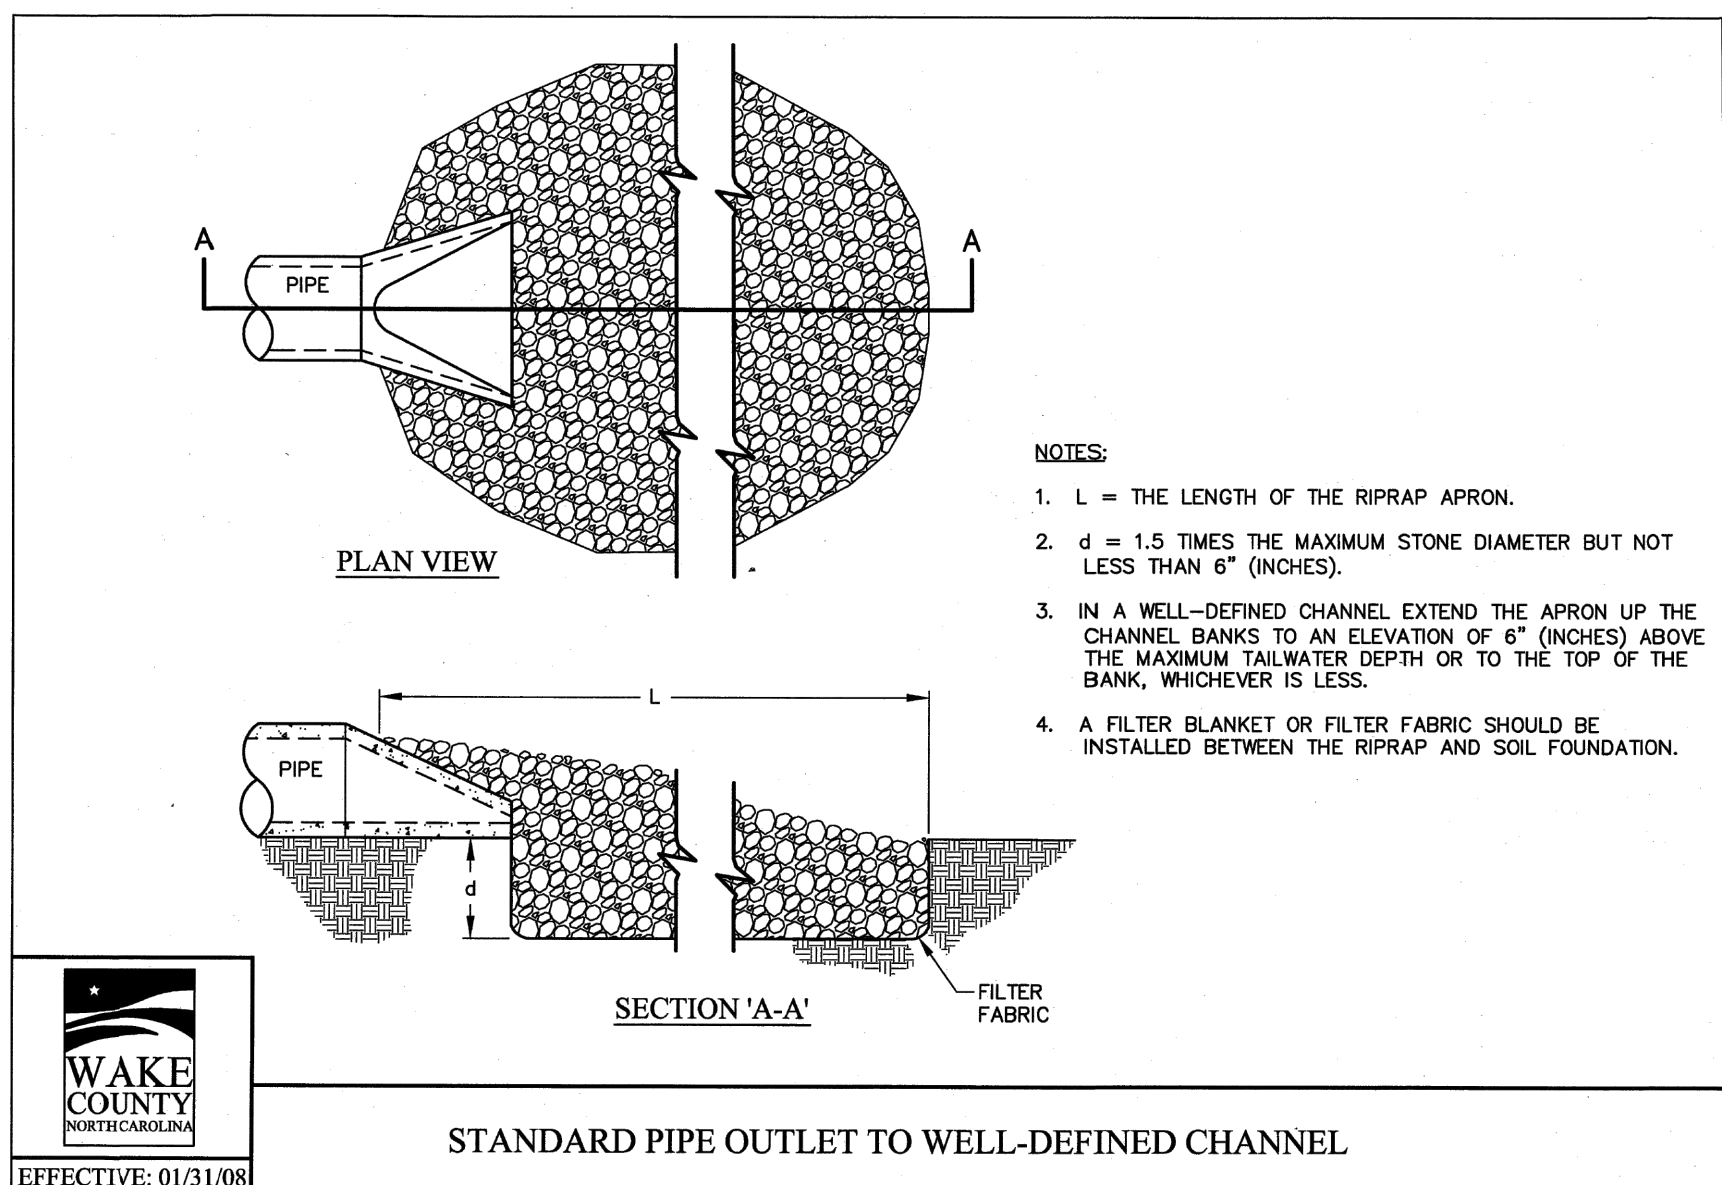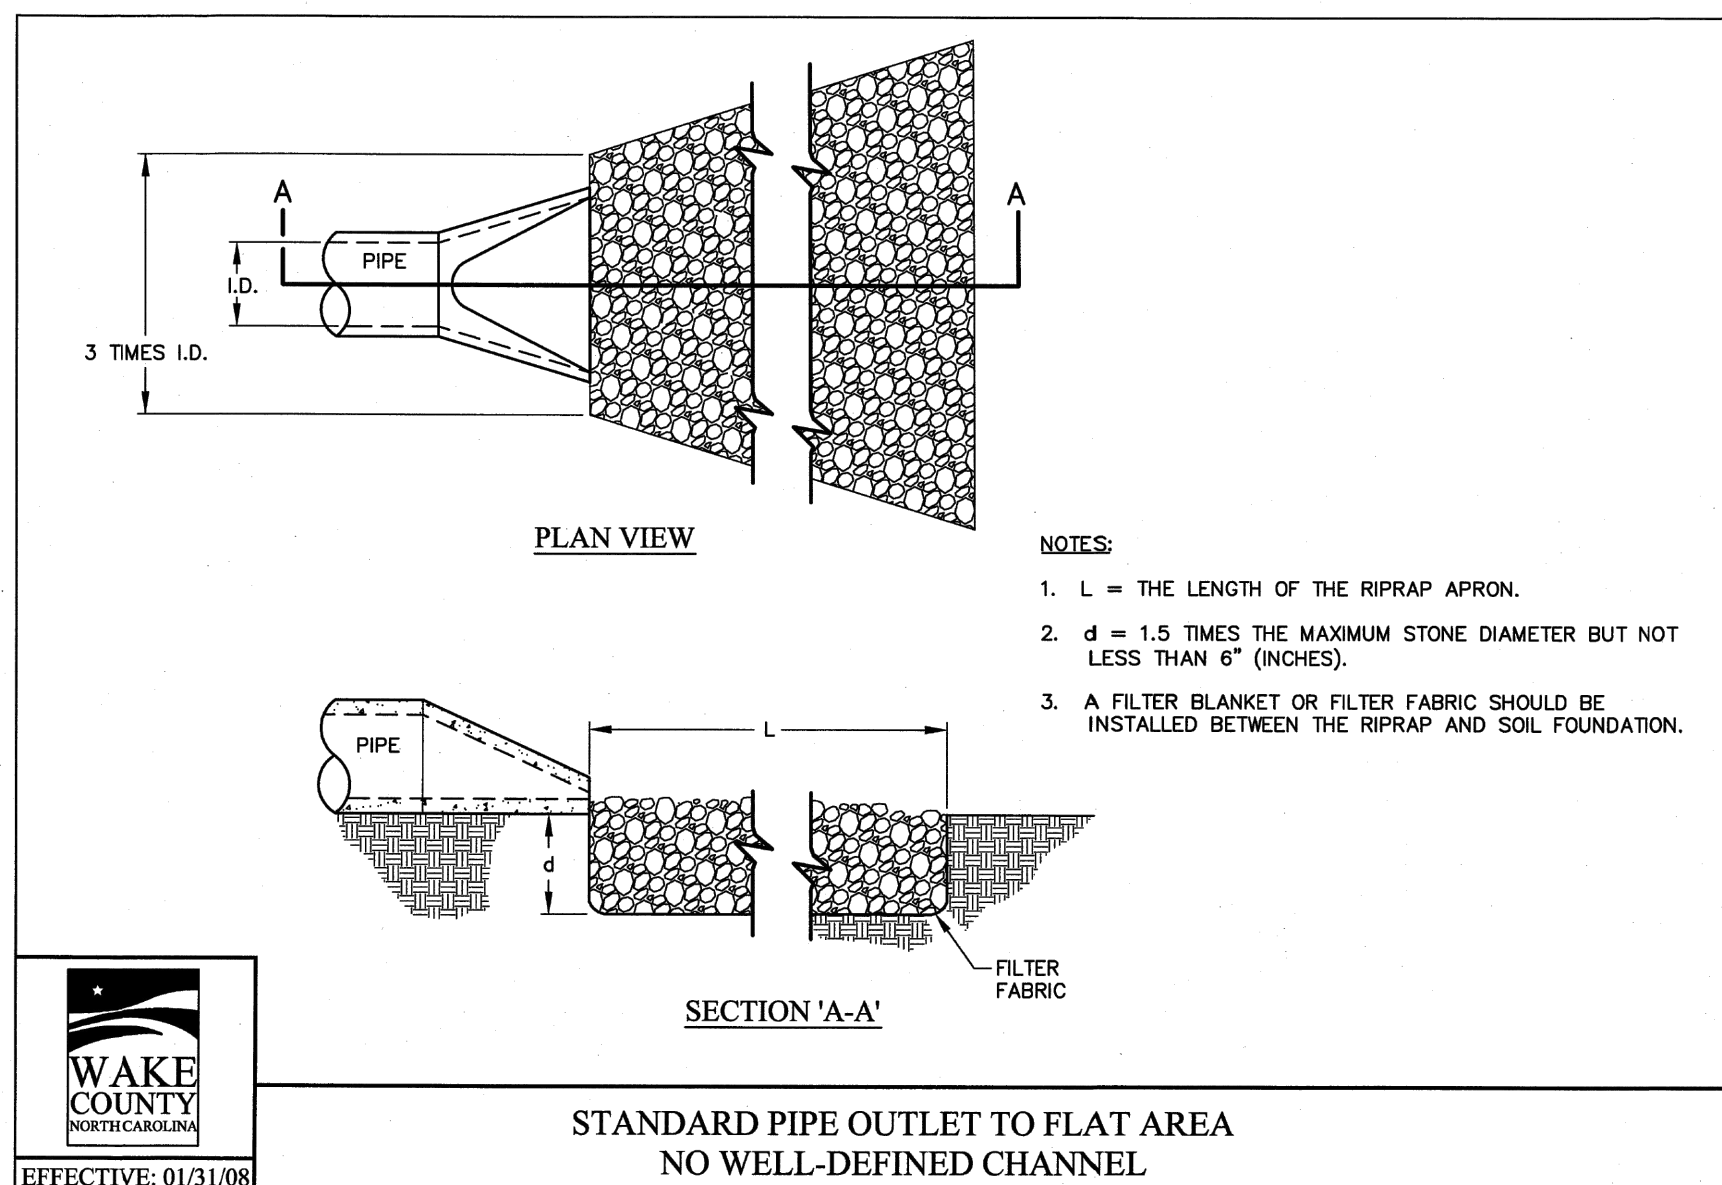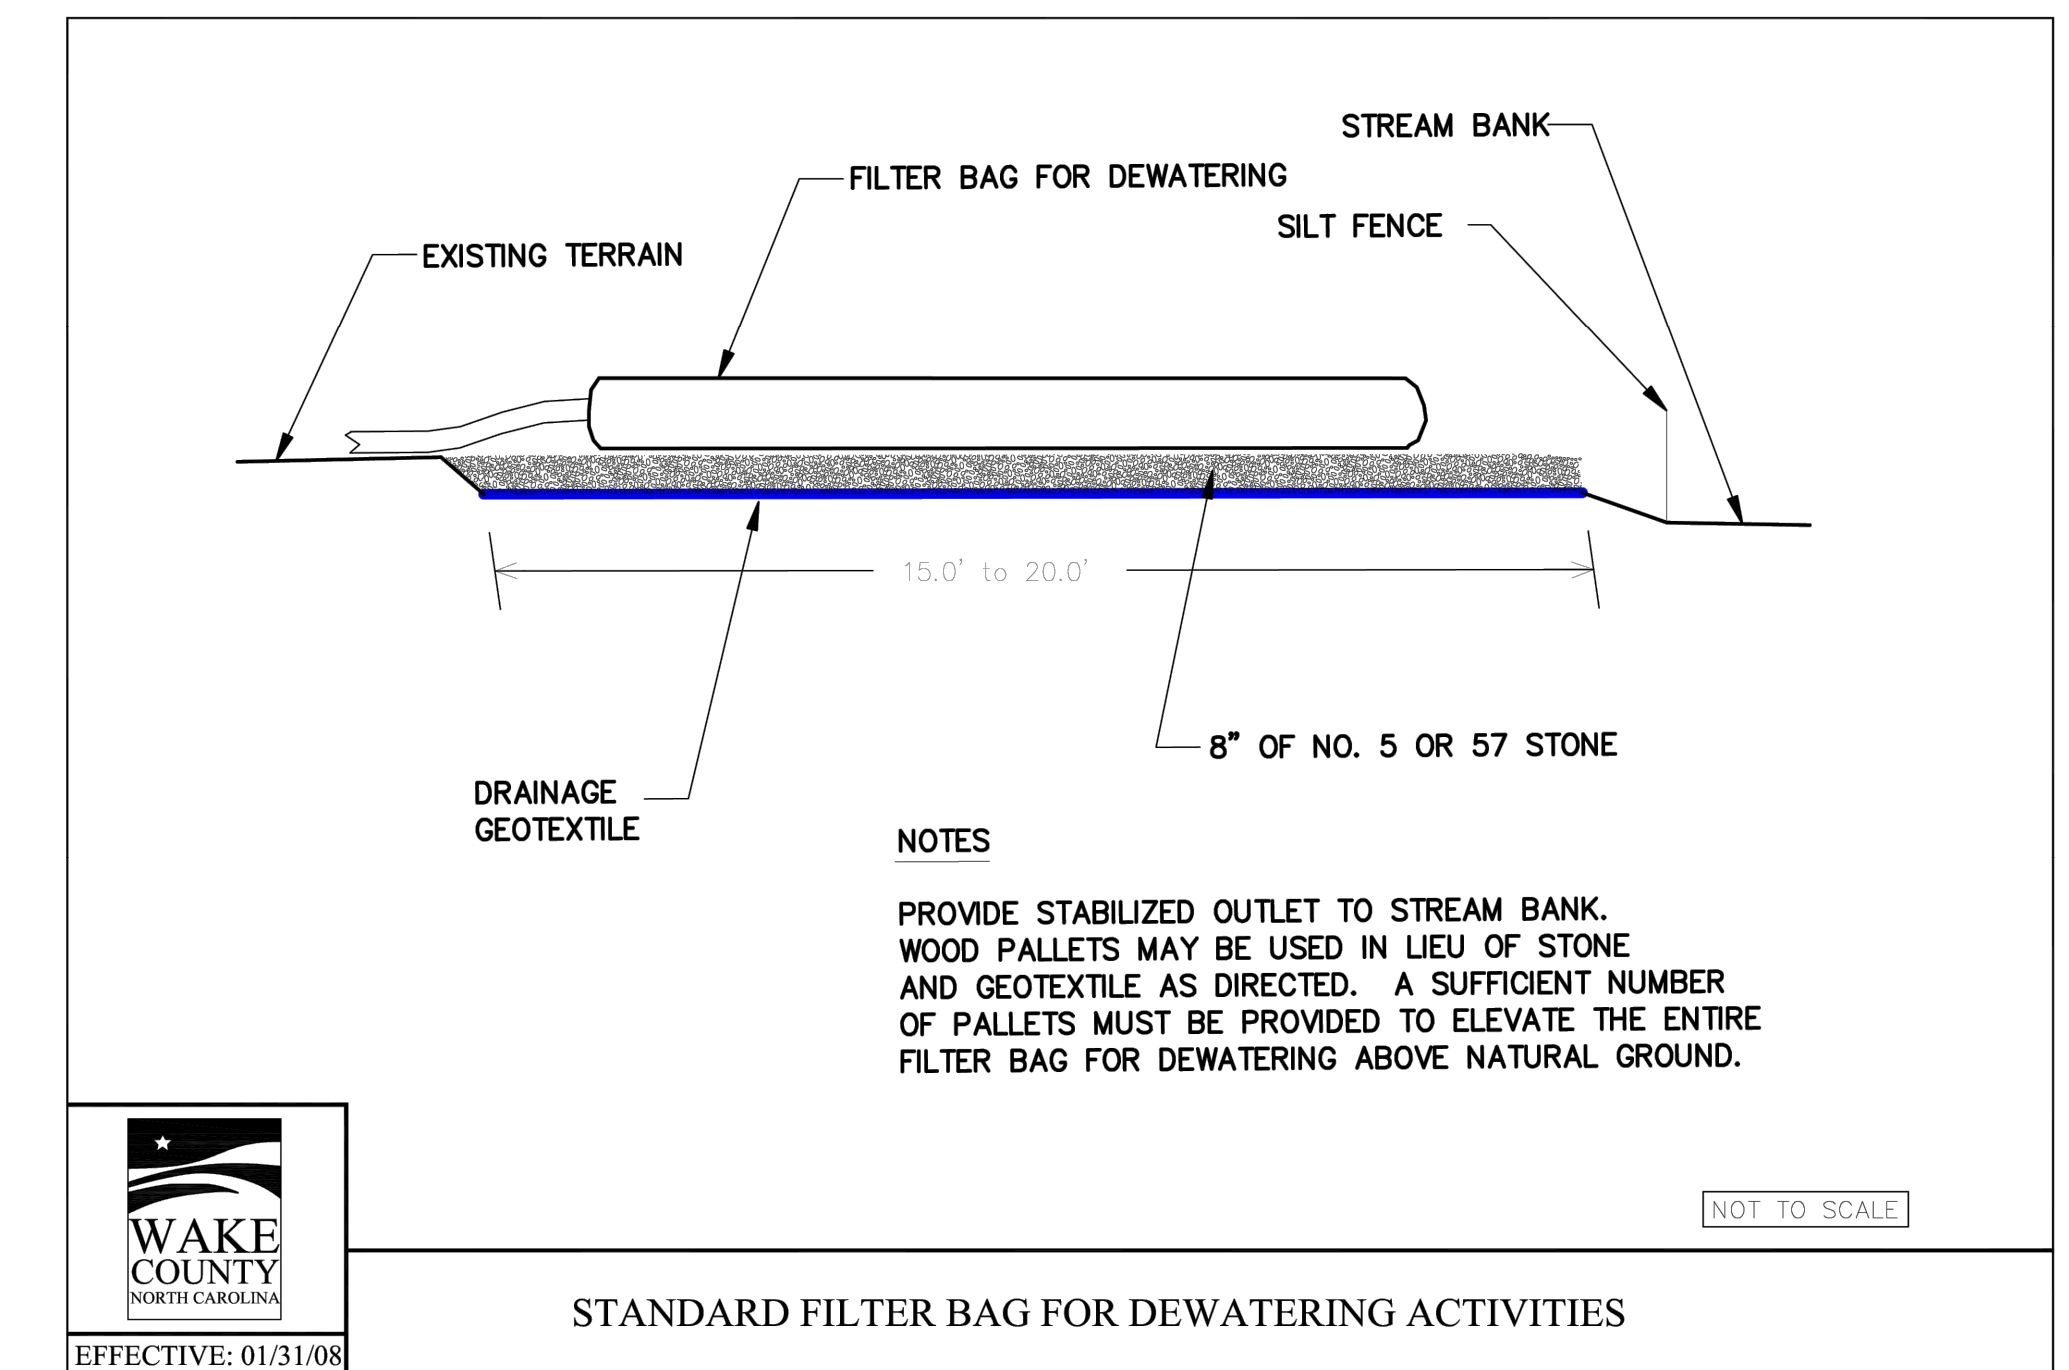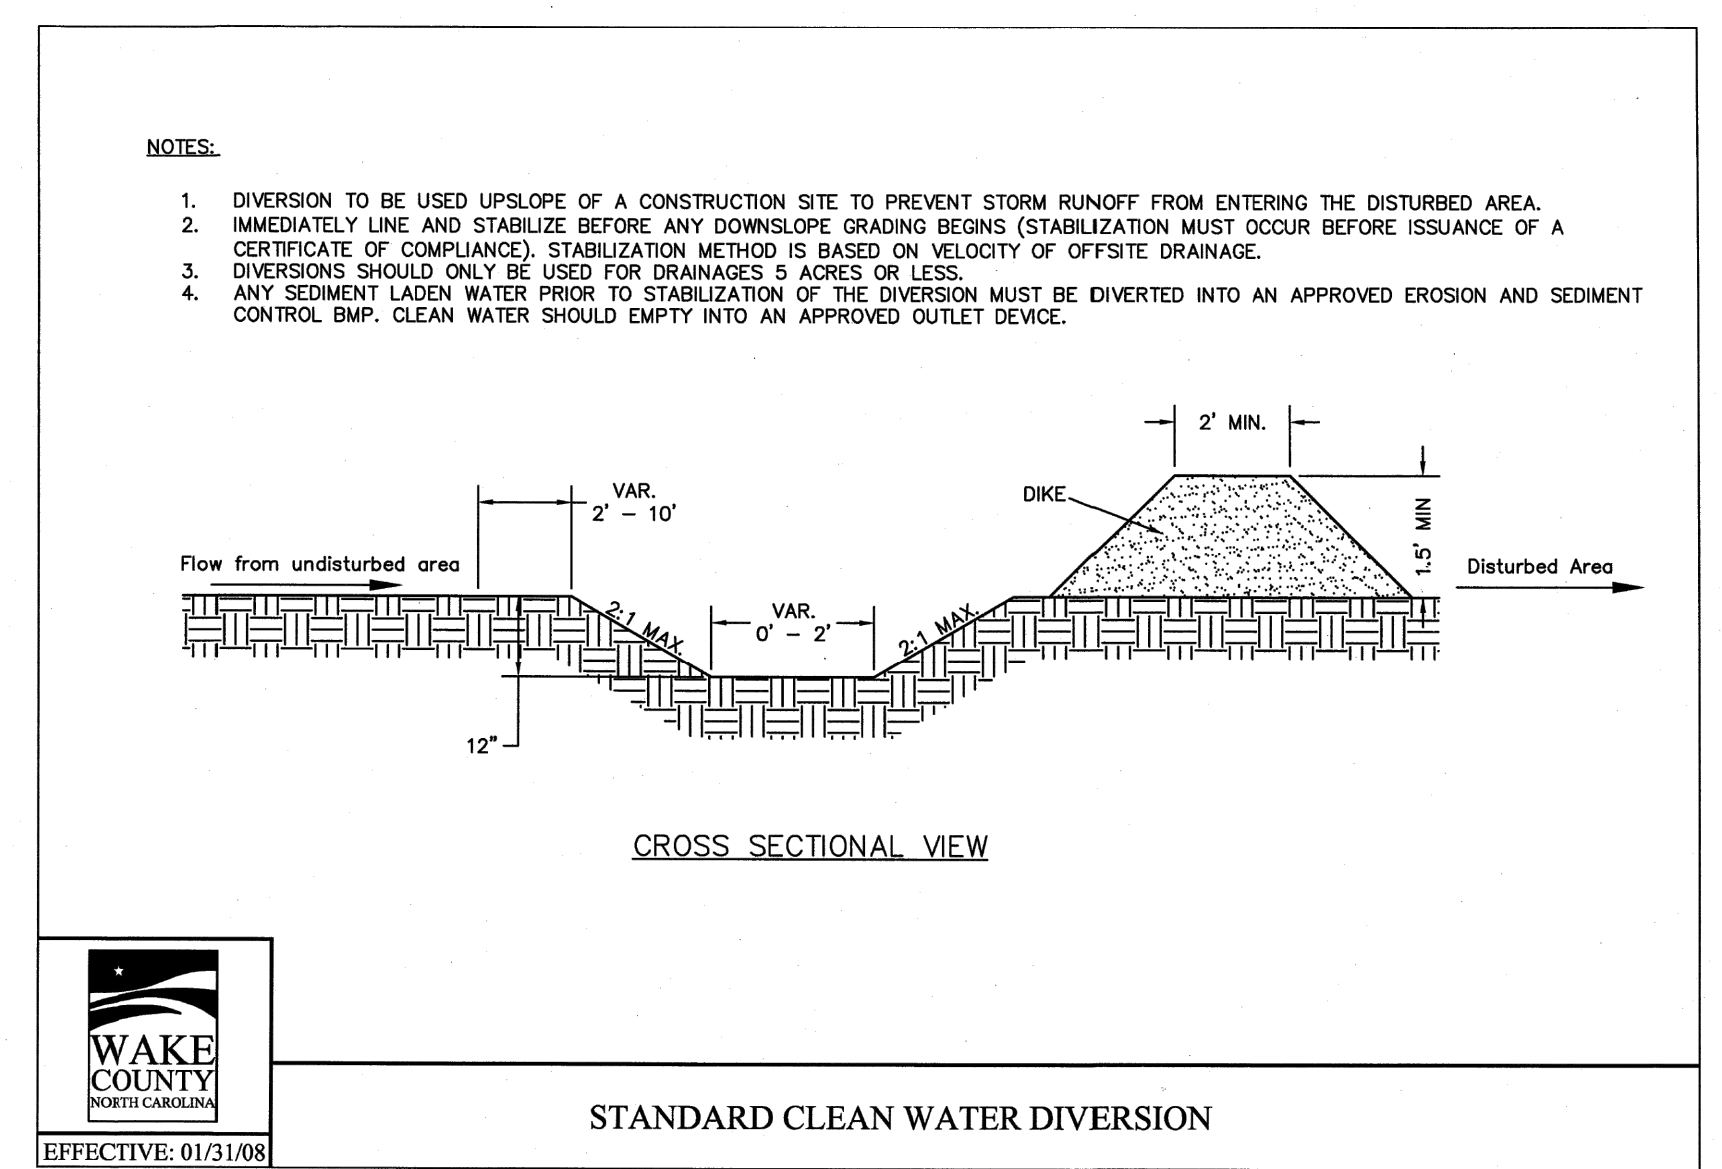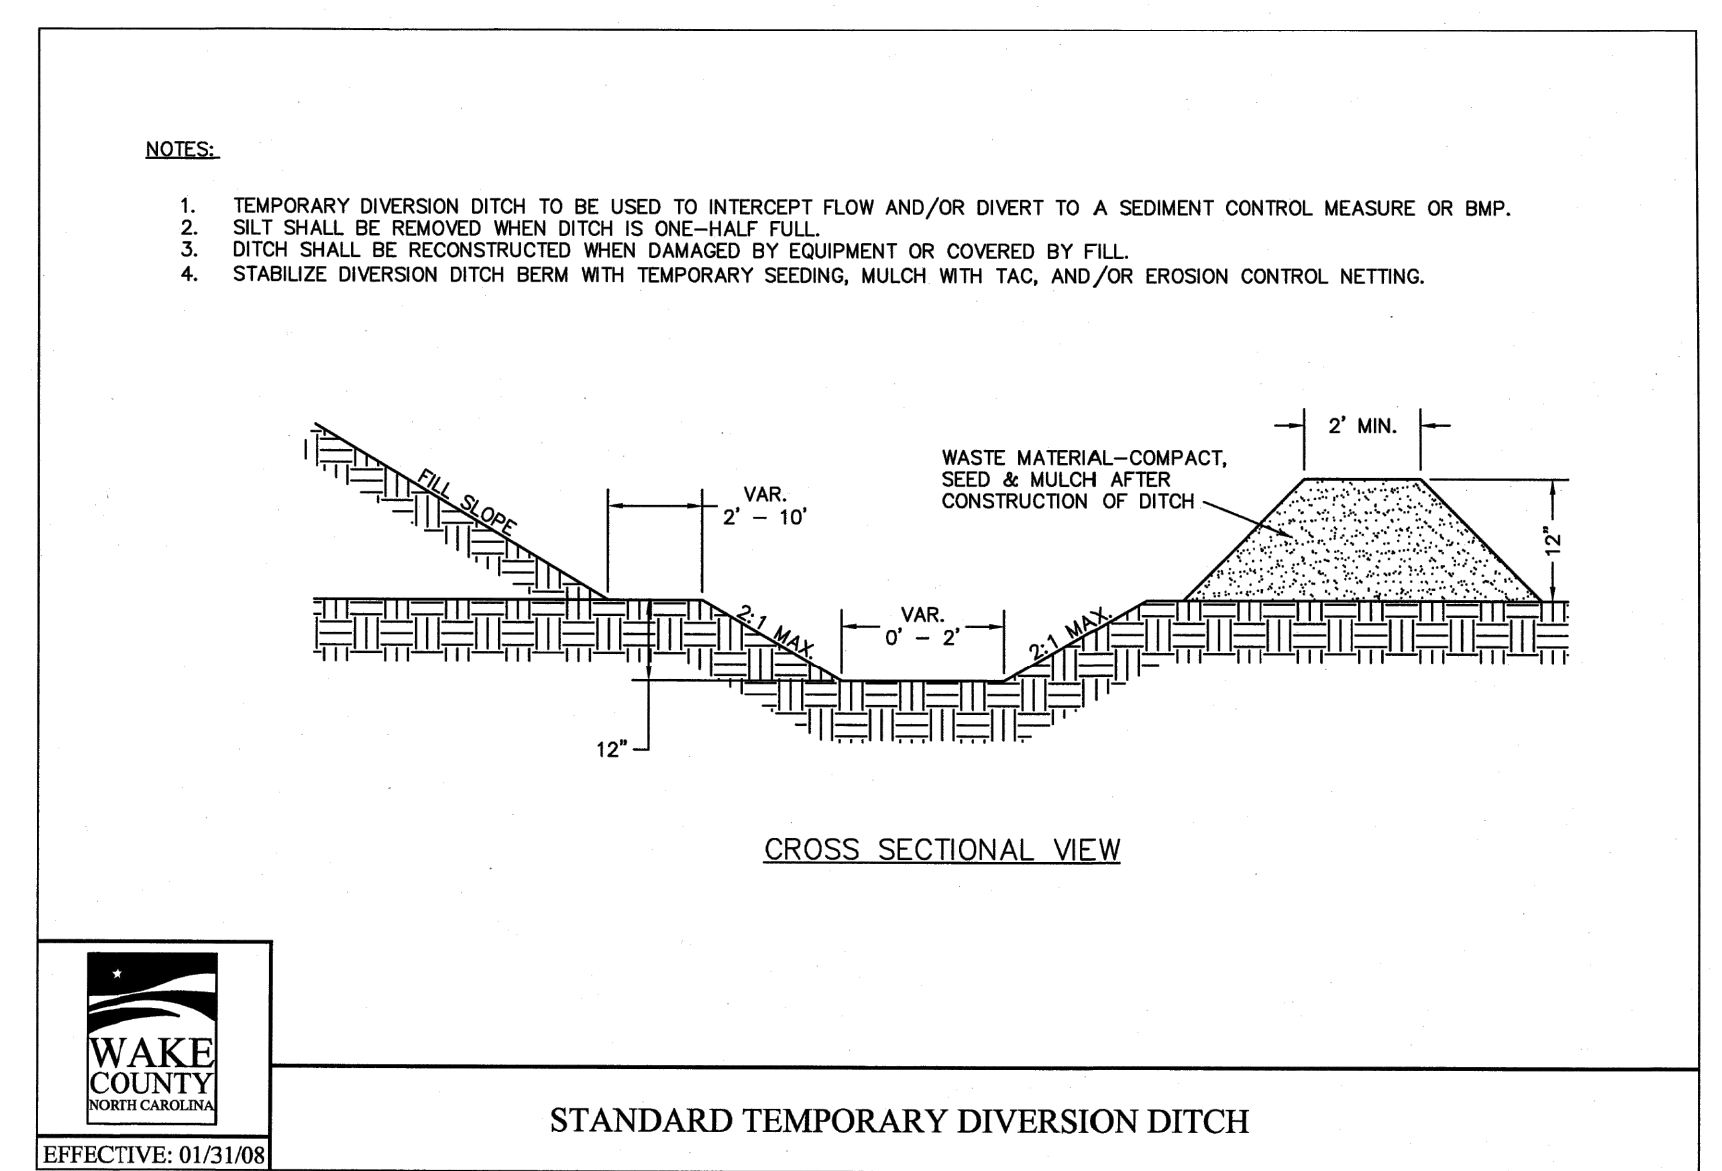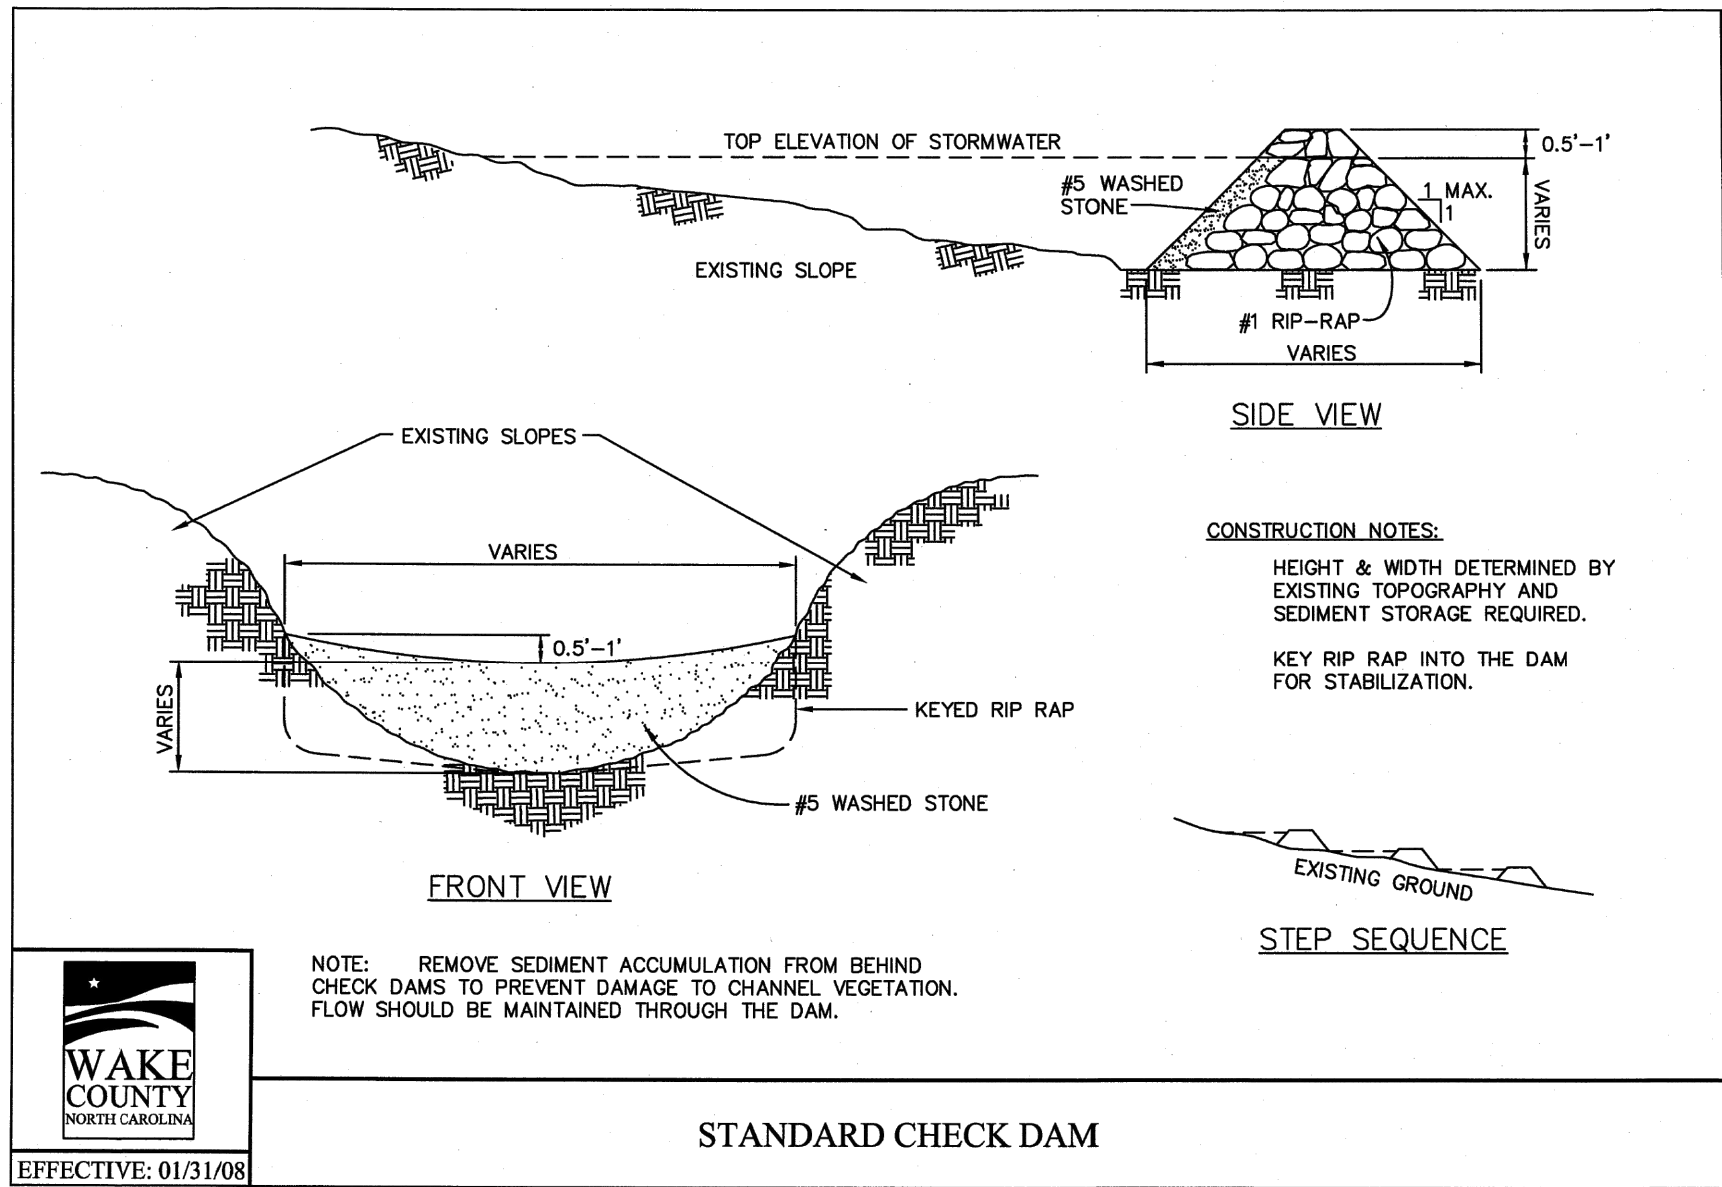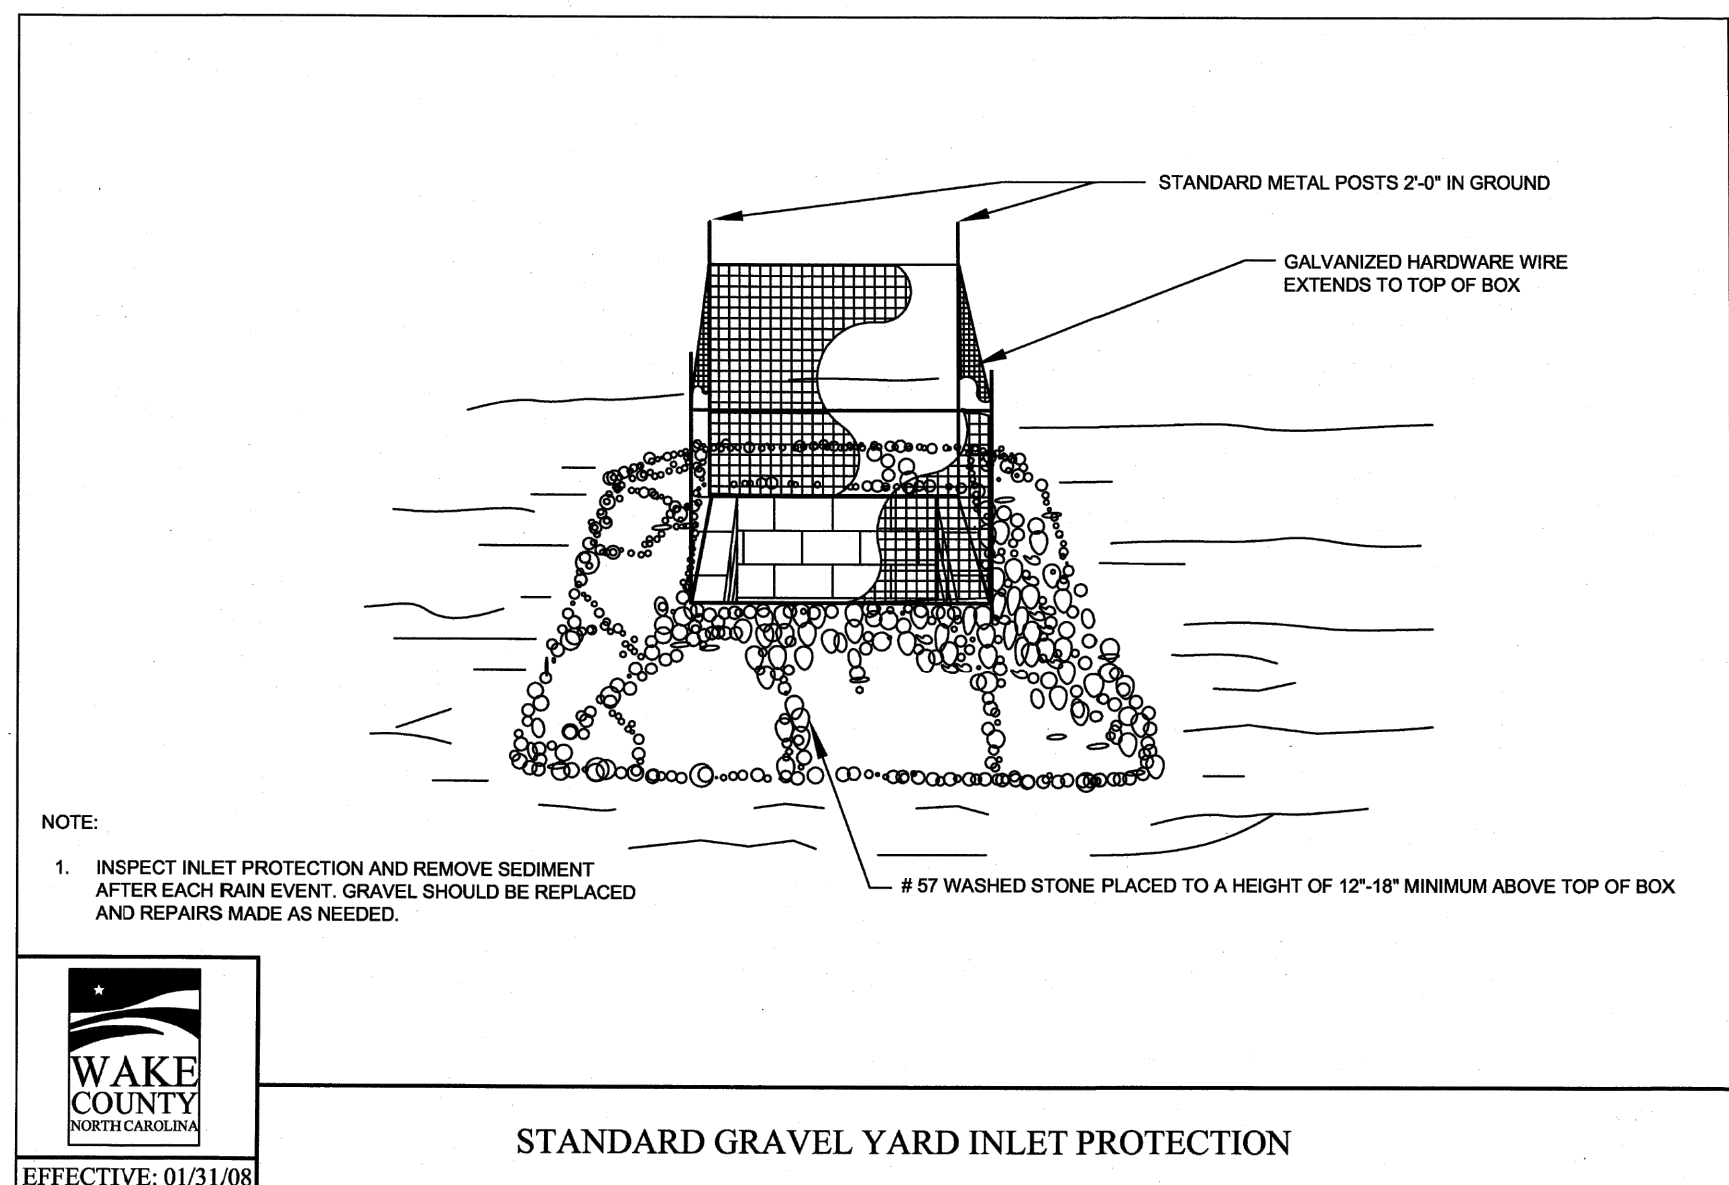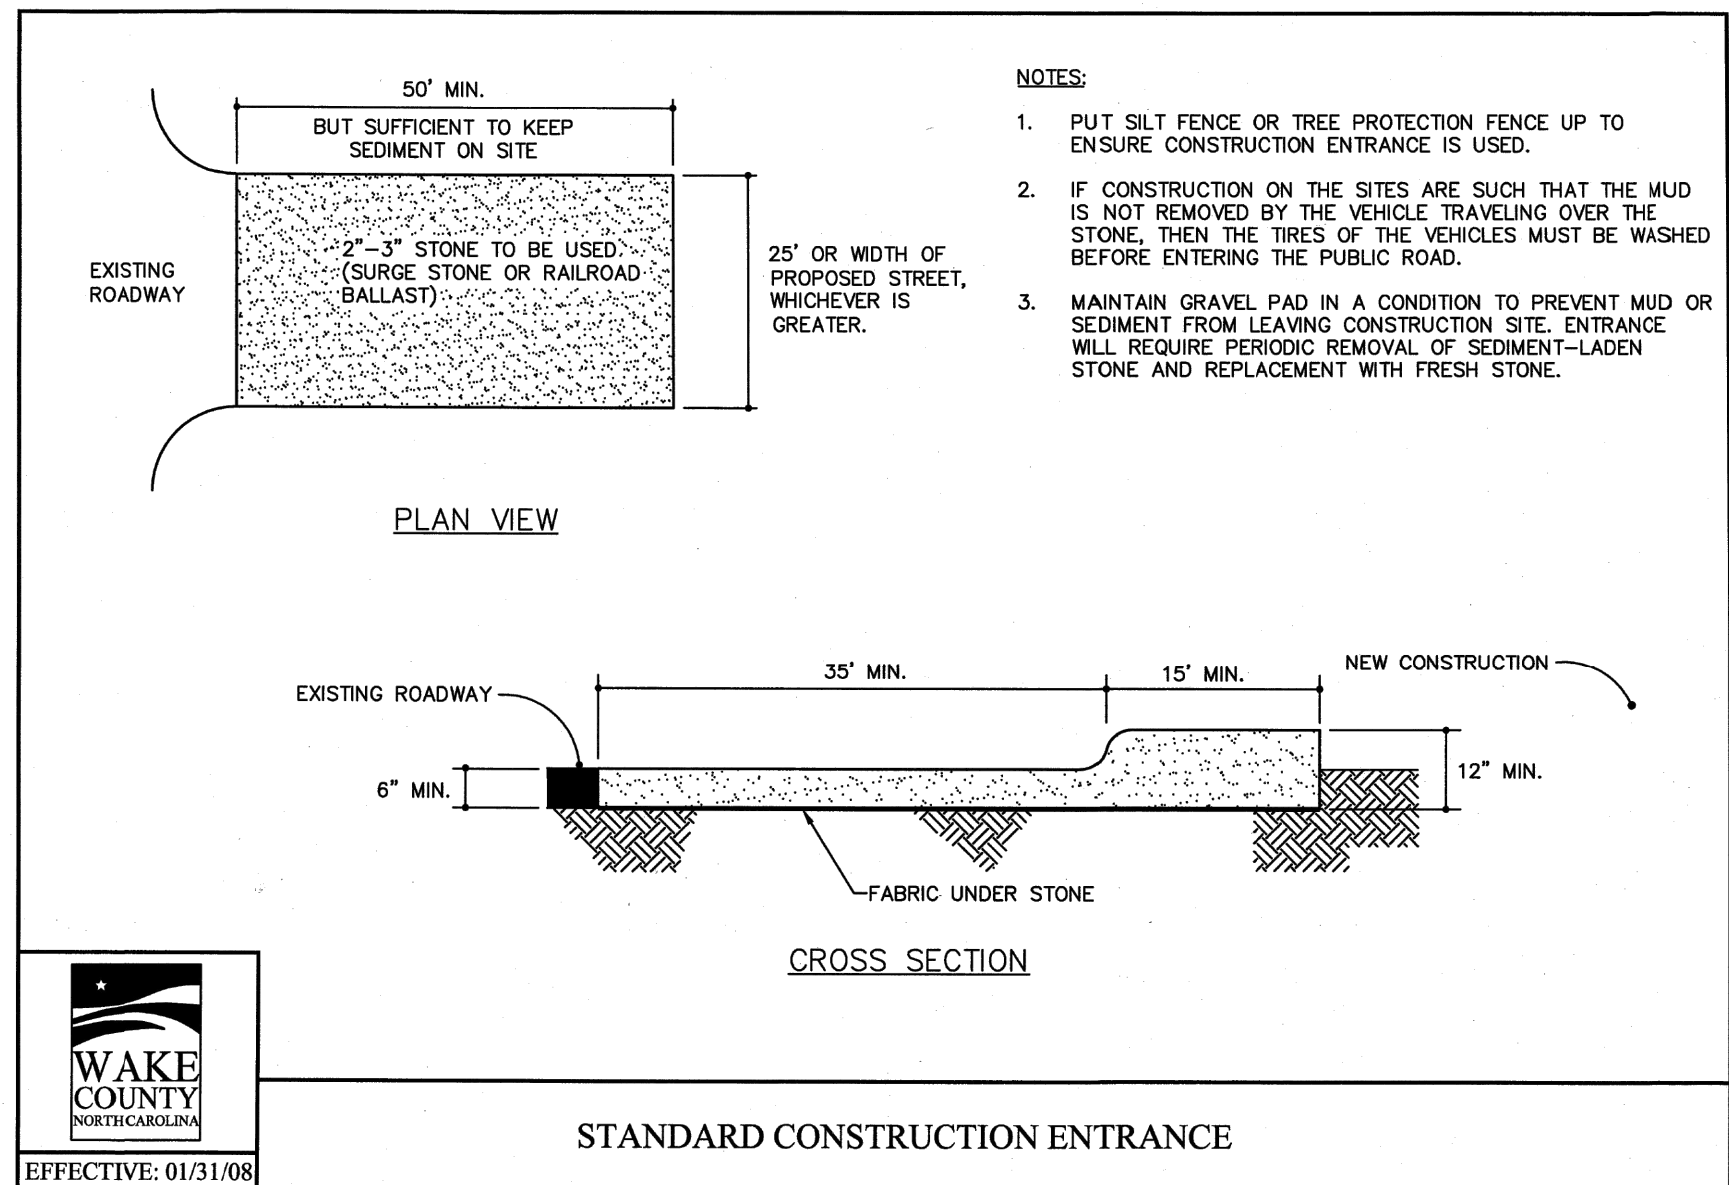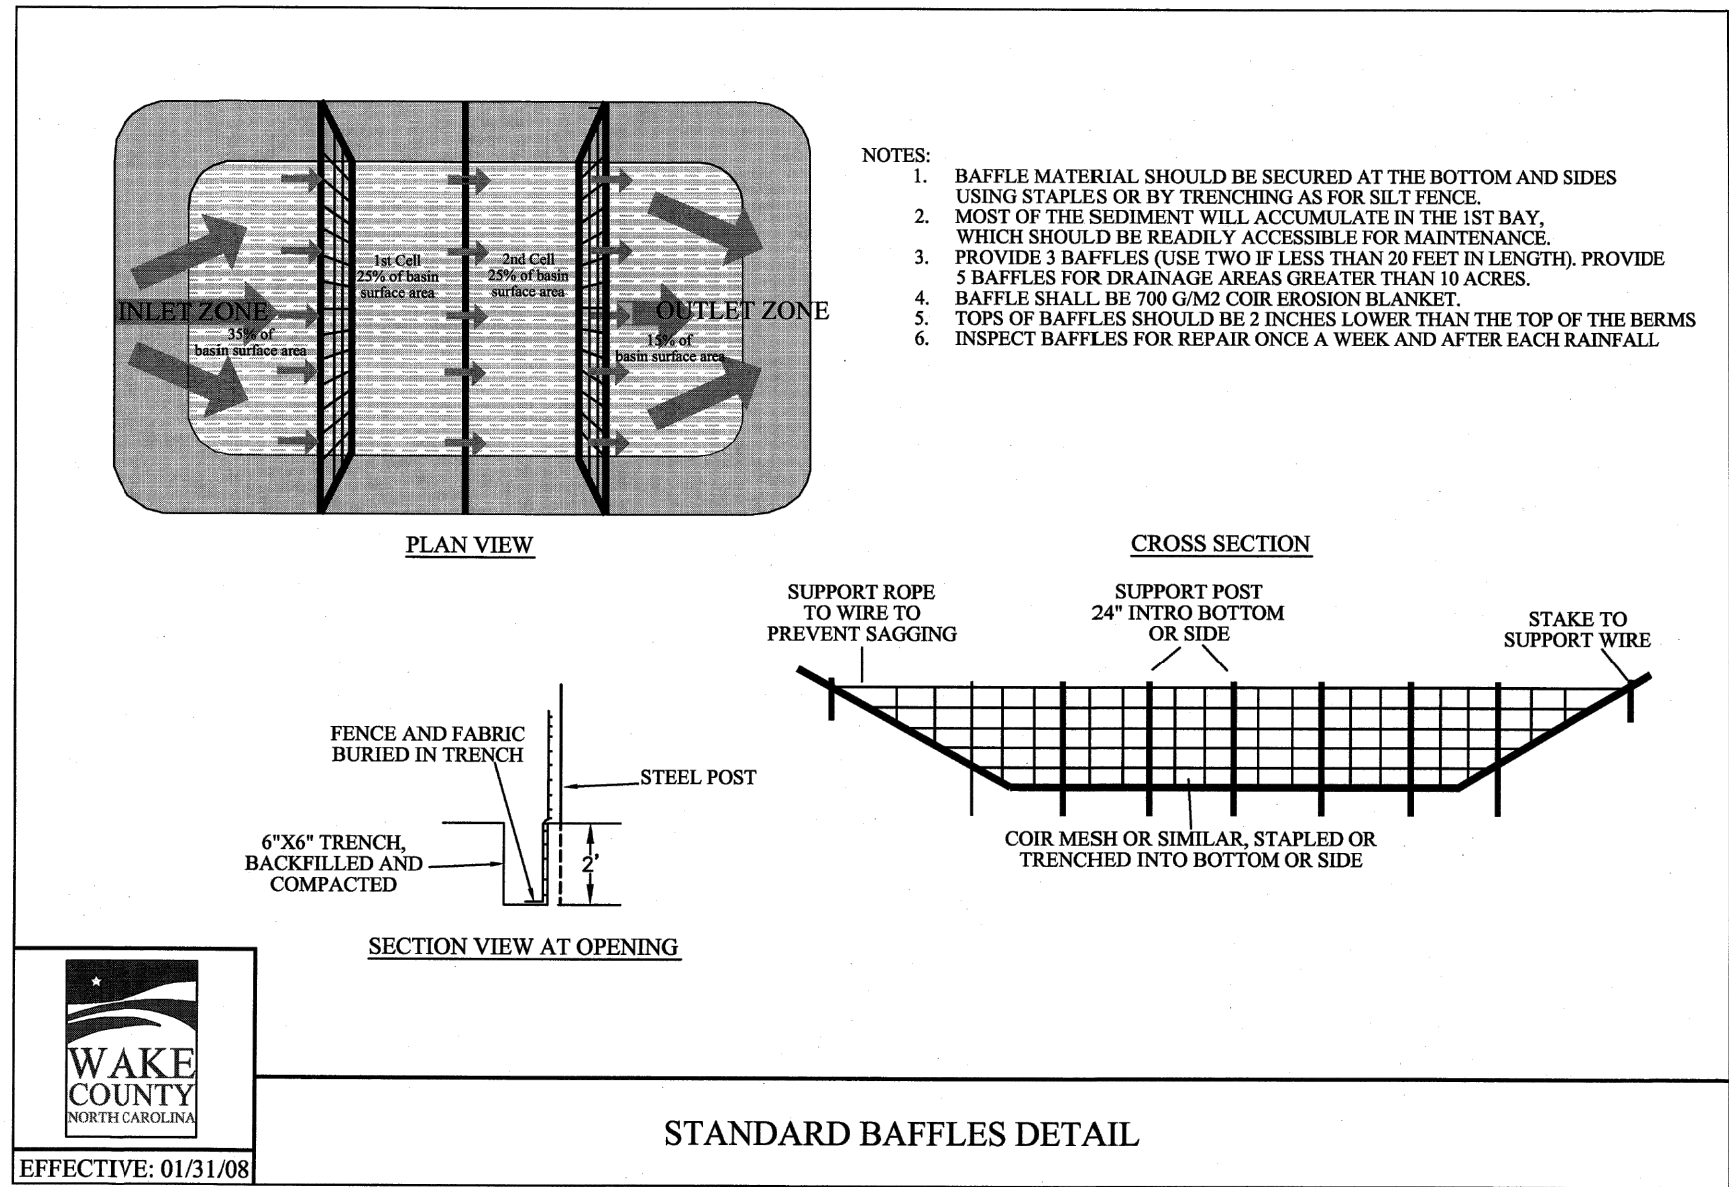

PER TOWN OF ROLESVILLE COMMENT		INITIAL SUBMITTAL
06/01/2023	REV	04/03/2023
DESIGNED BY: DF/CD		
DRAWN BY: DF/JWM		
REVIEWED BY: DF		
BCE		
5440 WADE PARK BLVD, SUITE 102 RALEIGH NC 27607 WWW.BCEINC.COM NC LICENSE #C-4397		
LENNAR CORPORATION		
1100 PERIMETER PARK DRIVE, SUITE 112 MORRISVILLE / NORTH CAROLINA / 27560		
PARKER RIDGE		
82 SCHOOL STREET ROLESVILLE / NORTH CAROLINA / 27571		
EROSION CONTROL DETAILS (1 OF 2)		
PRELIMINARY		
ENGINEER: FEDRA M. FERNANDEZ		
NOT FOR CONSTRUCTION		
FILE NUMBER: 8430-03		
DATE: 06/01/2023		
C8-2		





























\\browngay.net\panzura\Regions\NCA\Projects\Lennar\8430-03 - DWG\PlanSheets\On-Site\C2-2 - EROS-DETL.dwg Layout: 08-3 EROSION CONTROL DETAILS (2 OF 2) Plotted: 6/1/2023 3:36:17 PM

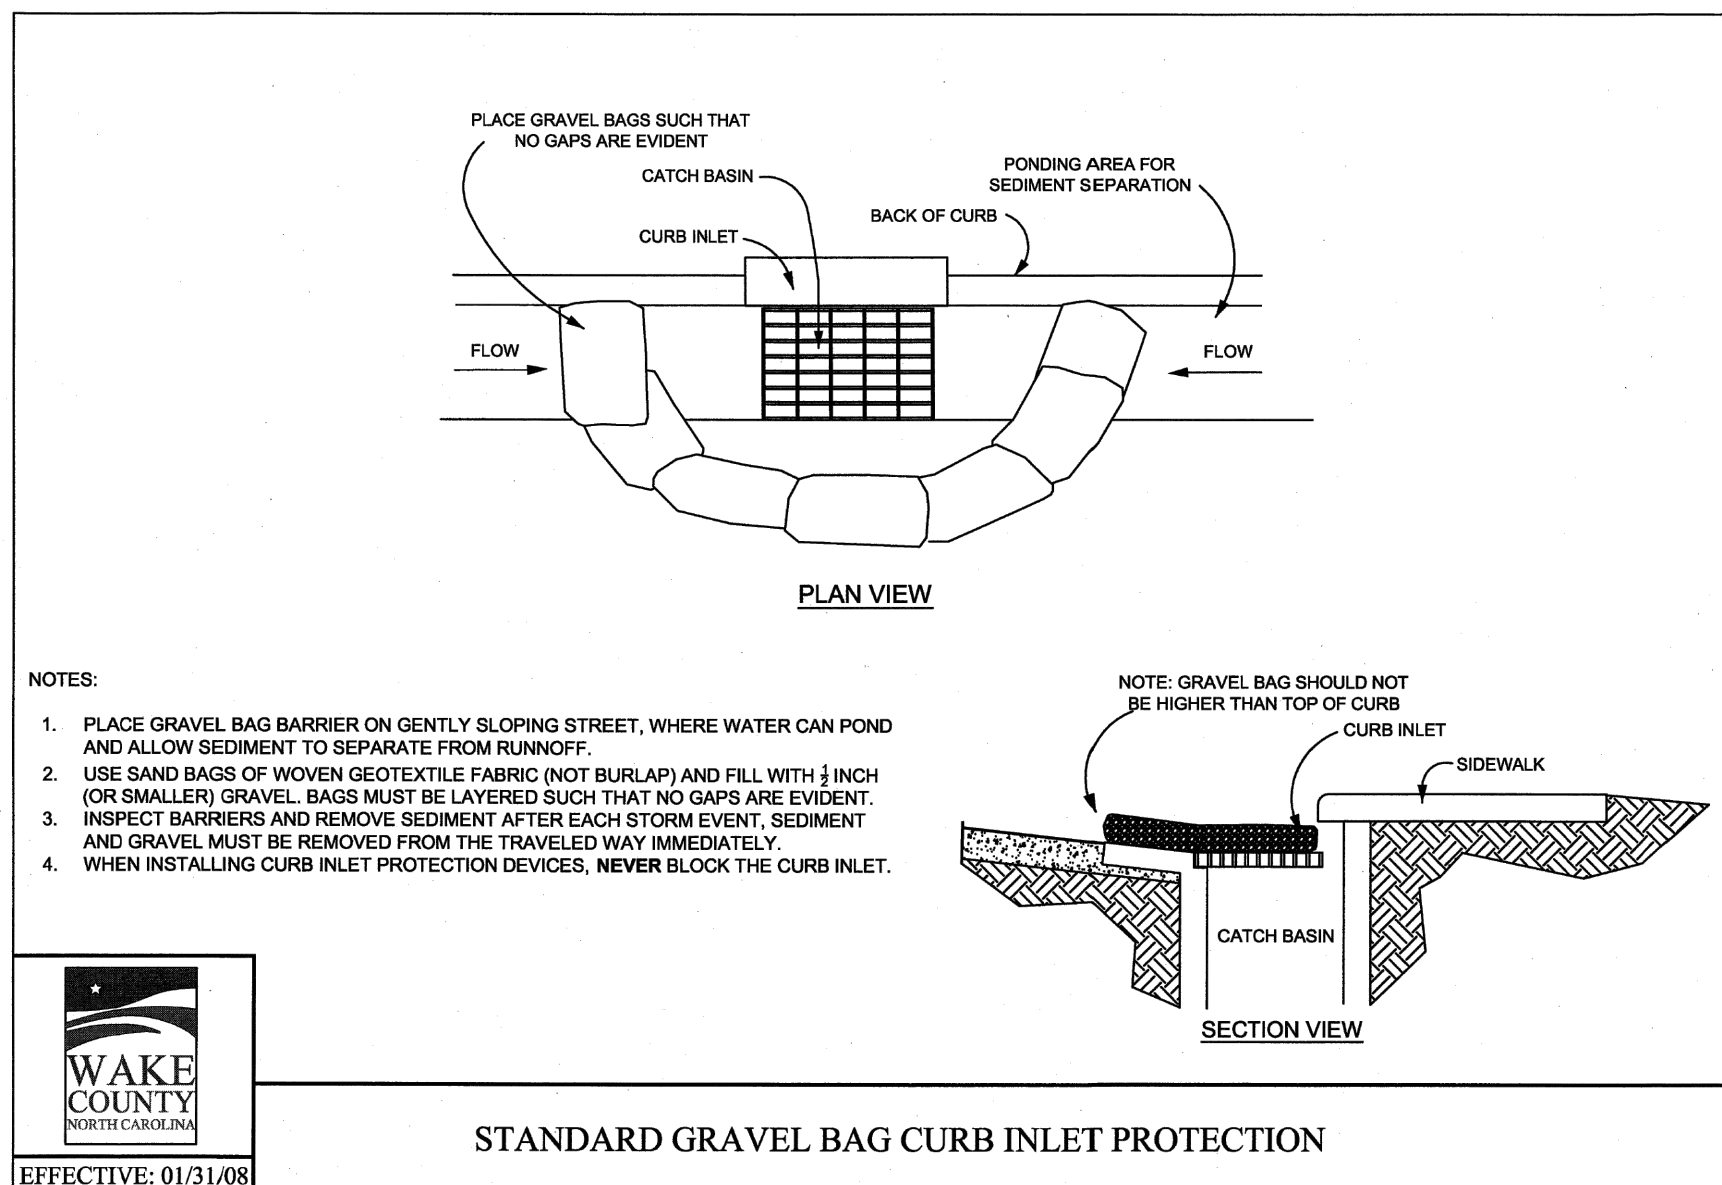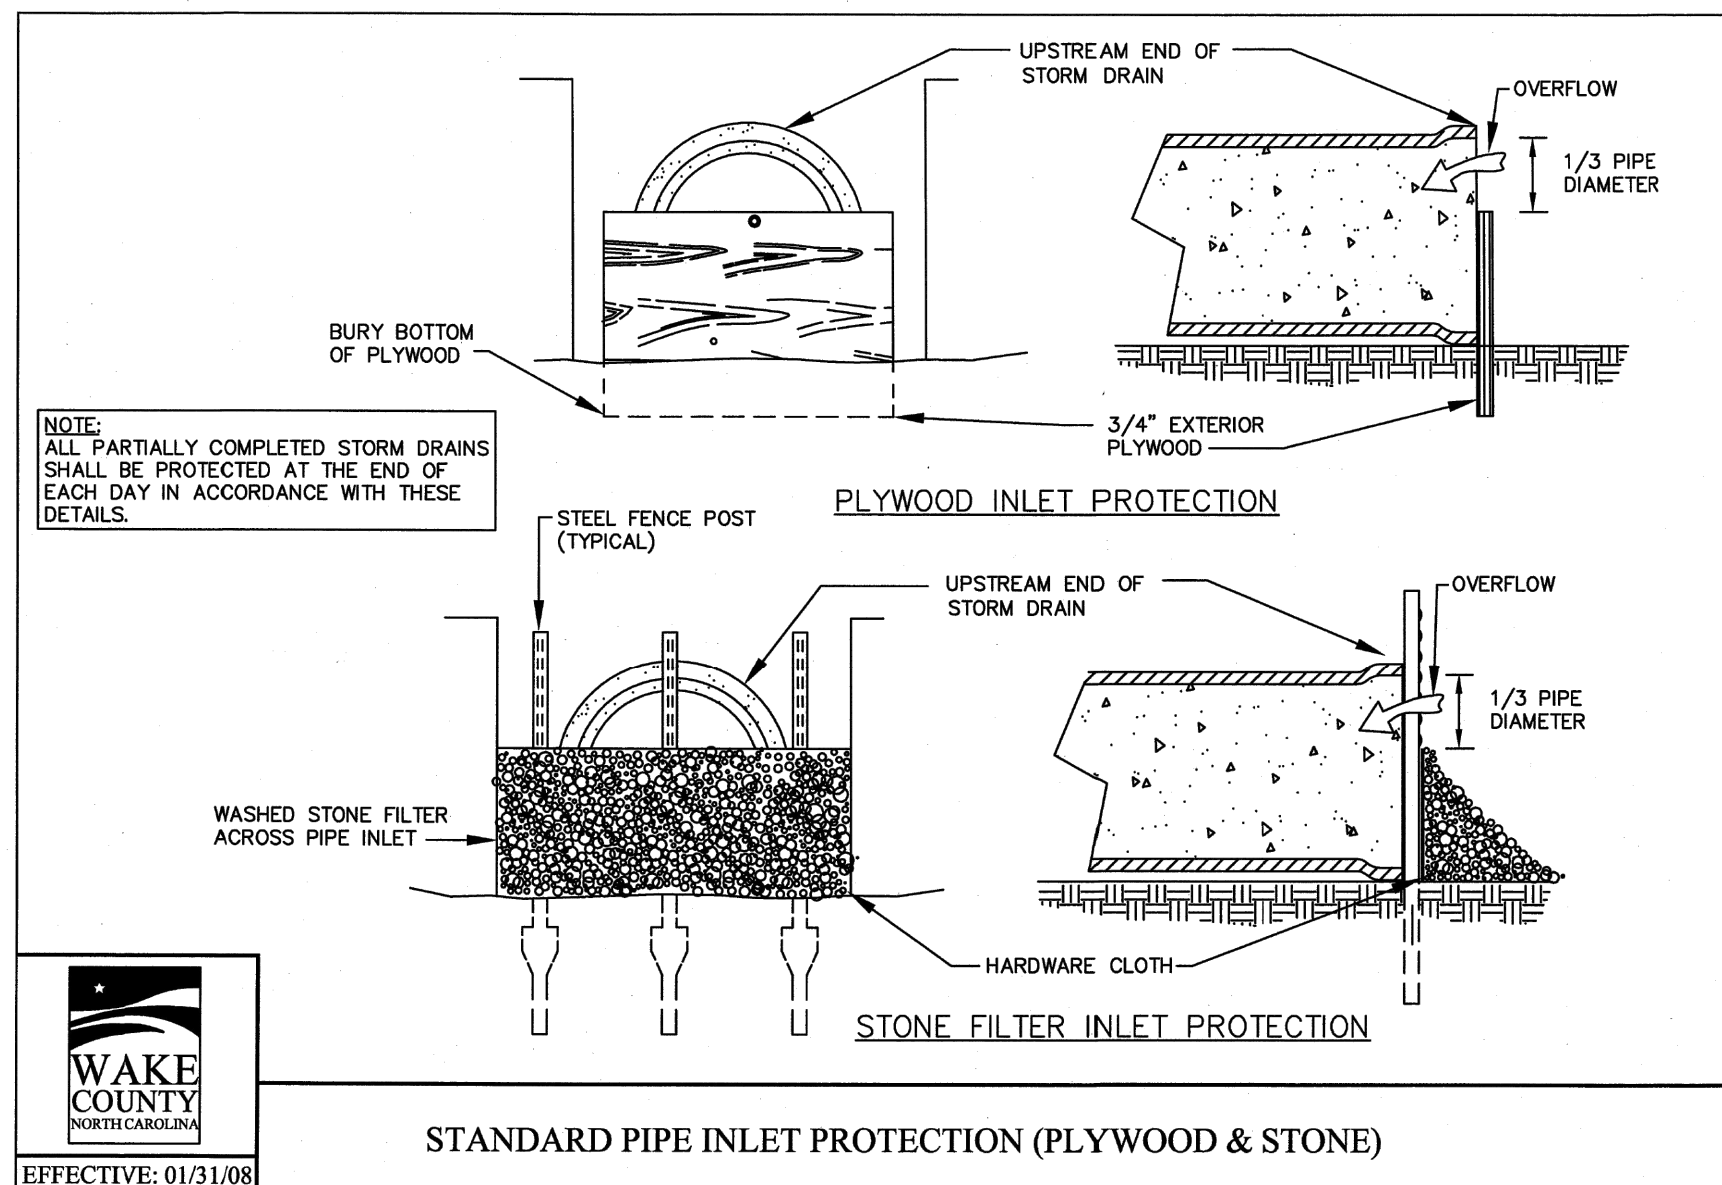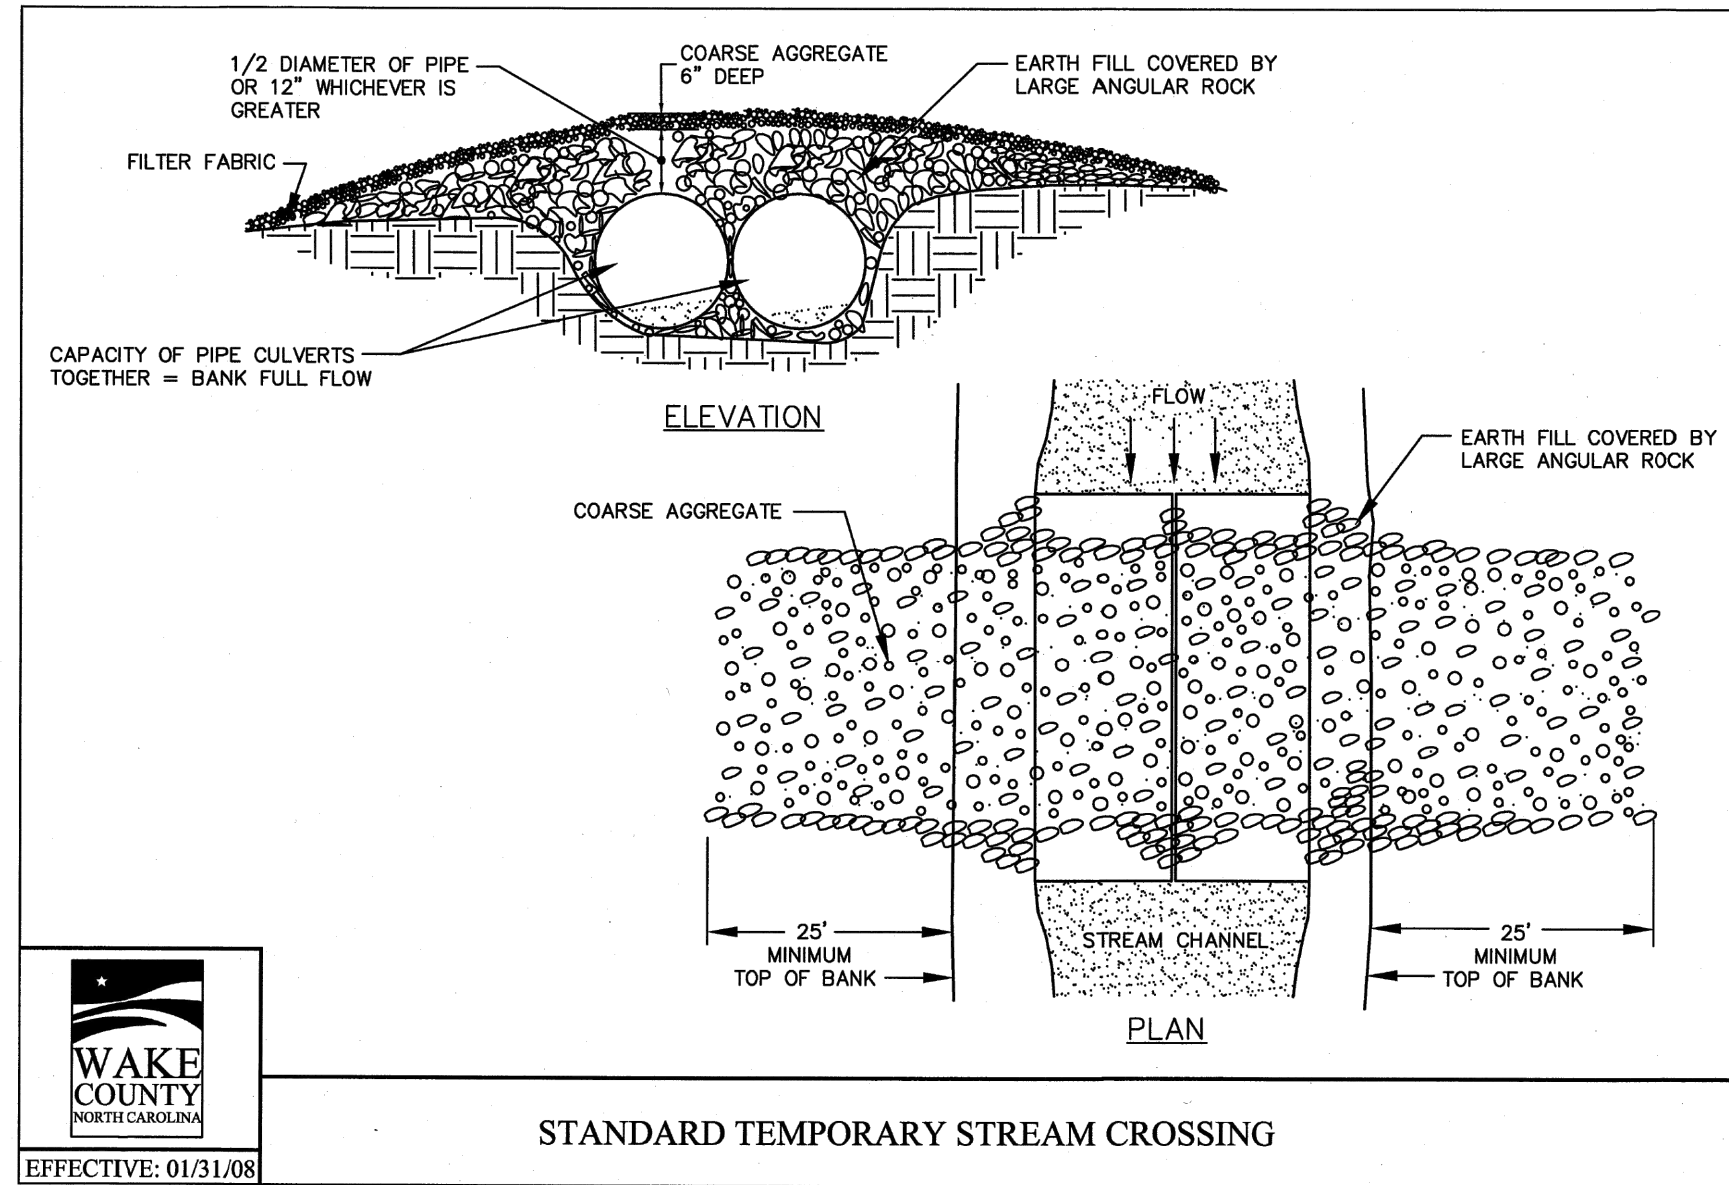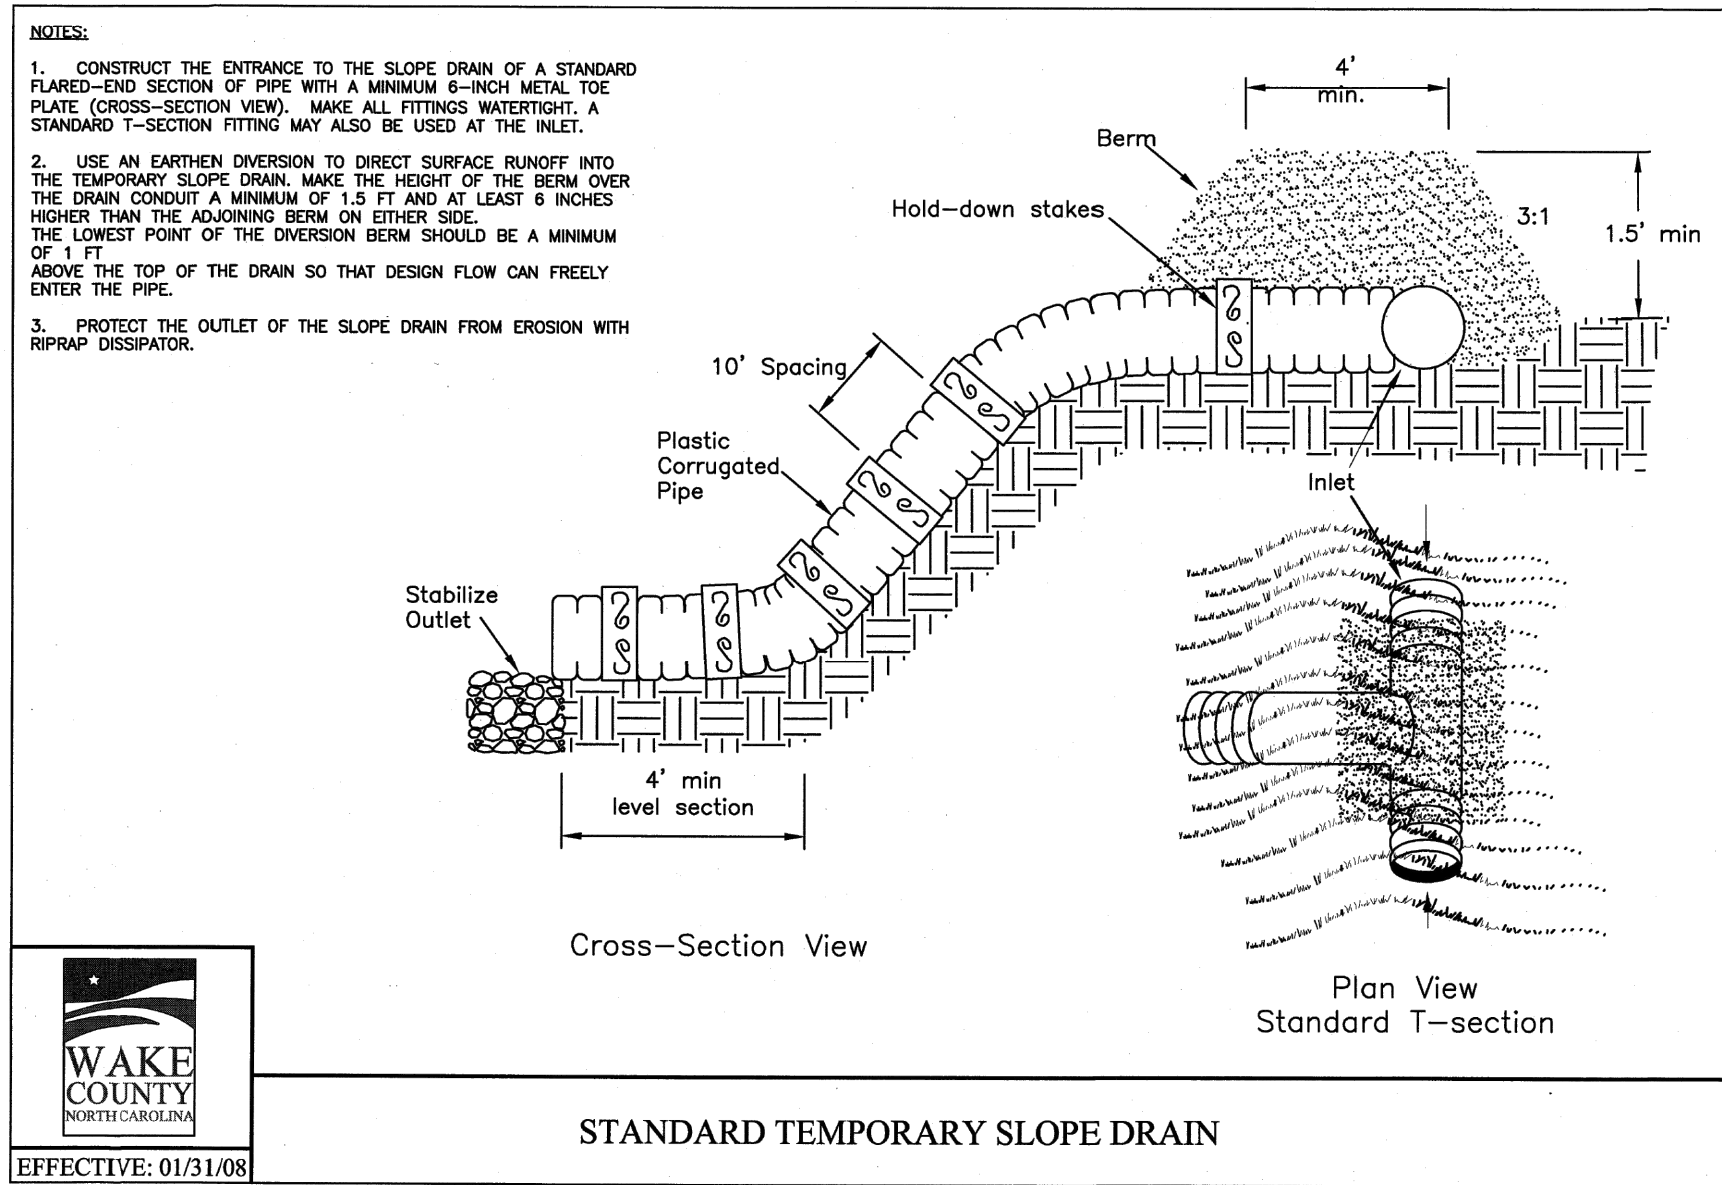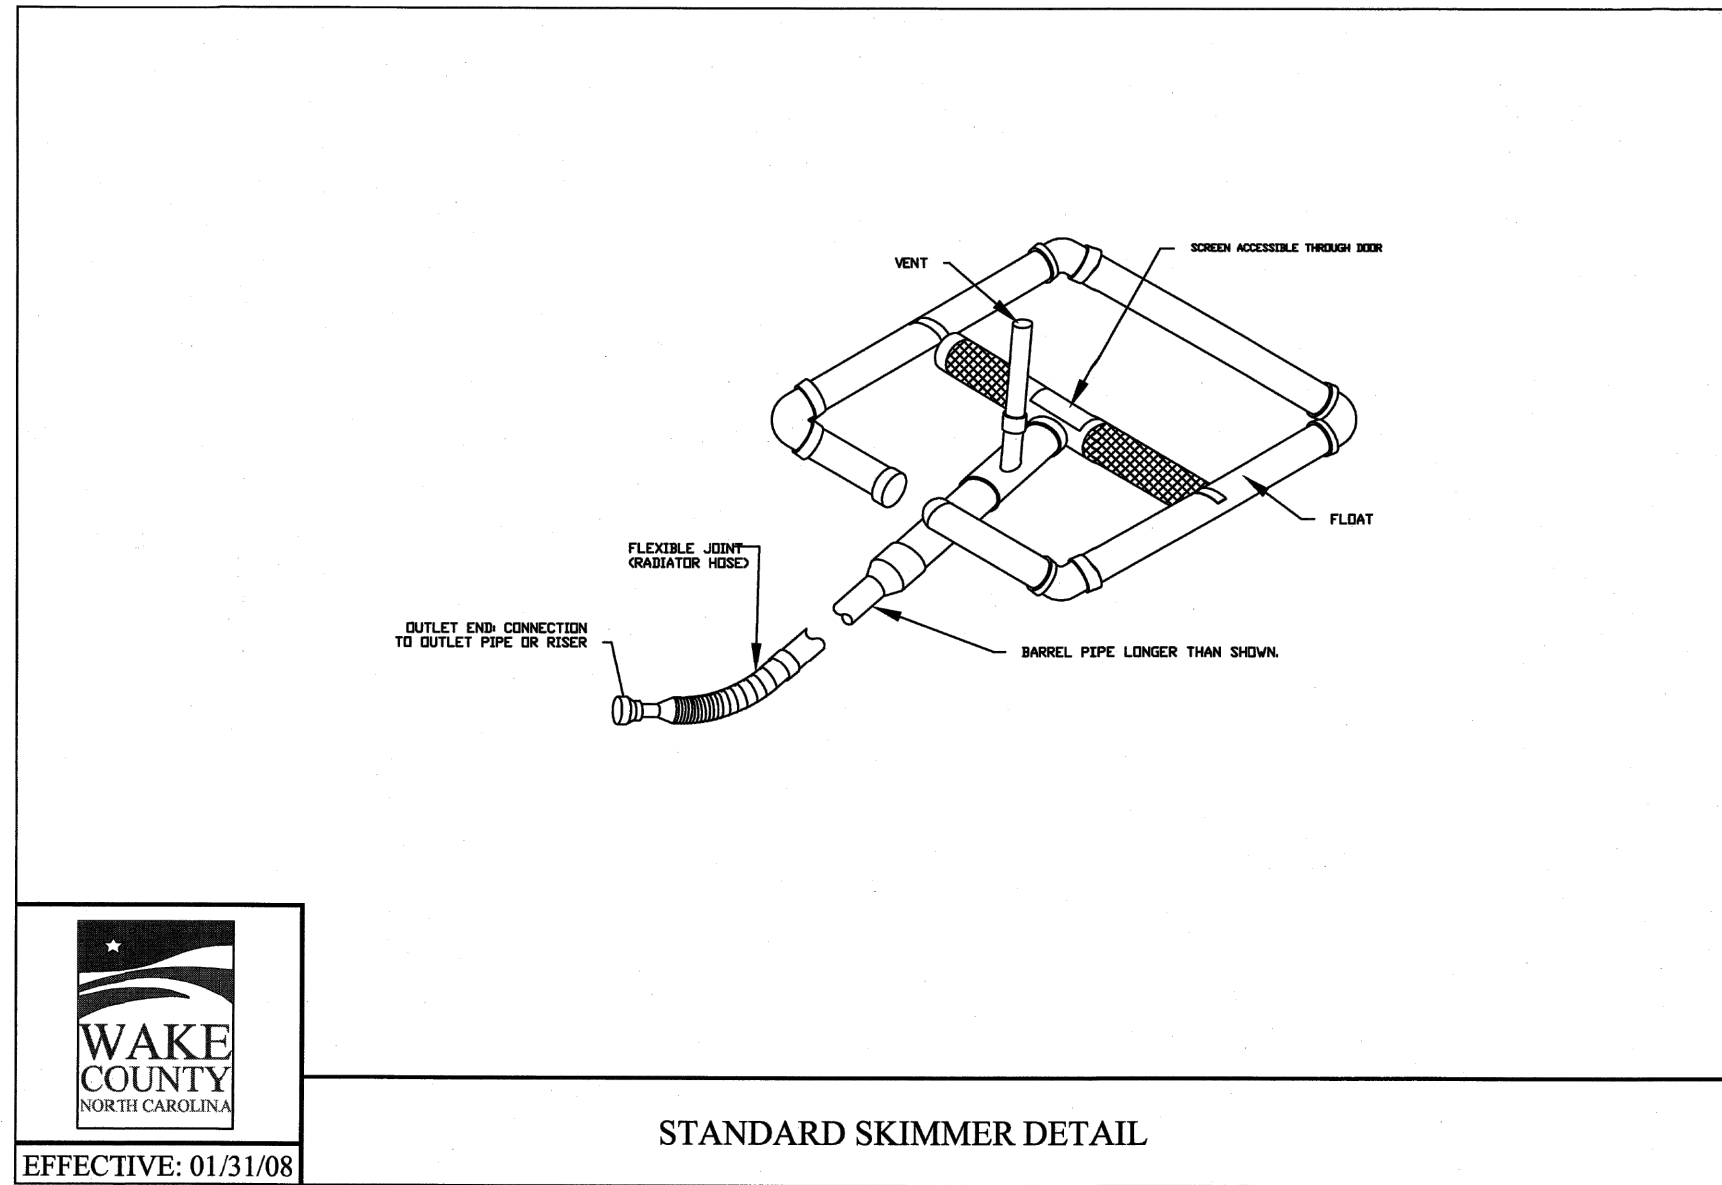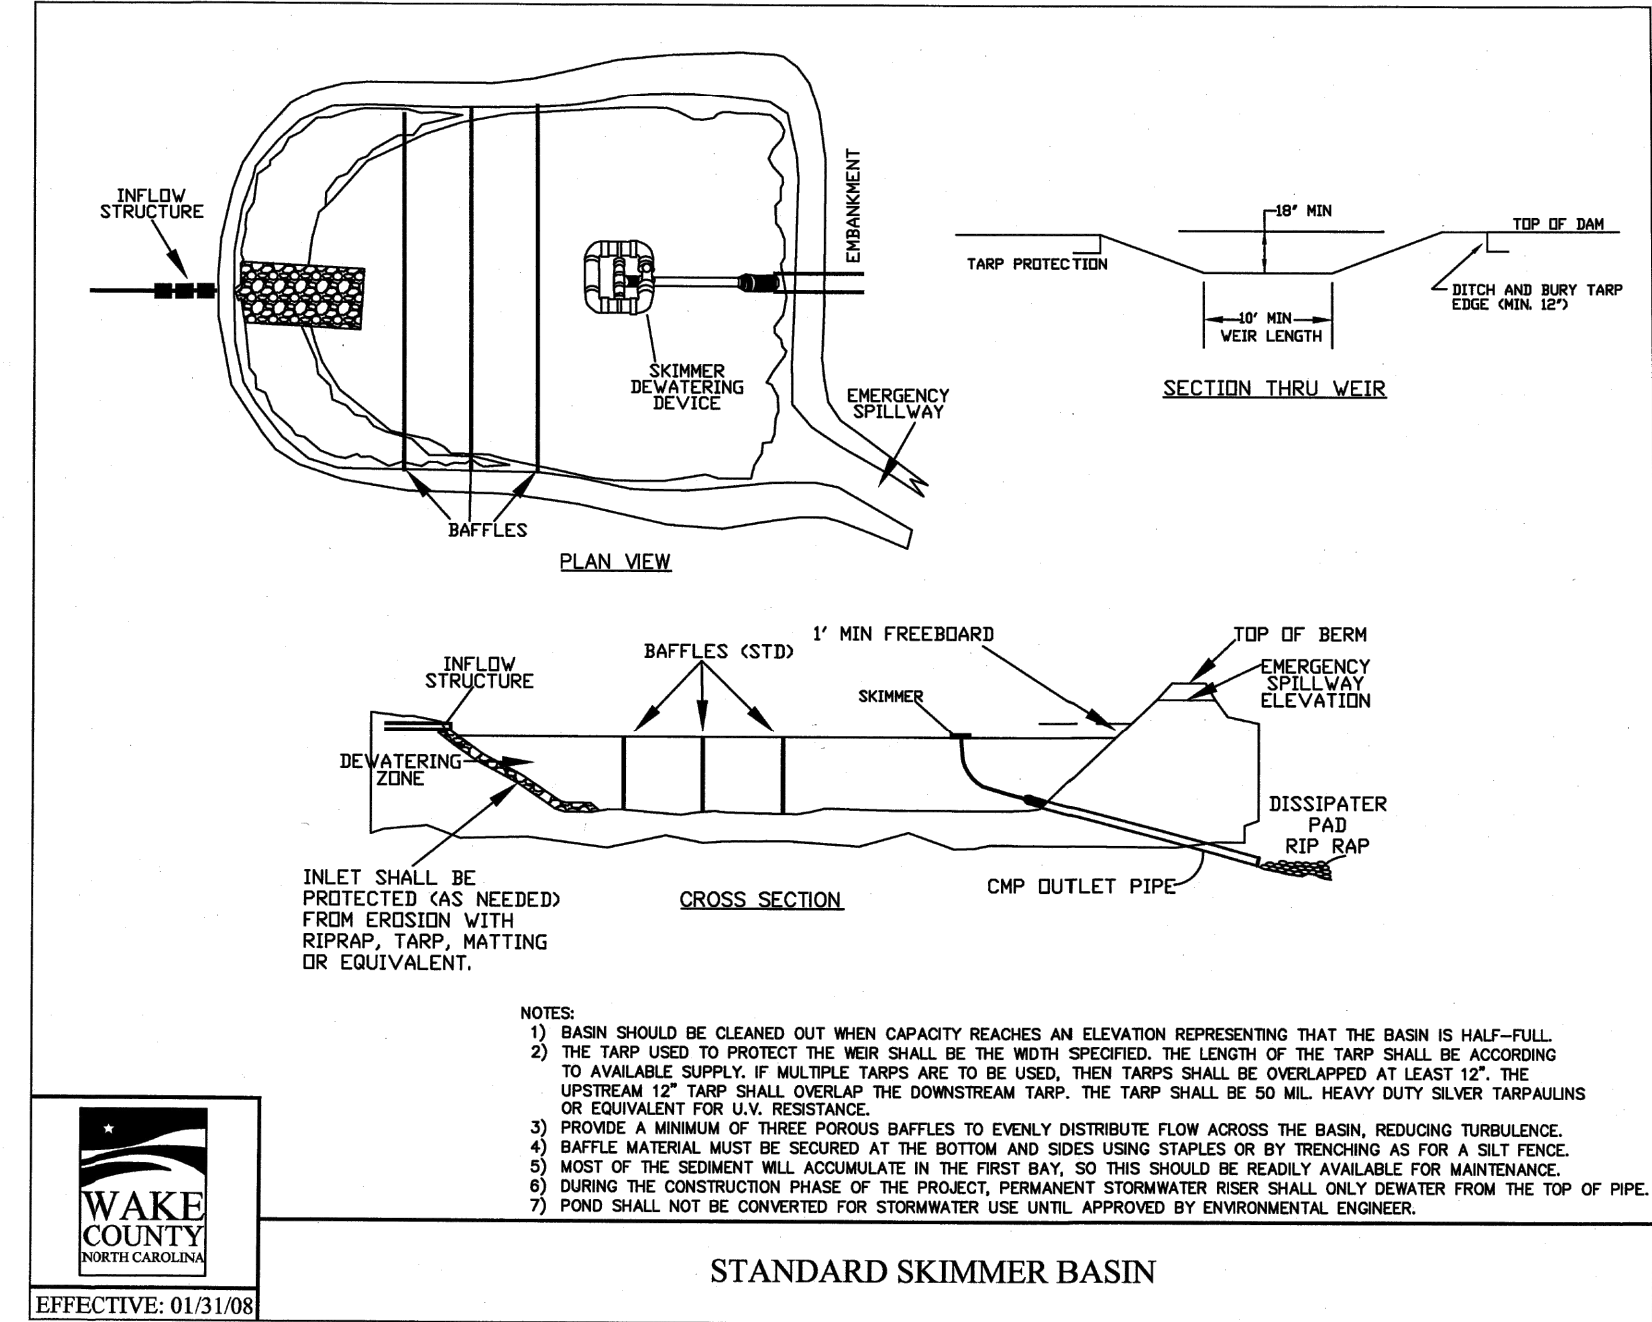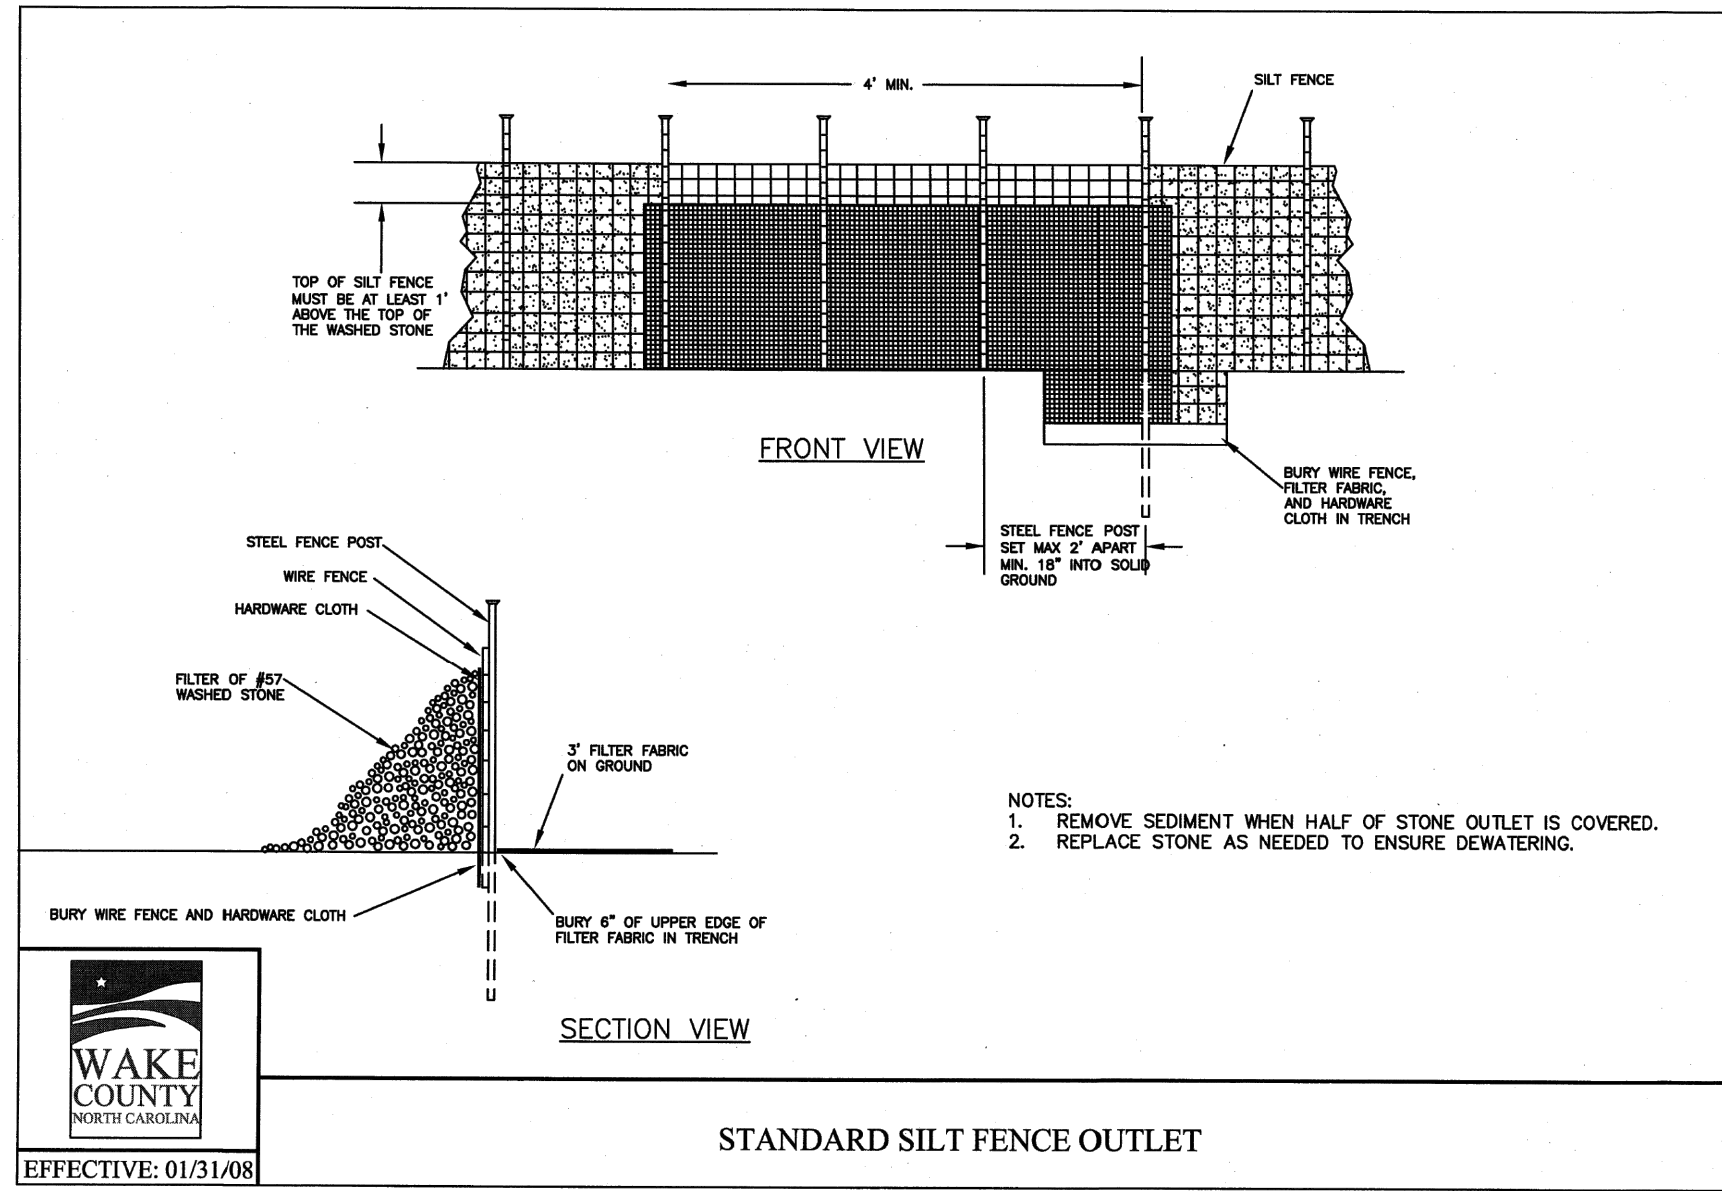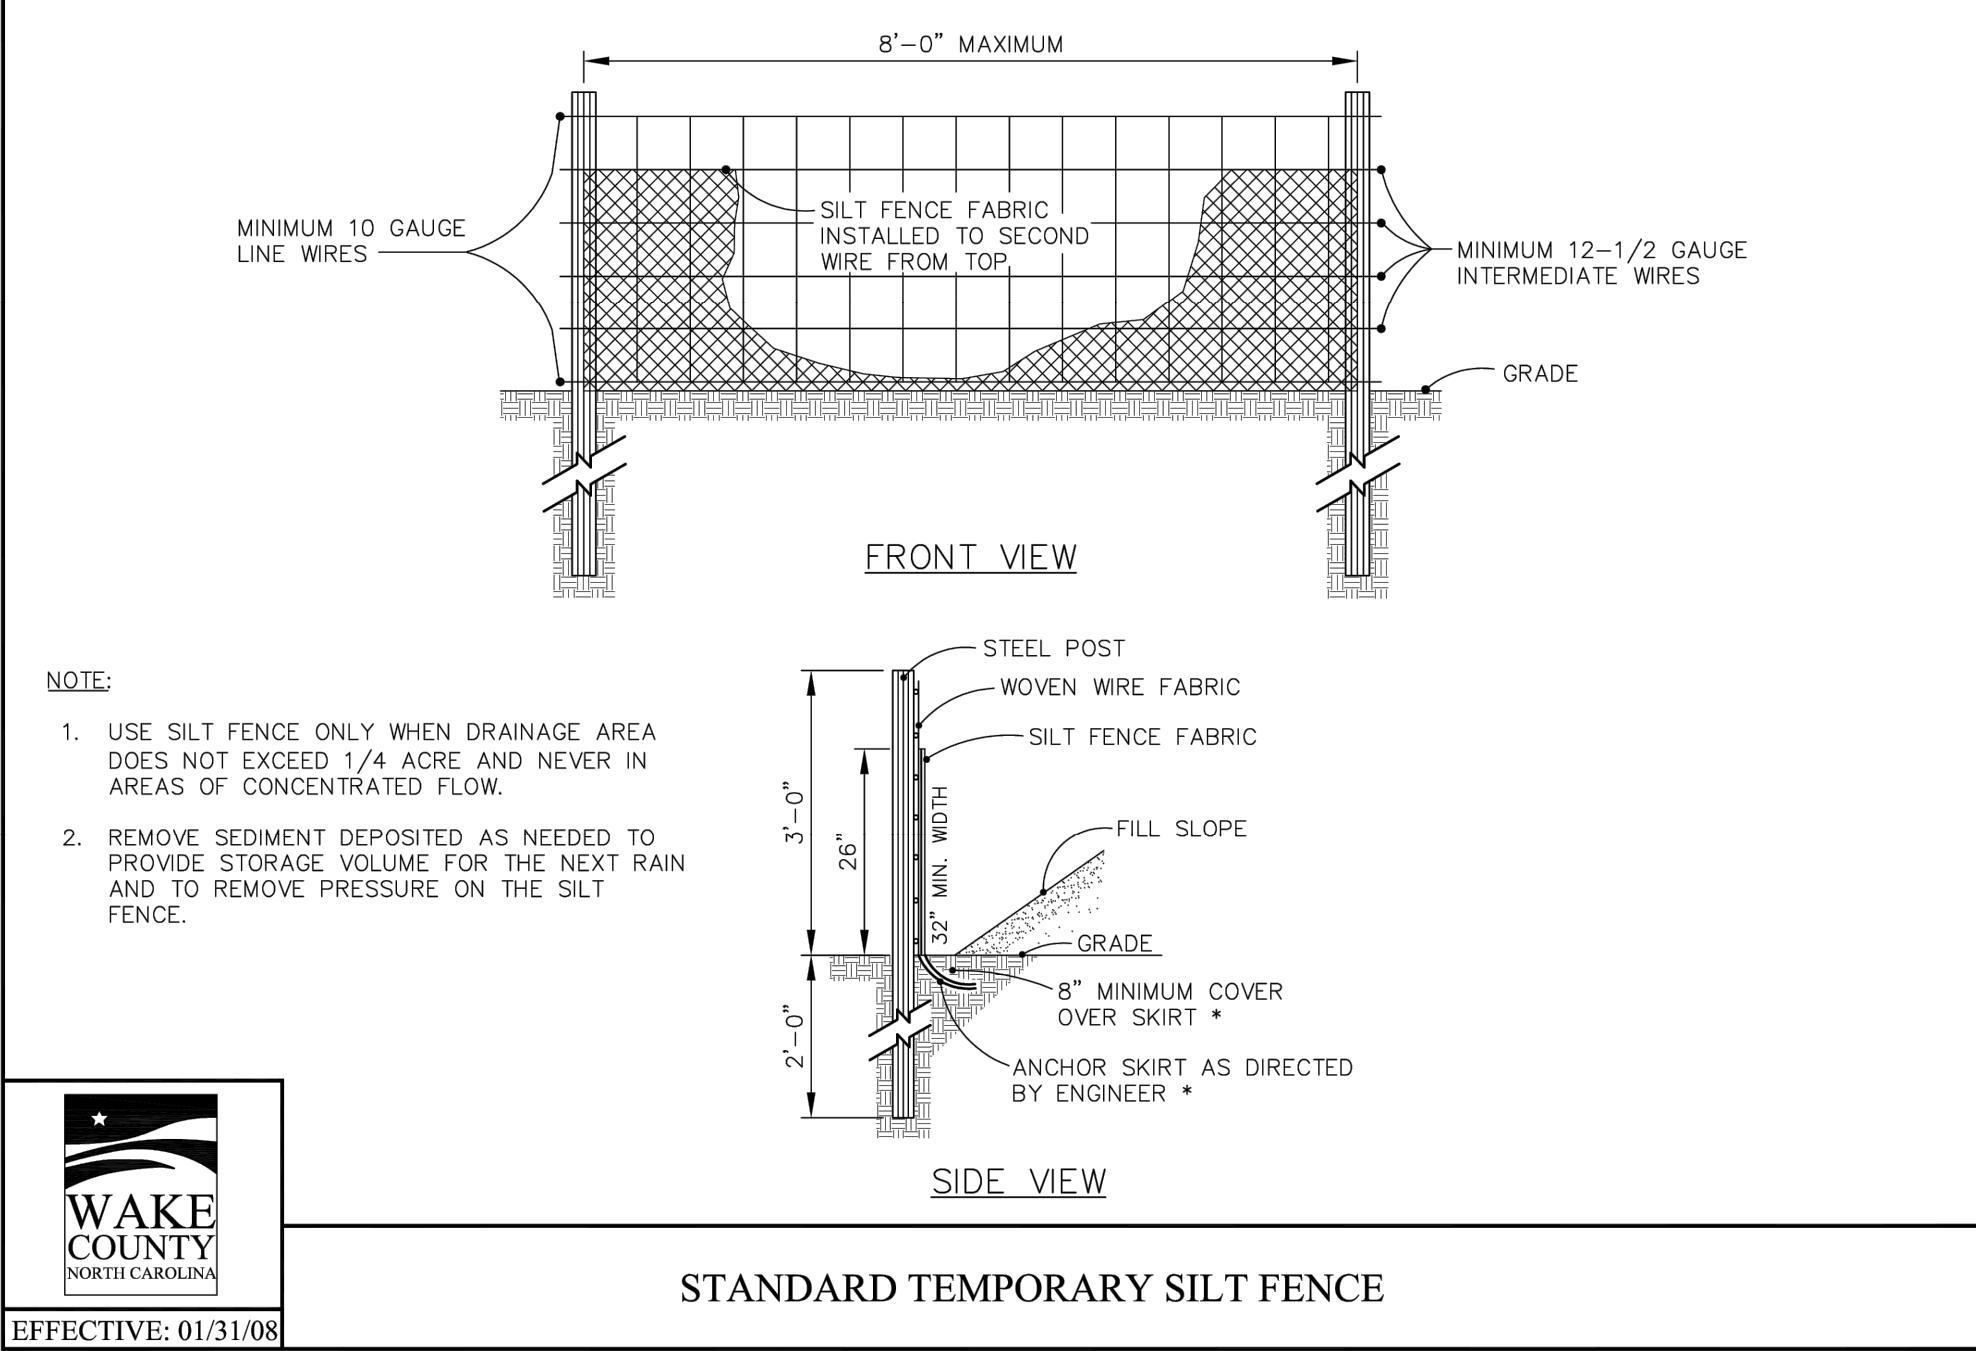


PER TOWN OF ROLESVILLE COMMENT		06/01/2023	REV	04/03/2023	INITIAL SUBMITTAL
DESIGNED BY:		DF/CD			
DRAWN BY:		DF/JWM			
REVIEWED BY:		DF			
BCE		5440 WADE PARK BLVD, SUITE 102 RALEIGH NC 27607 WWW.BCEINC.COM NC LICENSE #C-4397			
LENNAR CORPORAION		1100 PERIMETER PARK DRIVE, SUITE 112 MORRISVILLE / NORTH CAROLINA / 27560			
PARKER RIDGE		82 SCHOOL STREET ROLESVILLE / NORTH CAROLINA / 27571			
EROSION CONTROL DETAILS (2 OF 2)		PRELIMINARY ENGINEER FEDRA M. FERNANDEZ NOT FOR CONSTRUCTION FILE NUMBER: 8430-03 DATE: 06/01/2023 C8-3			



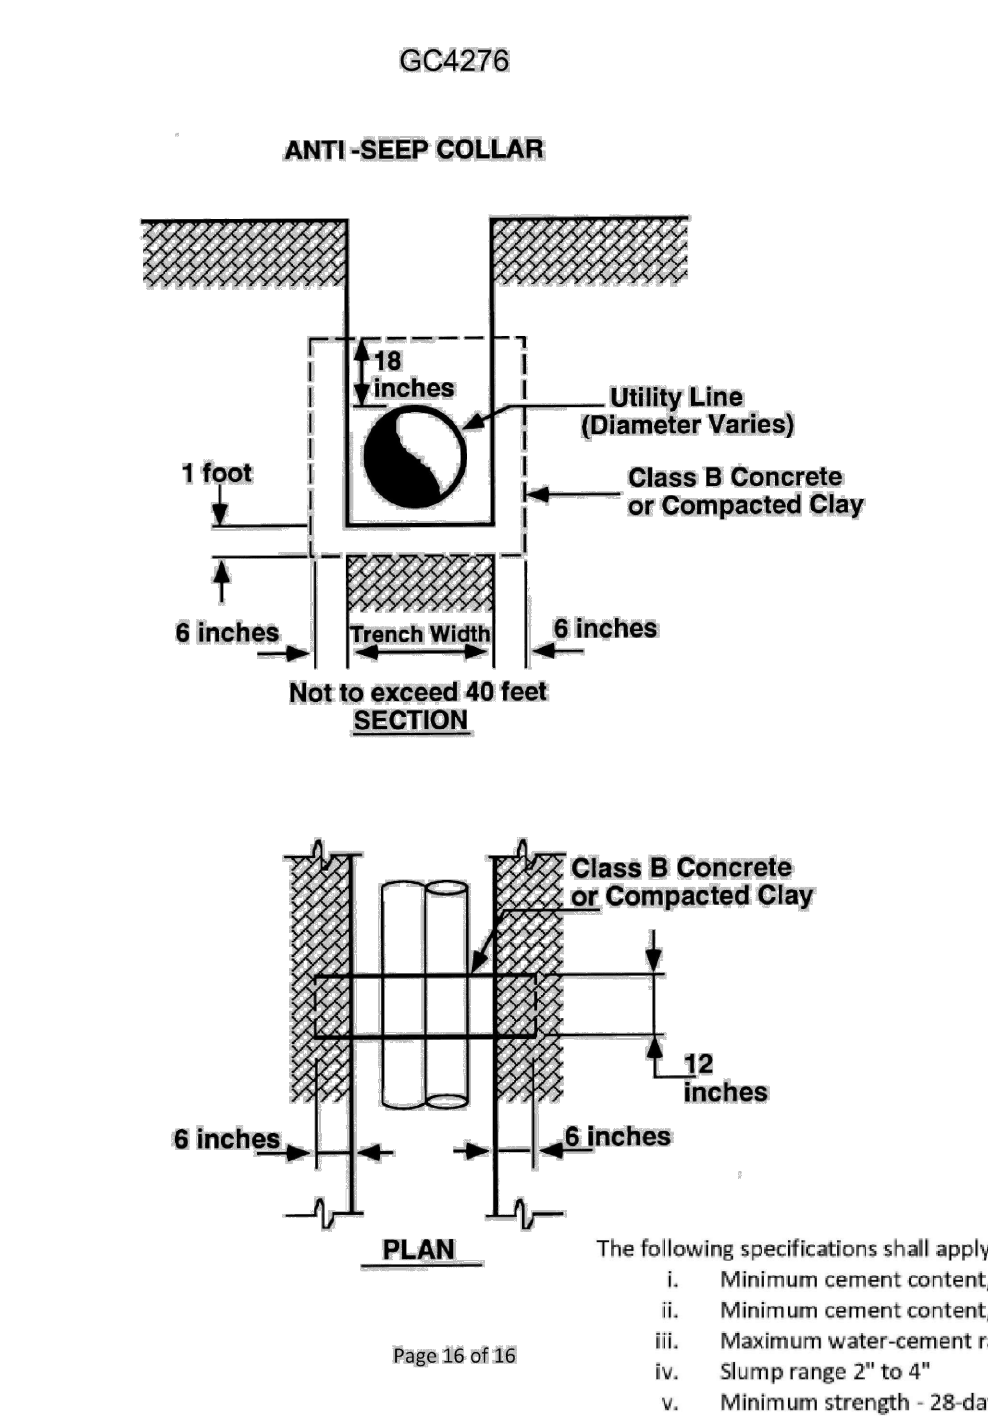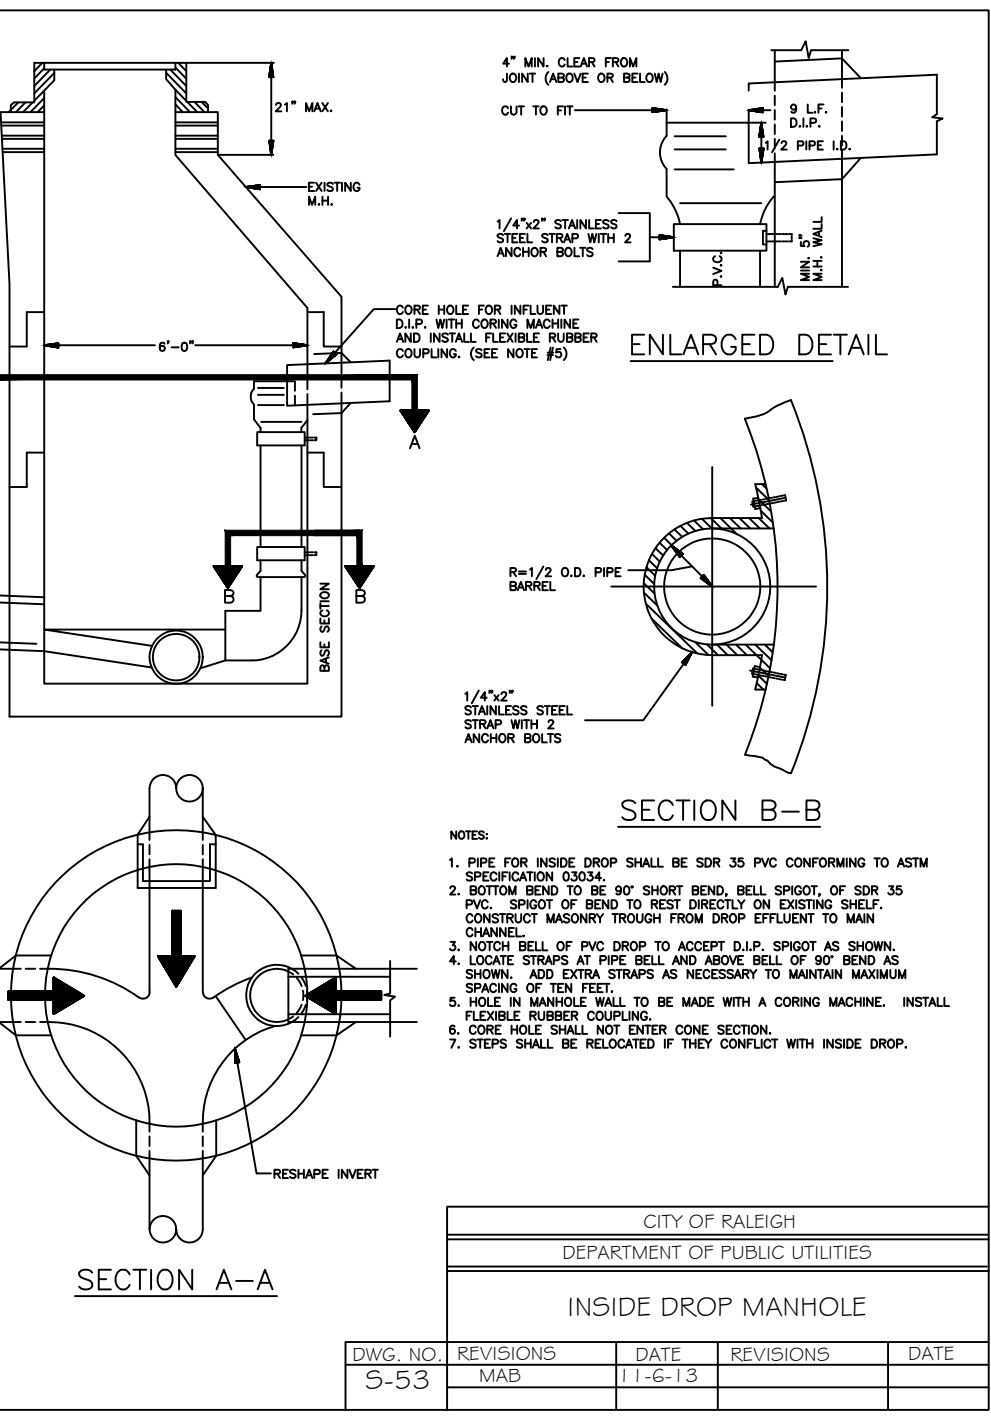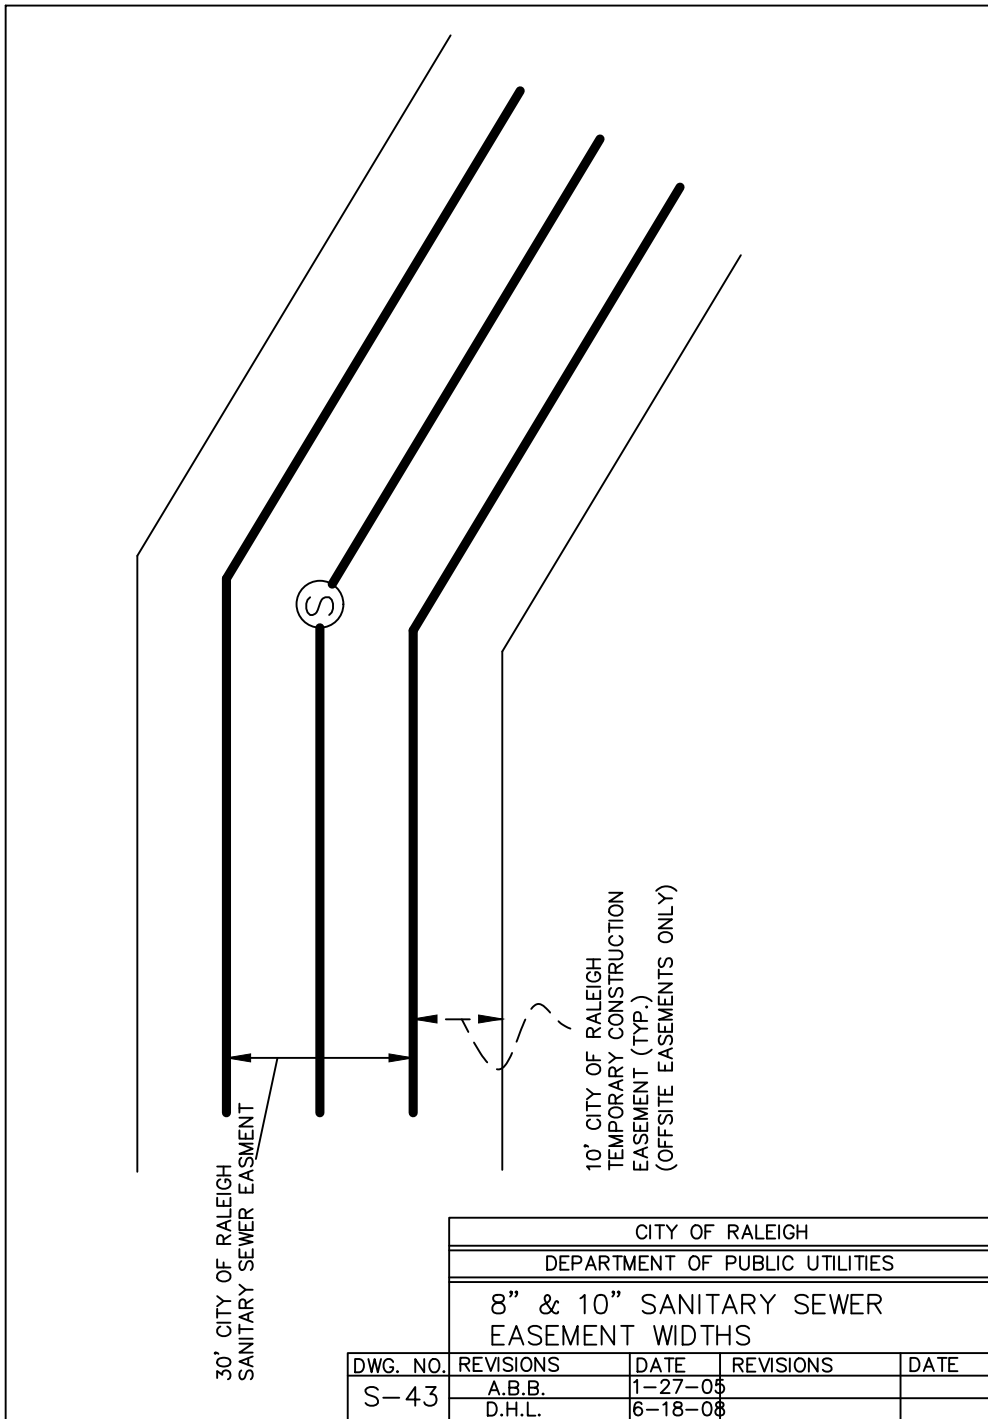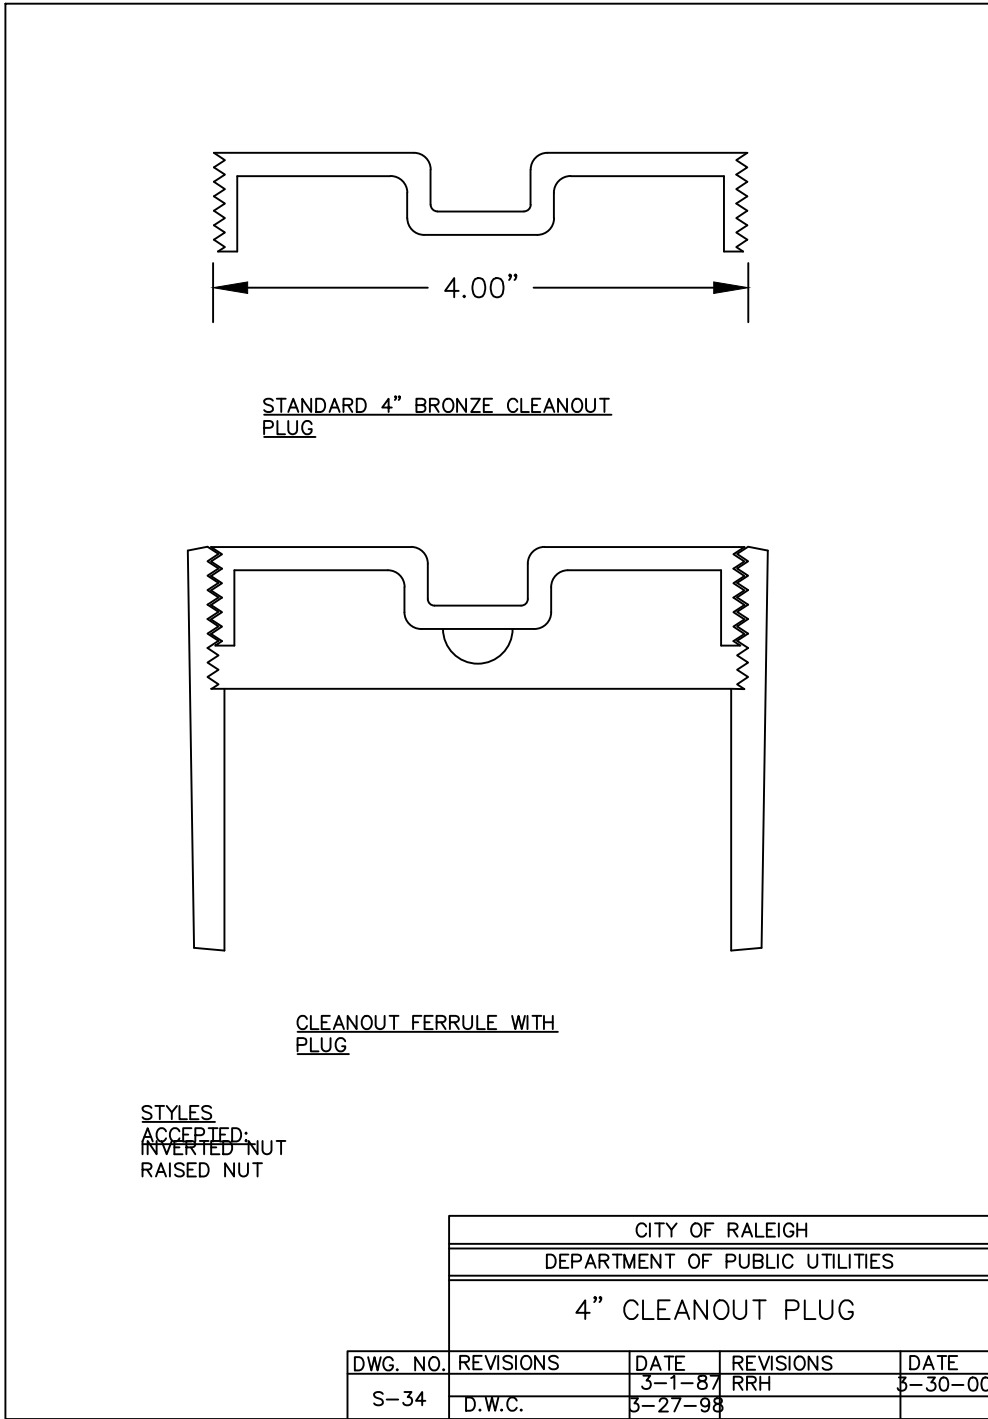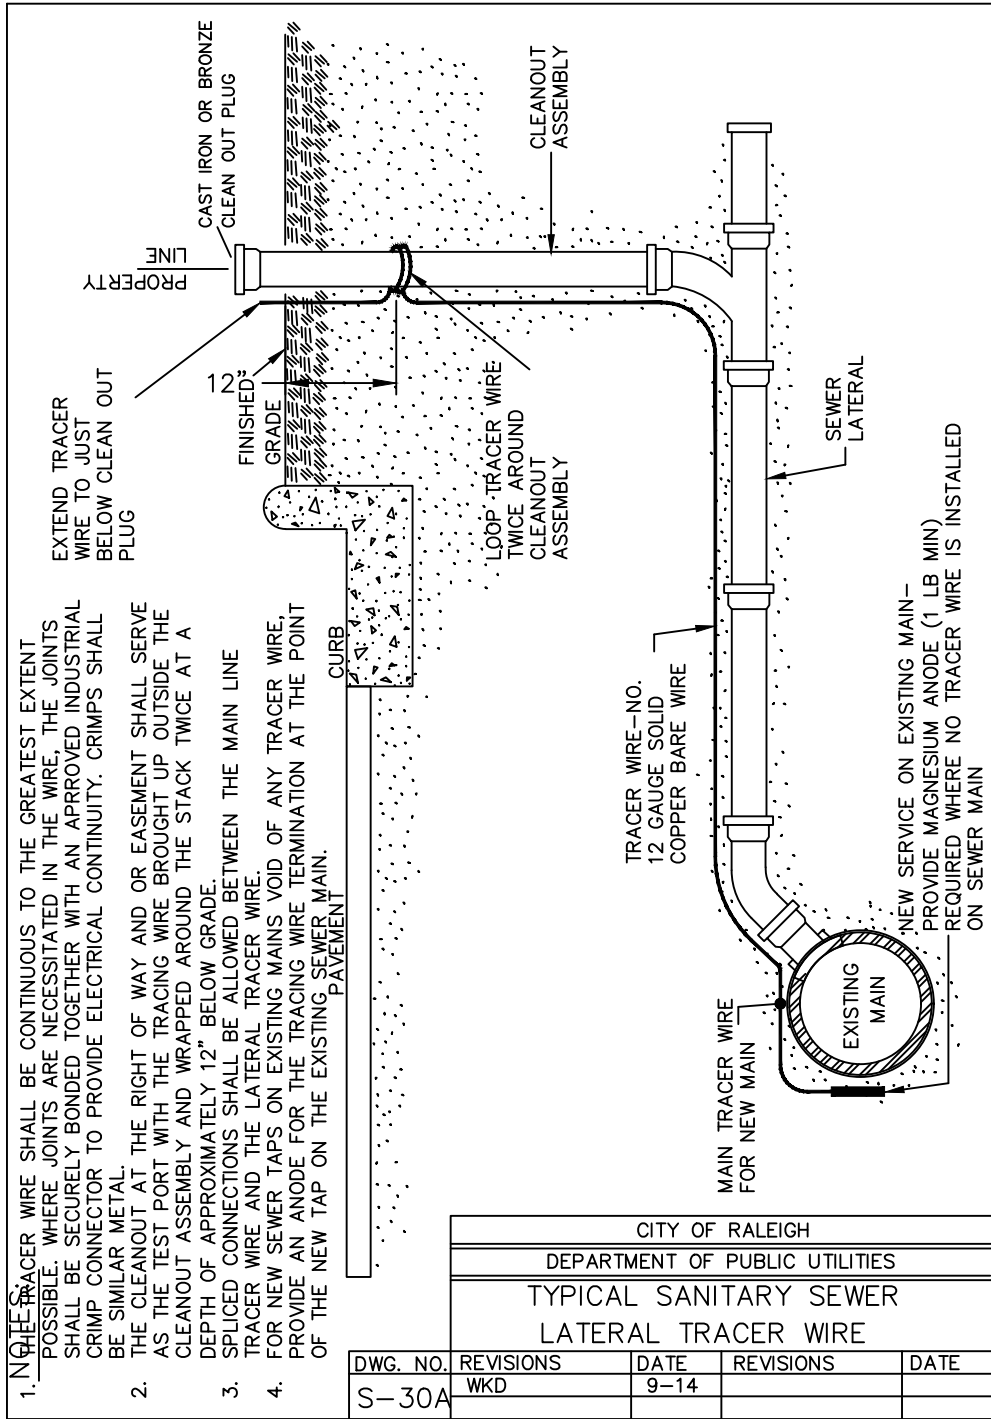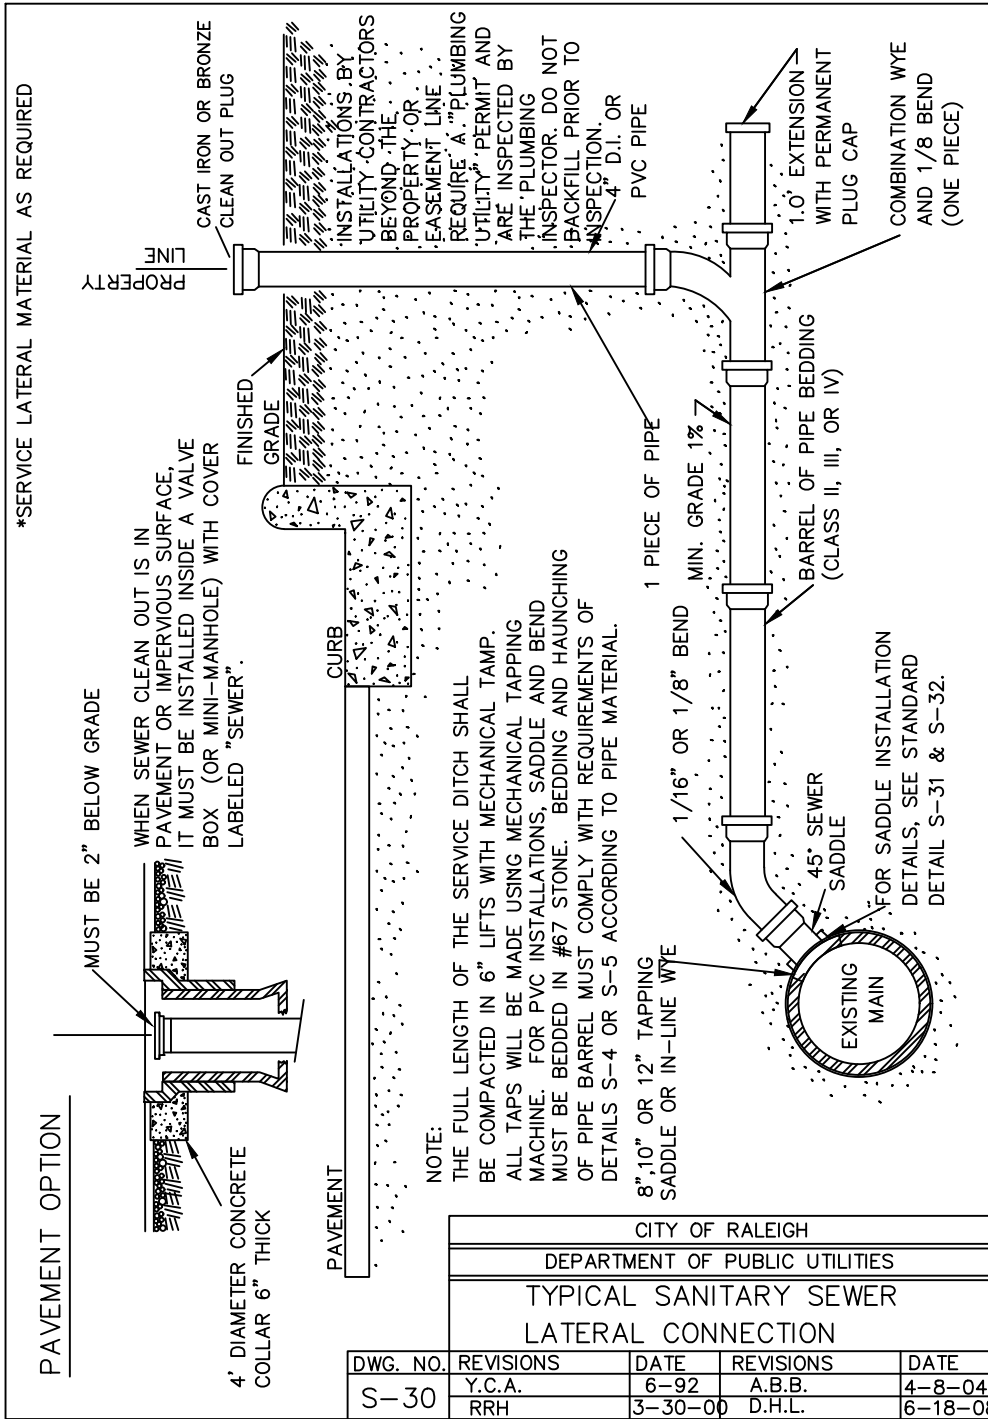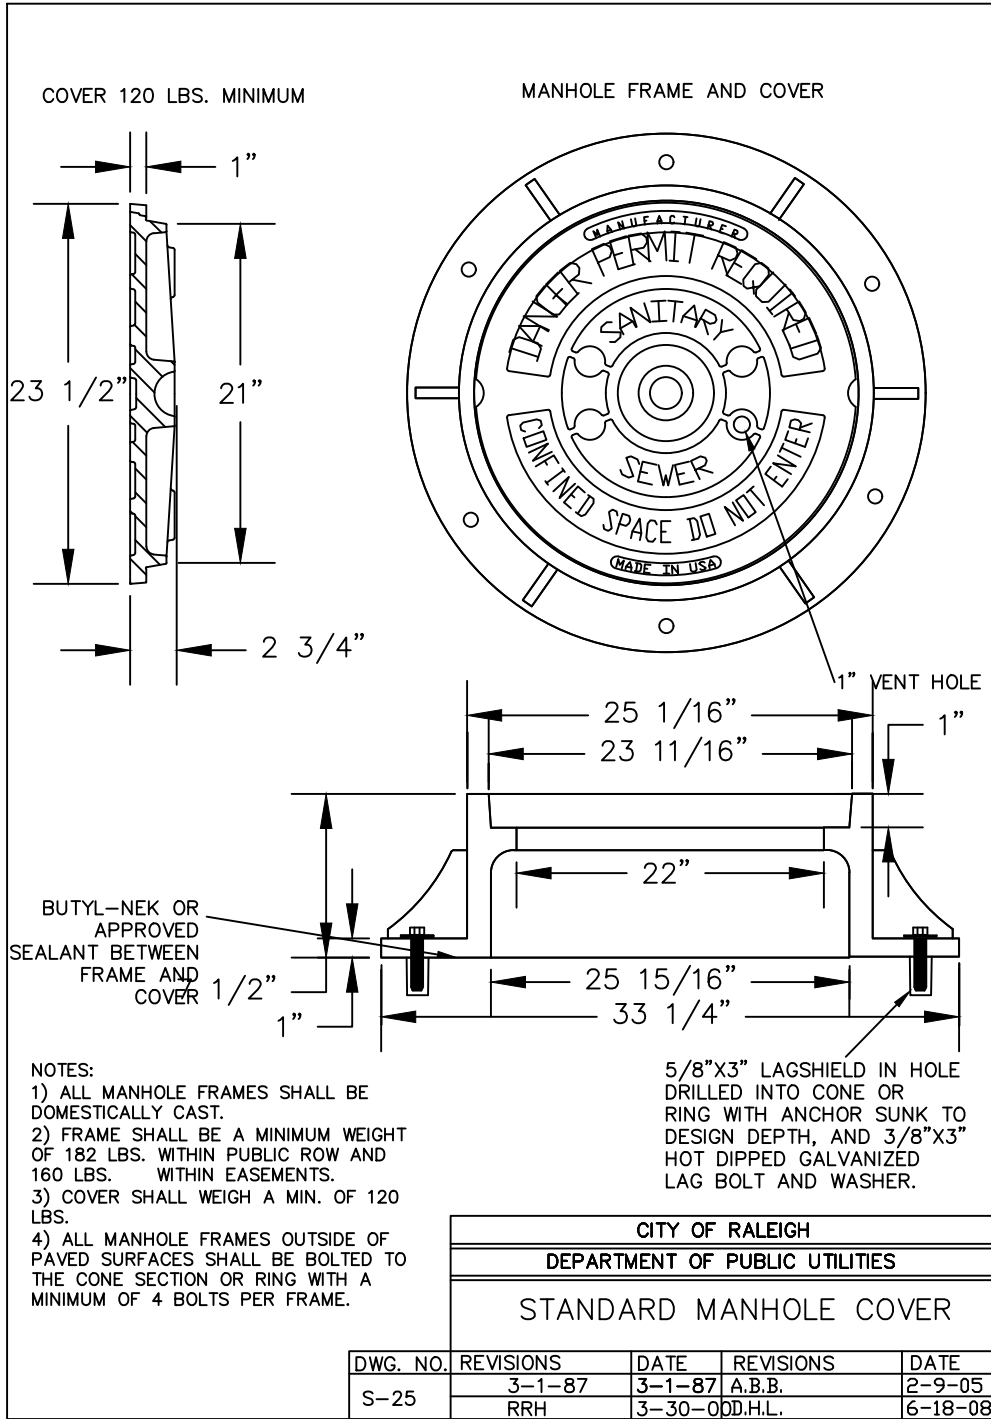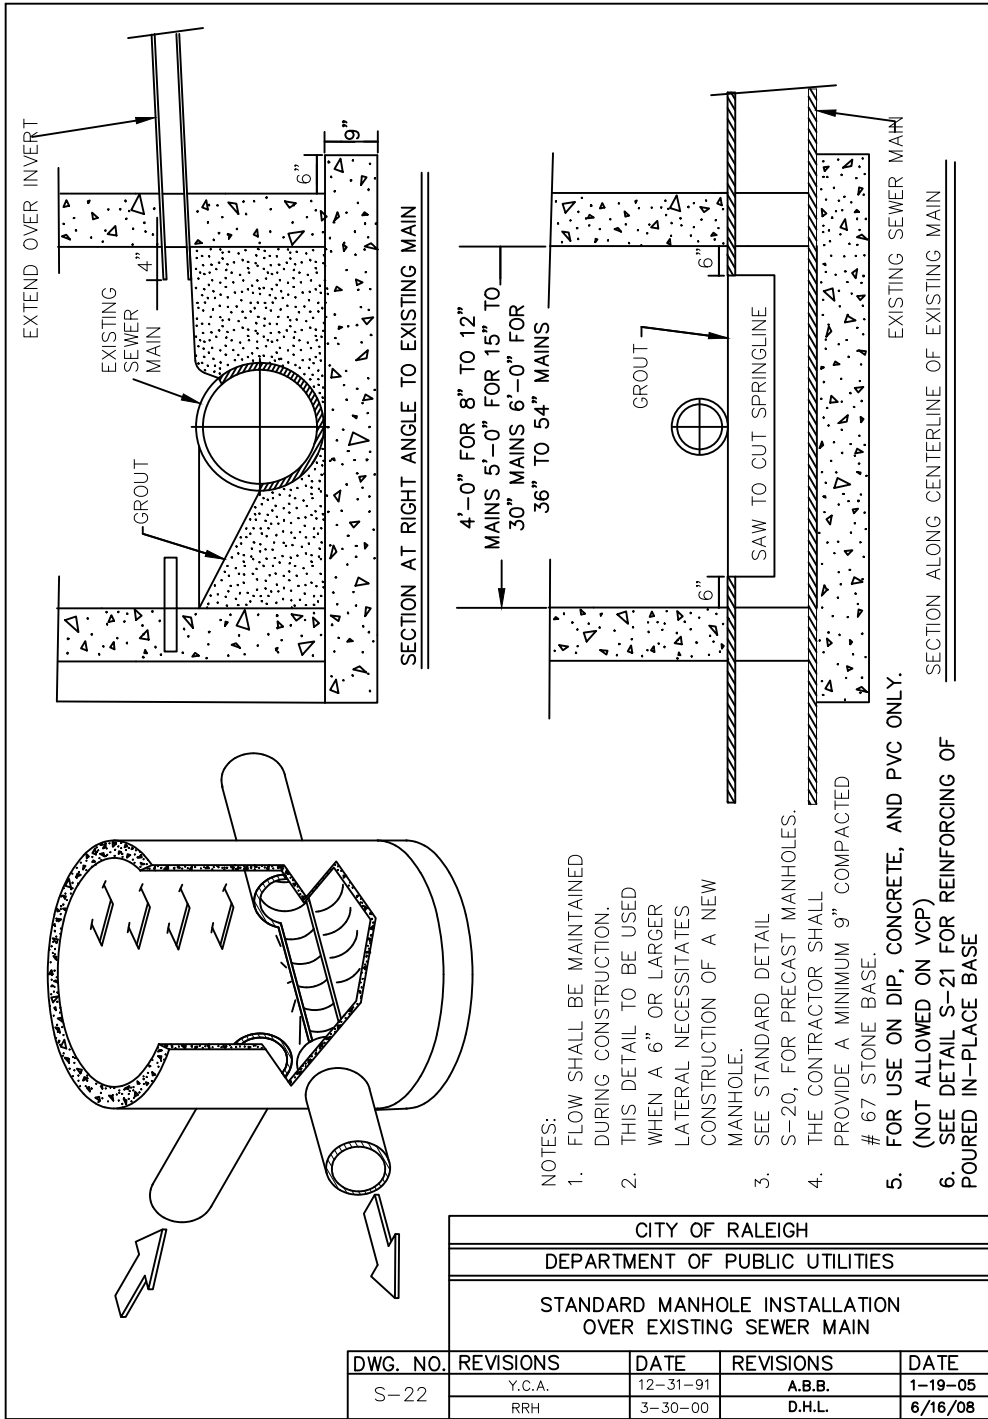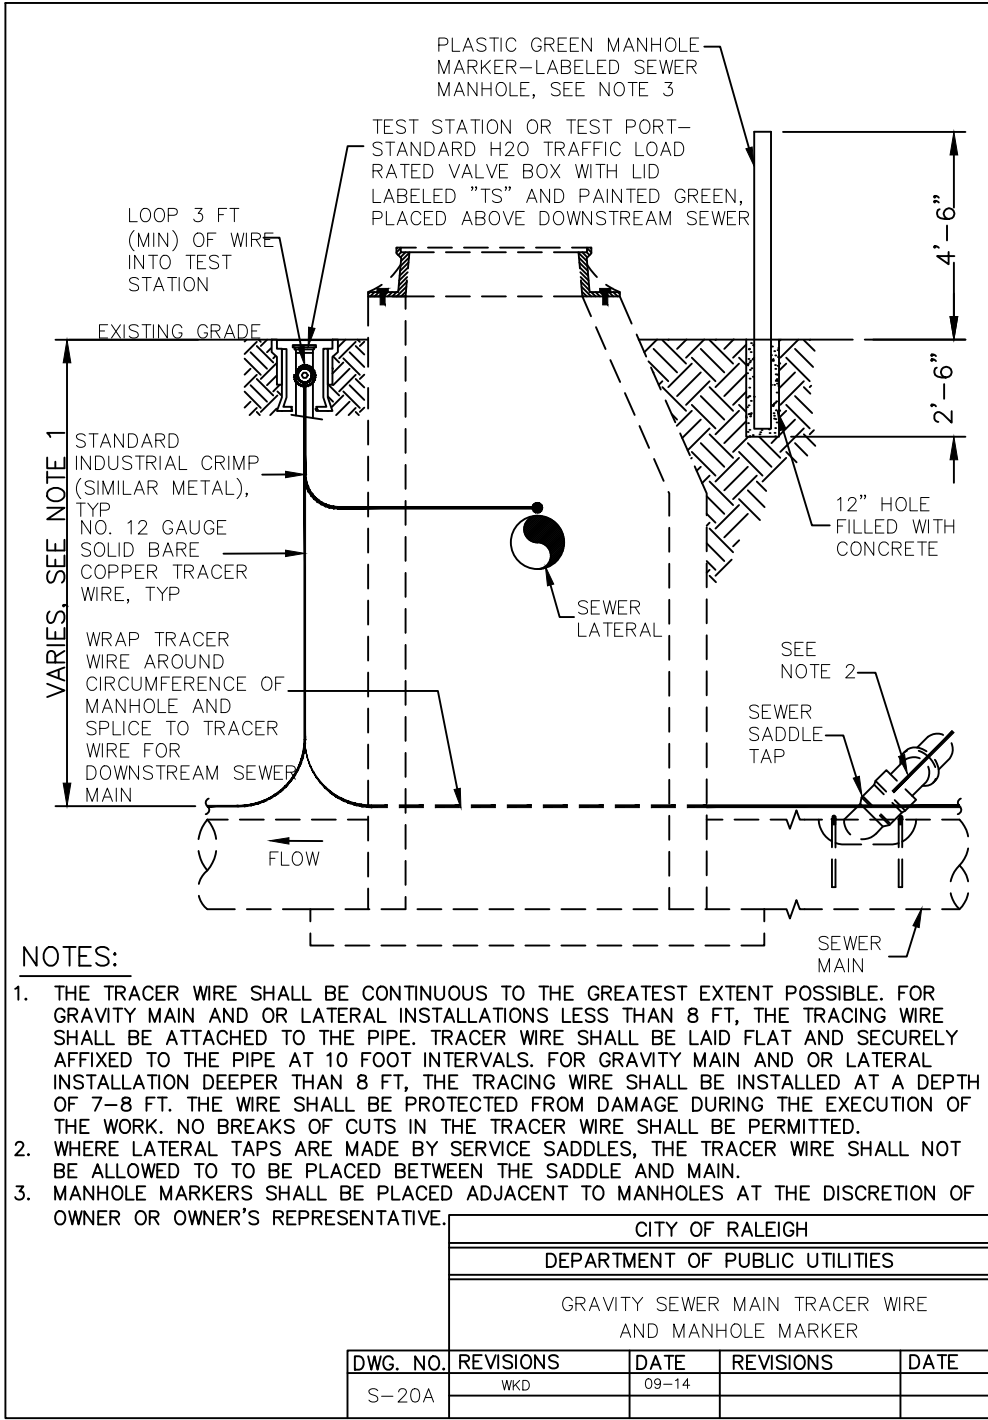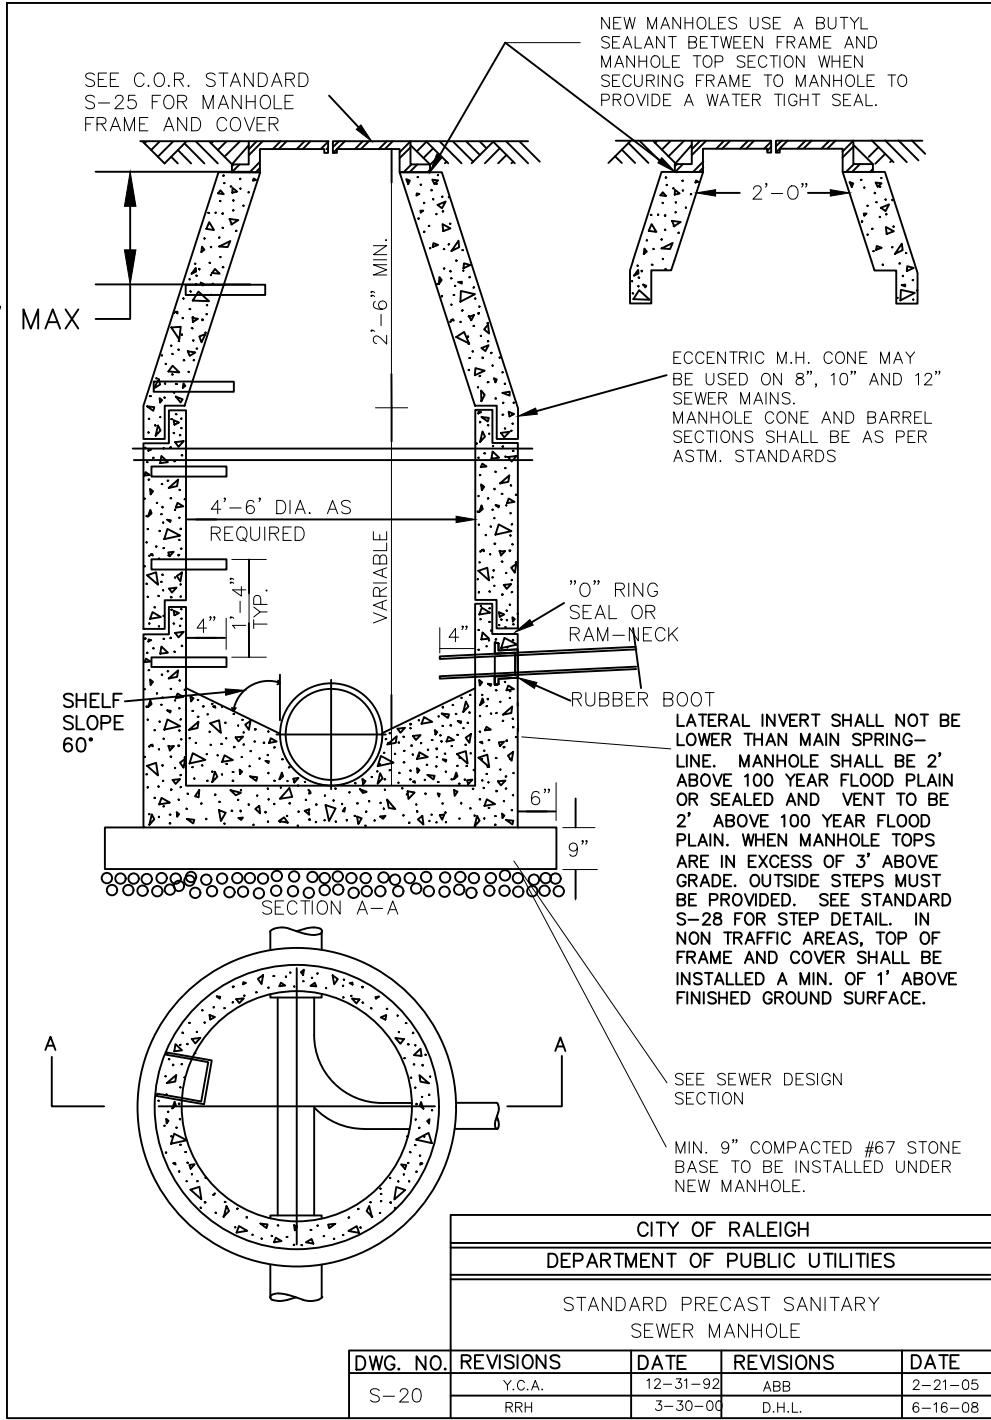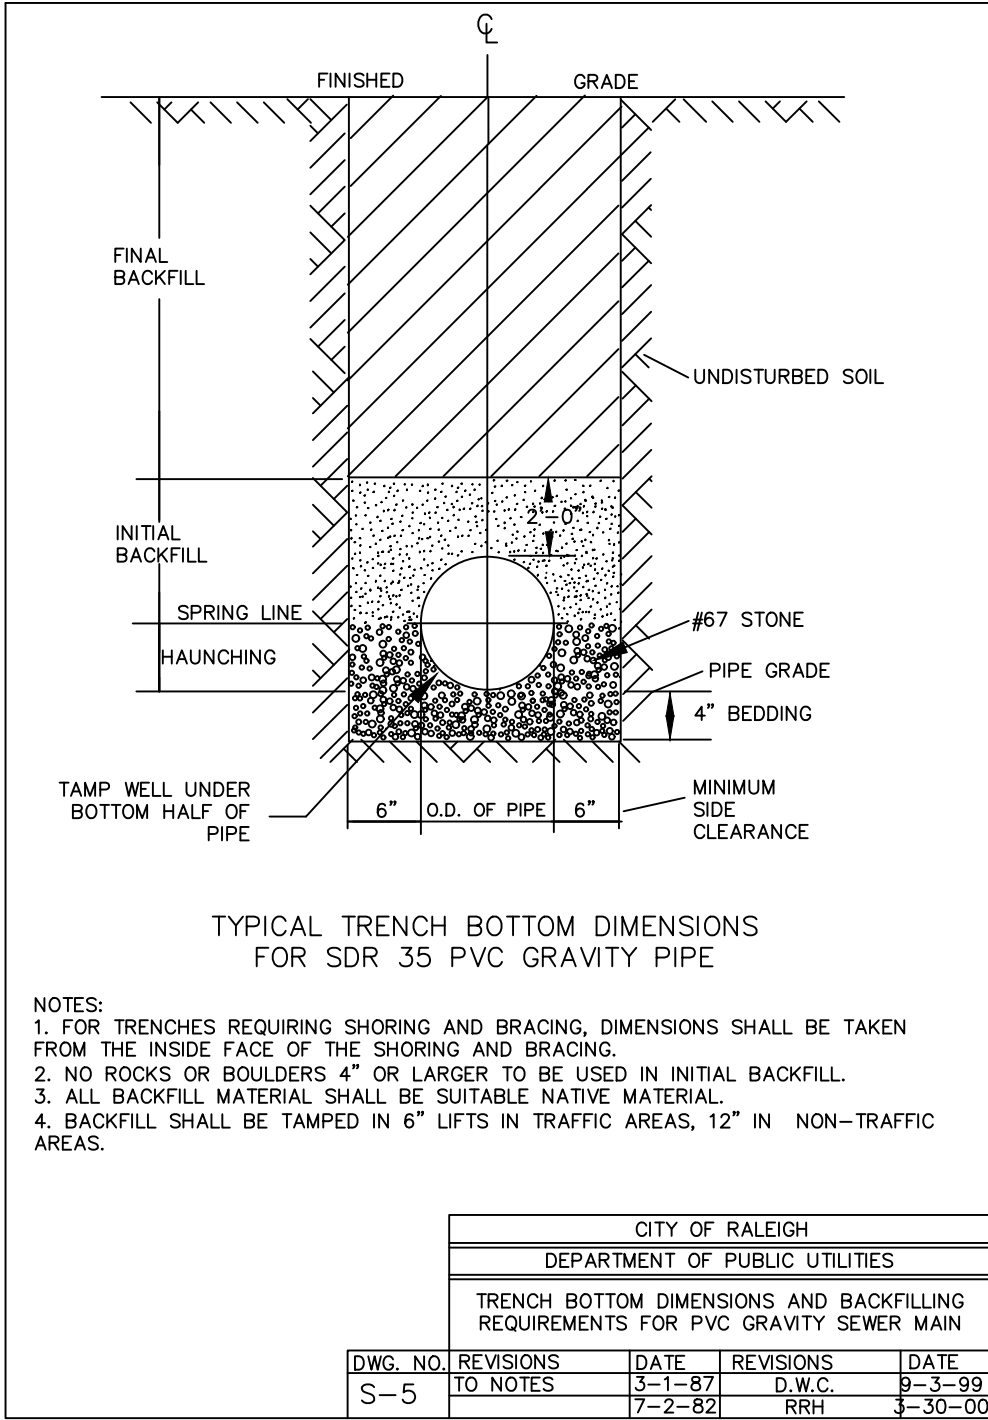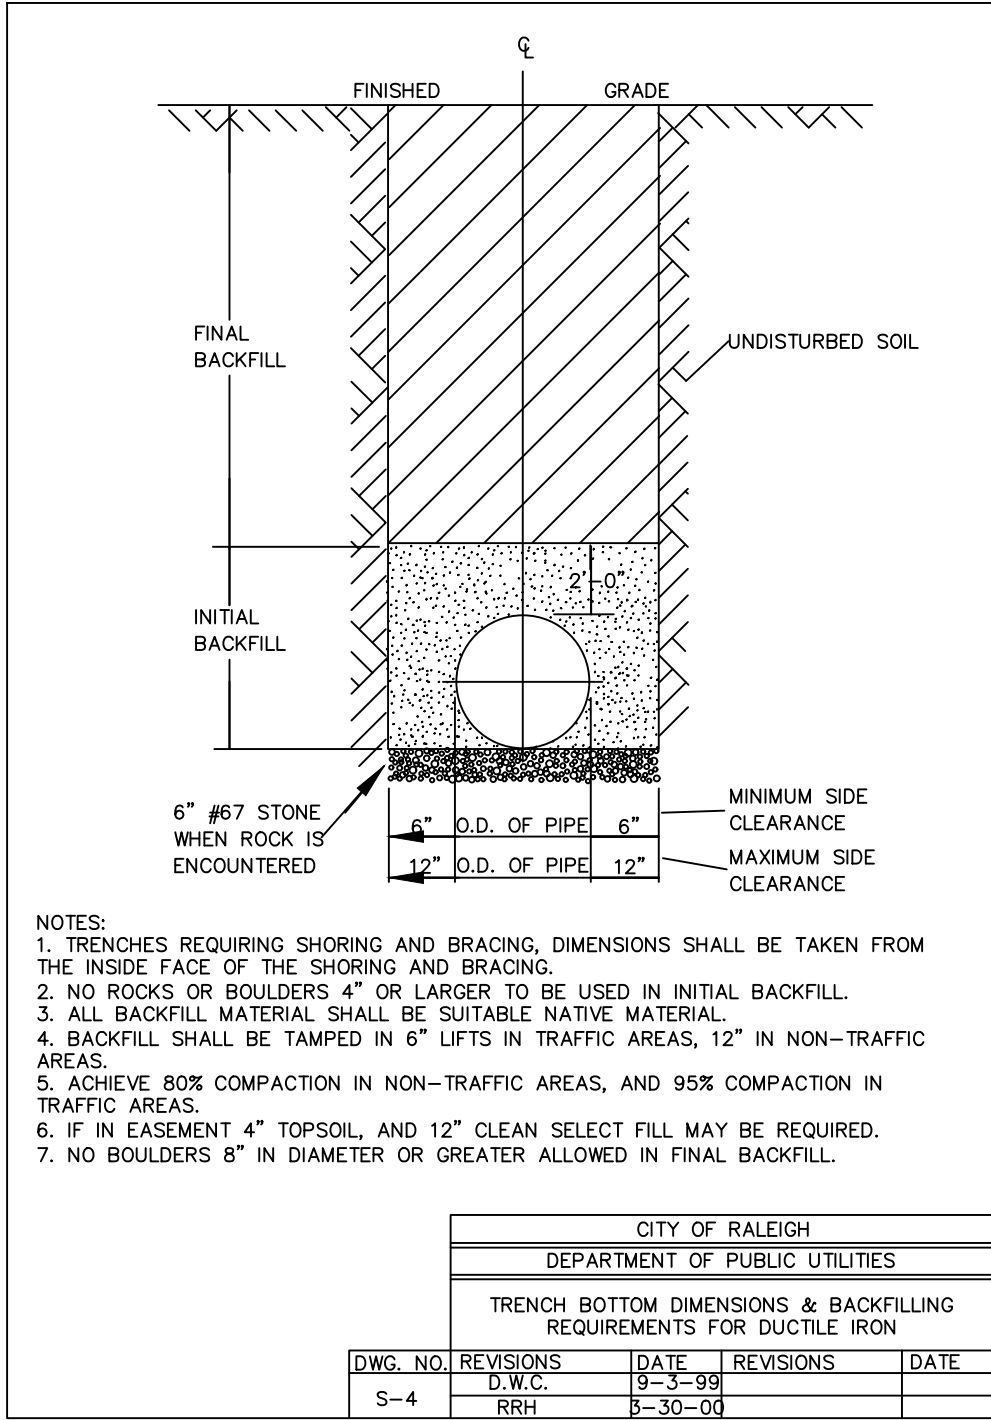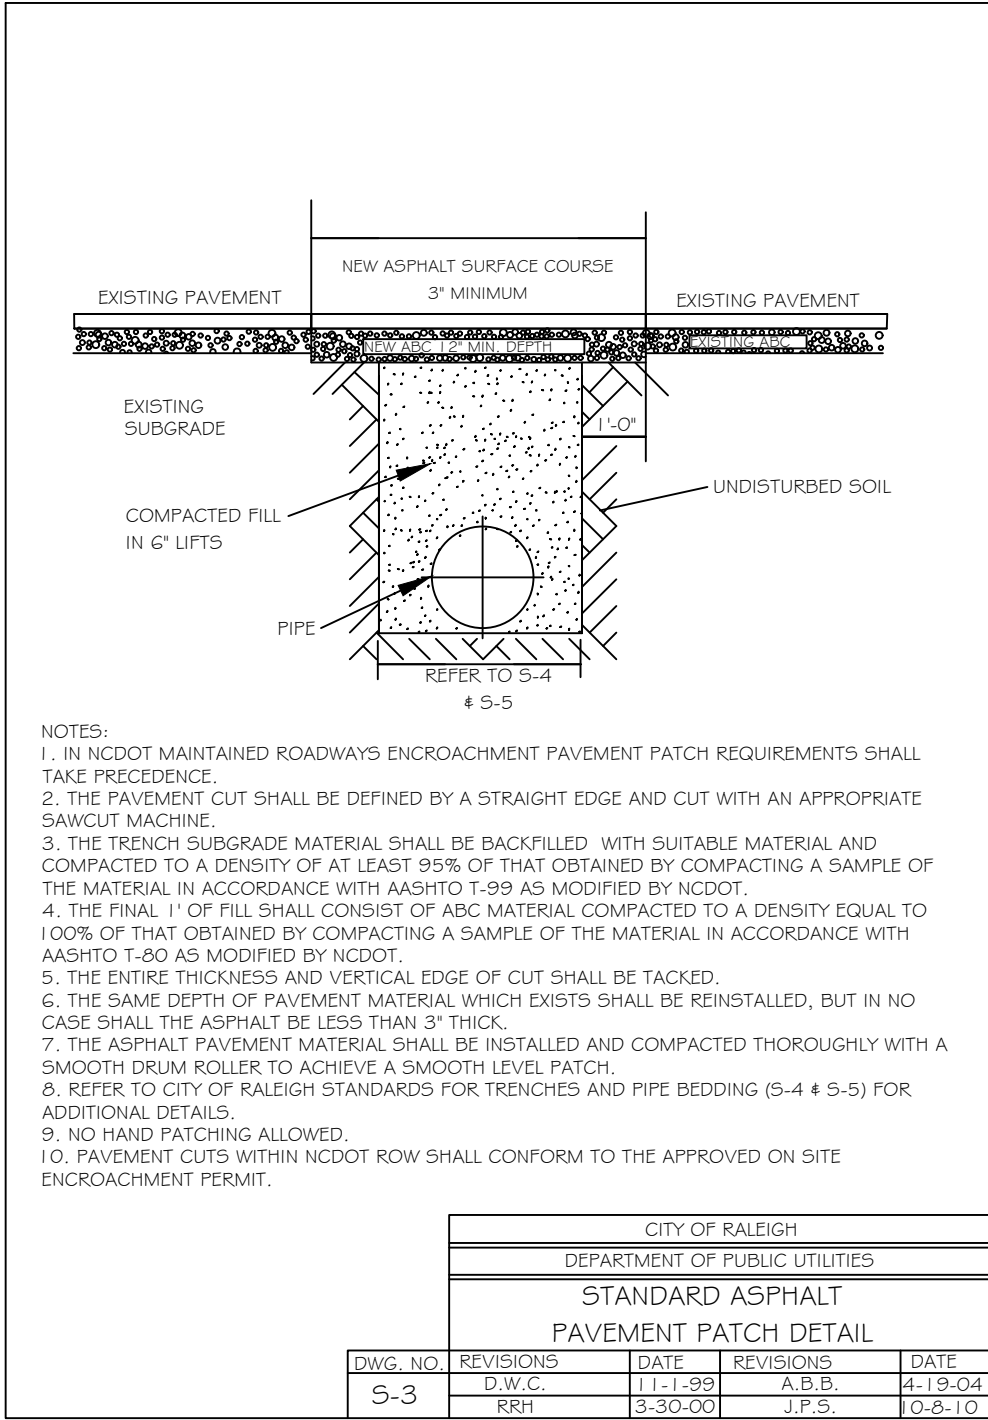

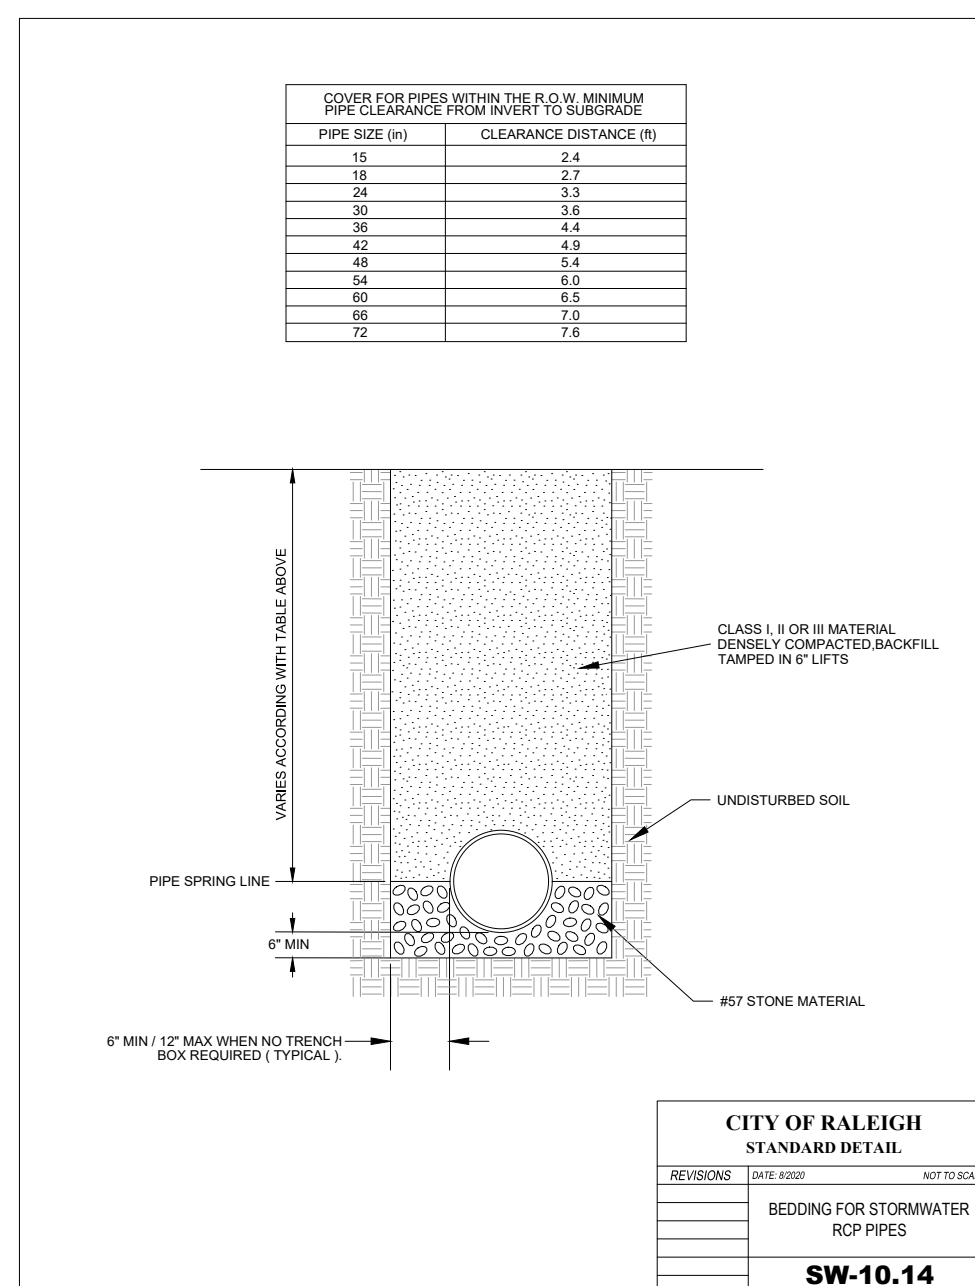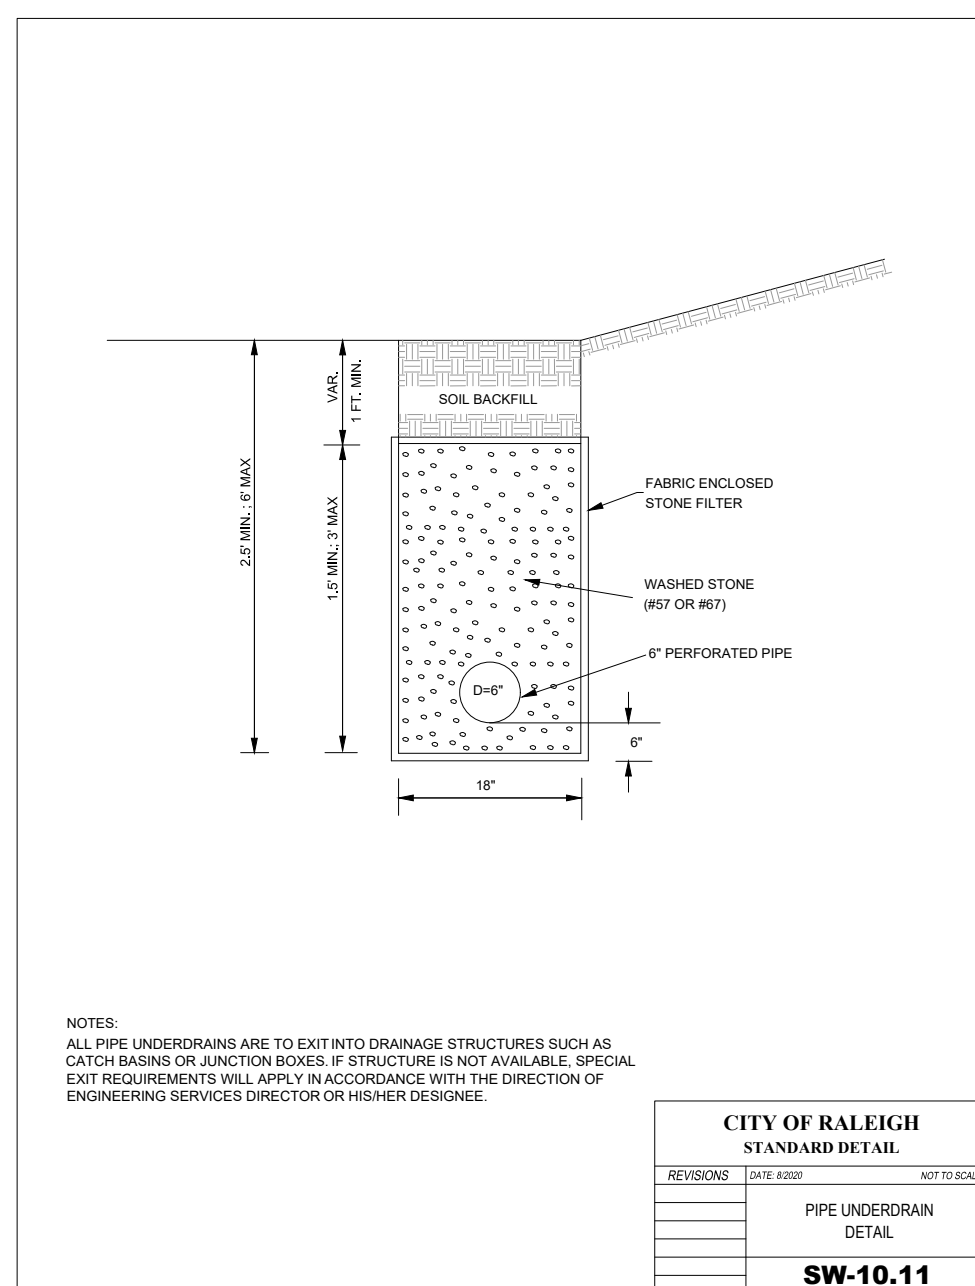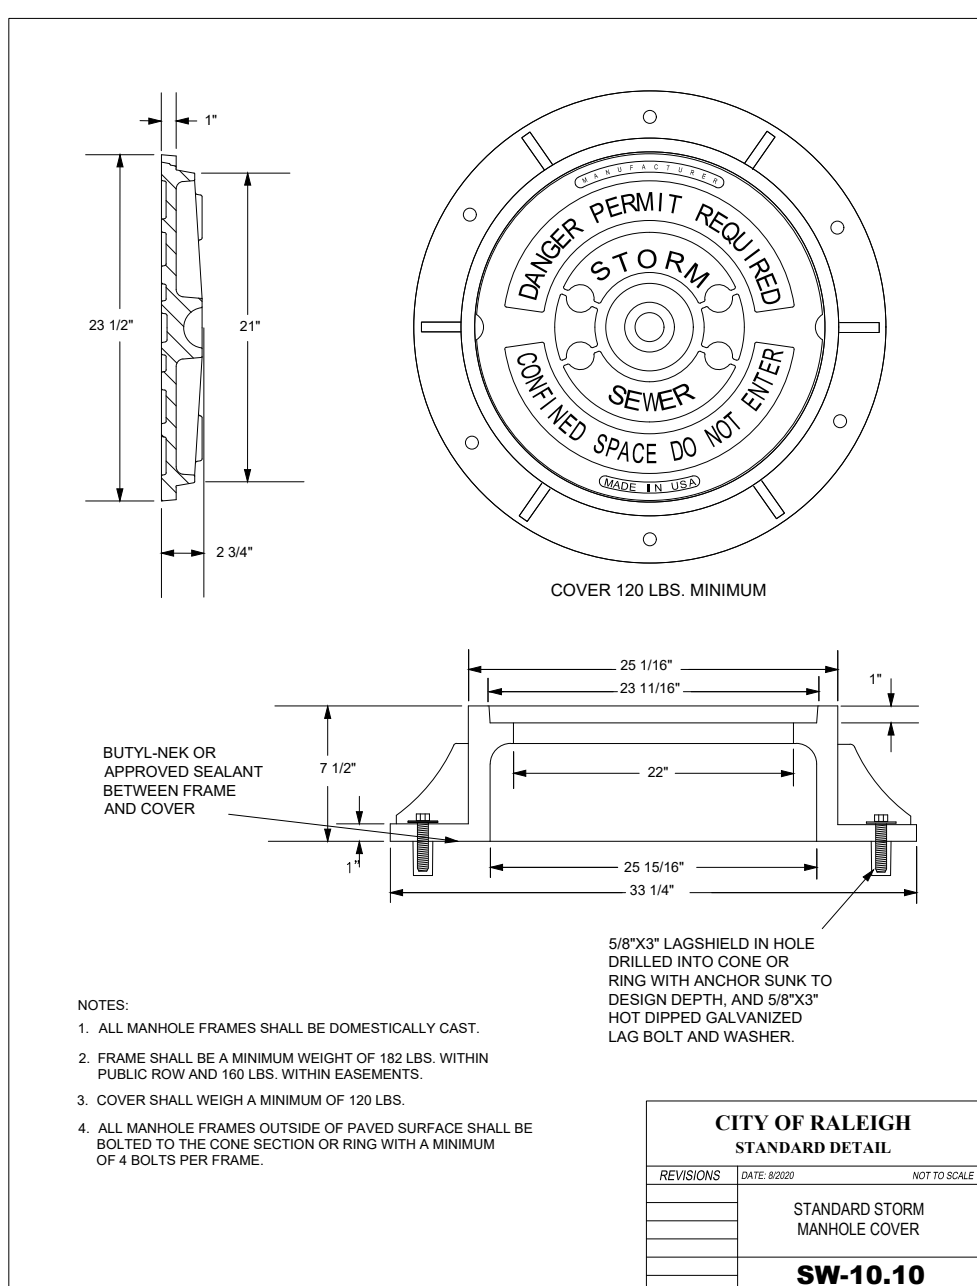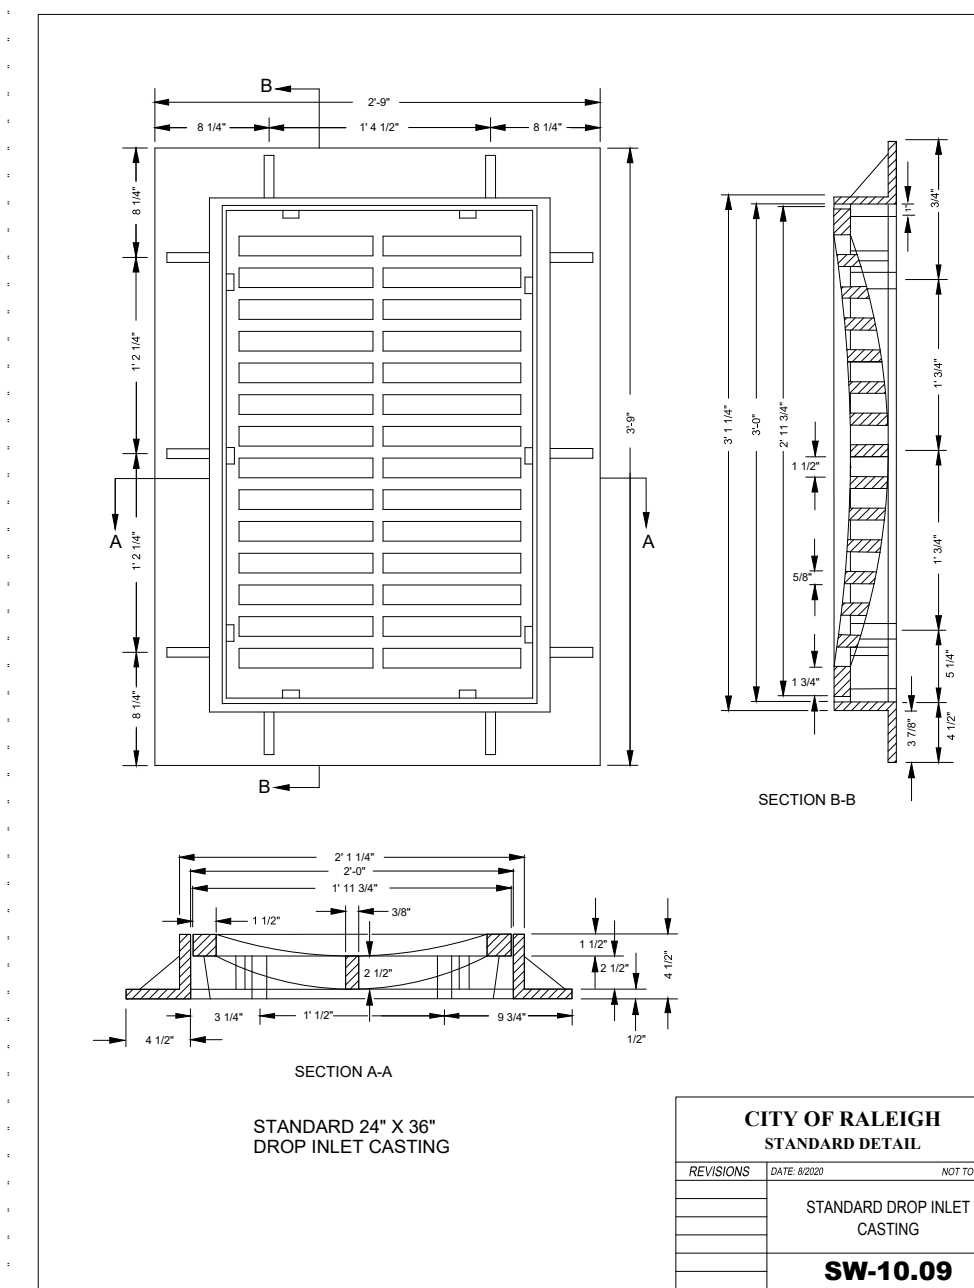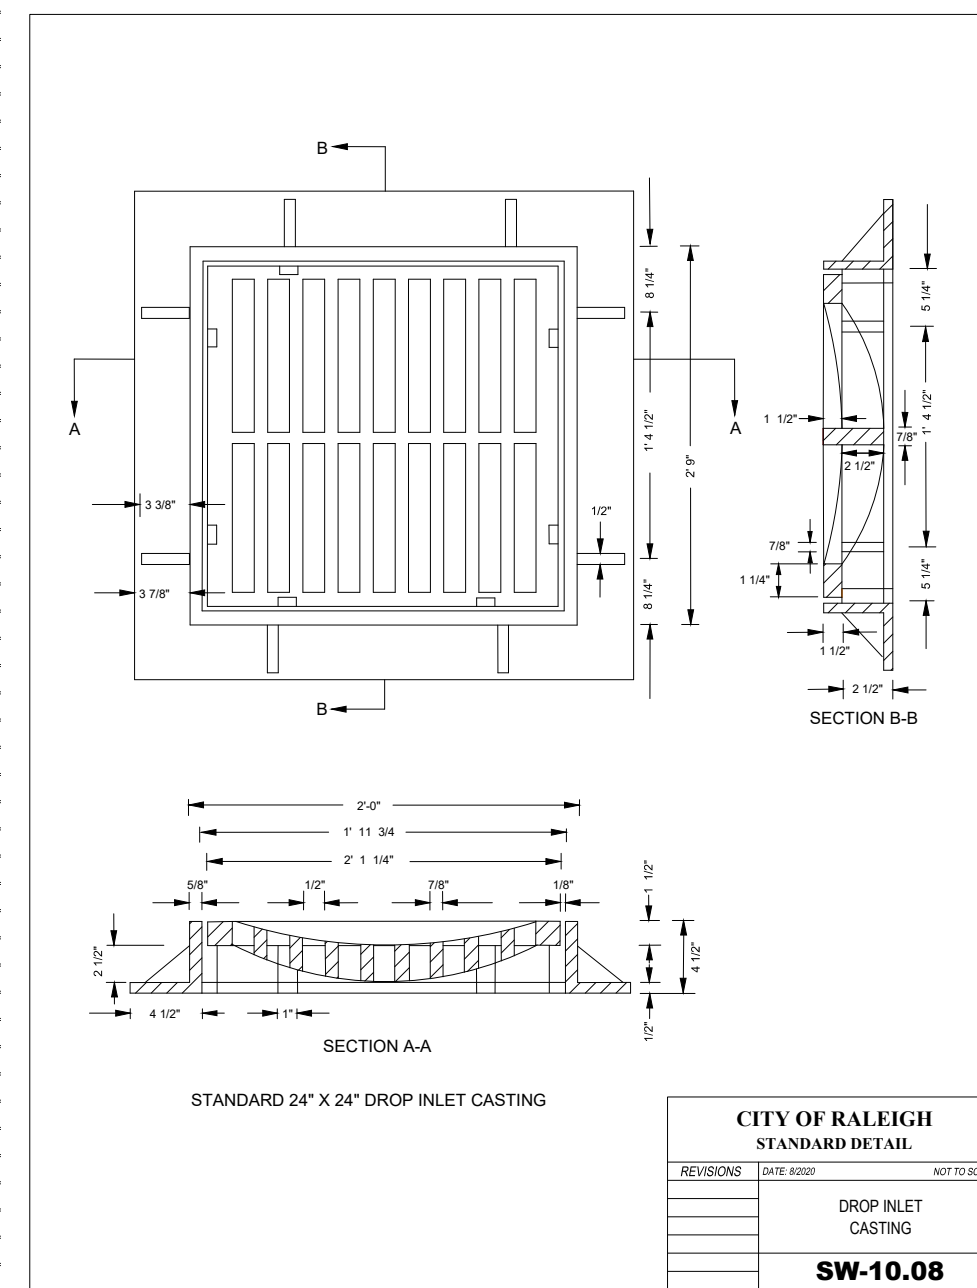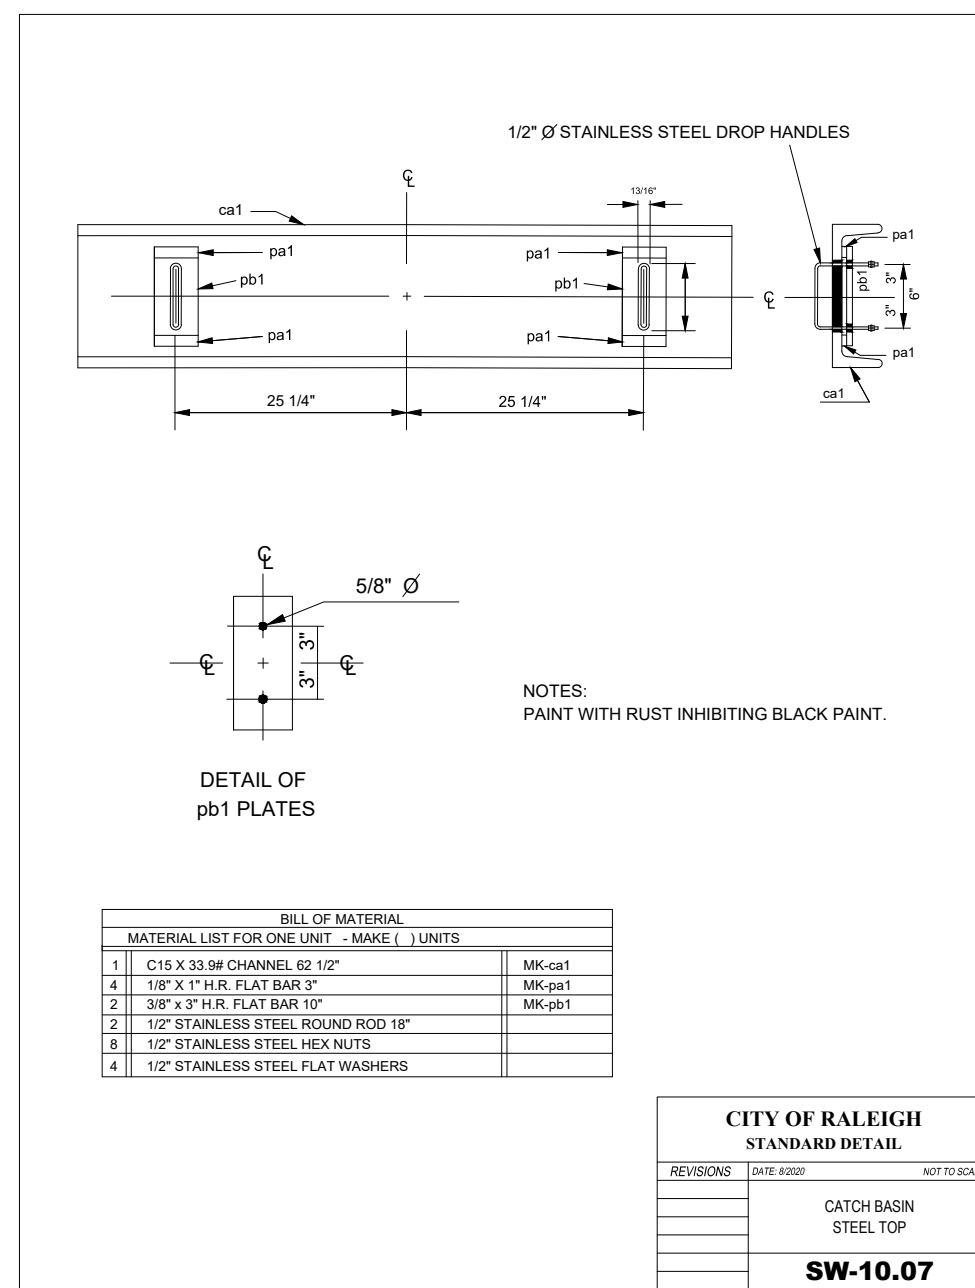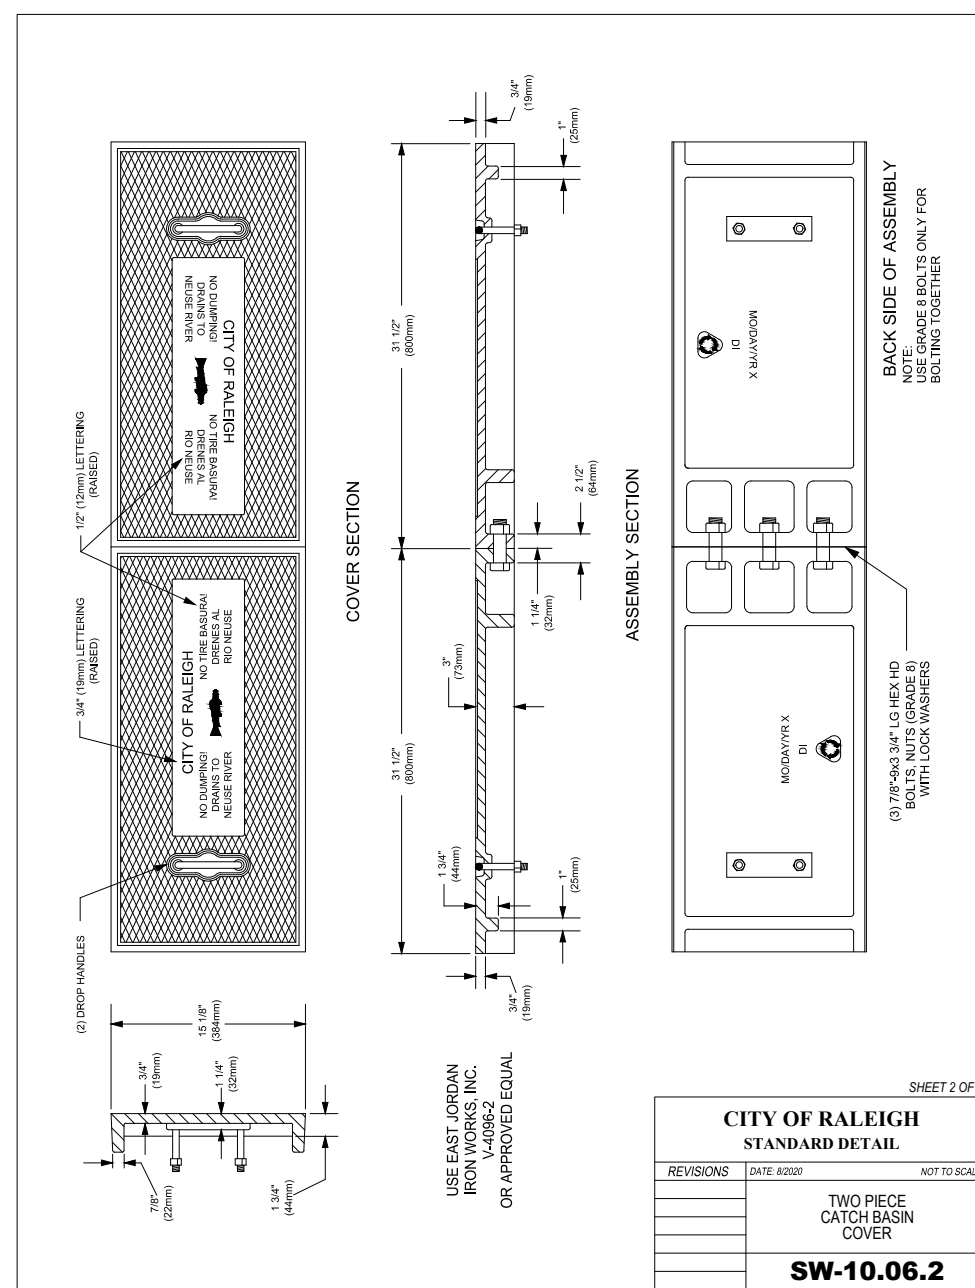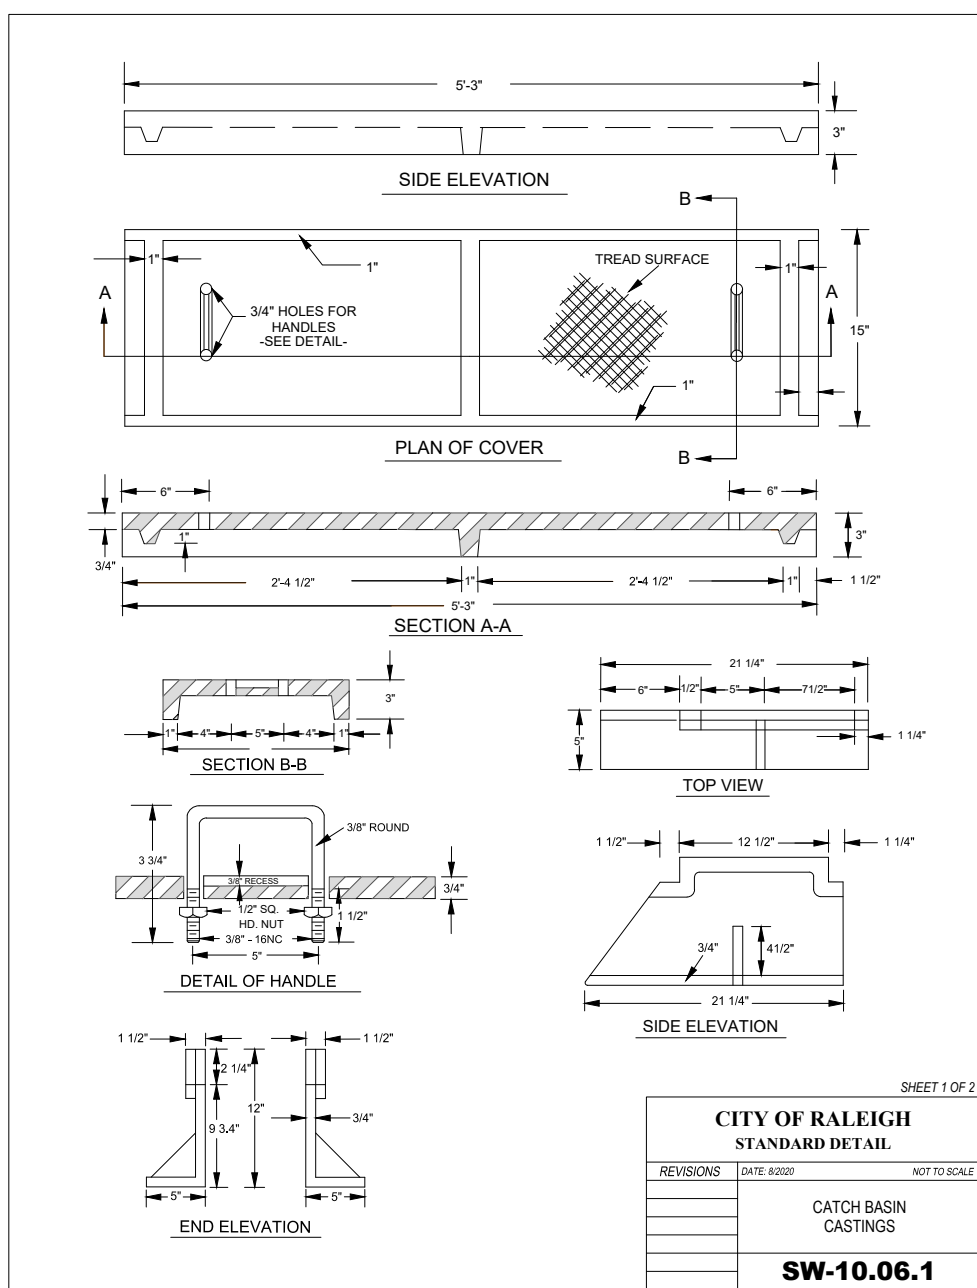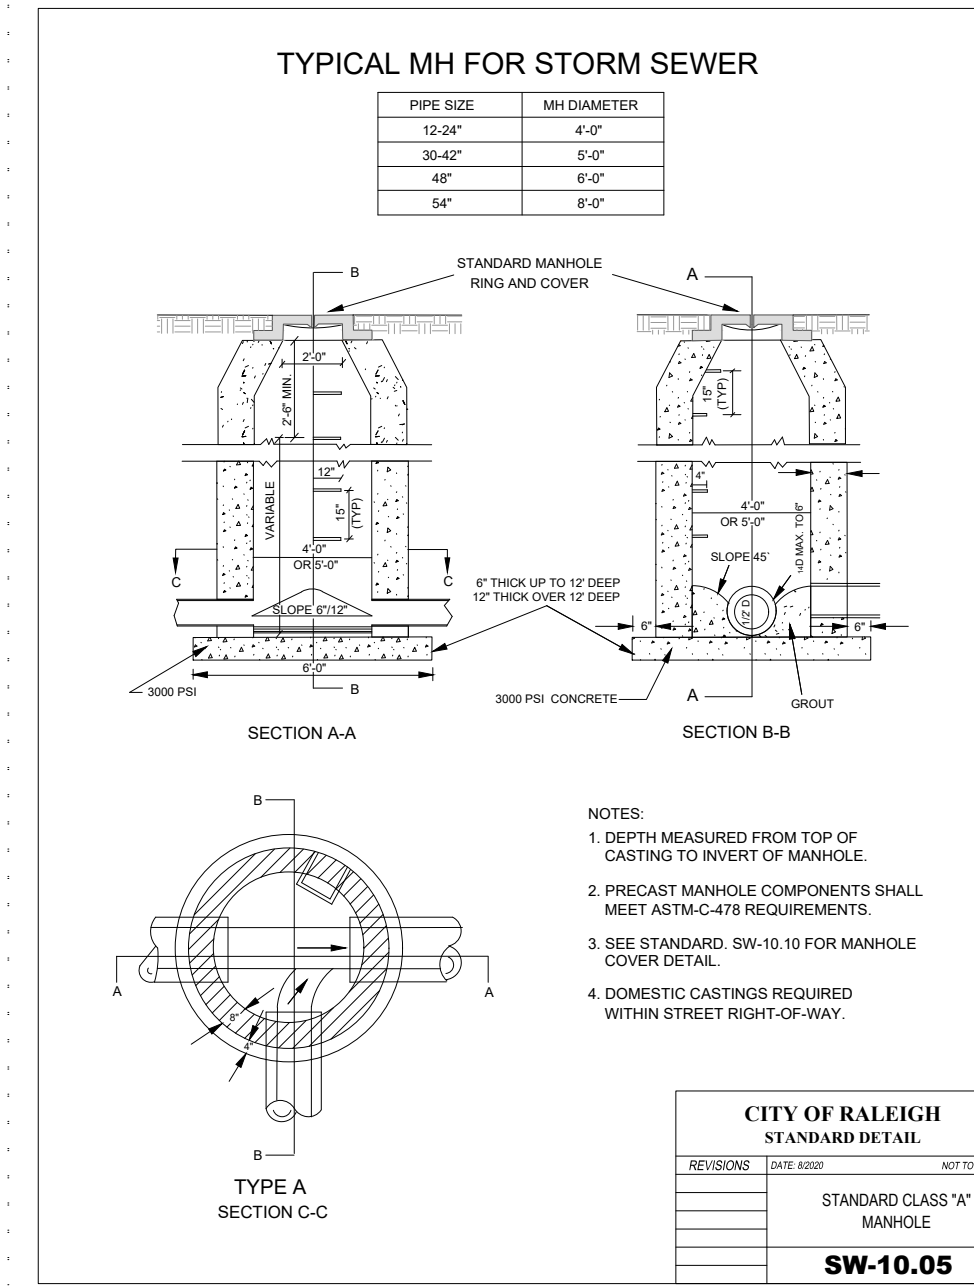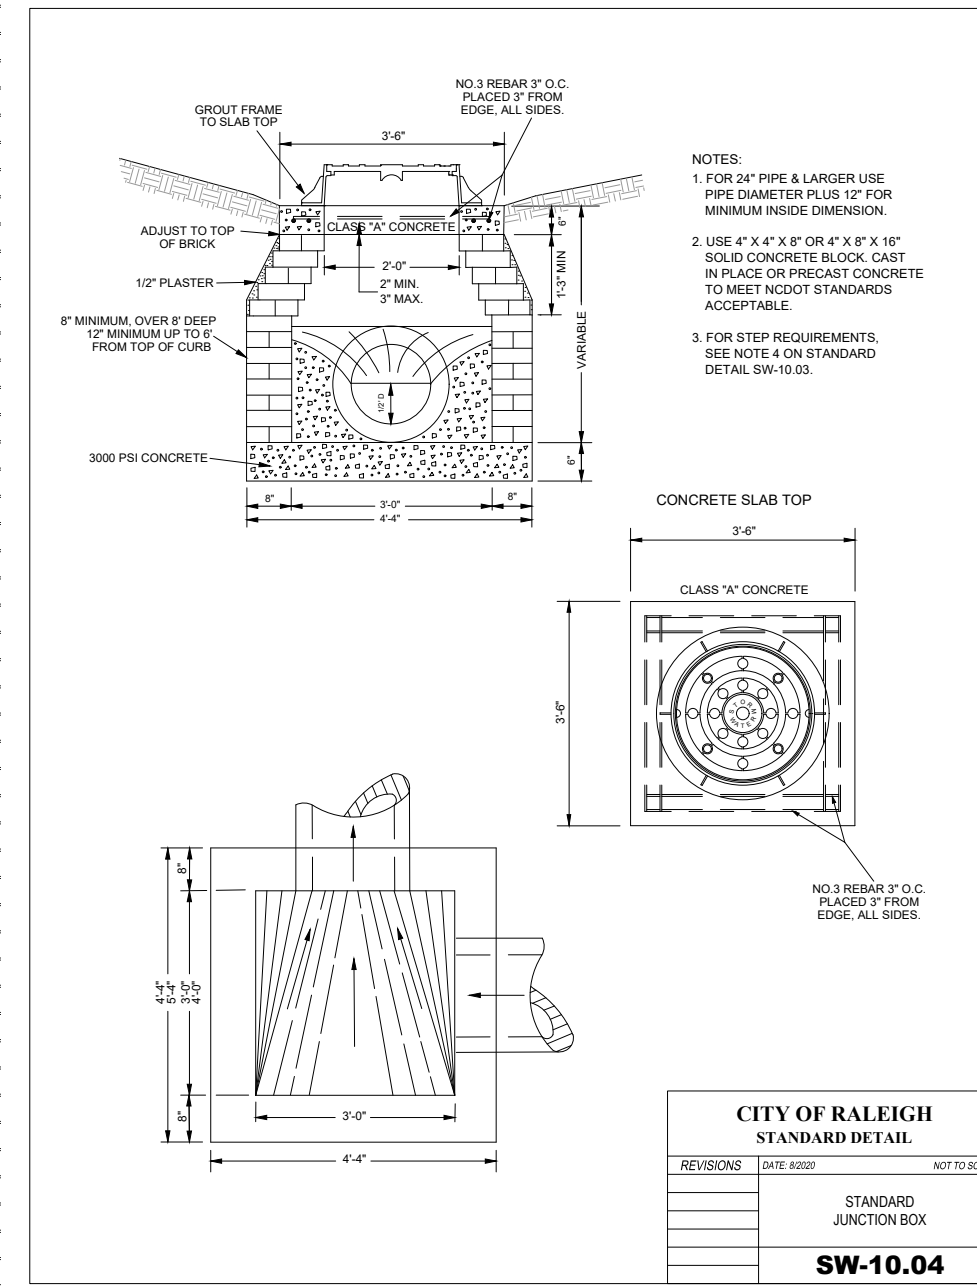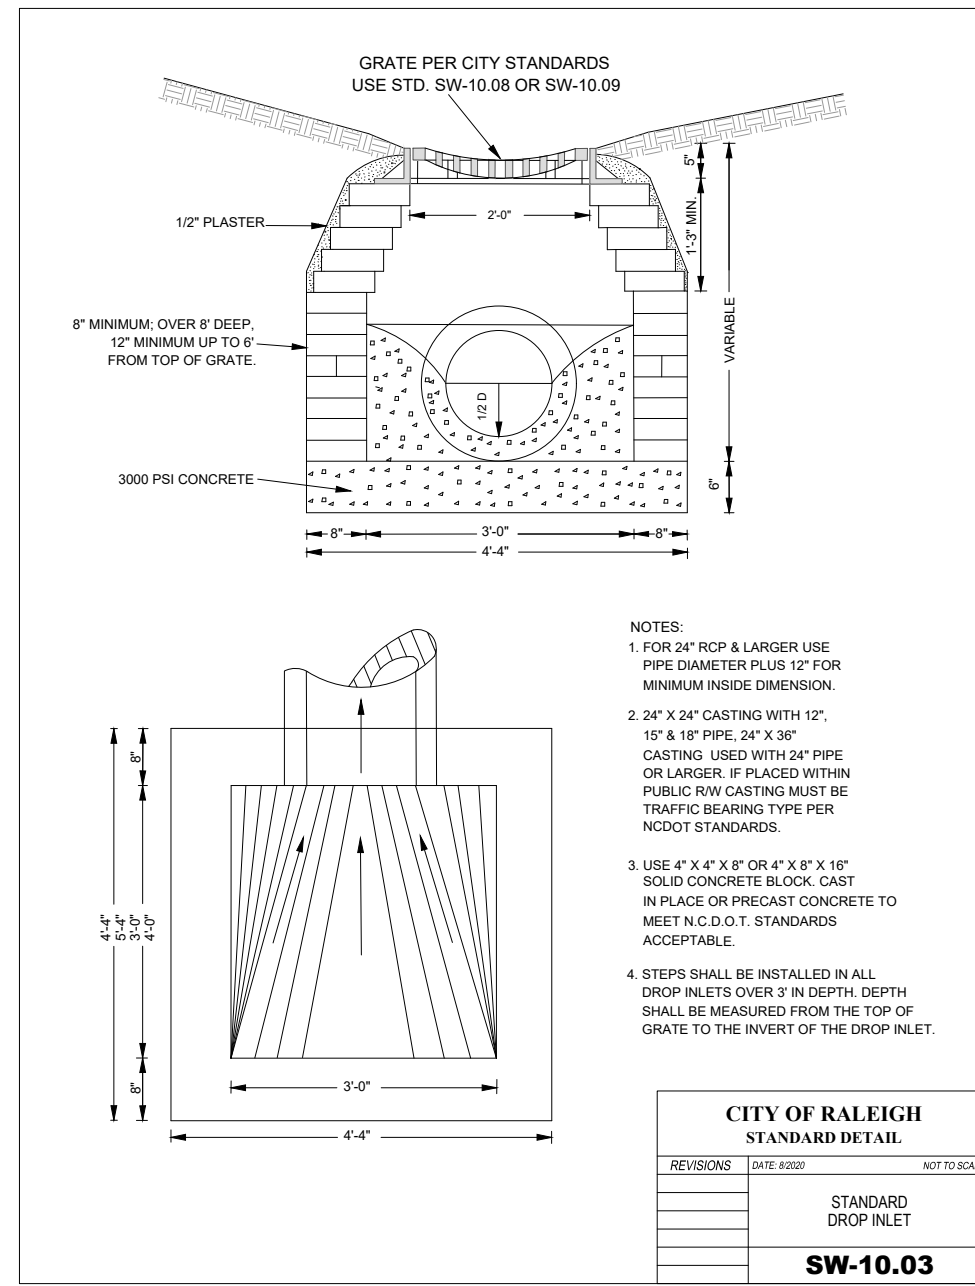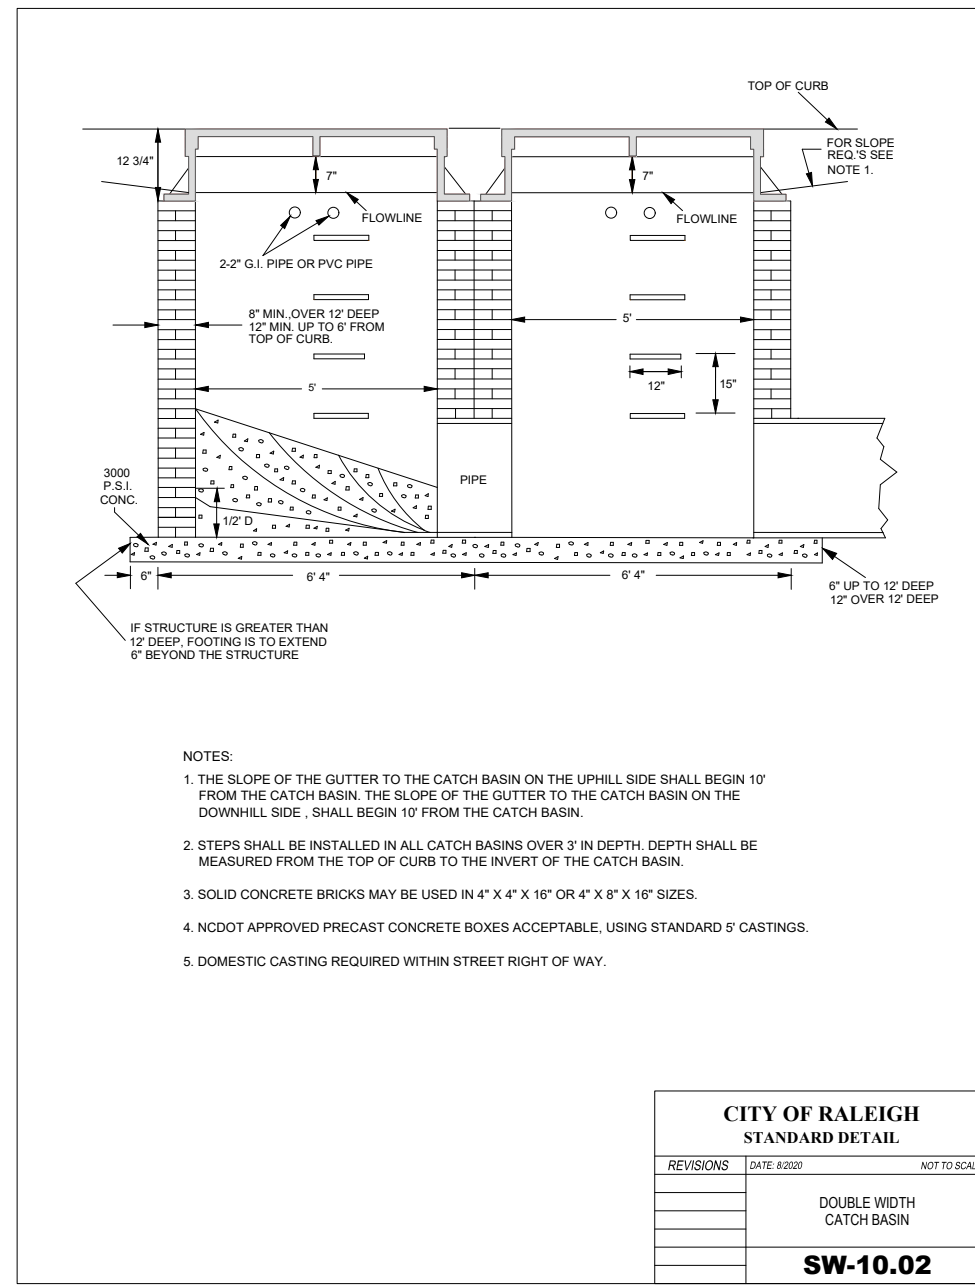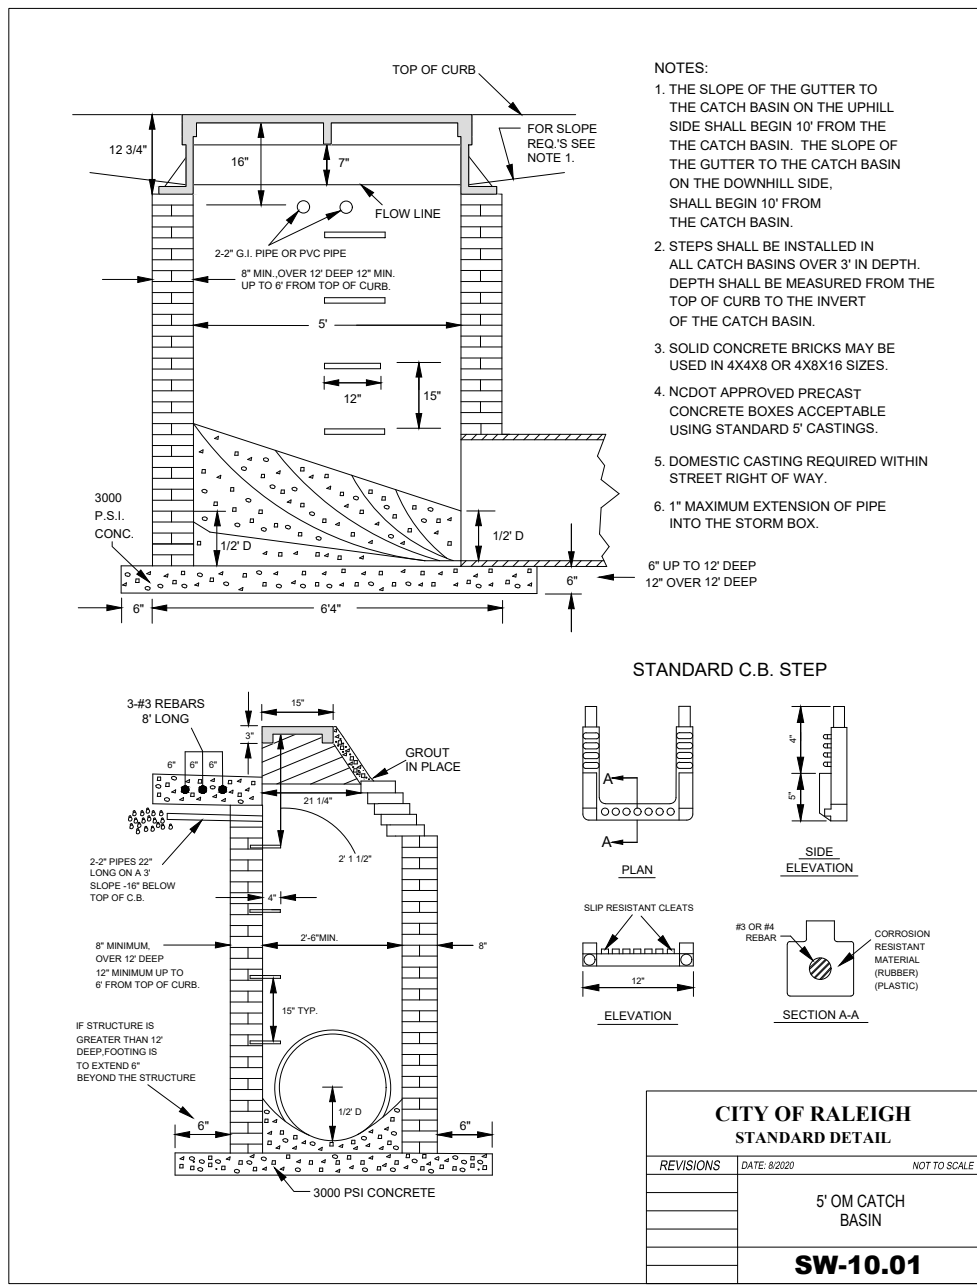

Missing or invalid reference
File: ..\..\..\Blocks\36 - 7001-110-526 A.pdf
Sheet: 1

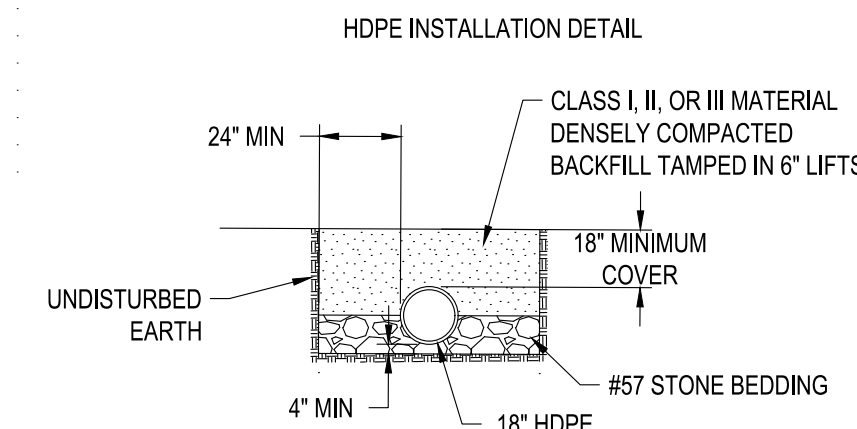

- HDPE INSTALLATION NOTES:**
1. ALL HDPE CONSTRUCTION IS TO BE DONE IN COMPLIANCE WITH CITY OF RALEIGH STANDARDS FOR HDPE PIPE.
 2. CONTRACTOR SHALL NOTIFY CITY OF RALEIGH 24 HOURS PRIOR TO HDPE PIPE INSTALLATION
 3. TRANSITIONS OF HDPE TO RCP REQUIRE DISSIMILAR MATERIALS ADAPTER CONSISTING OF A MASTIC COATING AND STAINLESS STEEL STRAPS, AND A FULL CONCRETE ENCASEMENT AROUND CONNECTION.
 4. ALL PIPE END TREATMENTS ARE TO BE REINFORCED CONCRETE MATERIAL.



Know what's below.
Call before you dig.

DESIGNED BY: DF/CD

DRAWN BY: DF/JWM

REVIEWED BY: DF

06/01/2023

04/03/2023

REV

PER TOWN OF ROLESVILLE COMMENT

INITIAL SUBMITTAL

LENNAR CORPORAION

1100 PERMETER PARK DRIVE, SUITE 112

MORRISVILLE / NORTH CAROLINA / 27560

PARKER RIDGE

82 SCHOOL STREET

ROLESVILLE / NORTH CAROLINA / 27571

STORM-DETAIL

PRELIMINARY

ENGINEER

EDWARD M. FERN

NOT FOR CONSTRUCTION

FILE NUMBER: 8430-03

DATE: 06/01/2023

C8-5

BCE



5440 WADE PARK BLVD, SUITE 102

RALEIGH NC 27607

WWW.BCEINC.COM

NC LICENSE #C-4397

©2023

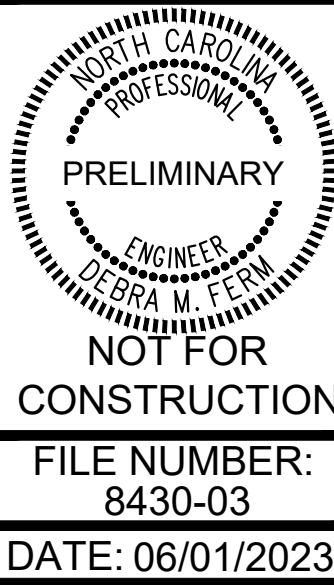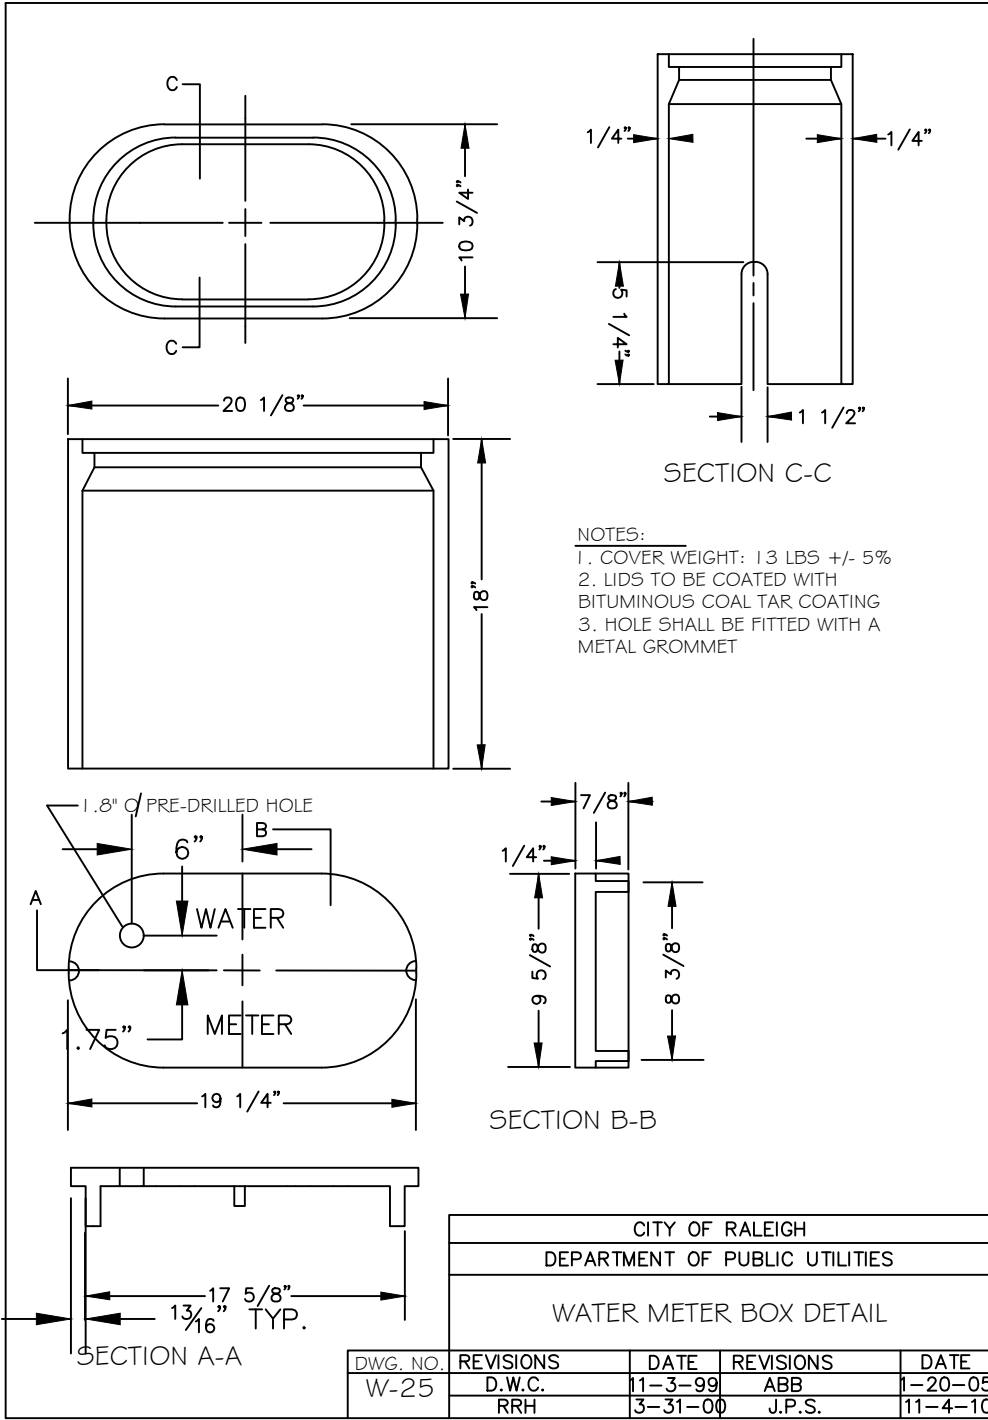

WATER DETAIL (2 OF 2)

PARKER RIDGE
82 SCHOOL STREET
ROLESVILLE / NORTH CAROLINA / 27571

LENNAR
CORPORAION
1100 PERIMETER PARK DRIVE, SUITE 112
MORRISVILLE / NORTH CAROLINA / 27560




DESIGNED BY: DF/CD
DRAWN BY: DF/JWM
REVIEWED BY: DF

REV 04/03/2023
06/01/2023

PER TOWN OF ROLESVILLE COMMENT
INITIAL SUBMITTAL

C8-7

OPEN SPACE BREAKDOWN BY AREA										
OPEN SPACE TYPE	OPEN SPACE #1	OPEN SPACE #2	OPEN SPACE #3	OPEN SPACE #4	OPEN SPACE #5	OPEN SPACE #6	OPEN SPACE #7	TOTAL AREA	PERCENTAGE	MAX ALLOWED
PASSIVE OPEN SPACE (AC)	13.43	0.34	2.79	1.21	0.47	0.6	5.9	24.74	NA	NA
STORMWATER PONDS (AC)	0	0	0	0	0	0	0	0	0.0%	5%
NATURAL RESOURCE AREAS (AC)	2.97	0	0.88	0	0	0	0	3.85	11.3%	20%
ACTIVE OPEN SPACE (AC)	1.73	0.33	0.82	0.73	0.16	0.32	1.45	5.54	NA	NA


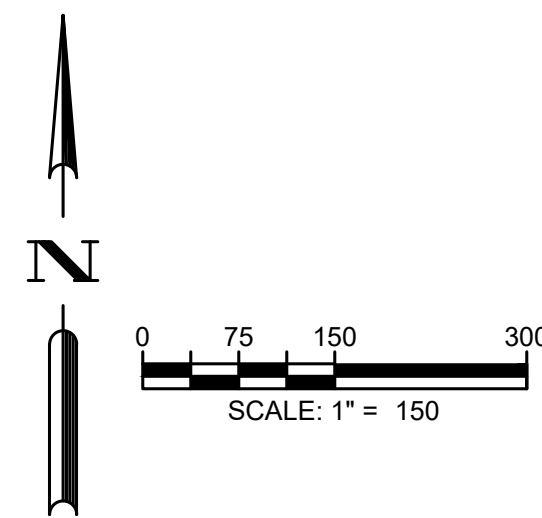




 NOT FOR CONSTRUCTION

FILE NUMBER:	8430-03
DATE:	06/01/2023

C9-0

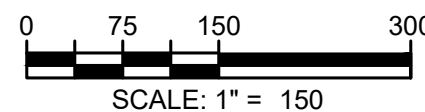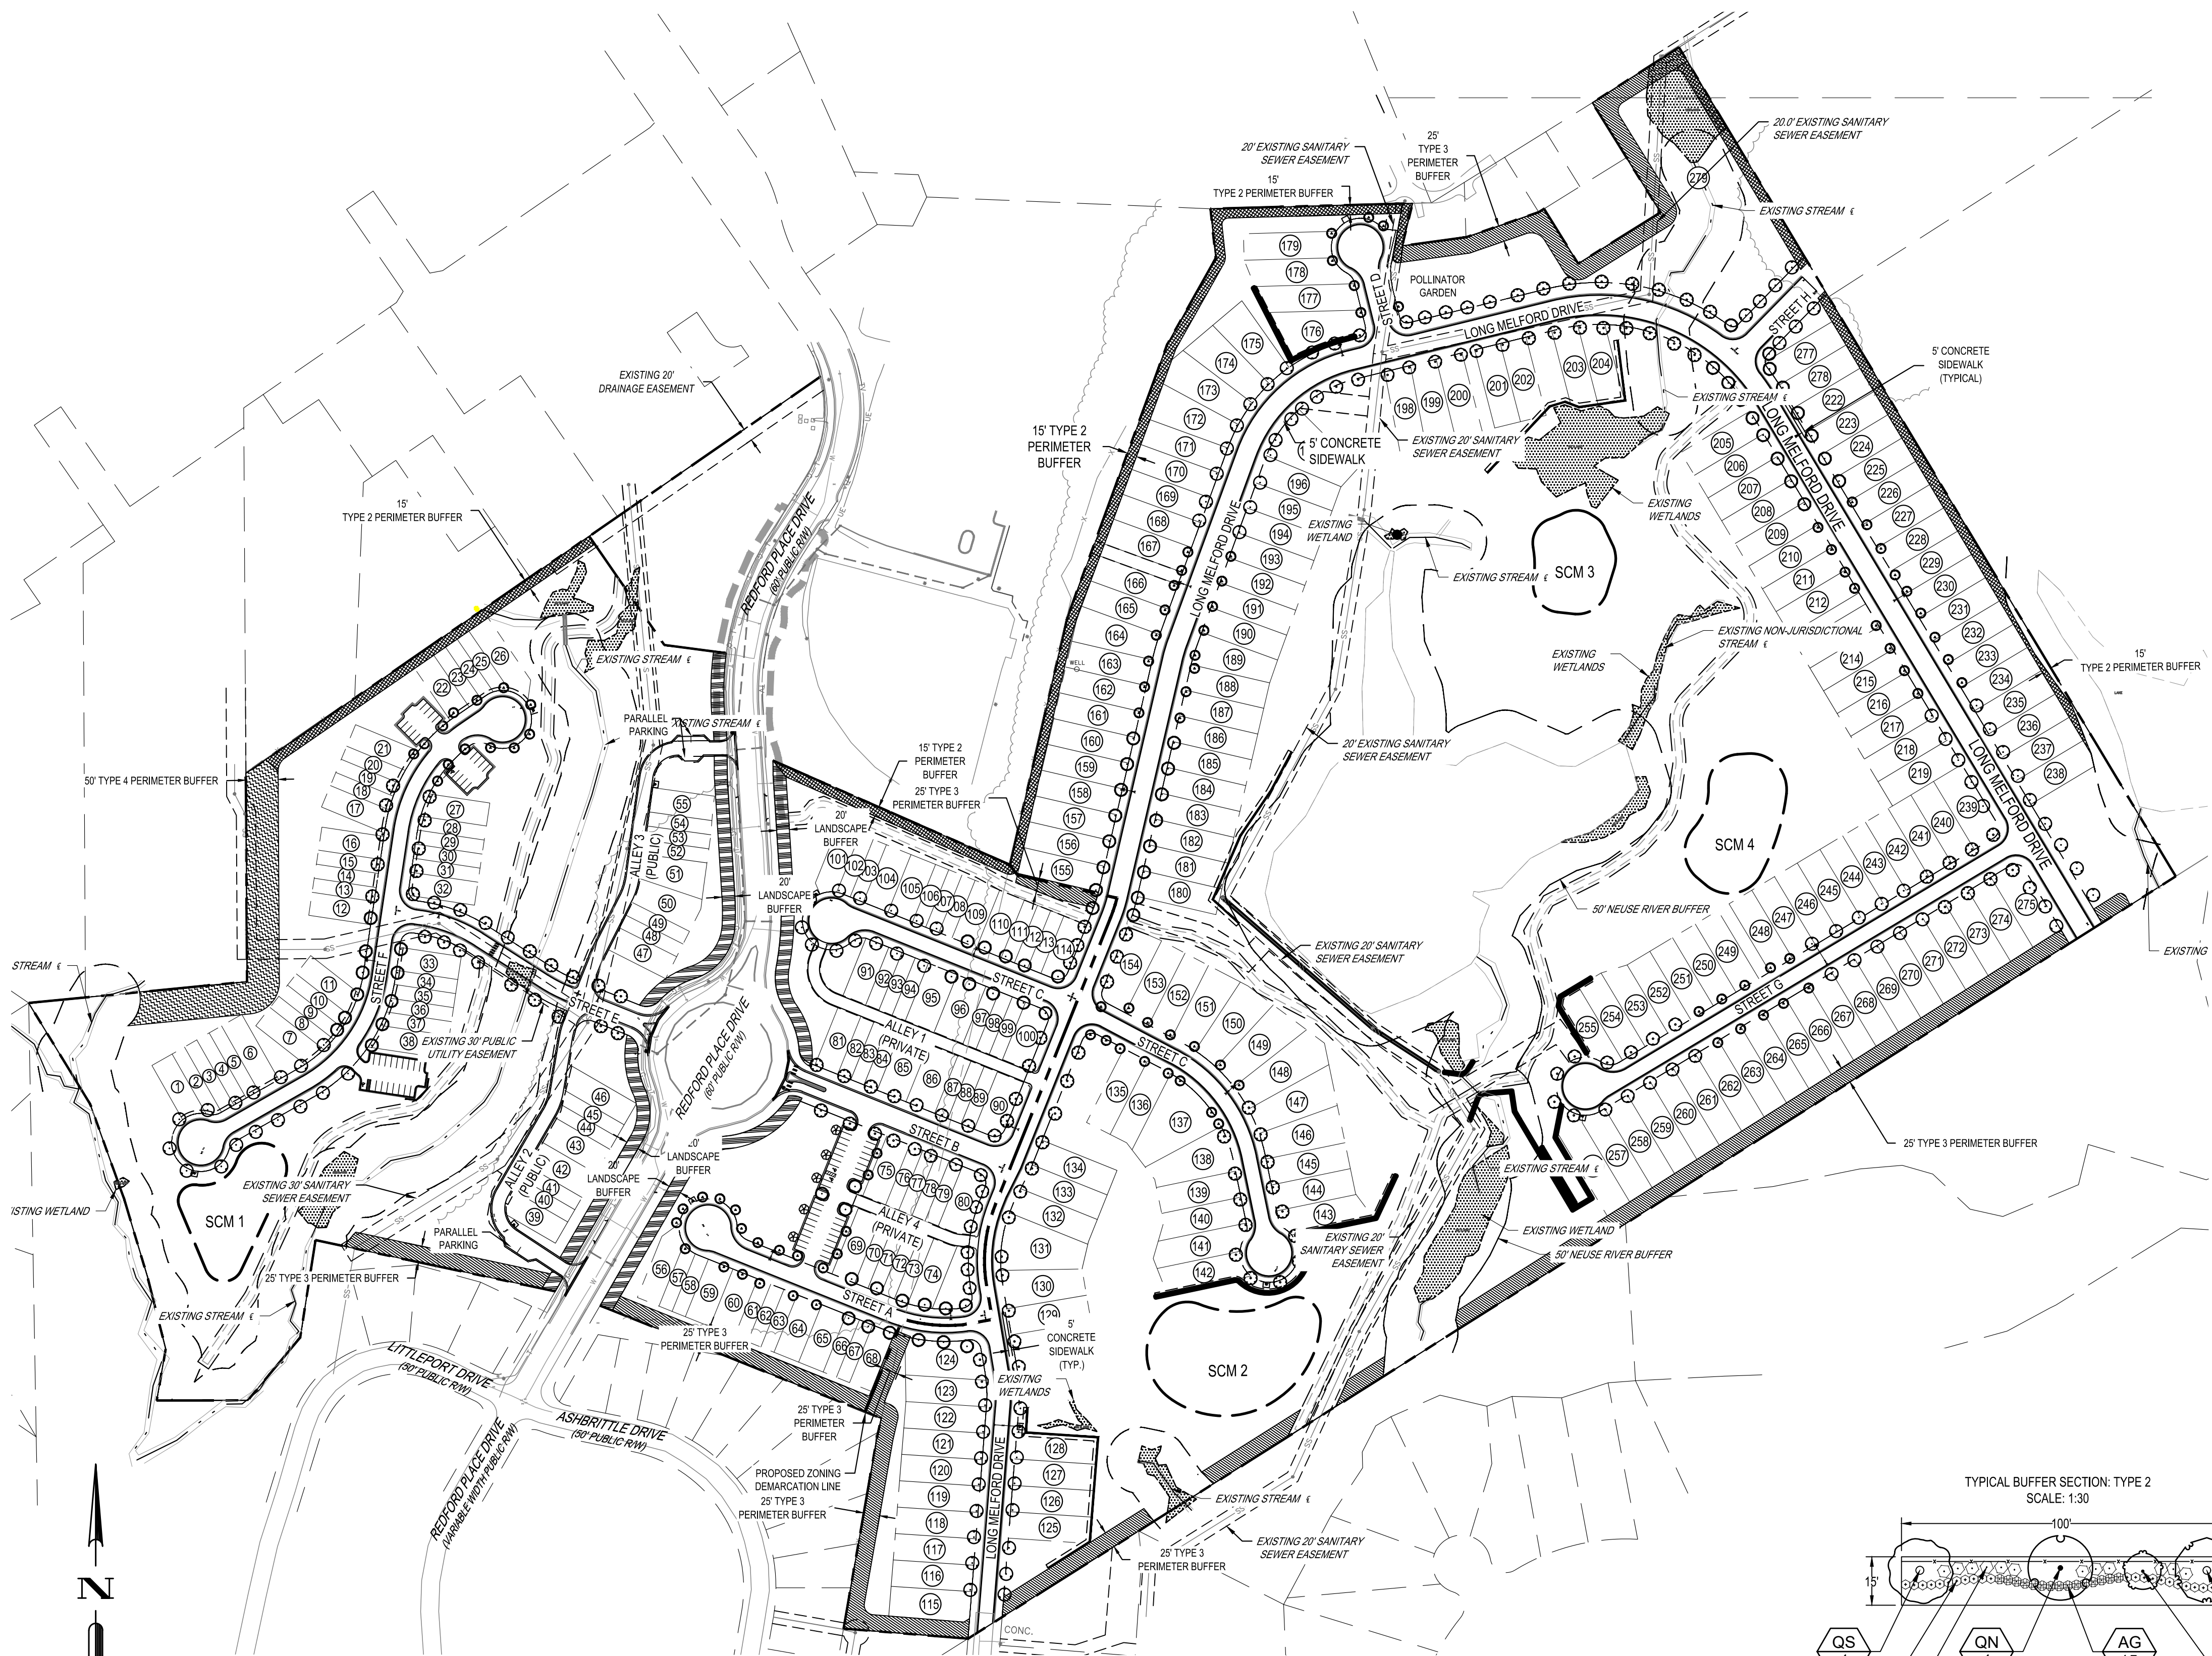

BUFFER LANDSCAPE (QUANTITIES T.B.D.)

CANOPY TREES	CODE	BOTANICAL NAME	COMMON NAME	CAL	HT
	QS	Quercus shumardii	Shumard Oak	2" MIN.	8' MIN.
UNDERSTORY TREES	CODE	BOTANICAL NAME	COMMON NAME	CAL	HT
	CC	Cercis canadensis	Eastern Redbud	1" MIN.	8' MIN.
	MS	Magnolia stellata	Star Magnolia	1" MIN.	8' MIN.
SHRUBS	CODE	BOTANICAL NAME	COMMON NAME	HT	SPR
	IC	Ilex cornuta 'Burfordii Nana'	Dwarf Burford Holly	18-24"	18-24"
	IR	Ilex crenata 'Rotundifolia'	Japanese Holly	18-24"	18-24"
	IG	Ilex glabra	Inkberry Holly	18-24"	18-24"
	LC	Loropetalum chinense	Chinese Fringe Flower	18-24"	18-24"


PARKING LANDSCAPE

PARKING LOT 'A'
REQUIRED: PERIMETER SHRUBS 3' O.C.
ROADWAY SCREENING
PROVIDED: 56 SHRUBS

REQUIRED: 1 TREE / 150 SF OF PARKING ISLANDS
1,669 SF PARKING ISLANDS = 11 TREES
PROVIDED: 12 TREES

PARKING LOT 'B'
REQUIRED: PERIMETER SHRUBS 3' O.C.
ROADWAY SCREENING
PROVIDED: 56 SHRUBS

PARKING LOT 'C'
REQUIRED: PERIMETER SHRUBS 3' O.C.
ROADWAY SCREENING
PROVIDED: 28 SHRUBS

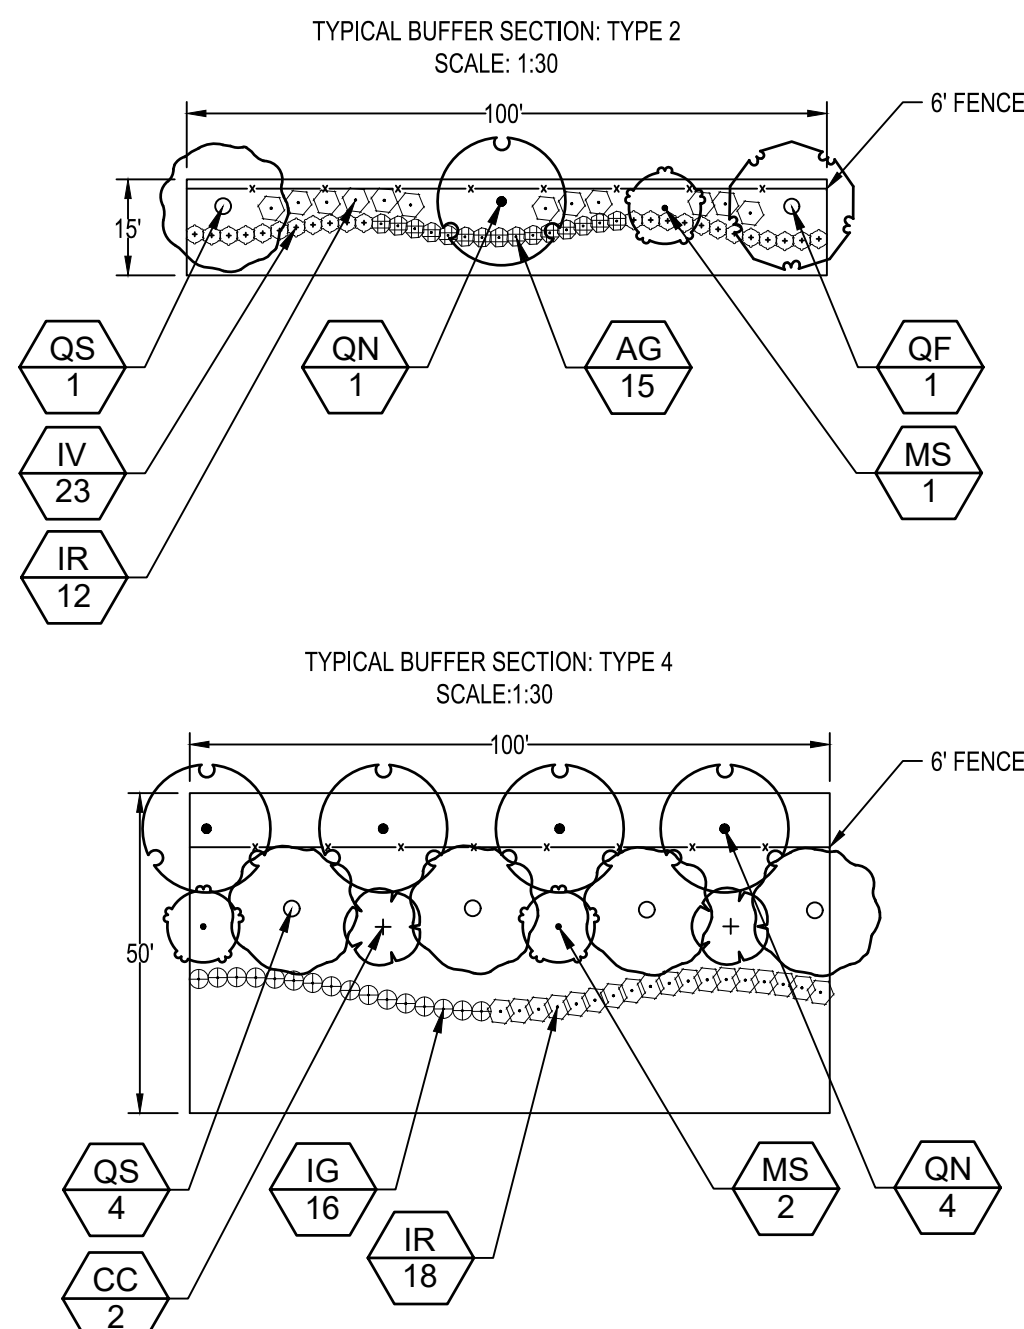

PLANT SCHEDULE

CANOPY TREES	CODE	QTY	BOTANICAL NAME	COMMON NAME	CAL	HT
	KP	5	Koelreuteria paniculata	Golden Rain Tree	2" MIN.	8' MIN.
	PS	98	Pistacia chinensis	Chinese Pistache	2" MIN.	8' MIN.
	QC	81	Quercus coccinea	Scarlet Oak	2" MIN.	8' MIN.
	QF	61	Quercus falcata	Southern Red Oak	2" MIN.	8' MIN.
	QN	95	Quercus nuttallii	Nuttall Oak	2" MIN.	8' MIN.
	ZS	68	Zelkova serrata	Sawleaf Zelkova	2" MIN.	8' MIN.
SHRUBS	CODE	QTY	BOTANICAL NAME	COMMON NAME	HT	SPR
	AG	56	Abelia x grandiflora	Glossy Abelia	18-24"	18-24"
	IV	47	Ilex vomitoria 'Nana'	Dwarf Yaupon	18-24"	18-24"

LANDSCAPE BUFFERS

PERIMETER BUFFER TYPE 2: 15' WIDTH, 3,338 TOTAL LF
REQUIRED: 3 CANOPY TREES PER 100 LF
1 UNDERSTORY TREE PER 100 LF
50 SHRUBS PER 100 LF
6' FENCE
PROVIDED: *SEE NOTE BELOW

PERIMETER BUFFER TYPE 3: 25' WIDTH, 3,884 TOTAL LF
REQUIRED: 4 CANOPY TREES PER 100 LF
2 UNDERSTORY TREES PER 100 LF
60 SHRUBS PER 100 LF
6' WALL (6' FENCE PER ZONING)
PROVIDED: *SEE NOTE BELOW

PERIMETER BUFFER TYPE 4: 50' WIDTH, 517 TOTAL LF
REQUIRED: 8 CANOPY TREES PER 100 LF
4 UNDERSTORY TREES PER 100 LF
CONTINUOUS HEDGE
3' WALL + 5' BERM (6' FENCE PER ZONING)
PROVIDED: *SEE NOTE BELOW

STREET BUFFER - REDFORD PLACE DRIVE: 20' WIDTH, 2,037 LF OF FRONTAGE
REQUIRED: 1 STREET TREE EVERY 40 LF OF FRONTAGE
2,037 LF OF FRONTAGE / 40' = 23 TREES
EXISTING STREET TREES SHALL SATISFY STREET TREE REQUIREMENT

* IF EXISTING CANOPY DOES NOT MEET BUFFER REQUIREMENTS, ADDITIONAL PLANTINGS MUST BE ADDED TO FULFILL BUFFER REQUIREMENTS (SEE TYPICAL BUFFER SECTIONS).

STREET TREES

REQUIRED: 1 STREET TREE EVERY 40 LF OF FRONTAGE

STREET A
REQUIRED: 918 LF OF FRONTAGE / 40' = 23 TREES
PROVIDED: 28 TREES

STREET B
REQUIRED: 554 LF OF FRONTAGE / 40' = 14 TREES
PROVIDED: 14 TREES

STREET C
REQUIRED: 1,722 LF OF FRONTAGE / 40' = 43 TREES
PROVIDED: 52 TREES

STREET D
REQUIRED: 292 LF OF FRONTAGE / 40' = 7 TREES
PROVIDED: 7 TREES

STREET E
REQUIRED: 704 LF OF FRONTAGE / 40' = 18 TREES
PROVIDED: 18 TREES


STREET F
REQUIRED: 1,660 LF OF FRONTAGE / 40' = 41 TREES
PROVIDED: 50 TREES

STREET G
REQUIRED: 1,528 LF OF FRONTAGE / 40' = 38 TREES
PROVIDED: 41 TREES

STREET H
REQUIRED: 264 LF OF FRONTAGE / 40' = 7 TREES
PROVIDED: 7 TREES

LONG MELFORD DRIVE
REQUIRED: 7,276 LF OF FRONTAGE / 40' = 182 TREES
PROVIDED: 182 TREES



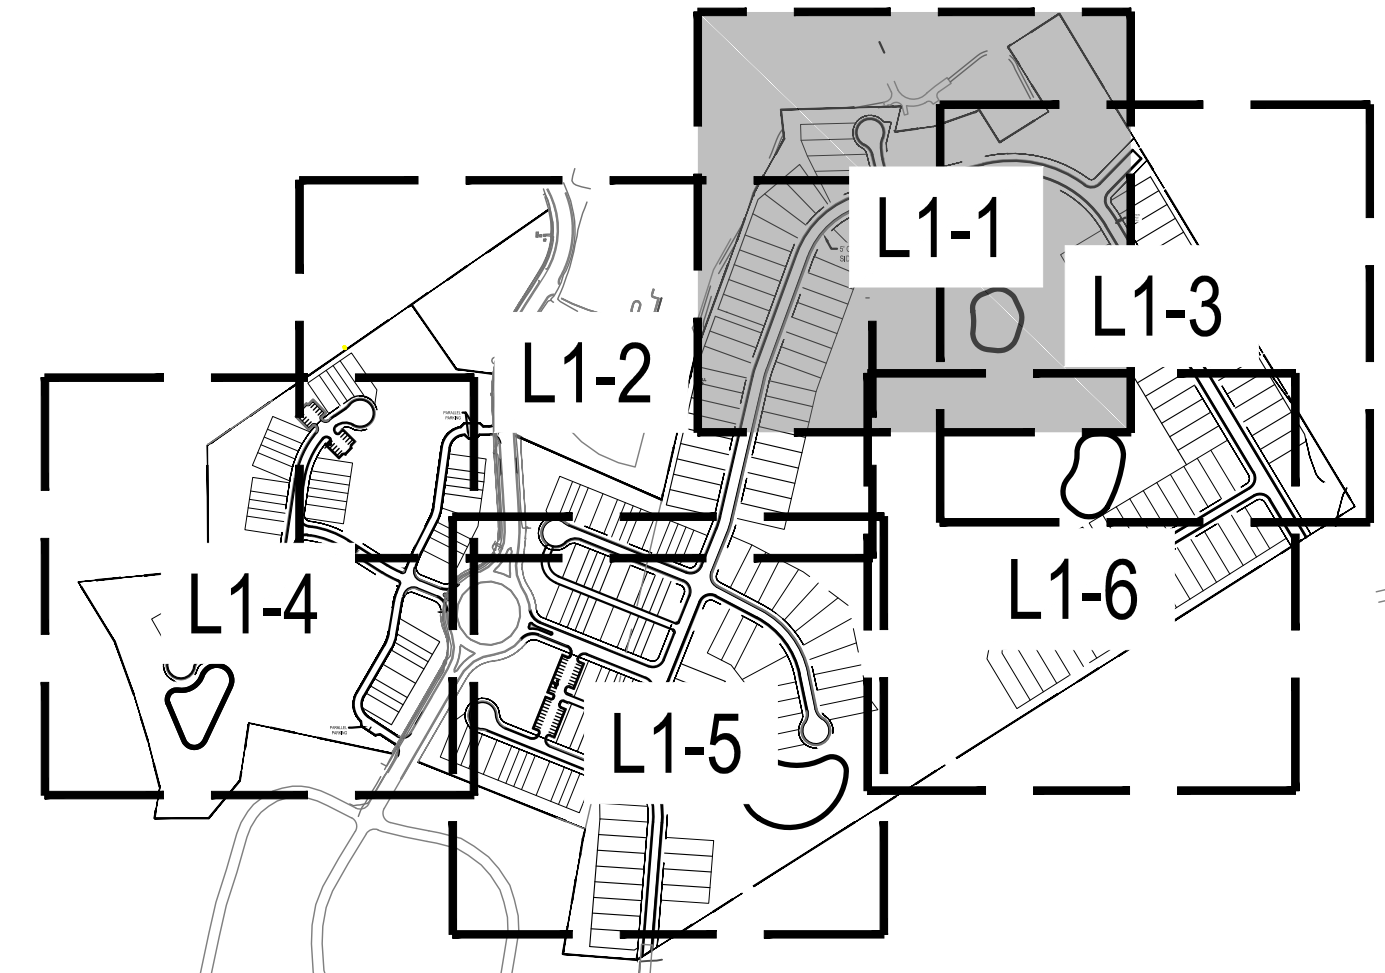

LANDSCAPE BUFFERS

PERIMETER BUFFER TYPE 2 (15' WIDTH)

PERIMETER BUFFER TYPE 3 (25' WIDTH)

PERIMETER BUFFER TYPE 4 (50' WIDTH)


STREET BUFFER (20' WIDTH)



Know what's below.
Call before you dig.


G:\NCA\Projects\Lennar\8430-03 - Lennar - School Street - Rolesville\03 - DWG\PlanSheets\On-Site\L1-0 - LS PLAN.dwg Layout: L1-2 Plotted: 6/1/2023 4:07:32 PM

REDFORD PLAZA, LLC
DB 16331 PG 976
BM 2006 PG 1022
PIN# 175882842

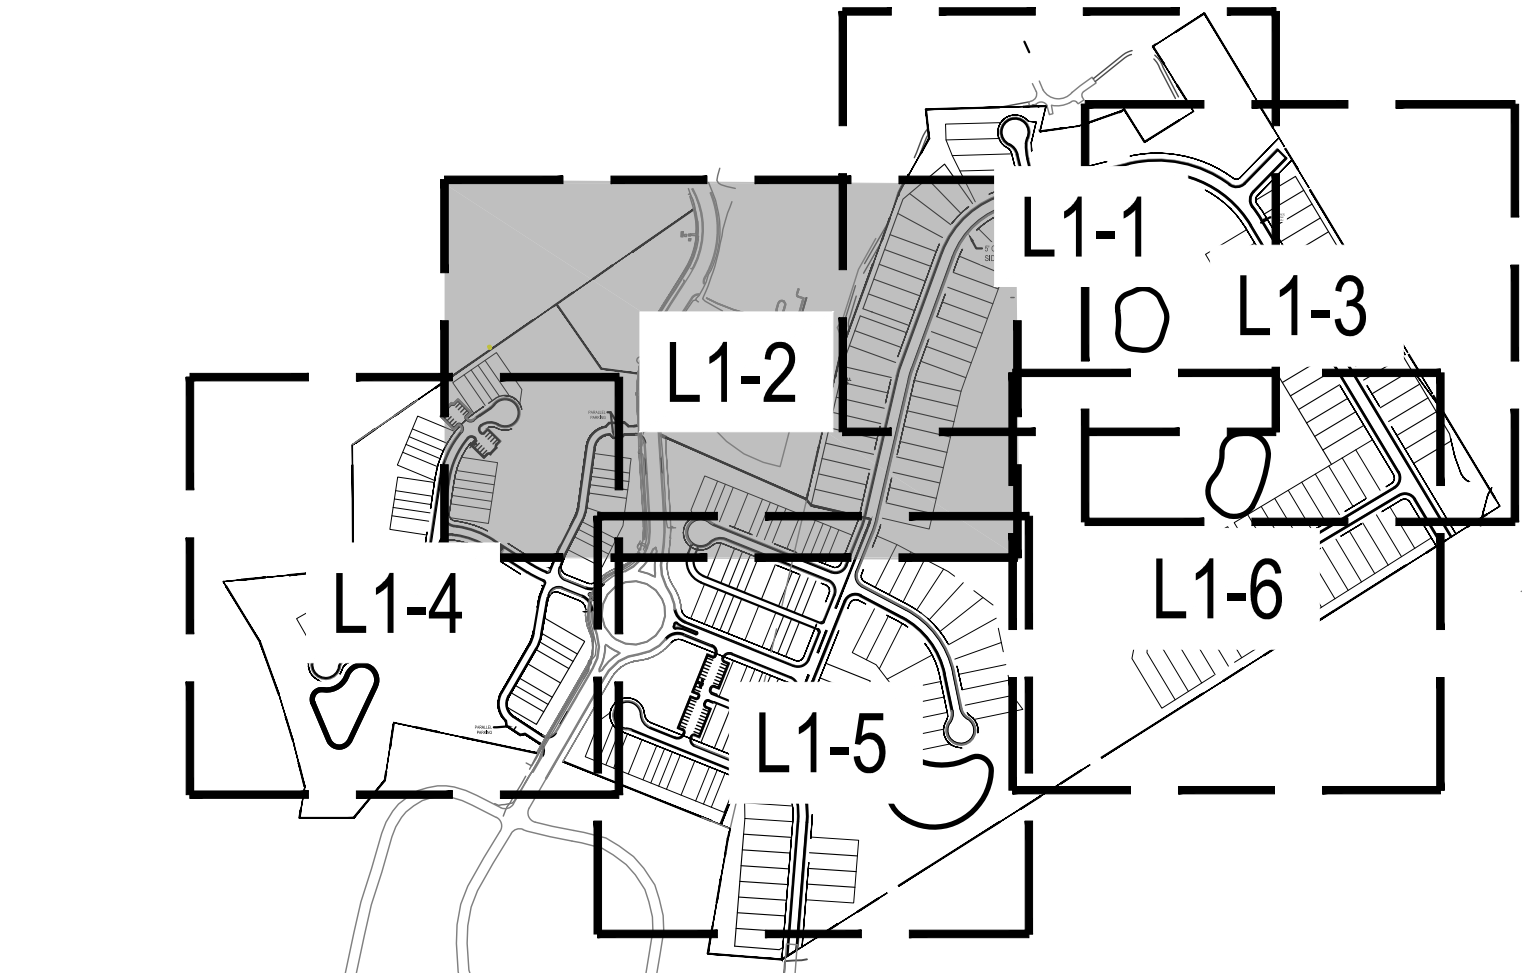


PLANT SCHEDULE L1-2						
CANOPY TREES	CODE	QTY	BOTANICAL NAME	COMMON NAME	CAL	HT
	PS	37	Pistacia chinensis	Chinese Pistache	2" MIN.	8' MIN.
	QC	26	Quercus coccinea	Scarlet Oak	2" MIN.	8' MIN.
	QF	8	Quercus falcata	Southern Red Oak	2" MIN.	8' MIN.
	QN	14	Quercus nuttallii	Nuttall Oak	2" MIN.	8' MIN.
	ZS	30	Zelkova serrata	Sawleaf Zelkova	2" MIN.	8' MIN.
SHRUBS	CODE	QTY	BOTANICAL NAME	COMMON NAME	HT	SPR
	IV	57	Ilex vomitoria 'Nana'	Dwarf Yaupon	18-24"	18-24"


LANDSCAPE BUFFERS

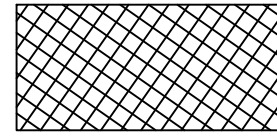

PERIMETER BUFFER TYPE 2 (15' WIDTH)

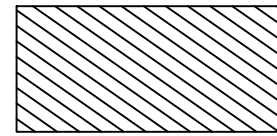

PERIMETER BUFFER TYPE 3 (25' WIDTH)

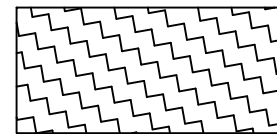


PERIMETER BUFFER TYPE 4 (50' WIDTH)



STREET BUFFER (20' WIDTH)

PIN# 1758800948

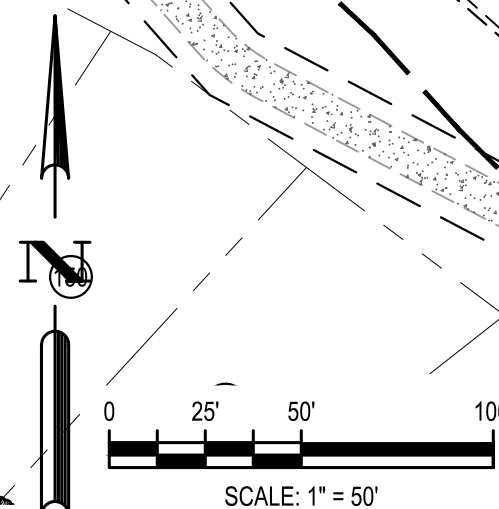

ORZ Zedrow, V
Call before you dig.

DESIGNED BY: DF/CD

DRAWN BY: DF/JWM

REVIEWED BY: DF

06/01/2023

04/03/2023

REV

PER TOWN OF ROLESVILLE COMMENT

INITIAL SUBMITTAL

BCE

5440 WADE PARK BLVD, SUITE 102
RALEIGH NC 27607
WWW.BCEINC.COM
NC LICENSE #C-4397

LENNAR

CORPORAION

1100 PERIMETER PARK DRIVE, SUITE 112
MORRISVILLE / NORTH CAROLINA / 27560

PARKER RIDGE

82 SCHOOL STREET
ROLESVILLE / NORTH CAROLINA / 27571

ENLARGED LANDSCAPE

PLAN (2 OF 6)


NORTH CAROLINA
REGISTERED
PRELIMINARY
PROJECT: 8430-03
PROJECT: 8430-03

NOT FOR
CONSTRUCTION

FILE NUMBER:
8430-03


DATE: 06/01/2023

L1-2

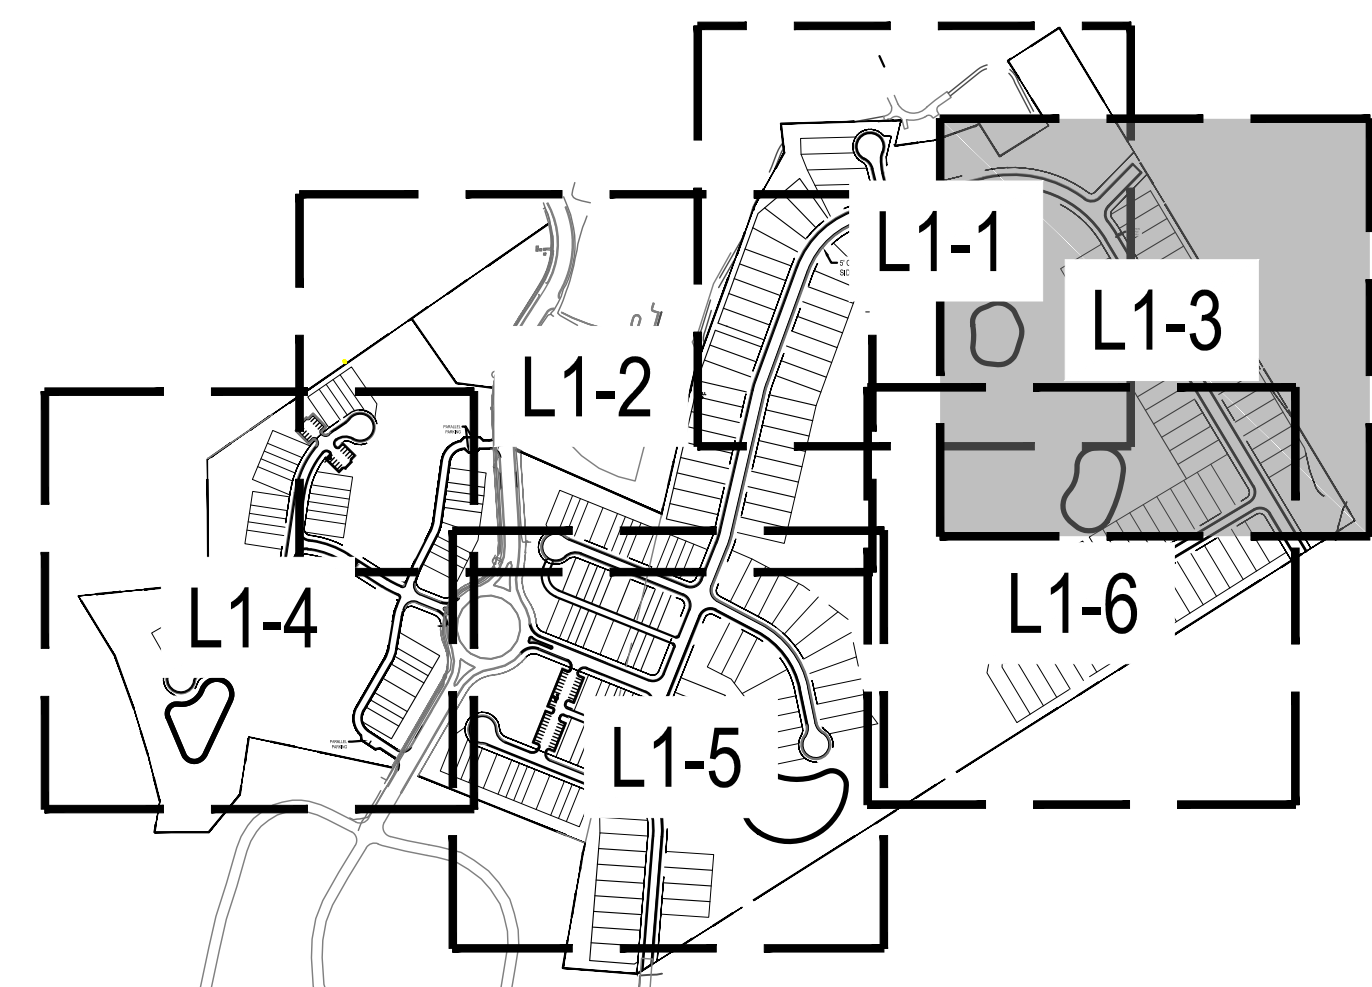


PLANT SCHEDULE L1-3						
CANOPY TREES	CODE	QTY	BOTANICAL NAME	COMMON NAME	CAL	HT
	PS	17	Pistacia chinensis	Chinese Pistache	2" MIN.	8' MIN.
	QC	24	Quercus coccinea	Scarlet Oak	2" MIN.	8' MIN.
	QF	2	Quercus falcata	Southern Red Oak	2" MIN.	8' MIN.
	QN	30	Quercus nuttallii	Nuttall Oak	2" MIN.	8' MIN.
	ZS	16	Zelkova serrata	Sawleaf Zelkova	2" MIN.	8' MIN.
SHRUBS	CODE	QTY	BOTANICAL NAME	COMMON NAME	HT	SPR
	IP	98	Ilex pernyi	Perry Holly	24-36"	24-36"
	VR	97	Viburnum rhytidophyllum	Leatherleaf Viburnum	24-36"	24-36"


LANDSCAPE BUFFERS

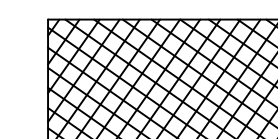

PERIMETER BUFFER TYPE 2 (15' WIDTH)

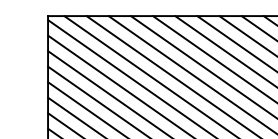



PERIMETER BUFFER TYPE 3 (25' WIDTH)

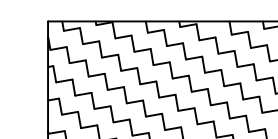

PERIMETER BUFFER TYPE 4 (50' WIDTH)




STREET BUFFER (20' WIDTH)

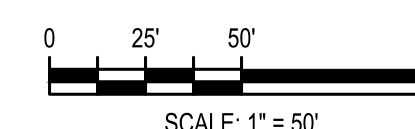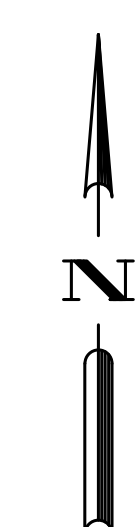

SCALE: 1" = 50'



Know what's below.
Call before you dig.

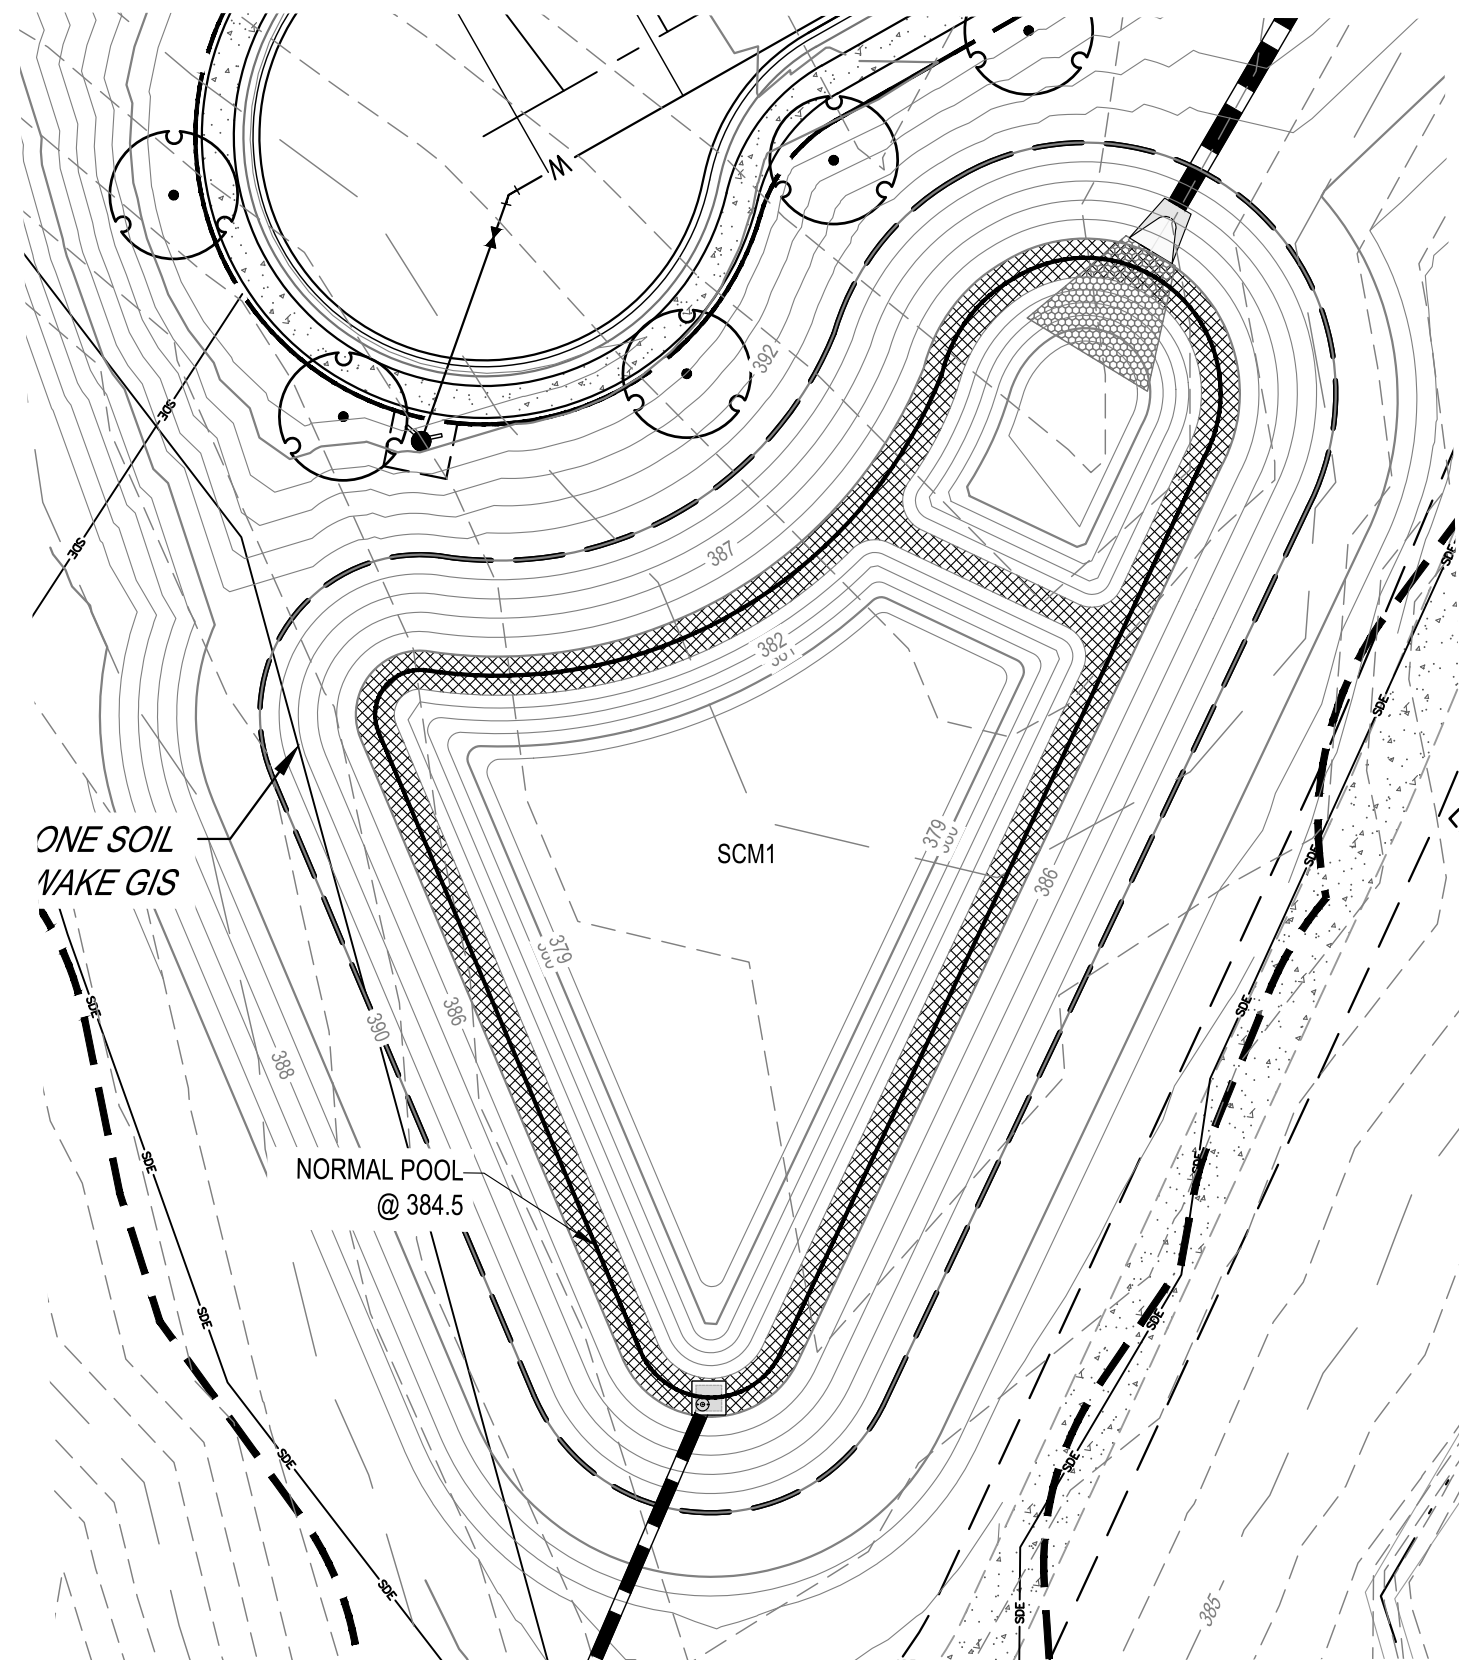

SCM 1 PLANTING CALCULATIONS


NORMAL POOL ELEVATION: 384.5

VEGETATED SHELF: 3,065 S.F. (0.5' BELOW TO 0.5'
ABOVE PERMANENT POND ELEV.)

REQUIRED: .25 PLANTS PER SQUARE FOOT
(3 MINIMUM HERBACEOUS SPECIES)
0.25 PLANTS x 3,065 SF = 766 PLANTS
PROVIDED: (255) HC, (255) LC, (255) CT

SCM 1 PLANTING SCHEDULE

KEY	QTY.	SCIENTIFIC NAME	COMMON NAME	CONT.
HC	255	HIBISCUS Coccineus	SCARLET ROSE MALLOW	24"Ø x 5" PLUG
LC	255	LOBELIA cardinalis	CARDINAL FLOWER	24"Ø x 5" PLUG
CT	255	CAREX tenera	QUILL SEDGE	24"Ø x 5" PLUG

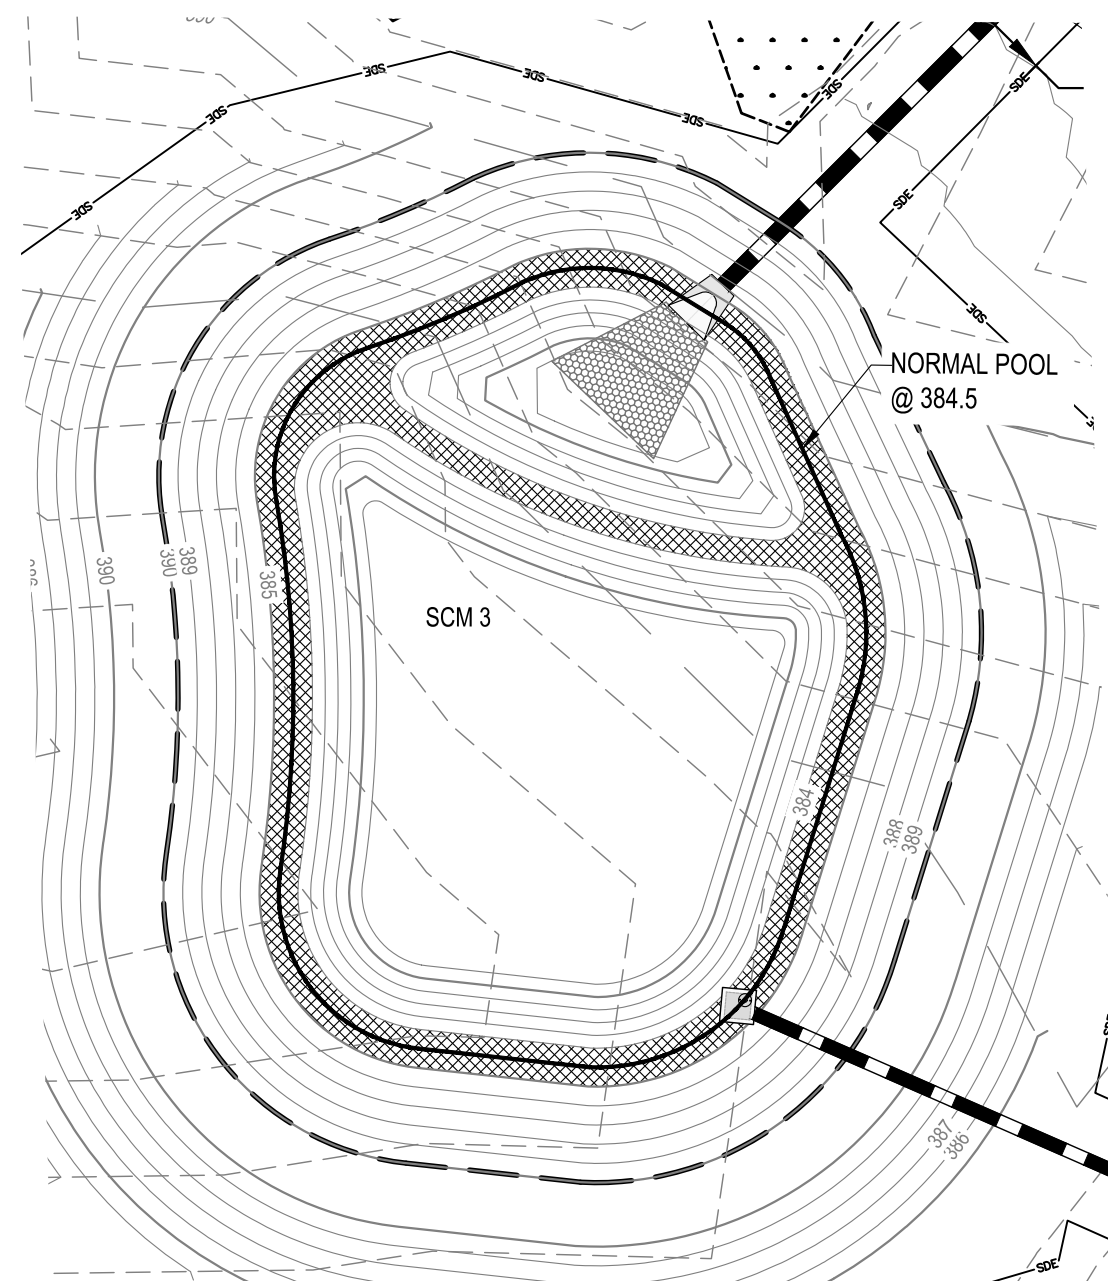 VEGETATED SHELF MIX

SCM 3 PLANTING CALCULATIONS


NORMAL POOL ELEVATION: 384.5

VEGETATED SHELF: 2,574 S.F. (0.5' BELOW TO 0.5' ABOVE PERMANENT POND ELEV.)

REQUIRED: .25 PLANTS PER SQUARE FOOT
(3 MINIMUM HERBACEOUS SPECIES)
0.25 PLANTS x 2,574 SF = 644 PLANTS
PROVIDED: (215) HC, (215) LC, (215) CT

SCM 3 PLANTING SCHEDULE

KEY	QTY.	SCIENTIFIC NAME	COMMON NAME	CON.
HC	215	HIBISCUS COCCINEUS	SCARLET ROSE MALLOW	24"Ø x 5" PLUG
LC	215	LOBELIA CARDINALIS	CARDINAL FLOWER	24"Ø x 5" PLUG
CT	215	CAREX TENERA	QUILL SEDGE	24"Ø x 5" PLUG

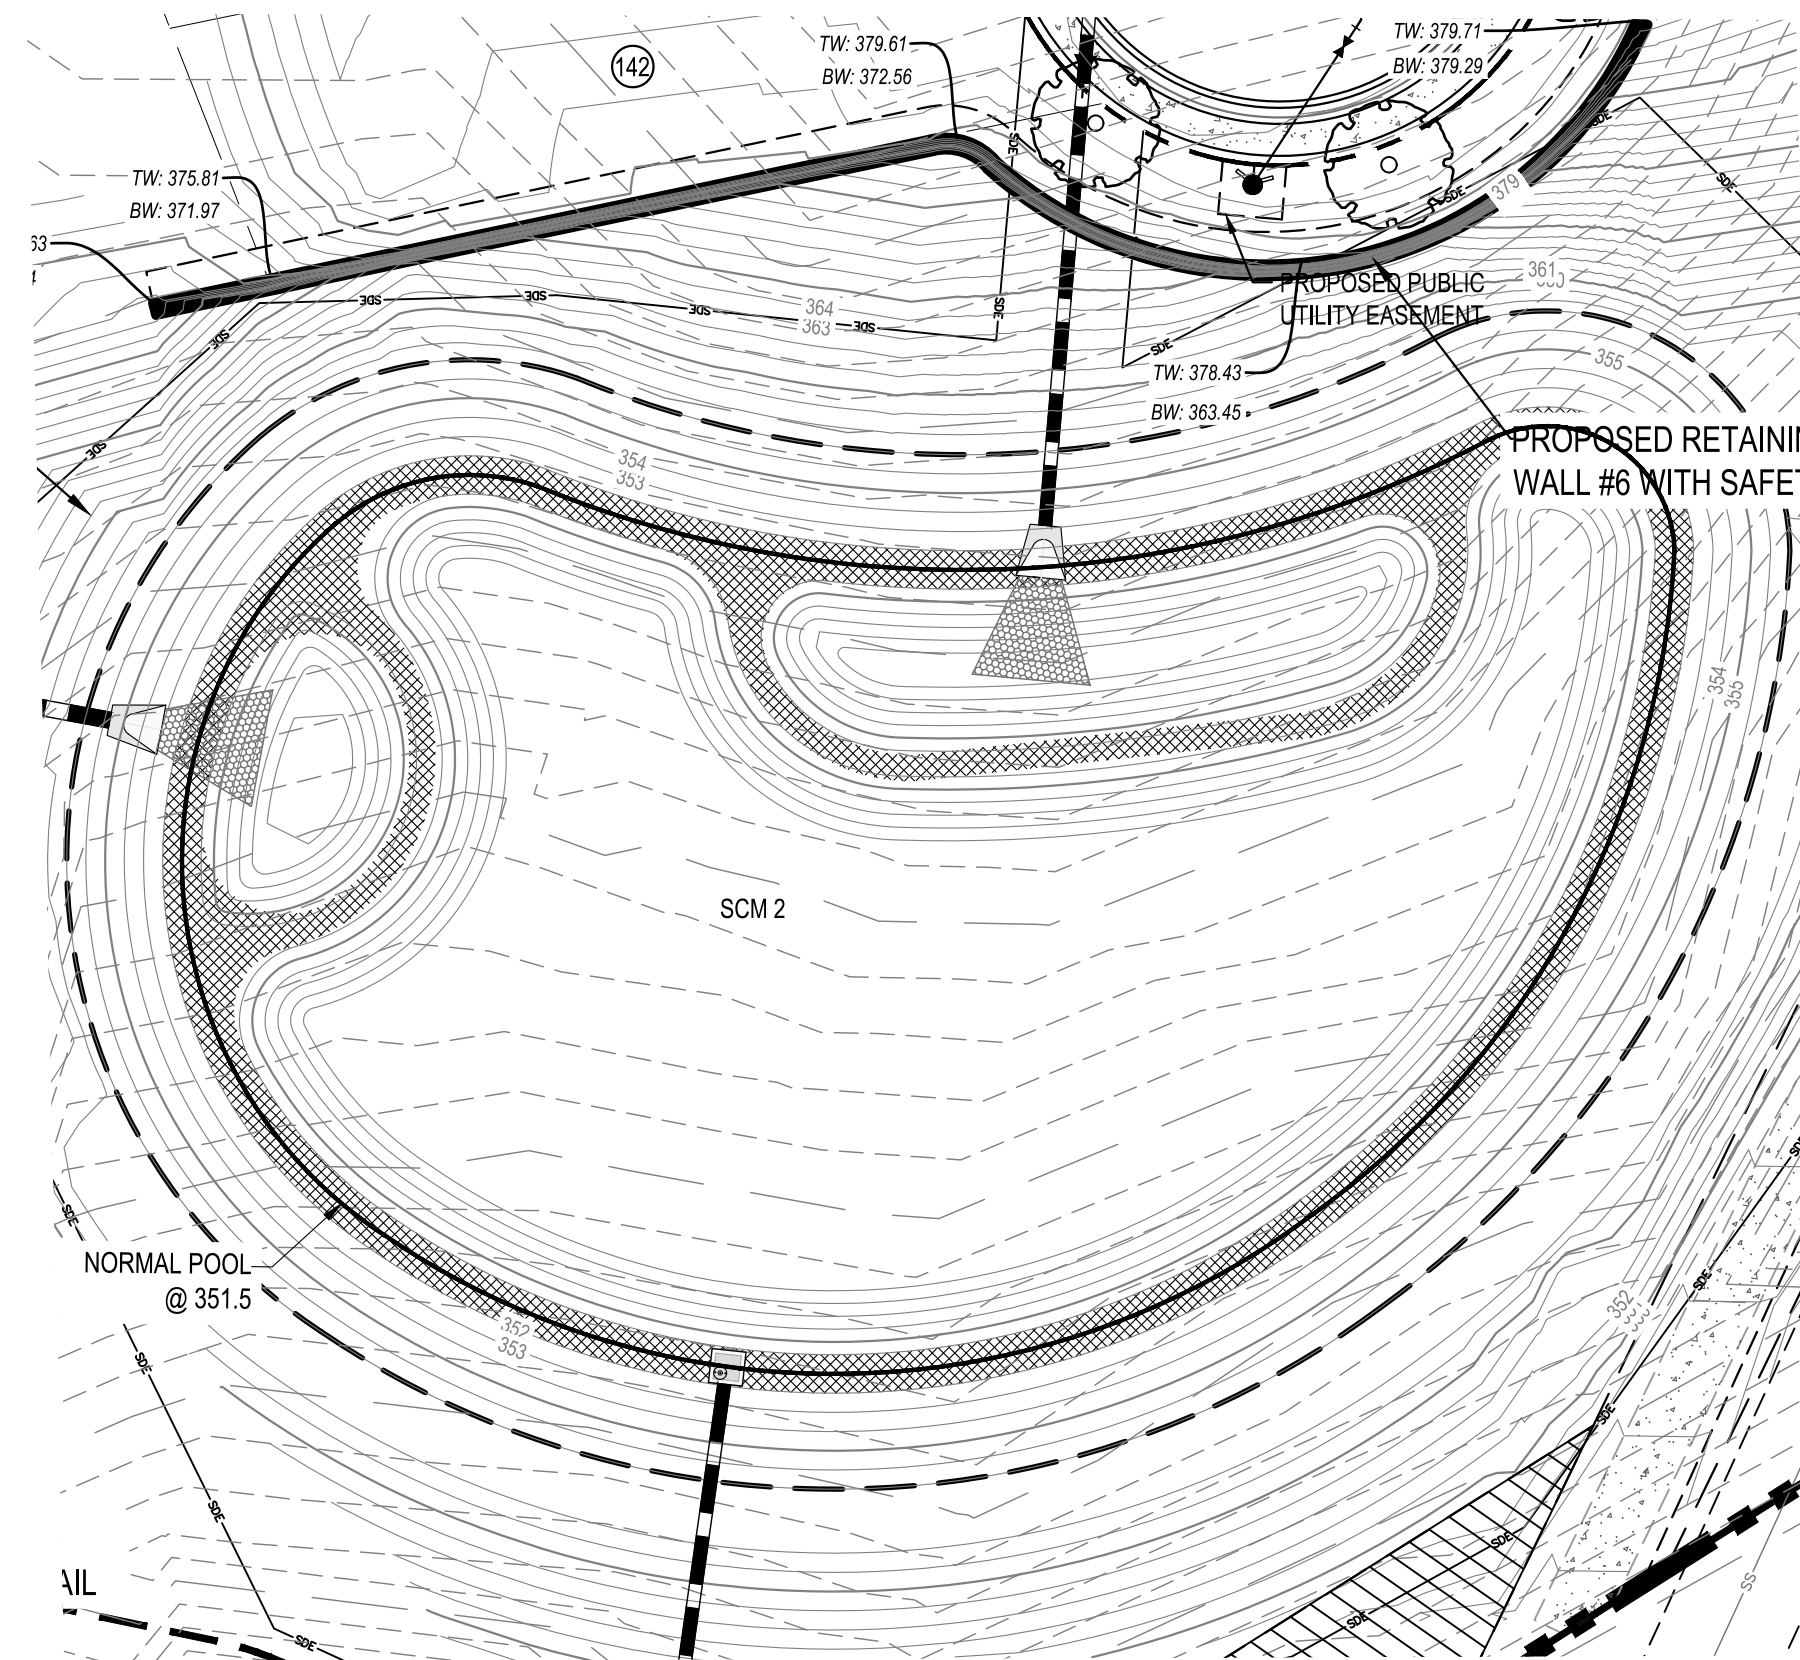 VEGETATED SHELF MIX

SCM 2 PLANTING CALCULATIONS



NORMAL POOL ELEVATION: 351.5

VEGETATED SHELF: 5,108 S.F. (0.5' BELOW TO 0.5' ABOVE PERMANENT POND ELEV.)

REQUIRED: .25 PLANTS PER SQUARE FOOT
(3 MINIMUM HERBACEOUS SPECIES)
0.25 PLANTS x 5,108 SF = 1,277 PLANTS
PROVIDED: (426) HC, (426) LC, (426) CT

SCM 2 PLANTING SCHEDULE

KEY	QTY.	SCIENTIFIC NAME	COMMON NAME	CON.
HC	426	HIBISCUS COCCINEUS	SCARLET ROSE MALLOW	24"Ø x 5" PLUG
LC	426	LOBELIA CARDINALIS	CARDINAL FLOWER	24"Ø x 5" PLUG
CT	426	CAREX TENERA	QUILL SEDGE	24"Ø x 5" PLUG

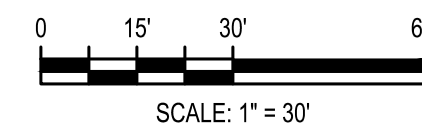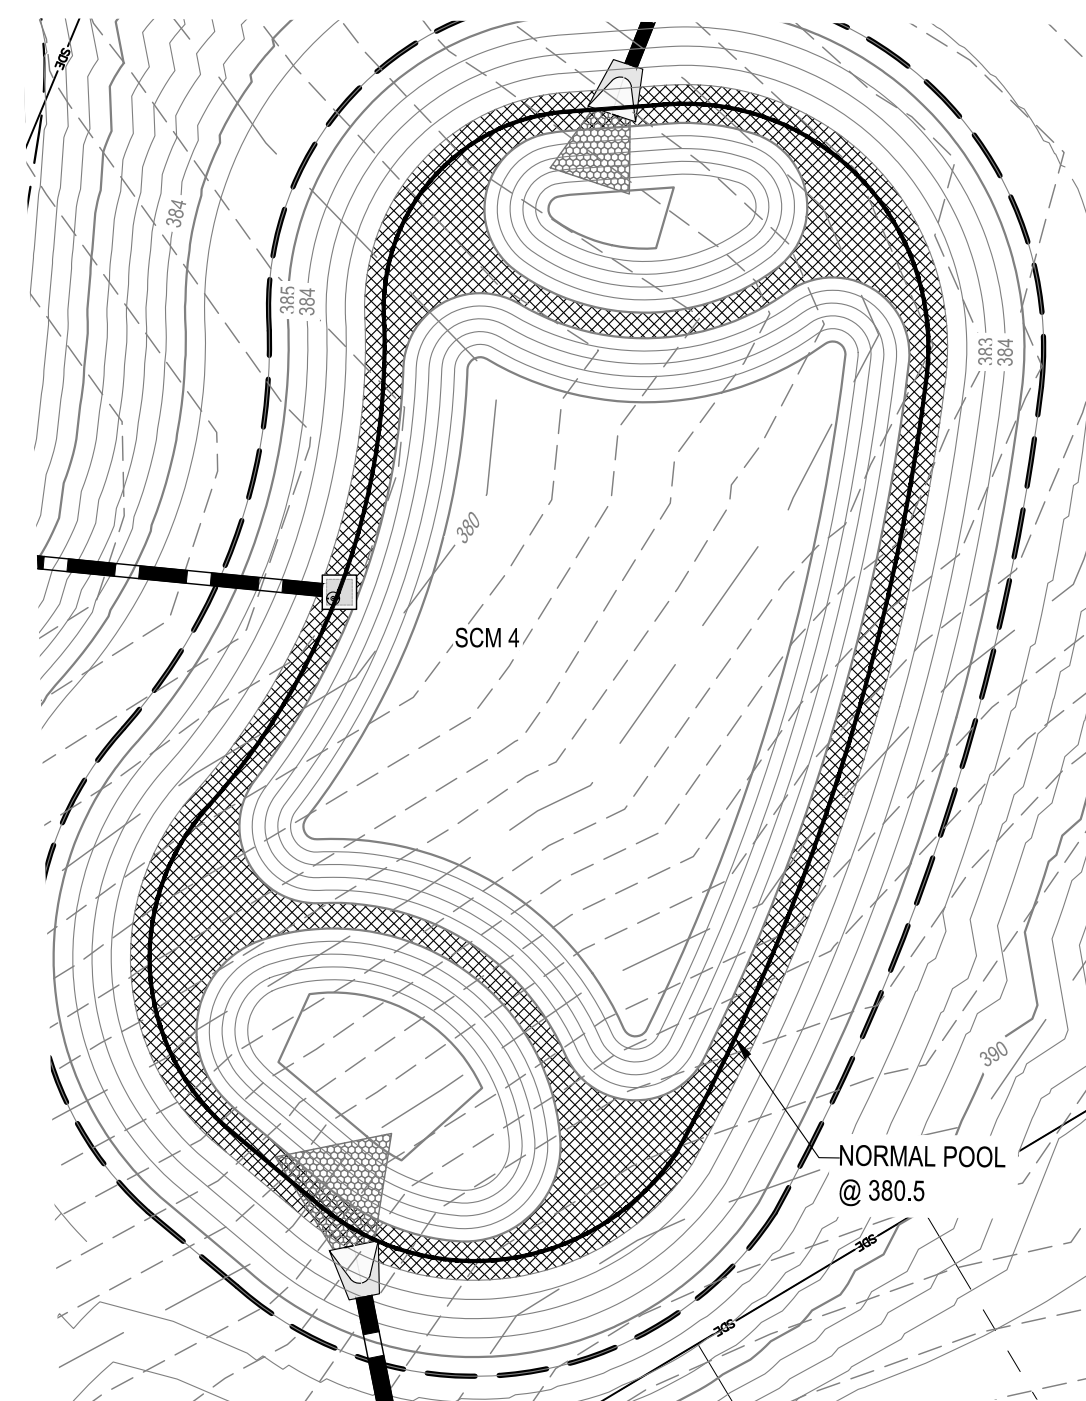 VEGETATED SHELF MIX

NOTES:

TREES AND WOODY SHRUBS ARE NOT PERMITTED ON THE DAM OR EMBANKMENT SLOPES AND ANY VOLUNTEERS SHOULD BE REMOVED AS PART OF REGULAR MAINTENANCE ACTIVITIES.

TREES AND SHRUBS MAY BE PLANTED OUTSIDE OF EMBANKMENT SLOPES AND CLEAR FROM MAINTENANCE EASEMENT.

SCM 4 PLANTING CALCULATIONS

NORMAL POOL ELEVATION: 380.5






VEGETATED SHELF: 4,398 S.F. (0.5' BELOW TO 0.5' ABOVE PERMANENT POND ELEV.)

REQUIRED: .25 PLANTS PER SQUARE FOOT
(3 MINIMUM HERBACEOUS SPECIES)
0.25 PLANTS x 4,398 SF = 1,100 PLANTS
PROVIDED: (367) HC, (367) LC, (367) CT

SCM 4 PLANTING SCHEDULE

KEY	QTY.	SCIENTIFIC NAME	COMMON NAME	CON.
HC	367	HIBISCUS COCCINEUS	SCARLET ROSE MALLOW	24"Ø x 5" PLUG
LC	367	LOBELIA CARDINALIS	CARDINAL FLOWER	24"Ø x 5" PLUG
CT	367	CAREX TENERA	QUILL SEDGE	24"Ø x 5" PLUG

 VEGETATED SHELF MIX

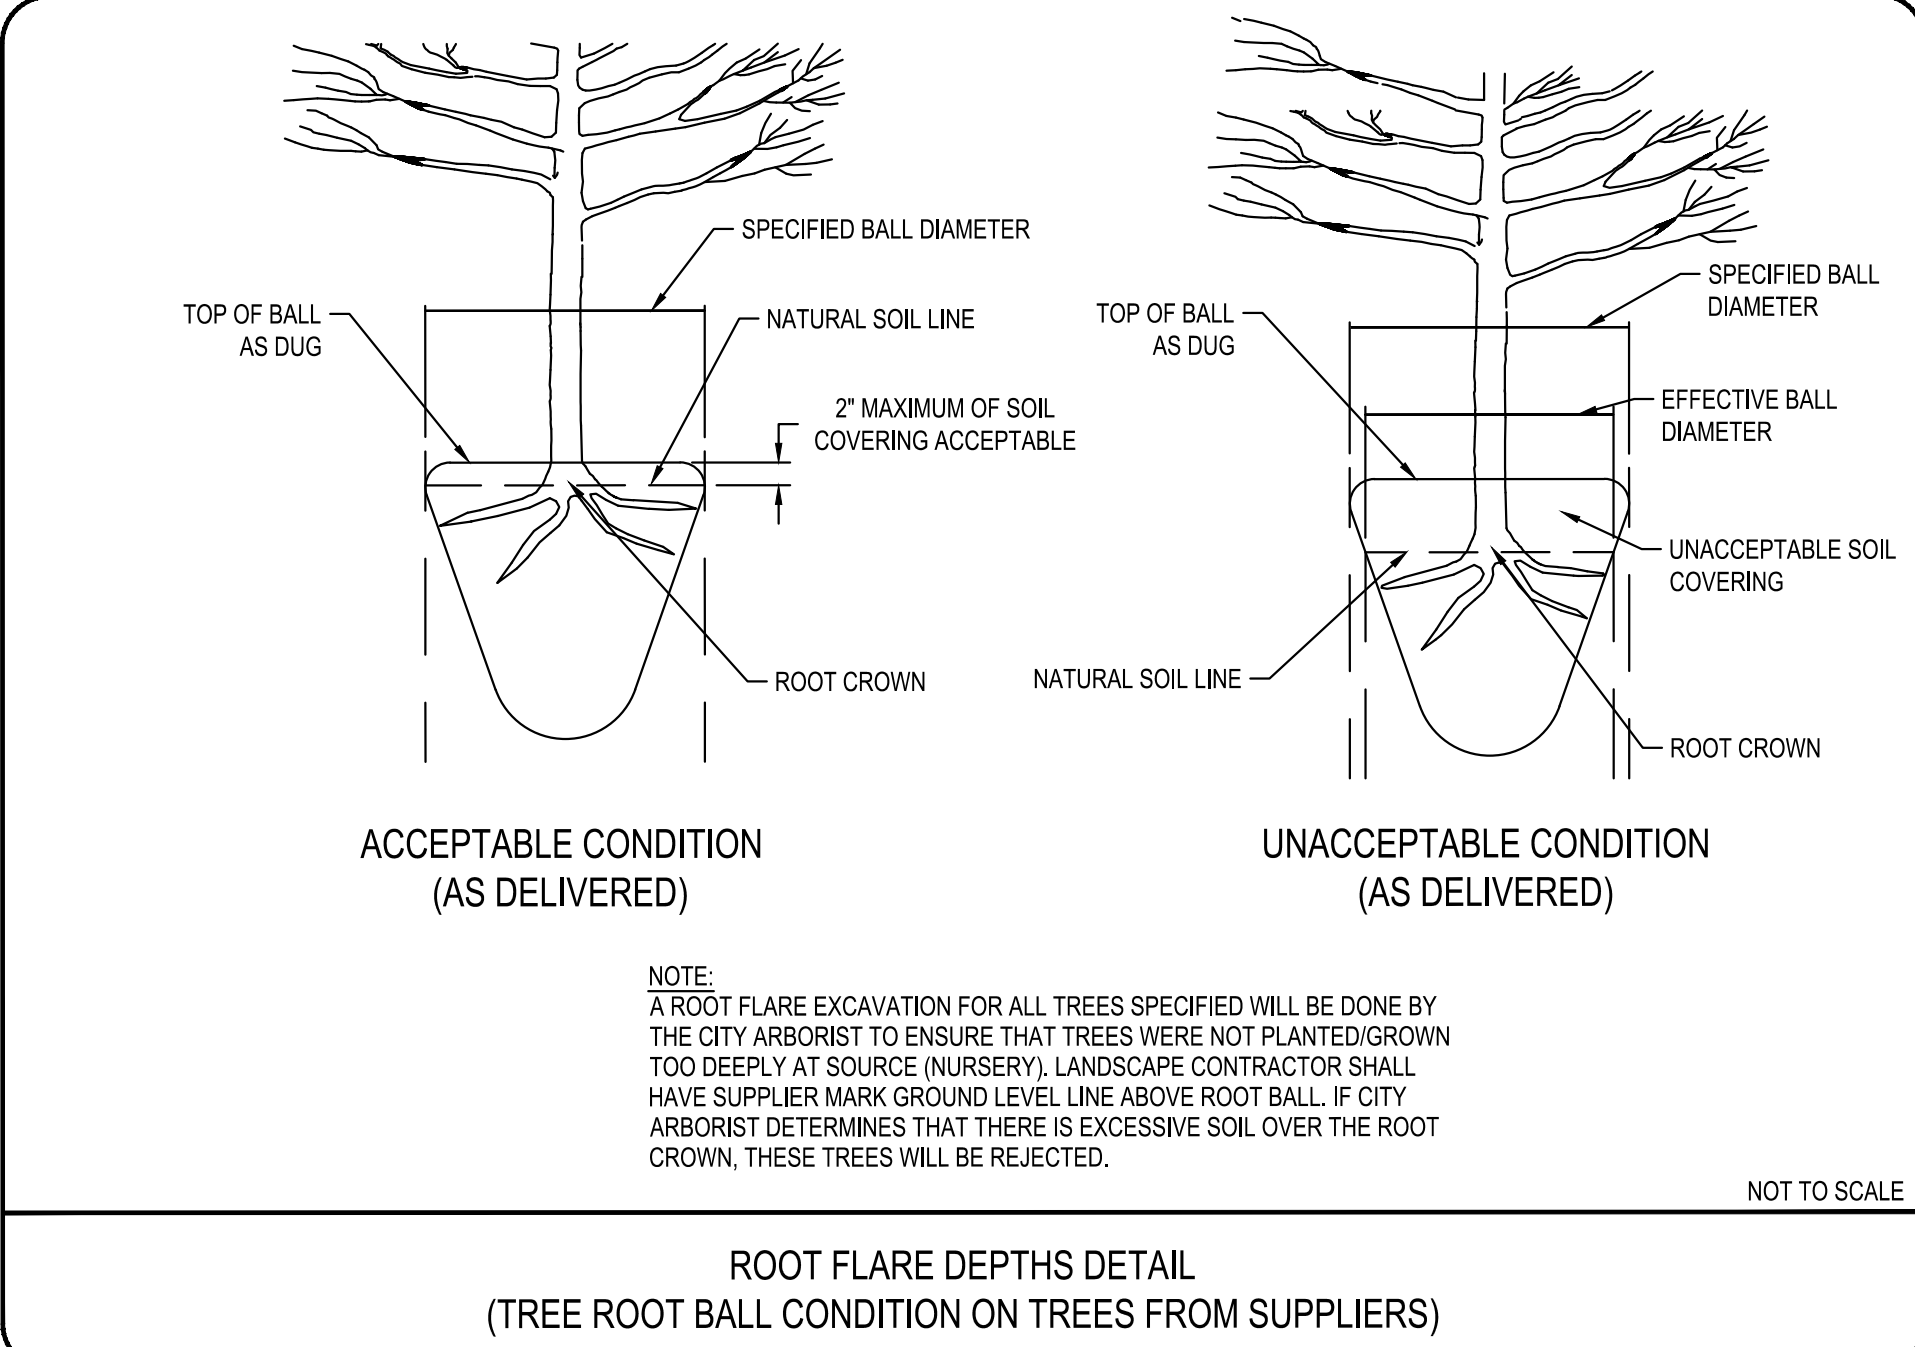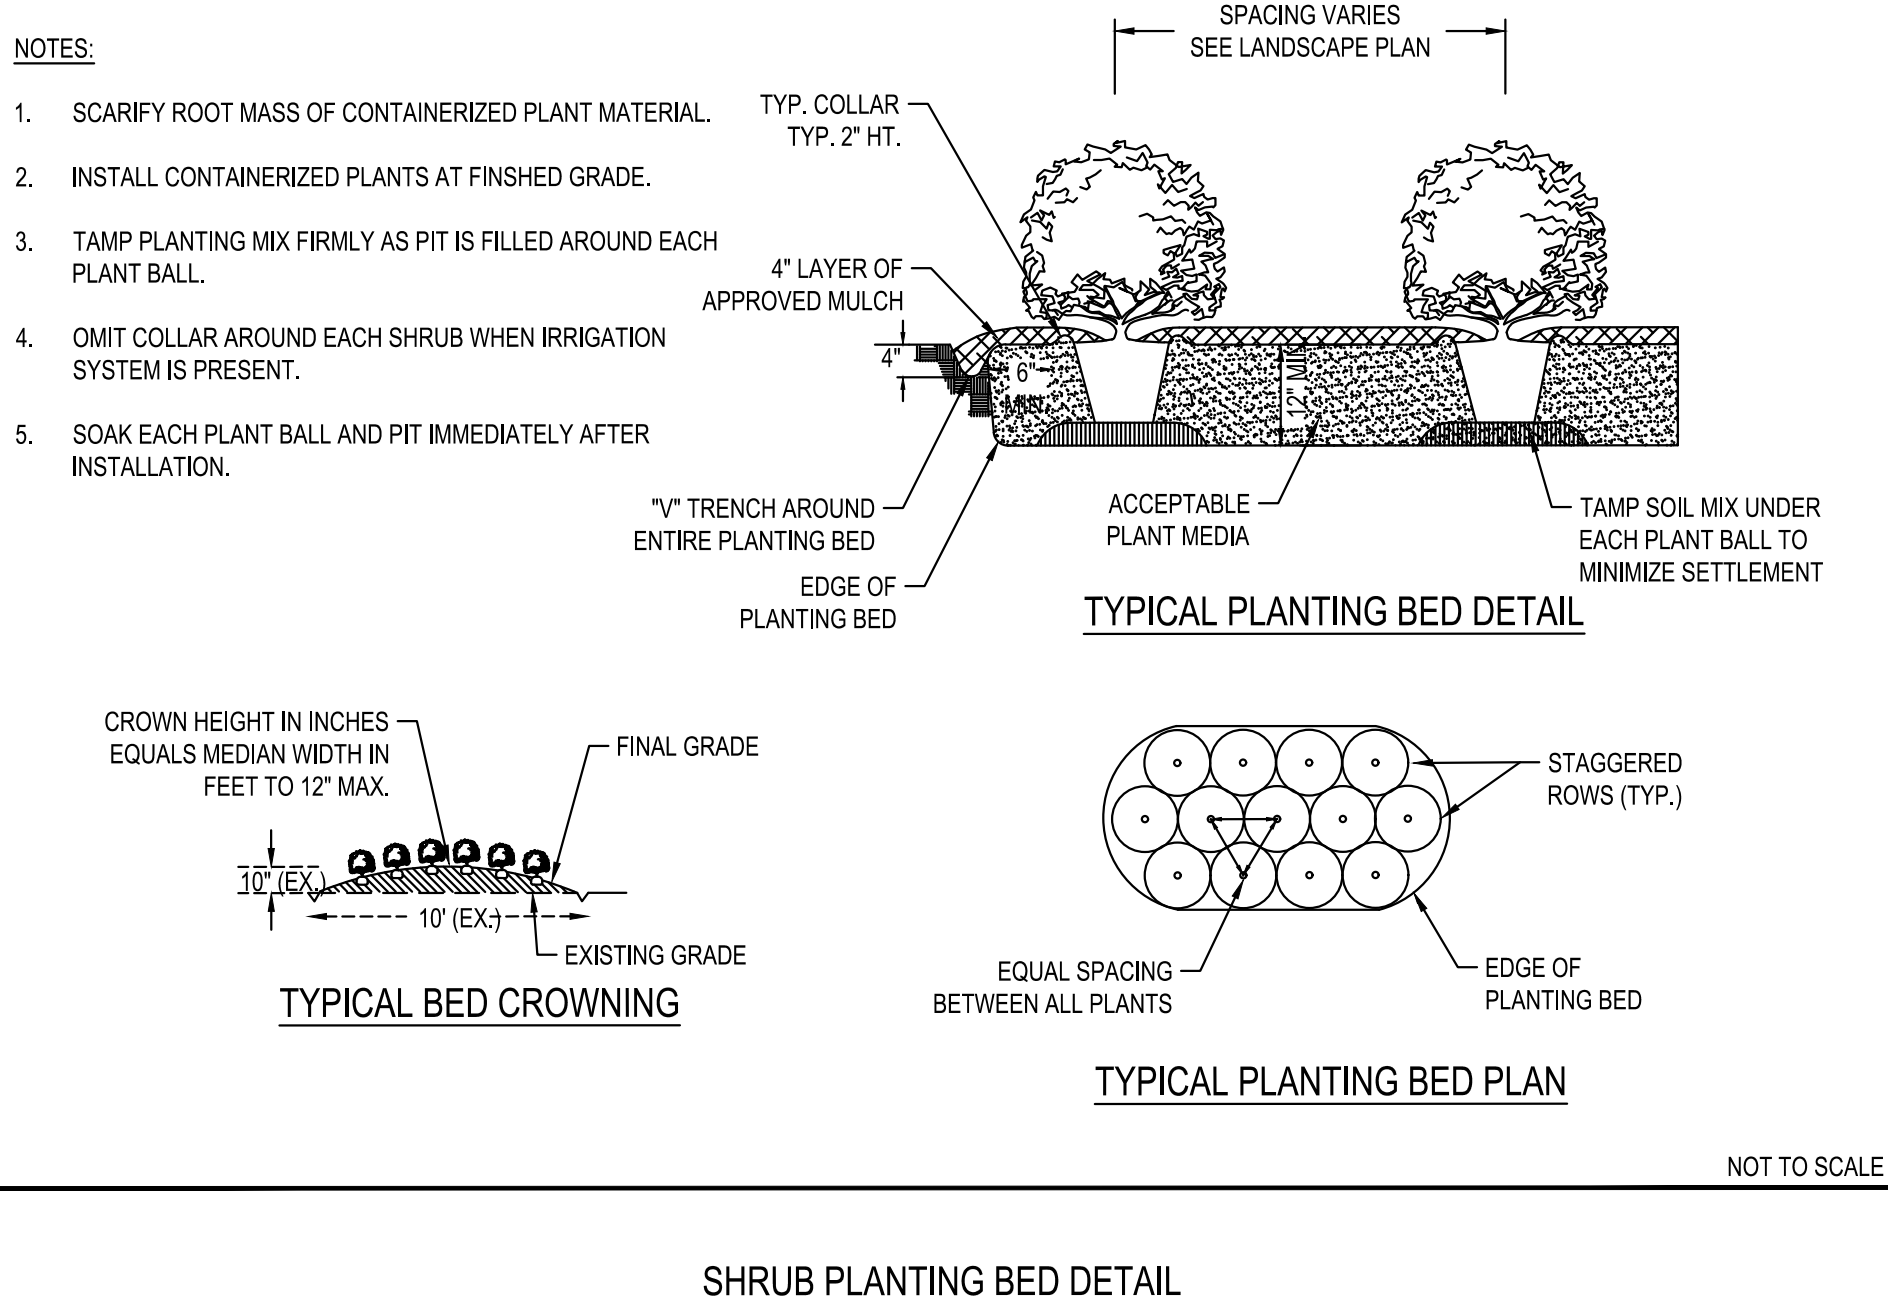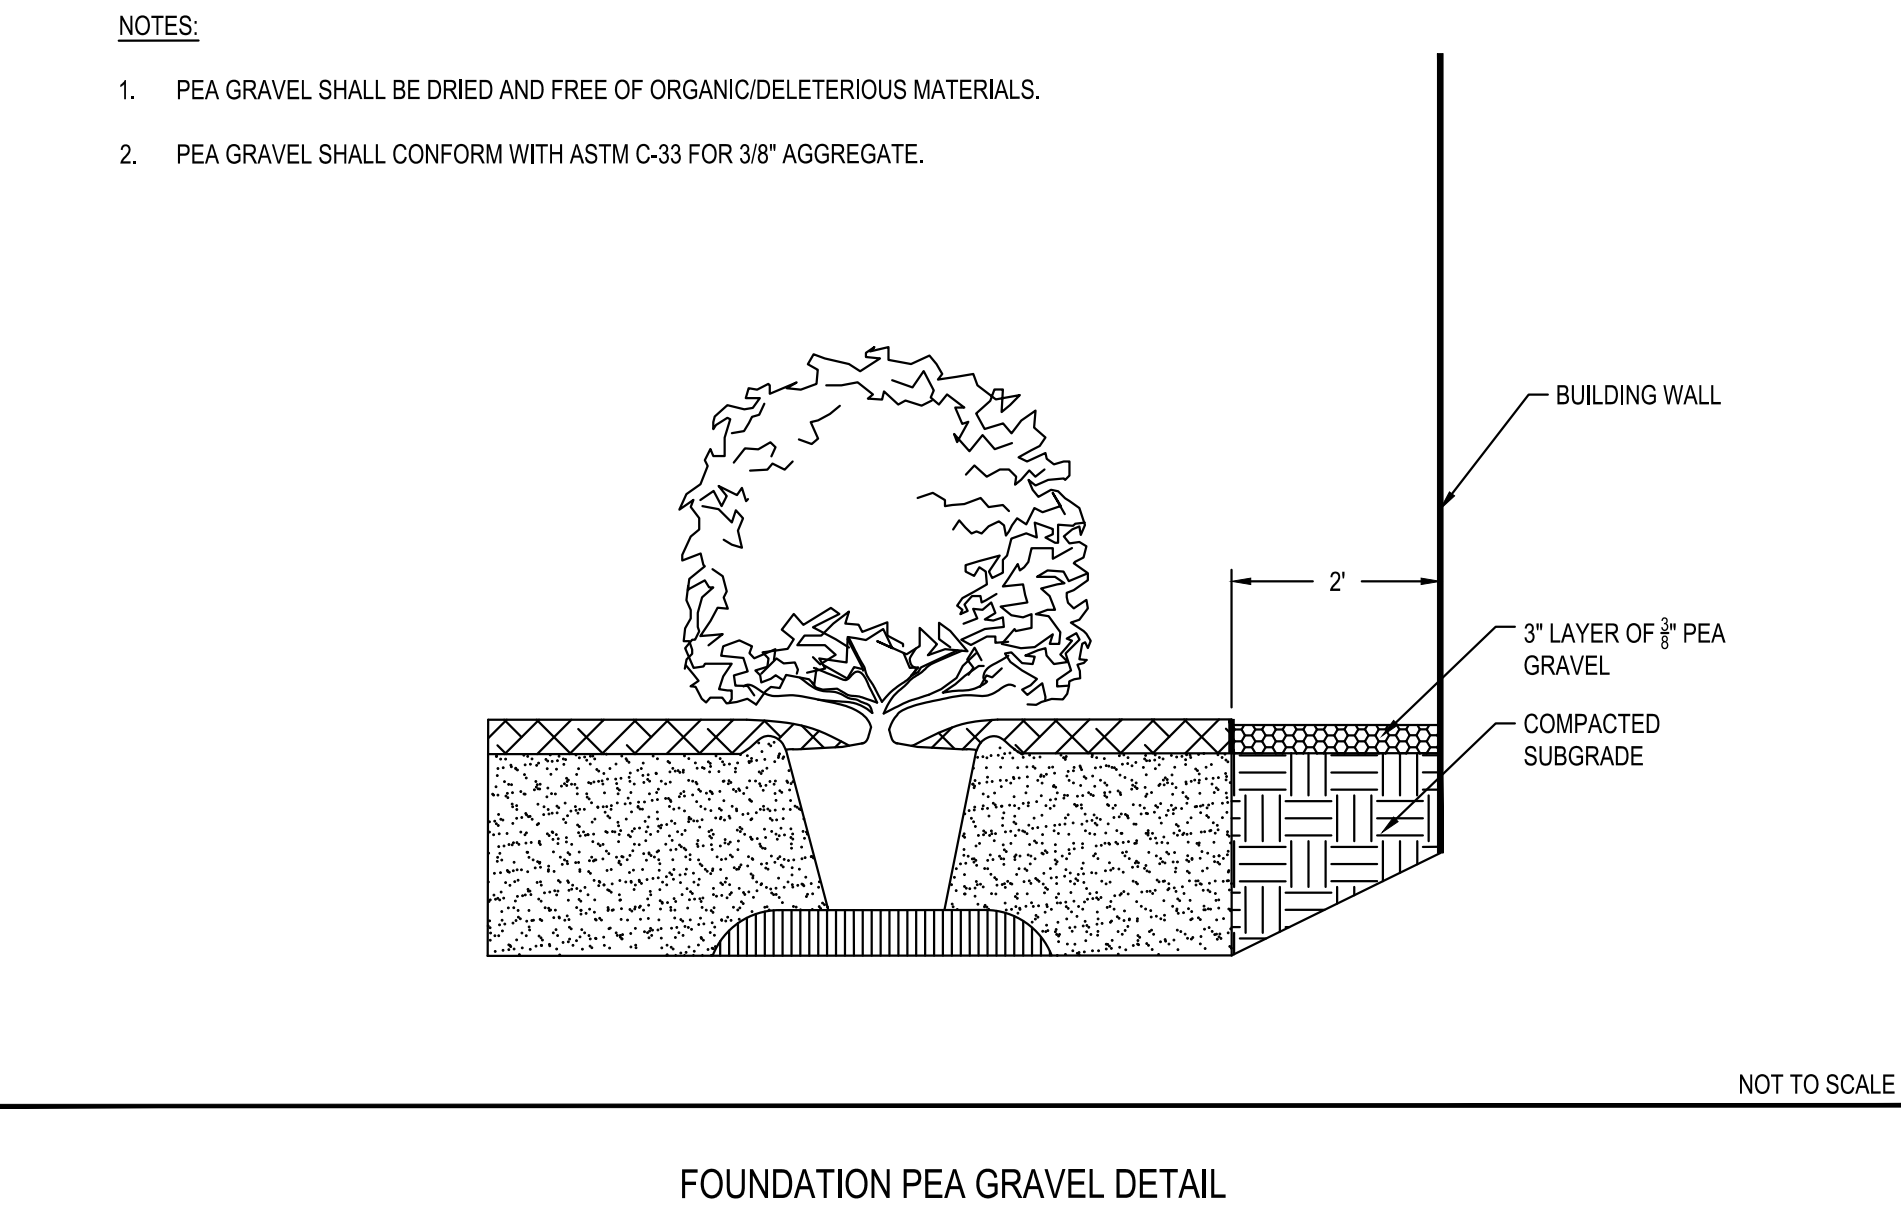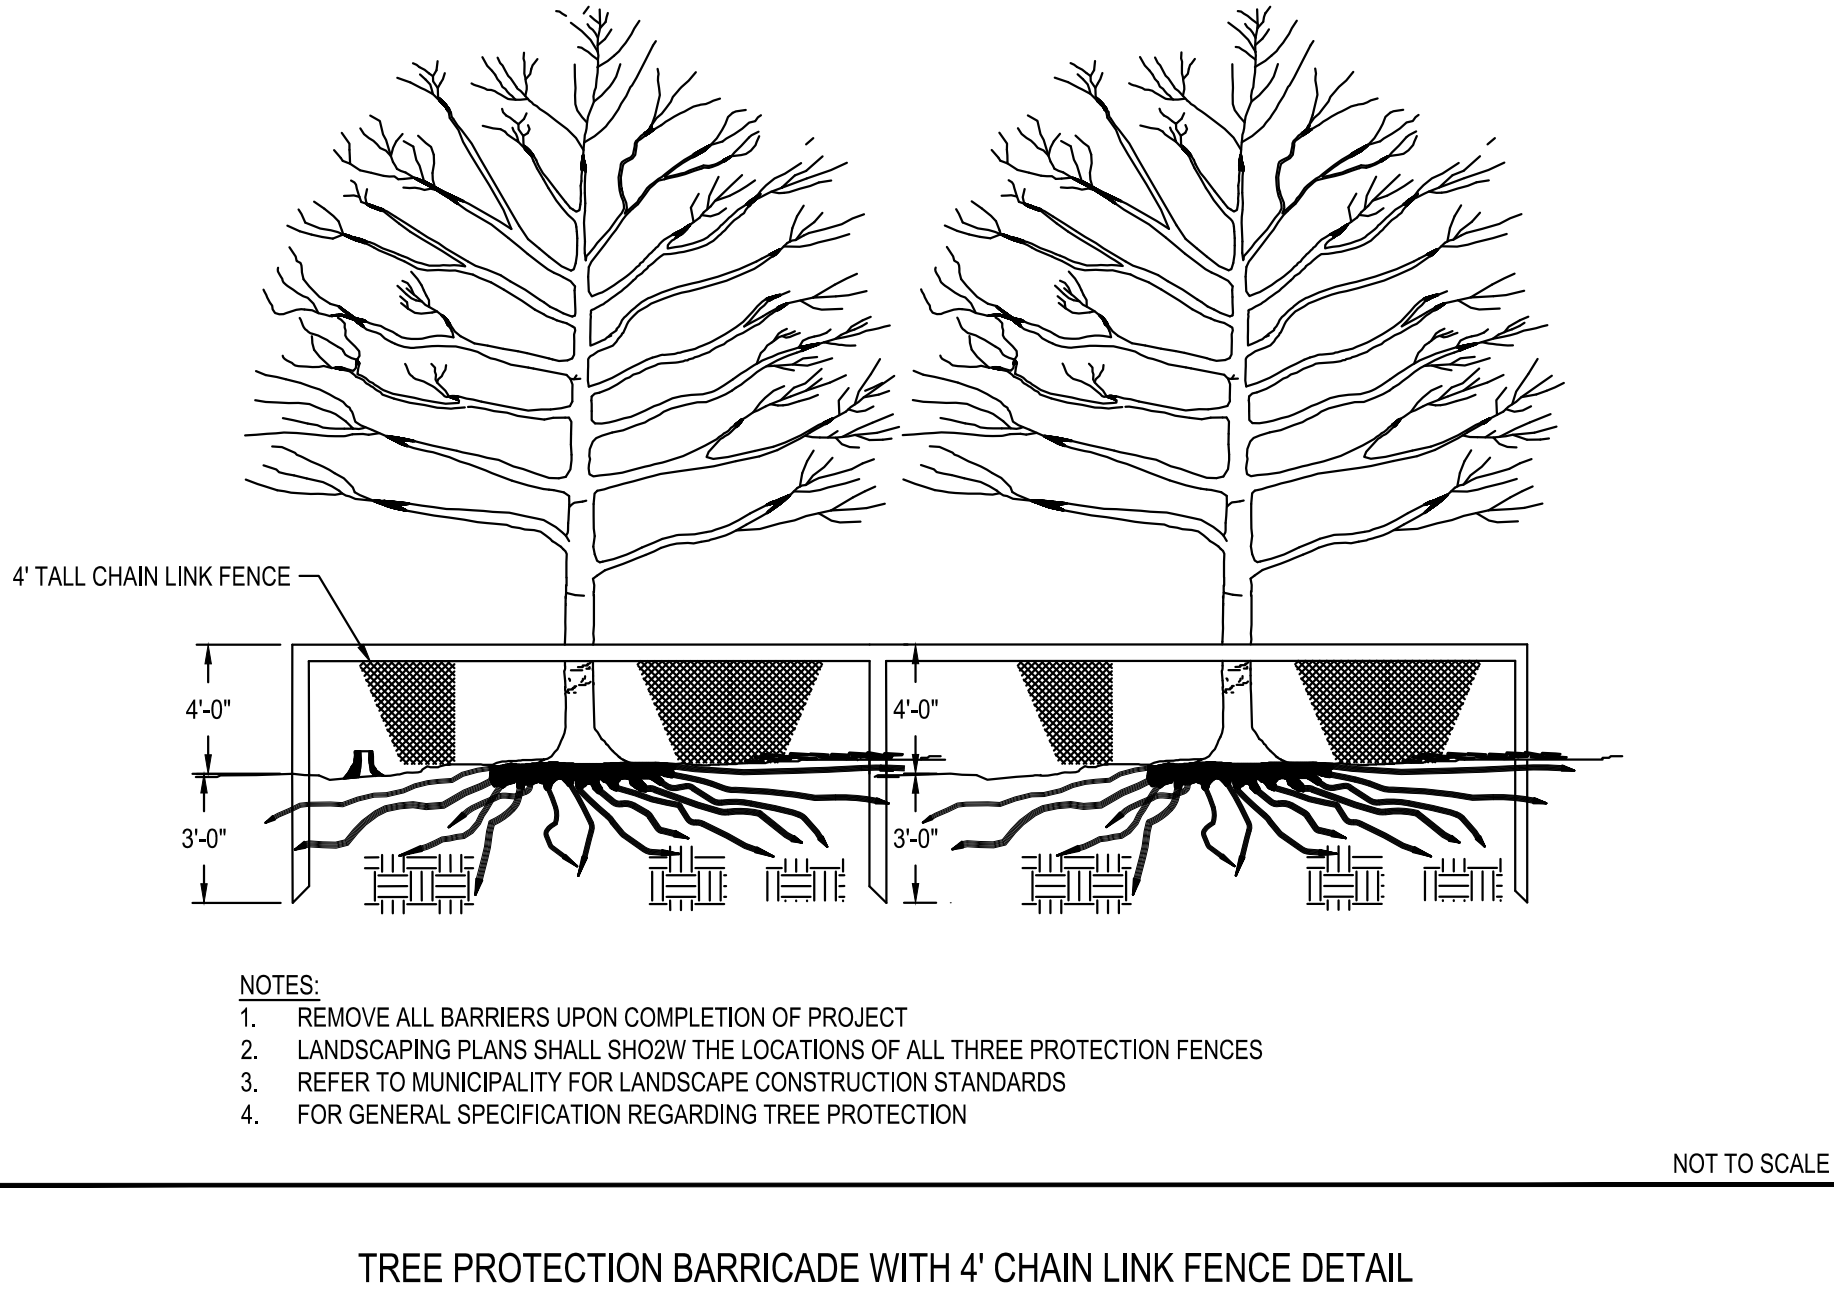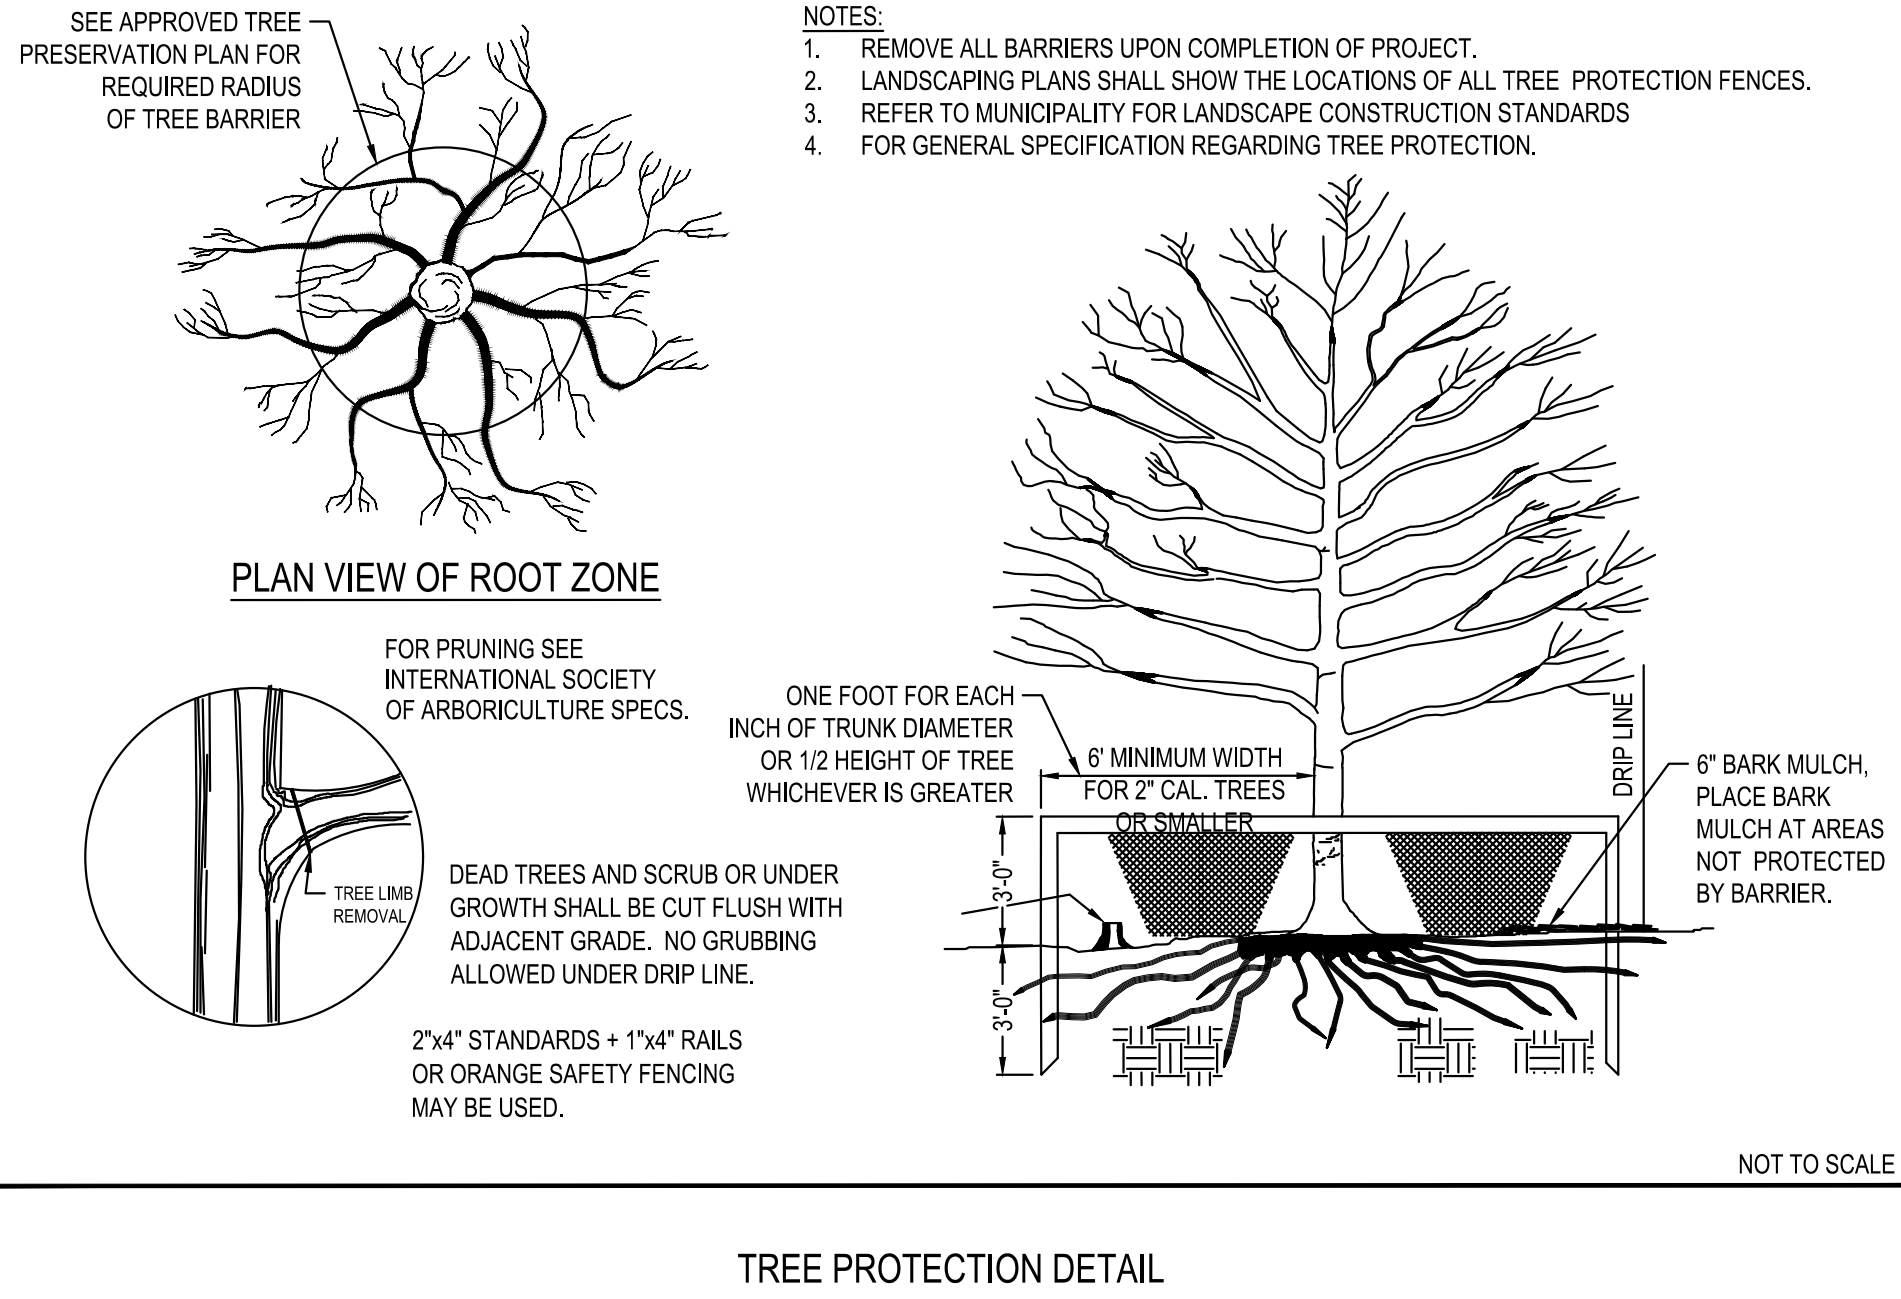

Know what's below.
Call before you dig.



NOT FOR CONSTRUCTION

FILE NUMBER:
8430-03

DATE: 06/01/2023

L1-8

PARKER RIDGE
82 SCHOOL STREET
ROLESVILLE / NORTH CAROLINA / 27571

LENNAR
CORPORAION
1100 PERIMETER PARK DRIVE, SUITE 112
MORRISVILLE / NORTH CAROLINA / 27560

BCE
5440 WADE PARK BLVD, SUITE 102
RALEIGH NC 27607
WWW.BCEINC.COM
NC LICENSE #C-4397

DESIGNED BY: DF/CD
DRAWN BY: DF/JWM
REVIEWED BY: DF

REV 04/03/2023
06/01/2023

PER TOWN OF ROLESVILLE COMMENT
INITIAL SUBMITTAL