

ALL CONSTRUCTION SHALL BE IN ACCORDANCE WITH CURRENT TOWN OF ROLESVILLE STANDARDS AND SPECIFICATIONS

SYMBOLS AND ABBREVIATIONS

ABC	AGGREGATE BASE COURSE
ALUM	ALUMINUM
AST2	ALUMINIZED STEEL – TYPE 2
B-B	BACK TO BACK
BOA	BLOW-OFF ASSEMBLY
C&G	CURB AND GUTTER
CFS	CUBIC FEET PER SECOND
CI	CURB INLET
CL	CENTER LINE
CMP	CORRUGATED METAL PIPE
CO	CLEAN OUT
COM	COMMUNICATION
CONC	CONCRETE
DCV	DOUBLE CHECK VALVE
DDCV	DOUBLE DETECTOR CHECK VALVE
DI	DROP INLET
DIP	DUCTILE IRON PIPE
EASE	EASEMENT
ELEC	ELECTRIC
EX	EXISTING
FES	FLARED END SECTION
FH	FIRE HYDRANT
FM	FORCE MAIN
FT	FEET
FT/SEC	FEET PER SEC
GALV	GALVANIZED
GV	GATE VALVE
HDPE	HIGH DENSITY POLYETHYLENE
L	LENGTH
LF	LINEAR FEET
MH	MANHOLE
PAVE	PAVEMENT
PE	FINISHED PAD ELEVATION
PP	POWER POLE
PVC	POLYVINYL CHLORIDE
R	RADIUS
R/W	RIGHT-OF-WAY
RED	REDUCER
RCP	REINFORCED CONCRETE PIPE
RPZ	REDUCED PRESSURE ZONE
SS	SANITARY SEWER
STA	STATION
TDD	TEMPORARY DIVERSION DITCH
TELE	TELEPHONE
TSB	TEMPORARY SEDIMENT BASIN
UG	UNDERGROUND
WCR	WHEELCHAIR RAMP
W/L	WATER LINE
WM	WATER METER
YI	YARD INLET


	EXISTING CURB INLET
	EXISTING GRATE INLET/YARD INLET
	EXISTING FLARED END SECTION
	EXISTING FIRE HYDRANT
	EXISTING BLOW-OFF ASSEMBLY
	EXISTING GATE VALVE
	EXISTING REDUCER
	EXISTING WATER METER
	EXISTING SAN SEWER MANHOLE
	EXISTING CLEAN OUT
	EXISTING POWER POLE
	EXISTING TELEPHONE PEDESTAL
	EXISTING AREA LIGHT
	EXISTING SIGN
	NEW CURB INLET
	NEW GRATE INLET/YARD INLET
	NEW FLARED END SECTION
	NEW FIRE HYDRANT
	NEW BLOW-OFF ASSEMBLY
	NEW GATE VALVE
	NEW REDUCER
	NEW WATER METER
	NEW TEE
	NEW PLUG
	NEW MANHOLE
	NEW CLEAN OUT
	NEW SIGN
	IRON PIPE
	BENCHMARK

	TEMP SILT FENCE
	TEMP TREE PROTECTION FENCE
	TEMP COMBINATION SILT/TREE PROTECTION FENCE
	TEMP DIVERSION DITCH
	DISTURBED LIMITS
	STREAM
	EXISTING GAS LINE
	EXISTING COMMUNICATIONS LINE
	EXISTING UNDERGROUND TELEPHONE
	EXISTING UNDERGROUND ELECTRIC
	EXISTING OVERHEAD ELECTRIC
	EXISTING WATER LINE
	EXISTING SANITARY SEWER FORCE MAIN
	EXISTING SANITARY SEWER
	EXISTING STORM DRAINAGE
	NEW STORM DRAINAGE
	NEW WATER LINE
	NEW SANITARY SEWER
	NEW SANITARY SEWER FORCE MAIN
	NEW GAS MAIN
	HANDICAPPED ACCESSIBLE ROUTE

NOTE: ALL CONSTRUCTION ACTIVITY MUST BE IN ACCORDANCE WITH THE ACCEPTED POLICIES OF THE TOWN OF ROLESVILLE AND NCDOT

COBBLESTONE VILLAGE MIXED USE DEVELOPMENT

TOWN OF ROLESVILLE, WAKE COUNTY, NORTH CAROLINA
CONSTRUCTION DRAWINGS
TOWN OF ROLESVILLE PROJECT NO.
SITE PLAN APPLICATION NO. CUP-SB-21-01
CASE NO. SP21-01

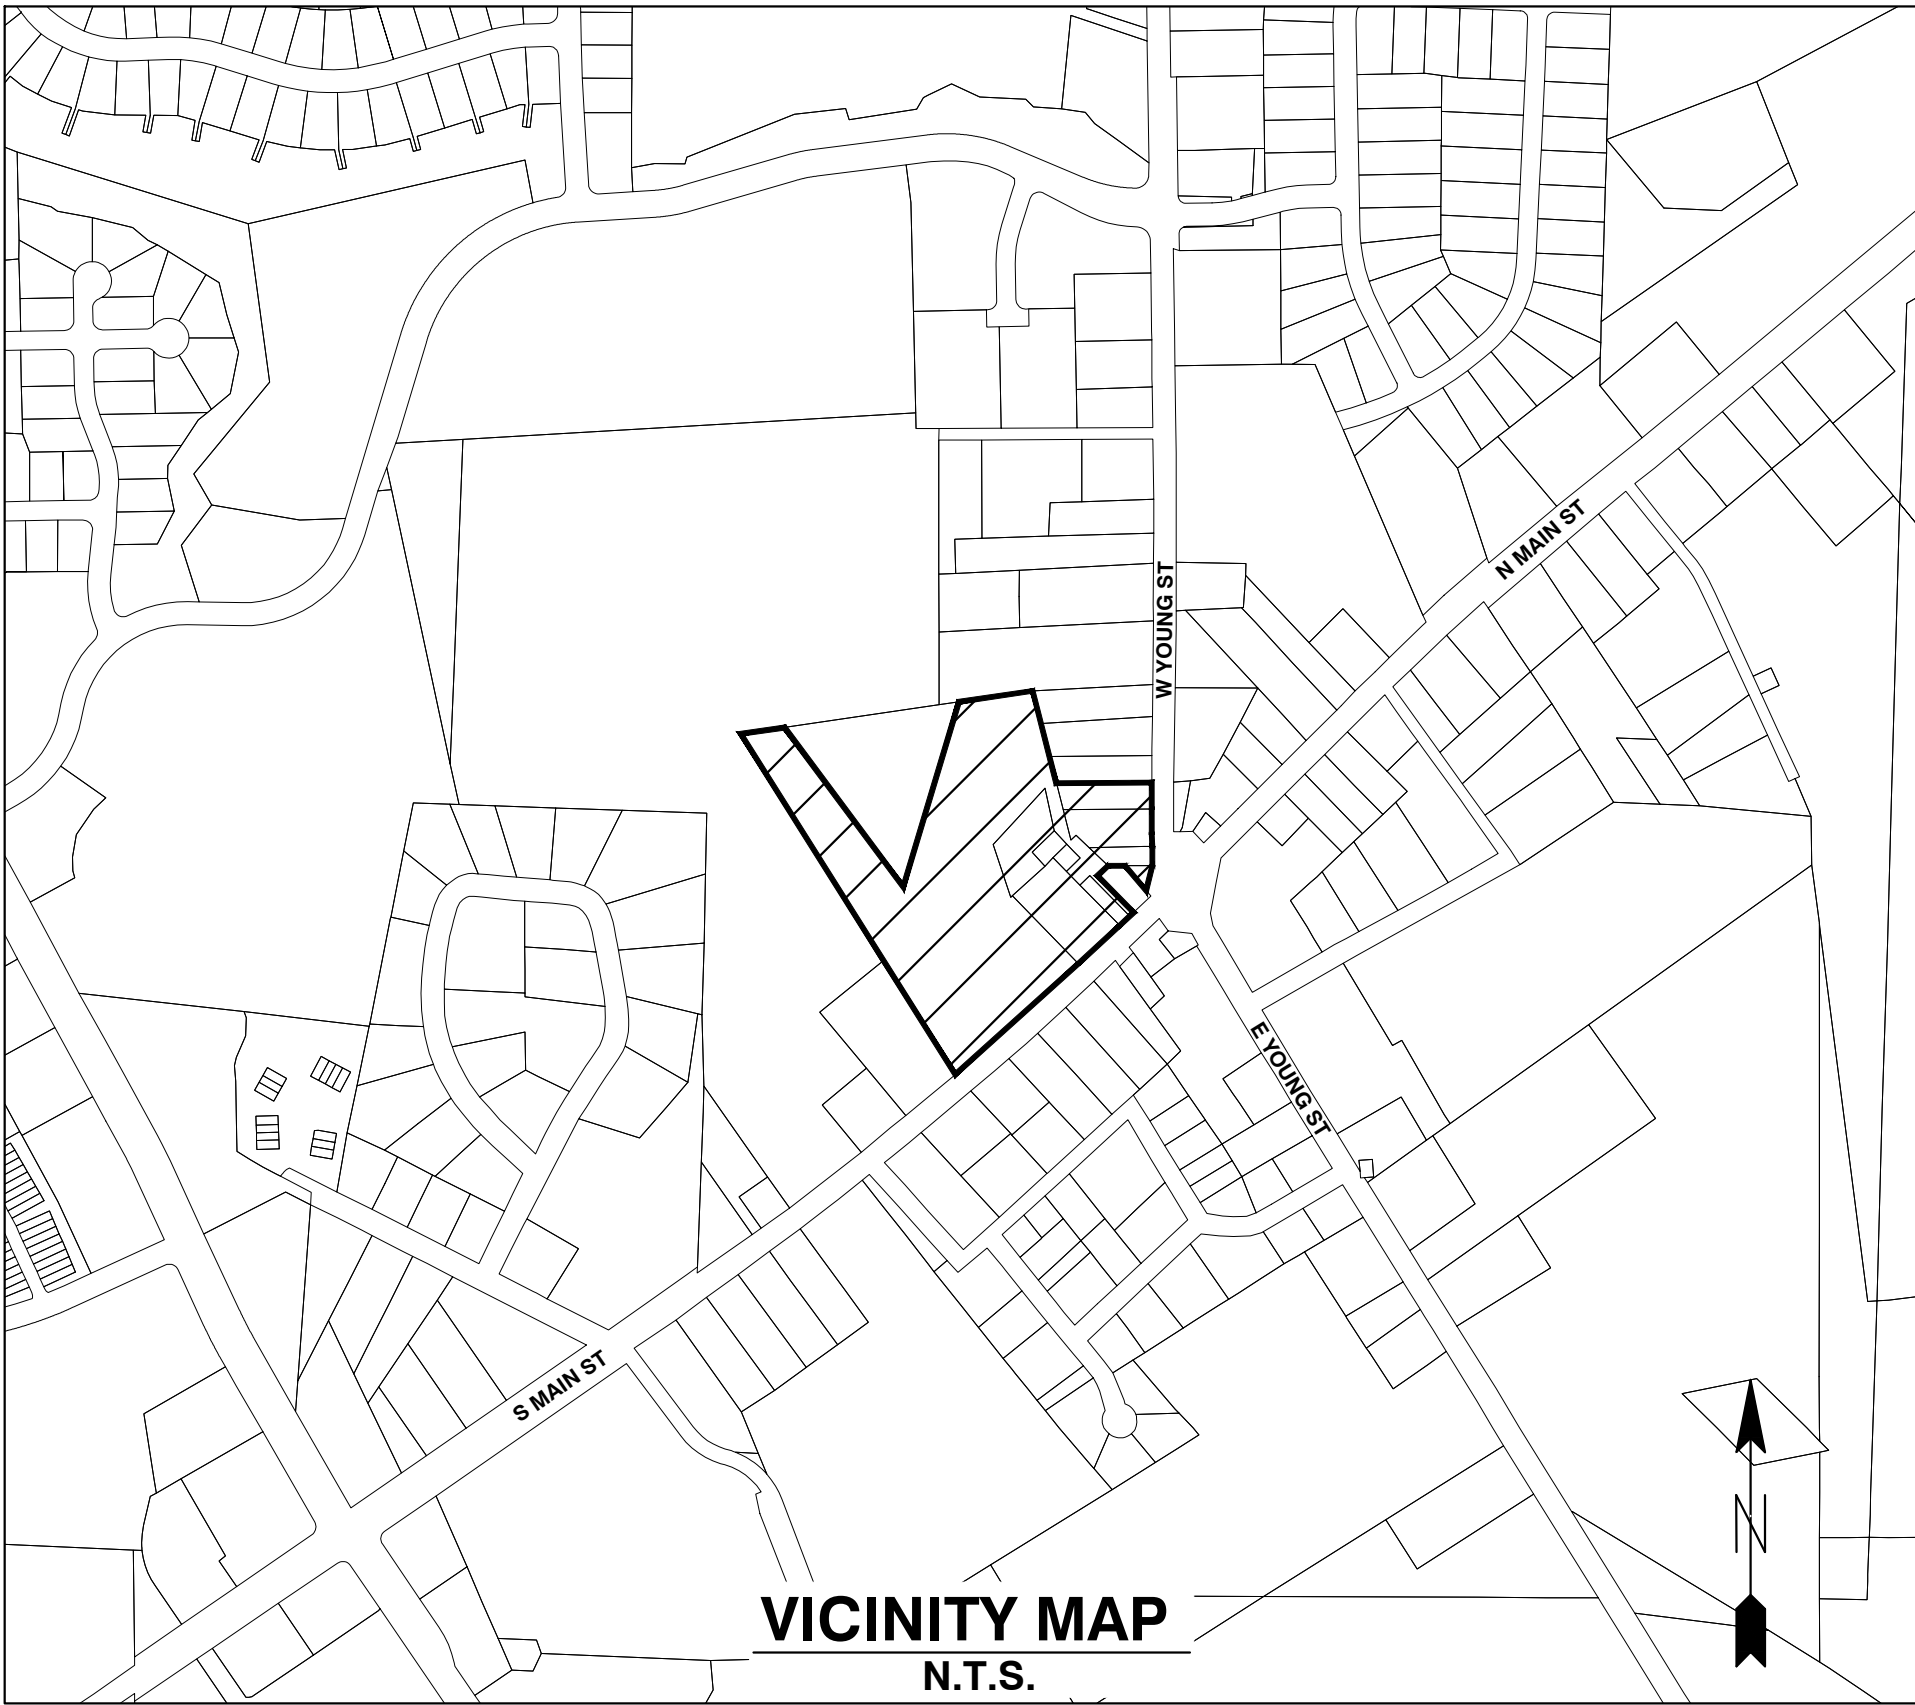

Public
Water Distribution / Extension System
The City of Raleigh consents to the connection and extension of the City's public water system as shown on this plan. The material and construction methods used for this project shall conform to the standards and specifications of the City's Public Utilities Handbook.

City of Raleigh
Public Utilities Department Permit # W-3879

Authorization to Construct See digital signature

Private
Sewer Collection / Extension System
The City of Raleigh consents to the connection to its public sewer system and extension of the private sewer collection system as shown on this plan. The material and construction methods used for this project shall conform to the standards and specifications of the City's Public Utilities Handbook.

City of Raleigh
Public Utilities Department Permit # S-4962 (P)

Authorization to Construct See digital signature

SITE PERMITTING APPROVAL

Water and Sewer Permits (if applicable)
The City of Raleigh consents to the connection and extension of the City's **Public Sewer System** as shown on this plan. The material and construction methods used for this project shall conform to the standards and specifications of the City's Public Utilities Handbook. **City of Raleigh Public Utilities Department Permit #** W-3879

The City of Raleigh consents to the connection and extension of the City's **Public Water System** as shown on this plan. The material and construction methods used for this project shall conform to the standards and specifications of the City's Public Utilities Handbook. **City of Raleigh Public Utilities Department Permit #** S-4962 (P)

The City of Raleigh consents to the connection to its public sewer system and extension of the **private sewer collection system** as shown on this plan. The material and construction methods used for this project shall conform to the standards and specifications of the City's Public Utilities Handbook.
City of Raleigh Public Utilities Department Permit # _____

CITY OF RALEIGH - PLANS AUTHORIZED FOR CONSTRUCTION

Electronic Approval: This approval is being issued electronically. This approval is valid only upon the signature of a City of Raleigh Review Officer below. The City will retain a copy of the approved plans. Any work authorized by this approval must proceed in accordance with the plans kept on file with the City. This electronic approval may not be edited once issued. Any modification to this approval once issued will invalidate this approval.

City of Raleigh Development Approval _____

Raleigh Water Review Officer _____

OWNER:

TOWN OF ROLESVILLE
P.O. BOX 250
ROLESVILLE, NC 27571-0250

DEVELOPER:

KDM DEVELOPMENT CORPORATION
1080 PITTSFORD VICTOR RD, STE 202
PITTSFORD NY 14534-3805

CONTACT: KENYON BURHNAM
PHONE: 585-465-0099
EMAIL: KBURNHA2@U.ROCHESTER.EDU

SHEET INDEX

COVER	
C0.1	EXISTING CONDITIONS & DEMOLITION PLAN
C1.1	SITE PLAN
C1.2	OPEN SPACE PLAN
C2.1	UTILITY PLAN
C3.1	GRADING AND DRAINAGE PLAN
C3.2	BMP DETAILS
C3.3	EROSION CONTROL PLAN - STAGE 1
C3.4	EROSION CONTROL PLAN - STAGE 2
C3.5	EROSION CONTROL DETAILS
C3.6	EROSION CONTROL DETAILS
C3.7	NCG01 PLAN
C3.8	STORM DRAINAGE PIPE & STRUCTURE TABLE
C4.1	PUBLIC WATERLINE PROFILE
C4.2	SANITARY SEWER PROFILE
C4.3	S. MAIN ST. - U.S. 401 WIDENING CROSS SECTIONS
L1.1	LANDSCAPE PLAN
L1.2	LANDSCAPE DETAILS
SL-101	LIGHTING PLAN
C5.1	DETAILS
C5.2	DETAILS
C5.3	DETAILS
C5.4	DETAILS
C5.5	DETAILS
C5.6	DETAILS

#1 Storm calculations (10/25yr) and drainage area maps (pre/post/inlet) will be needed prior to approval. With out engineering is not able to complete the review

CONSTRUCTION NOTES

- ALL CONSTRUCTION SHALL BE IN ACCORDANCE WITH APPLICABLE MUNICIPALITY STANDARDS, SPECIFICATIONS, AND DETAILS. WORK IN THIS PROJECT SHALL ALSO CONFORM TO THESE PLANS, THE LATEST EDITIONS OF THE NORTH CAROLINA DEPARTMENT OF TRANSPORTATION (NCDOT) ROAD AND BRIDGE SPECIFICATIONS, THE ROAD AND BRIDGE STANDARDS, THE NORTH CAROLINA EROSION AND SEDIMENT CONTROL HANDBOOK, THE NORTH CAROLINA EROSION AND SEDIMENT CONTROL REGULATIONS, THE FINAL GEOTECHNICAL REPORT, AND GENERAL DESIGN STANDARDS. IN THE EVENT OF CONFLICT BETWEEN ANY OF THESE STANDARDS, SPECIFICATIONS, OR PLANS, THE MOST STRINGENT SHALL GOVERN.
- THE CONTRACTOR SHALL BE SOLELY RESPONSIBLE FOR TRENCH SAFETY DURING ALL PHASES OF CONSTRUCTION.
- THE LOCATION AND SIZE OF EXISTING UTILITIES AS SHOWN IS APPROXIMATE ONLY. THE CONTRACTOR IS RESPONSIBLE FOR HORIZONTALLY AND VERTICALLY LOCATING AND PROTECTING ALL PUBLIC OR PRIVATE UTILITIES WHICH LIE IN OR ADJACENT TO THE CONSTRUCTION SITE. AT LEAST 48 HOURS PRIOR TO ANY DEMOLITION, GRADING, OR CONSTRUCTION ACTIVITY, THE CONTRACTOR SHALL NOTIFY THE NORTH CAROLINA ONE-CALL UTILITIES LOCATION SERVICE (ULOCOS) AT 1-800-632-4949 FOR PROPER IDENTIFICATION OF EXISTING UTILITIES WITHIN THE SITE.
- THE CONTRACTOR SHALL SALVAGE AND PROTECT ALL EXISTING POWER POLES, SIGNS, MANHOLES, TELEPHONE RISERS, WATER VALVES, ETC. DURING ALL CONSTRUCTION PHASES. THE CONTRACTOR SHALL REPAIR, AT HIS OWN EXPENSE, ANY EXISTING UTILITIES DAMAGED DURING CONSTRUCTION.
- TRAFFIC CONTROL ON PUBLIC STREETS SHALL BE IN CONFORMANCE WITH THE TRAFFIC CONTROL PLAN, THE MANUAL OF UNIFORM TRAFFIC CONTROL DEVICES, AND AS FURTHER DIRECTED BY CITY AND STATE INSPECTORS.
- ANY DISCREPANCIES FOUND BETWEEN THE DRAWINGS AND SPECIFICATIONS AND SITE CONDITIONS OR ANY INCONSISTENCIES OR AMBIGUITIES IN DRAWINGS OR SPECIFICATIONS SHALL BE IMMEDIATELY REPORTED TO THE ENGINEER, IN WRITING, WHO SHALL PROMPTLY ADDRESS SUCH INCONSISTENCIES OR AMBIGUITIES. WORK DONE BY THE CONTRACTOR AFTER HIS DISCOVERY OF SUCH DISCREPANCIES, INCONSISTENCIES, OR AMBIGUITIES SHALL BE DONE AT THE CONTRACTOR'S RISK.
- A PRE-CONSTRUCTION CONFERENCE SHALL BE HELD PRIOR TO THE START OF CONSTRUCTION. THE CONTRACTOR SHALL ARRANGE THE MEETING WITH THE CITY ENGINEERING DIVISION.
- CONTRACTOR IS RESPONSIBLE FOR VERIFYING ALL REQUIRED PERMITS AND APPROVALS PRIOR TO COMMENCING CONSTRUCTION.
- ALL AREAS SHALL BE GRADED FOR POSITIVE DRAINAGE, AND AS SHOWN ON THESE PLANS, THE CONTRACTOR SHALL MAINTAIN ADEQUATE SITE DRAINAGE DURING ALL PHASES OF CONSTRUCTION. THE CONTRACTOR SHALL USE SILT FENCES (OR OTHER METHODS APPROVED BY THE ENGINEER AND APPLICABLE MUNICIPALITY) AS REQUIRED TO PREVENT SILT AND CONSTRUCTION DEBRIS FROM FLOWING ONTO ADJACENT PROPERTIES. CONTRACTOR SHALL COMPLY WITH ALL APPLICABLE FEDERAL, STATE, OR LOCAL EROSION, CONSERVATION, AND SITUATION ORDINANCES. CONTRACTOR SHALL REMOVE ALL TEMPORARY EROSION CONTROL DEVICES UPON COMPLETION OF PERMANENT DRAINAGE FACILITIES AND THE ESTABLISHMENT OF A STAND OF GRASS OR OTHER GROWTH TO PREVENT EROSION.
- THE CONTRACTOR SHALL CLEAN AND GRUB THE SITE AND PLACE, COMPACT, AND MOISTURE CONDITION ALL FILL PER THE PROJECT GEOTECHNICAL ENGINEER'S SPECIFICATIONS. THE FILL MATERIAL TO BE USED SHALL BE APPROVED BY THE GEOTECHNICAL ENGINEER PRIOR TO PLACEMENT.
- MATERIALS USED TO CONSTRUCT EMBANKMENTS FOR ANY PURPOSE, BACKFILL AROUND DRAINAGE STRUCTURES, OR IN UTILITY TRENCHES FOR ANY OTHER DEPRESSION REQUIRING FILL OR BACKFILL SHALL BE COMPACTED TO 95% OF MAXIMUM DENSITY AS DETERMINED BY THE STANDARD PROCTOR TEST AS SET OUT IN ASTM STANDARD D698. STONE BACKFILL SHALL BE COMPACTED TO 95% MAXIMUM DENSITY AS DETERMINED BY THE MODIFIED PROCTOR TEST AS SET OUT IN ASTM STANDARD D1557. THE CONTRACTOR SHALL, PRIOR TO ANY OPERATIONS INVOLVING FILLING OR BACKFILLING, SUBMIT THE RESULTS OF THE PROCTOR TEST TOGETHER WITH A CERTIFICATION THAT THE SOIL TESTED IS REPRESENTATIVE OF THE MATERIALS TO BE USED ON THE PROJECT. TESTS SHALL BE CONDUCTED BY A CERTIFIED MATERIALS TESTING LABORATORY AND THE CERTIFICATIONS MADE BY A LICENSED PROFESSIONAL ENGINEER REPRESENTING THE LABORATORY.
- PROPOSED CONTOURS AND GUTTER GRADIENTS ARE APPROXIMATE. PROPOSED SPOT ELEVATIONS AND ROADWAY PROFILES/SUPERELEVATIONS ARE TO BE USED IN CASE OF DISCREPANCY.
- THE CONTRACTOR SHALL REVIEW, VERIFY AND COORDINATE ALL DIMENSIONS SHOWN ON PLANS, INCLUDING THE HORIZONTAL AND VERTICAL LOCATION OF CURB INLETS AND GRATE INLETS AND ALL UTILITIES CROSSING THE STORM SEWER PRIOR TO STARTING PROJECT.
- ALL CURB JOINTS SHALL EXTEND THROUGH THE CURB. MINIMUM LENGTH OF OFFSET JOINTS AT RADIUS POINTS IS 1.5 FEET. ALL JOINTS SHALL BE SEALED WITH JOINT SEALANT.
- ALL HANDICAP RAMPING, STRIPING, AND PAVEMENT MARKINGS SHALL CONFORM TO ADA REQUIREMENTS AND THE NORTH CAROLINA STATE BUILDING CODE, VOL. 1-C ACCESSIBILITY CODE.
- OWNER SHALL PROVIDE FENCING AND OTHER SAFETY MEASURES NECESSARY IN AND AROUND ANY PROPOSED STORMWATER MANAGEMENT MEASURES (PONDS, WETLANDS, ETC.) OBTAINING PROPER PERMITS SHALL BE THE RESPONSIBILITY OF THE OWNER.
- RETAINING WALLS EXCEEDING 30 INCHES IN HEIGHT SHALL INCLUDE FALL PROTECTION IN THE FORM OF A HANDRAIL OR FENCING ON THE HIGH SIDE OF THE RETAINING WALL.
- PROPER COMPACTION OF ALL FILL SOILS PLACED ON SITE SHALL BE THE RESPONSIBILITY OF THE CONTRACTOR. COMPACTION SHALL BE ADEQUATE TO SUPPORT THE PROPOSED USE OF AREAS IN WHICH FILL SOILS ARE PLACED. THE CONTRACTOR SHALL HIRE A GEOTECHNICAL ENGINEER TO TEST AND VERIFY THAT COMPACTION IS ADEQUATE FOR THE PROPOSED USE OF IN THE AREA OF FILL PLACEMENT.
- ALL ASPECTS OF THIS PROJECT SHALL BE IN FULL COMPLIANCE WITH CURRENT ADA STANDARDS. IF THE CONTRACTOR NOTES ANY ASPECTS OF THE PROJECT WHICH ARE NOT IN COMPLIANCE, THE ENGINEER SHALL BE NOTIFIED PRIOR TO ANY FURTHER WORK BEING PERFORMED. ANY WORK PERFORMED AFTER THE CONTRACTOR NOTES SUCH A NON COMPLIANCE IS SUBJECT TO REMOVAL AND REPAIR AT THE CONTRACTOR'S EXPENSE.
- THE CONTRACTOR OR OWNER SHALL EMPLOY A GEOTECHNICAL ENGINEER TO TEST ALL EMBANKMENTS AND FILL PLACEMENT FOR PROPER COMPACTION. PROPER COMPACTION SHALL BE PER THE GEOTECHNICAL ENGINEER'S RECOMMENDATIONS OR THESE PLANS, WHICHEVER IS MORE STRINGENT. EMBANKMENTS FOR PONDS SHALL BE PLACED IN 6 INCH LOOSE LAYERS AND SHALL BE COMPACTED TO A DENSITY OF NO LESS THAN 95% OF THE STANDARD PROCTOR MAXIMUM DENSITY AT A MOISTURE IN ACCORDANCE WITH ASTM D698. THE CONTRACTOR SHALL TAKE PHOTOGRAPHS OF THE OUTLET STRUCTURE AT ALL AT ALL PHASES OF INSTALLATION AND SHALL RETAIN WITH GEOTECHNICAL TESTING DATA. THE CONTRACTOR SHALL ALSO RETAIN ALL SHIPPING RECORDS AND SPECIFICATIONS FOR THE OUTLET STRUCTURE MATERIALS AND STRUCTURES. ALL OF THE ABOVE DATA MAY BE REQUIRED AS PART OF THE MUNICIPALITY AS-BUILT PROCESS AND SHALL BE MADE AVAILABLE TO THE ENGINEER UPON REQUEST. THE CONTRACTOR AND OWNER SHALL HAVE DOCUMENTATION OF THESE TESTS AVAILABLE UPON REQUEST.
- RETAINING WALLS SHOWN HEREIN SHALL BE DESIGNED BY A QUALIFIED PROFESSIONAL ENGINEER WITH EXPERIENCE DESIGNING RETAINING WALLS. AT LEAST 14 DAYS PRIOR TO BEGINNING CONSTRUCTION OF RETAINING WALLS, THE CONTRACTOR SHALL CONTACT THE OWNER'S GEOTECHNICAL ENGINEER TO SCHEDULE AND COORDINATE ALL APPROPRIATE INSPECTIONS, TESTING, AND VERIFICATION NECESSARY DURING RETAINING WALL CONSTRUCTION. THE GEOTECHNICAL ENGINEER SHALL PROVIDE CONTINUOUS INSPECTION, TESTING AND VERIFICATION FOR THE DURATION OF RETAINING WALL CONSTRUCTION. PROPER SCHEDULING, EXECUTION, AND RECORD KEEPING FOR ALL REQUIRED INSPECTIONS, TESTING, AND VERIFICATION SHALL BE THE RESPONSIBILITY OF THE CONTRACTOR. SUCH RECORDS SHALL BE RETAINED AND SHALL BE PROVIDED TO THE OWNER AND BASS, NIXON & KENNEDY, INC. ALL MONITORING, TESTING, AND VERIFICATION SHALL CONFORM TO THE MOST RECENT VERSION OF THE NC BUILDING CODE CHAPTER 18, SECTION 1806 OR THE WALL DESIGN ENGINEER'S SPECIFICATIONS, WHICHEVER IS MORE STRINGENT.



QUANTITY SUMMARY

PHASE NUMBER(S)	1
NUMBER OF LOT(S)	1
LOT NUMBER(S) BY PHASE	N/A
NUMBER OF UNITS	196
LIVABLE BUILDINGS	6
OPEN SPACE (AC)	1.92
NUMBER OF OPEN SPACE LOTS	N/A
PUBLIC WATER (LF)	875
PRIVATE SEWER (LF)	550
PUBLIC STREET (LF)	0
PUBLIC SIDEWALK (LF)	255

ENGINEER:

BNK

BASS, NIXON & KENNEDY, INC.
CONSULTING ENGINEERS

6310 CHAPEL HILL ROAD, SUITE 250
RALEIGH, NORTH CAROLINA 27607
TELEPHONE: (919) 851-4422
FAX: (919) 851-8968

CERTIFICATION NUMBERS: NCBELS (C-0110)
NCBOLA (C-0267)

CONTACT: MARTY D. BIZZELL, PE, CPESC
EMAIL: Marty.Bizzell@BNKinc.com



EROSION CONTROL, STORMWATER AND FLOODPLAIN MANAGEMENT

APPROVED

EROSION CONTROL ☐ S-

STORMWATER MGMT. ☐ S-

FLOOD STUDY ☐ S-

DATE _____




ENVIRONMENTAL CONSULTANT SIGNATURE

CITY OF RALEIGH - PLANS AUTHORIZED FOR CONSTRUCTION

Electronic Approval: This approval is being issued electronically. This approval is valid only upon the signature of a City of Raleigh Review Officer below. The City will retain a copy of the approved plans. Any work authorized by this approval must proceed in accordance with the plans kept on file with the City. This electronic approval may not be edited once issued. Any modification to this approval once issued will invalidate this approval.

City of Raleigh Development Approval

Raleigh Water Review Officer

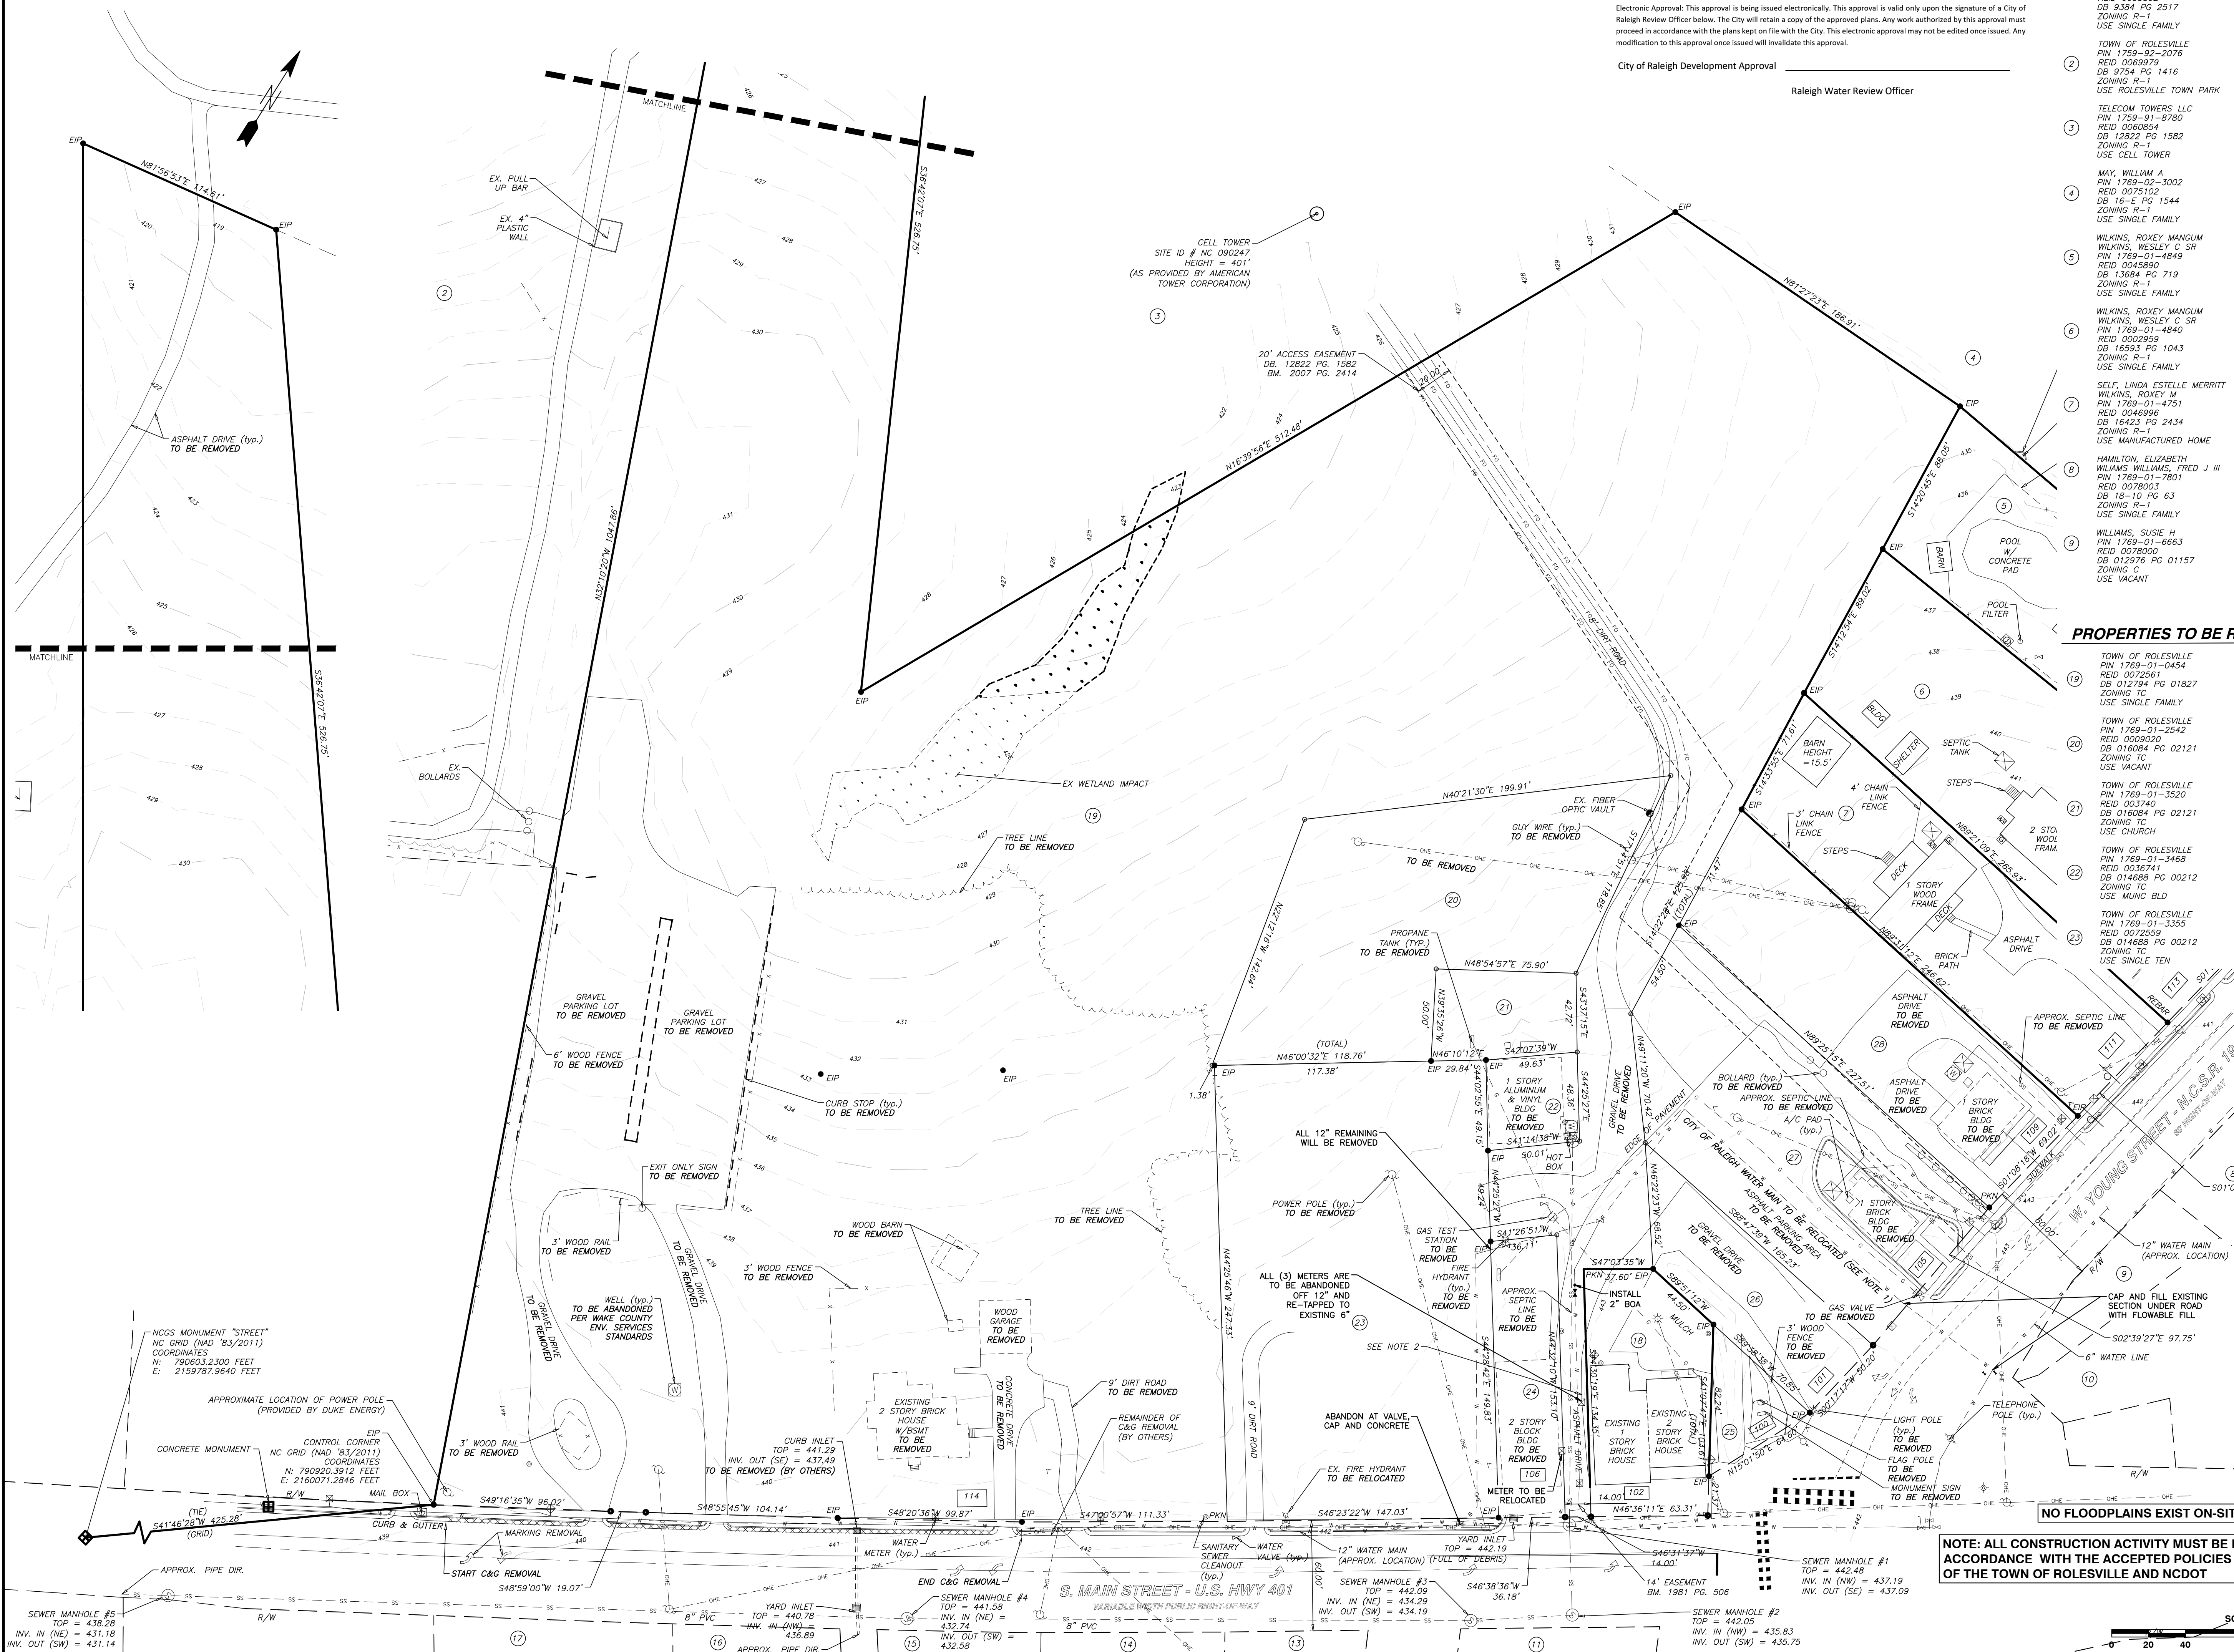


PROPERTIES TO BE RECOMBINED

- | | | | |
|----|--|----|--|
| 19 | TOWN OF ROLESVILLE
PIN 1769-01-0454
REID 0009020
DB 012794 PG 01827
ZONING TC
USE SINGLE FAMILY | 24 | TOWN OF ROLESVILLE
PIN 1769-01-2542
REID 0009020
DB 016084 PG 02121
ZONING TC
USE VACANT |
| 20 | TOWN OF ROLESVILLE
PIN 1769-01-3520
REID 003740
DB 016084 PG 02121
ZONING TC
USE CHURCH | 25 | TOWN OF ROLESVILLE
PIN 1769-01-5454
REID 0009020
DB 016074 PG 01997
ZONING TC
USE VACANT |
| 21 | TOWN OF ROLESVILLE
PIN 1769-01-3468
REID 0036741
DB 014688 PG 00212
ZONING TC
USE MUNC BLD | 26 | TOWN OF ROLESVILLE
PIN 1769-01-5408
REID 0008897
DB 011527 PG 00426
ZONING TC
USE VACANT |
| 22 | TOWN OF ROLESVILLE
PIN 1769-01-3353
REID 0022559
DB 014688 PG 00212
ZONING TC
USE SINGLE TEN | 27 | TOWN OF ROLESVILLE
PIN 1769-01-4576
REID 0012576
DB 005741 PG 00921
ZONING TC
USE MUNC BLD |
| 23 | TOWN OF ROLESVILLE
PIN 1769-01-4654
REID 0006993
DB 016026 PG 00705
ZONING TC
USE SINGL TEN | 28 | TOWN OF ROLESVILLE
PIN 1769-01-4654
REID 0006993
DB 016026 PG 00705
ZONING TC
USE SINGL TEN |

- NOTES:
- EXISTING WATER MAIN TO REMAIN ACTIVE UNTIL THE PROPOSED WATER LINE IS INSTALLED, TESTED, AND READY TO BE ACTIVE.
 - SERVICES TO EXISTING BUILDINGS TO REMAIN IN PLACE THROUGHOUT CONSTRUCTION. CONTRACTOR TO VERIFY SERVICE LOCATIONS.
 - EXISTING WELLS AND SEPTIC SYSTEMS TO BE ABANDONED PER ALL WAKE COUNTY ENVIRONMENTAL SERVICES, STANDARDS & SPECIFICATIONS.

NOTE: ALL CONSTRUCTION ACTIVITY MUST BE IN ACCORDANCE WITH THE ACCEPTED POLICIES OF THE TOWN OF ROLESVILLE AND NCDOT

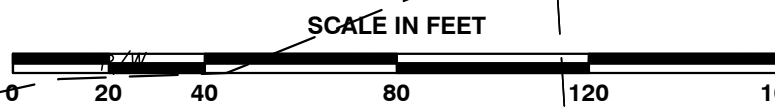

BASS, NIXON & KENNEDY, INC.
CONSULTING ENGINEERS
6310 CHAPEL HILL ROAD, SUITE 250, RALEIGH, NC 27607
TELEPHONE: (919) 881-4422 FAX: (919) 881-8888
CERTIFICATION NUMBERS: NCBELS (C-0267)

PROGRESS	DATE	BY	DESCRIPTION
03/19/17			

COBBLESTONE VILLAGE
MIXED USE DEVELOPMENT
TOWN OF ROLESVILLE, WAKE COUNTY, NORTH CAROLINA

SHEET
C0.1

TOWN OF ROLESVILLE PROJECT NO.


BASS, NIXON & KENNEDY, INC.
CONSULTING ENGINEERS
6310 CHAPEL HILL, ROAD, SUITE 250, RALEIGH, NC 27607
TELEPHONE: (919)851-4422 FAX: (919)851-8968
CERTIFICATION NUMBERS: NOBELS (C-0110); NCOLA (C-0267)

[illegible]

**COBBLESTONE
VILLAGE
MIXED USE DEVELOPMENT**
TOWN OF ROLESVILLE, WAKE COUNTY, NORTH CAROLINA

SHEET
C1.2

NOT RELEASED FOR CONSTRUCTION OR BID SOLICITATION

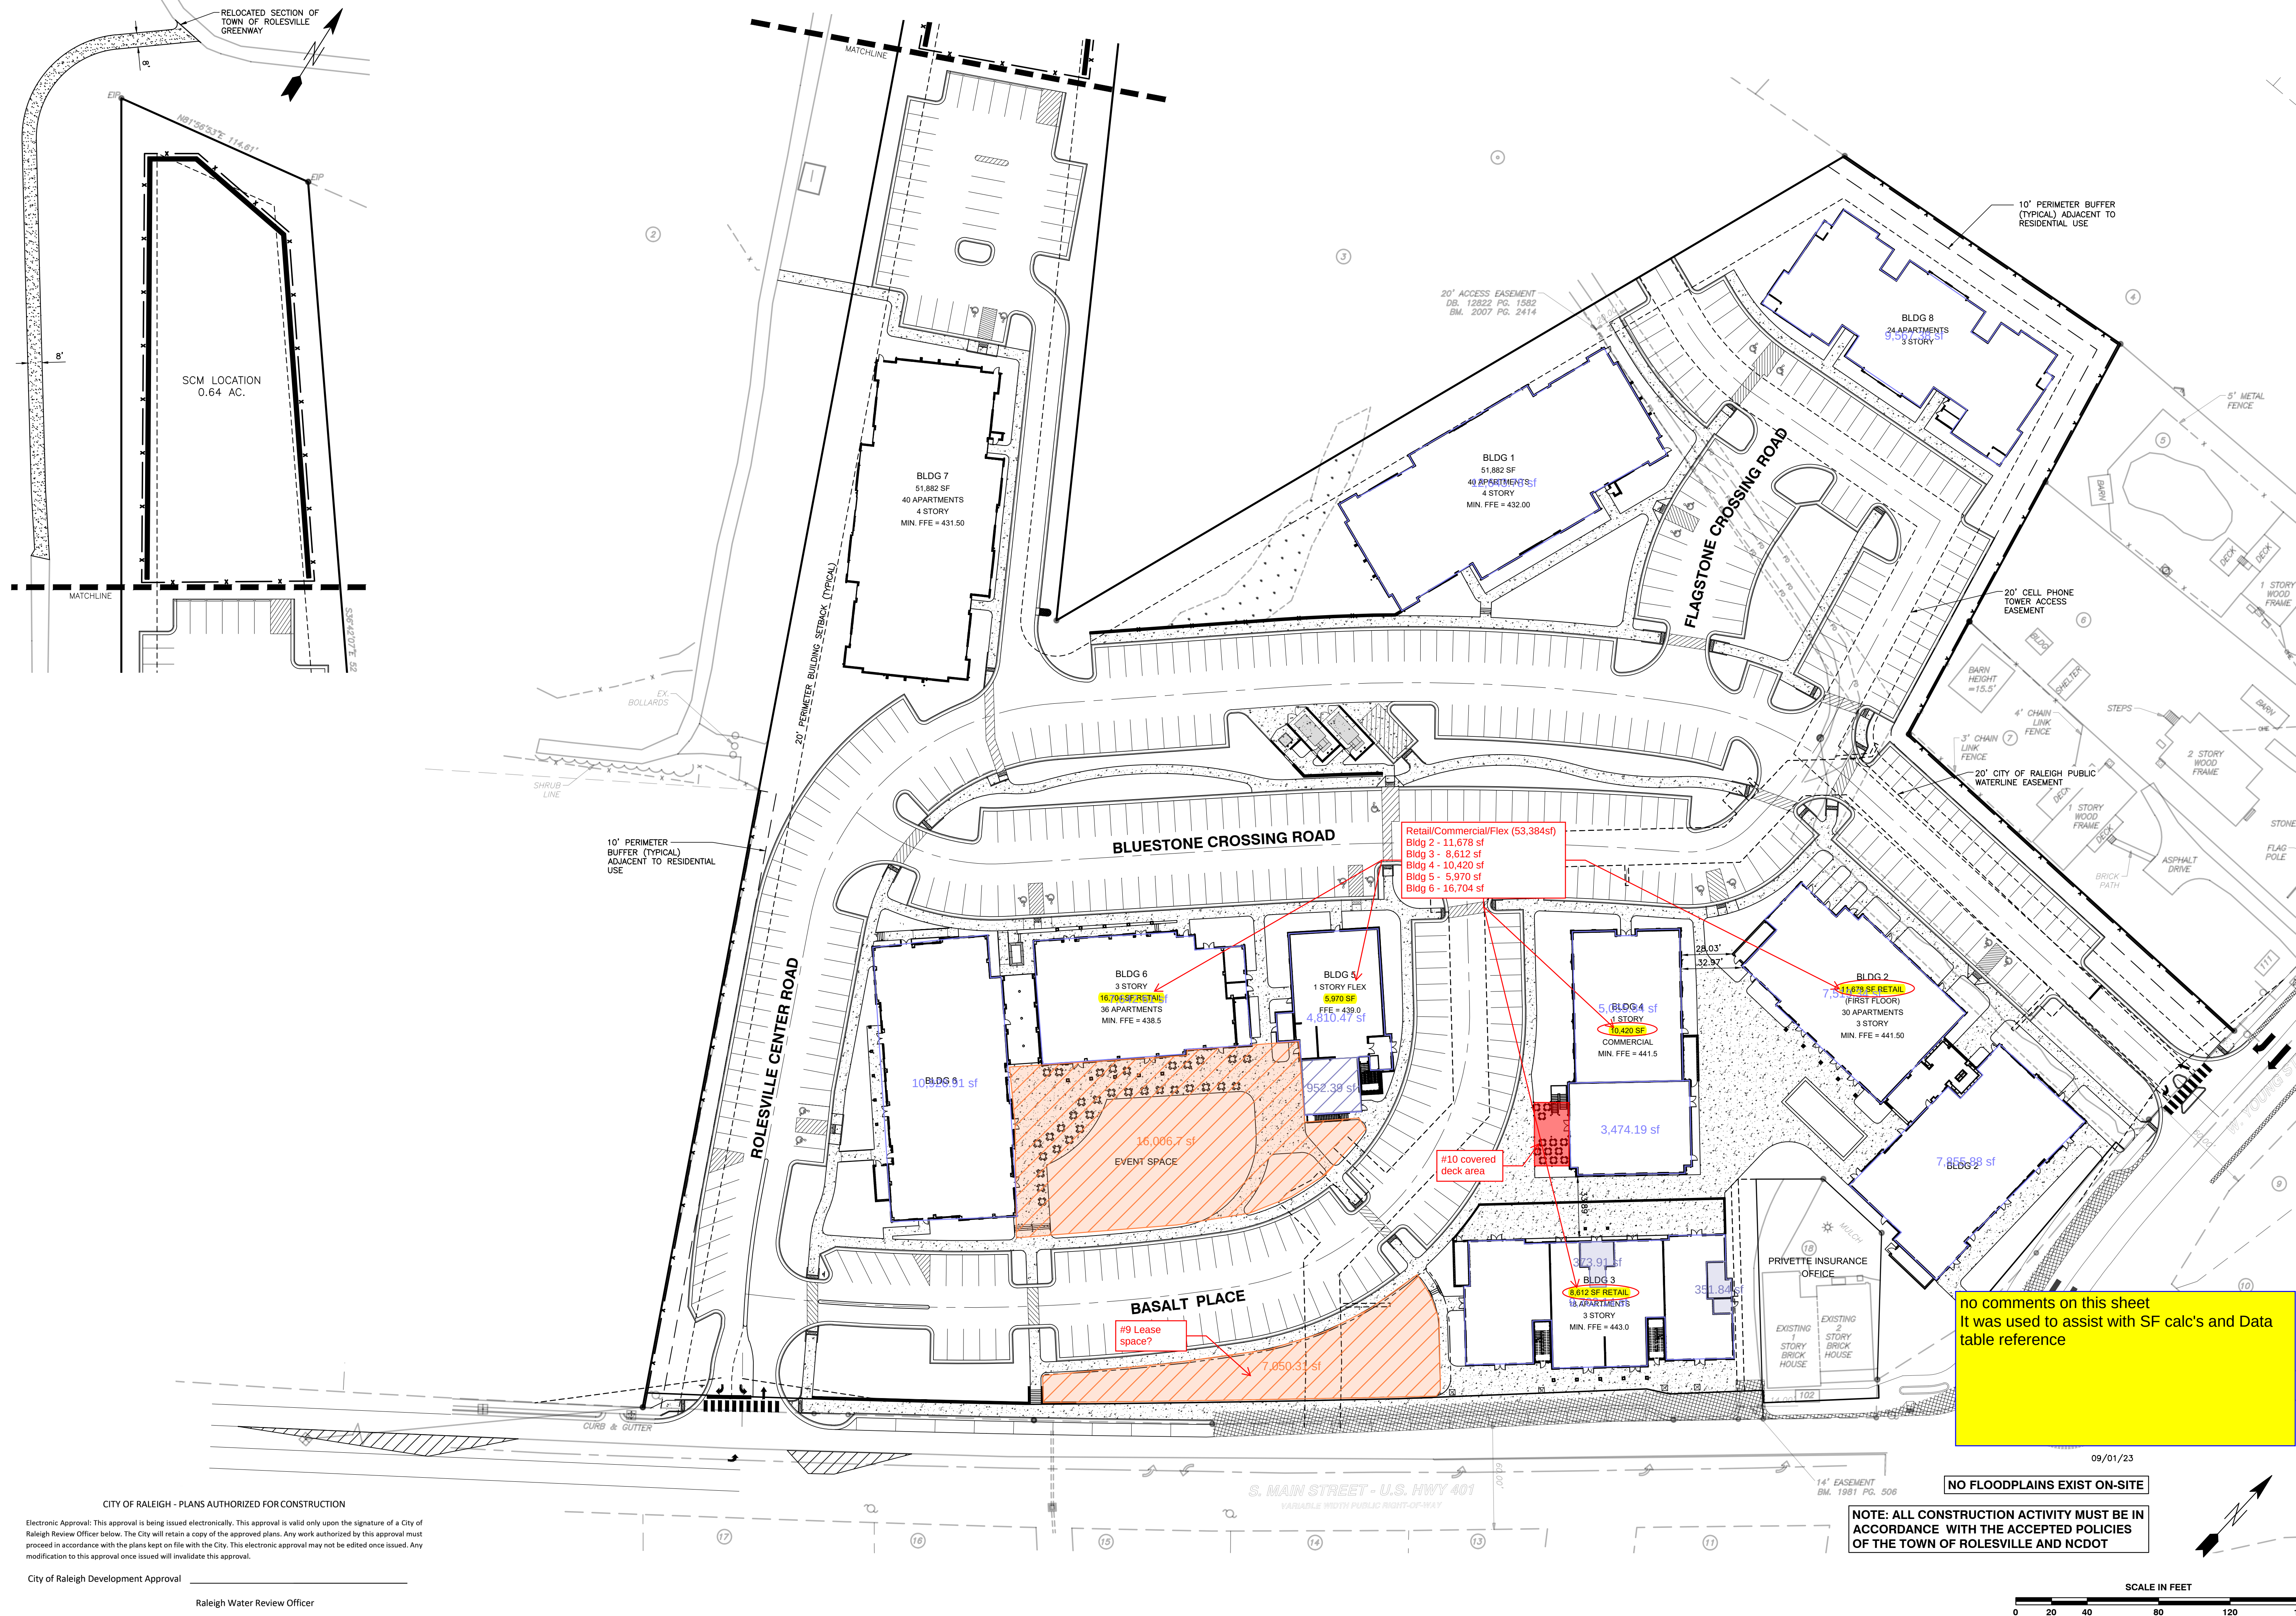

CITY OF RALEIGH - PLANS AUTHORIZED FOR CONSTRUCTION

Electronic Approval: This approval is being issued electronically. This approval is valid only upon the signature of a City of Raleigh Review Officer below. The City will retain a copy of the approved plans. Any work authorized by this approval must proceed in accordance with the plans kept on file with the City. This electronic approval may not be edited once issued. Any modification to this approval once issued will invalidate this approval.

City of Raleigh Development Approval

Raleigh Water Review Officer

NO FLOODPLAINS EXIST ON-SITE

NOTE: ALL CONSTRUCTION ACTIVITY MUST BE IN ACCORDANCE WITH THE ACCEPTED POLICIES OF THE TOWN OF ROLESVILLE AND NCDOT

09/01/23

SCALE IN FEET

Age Group	No	Yes	Don't know	No answer	Other
0-20	10%	10%	10%	10%	10%
21-40	10%	10%	10%	10%	10%
41-60	10%	10%	10%	10%	10%
61-80	10%	10%	10%	10%	10%
81+	10%	10%	10%	10%	10%

TOWN OF ROLESVILLE PROJECT NO

CITY OF RALEIGH - PLANS AUTHORIZED FOR CONSTRUCTION

Electronic Approval: This approval is being issued electronically. This approval is valid only upon the signature of a City of Raleigh Review Officer below. The City will retain a copy of the approved plans. Any work authorized by this approval must proceed in accordance with the plans kept on file with the City. This electronic approval may not be edited once issued. Any modification to this approval once issued will invalidate this approval.

City of Raleigh Development Approval

Raleigh Water Review Officer

Public

Water Distribution / Extension System

The City of Raleigh consents to the connection and extension of the City's public water system as shown on this plan. The material and construction methods used for this project shall conform to the standards and specifications of the City's Public Utilities Handbook.

City of Raleigh
Public Utilities Department Permit # W-3879
Authorization to Construct See digital signature

Private

Sewer Collection / Extension System

The City of Raleigh consents to the connection to its public sewer system and extension of the private sewer collection system as shown on this plan. The material and construction methods used for this project shall conform to the standards and specifications of the City's Public Utilities Handbook.

City of Raleigh
Public Utilities Department Permit # S-4962 (P)
Authorization to Construct See digital signature

ATTENTION CONTRACTORS

The Construction Contractor responsible for the extension of water, sewer, and/or reuse, as approved in these plans, is responsible for contacting the Public Utilities Department at (919) 996-4540 at least twenty four hours prior to beginning any of their construction.

Failure to notify both City Departments in advance of beginning construction, will result in the issuance of monetary fines, and require reinstallation of any water or sewer facilities not inspected as a result of this notification failure.

Failure to call for Inspection, Install a Downstream Plug, have Permitted Plans on the Jobsite, or any other Violation of City of Raleigh Standards will result in a Fine and Possible Exclusion from future work in the City of Raleigh.

STANDARD UTILITY NOTES (as applicable):

- All materials & construction methods shall be in accordance with City of Raleigh design standards, details & specifications (reference: CORPUD Handbook, current edition)
- Utility separation requirements:
 - A distance of 100' shall be maintained between sanitary sewer & any private or public water supply source such as an impounded reservoir used as a source of drinking water. If adequate lateral separation cannot be achieved, remove sanitary sewer pipe shall be specified & installed to wateline specifications. However, the minimum separation shall not be less than 25' from a private well or 50' from a public well
 - When installing water &/or sewer mains, the horizontal separation between utilities shall be 10'. If this separation cannot be maintained due to existing conditions, the variation allowed is the water main in a separate trench with the elevation of the water main at least 18" above the top of the sewer & must be approved by the Public Utilities Director. All distances are measured from outside diameter to outside diameter
 - Where it is impossible to obtain proper separation, or anytime a sanitary sewer passes over a watermain, DIP materials or steel encasement extended 10' on each side of crossing must be specified & installed to wateline specifications
 - 5.0' minimum horizontal separation is required between all sanitary sewer & storm sewer facilities, unless DIP material is specified for sanitary sewer
 - Maintain 18" min. vertical separation at all watermain & RCP storm drain crossings; maintain 24" min. vertical separation at all sanitary sewer & RCP storm drain crossings. Where adequate separations cannot be achieved, specify DIP materials & a concrete cradle having 6" min. clearance (per CORPUD details W-41 & S-49)
 - All other underground utilities shall cross water & sewer facilities with 18" min. vertical separation required
- Any necessary field revisions are subject to review & approval of an amended plan &/or profile by the City of Raleigh Public Utilities Department prior to construction
- Contractor shall maintain continuous water & sewer service to existing residences & businesses throughout construction of project. Any necessary service interruptions shall be preceded by a 24 hour advance notice to the City of Raleigh Public Utilities Department
- 3.0' minimum cover is required on all water mains & sewer forcemains. 4.0' minimum cover is required on all reuse mains
- It is the developer's responsibility to abandon or remove existing water & sewer services not being used in redevelopment of a site unless otherwise directed by the City of Raleigh Public Utilities Department. This includes abandoning tap at main & removal of service from ROW or easement per CORPUD Handbook procedure
- Install 3/4" copper* water services with meters located at ROW or within a 2'x2' Wateline Easement immediately adjacent. *NOTE: it is the applicant's responsibility to properly size the water service for each connection to provide adequate flow & pressure*
- Install 4" PVC* sewer services @ 1.0% minimum grade with cleanouts located at ROW or easement line & spaced every 75 linear feet maximum
- Pressure reducing valves are required on all water services exceeding 80 psi; backwater valves are required on all sanitary sewer services having building drains lower than 1.0' above the next upstream manhole
- All environmental permits applicable to the project must be obtained from NCDWQ, USACE, &/or FEMA for any riparian buffer, wetland &/or floodplain impacts (respectively) prior to construction.
- NCDOT / Railroad Encroachment Agreements are required for any utility work (including main extensions & service taps) within state or railroad ROW prior to construction
- Grease Interceptor / Oil Water Separator sizing calculations & installation specifications shall be approved by the CORPUD FOG Program Coordinator prior to issuance of a Building Permit. Contact Tim Besley at (919) 996-2334 or timothy.besley@raleighnc.gov for more information
- Cross-connection control protection devices are required based on degree of health hazard involved as listed in Appendix-B of the Rules Governing Public Water Systems in North Carolina. These guidelines are the minimum requirements. The devices shall meet American Society of Sanitary Engineering (ASSE) standards or be on the University of Southern California approval list. The devices shall be installed and tested (both initial and periodic testing thereafter) in accordance with the manufacturer's recommendations or the local cross-connection control program, whichever is more stringent. Contact Joanie Hartley at (919) 996-5923 or joanie.hartley@raleighnc.gov for more information

NOTES:

- FOR BUILDING SEWER PLUMBING THE FURTHEST MAIN UNDER SLAB UPSET 1.5' BELOW FFE.
- BACKFLOW PREVENTERS TO BE LOCATED INSIDE OF BUILDINGS 2, 3, 4, 5, & 6.

Highlighted items are for ID items. only need to reference comment notes

NOTE: ALL CONSTRUCTION ACTIVITY MUST BE IN ACCORDANCE WITH THE ACCEPTED POLICIES OF THE TOWN OF ROLESVILLE AND NCDOT

NO FLOODPLAINS EXIST ON-SITE

SCALE IN FEET

0 20 40 80 120 160

B N K

BASS, NIXON & KENNEDY, INC.

CONSULTING ENGINEERS

6310 CHAPEL HILL ROAD, SUITE 250, RALEIGH, NC 27607

TELEPHONE: (919) 981-4422 FAX: (919) 981-6868

CERTIFICATION NUMBERS: NCBELS (C-0110); NCBOLA (C-0267)

PROGRESS	DATE	BY	DESCRIPTION	REVISIONS
03-19157				

UTILITY PLAN

NO. DATE

CHK BY: MDB

SCALE: 1" = 40'

TOWN OF ROLESVILLE, WAKE COUNTY, NORTH CAROLINA

COBBLESTONE VILLAGE

MIXED USE DEVELOPMENT

SHEET C2.1

TOWN OF ROLESVILLE PROJECT NO.

NOT RELEASED FOR CONSTRUCTION OR BID SOLICITATION


Electronic Approval: This approval is being issued electronically. This approval is valid only upon the signature of a City of Raleigh Review Officer below. The City will retain a copy of the approved plans. Any work authorized by this approval must proceed in accordance with the plans kept on file with the City. This electronic approval may not be edited once issued. Any modification to this approval once issued will invalidate this approval.

City of Raleigh Development Approval


Raleigh Water Review Officer

Structure	d _o (ft)	Velocity (fps)	Length (ft)	Width (ft)	Depth (in)	Type	d ₅₀
FES 1	2.00	7.4	12	6	22	Class 'B'	6" - 13"
FES 3	3.00	6.5	18	9	22	Class 'B'	6" - 13"

* Per NYDoT Dissipator Schedule Fig.1



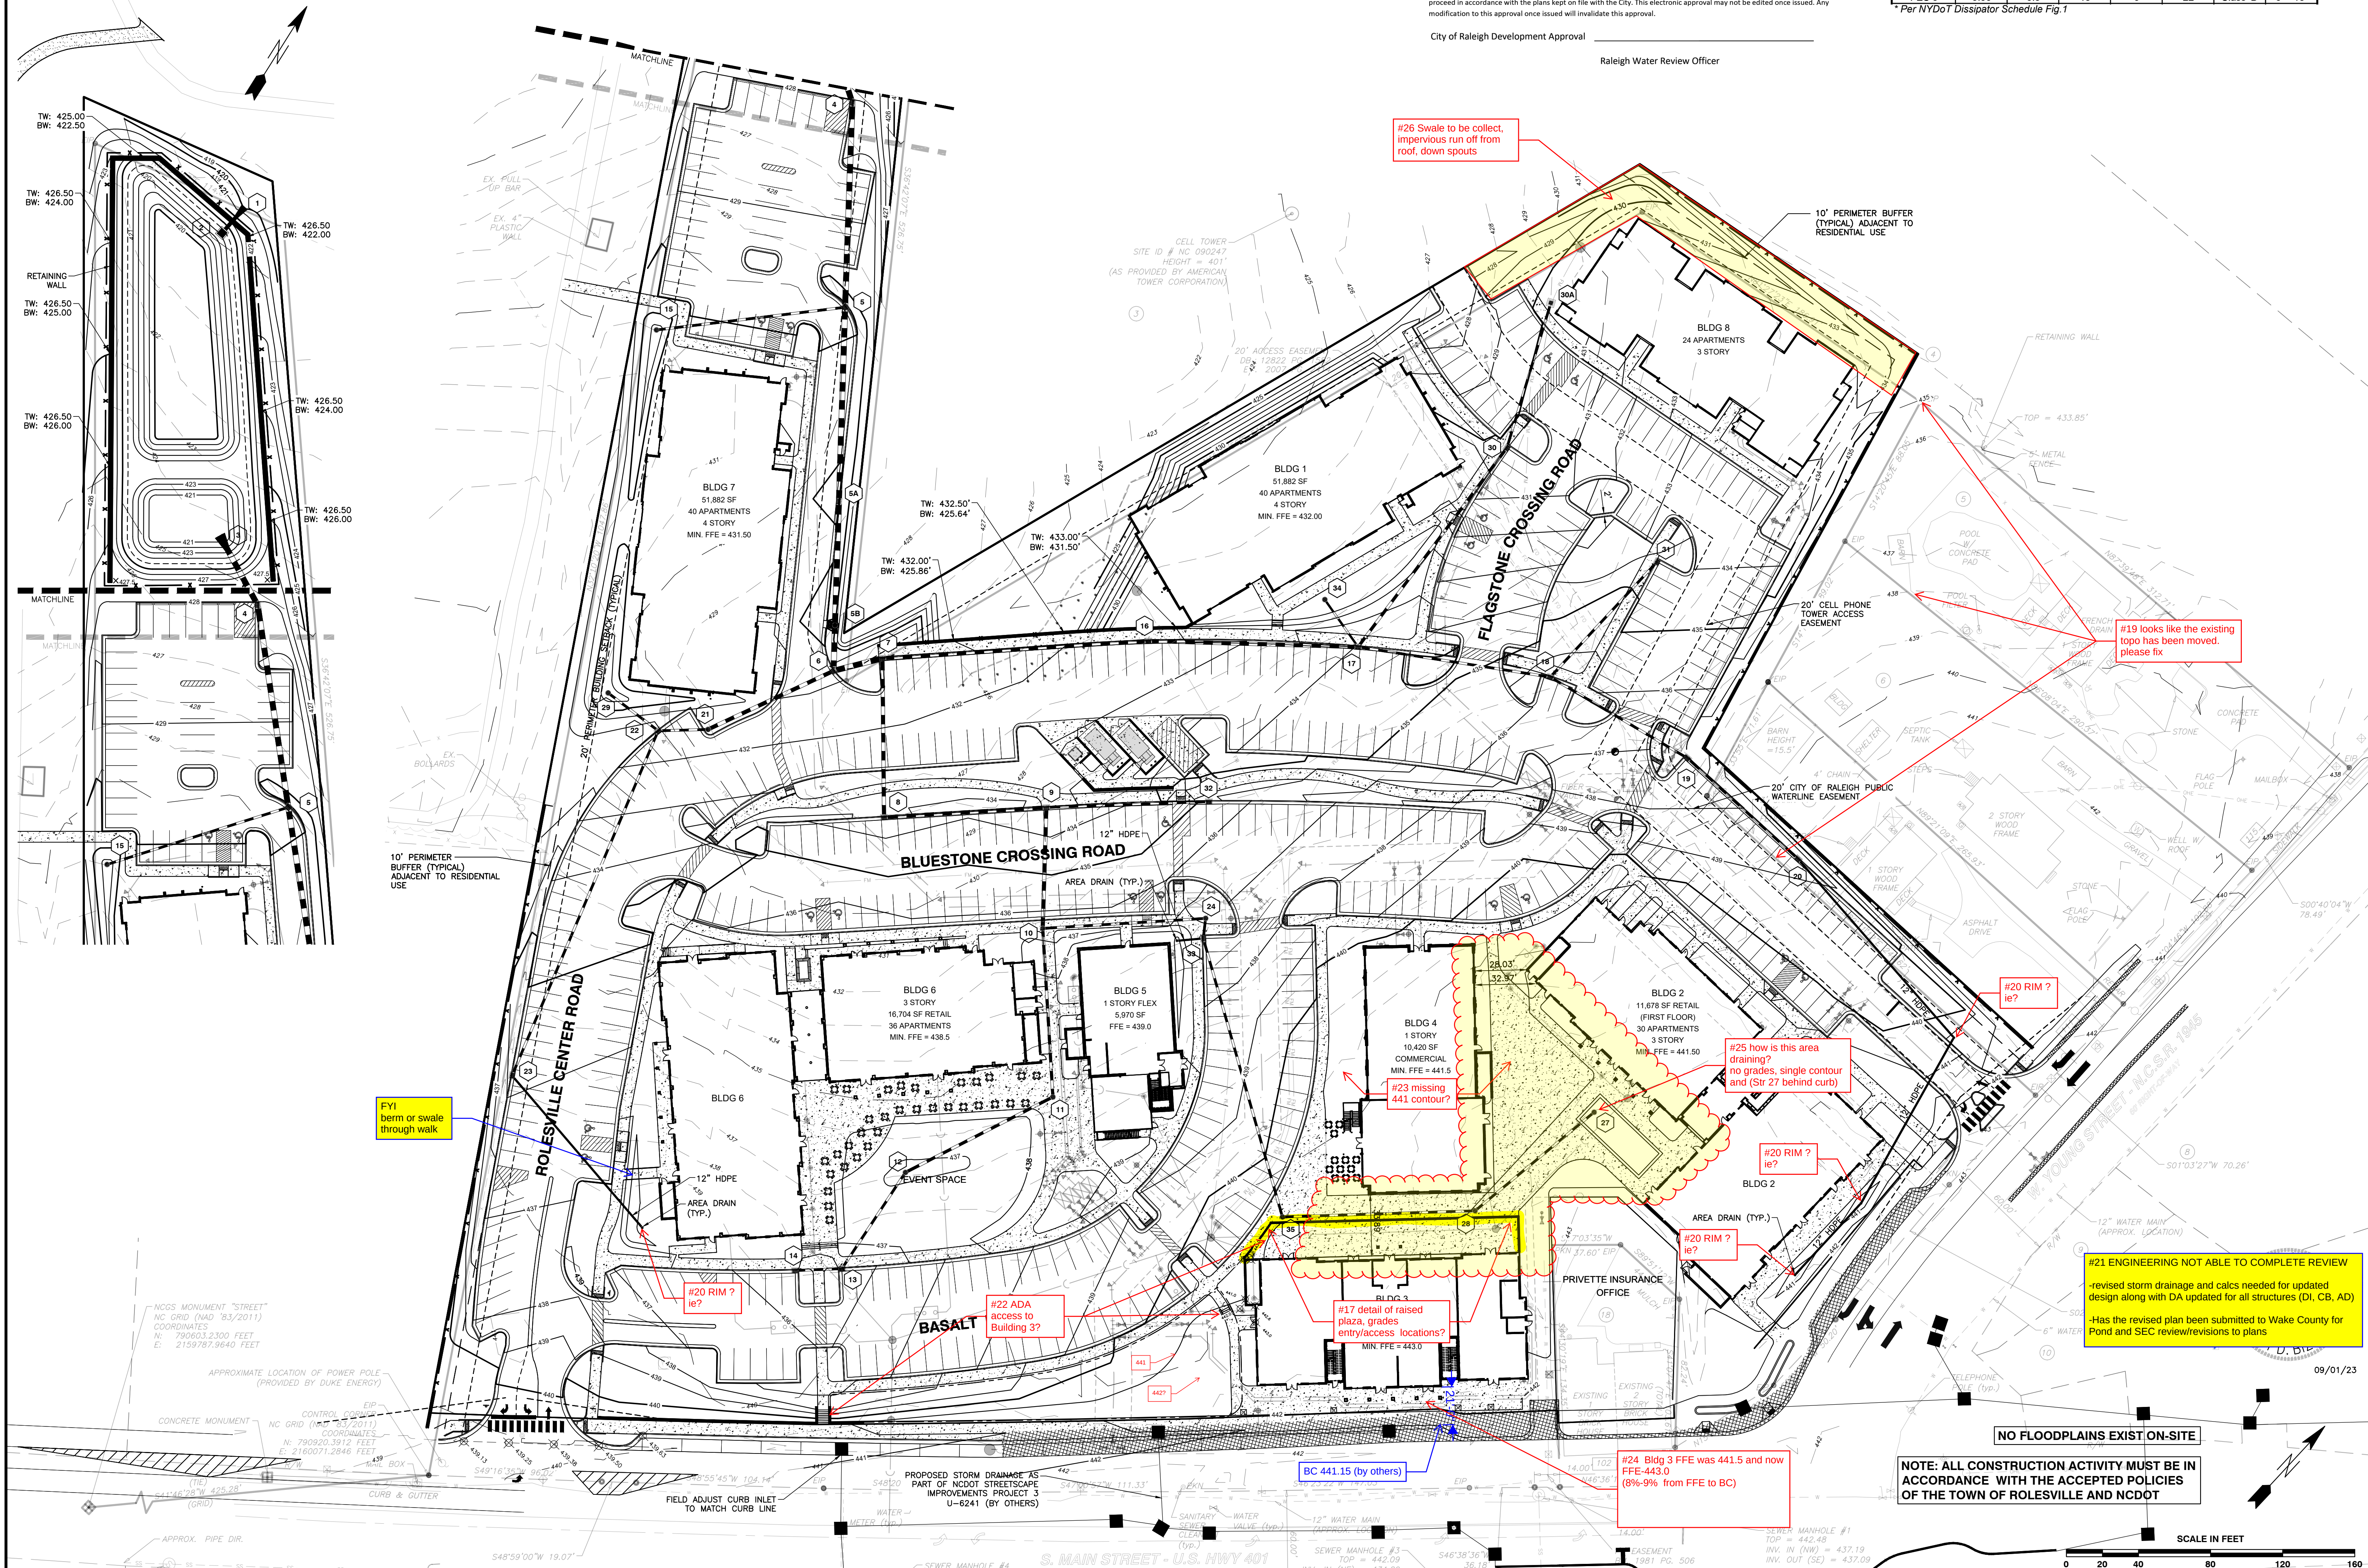


TOWN OF ROLESVILLE PROJECT NO

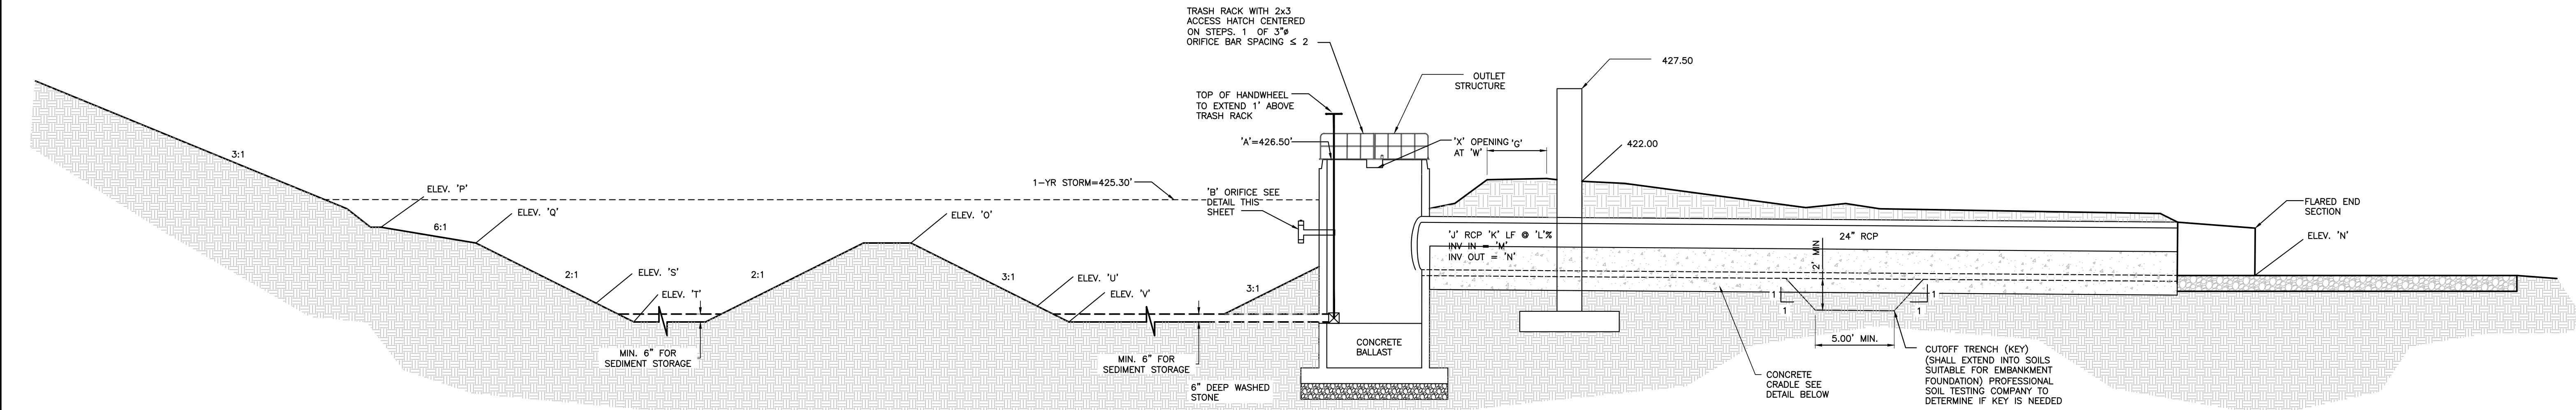

CROSS-SECTION OF WET POND A-A


NTS

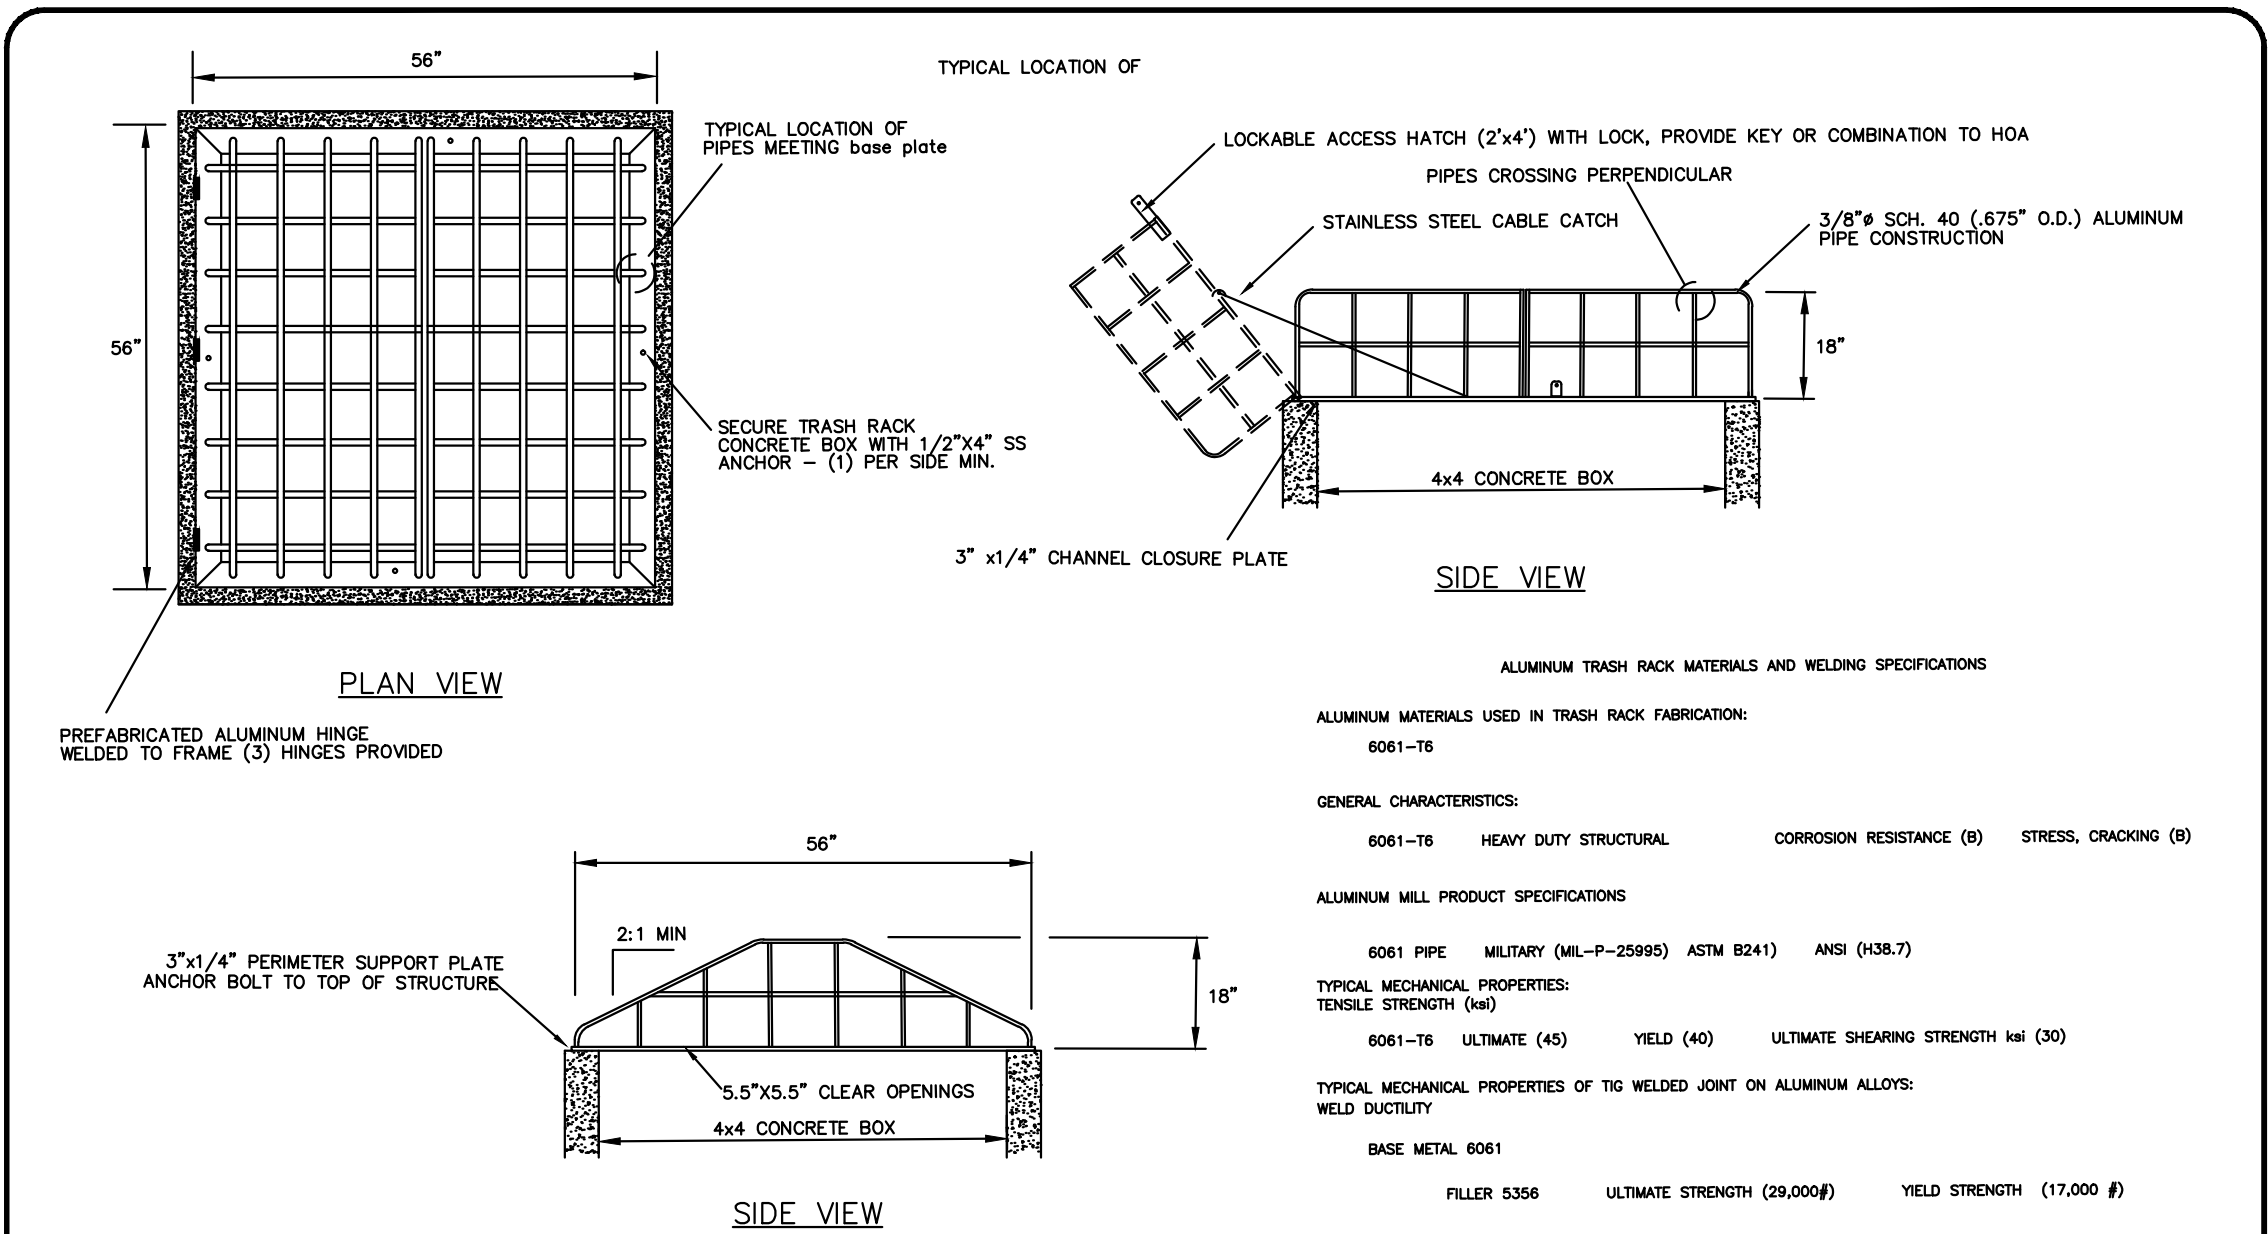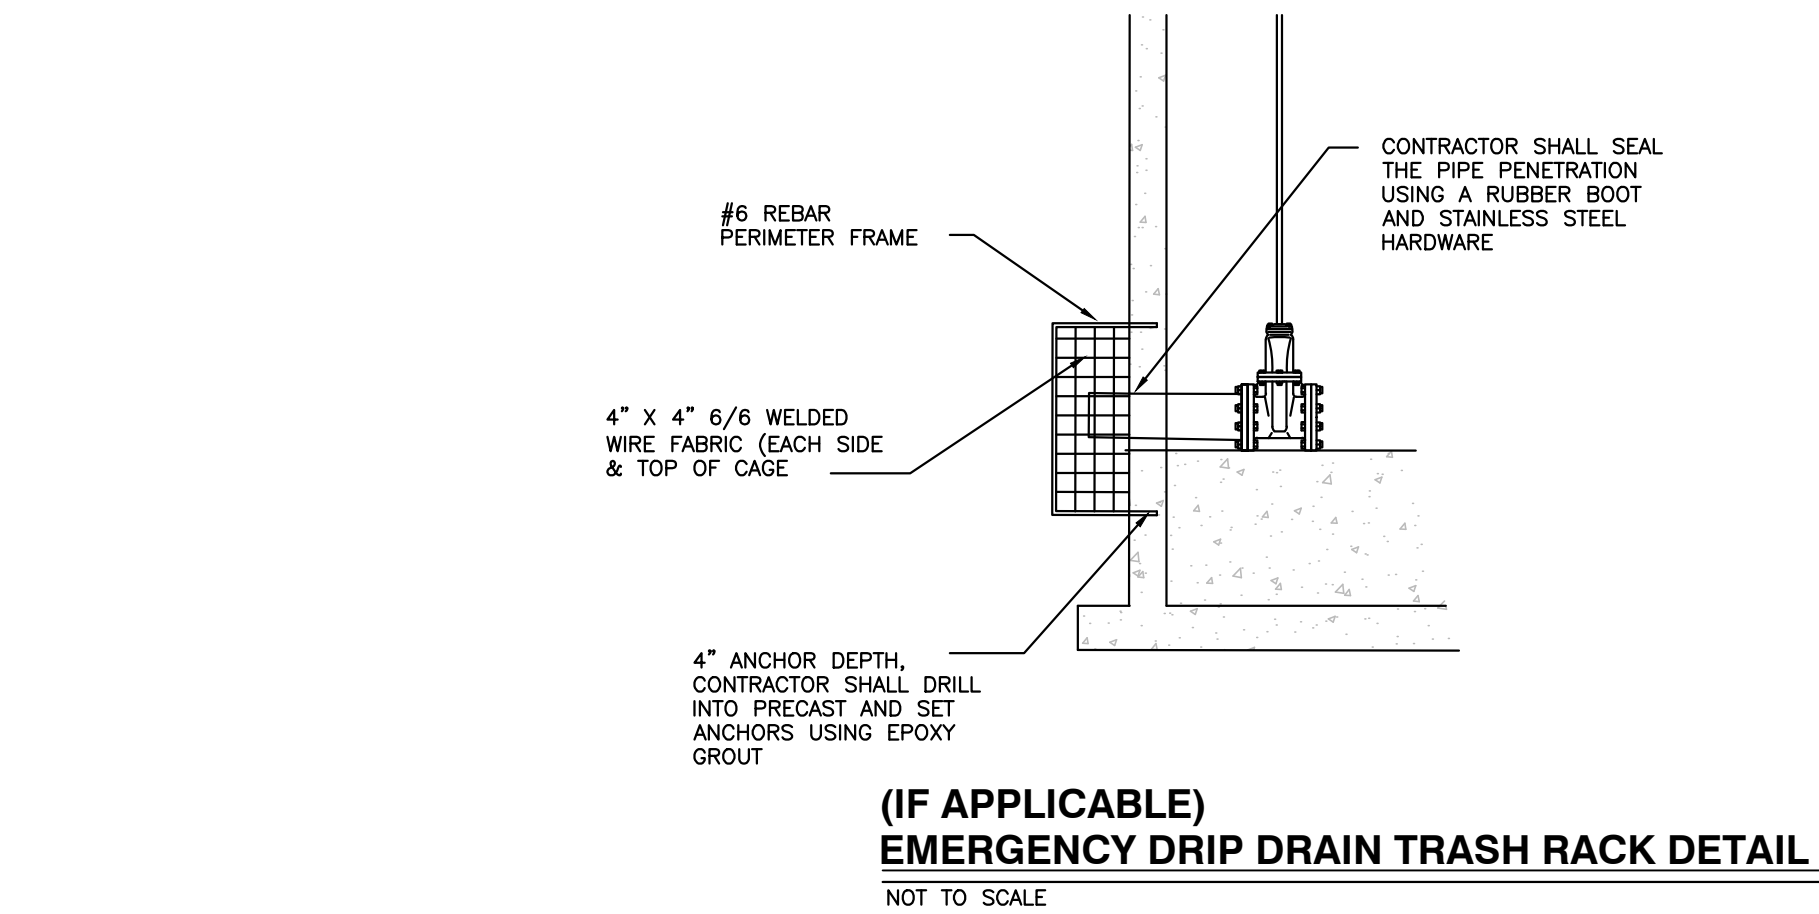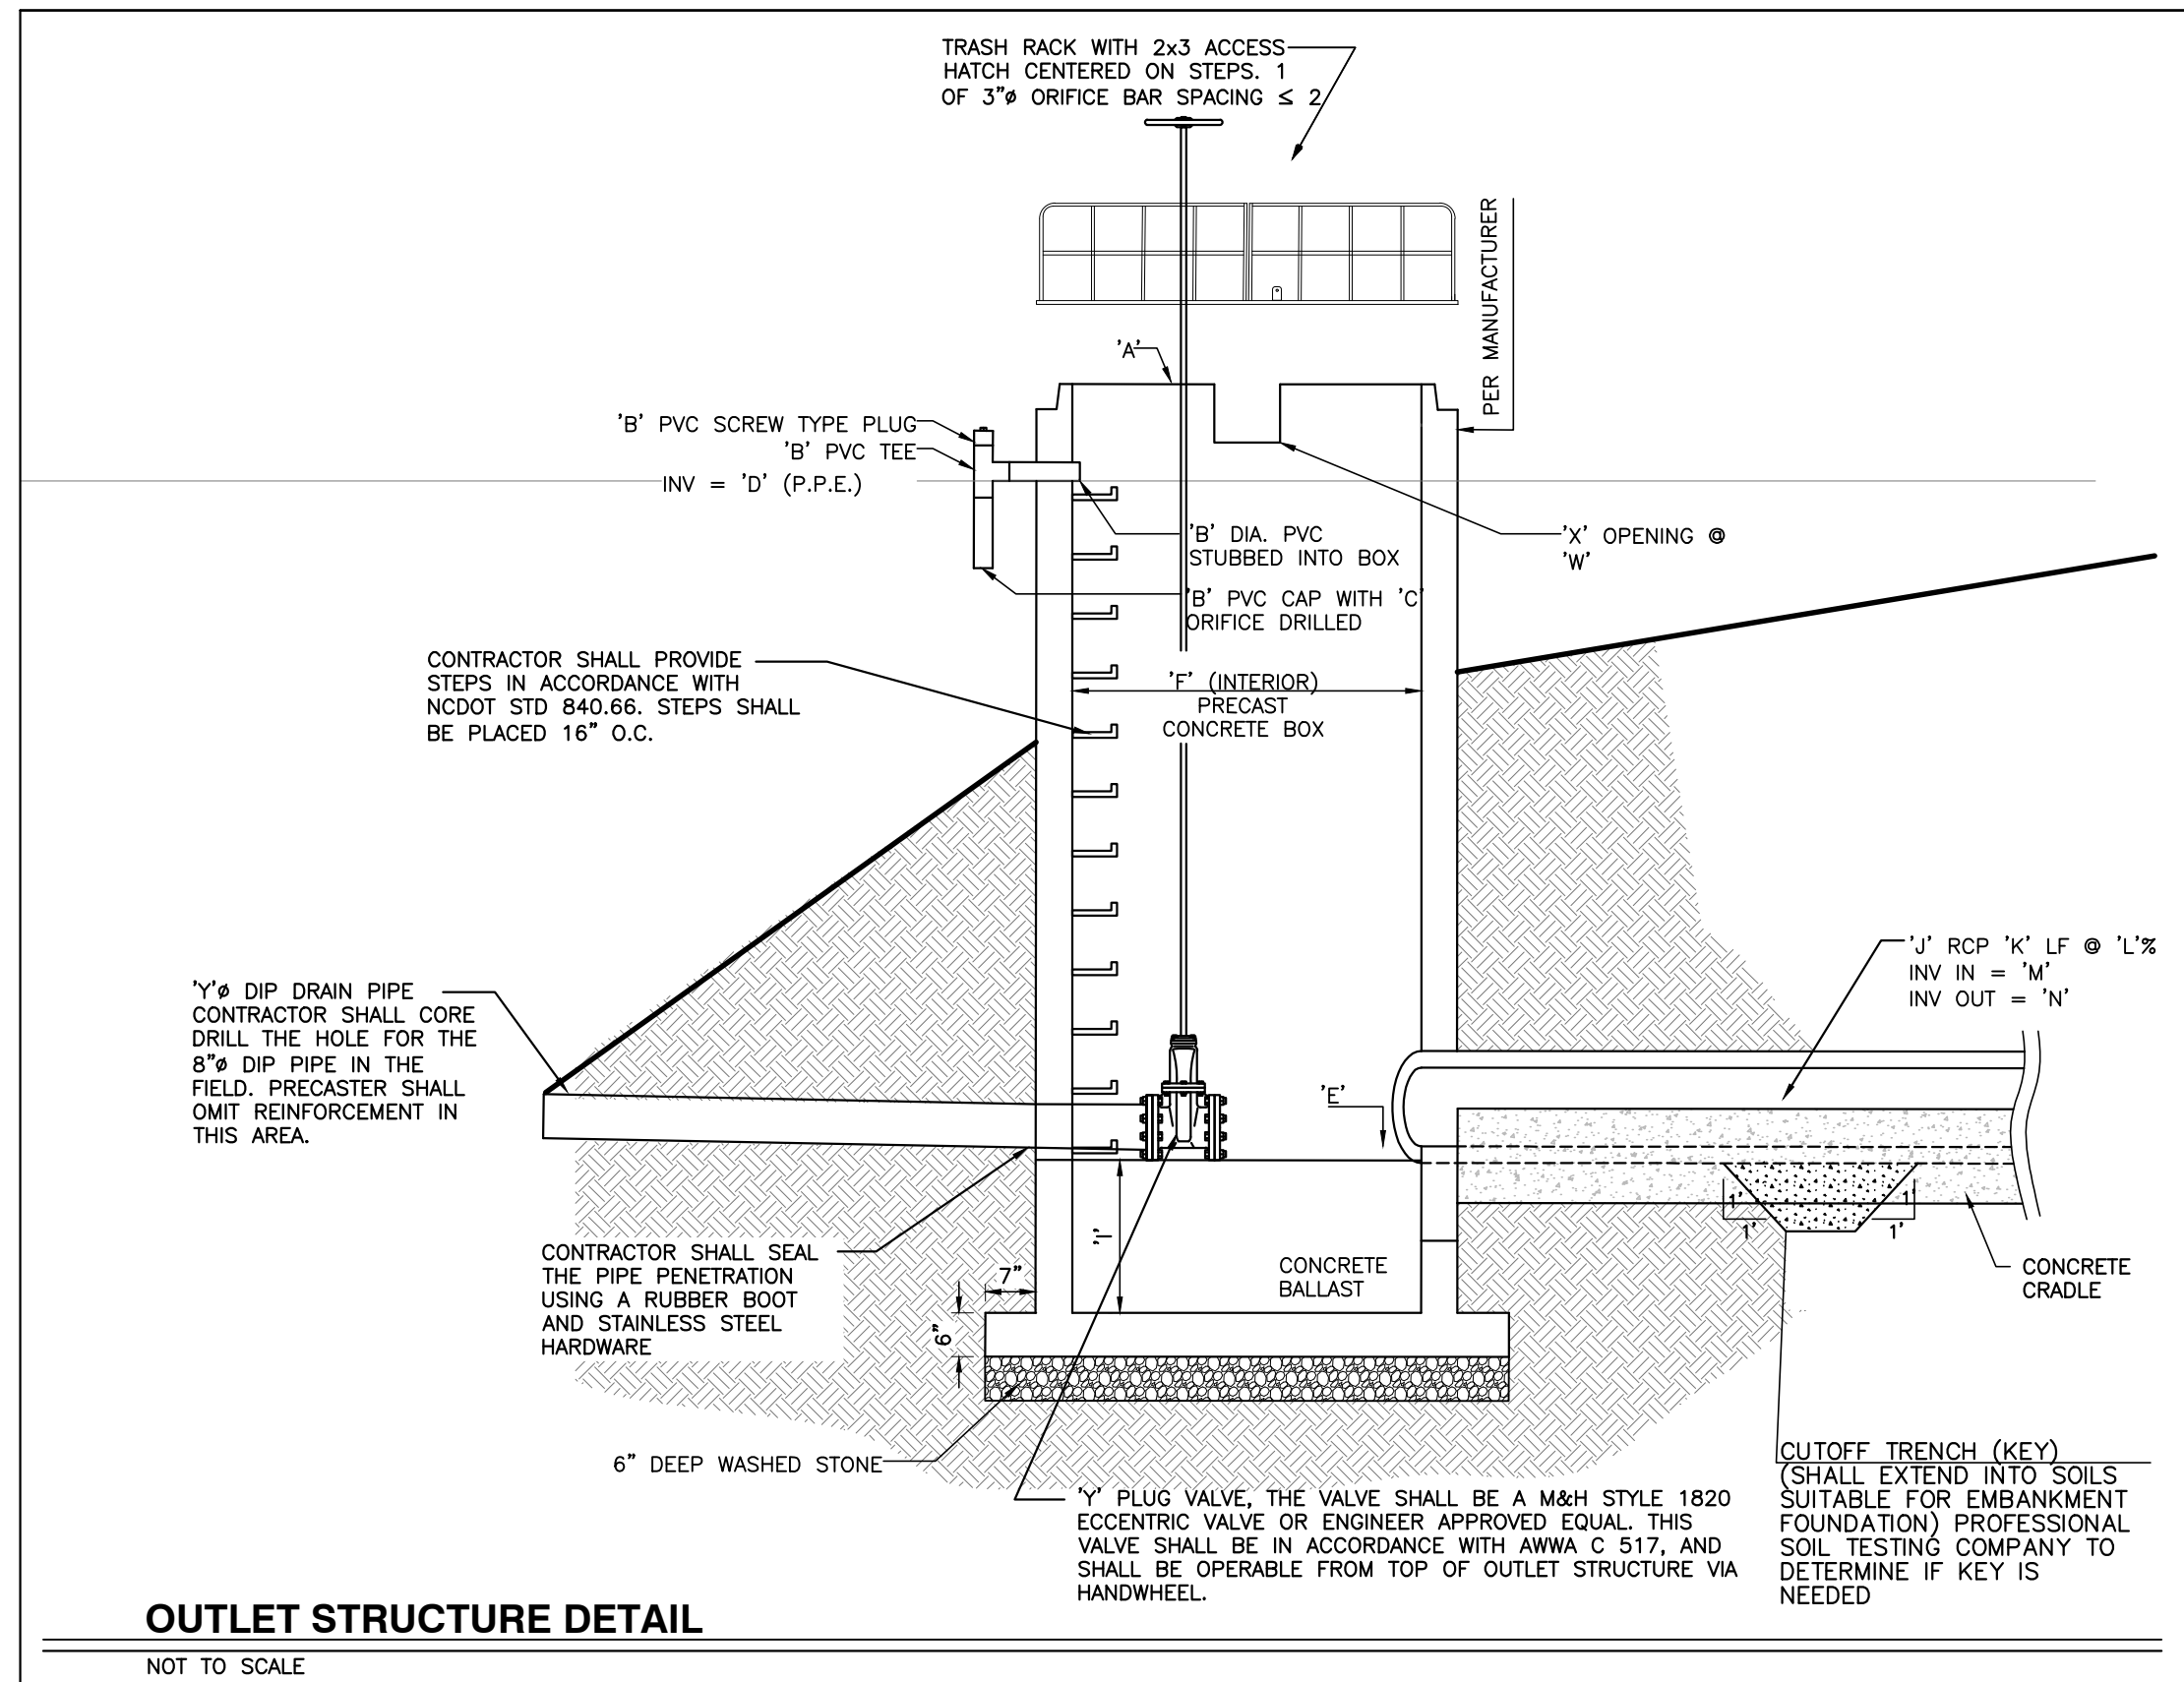

TRASH RACK SUBMITTAL - Aluminum Trashrack for 4x4 Box

TRASH RACK DETAIL


NTS

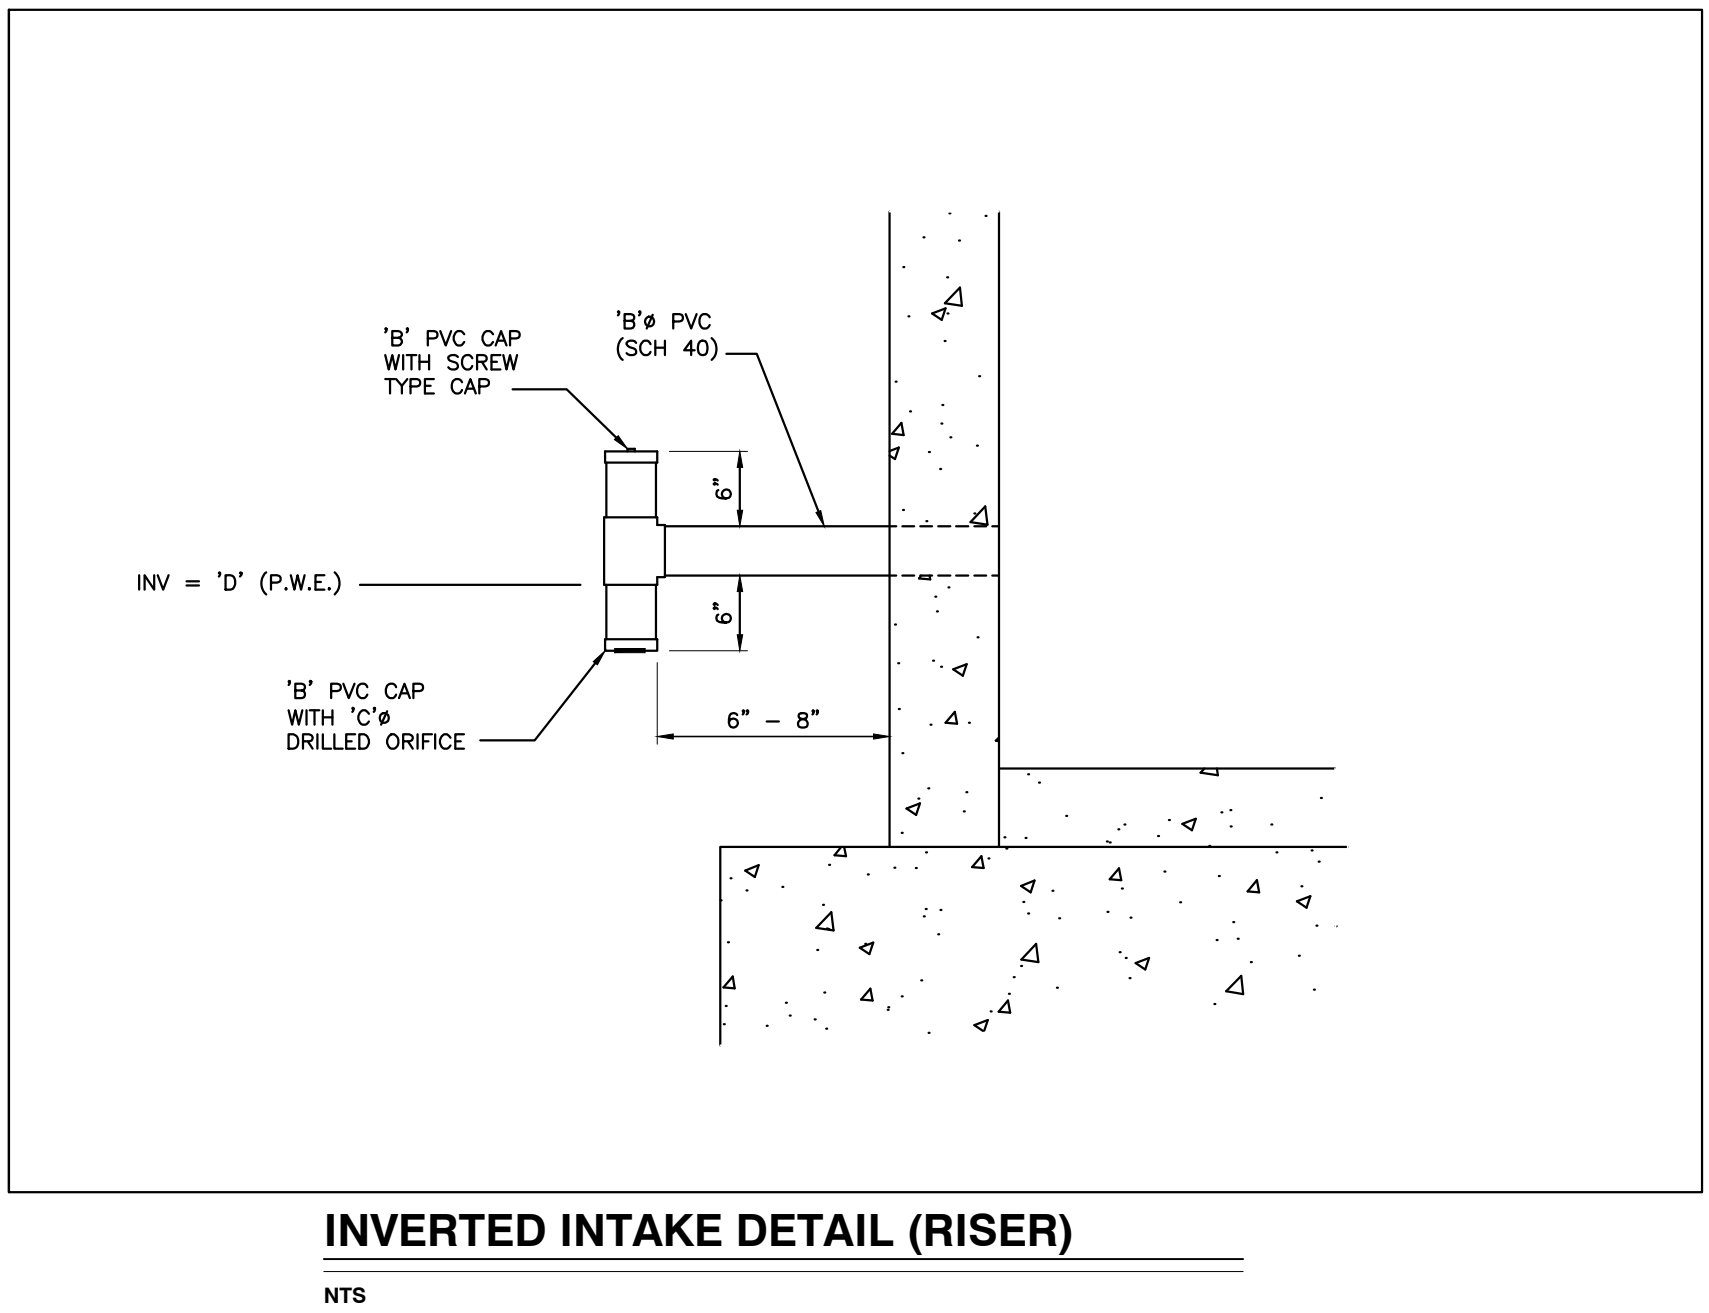

POND LEGEND - SCM		
Description	Design	As-Built
A Top of Riser	426.50 ft	
B Diameter of PVC Drawdown Pipe	4 in	
C Drawdown Orifice Opening	2.5 in	
D Drawdown Pipe Elevation / Permanent Pool	424.50 ft	
E Inside Bottom Riser Elevation	420.00 ft	
F Outlet Structure Size	4ft x 4ft	
G Top of Berm Width	10 ft	
H Top of Dam	428.00 ft	
I Ballast Thickness	40 in	
J Size of Outlet Pipe	24 in	
K Length of Outlet Pipe	18 ft	
L Slope of Outlet Pipe	2.78 %	
M Invert in Outlet Pipe	420.00 ft	
N Invert Out Outlet Pipe	419.80 ft	
O Top Elevation Forebay Berm	424.00 ft	
P Elevation Top of Litoral Shelf	425.00 ft	
Q Elevation Bottom of Litoral Shelf	424.00 ft	
R Slope of Litoral Shelf	6:1	
S Sediment Cleanout Elevation Forbay	422.00 ft	
T Bottom Elevation Forebay	421.00 ft	
U Sediment Cleanout Elevation Permanent Pool	421.00 ft	
V Bottom Elevation Permanent Pool	420.00 ft	
W Elevation Secondary Weir	426.20 ft	
X Width Secondary Weir	12 in	

Special Instructions

Place Drawdown pipe opposite of outlet pipe and ensure a minimum of 12" clearance between drawdown pipe opening and ground elevation to allow for proper drainage. Place secondary weir above drawdown pipe on same side of outlet structure.

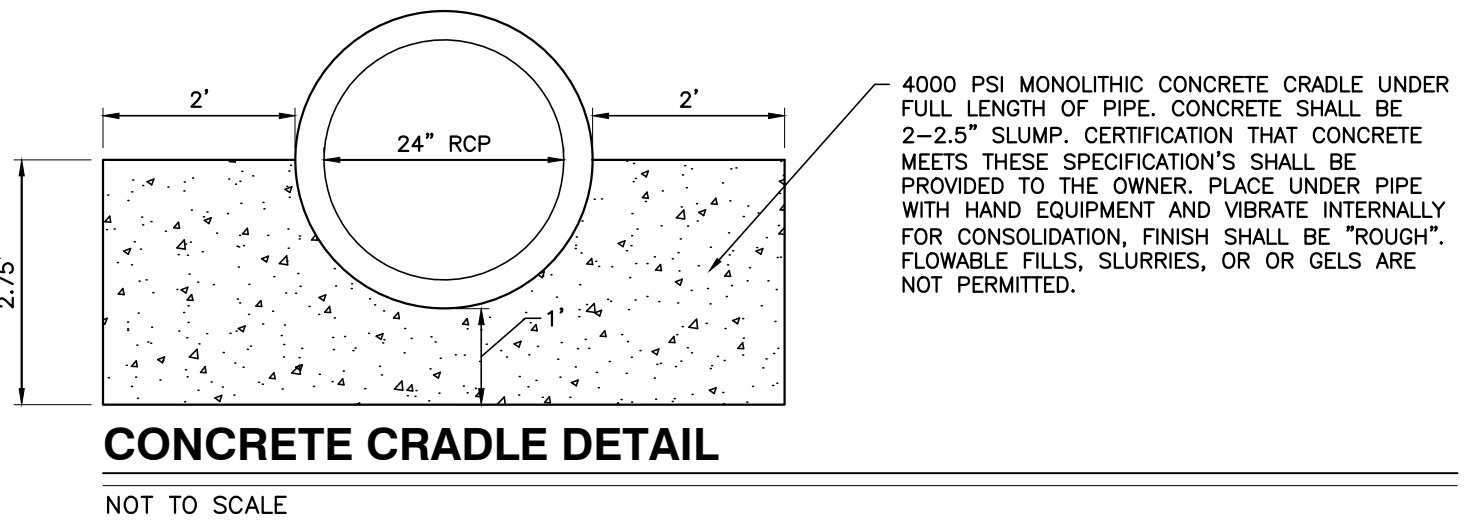

CITY OF RALEIGH - PLANS AUTHORIZED FOR CONSTRUCTION

Electronic Approval: This approval is being issued electronically. This approval is valid only upon the signature of a City of Raleigh Review Officer below. The City will retain a copy of the approved plans. Any work authorized by this approval must proceed in accordance with the plans kept on file with the City. This electronic approval may not be edited once issued. Any modification to this approval once issued will invalidate this approval.

City of Raleigh Development Approval _____

Raleigh Water Review Officer



09/01/23

NO FLOODPLAINS EXIST ON-SITE

NOTE: ALL CONSTRUCTION ACTIVITY MUST BE IN ACCORDANCE WITH THE ACCEPTED POLICIES OF THE TOWN OF ROLESVILLE AND NCDOT

BASS, NIXON & KENNEDY, INC.
CONSULTING ENGINEERS
6310 CHAPEL HILL ROAD, SUITE 250, RALEIGH, NC 27607
TELEPHONE: (919) 881-4422 FAX: (919) 881-6868
CERTIFICATION NUMBERS: NCBELS (C-0110); NCBOLA (C-0267)

PROGRESS	MM	DATE	BY	DESCRIPTION	REVISIONS
03-19157	MM				
JOB NO.					
BMP DETAILS					
SCALE: N.T.S.					
CHK BY: MDB					

COBBLESTONE VILLAGE
MIXED USE DEVELOPMENT
TOWN OF ROLESVILLE, WAKE COUNTY, NORTH CAROLINA

SHEET
C3.2

CONSTRUCTION SEQUENCE - STAGE 1

- ONCE THE EROSION AND SEDIMENT CONTROL PLAN APPROVAL AND NC001 CERTIFICATE OF COVERAGE ARE OBTAINED, SCHEDULE A PRECONSTRUCTION CONFERENCE WITH THE ENVIRONMENTAL CONSULTANT, OBTAIN A LAND-DISTURBING PERMIT.
- INSTALL GRAVEL CONSTRUCTION PAD, TEMPORARY DIVERSIONS, SILT FENCE, SKIMMER SEDIMENT BASINS AND OTHER MEASURES AS SHOWN ON THE APPROVED PLAN. CLEAR ONLY AS NECESSARY TO INSTALL THESE DEVICES. SEED TEMPORARY DIVERSIONS, BERMS AND BASINS IMMEDIATELY AFTER CONSTRUCTION.
- CALL ENVIRONMENTAL CONSULTANT FOR AN ONSITE INSPECTION BY THE ENVIRONMENTAL CONSULTANT TO OBTAIN A CERTIFICATE OF COMPLIANCE. BEGIN CLEARING AND GRUBBING. MAINTAIN DEVICES AS NEEDED. ROUGH GRADE SITE.
- STABILIZE SITE AS AREAS ARE BROUGHT UP TO FINISH GRADE WITH VEGETATION, PAVING, DITCH LININGS, ETC. SEED AND MULCH DENUDED AREAS PER GROUND STABILIZATION TIME FRAMES.
- STABILIZE SITE AS AREAS ARE BROUGHT UP TO FINISH GRADE WITH VEGETATION, ALLEY PAVING, DITCH LININGS, ETC. SEED AND MULCH DENUDED AREAS PER GROUND STABILIZATION TIME FRAMES.
- CALL ENVIRONMENTAL CONSULTANT FOR AN ONSITE INSPECTION BY THE ENVIRONMENTAL CONSULTANT PRIOR TO THE REMOVAL OF SKIMMER SEDIMENT BASIN #1.
- CONTINUE TO SOIL EROSION PLAN STAGE 2 ONCE SKIMMER BASIN #1 HAS BEEN REMOVED.

NOTE: WAKE COUNTY MUST GRANT PERMISSION TO CONVERT THE SEDIMENT BASIN OVER TO THE STORMWATER USE PRIOR TO COMPLETING ANY RELATED WORK.

TOTAL DISTURBED AREA = 11.0 AC

DENUDED AREA = 10.96 AC

REQUIRED WAKE COUNTY BASIN REMOVAL AND/OR CONVERSION SEQUENCE

- SCHEDULE A SITE MEETING WITH THE ENVIRONMENTAL CONSULTANT TO DETERMINE IF A BASIN CAN BE REMOVED OR CONVERTED TO A PERMANENT STORMWATER POND, INSTALL SILT FENCING OR OTHER TEMPORARY EROSION CONTROL MEASURES AS NEEDED PRIOR TO REMOVAL OF THE BASIN.
- UTILIZE OUTLET STRUCTURES THAT WITHDRAW WATER FROM THE SEDIMENT BASIN SURFACE FOR DRAW DOWN OF WATER IN BASIN FOR MAINTENANCE OR CLOSE OUT UNLESS INFEASIBLE. SEE REQUIREMENTS OF NC001 PERMIT PART I, SECTION G, ITEM (4) ENTITLED "DRAW DOWN OF SEDIMENT BASINS FOR MAINTENANCE OR CLOSE OUT" AND REFER TO WAKE COUNTY "FILTER BAG FOR Dewatering ACTIVITIES" CONSTRUCTION DETAIL.
- REMOVE BASIN(S) AND ASSOCIATED TEMPORARY DIVERSION DITCHES, IF CULVERT PIPES NEED TO BE EXTENDED, PERFORM THIS OPERATION AT THIS TIME. FINE GRADE AREA IN PREPARATION FOR SEEDING.
- PERFORM SEEDBED PREPARATION, SEED, MULCH AND ASPHALT TACK ANY RESULTING BARE AREAS IMMEDIATELY.
- INSTALL VELOCITY DISSIPATORS AND/OR LEVEL SPREADERS AS REQUIRED ON THE EROSION CONTROL PLAN.
- WHEN SITE IS FULLY STABILIZED, CALL ENVIRONMENTAL CONSULTANT FOR APPROVAL OF REMOVING REMAINING TEMPORARY EROSION CONTROL MEASURES AND ADVICE ON WHEN SITE CAN BE ISSUED A CERTIFICATE OF COMPLETION. NOTE: A MEETING SHOULD ALSO BE SCHEDULED WITH THE ENVIRONMENTAL CONSULTANT TO DETERMINE WHEN A BASIN MAY BE CONVERTED FOR STORMWATER USE. SOME MUNICIPALITIES MAY ALSO REQUIRE THIS.

SEDIMENT BASIN SUMMARY CHART

Sediment Basin Number	1	2	3
Drainage Area (acres)	3.42	4.61	0.6
Orifice (ft)	(0.5)(7.22)(3.42)=12.35	(0.5)(7.22)(4.61)=16.64	(0.5)(7.22)(0.60)=2.17
Weir Size (ft)	10 x 1.5	10 x 1.5	10 x 1.5
Surface Area Required (SF)	(435)(12.35)=5,372	(435)(16.64)=7,238	(435)(2.17)=944
Volume Required (CF)	(1800)(3.42)=6,156	(1800)(4.61)=8,298	(1800)(0.60)=1,080
Dimensions (ft)	see plans	see plans	see plans
Surface Area Provided (SF)	5,400	10,640	1,584
Volume Provided (CF)	13,572	27,636	2,563
Skimmer Size	4"	4"	3"
Orifice Radius	0.5"	0.5"	0.25"
Orifice Diameter	1.0"	1.25"	0.5"
Drawdown Time (days)	4.62	3.98	3.74
Number of Baffles	3	3	3

Structure	d _o (ft)	Velocity (fps)	Length (ft)	Width (ft)	Depth (ft)	Type	d ₅₀
FES 1	2.00	7.4	12	6	22	Class B'	6" - 13"
FES 3	3.00	6.5	18	9	22	Class B'	6" - 13"
DV DITCH 1"	1.25	5.3	5	4	9	Class A'	3" - 6"
DV DITCH 2"	1.25	5.3	5	4	9	Class A'	3" - 6"
DV DITCH 3"	1.25	5.3	5	4	9	Class A'	3" - 6"
DV DITCH 4"	1.25	5.3	5	4	9	Class A'	3" - 6"
PIPE 1"	1.25	5.3	5	4	9	Class A'	3" - 6"
PIPE 2"	1.25	5.3	5	4	9	Class A'	3" - 6"


* Per NYDOT Dissipator Schedule Fig. 1

CITY OF RALEIGH - PLANS AUTHORIZED FOR CONSTRUCTION

Electronic Approval: This approval is being issued electronically. This approval is valid only upon the signature of a City of Raleigh Review Officer below. The City will retain a copy of the approved plans. Any work authorized by this approval must proceed in accordance with the plans kept on file with the City. This electronic approval may not be edited once issued. Any modification to this approval once issued will invalidate this approval.

City of Raleigh Development Approval _____

Raleigh Water Review Officer _____

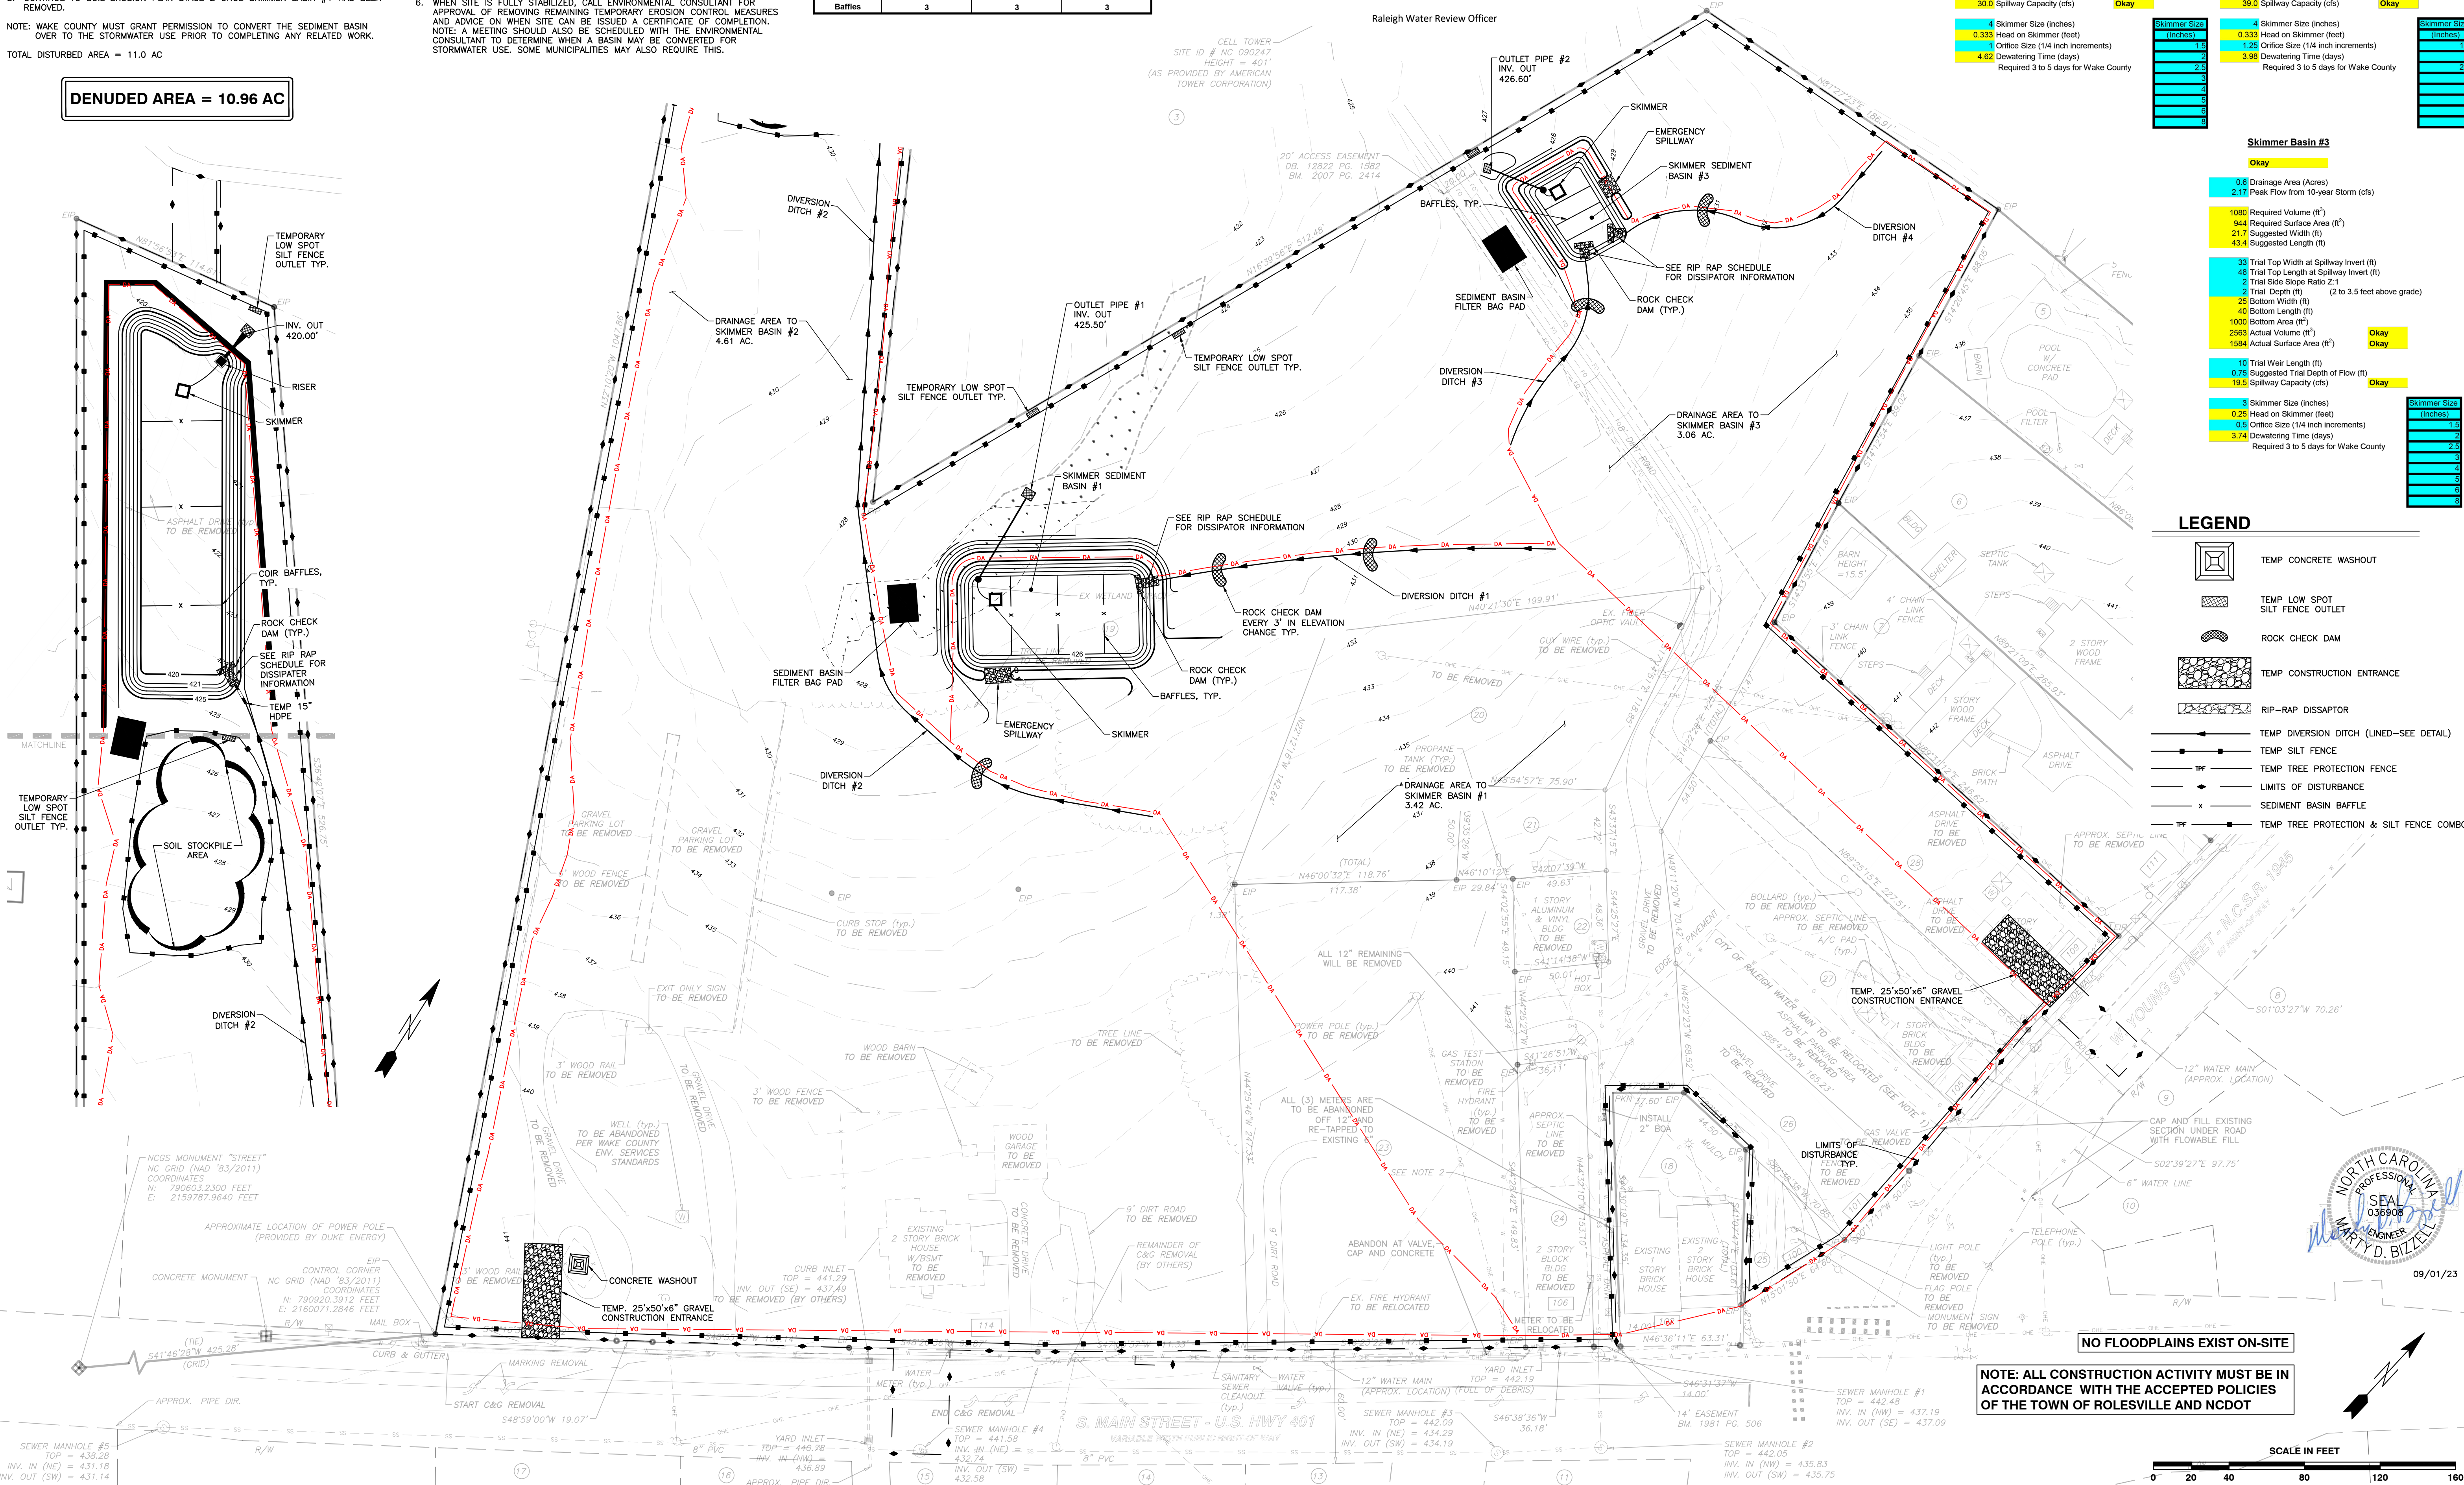

DITCH/CHANNEL CALCULATIONS							
DIVERSION DITCH ID	LENGTH (LF)	DA (Ac)	Q10 (CFS)	SLOPE (%)	V10 (FPS)	PERMISSIBLE SHEAR STRESS (PSF)	CALCULATED SHEAR STRESS (PSF)
DV-1	296	1.02	2.34	2.00	2.01	SC150	0.78
DV-2	495	1.00	2.30	2.60	2.29	SC150	2.00
DV-3	442	0.52	1.19	1.80	0.92	SC150	1.80
DV-4	167	0.08	0.13	2.90	0.96	SC150	1.80

* NAG = NORTH AMERICAN GREEN OR EQUIVALENT

Skimmer Basin #1

Okay	
3.42 Drainage Area (Acres)	12.35 Peak Flow from 10-year Storm (cfs)
6156 Required Volume (ft³)	5372 Required Surface Area (ft²)
51.8 Suggested Width (ft)	103.8 Suggested Length (ft)
54 Trial Top Width at Spillway Invert (ft)	100 Trial Top Length at Spillway Invert (ft)
3 Trial Side Slope Ratio 2:1	3 Trial Depth (ft) (2 to 3.5 feet above grade)
42 Bottom Width (ft)	178 Bottom Length (ft)
3698 Bottom Area (ft²)	13572 Actual Volume (ft³)
5400 Actual Surface Area (ft²)	10 Trial Weir Length (ft)
0.75 Suggested Trial Depth of Flow (ft)	39.0 Spillway Capacity (cfs)
4 Skimmer Size (inches)	0.333 Head on Skimmer (feet)
1.25 Orifice Size (1/4 inch increments)	4.62 Dewatering Time (days)
Required 3 to 5 days for Wake County	

Skimmer Basin #2

Okay	
4.61 Drainage Area (Acres)	16.64 Peak Flow from 10-year Storm (cfs)
8298 Required Volume (ft³)	7238 Required Surface Area (ft²)
60.2 Suggested Width (ft)	120.3 Suggested Length (ft)
56 Trial Top Width at Spillway Invert (ft)	180 Trial Top Length at Spillway Invert (ft)
2 Trial Side Slope Ratio 2:1	3 Trial Depth (ft) (2 to 3.5 feet above grade)
44 Bottom Width (ft)	178 Bottom Length (ft)
7832 Bottom Area (ft²)	27636 Actual Volume (ft³)
10640 Actual Surface Area (ft²)	20 Trial Weir Length (ft)
0.75 Suggested Trial Depth of Flow (ft)	39.0 Spillway Capacity (cfs)
4 Skimmer Size (inches)	0.333 Head on Skimmer (feet)
1.25 Orifice Size (1/4 inch increments)	3.98 Dewatering Time (days)
Required 3 to 5 days for Wake County	

Skimmer Basin #3


Okay	
0.6 Drainage Area (Acres)	2.17 Peak Flow from 10-year Storm (cfs)
1080 Required Volume (ft³)	944 Required Surface Area (ft²)
21.7 Suggested Width (ft)	43.4 Suggested Length (ft)
33 Trial Top Width at Spillway Invert (ft)	48 Trial Top Length at Spillway Invert (ft)
2 Trial Side Slope Ratio 2:1	2 Trial Depth (ft) (2 to 3.5 feet above grade)
23 Bottom Width (ft)	40 Bottom Length (ft)
1000 Bottom Area (ft²)	2563 Actual Volume (ft³)
1584 Actual Surface Area (ft²)	10 Trial Weir Length (ft)
0.75 Suggested Trial Depth of Flow (ft)	19.3 Spillway Capacity (cfs)
4 Skimmer Size (inches)	0.333 Head on Skimmer (feet)
0.8 Orifice Size (1/4 inch increments)	3.74 Dewatering Time (days)
Required 3 to 5 days for Wake County	

LEGEND

- TEMP CONCRETE WASHOUT
- TEMP LOW SPOT SILT FENCE OUTLET
- ROCK CHECK DAM
- TEMP CONSTRUCTION ENTRANCE
- RIP-RAP DISSIPATOR
- TEMP DIVERSION DITCH (LINED-SEE DETAIL)
- TEMP SILT FENCE
- TEMP TREE PROTECTION FENCE
- LIMITS OF DISTURBANCE
- SEDIMENT BASIN BAFFLE
- TEMP TREE PROTECTION & SILT FENCE COMBO

NO FLOODPLAINS EXIST ON-SITE

NOTE: ALL CONSTRUCTION ACTIVITY MUST BE IN ACCORDANCE WITH THE ACCEPTED POLICIES OF THE TOWN OF ROLESVILLE AND NCDOT

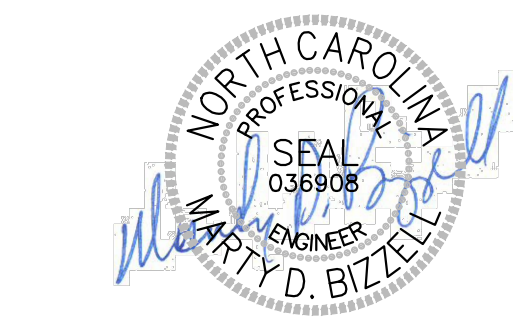

SCALE IN FEET

BASS, NIXON & KENNEDY, INC.
CONSULTING ENGINEERS
6310 CHASE HILL ROAD, SUITE 250, RALEIGH, NC 27607
TELEPHONE: (919) 881-4422 FAX: (919) 881-8986
CERTIFICATION NUMBERS: NCBELS (C-0110); NCBOLA (C-0267)

PROGRESS DRAWN BY
DATE
JOB NO.
EROSION CONTROL
PLAN - STAGE 1

COBBLESTONE VILLAGE
MIXED USE DEVELOPMENT
TOWN OF ROLESVILLE, WAKE COUNTY, NORTH CAROLINA

SHEET
C3.3

NOT RELEASED FOR CONSTRUCTION OR BID SOLICITATION

CONSTRUCTION SEQUENCE - STAGE 2

- BEGIN CONSTRUCTION OF ALL BUILDINGS.
 - STABILIZE SITE AS NEW DISTURBED AREAS ARE BROUGHT UP TO FINISH GRADE WITH VEGETATION, PAVING, DITCH LININGS, ETC. SEED AND MULCH DENUDED AREAS PER GROUND STABILIZATION TIME FRAMES.
 - WHEN CONSTRUCTION OF PARKING LOTS ARE COMPLETE AND ALL AREAS ARE STABILIZED COMPLETELY, CALL ENVIRONMENTAL CONSULTANT FOR AN INSPECTION.
 - IF THE SITE IS APPROVED, REMOVE TEMPORARY DIVERSIONS, SILT FENCE, SEDIMENT BASINS, ETC., AND SEED OUT OR STABILIZE ANY RESULTING BARE AREAS. ALL REMAINING PERMANENT EROSION CONTROL DEVICES, SUCH AS VELOCITY DISSIPATORS, SHOULD NOW BE INSTALLED.
 - WHEN VEGETATION HAS BECOME ESTABLISHED, CALL FOR A FINAL SITE INSPECTION BY THE ENVIRONMENTAL CONSULTANT. OBTAIN A CERTIFICATE OF COMPLETION.
- NOTE: WAKE COUNTY MUST GRANT PERMISSION TO CONVERT THE SEDIMENT BASIN OVER TO THE STORMWATER USE PRIOR TO COMPLETING ANY RELATED WORK.
- TOTAL DISTURBED AREA = 10.96 AC
- ENVIRONMENTAL CONSULTANT: JEEVAN NEUPANE (919-819-8907)

REQUIRED WAKE COUNTY BASIN REMOVAL AND/OR CONVERSION SEQUENCE

- SCHEDULE A SITE MEETING WITH THE ENVIRONMENTAL CONSULTANT TO DETERMINE IF A BASIN CAN BE REMOVED OR CONVERTED TO A PERMANENT STORMWATER POND. INSTALL SILT FENCING OR OTHER TEMPORARY EROSION CONTROL MEASURES AS NEEDED PRIOR TO REMOVAL OF THE BASIN.
- UTILIZE OUTLET STRUCTURES THAT WITHDRAW WATER FROM THE SEDIMENT BASIN SURFACE FOR DRAW DOWN OF WATER IN BASIN FOR MAINTENANCE OR CLOSE OUT UNLESS INFEASIBLE. SEE REQUIREMENTS OF NC001 PERMIT PART II, SECTION G, ITEM (4) ENTITLED "DRAW DOWN OF SEDIMENT BASINS FOR MAINTENANCE OR CLOSE OUT" AND REFER TO WAKE COUNTY "FILTER BAG FOR DEWATERING ACTIVITIES" CONSTRUCTION DETAIL.
- REMOVE BASIN(S) AND ASSOCIATED TEMPORARY DIVERSION DITCHES. IF CULVERT PIPES NEED TO BE EXTENDED, PERFORM THIS OPERATION AT THIS TIME. FINE GRADE AREA IN PREPARATION FOR SEEDING.
- PERFORM SEEDBED PREPARATION, SEED, MULCH AND ASPHALT TACK ANY RESULTING BARE AREAS IMMEDIATELY.
- INSTALL VELOCITY DISSIPATORS AND/OR LEVEL SPREADERS AS REQUIRED ON THE EROSION CONTROL PLAN.
- WHEN SITE IS FULLY STABILIZED, CALL ENVIRONMENTAL CONSULTANT FOR APPROVAL OF REMOVING REMAINING TEMPORARY EROSION CONTROL MEASURES AND ADVICE ON WHEN SITE CAN BE ISSUED A CERTIFICATE OF COMPLETION. NOTE: A MEETING SHOULD ALSO BE SCHEDULED WITH THE ENVIRONMENTAL CONSULTANT TO DETERMINE WHEN A BASIN MAY BE CONVERTED FOR STORMWATER USE. SOME MUNICIPALITIES MAY ALSO REQUIRE THIS.

Skimmer Basin #2

Okay
6.99 Drainage Area (Acres)
25.23 Peak Flow from 10-year Storm (cfs)
12562 Required Volume (ft³)
10975 Required Surface Area (ft²)
74.1 Suggested Width (ft)
148.2 Suggested Length (ft)
58 Trial Top Width at Spillway Invert (ft)
190 Trial Top Length at Spillway Invert (ft)
3 Trial Side Slope Ratio 2:1
3 Trial Depth (ft) (2 to 3.5 feet above grade)
46 Bottom Width (ft)
176 Bottom Length (ft)
8188 Bottom Area (ft²)
28740 Actual Volume (ft³)
11020 Actual Surface Area (ft²)
20 Trial Weir Length (ft)
0.75 Suggested Trial Depth of Flow (ft)
39.9 Spillway Capacity (cfs)
Okay
Okay
4 Skimmer Size (inches)
0.333 Head on Skimmer (feet)
1.58 Orifice Size (1/4 inch increments)
4.20 Dewatering Time (days)
Required 3 to 5 days for Wake County

SEDIMENT BASIN SUMMARY CHART					
Sediment Basin Number	1	2			
Drainage Area (acres)	1.74	6.99			
Q10(cfs)	(0.5)(7.22)(1.74)=6.28	(0.5)(7.22)(6.99)=25.23			
Weir Size (ft)	10 x 1.5	10 x 1.5			
Surface Area Required (SF)	(435)(6.28)=2,732	(435)(25.23)=10,975			
Volume Required (CF)	(1800)(1.74)=3,132	(1800)(6.99)=12,582			
Dimensions (ft)	see plans	see plans			
Surface Area Provided (SF)	2,800	11,000			
Volume Provided (CF)	5,648	27,800			
Skimmer Size	4"	7.5"			
Orifice Radius	0.4"	0.75"			
Orifice Diameter	0.75"	1.5"			
Drawdown Time (Days)	4.18	4.2			
Number of Baffles	3	3			

DITCH/CHANNEL CALCULATIONS

DIVERSION DITCH ID	LENGTH (LF)	DA (Ac)	Q10 (CFS)	SLOPE (%)	V10 (FPS)	LINER *	PERMISSIBLE SHEAR STRESS (PSF)	CALCULATED SHEAR STRESS (PSF)
DV-1	296	1.02	2.34	2.00	2.01	SC150	2.00	0.78
DV-2	495	1.00	2.30	2.60	2.29	SC150	2.00	0.94
DV-3	442	0.52	1.19	1.80	0.92	SC150	1.80	0.29
DV-4	167	0.06	0.13	2.90	0.96	SC150	1.80	0.38

* NAG = NORTH AMERICAN GREEN OR EQUIVALENT

LEGEND

- TEMP CONSTRUCTION ENTRANCE
- TEMP LOW SPOT SILT FENCE OUTLET
- TEMP INLET PROTECTION
- RIP-RAP DISSIPATOR
- TEMP SILT FENCE
- TEMP TREE PROTECTION FENCE
- LIMITS OF DISTURBANCE
- SEDIMENT BASIN BAFFLE
- TEMP TREE PROTECTION & SILT FENCE COMBO


CITY OF RALEIGH - PLANS AUTHORIZED FOR CONSTRUCTION

Electronic Approval: This approval is being issued electronically. This approval is valid only upon the signature of a City of Raleigh Review Officer below. The City will retain a copy of the approved plans. Any work authorized by this approval must proceed in accordance with the plans kept on file with the City. This electronic approval may not be edited once issued. Any modification to this approval once issued will invalidate this approval.

City of Raleigh Development Approval

Raleigh Water Review Officer

#27 Update SEC plans per revised storm

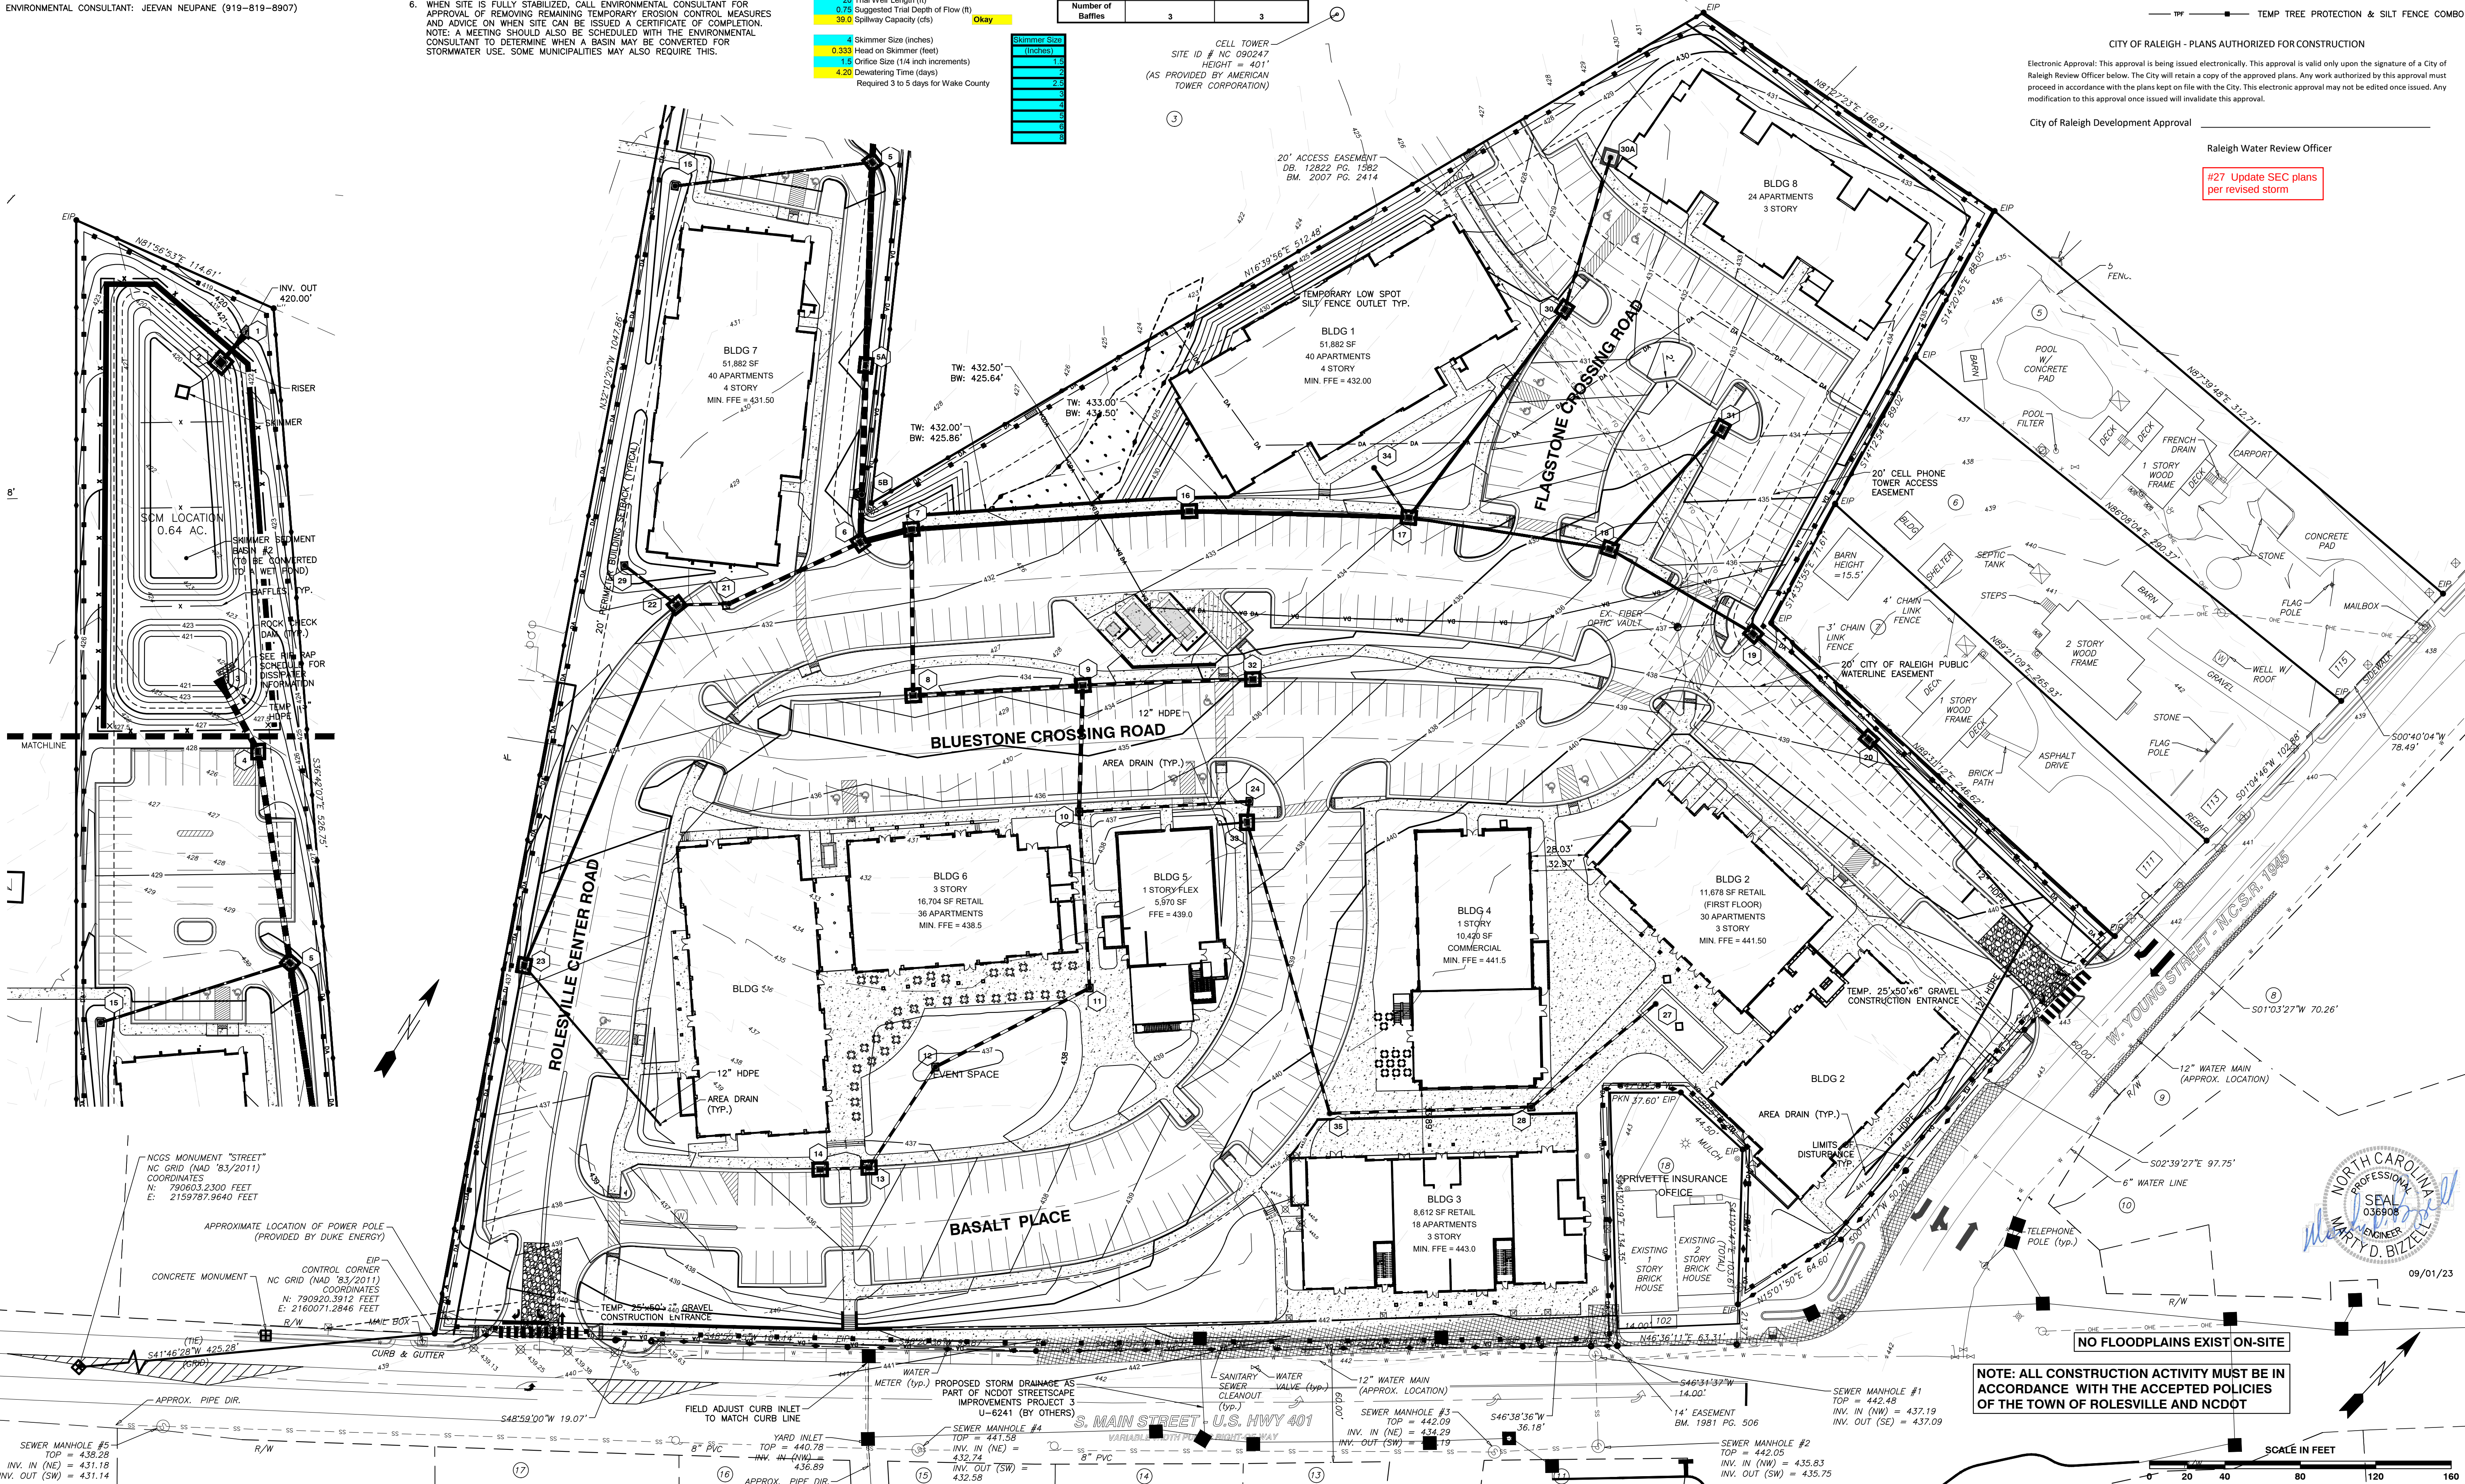


BASS, NIXON & KENNEDY, INC.
CONSULTING ENGINEERS
6310 CHAPEL HILL ROAD, SUITE 250, RALEIGH, NC 27607
TELEPHONE: (919) 851-4422 FAX: (919) 851-8986
CERTIFICATION NUMBERS: NCBELS (C-0110); NCBOLA (C-0267)

PROGRESS MRN
DATE DRAWN BY
JOB NO. EROSION CONTROL
PLAN - STAGE 2

COBBLESTONE VILLAGE
MIXED USE DEVELOPMENT
TOWN OF ROLESVILLE, WAKE COUNTY, NORTH CAROLINA

SHEET
C3.4

NOT RELEASED FOR CONSTRUCTION OR BID SOLICITATION

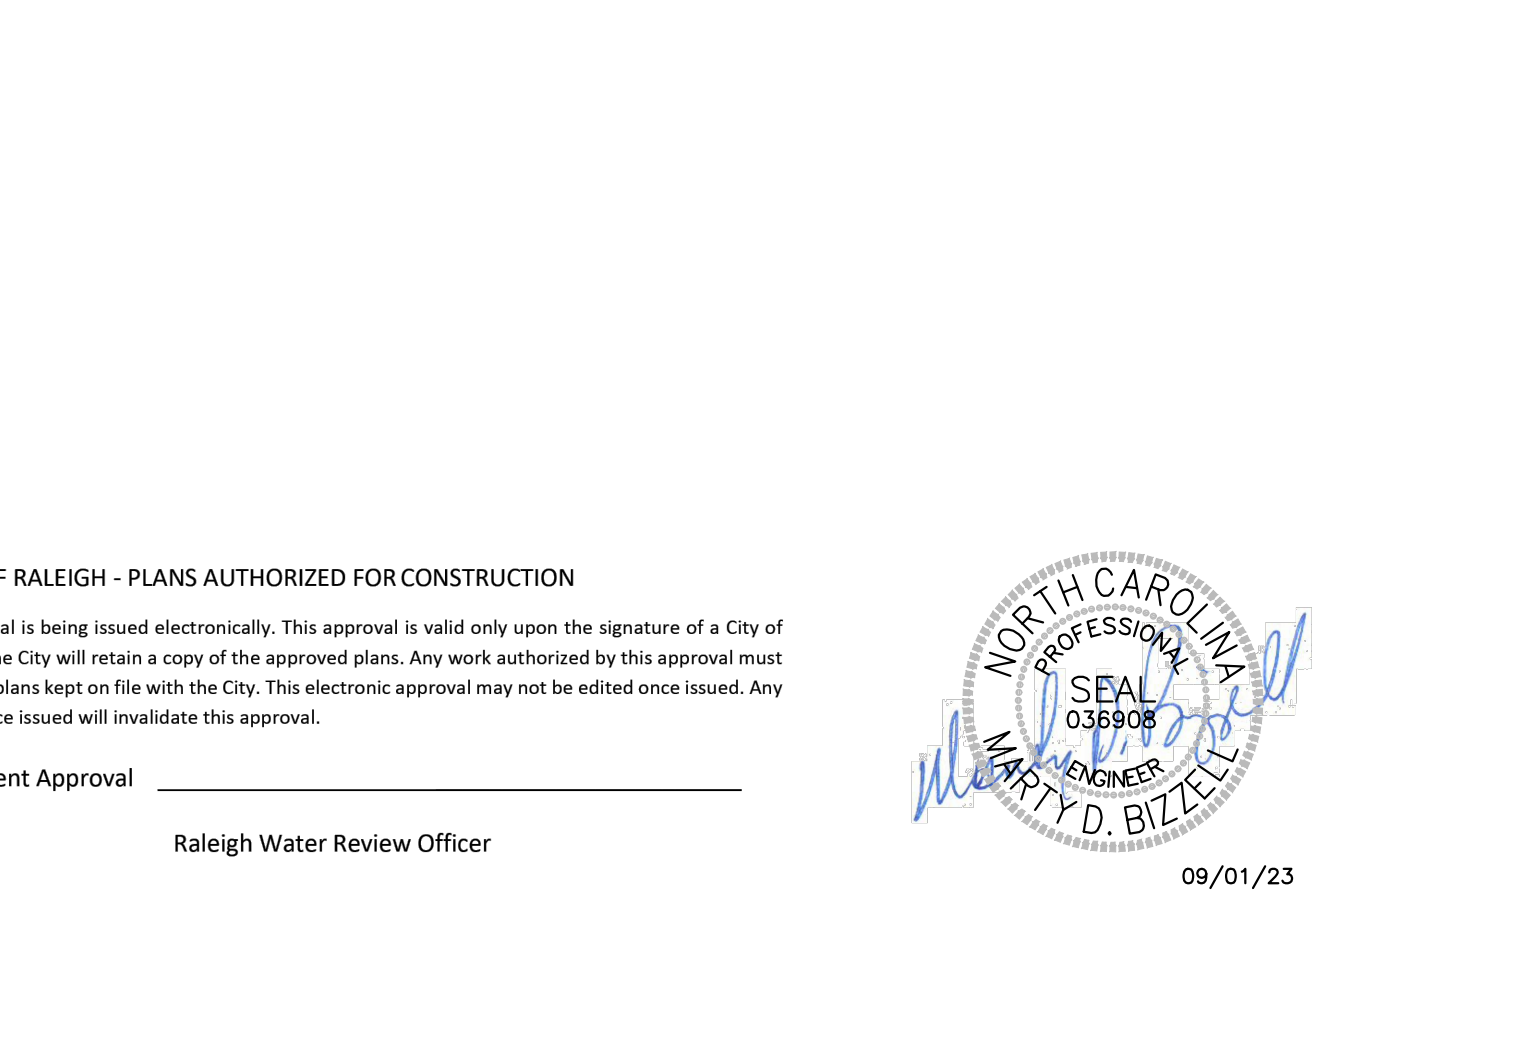



CITY OF RALEIGH - PLANS AUTHORIZED FOR CONSTRUCTION


Electronic Approval: This approval is being issued electronically. This approval is valid only upon the signature of a City of Raleigh Review Officer below. The City will retain a copy of the approved plans. Any work authorized by this approval must proceed in accordance with the plans kept on file with the City. This electronic approval may not be edited once issued. Any modification to this approval once issued will invalidate this approval.

City of Raleigh Development Approval _____

Raleigh Water Review Officer

#28 WHAT HAPPEN TO THE
STORMDRAINAGE PIPE TABLES
 
#30 Have as built
been completed?



STORMDRAINAGE STRUCTURE TABLE		
STRUCTURE NAME	INSERTION RIM ELEVATION (FLOWLINE)	STRUCTURE TYPE
1	422.45 INV. IN= 419.80 (2)	24" FES
2	425.18 INV. OUT= 420.00 (1)	RISER
3	424.83 INV. IN= 421.00 (4)	36" FES
4	428.06 INV. IN= 421.36 (5) INV. OUT= 421.26 (3)	NCDOT CURB INLET
5A	429.50 INV. IN= 422.79 (5B) INV. OUT= 422.79 (5)	NCDOT CURB INLET
5B	428.50 INV. IN= 423.20 (6) INV. OUT= 423.20 (5A)	HDPE YARD INLET
5	429.08 INV. IN= 422.14 (5A) INV. IN= 423.05 (15) INV. OUT= 422.04 (4)	NCDOT CURB INLET
6	430.99 INV. IN= 423.45 (7) INV. IN= 423.45 (21) INV. OUT= 423.35 (5B)	NCDOT CURB INLET
7	431.15 INV. IN= 424.94 (8) INV. IN= 423.72 (16) INV. OUT= 423.62 (6)	NCDOT CURB INLET

STORMDRAINAGE STRUCTURE TABLE		
STRUCTURE NAME	INSERTION RIM ELEVATION (FLOWLINE)	STRUCTURE TYPE
8	433.95 INV. IN= 425.92 (9) INV. OUT= 425.82 (7)	NCDOT CURB INLET
9	433.95 INV. IN= 426.92 (10) INV. IN= 428.60 (32) INV. OUT= 426.82 (8)	NCDOT CURB INLET
10	436.44 INV. IN= 427.69 (11) INV. IN= 430.86 (24) INV. OUT= 427.59 (9)	HDPE YARD INLET
11	437.44 INV. IN= 428.73 (12) INV. OUT= 428.63 (10)	HDPE YARD INLET
12	435.50 INV. IN= 429.75 (13) INV. OUT= 429.65 (11)	HDPE YARD INLET
13	436.00 INV. IN= 430.49 (14) INV. OUT= 430.39 (12)	NCDOT CURB INLET
14	436.00 INV. OUT= 430.75 (13)	NCDOT CURB INLET
15	428.50 INV. OUT= 424.10 (5)	HDPE YARD INLET
16	429.68 INV. IN= 424.71 (17) INV. OUT= 424.61 (7)	NCDOT CURB INLET

STORMDRAINAGE STRUCTURE TABLE		
STRUCTURE NAME	INSERTION RIM ELEVATION (FLOWLINE)	STRUCTURE TYPE
17	434.01 INV. IN= 427.77 (18) INV. IN= 425.51 (30) INV. IN= 427.77 (34) INV. OUT= 425.41 (16)	NCDOT CURB INLET
18	436.04 INV. IN= 430.69 (19) INV. IN= 428.95 (31) INV. OUT= 428.85 (17)	NCDOT CURB INLET
19	437.52 INV. IN= 431.67 (20) INV. OUT= 431.57 (18)	NCDOT CURB INLET
20	438.65 INV. OUT= 432.50 (19)	NCDOT CURB INLET
21	431.60 INV. IN= 424.32 (22) INV. OUT= 424.22 (6)	HDPE YARD INLET
22	432.00 INV. IN= 424.70 (23) INV. IN= 424.70 (29) INV. OUT= 424.60 (21)	NCDOT CURB INLET
23	435.99 INV. OUT= 428.78 (22)	NCDOT CURB INLET
24	437.18 INV. IN= 432.32 (33) INV. OUT= 432.22 (10)	HDPE YARD INLET
27	441.00 INV. OUT= 436.27 (28)	HDPE YARD INLET

STORMDRAINAGE STRUCTURE TABLE		
STRUCTURE NAME	INSERTION RIM ELEVATION (FLOWLINE)	STRUCTURE TYPE
28	441.00 INV. IN= 435.41 (27) INV. OUT= 435.31 (35)	HDPE YARD INLET
29	428.50 INV. OUT= 425.05 (22)	HDPE YARD INLET
30A	430.12 INV. OUT= 426.76 (30)	HDPE YARD INLET
30	430.12 INV. IN= 426.34 (30A) INV. OUT= 426.34 (17)	NCDOT CURB INLET
31	434.05 INV. OUT= 429.82 (18)	NCDOT CURB INLET
32	435.72 INV. OUT= 429.50 (9)	NCDOT CURB INLET
33	437.87 INV. IN= 432.53 (35) INV. OUT= 432.43 (24)	NCDOT CURB INLET
34	430.03 INV. OUT= 428.09 (17)	HDPE YARD INLET
35	441.08 INV. IN= 434.24 (28) INV. OUT= 434.14 (33)	HDPE YARD INLET

NOTE: ALL STORM ITEMS SHALL BE AS-BUILT PER THE TOWN UDO SECTION 7.5.5, WHICH SPECIFIES REQUIREMENTS AS-BUILTS FOR STORM.

#29 Identify what
storm is NEW



09/01/23


COBBLESTONE
VILLAGE
MIXED USE DEVELOPMENT
TOWN OF ROLESVILLE, WAKE COUNTY, NORTH CAROLINA

BASS, NIXON & KENNEDY, INC.
CONSULTING ENGINEERS
6310 CHAPEL HILL ROAD, SUITE 250, RALEIGH, NC 27607
TELEPHONE: (919) 881-1122 FAX: (919) 881-8888
CERTIFICATION NUMBERS: NCBELS (C-0110); NCBOLA (C-0267)

NO.	DATE	DESCRIPTION	BY

03-19157	PROGRESS	MRM	DRAWN BY
JOB NO.	DATE		
STORM DRAINAGE PIPE & STRUCTURE TABLE			
SCALE:	CHK BY: MDB	REVISIONS	

SHEET
C3.8

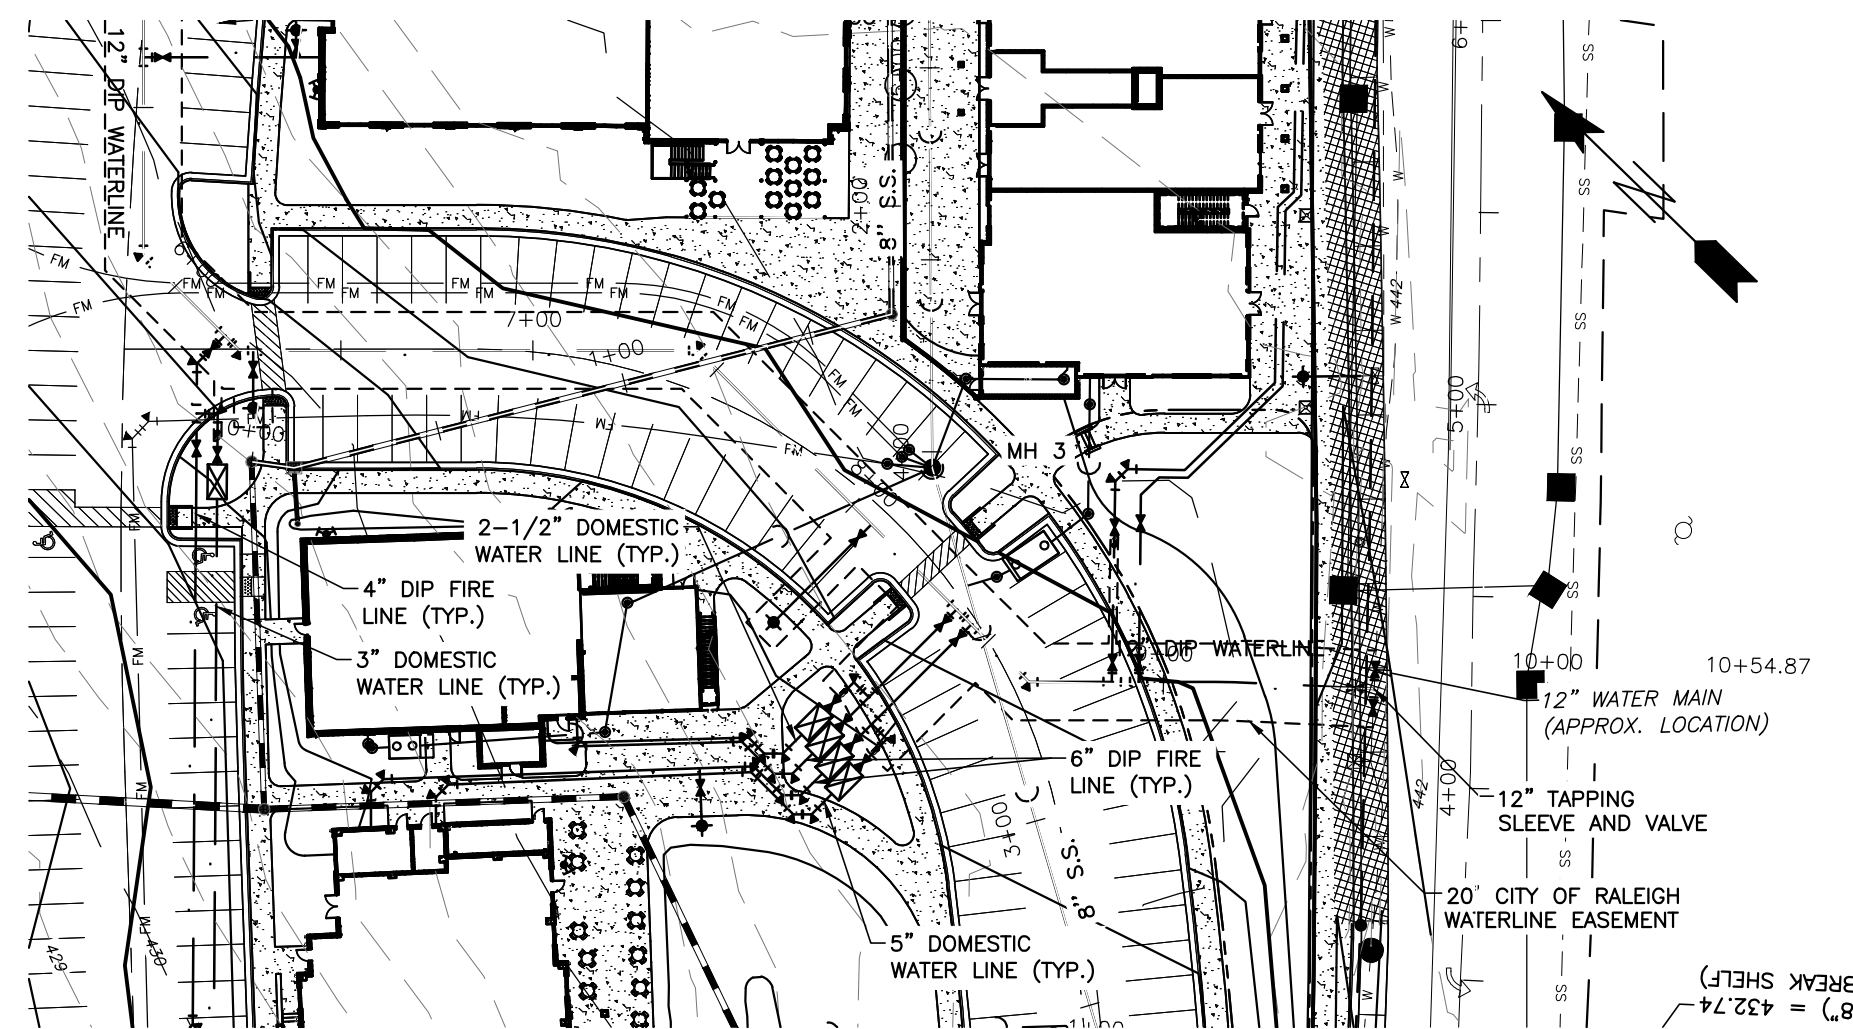

CITY OF RALEIGH - PLANS AUTHORIZED FOR CONSTRUCTION

Electronic Approval: This approval is being issued electronically. This approval is valid only upon the signature of a City of Raleigh Review Officer below. The City will retain a copy of the approved plans. Any work authorized by this approval must proceed in accordance with the plans kept on file with the City. This electronic approval may not be edited once issued. Any modification to this approval once issued will invalidate this approval.

City of Raleigh Development Approval _____

Raleigh Water Review Officer

NOTE: ALL CONSTRUCTION ACTIVITY MUST BE IN ACCORDANCE WITH THE ACCEPTED POLICIES OF THE TOWN OF ROLESVILLE AND NCDOT

09/01/23


SHEET

C4.1


COBLESTONE VILLAGE

MIXED USE DEVELOPMENT

TOWN OF ROLESVILLE, WAKE COUNTY, NORTH CAROLINA

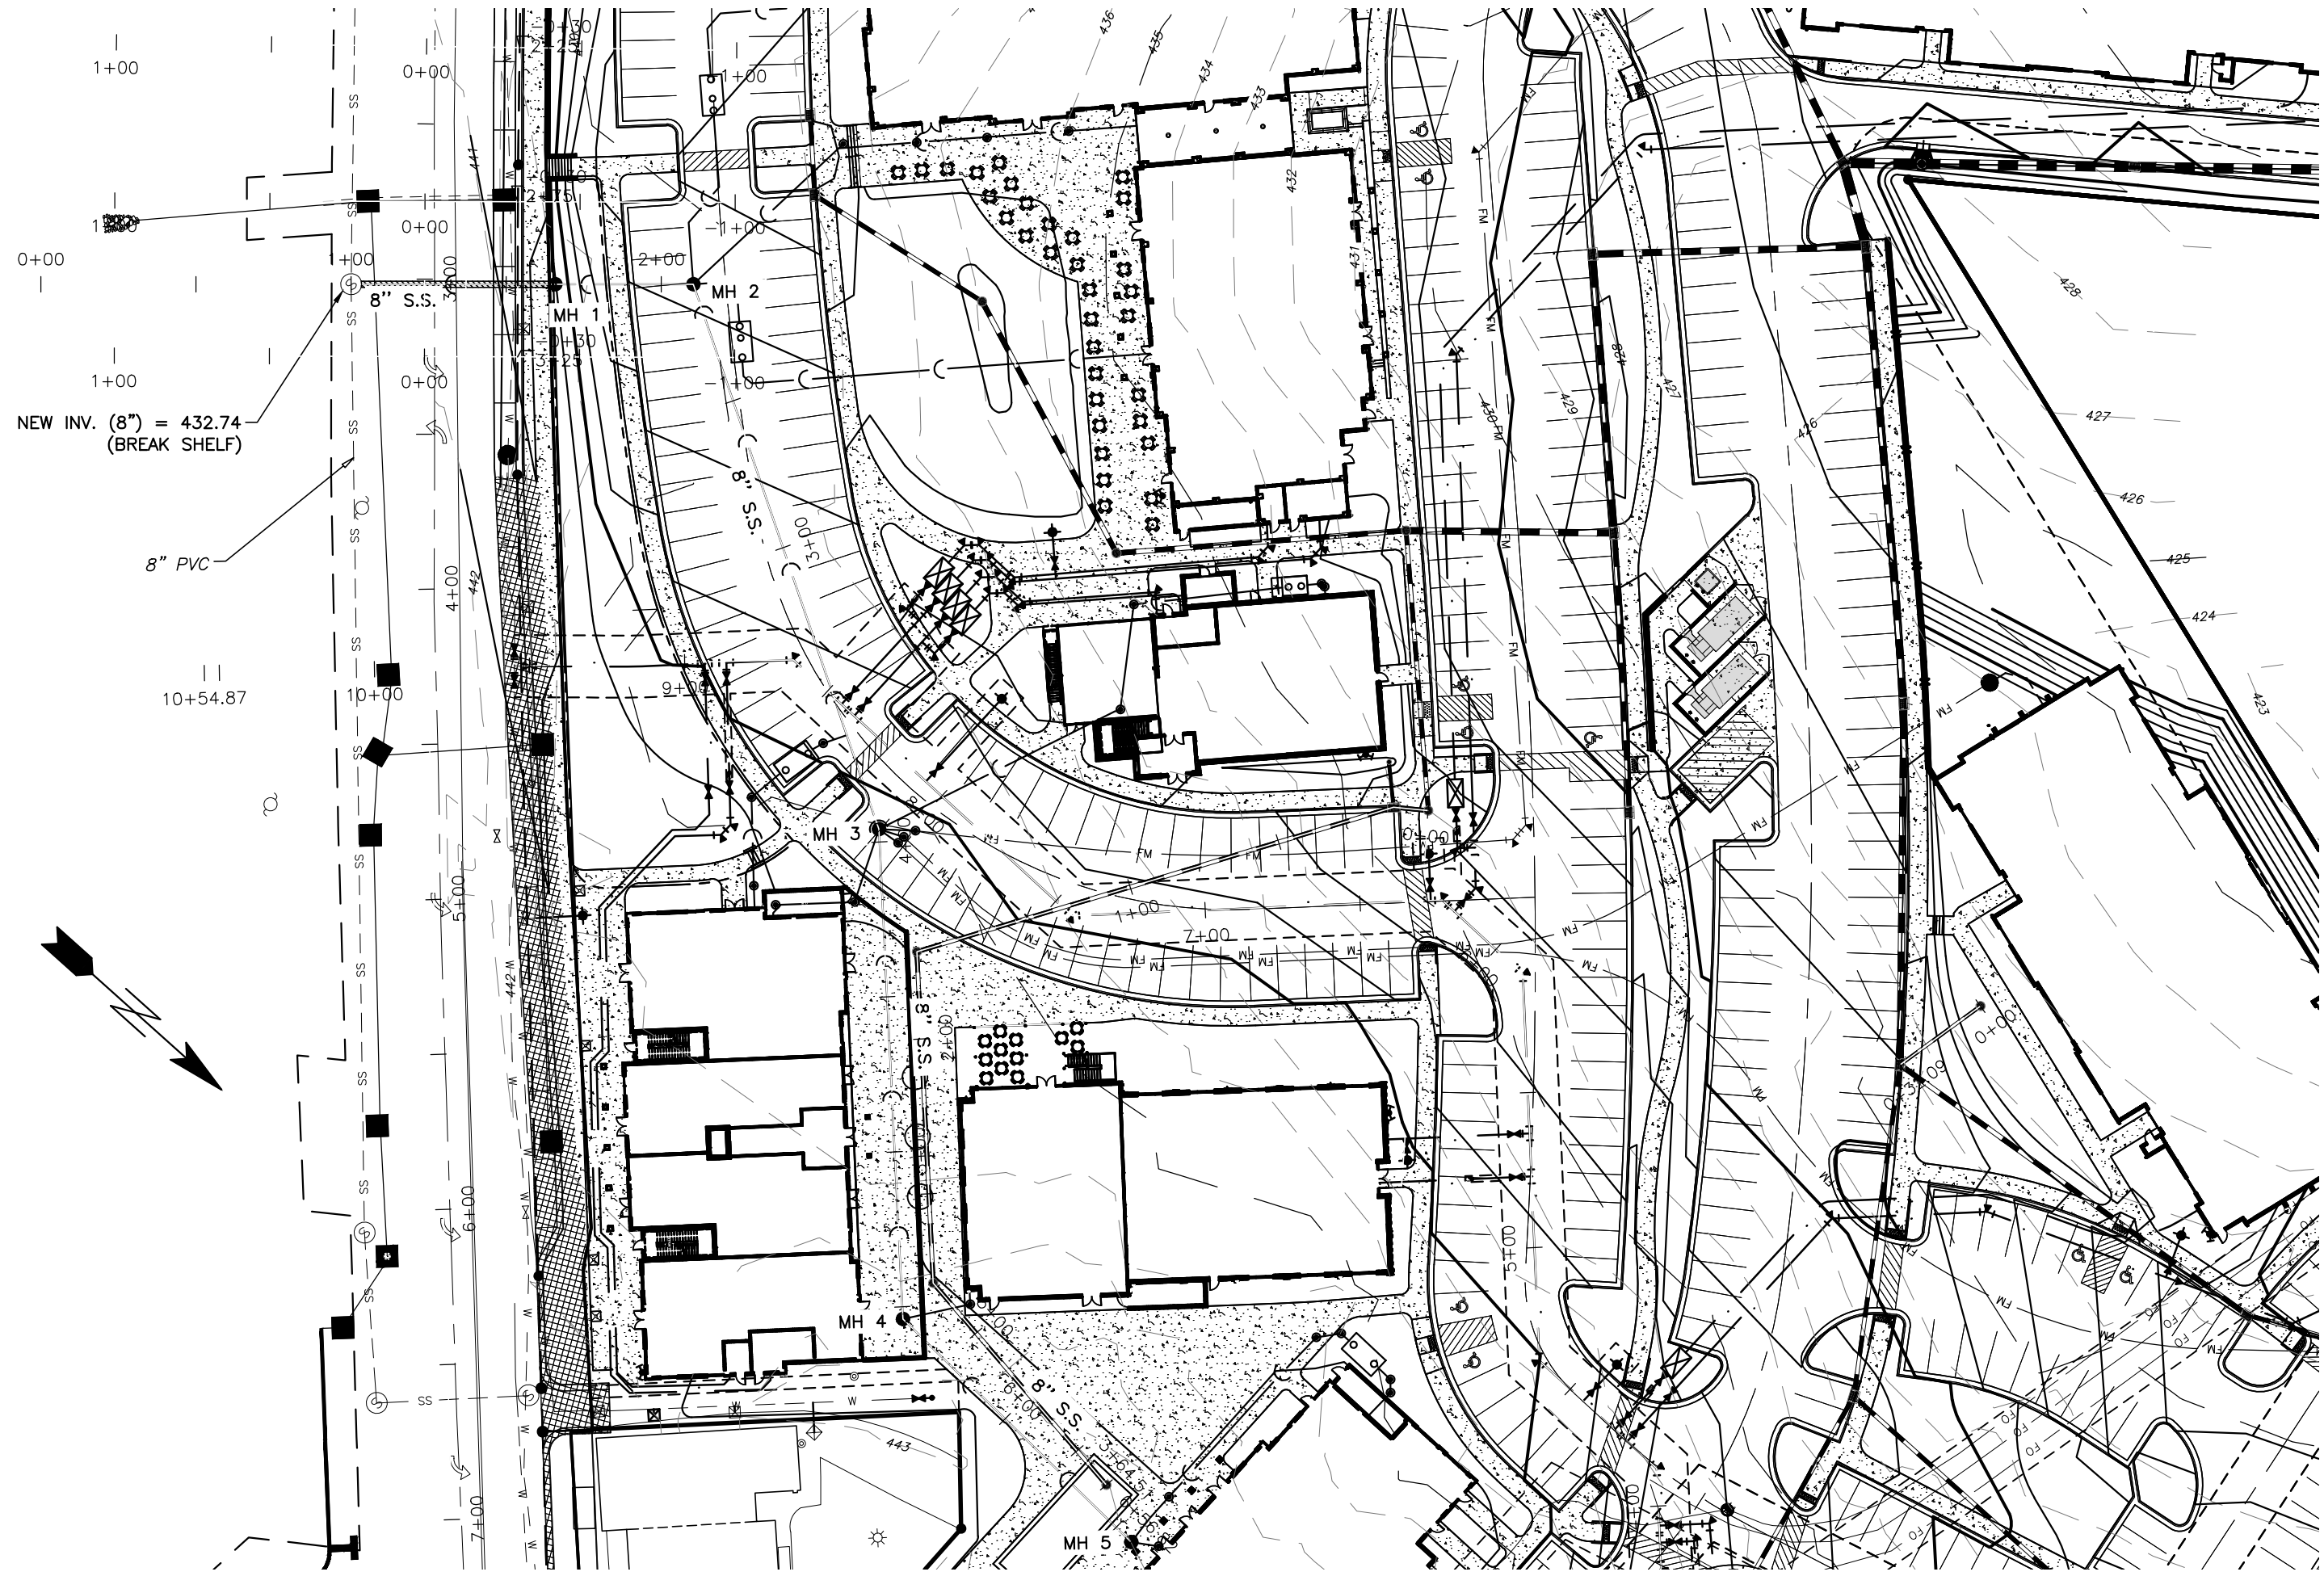

SANITARY SEWER PROFILE

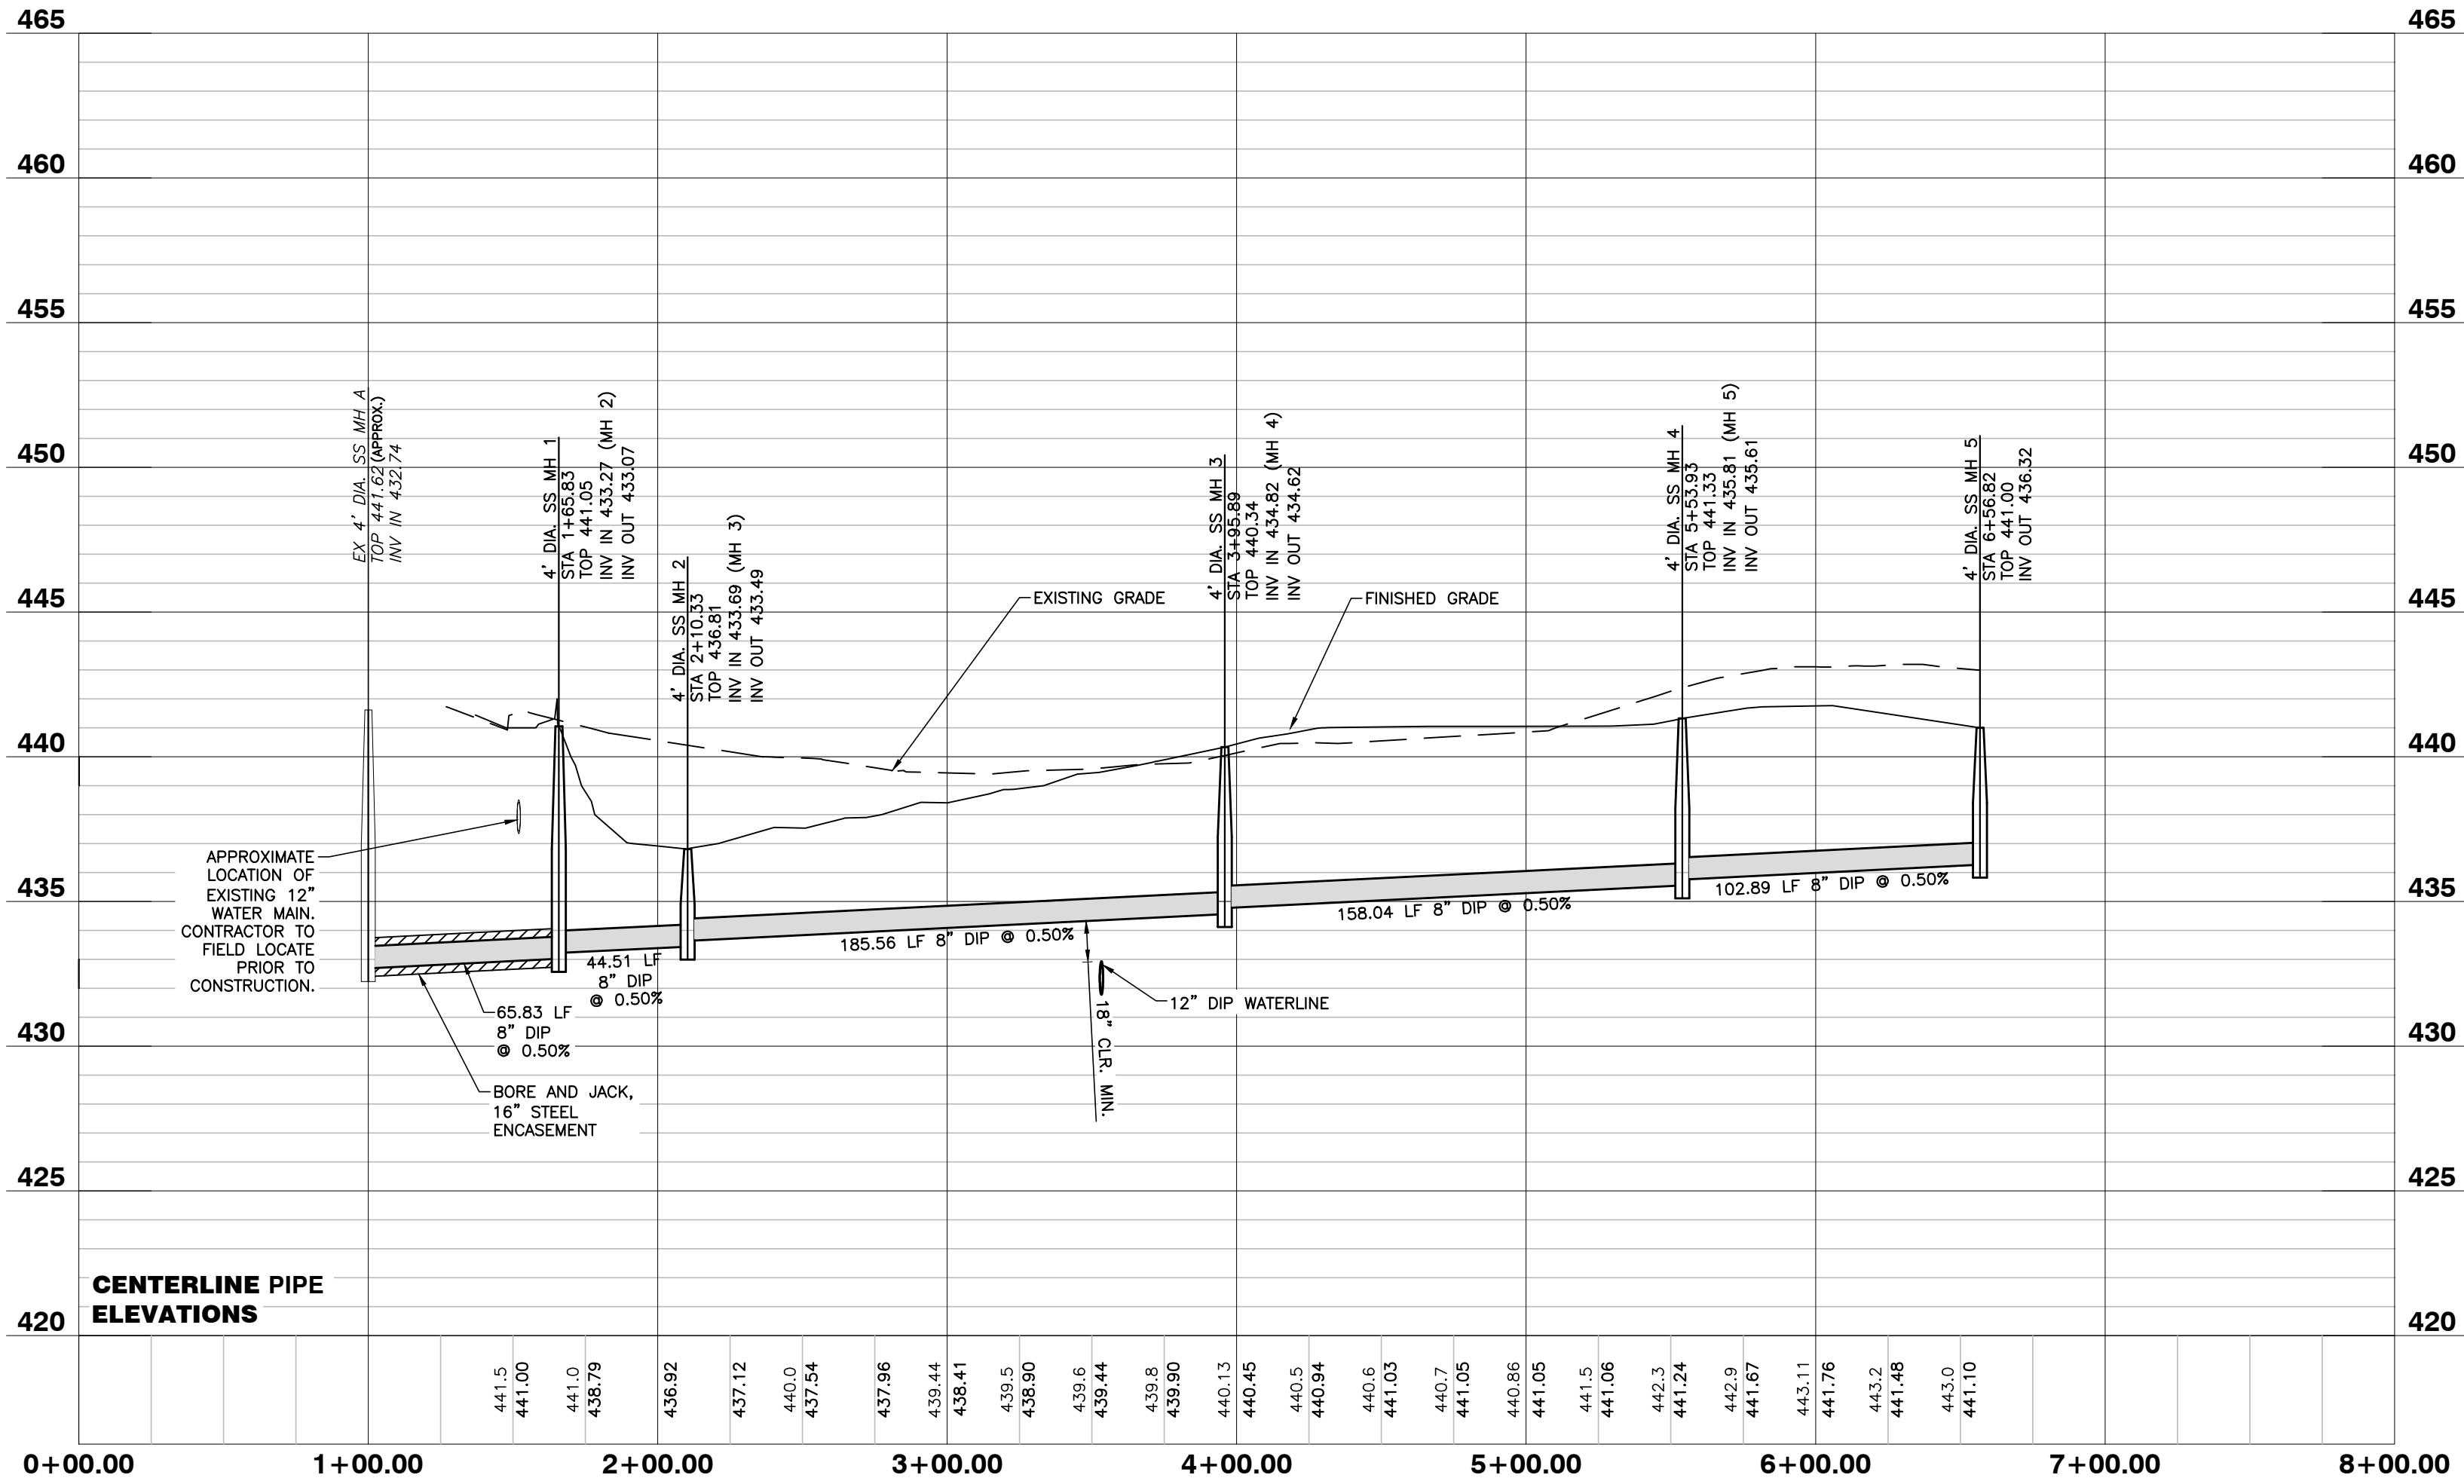

09/01/23

NO FLOODPLAINS EXIST ON-SITE

NOTE: ALL CONSTRUCTION ACTIVITY MUST BE IN ACCORDANCE WITH THE ACCEPTED POLICIES OF THE TOWN OF ROLESVILLE AND NCDOT

Private
Sewer Collection / Extension System
The City of Raleigh consents to the connection to its public sewer system and extension of the private sewer collection system as shown on this plan. The material and construction methods used for this project shall conform to the standards and specifications of the City's Public Utilities Handbook.
City of Raleigh
Public Utilities Department Permit # S-4962 (P)
Authorization to Construct See digital signature

CITY OF RALEIGH - PLANS AUTHORIZED FOR CONSTRUCTION

Electronic Approval: This approval is being issued electronically. This approval is valid only upon the signature of a City of Raleigh Review Officer below. The City will retain a copy of the approved plans. Any work authorized by this approval must proceed in accordance with the plans kept on file with the City. This electronic approval may not be edited once issued. Any modification to this approval once issued will invalidate this approval.

City of Raleigh Development Approval

Raleigh Water Review Officer

BASS, NIXON & KENNEDY, INC.
CONSULTING ENGINEERS
6310 CHAPEL HILL ROAD, SUITE 250, RALEIGH, NC 27607
TELEPHONE: (919) 881-1422 FAX: (919) 881-8888
CERTIFICATION NUMBERS: NCBELS (C-0110); NCBOLA (C-0267)





NO.	DATE	DESCRIPTION	BY

03-19157 PROGRESS MRN
JOB NO. DATE DRAWN BY
SANITARY SEWER PROFILE

SCALE: 1" = 50' H; 1" = 5' V CHK BY: MDB

COBBLESTONE VILLAGE
MIXED USE DEVELOPMENT
TOWN OF ROLESVILLE, WAKE COUNTY, NORTH CAROLINA

SHEET
C4.2

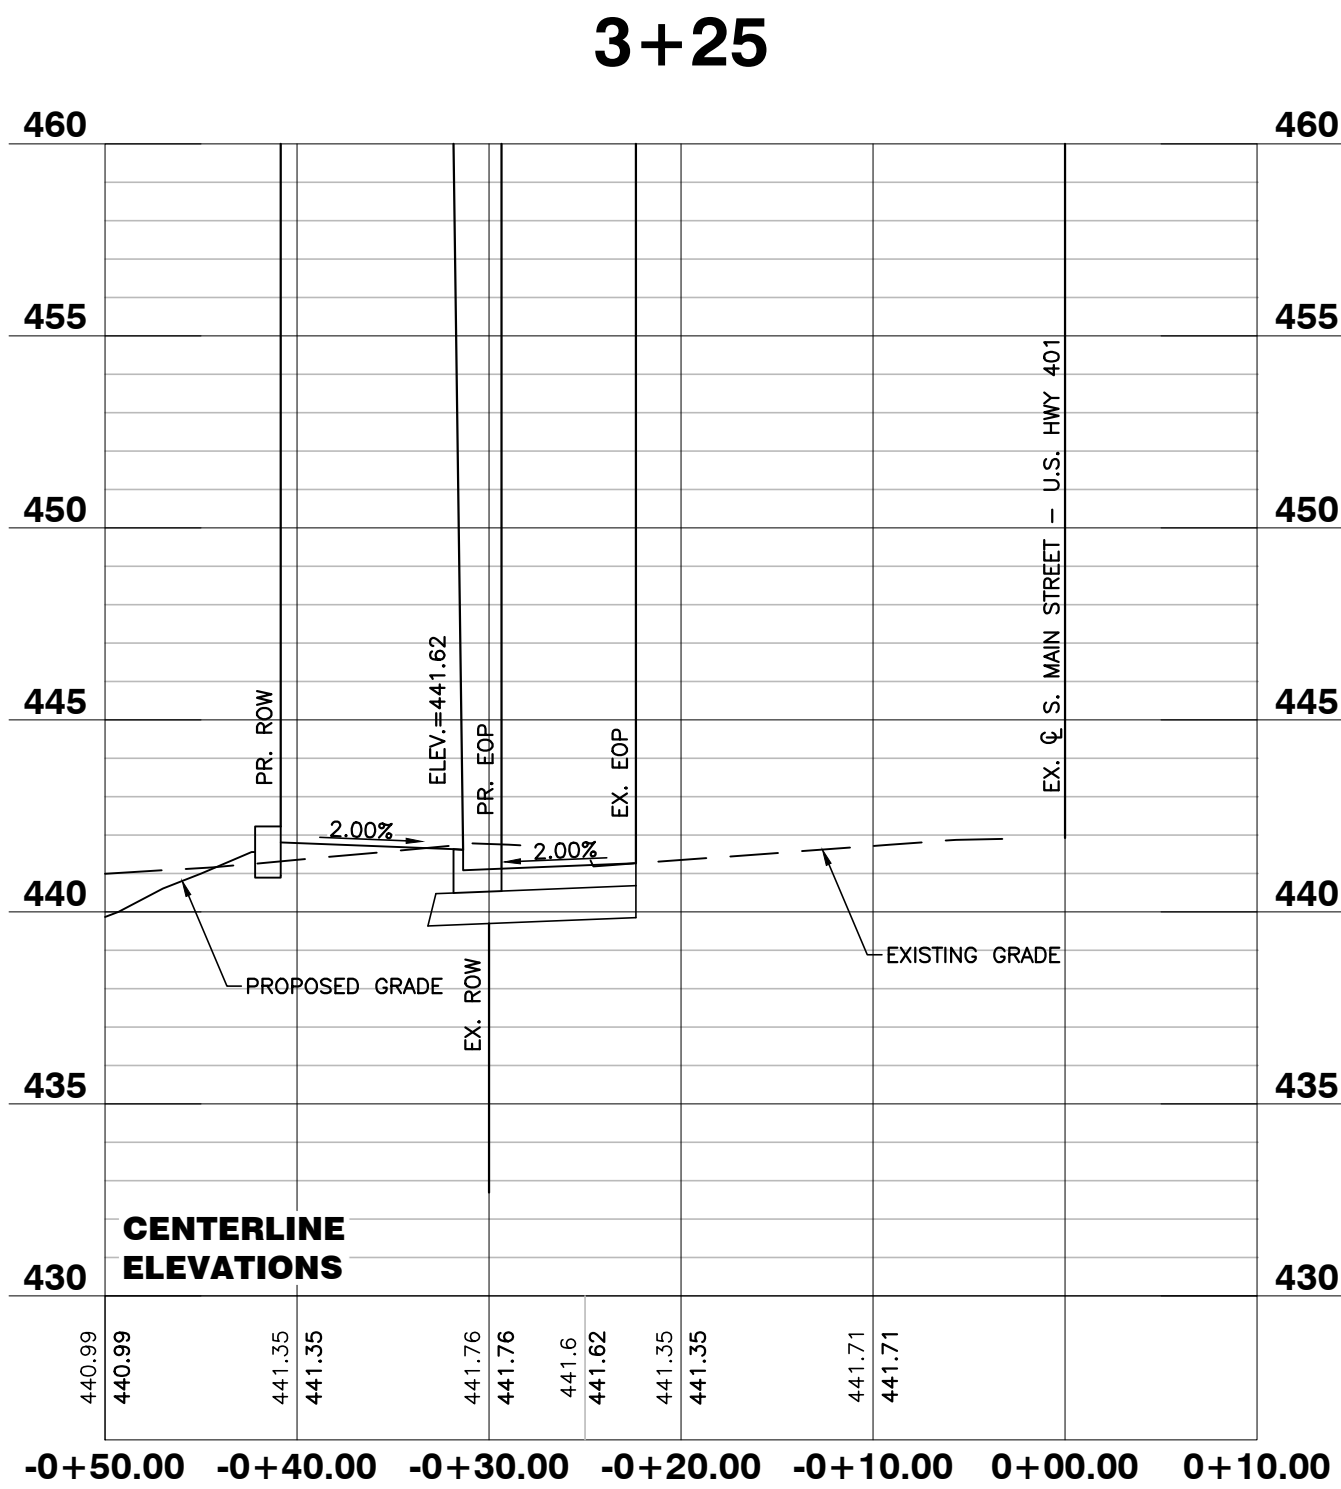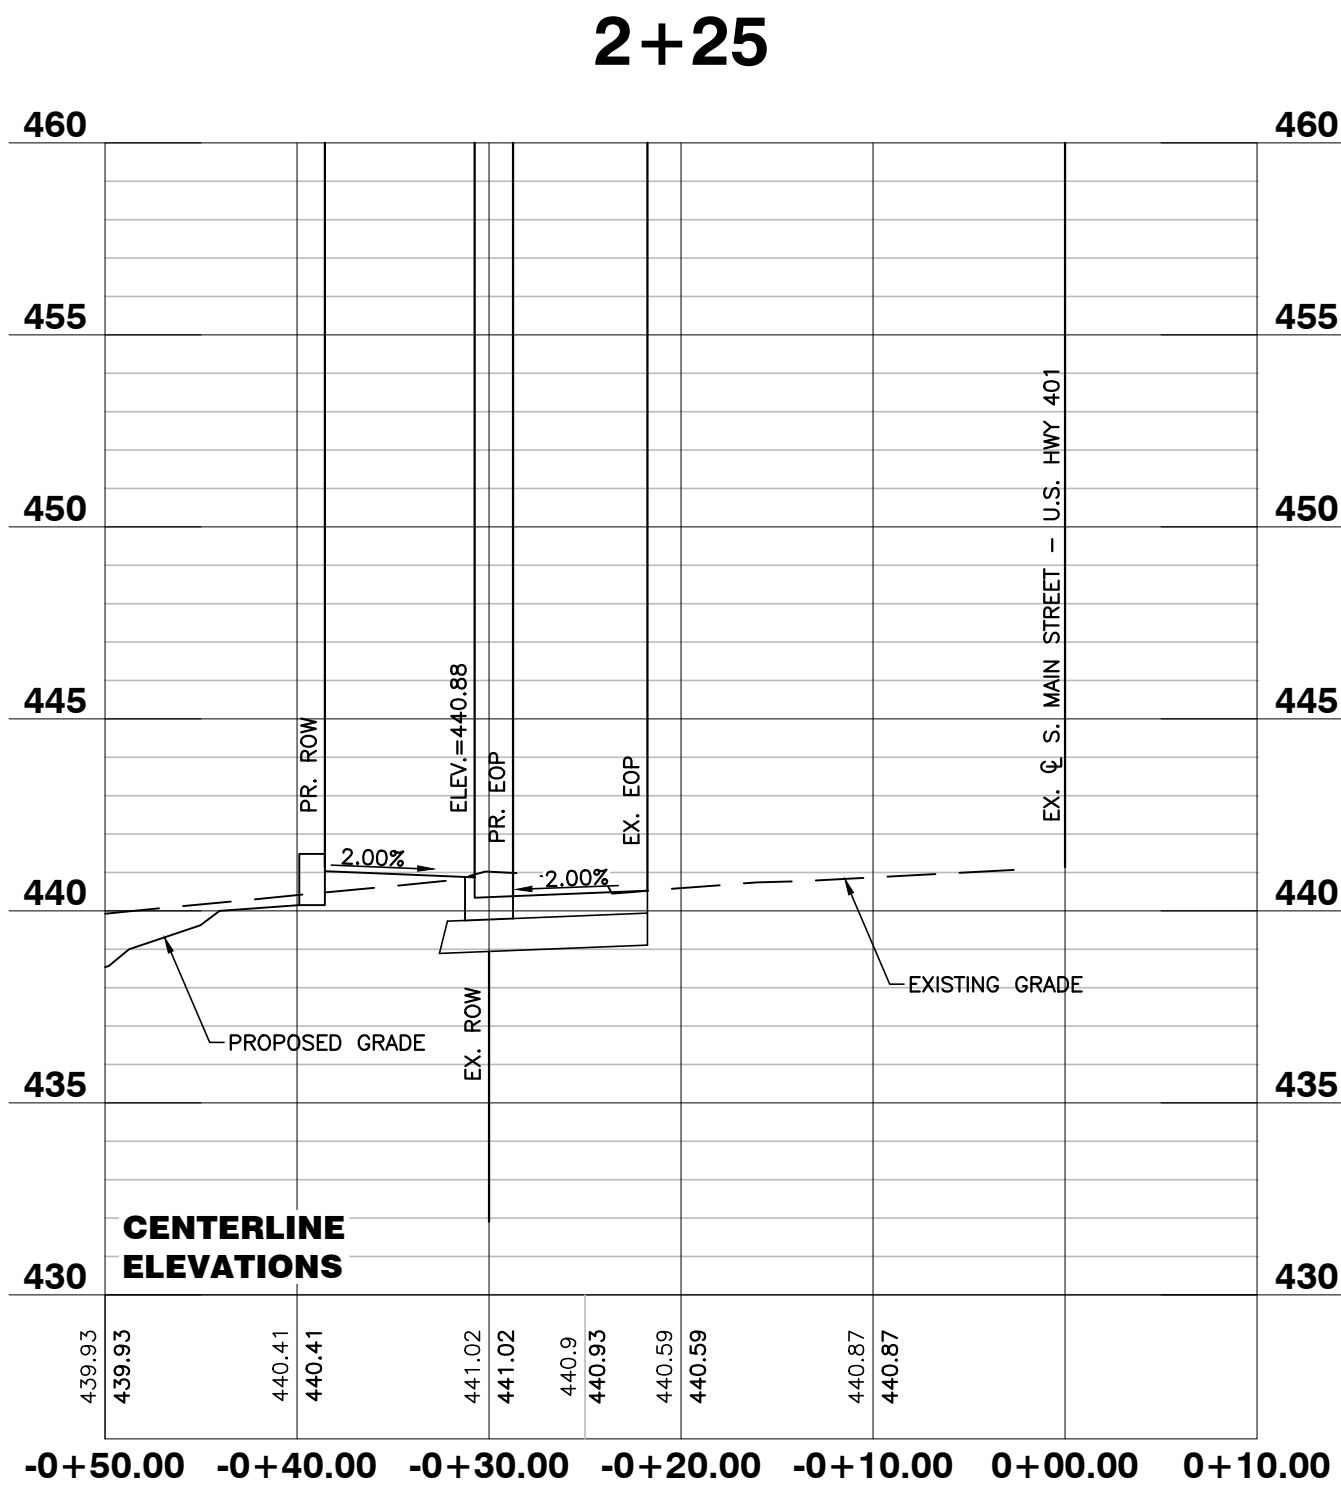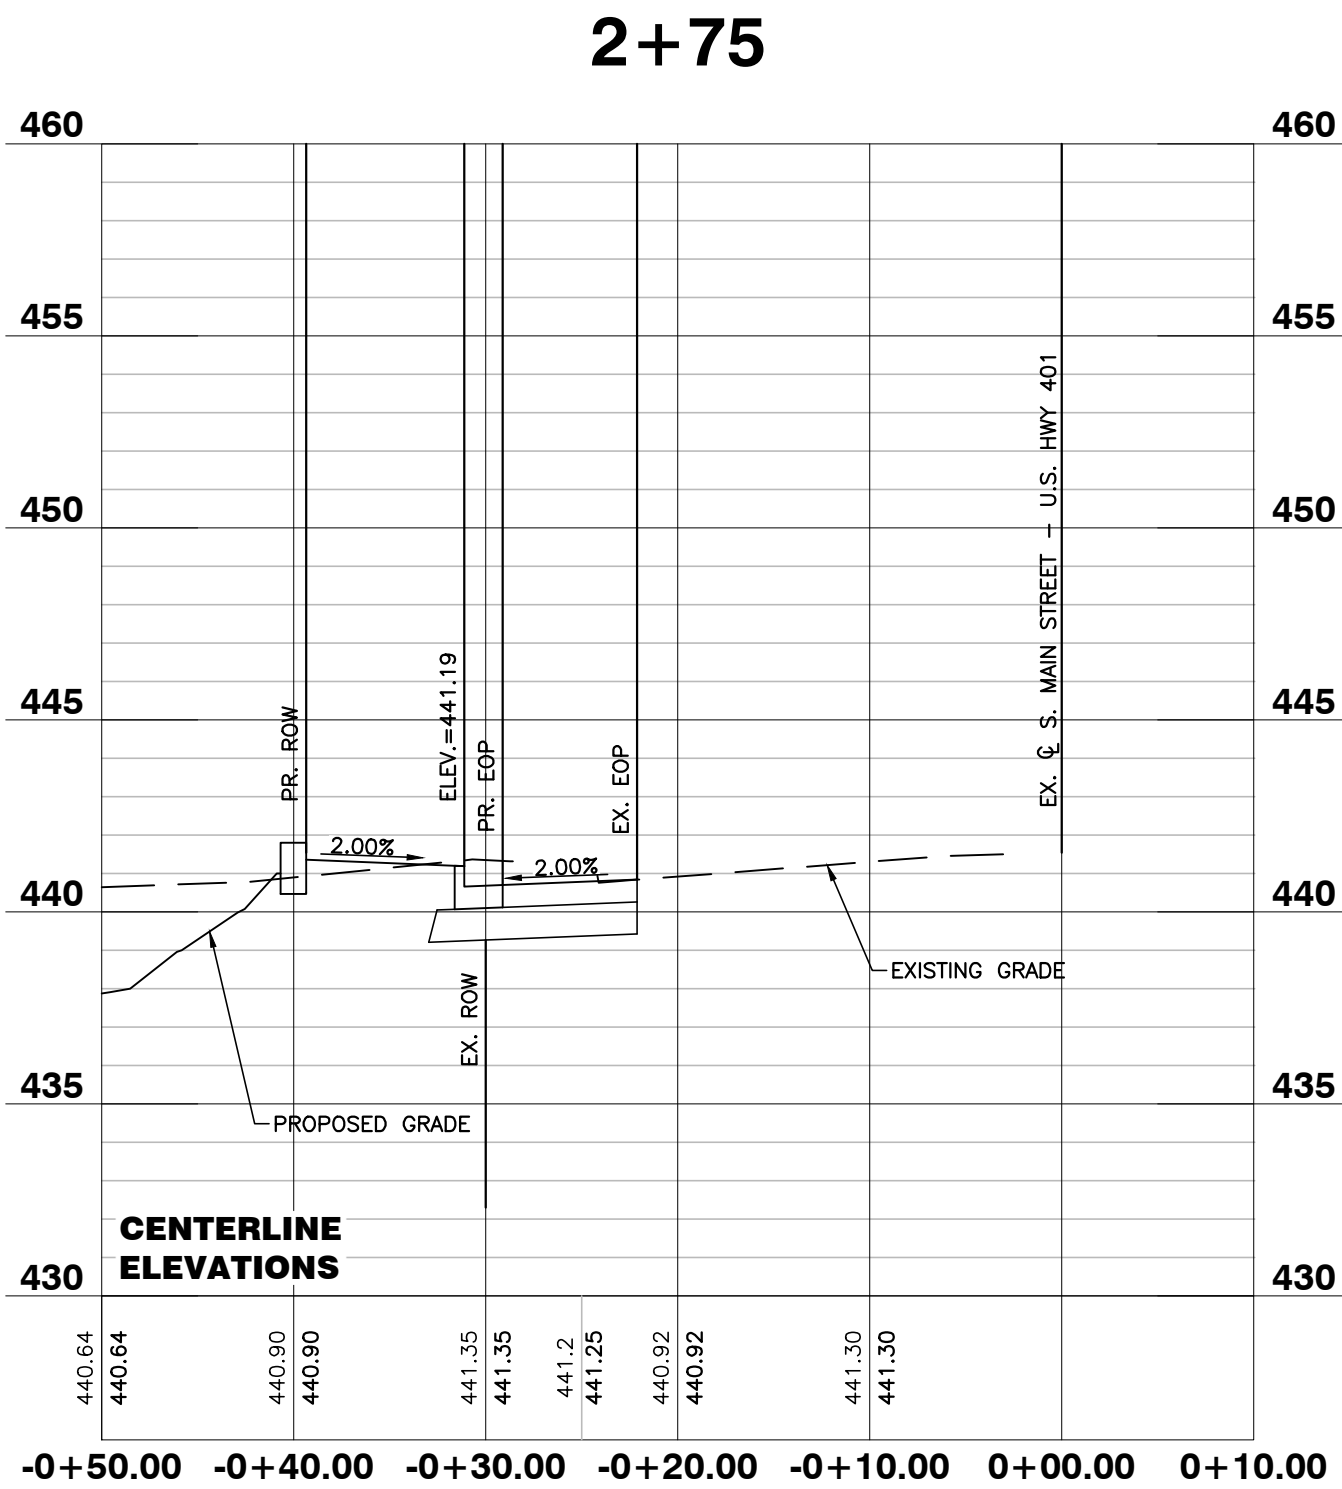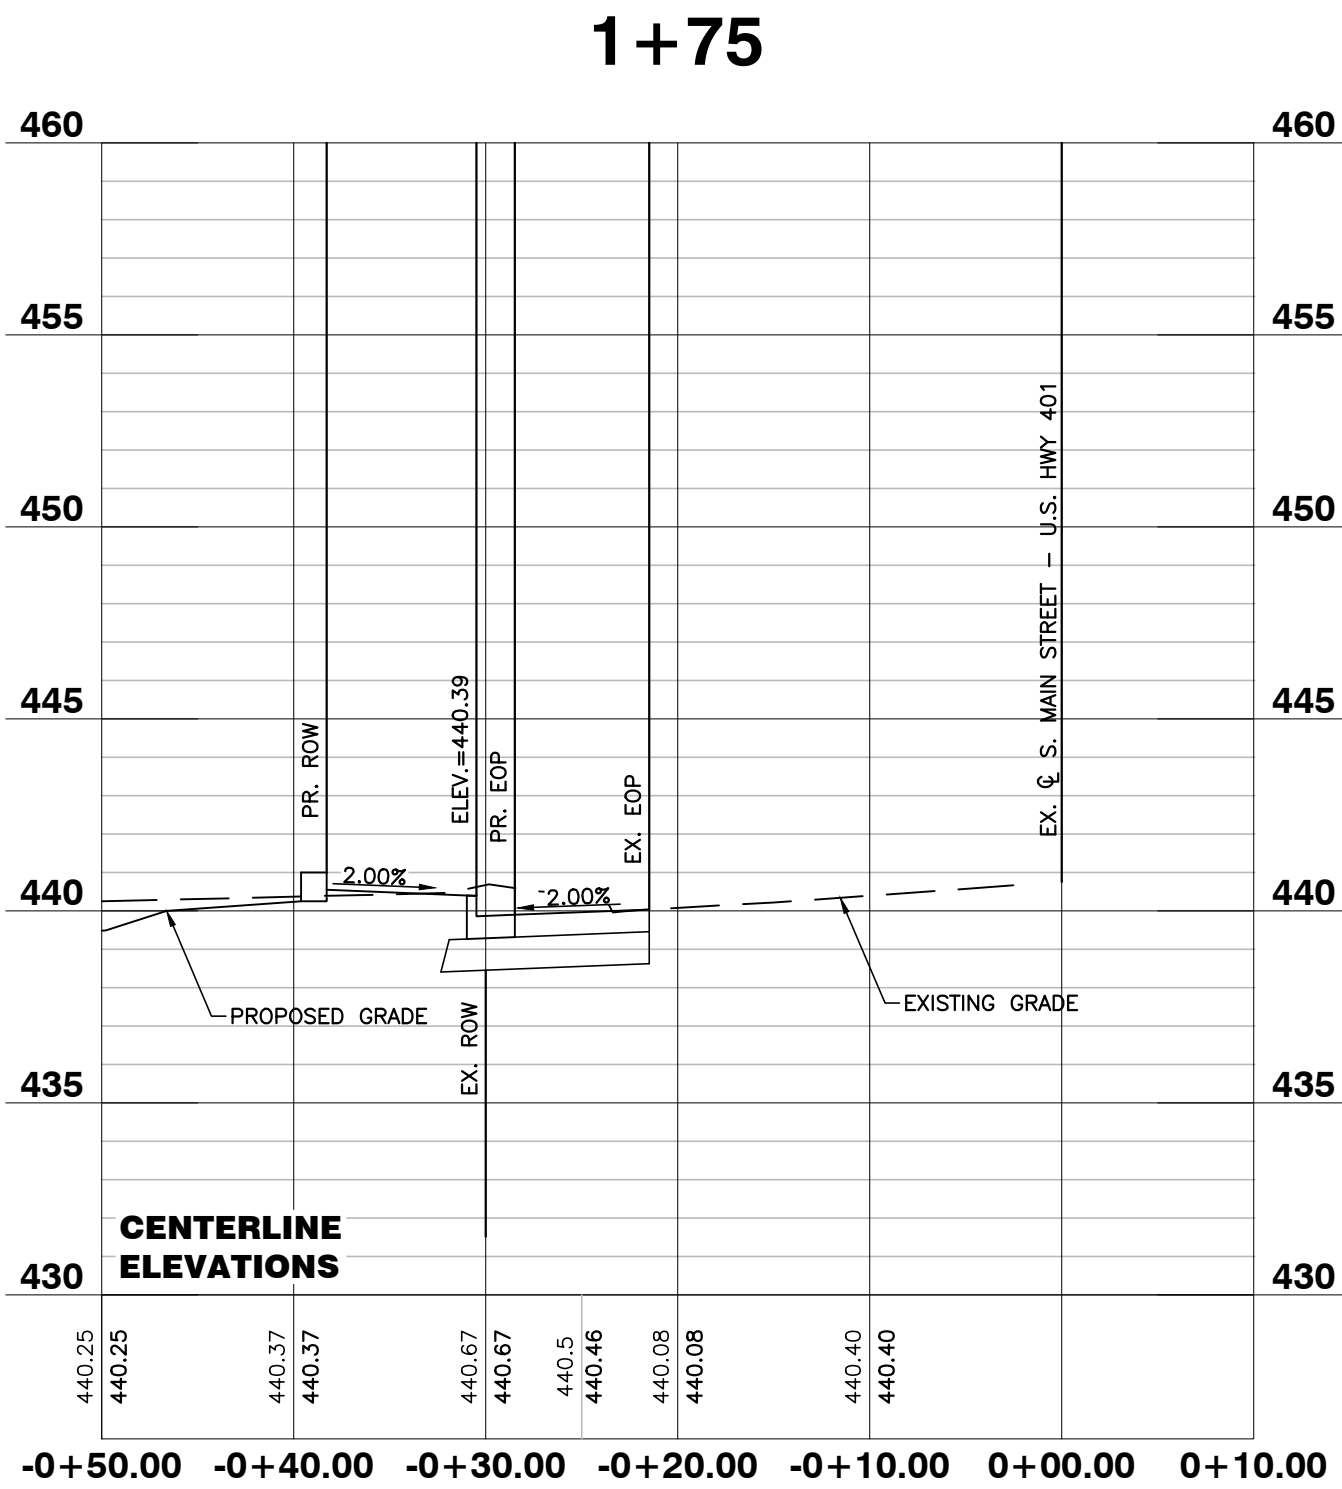

CITY OF RALEIGH - PLANS AUTHORIZED FOR CONSTRUCTION

Electronic Approval: This approval is being issued electronically. This approval is valid only upon the signature of a City of Raleigh Review Officer below. The City will retain a copy of the approved plans. Any work authorized by this approval must proceed in accordance with the plans kept on file with the City. This electronic approval may not be edited once issued. Any modification to this approval once issued will invalidate this approval.

City of Raleigh Development Approval _____

Raleigh Water Review Officer

NO FLOODPLAINS EXIST ON-SITE

NOTE: ALL CONSTRUCTION ACTIVITY MUST BE IN ACCORDANCE WITH THE ACCEPTED POLICIES OF THE TOWN OF ROLESVILLE AND NCDOT



09/01/23

COBBLESTONE VILLAGE MIXED USE DEVELOPMENT
TOWN OF ROLESVILLE, WAKE COUNTY, NORTH CAROLINA

SHEET C4.3


03-19157 PROGRESS MRM
JOB NO. DATE DRAWN BY
S. MAIN ST. - U.S. 401
WIDENING CROSS SECTIONS
SCALE: 1" = 50' H; 1" = 5' V CHK BY: MDB

NO.	DATE	DESCRIPTION	BY

BASS, NIXON & KENNEDY, INC.
CONSULTING ENGINEERS
6310 CHAPEL HILL ROAD, SUITE 250, RALEIGH, NC 27607
TELEPHONE: (919) 851-1122 FAX: (919) 851-8888
CERTIFICATION NUMBERS: NCBELS (C-0110); NCBOLA (C-0287)



Outdoor Lighting
Shoebox LED

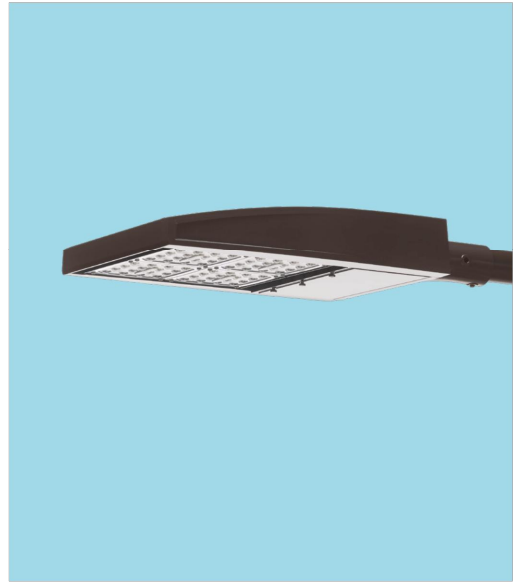

The energy-efficient Shoebox LED combines a decorative, contemporary style with versatility and ample lighting effect that is perfect for streets, parking lots, commercial buildings and residential communities. The Shoebox LED provides excellent color rendition along with a controlled light pattern that reduces glare and keeps the light directed only where you want it. Available in black, dark bronze, gray or white with one to four fixtures per pole.

LED (Light Emitting Diode)	150, 220, 420, 530 watts
Mounting heights	25', 30', 35'
Colors	Black Bronze Gray White
Poles	Fiberglass (1 or 2 fixtures per pole) Decorative tapered metal Decorative square metal

Note: 35' pole available in black or bronze only.

For additional information, visit us at duke-energy.com/OutdoorLighting or call us toll free at 866.769.6417.



Outdoor Lighting
Shoebox LED

Light source: LED (white)				
Replacement for* LED Wattage 150 – 250-watt HPS and metal halide; LED Wattage 205 – up to 400-watt metal halide; LED Wattage 530 – 1,000-watt metal halide				
Warm-up and restrike time: Instant on (no warm-up or restrike time)				
Wattage	BUG Rating	Light Pattern	Lumens	Color Temp
LED 150	B5-U0-G3	IESNA Type V (circular)	19580	4,000K
LED 150	B3-U0-G4	IESNA Type IV (forward throw)	18459	
LED 150	B2-U0-G3	IESNA Type III (oval)	19006	
LED 220	B5-U0-G3	IESNA Type V (circular)	25870	
LED 220	B3-U0-G4	IESNA Type IV (forward throw)	24390	
LED 220	B2-U0-G4	IESNA Type III (oval)	25114	
LED 420	B5-U0-G5	IESNA Type V (circular)	48514	
LED 420	B3-U0-G5	IESNA Type IV (forward throw)	43765	
LED 530	B5-U0-G5	IESNA Type V (circular)	60296	
LED 530	B3-U0-G5	IESNA Type IV (forward throw)	54395	


* These are approximate replacement suggestions; actual conditions could be different.

Poles available:	Mounting height	Color
Round tapered decorative metal*	35'	Black Bronze
Decorative square metal*	25' and 30'	Black Bronze Gray White
Fiberglass	30'	Black (1 or 2 fixtures per pole) Gray (1 or 2 fixtures per pole)



Features	Benefits
Little or no installation cost	Frees up capital for other projects
Design services by lighting professionals included	Meets industry standards and lighting ordinances
Maintenance included	Eliminates high and unexpected repair bills
Electricity included	Less expensive than metered service
Warranty included	Worry-free
One low monthly cost on your electric bill	Convenience and savings for you
Turnkey operation	Provides hassle-free installation and service
Backed by over 40 years of experience	A name you can trust today ... and tomorrow

*2" raised foundation available when required on metal poles only.

©2019 Duke Energy Corporation 193519 12/19

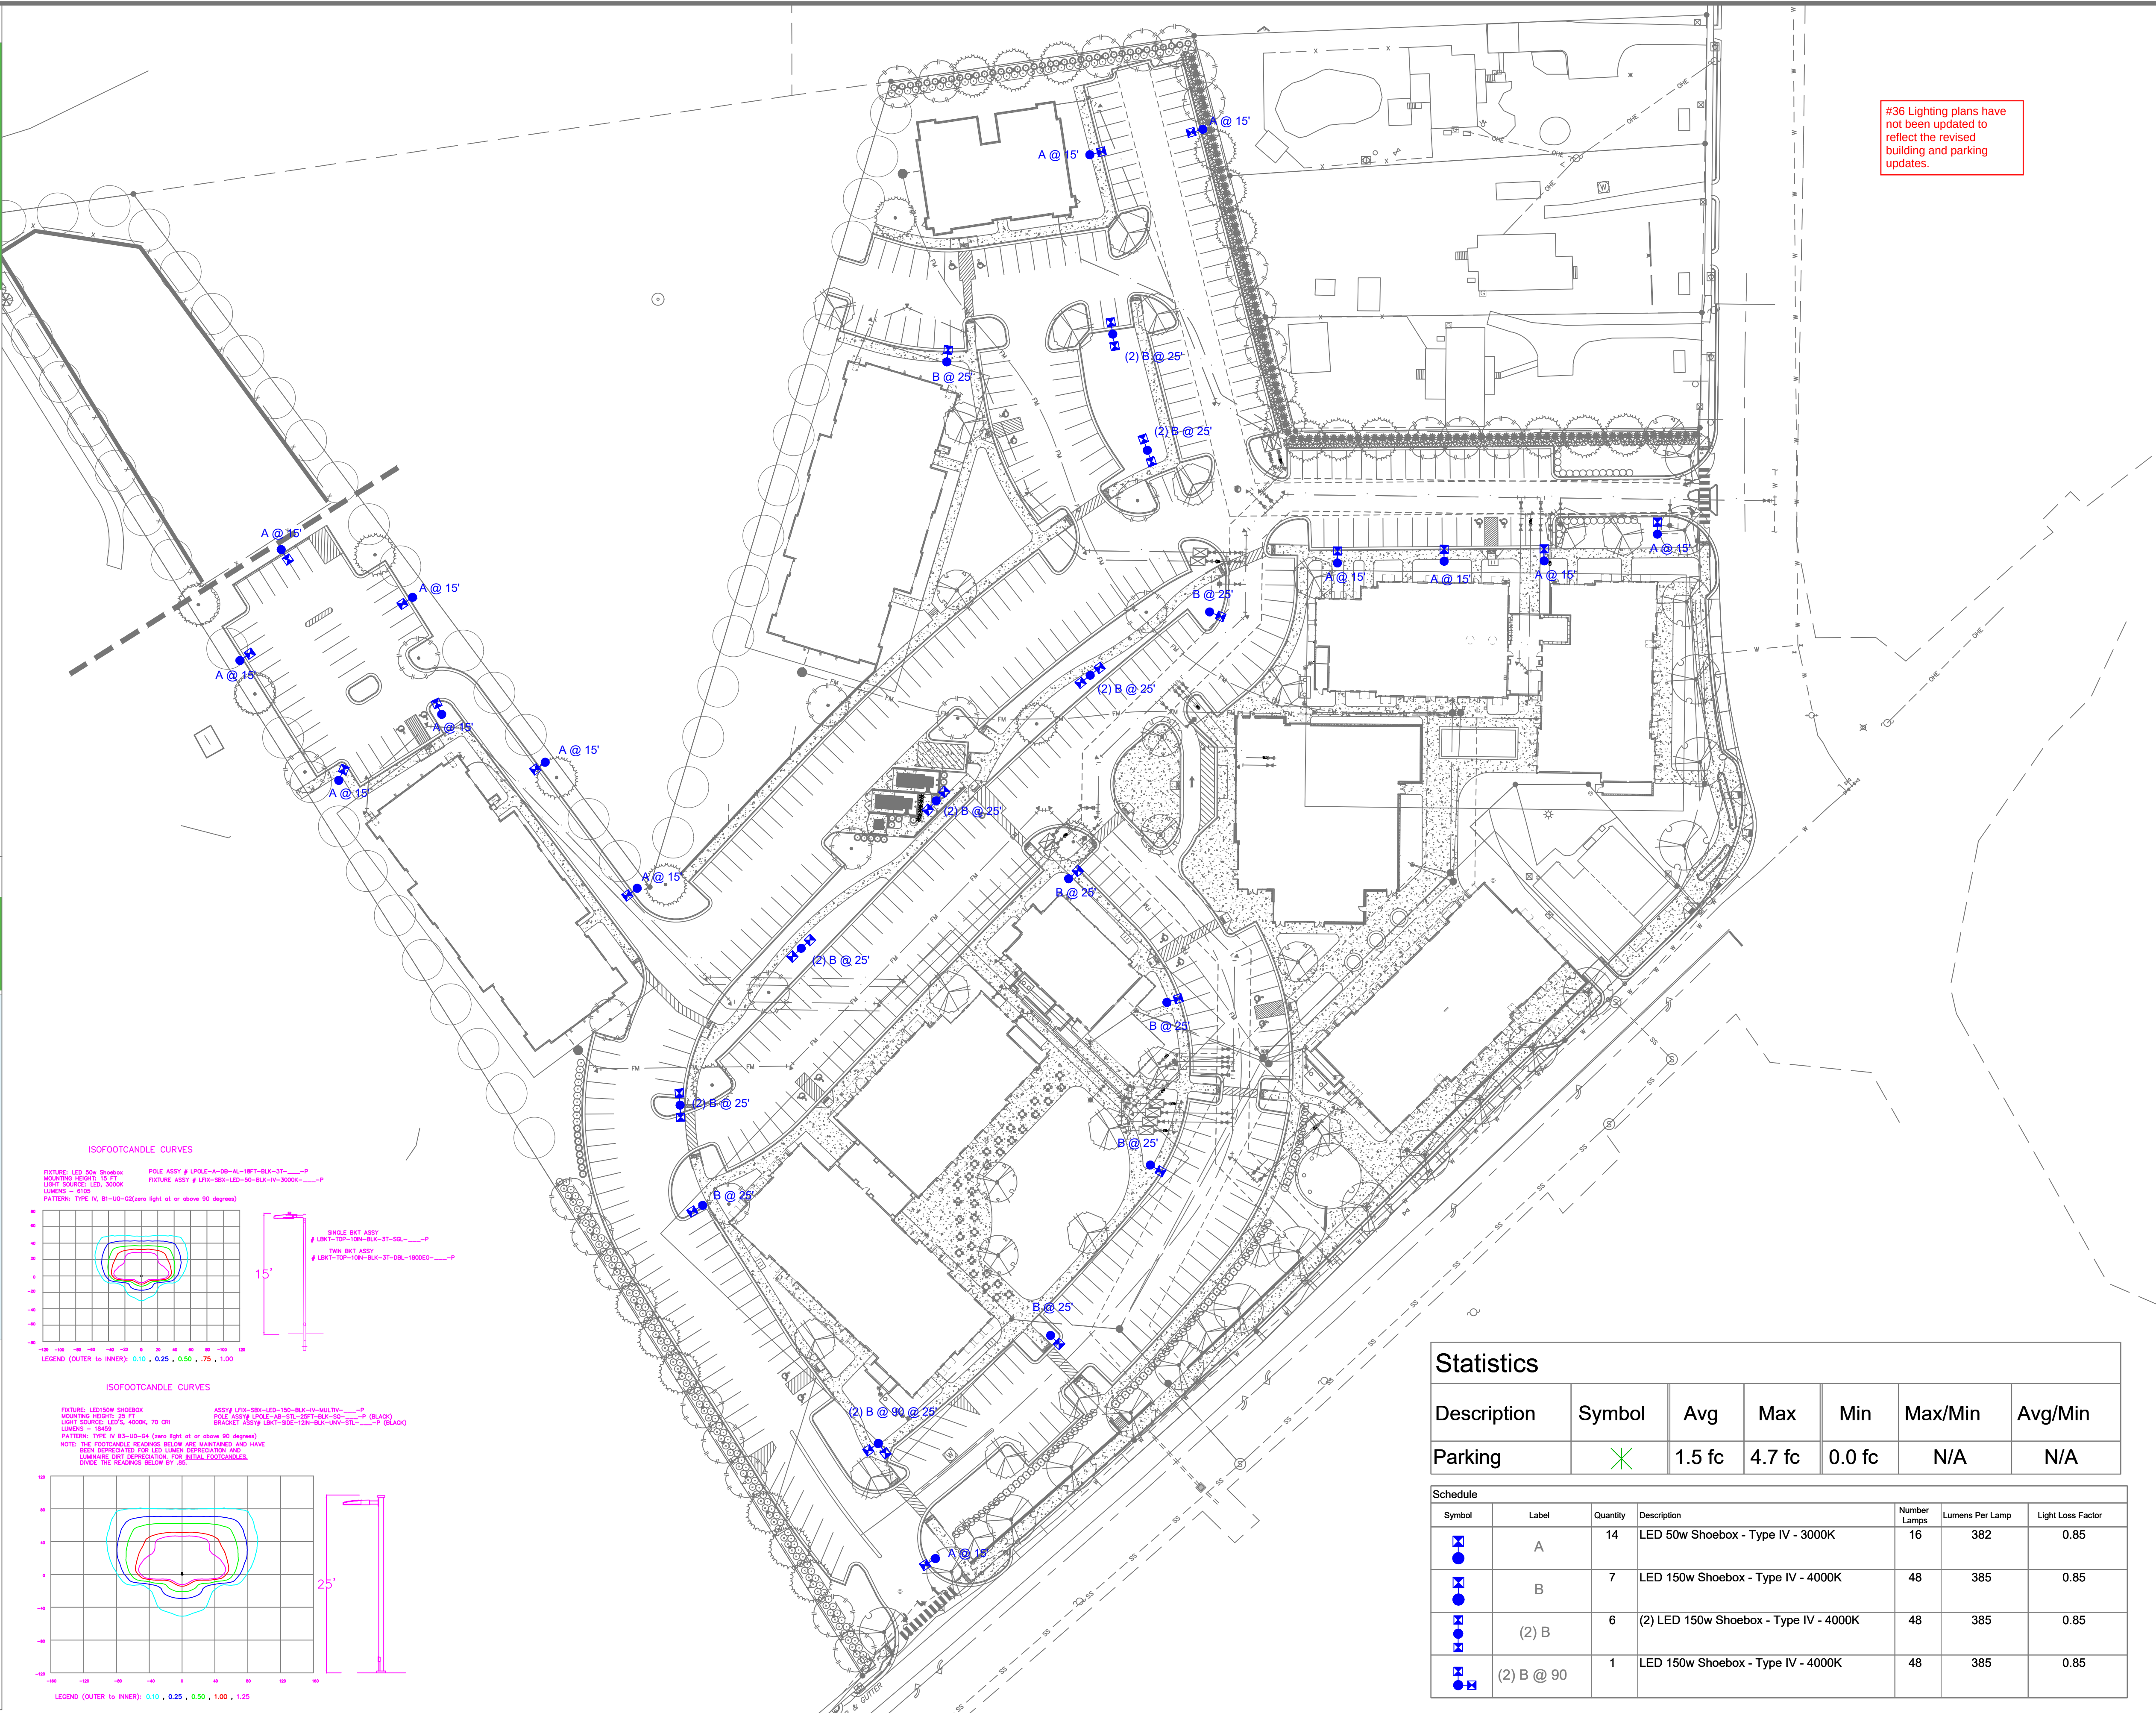

#36 Lighting plans have not been updated to reflect the revised building and parking updates.

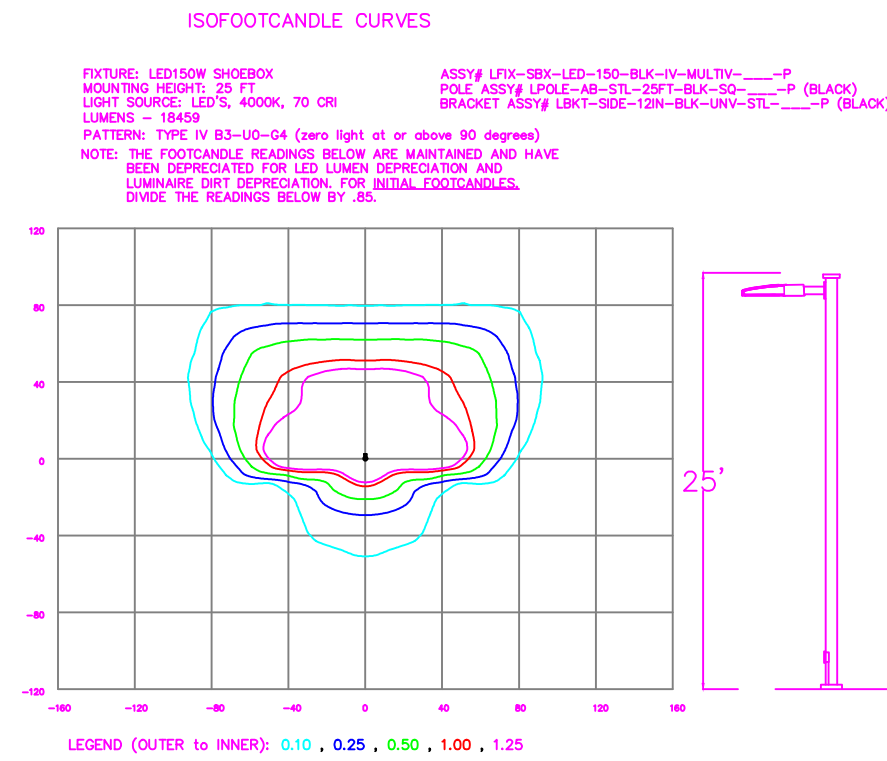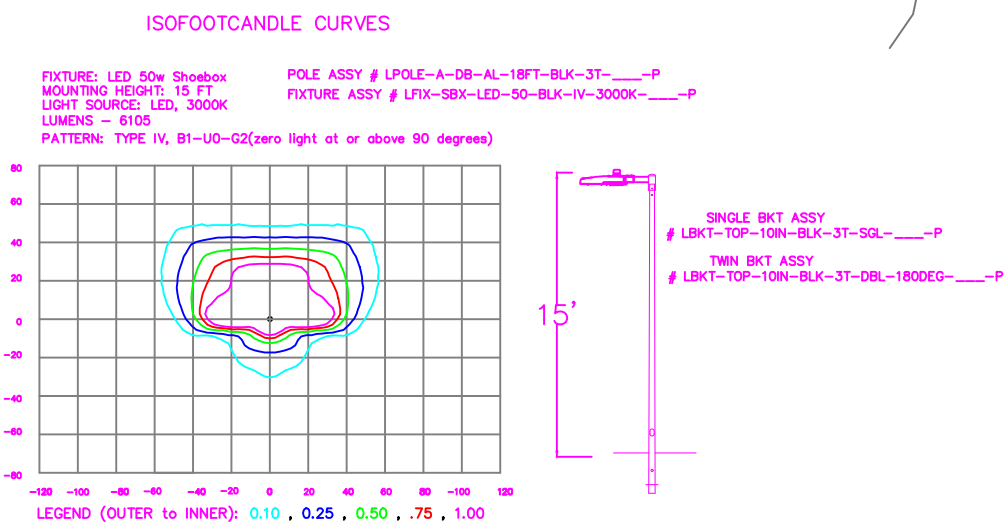

Statistics

Description	Symbol	Avg	Max	Min	Max/Min	Avg/Min
Parking	✕	1.5 fc	4.7 fc	0.0 fc	N/A	N/A

Schedule						
Symbol	Label	Quantity	Description	Number Lamps	Lumens Per Lamp	Light Loss Factor
●	A	14	LED 50w Shoebox - Type IV - 3000K	16	382	0.85
●	B	7	LED 150w Shoebox - Type IV - 4000K	48	385	0.85
●	(2) B	6	(2) LED 150w Shoebox - Type IV - 4000K	48	385	0.85
●	(2) B @ 90	1	LED 150w Shoebox - Type IV - 4000K	48	385	0.85

LIGHTING DESIGN TOLERANCE

The calculated footcandle light levels in this lighting design are predicted values and are based on specific information that has been supplied to Duke Energy. Any inaccuracies in the supplied information, differences in luminaire installation, lighted area geometry including elevation differences, reflective properties of surrounding surfaces, obstructions (follage or otherwise) in the lighted area, or lighting from sources other than listed in this design may produce different results from the predicted values. Normal tolerances of voltage, lamp output, and ballast and luminaire manufacture will also affect results.




PROPRIETARY & CONFIDENTIAL
















This document together with the concepts and designs presented herein, presented as an instrument of service, is the sole property of Duke Energy, and is intended only for the specific purpose and prospective client as stated in the title block of this drawing. Any use, copying, reproduction or disclosure of the drawing, design or any information contained herein by the prospective customer or other entities, including without limitation, architects, engineers, or equipment manufacturers is hereby expressly prohibited and shall not be permitted absent prior written consent from, and payment of compensation to Duke Energy. Duke Energy disclaims any liability or responsibility for any unauthorized use of or reliance on this document.

COBBLESTONE VILLAGE




Rolesville, NC		
SITE LIGHTING PLAN		
Designed by DEP LIGHTING SOLUTIONS		
Reviewed by T. Ferguson	Scale 1" = 50'	
Date 02/14/2022	Size "Arch D"	
Description LED Shoebox		
Drawing No. 22-0047A	Sht. 1	OF 1




Rev A	02/14/22	LED Shoebox	NJ
REV#	DATE	REVISION	BY

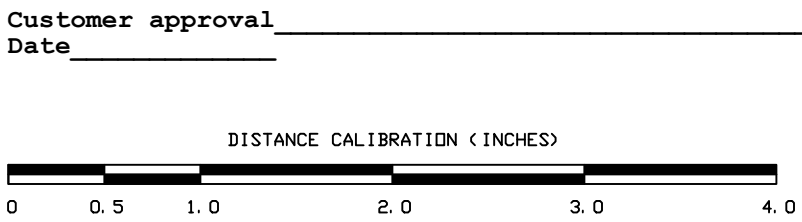

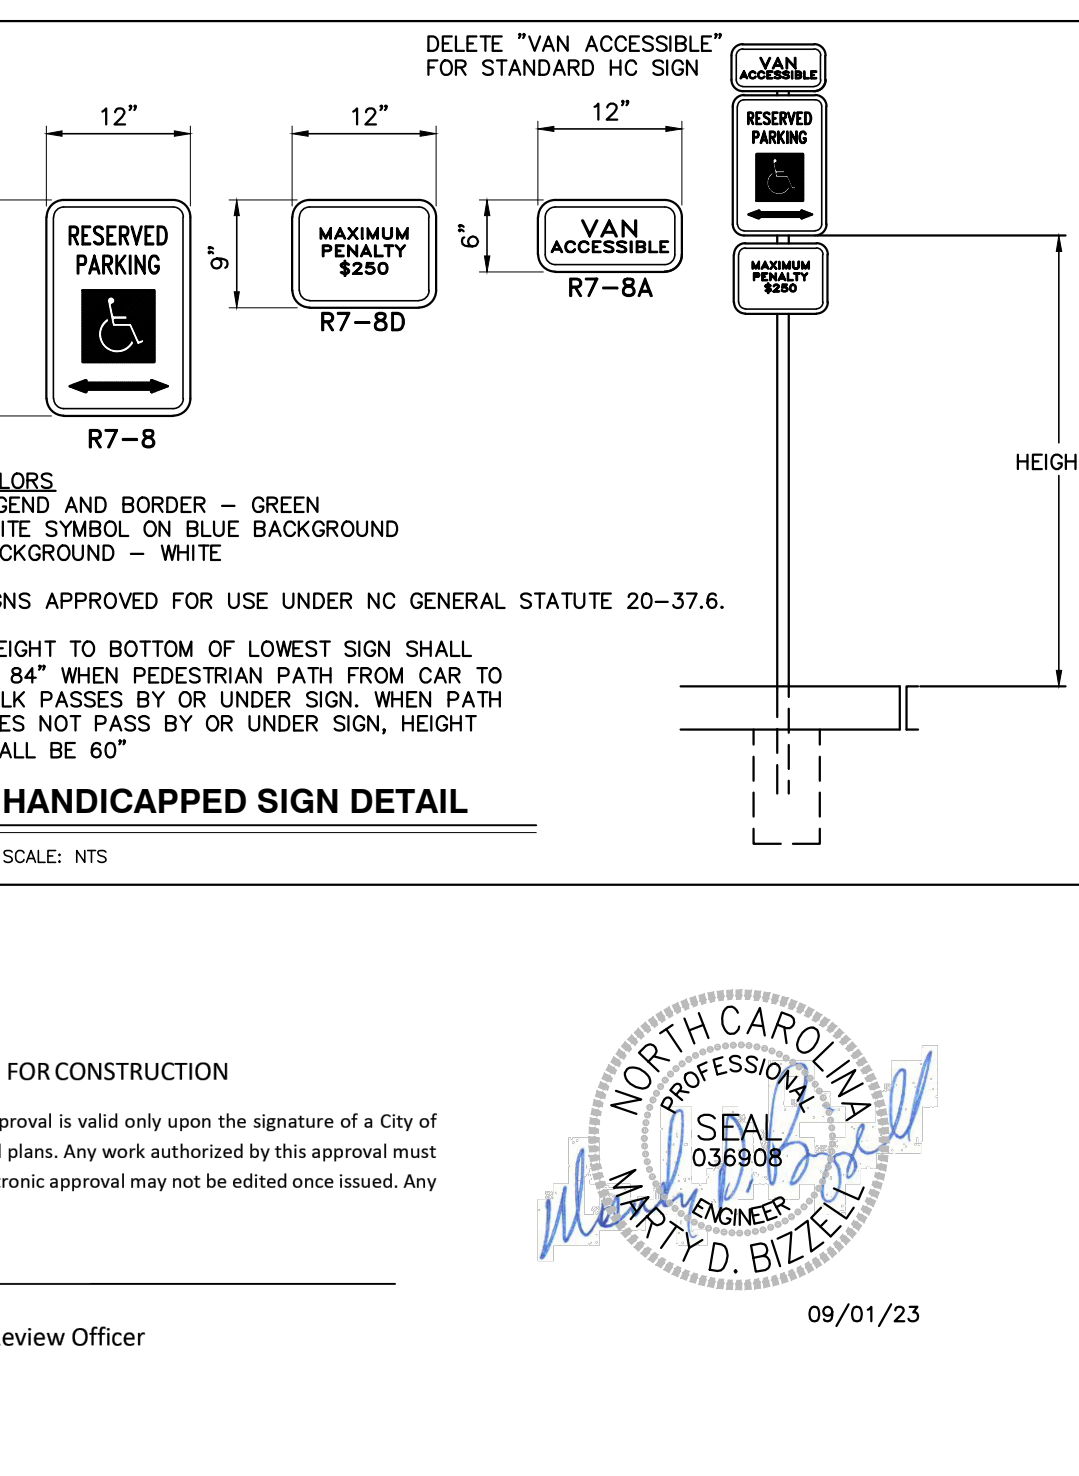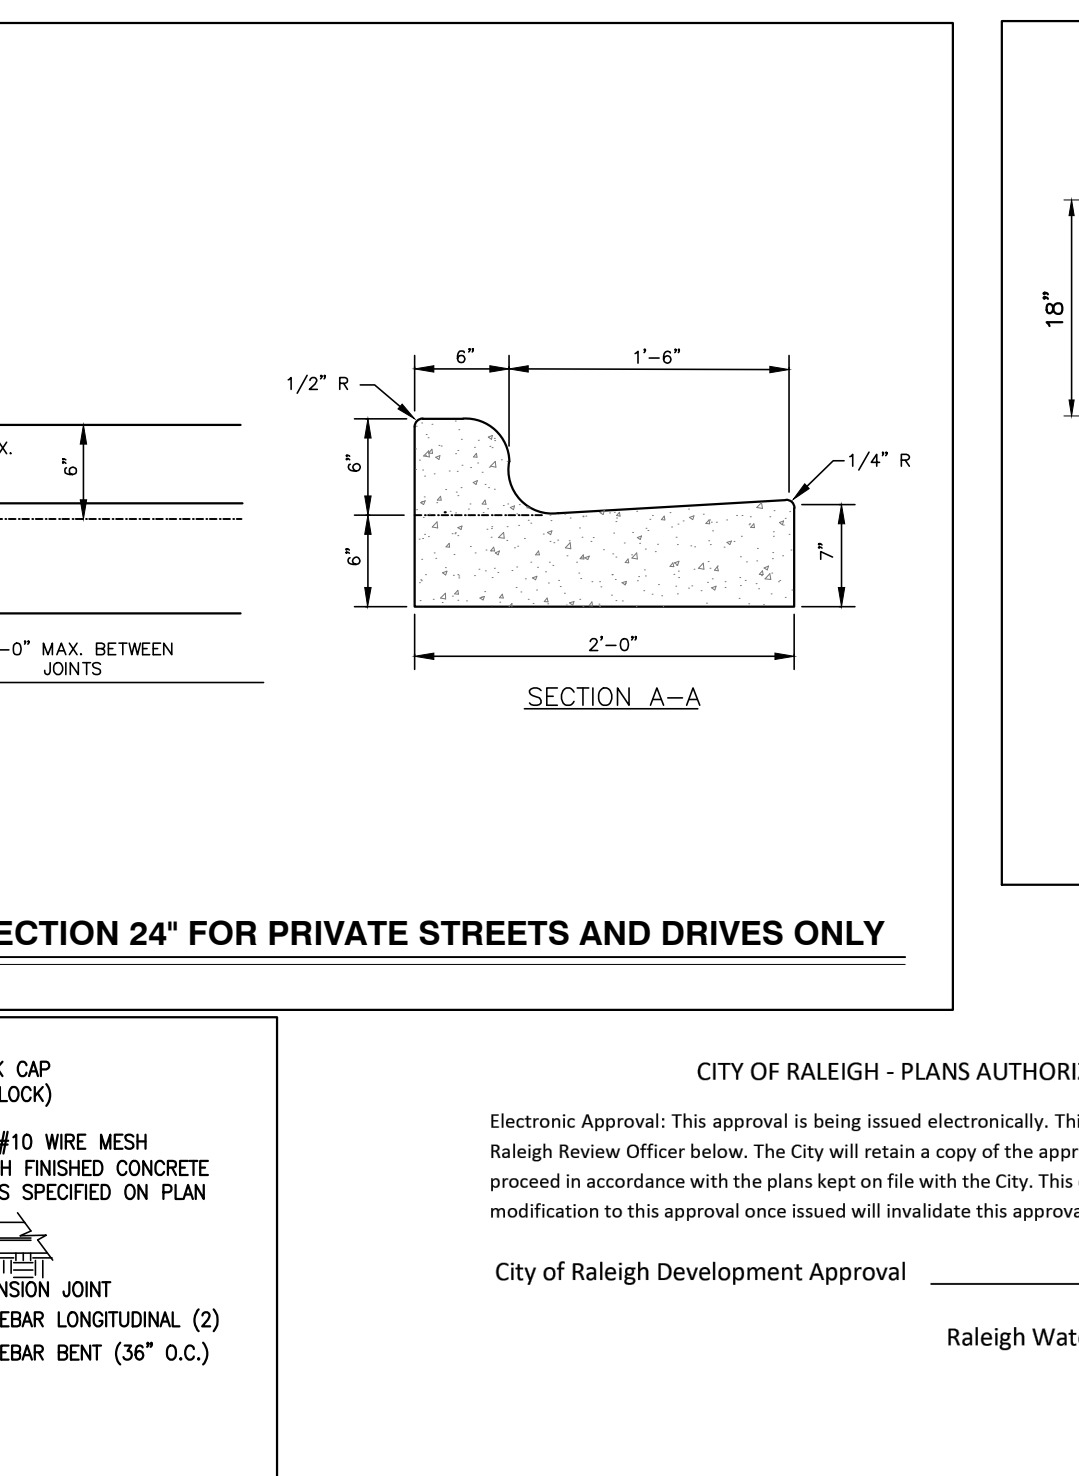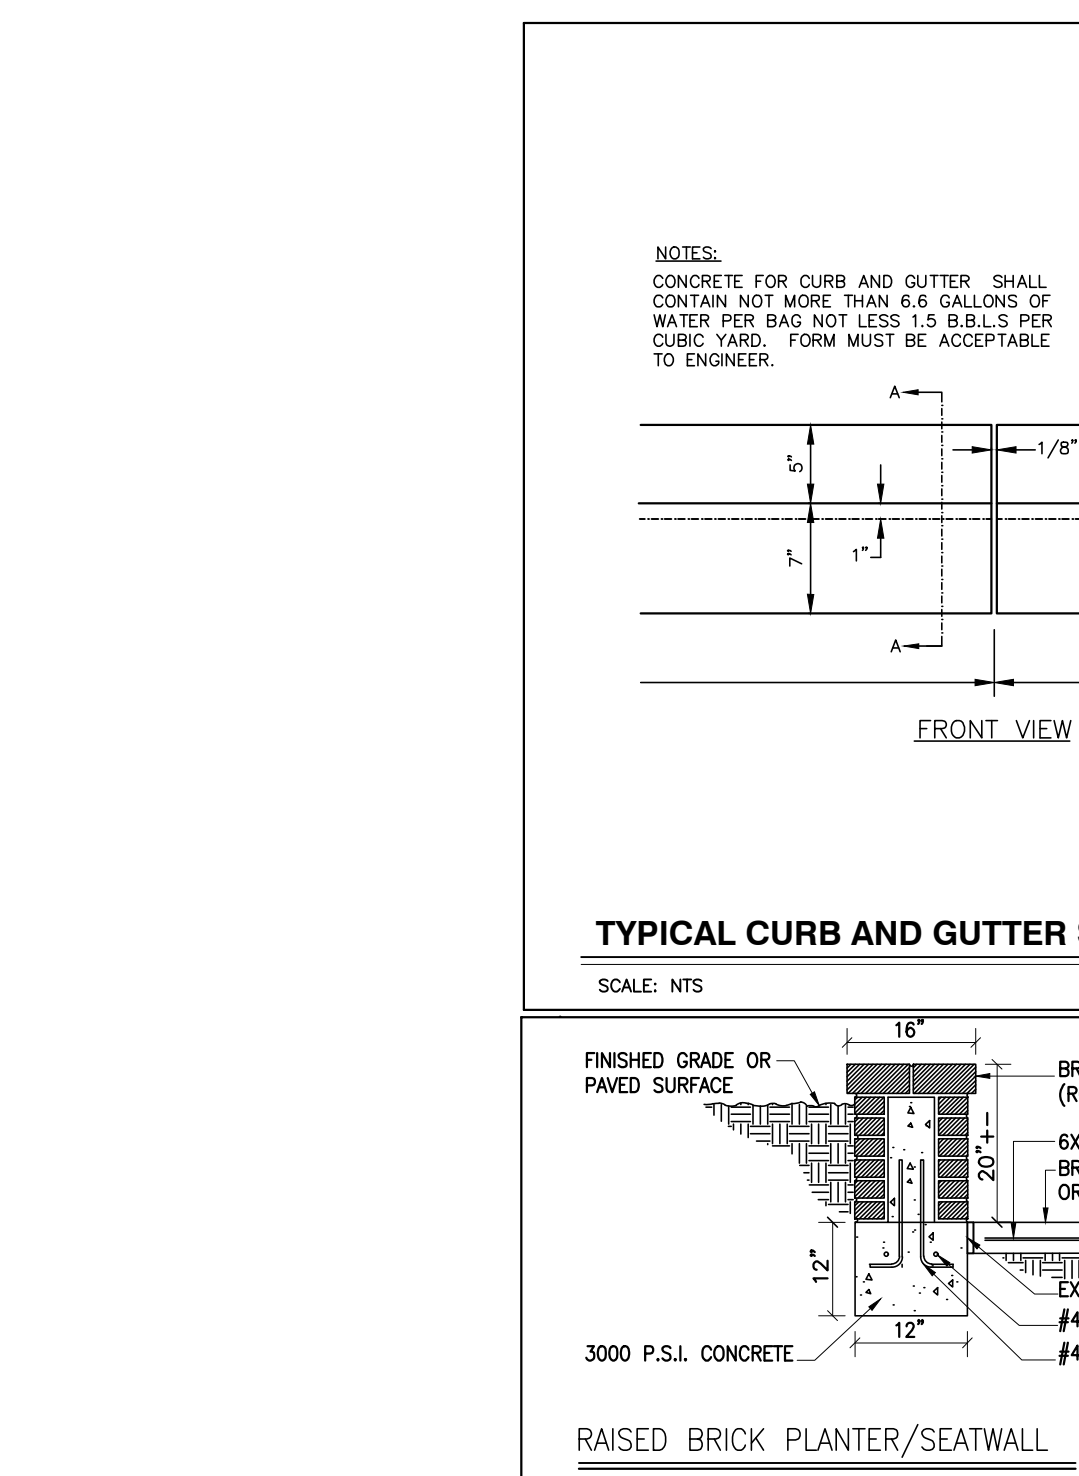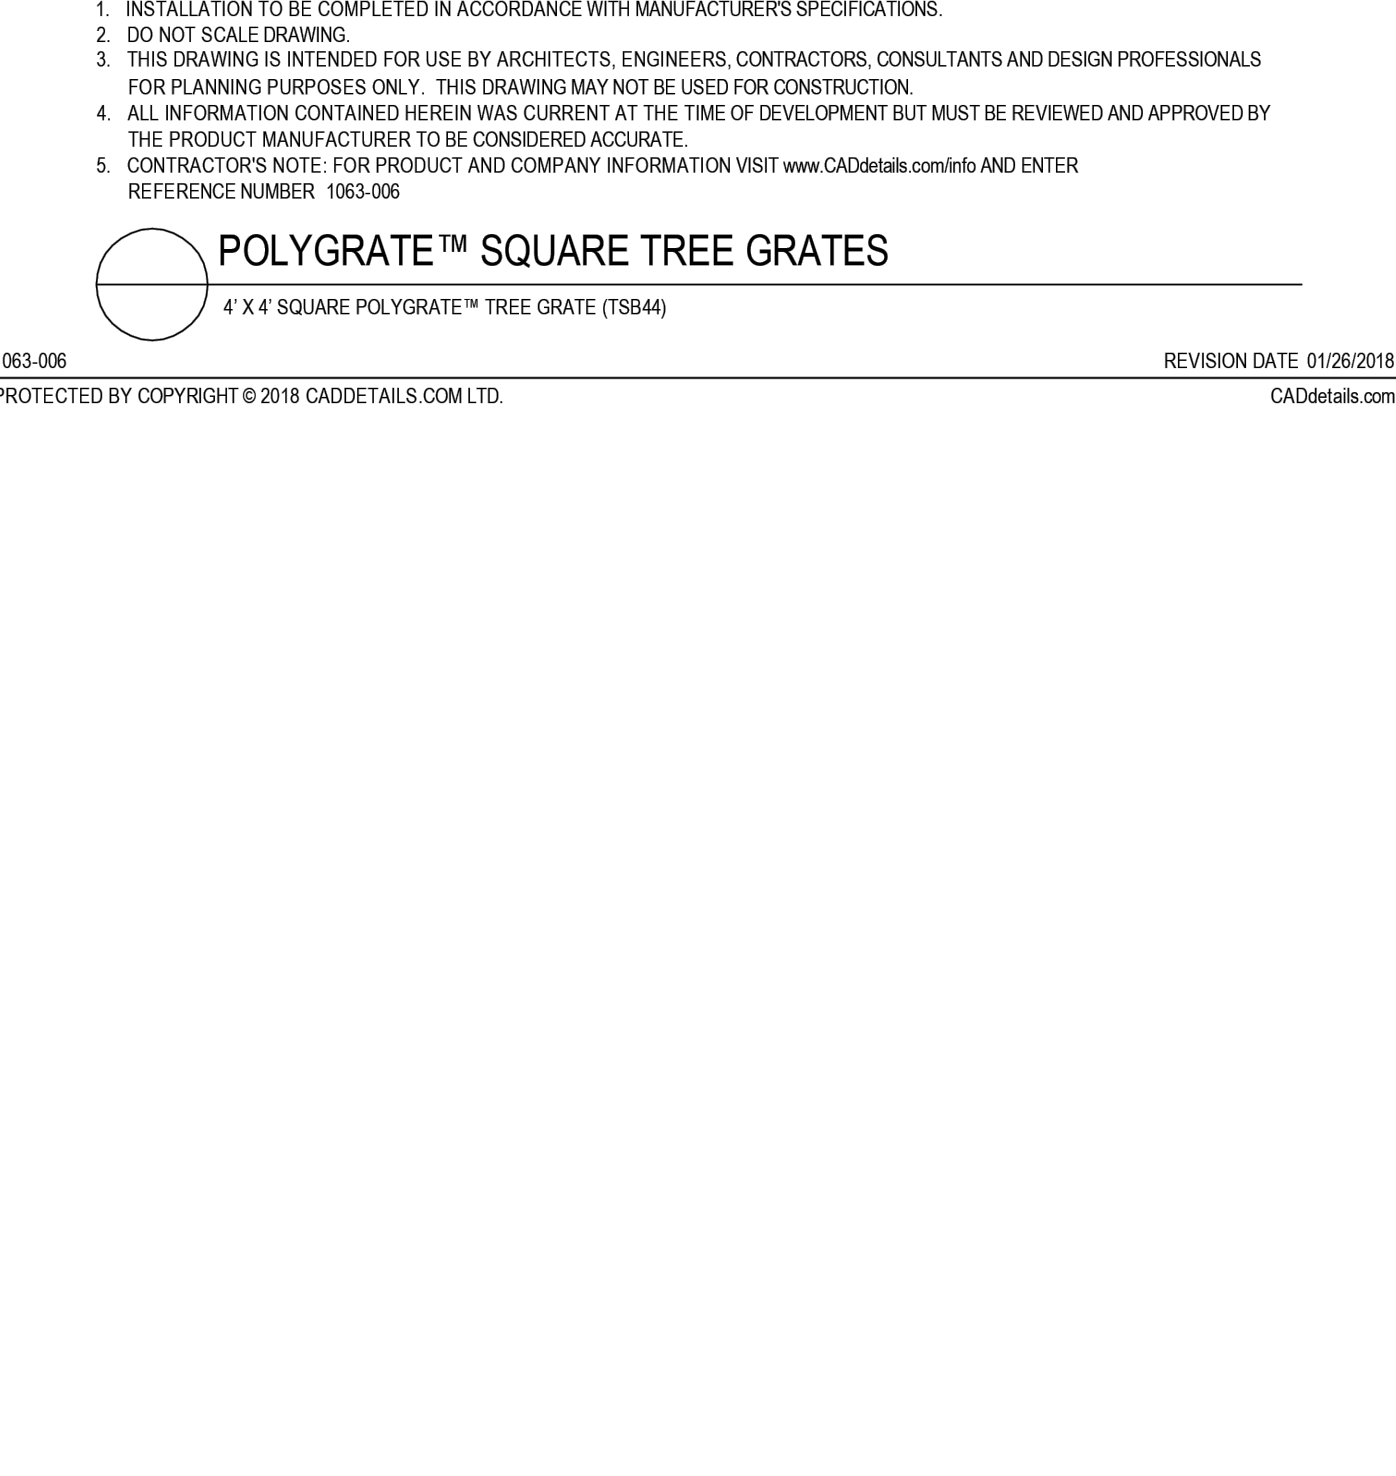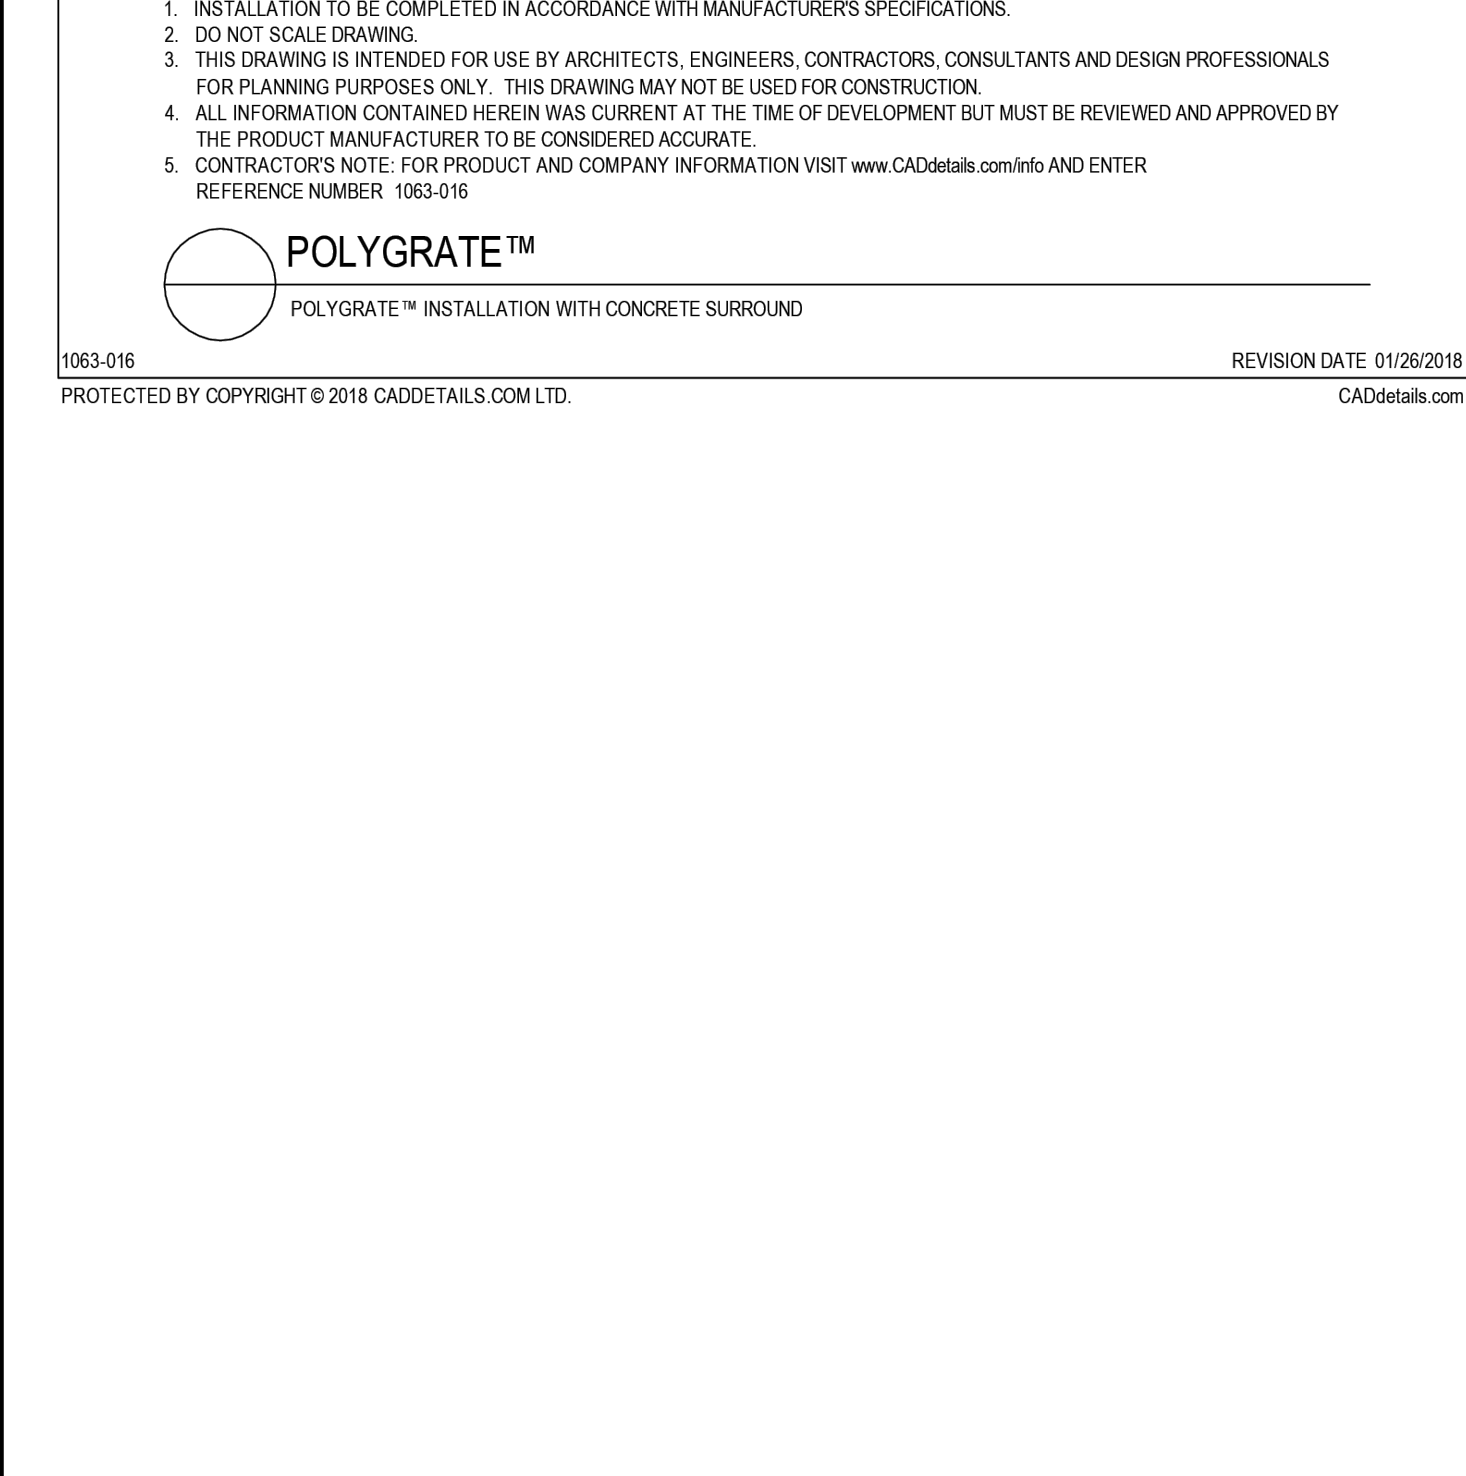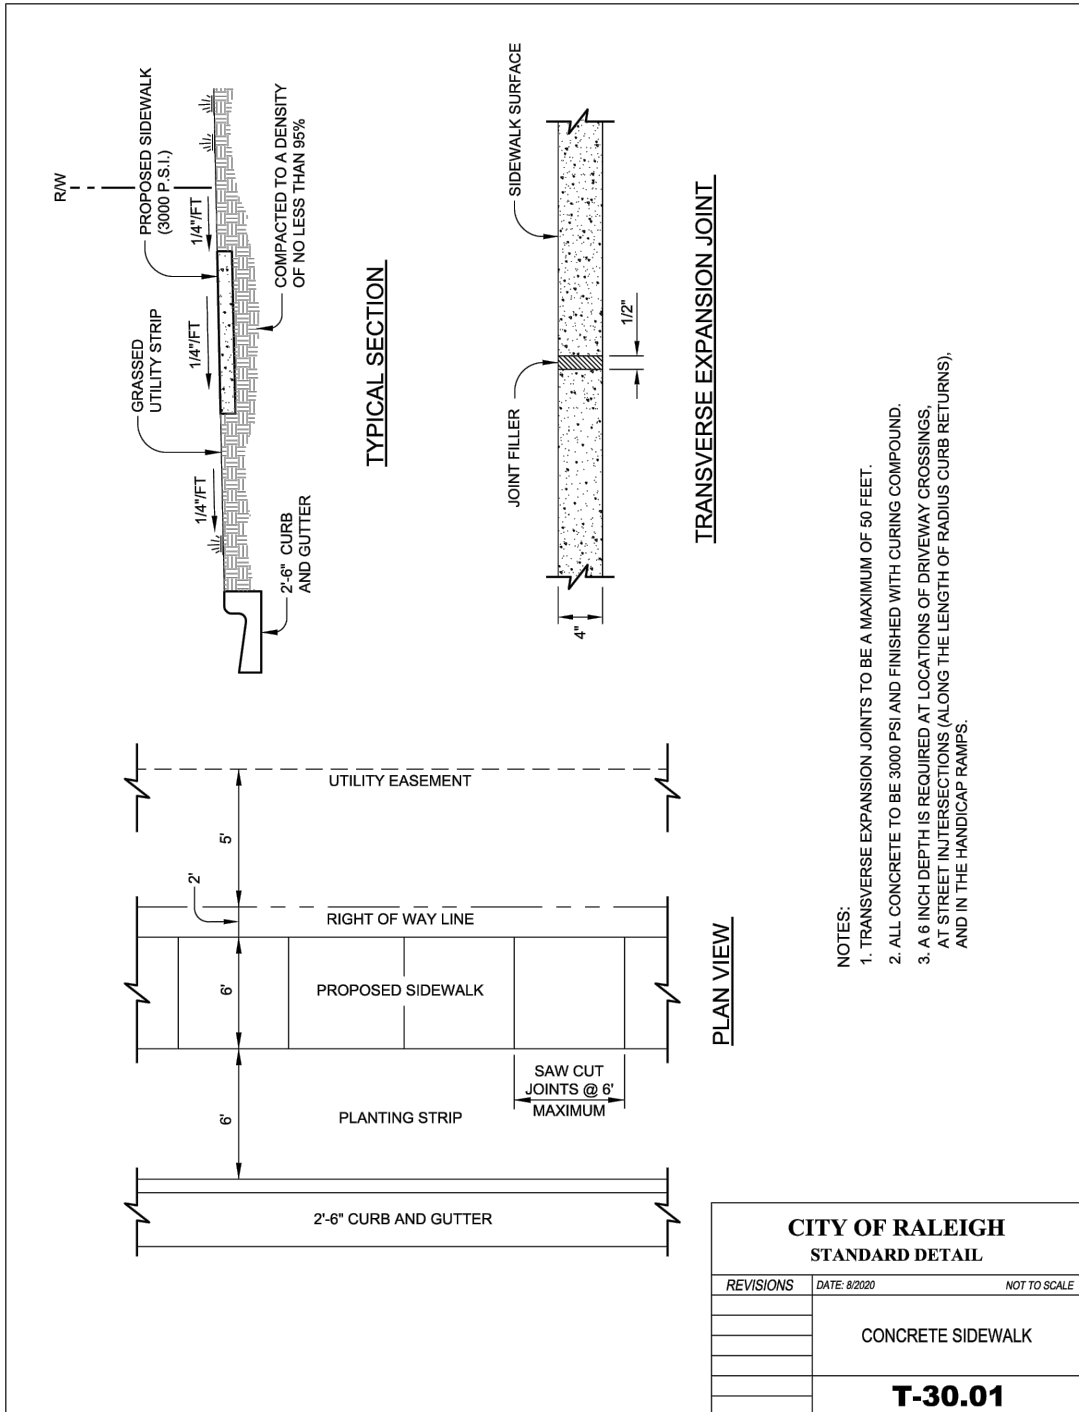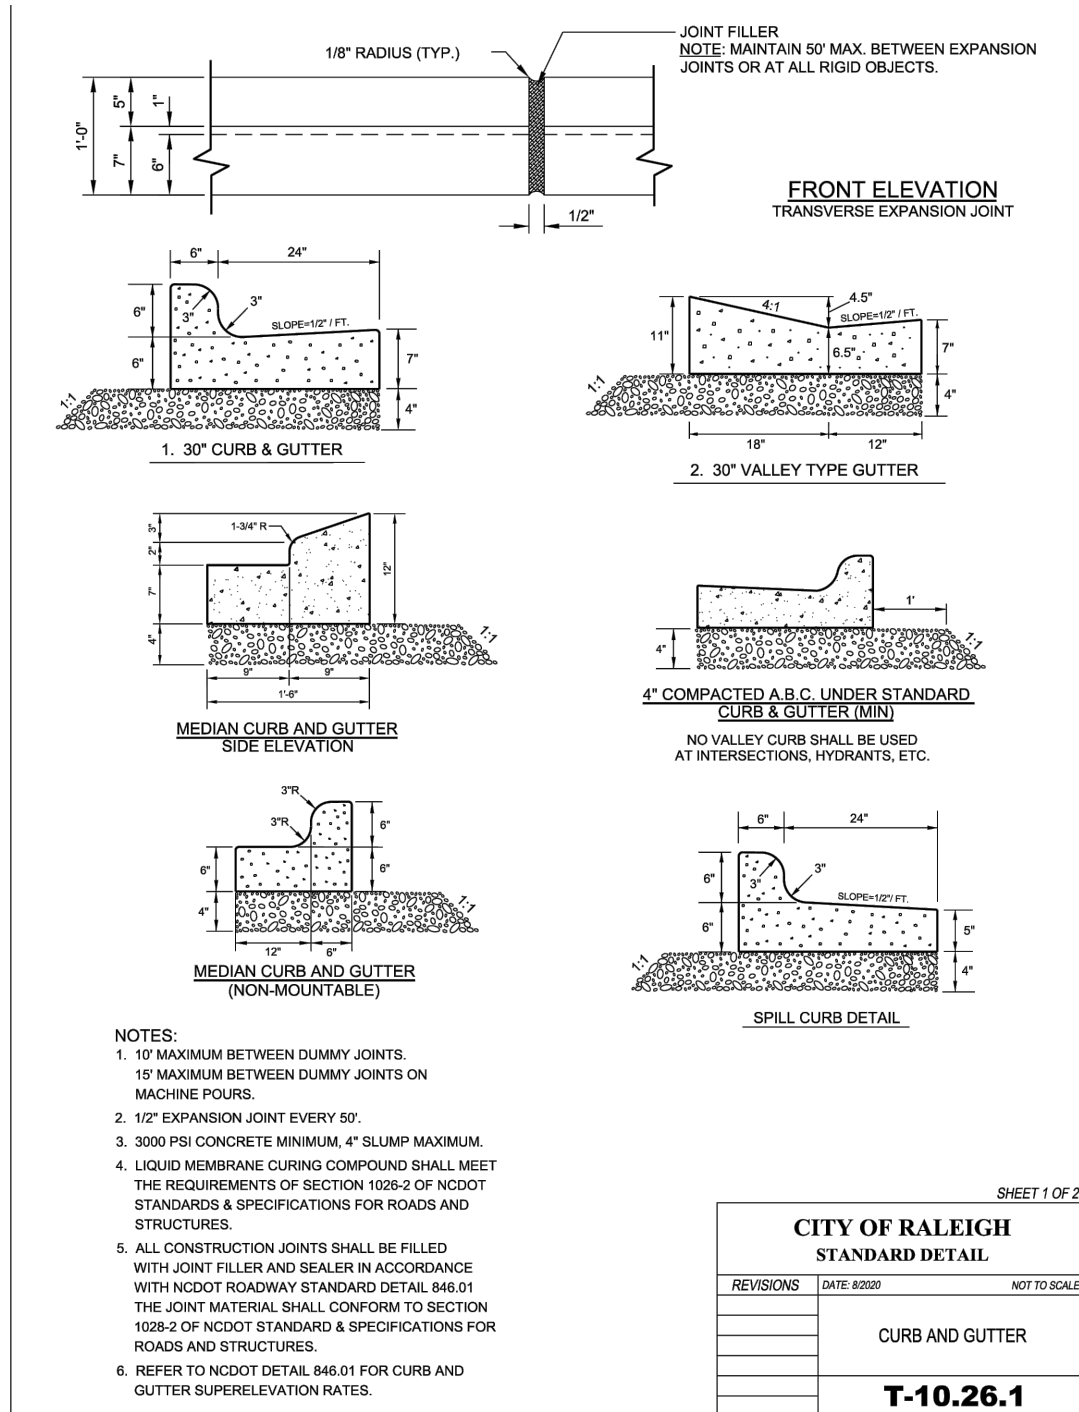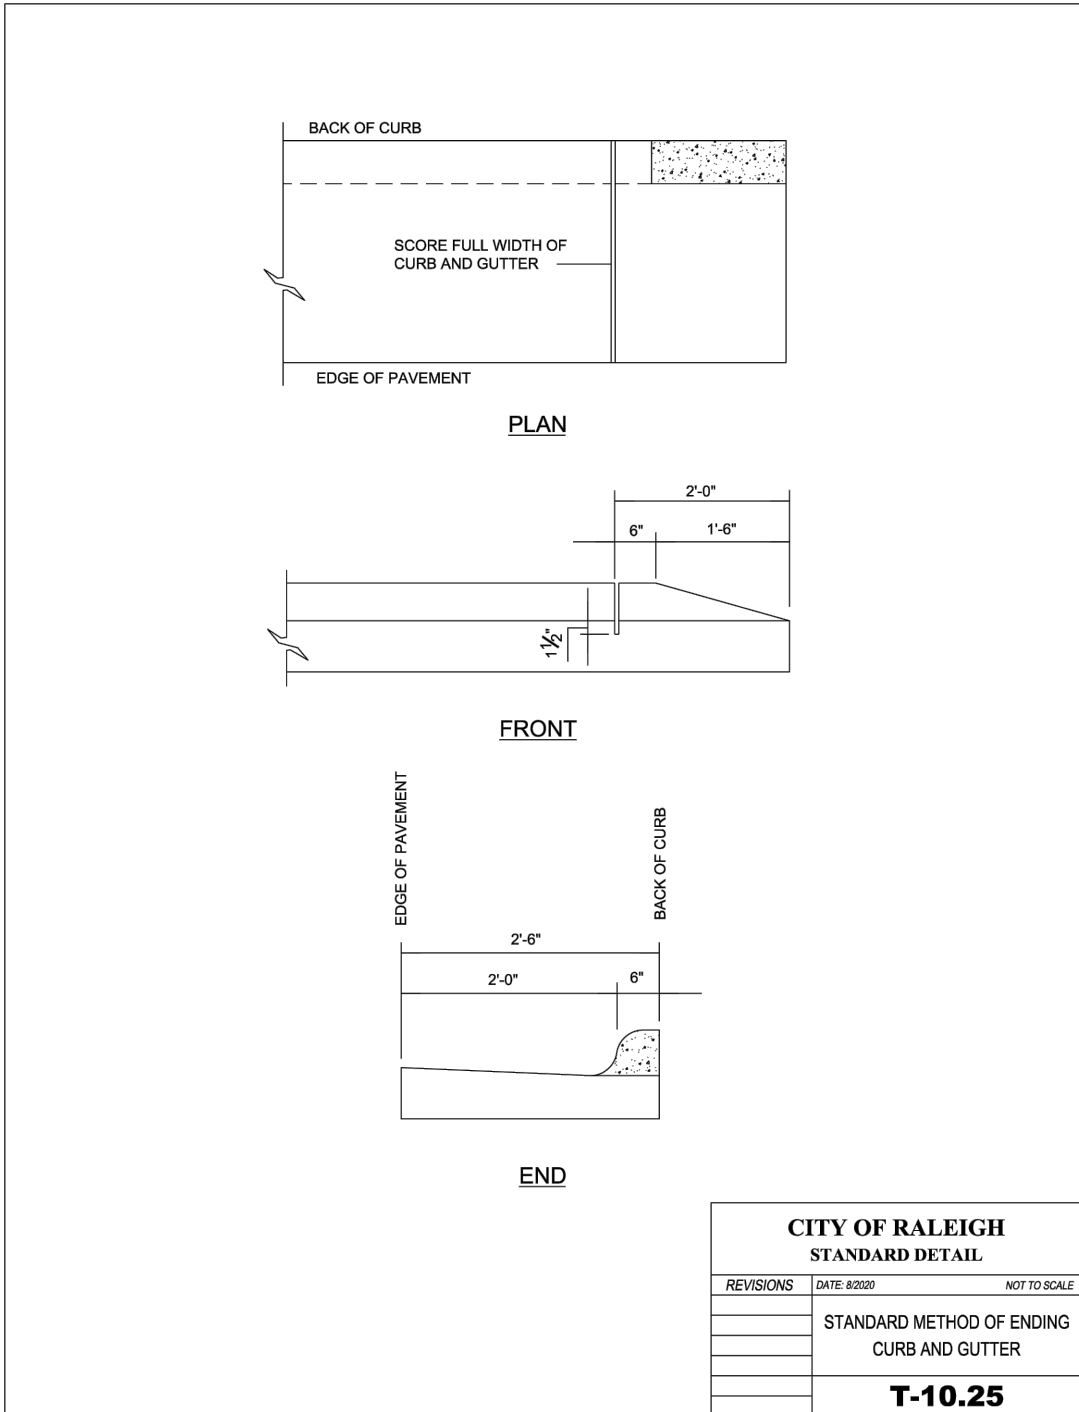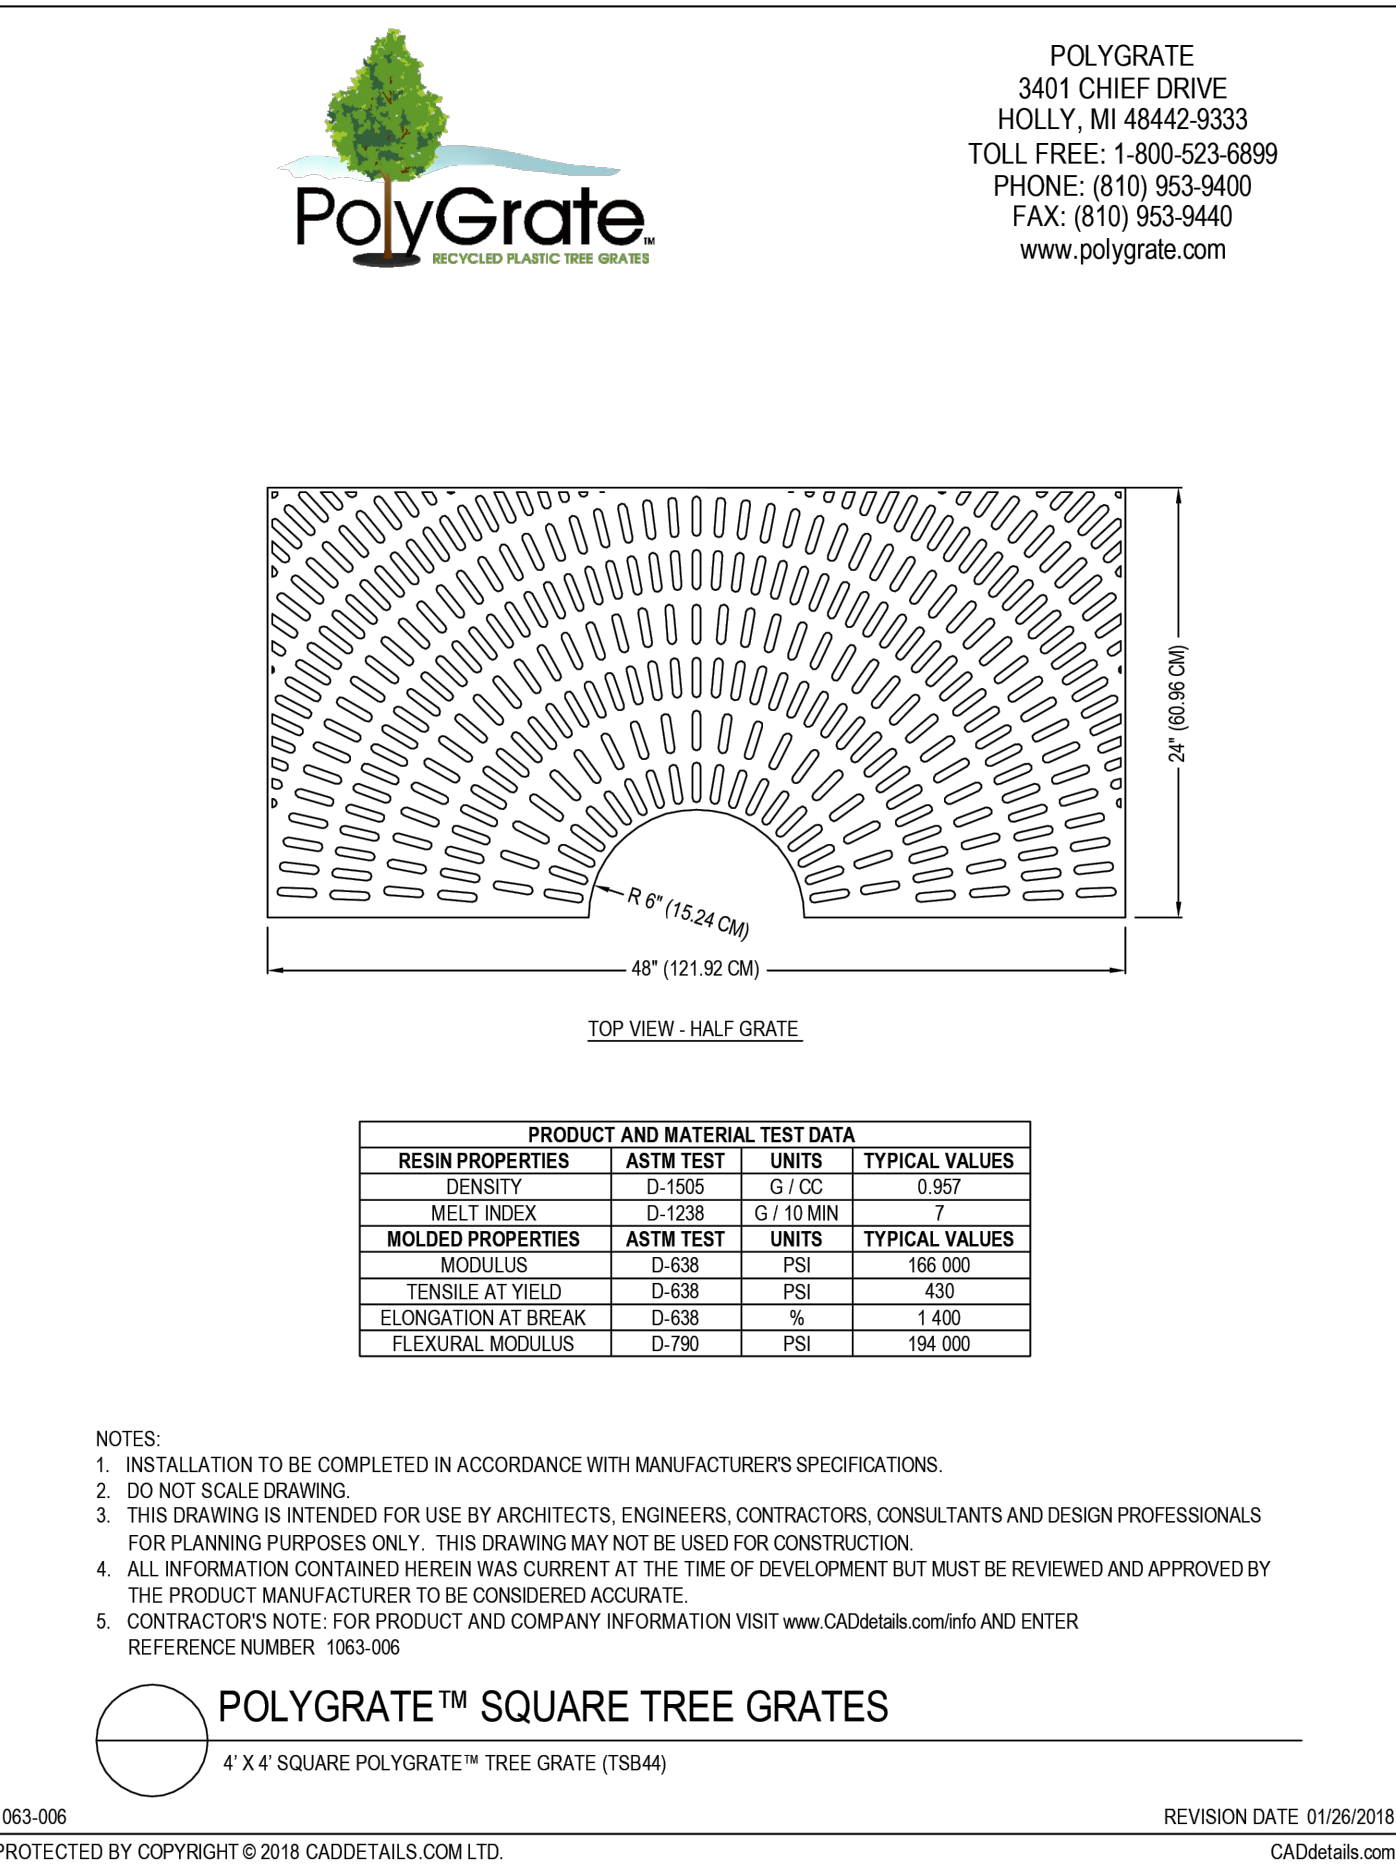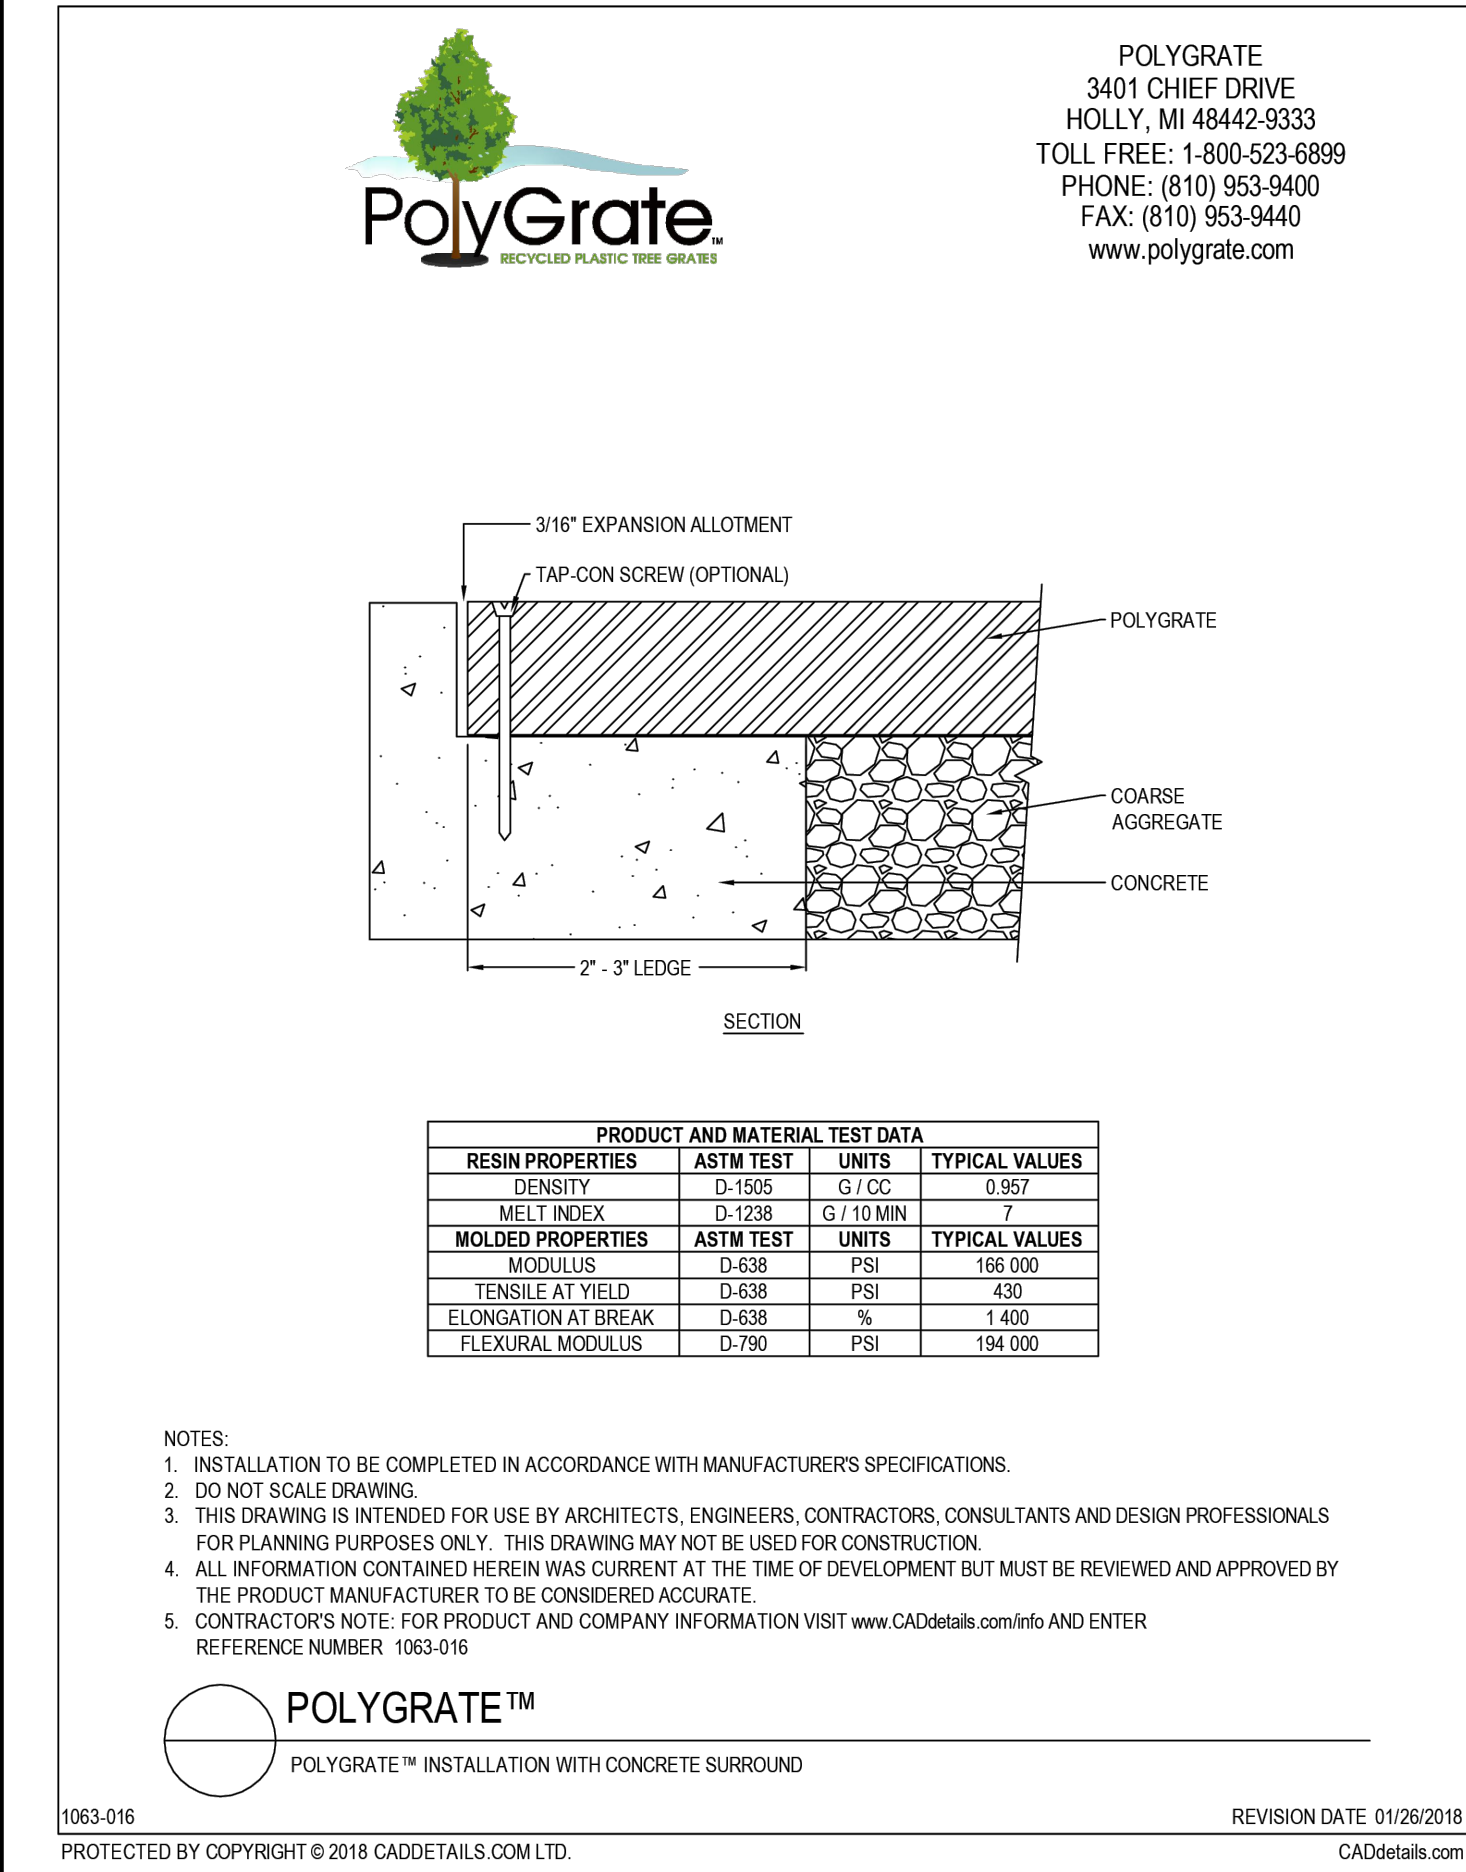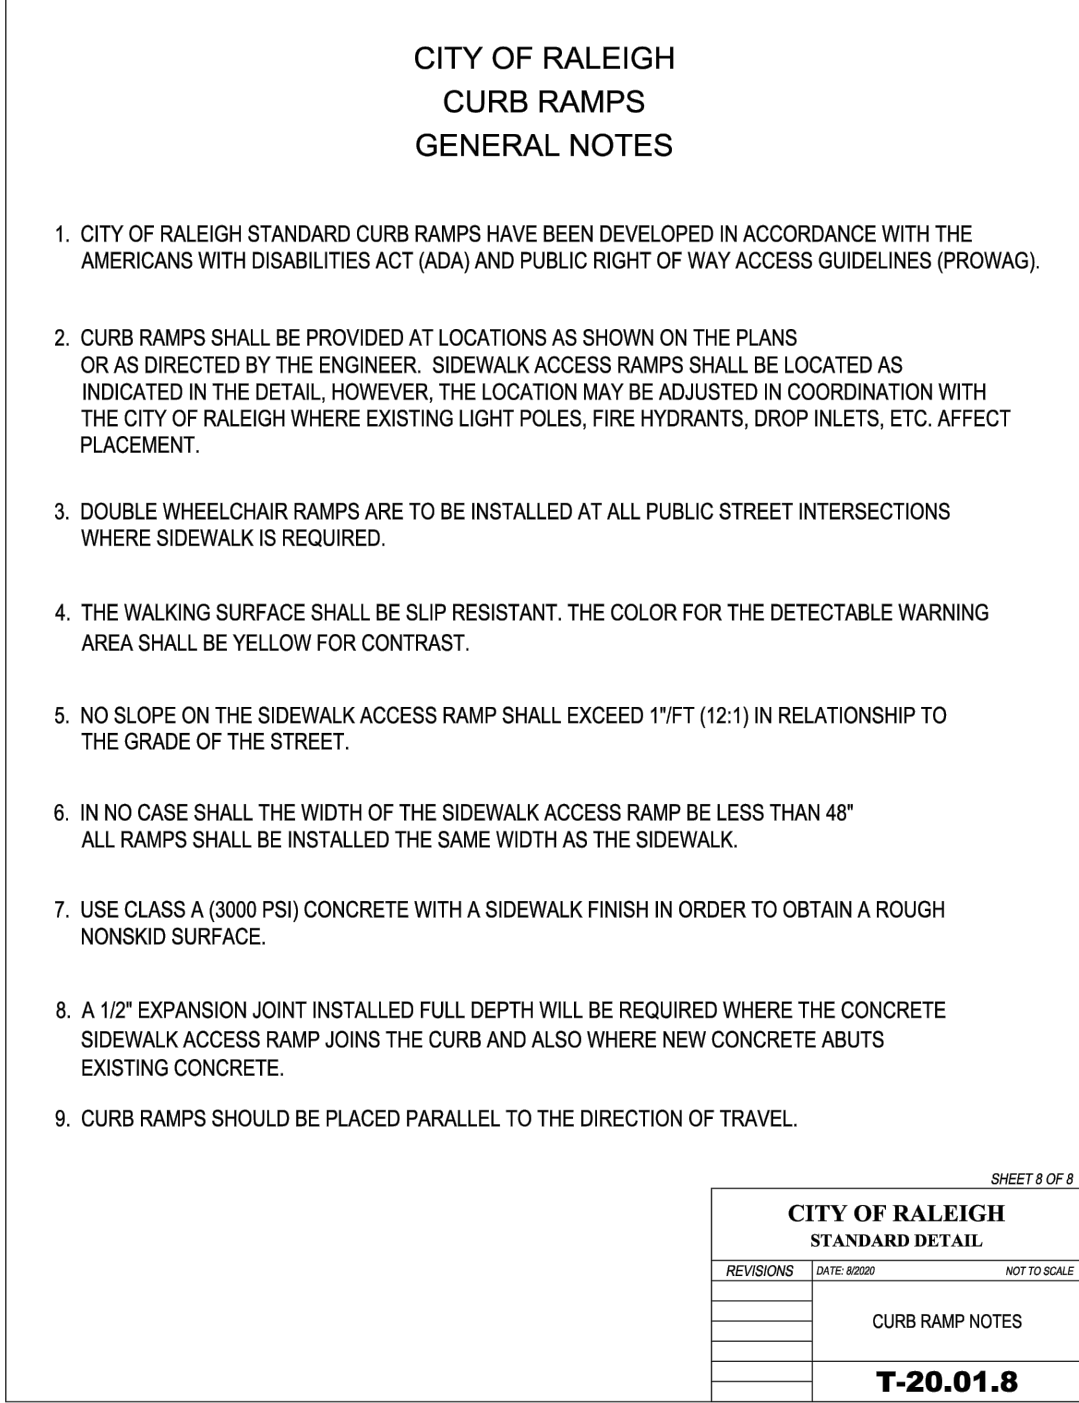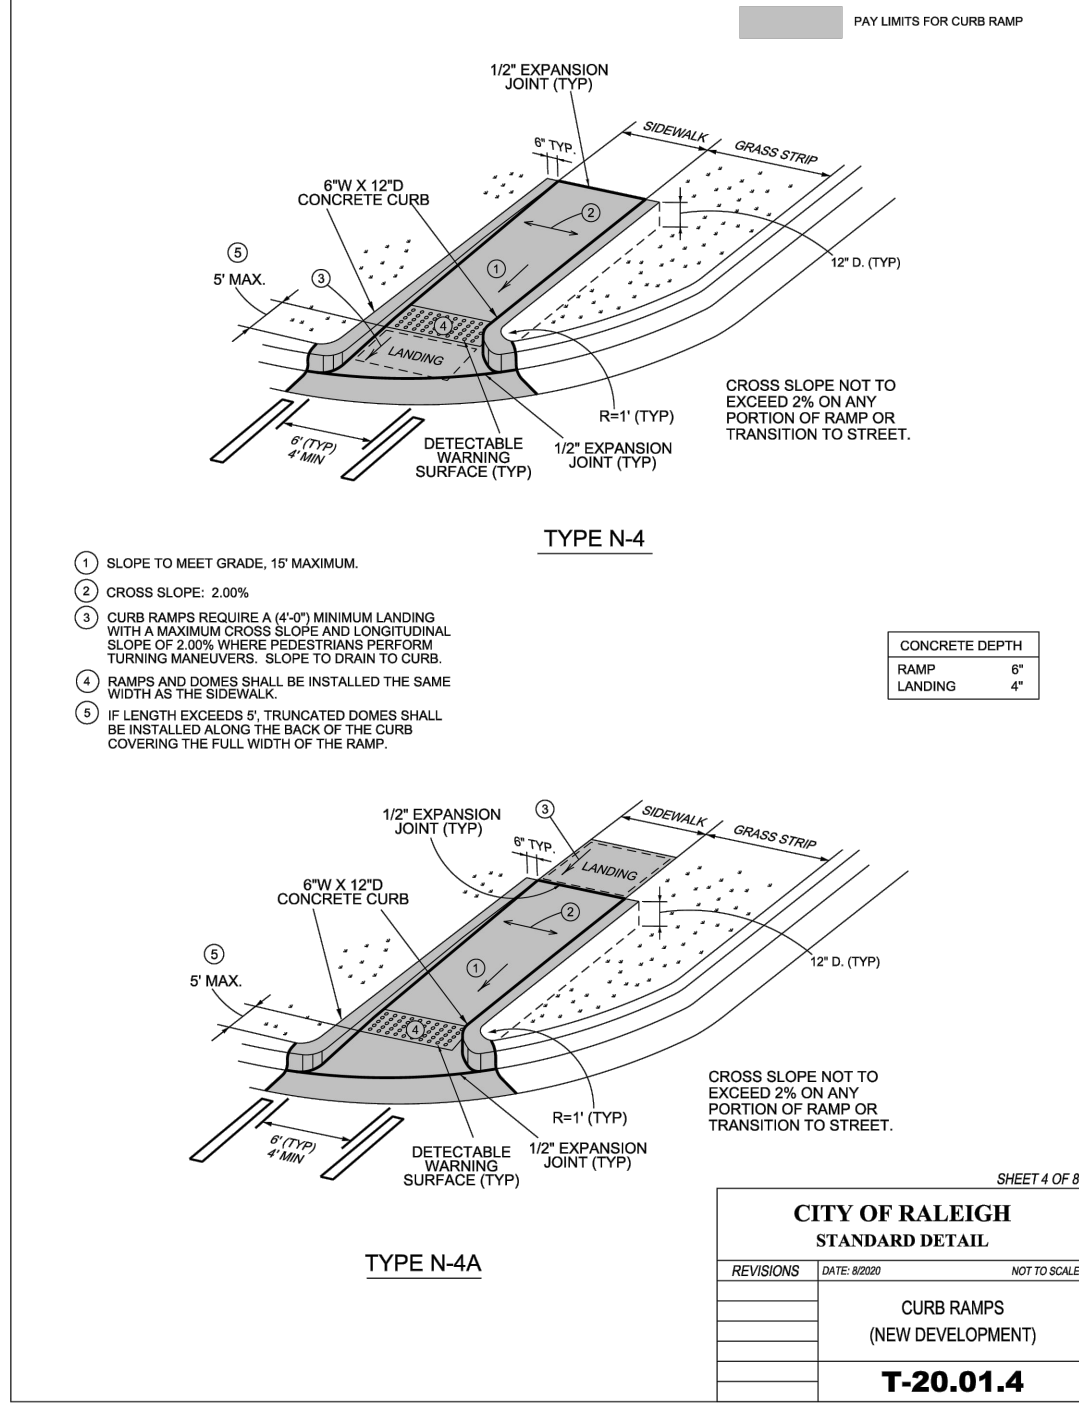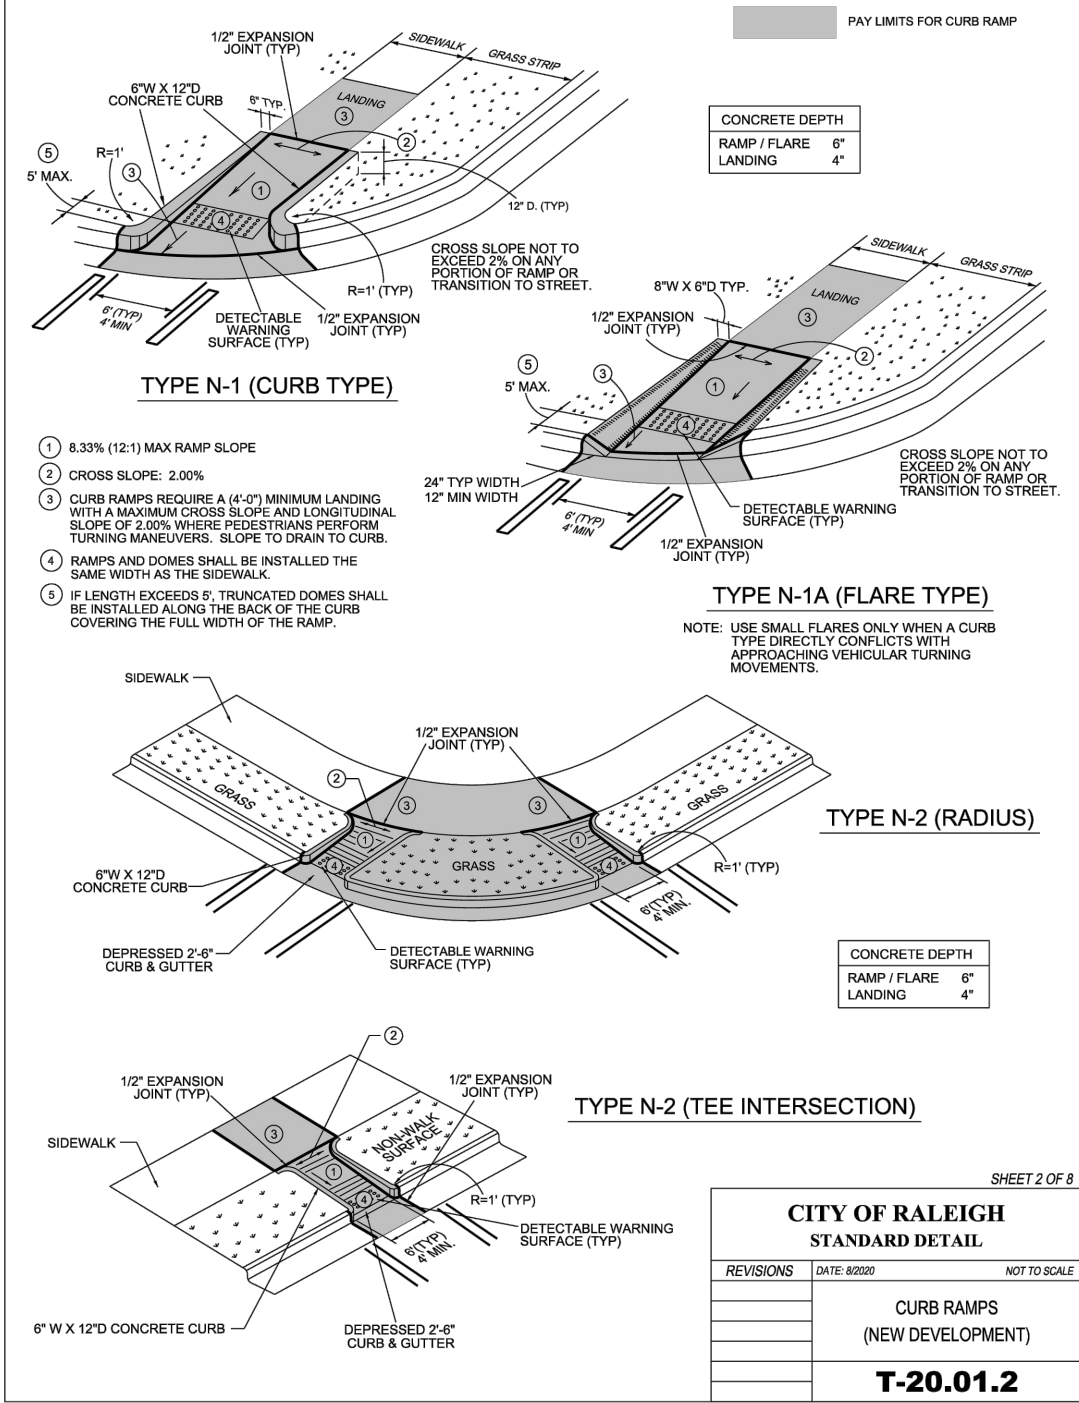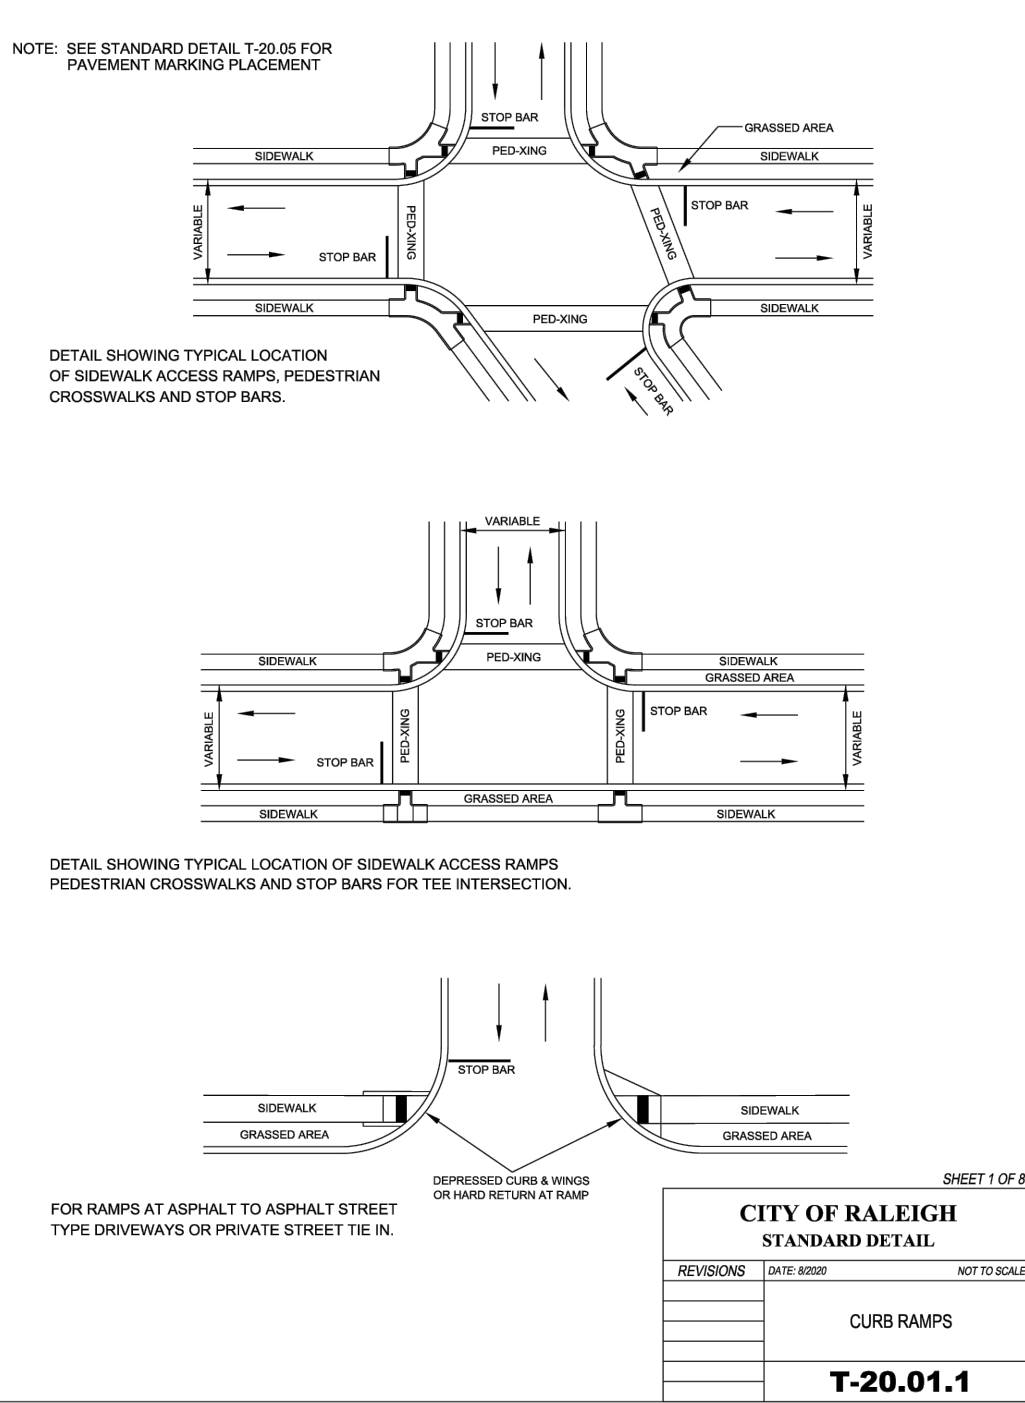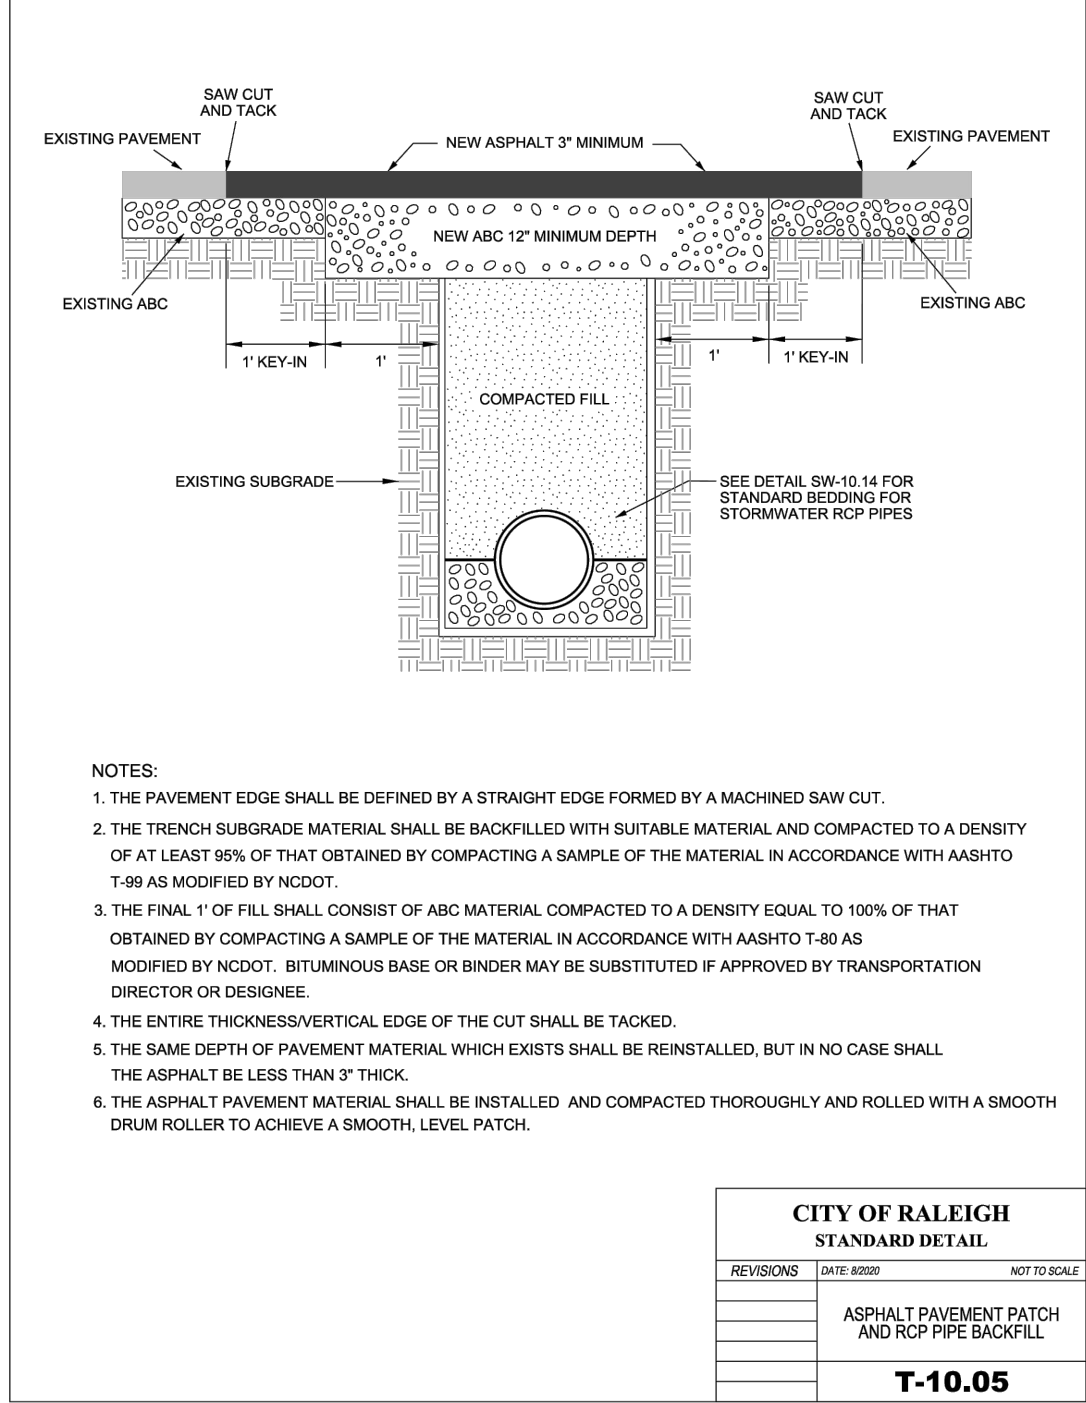

TOWN OF ROLESVILLE PROJECT NO.

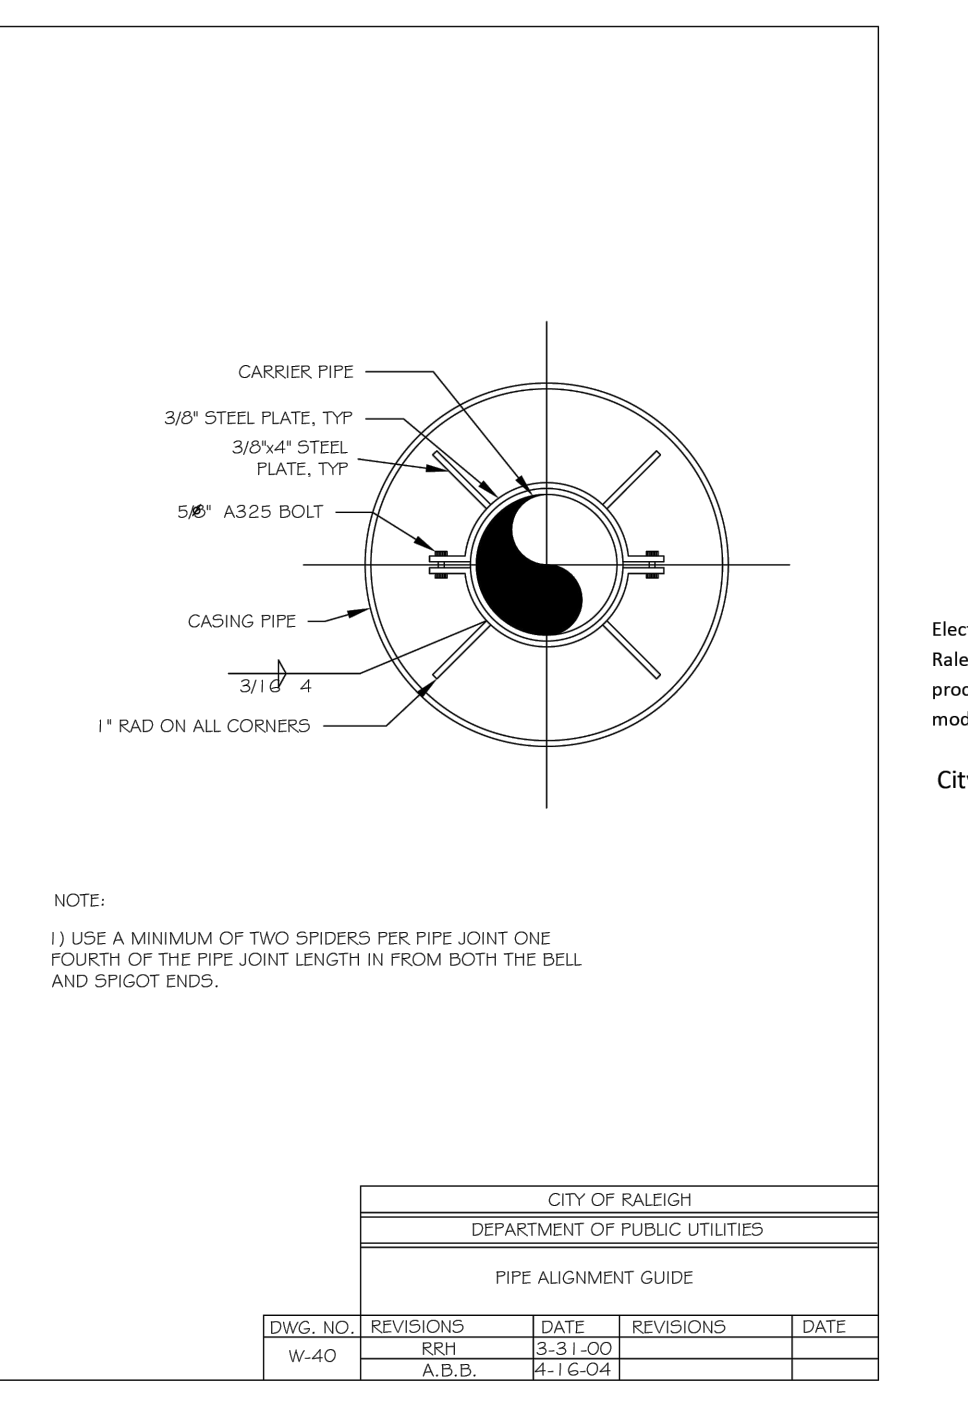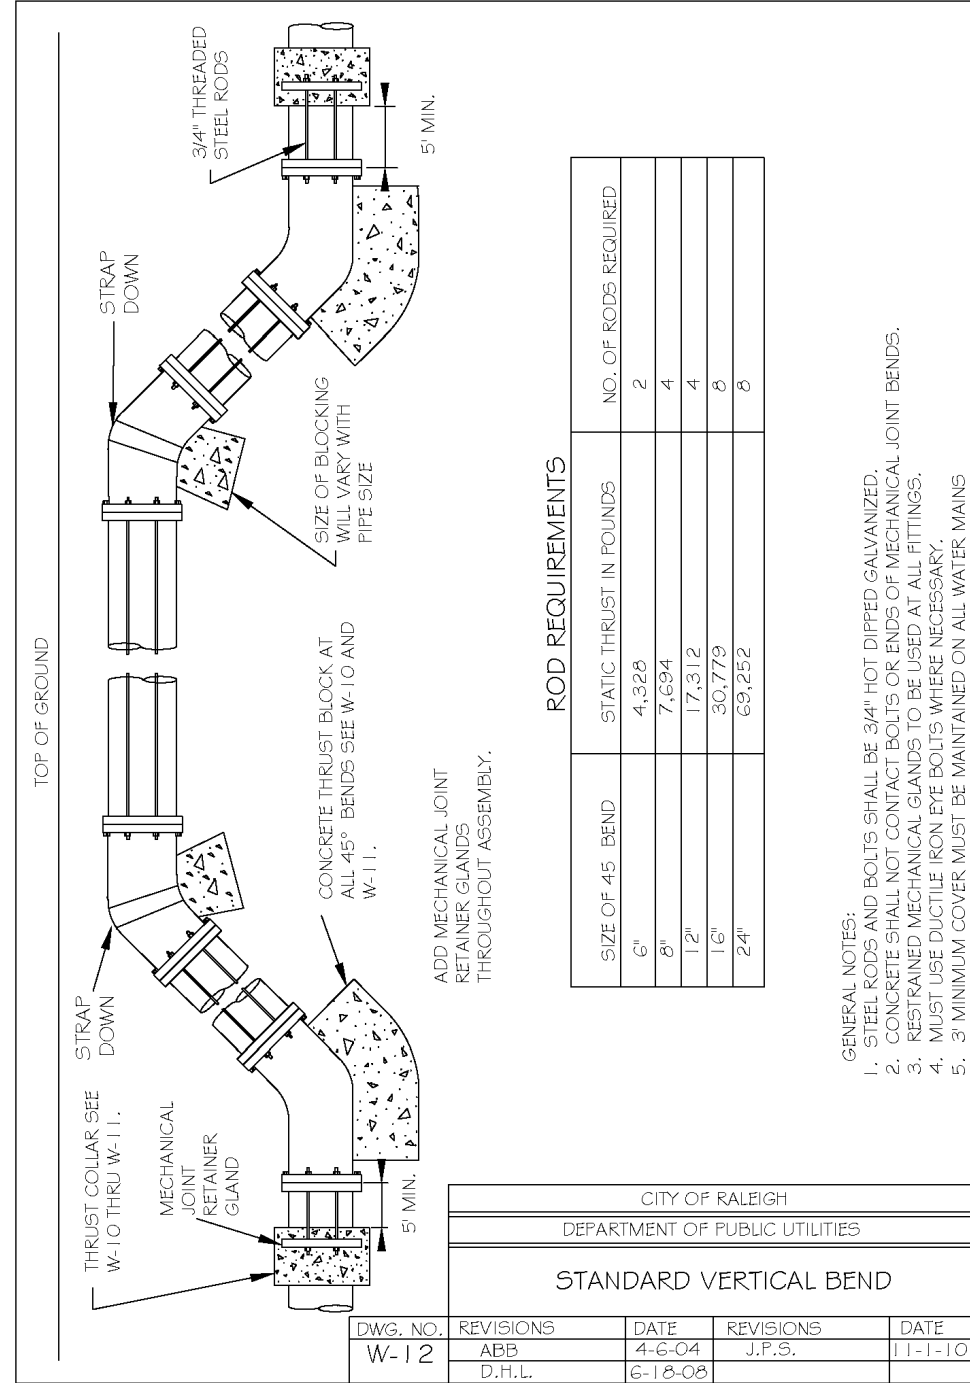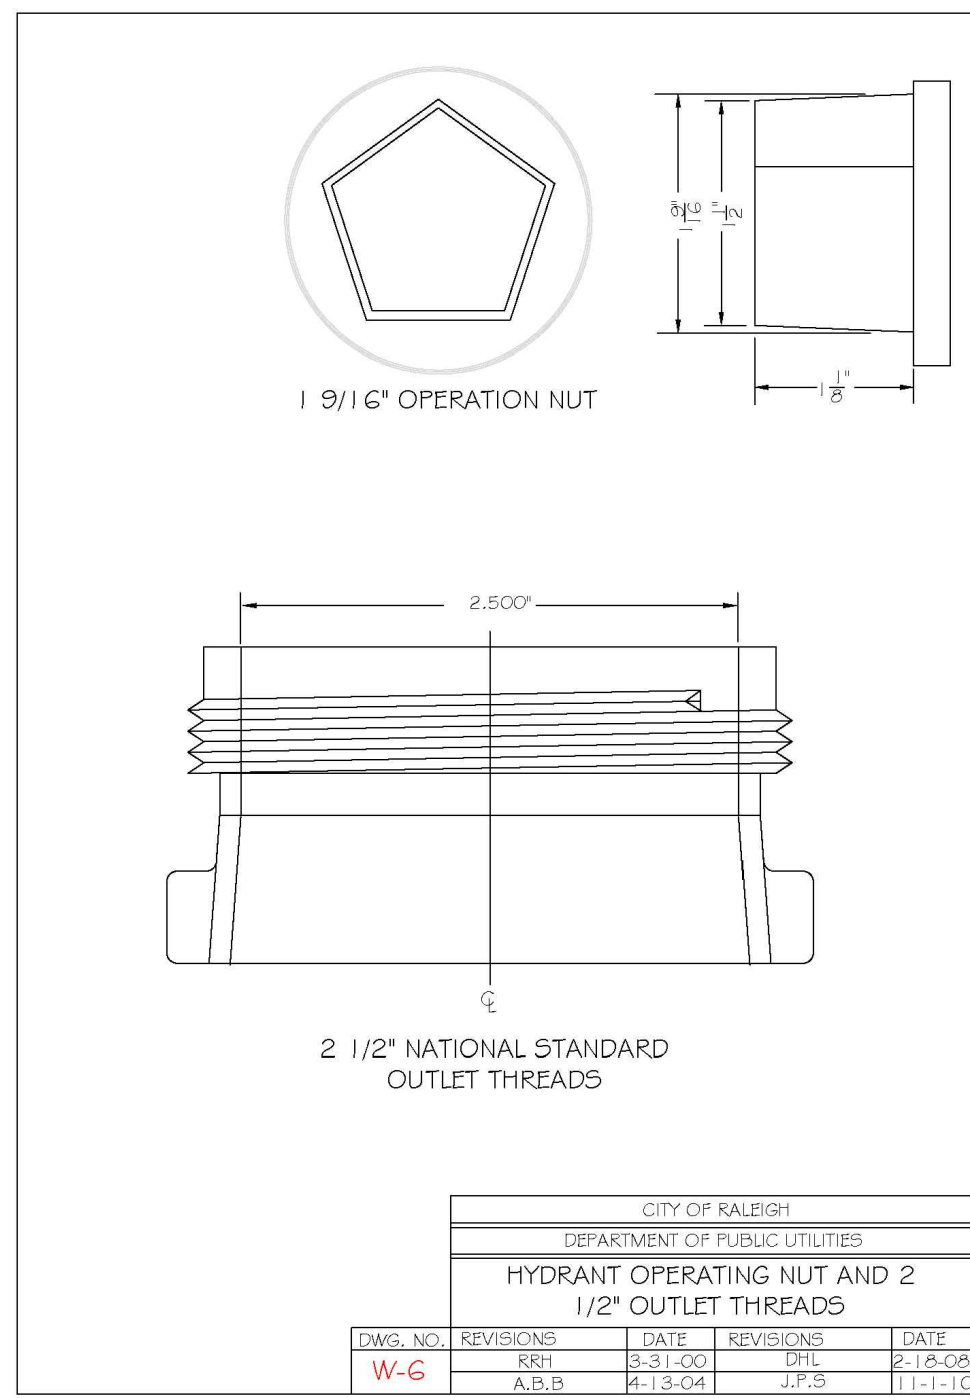

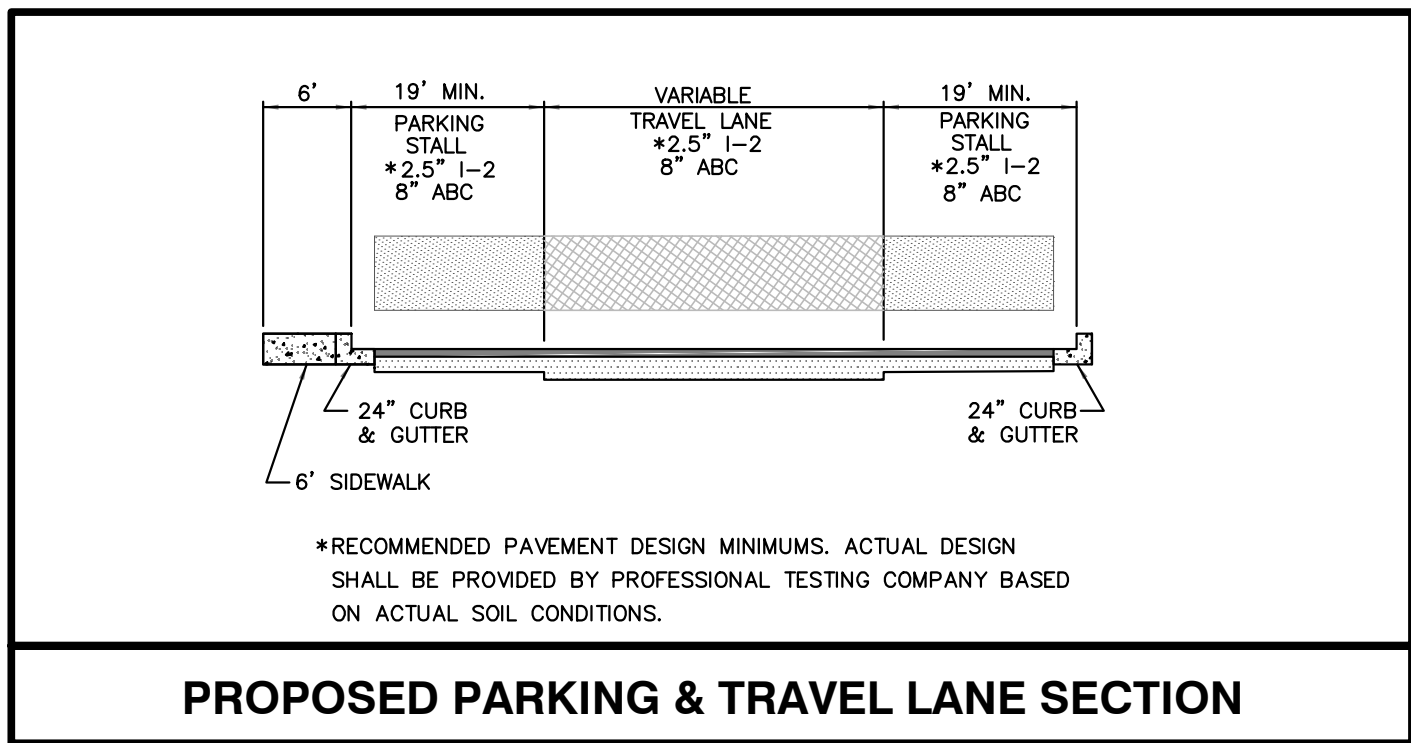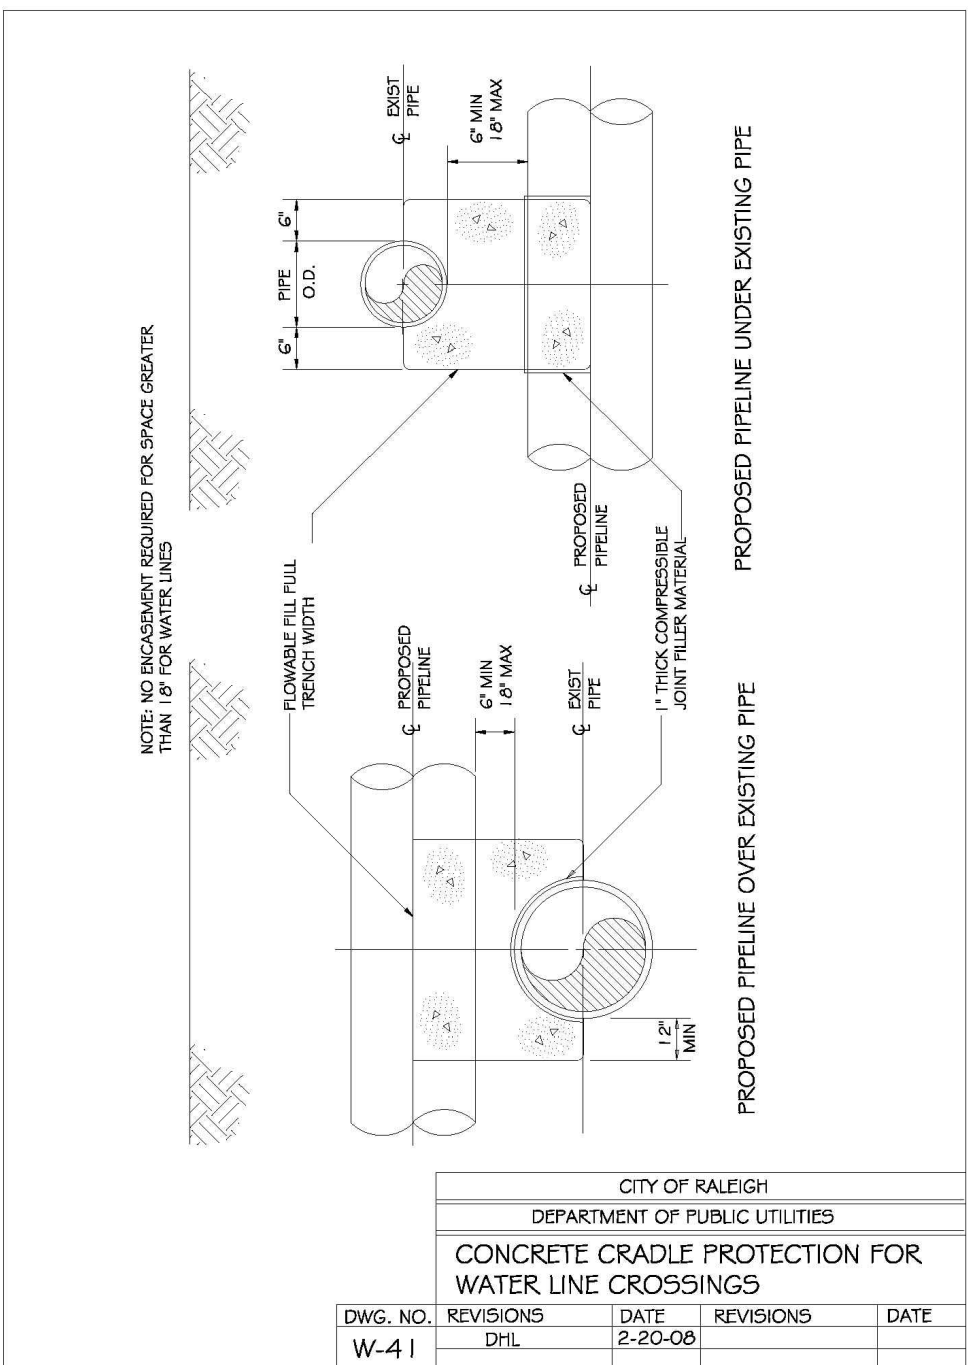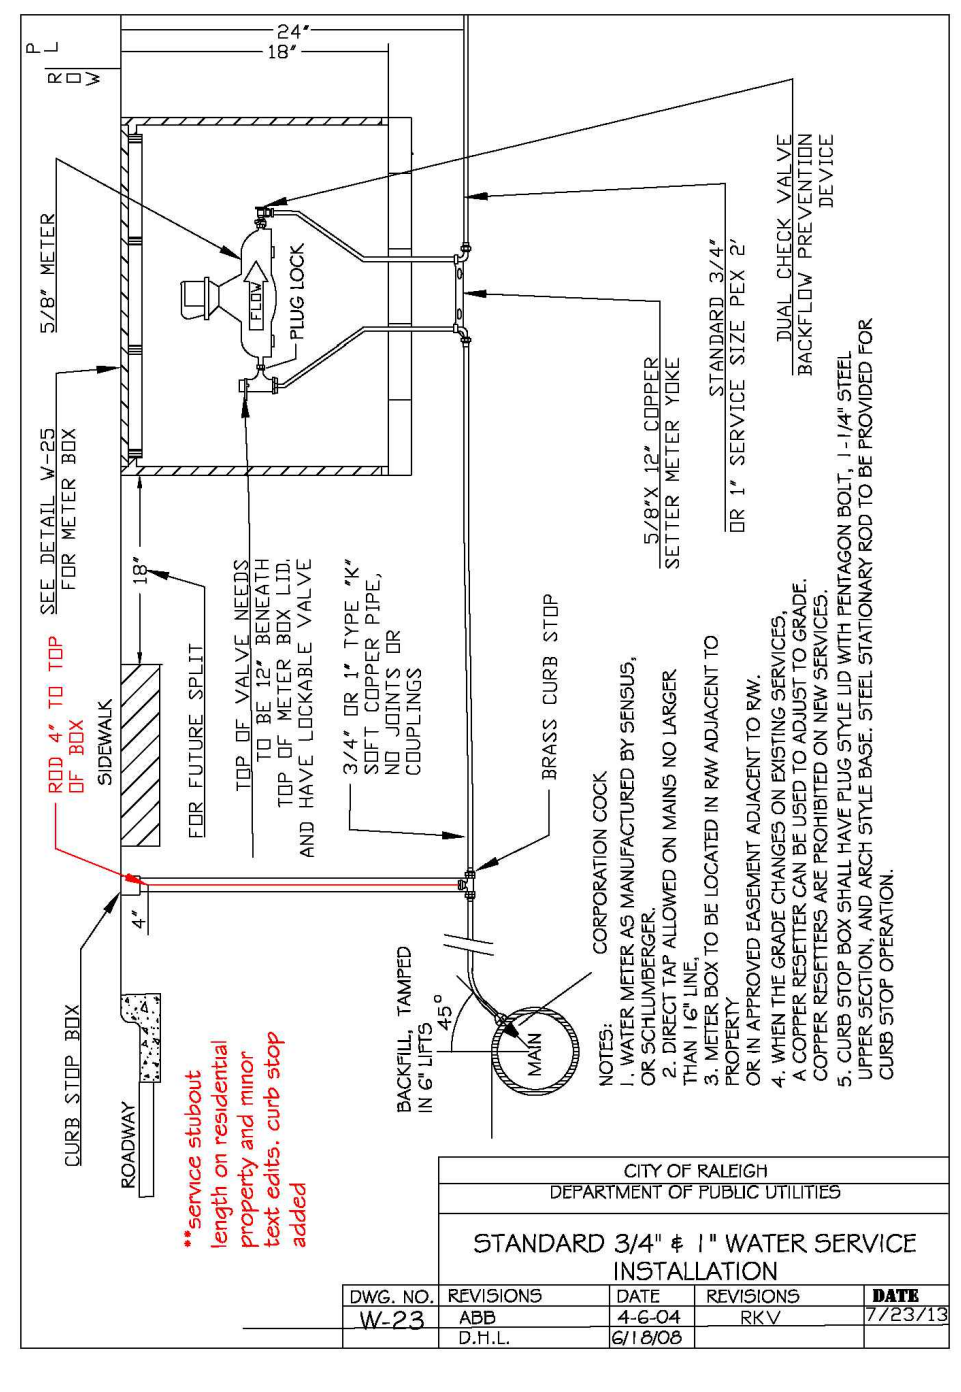

FLEXIBLE PIPE									
Round Corrugated Steel Pipe 2 1/2 x 1/8 corrugation -"					Round Corrugated Aluminum Pipe 2 1/2 x 1/8 corrugation -"				
Diameter (inches)	Minimum cover (inches)	Maximum Height of Cover (feet)			Diameter (inches)	Minimum cover (inches)	Maximum Height of Cover (feet)		
		(da)	15	12	10		(da)	15	12
10	12	15	10	8	10	12	15	10	8
15	12	165	204		15	12	98	123	174
18	12	155	199		18	12	81	102	141
21	12	150	194		21	12	69	87	123
24	12	100	126	178	24	12	60	76	108
30	12	77	100	123	30	12	47	60	85
36	12	65	83	117	36	12	40	50	71
42	12	57	70	100	42	12	36	45	62
48	12	48	61	87	48	12	30	38	52
54	12	44	54	77	54	12	27	34	46
60	12			69	60	12			46
66	12			61	66	12			40
72	12			74	72	12			35
78	12			81	78	12			31
84	12			89	84	12			28

HOPE

- (Minimum fill) 2' for pipe diameters $\geq 18"$ and $\leq 30"$
- (Maximum fill) 2' for pipe diameters $\geq 24"$ and $\leq 36"$

PVC

- (Minimum fill) 2' for pipe diameters $\geq 18"$ and $\leq 36"$
- (Maximum fill) 30' for pipe diameters $\geq 12"$ and $\leq 36"$

* FILL HEIGHT IS MEASURED FROM THE TOP OF THE PIPE TO THE BOTTOM OF THE PAVEMENT STRUCTURE

RCPP

- (Minimum fill) 1' for Class IV & Class V
- (Maximum fill) 2' for Class III & Class II

- (Maximum fill) 10' - Class II pipe
- 20' - Class III pipe
- 30' - Class IV pipe
- 40' - Class V pipe

(For fills $> 40'$ & $< 80'$ use LRFD Direct Design Method)

* FILL HEIGHT IS MEASURED FROM THE TOP OF THE PIPE TO THE BOTTOM OF THE PAVEMENT STRUCTURE

CDP

- ASHTO M88
- ASHTO M198

HOPE

- ASTM F949 or ASHTO M24

PVC

- ASTM F949 or ASHTO M24

* FILL HEIGHTS SHOWN WERE CALCULATED USING ASHTO LRFD BRIDGE DESIGN SPECIFICATIONS

1" MINIMUM COVER FOR ALL SIDE DRAIN PIPE IN ACCORDANCE WITH THE STANDARD SPECIFICATIONS

RCPP

- ASHTO M170

* FILL HEIGHTS SHOWN WERE CALCULATED USING ASHTO LRFD BRIDGE DESIGN SPECIFICATIONS

1" MINIMUM COVER FOR ALL SIDE DRAIN PIPE IN ACCORDANCE WITH THE STANDARD SPECIFICATIONS

LIB

STATE OF NORTH CAROLINA

DEPARTMENT OF TRANSPORTATION

RALEIGH, N.C.

RAHWAY STANDARD DRAWING FOR

METHOD OF PIPE INSTALLATION

FLL HEIGHT TABLES

301

302

303

301

302

303

PLAN VIEW OF TYPICAL CURB AND GUTTER OCCURRENCES

PLAN VIEW OF TRANSITION EXPANSION GUTTER TO 2'-6" CURB AND GUTTER

NOTES:
 1. THE TRANSITION FROM 4'-0" CONCRETE EXPRESSWAY GUTTER TO 2'-6" CONCRETE CURB AND GUTTER, PLACE 15" EXPANSION JOINTS AT 20' INTERVALS.
 2. PLACE GROOVE JOINTS 1' DEEP AT 15'-4" INTERVALS BETWEEN EXPANSION JOINTS.
 3. FILL AND SEAL THE TOP 15" OF THE EXPANSION JOINTS AND 1" OF CONTRACTION JOINTS WITH APPROVED JOINT SEALING COMPOUND.

STATE OF
 NORTH CAROLINA
 DEPT. OF TRANSPORTATION
 1-181

ROADWAY STANDARD DRAWING FOR
 CONCRETE CURB & GUTTER
 AND CURB & GUTTER

SHEET 3 OF 3
 846.

Figure 10 consists of two diagrams illustrating the typical location of curb ramps and stop lines for T-intersections. The left diagram is a plan view showing a 'VAP. ROAD' (Variable Road) intersecting a 'SIDEWALK' and 'STOP LINE'. It includes labels for 'SEE NOTE 12', 'SEE NOTE 3', 'SEE NOTE 10', and '4'-0" (TYP)'. The right diagram is a side elevation showing the 'SIDEWALK', 'STOP LINE', and '4'-0" (TYP)' dimension. It also includes labels for 'SEE NOTE 12', 'SEE NOTE 10', and 'SEE NOTE 4'. A legend at the bottom defines symbols for 'ROADWAY PLAN SYMBOL (CR) FOR PROPOSED CURB RAMP', 'PROPOSED CURB RAMP W/ LANDING', 'PROPOSED OR FUTURE SIDEWALK', 'ALLOWABLE LOCATIONS', and 'DUAL RAMP RADIUS'.



CITY OF RALEIGH - PLANS AUTHORIZED FOR CONSTRUCTION

Approval: This approval is being issued electronically. This approval is valid only upon the signature of a City of Raleigh official below. The City will retain a copy of the approved plans. Any work authorized by this approval must be in accordance with the plans kept on file with the City. This electronic approval may not be edited once issued. Any use of this approval once issued will invalidate this approval.

City Engineer Development Approval _____


Raleigh Water Review Officer _____

09/01/23

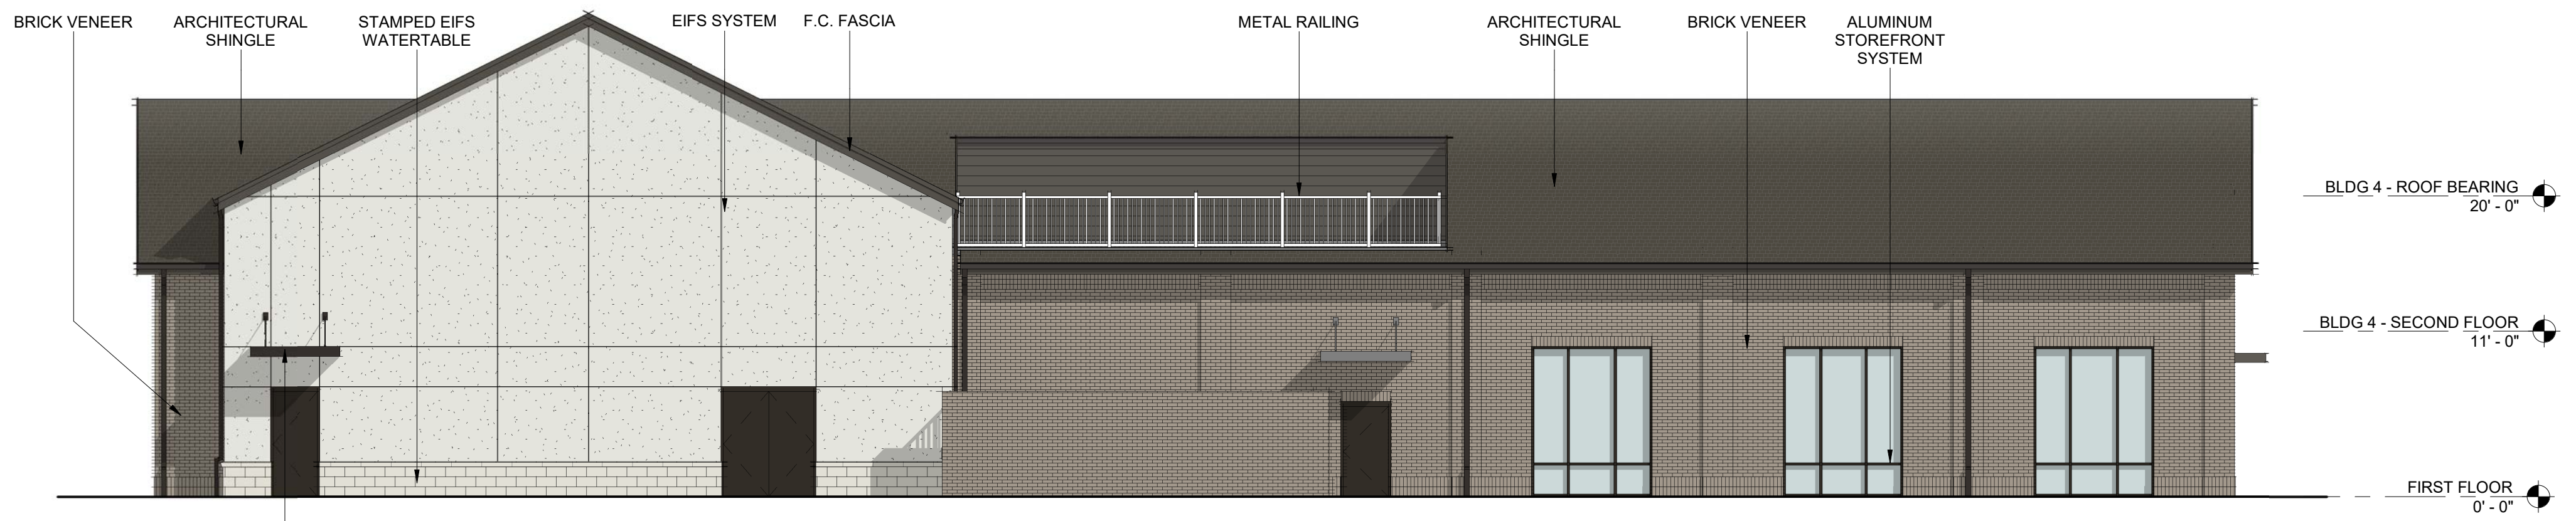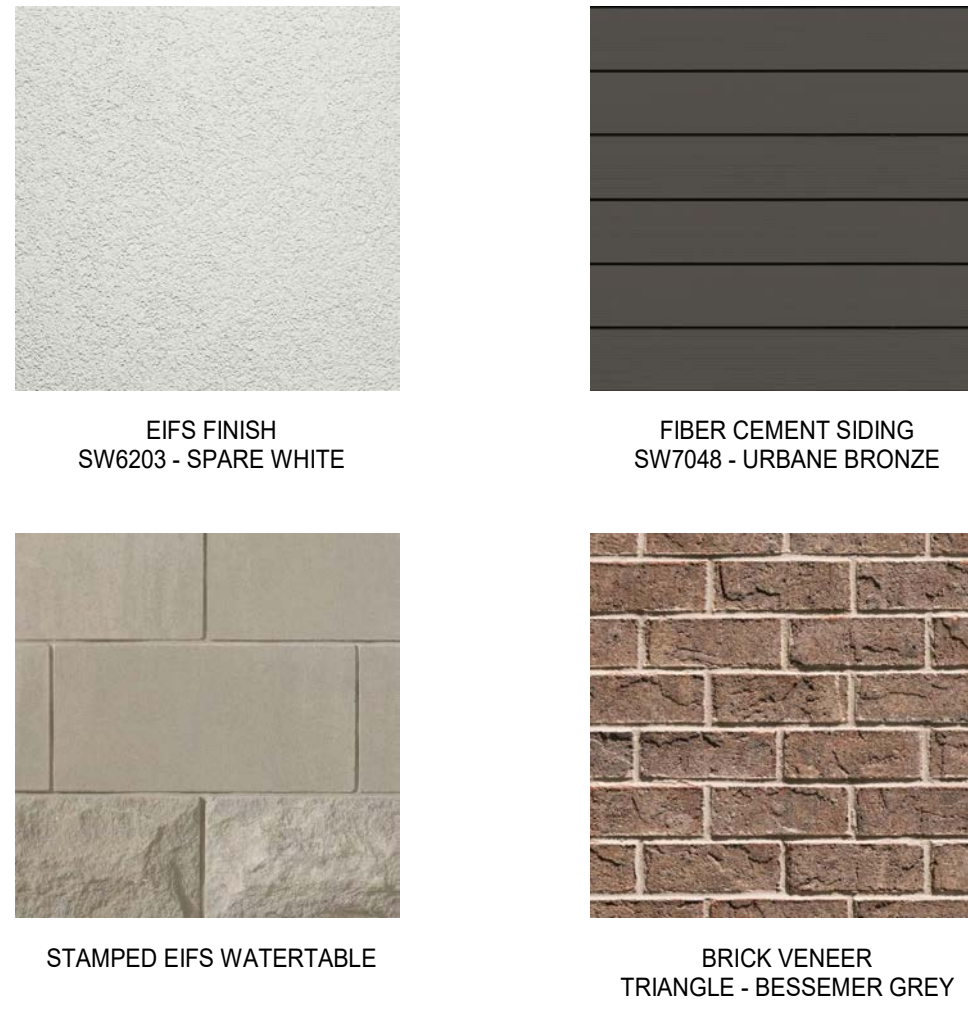

TRC - EAST ELEVATION COLOR 3
1/8" = 1'-0"


MATERIAL SWATCHES - BUILDING 4 1" = 1'-0"

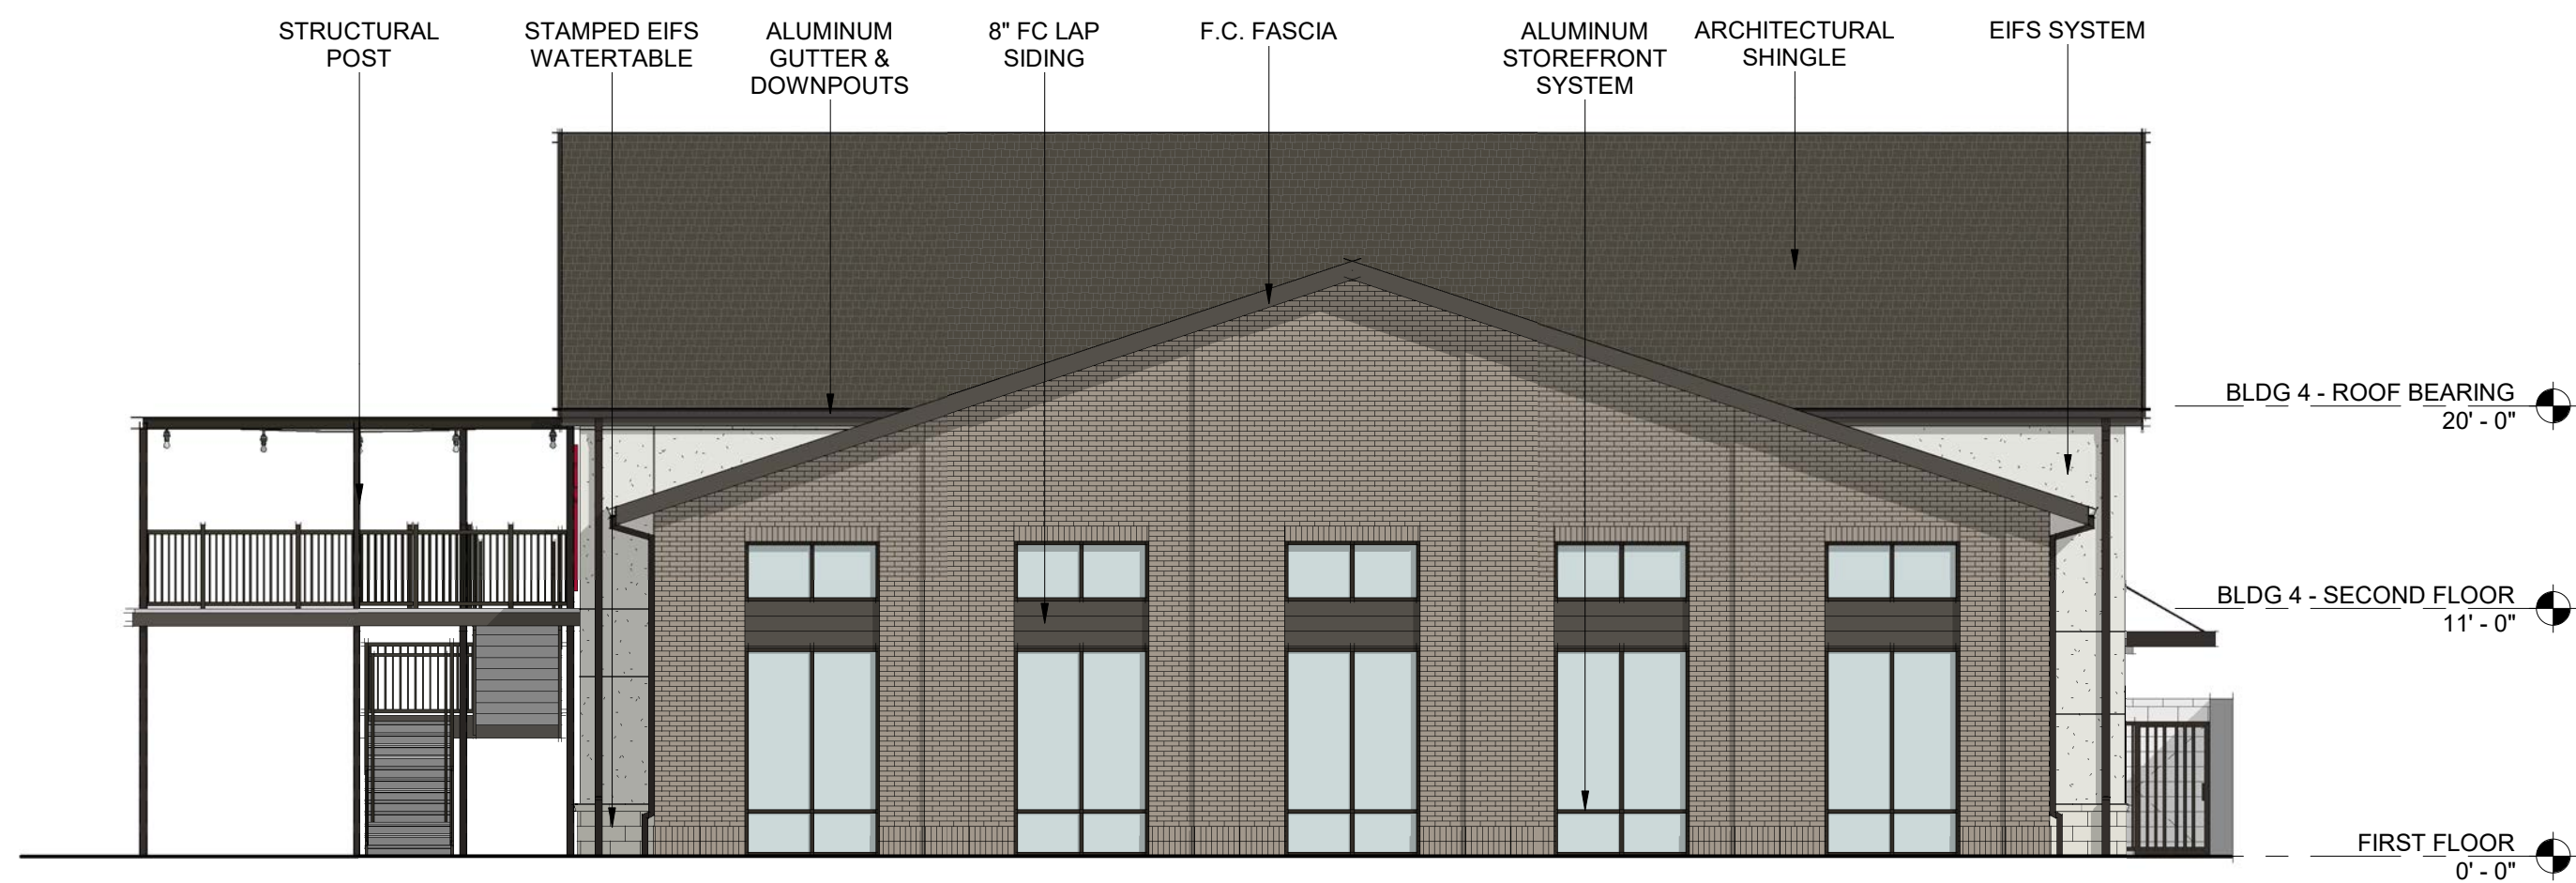

TRC - SOUTH ELEVATION COLOR 4
1/8" = 1'-0"

TRANSPARENCY CALCULATIONS
GROUND LEVEL (RETAIL USE):
TOTAL FACADE AREA (WxH): 496 SF
REQ'D AREA OF TRANSPARENCY: 496 SF x 0.4 = 198 SF
AREA OF TRANSPARENCY: 198 SF 40%


Section 7.4 - Town Center Overlay District
7.4.18 Windows, doors, display windows and/or arcades shall make up at least 40 percent of the street facade on the first story as measured from two feet above grade to ten feet above grade.
Blank walls are not permitted adjacent to streets.

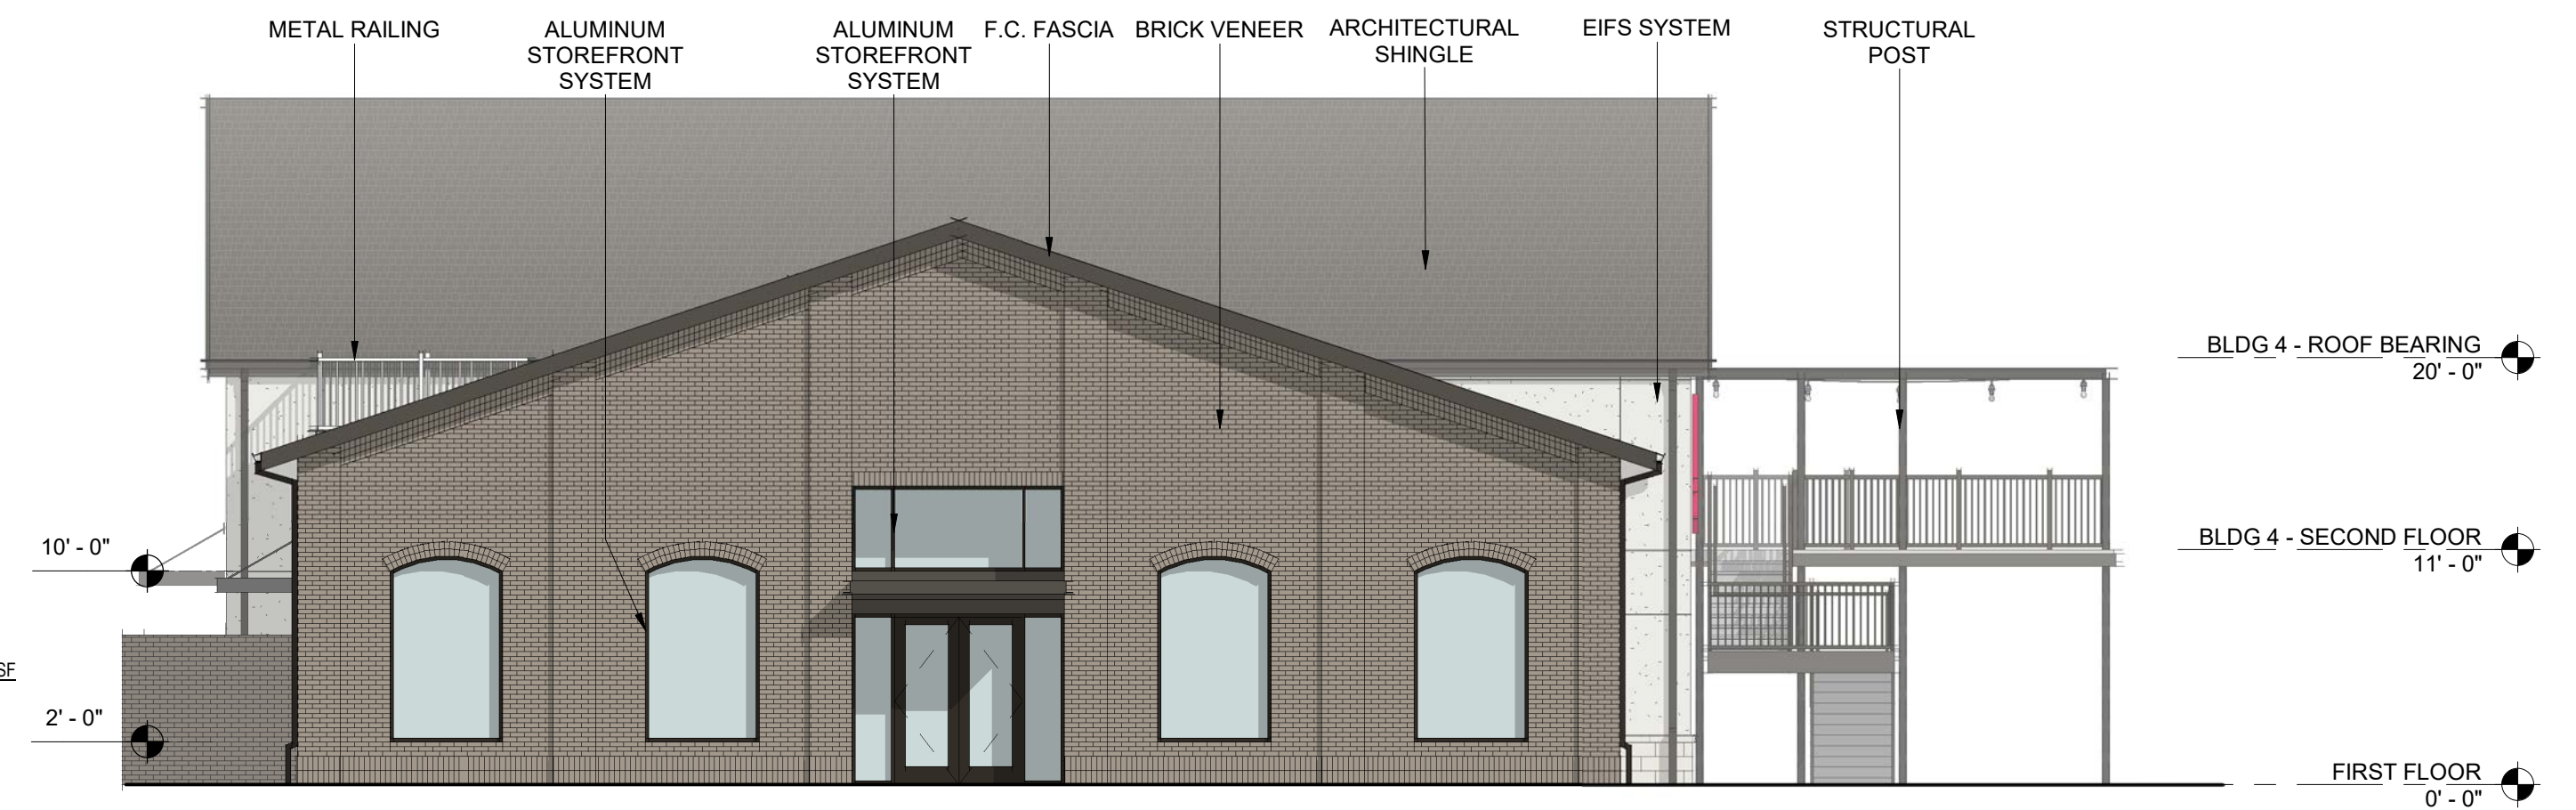

TRC - NORTH ELEVATION COLOR 2
1/8" = 1'-0"

TRANSPARENCY CALCULATIONS
GROUND LEVEL (RETAIL USE):
TOTAL FACADE AREA (WxH): 1,105 SF
REQ'D AREA OF TRANSPARENCY: 1,105 SF x 0.4 = 442 SF
AREA OF TRANSPARENCY: 442 SF 40%

Section 7.4 - Town Center Overlay District
7.4.18 Windows, doors, display windows and/or arcades shall make up at least 40 percent of the street facade on the first story as measured from two feet above grade to ten feet above grade.
Blank walls are not permitted adjacent to streets.

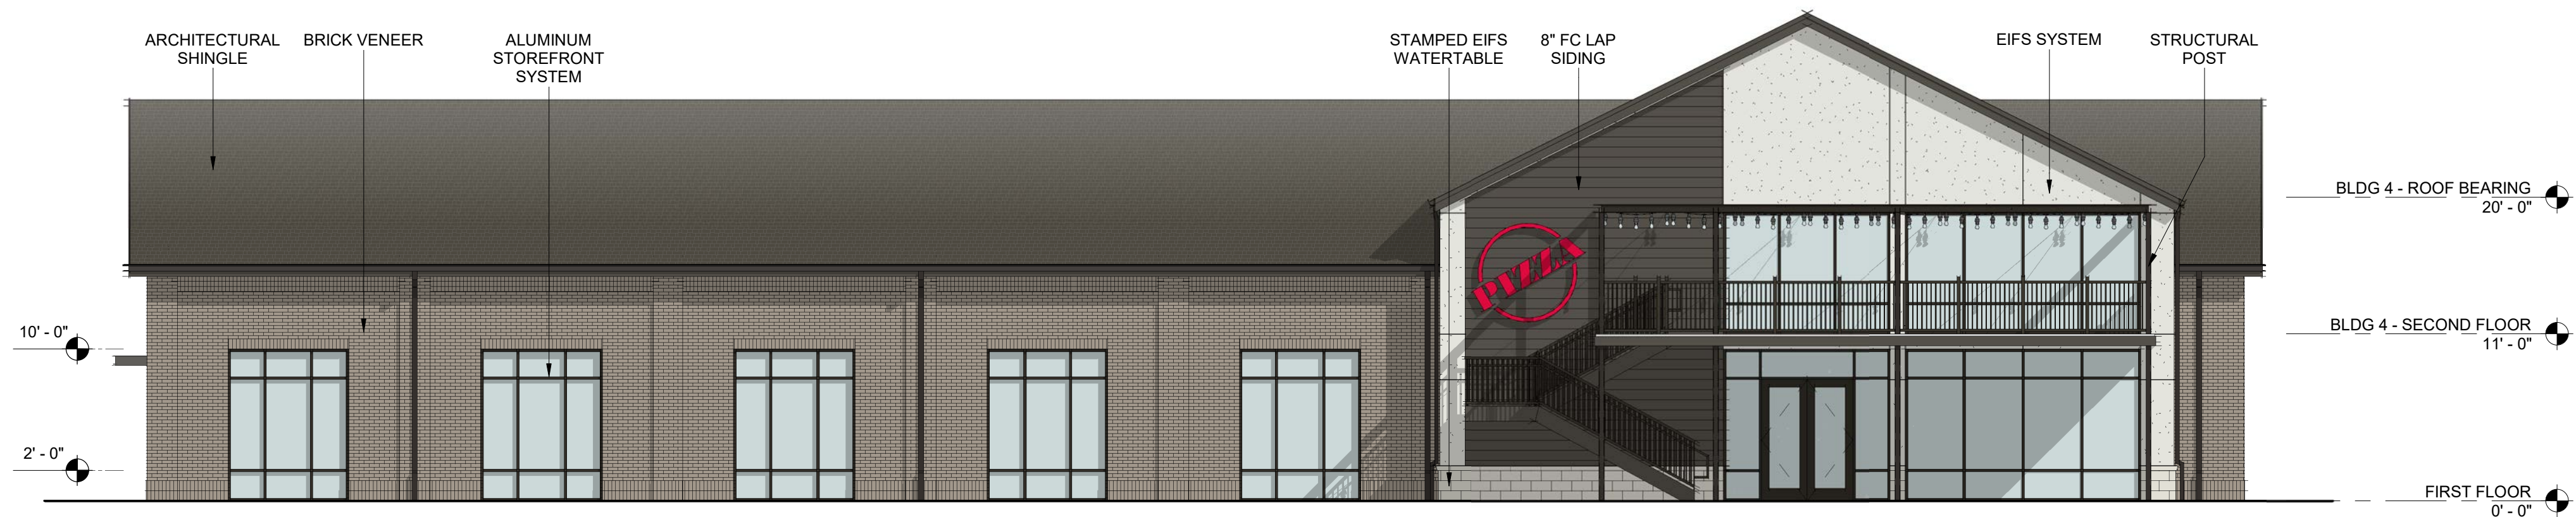


TRC - WEST ELEVATION COLOR 1
1/8" = 1'-0"



COBBLESTONE VILLAGE
ROLESVILLE, NORTH CAROLINA



FIBER CEMENT SIDING
SW7048 - URBANE BRONZE

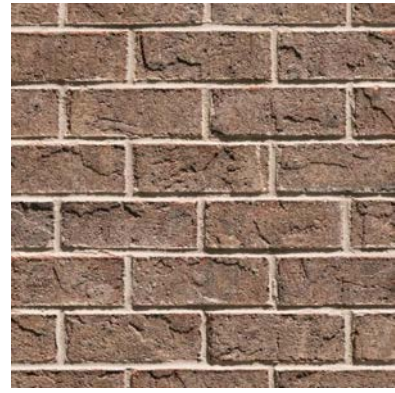

BRICK VENEER
TRIANGLE - BESSEMER GREY




3D View BLDG 5 - SE 6




3D View BLDG 5 - NE 5

MAT. SWATCHES - BLDG 5 1" = 1'-0"

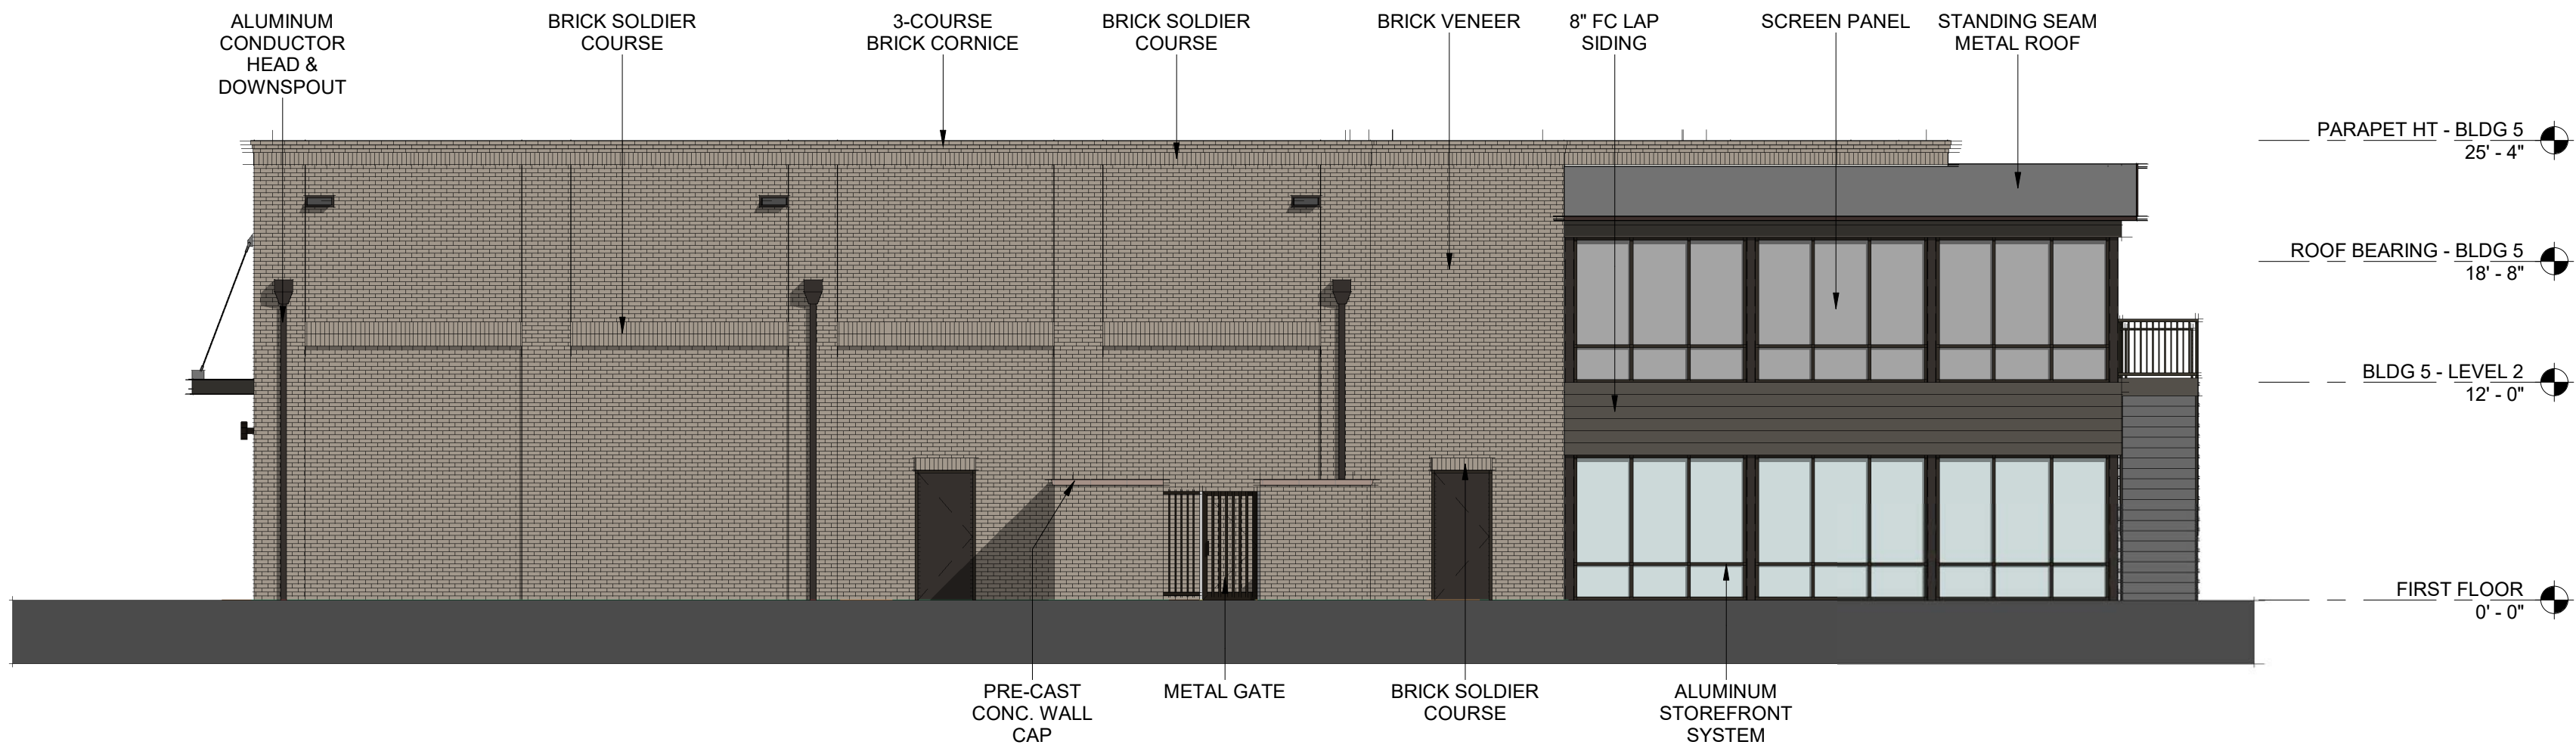

BLDG 5 - WEST ELEVATION 4 1/8" = 1'-0"

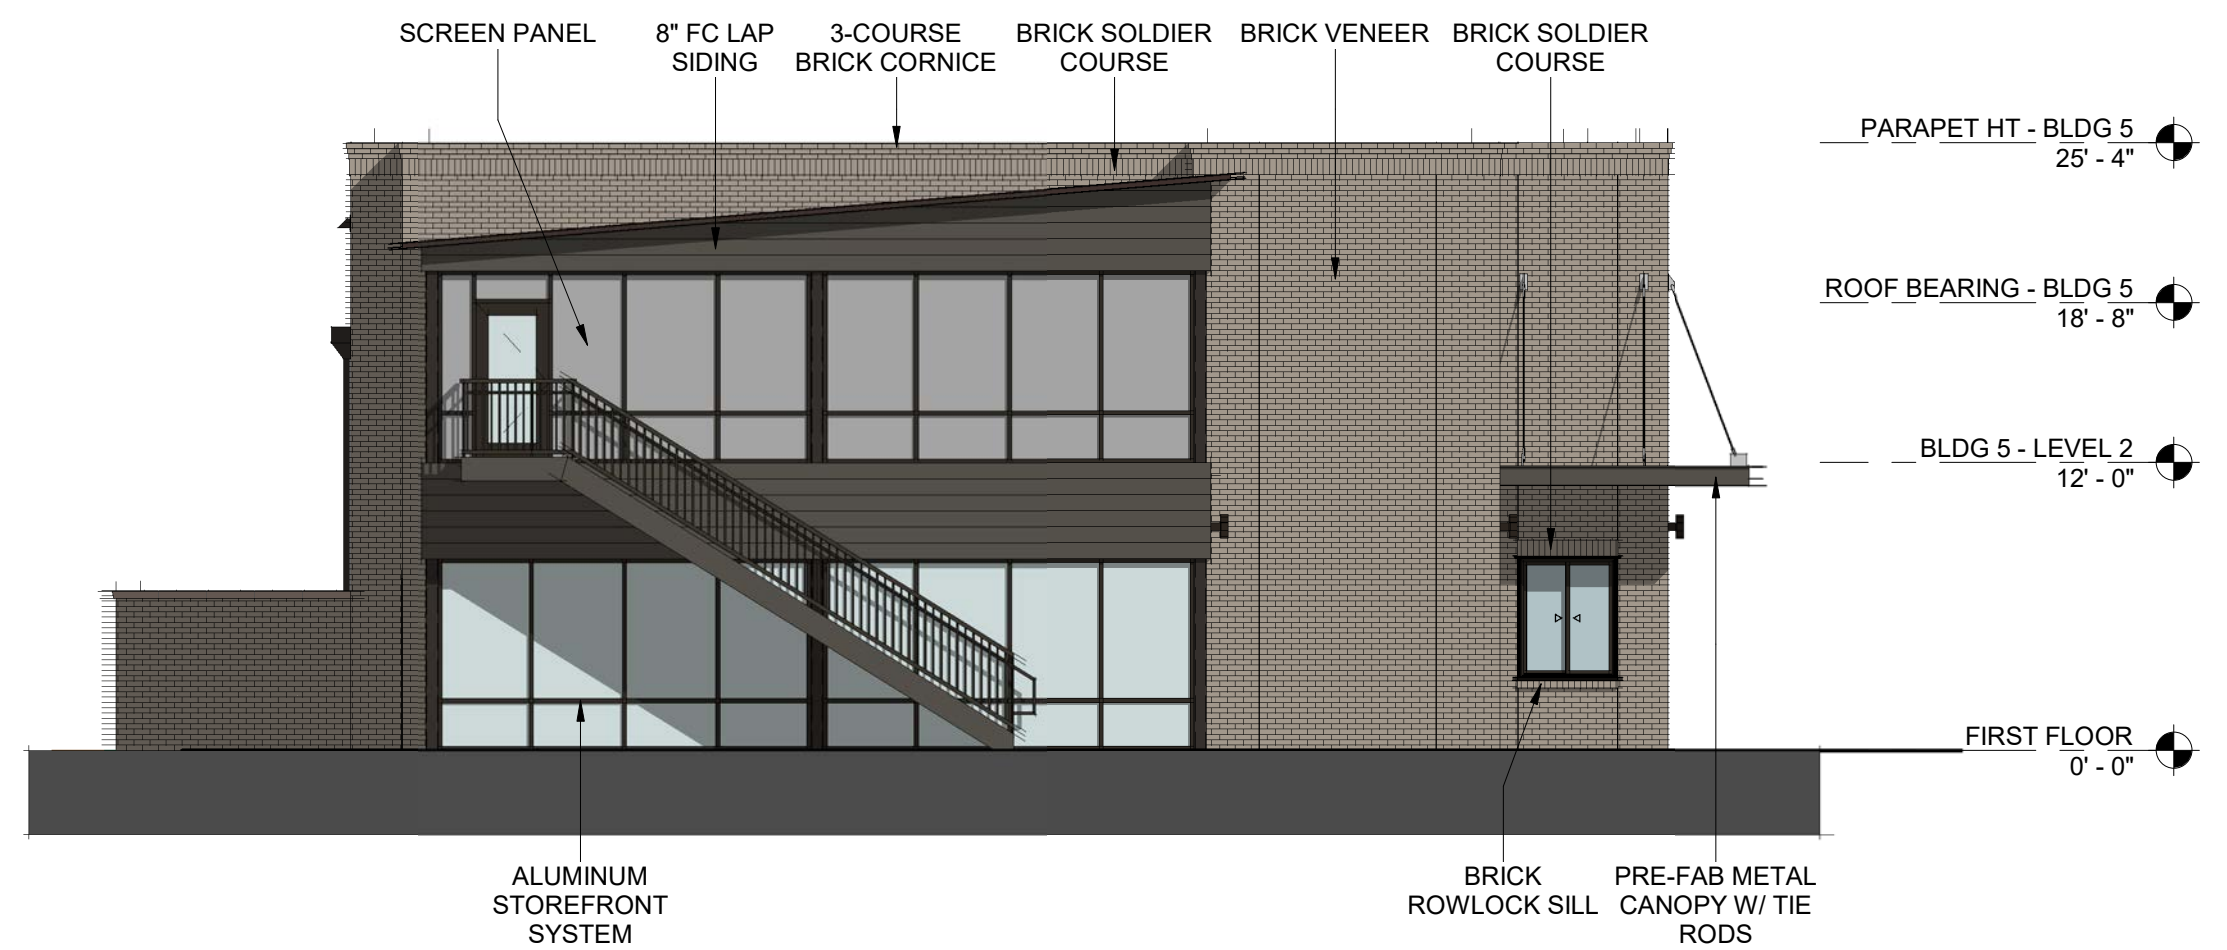


BLDG 5 - SOUTH ELEVATION 2 1/8" = 1'-0"

TRANSPARENCY CALCULATIONS
GROUND LEVEL (RETAIL USE):
TOTAL FACADE AREA (WxH): 824 SF
REQD AREA OF TRANSPARENCY: 824 SF x 0.4 = 330 SF
AREA OF TRANSPARENCY: 453 SF 55%

Section 7.4: - Town Center Overlay District

7.4.18 Windows, doors, display windows and/or arcades shall make up at least 40 percent of the street facade on the first story as measured from two feet above grade to ten feet above grade.
Blank walls are not permitted adjacent to streets.

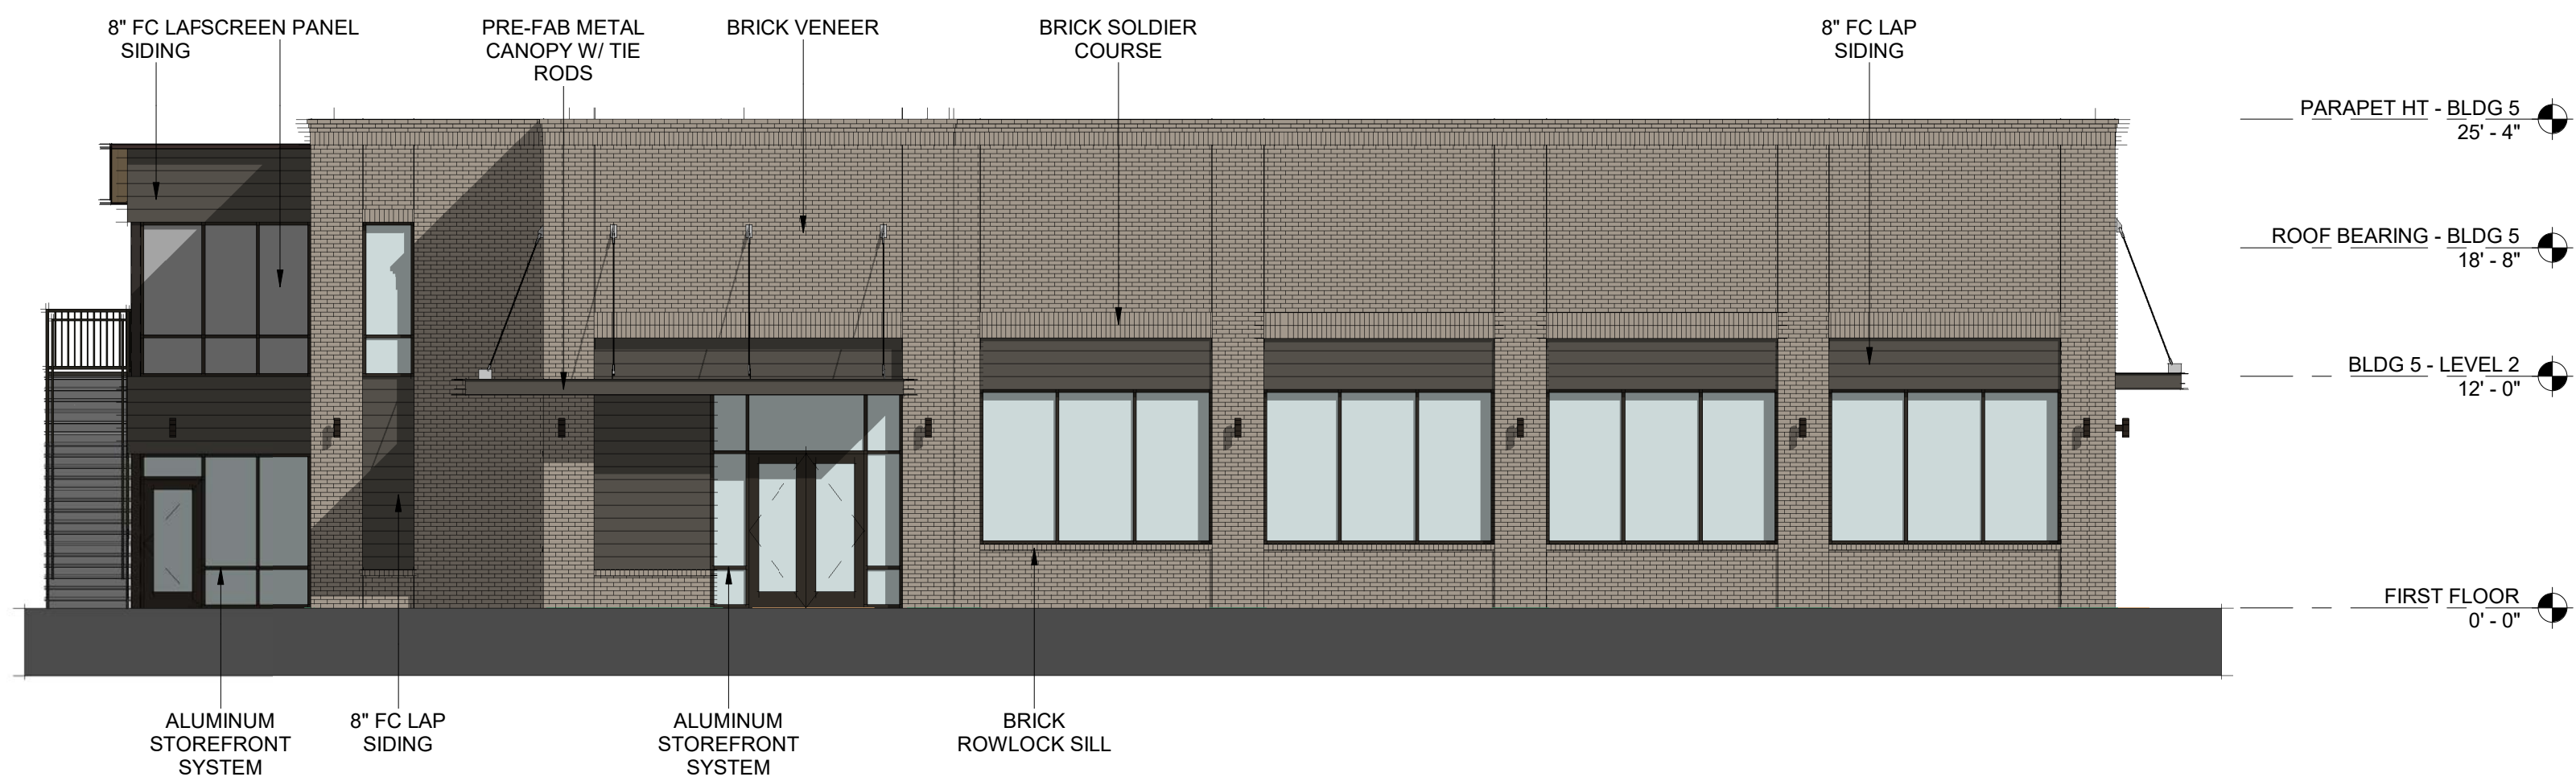


BLDG 5 - EAST ELEVATION 3 1/8" = 1'-0"

TRANSPARENCY CALCULATIONS
GROUND LEVEL (RETAIL USE):
TOTAL FACADE AREA (WxH): 412 SF
REQD AREA OF TRANSPARENCY: 412 SF x 0.4 = 165 SF
AREA OF TRANSPARENCY: 165 SF 40%

Section 7.4: - Town Center Overlay District

7.4.18 Windows, doors, display windows and/or arcades shall make up at least 40 percent of the street facade on the first story as measured from two feet above grade to ten feet above grade.
Blank walls are not permitted adjacent to streets.

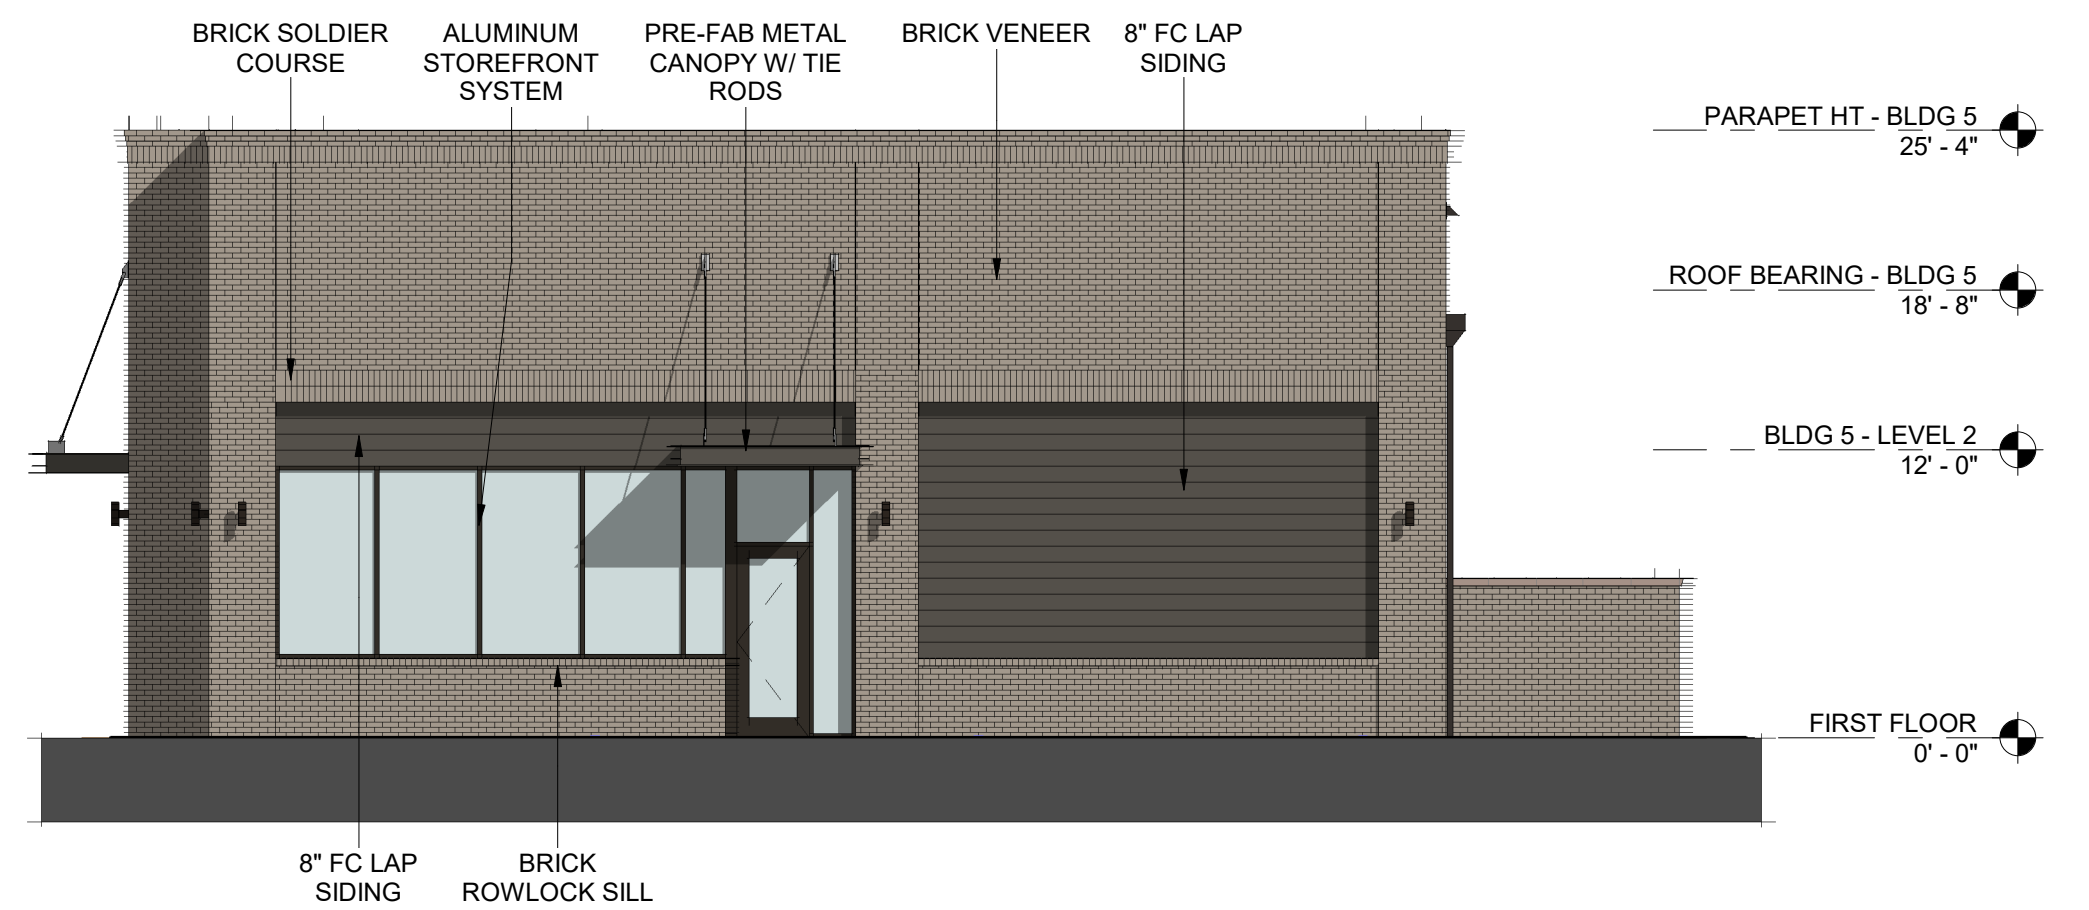

BLDG 5 - NORTH ELEVATION 1 1/8" = 1'-0"



COBBLESTONE VILLAGE
ROLESVILLE, NORTH CAROLINA

EXTERIOR ELEVATIONS - BUILDING 5 A05
As indicated | 019032 | 09.01.23



BLDG 8 - 03 RIGHT SIDE ELEVATION

1/8" = 1'-0"

4



BLDG 8 - 02 REAR ELEVATION

1/8" = 1'-0"

2

ROOF BRG. 1 - APTS
30' - 5 1/4"

THIRD FLOOR - APTS
21' - 4"

SECOND FLOOR - APTS
10' - 8"

FIRST FLOOR
0' - 0"



BLDG 8 - 04 LEFT SIDE ELEVATION

1/8" = 1'-0"

3



BLDG 8 - 01 FRONT ELEVATION

1/8" = 1'-0"

1

ROOF BRG. 1 - APTS
30' - 5 1/4"

THIRD FLOOR - APTS
21' - 4"

SECOND FLOOR - APTS
10' - 8"

FIRST FLOOR
0' - 0"

ARCHITECTURAL ASPHALT
SHINGLES

FIBER CEMENT 'BOARD
& BATTEN' SIDING

ALUMINUM
GUARDRAILS

MANUFACTURED
STONE HEADER

MANUFACTURED STONE
SILL

MANUFACTURED
STONE VENEER

VINYL WINDOWS

FIBER CEMENT LAP SIDING

FIBER CEMENT LAP SIDING

FIBER CEMENT PANEL & TRIM

SW 7048
Urbane Bronze

LAP SIDING -
8" EXPOSURE
PANEL & TRIM BOARD

SW 2803
Rookwood
Terra Cotta

LAP SIDING -
8" EXPOSURE

SW 6187
Rosemary

BOARD & BATTON
SIDING

SW 9164
Illusive Green

LAP SIDING -
6" EXPOSURE
PANEL & TRIM BOARD

SW 7042
Shoji White

LAP SIDING -
6" EXPOSURE

SW 7006
Extra White

PANEL & TRIM BOARD



COBBLESTONE VILLAGE

ROLESVILLE, NORTH CAROLINA

EXTERIOR ELEVATIONS - BUILDING 8

A08

1/8" = 1'-0" | 019032 | 09.01.23