



THE TOWN OF ROLESVILLE
DB 5134 PG 618
BM 1991 PG 1333
PIN# 1758980948
ZONE: PUD
USE: CLUB HSE

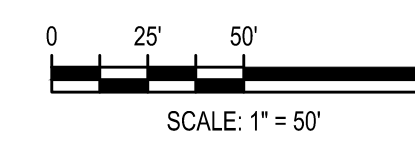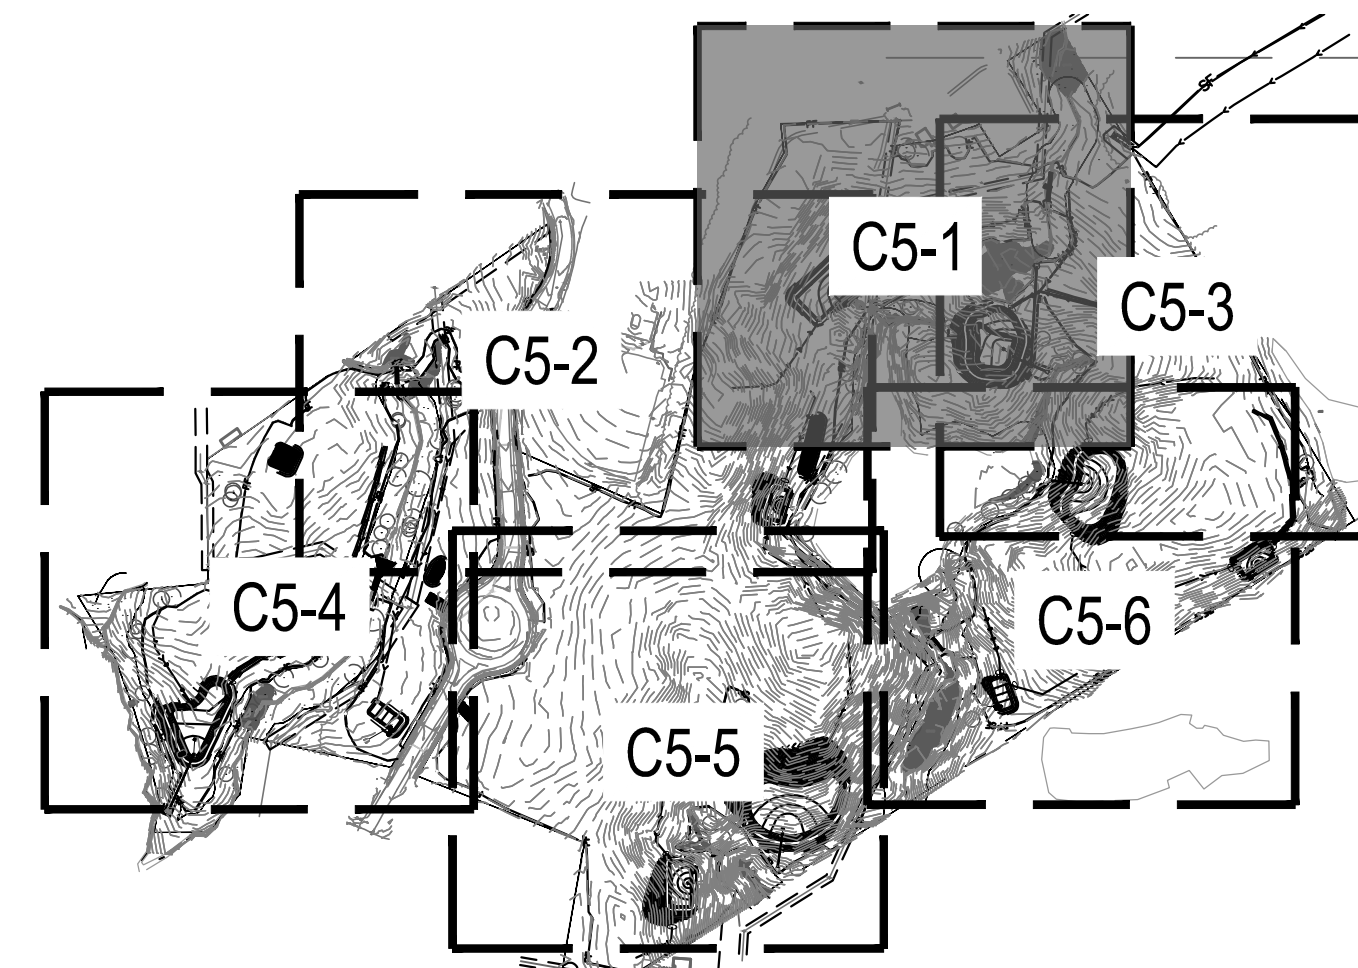

Know what's below.
Call before you dig.

G:\NCA\Projects\Lennar\8430-03 - DWG\PlanSheets\On-Site\C2-0 - EROS-PH1.dwg Layout: C5-2 ENLARGED PHASE 1 EROSION CONTROL PLAN (2 OF 6) Plotted: 10/10/2023 8:01:10 PM

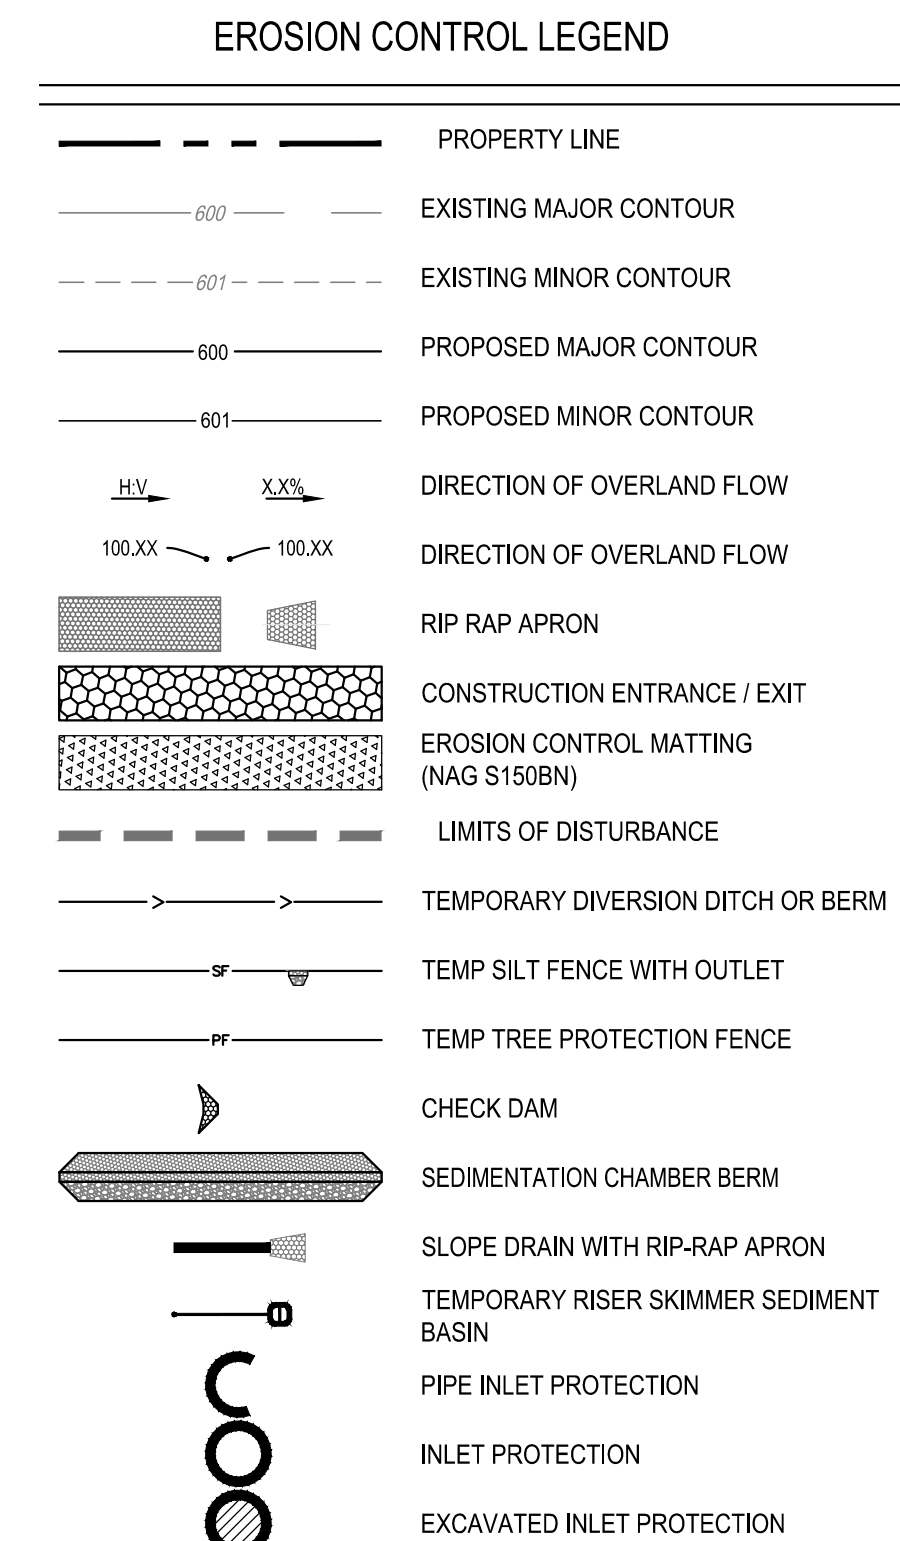



DESIGNED BY: DF/CD	
DRAWN BY: DF/JWM	
REVIEWED BY: DF	
10/02/2023 PER TOWN OF ROLESVILLE COMMENT	
08/01/2023 PER TOWN OF ROLESVILLE COMMENT	
06/01/2023 INITIAL SUBMITTAL	
REV	
BCE	
5440 WADE PARK BLVD, SUITE 102 RALEIGH NC 27607 WWW.BCEINC.COM NC LICENSE #C-4397	
LENNAR CORPORAION 1100 PERIMETER PARK DRIVE, SUITE 112 MORRISVILLE / NORTH CAROLINA / 27560	
PARKER RIDGE 82 SCHOOL STREET ROLESVILLE / NORTH CAROLINA / 27571	
ENLARGED PHASE 1 EROSION CONTROL PLAN (2 OF 6)	
PRELIMINARY ENGINEER FEDRA M. FERNANDEZ 10-12-23 NOT FOR CONSTRUCTION	
FILE NUMBER: 8430-03	
DATE: 10/02/2023	
C5-2	

G:\NCA\Projects\Lennar\8430-03 - Lennar - School Street - Rolesville\03 - DWG\PlanSheets\On-Site\C2-0 - EROS-PH1.dwg Layout: C5-4 ENLARGED PHASE 1 EROSION CONTROL PLAN (4 OF 6) Plotted: 10/11/2023 9:51:39 AM

MAX VIII, LLC
36 PG 1235
3 PG 1030
758785571
GC-CZ
MINIWHSE

STORAGE MAX II, LLC
DB 11710 PG 2072
BM 2005 PG 2354
PIN# 1758787576
ZONE: GC-CZ
USE: MINIWHSE

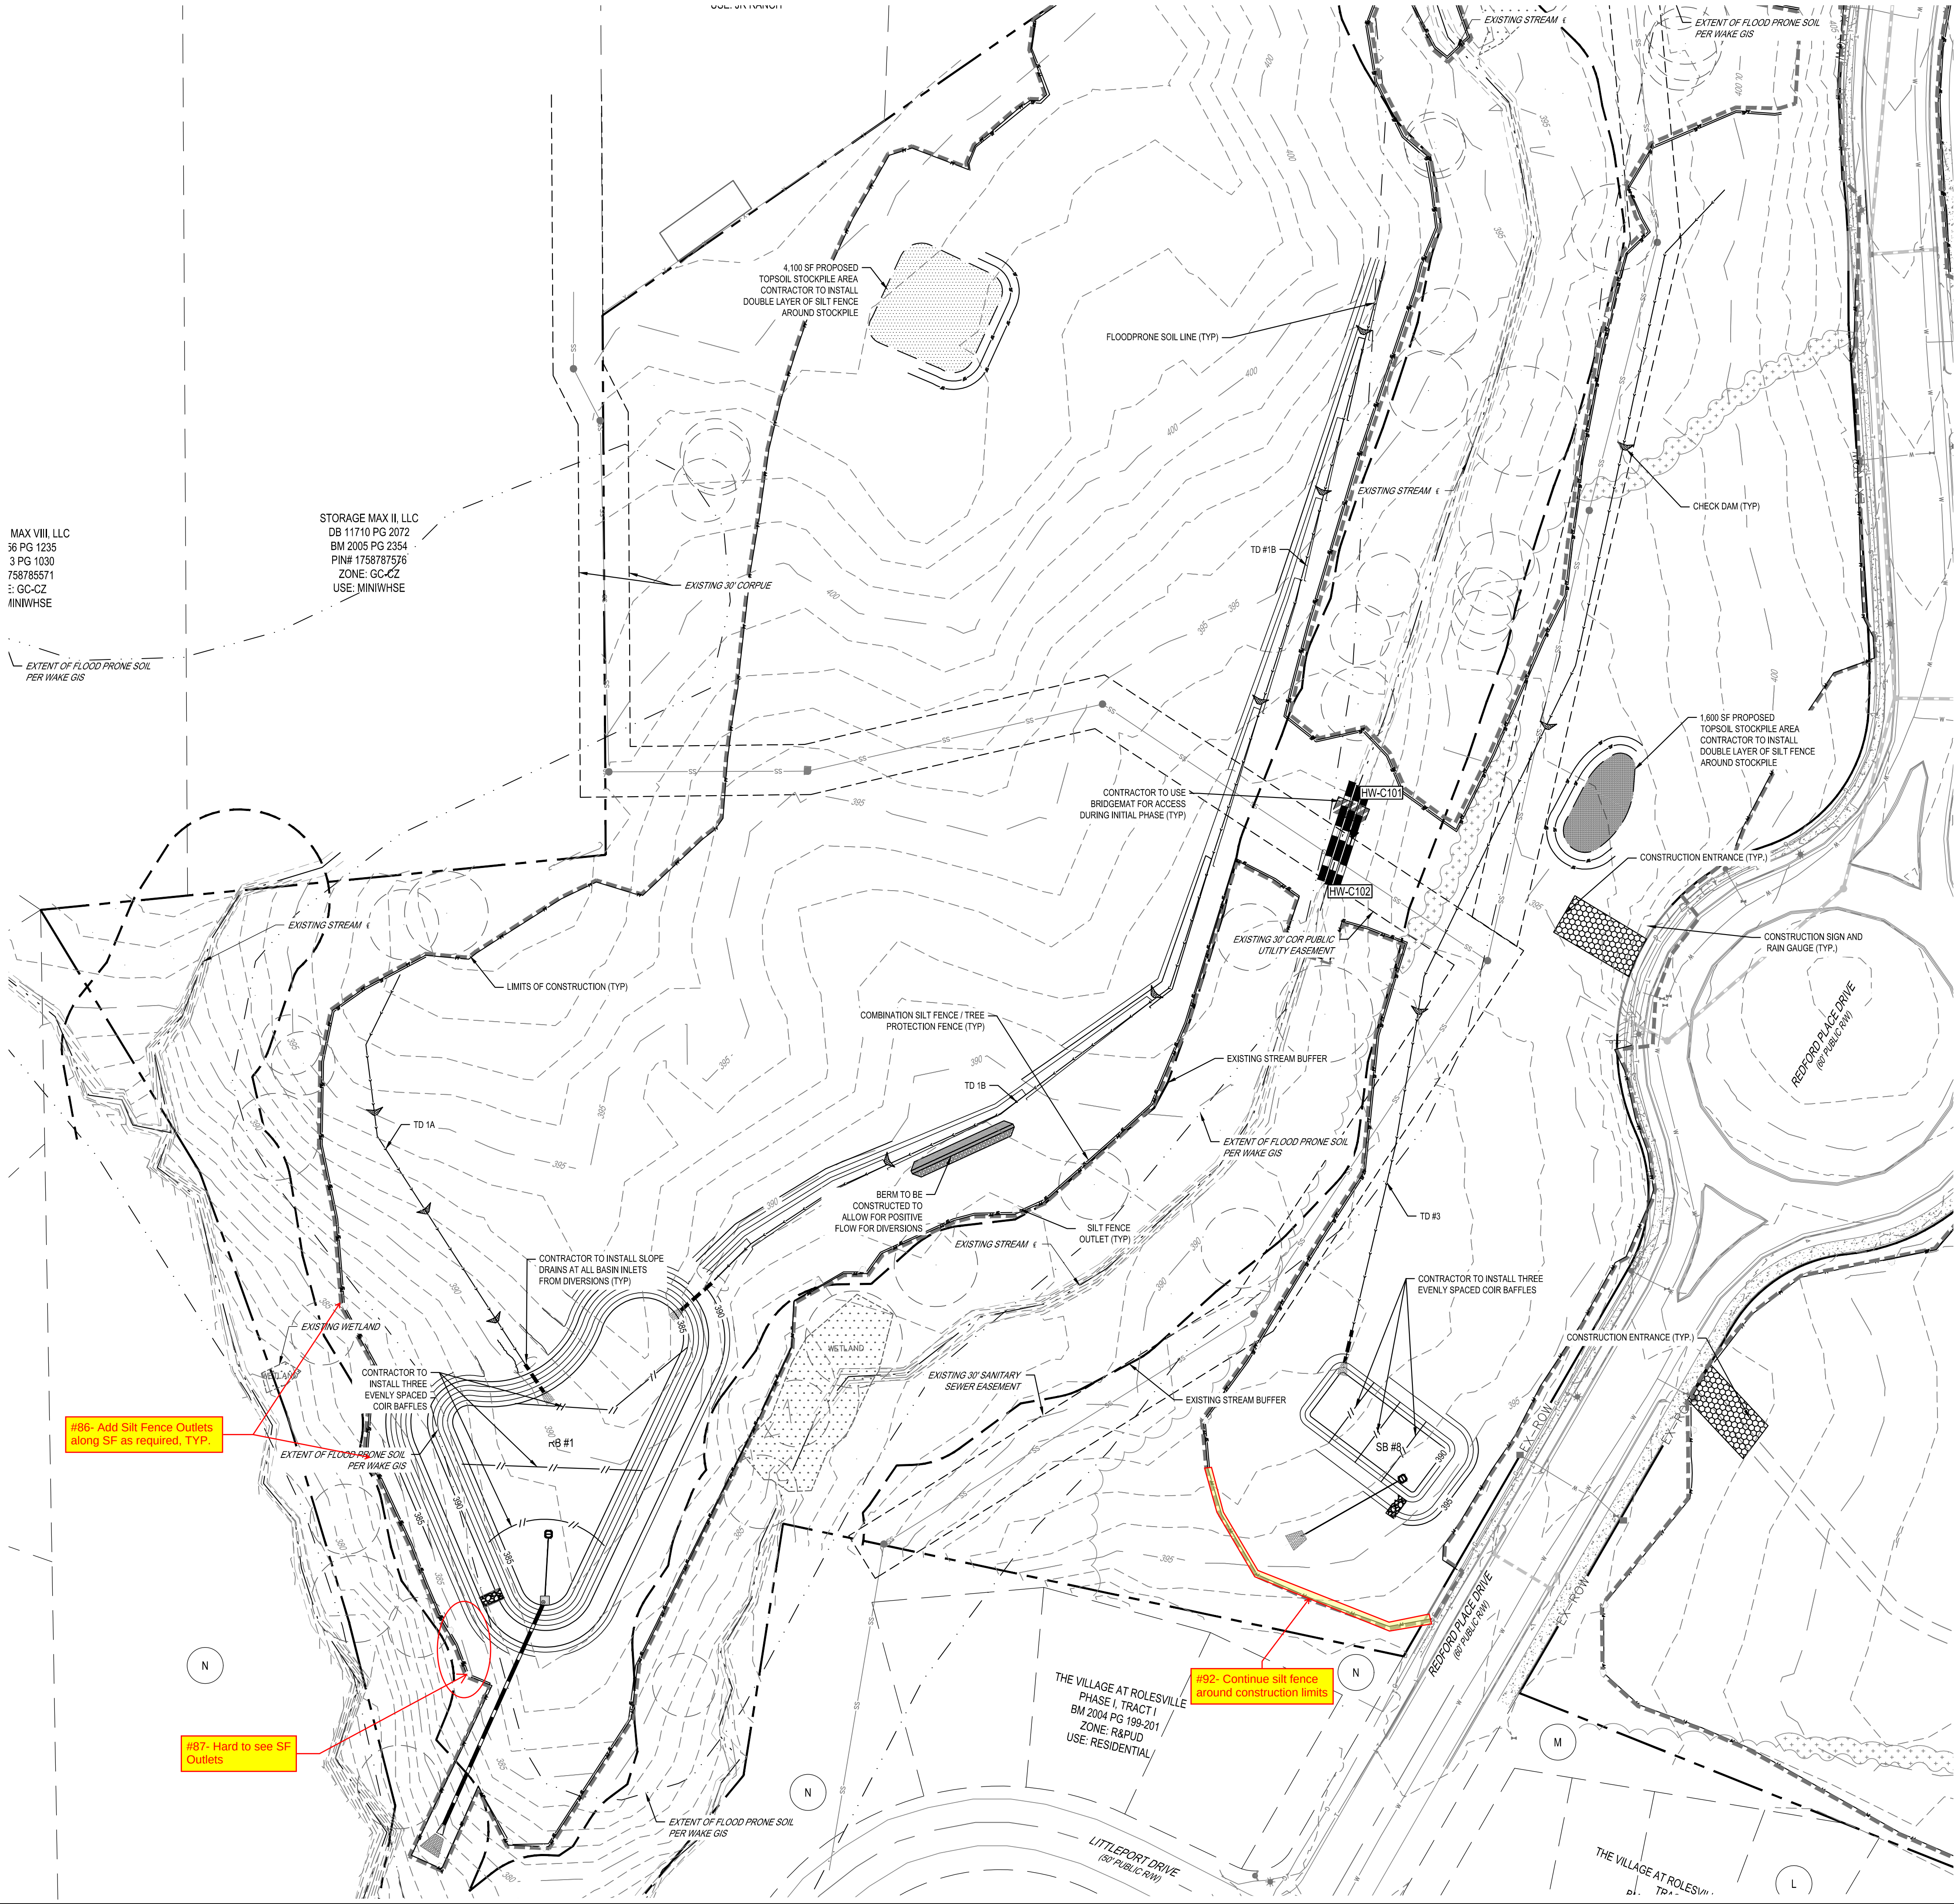

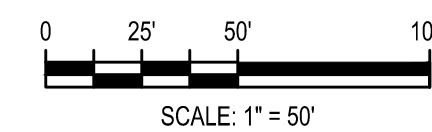


Know what's below.
Call before you dig.





 PRELIMINARY
 ENGINEER
 DEBRA M. FERRY
 10-12-23
 NOT FOR
 CONSTRUCTION
 FILE NUMBER:
 8430-03
 DATE: 10/02/2023
 C5-5

G:\NCA\Projects\Lennar\8430-03 - Lennar - School Street - Rolesville\03 - DWG\PlanSheets\On-Site\C5-2-0 - EROS-PH1.dwg Layout: C5-6 ENLARGED PHASE 1 EROSION CONTROL PLAN (6 OF 6) Plotted: 10/11/2023 9:55:54 AM

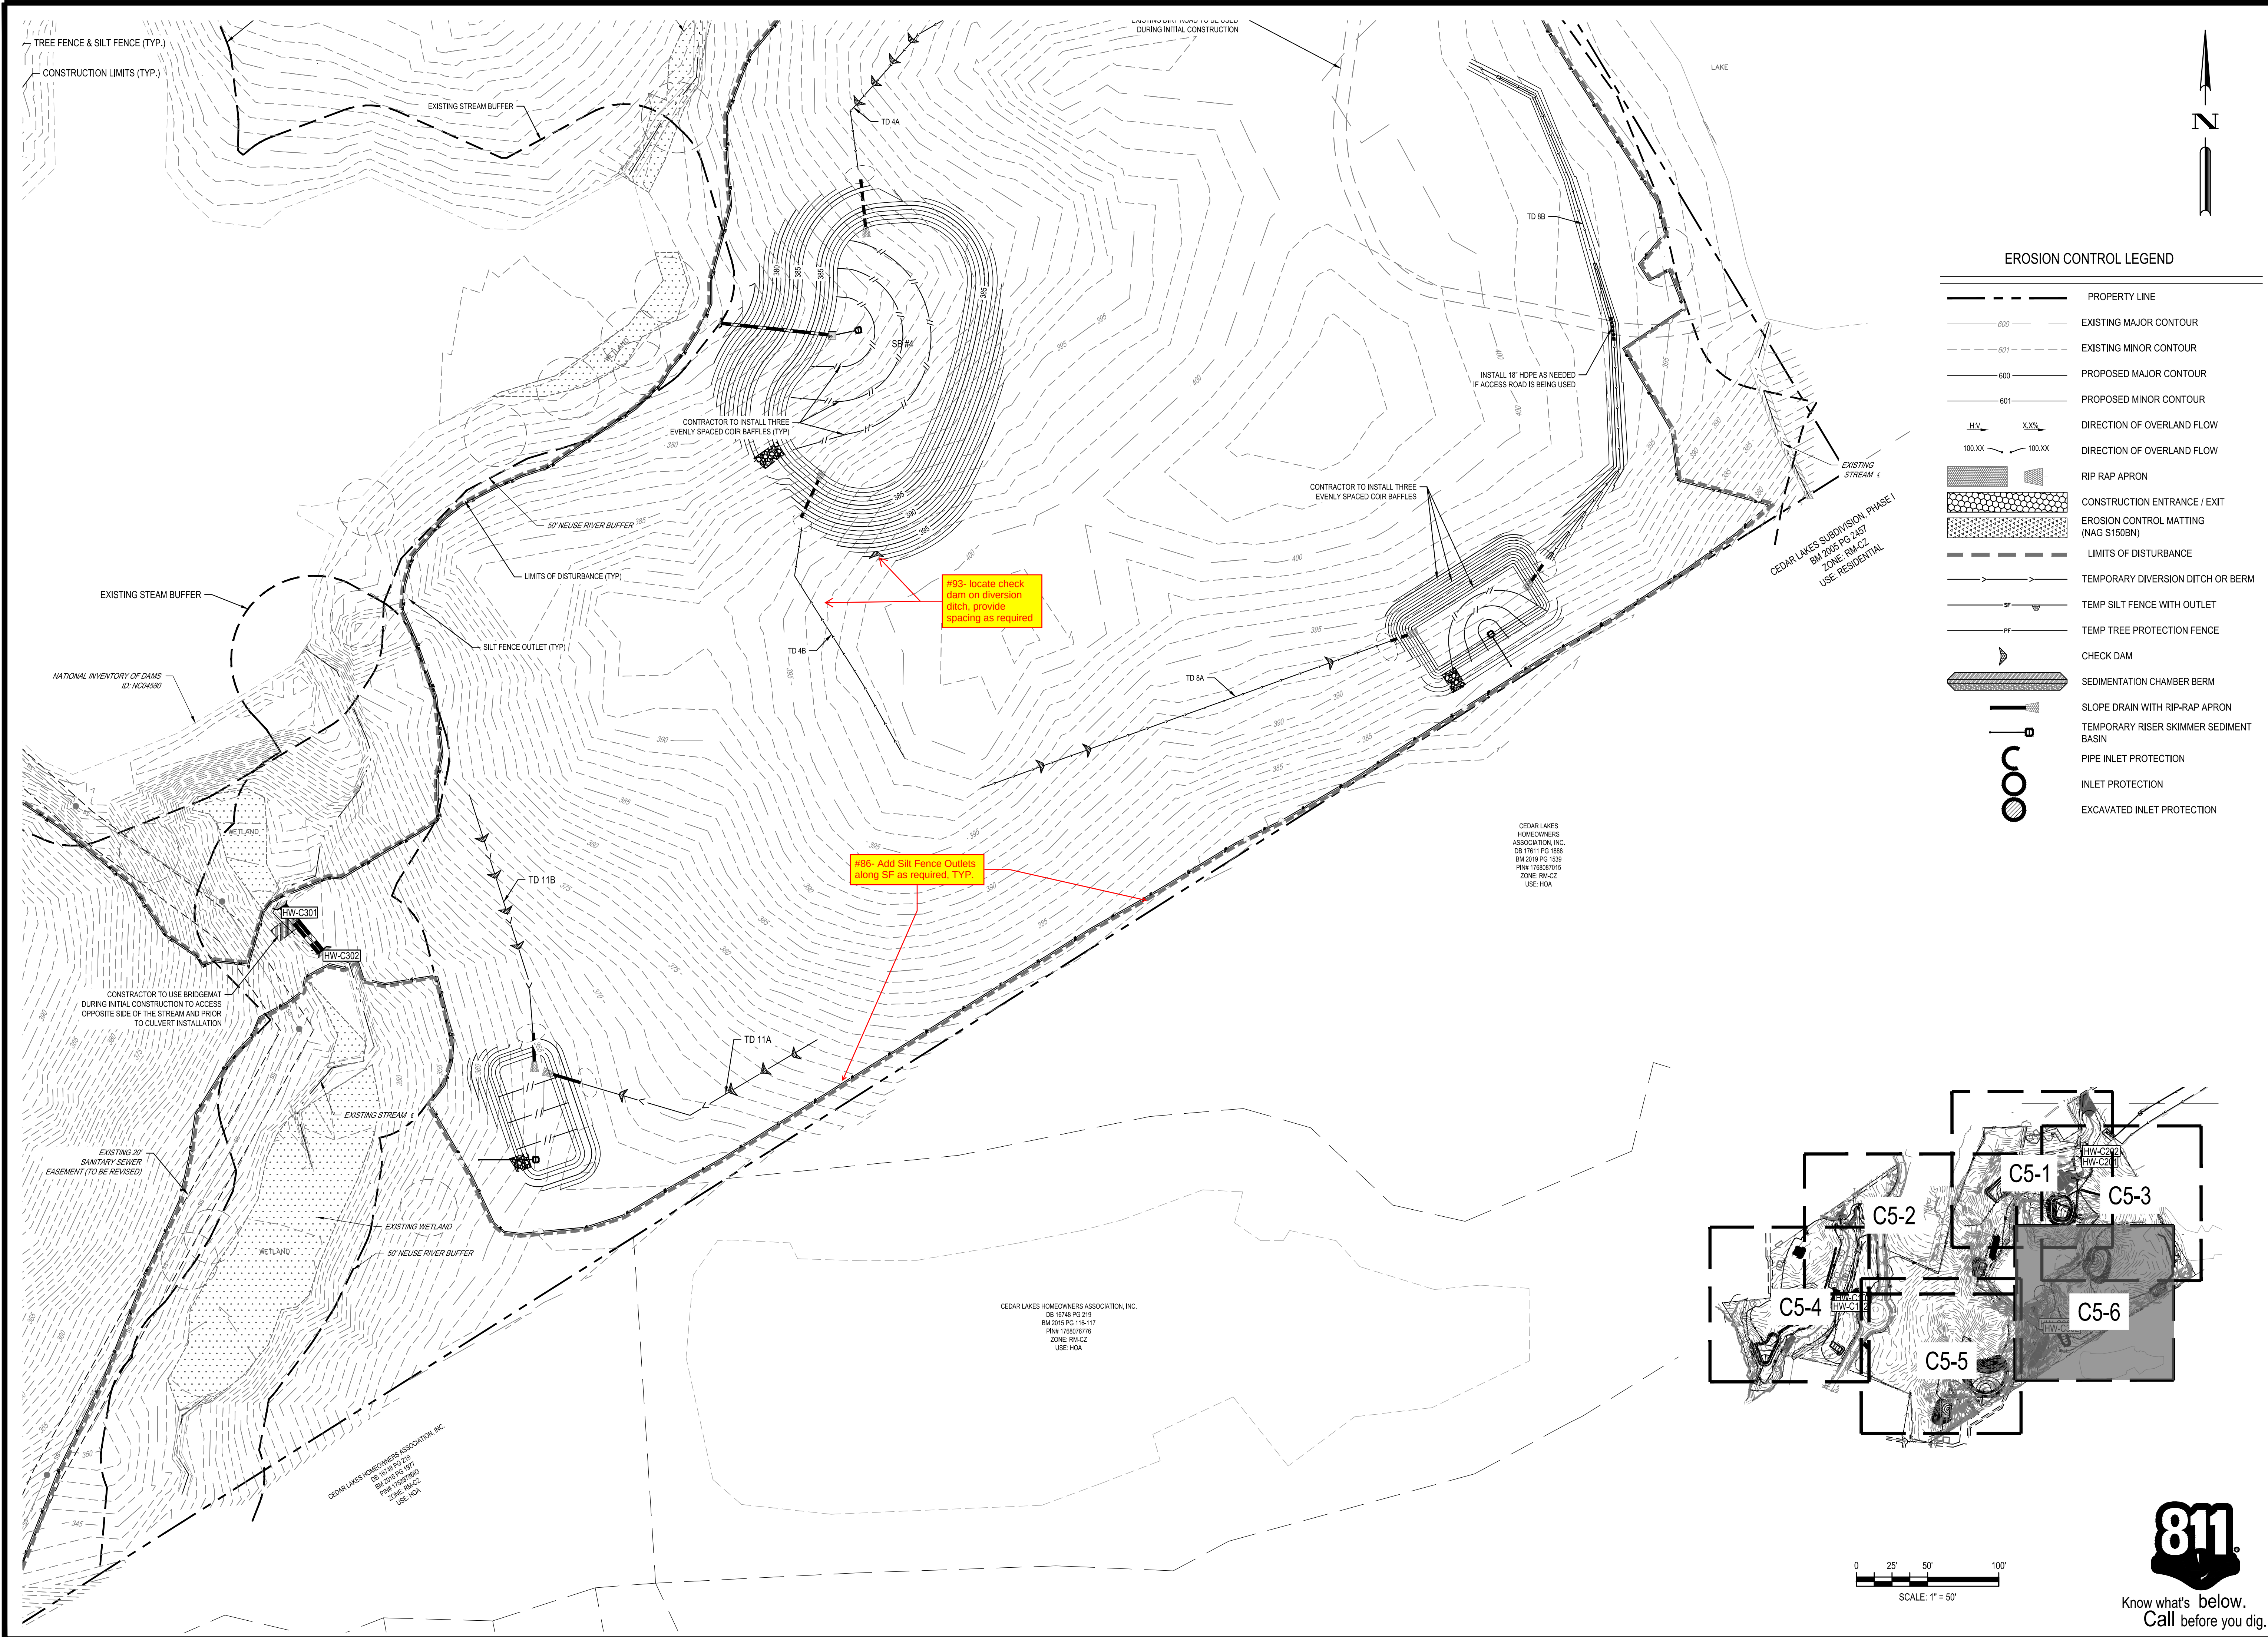

EROSION CONTROL LEGEND	
	PROPERTY LINE
	EXISTING MAJOR CONTOUR
	EXISTING MINOR CONTOUR
	PROPOSED MAJOR CONTOUR
	PROPOSED MINOR CONTOUR
	DIRECTION OF OVERLAND FLOW
	DIRECTION OF OVERLAND FLOW
	RIP RAP APRON
	CONSTRUCTION ENTRANCE / EXIT
	EROSION CONTROL MATTING (NAG S150BN)
	LIMITS OF DISTURBANCE
	TEMPORARY DIVERSION DITCH OR BERM
	TEMP SILT FENCE WITH OUTLET
	TEMP TREE PROTECTION FENCE
	CHECK DAM
	SEDIMENTATION CHAMBER BERM
	SLOPE DRAIN WITH RIP-RAP APRON
	TEMPORARY RISER SKIMMER SEDIMENT BASIN
	PIPE INLET PROTECTION
	INLET PROTECTION
	EXCAVATED INLET PROTECTION

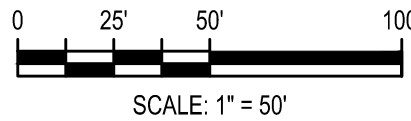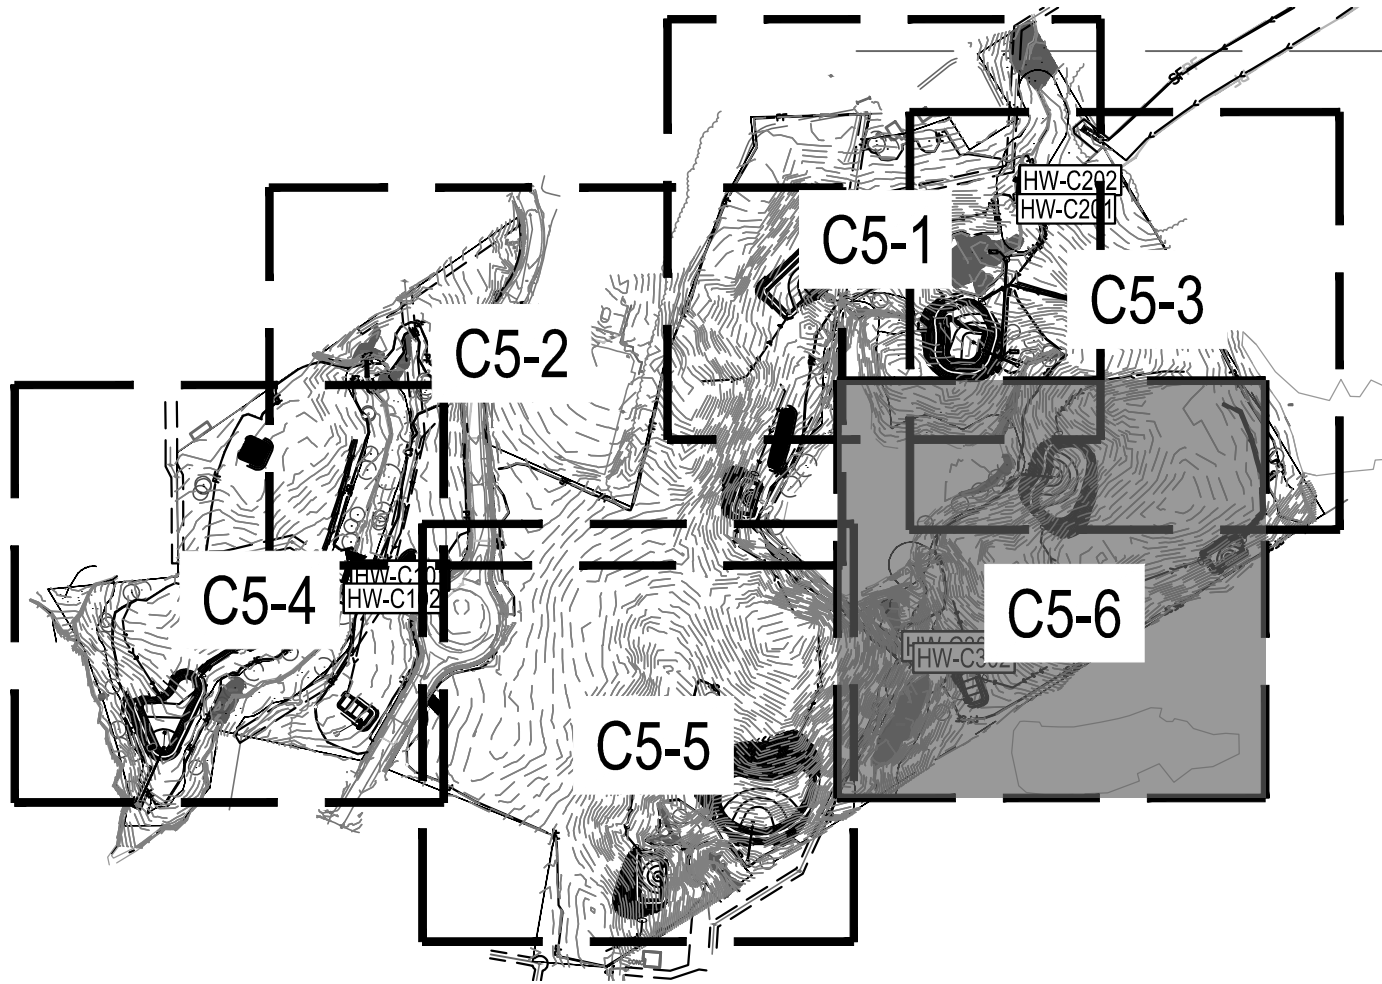

DESIGNED BY:	DF/CD
DRAWN BY:	DF/JWM
REVIEWED BY:	DF
PER TOWN OF ROLESVILLE COMMENT	10/02/2023
PER TOWN OF ROLESVILLE COMMENT	08/01/2023
INITIAL SUBMITTAL	06/01/2023
REV	
BCE	
5440 WADE PARK BLVD, SUITE 102 RALEIGH NC 27607 WWW.BCEINC.COM NC LICENSE #C-4397	
LENNAR CORPORAION	
1100 PERIMETER PARK DRIVE, SUITE 112 MORRISVILLE / NORTH CAROLINA / 27560	
PARKER RIDGE	
82 SCHOOL STREET ROLESVILLE / NORTH CAROLINA / 27571	
ENLARGED PHASE 1 EROSION CONTROL PLAN (6 OF 6)	
PRELIMINARY	
NOT FOR CONSTRUCTION	
FILE NUMBER: 8430-03	
DATE: 10/02/2023	
C5-6	

WAKE COUNTY BOARD OF EDUCATION
BM 2003 PG 557
PIN# 1758990785
ZONE: RL
USE: SCHOOL

#86- Silt Fence Outlets at Low Points

THE TOWN OF ROLESVILLE
DB 5134 PG 618
BM 1991 PG 1333
PIN# 1758980948
ZONE: PUD
USE: CLUB HSE




HATCHED SLOPES ARE 3:1 OR GREATER AND
REQUIRE STABILIZATION PER TABLE AT LEFT

SECTION E: GROUND STABILIZATION		
Required Ground Stabilization Timelines		
Site Area Description	Stabilize within this many calendar days after ceasing land disturbance	Timeframe variations
(a) Perimeter ditches, swales, ditches, and perimeter slopes	7	None
(b) High Quality Water (HWQ) Zones	7	None
(c) Slopes steeper than 3:1	14	If slopes are 10° or less in length and are not steeper than 2:1, 14 days are allowed 7 days for slopes greater than 50° in length and with slopes steeper than 4:1 7 days for perimeter ditches, swales, ditches, perimeter slopes and HWQ Zones 10-days for Falls Lake Watershed
(d) Slopes 3:1 to 4:1	14	7 days for perimeter ditches, swales, ditches, perimeter slopes and HWQ Zones 10-days for Falls Lake Watershed unless there is zero slope
(e) Areas with slopes flatter than 3:1	14	7 days for perimeter ditches, swales, ditches, perimeter slopes and HWQ Zones 10-days for Falls Lake Watershed unless there is zero slope

Note: After the permanent cessation of construction activities, any areas with temporary ground stabilization shall be converted to permanent ground stabilization as soon as practicable but in no case longer than 90 calendar days after the last land disturbing activity. Temporary stabilization shall be maintained in a manner to reduce the surface stable against accelerated erosion until permanent ground stabilization is achieved.

Note: After the permanent cessation of construction activities, any areas with temporary ground stabilization shall be converted to permanent ground stabilization as soon as practicable but in no case longer than 90 calendar days after the last land disturbing activity. Temporary ground stabilization shall be maintained in a manner to render the surface stable against accelerated erosion until permanent ground stabilization is achieved.

EROSION CONTROL LEGEND

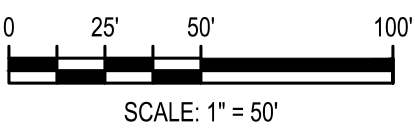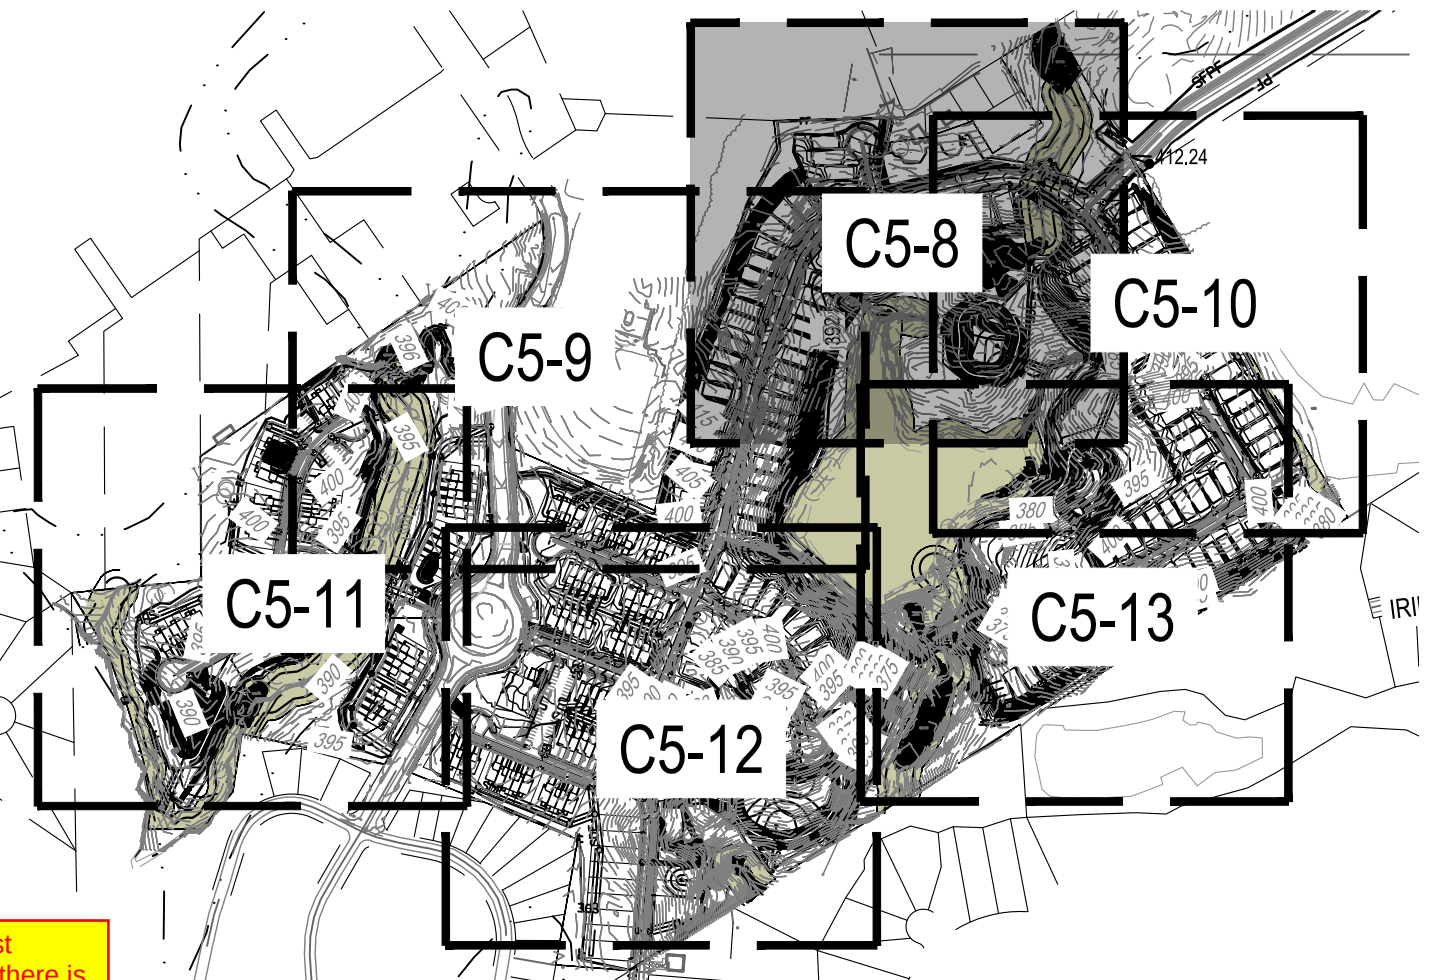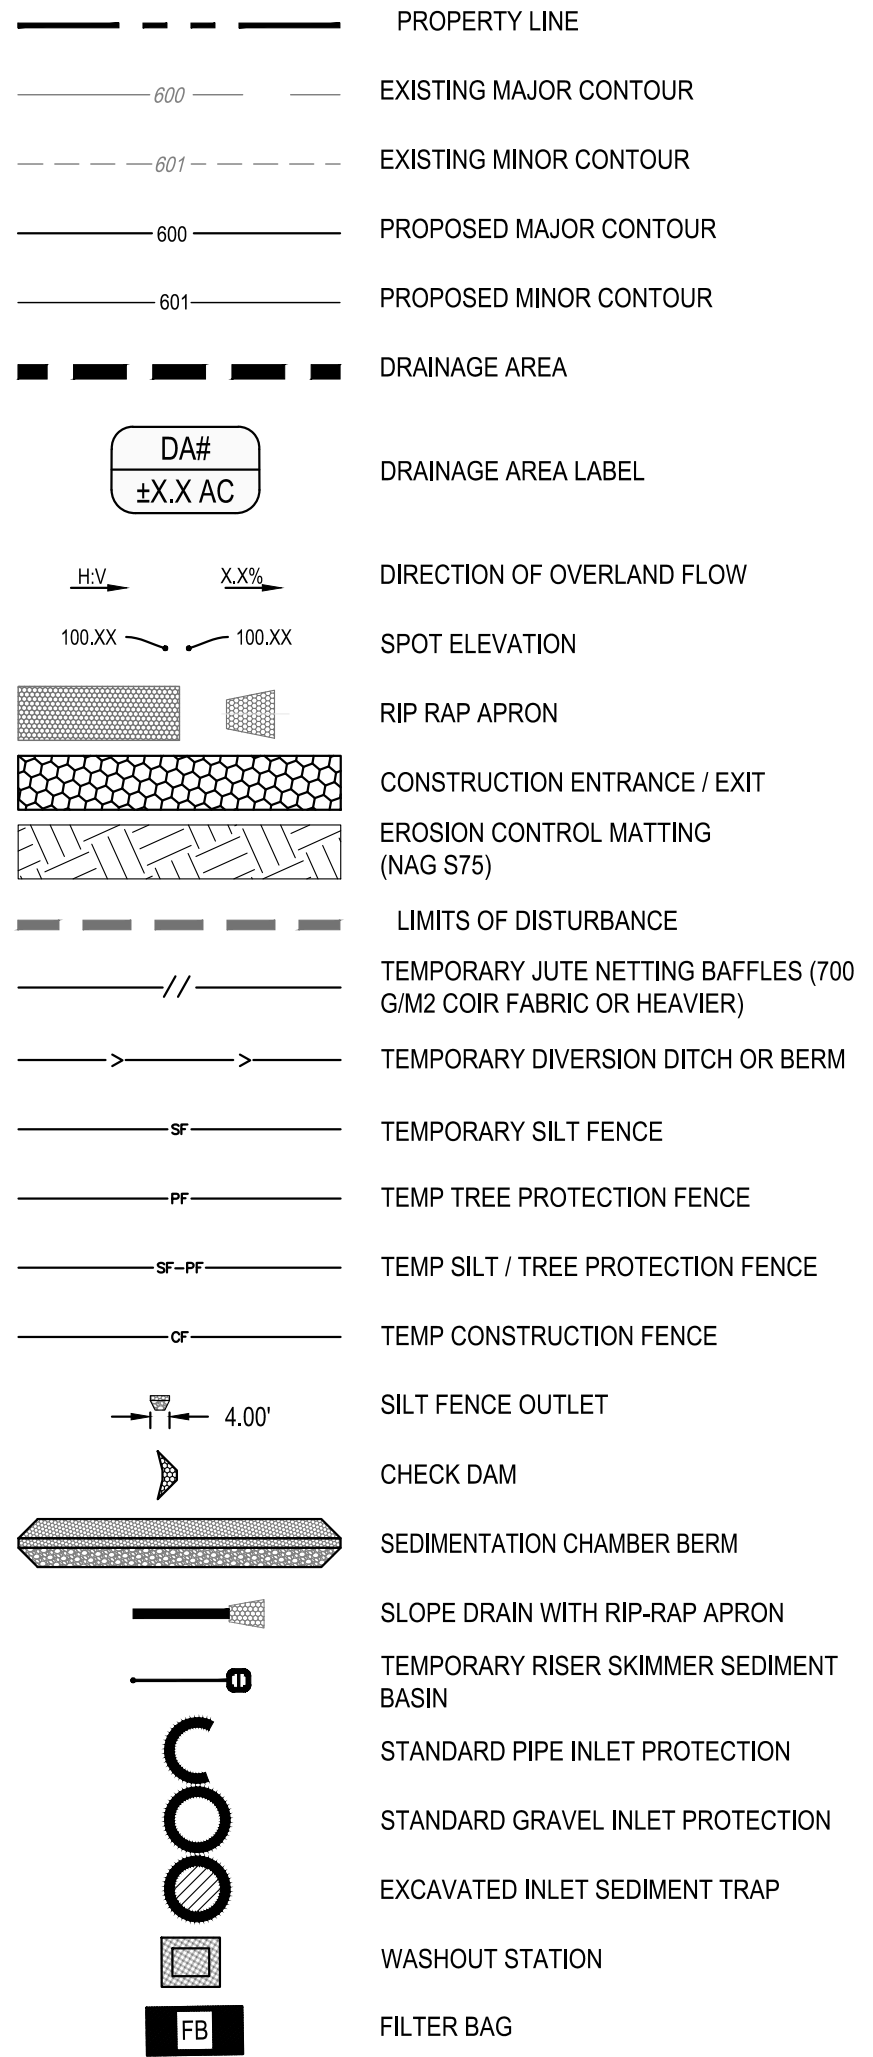

Know what's below.
Call before you dig.

**LENNAR
CORPORAION**
1100 PERIMETER PARK DRIVE, SUITE 200
MORRISVILLE / NORTH CAROLINA / 27560

PARKER RIDGE
82 SCHOOL STREET
ROLESVILLE / NORTH CAROLINA / 27081

ENLARGED PHASE 2
EROSION CONTROL
PLAN (1 OF 6)



NORTH CAROLINA
 PROFESSIONAL
 PRELIMINARY
 ENGINEER
 DEBRA M. FEARN
 10-12-23
 NOT FOR
 CONSTRUCTION
 FILE NUMBER:
 8430-03
 DATE: 10/02/2023

C5-8

08/01/2023	PER TOWN OF ROLESVILLE COMMENT
06/01/2023	INITIAL SUBMITTAL

5440 WADE PARK BLVD, SUITE 102
RALEIGH NC 27607
WWW.BGEINC.COM
NC LICENSE #C-4397 ©20

1100 PERIMETER PARK DRIVE, SUITE 112
MORRISVILLE / NORTH CAROLINA / 27560

82 SCHOOL STREET
ROLESVILLE / NORTH CAROLINA / 27059

ENLARGED PHASE 2
EROSION CONTROL
PLAN (1 OF 6)




NORTH CAROLINA
 PROFESSIONAL
 PRELIMINARY
 ENGINEER
 DEBRA M. FEARN
 10-12-23
 NOT FOR
 CONSTRUCTION
 FILE NUMBER:
 8430-03
 DATE: 10/02/2023

C5-8

SECTION E: GROUND STABILIZATION		
Site Area Description	Required Ground Stabilization Timeframes	
	Stabilize within this many calendar days after ceasing land disturbance	Timeframe variations
(a) Perimeter dikes, swales, ditches, and perimeter slopes	7	None
(b) High Quality Water (HQW) Zones	7	None
(c) Slopes steeper than 3:1	7	If slopes are 10' or less in length and are not steeper than 2:1, 14 days are allowed
(d) Slopes 3:1 to 4:1	14	- 7 days for slopes greater than 50' in length and with slopes steeper than 4:1 - 7 days for perimeter dikes, swales, ditches, perimeter slopes and HQW Zones - 10 days for Falls Lake Watershed
(e) Areas with slopes flatter than 4:1	14	- 7 days for perimeter dikes, swales, ditches, perimeter slopes and HQW Zones - 10 days for Falls Lake Watershed unless there is zero slope

Note: After the permanent cessation of construction activities, any areas with temporary ground stabilization shall be converted to permanent ground stabilization as soon as practicable but in no case longer than 90 calendar days after the last land disturbing activity. Temporary ground stabilization shall be maintained in a manner to render the surface stable against accelerated erosion until permanent ground stabilization is achieved.

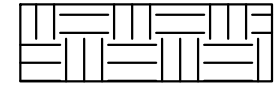

HATCHED SLOPES ARE 3:1 OR GREATER AND REQUIRE STABILIZATION PER TABLE ABOVE


REDFORD PLAZA, LLC
DB 16331 PG 976
BM 1993 PG 1381
PIN# 1758895219
ZONE: R&PUD
USE: NBHD S/C

REDFORD PLAZA, LLC
DB 16331 PG 976
BM 2006 PG 1022
PIN# 1758882842
ZONE: R&PUD
USE: BUSINESS

EROSION CONTROL LEGEND

- PROPERTY LINE
- EXISTING MAJOR CONTOUR
- EXISTING MINOR CONTOUR
- PROPOSED MAJOR CONTOUR
- PROPOSED MINOR CONTOUR
- DRAINAGE AREA
- DRAINAGE AREA LABEL
- DIRECTION OF OVERLAND FLOW
- SPOT ELEVATION
- RIP RAP APRON
- CONSTRUCTION ENTRANCE / EXIT
- EROSION CONTROL MATTING (NAG S75)
- LIMITS OF DISTURBANCE

- TEMPORARY JUTE NETTING BAFLES (700 G/M2 COIR FABRIC OR HEAVIER)
- TEMPORARY DIVERSION DITCH OR BERM
- TEMPORARY SILT FENCE
- TEMP TREE PROTECTION FENCE
- TEMP SILT / TREE PROTECTION FENCE
- TEMP CONSTRUCTION FENCE
- SILT FENCE OUTLET
- CHECK DAM
- SEDIMENTATION CHAMBER BERM
- SLOPE DRAIN WITH RIP-RAP APRON
- TEMPORARY RISER SKIMMER SEDIMENT BASIN
- STANDARD PIPE INLET PROTECTION
- STANDARD GRAVEL INLET PROTECTION
- EXCAVATED INLET SEDIMENT TRAP
- WASHOUT STATION
- FILTER BAG

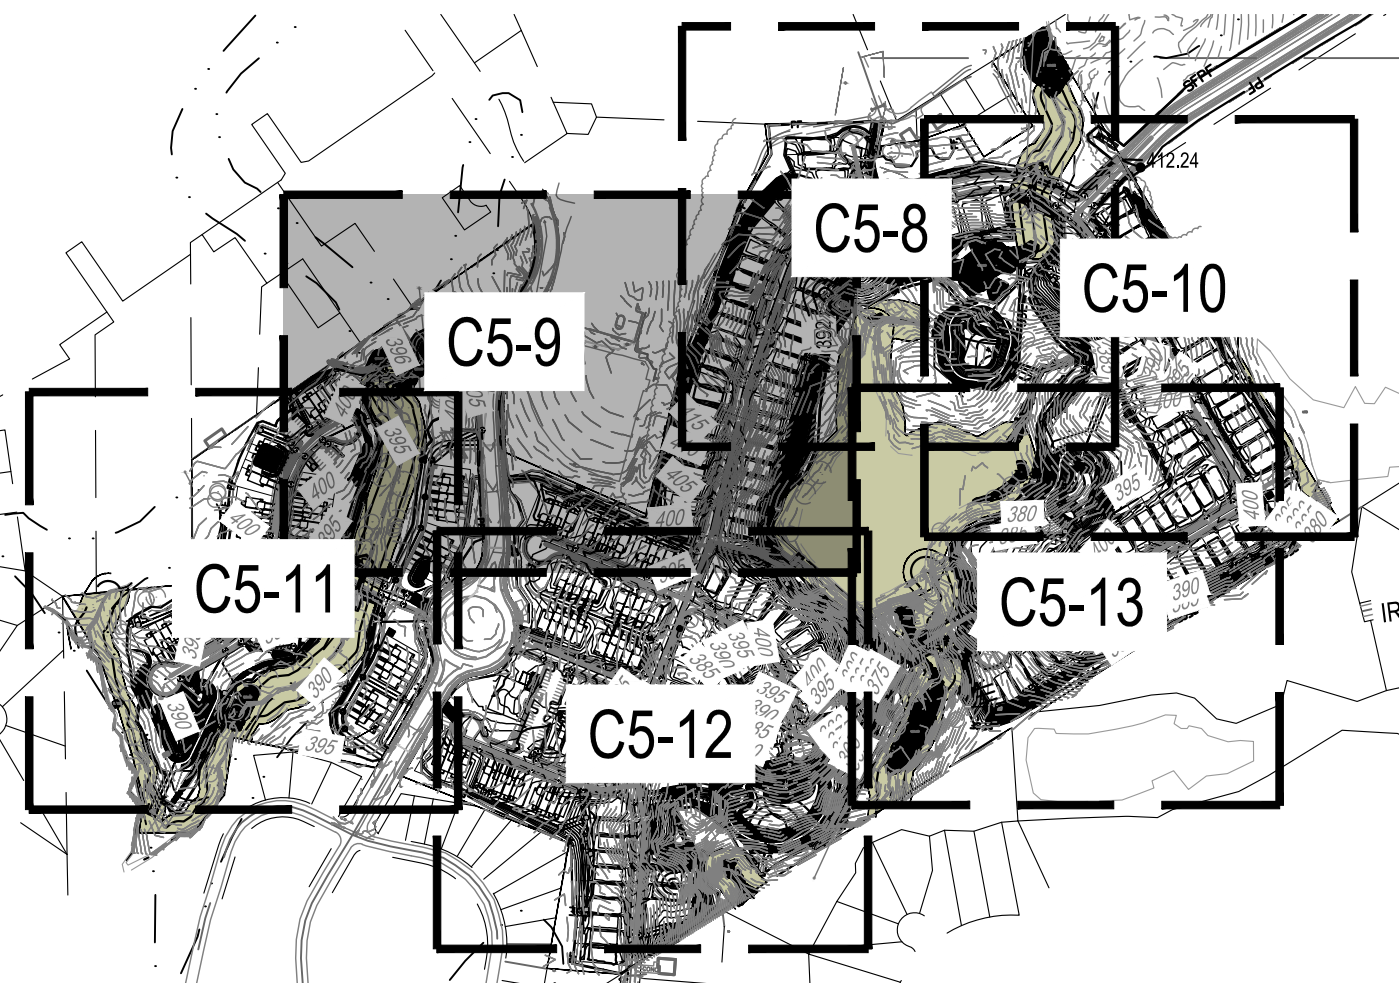

0 25' 50' 100'
SCALE: 1" = 50'



Know what's below.
Call before you dig.

DESIGNED BY: DFC/CD
DRAWN BY: DFC/JWM
REVIEWED BY: DFC

PER TOWN OF ROLESVILLE COMMENT
10/02/2023

PER TOWN OF ROLESVILLE COMMENT
08/01/2023

INITIAL SUBMITTAL
06/01/2023

REV

5440 WADE PARK BLVD, SUITE 102
RALEIGH NC 27607
WWW.BCEINC.COM
NC LICENSE #C-4397


LENARR
CORPORAION
1100 PERIMETER PARK DRIVE, SUITE 112
MORRISVILLE / NORTH CAROLINA / 27560

PARKER RIDGE
82 SCHOOL STREET
ROLESVILLE / NORTH CAROLINA / 27571

ENLARGED PHASE 2
EROSION CONTROL
PLAN (2 OF 6)

NOT FOR
CONSTRUCTION
FILE NUMBER:
8430-03
DATE: 10/02/2023

C5-9

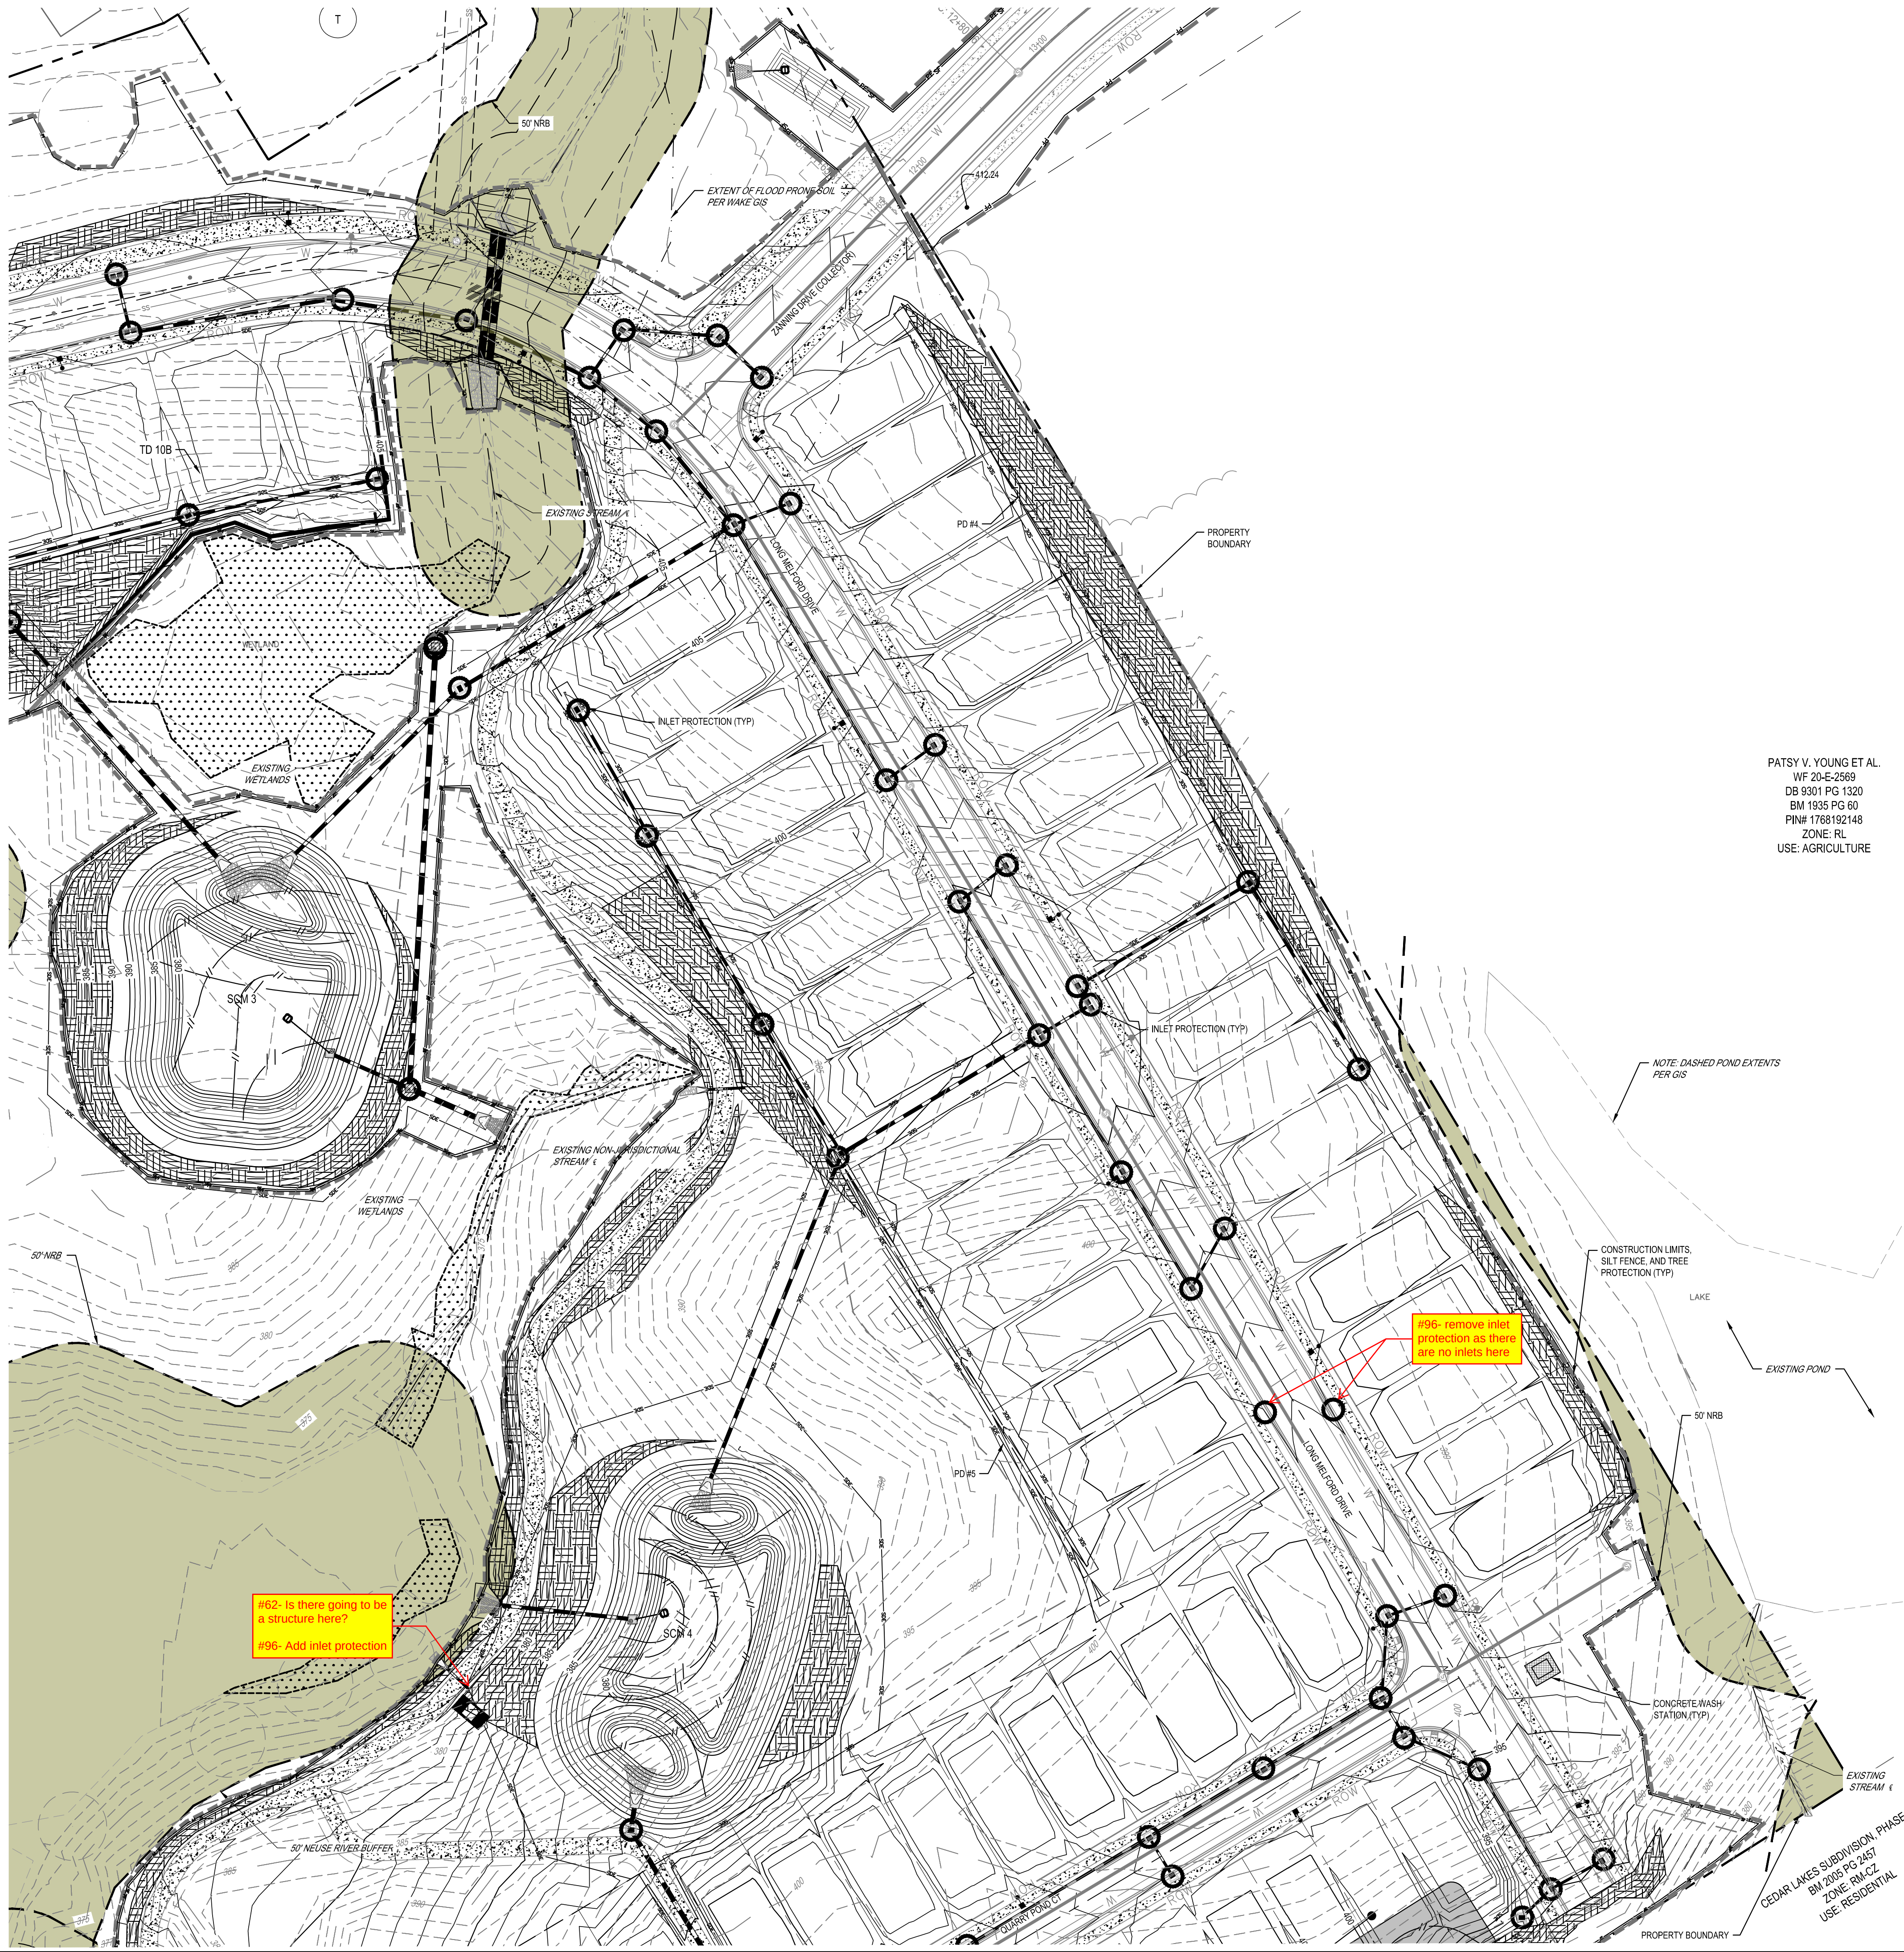

PATSY V. YOUNG ET AL.
WF 20-E-2569
DB 9301 PG 1320
BM 1935 PG 60
PIN# 1768192148
ZONE: RL
USE: AGRICULTURE

#96- remove inlet protection as there are no inlets here.

#62- Is there going to be a structure here?
#96- Add inlet protection

SECTION E: GROUND STABILIZATION		
Site Area Description	Required Ground Stabilization Timeframes	
	Stabilize within this many calendar days after ceasing land disturbance	Timeframe variations
(a) Perimeter dikes, swales, ditches, and perimeter slopes	7	None
(b) High Quality Water (HQW) Zones	7	None
(c) Slopes steeper than 3:1	7	If slopes are 10' or less in length and are not steeper than 2:1, 14 days are allowed
(d) Slopes 3:1 to 4:1	14	- 7 days for slopes greater than 50' in length and with slopes steeper than 4:1 - 7 days for perimeter dikes, swales, ditches, perimeter slopes and HQW Zones - 10 days for Falls Lake Watershed
(e) Areas with slopes flatter than 4:1	14	- 7 days for perimeter dikes, swales, ditches, perimeter slopes and HQW Zones - 10 days for Falls Lake Watershed unless there is zero slope

Note: After the permanent cessation of construction activities, any areas with temporary ground stabilization shall be converted to permanent ground stabilization as soon as practicable but in no case longer than 90 calendar days after the last land disturbing activity. Temporary ground stabilization shall be maintained in a manner to render the surface stable against accelerated erosion until permanent ground stabilization is achieved.





HATCHED SLOPES ARE 3:1 OR GREATER AND REQUIRE STABILIZATION PER TABLE AT LEFT



EROSION CONTROL LEGEND

- PROPERTY LINE
- EXISTING MAJOR CONTOUR
- EXISTING MINOR CONTOUR
- PROPOSED MAJOR CONTOUR
- PROPOSED MINOR CONTOUR
- DRAINAGE AREA
- DRAINAGE AREA LABEL
- DIRECTION OF OVERLAND FLOW
- SPOT ELEVATION
- RIP RAP APRON
- CONSTRUCTION ENTRANCE / EXIT
- EROSION CONTROL MATTING (NAG S75)
- LIMITS OF DISTURBANCE
- TEMPORARY JUTE NETTING BAFFLES (700 GM2 COIR FABRIC OR HEAVIER)
- TEMPORARY DIVERSION DITCH OR BERM
- TEMPORARY SILT FENCE
- TEMP TREE PROTECTION FENCE
- TEMP SILT / TREE PROTECTION FENCE
- TEMP CONSTRUCTION FENCE
- SILT FENCE OUTLET
- CHECK DAM
- SEDIMENTATION CHAMBER BERM
- SLOPE DRAIN WITH RIP-RAP APRON
- TEMPORARY RISER SKIMMER SEDIMENT BASIN
- STANDARD PIPE INLET PROTECTION
- STANDARD GRAVEL INLET PROTECTION
- EXCAVATED INLET SEDIMENT TRAP
- WASHOUT STATION
- FILTER BAG

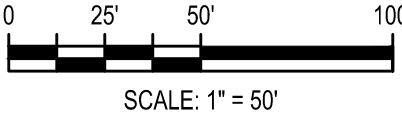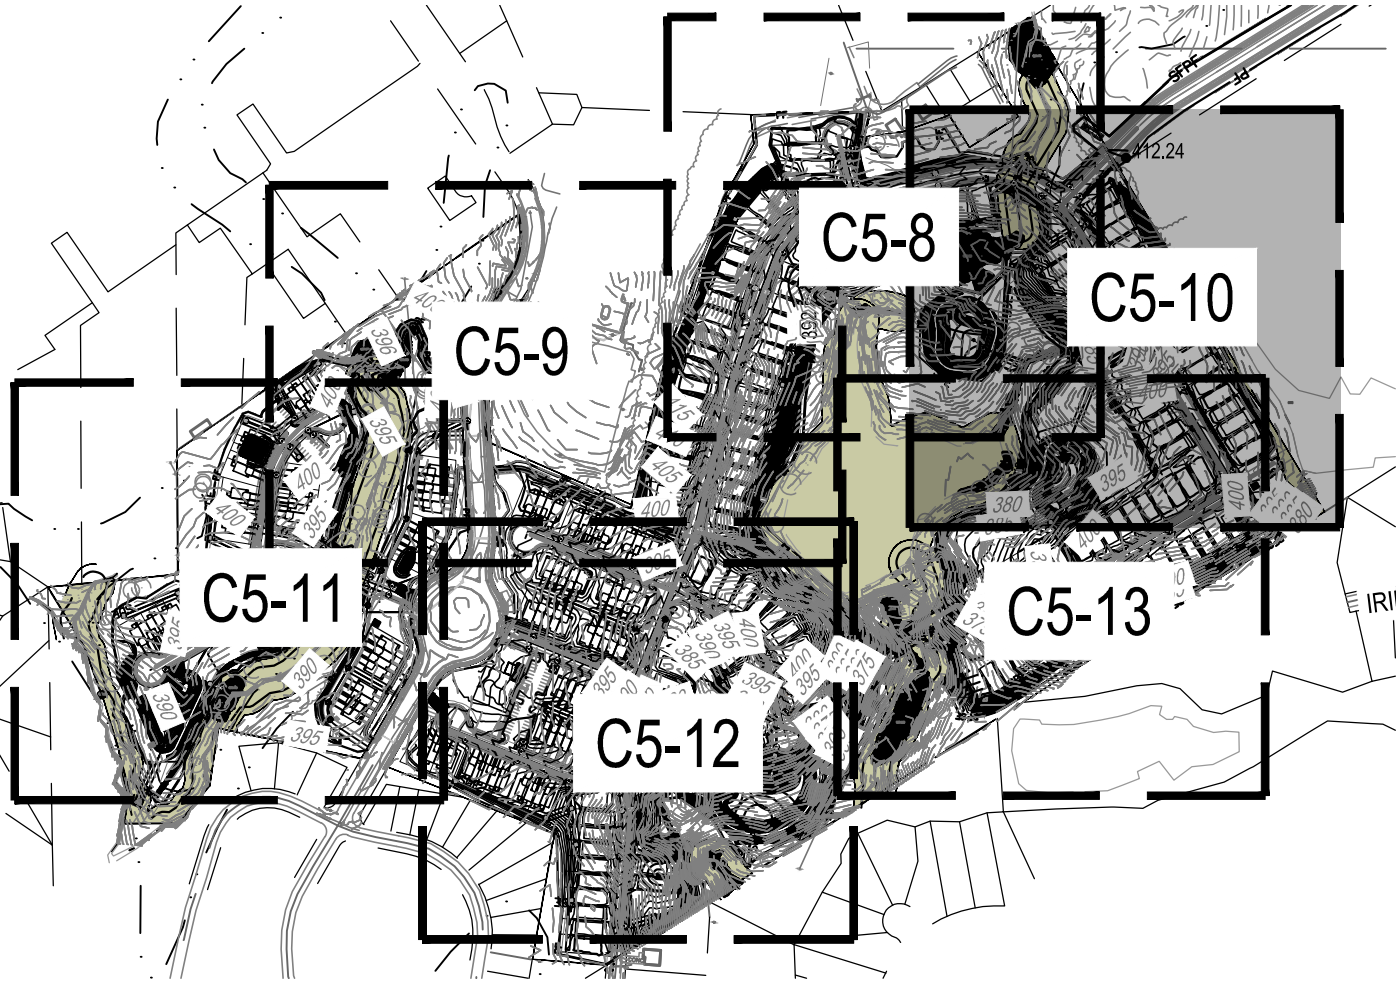

Know what's below.
Call before you dig.

DESIGNED BY: DF/CD
DRAWN BY: DF/JWM
REVIEWED BY: DF

PER TOWN OF ROLESVILLE COMMENT
10/02/2023
PER TOWN OF ROLESVILLE COMMENT
08/01/2023
INITIAL SUBMITTAL
06/01/2023
REV

BCE
5440 WADE PARK BLVD, SUITE 102
RALEIGH NC 27607
WWW.BCEINC.COM
NC LICENSE #C-4397

LENNAR
CORPORAION
1100 PERIMETER PARK DRIVE, SUITE 112
MORRISVILLE / NORTH CAROLINA / 27560

PARKER RIDGE
82 SCHOOL STREET
ROLESVILLE / NORTH CAROLINA / 27571

ENLARGED PHASE 2
EROSION CONTROL
PLAN (3 OF 6)

PRELIMINARY
ENGINEER
FEDRA M. FERNANDEZ
10-12-23
NOT FOR
CONSTRUCTION
FILE NUMBER:
8430-03
DATE: 10/02/2023
C5-10





SECTION E: GROUND STABILIZATION		
Required Ground Stabilization Timeframes		
Site Area Description	Stabilize within this many calendar days after ceasing land disturbance	Timeframe variations
(a) Perimeter dikes, swales, ditches, and perimeter slopes	7	None
(b) High Quality Water (HQP) Zones	7	None
(c) Slopes steeper than 3:1	7	If slopes are 10' or less in length and are not steeper than 2:1, 14 days are allowed. 7 days for slopes greater than 50' in length and with slopes steeper than 4:1
(d) Slopes 3:1 to 4:1	14	7 days for perimeter dikes, swales, ditches, perimeter slopes and HQW Zones 10 days for Falls Lake Watershed
(e) Areas with slopes flatter than 4:1	14	7 days for perimeter dikes, swales, ditches, perimeter slopes and HQW Zones 10 days for Falls Lake Watershed unless there is zero slope

Note: After the permanent cessation of construction activities, any areas with temporary ground stabilization shall be converted to permanent ground stabilization as soon as practicable but in no case longer than 90 calendar days after the last land disturbing activity. Temporary ground stabilization shall be maintained in a manner to render the surface stable against accelerated erosion until permanent ground stabilization is achieved.

EROSION CONTROL LEGEND

- PROPERTY LINE
- EXISTING MAJOR CONTOUR
- EXISTING MINOR CONTOUR
- PROPOSED MAJOR CONTOUR
- PROPOSED MINOR CONTOUR
- DRAINAGE AREA
- DRAINAGE AREA LABEL
- DIRECTION OF OVERLAND FLOW
- SPOT ELEVATION
- RIP RAP APRON
- CONSTRUCTION ENTRANCE / EXIT
- EROSION CONTROL MATTING (NAG S75)
- LIMITS OF DISTURBANCE
- TEMPORARY JUTE NETTING BAFFLES (700 GM2 COIR FABRIC OR HEAVIER)
- TEMPORARY DIVERSION DITCH OR BERM
- TEMPORARY SILT FENCE
- TEMP TREE PROTECTION FENCE
- TEMP SILT / TREE PROTECTION FENCE
- TEMP CONSTRUCTION FENCE
- SILT FENCE OUTLET
- CHECK DAM
- SEDIMENTATION CHAMBER BERM
- SLOPE DRAIN WITH RIP-RAP APRON
- TEMPORARY RISER SKIMMER SEDIMENT BASIN
- STANDARD PIPE INLET PROTECTION
- STANDARD GRAVEL INLET PROTECTION
- EXCAVATED INLET SEDIMENT TRAP
- WASHOUT STATION
- FILTER BAG

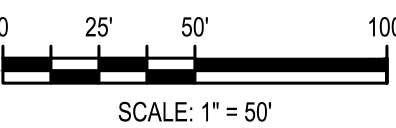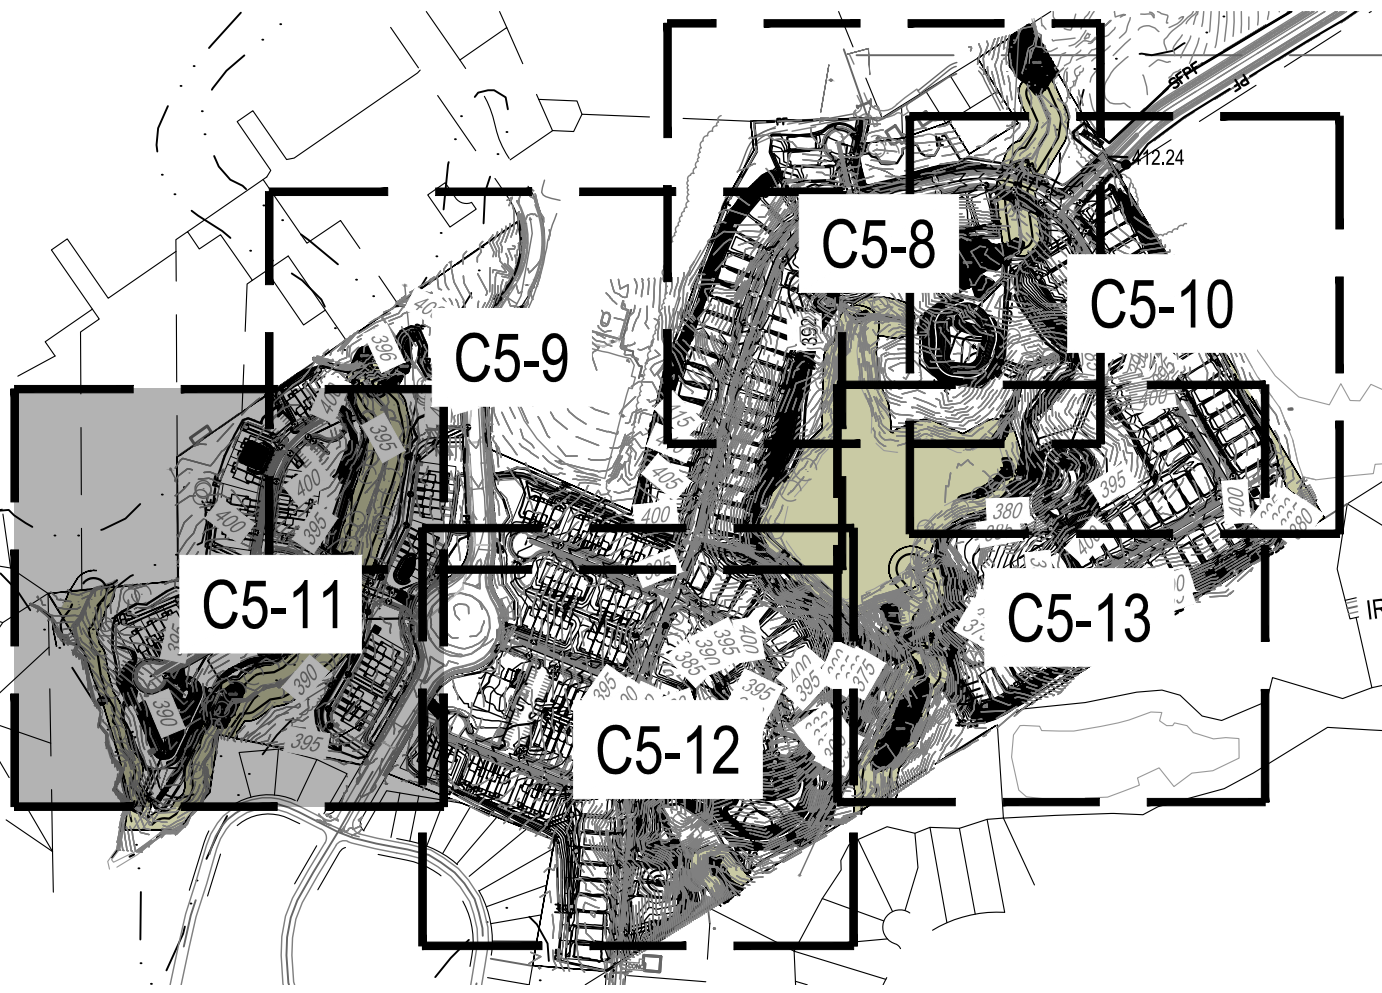

PER TOWN OF ROLESVILLE COMMENT

10/02/2023

DESIGNED BY: DF/CD

PER TOWN OF ROLESVILLE COMMENT

08/01/2023

DRAWN BY: DF/JWM

INITIAL SUBMITTAL

06/01/2023

REVIEWED BY: DF

REVISIONS

REV

06/01/2023

INITIAL SUBMITTAL

LENARR CORPORAION

1100 PERIMETER PARK DRIVE, SUITE 112

MORRISVILLE / NORTH CAROLINA / 27560

PARKER RIDGE

82 SCHOOL STREET

ROLESVILLE / NORTH CAROLINA / 27571

ENLARGED PHASE 2

EROSION CONTROL

PLAN (4 OF 6)


PRELIMINARY

NOT FOR CONSTRUCTION

FILE NUMBER: 8430-03


DATE: 10/02/2023

C5-11

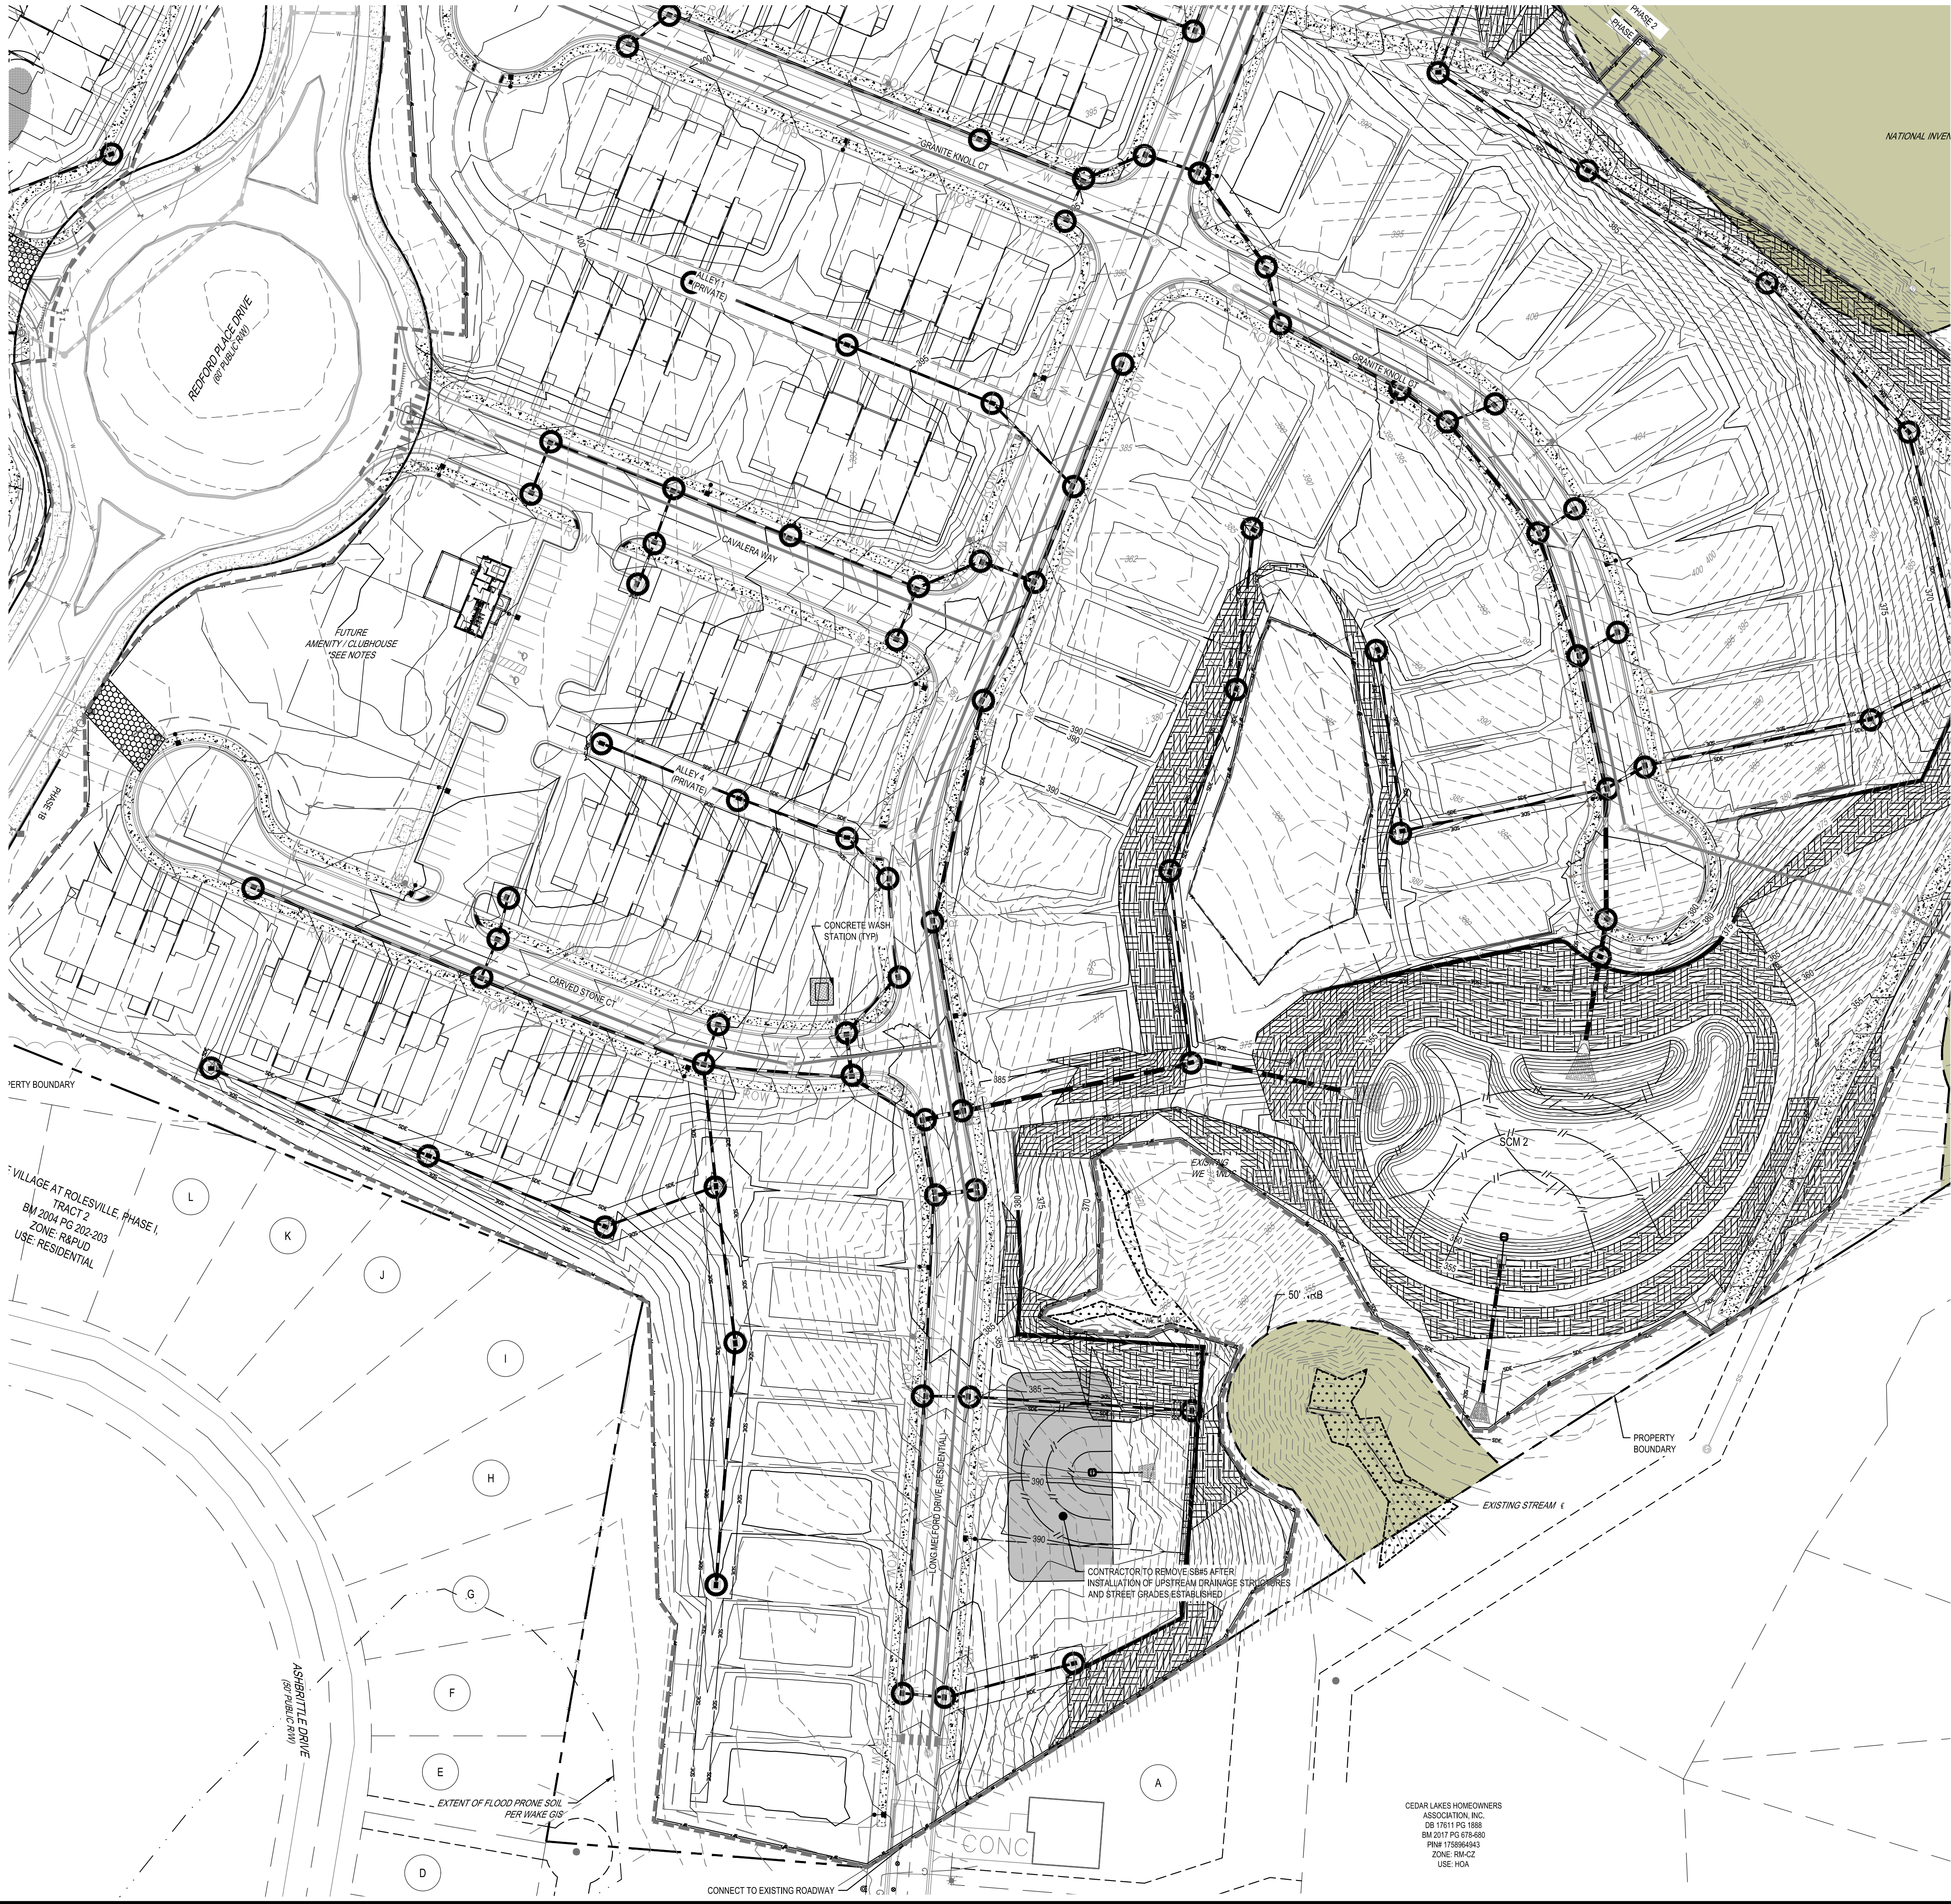

SECTION E: GROUND STABILIZATION		
Site Area Description	Required Ground Stabilization Timeframes	
	Stabilize within this many calendar days after ceasing land disturbance	Timeframe variations
(a) Perimeter dikes, swales, ditches, and perimeter slopes	7	None
(b) High Quality Water (H2W) Zones	7	None
(c) Slopes steeper than 3:1	7	If slopes are 10' or less in length and are not steeper than 2:1, 14 days are allowed -7 days for slopes greater than 50' in length and with slopes steeper than 4:1
(d) Slopes 3:1 to 4:1	14	-7 days for perimeter dikes, swales, ditches, perimeter slopes and H2W Zones -10 days for Falls Lake Watershed
(e) Areas with slopes flatter than 4:1	14	-7 days for perimeter dikes, swales, ditches, perimeter slopes and H2W Zones -10 days for Falls Lake Watershed unless there is zero slope


Note: After the permanent cessation of construction activities, any areas with temporary ground stabilization shall be converted to permanent ground stabilization as soon as practicable but in no case longer than 90 calendar days after the last land disturbing activity. Temporary ground stabilization shall be maintained in a manner to render the surface stable against accelerated erosion until permanent ground stabilization is achieved.

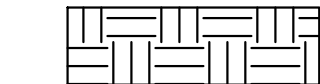

HATCHED SLOPES ARE 3:1 OR GREATER AND REQUIRE STABILIZATION PER TABLE AT LEFT

EROSION CONTROL LEGEND

- PROPERTY LINE
- EXISTING MAJOR CONTOUR
- EXISTING MINOR CONTOUR
- PROPOSED MAJOR CONTOUR
- PROPOSED MINOR CONTOUR
- DRAINAGE AREA
- DRAINAGE AREA LABEL
- DIRECTION OF OVERLAND FLOW
- SPOT ELEVATION
- RIP RAP APRON
- CONSTRUCTION ENTRANCE / EXIT
- EROSION CONTROL MATTING (NAG S75)
- LIMITS OF DISTURBANCE
- TEMPORARY JUTE NETTING BAFFLES (700 GM2 COIR FABRIC OR HEAVIER)
- TEMPORARY DIVERSION DITCH OR BERM
- TEMPORARY SILT FENCE
- TEMP TREE PROTECTION FENCE
- TEMP SILT / TREE PROTECTION FENCE
- TEMP CONSTRUCTION FENCE
- SILT FENCE OUTLET
- CHECK DAM
- SEDIMENTATION CHAMBER BERM
- SLOPE DRAIN WITH RIP-RAP APRON
- TEMPORARY RISER SKIMMER SEDIMENT BASIN
- STANDARD PIPE INLET PROTECTION
- STANDARD GRAVEL INLET PROTECTION
- EXCAVATED INLET SEDIMENT TRAP
- WASHOUT STATION
- FILTER BAG

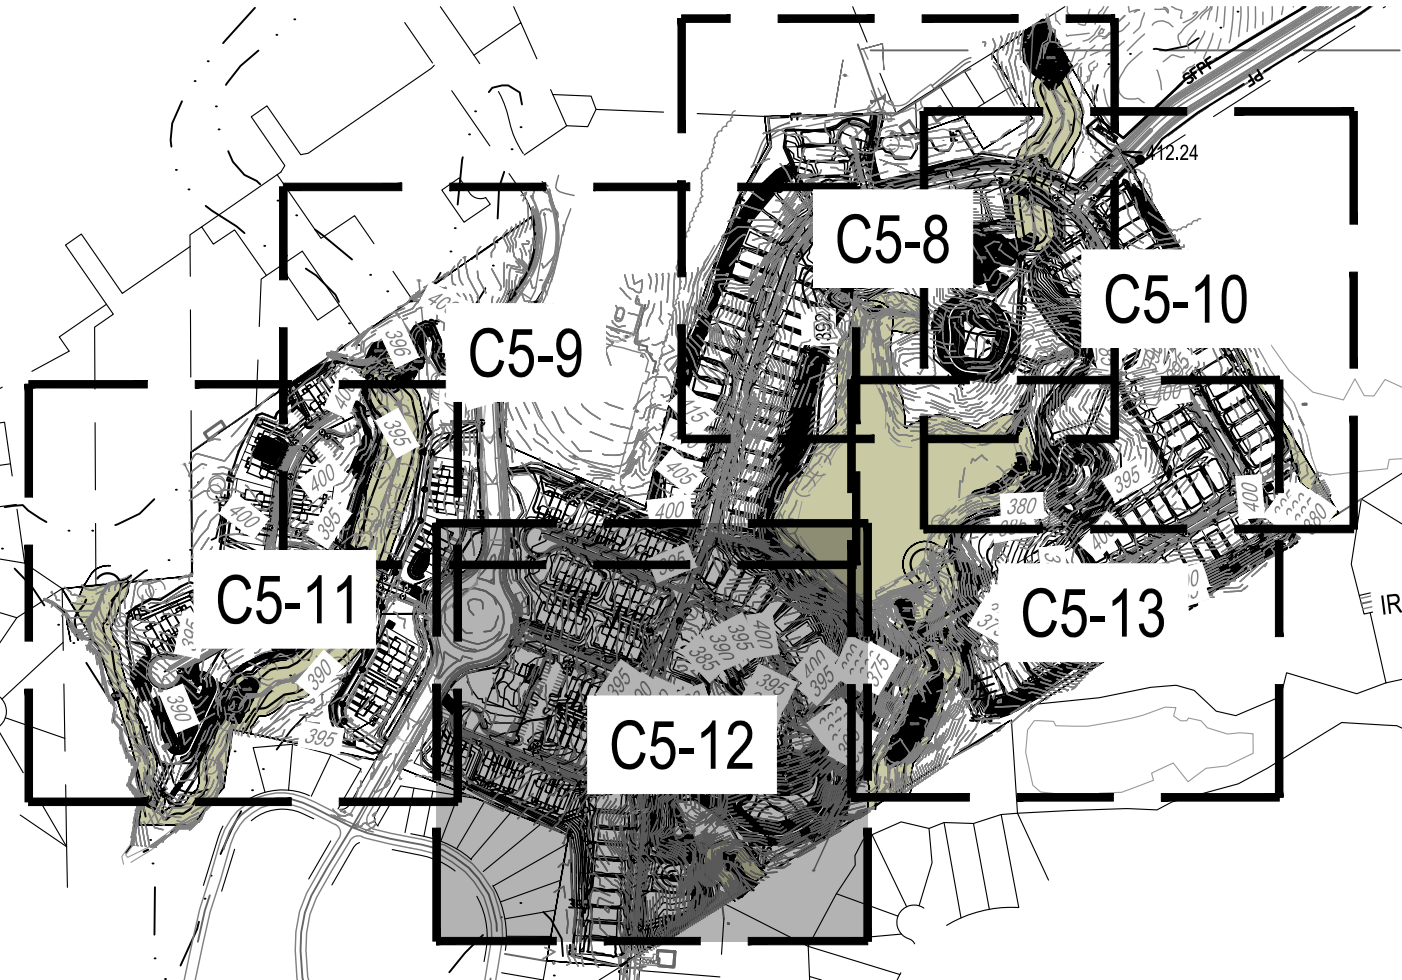

0 25' 50' 100'
SCALE: 1" = 50'



Know what's below.
Call before you dig.

DESIGNED BY: DF/CD
DRAWN BY: DF/JWM
REVIEWED BY: DF

PER TOWN OF ROLESVILLE COMMENT
10/02/2023
PER TOWN OF ROLESVILLE COMMENT
08/01/2023
INITIAL SUBMITTAL
06/01/2023
REV

LENNA
CORPORAION
1100 PERIMETER PARK DRIVE, SUITE 112
MORRISVILLE / NORTH CAROLINA / 27560

PARKER RIDGE
82 SCHOOL STREET
ROLESVILLE / NORTH CAROLINA / 27571

ENLARGED PHASE 2
EROSION CONTROL
PLAN (5 OF 6)

PRELIMINARY
ENGINEER
10-12-23
NOT FOR
CONSTRUCTION
FILE NUMBER:
8430-03
DATE: 10/02/2023
C5-12

