

ROLESVILLE - MITCHELL MILL - ELLIS


MAJOR SUBDIVISION - SKETCH PLAN

PROJECT NUMBER: MA 22-01




SITE INFORMATION:	
LOCATION:	0 - 5326 MITCHELL MILL RD
COUNTY:	WAKE
PARENT PIN:	1757758529, 1757761273, 1757778982, 1757750520
DB/PG:	001318 / 000333
CURRENT ZONING:	R-30 (WAKE COUNTY)
PROPOSED ZONING:	NEIGHBORHOOD CENTER MIXED USE (NC)
ACREAGE:	115.94 AC
LAND CLASS:	RESIDENTIAL
RESIDENTIAL AREA:	2,466,559 SF (56.62 AC = 50% OF TOTAL SITE)
NON-RESIDENTIAL OPEN SPACE:	2,464,828 SF (56.58 AC = 50% OF TOTAL SITE)
LOT ACREAGE:	
TOTAL NUMBER PROPOSED LOTS:	318
NUMBER OF TOWNHOMES:	107
NUMBER OF SINGLE FAMILY:	211
PROPOSED DENSITY:	2.74 DU/AC
MINIMUM ALLOWED LOT SIZE:	2,000 SF
MINIMUM PROPOSED LOT SIZE:	2,000 SF
MAXIMUM PROPOSED LOT SIZE:	17,926 SF (LOT 3)
AVERAGE PROPOSED LOT SIZE:	5,647 SF
MINIMUM ALLOWABLE LOT WIDTH:	20'
MINIMUM PROPOSED LOT WIDTH:	20'

SITE DATA TABLE	
LOT TYPES:	
SINGLE FAMILY LOT SIZE	6,000 SF
REQUIRED SINGLE FAMILY LOT WIDTH:	50'
PROPOSED SINGLE FAMILY LOT WIDTH:	50'
REQUIRED TOWNHOME LOT WIDTH:	20'
PROPOSED TOWNHOME LOT WIDTH:	20'
RESIDENTIAL PARKING TOTALS	102 SPACES
REQUIRED SETBACKS:	PROPOSED SETBACKS:
FRONT: 20'	FRONT: 15'
SIDE: 10'	SIDE: 10'
CORNER: 15'	CORNER: 15'
REAR: 10'	REAR: 10'
BUFFER REQUIREMENTS:	25'
ROAD WIDENING	ADDITIONAL 25' OF ROW DEDICATION
OPEN SPACE AREA REQUIRED	15% TOTAL AREA
CIVIL ENGINEERING:	STRONG ROCK ENGINEERING GROUP, PLLC PO BOX 55992 RALEIGH, NC 27624 COMPANY LICENSE #: P-2166 CONTACT: JOSH LAMBERT, PE 984.200.1932 (O) JOSH@STRONGROCKGROUP.COM
OWNER INFORMATION:	ALAN AND RANDY WATKINS, 3609 ROCK FARM RD, WAKE FOREST, NC 27587, 981-481-3000 LAURA AND RANDALL WATKINS, 3544 DONLIN DR., WAKE FOREST, NC 27587, 981-481-3000 MITCHELL MILL ROAD INVESTORS, LLC, 105 WESTON ESTATES WAY, CARY, NC 27513, 919-389-2372 STEPHEN ELLIS
UTILITY PROVIDERS	CITY OF RALEIGH WILL PROVIDE

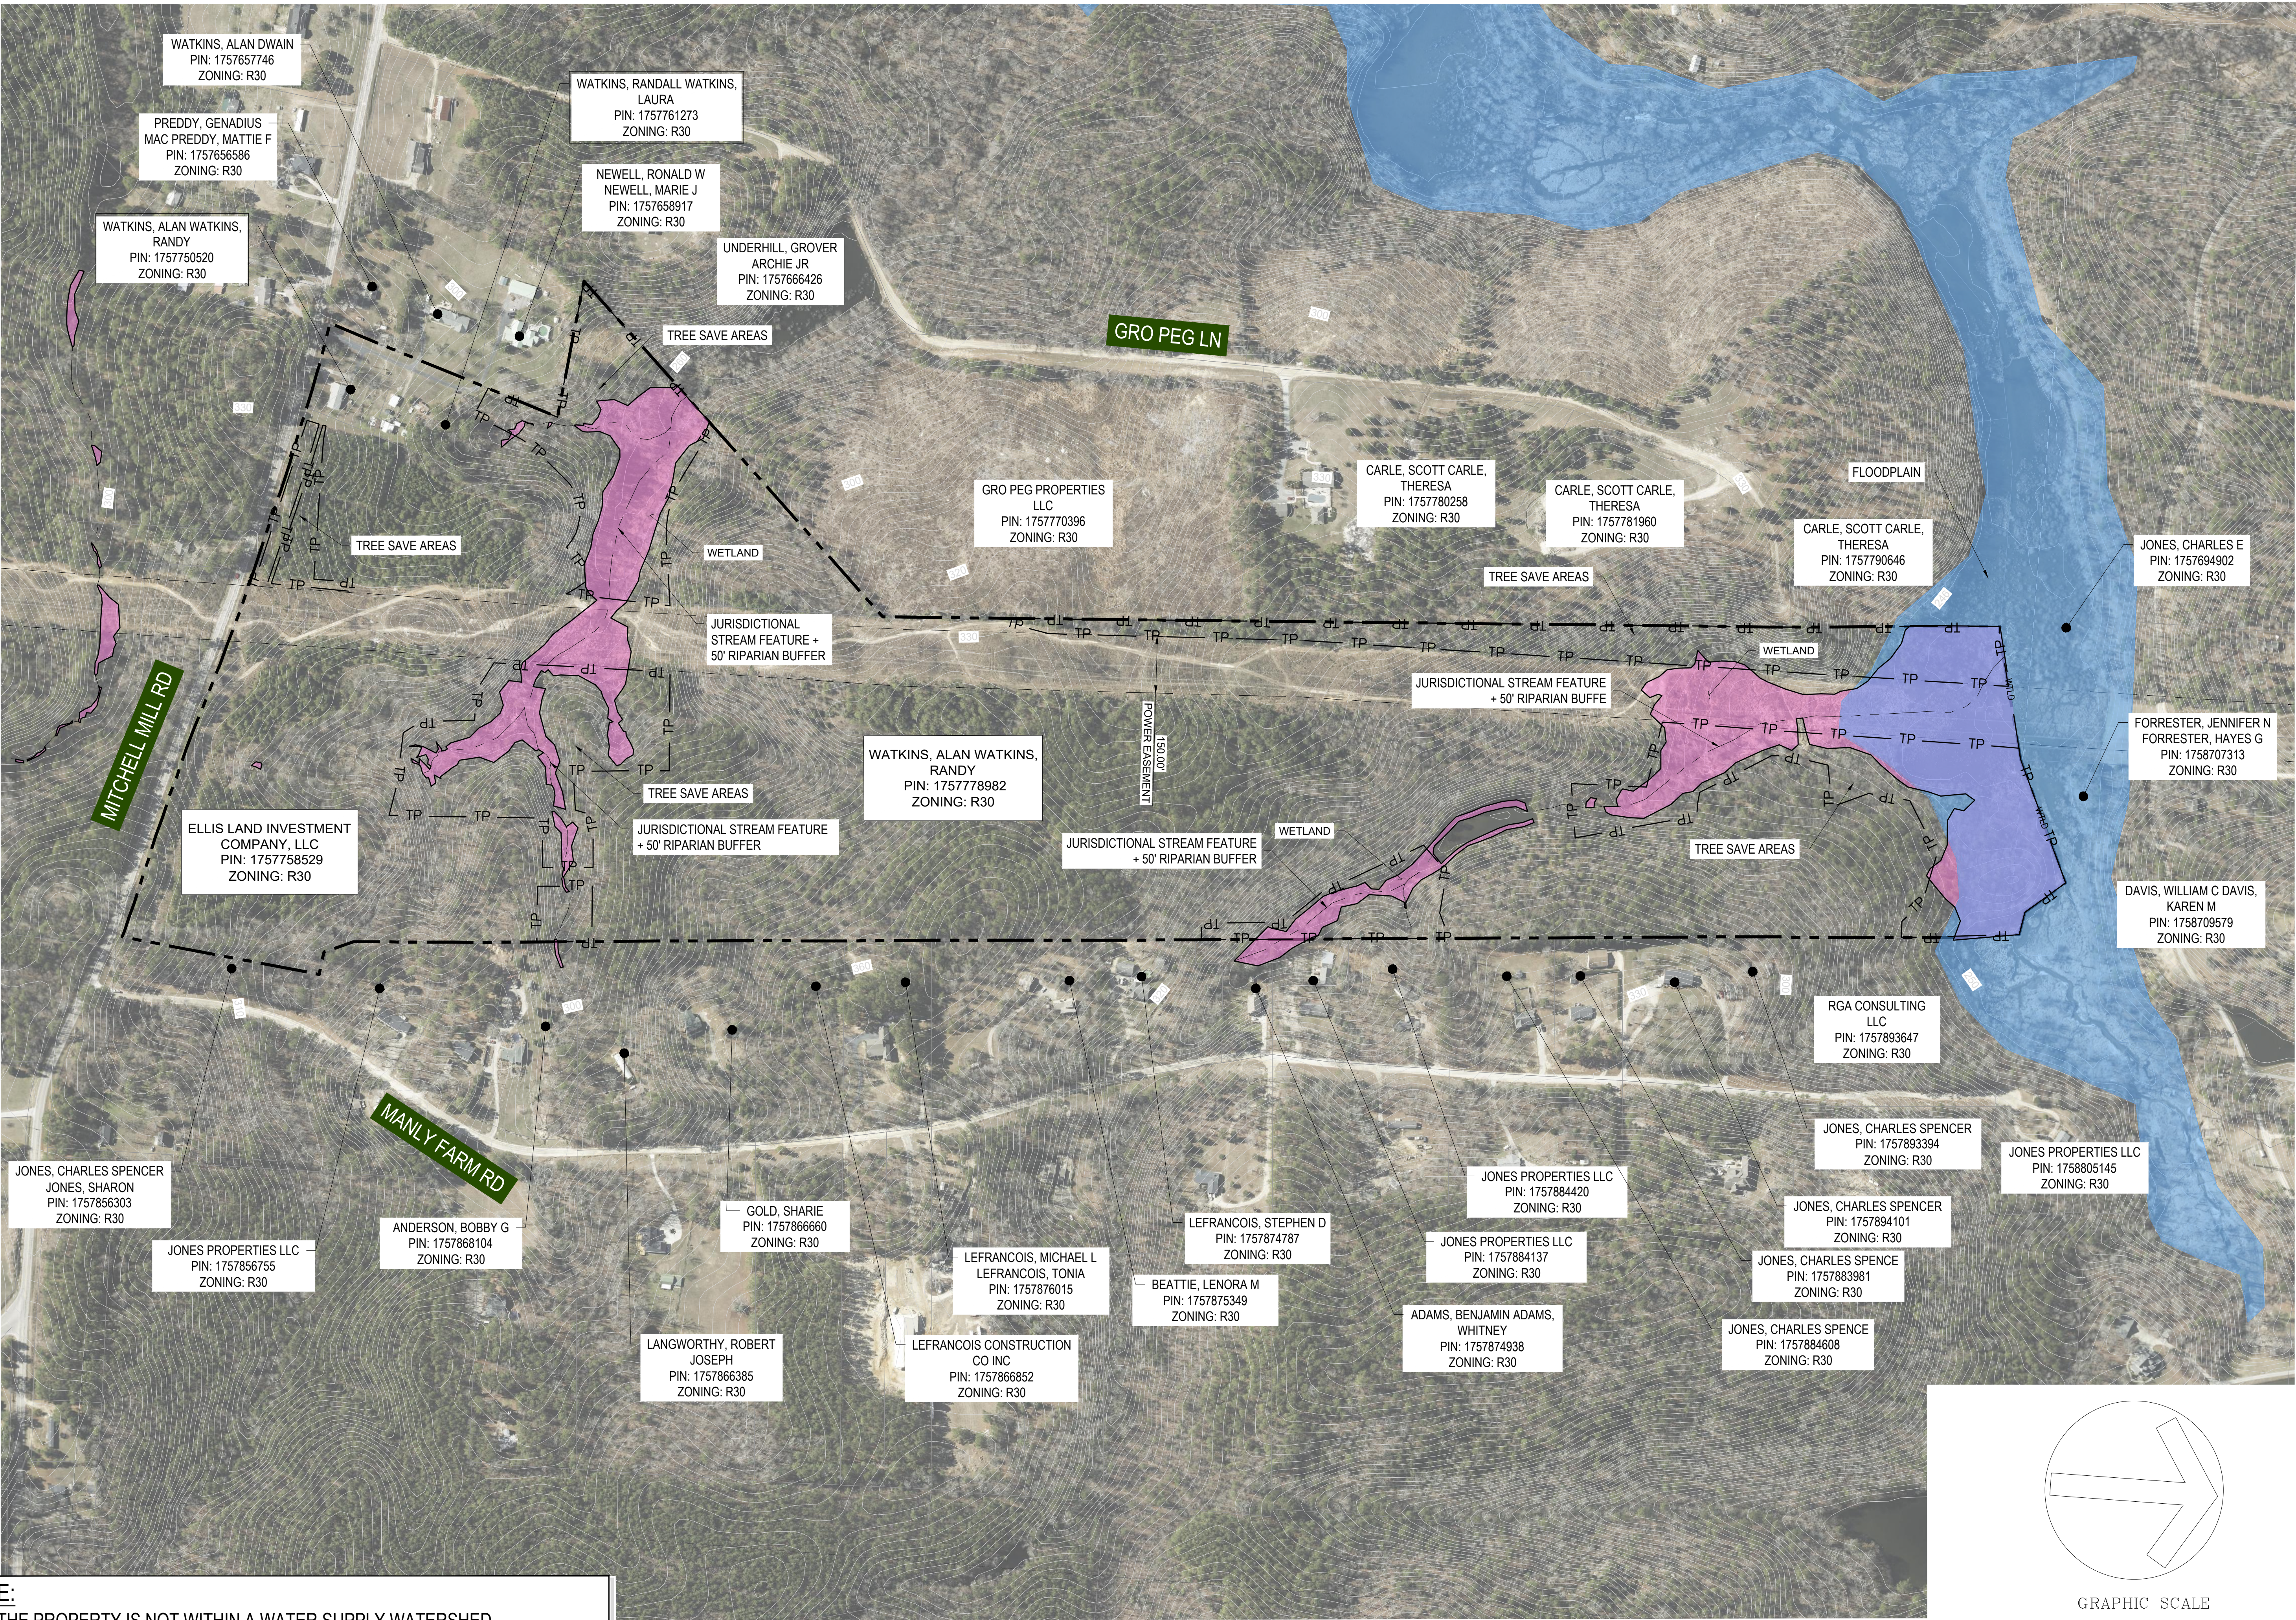

NOTE:

1. THE PROPERTY IS NOT WITHIN A WATER SUPPLY WATERSHED.
2. WETLANDS HAVE BEEN FIELD LOCATED.

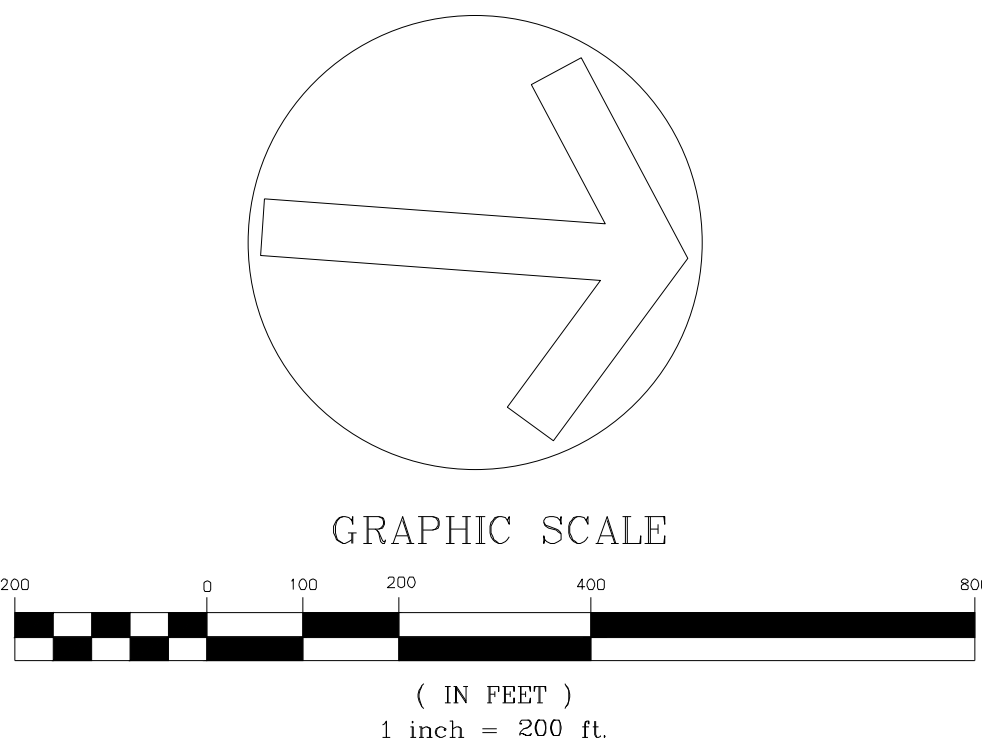



STRONG ROCK PROJECT
DATE
SCALE AS SHOWN
DESIGNED BY JWIL
DRAWN BY JWIL
CHECKED BY JWIL

ELLIS - ROLESVILLE - MITCHELL - MILL
TOWN OF ROLESVILLE, WAKE COUNTY, NORTH CAROLINA

DRAWING
SHEET

03 OF 06

LEGEND:


- OPEN SPACE
- POND
- ROAD

PRELIMINARY SKETCH "D"

UNIT TYPE	LOT SIZE	UNIT COUNT	PERCENTAGE
TOWNHOMES	20' x 100' LOTS	107 UNITS	(34%)
SINGLE FAMILY	50' x 120' LOTS	211 UNITS	(66%)
TOTAL		318 UNITS	

GRAPHIC SCALE


(IN FEET)
1 inch = 200 ft.

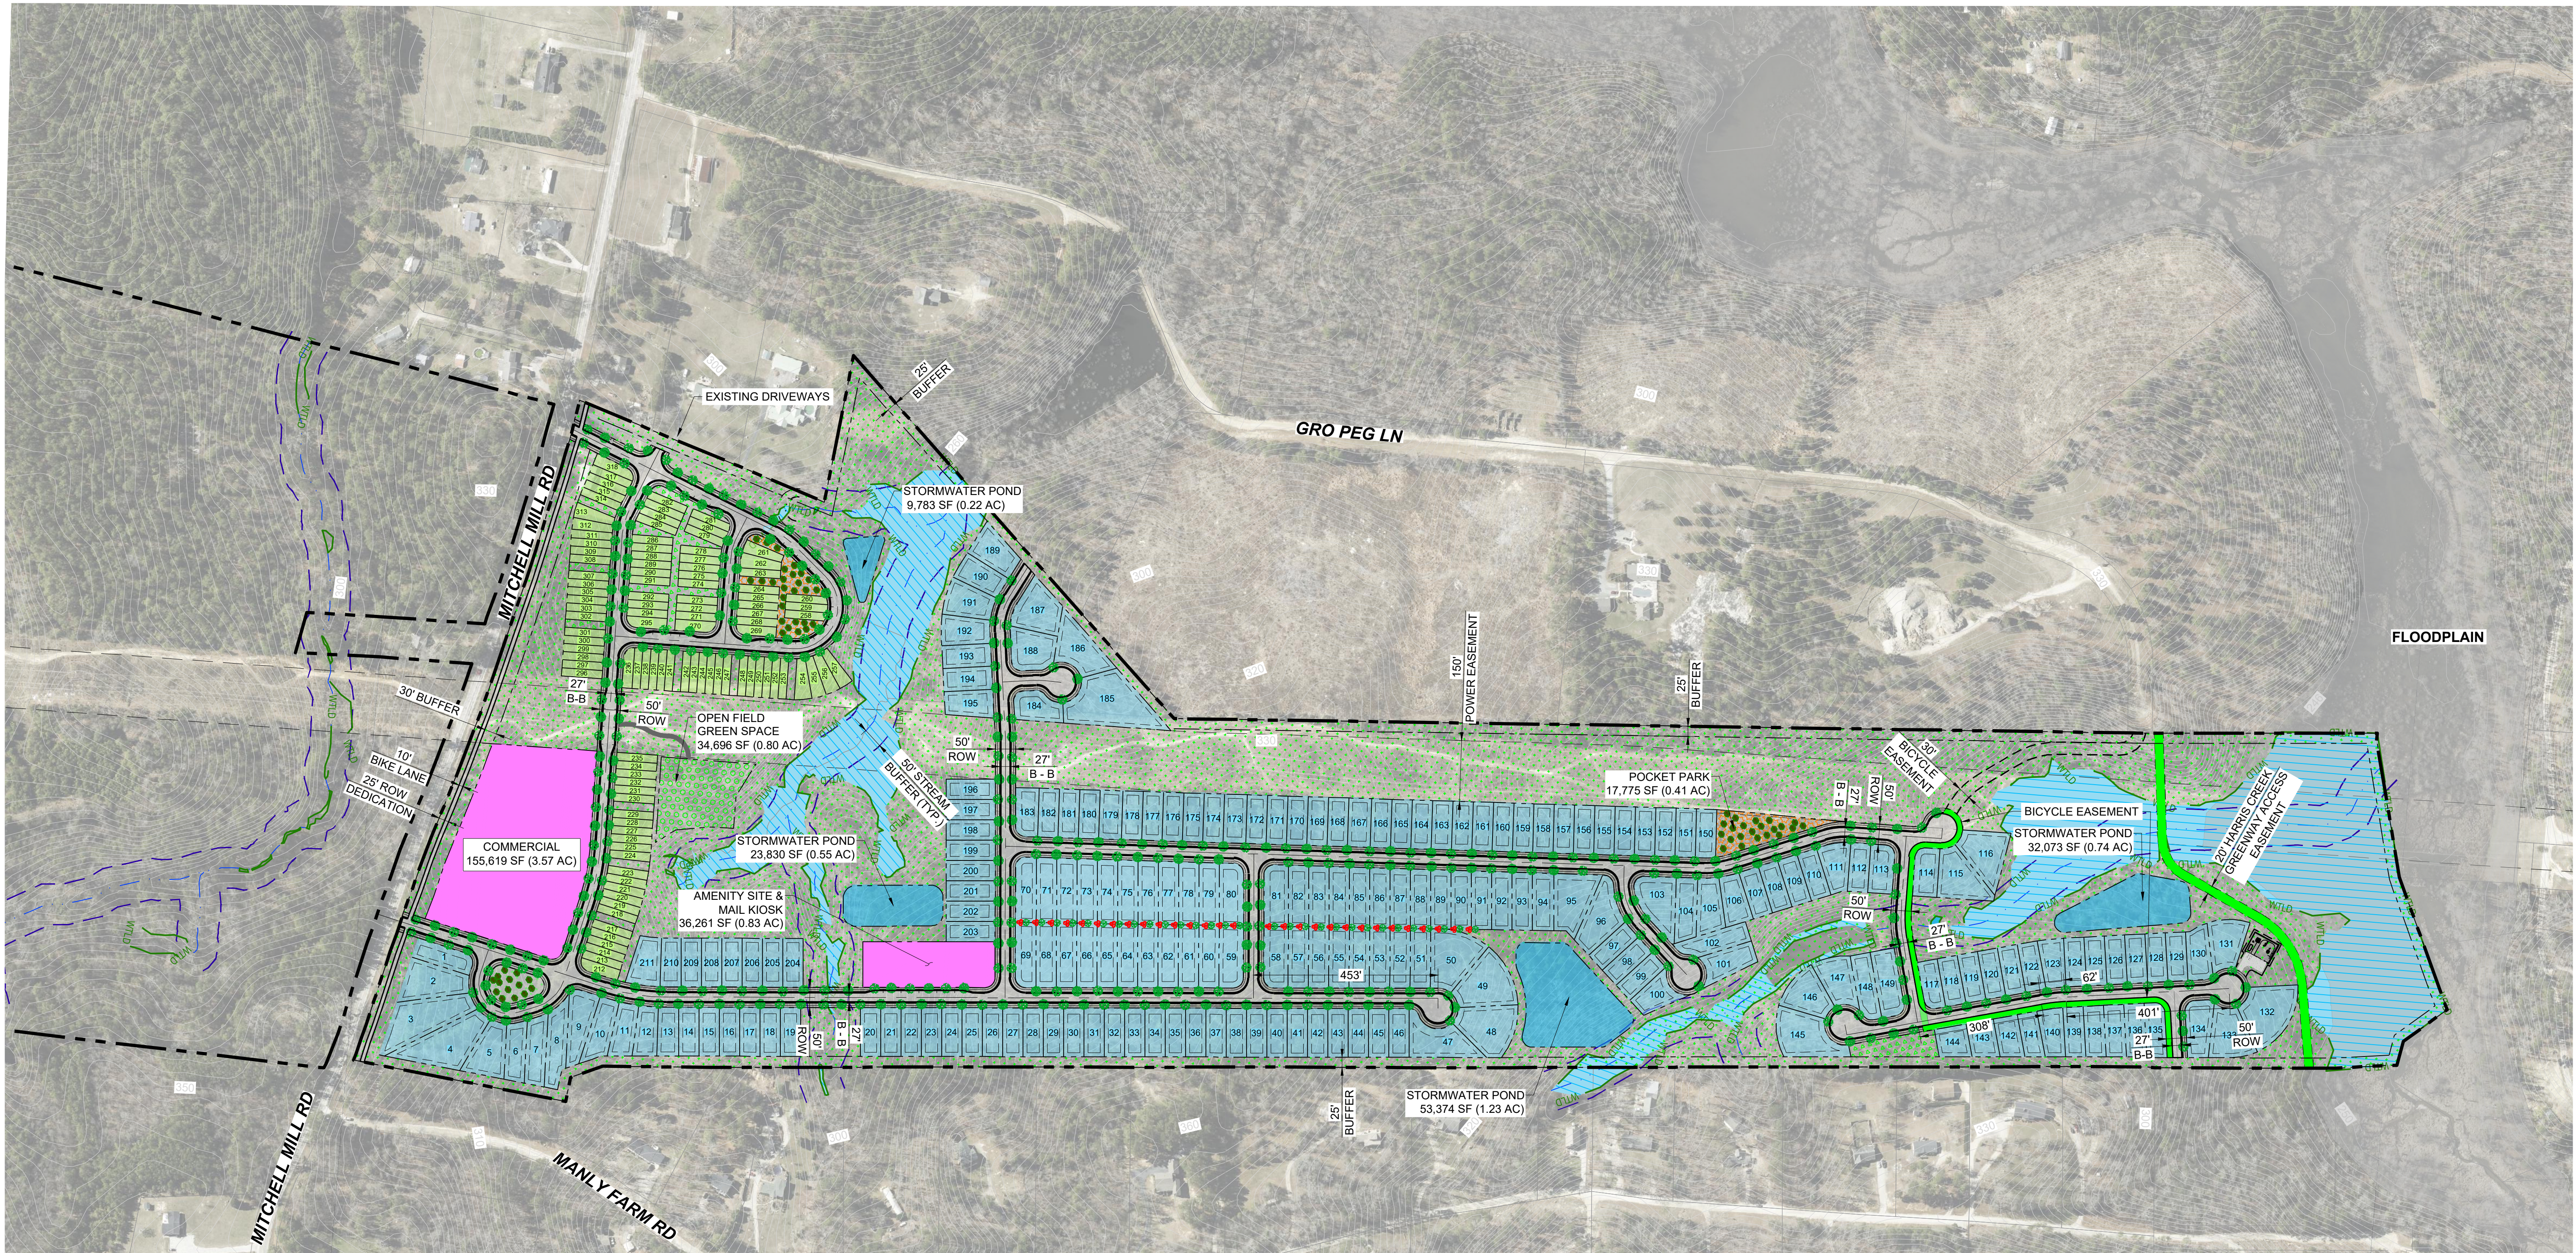

LEGEND:

- ULMUS PARVIFOLIA (UP)
- ACER SACCHARUM (AS)
- ILEX GLABRA (IG)
- ILEX X 'NELLIE R STEVENS (IN)
- QUERCUS NUTTALLII

STREET TREE TABLE:							
KEY	QTY	BOTANICAL NAME	COMMON NAME	MIN. INSTALLED SIZE	ROOT	TYPE	REMARKS
UP	200	ULMUS PARVIFOLIA	LACEBARK ELM	2.5" CAL, 12' MIN.	B&B	STREET TREES	SINGLE STRAIGHT LEADER. FULL & HEAVY.
AS	203	ACER SACCHARUM	SUGAR MAPLE	2.5" CAL, 12' MIN.	B&B	STREET TREES	SINGLE STRAIGHT LEADER. FULL & HEAVY.
UNDERSTORY TREES							
	63	QUERCUS NUTTALLII	NUTTALL OAK	2.5" CAL., 10' HT MIN.	B&B	STREET TREES	
SHURBS							
IG	87	ILEX GLABRA	INKBERRY HOLLY	24" HT	5 GAL.	PERIMETER BUFFER	FULL & HEAVY. HEIGHT: 4' AFTER 2 YEARS.
IN	29	ILEX X' NELLIE R STEVENS	NELLIE STEVENS HOLLY	24" HT	5 GAL.	PERIMETER BUFFER	FULL & HEAVY. HEIGHT: 4' AFTER 2 YEARS.

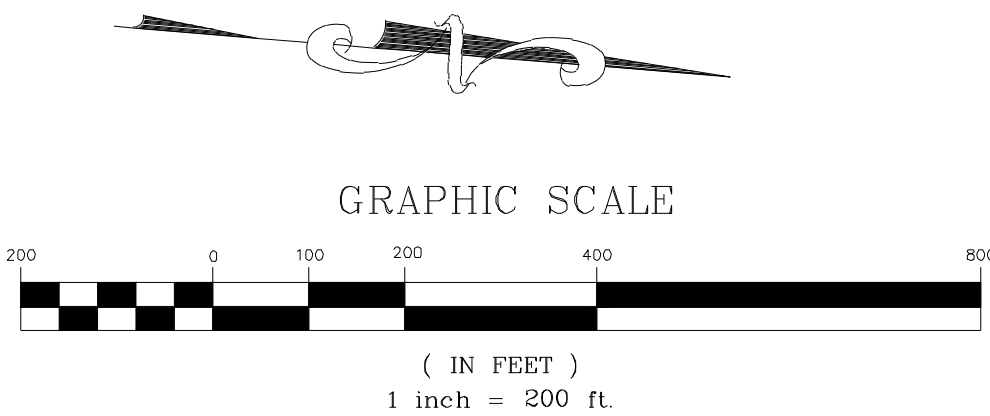

SEAL:
NORTH CAROLINA
PROFESSIONAL
ENGINEER
036225
JOSHUA W. LAMBERT

STRONGROCK

ENGINEERING GROUP

STRONG ROCK ENGINEERING GROUP, PLLC / COMPANY LICENSE # P-2166
6801 FALLS OF NEUSE RD. SUITE 108 RALEIGH, NC 27615 | JOSH@STRONGROCKENGINEERING.COM

STRONG ROCK PROJECT

DATE

SCALE AS SHOWN

DESIGNED BY JWL

DRAWN BY JWL

CHECKED BY JWL

ELLIS - ROLESVILLE - MITCHELL - MILL
TOWN OF ROLESVILLE, WAKE COUNTY, NORTH CAROLINA

SKETCH PLAN
LANDSCAPE PLAN

DRAWING SHEET

C-4.0




04 OF 06

REVISIONS

DATE

BY

LEGEND:

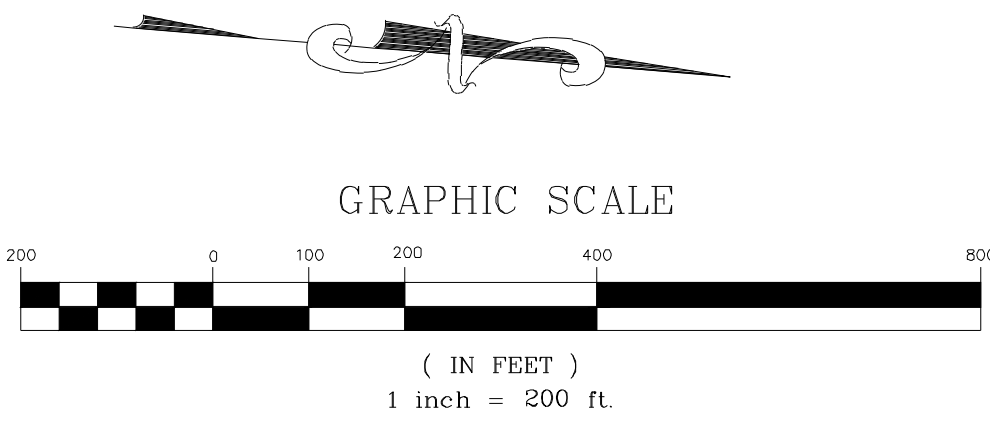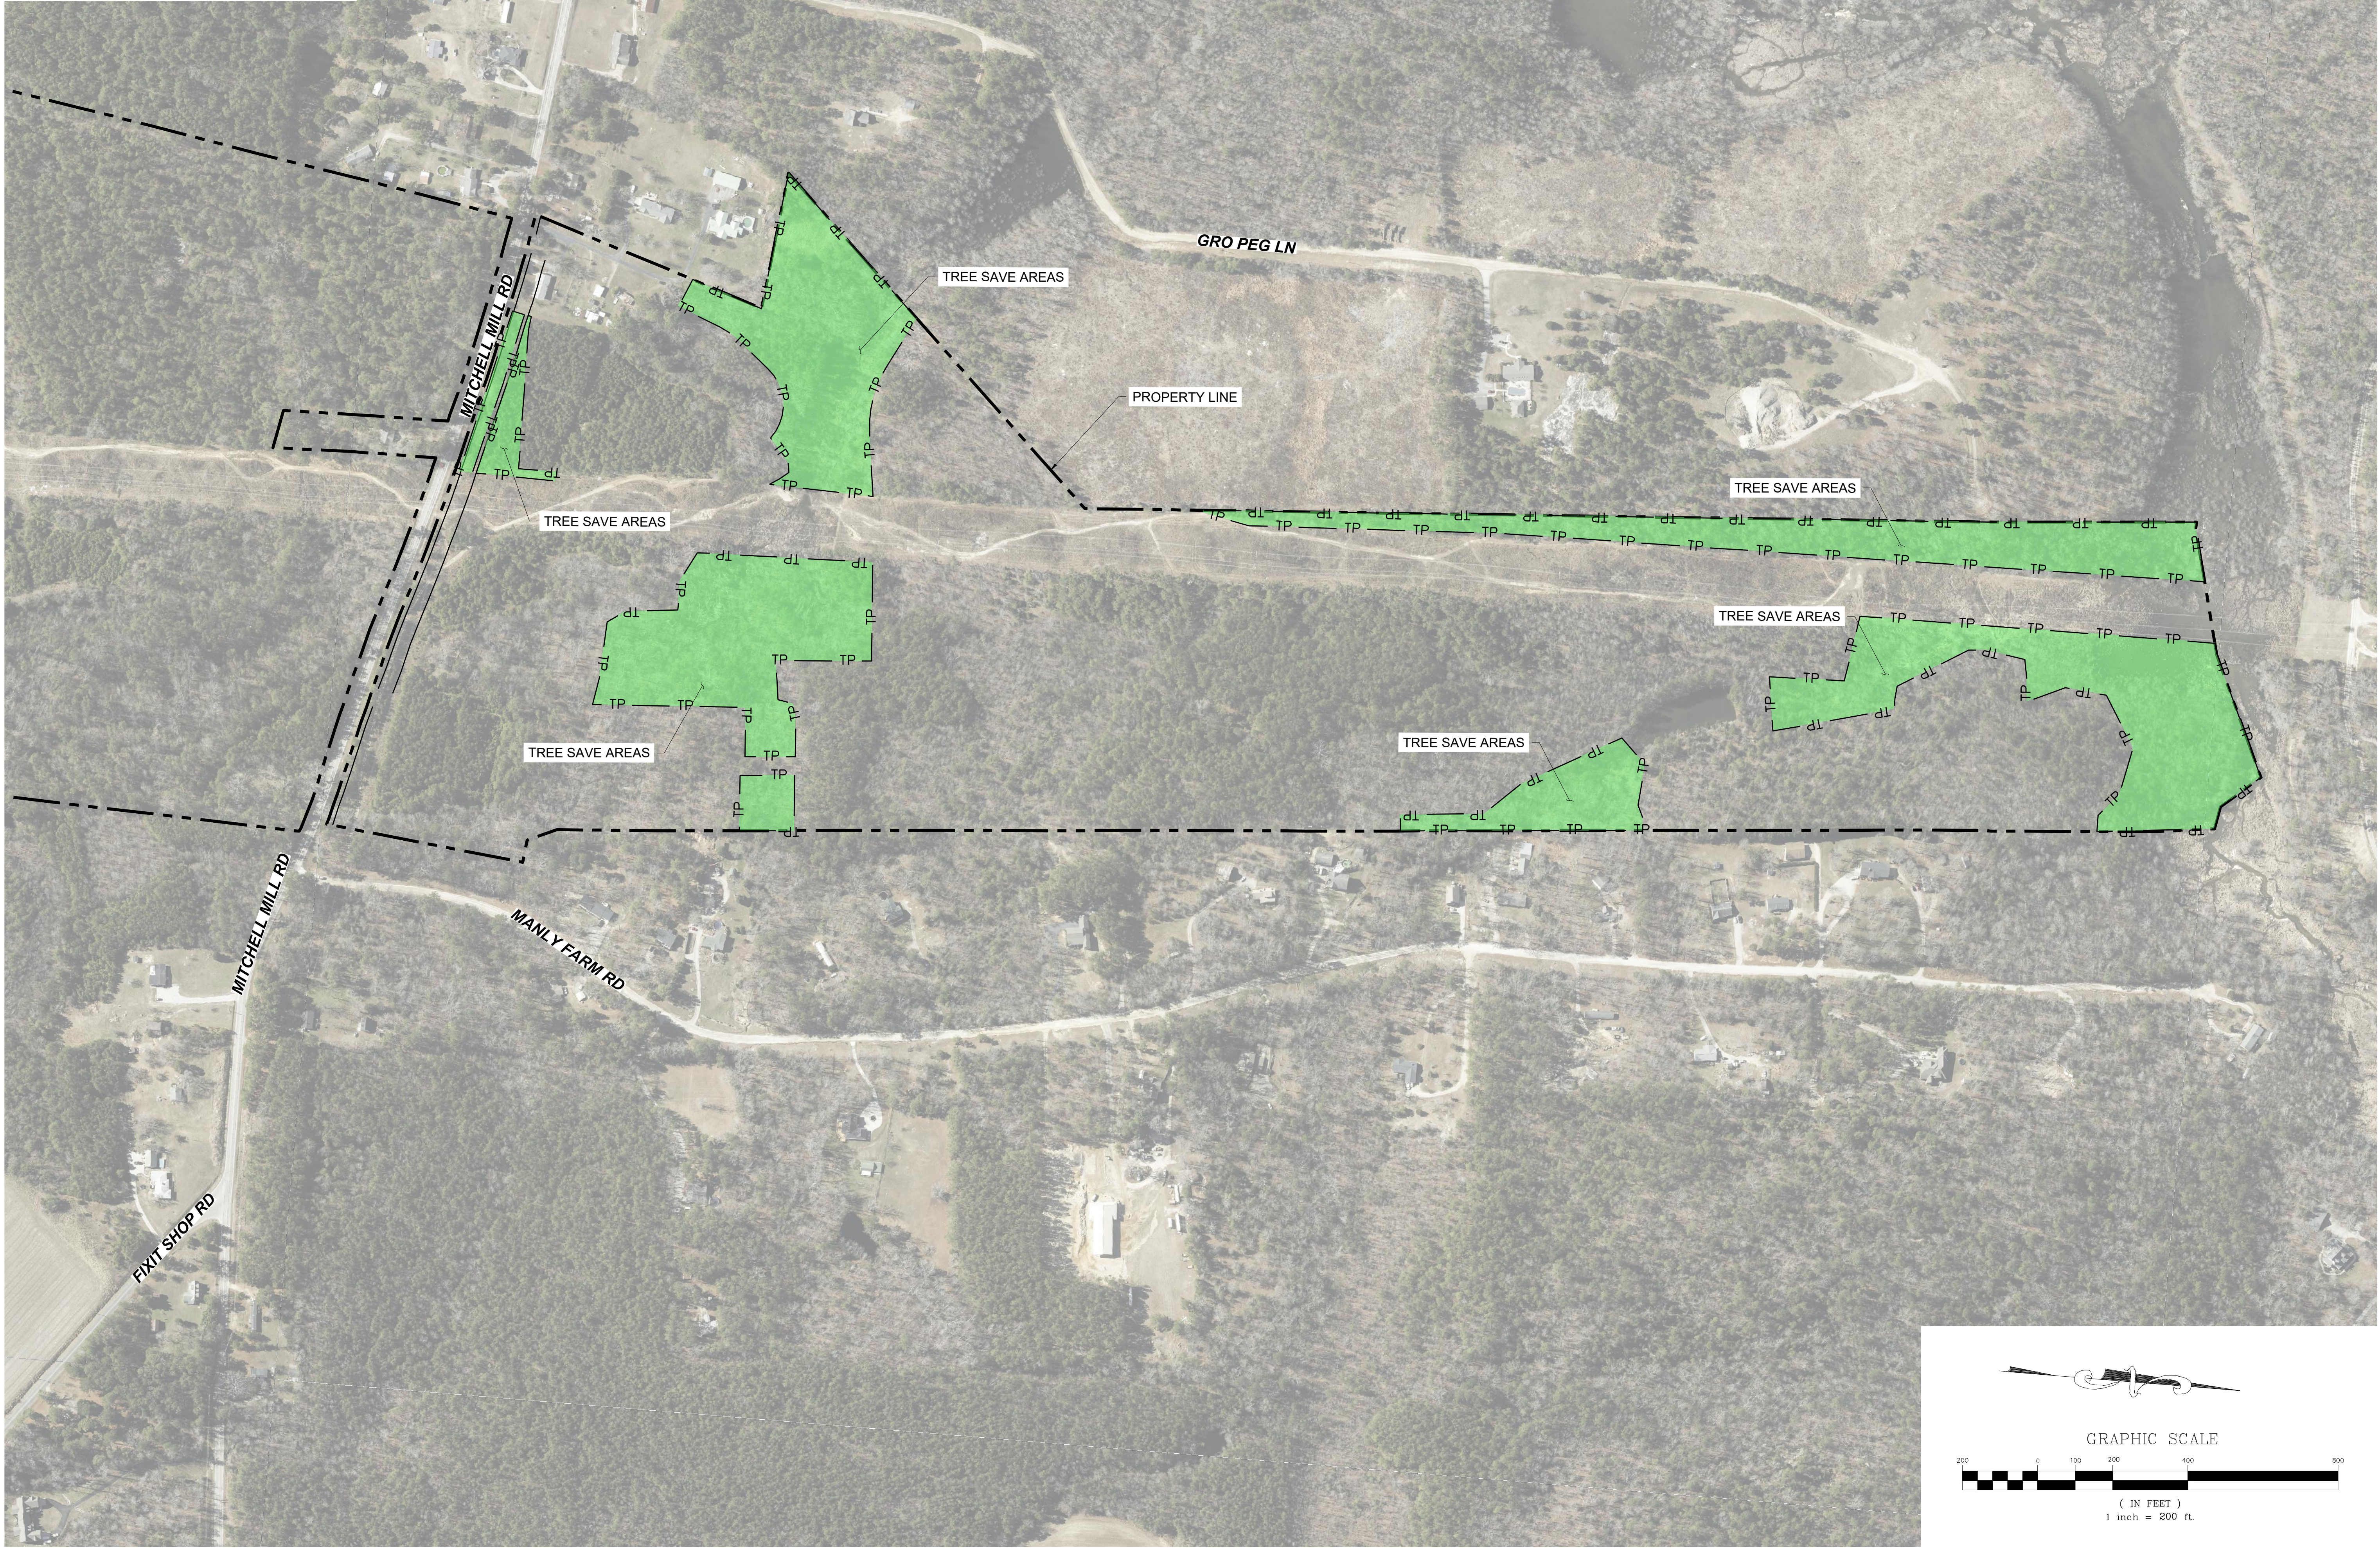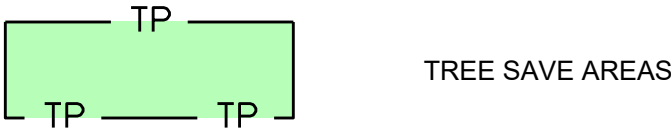

ELLIS - ROLESVILLE - MITCHELL - MILL
TOWN OF ROLESVILLE, WAKE COUNTY, NORTH CAROLINA
**SKETCH PLAN
PRESERVATION PLAN**

DRAWING
SHEET

C-5.0

05 OF 06

STRONGROCK
ENGINEERING GROUP
STRONG ROCK ENGINEERING GROUP, PLLC / COMPANY LICENSE # P-2166
6801 FALLS OF NEUSE RD, SUITE 108 RALEIGH, NC 27615 | JOSH@STRONGROCKENGINEERING.COM

SEAL:
NORTH CAROLINA
PROFESSIONAL
ENGINEER
036225
JOSHUA W. LAMBERT

No.	REVISIONS	DATE	BY

STRONG ROCK PROJECT	DATE
SCALE AS SHOWN	DESIGNED BY JWL
DRAWN BY JWL	CHECKED BY JWL



SINGLE FAMILY #1



SINGLE FAMILY #2



SINGLE FAMILY #3




TOWNHOMES #1



TOWNHOMES #2

NOTE:

ELEVATIONS SHOWN ARE FOR ILLUSTRATIVE PURPOSES TO SHOW AN EXAMPLE OF PRODUCT TYPE AT TIME OF BUILDING PERMIT. EACH BLOCK WILL CONTAIN AN ARRAY OF DIFFERENT ELEVATIONS TO MEET THE TOWN OF ROLESVILLE'S ARCHITECTURAL VARIABILITY STANDARD.

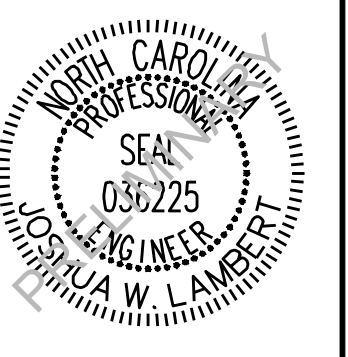

STRONG  **ROCK**
ENGINEERING GROUP
STRONG ROCK ENGINEERING GROUP, PLLC (COMPANY LICENSE # P-2168)
6801 FALLS OF NEUSE RD. SUITE 108 WAKEFIEld, NC 27615 | JOSH@STRONGROCKENGINEERING.COM

DATE	
SCALE	AS SHOWN
DESIGNED BY	JWL
DRAWN BY	JWL
CHECKED BY	JWL

SKETCH PLAN

ARCHITECTURAL DESIGNS

DRAWING
SHEET

C-6.0

6 OF 06