
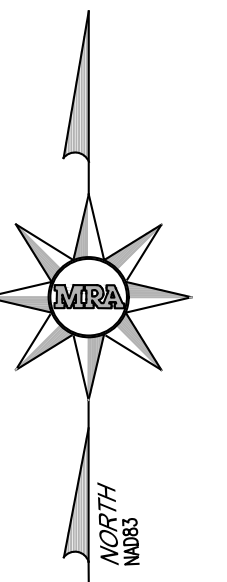


KEY PLAN
NOT TO SCALE

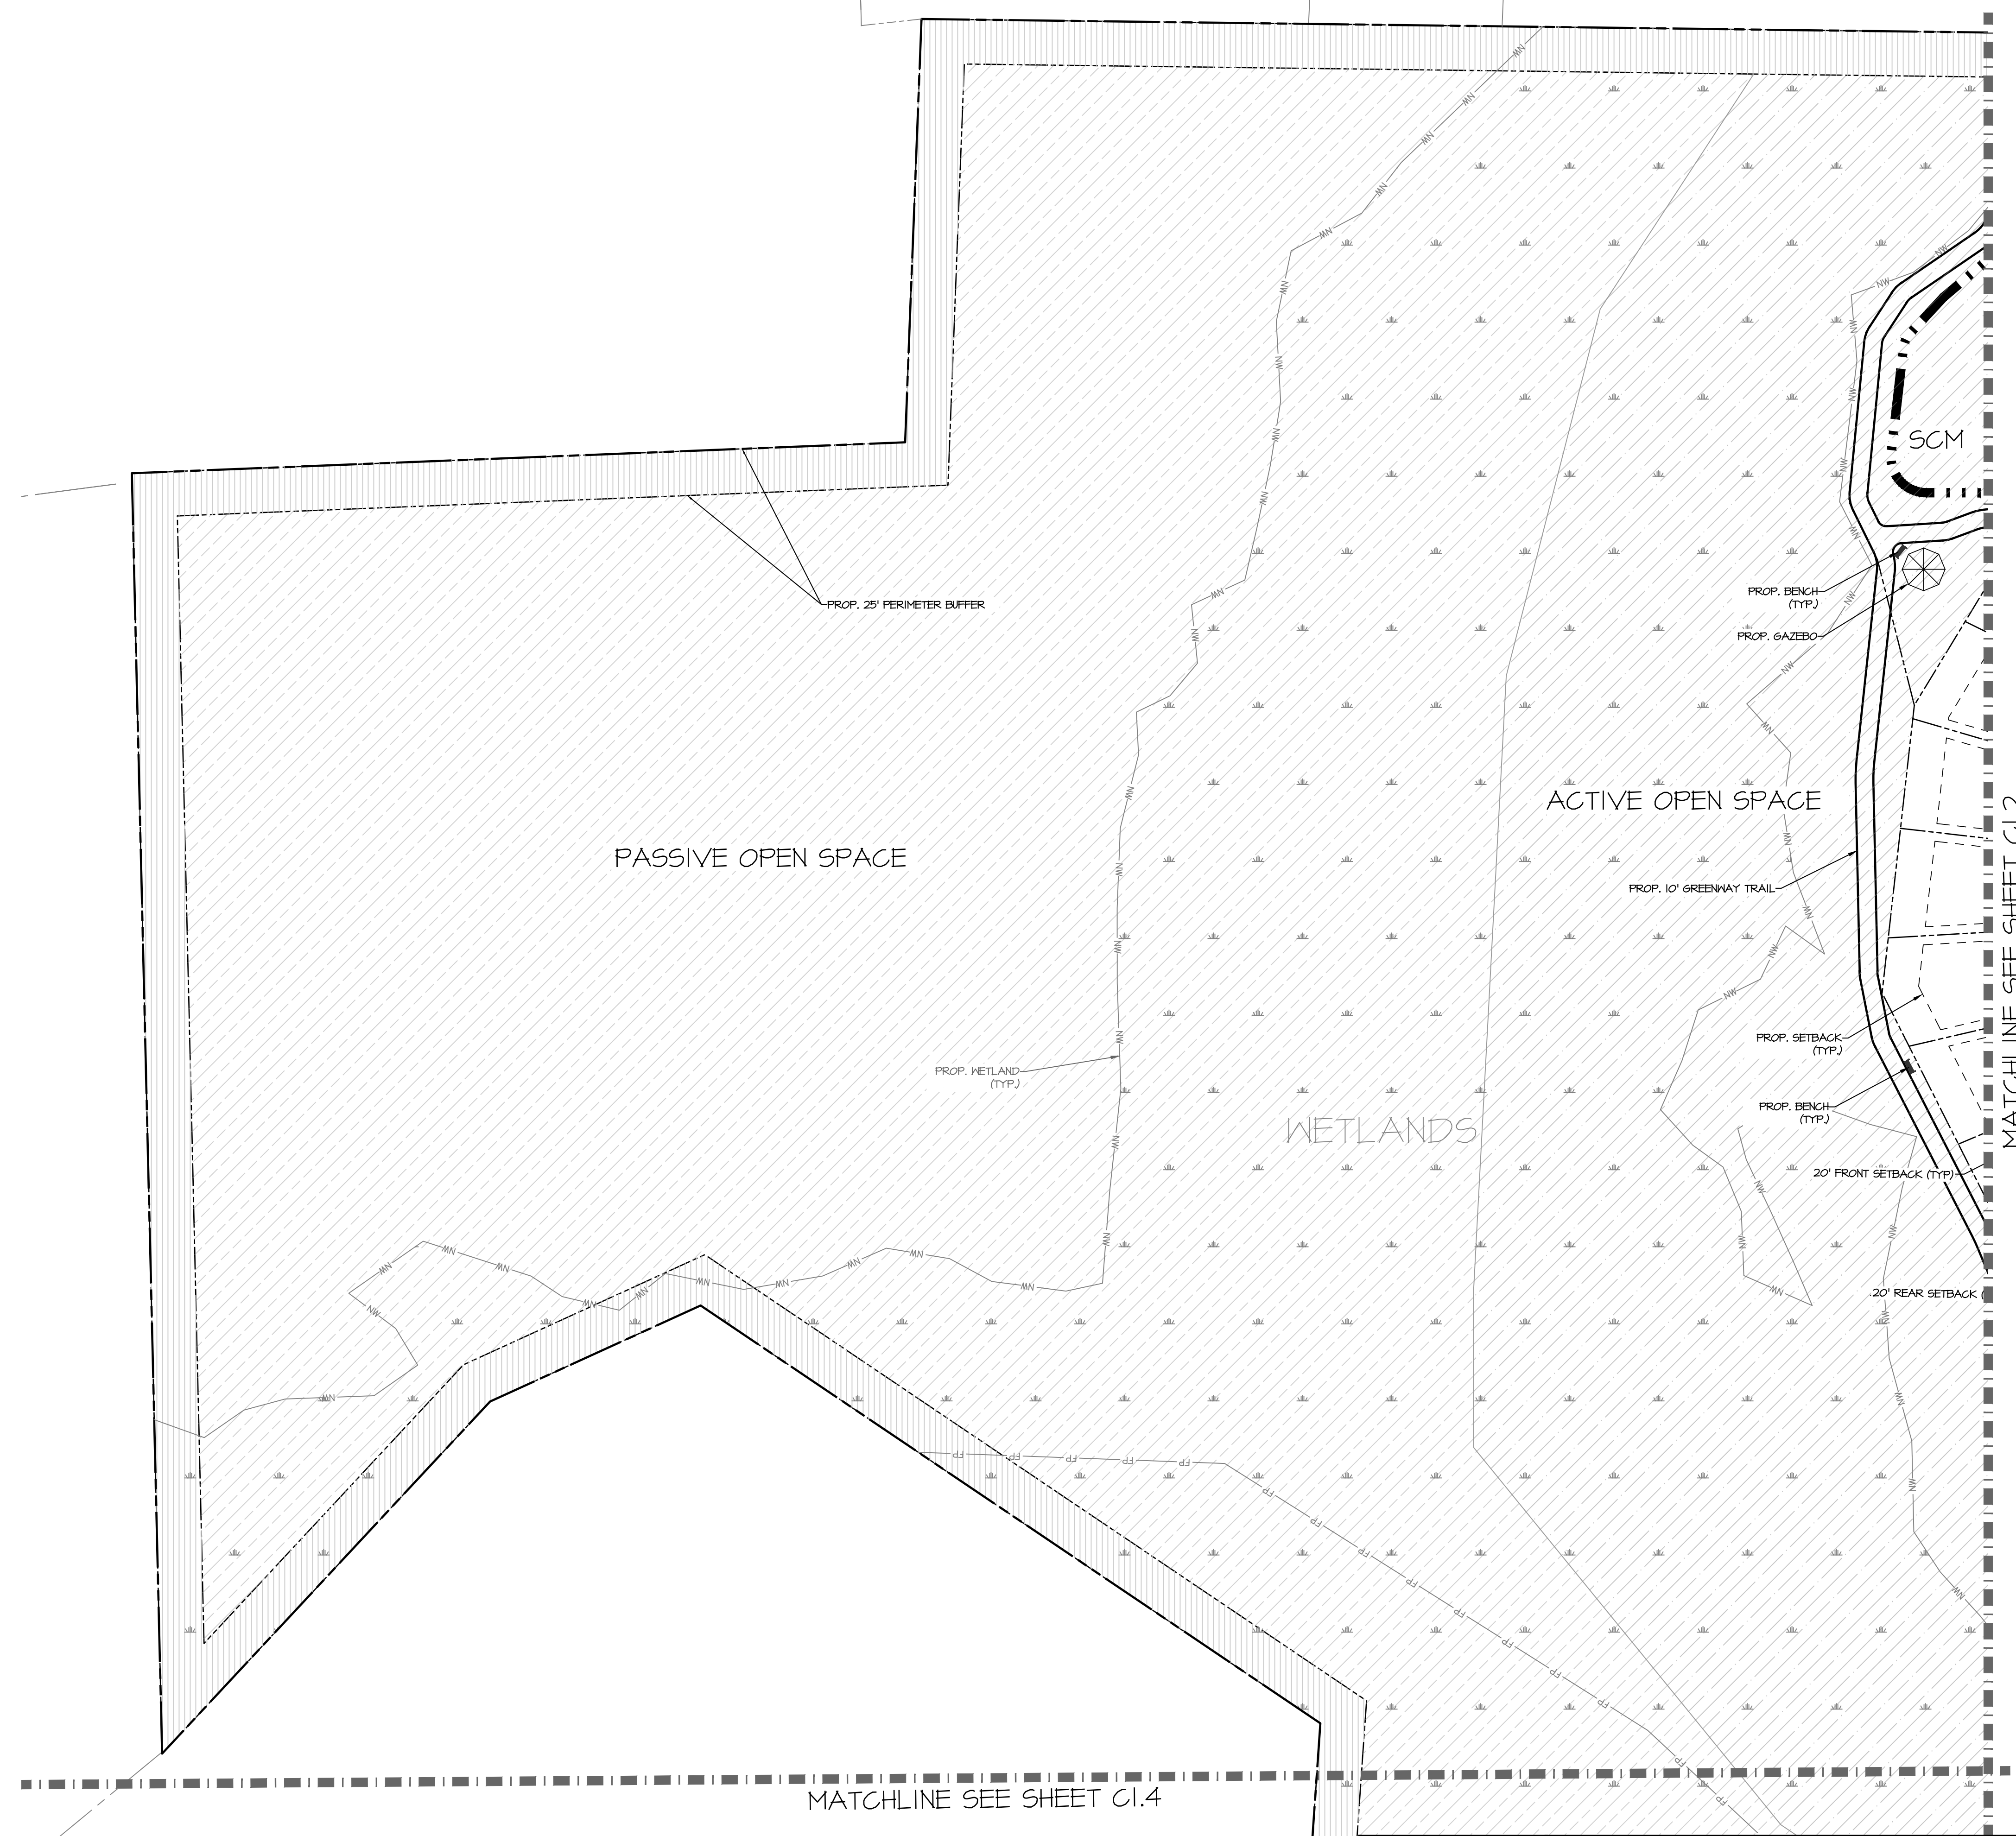

LEGEND

- PR, RIGHT OF WAY
- PR, LOT LINE/PARCEL LINE
- PR, EASEMENT
- PR, BUILDING
- PR, GARD & LETTER
- PR, RETAINING WALL
- PR, ROAD CENTER LINE
- PR, HEAVY DUTY PAVEMENT
- PR, LIGHT DUTY PAVEMENT
- PR, 20' PERIMETER BUFFER
- PR, SCH ACCESS EASEMENT
- PR, OPEN SPACE
- PR, IMPROVED OPEN SPACE
- PR, ACTIVE OPEN SPACE
- PR, FENCE
- PR, HANDICAP PARKING
- PR, HANDICAP RAMP
- PR, LOT NUMBER
- PR, OPEN SPACE
- PR, PARKING SPACE COUNT
- PR, LIMIT OF DISTURBANCE
- PR, TREE PROTECTION FENCE
- PR, TREELINE
- PR, F' CONTOUR
- EX, F' CONTOUR
- EX, F' CONTOUR
- EX, F' CONTOUR
- EX, F' CONTOUR
- EX, PROPERTY LINE
- EX, RIGHT-OF-WAY
- EX, ADJACENT PROPERTY LINE
- EX, EASEMENT
- EX, 24 HOURS CHANGE FLOODPLAIN
- EX, NON-TIDAL WETLAND
- EX, STREAM BUFFER
- EX, GARB
- EX, PAVEMENT/EDGE OF GUTTER
- EX, HALK
- EX, STREAMFORD
- EX, TREELINE
- EX, TREE
- EX, STORM DRAIN
- EX, SANITARY LINE
- EX, WATERLINE
- EX, GAS LINE
- EX, UNDERGROUND ELECTRIC
- EX, OVERHEAD ELECTRIC
- EXISTING PROPOSED
- FIRE HYDRANT
- WATER VALVE
- RESISTOR
- WATER METER
- POWER POLE
- LIGHT POLE
- PROP. TRASH CAN
- PROP. BENCH

PRELIMINARY
NOT FOR CONSTRUCTION
FOR REVIEW ONLY

ENGINEER'S SEAL

TOWN OF ROLESVILLE WAKE COUNTY, NORTH CAROLINA

SITE PLAN - SHEET 1 OF 6
FOR
JONESVILLE ROAD


No.	DATE	REVISIONS

MRA



MORRIS & RITCHIE ASSOCIATES OF NC, PC
ENGINEERS, ARCHITECTS, PLANNERS, SURVEYORS AND LANDSCAPE ARCHITECTS
5605 CHAPEL HILL RD. STE 112
RALEIGH, NC 27607
(984) 200-2103
LICENSE # C-4182
WWW.MRAGTA.COM
© 2021 MORRIS & RITCHIE ASSOCIATES, INC.

STATUS: **PRELIMINARY NOT FOR CONSTRUCTION**

REVISION: -- SHEET: **C1.1**

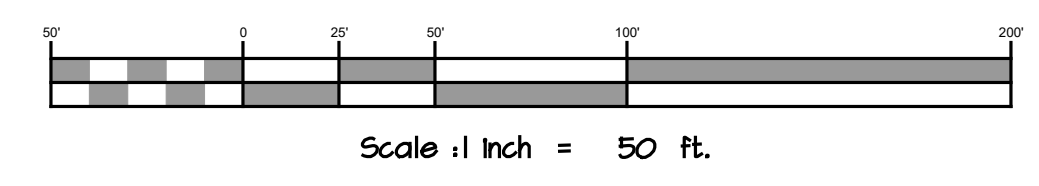

MATCHLINE SEE SHEET C1.2

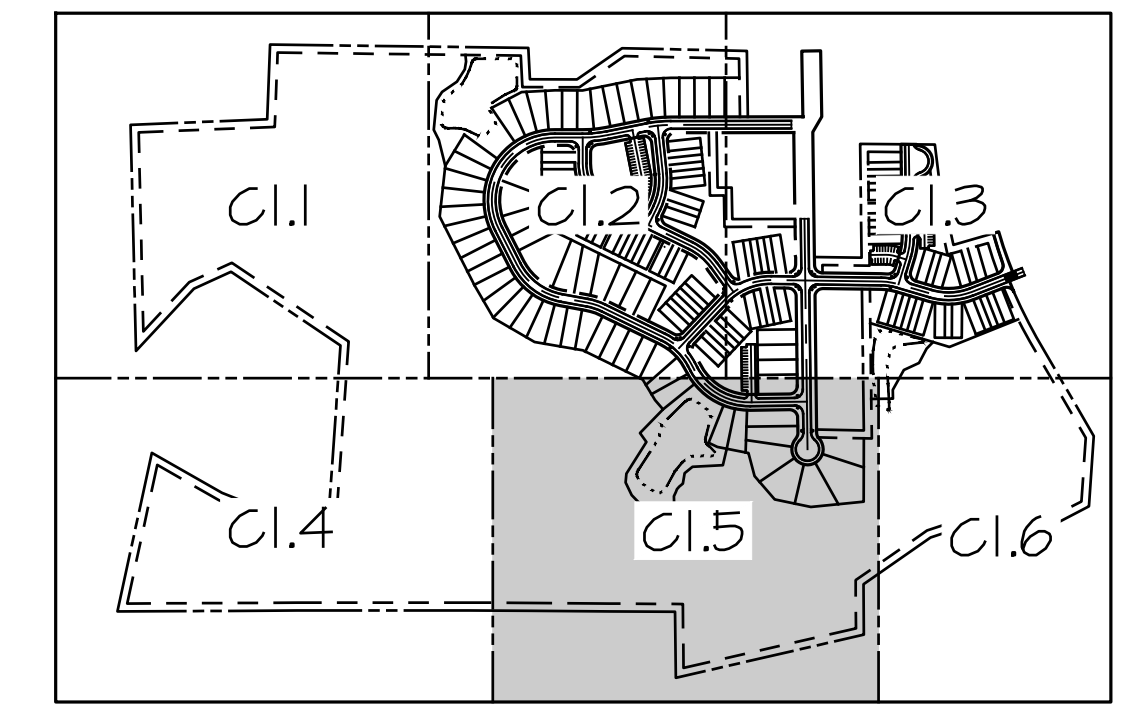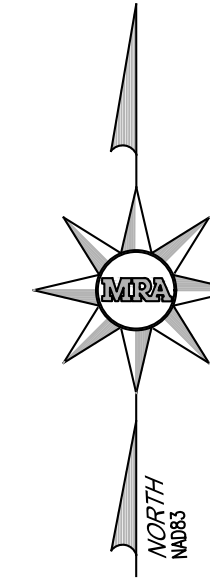

KEY PLAN
NOT TO SCALE

MATCHLINE SEE SHEET C1.4

MATCHLINE SEE SHEET C1.6

Please align the side lot line of Lot 8 with the corner of Lot 5.

LEGEND

- PR, RIGHT OF WAY
- PR, LOT LINE/PARCEL LINE
- PR, EASEMENT
- PR, BUILDING
- PR, CURB & GUTTER
- PR, RETAINING WALL
- PR, ROAD CONTROL LINE
- PR, HEAVY DUTY PAVEMENT
- PR, LIGHT DUTY PAVEMENT
- 20' FRESHET BUFFER
- PR, SCH ACCESS EASEMENT
- PR, OPEN SPACE
- PR, IMPROVED OPEN SPACE
- PR, ACTIVE OPEN SPACE
- PR, FENCE
- PR, HANDICAP PARKING
- PR, HANDICAP RAMP
- PR, LOT NUMBER
- PR, PARKING SPACE COUNT
- PR, OPEN SPACE
- PR, LIMIT OF DISTURBANCE
- PR, TREE PROTECTION FENCE
- PR, TRESLIE
- PR, 1' CONTOUR
- EX, 1' CONTOUR
- EX, 5' CONTOUR
- EX, 10' CONTOUR
- EX, PROPERTY LINE
- EX, RIGHT-OF-WAY
- EX, ADJACENT PROPERTY LINE
- EX, EASEMENT
- EX, 24 HOURS CHANGE FLOODPLAIN
- EX, NON-TIDAL WETLAND
- NW
- SB
- EX, STREAM BUFFER
- EX, BRIDGE
- EX, GARB
- EX, PAVEMENT/EDGE OF GUTTER
- EX, WALK
- EX, STREAMFORD
- EX, TRESLIE
- EX, TREE
- SD
- SAN
- W
- EX, SANITARY LINE
- EX, WATERLINE
- EX, GAS LINE
- UG, EX, UNDERGROUND ELECTRIC
- OH, EX, OVERHEAD ELECTRIC
- EXISTING PROPOSED
- FIRE HYDRANT
- WATER VALVE
- RESERVOIR
- WATER METER
- POWER POLE
- LIGHT POLE
- PROP. TRASH CAN
- PROP. BENCH

ACTIVE OPEN SPACE

SCM


WETLANDS

PASSIVE OPEN SPACE

ADJACENT PROPERTY OWNER (TYP.)

EXIST. SEWER (TYP.)
EXIST. SEWER EASEMENT (TYP.)

PROP. 25' PERIMETER BUFFER

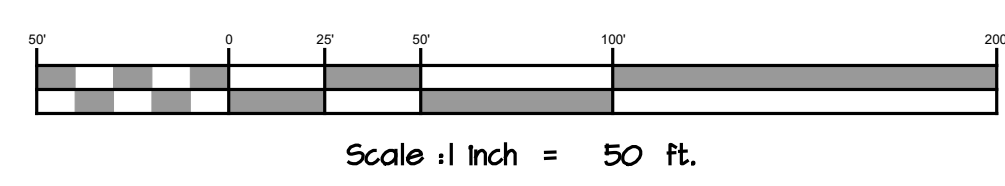

No.	DATE	REVISIONS

PRELIMINARY
NOT FOR CONSTRUCTION


ENGINEER'S SEAL

SITE PLAN - SHEET 5 OF 6
FOR
JONESVILLE ROAD




TOWN OF ROLESVILLE WAKE COUNTY, NORTH CAROLINA

MORRIS & RITCHIE ASSOCIATES OF NC, PC
ENGINEERS, ARCHITECTS, PLANNERS, SURVEYORS AND LANDSCAPE ARCHITECTS
5605 CHAPEL HILL RD. STE 112
RALEIGH, NC 27607
(984) 200-2103
LICENSE # C-4182
WWW.MRAGTA.COM
© 2021 MORRIS & RITCHIE ASSOCIATES, INC.

STATUS: PRELIMINARY NOT FOR CONSTRUCTION	REVISION SHEET: -- C1.5
--	--------------------------------------

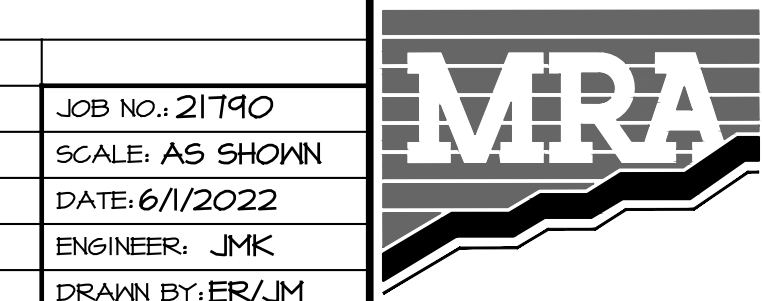


STATUS: PRELIMINARY NOT FOR CONSTRUCTION REVISION: -- SHEET: C1.5

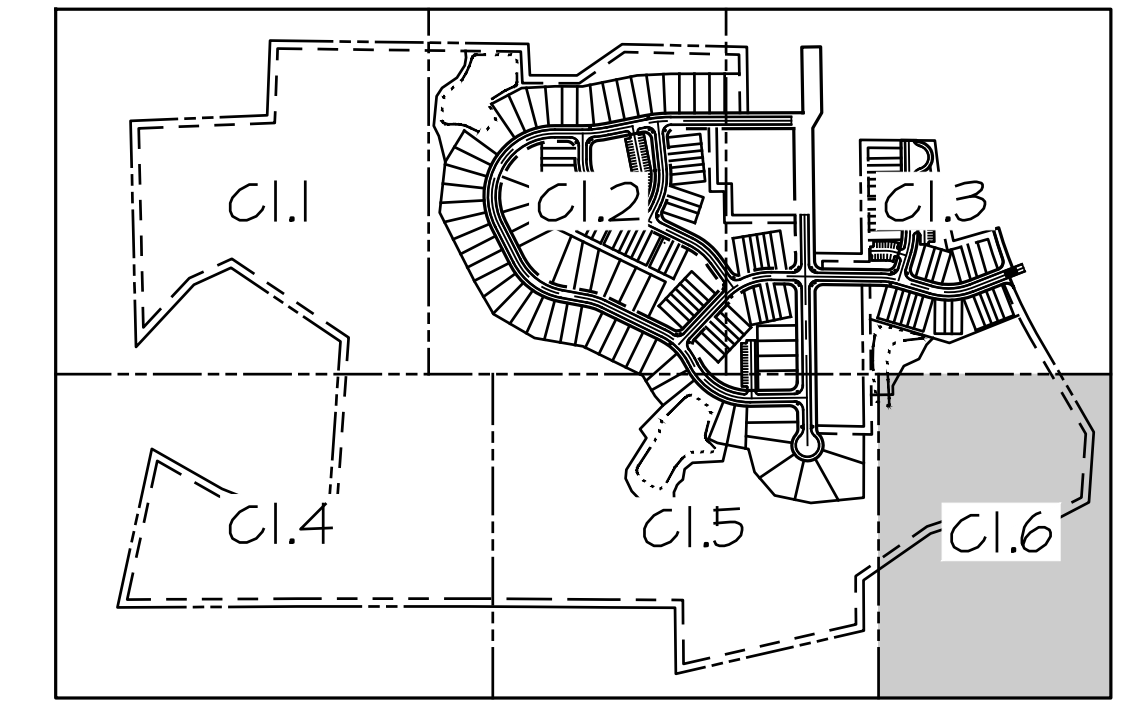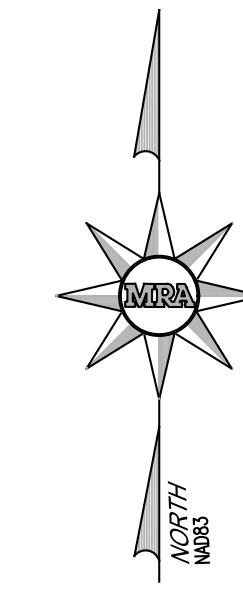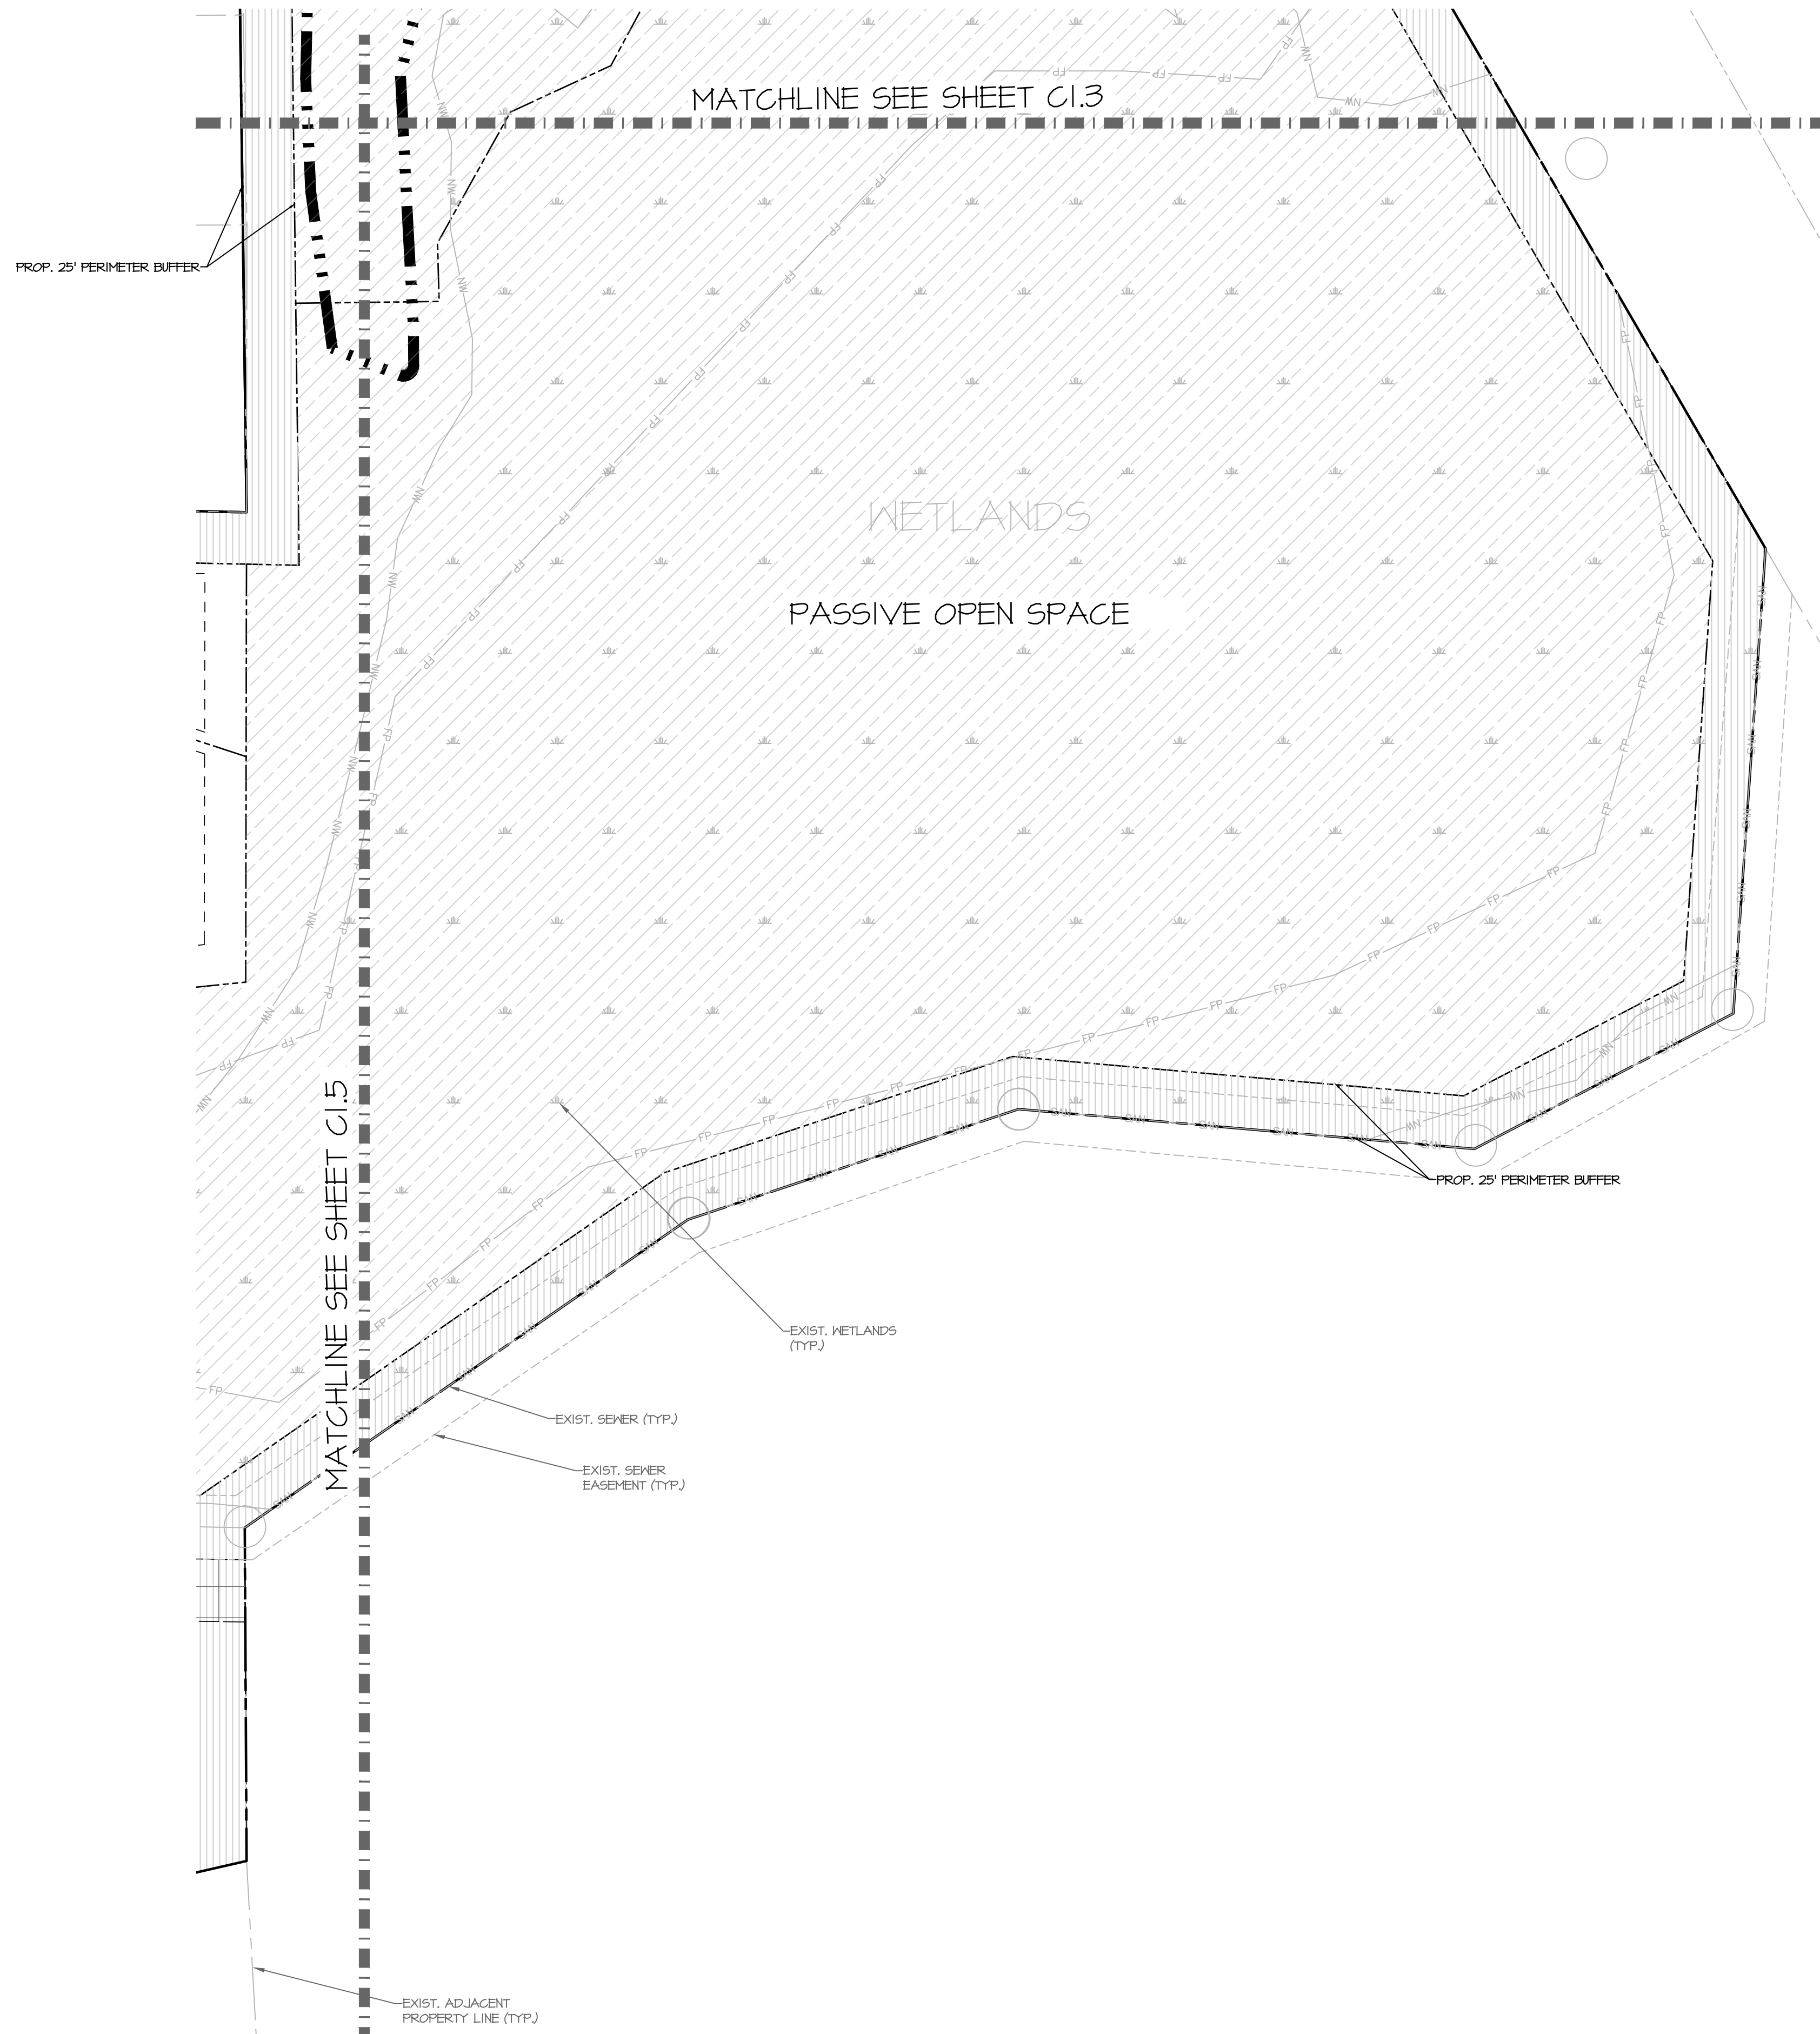

LEGEND

PR. RIGHT OF WAY	PR. LOT LINE/PARCEL LINE
PR. EASEMENT	PR. CURB & GUTTER
PR. BUILDING	PR. ROAD CENTER LINE
PR. RETAINING WALL	PR. LIGHT DUTY PAVEMENT
PR. HEAVY DUTY PAVEMENT	20' PERIMETER BUFFER
PR. SCH ACCESS EASEMENT	PR. OPEN SPACE
PR. IMPROVED OPEN SPACE	PR. ACTIVE OPEN SPACE
PR. FENCE	PR. HANDICAP PARKING
PR. HANDICAP RAMP	PR. LOT NUMBER
PR. OPEN SPACE	PR. PARKING SPACE COUNT
PR. LIMIT OF DISTURBANCE	PR. TREE PROTECTION FENCE
PR. TRESSELINE	PR. F' CONTOUR
EX. F' CONTOUR	EX. F' CONTOUR
EX. F' CONTOUR	EX. F' CONTOUR
EX. PROPERTY LINE	EX. RIGHT-OF-WAY
EX. ADJACENT PROPERTY LINE	EX. EASEMENT
EX. 30 ANNUAL CHANCE FLOODPLAIN	EX. NON-TIDAL WETLAND
NW	EX. STREAM BUFFER
SB	EX. BUILDING
EX. GARB	EX. PAVEMENT/EDGE OF GUTTER
EX. HALK	EX. STREAM/POND
EX. TRESSELINE	EX. TREE
SD	EX. STORM DRAIN
SAN	EX. SANITARY LINE
W	EX. WATERLINE
G	EX. GAS LINE
UGE	EX. UNDERGROUND ELECTRIC
OHE	EX. OVERHEAD ELECTRIC
EXISTING PROPOSED	FIRE HYDRANT
o	WATER VALVE
+	RESISOR
□	WATER METER
□	POWER POLE
o	LIGHT POLE
o	PROP. TRASH CAN
o	PROP. BENCH

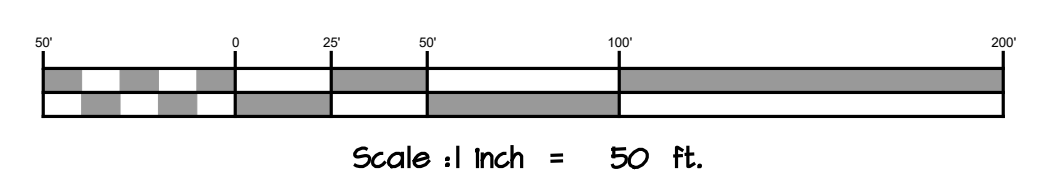

PRELIMINARY
NOT FOR
CONSTRUCTION

FOR REVIEW ONLY

ENGINEER'S SEAL

SITE PLAN - SHEET 6 OF 6

FOR
JONESVILLE ROAD

TOWN OF ROLESVILLE WAKE COUNTY, NORTH CAROLINA

MORA

STATUS: PRELIMINARY NOT FOR CONSTRUCTION

MORRIS & RITCHIE ASSOCIATES OF NC, PC
ENGINEERS, ARCHITECTS, PLANNERS, SURVEYORS AND LANDSCAPE ARCHITECTS
5605 CHAPEL HILL RD. STE 112
RALEIGH, NC 27607
(984) 200-2103
LICENSE # C-4182
WWW.MRAGTA.COM
© 2021 MORRIS & RITCHIE ASSOCIATES, INC.

No.	DATE	REVISIONS

No.	DATE	REVISIONS

JOB NO. 21790
SCALE: AS SHOWN
DATE: 6/1/2022
ENGINEER: JMK
DRAWN BY: ER/JM
DESIGN BY: DC
REVIEW BY: JMK

SHEET: C1.6

