


KEY PLAN  
NOT TO SCALE

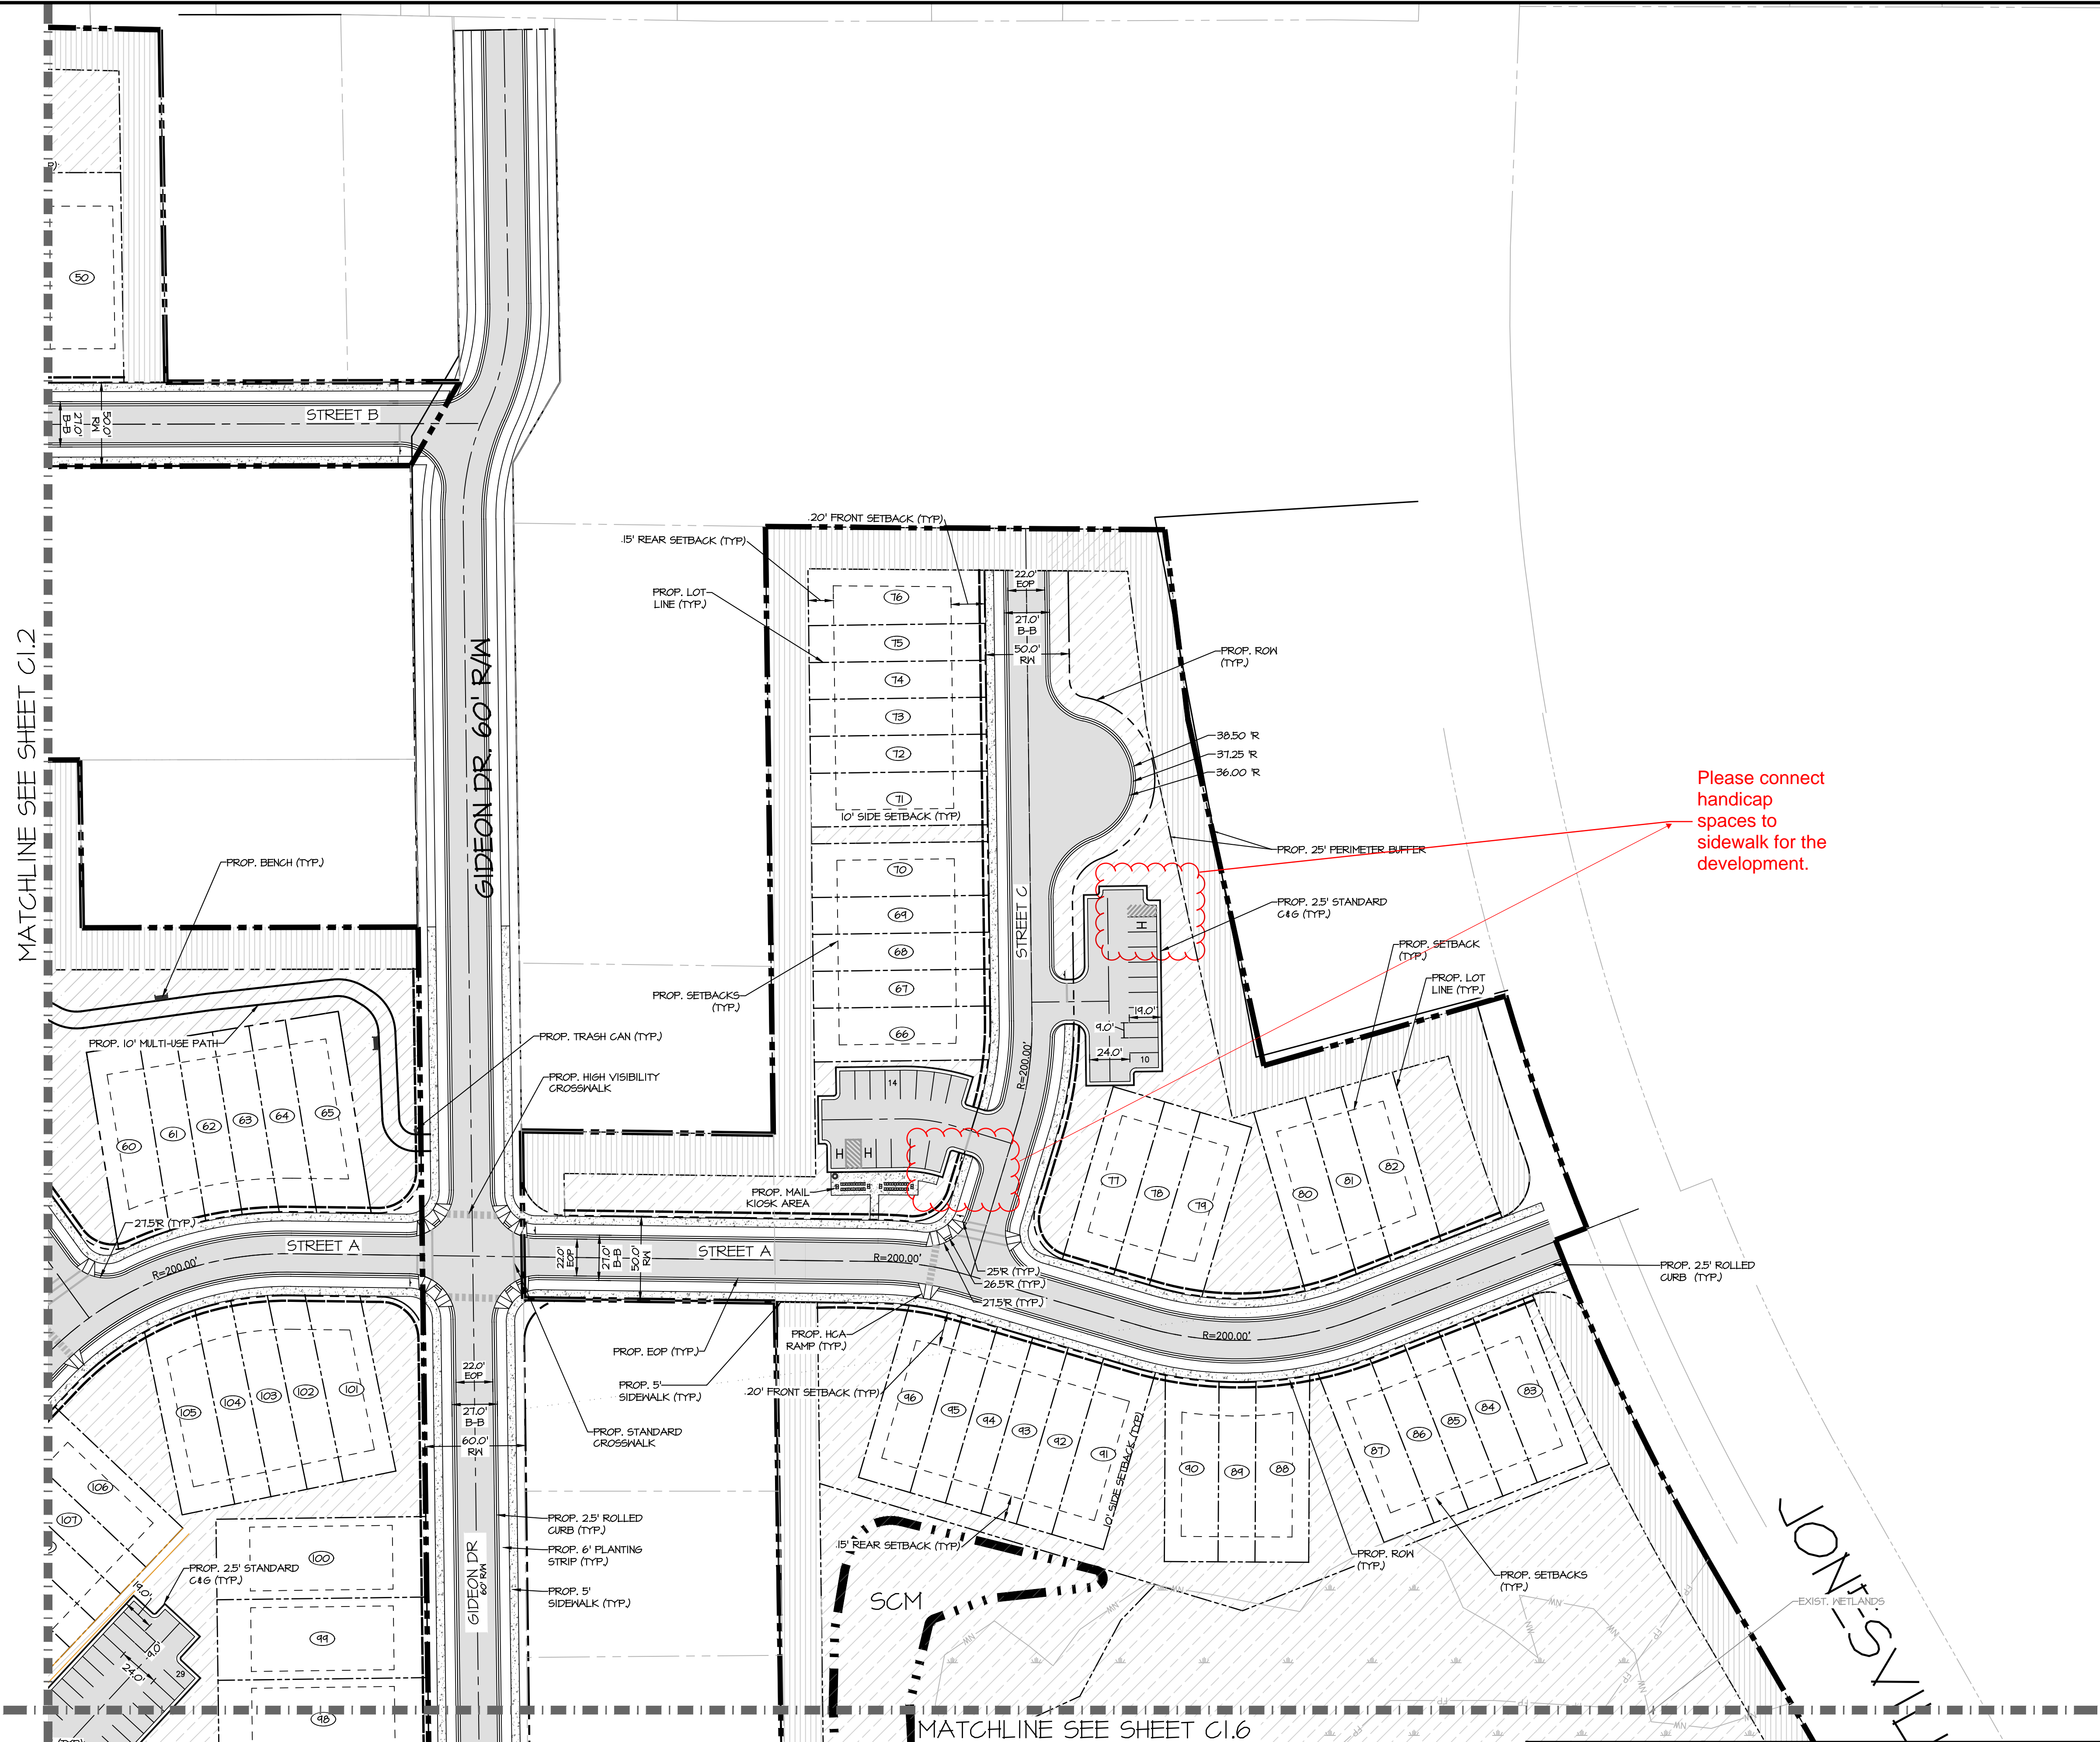


Please connect  
handicap  
spaces to  
sidewalk for the  
development.

LEGEND

- PR. RIGHT OF WAY
- PR. LOT LINE/PARCEL LINE
- PR. EASEMENT
- PR. BUILDING
- PR. CURB & GUTTER
- PR. ROAD CONTROL LINE
- PR. RETAINING WALL
- PR. LIGHT DUTY PAVEMENT
- PR. HEAVY DUTY PAVEMENT
- PR. 20' PERIMETER BUFFER
- PR. SCH ACCESS EASEMENT
- PR. OPEN SPACE
- PR. IMPROVED OPEN SPACE
- PR. ACTIVE OPEN SPACE
- PR. FENCE
- PR. HANDICAP PARKING
- PR. HANDICAP RAMP
- PR. LOT NUMBER
- PR. OPEN SPACE
- PR. PARKING SPACE COUNT
- PR. LIMIT OF DISTURBANCE
- PR. TREE PROTECTION FENCE
- PR. TREE LINE
- PR. 1' CONTOUR
- PR. 5' CONTOUR
- EX. 1' CONTOUR
- EX. 5' CONTOUR
- EX. PROPERTY LINE
- EX. RIGHT-OF-WAY
- EX. ADJACENT PROPERTY LINE
- EX. EASEMENT
- EX. FLOODPLAIN
- EX. NON-TIDAL WETLAND
- EX. STREAM BUFFER
- EX. BUILDING
- EX. GARB
- EX. FURNITURE/EDGE OF GUTTER
- EX. HALK
- EX. STREAMPOND
- EX. TREE
- EX. STORM DRAIN
- EX. SANITARY LINE
- EX. WATERLINE
- EX. GAS LINE
- EX. UNDERGROUND ELECTRIC
- EX. OVERHEAD ELECTRIC
- EXISTING PROPOSED
- FIRE HYDRANT
- WATER VALVE
- SEWER
- WATER METER
- POWER POLE
- LIGHT POLE
- PROP. TRASH CAN
- PROP. BENCH



**SITE PLAN - SHEET 3 OF 6**  
FOR  
**JONESVILLE ROAD**  
TOWN OF ROLESVILLE WAKE COUNTY, NORTH CAROLINA

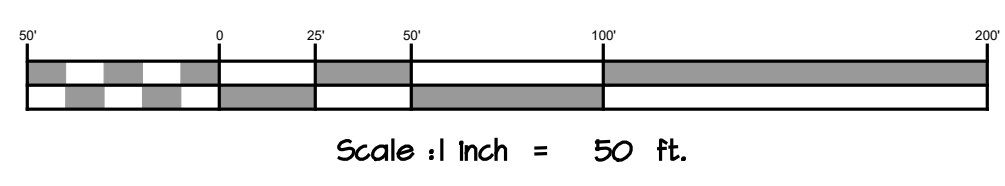

No.	DATE	REVISIONS
A	9/30/2022	REVISED PER TOWN OF ROLESVILLE COMMENTS



**MORRIS & RITCHIE ASSOCIATES OF NC, PC**  
ENGINEERS, ARCHITECTS, PLANNERS, SURVEYORS AND LANDSCAPE ARCHITECTS  
5605 CHAPEL HILL RD, STE 112  
RALEIGH, NC 27607  
(984) 200-2103  
LICENSE # C-4182  
WWW.MRAGTA.COM  
© 2021 MORRIS & RITCHIE ASSOCIATES, INC.

STATUS: PRELIMINARY NOT FOR CONSTRUCTION REVISION SHEET: A C1.3

S:\PROJECTS\NC\2021\1790 - Jonesville RA\20-10E\10 Prelim\10 Plot\1 - SITE PLAN.dwg, 9/30/2022 2:47:02 PM, Copyright 2022 Morris & Ritchie Associates, Inc.
















**LEGEND**

- PR. RIGHT OF WAY
- PR. LOT LINE/ PARCEL LINE
- PR. EASEMENT
- PR. BUILDING
- PR. CURB & GUTTER
- PR. RETAINING WALL
- PR. ROW CENTER LINE
- PR. HEAVY DUTY PAVEMENT
- PR. LIGHT DUTY PAVEMENT
- 20' PERIMETER BUFFER
- PR. SCM ACCESS EASEMENT
- PR. OPEN SPACE
- PR. IMPROVED OPEN SPACE
- PR. ACTIVE OPEN SPACE
- PR. FENCE
- PR. HANDICAP PARKING
- PR. HANDICAP RAMP
- PR. LOT NUMBER
- PR. PARKING SPACE COUNT
- PR. OPEN SPACE
- PR. LIMIT OF DISTURBANCE
- PR. TREE PROTECTION FENCE
- PR. TREE LINE
- PR. 1' CONTOUR
- PR. 5' CONTOUR
- PR. 10' CONTOUR
- PR. 20' CONTOUR
- EX. PROPERTY LINE
- EX. RIGHT-OF-WAY
- EX. ADJACENT PROPERTY LINE
- EX. EASEMENT
- EX. FLOODPLAIN
- EX. NON-TIDAL WETLAND
- EX. STREAM BUFFER
- EX. BUILDING
- EX. CARE
- EX. PAVEMENT/EDGE OF GUTTER
- EX. WALL
- EX. DRIVEWAY/PORCH
- EX. TREE LINE
- EX. TREE
- EX. STORM DRAIN
- EX. SANITARY LINE
- EX. WATER LINE
- EX. GAS LINE
- EX. UNDERGROUND ELECTRIC
- EX. OVERHEAD ELECTRIC
- EXISTING PROPOSED
- FIRE HYDRANT
- WATER VALVE
- REDUCER
- WATER METER
- POWER POLE
- LIGHT POLE
- DEAD END SIGN / X

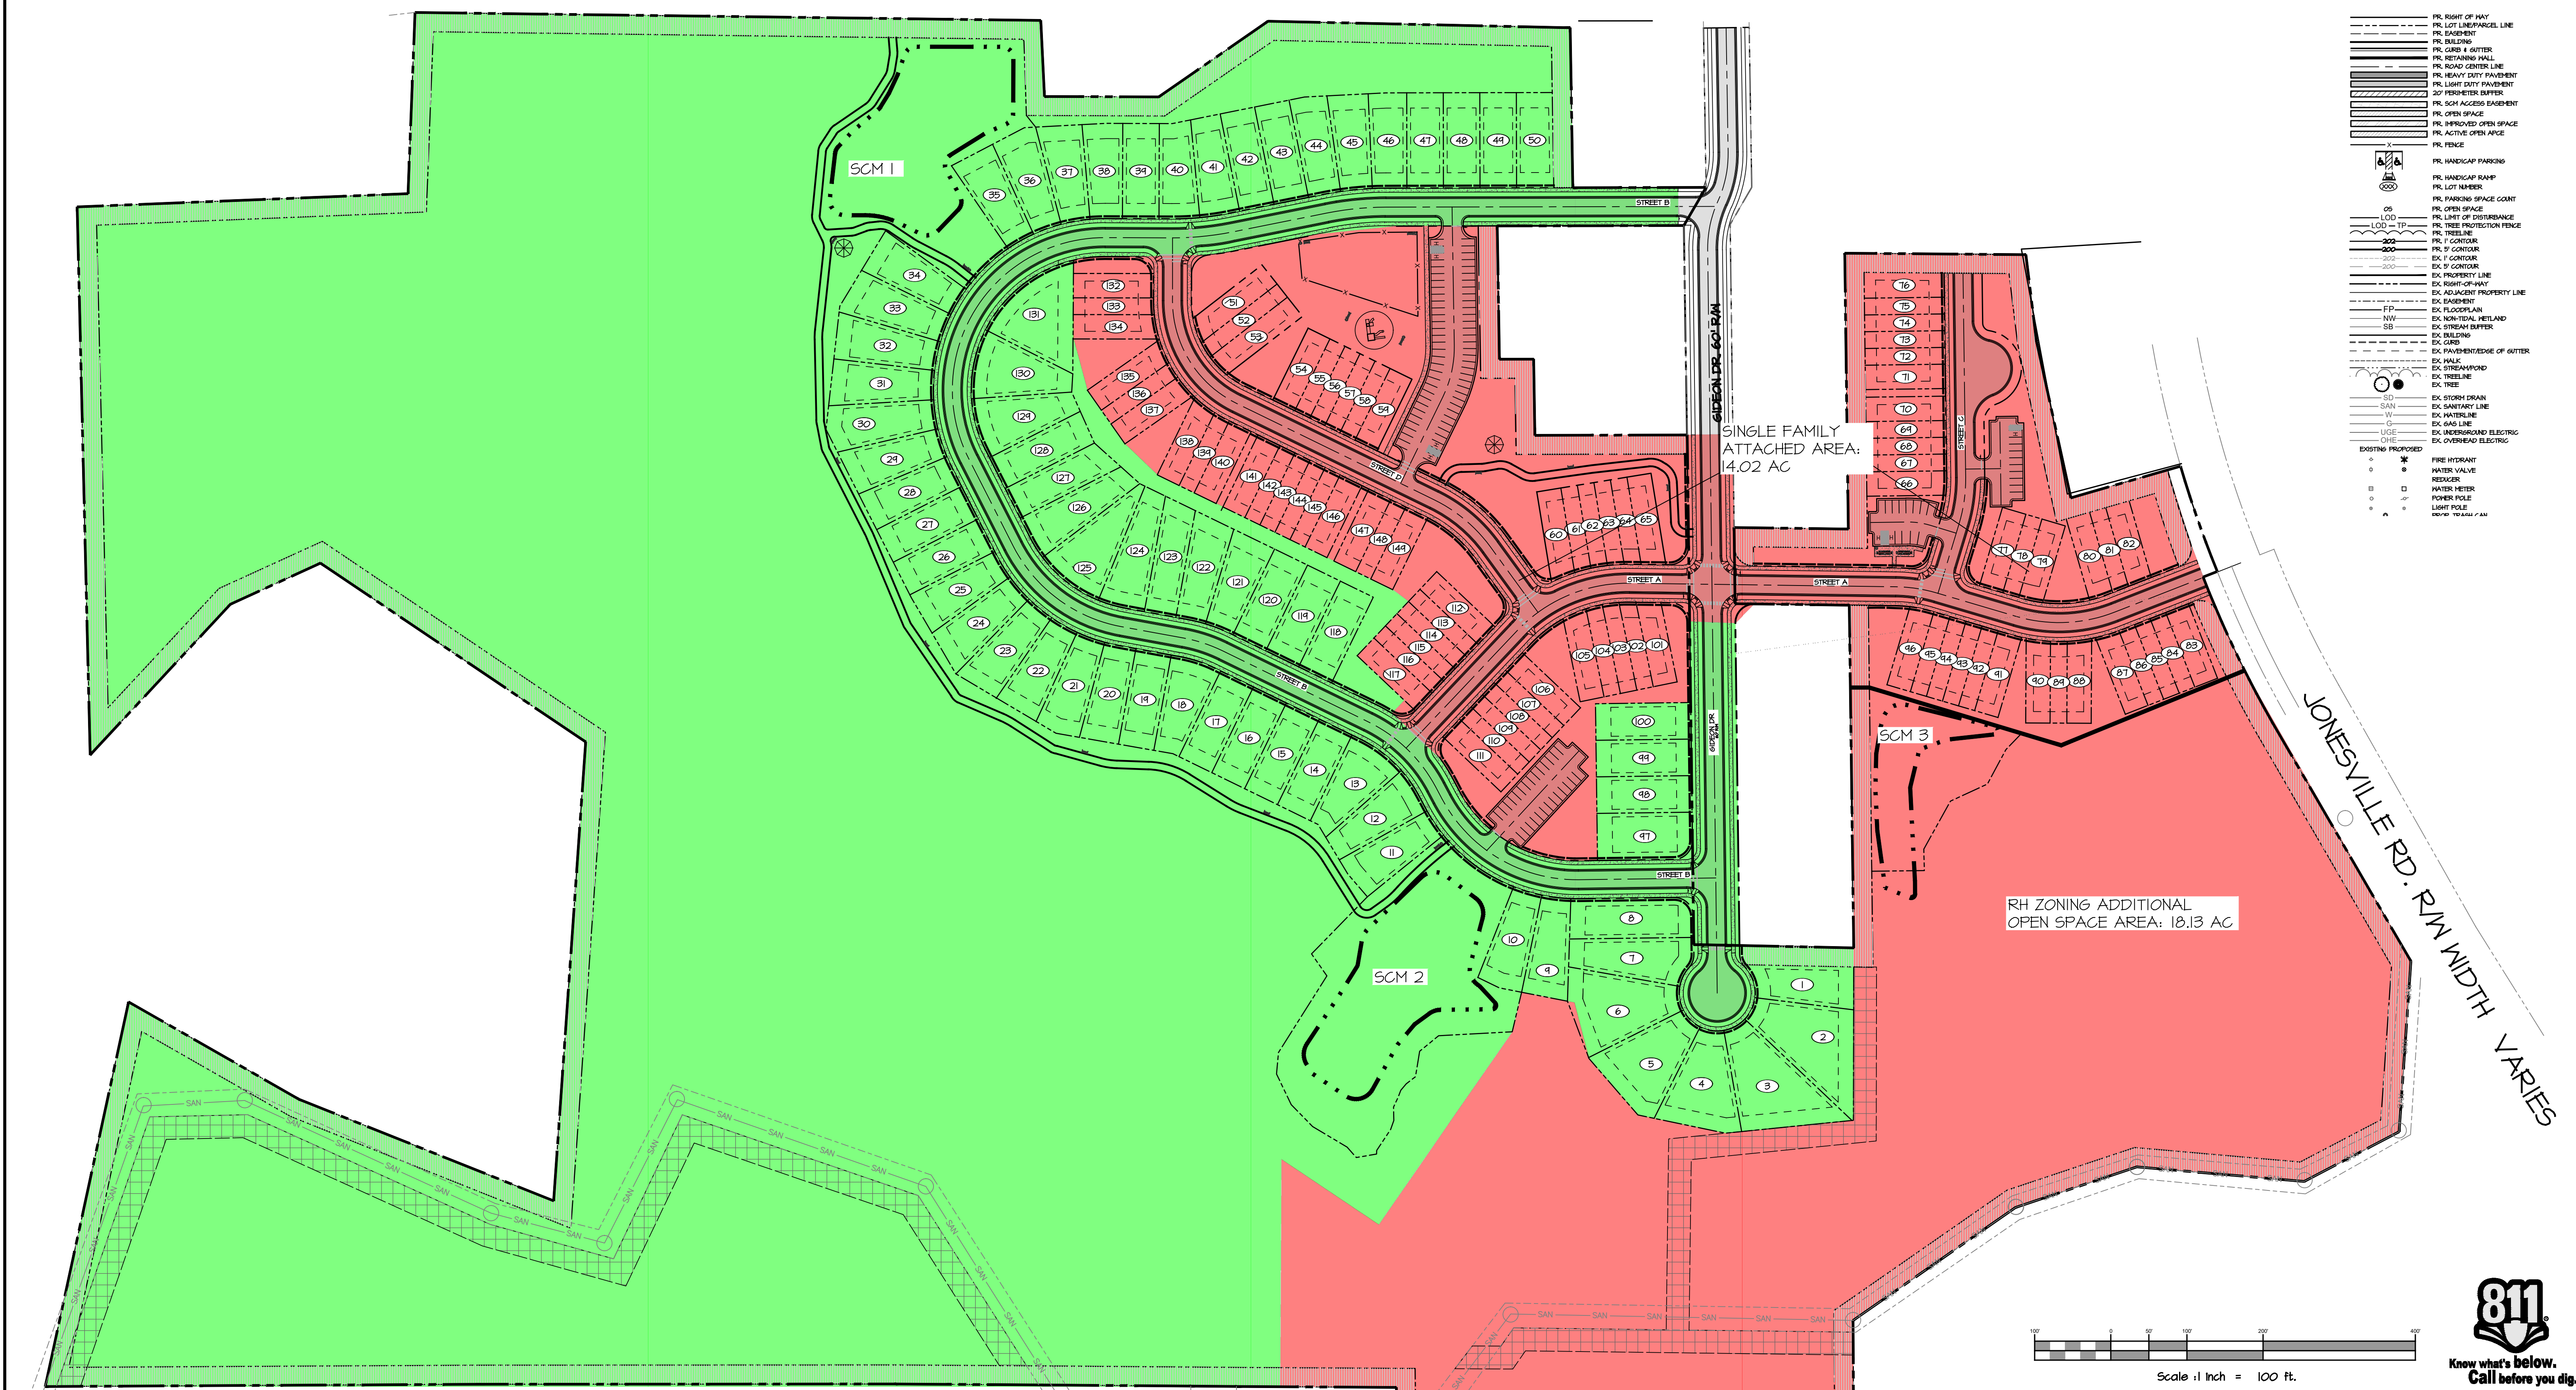



SINGLE FAMILY ATTACHED AREA: 14.02 AC

RH ZONING ADDITIONAL OPEN SPACE AREA: 18.13 AC

JONESVILLE RD. RW WIDTH VARIES

**LEGEND**

	<b>RESIDENTIAL MEDIUM DENSITY:</b>	AREA: 61.08 ACRES	UNITS: 68 SF UNITS	DENSITY: 64/61.08 = 1.11 UNITS/ACRE
	<b>RESIDENTIAL HIGH DENSITY:</b>	14.02 ACRES (32.15 ACRES TOTAL)	81 TH UNITS	81/14.02 = 5.77 UNITS/ACRE
	RESIDENTIAL MEDIUM DENSITY OPEN SPACE	REQUIRED: 4.10 AC PROVIDED: 44.09 AC		
	RESIDENTIAL HIGH DENSITY OPEN SPACE	REQUIRED: 2.10 AC PROVIDED: 3.13 AC (+18.13 ADDITIONAL ACRES)		

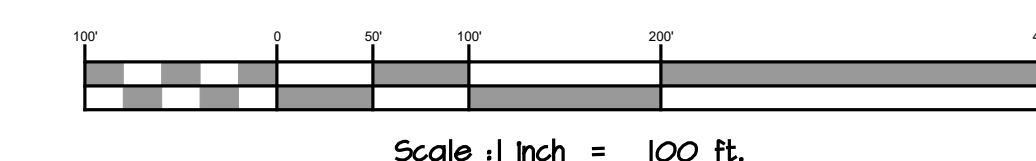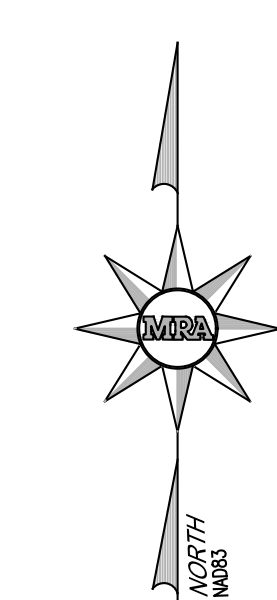

**PRELIMINARY FOR REVIEW ONLY**  
**NOT FOR CONSTRUCTION**

ENGINEER'S SEAL

**OVERALL ZONING PLAN**  
FOR  
**JONESVILLE ROAD**

TOWN OF ROLESVILLE WAKE COUNTY, NORTH CAROLINA

**MORRIS & RITCHIE ASSOCIATES OF NC, PC**  
ENGINEERS, ARCHITECTS, PLANNERS, SURVEYORS AND LANDSCAPE ARCHITECTS  
5605 CHAPEL HILL RD. STE 112  
RALEIGH, NC 27607  
(984) 200-2103  
LICENSE # C-4182  
WWW.MRAGTA.COM  
© 2021 MORRIS & RITCHIE ASSOCIATES, INC.

STATUS: **PRELIMINARY NOT FOR CONSTRUCTION**

REVISION: **A**

SHEET: **C1.7**

No.	DATE	REVISIONS
A	9/30/2022	REVISED PER TOWN OF ROLESVILLE COMMENTS

S:\PROJECTS\CY 2021\21790 - Jonesville RA\20-10E\10 Prelim\PILOT\1 - OVERBALL SITE PLAN.dwg, 9/30/2022, 2:47:34 PM, Copyright 2022 Morris & Ritchie Associates, Inc.