

# ALL CONSTRUCTION SHALL BE IN ACCORDANCE WITH CURRENT TOWN OF ROLESVILLE STANDARDS AND SPECIFICATIONS

## SYMBOLS AND ABBREVIATIONS

|        |                             |   |   |
|--------|-----------------------------|---|---|
| ABC    | AGGREGATE BASE COURSE       | — | EXISTING CURB INLET                         |
| ALUM   | ALUMINUM                    | □ | EXISTING GRATE INLET/YARD INLET             |
| AST2   | ALUMINIZED STEEL - TYPE 2   | — | EXISTING FLARED END SECTION                 |
| B-B    | BACK TO BACK                | ⊕ | EXISTING FIRE HYDRANT                       |
| BOA    | BLOW-OFF ASSEMBLY           | — | EXISTING BLOW-OFF ASSEMBLY                  |
| C&G    | CURB AND GUTTER             | — | EXISTING GATE VALVE                         |
| CFS    | CUBIC FEET PER SECOND       | — | EXISTING REDUCER                            |
| CI     | CURB INLET                  | — | EXISTING WATER METER                        |
| CL     | CENTER LINE                 | — | EXISTING SAN SEWER MANHOLE                  |
| CMP    | CORRUGATED METAL PIPE       | — | EXISTING CLEAN OUT                          |
| CO     | CLEAN OUT                   | — | EXISTING POWER POLE                         |
| COM    | COMMUNICATION               | — | EXISTING TELEPHONE PEDESTAL                 |
| CONC   | CONCRETE                    | — | EXISTING AREA LIGHT                         |
| DCV    | DOUBLE CHECK VALVE          | — | EXISTING SIGN                               |
| DDCV   | DOUBLE DETECTOR CHECK VALVE | — | NEW CURB INLET                              |
| DI     | DROP INLET                  | — | NEW GRATE INLET/YARD INLET                  |
| DIP    | DUCTILE IRON PIPE           | — | NEW FLARED END SECTION                      |
| EASE   | EASEMENT                    | — | NEW FIRE HYDRANT                            |
| ELEC   | ELECTRIC                    | — | NEW BLOW-OFF ASSEMBLY                       |
| EX     | EXISTING                    | — | NEW GATE VALVE                              |
| FES    | FLARED END SECTION          | — | NEW REDUCER                                 |
| FH     | FIRE HYDRANT                | — | NEW WATER METER                             |
| FM     | FORCE MAIN                  | — | NEW TEE                                     |
| FT     | FEET                        | — | NEW FLUG                                    |
| FT/SEC | FEET PER SEC                | — | NEW MANHOLE                                 |
| GALV   | GALVANIZED                  | — | NEW CLEAN OUT                               |
| GV     | GATE VALVE                  | — | NEW SIGN                                    |
| HDPE   | HIGH DENSITY POLYETHYLENE   | — | IRON PIPE                                   |
| L      | LENGTH                      | — | BENCHMARK                                   |
| LF     | LINEAR FEET                 | — | —   |
| MH     | MANHOLE                     | — | TEMP SILT FENCE                             |
| PAVE   | PAVEMENT                    | — | TEMP TREE PROTECTION FENCE                  |
| PE     | FINISHED PAD ELEVATION      | — | TEMP COMBINATION SILT/TREE PROTECTION FENCE |
| PP     | POWER POLE                  | — | TEMP DIVERSION DITCH                        |
| PVC    | POLYVINYL CHLORIDE          | — | DISTURBED LIMITS                            |
| R      | RADIUS                      | — | STREAM                                      |
| R/W    | RIGHT-OF-WAY                | — | —   |
| RED    | REDUCER                     | — | EXISTING GAS LINE                           |
| RCP    | REINFORCED CONCRETE PIPE    | — | EXISTING COMMUNICATIONS LINE                |
| RPZ    | REDUCED PRESSURE ZONE       | — | EXISTING UNDERGROUND TELEPHONE              |
| SS     | SANITARY SEWER              | — | EXISTING UNDERGROUND ELECTRIC               |
| STA    | STATION                     | — | EXISTING OVERHEAD ELECTRIC                  |
| TDD    | TEMPORARY DIVERSION DITCH   | — | EXISTING WATER LINE                         |
| TELE   | TELEPHONE                   | — | EXISTING SANITARY SEWER FORCE MAIN          |
| TSB    | TEMPORARY SEDIMENT BASIN    | — | EXISTING SANITARY SEWER                     |
| UG     | UNDERGROUND                 | — | EXISTING STORM DRAINAGE                     |
| WCR    | WHEELCHAIR RAMP             | — | NEW STORM DRAINAGE                          |
| W/L    | WATER LINE                  | — | NEW WATER LINE                              |
| WM     | WATER METER                 | — | NEW SANITARY SEWER                          |
| YI     | YARD INLET                  | — | NEW SANITARY SEWER FORCE MAIN               |
|        |                             | — | NEW GAS MAIN                                |
|        |                             | — | HANDICAPPED ACCESSIBLE ROUTE                |

NOTE: ALL CONSTRUCTION ACTIVITY MUST BE IN ACCORDANCE WITH THE ACCEPTED POLICIES OF THE TOWN OF ROLESVILLE AND NCDOT


# COBBLESTONE VILLAGE

## MIXED USE DEVELOPMENT

TOWN OF ROLESVILLE, WAKE COUNTY, NORTH CAROLINA

# CONSTRUCTION DRAWINGS

## TOWN OF ROLESVILLE PROJECT NO. SITE PLAN APPLICATION NO. CUP-SB-21-01

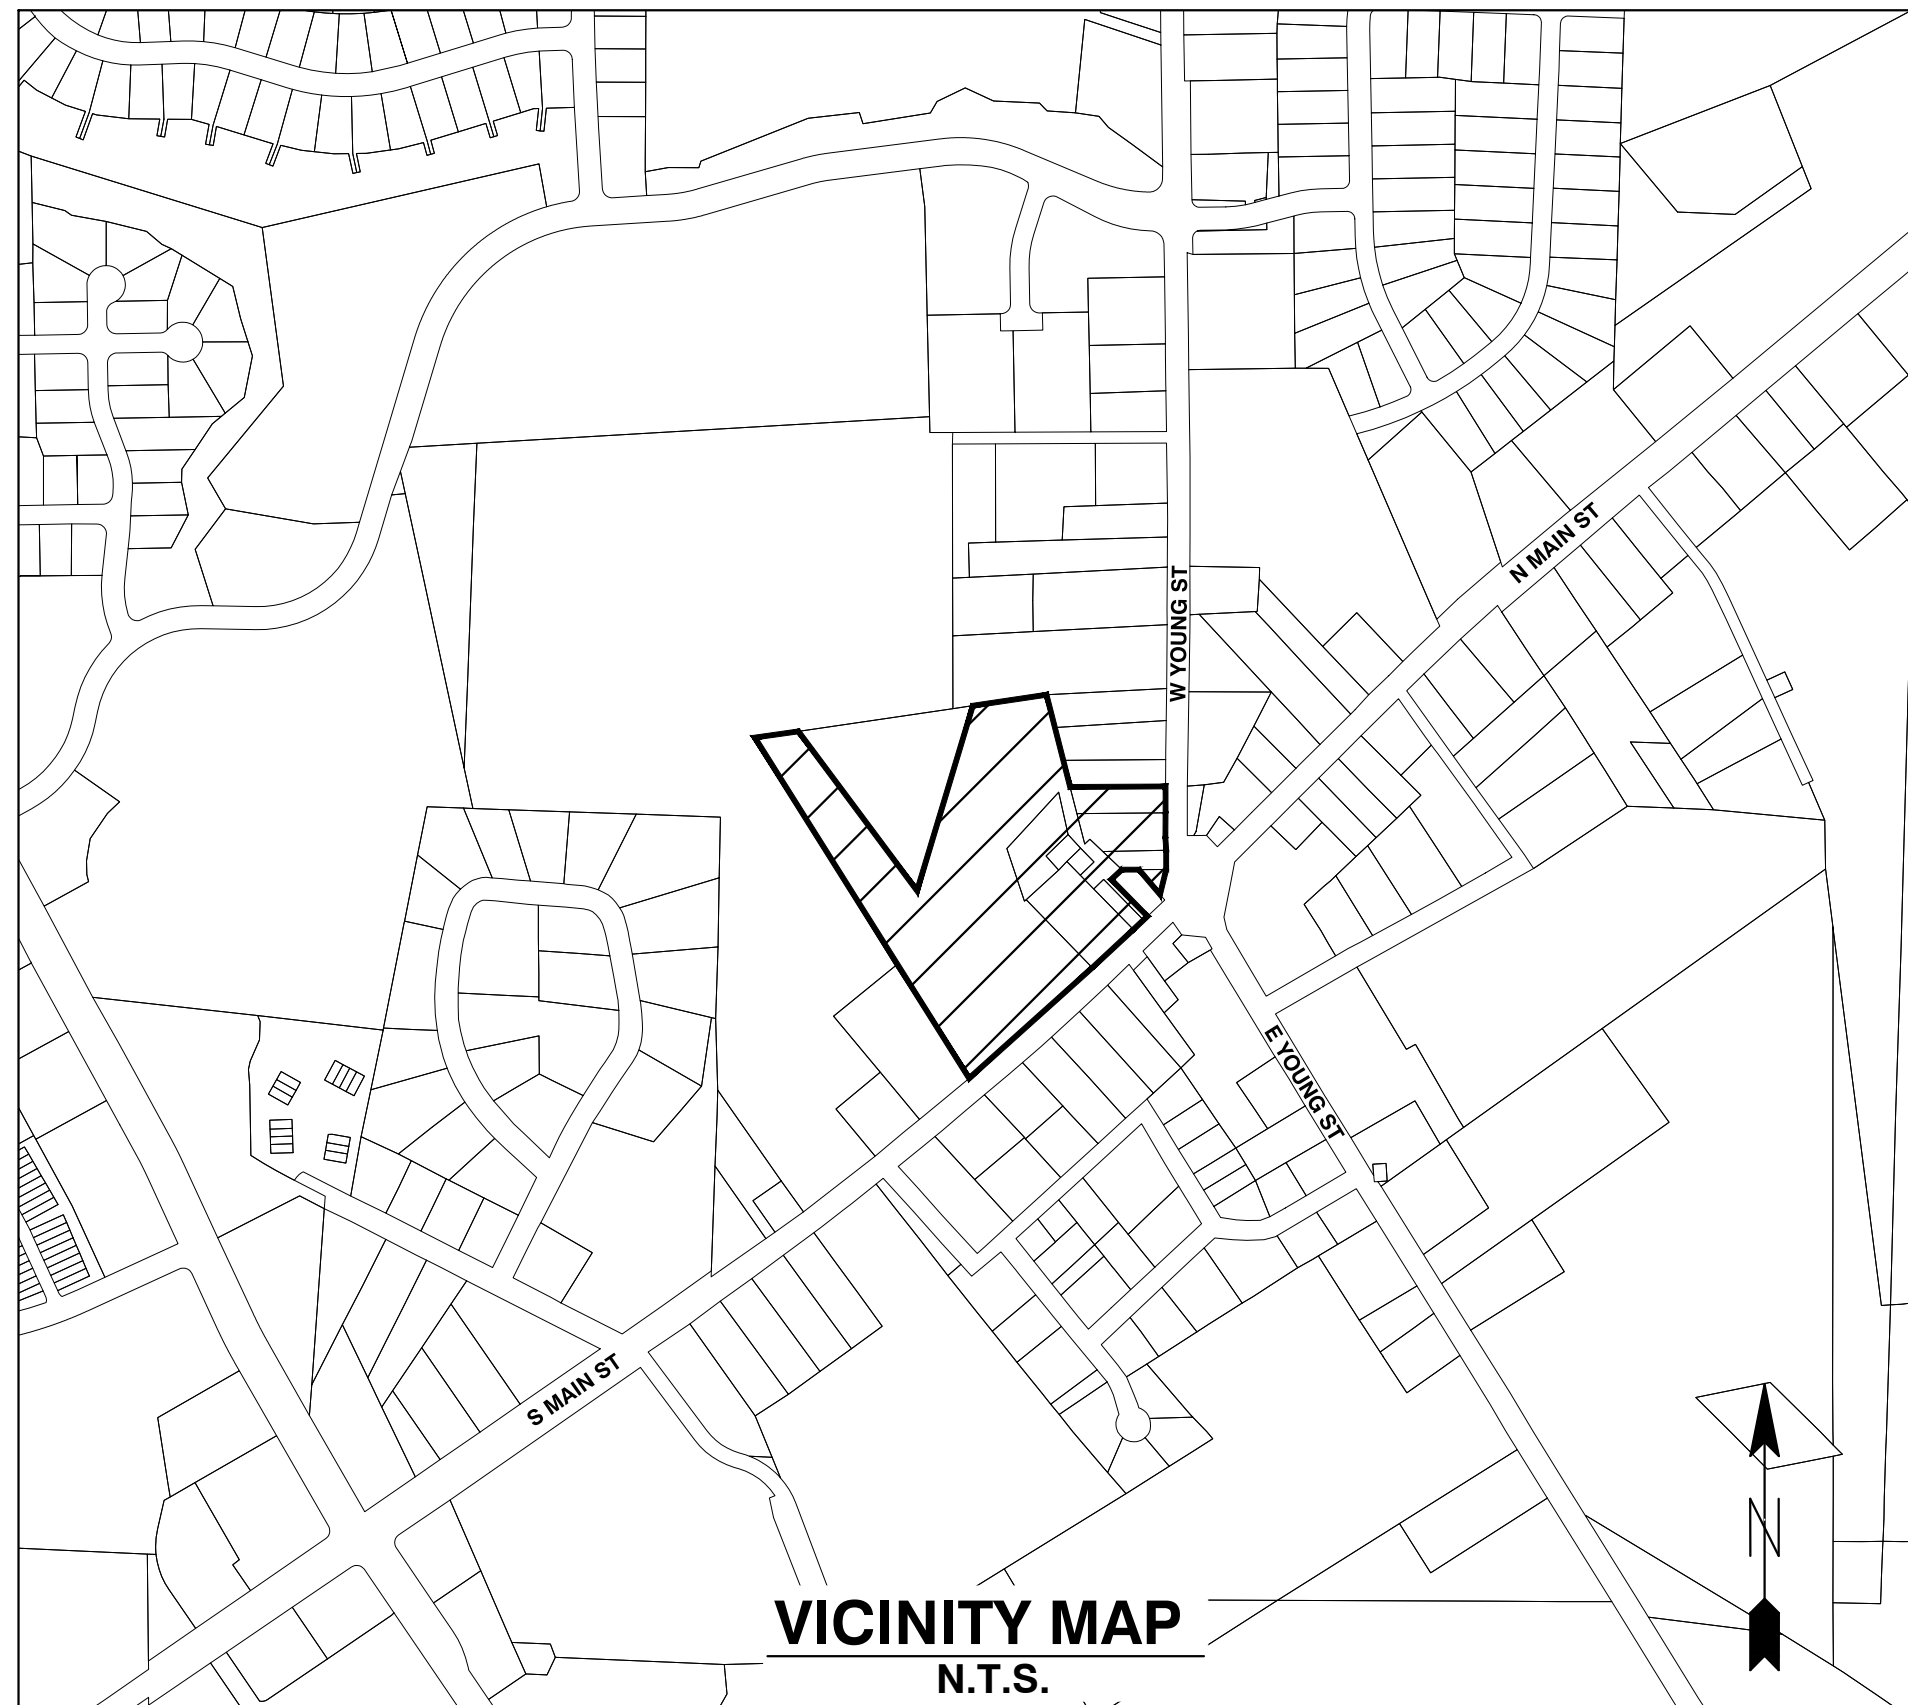

**Public**  
**Water Distribution / Extension System**  
The City of Raleigh consents to the connection and extension of the City's public water system as shown on this plan. The material and construction methods used for this project shall conform to the standards and specifications of the City's Public Utilities Handbook.  
City of Raleigh  
Public Utilities Department Permit # W-3879  
Authorization to Construct See digital signature

**Private**  
**Sewer Collection / Extension System**  
The City of Raleigh consents to the connection to its public sewer system and extension of the private sewer collection system as shown on this plan. The material and construction methods used for this project shall conform to the standards and specifications of the City's Public Utilities Handbook.  
City of Raleigh  
Public Utilities Department Permit # S-4962 (P)  
Authorization to Construct See digital signature

### SITE PERMITTING APPROVAL

**Water and Sewer Permits (if applicable)**  
The City of Raleigh consents to the connection and extension of the City's Public Sewer System as shown on this plan. The material and construction methods used for this project shall conform to the standards and specifications of the City's Public Utilities Handbook. City of Raleigh Public Utilities Department Permit # W-3879  
The City of Raleigh consents to the connection and extension of the City's Public Water System as shown on this plan. The material and construction methods used for this project shall conform to the standards and specifications of the City's Public Utilities Handbook. City of Raleigh Public Utilities Department Permit # S-4962 (P)  
The City of Raleigh consents to the connection to its public sewer system and extension of the private sewer collection system as shown on this plan. The material and construction methods used for this project shall conform to the standards and specifications of the City's Public Utilities Handbook.  
City of Raleigh Public Utilities Department Permit #

CITY OF RALEIGH - PLANS AUTHORIZED FOR CONSTRUCTION  
Electronic Approval: This approval is being issued electronically. This approval is valid only upon the signature of a City of Raleigh Review Officer below. The City will retain a copy of the approved plans. Any work authorized by this approval must proceed in accordance with the plans kept on file with the City. This electronic approval may not be relied upon issued. Any modification to this approval once issued will invalidate this approval.  
City of Raleigh Development Approval \_\_\_\_\_  
Raleigh Water Review Officer

**OWNER:**  
**TOWN OF ROLESVILLE**  
P.O. BOX 250  
ROLESVILLE, NC 27571-0250

**DEVELOPER:**  
**KDM DEVELOPMENT CORPORATION**  
1080 PITTSFORD VICTOR RD, STE 202  
PITTSFORD NY 14534-3805

**CONTACT: KENYON BURHNAM**  
**PHONE: 585-465-0099**  
**EMAIL: KBURNHA2@U.ROCHESTER.EDU**

## SHEET INDEX

|               |  |
|---------------|--|
| <b>COVER</b>  |  |
| <b>C0.1</b>   | <b>EXISTING CONDITIONS &amp; DEMOLITION PLAN</b> |
| <b>C1.1</b>   | <b>SITE PLAN</b>                                 |
| <b>C2.1</b>   | <b>UTILITY PLAN</b>                              |
| <b>C3.1</b>   | <b>GRADING AND DRAINAGE PLAN</b>                 |
| <b>C3.2</b>   | <b>BMP DETAILS</b>                               |
| <b>C3.3</b>   | <b>EROSION CONTROL PLAN - STAGE 1</b>            |
| <b>C3.4</b>   | <b>EROSION CONTROL PLAN - STAGE 2</b>            |
| <b>C3.5</b>   | <b>EROSION CONTROL DETAILS</b>                   |
| <b>C3.6</b>   | <b>EROSION CONTROL DETAILS</b>                   |
| <b>C3.7</b>   | <b>NGC01 PLAN</b>                                |
| <b>C3.8</b>   | <b>STORM DRAINAGE PIPE &amp; STRUCTURE TABLE</b> |
| <b>C4.1</b>   | <b>PUBLIC WATERLINE PROFILE</b>                  |
| <b>C4.2</b>   | <b>SANITARY SEWER PROFILE</b>                    |
| <b>L1.1</b>   | <b>LANDSCAPE PLAN</b>                            |
| <b>SL-101</b> | <b>LIGHTING PLAN</b>                             |
| <b>C5.1</b>   | <b>DETAILS</b>                                   |
| <b>C5.2</b>   | <b>DETAILS</b>                                   |
| <b>C5.3</b>   | <b>DETAILS</b>                                   |
| <b>C5.4</b>   | <b>DETAILS</b>                                   |
| <b>C5.5</b>   | <b>DETAILS</b>                                   |
| <b>A2.21</b>  | <b>EXTERIOR ELEVATIONS - BLDG 2</b>              |
| <b>A2.22</b>  | <b>EXTERIOR ELEVATIONS - BLDG 2</b>              |
| <b>A2.31</b>  | <b>EXTERIOR ELEVATIONS - BLDG 3</b>              |
| <b>A2.32</b>  | <b>EXTERIOR ELEVATIONS - BLDG 3</b>              |
| <b>A2.51</b>  | <b>EXTERIOR ELEVATIONS - BLDG 5</b>              |
| <b>A2.61</b>  | <b>EXTERIOR ELEVATIONS - BLDG 6</b>              |
| <b>A2.62</b>  | <b>EXTERIOR ELEVATIONS - BLDG 6</b>              |
| <b>A2.71</b>  | <b>EXTERIOR ELEVATIONS - BLDGS 1 &amp; 7</b>     |
| <b>A2.72</b>  | <b>EXTERIOR ELEVATIONS - BLDGS 1 &amp; 7</b>     |
| <b>A2.81</b>  | <b>EXTERIOR ELEVATIONS - BLDG 8</b>              |

## CONSTRUCTION NOTES


- ALL CONSTRUCTION SHALL BE IN ACCORDANCE WITH APPLICABLE MUNICIPALITY STANDARDS, SPECIFICATIONS, AND DETAILS. WORK IN THIS PROJECT SHALL ALSO CONFORM TO THESE PLANS, THE LATEST EDITIONS OF THE NORTH CAROLINA DEPARTMENT OF TRANSPORTATION (NCDOT) ROAD AND BRIDGE SPECIFICATIONS, THE ROAD AND BRIDGE STANDARDS, THE NORTH CAROLINA EROSION AND SEDIMENT CONTROL HANDBOOK, THE NORTH CAROLINA EROSION AND SEDIMENT CONTROL REGULATIONS, THE FINAL GEOTECHNICAL REPORT, AND GENERAL DESIGN STANDARDS. IN THE EVENT OF CONFLICT BETWEEN ANY OF THESE STANDARDS, SPECIFICATIONS, OR THE MOST STRINGENT SHALL GOVERN.
- THE CONTRACTOR SHALL BE SOLELY RESPONSIBLE FOR TRENCH SAFETY DURING ALL PHASES OF CONSTRUCTION.
- THE LOCATION AND SIZE OF EXISTING UTILITIES AS SHOWN IS APPROXIMATE ONLY. THE CONTRACTOR IS RESPONSIBLE FOR HORIZONTALLY AND VERTICALLY LOCATING AND PROTECTING ALL PUBLIC OR PRIVATE UTILITIES WHICH LIE IN OR ADJACENT TO THE CONSTRUCTION SITE. AT LEAST 48 HOURS PRIOR TO ANY DEMOLITION, GRADING, OR CONSTRUCTION ACTIVITY, THE CONTRACTOR SHALL NOTIFY THE NORTH CAROLINA ONE-CALL UTILITIES LOCATION SERVICE (1-800-632-4949 FOR PROPER IDENTIFICATION OF EXISTING UTILITIES WITHIN THE SITE.
- THE CONTRACTOR SHALL SALVAGE AND PROTECT ALL EXISTING POWER POLES, SIGNS, MANHOLES, TELEPHONE RISERS, WATER VALVES, ETC. DURING ALL CONSTRUCTION PHASES. THE CONTRACTOR SHALL REPAIR, AT HIS OWN EXPENSE, ANY EXISTING UTILITIES DAMAGED DURING CONSTRUCTION.
- TRAFFIC CONTROL ON PUBLIC STREETS SHALL BE IN CONFORMANCE WITH THE TRAFFIC CONTROL PLAN, THE MANUAL OF UNIFORM TRAFFIC CONTROL DEVICES, AND AS FURTHER DIRECTED BY CITY AND STATE INSPECTORS.
- ANY DISCREPANCIES FOUND BETWEEN THE DRAWINGS AND SPECIFICATIONS AND SITE CONDITIONS OR ANY INCONSISTENCIES OR AMBIGUITIES IN DRAWINGS OR SPECIFICATIONS SHALL BE IMMEDIATELY REPORTED TO THE ENGINEER, IN WRITING, WHO SHALL PROMPTLY ADDRESS SUCH INCONSISTENCIES OR AMBIGUITIES. WORK DONE BY THE CONTRACTOR AFTER HIS DISCOVERY OF SUCH DISCREPANCIES, INCONSISTENCIES, OR AMBIGUITIES SHALL BE DONE AT THE CONTRACTOR'S RISK.
- A PRE-CONSTRUCTION CONFERENCE SHALL BE HELD PRIOR TO THE START OF CONSTRUCTION. THE CONTRACTOR SHALL ARRANGE THE MEETING WITH THE CITY ENGINEERING DIVISION.
- CONTRACTOR IS RESPONSIBLE FOR VERIFYING ALL REQUIRED PERMITS AND APPROVALS PRIOR TO COMMENCING CONSTRUCTION.
- ALL AREAS SHALL BE GRADED FOR POSITIVE DRAINAGE, AND AS SHOWN ON THESE PLANS, THE CONTRACTOR SHALL MAINTAIN ADEQUATE SITE DRAINAGE DURING ALL PHASES OF CONSTRUCTION. THE CONTRACTOR SHALL USE SILT FENCES (OR OTHER METHODS APPROVED BY THE ENGINEER AND APPLICABLE MUNICIPALITY) AS REQUIRED TO PREVENT SILT AND CONSTRUCTION DEBRIS FROM FLOWING ONTO ADJACENT PROPERTIES. CONTRACTOR SHALL COMPLY WITH ALL APPLICABLE FEDERAL, STATE, OR LOCAL EROSION, CONSERVATION, AND SILTATION ORDINANCES. CONTRACTOR SHALL REMOVE ALL TEMPORARY EROSION CONTROL DEVICES UPON COMPLETION OF PERMANENT DRAINAGE FACILITIES AND THE ESTABLISHMENT OF A STAND OF GRASS OR OTHER GROWTH TO PREVENT EROSION.
- THE CONTRACTOR SHALL CLEAR AND GRUB THE SITE AND PLACE, COMPACT, AND MOISTURE CONDITION ALL FILL PER THE PROJECT GEOTECHNICAL ENGINEER'S SPECIFICATIONS. THE FILL MATERIAL TO BE USED SHALL BE APPROVED BY THE GEOTECHNICAL ENGINEER PRIOR TO PLACEMENT.
- MATERIALS USED TO CONSTRUCT EMBANKMENTS FOR ANY PURPOSE, BACKFILL AROUND DRAINAGE STRUCTURES, OR IN UTILITY TRENCHES FOR ANY OTHER DEPRESSION REQUIRING FILL OR BACKFILL SHALL BE COMPACTED TO 95% OF MAXIMUM DENSITY AS DETERMINED BY THE STANDARD PROCTOR TEST AS SET OUT IN ASTM STANDARD D998. STONE BACKFILL SHALL BE COMPACTED TO 95% MAXIMUM DENSITY AS DETERMINED BY THE MODIFIED PROCTOR TEST AS SET OUT IN ASTM STANDARD D1557. THE CONTRACTOR SHALL, PRIOR TO ANY OPERATIONS INVOLVING FILLING OR BACKFILLING, SUBMIT THE RESULTS OF THE PROCTOR TEST TOGETHER WITH A CERTIFICATION THAT THE SOIL TESTED IS REPRESENTATIVE OF THE MATERIALS TO BE USED ON THE PROJECT. TESTS SHALL BE CONDUCTED BY A CERTIFIED MATERIALS TESTING LABORATORY AND THE CERTIFICATIONS MADE BY A LICENSED PROFESSIONAL ENGINEER REPRESENTING THE LABORATORY.
- PROPOSED CONTOURS AND GUTTER GRADIENTS ARE APPROXIMATE. PROPOSED SPOT ELEVATIONS AND ROADWAY PROFILES/SUPERELEVATIONS ARE TO BE USED IN CASE OF DISCREPANCY.
- THE CONTRACTOR SHALL REVIEW, VERIFY AND COORDINATE ALL DIMENSIONS SHOWN ON PLANS, INCLUDING THE HORIZONTAL AND VERTICAL LOCATION OF CURB INLETS AND GRATE INLETS AND ALL UTILITIES CROSSING THE STORM SEWER PRIOR TO STARTING PROJECT.
- ALL CURB JOINTS SHALL EXTEND THROUGH THE CURB. MINIMUM LENGTH OF OFFSET JOINTS AT RADIUS POINTS IS 1.5 FEET. ALL JOINTS SHALL BE SEALED WITH JOINT SEALANT.
- ALL HANDICAP RAMPING, STRIPING, AND PAVEMENT MARKINGS SHALL CONFORM TO ADA REQUIREMENTS AND THE 'NORTH CAROLINA STATE BUILDING CODE, VOL. 1-C ACCESSIBILITY CODE.
- OWNER SHALL PROVIDE FENCING AND OTHER SAFETY MEASURES NECESSARY IN AND AROUND ANY PROPOSED STORMWATER MANAGEMENT MEASURES (PONDS, WETLANDS, ETC.) OBTAINING PROPER PERMITS SHALL BE THE RESPONSIBILITY OF THE OWNER.
- RETAINING WALLS EXCEEDING 30 INCHES IN HEIGHT SHALL INCLUDE FALL PROTECTION IN THE FORM OF A HANDRAIL OR FENCING ON THE HIGH SIDE OF THE RETAINING WALL.
- PROPER COMPACTION OF ALL FILL SOILS PLACED ON SITE SHALL BE THE RESPONSIBILITY OF THE CONTRACTOR. COMPACTION SHALL BE ADEQUATE TO SUPPORT THE PROPOSED USE OF AREAS IN WHICH FILL SOILS ARE PLACED. THE CONTRACTOR SHALL HIRE A GEOTECHNICAL ENGINEER TO TEST AND VERIFY THAT COMPACTION IS ADEQUATE FOR THE PROPOSED USE OF THE AREA OF FILL PLACEMENT.
- ALL ASPECTS OF THIS PROJECT SHALL BE IN FULL COMPLIANCE WITH CURRENT ADA STANDARDS. IF THE CONTRACTOR NOTES ANY ASPECTS OF THE PROJECT WHICH ARE NOT IN COMPLIANCE, THE ENGINEER SHALL BE NOTIFIED PRIOR TO ANY FURTHER WORK BEING PERFORMED. ANY WORK PERFORMED AFTER THE CONTRACTOR NOTES SUCH A NON COMPLIANCE IS SUBJECT TO REMOVAL AND REPAIR AT THE CONTRACTOR'S EXPENSE.
- THE CONTRACTOR OR OWNER SHALL EMPLOY A GEOTECHNICAL ENGINEER TO TEST ALL EMBANKMENTS AND FILL PLACEMENT FOR PROPER COMPACTION. PROPER COMPACTION SHALL BE PER THE GEOTECHNICAL ENGINEER'S RECOMMENDATIONS OR THESE PLANS, WHICHEVER IS MORE STRINGENT. EMBANKMENTS FOR PONDS SHALL BE PLACED IN 6 INCH LOOSE LAYERS AND SHALL BE COMPACTED TO A DENSITY OF NO LESS THAN 95% OF THE STANDARD PROCTOR MAXIMUM DENSITY AT A MOISTURE CONTENT OF 4% OR TWO PERCENTAGE POINTS OF THE OPTIMUM MOISTURE CONTENT IN ACCORDANCE WITH ASTM D998. THE CONTRACTOR SHALL TAKE PHOTOGRAPHS OF THE OUTLET STRUCTURE AT ALL AT ALL PHASES OF INSTALLATION AND SHALL RETAIN WITH GEOTECHNICAL TESTING DATA. THE CONTRACTOR SHALL ALSO RETAIN ALL SHIPPING RECORDS AND SPECIFICATIONS FOR THE OUTLET STRUCTURE MATERIALS AND STRUCTURES. ALL OF THE ABOVE DATA MAY BE REQUIRED AS PART OF THE MUNICIPALITY AS-BUILT PROCESS AND SHALL BE MADE AVAILABLE TO THE ENGINEER UPON REQUEST. THE CONTRACTOR AND OWNER SHALL HAVE DOCUMENTATION OF THESE TESTS AVAILABLE UPON REQUEST.
- RETAINING WALLS SHOWN HEREIN SHALL BE DESIGNED BY A QUALIFIED PROFESSIONAL ENGINEER WITH EXPERIENCE DESIGNING RETAINING WALLS. AT LEAST 14 DAYS PRIOR TO BEGINNING CONSTRUCTION OF RETAINING WALLS, THE CONTRACTOR SHALL CONTACT THE OWNER'S GEOTECHNICAL ENGINEER TO SCHEDULE AND COORDINATE ALL APPROPRIATE INSPECTIONS, TESTING, AND VERIFICATION NECESSARY DURING RETAINING WALL CONSTRUCTION. THE GEOTECHNICAL ENGINEER SHALL PROVIDE CONTINUOUS INSPECTION, TESTING AND VERIFICATION FOR THE DURATION OF RETAINING WALL CONSTRUCTION. PROPER SCHEDULING, EXECUTION, AND RECORD KEEPING FOR ALL REQUIRED INSPECTIONS, TESTING, AND VERIFICATION SHALL BE THE RESPONSIBILITY OF THE CONTRACTOR. SUCH RECORDS SHALL BE RETAINED AND SHALL BE PROVIDED TO THE OWNER AND BASS, NIXON & KENNEDY, INC. ALL MONITORING, TESTING, AND VERIFICATION SHALL CONFORM TO THE MOST RECENT VERSION OF THE NC BUILDING CODE CHAPTER 18, SECTION 1806 OR THE WALL DESIGN ENGINEER'S SPECIFICATIONS, WHICHEVER IS MORE STRINGENT.



## QUANTITY SUMMARY

|                           |      |
|---------------------------|------|
| PHASE NUMBER(S)           | 1    |
| NUMBER OF LOT(S)          | 1    |
| LOT NUMBER(S) BY PHASE    | N/A  |
| NUMBER OF UNITS           | 180  |
| LIVABLE BUILDINGS         | 6    |
| OPEN SPACE (AC)           | 2.32 |
| NUMBER OF OPEN SPACE LOTS | N/A  |
| PUBLIC WATER (LF)         | 875  |
| PRIVATE SEWER (LF)        | 550  |
| PUBLIC STREET (LF)        | 0    |
| PUBLIC SIDEWALK (LF)      | 0    |

## ENGINEER:

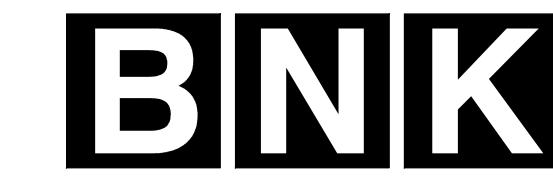

**BASS, NIXON & KENNEDY, INC.**  
**CONSULTING ENGINEERS**  
6310 CHAPEL HILL ROAD, SUITE 250  
RALEIGH, NORTH CAROLINA 27607  
TELEPHONE: (919) 851-4422  
FAX: (919) 851-8968

**CERTIFICATION NUMBERS: NCBELS (C-0110) NCBOLA (C-0267)**

**CONTACT: MARTY D. BIZZELL, PE, CPESC**  
**EMAIL: Marty.Bizzell@BNKinc.com**



## EROSION CONTROL, STORMWATER AND FLOODPLAIN MANAGEMENT


**APPROVED**  
EROSION CONTROL  S-\_\_\_\_\_  
STORMWATER MGMT.  S-\_\_\_\_\_  
FLOOD STUDY  S-\_\_\_\_\_  
DATE \_\_\_\_\_



CITY OF RALEIGH - PLANS AUTHORIZED FOR CONSTRUCTION

Electronic Approval: This approval is being issued electronically. This approval is valid only upon the signature of a City of Raleigh Review Officer below. The City will retain a copy of the approved plans. Any work authorized by this approval must proceed in accordance with the plans kept on file with the City. This electronic approval may not be edited once issued. Any modification to this approval once issued will invalidate this approval.

City of Raleigh Development Approval \_\_\_\_\_  
 Raleigh Water Review Officer \_\_\_\_\_

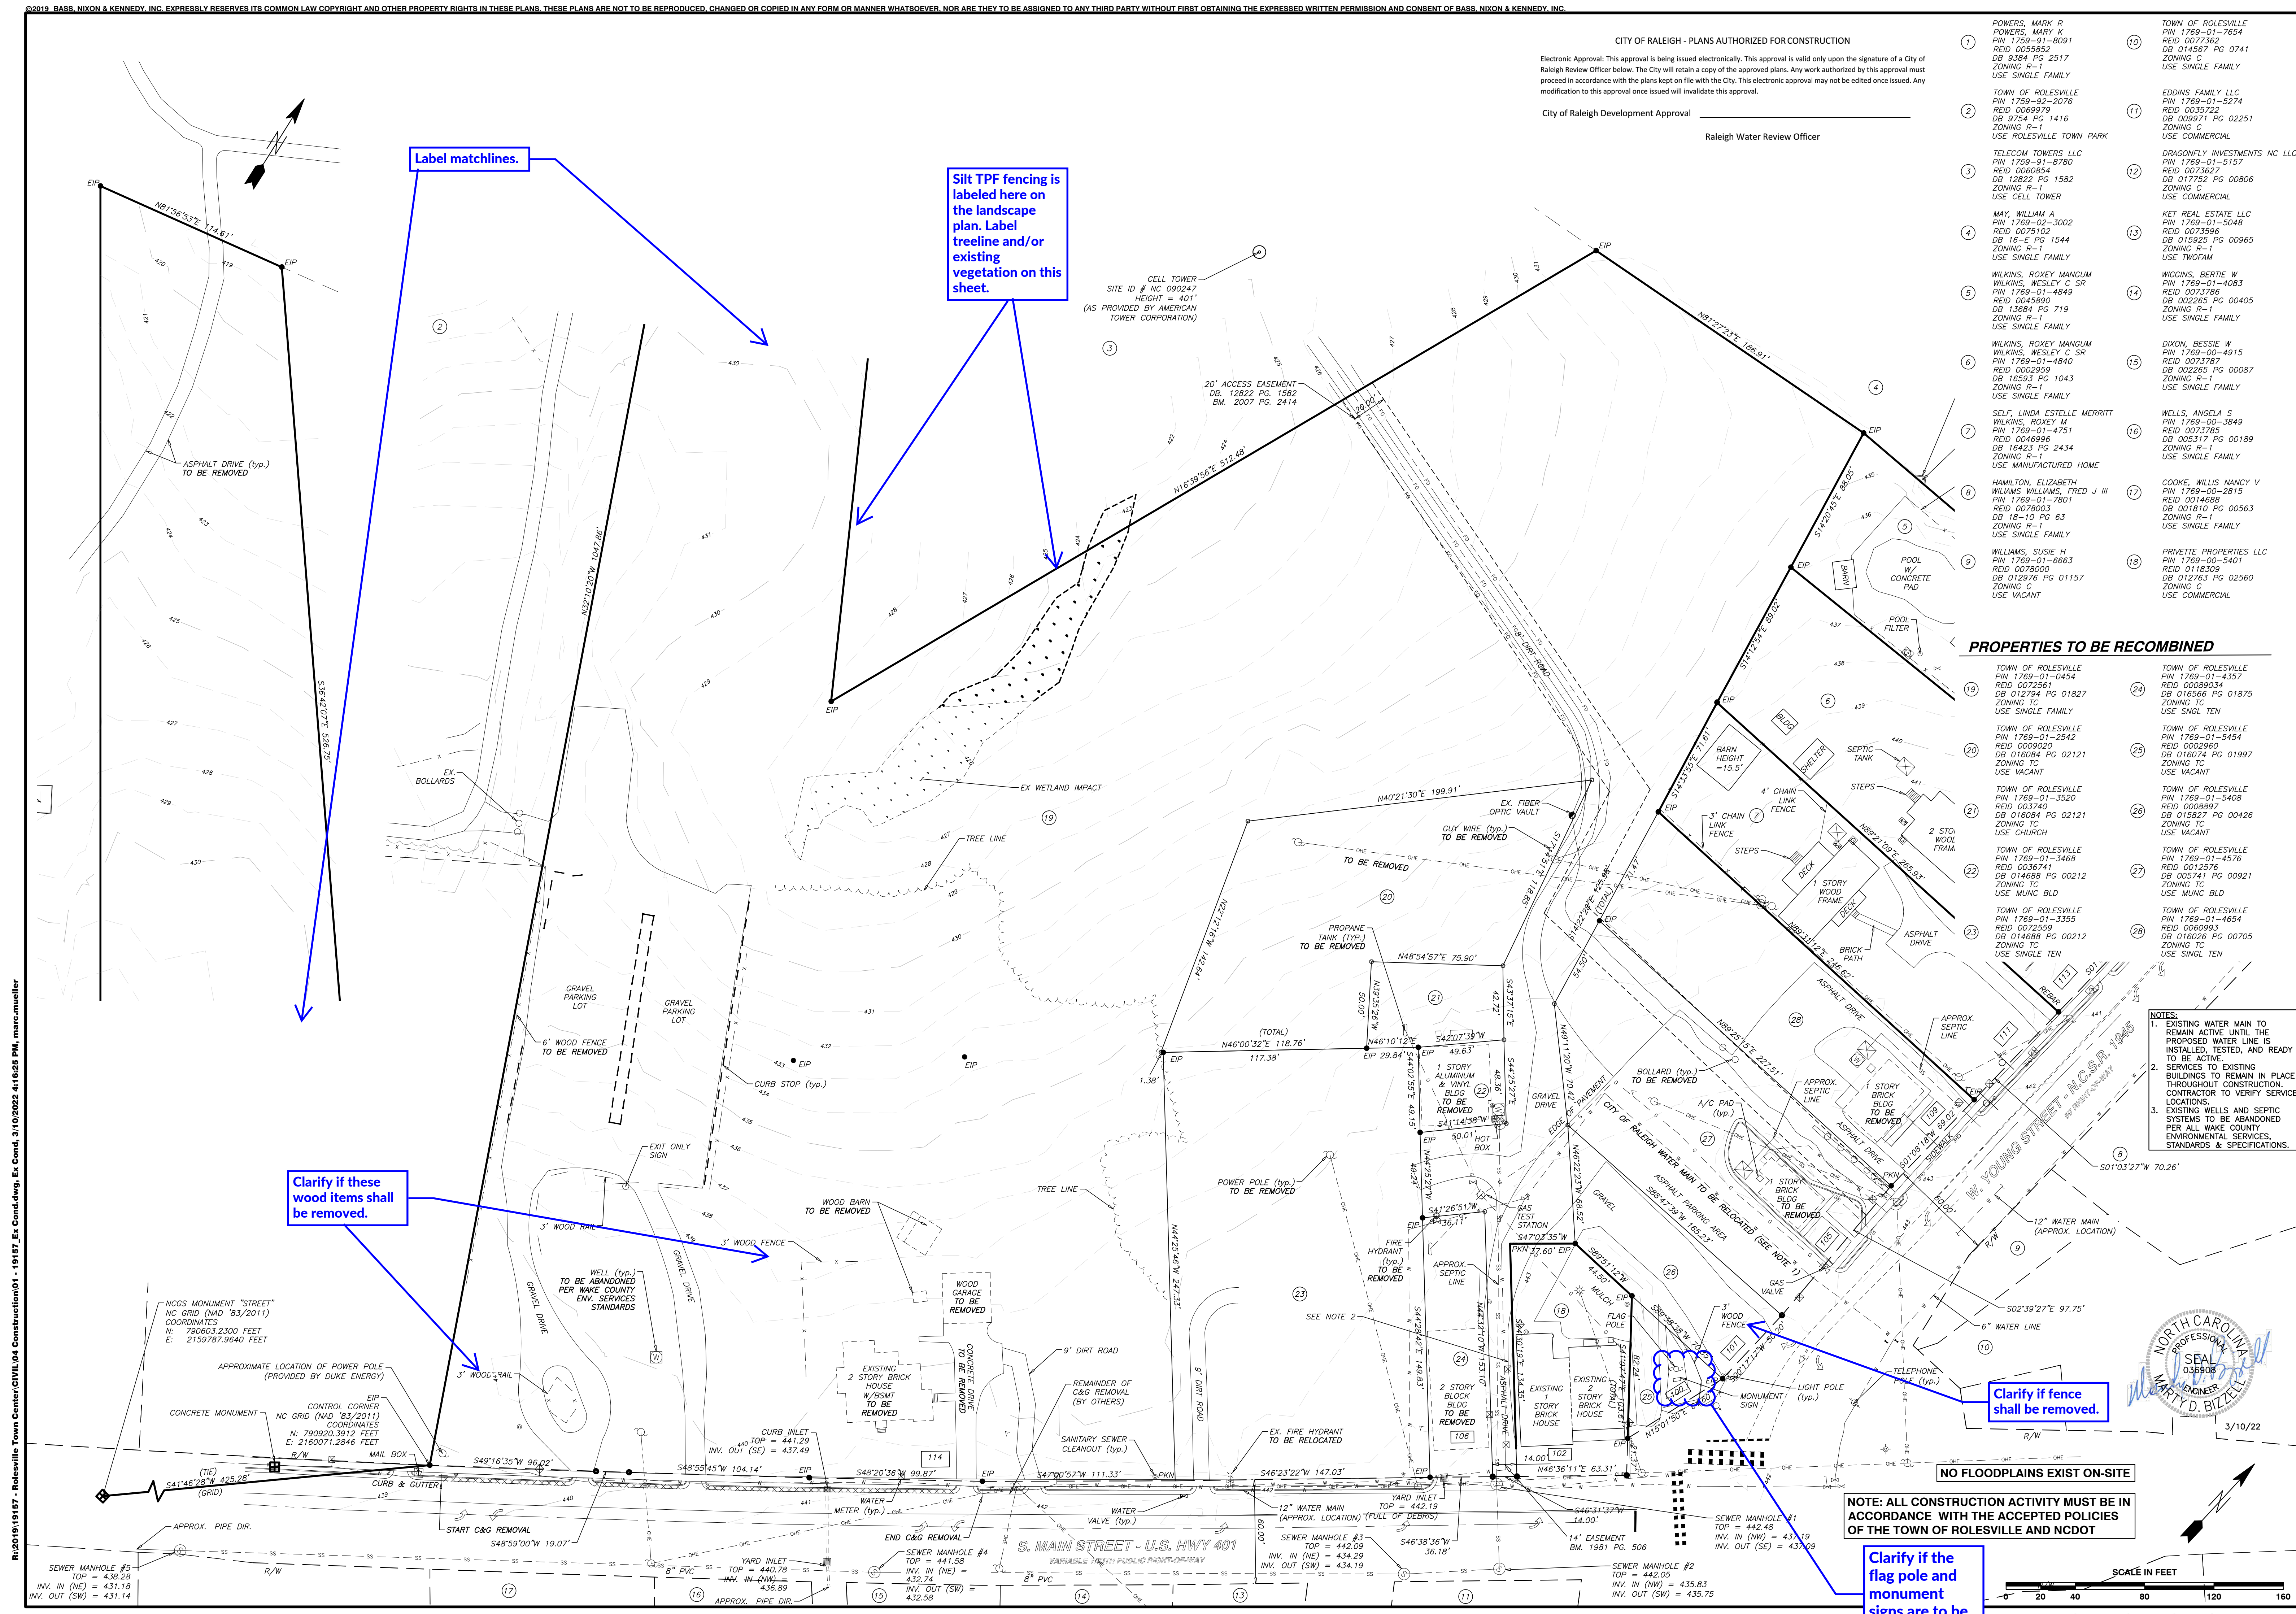

Label matchlines.

Silt TPF fencing is labeled here on the landscape plan. Label treeline and/or existing vegetation on this sheet.

Clarify if these wood items shall be removed.

Clarify if fence shall be removed.

Clarify if the flag pole and monument signs are to be removed.


PROPERTIES TO BE RECOMBINED

|    |   |    |   |
|----|---|----|---|
| 19 | TOWN OF ROLESVILLE<br>PIN 1769-01-0454<br>REID 00089020<br>DB 016084 PG 02121<br>ZONING TC<br>USE VACANT    | 24 | TOWN OF ROLESVILLE<br>PIN 1769-01-2542<br>REID 00090260<br>DB 016074 PG 01997<br>ZONING TC<br>USE VACANT    |
| 20 | TOWN OF ROLESVILLE<br>PIN 1769-01-3520<br>REID 003740<br>DB 016084 PG 02121<br>ZONING TC<br>USE CHURCH      | 25 | TOWN OF ROLESVILLE<br>PIN 1769-01-5408<br>REID 0008897<br>DB 015827 PG 00426<br>ZONING TC<br>USE VACANT     |
| 21 | TOWN OF ROLESVILLE<br>PIN 1769-01-3468<br>REID 0036741<br>DB 014688 PG 00212<br>ZONING TC<br>USE MUNC BLD   | 26 | TOWN OF ROLESVILLE<br>PIN 1769-01-4576<br>REID 0012576<br>DB 005741 PG 00921<br>ZONING TC<br>USE MUNC BLD   |
| 22 | TOWN OF ROLESVILLE<br>PIN 1769-01-3468<br>REID 0036741<br>DB 014688 PG 00212<br>ZONING TC<br>USE SINGLE TEN | 27 | TOWN OF ROLESVILLE<br>PIN 1769-01-4654<br>REID 0002559<br>DB 014688 PG 00212<br>ZONING TC<br>USE SINGLE TEN |
| 23 | TOWN OF ROLESVILLE<br>PIN 1769-01-3468<br>REID 0036741<br>DB 014688 PG 00212<br>ZONING TC<br>USE SINGLE TEN | 28 | TOWN OF ROLESVILLE<br>PIN 1769-01-4654<br>REID 0002559<br>DB 014688 PG 00212<br>ZONING TC<br>USE SINGLE TEN |

- NOTES:
- EXISTING WATER MAIN TO REMAIN ACTIVE UNTIL THE PROPOSED WATER LINE IS INSTALLED, TESTED, AND READY TO BE ACTIVE.
  - SERVICES TO EXISTING BUILDINGS TO REMAIN IN PLACE THROUGHOUT CONSTRUCTION. CONTRACTOR TO VERIFY SERVICE LOCATIONS.
  - EXISTING WELLS AND SEPTIC SYSTEMS TO BE ABANDONED PER ALL WAKE COUNTY ENVIRONMENTAL SERVICES, STANDARDS & SPECIFICATIONS.



NOTE: ALL CONSTRUCTION ACTIVITY MUST BE IN ACCORDANCE WITH THE ACCEPTED POLICIES OF THE TOWN OF ROLESVILLE AND NCDOT

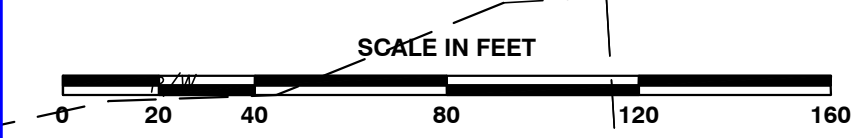

**BASS, NIXON & KENNEDY, INC.**  
 CONSULTING ENGINEERS  
 6310 CHAPEL HILL ROAD, SUITE 250, RALEIGH, NC 27607  
 TELEPHONE: (919) 881-4422 FAX: (919) 881-6886  
 CERTIFICATION NUMBERS: NCBELS (C-0110); NCBOLA (C-0267)

| NO. | DATE | DESCRIPTION | BY |
|-----|------|-------------|----|
|     |      |             |    |
|     |      |             |    |
|     |      |             |    |

PROGRESS DRAWN BY: MRM  
 DATE: 03-18-22  
 JOB NO.: 19187-EX-CON-DEM-PLN  
 EXISTING CONDITIONS & DEMOLITION PLAN  
 SCALE: 1" = 40'  
 CHK BY: MDB

**COBBLESTONE VILLAGE MIXED USE DEVELOPMENT**  
 TOWN OF ROLESVILLE, WAKE COUNTY, NORTH CAROLINA

SHEET **C0.1**

TOWN OF ROLESVILLE PROJECT NO. \_\_\_\_\_

NOT RELEASED FOR CONSTRUCTION OR BID SOLICITATION

- CONDITIONS OF APPROVAL:**
1. TECHNICAL REVIEW COMMITTEE APPROVAL AND ISSUANCE OF REQUIRED PERMITS FROM ALL AGENCIES MUST BE ACHIEVED AND SUBMITTED FOR REVIEW AND RECORD RETENTION PRIOR TO FINAL SIGNATURE AND APPROVAL OF THE SITE PLAN.
  2. CROSS-CONNECTION ACCESS TO ONE OF THE THREE ADJACENT PROPERTIES TO THE EAST ALONG W. YOUNG STREET (111, 113, AND 115 W. YOUNG STREET) FOR FUTURE DEVELOPMENT WILL BE PROVIDED.
  3. BEST EFFORTS WILL BE MADE FOR GREENWAY ACCESS ACROSS THE TELECOM TOWERS, LLC SITE FOR PEDESTRIAN TRAFFIC FROM OVERFLOW PARKING SITE LOCATED AT THE TERMINUS OF SCARBORO STREET IN MAIN STREET PARK.
  4. BASED UPON TESTIMONY REGARDING SHARED PARKING IN A MIXED-USE DEVELOPMENT, A 15% PARKING REDUCTION IS GRANTED RESULTING IN 467 REQUIRED SPACES.
  5. A MAXIMUM HEIGHT OF 60 FEET IS APPROVED PER THE BUILDING HEIGHT DESIGN ALTERNATIVE FOR THE SITE AS SHOWN ON THE SITE PLAN, PROVIDED ALL OTHER APPLICABLE STANDARDS ACCORDING TO THE LDO ARE MET.

Include height, square footage, and FFE for all buildings. Buildings 2, 4, and 6 do not include values.

Provide bicycle rack detail.

The cover sheet states there shall be 2.32 acres of open space. On the plan sheet, label open space locations as well as the size of each space



CITY OF RALEIGH - PLANS AUTHORIZED FOR CONSTRUCTION

Electronic Approval: This approval is being issued electronically. This approval is valid only upon the signature of a City of Raleigh Review Officer below. The City will retain a copy of the approved plans. Any work authorized by this approval must proceed in accordance with the plans kept on file with the City. This electronic approval may not be edited once issued. Any modification to this approval once issued will invalidate this approval.


City of Raleigh Development Approval \_\_\_\_\_  
 Raleigh Water Review Officer \_\_\_\_\_

**OVERALL SITE DATA**

|  |  |
|--|--|
| SITE AREA  | 10.96 AC (477,418 SF±)   |
| P.I.N.   | 1769-01-0454, 1769-01-4357, 1769-01-3355<br>1769-01-3468, 1769-01-2542, 1769-01-3520<br>1769-01-4654, 1769-01-5454, 1769-01-5408, 1769-01-4576 |
| ZONING DISTRICT:   | TOWN CENTER (TC)<br>RESIDENTIAL, MIXED USE   |
| OPEN SPACE AREA  | 3.48 AC  |
| IMPERVIOUS AREA:   | 7.48 AC  |
| IMPERVIOUS AREA (%):   | 68%  |
| APARTMENT MIX  | 112 UNITS  |
| 1 BEDROOM  | 64 UNITS   |
| 2 BEDROOM  | 176 UNITS  |
| TOTAL APARTMENTS   |  |
| RESIDENTIAL DENSITY:   | 16.06 UNITS/ACRE   |
| RETAIL/COMMERCIAL:   | 49,830 SQUARE FEET   |
| MUNICIPAL FLEX SPACE:  | 15,900 SQUARE FEET   |
| TOTAL:   | 65,730 SQUARE FEET   |
| EVENT SPACE:   | 0.44 ACRES/ 18,976 SQUARE FEET   |
| PARKING REQUIREMENTS PER TC DISTRICT DEVELOPMENT STANDARDS                           |  |
| MIXED USE RESIDENTIAL: 2.0 SPACES PER UNIT   | 176 x 2 = 352 SPACES REQUIRED  |
| MIXED USE NON-RESIDENTIAL: 3 SPACES PER 1000 GSF                                     | 65,730/1000 x 3 = 197 SPACES REQUIRED  |
| TOTAL PARKING REQUIRED/PROVIDED:   | 549 SPACES REQUIRED/ 468 PROVIDED  |
| 5% OF ON STREET PARKING MAY BE COUNTED AS REQUIRED PARKING (28 ALLOWED/ 24 PROVIDED) |  |
| 15% PARKING REDUCTION ALLOWED FOR SHARED PARKING: 549 x .85 = 467 REQUIRED           |  |
| BUILDING 1:  | 51,882 SF APARTMENTS   |
| BUILDING 2:  | 16,641 SF RETAIL   |
| BUILDING 3:  | 11,405 SF RETAIL   |
| BUILDING 4:  | 15,900 SF MUNICIPAL  |
| BUILDING 5:  | 3,816 FLEX   |
| BUILDING 6:  | 18,148 SF RETAIL   |
| BUILDING 7:  | 51,882 SF APARTMENTS   |
| BUILDING 8:  | 17,453 SF APARTMENTS   |

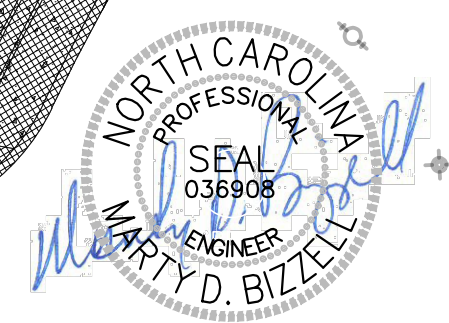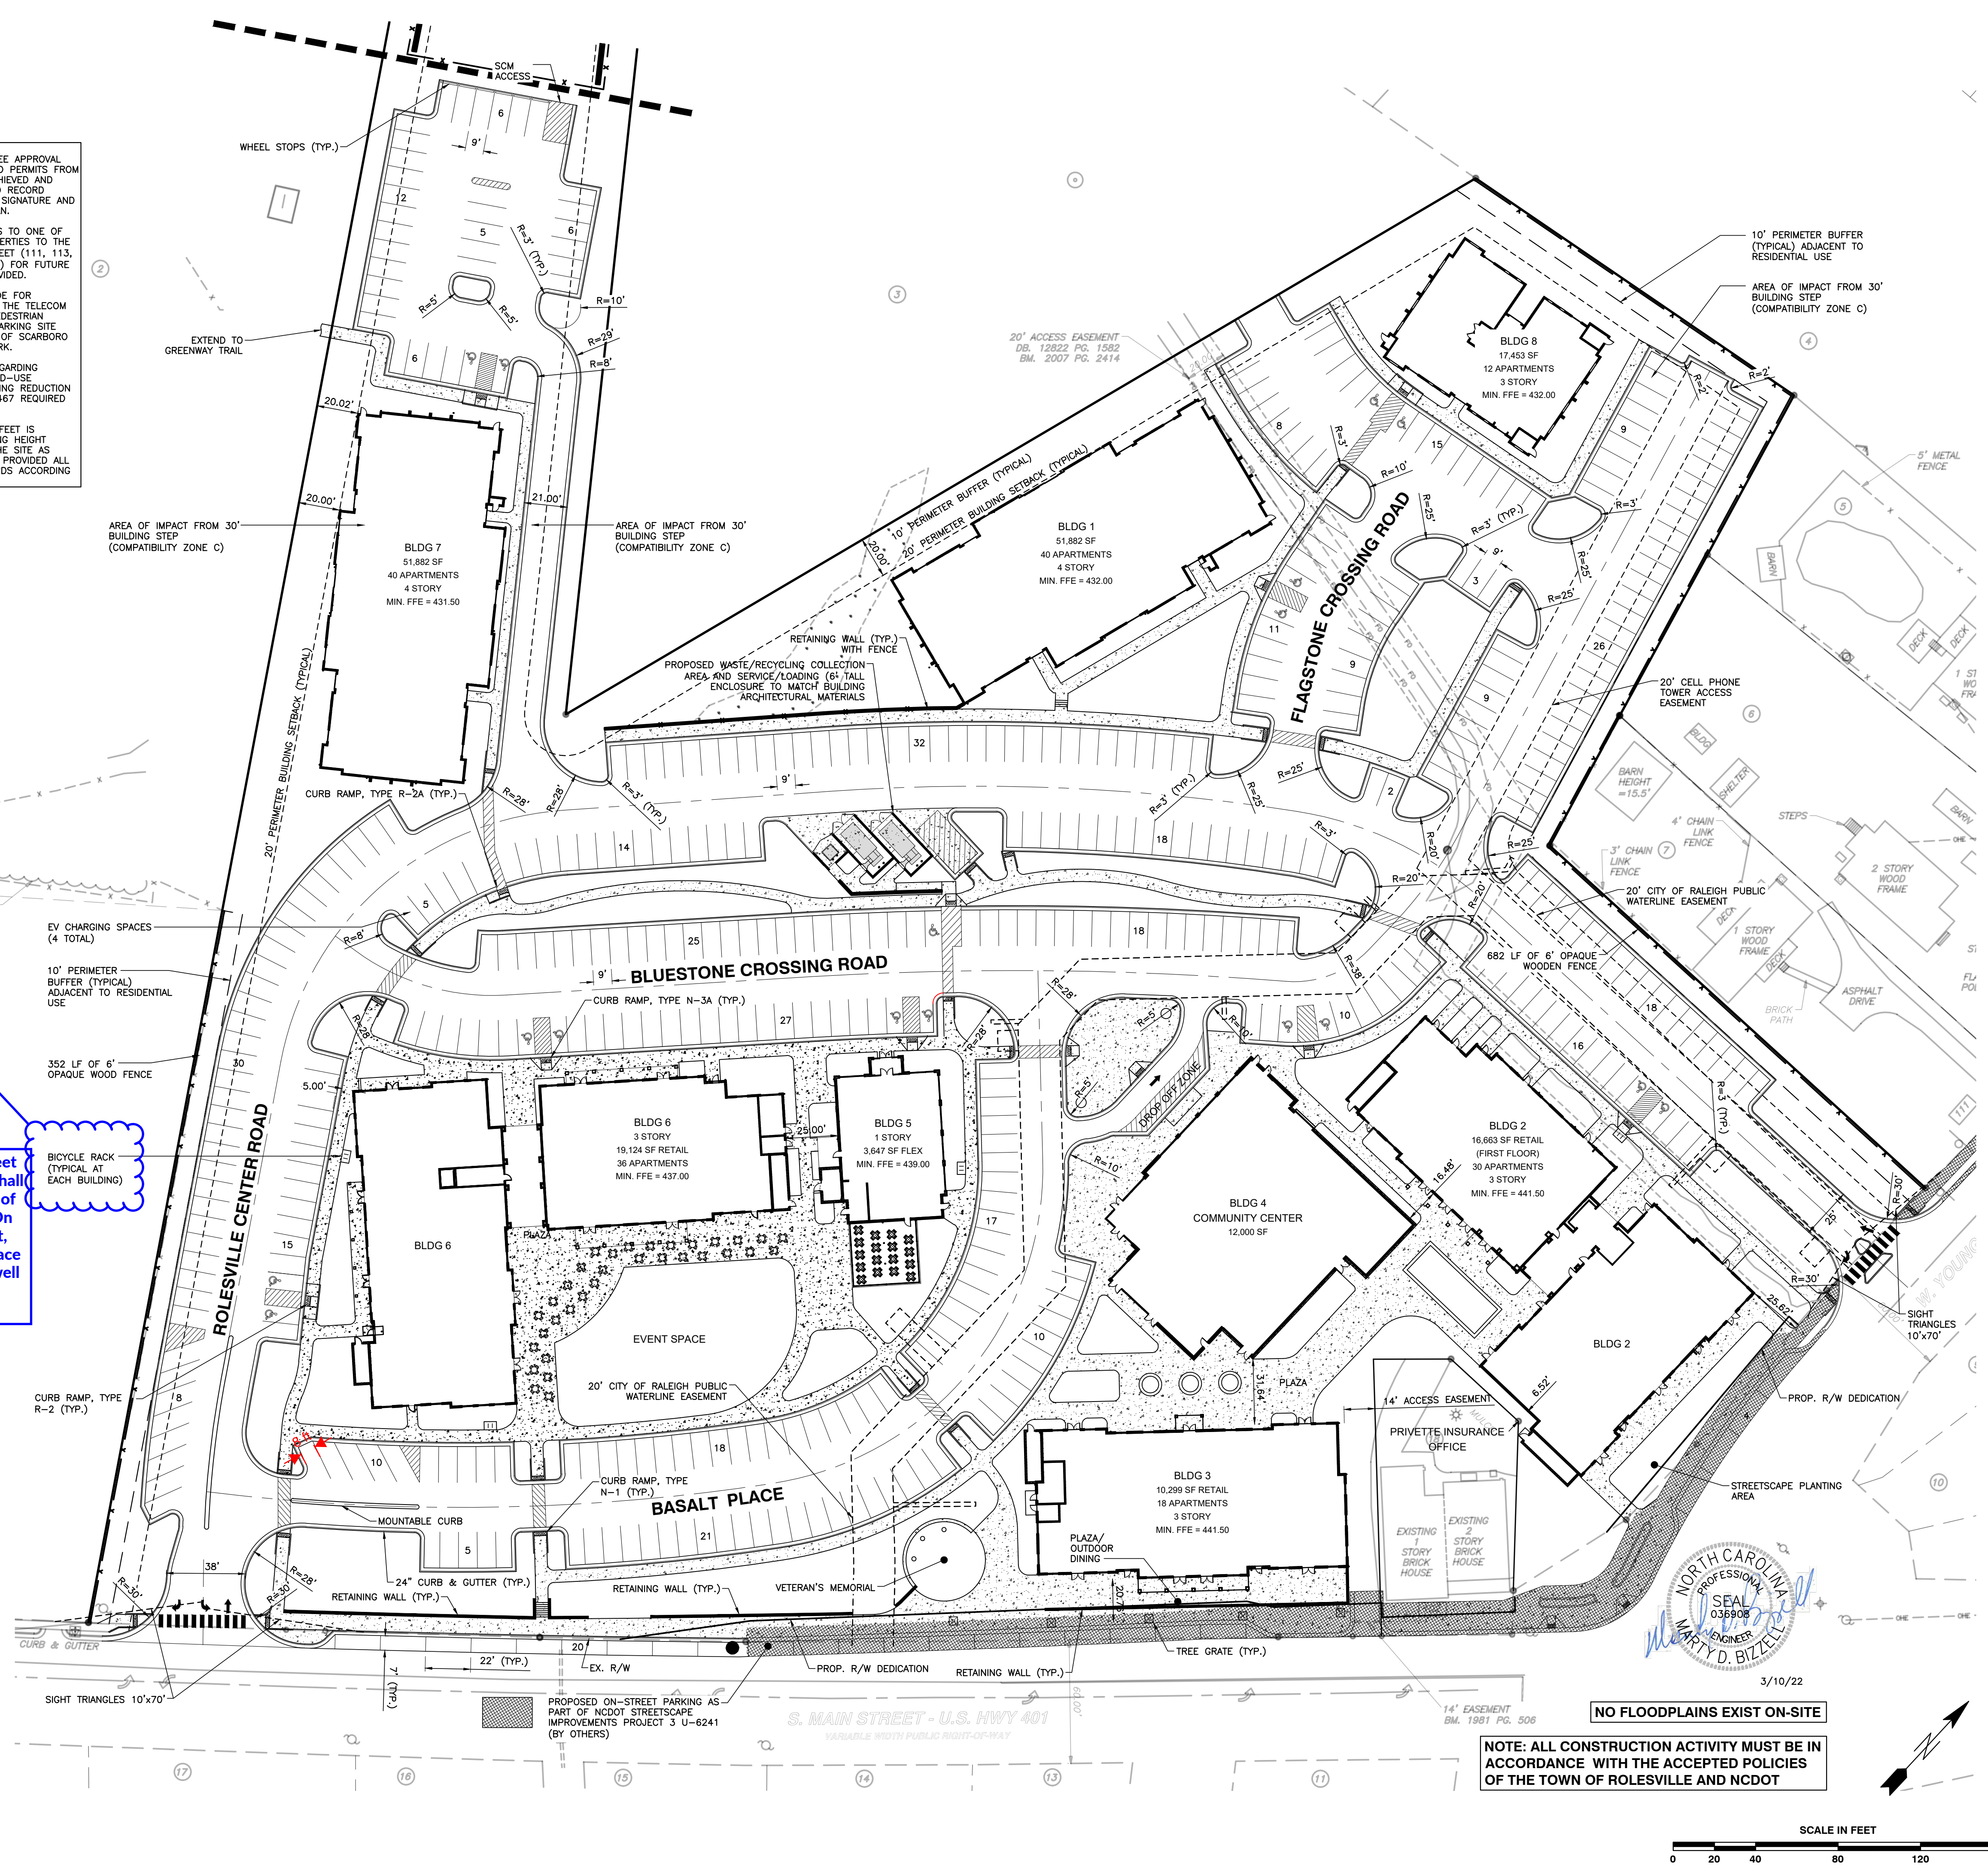

NOTE: ALL CONSTRUCTION ACTIVITY MUST BE IN ACCORDANCE WITH THE ACCEPTED POLICIES OF THE TOWN OF ROLESVILLE AND NCDOT

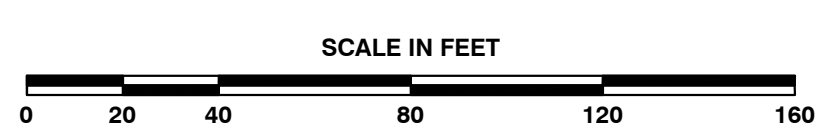

| NO. | DATE | DESCRIPTION | BY |
|-----|------|-------------|----|
|     |      |             |    |
|     |      |             |    |
|     |      |             |    |

CITY OF RALEIGH - PLANS AUTHORIZED FOR CONSTRUCTION

Electronic Approval: This approval is being issued electronically. This approval is valid only upon the signature of a City of Raleigh Review Officer below. The City will retain a copy of the approved plans. Any work authorized by this approval must proceed in accordance with the plans kept on file with the City. This electronic approval may not be edited once issued. Any modification to this approval once issued will invalidate this approval.

City of Raleigh Development Approval \_\_\_\_\_  
 Raleigh Water Review Officer \_\_\_\_\_


**Public**  
**Water Distribution / Extension System**  
 The City of Raleigh consents to the connection and extension of the City's public water system as shown on this plan. The material and construction methods used for this project shall conform to the standards and specifications of the City's Public Utilities Handbook.  
 City of Raleigh  
 Public Utilities Department Permit # W-3879  
 Authorization to Construct See digital signature

**Private**  
**Sewer Collection / Extension System**  
 The City of Raleigh consents to the connection to its public sewer system and extension of the private sewer collection system as shown on this plan. The material and construction methods used for this project shall conform to the standards and specifications of the City's Public Utilities Handbook.  
 City of Raleigh  
 Public Utilities Department Permit # S-4962 (P)  
 Authorization to Construct See digital signature

**ATTENTION CONTRACTORS**  
 The Construction Contractor responsible for the extension of water, sewer, and/or reuse, as approved in these plans, is responsible for contacting the Public Utilities Department at (919) 996-4540 at least twenty four hours prior to beginning any of their construction.  
**Failure** to notify both City Departments in advance of beginning construction, will result in the issuance of monetary fines, and require reinstallation of any water or sewer facilities not inspected as a result of this notification failure.  
**Failure** to call for Inspection, Install a Downstream Plug, have Permitted Plans on the Jobsite, or any other Violation of City of Raleigh Standards will result in a Fine and Possible Exclusion from future work in the City of Raleigh.


- STANDARD UTILITY NOTES (as applicable):**
- All materials & construction methods shall be in accordance with City of Raleigh design standards & specifications (reference: CORPUD Handbook, current edition)
  - Utility separation requirements:
    - A distance of 100' shall be maintained between sanitary sewer & any private or public water supply source such as an impounded reservoir used as a source of drinking water. If adequate lateral separation cannot be achieved, ferrous sanitary sewer pipe shall be specified & installed to watertight specifications. However, the minimum separation shall not be less than 25' from a private well or 50' from a public well
    - When installing water &/or sewer mains, the horizontal separation between utilities shall be 10'. If this separation cannot be maintained due to existing conditions, the variation allowed is the water main in a separate trench with the elevation of the water main at least 18" above the top of the sewer & must be approved by the Public Utilities Director. All distances are measured from outside diameter to outside diameter
    - Where it is impossible to obtain proper separation, or anytime a sanitary sewer passes over a watermain, DIP materials or steel encasement extended 10' on each side of crossing must be specified & installed to watertight specifications
    - 5.0' minimum horizontal separation is required between all sanitary sewer & storm sewer facilities, unless DIP material is specified for sanitary sewer
    - Maintain 18" min. vertical separation at all watermain & RCP storm drain crossings; maintain 24" min. vertical separation at all sanitary sewer & RCP storm drain crossings. Where adequate separations cannot be achieved, specify DIP materials & a concrete cradle having 6" min. clearance (per CORPUD details W-41 & S-49)
    - All other underground utilities shall cross water & sewer facilities with 18" min. vertical separation required
  - Any necessary field revisions are subject to review & approval of an amended plan &/or profile by the City of Raleigh Public Utilities Department prior to construction
  - Contractor shall maintain continuous water & sewer service to existing residences & businesses throughout construction of project. Any necessary service interruptions shall be preceded by a 24 hour advance notice to the City of Raleigh Public Utilities Department
  - 3.0' minimum cover is required on all water mains & sewer force mains. 4.0' minimum cover is required on all reuse mains
  - It is the developer's responsibility to abandon or remove existing water & sewer services not being used in redevelopment of a site unless otherwise directed by the City of Raleigh Public Utilities Department. This includes abandoning tap at main & removal of service from ROW or easement per CORPUD Handbook procedure
  - Install 3/4" copper\* water services with meters located at ROW or within a 2'x2' Watertight Easement immediately adjacent. *NOTE: It is the applicant's responsibility to properly size the water service for each connection to provide adequate flow & pressure*
  - Install 4" PVC\* sewer services @ 1.0% minimum grade with cleanouts located at ROW or easement line & spaced every 75 linear feet maximum
  - Pressure reducing valves are required on all water services exceeding 80 psi; backwater valves are required on all sanitary sewer services having building drains lower than 1.0' above the next upstream manhole
  - All environmental permits applicable to the project must be obtained from NCDWQ, USACE &/or FEMA for any riparian buffer, wetland &/or floodplain impacts (respectively) prior to construction.
  - NCDOT / Railroad Encroachment Agreements are required for any utility work (including main extensions & service taps) within state or railroad ROW prior to construction
  - Grease Interceptor / Oil Water Separator sizing calculations & installation specifications shall be approved by the CORPUD FOG Program Coordinator prior to issuance of a Building Permit. Contact Tim Besley at (919) 996-2334 or [timothy.besley@raleighnc.gov](mailto:timothy.besley@raleighnc.gov) for more information
  - Cross-connection control protection devices are required based on degree of health hazard involved as listed in Appendix-B of the Rules Governing Public Water Systems in North Carolina. These guidelines are the minimum requirements. The devices shall meet American Society of Sanitary Engineering (ASSE) standards or be on the University of Southern California approval list. The devices shall be installed and tested (both initial and periodic testing thereafter) in accordance with the manufacturer's recommendations or the local cross-connection control program, whichever is more stringent. Contact Joanie Hartley at (919) 996-5923 or [joanie.hartley@raleighnc.gov](mailto:joanie.hartley@raleighnc.gov) for more information

- NOTES:**
- FOR BUILDING SEWER PLUMBING THE FURTHEST MAIN UNDER SLAB UPSET 1.5' BELOW FFE.
  - BACKFLOW PREVENTERS TO BE LOCATED INSIDE OF BUILDINGS 2, 3, 4, 5, & 6.

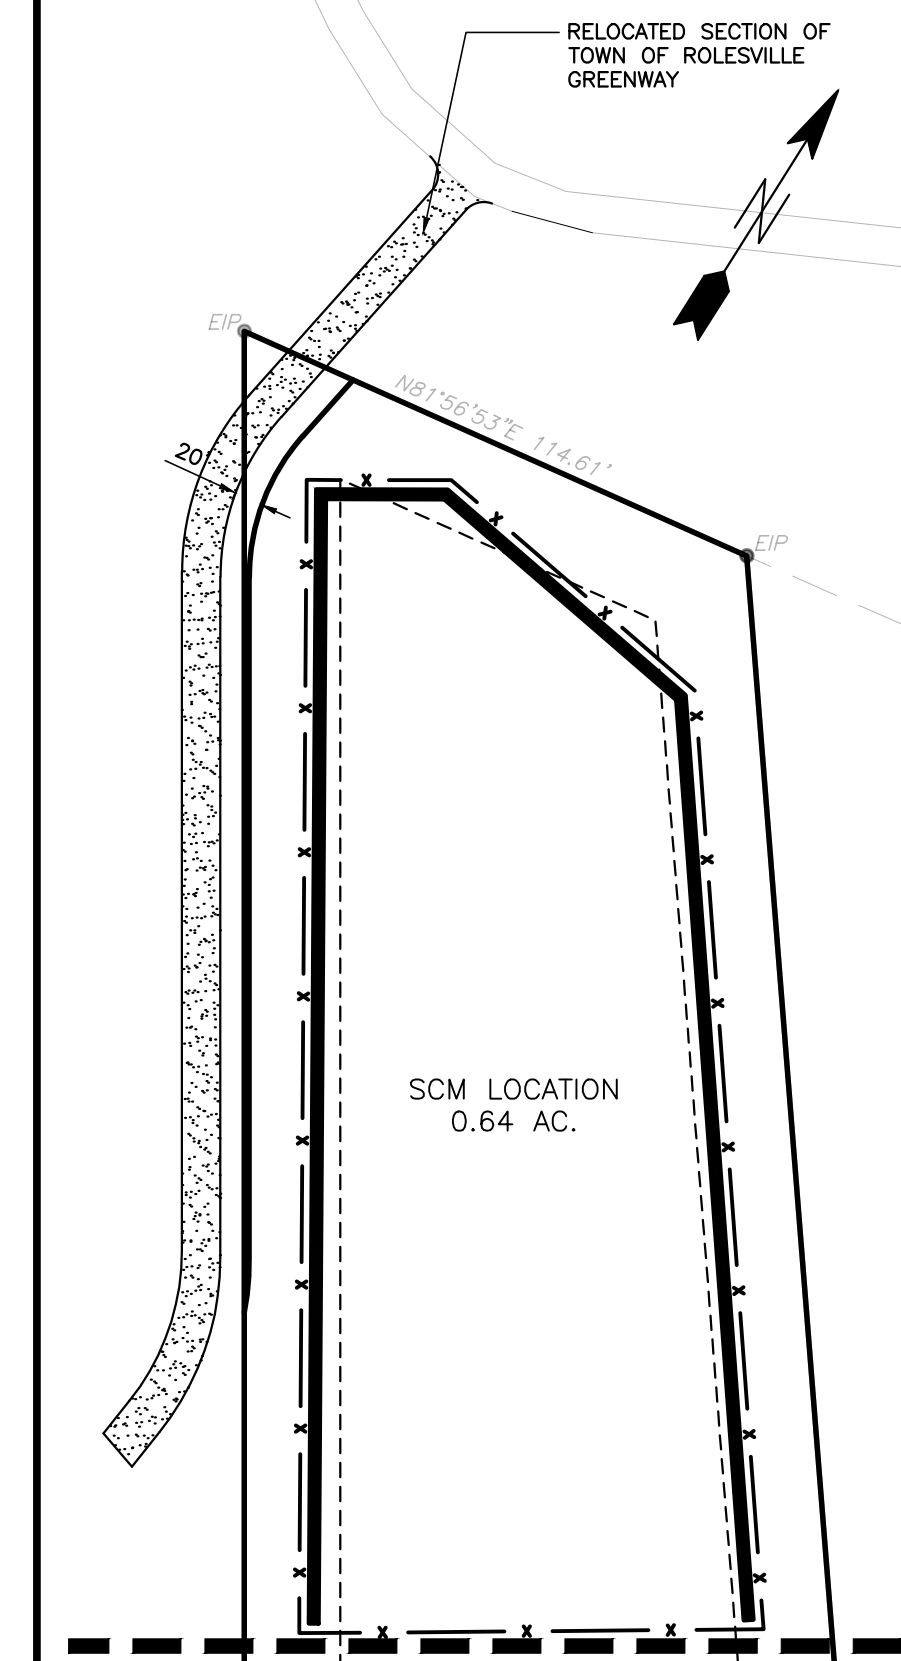


Four of these 5 spaces are noted as EV charging spaces on the cover sheet. Label location of charging utilities.


R:\2019\19187 - Rolesville Town Center CIVIL\04 Construction\03 - 19187\_UTILITY.dwg, Utility Plan, 3/10/2022, 4:26:49 PM, mncr.m.weller

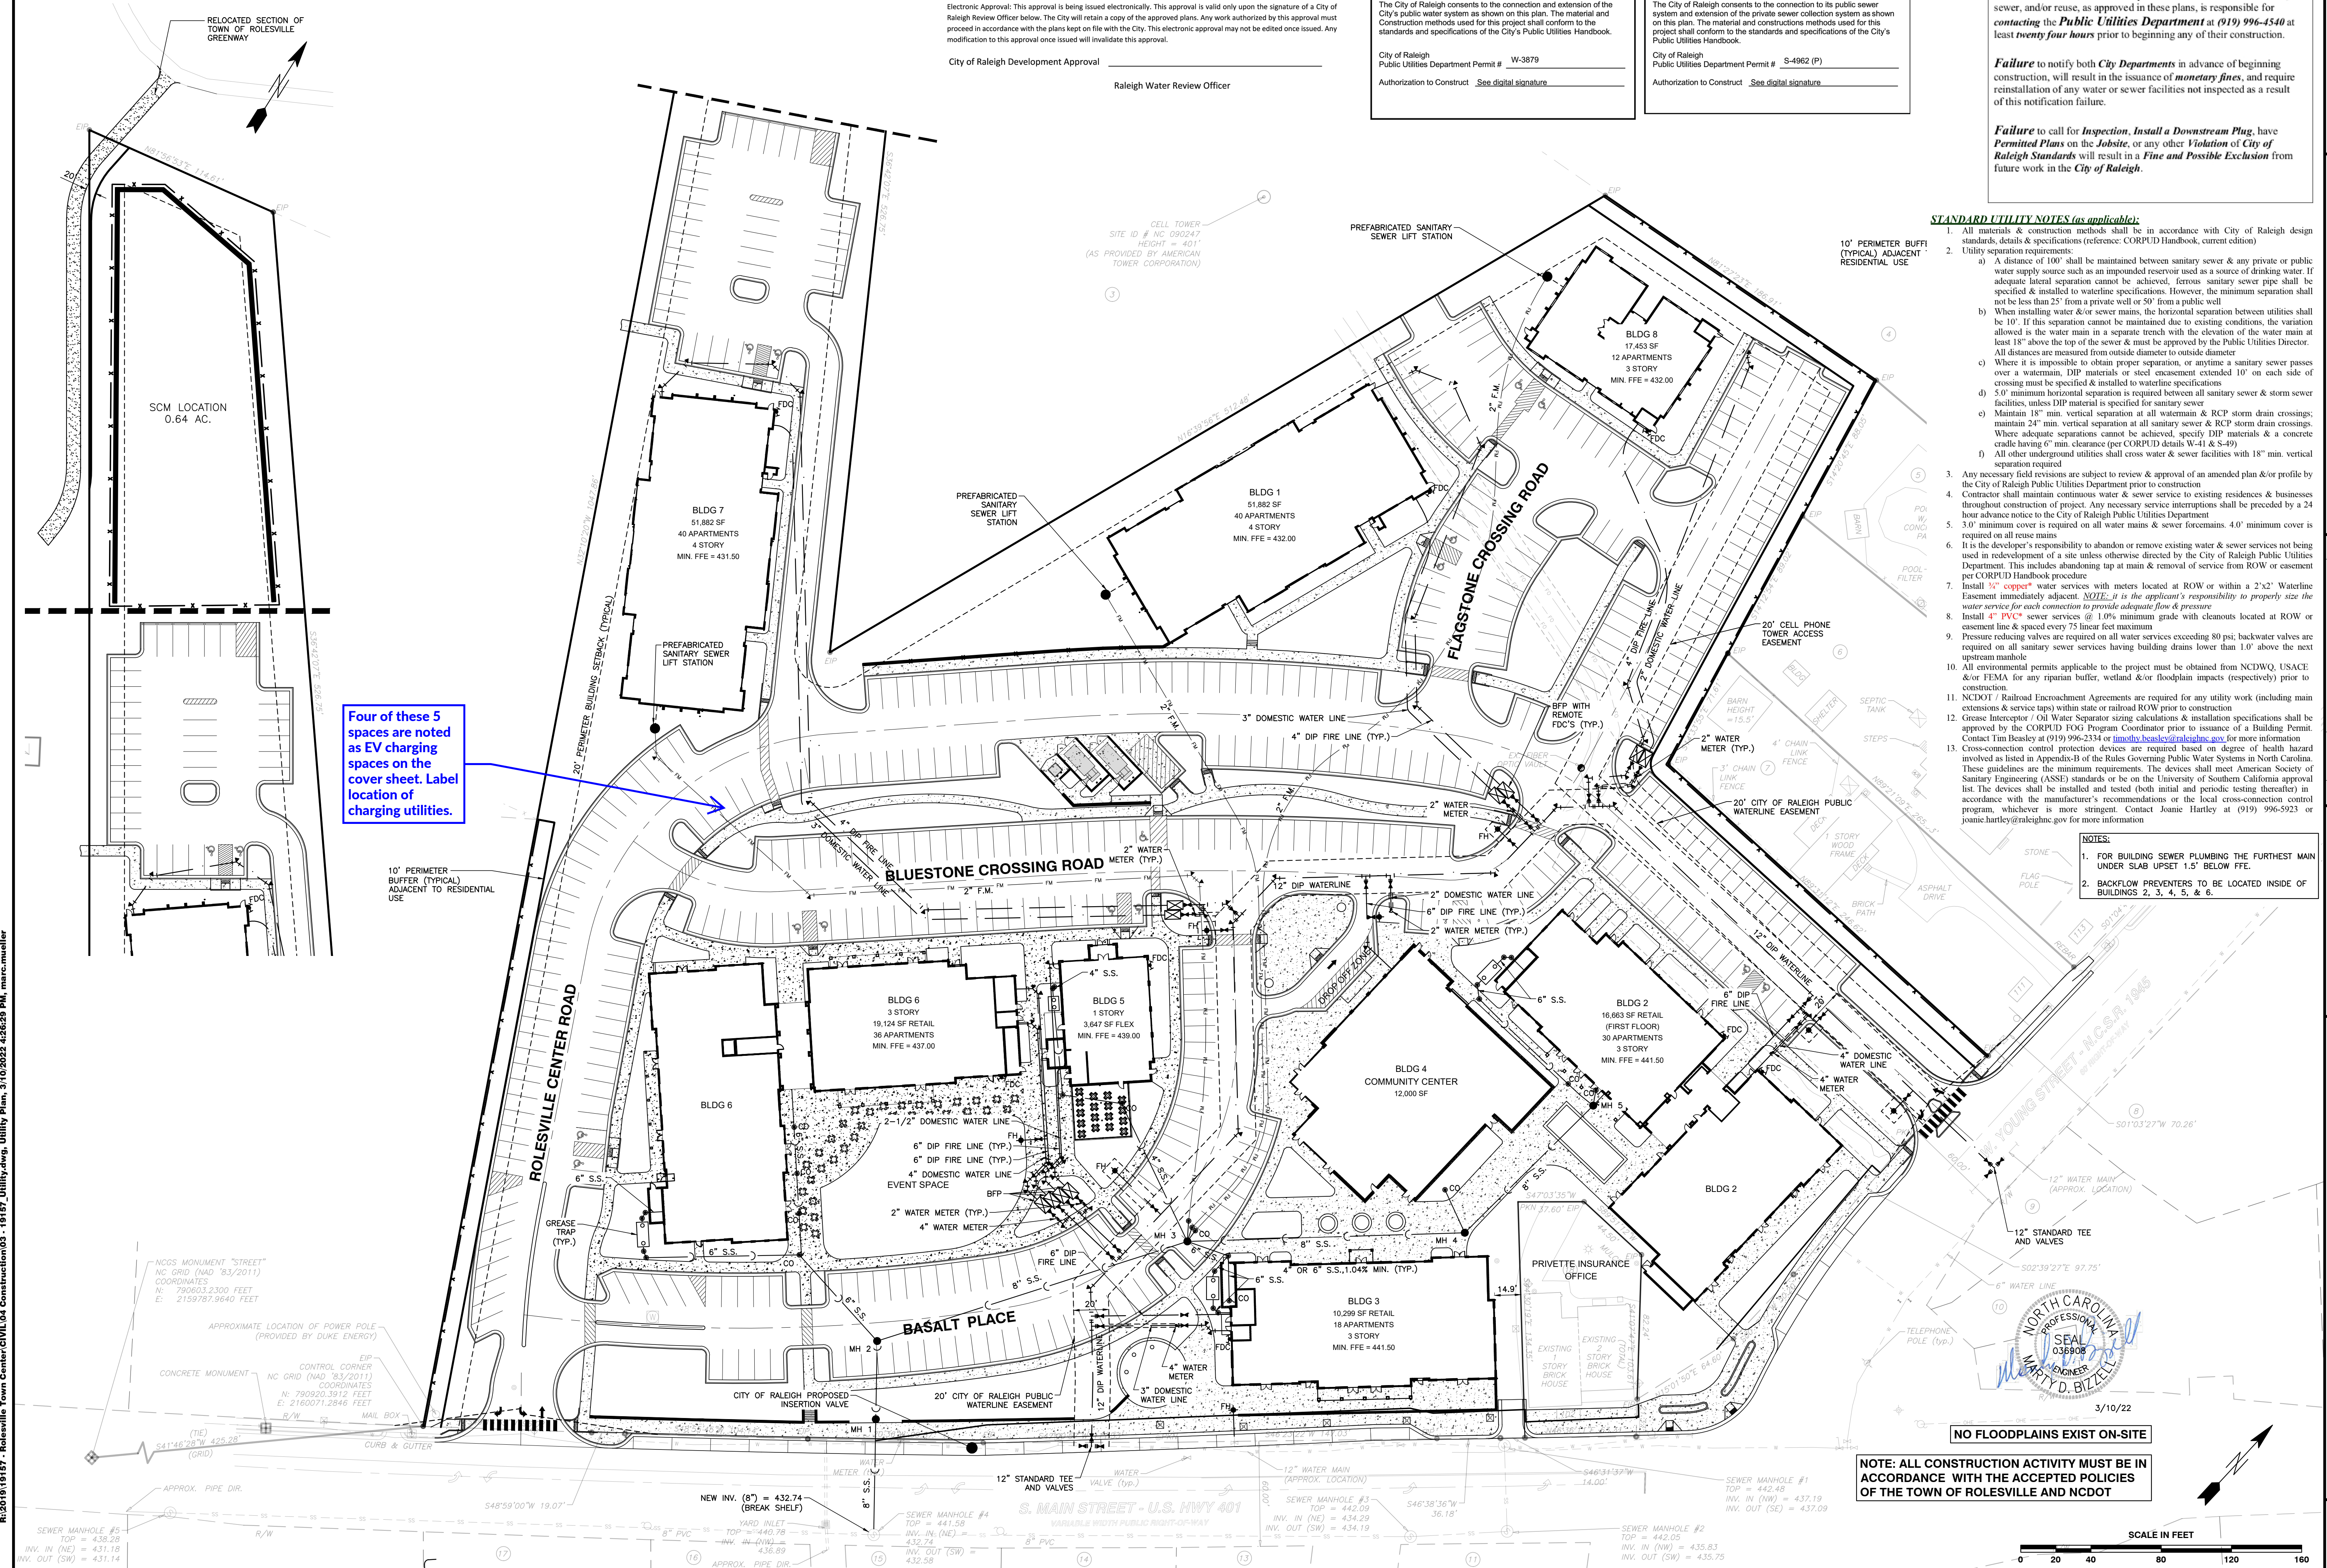

NOTE: ALL CONSTRUCTION ACTIVITY MUST BE IN ACCORDANCE WITH THE ACCEPTED POLICIES OF THE TOWN OF ROLESVILLE AND NCDOT

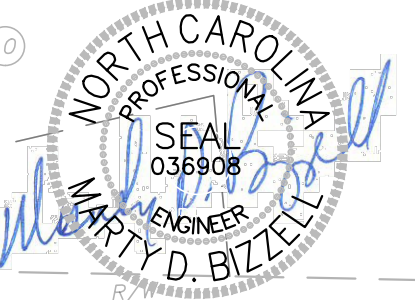

3/10/22

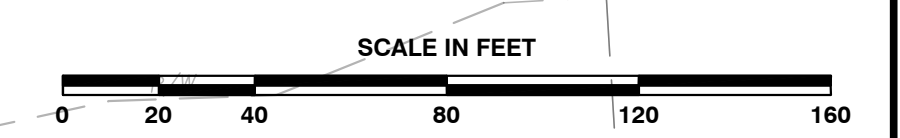

**BASS, NIXON & KENNEDY, INC.**  
**CONSULTING ENGINEERS**  
 6310 CHAPEL HILL ROAD, SUITE 950, RALEIGH, NC 27607  
 TELEPHONE: (919) 981-1122 FAX: (919) 981-8686  
 CERTIFICATION NUMBERS: NCBELS (C-0110); NCBOLA (C-0267)

| NO. | DATE | DESCRIPTION | BY |
|-----|------|-------------|----|
|     |      |             |    |
|     |      |             |    |
|     |      |             |    |
|     |      |             |    |

**COBBLESTONE VILLAGE**  
**MIXED USE DEVELOPMENT**  
 TOWN OF ROLESVILLE, WAKE COUNTY, NORTH CAROLINA  
 SHEET C2.1  
 UTILITY PLAN  
 SCALE: 1" = 40'  
 CHK BY: MDB

NOT RELEASED FOR CONSTRUCTION OR BID SOLICITATION



CITY OF RALEIGH - PLANS AUTHORIZED FOR CONSTRUCTION

Electronic Approval: This approval is being issued electronically. This approval is valid only upon the signature of a City of Raleigh Review Officer below. The City will retain a copy of the approved plans. Any work authorized by this approval must proceed in accordance with the plans kept on file with the City. This electronic approval may not be edited once issued. Any modification to this approval once issued will invalidate this approval.

City of Raleigh Development Approval \_\_\_\_\_  
 Raleigh Water Review Officer

| Structure | d <sub>1</sub> (ft) | Velocity (fps) | Length (ft) | Width (ft) | Depth (in) | Type      | d <sub>50</sub> |
|-----------|---------------------|----------------|-------------|------------|------------|-----------|-----------------|
| FES 1     | 2.00                | 7.4            | 12          | 6          | 22         | Class 'B' | 6" - 13"        |
| FES 3     | 3.00                | 6.5            | 18          | 9          | 22         | Class 'B' | 6" - 13"        |


\* Per NYDOT Dissipator Schedule Fig.1

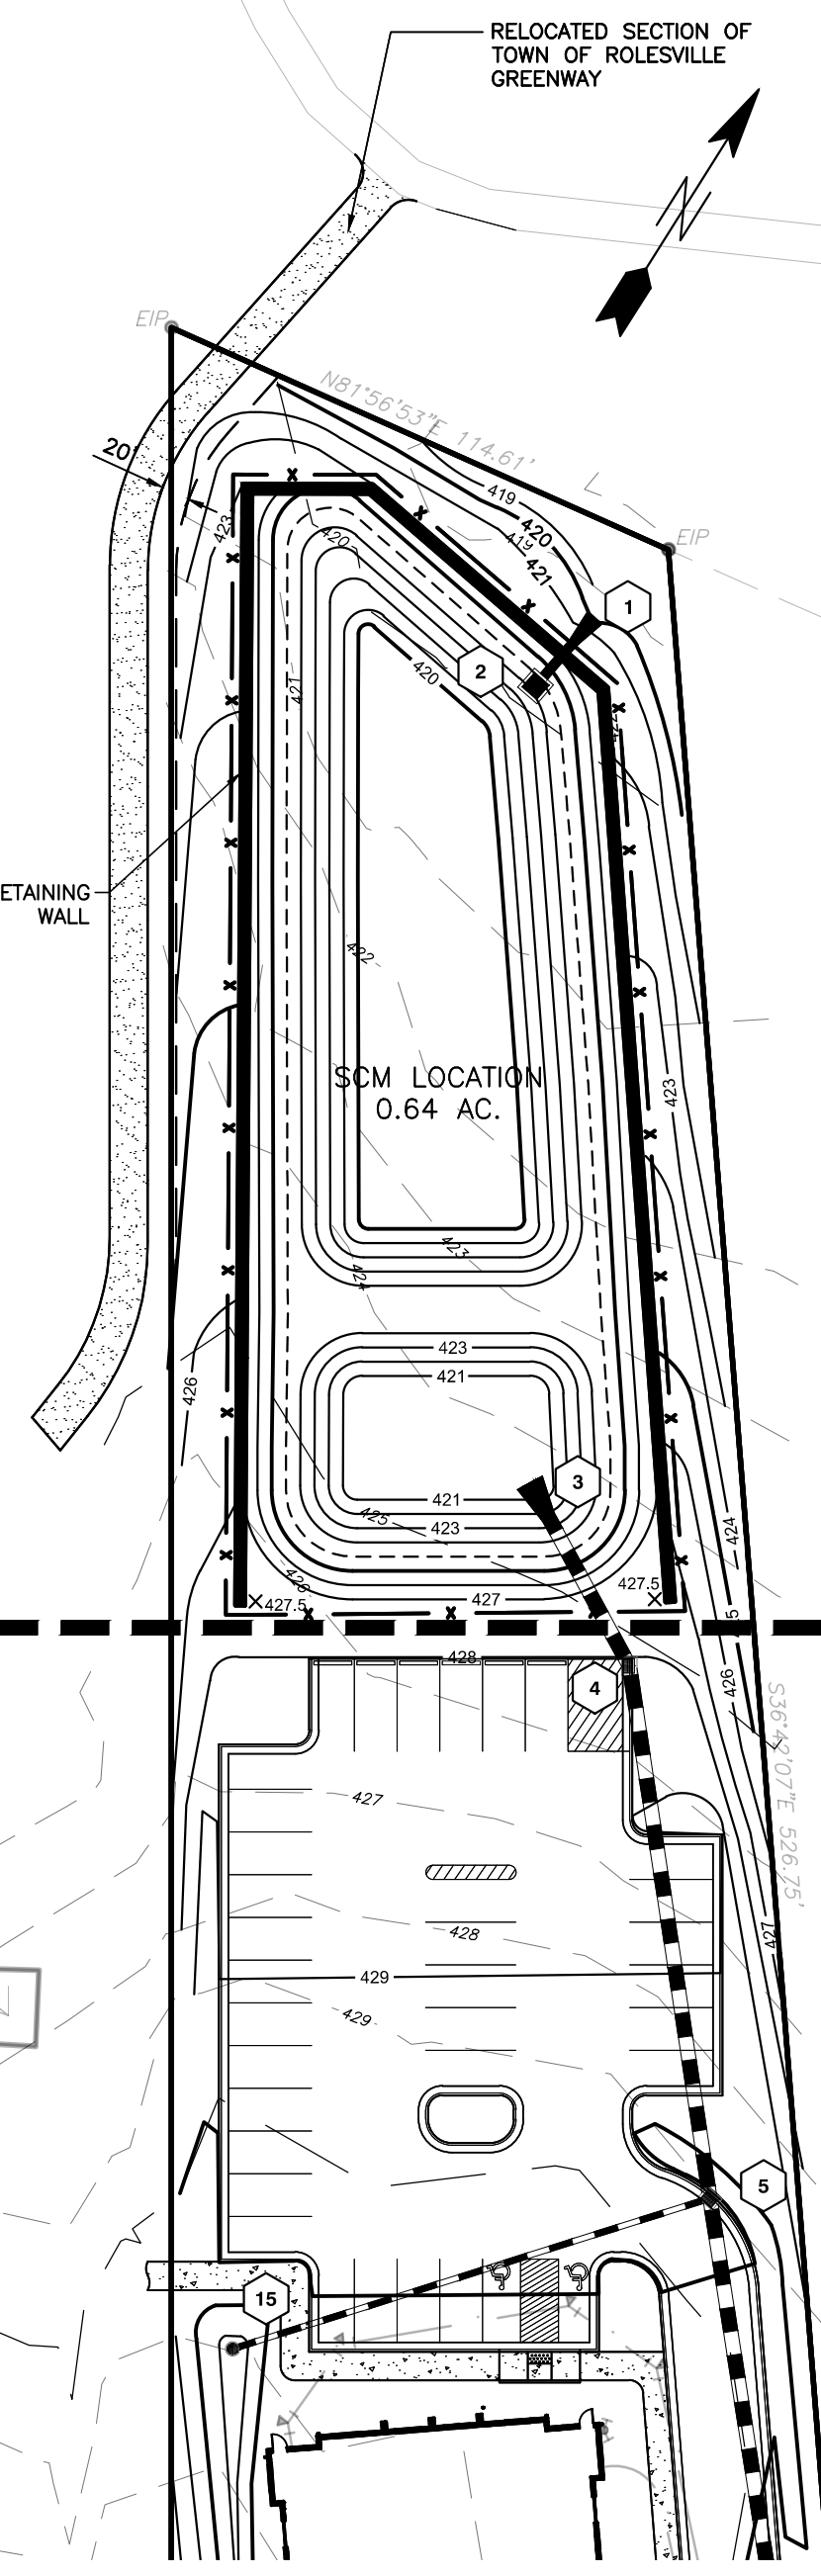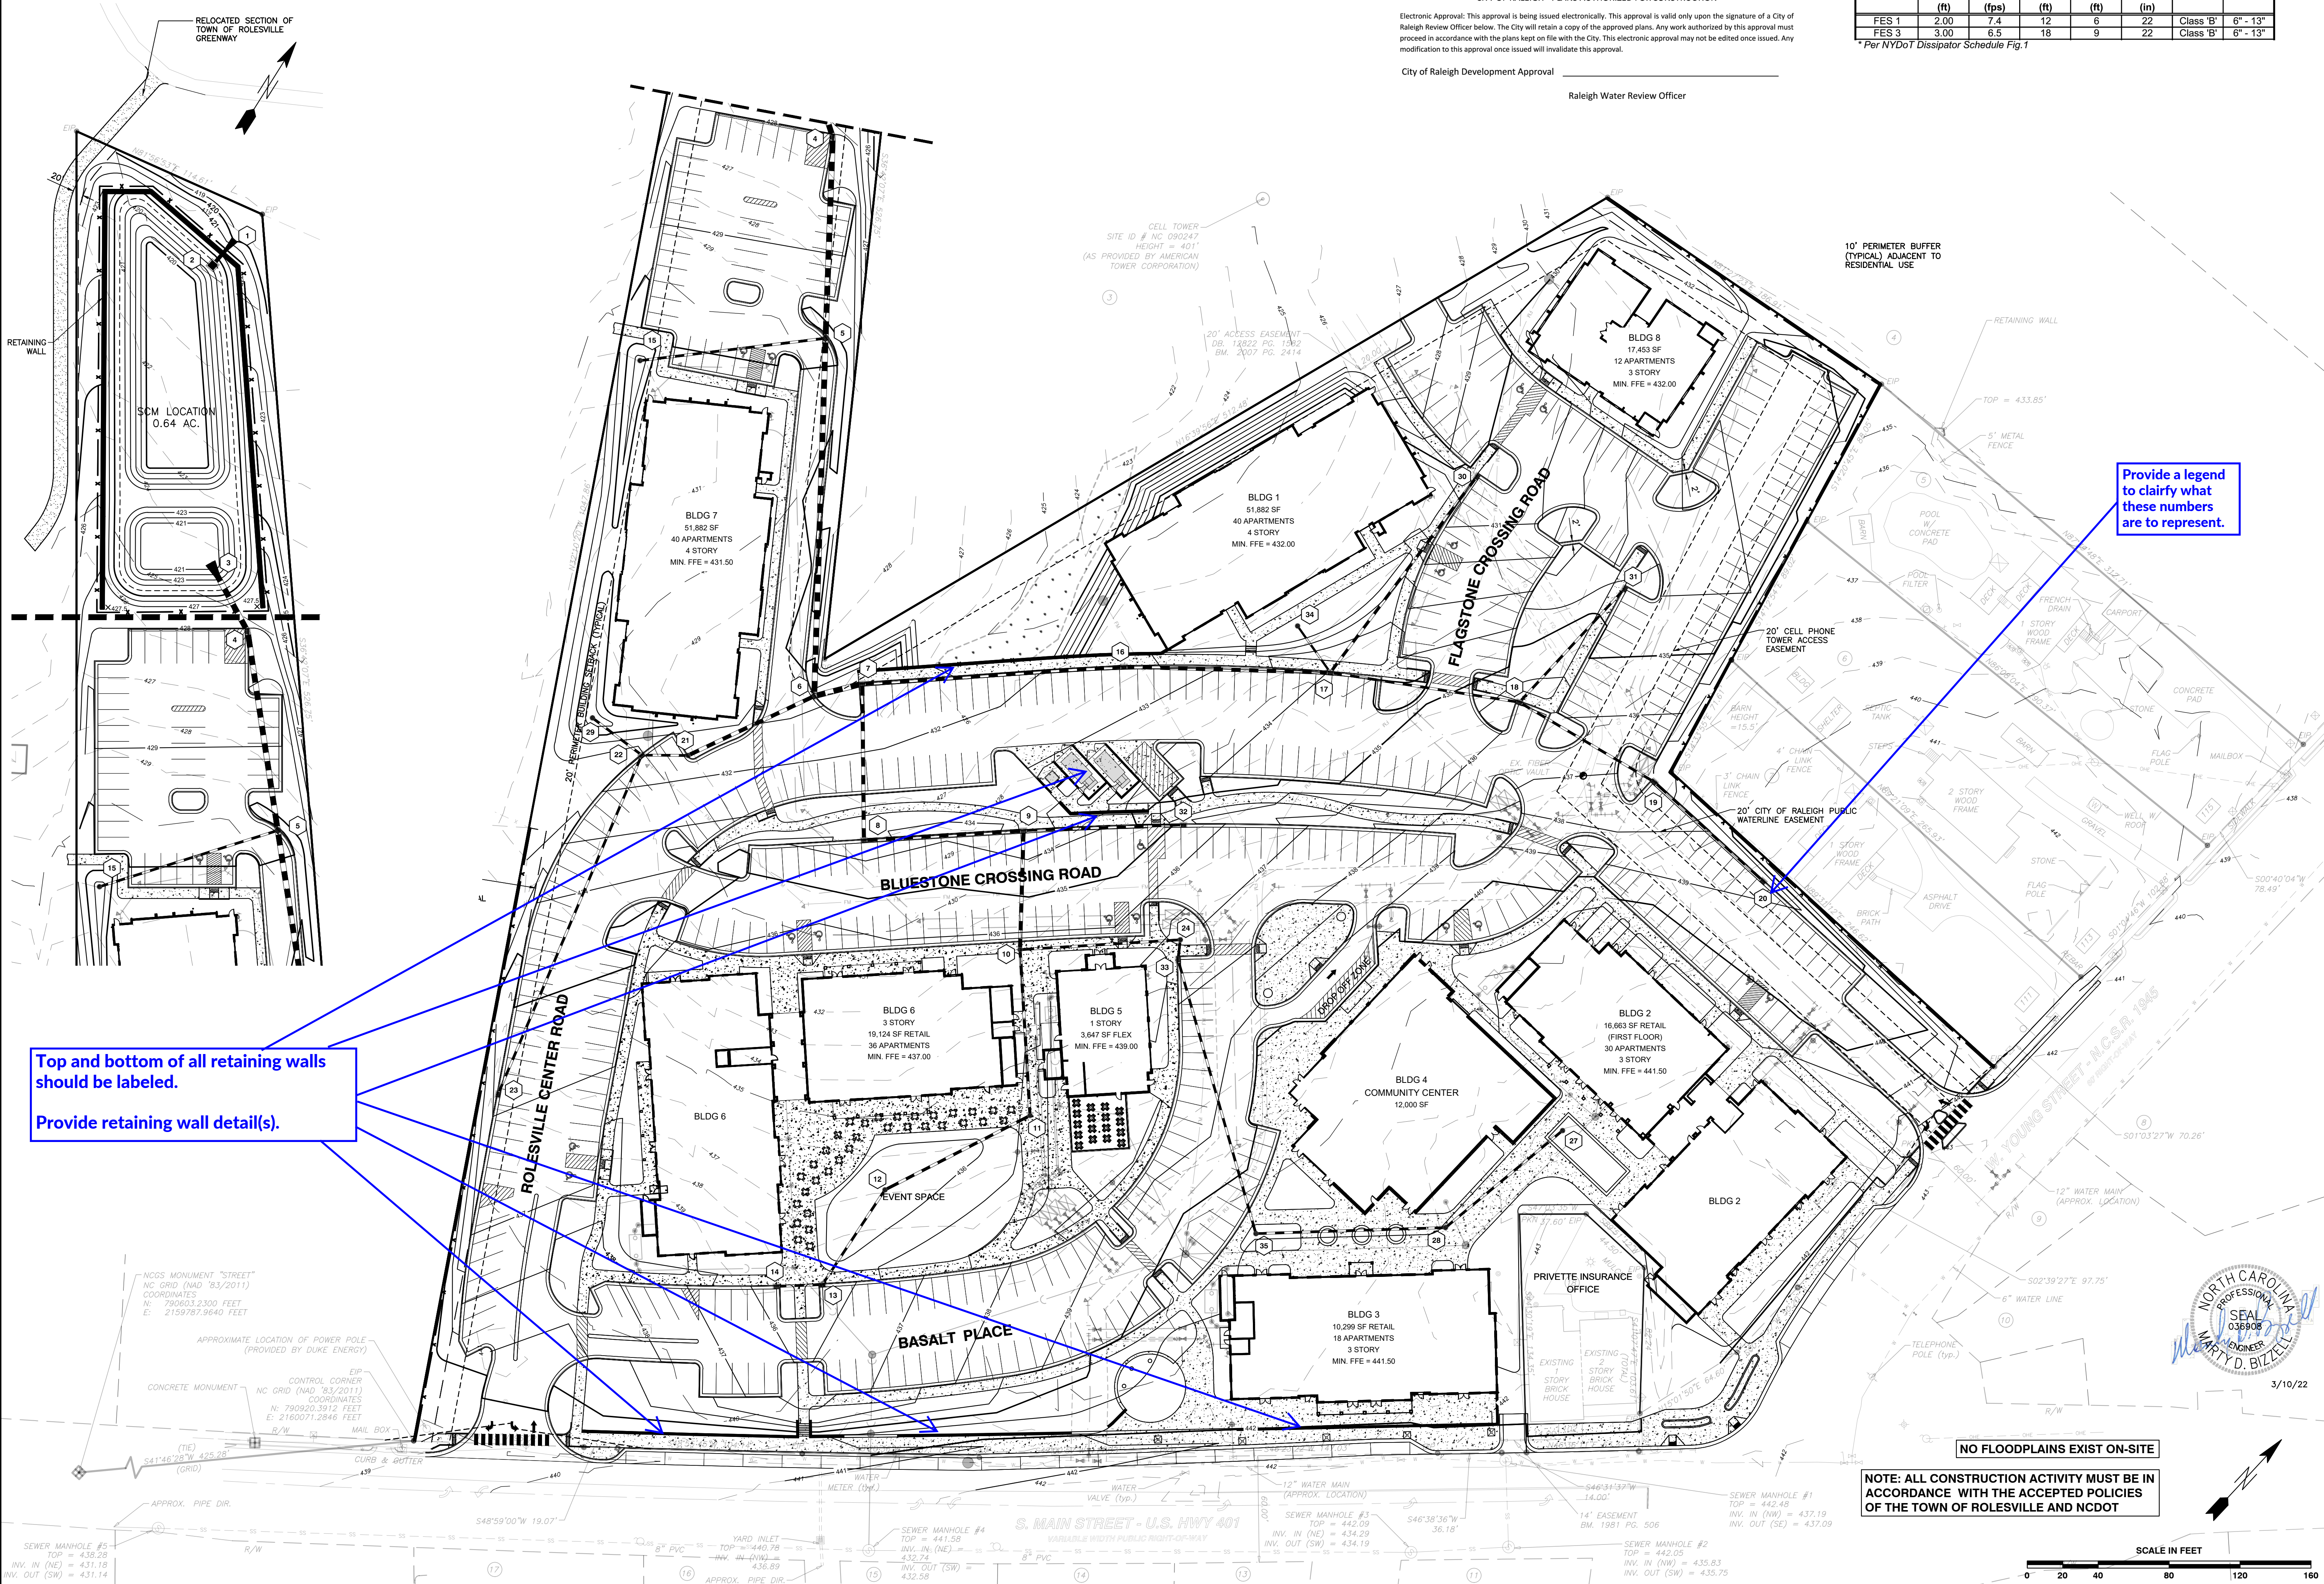

Provide a legend to clarify what these numbers are to represent.

Top and bottom of all retaining walls should be labeled.  
 Provide retaining wall detail(s).

NOTE: ALL CONSTRUCTION ACTIVITY MUST BE IN ACCORDANCE WITH THE ACCEPTED POLICIES OF THE TOWN OF ROLESVILLE AND NCDOT

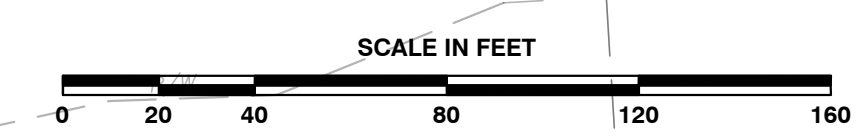

**BASS, NIXON & KENNEDY, INC.**  
 CONSULTING ENGINEERS  
 6310 CHAPEL HILL ROAD, SUITE 250, RALEIGH, NC 27607  
 TELEPHONE: (919) 881-1122 FAX: (919) 881-6886  
 CERTIFICATION NUMBERS: NCBELS (C-0110); NCBOLA (C-0267)


| NO. | DATE | DESCRIPTION | BY |
|-----|------|-------------|----|
|     |      |             |    |
|     |      |             |    |

COBBLESTONE VILLAGE  
 MIXED USE DEVELOPMENT  
 TOWN OF ROLESVILLE, WAKE COUNTY, NORTH CAROLINA

SHEET C3.1


NOT RELEASED FOR CONSTRUCTION OR BID SOLICITATION

R:\2019\19157 - Rolesville Town Center CIVIL\04 Construction\04 - 19157\_Grading\dwg, Grading Plan, 3/10/2022 4:29:31 PM, marc.mueller

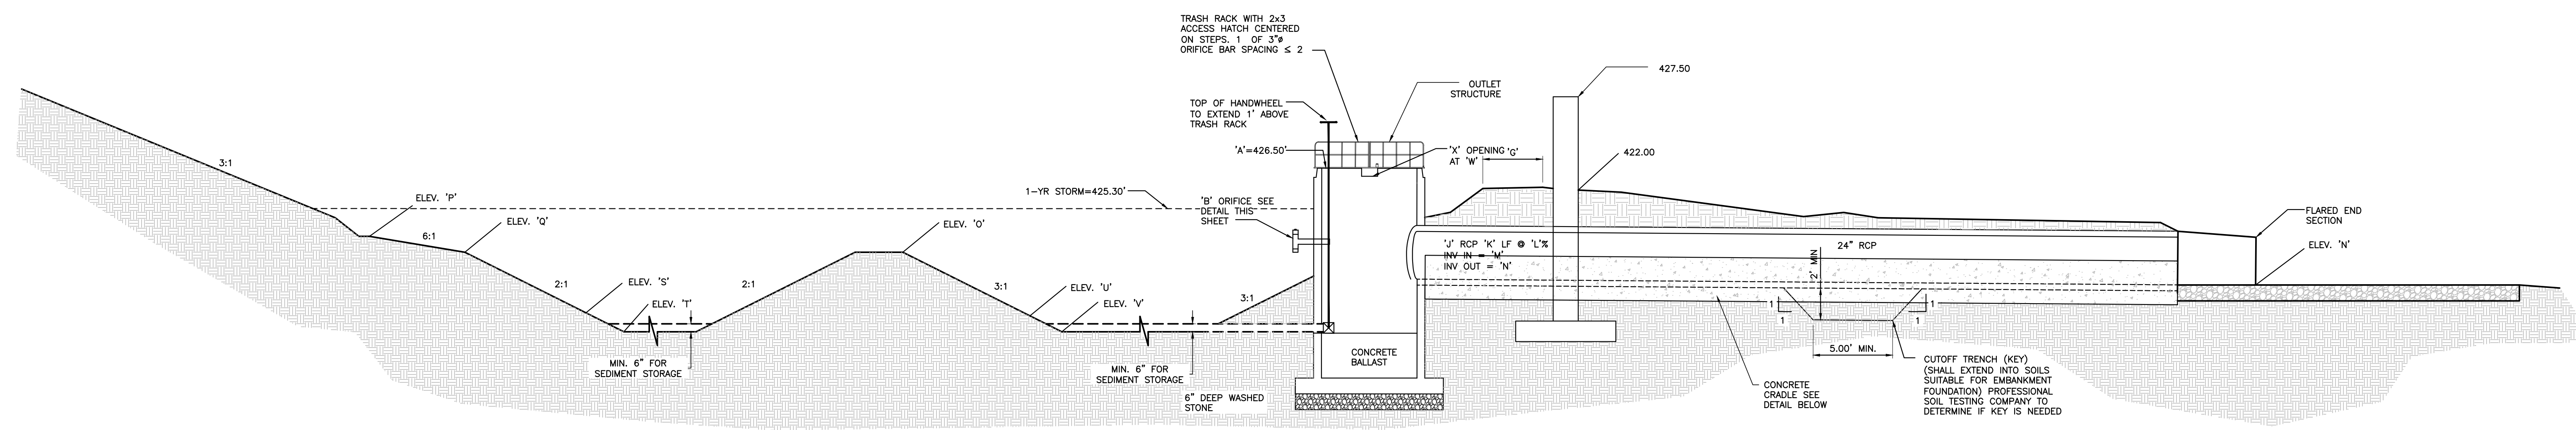

CROSS-SECTION OF WET POND A-A


Table with 2 columns: Description and Value. Contains buoyancy calculations for riser/barrel, ballast concrete requirements, and material specifications.

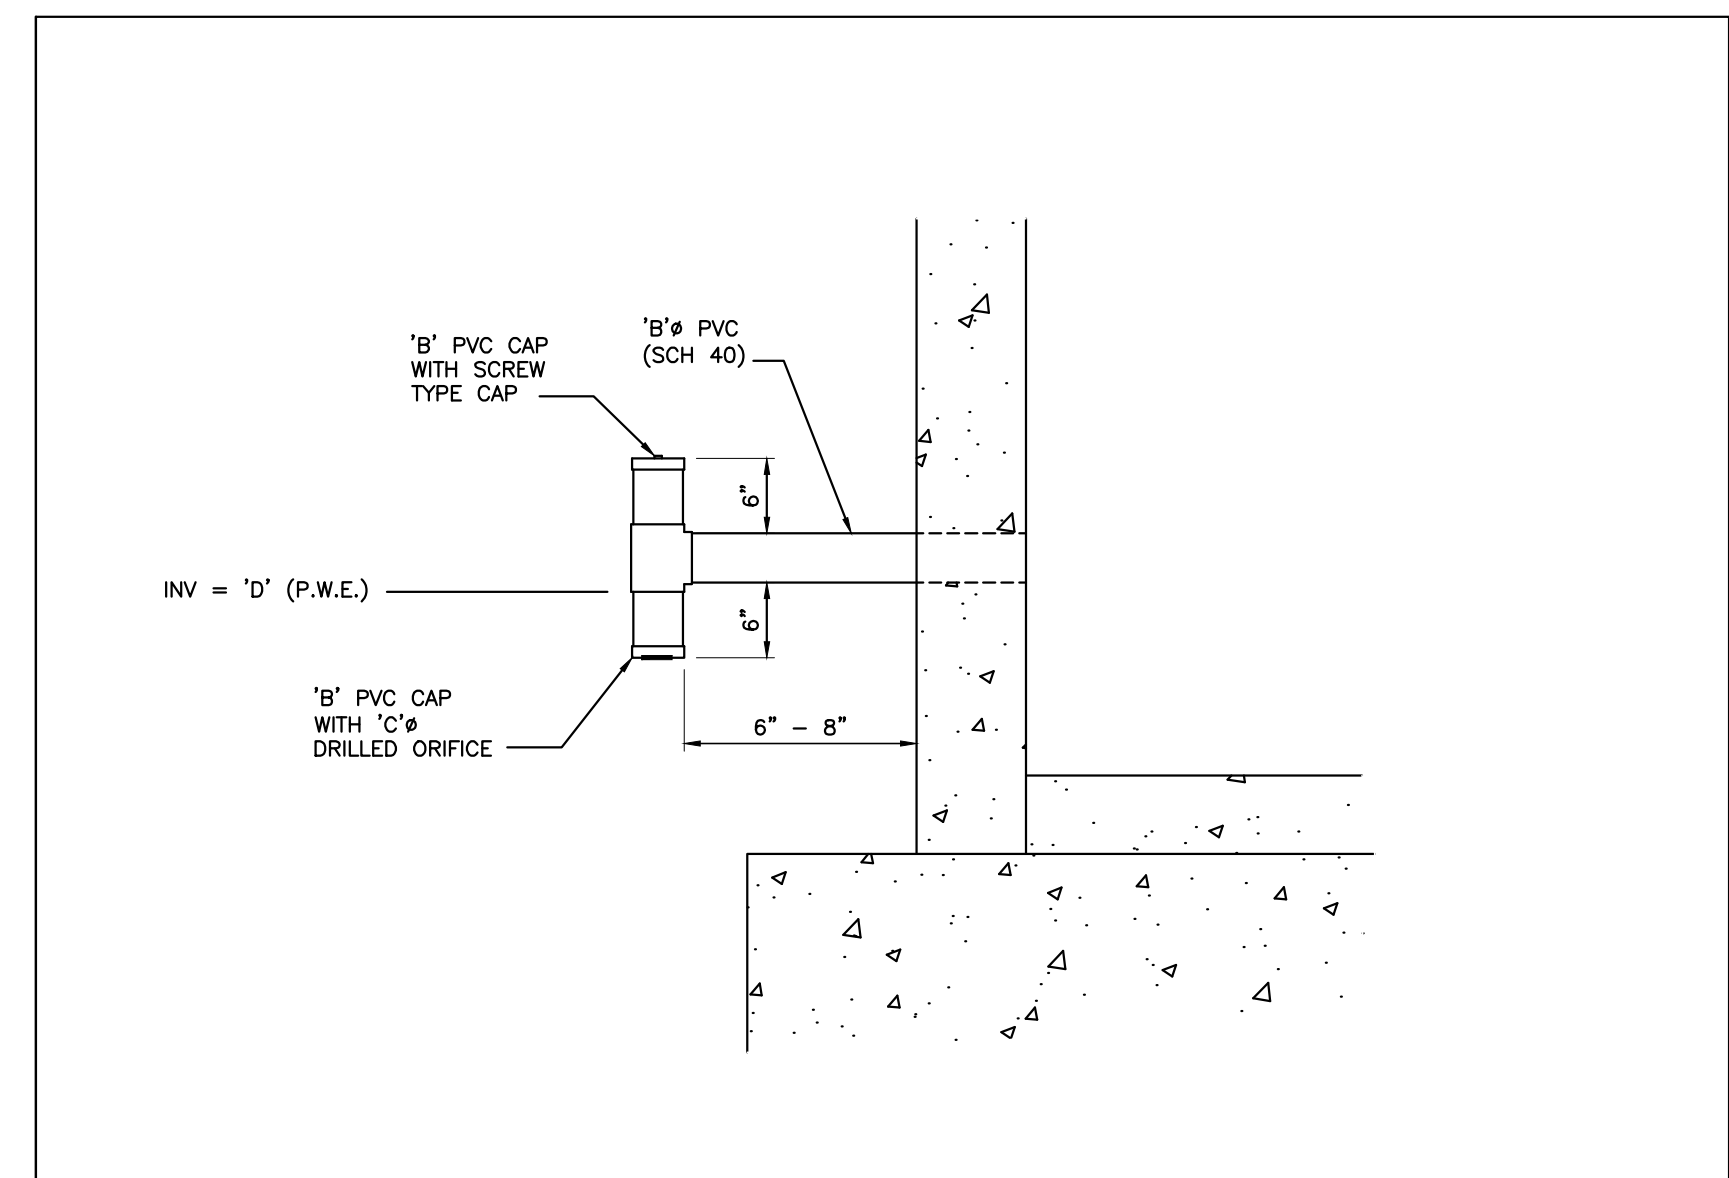


INVERTED INTAKE DETAIL ( RISER)

POND LEGEND - SCM table with 3 columns: Description, Design, and As-Built. Lists various pond components and their elevations/positions.

Special Instructions: Place Drawdown pipe opposite of outlet pipe and ensure a minimum of 12" clearance between drawdown pipe opening and ground elevation to allow for proper drainage.

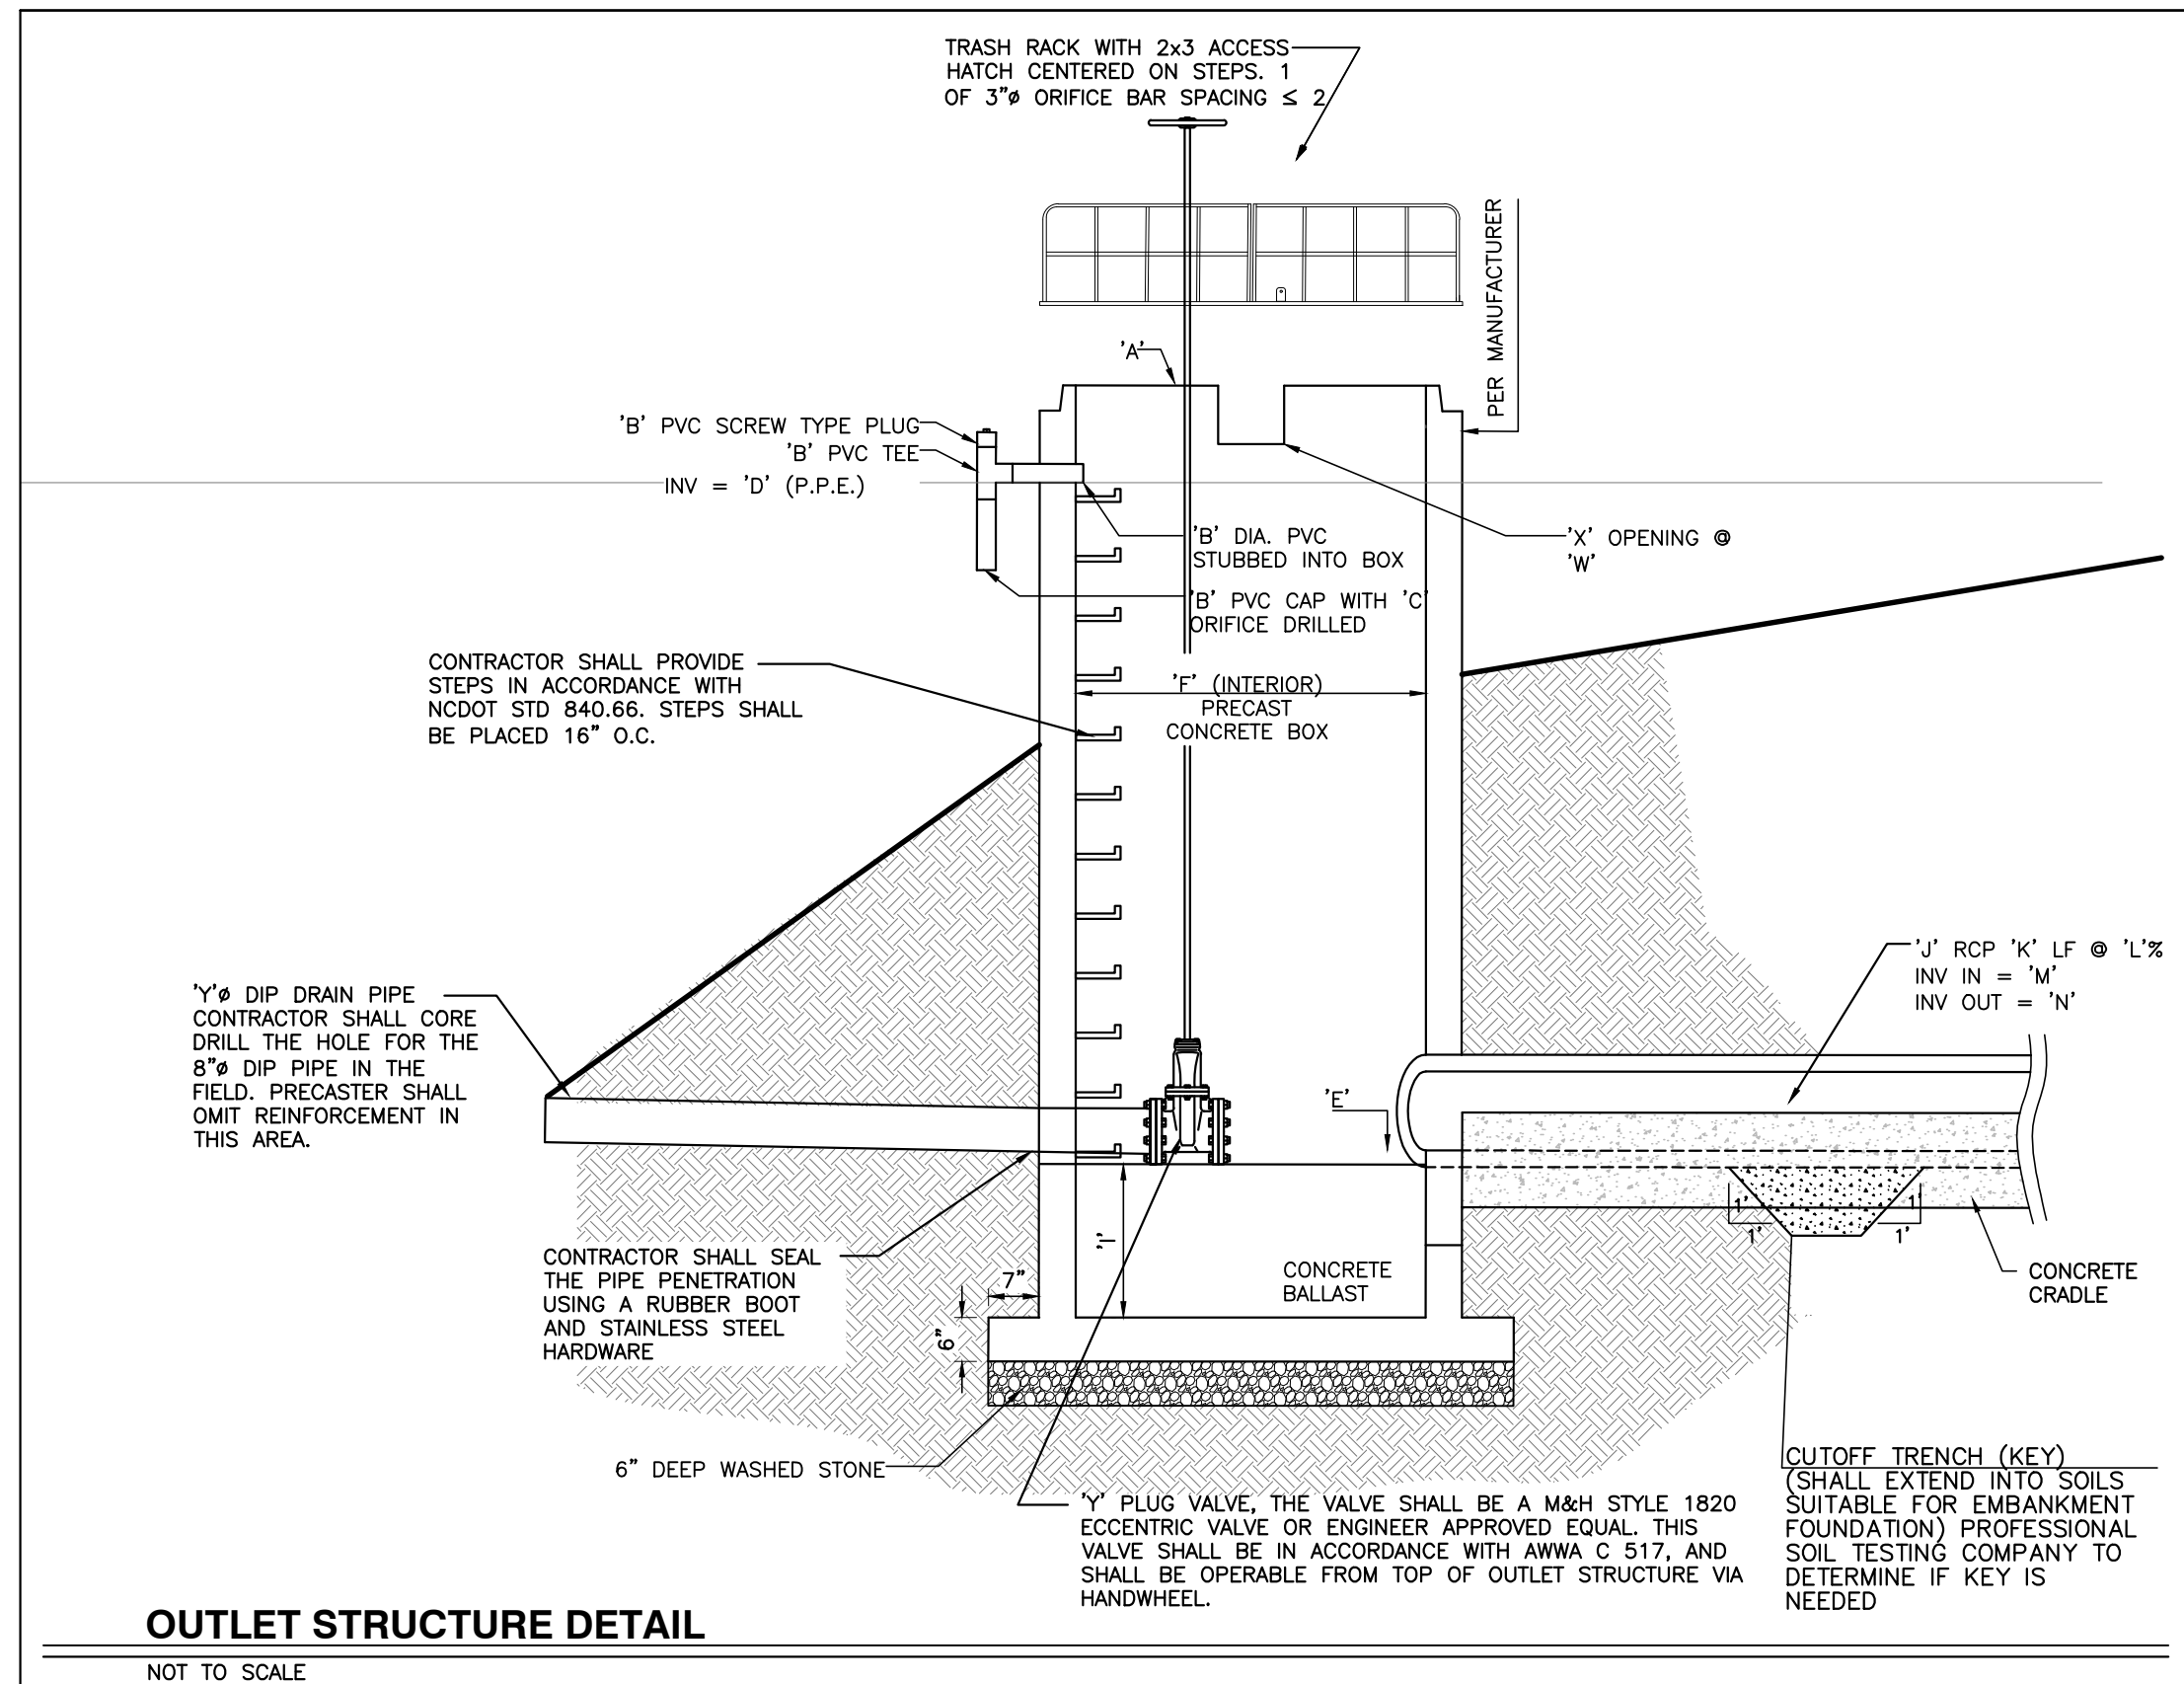


OUTLET STRUCTURE DETAIL

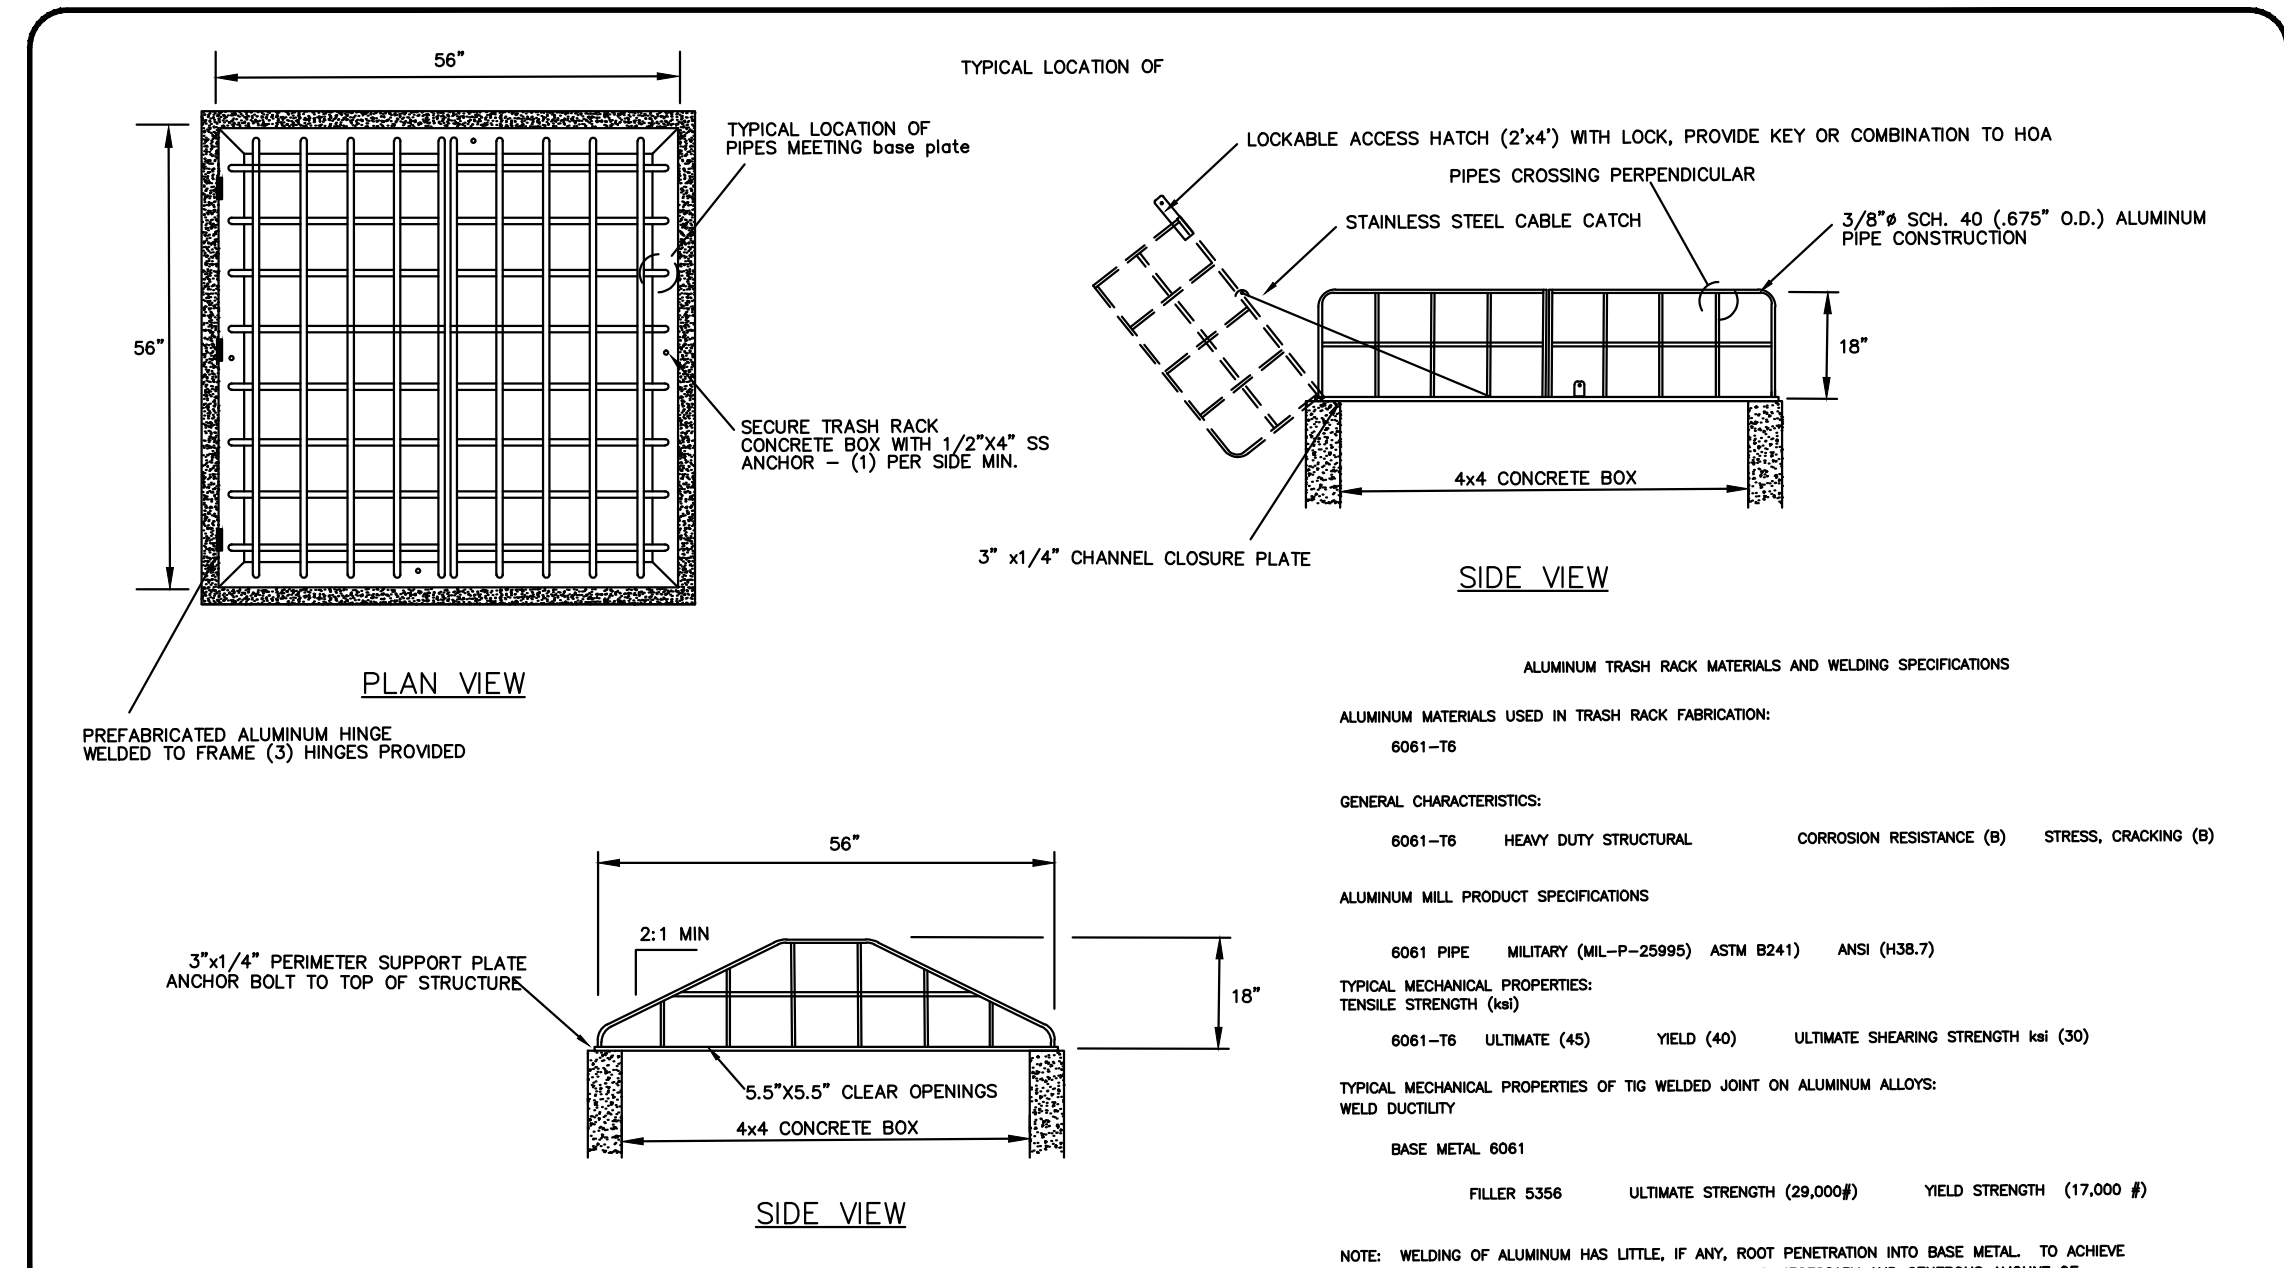

TRASH RACK SUBMITTAL - Aluminum Trashrack for 4x4 Box

TRASH RACK DETAIL

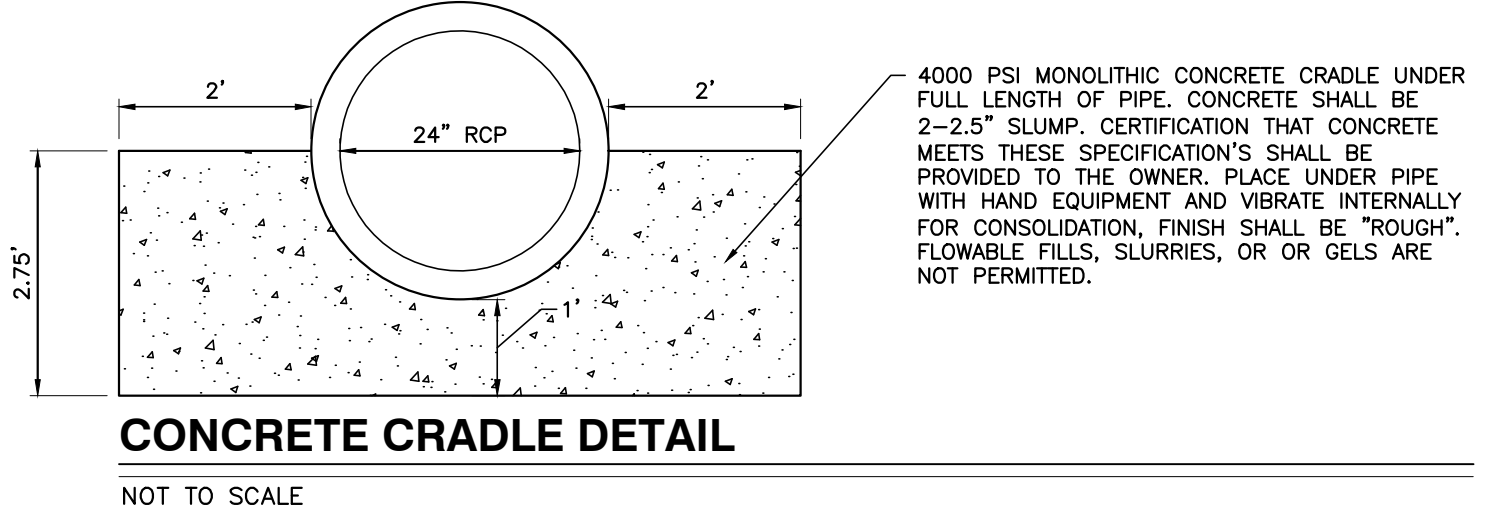

CONCRETE CRADLE DETAIL


CITY OF RALEIGH - PLANS AUTHORIZED FOR CONSTRUCTION. Electronic Approval: This approval is being issued electronically. This approval is valid only upon the signature of a City of Raleigh Review Officer below.



3/10/22

NO FLOODPLAINS EXIST ON-SITE

NOTE: ALL CONSTRUCTION ACTIVITY MUST BE IN ACCORDANCE WITH THE ACCEPTED POLICIES OF THE TOWN OF ROLESVILLE AND NCDOT

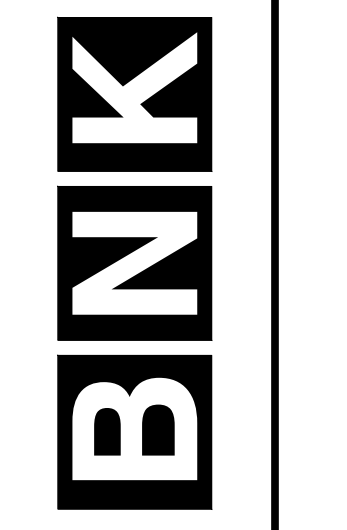

BASS, NIXON & KENNEDY, INC. CONSULTING ENGINEERS. 6310 CHAPEL HILL ROAD, SUITE 250, RALEIGH, NC 27607

Table with columns: NO., DATE, DESCRIPTION, BY. Lists revisions to the drawing.

PROGRESS MRM DATE DRAWN BY. JOB NO. BMP DETAILS. SCALE: N.T.S. CHK BY: MDB

COBBLESTONE VILLAGE MIXED USE DEVELOPMENT. TOWN OF ROLESVILLE, WAKE COUNTY, NORTH CAROLINA

SHEET C3.2

**CONSTRUCTION SEQUENCE - STAGE 1**

- ONCE THE EROSION AND SEDIMENT CONTROL PLAN APPROVAL AND NCG01 CERTIFICATE OF COVERAGE ARE OBTAINED, SCHEDULE A PRECONSTRUCTION CONFERENCE WITH THE ENVIRONMENTAL CONSULTANT, OBTAIN A LAND-DISTURBING PERMIT.
- INSTALL GRAVEL CONSTRUCTION PAD, TEMPORARY DIVERSIONS, SILT FENCE, SKIMMER SEDIMENT BASINS AND OTHER MEASURES AS SHOWN ON THE APPROVED PLAN. CLEAR ONLY AS NECESSARY TO INSTALL THESE DEVICES. SEED TEMPORARY DIVERSIONS, BERMS AND BASINS IMMEDIATELY AFTER CONSTRUCTION.
- CALL ENVIRONMENTAL CONSULTANT FOR AN ONSITE INSPECTION BY THE ENVIRONMENTAL CONSULTANT TO OBTAIN A CERTIFICATE OF COMPLIANCE.
- BEGIN CLEARING AND GRUBBING. MAINTAIN DEVICES AS NEEDED. ROUGH GRADE SITE.
- STABILIZE SITE AS AREAS ARE BROUGHT UP TO FINISH GRADE WITH VEGETATION, PAVING, DITCH LININGS, ETC. SEED AND MULCH DENUDEED AREAS PER GROUND STABILIZATION TIME FRAMES.
- STABILIZE SITE AS AREAS ARE BROUGHT UP TO FINISH GRADE WITH VEGETATION, ALLEY PAVING, DITCH LININGS, ETC. SEED AND MULCH DENUDEED AREAS PER GROUND STABILIZATION TIME FRAMES.
- CALL ENVIRONMENTAL CONSULTANT FOR AN ONSITE INSPECTION BY THE ENVIRONMENTAL CONSULTANT PRIOR TO THE REMOVAL OF SKIMMER SEDIMENT BASIN #1.
- CONTINUE TO SOIL EROSION PLAN STAGE 2 ONCE SKIMMER BASIN #1 HAS BEEN REMOVED.

NOTE: WAKE COUNTY MUST GRANT PERMISSION TO CONVERT THE SEDIMENT BASIN OVER TO THE STORMWATER USE PRIOR TO COMPLETING ANY RELATED WORK.  
TOTAL DISTURBED AREA = 11.0 AC

**DENUDED AREA = 10.96 AC**

**REQUIRED WAKE COUNTY BASIN REMOVAL AND/OR CONVERSION SEQUENCE**

- SCHEDULE A SITE MEETING WITH THE ENVIRONMENTAL CONSULTANT TO DETERMINE IF A BASIN CAN BE REMOVED OR CONVERTED TO A PERMANENT STORMWATER POND, INSTALL SILT FENCING OR OTHER TEMPORARY EROSION CONTROL MEASURES AS NEEDED PRIOR TO REMOVAL OF THE BASIN.
- UTILIZE OUTLET STRUCTURES THAT WITHDRAW WATER FROM THE SEDIMENT BASIN SURFACE FOR DRAW DOWN OF WATER IN BASIN FOR MAINTENANCE OR CLOSE OUT UNLESS INFEASIBLE. SEE REQUIREMENTS OF NCG01 PERMIT PART I, SECTION C, ITEM (4) ENTITLED "DRAW DOWN OF SEDIMENT BASINS FOR MAINTENANCE OR CLOSE OUT" AND REFER TO WAKE COUNTY "FILTER BAG FOR DEWATERING ACTIVITIES" CONSTRUCTION DETAIL.
- REMOVE BASIN(S) AND ASSOCIATED TEMPORARY DIVERSION DITCHES, IF CULVERT PIPES NEED TO BE EXTENDED, PERFORM THIS OPERATION AT THIS TIME. FINE GRADE AREA IN PREPARATION FOR SEEDING.
- PERFORM SEEDBED PREPARATION, SEED, MULCH AND ASPHALT TACK ANY RESULTING BARE AREAS IMMEDIATELY.
- INSTALL VELOCITY DISSIPATORS AND/OR LEVEL SPREADERS AS REQUIRED ON THE EROSION CONTROL PLAN.
- WHEN SITE IS FULLY STABILIZED, CALL ENVIRONMENTAL CONSULTANT FOR APPROVAL OF REMOVING REMAINING TEMPORARY EROSION CONTROL MEASURES AND ADVISE ON WHEN SITE CAN BE ISSUED A CERTIFICATE OF COMPLETION. NOTE: A MEETING SHOULD ALSO BE SCHEDULED WITH THE ENVIRONMENTAL CONSULTANT TO DETERMINE WHEN A BASIN MAY BE CONVERTED FOR STORMWATER USE. SOME MUNICIPALITIES MAY ALSO REQUIRE THIS.

**SEDIMENT BASIN SUMMARY CHART**

| Sediment Basin Number      | 1                       | 2                       | 3                      |
|----------------------------|-------------------------|-------------------------|------------------------|
| Drainage Area (Acres)      | 3.42                    | 4.61                    | 0.6                    |
| Orifice (ft)               | (0.5)(7.22)(3.42)=12.35 | (0.5)(7.22)(4.61)=16.64 | (0.5)(7.22)(0.60)=2.17 |
| Weir Size (ft)             | 10 x 1.5                | 10 x 1.5                | 10 x 1.5               |
| Surface Area Required (SF) | (435)(12.35)=5,372      | (435)(16.64)=7,238      | (435)(2.17)=944        |
| Volume Required (CF)       | (1800)(3.42)=6,156      | (1800)(4.61)=8,298      | (1800)(0.60)=1,080     |
| Dimensions (ft)            | see plans               | see plans               | see plans              |
| Surface Area Provided (SF) | 5,400                   | 10,640                  | 1,584                  |
| Volume Provided (CF)       | 13,572                  | 27,636                  | 2,563                  |
| Skimmer Size               | 4"                      | 4"                      | 3"                     |
| Orifice Radius             | 0.5"                    | 0.5"                    | 0.25                   |
| Orifice Diameter           | 1.0"                    | 1.25"                   | 0.5                    |
| Drawdown Time (days)       | 4.62                    | 3.98                    | 3.74                   |
| Number of Baffles          | 3                       | 3                       | 3                      |

**DITCH/CHANNEL CALCULATIONS**

| DIVERSION DITCH ID | LENGTH (LF) | DA (Ac) | G10 (CFS) | SLOPE (%) | V10 (FPS) | LINER* | PERMISSIBLE SHEAR STRESS (PSF) | CALCULATED SHEAR STRESS (PSF) |
|--------------------|-------------|---------|-----------|-----------|-----------|--------|--------------------------------|-------------------------------|
| DV-1               | 296         | 1.02    | 2.34      | 2.00      | 2.01      | SC150  | 2.00                           | 0.78                          |
| DV-2               | 495         | 1.00    | 2.30      | 2.60      | 2.29      | SC150  | 2.00                           | 0.84                          |
| DV-3               | 442         | 0.52    | 1.19      | 1.80      | 0.92      | SC150  | 1.80                           | 0.29                          |
| DV-4               | 167         | 0.08    | 0.13      | 2.90      | 0.96      | SC150  | 1.80                           | 0.38                          |

\*NAG = NORTH AMERICAN GREEN OR EQUIVALENT

**CITY OF RALEIGH - PLANS AUTHORIZED FOR CONSTRUCTION**

Electronic Approval: This approval is being issued electronically. This approval is valid only upon the signature of a City of Raleigh Review Officer below. The City will retain a copy of the approved plans. Any work authorized by this approval must proceed in accordance with the plans kept on file with the City. This electronic approval may not be edited once issued. Any modification to this approval once issued will invalidate this approval.

City of Raleigh Development Approval \_\_\_\_\_

Raleigh Water Review Officer \_\_\_\_\_

**Skimmer Basin #1**

Okay

- 3.42 Drainage Area (Acres)
- 12.35 Peak Flow from 10-year Storm (cfs)
- 6156 Required Volume (ft<sup>3</sup>)
- 6372 Required Surface Area (ft<sup>2</sup>)
- 60.2 Suggested Width (ft)
- 103.7 Suggested Length (ft)
- 54 Trial Top Width at Spillway Invert (ft)
- 100 Trial Top Length at Spillway Invert (ft)
- 2 Trial Side Slope Ratio Z:1
- 3 Trial Depth (ft) (2 to 3.5 feet above grade)
- 48 Bottom Width (ft)
- 96 Bottom Length (ft)
- 3606 Bottom Area (ft<sup>2</sup>)
- 1572 Actual Volume (ft<sup>3</sup>)
- 5400 Actual Surface Area (ft<sup>2</sup>)
- 10 Trial Weir Length (ft)
- 0.75 Suggested Trial Depth of Flow (ft)
- 30.0 Spillway Capacity (cfs)
- 4 Skimmer Size (inches)
- 0.333 Head on Skimmer (feet)
- 1.25 Orifice Size (1/4 inch increments)
- 4.62 Dewatering Time (days)
- Required 3 to 5 days for Wake County

**Skimmer Basin #2**


Okay

- 4.61 Drainage Area (Acres)
- 16.64 Peak Flow from 10-year Storm (cfs)
- 8298 Required Volume (ft<sup>3</sup>)
- 7238 Required Surface Area (ft<sup>2</sup>)
- 60.2 Suggested Width (ft)
- 120.3 Suggested Length (ft)
- 56 Trial Top Width at Spillway Invert (ft)
- 190 Trial Top Length at Spillway Invert (ft)
- 2 Trial Side Slope Ratio Z:1
- 3 Trial Depth (ft) (2 to 3.5 feet above grade)
- 44 Bottom Width (ft)
- 88 Bottom Length (ft)
- 7832 Bottom Area (ft<sup>2</sup>)
- 2763 Actual Volume (ft<sup>3</sup>)
- 10640 Actual Surface Area (ft<sup>2</sup>)
- 20 Trial Weir Length (ft)
- 0.75 Suggested Trial Depth of Flow (ft)
- 39.0 Spillway Capacity (cfs)
- 4 Skimmer Size (inches)
- 0.333 Head on Skimmer (feet)
- 1.25 Orifice Size (1/4 inch increments)
- 3.98 Dewatering Time (days)
- Required 3 to 5 days for Wake County

**Skimmer Basin #3**

Okay


- 0.6 Drainage Area (Acres)
- 2.17 Peak Flow from 10-year Storm (cfs)
- 1080 Required Volume (ft<sup>3</sup>)
- 944 Required Surface Area (ft<sup>2</sup>)
- 21.7 Suggested Width (ft)
- 43.4 Suggested Length (ft)
- 33 Trial Top Width at Spillway Invert (ft)
- 48 Trial Top Length at Spillway Invert (ft)
- 2 Trial Side Slope Ratio Z:1
- 2 Trial Depth (ft) (2 to 3.5 feet above grade)
- 23 Bottom Width (ft)
- 40 Bottom Length (ft)
- 1000 Bottom Area (ft<sup>2</sup>)
- 2563 Actual Volume (ft<sup>3</sup>)
- 1584 Actual Surface Area (ft<sup>2</sup>)
- 10 Trial Weir Length (ft)
- 0.75 Suggested Trial Depth of Flow (ft)
- 19.3 Spillway Capacity (cfs)
- 3 Skimmer Size (inches)
- 0.25 Head on Skimmer (feet)
- 0.8 Orifice Size (1/4 inch increments)
- 3.74 Dewatering Time (days)
- Required 3 to 5 days for Wake County

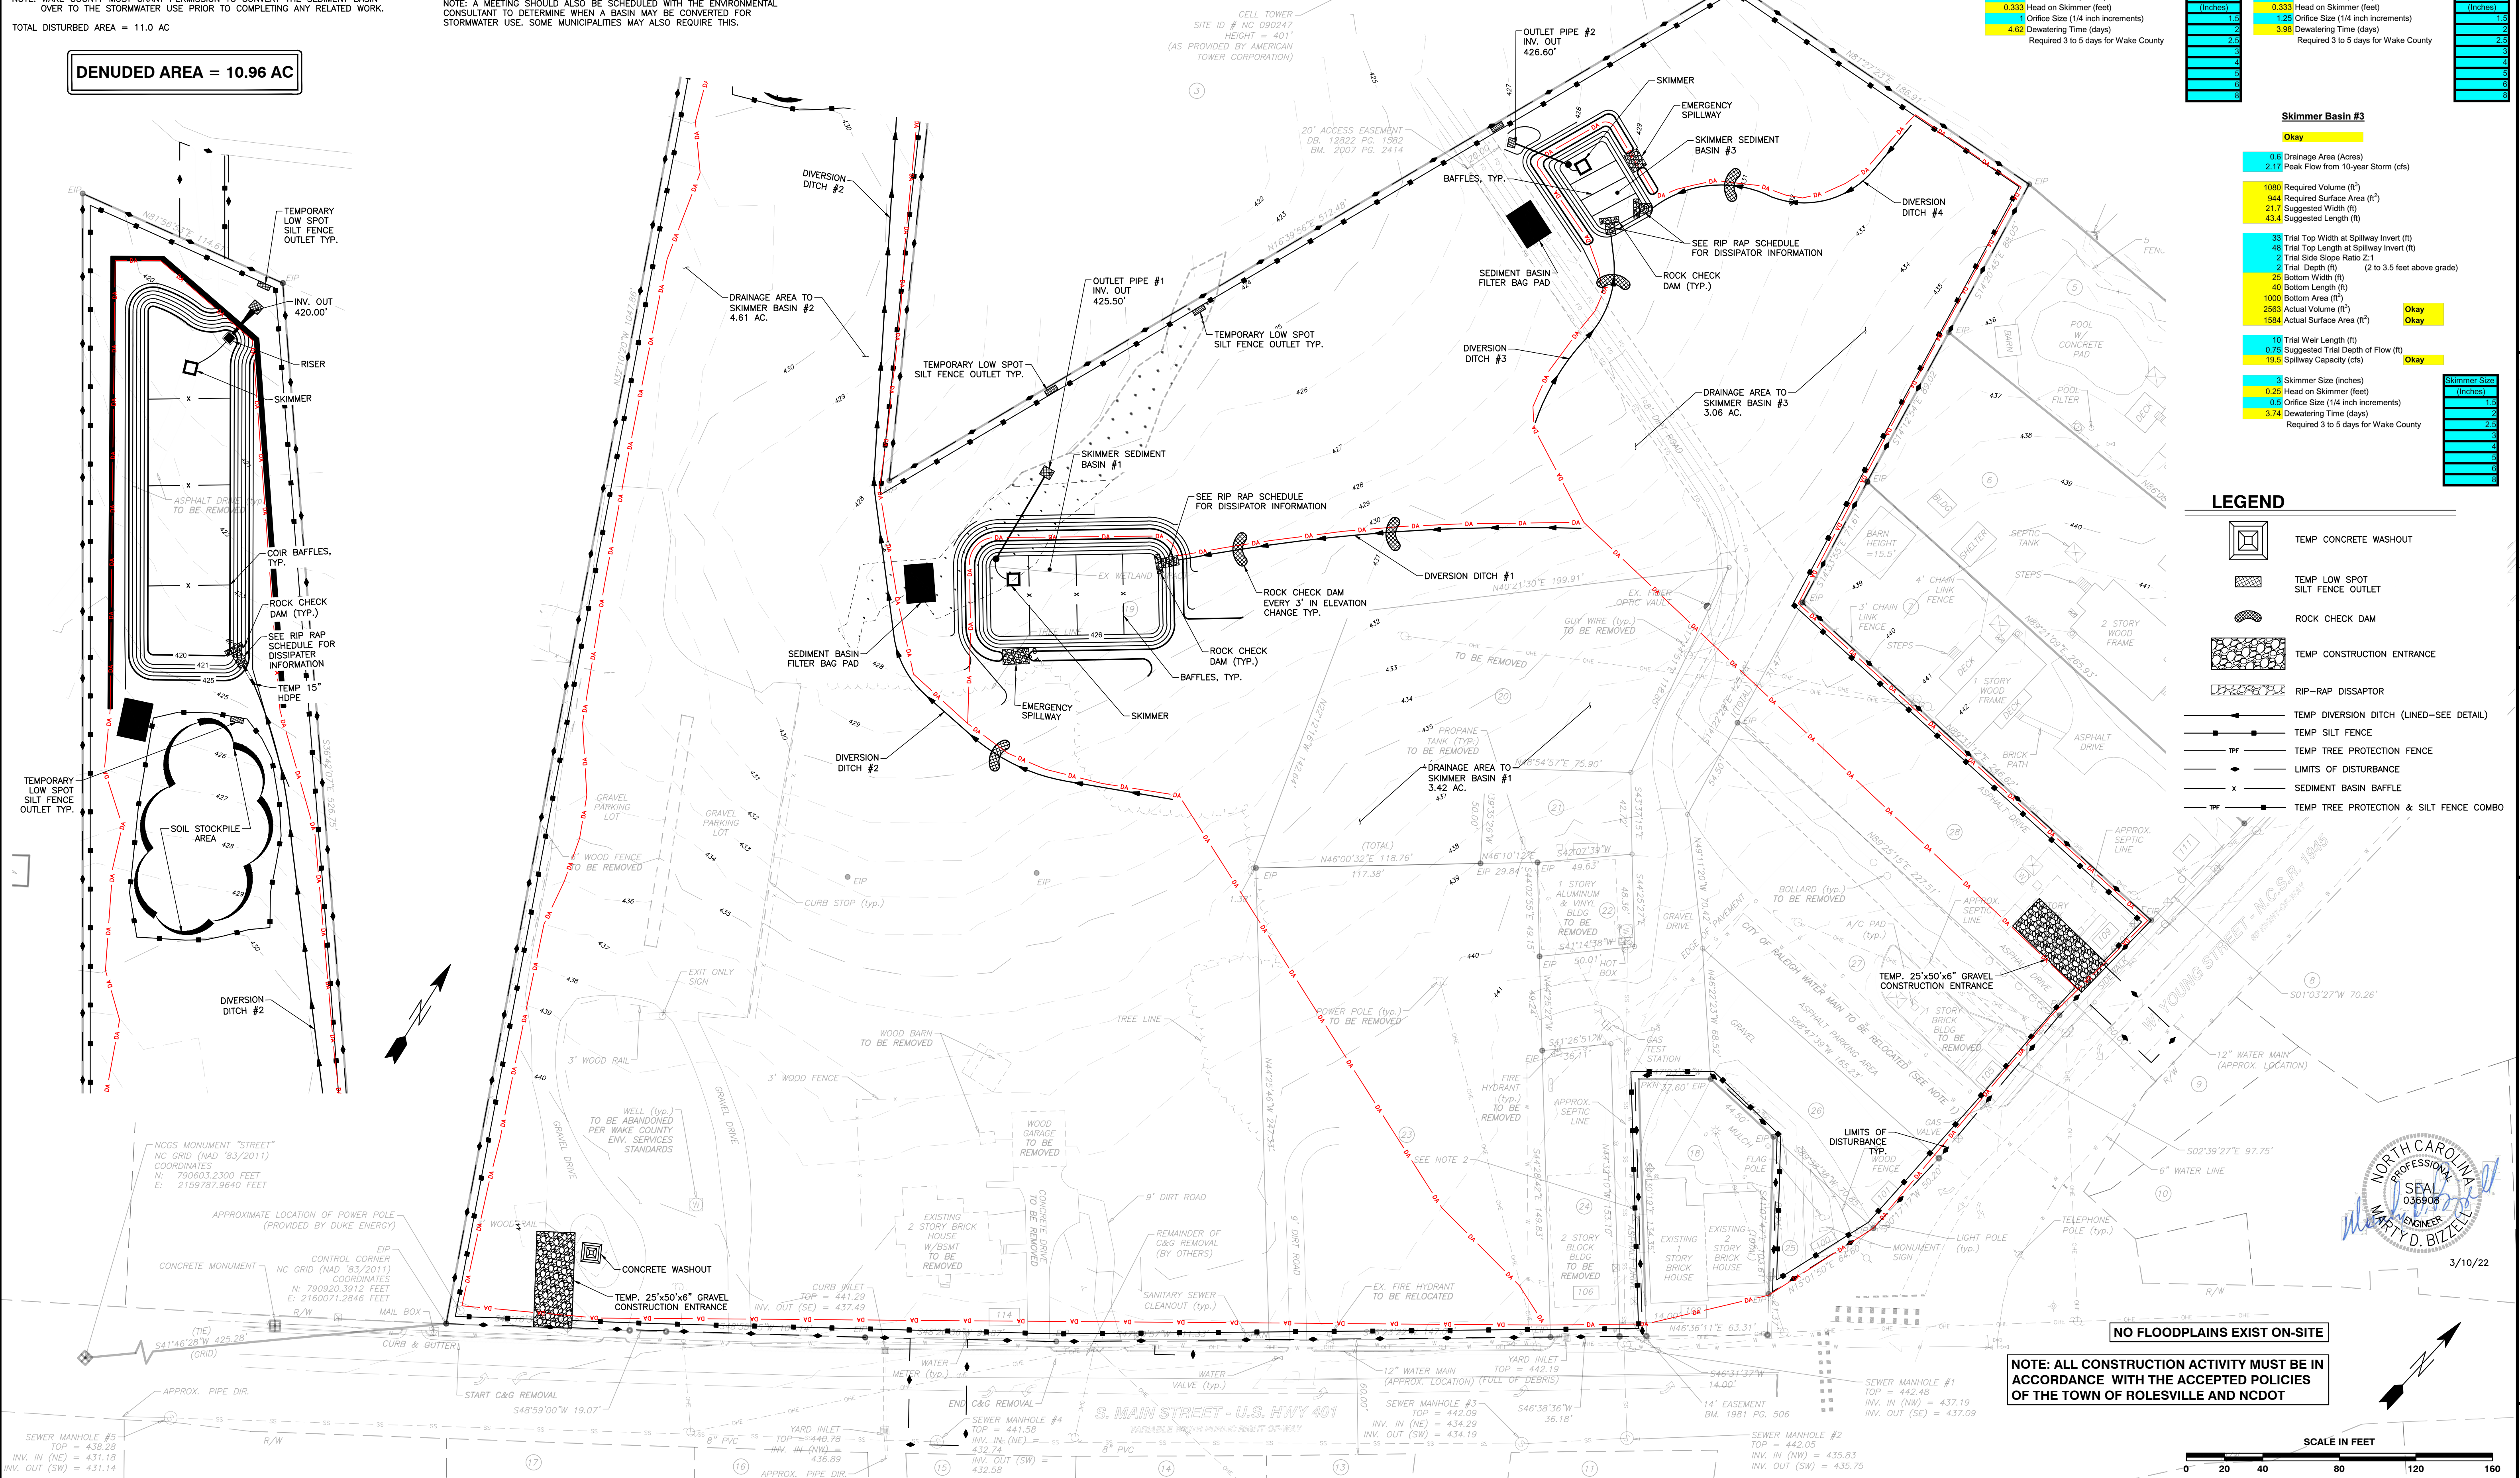

**LEGEND**

- TEMP CONCRETE WASHOUT
- TEMP LOW SPOT SILT FENCE OUTLET
- ROCK CHECK DAM
- TEMP CONSTRUCTION ENTRANCE
- RIP-RAP DISSIPATOR
- TEMP DIVERSION DITCH (LINED-SEE DETAIL)
- TEMP SILT FENCE
- TEMP TREE PROTECTION FENCE
- LIMITS OF DISTURBANCE
- SEDIMENT BASIN BAFFLE
- TEMP TREE PROTECTION & SILT FENCE COMBO

**NOTE: ALL CONSTRUCTION ACTIVITY MUST BE IN ACCORDANCE WITH THE ACCEPTED POLICIES OF THE TOWN OF ROLESVILLE AND NCDOT**

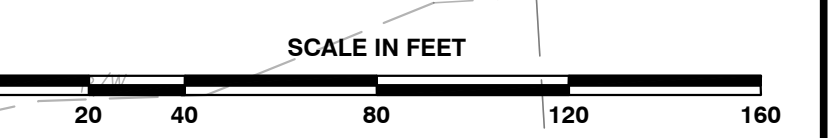

**BASS, NIXON & KENNEDY, INC.**  
CONSULTING ENGINEERS  
6310 CHARLETTOWN ROAD, SUITE 250, RALEIGH, NC 27607  
TELEPHONE: (919)881-4422 FAX: (919)881-8686  
CERTIFICATION NUMBERS: NCBELS (C-0110); NCBOLA (C-0267)

**COBBLESTONE VILLAGE**  
MIXED USE DEVELOPMENT  
TOWN OF ROLESVILLE, WAKE COUNTY, NORTH CAROLINA

**PROGRESS** MRM  
**DATE** DRAWN BY  
**JOB NO.** EROSION CONTROL  
PLAN - STAGE 1

**NO. DATE DESCRIPTION REVISIONS**

SCALE: 1" = 40'

CHK BY: MDB

**SHEET C3.3**

**TOWN OF ROLESVILLE PROJECT NO.**

3/10/22

NOT RELEASED FOR CONSTRUCTION OR BID SOLICITATION

### CONSTRUCTION SEQUENCE - STAGE 2

- BEGIN CONSTRUCTION OF ALL BUILDINGS.
  - STABILIZE SITE AS NEW DISTURBED AREAS ARE BROUGHT UP TO FINISH GRADE WITH VEGETATION, PAVING, DITCH LININGS, ETC. SEED AND MULCH DENuded AREAS PER GROUND STABILIZATION TIME FRAMES.
  - WHEN CONSTRUCTION OF PARKING LOTS ARE COMPLETE AND ALL AREAS ARE STABILIZED COMPLETELY, CALL ENVIRONMENTAL CONSULTANT FOR AN INSPECTION.
  - IF THE SITE IS APPROVED, REMOVE TEMPORARY DIVERSIONS, SILT FENCE, SEDIMENT BASINS, ETC., AND SEED OUT OR STABILIZE ANY RESULTING BARE AREAS. ALL REMAINING PERMANENT EROSION CONTROL DEVICES, SUCH AS VELOCITY DISSIPATORS, SHOULD NOW BE INSTALLED.
  - WHEN VEGETATION HAS BECOME ESTABLISHED, CALL FOR A FINAL SITE INSPECTION BY THE ENVIRONMENTAL CONSULTANT, OBTAIN A CERTIFICATE OF COMPLETION.
- NOTE: WAKE COUNTY MUST GRANT PERMISSION TO CONVERT THE SEDIMENT BASIN OVER TO THE STORMWATER USE PRIOR TO COMPLETING ANY RELATED WORK.
- TOTAL DISTURBED AREA = 10.96 AC
- ENVIRONMENTAL CONSULTANT: JEEVAN NEUPANE (919-819-8907)

### REQUIRED WAKE COUNTY BASIN REMOVAL AND/OR CONVERSION SEQUENCE

- SCHEDULE A SITE MEETING WITH THE ENVIRONMENTAL CONSULTANT TO DETERMINE IF A BASIN CAN BE REMOVED OR CONVERTED TO A PERMANENT STORMWATER POND. INSTALL SILT FENCING OR OTHER TEMPORARY EROSION CONTROL MEASURES AS NEEDED PRIOR TO REMOVAL OF THE BASIN.
- UTILIZE OUTLET STRUCTURES THAT WITHDRAW WATER FROM THE SEDIMENT BASIN SURFACE FOR DRAW DOWN OF WATER IN BASIN FOR MAINTENANCE OR CLOSE OUT UNLESS INFEASIBLE. SEE REQUIREMENTS OF NC001 PERMIT PART II, SECTION C, ITEM (4) ENTITLED "DRAW DOWN OF SEDIMENT BASINS FOR MAINTENANCE OR CLOSE OUT" AND REFER TO WAKE COUNTY "FILTER BAG FOR DEWATERING ACTIVITIES" CONSTRUCTION DETAIL.
- REMOVE BASIN(S) AND ASSOCIATED TEMPORARY DIVERSION DITCHES. IF CULVERT PIPES NEED TO BE EXTENDED, PERFORM THIS OPERATION AT THIS TIME. FINE GRADE AREA IN PREPARATION FOR SEEDING.
- PERFORM SEEDBED PREPARATION, SEED, MULCH AND ASPHALT TACK ANY RESULTING BARE AREAS IMMEDIATELY.
- INSTALL VELOCITY DISSIPATORS AND/OR LEVEL SPREADERS AS REQUIRED ON THE EROSION CONTROL PLAN.
- WHEN SITE IS FULLY STABILIZED, CALL ENVIRONMENTAL CONSULTANT FOR APPROVAL OF REMOVING REMAINING TEMPORARY EROSION CONTROL MEASURES AND ADVICE ON WHEN SITE CAN BE ISSUED A CERTIFICATE OF COMPLETION. NOTE: A MEETING SHOULD ALSO BE SCHEDULED WITH THE ENVIRONMENTAL CONSULTANT TO DETERMINE WHEN A BASIN MAY BE CONVERTED FOR STORMWATER USE. SOME MUNICIPALITIES MAY ALSO REQUIRE THIS.

### Skimmer Basin #2

| Item   | Value | Status |
|--|-------|--------|
| 6.99 Drainage Area (Acres)                     | 6.99  | Okay   |
| 25.23 Peak Flow from 10-year Storm (cfs)       | 25.23 | Okay   |
| 12582 Required Volume (ft <sup>3</sup> )       | 12582 | Okay   |
| 10975 Required Surface Area (ft <sup>2</sup> ) | 10975 | Okay   |
| 74.1 Suggested Width (ft)                      | 74.1  | Okay   |
| 148.2 Suggested Length (ft)                    | 148.2 | Okay   |
| 58 Trial Top Width at Spillway Invert (ft)     | 58    | Okay   |
| 190 Trial Top Length at Spillway Invert (ft)   | 190   | Okay   |
| 2 Trial Side Slope Ratio 2:1                   | 2:1   | Okay   |
| 3 Trial Depth (ft) (2 to 3.5 feet above grade) | 3     | Okay   |
| 46 Bottom Width (ft)                           | 46    | Okay   |
| 178 Bottom Length (ft)                         | 178   | Okay   |
| 8188 Bottom Area (ft <sup>2</sup> )            | 8188  | Okay   |
| 28740 Actual Volume (ft <sup>3</sup> )         | 28740 | Okay   |
| 11020 Actual Surface Area (ft <sup>2</sup> )   | 11020 | Okay   |
| 20 Trial Weir Length (ft)                      | 20    | Okay   |
| 0.75 Suggested Trial Depth of Flow (ft)        | 0.75  | Okay   |
| 39.9 Spillway Capacity (cfs)                   | 39.9  | Okay   |
| 4 Skimmer Size (inches)                        | 4     | Okay   |
| 0.333 Head on Skimmer (feet)                   | 0.333 | Okay   |
| 156 Orifice Size (1/4 inch increments)         | 156   | Okay   |
| 4.20 Dewatering Time (days)                    | 4.20  | Okay   |

| Skimmer Size (inches) | Head on Skimmer (feet) |
|-----------------------|------------------------|
| 4                     | 0.333                  |
| 6                     | 0.167                  |
| 8                     | 0.111                  |
| 10                    | 0.074                  |
| 12                    | 0.056                  |
| 14                    | 0.043                  |
| 16                    | 0.034                  |
| 18                    | 0.028                  |
| 20                    | 0.023                  |
| 24                    | 0.017                  |
| 30                    | 0.011                  |
| 36                    | 0.008                  |
| 42                    | 0.006                  |
| 48                    | 0.005                  |
| 54                    | 0.004                  |
| 60                    | 0.003                  |
| 66                    | 0.003                  |
| 72                    | 0.002                  |
| 78                    | 0.002                  |
| 84                    | 0.002                  |
| 90                    | 0.002                  |
| 96                    | 0.002                  |
| 102                   | 0.002                  |
| 108                   | 0.002                  |
| 114                   | 0.002                  |
| 120                   | 0.002                  |

### SEDIMENT BASIN SUMMARY CHART

| Sediment Basin Number      | 1                      | 2                       |
|----------------------------|------------------------|-------------------------|
| Drainage Area (acres)      | 1.74                   | 6.99                    |
| Q10(cfs)                   | (0.5)(7.22)(1.74)=6.28 | (0.5)(7.22)(6.99)=25.23 |
| Weir Size (ft)             | 10 x 1.5               | 10 x 1.5                |
| Surface Area Required (SF) | (435)(6.28)=2,732      | (435)(25.23)=10,975     |
| Volume Required (CF)       | (1800)(1.74)=3,132     | (1800)(6.99)=12,582     |
| Dimensions (ft)            | see plans              | see plans               |
| Surface Area Provided (SF) | 2,800                  | 11,000                  |
| Volume Provided (CF)       | 5,646                  | 27,900                  |
| Skimmer Size               | 4"                     | 4"                      |
| Orifice Radius             | 0.4"                   | 0.75"                   |
| Orifice Diameter           | 0.75"                  | 1.5"                    |
| Drawdown Time (Days)       | 4.18                   | 4.2                     |
| Number of Baffles          | 3                      | 3                       |

### DITCH/CHANNEL CALCULATIONS

| DIVERSION DITCH ID | LENGTH (LF) | DA (Ac) | Q10 (CFS) | SLOPE (%) | V10 (FPS) | LINER * | PERMISSIBLE SHEAR STRESS (PSF) | CALCULATED SHEAR STRESS (PSF) |
|--------------------|-------------|---------|-----------|-----------|-----------|---------|--------------------------------|-------------------------------|
| DV-1               | 296         | 1.02    | 2.34      | 2.00      | 2.01      | SC150   | 2.00                           | 0.78                          |
| DV-2               | 495         | 1.00    | 2.30      | 2.60      | 2.29      | SC150   | 2.00                           | 0.94                          |
| DV-3               | 442         | 0.52    | 1.19      | 1.80      | 0.92      | SC150   | 1.80                           | 0.29                          |
| DV-4               | 167         | 0.06    | 0.13      | 2.90      | 0.96      | SC150   | 1.80                           | 0.38                          |

\* NAG = NORTH AMERICAN GREEN OR EQUIVALENT

### LEGEND


- TEMP CONSTRUCTION ENTRANCE
- TEMP LOW SPOT SILT FENCE OUTLET
- TEMP INLET PROTECTION
- RIP-RAP DISSIPATOR
- TEMP SILT FENCE
- TEMP TREE PROTECTION FENCE
- LIMITS OF DISTURBANCE
- SEDIMENT BASIN BAFFLE
- TEMP TREE PROTECTION & SILT FENCE COMBO

### CITY OF RALEIGH - PLANS AUTHORIZED FOR CONSTRUCTION

Electronic Approval: This approval is being issued electronically. This approval is valid only upon the signature of a City of Raleigh Review Officer below. The City will retain a copy of the approved plans. Any work authorized by this approval must proceed in accordance with the plans kept on file with the City. This electronic approval may not be edited once issued. Any modification to this approval once issued will invalidate this approval.

City of Raleigh Development Approval

Raleigh Water Review Officer

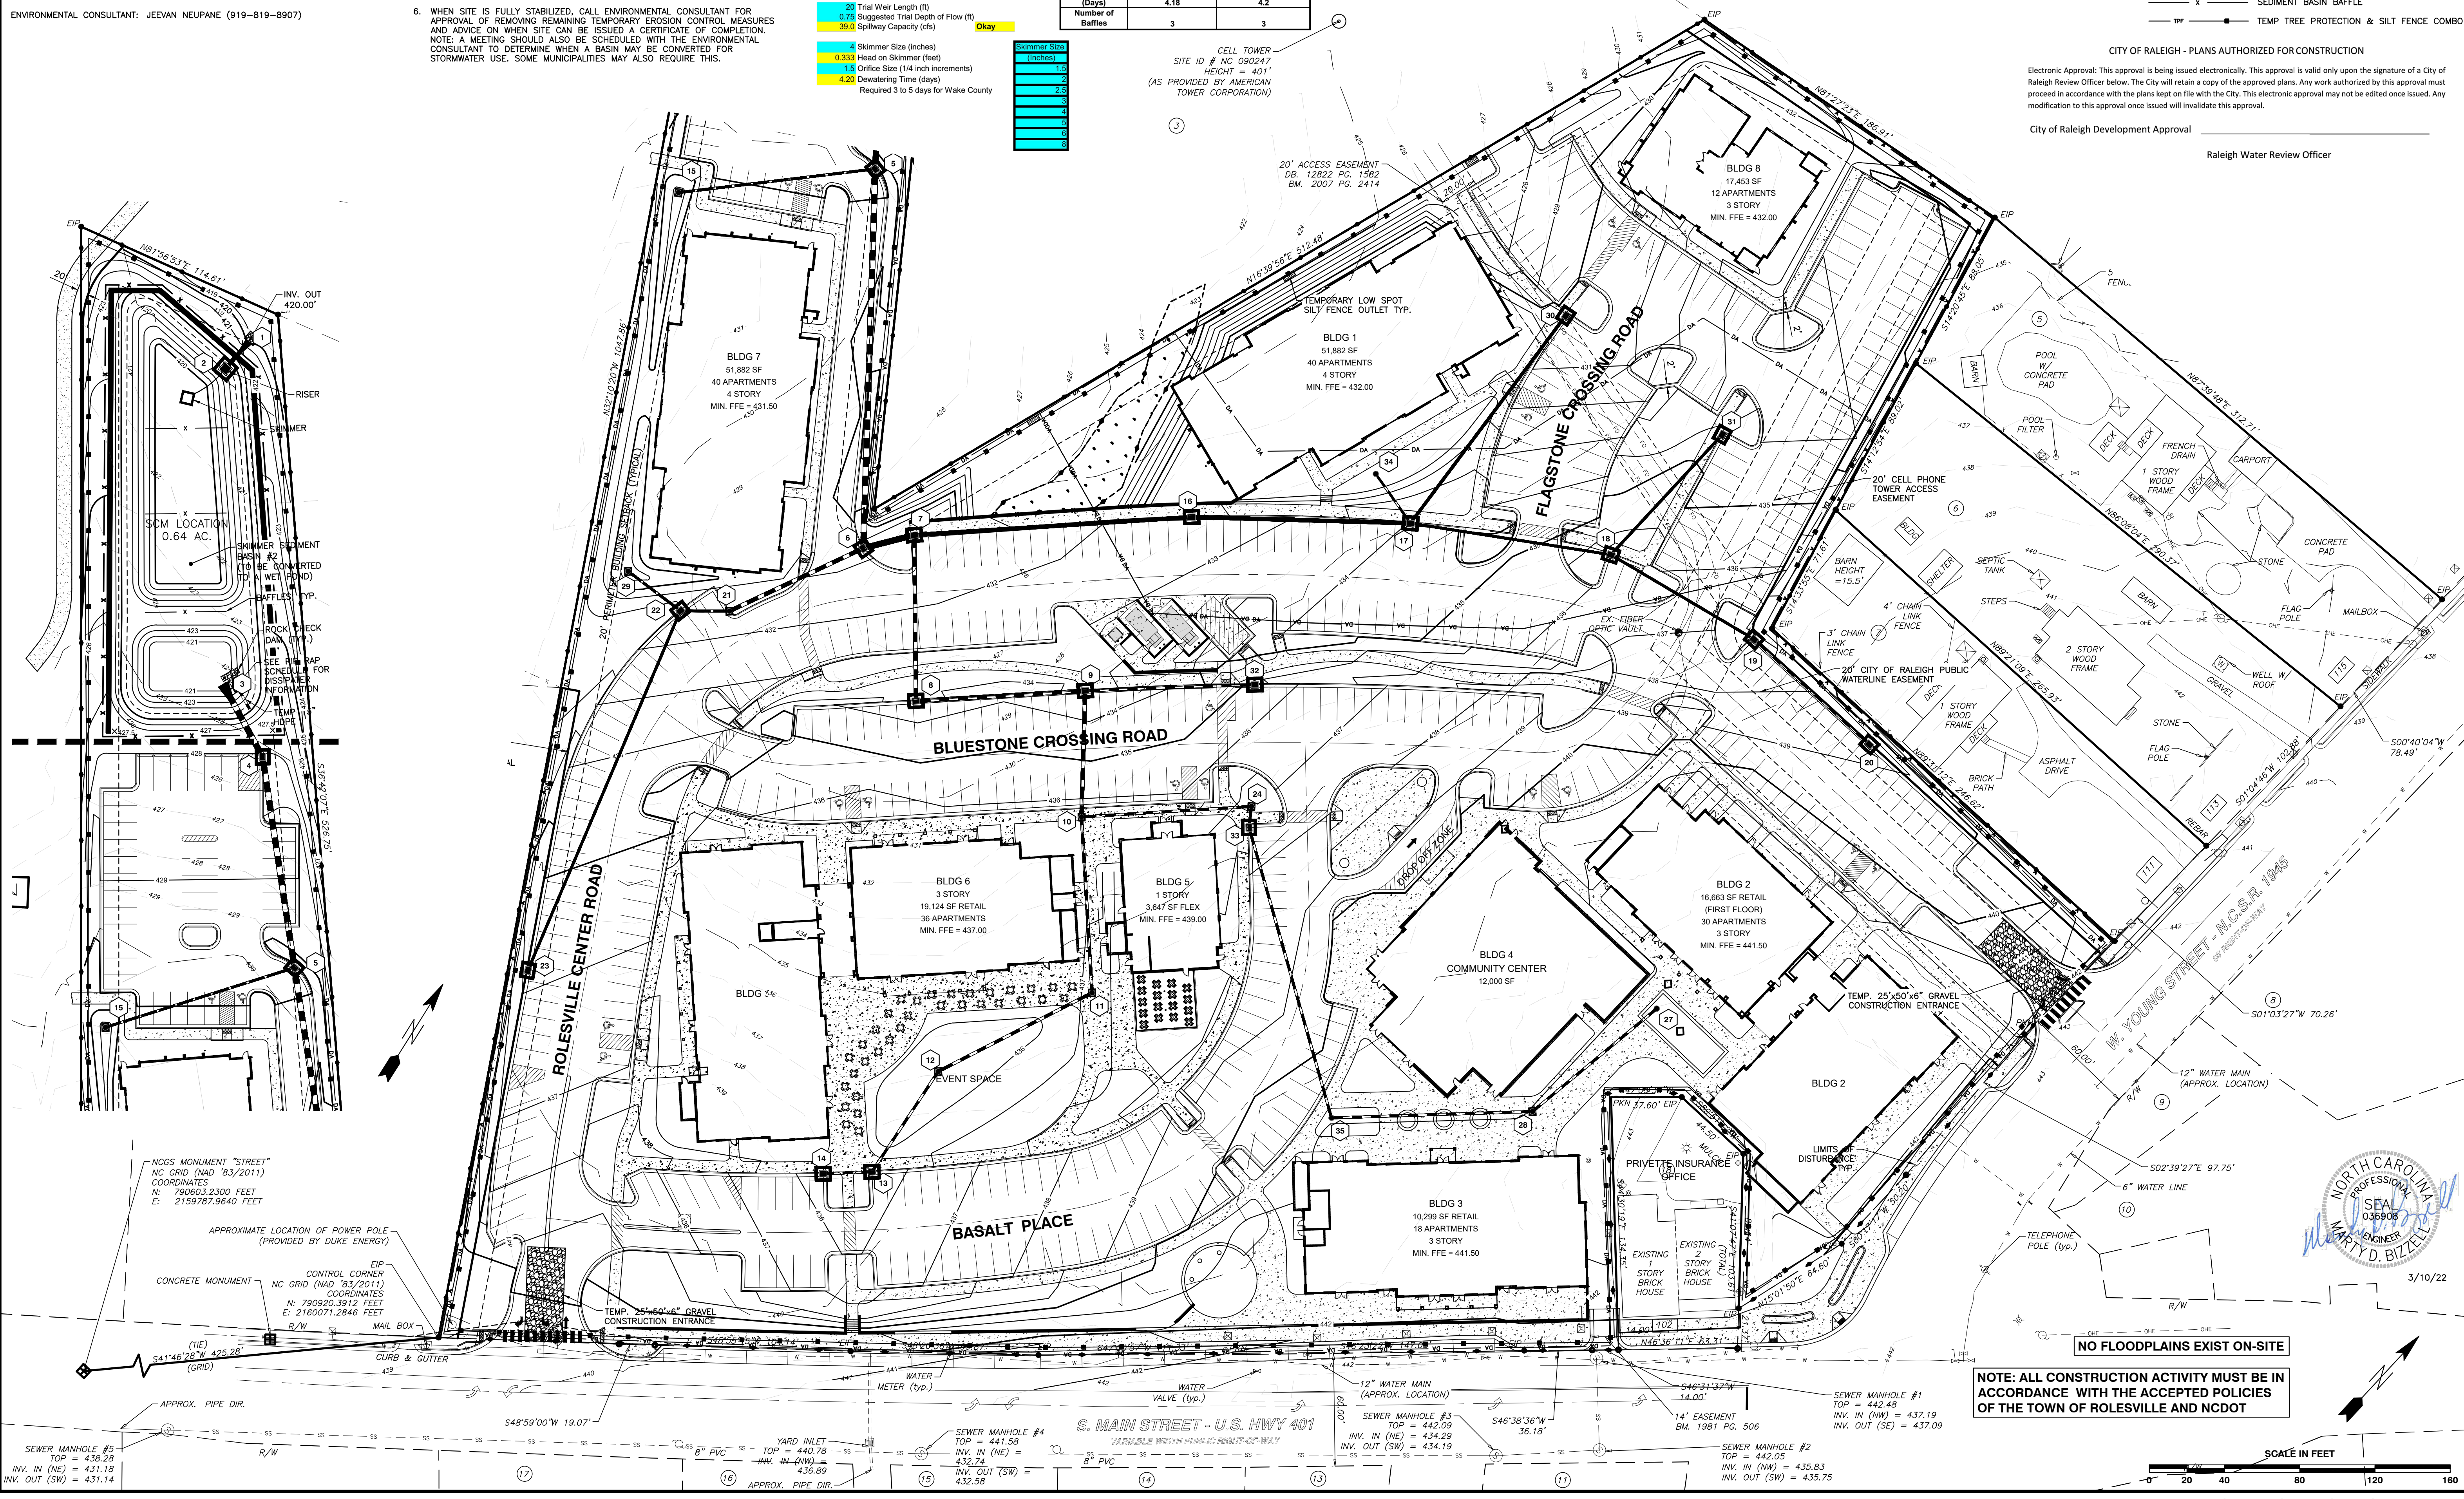

BNK

BASS, NIXON & KENNEDY, INC. CONSULTING ENGINEERS

6310 CHAPEL HILL ROAD, SUITE 250, RALEIGH, NC 27607

TELEPHONE: (919)881-4422 FAX: (919)881-8686

CERTIFICATION NUMBERS: NCBELS (C-0110); NCBOLA (C-0267)

JOB NO. 03-19187

DATE 03/10/2022

DRAWN BY MRM

CHECKED BY MRM

SCALE: 1" = 40'

EROSION CONTROL PLAN - STAGE 2

NO. DATE DESCRIPTION REVISIONS

| NO. | DATE | DESCRIPTION | BY |
|-----|------|-------------|----|
|     |      |             |    |

COBBLESTONE VILLAGE

MIXED USE DEVELOPMENT

TOWN OF ROLESVILLE, WAKE COUNTY, NORTH CAROLINA

NOT RELEASED FOR CONSTRUCTION OR BID SOLICITATION

SHEET C3.4

TOWN OF ROLESVILLE PROJECT NO.



R:\2019\19187 - Rolesville Town Center\CIVIL\04\_Construction\06 - 19187\_Erosion Control Phase 2.dwg, Erosion Control Phase 2, 3/10/2022 4:52:26 PM, marc.mueller





NOTE: ALL CONSTRUCTION ACTIVITY MUST BE IN ACCORDANCE WITH THE ACCEPTED POLICIES OF THE TOWN OF ROLESVILLE AND NCDOT







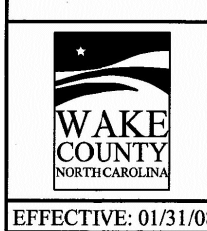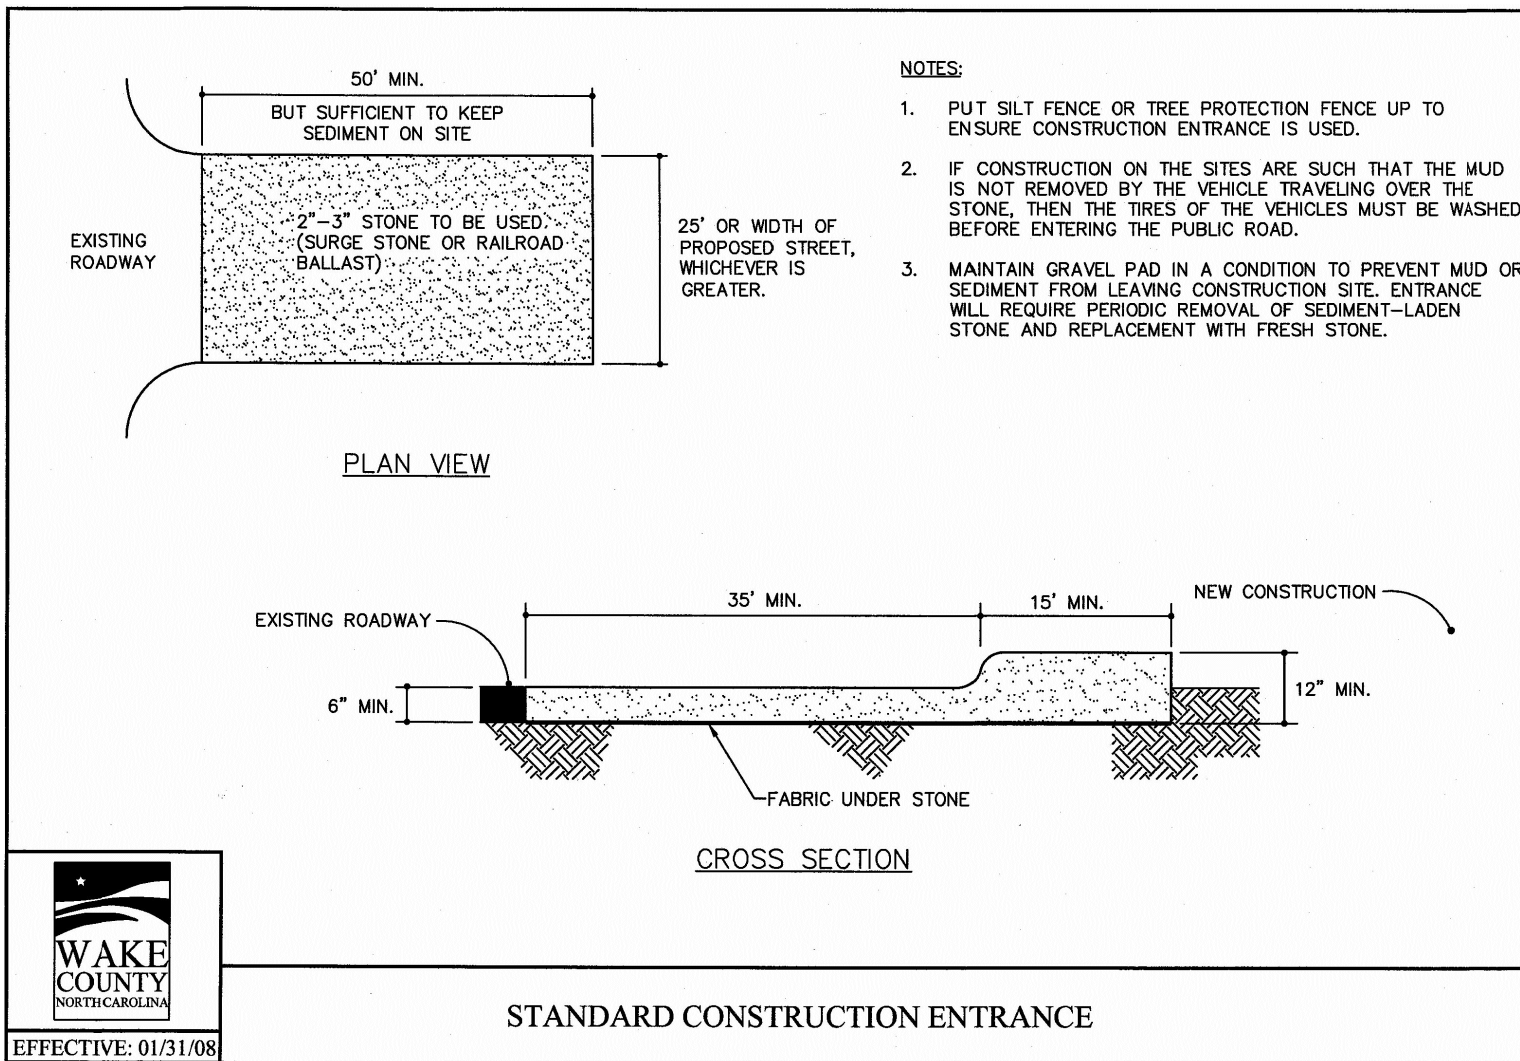



EFFECTIVE: 01/31/08

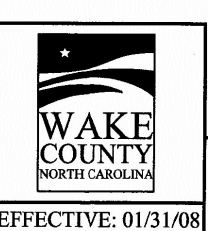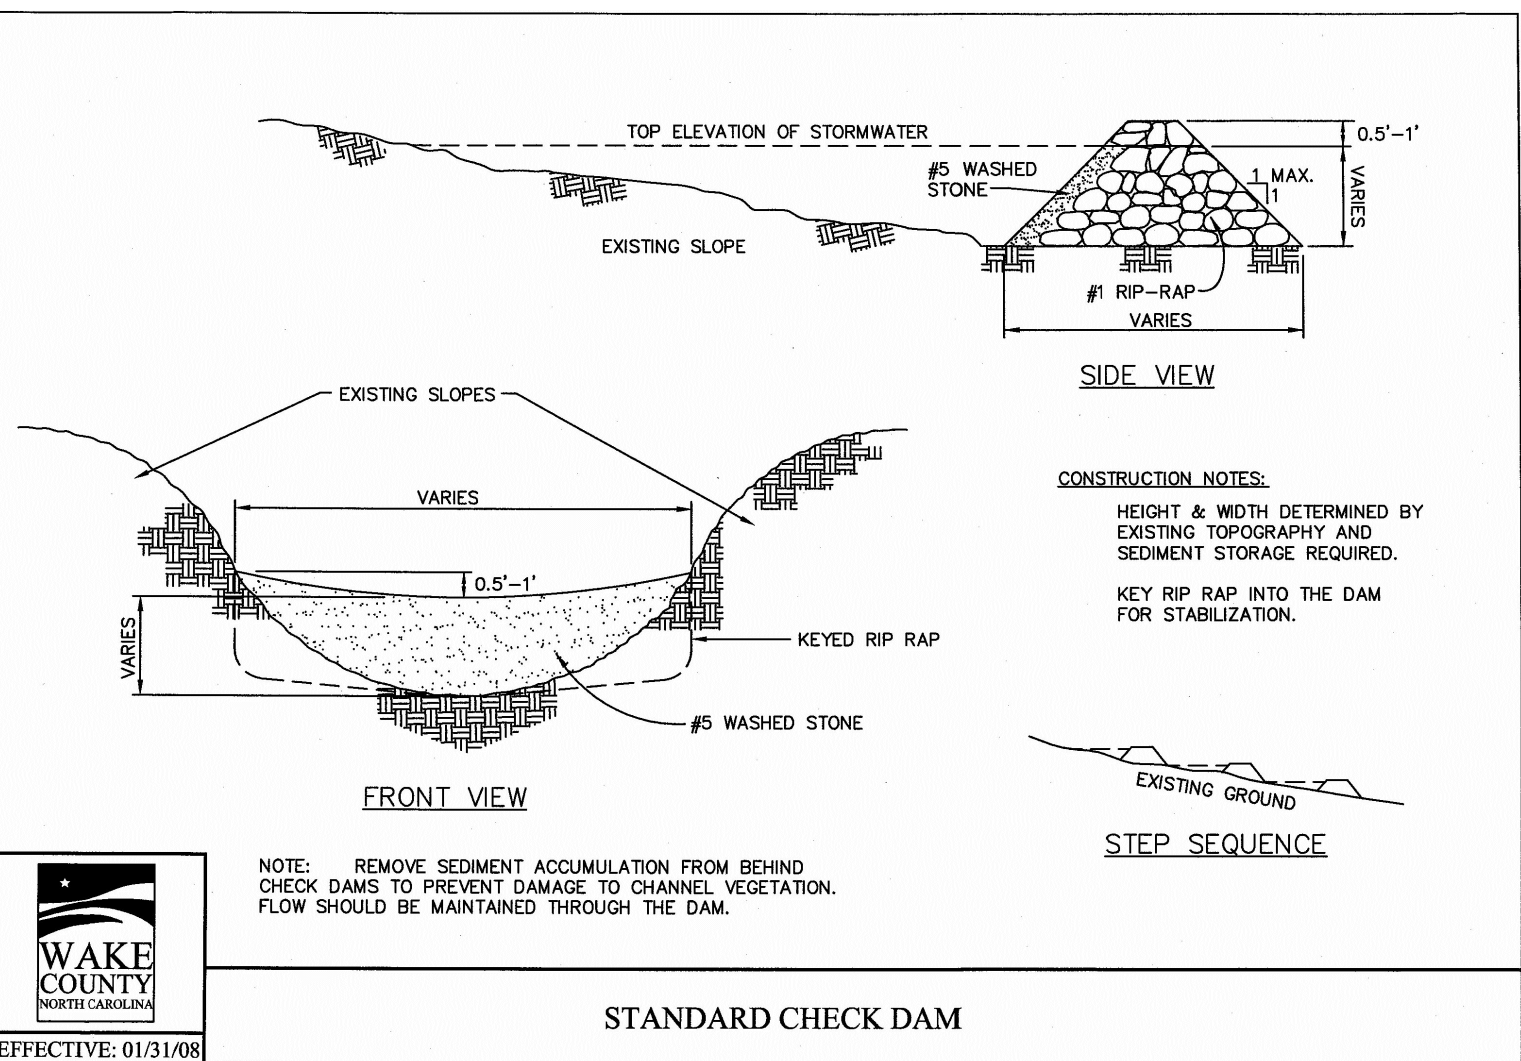



EFFECTIVE: 01/31/08

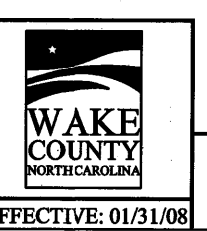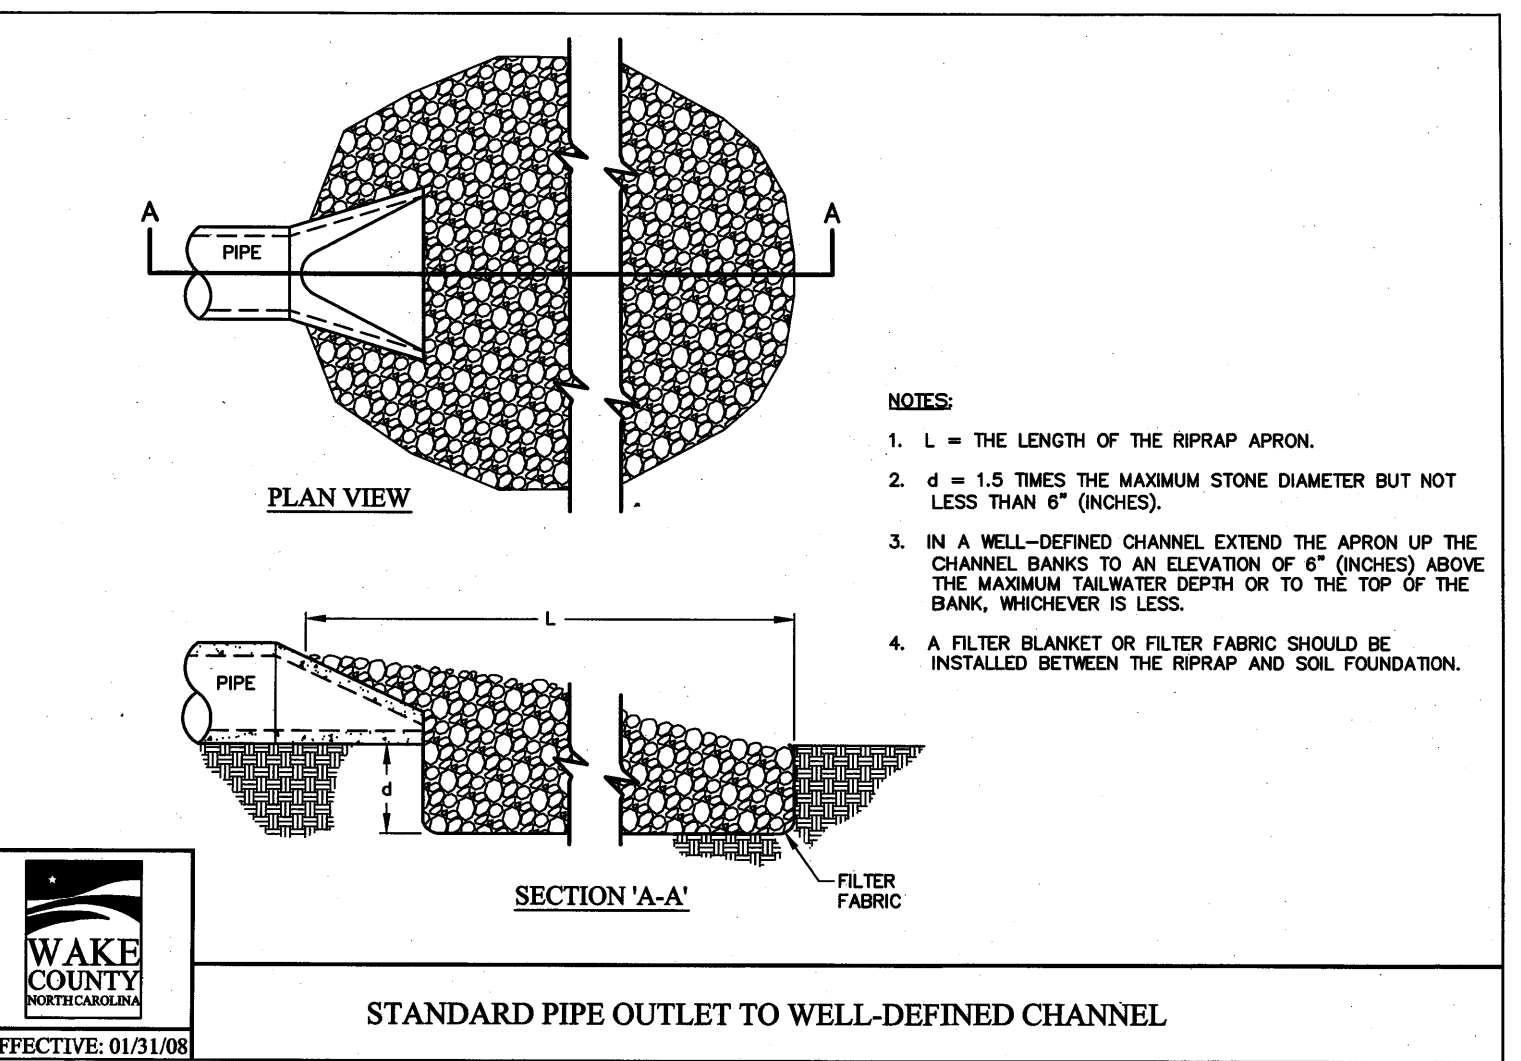



EFFECTIVE: 01/31/08

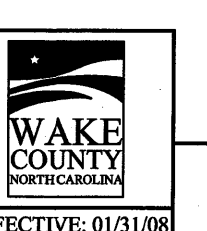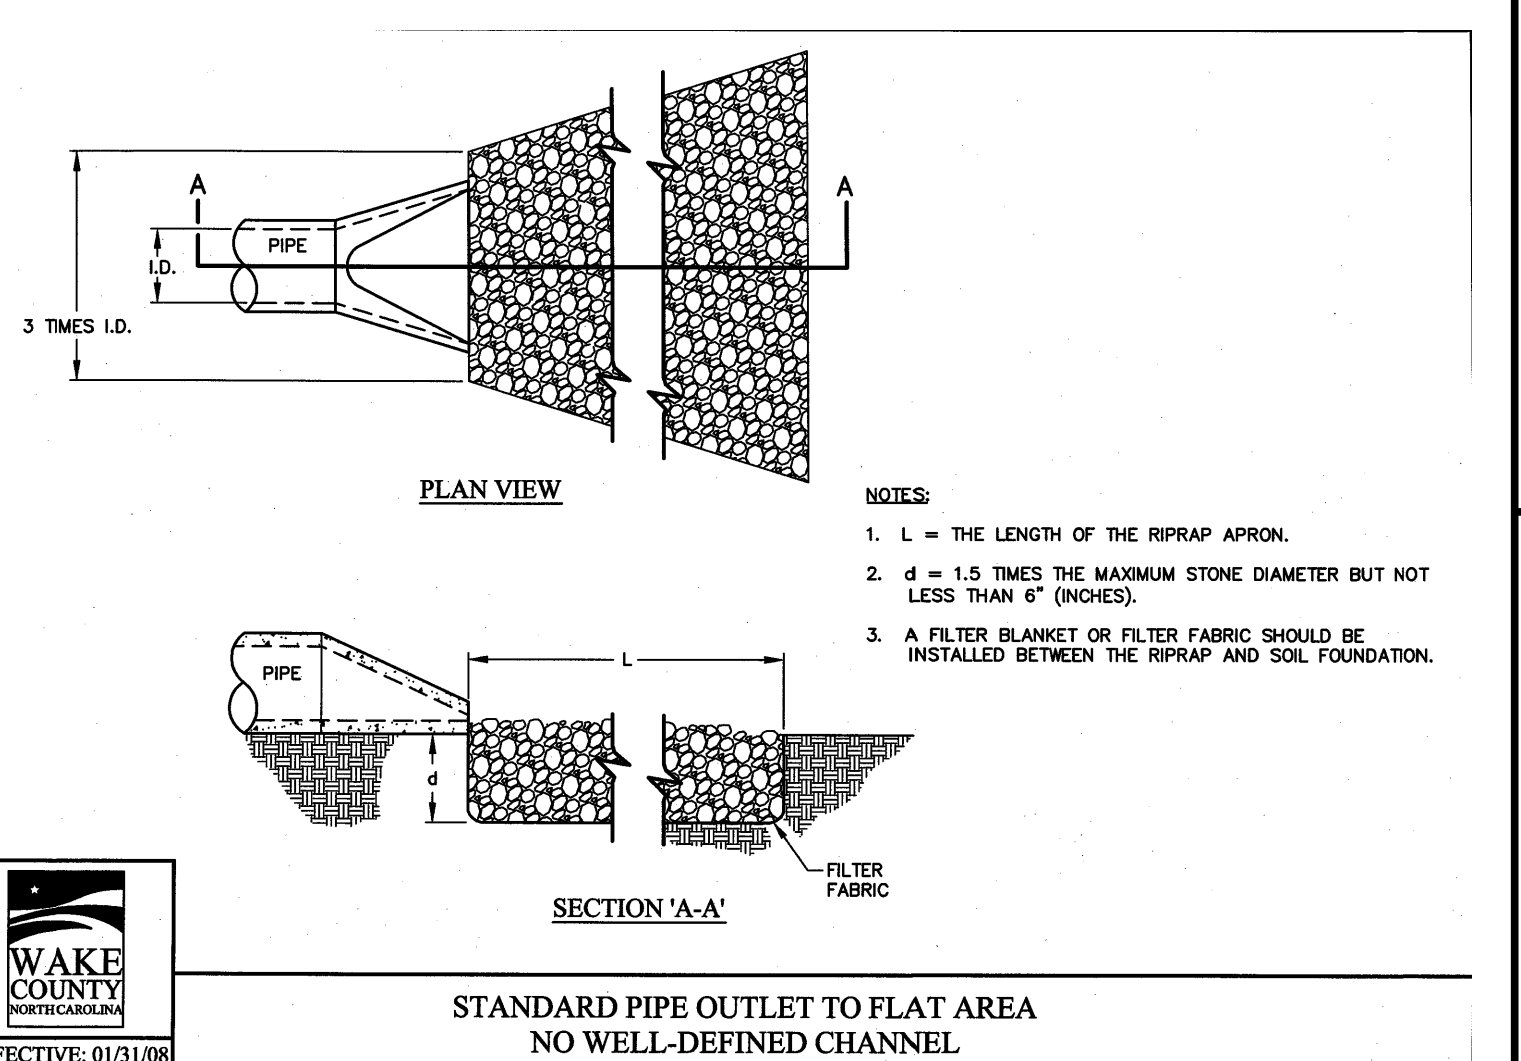



EFFECTIVE: 01/31/08

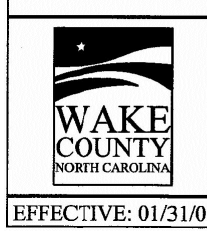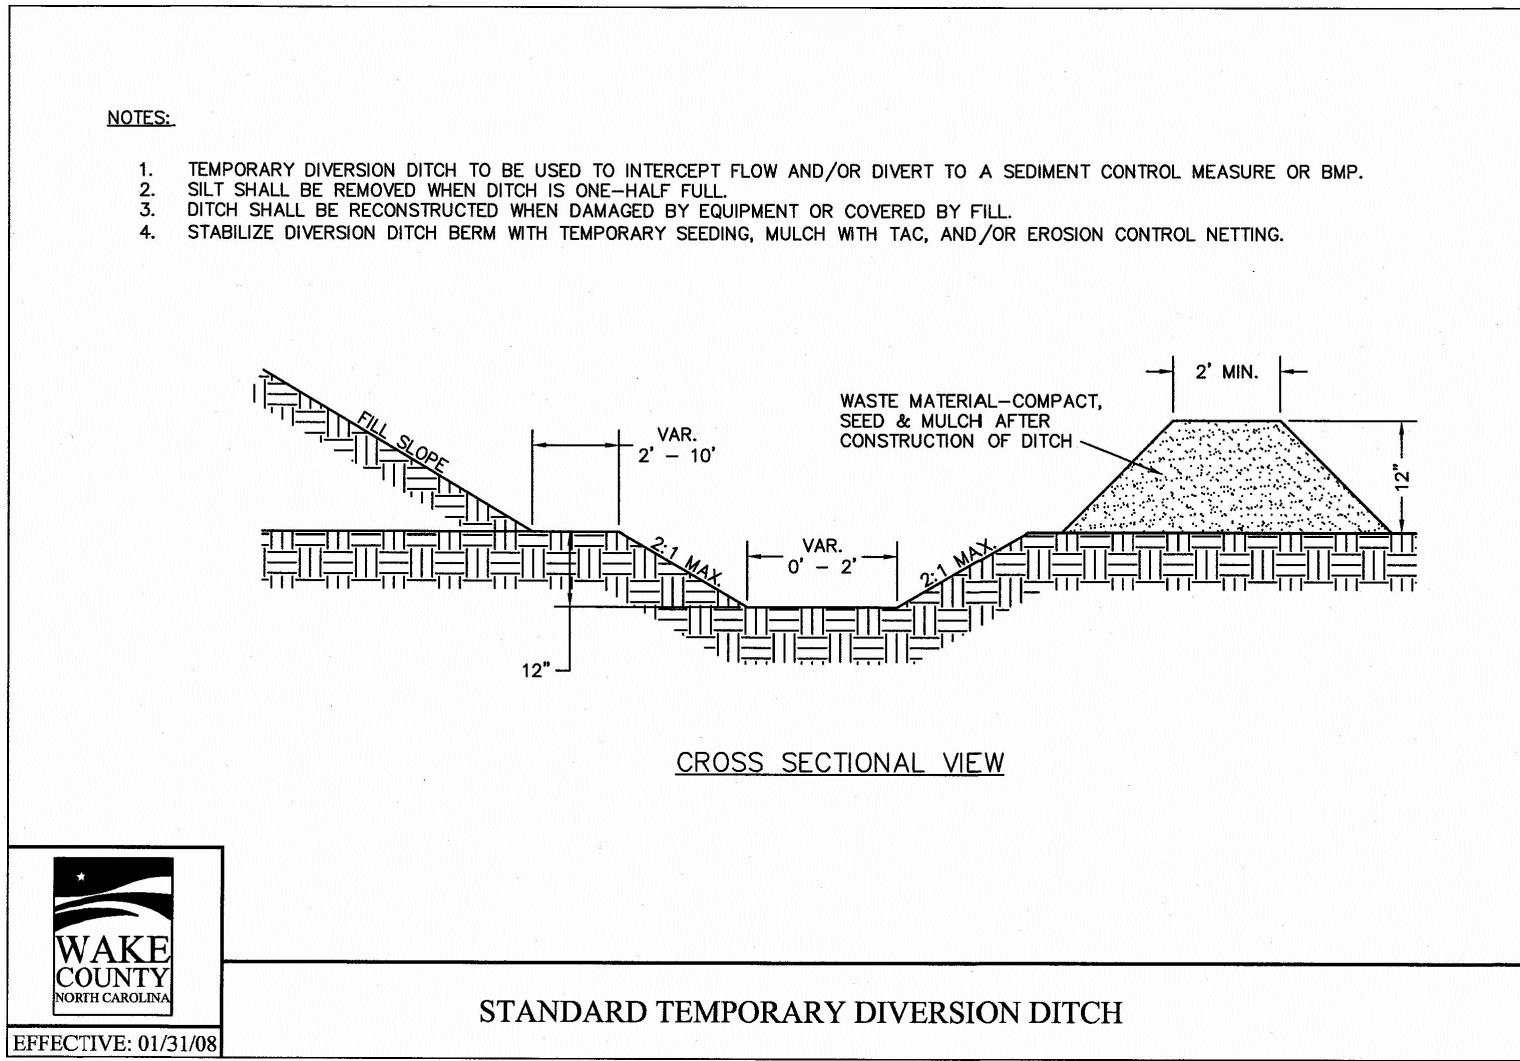


EFFECTIVE: 01/31/08

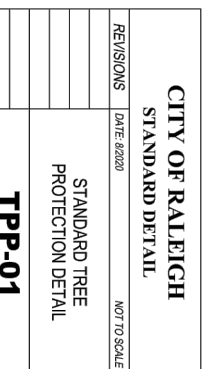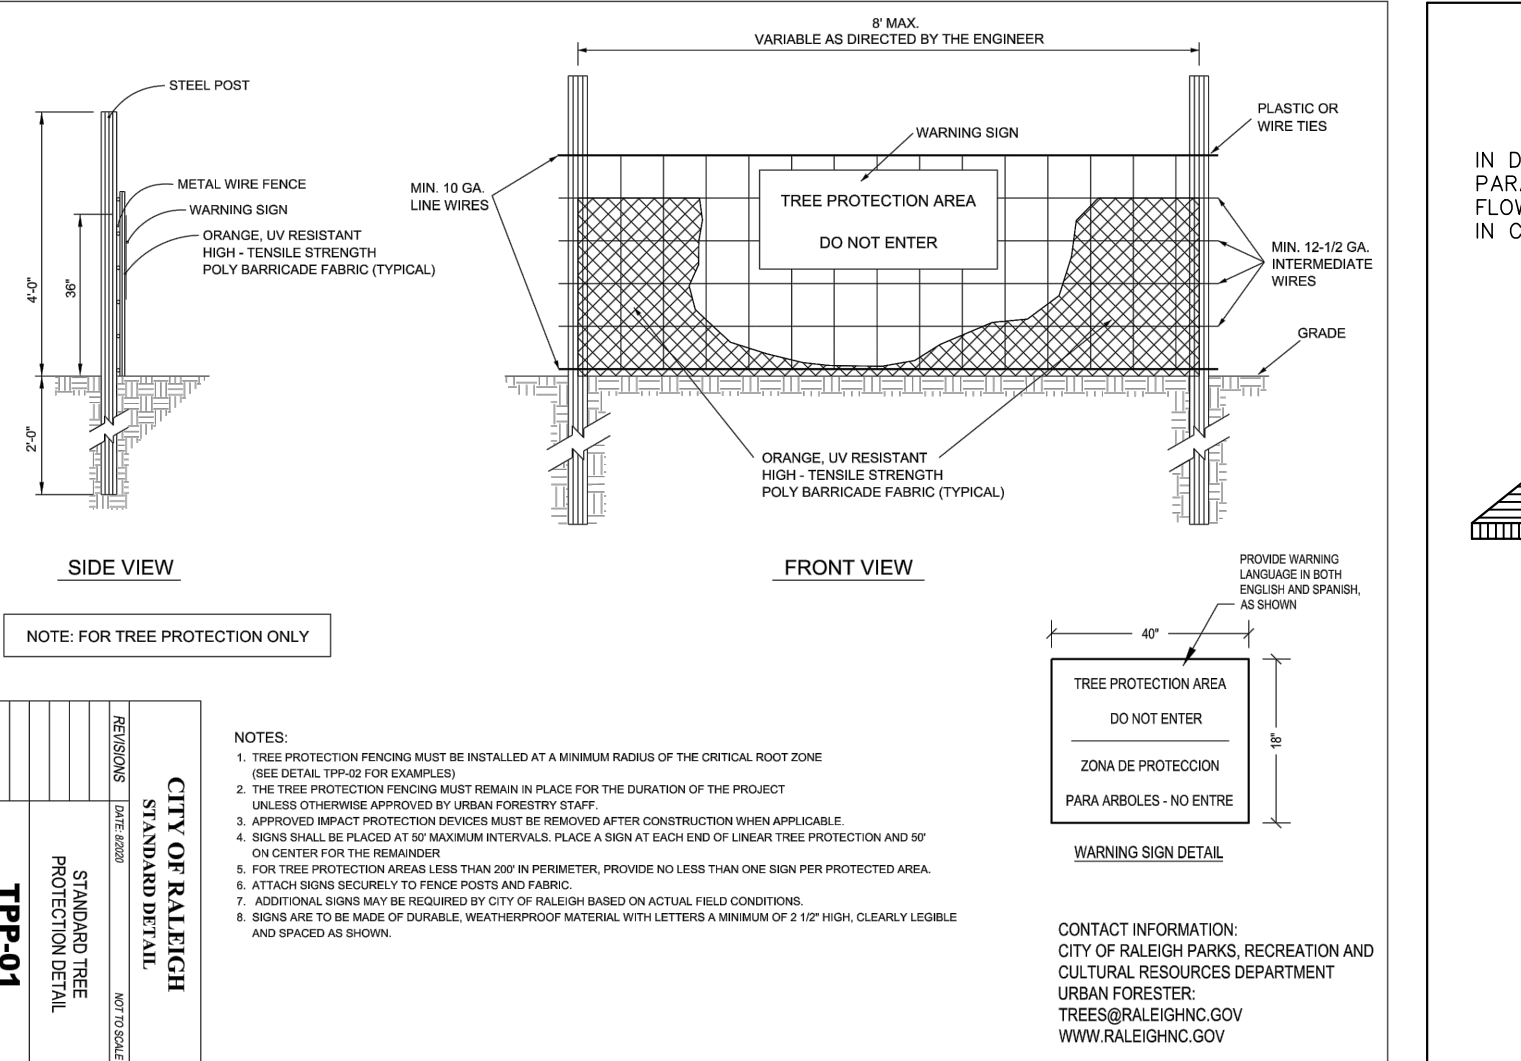

EFFECTIVE: 01/31/08

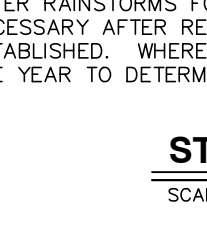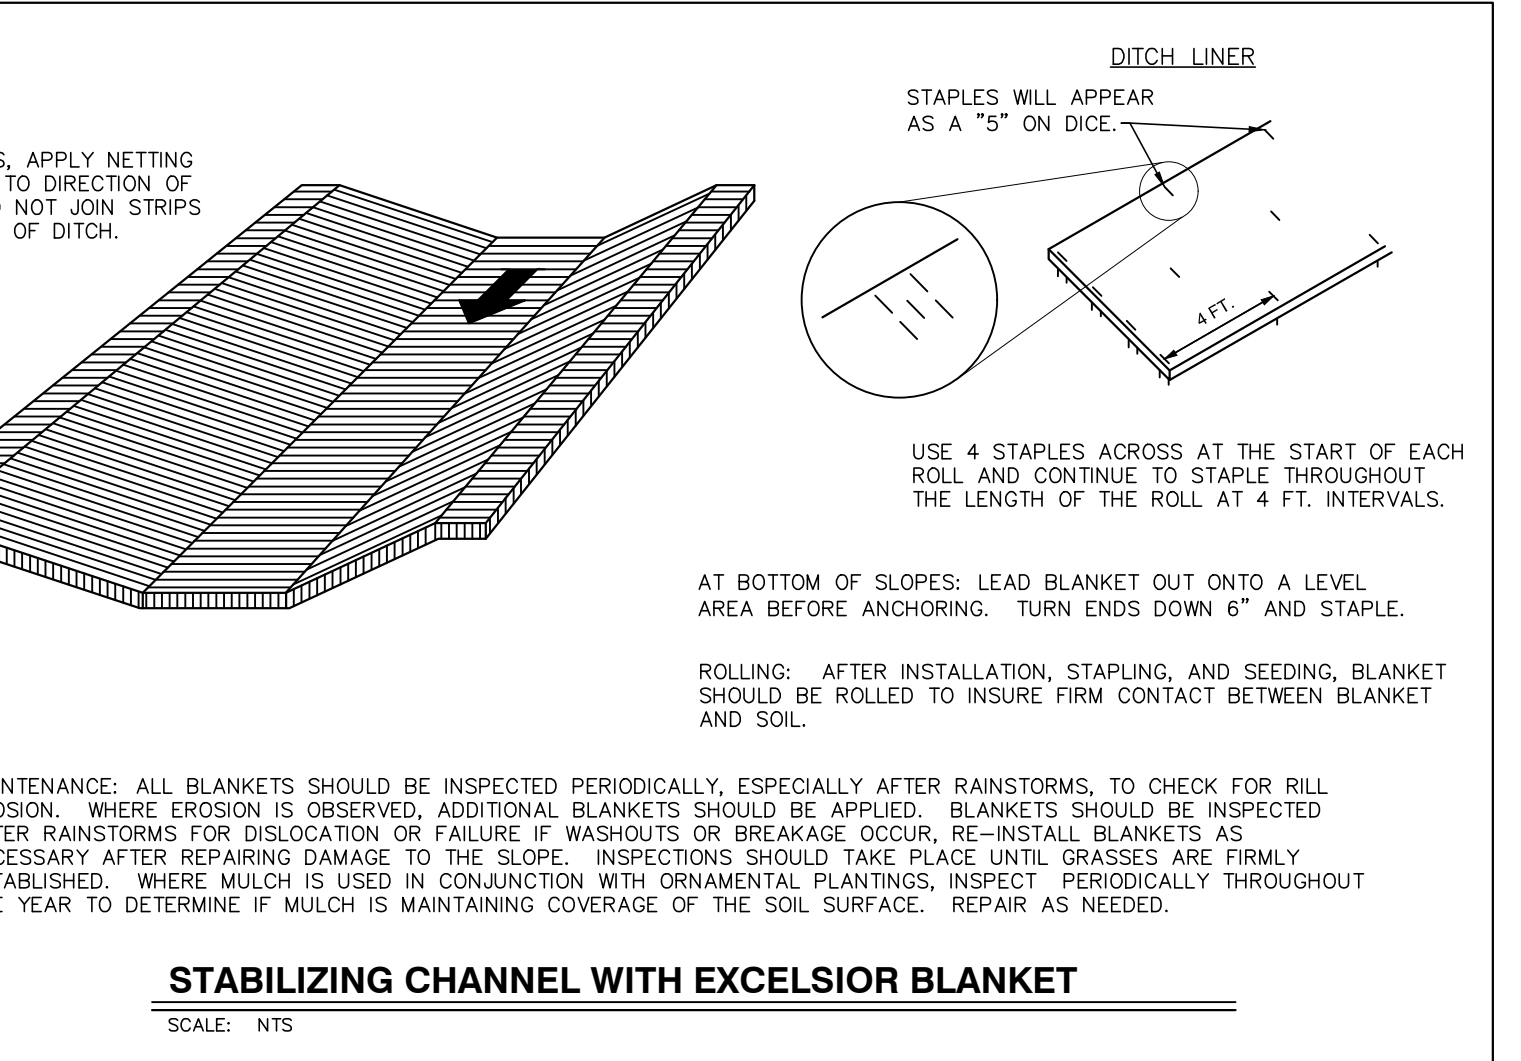



EFFECTIVE: 01/31/08

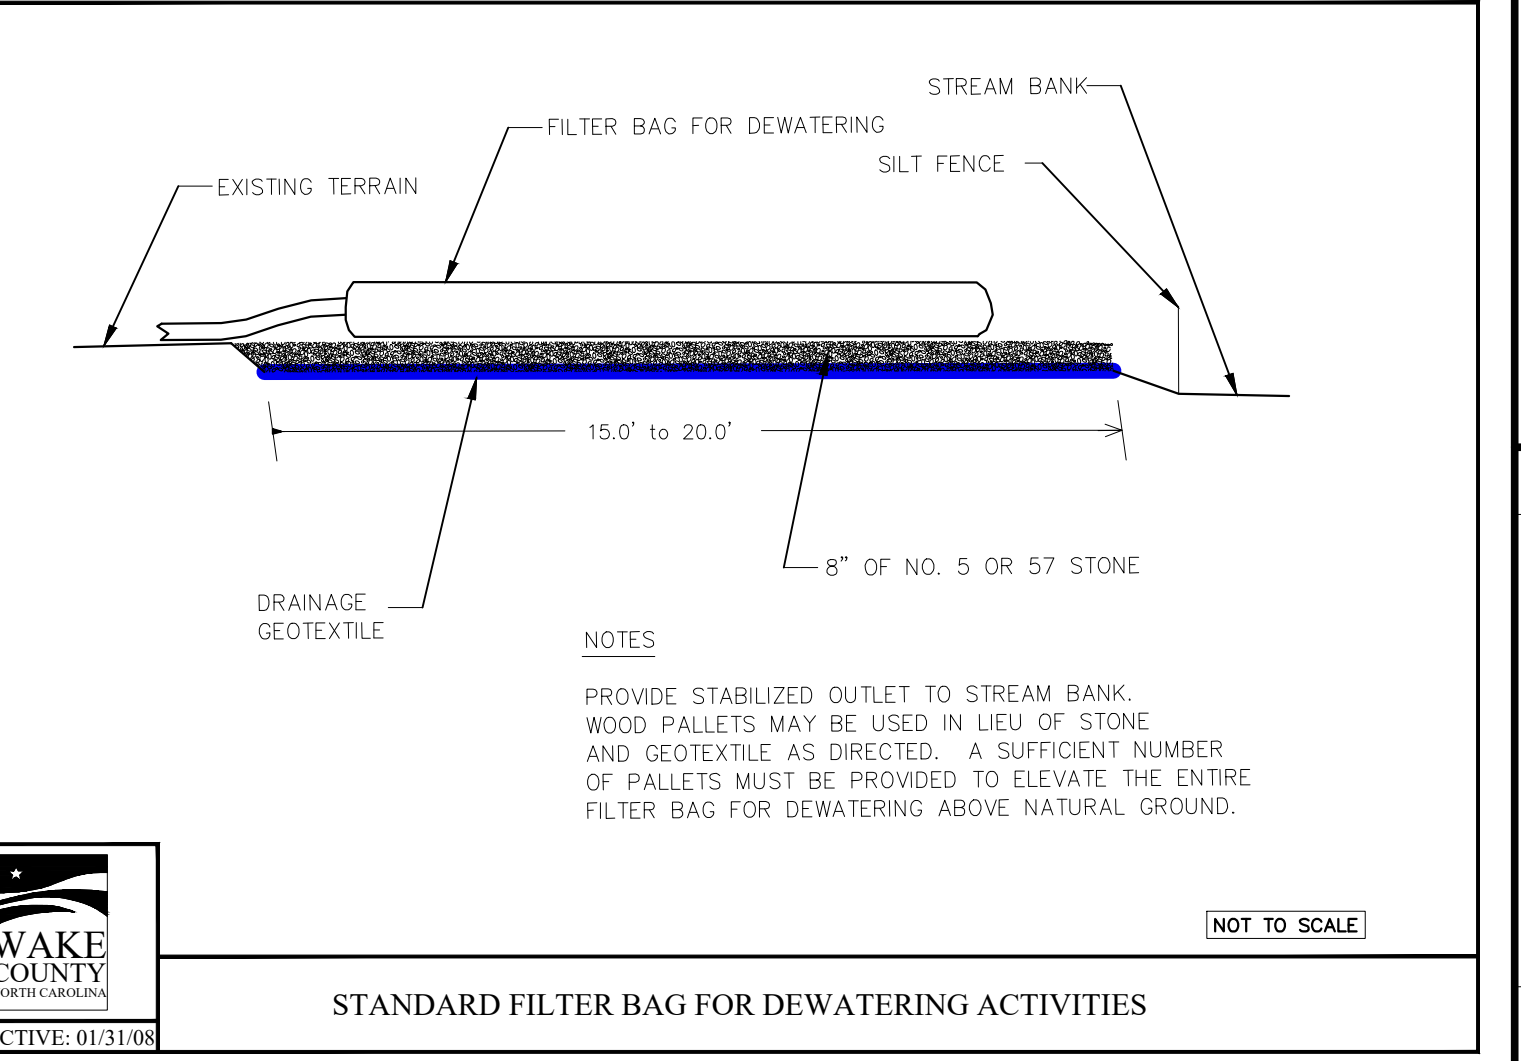

EFFECTIVE: 01/31/08



EFFECTIVE: 01/31/08

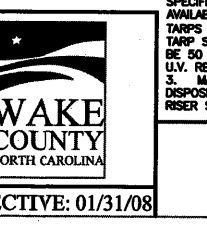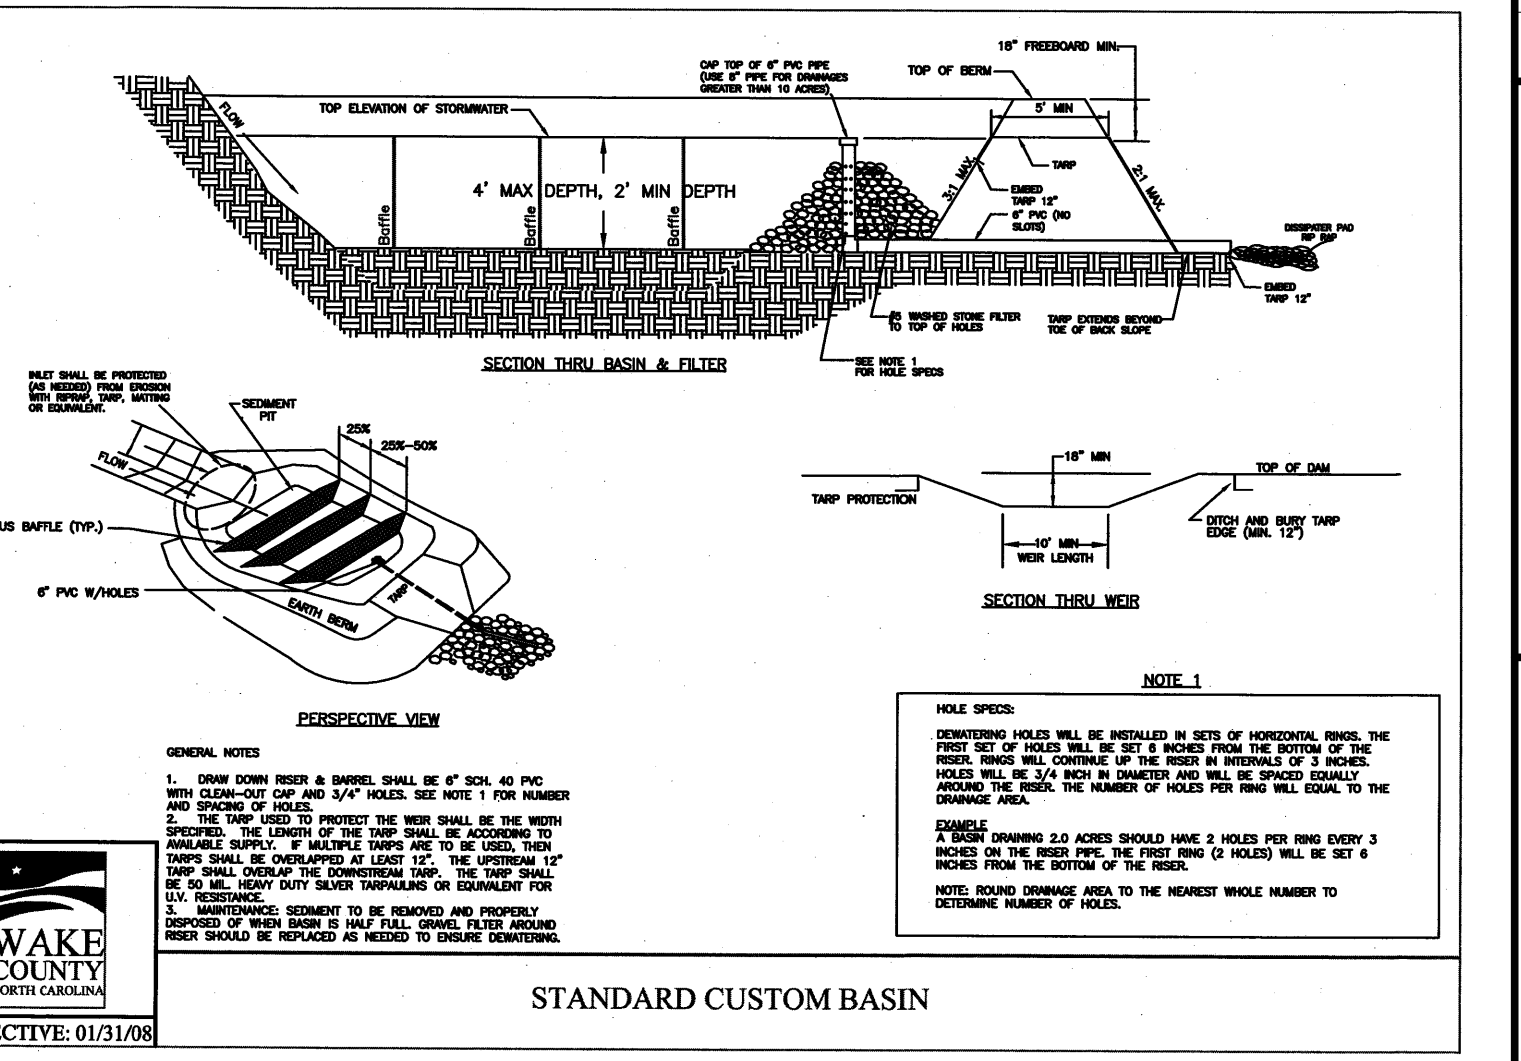

EFFECTIVE: 01/31/08

**BASS, NIXON & KENNEDY, INC.**  
**CONSULTING ENGINEERS**  
 6310 CHAPEL HILL ROAD, SUITE 250, RALEIGH, NC 27607  
 TELEPHONE: (919) 881-4122 FAX: (919) 881-6868  
 CERTIFICATION NUMBERS: NCBELS (C-0110); NCBOLA (C-0267)

| NO. | DATE | DESCRIPTION | BY |
|-----|------|-------------|----|
|     |      |             |    |

PROGRESS DRAWN BY: MRM  
 DATE: 03-19-17  
 JOB NO.: 19197

**EROSION CONTROL DETAILS**

SCALE: N.T.S.

CHK BY: MDB

**COBBLESTONE VILLAGE MIXED USE DEVELOPMENT**  
 TOWN OF ROLESVILLE, WAKE COUNTY, NORTH CAROLINA

SHEET C3.5







CITY OF RALEIGH - PLANS AUTHORIZED FOR CONSTRUCTION

Electronic Approval: This approval is being issued electronically. This approval is valid only upon the signature of a City of Raleigh Review Officer below. The City will retain a copy of the approved plans. Any work authorized by this approval must proceed in accordance with the plans kept on file with the City. This electronic approval may not be edited once issued. Any modification to this approval once issued will invalidate this approval.

City of Raleigh Development Approval \_\_\_\_\_



Raleigh Water Review Officer \_\_\_\_\_



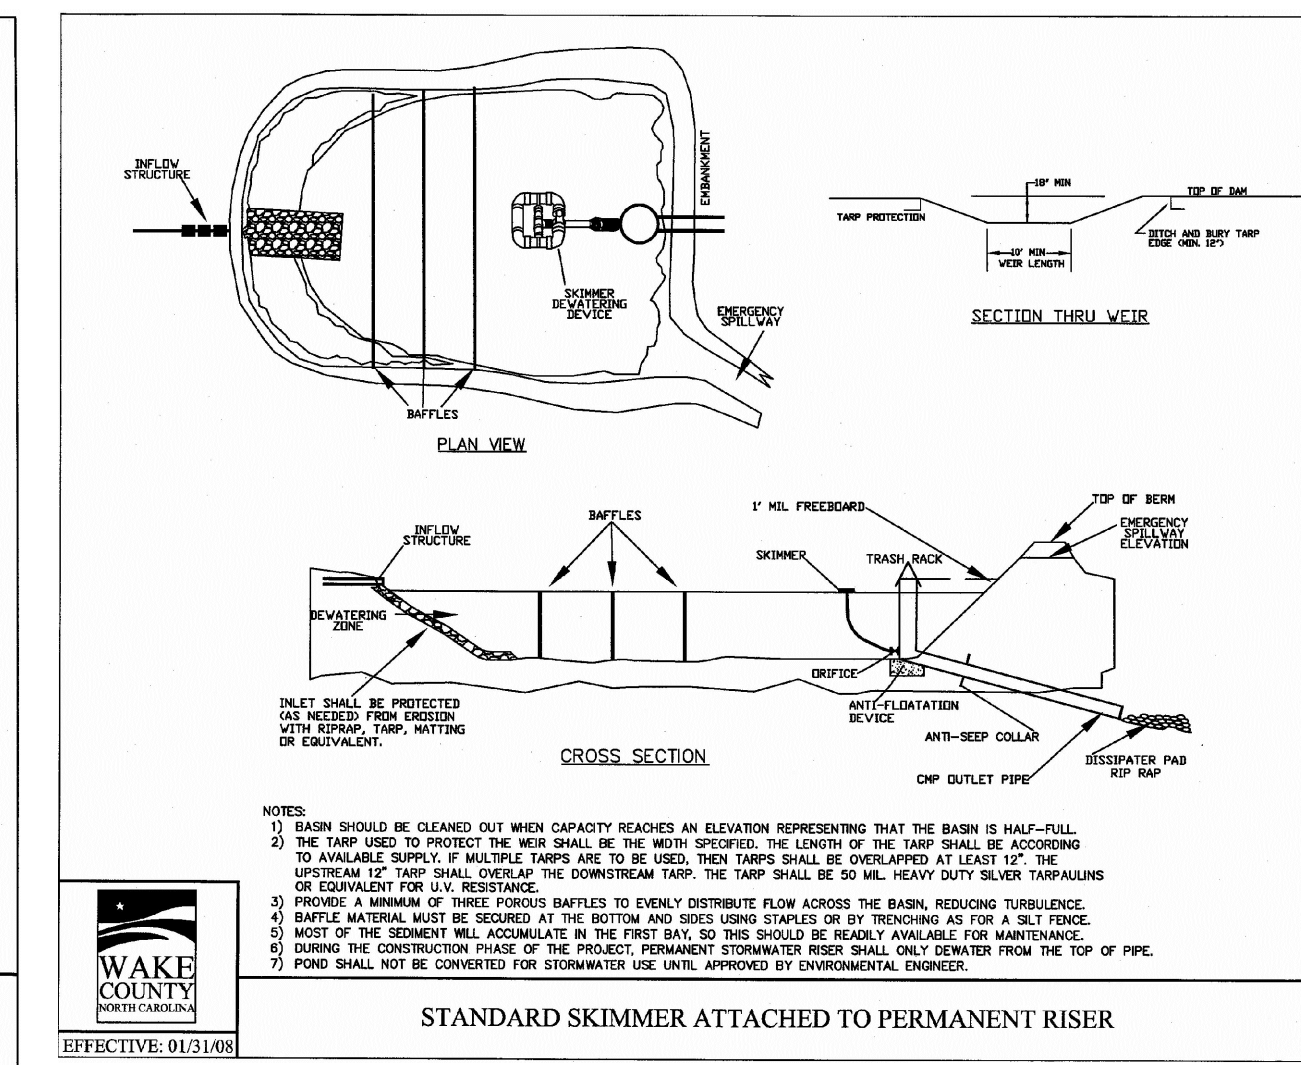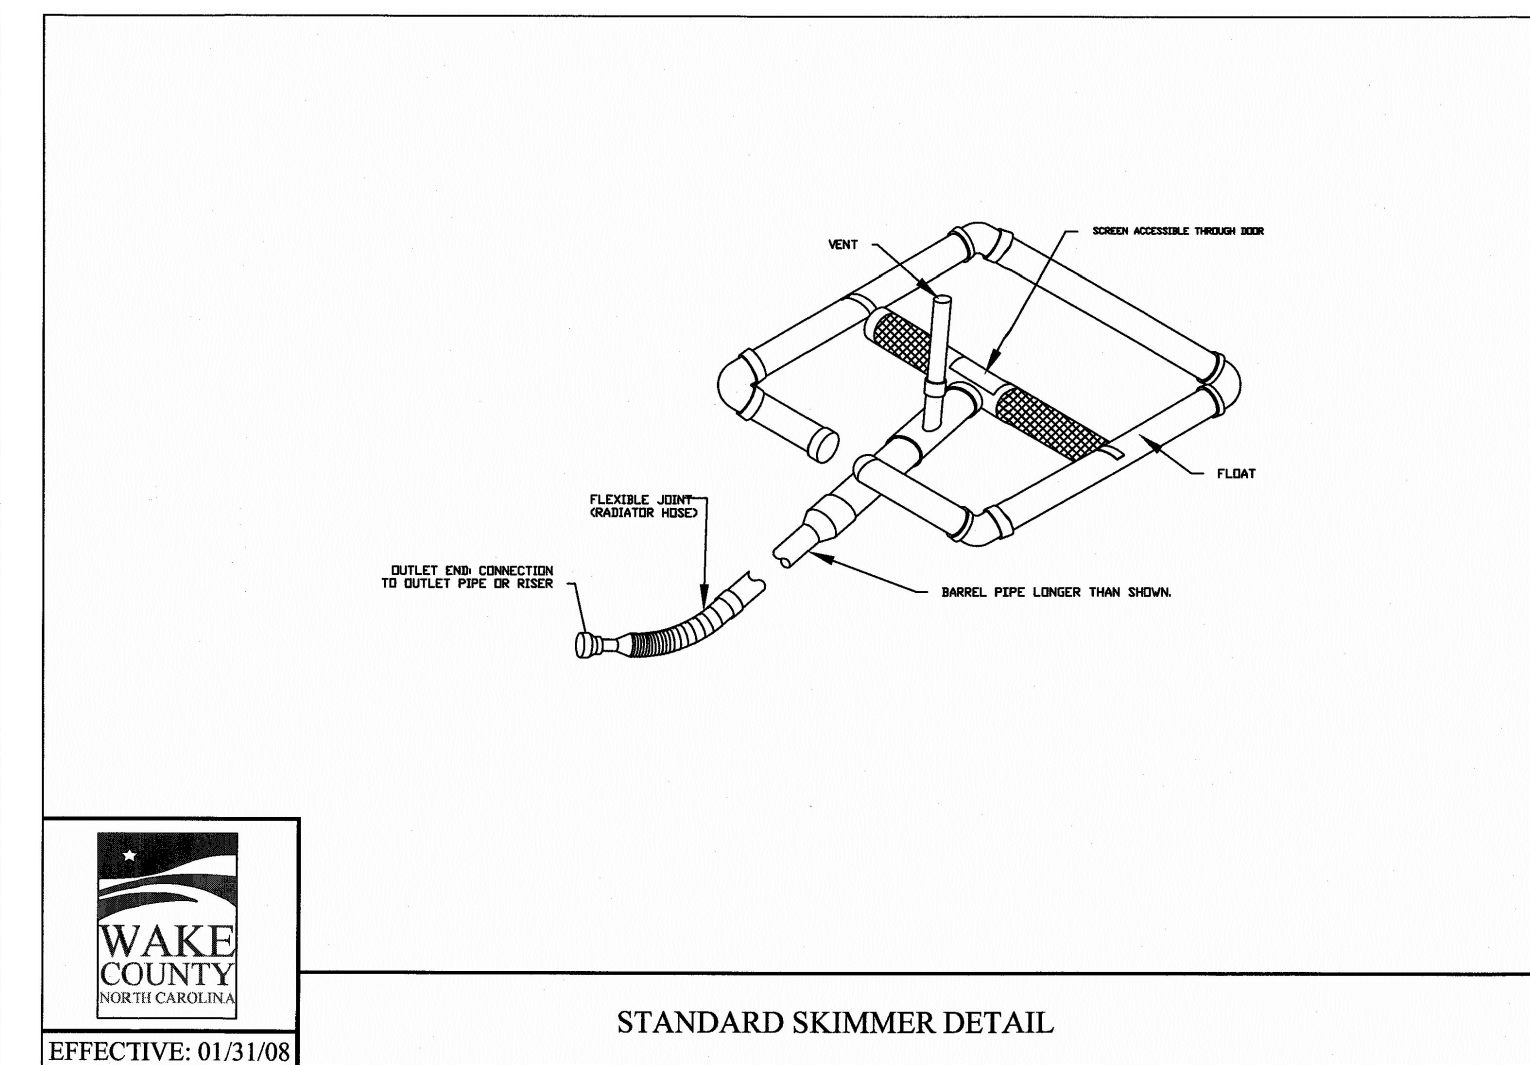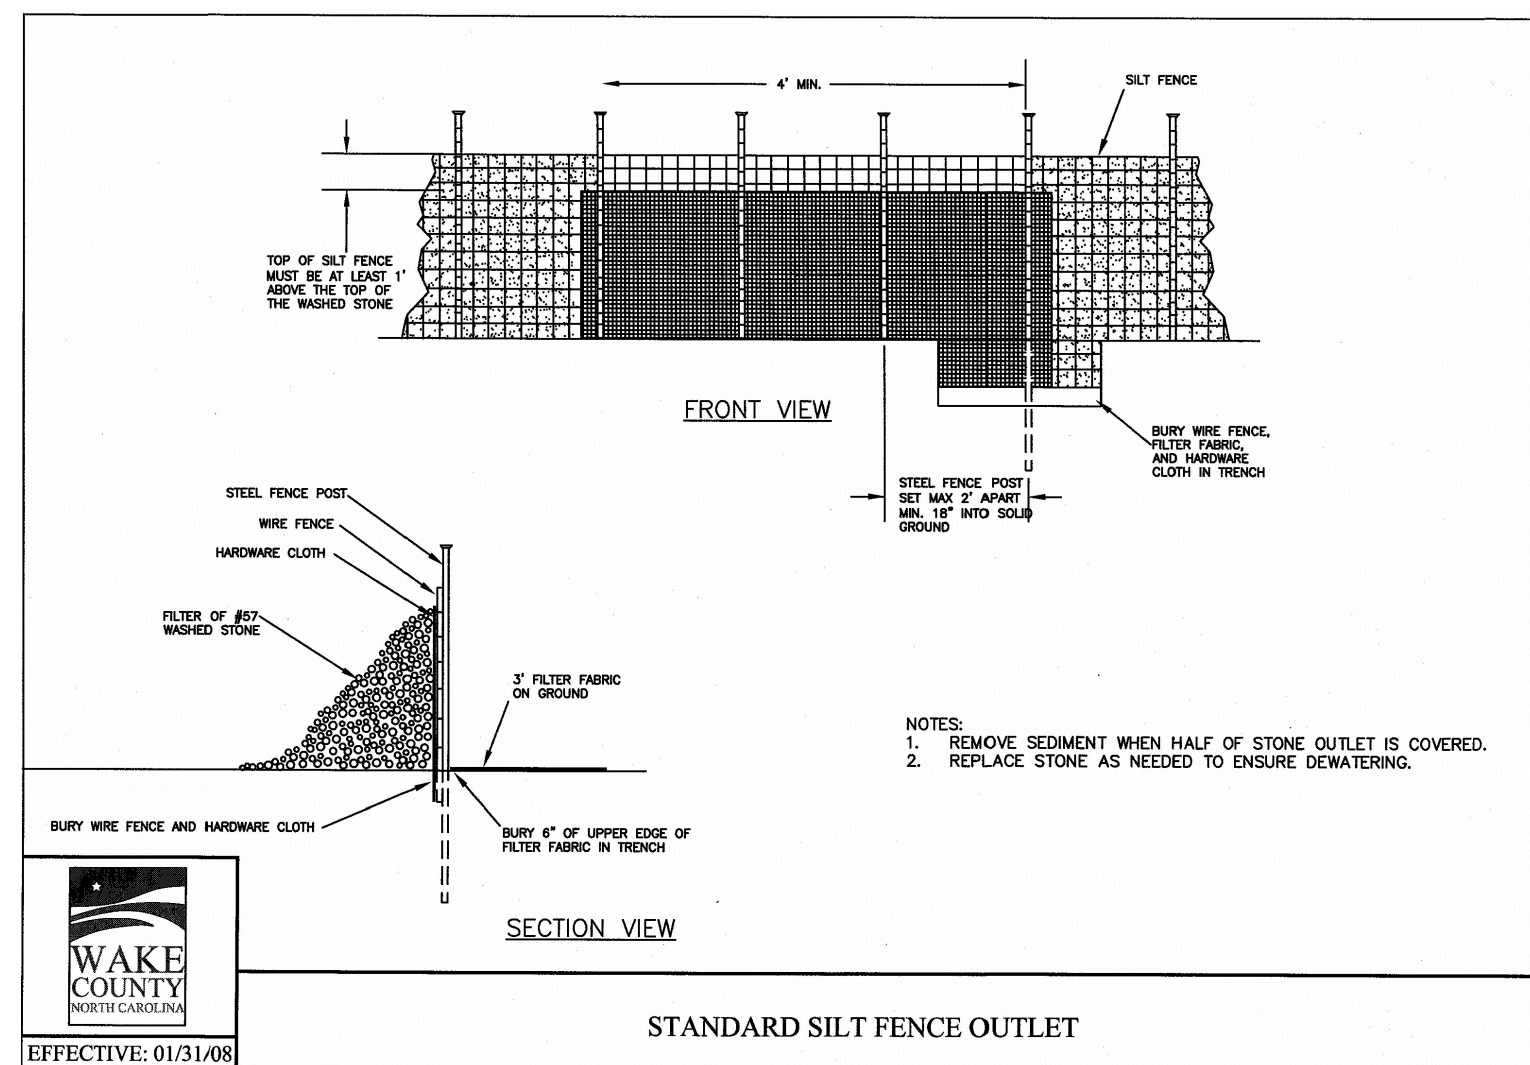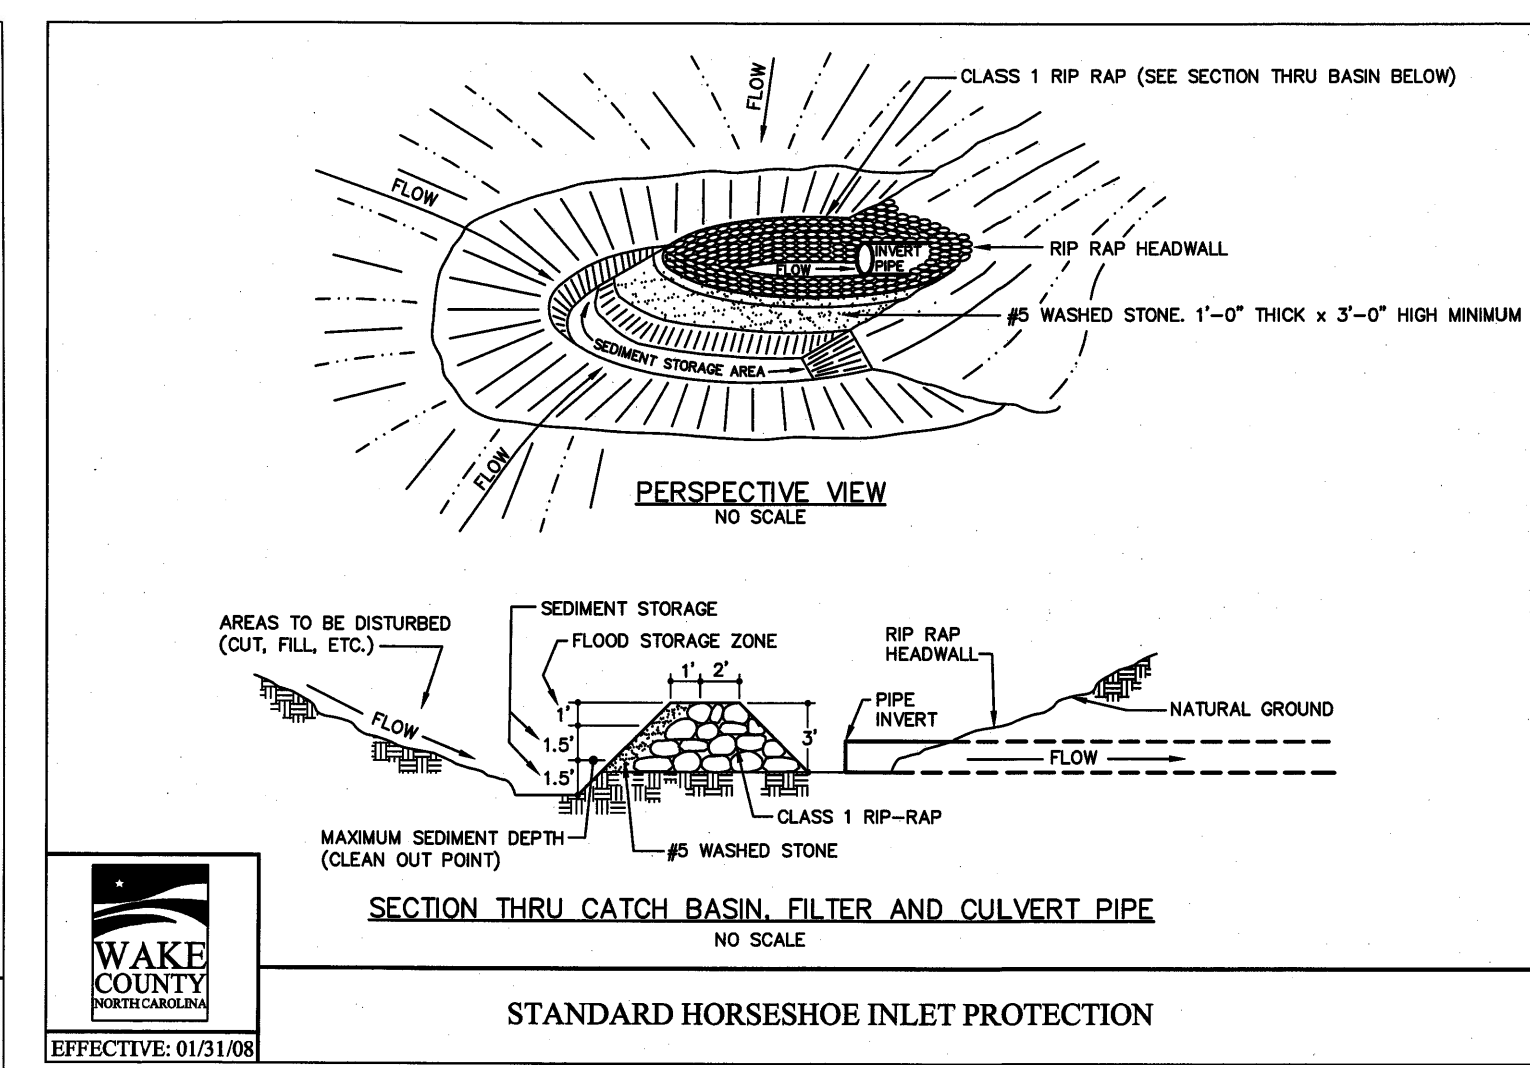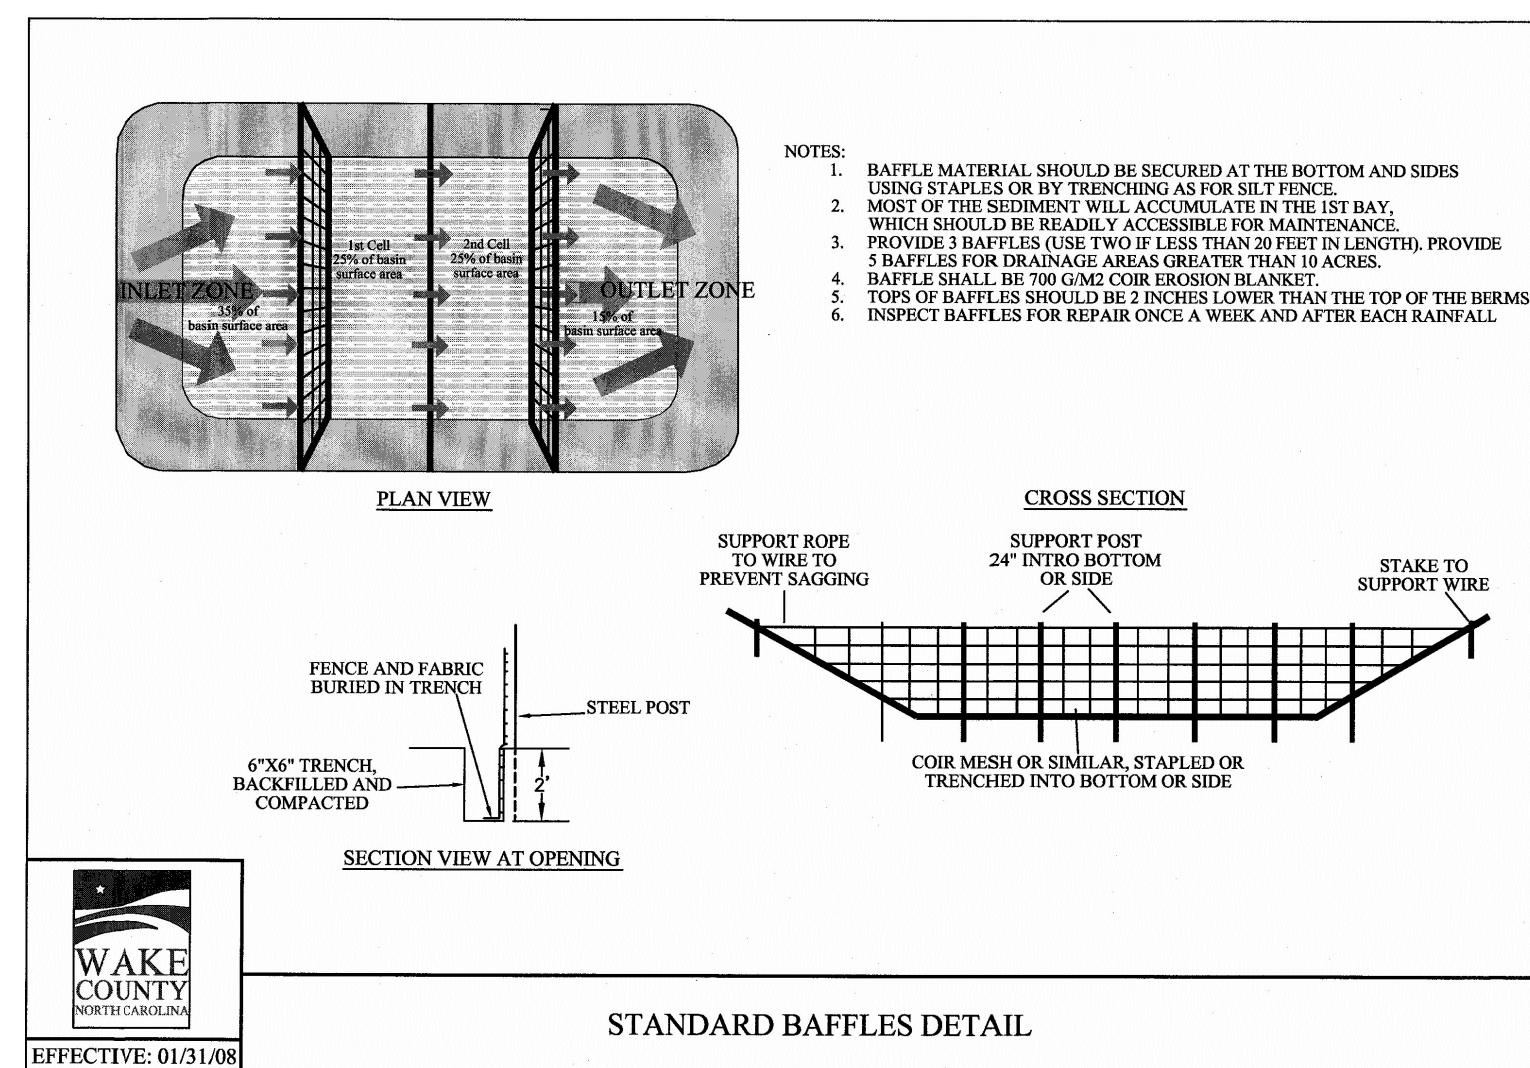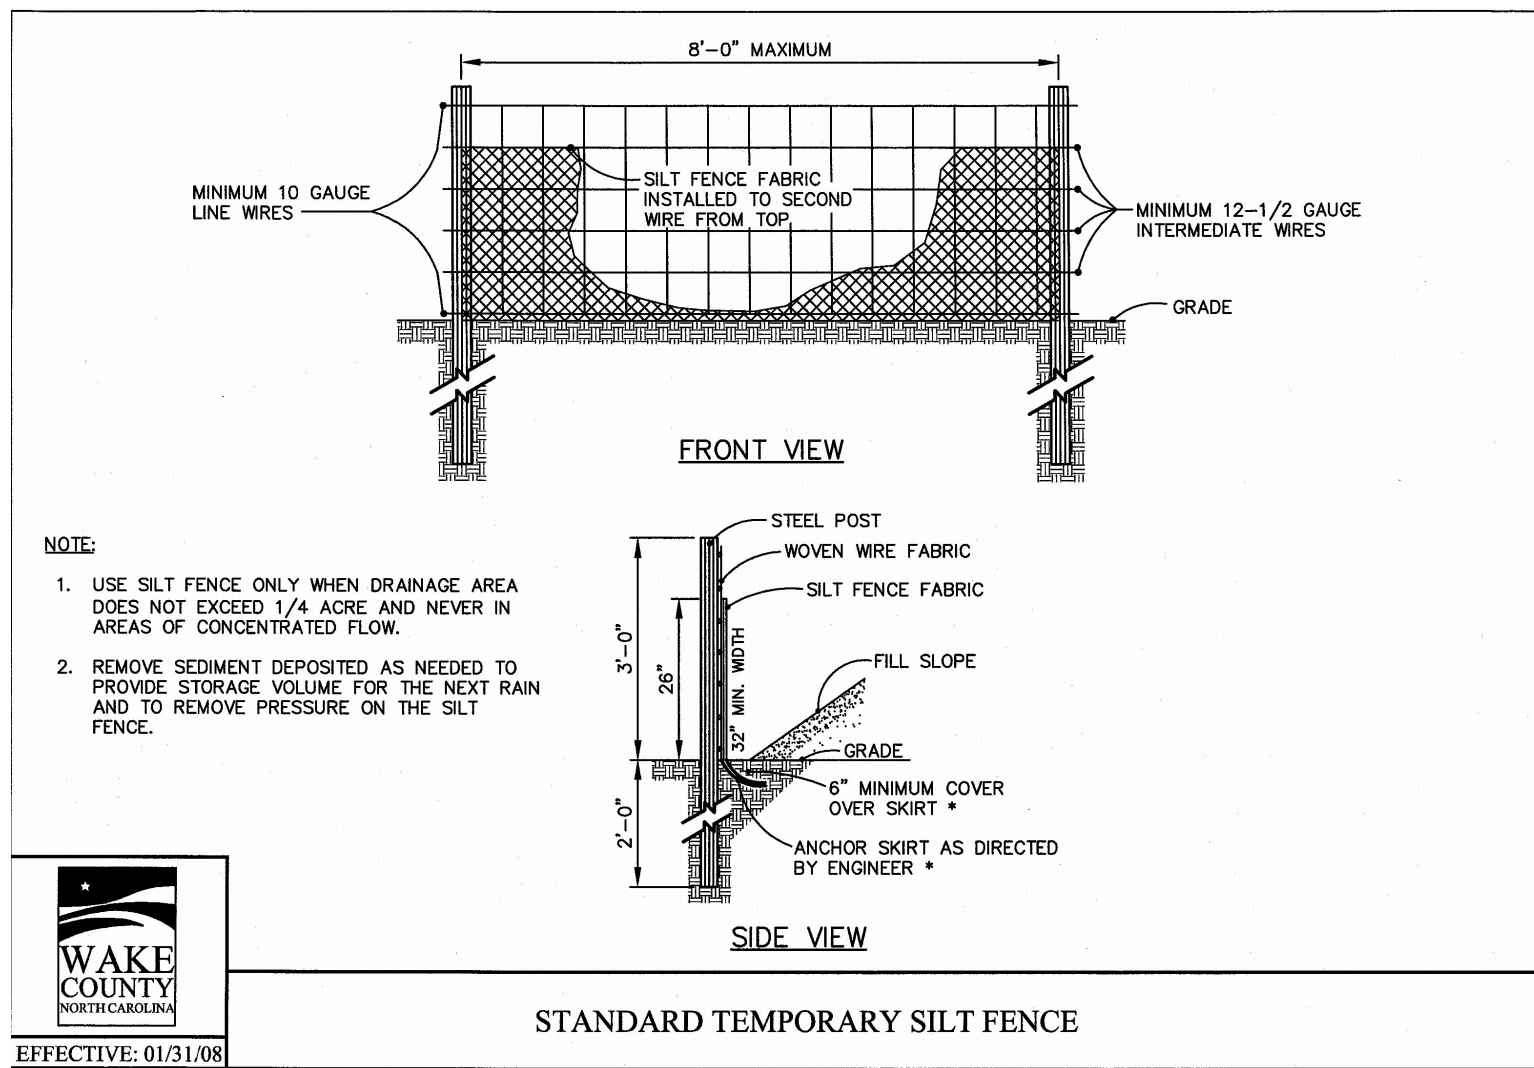

**SEEDING INFORMATION:**

| SEEDBED PREPARATION   |  |                    |
|---|--|--------------------|
| 1.  | CHISEL COMPACTED AREAS AND SPREAD TOPSOIL 3 INCHES DEEP OVER ADVERSE SOIL CONDITIONS, IF AVAILABLE.  |                    |
| 2.  | RIP THE ENTIRE AREA TO 6 INCHES DEPTH.   |                    |
| 3.  | REMOVE ALL LOOSE ROCK, ROOTS, AND OTHER OBSTRUCTIONS LEAVING SURFACE REASONABLY SMOOTH AND UNIFORM.  |                    |
| 4.  | APPLY AGRICULTURAL LIME, FERTILIZER, AND SUPER PHOSPHATE UNIFORMLY AND MIX WITH SOIL (SEE BELOW*).   |                    |
| 5.  | CONTINUE TILLAGE UNTIL A WELL PULVERIZED FIRM, REASONABLY UNIFORM SEEDBED IS PREPARED 4 TO 6 INCHES DEEP.  |                    |
| 6.  | SEED ON A FRESHLY PREPARED SEEDBED AND COVER LIGHTLY WITH SEEDING EQUIPMENT OR CULTPACK AFTER SEEDING.   |                    |
| 7.  | MULCH IMMEDIATELY AFTER SEEDING AND ANCHOR MULCH.  |                    |
| 8.  | INSPECT ALL SEEDED AREAS AND MAKE NECESSARY REPAIRS OR RESEEDINGS WITHIN THE PLANTING SEASON, IF POSSIBLE. IF STAND SHOULD BE OVER 50% DAMAGED, REESTABLISH FOLLOWING ORIGINAL LIME, FERTILIZER AND SEEDING RATES. |                    |
| 9.  | CONSULT CONSERVATION INSPECTOR ON MAINTENANCE TREATMENT AND FERTILIZATION AFTER PERMANENT COVER IS ESTABLISHED.  |                    |
| * APPLY AGRICULTURAL LIMESTONE - 2 TONS/ACRE<br>FERTILIZER - 10-10-10 ANALYSIS AT 800-1,000 LBS./ACRE<br>SUPER PHOSPHATE - 500 LBS/ACRE OF 20% ANALYSIS SUPER PHOSPHATE<br>MULCH - 2 TONS (APPROX. 80 BALES) SMALL GRAIN STRAW/ACRE<br>ANCHOR - TACK WITH LIQUID ASPHALT AT 400 GAL./ACRE OR EMULSIFIED ASPHALT AT 300 GALLONS/ACRE |  |                    |
| SEEDING SCHEDULE  |  |                    |
| PERMANENT SEEDING - SHOULDERS, SIDE DITCHES, SLOPES (MAX. 3:1)  |  |                    |
| DATE  | TYPE   | PLANTING RATE      |
| AUG. 15 - NOV. 1  | TALL FESCUE  | 200 LBS./ACRE      |
| NOV. 1 - MAR. 1   | TALL FESCUE AND ABRUZZI RYE (NURSE CROP)   | 200 LBS./ACRE      |
| MAR. 1 - APR. 15  | TALL FESCUE  | 200 LBS./ACRE      |
| APR. 15 - JUN. 30   | HULLED COMMON BERMUDAGRASS   | 15 LBS./ACRE       |
| PERMANENT SEEDING - SLOPES (3:1 TO 2:1)   |  |                    |
| AUG. 15 - NOV. 1  | TALL FESCUE AND SERICEA LESPEDEZA (UNHULLED, UNSCARIFIED)  | 200 LBS./ACRE      |
| NOV. 1 - MAR. 1   | TALL FESCUE AND SERICEA LESPEDEZA (UNHULLED, UNSCARIFIED) AND ABRUZZI RYE  | 60 TO 70 LBS./ACRE |
| MAR. 1 - JUN. 1   | TALL FESCUE AND SERICEA LESPEDEZA (SCARIFIED)  | 200 LBS./ACRE      |
| MAR. 15 - JUN. 30   | WEEDING LOVEGRASS AND SERICEA LESPEDEZA (SCARIFIED)  | 10 LBS./ACRE       |
| MAR. 15 - JUN. 30   | HULLED COMMON BERMUDAGRASS AND SERICEA LESPEDEZA (SCARIFIED)   | 40 TO 50 LBS./ACRE |
| MAR. 15 - JUN. 30   | HULLED COMMON BERMUDAGRASS AND SERICEA LESPEDEZA (SCARIFIED)   | 15 LBS./ACRE       |
| MAR. 15 - JUN. 30   | HULLED COMMON BERMUDAGRASS AND SERICEA LESPEDEZA (SCARIFIED)   | 40 TO 50 LBS./ACRE |
| TEMPORARY SEEDING   |  |                    |
| JUNE 1 - SEPT. 1  | TALL FESCUE AND BROWNTOP MILLET (NURSE CROP) OR SORGHUM-SUDAN HYBRIDS (NURSE CROP)   | 200 LBS./ACRE      |
|   |  | 35 LBS./ACRE       |
|   |  | 30 LBS./ACRE       |
| CONSULT CONSERVATION ENGINEER OR SOIL CONSERVATION SERVICE FOR ADDITIONAL INFORMATION CONCERNING OTHER ALTERNATIVES FOR VEGETATION OF DENIED AREAS. THE ABOVE VEGETATION RATES ARE THOSE WHICH DO WELL UNDER LOCAL CONDITIONS; OTHER SEEDING RATE COMBINATIONS ARE POSSIBLE.  |  |                    |
| *NURSE CROP/TEMPORARY-RESEED ACCORDING TO OPTIMUM SEASON FOR DESIRED PERMANENT VEGETATION. DO NOT ALLOW TEMPORARY COVER TO GROW OVER 12" IN HEIGHT BEFORE MOWING, OTHERWISE FESCUE MAY BE SHADED OUT.   |  |                    |

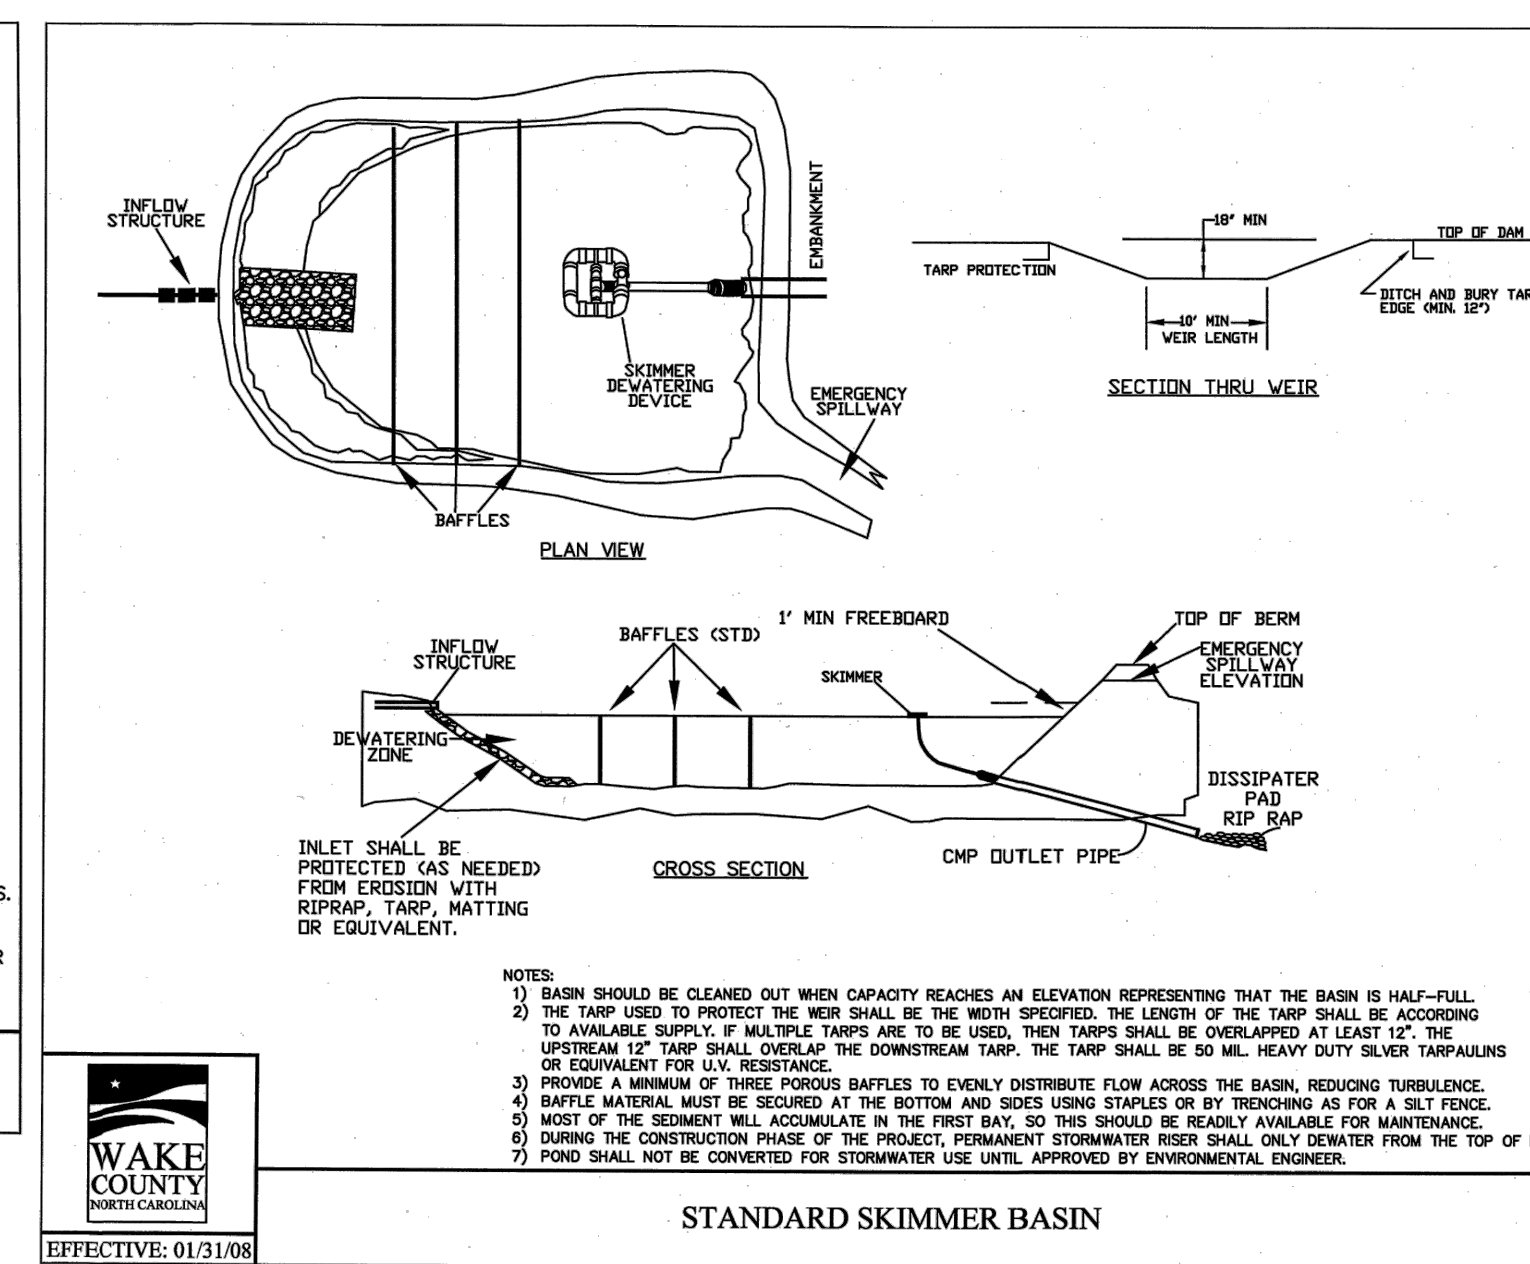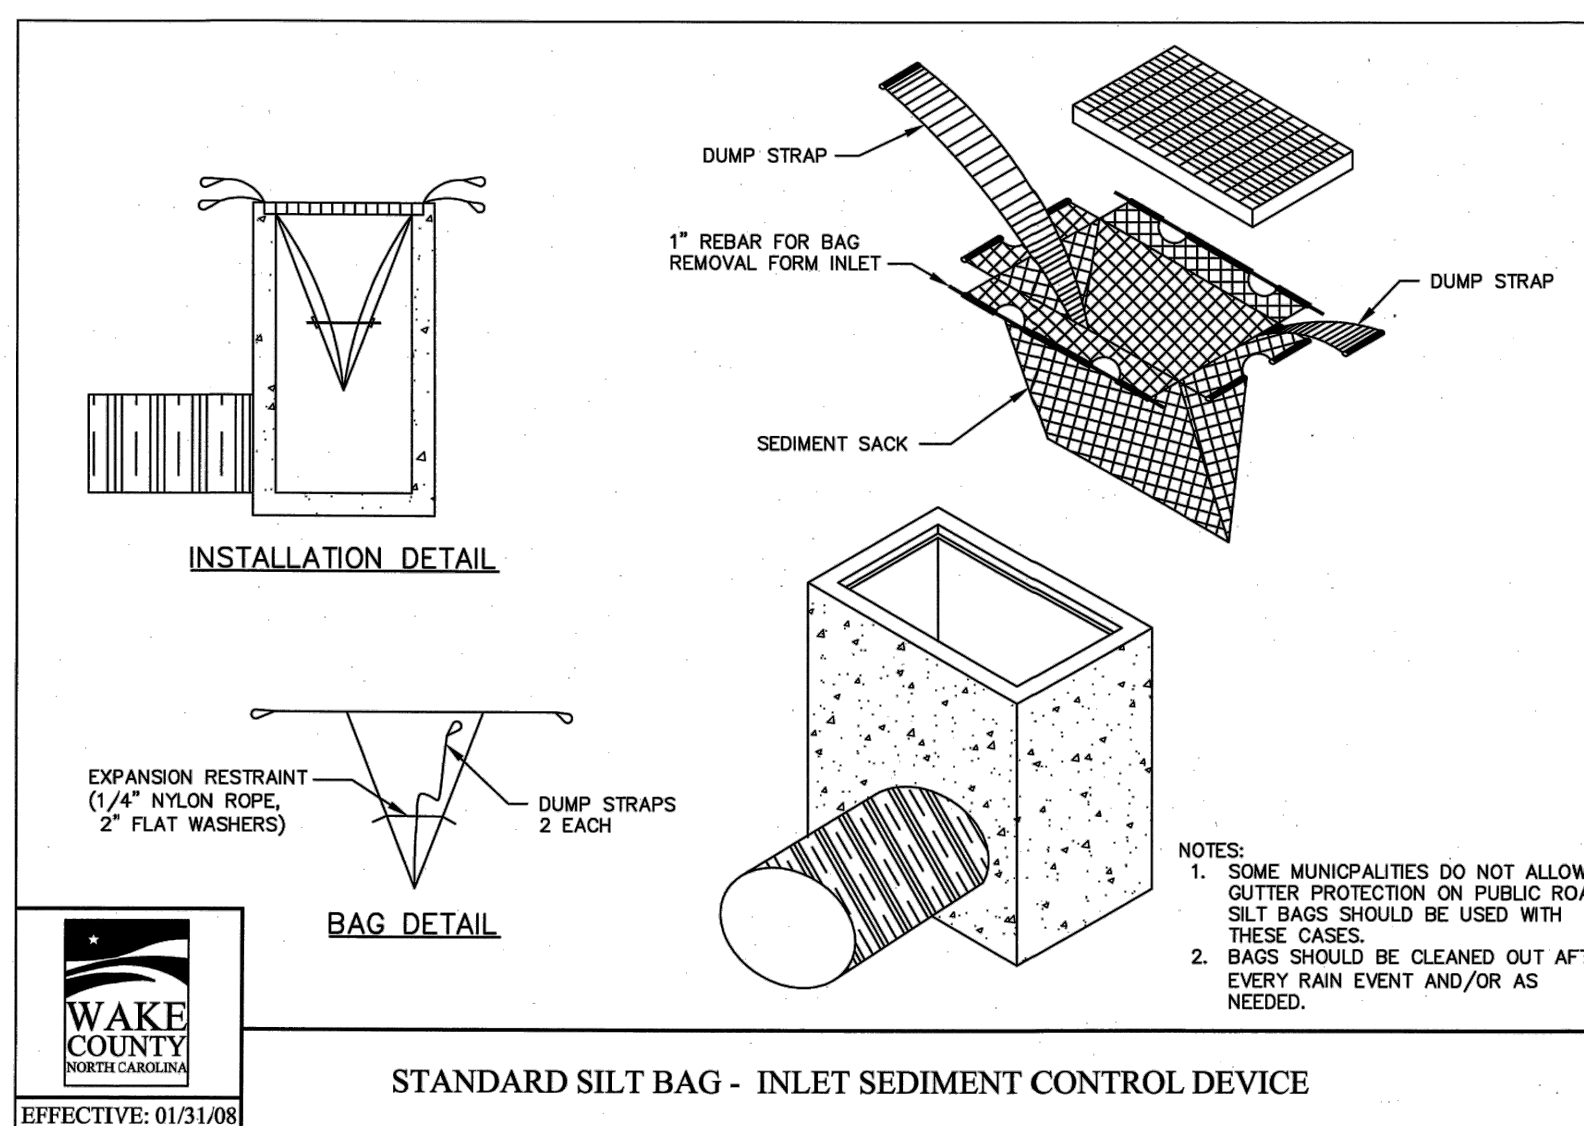

CITY OF RALEIGH - PLANS AUTHORIZED FOR CONSTRUCTION

Electronic Approval: This approval is being issued electronically. This approval is valid only upon the signature of a City of Raleigh Review Officer below. The City will retain a copy of the approved plans. Any work authorized by this approval must proceed in accordance with the plans kept on file with the City. This electronic approval may not be edited once issued. Any modification to this approval once issued will invalidate this approval.

City of Raleigh Development Approval \_\_\_\_\_

Raleigh Water Review Officer \_\_\_\_\_



3/10/22



**BASS, NIXON & KENNEDY, INC.**  
CONSULTING ENGINEERS  
6310 CHAPEL HILL ROAD, SUITE 250, RALEIGH, NC 27607  
TELEPHONE: (919) 881-4422 FAX: (919) 881-8686  
CERTIFICATION NUMBERS: NCBELS (C-010); NCBOLA (C-0267)

| NO. | DATE | DESCRIPTION | BY |
|-----|------|-------------|----|
|     |      |             |    |
|     |      |             |    |
|     |      |             |    |

COBBLESTONE VILLAGE MIXED USE DEVELOPMENT  
TOWN OF ROLESVILLE, WAKE COUNTY, NORTH CAROLINA  
SCALE: N.T.S.  
CHK BY: MDB  
EROSION CONTROL DETAILS  
JOB NO. \_\_\_\_\_  
DATE \_\_\_\_\_  
DRAWN BY \_\_\_\_\_  
MIRN \_\_\_\_\_  
PROGRESS \_\_\_\_\_  
03-19187

SHEET C3.6

| NO. | DATE | DESCRIPTION | BY |
|-----|------|-------------|----|
|     |      |             |    |
|     |      |             |    |
03-19187  
JOB NO.

PROGRESS  
DATE

DRAWN BY

NCG01 PLAN

CHK BY: MDB

SCALE: N.T.S.

TOWN OF ROLESVILLE, WAKE COUNTY, NORTH CAROLINA

COBLESTONE VILLAGE

MIXED USE DEVELOPMENT

3/10/22

SHEET C3.7

NOT RELEASED FOR CONSTRUCTION OR BID SOLICITATION

City of Raleigh Development Approval

Raleigh Water Review Officer

3/10/22

Professional Engineer Seal for W. D. Bizzell

3/10/22

3/10/22

**GROUND STABILIZATION AND MATERIALS HANDLING PRACTICES FOR COMPLIANCE WITH THE NCG01 CONSTRUCTION GENERAL PERMIT**  
Implementing the details and specifications on this plan sheet will result in the construction activity being considered compliant with the Ground Stabilization and Materials Handling sections of the NCG01 Construction General Permit (Sections E and F, respectively). The permittee shall comply with the Erosion and Sediment Control plan approved by the delegated authority having jurisdiction. All details and specifications shown on this sheet may not apply depending on site conditions and the delegated authority having jurisdiction.

**Temporary and Permanent Groundcover\***

| STABILIZATION TIMEFRAMES<br>(Effective Aug. 5, 2011) |               |  |
|--|---------------|--|
| SITE AREA DESCRIPTION                                | STABILIZATION | TIMEFRAME EXCEPTIONS   |
| Perimeter dikes, seals, ditches, slopes              | 7 days        | None   |
| High Quality Water (HQW) Zones                       | 7 days        | None   |
| Slopes steeper than 3:1                              | 7 days        | If slopes are 10' or less in length and are not steeper than 3:1, 14 days are allowed. |
| Slopes 3:1 or flatter                                | 14 days       | 7 days for slopes greater than 50' in length.  |
| All other areas with slopes flatter than 4:1         | 14 days       | None, except for perimeters and HQW Zones.   |

\*-For Falls Lake watershed, in disturbed areas where grading activities are incomplete, provide temporary groundcover no later than seven (7) days for slopes steeper than 3:1; ten (10) days for slopes equal to or flatter than 3:1; fourteen (14) days for areas with no slope.

**GROUND STABILIZATION SPECIFICATION**  
Stabilize the ground sufficiently so that rain will not dislodge the soil. Use one of the techniques in the table below:

| Temporary Stabilization  | Permanent Stabilization   |
|--|---|
| <ul style="list-style-type: none"> <li>Temporary grass seed covered with straw or other mulches and tackifiers</li> <li>Hydroseeding</li> <li>Roll-on erosion control products with or without temporary grass seed</li> <li>Appropriately applied straw or other mulch</li> <li>Plastic sheeting</li> </ul> | <ul style="list-style-type: none"> <li>Permanent grass seed covered with straw or other mulches and tackifiers</li> <li>Geotextile fabrics such as permanent soil reinforcement matting</li> <li>Hydroseeding</li> <li>Strips or other permanent plantings covered with mulch</li> <li>Uniform and evenly distributed ground cover sufficient to restrain erosion</li> <li>Structural methods such as concrete, asphalt or retaining walls</li> </ul> |

**POLYACRYLAMIDES (PAMS) AND FLOCCULANTS**  
1. Select flocculants that are appropriate for the soils being exposed during construction, selecting from the *NC DWR List of Approved PAMS/Flocculants*.  
2. Apply flocculants at or before the inlets to Erosion and Sediment Control Measures.  
3. Apply flocculants at the concentrations specified in the *NC DWR List of Approved PAMS/Flocculants* and in accordance with the manufacturer's instructions.  
4. Provide ponding area for containment of treated Stormwater before discharging off-site.  
5. Store flocculants in leak-proof containers that are kept under storm-resistant cover or surrounded by secondary containment structures.




**EQUIPMENT AND VEHICLE MAINTENANCE**  
1. Maintain vehicles and equipment to prevent discharge of fluids.  
2. Provide drip pans under any stored equipment.  
3. Identify leaks and repair as soon as feasible, or remove leaking equipment from the project.  
4. Collect all spent fluids, store in separate containers and properly dispose as hazardous waste (recycle when possible).  
5. Remove leaking vehicles and construction equipment from service until the problem has been corrected.  
6. Bring used fuels, lubricants, coolants, hydraulic fluids and other petroleum products to a recycling or disposal center that handles these materials.

**LITTER, BUILDING MATERIAL AND LAND CLEARING WASTE**  
1. Never bury or burn waste. Place litter and debris in approved waste containers.  
2. Provide a sufficient number of waste containers on site to manage the quantity of waste produced.  
3. Locate waste containers at least 50 feet away from storm drain inlets and surface waters unless no other alternatives are reasonably available.  
4. Locate waste containers on areas that do not receive substantial amounts of runoff from upland areas and does not drain directly to a storm drain, stream or wetland.  
5. Cover waste containers at the end of each workday and before storm events. Repair or replace damaged waste containers.  
6. Anchor all lightweight items in waste containers during times of high winds.  
7. Empty waste containers as needed to prevent overflow.  
8. Dispose waste off-site at an approved disposal facility.

**PAINT AND OTHER LIQUID WASTE**  
1. Do not dump paint and other liquid waste into storm drains, streams or wetlands.  
2. Locate paint washouts at least 50 feet away from storm drain inlets and surface waters unless no other alternatives are reasonably available.  
3. Contain liquid wastes in a controlled area.  
4. Containment must be labeled, sized and placed appropriately for the needs of site.  
5. Prevent the discharge of soaps, solvents, detergents and other liquid wastes from construction sites.

**PORTABLE TOILETS**  
1. Install portable toilets on level ground, at least 50 feet away from storm drains, streams or wetlands unless there is no alternative reasonably available. If 50 foot offset is not attainable, provide relocation of portable toilet behind silt fence or place on a gravel pad and surround with sand bags.  
2. Provide staking or anchoring of portable toilets during periods of high winds or in high foot traffic areas.  
3. Monitor portable toilets for leaking and properly dispose of any leaked material. Utilize a licensed sanitary waste hauler to remove leaking portable toilets and replace with properly operating unit.

**EARTHEN STOCKPILE MANAGEMENT**  
1. Show stockpile locations on plans. Locate earthen-material stockpile areas at least 50 feet away from storm drain inlets, sediment basins, perimeter sediment controls and surface waters unless it can be shown no other alternatives are reasonably available.  
2. Protect stockpile with silt fence installed along toe of slope with a minimum offset of five feet from the toe of stockpile.  
3. Provide stable stone access point when feasible.  
4. Stabilize stockpile within the timeframes provided on this sheet and in accordance with the approved plan and any additional requirements. Soil stabilization is defined as vegetative, physical or chemical coverage techniques that will restrain accelerated erosion on disturbed soils for temporary or permanent control needs.

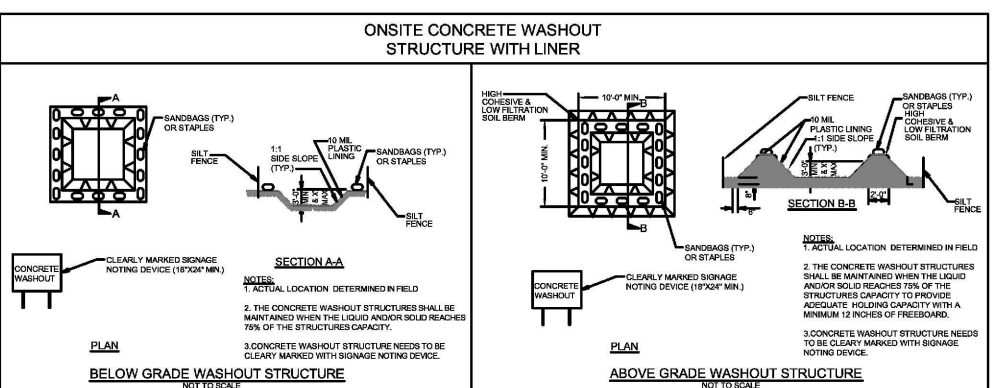

**CONCRETE WASHOUTS**  
1. Do not discharge concrete or cement slurry from the site.  
2. Dispose of, or recycle settled, hardened concrete residue in accordance with local and state solid waste regulations and at an approved facility.  
3. Manage washout from mortar mixers in accordance with the above item and in addition place the mixer and associated materials on impervious barrier and within lot perimeter silt fence.  
4. Install temporary concrete washouts per local requirements, where applicable. If an alternate method or product is to be used, contact your approval authority for review and approval. If local standard details are not available, use one of the types of temporary concrete washouts provided on this detail.  
5. Do not use concrete washouts for dewatering or storing defective curb or sidewalk sections. Stormwater accumulated within the washout may not be pumped into or discharged to the storm drain system or receiving surface waters. Liquid waste must be pumped out and removed from project.  
6. Locate washouts at least 50 feet from storm drain inlets and surface waters unless it can be shown that no other alternatives are reasonably available. At a minimum, install protection of storm drain inlet(s) closest to the washout which could receive spills or overflow.  
7. Locate washouts in an easily accessible area, on level ground and install a stone entrance pad in front of the washout. Additional controls may be required by the approving authority.  
8. Install at least one sign directing concrete trucks to the washout within the project limits. Post signage on the washout itself to identify this location.  
9. Remove leavings from the washout when at approximately 75% capacity to limit overflow events. Replace the tarp, sand bags or other temporary structural components when no longer functional. When utilizing alternative or proprietary products, follow manufacturer's instructions.  
10. At the completion of the concrete work, remove remaining leavings and dispose of in an approved disposal facility. Fill pit, if applicable, and stabilize any disturbance caused by removal of washout.

**HERBICIDES, PESTICIDES AND RODENTICIDES**  
1. Store and apply herbicides, pesticides and rodenticides in accordance with label restrictions.  
2. Store herbicides, pesticides and rodenticides in their original containers with the label, which lists directions for use, ingredients and first aid steps in case of accidental poisoning.  
3. Do not store herbicides, pesticides and rodenticides in areas where flooding is possible or where they may spill or leak into wells, stormwater drains, ground water or surface water. If a spill occurs, clean area immediately.  
4. Do not stockpile these materials on-site.

**HAZARDOUS AND TOXIC WASTE**  
1. Create designated hazardous waste collection areas on-site.  
2. Place hazardous waste containers under cover or in secondary containment.  
3. Do not store hazardous chemicals, drums or bagged materials directly on the ground.

**NCG01 GROUND STABILIZATION AND MATERIALS HANDLING** EFFECTIVE: 03/01/19

**PART III SELF-INSPECTION, RECORDKEEPING AND REPORTING**  
**SECTION A: SELF-INSPECTION**  
Self-inspections are required during normal business hours in accordance with the table below. When adverse weather or site conditions would cause the safety of the inspection personnel to be in jeopardy, the inspection may be delayed until the next business day on which it is safe to perform the inspection. In addition, when a storm event of equal to or greater than 1.0 inch occurs outside of normal business hours, the self-inspection shall be performed upon the commencement of the next business day. Any time when inspections were delayed shall be noted in the Inspection Record.

| Inspect  | Frequency (during normal business hours)   | Inspection records must include:  |
|--|--|---|
| (1) Rain gauge maintained in good working order    | Daily  | Daily rainfall amounts. If no daily rain gauge observations are made during weekend or holiday periods, and no individual-day rainfall information is available, record the cumulative rain measurement for those un-extended days (ens this will determine if a site inspection is needed). Days on which no rainfall occurred shall be recorded as "zero". The permittee may use another rain-monitoring device approved by the Division. |
| (2) E&S Measures                                   | At least once per 7 calendar days and within 24 hours of a rain event ≥ 1.0 inch in 24 hours | 1. Identification of the measures inspected,<br>2. Date and time of the inspection,<br>3. Name of the person performing the inspection,<br>4. Indication of whether the measures were operating properly,<br>5. Description of maintenance needs for the measure,<br>6. Description, evidence, and date of corrective actions taken.  |
| (3) Stormwater discharge outfalls (DOA)            | At least once per 7 calendar days and within 24 hours of a rain event ≥ 1.0 inch in 24 hours | 1. Identification of the discharge outfalls inspected,<br>2. Date and time of the inspection,<br>3. Name of the person performing the inspection,<br>4. Evidence of indicators of stormwater pollution such as oil sheen, floating or suspended solids or discoloration,<br>5. Indication of visible sediment leaving the site,<br>6. Description, evidence, and date of corrective actions taken.  |
| (4) Perimeter of site                              | At least once per 7 calendar days and within 24 hours of a rain event ≥ 1.0 inch in 24 hours | If visible sedimentation is found outside site limits, then a record of the following shall be made:<br>1. Actions taken to clean up or stabilize the sediment that has left the site limits.<br>2. Description, evidence, and date of corrective actions taken, and<br>3. An explanation as to the actions taken to control future releases.   |
| (5) Streams or wetlands on-site (where accessible) | At least once per 7 calendar days and within 24 hours of a rain event ≥ 1.0 inch in 24 hours | If the stream or wetland has increased visible sedimentation or a stream has visible increased turbidity from the construction activity, then a record of the following shall be made:<br>1. Description, evidence and date of corrective actions taken, and<br>2. Records of the required reports to the appropriate Division Regional Office per Part III, Section C, Item 2(a) of this permit.   |
| (6) Ground stabilization measures                  | After each phase of grading  | 1. The phase of the stabilization activity, including the use of erosion control measures, clearing and grubbing, installation of storm control measures, and other stabilization measures, and<br>2. Documentation that the required ground stabilization measures have been provided within the required timeframe or an assurance that they will be provided as soon as possible.  |

NOTE: The rain inspection resets the required 7 calendar day inspection requirement.

**PART III SELF-INSPECTION, RECORDKEEPING AND REPORTING**  
**SECTION B: RECORDKEEPING**  
**1. E&S Plan Documentation**  
The approved E&S plan as well as any approved deviation shall be kept on the site. The approved E&S plan must be kept up-to-date throughout the coverage under this permit. The following items pertaining to the E&S plan shall be kept on site and available for inspection at all times during normal business hours.

| Item to Document  | Documentation Requirements  |
|---|---|
| (a) Each E&S measure has been installed and does not significantly deviate from the locations, dimensions and relative elevations shown on the approved E&S plan. | Initial and date each E&S measure on a copy of the approved E&S plan or complete, date and sign an inspection report that lists each E&S measure shown on the approved E&S plan. This documentation is required upon the initial installation of the E&S measures or if the E&S measures are modified after initial installation. |
| (b) A phase of grading has been completed.  | Initial and date a copy of the approved E&S plan or complete, date and sign an inspection report to indicate completion of the construction phase.  |
| (c) Ground cover is located and installed in accordance with the approved E&S plan.   | Initial and date a copy of the approved E&S plan or complete, date and sign an inspection report to indicate compliance with approved ground cover specifications.  |
| (d) The maintenance and repair requirements for all E&S measures  | Complete, date and sign an inspection report.   |
| (e) Corrective actions have been taken to E&S measures.   | Initial and date a copy of the approved E&S plan or complete, date and sign an inspection report to indicate the completion of the corrective action.   |

**2. Additional Documentation to be Kept on Site**  
In addition to the E&S plan documents above, the following items shall be kept on the site and available for inspectors at all times during normal business hours, unless the Division provides a site-specific exemption based on unique site conditions that make this requirement not practical:  
(a) This General Permit as well as the Certificate of Coverage, after it is received.  
(b) Records of inspections made during the previous twelve months. The permittee shall record the required observations on the Inspection Record Form provided by the Division or a similar inspection form that includes all the required elements. Use of electronically-available records in lieu of the required paper copies will be allowed if shown to provide equal access and utility as the hard-copy records.

**3. Documentation to be Retained for Three Years**  
All data used to complete the e-NOI and all inspection records shall be maintained for a period of three years after project completion and made available upon request. (40 CFR 122.41)

**PART III SELF-INSPECTION, RECORDKEEPING AND REPORTING**  
**SECTION C: REPORTING**  
**1. Occurrences that Must be Reported**  
Permittees shall report the following occurrences:  
(a) Visible sediment deposition in a stream or wetland.  
(b) Oil spills if:  
• They are 25 gallons or more,  
• They are less than 25 gallons but cannot be cleaned up within 24 hours,  
• They cause sheen on surface waters (regardless of volume), or  
• They are within 100 feet of surface waters (regardless of volume).  
(c) Releases of hazardous substances in excess of reportable quantities under Section 311 of the Clean Water Act (Ref: 40 CFR 110.3 and 40 CFR 117.3) or Section 102 of CERCLA (Ref: 40 CFR 302.4) or G.S. 143-215.85.  
(d) Anticipated bypasses and unanticipated bypasses.  
(e) Noncompliance with the conditions of this permit that may endanger health or the environment.

**2. Reporting Timeframes and Other Requirements**  
After a permittee becomes aware of an occurrence that must be reported, he shall contact the appropriate Division regional office within the timeframes and in accordance with the other requirements listed below. Occurrences outside normal business hours may also be reported to the Department's Environmental Emergency Center personnel at (800) 858-0368.

| Occurrence   | Reporting Timeframes (After Discovery) and Other Requirements   |
|--|---|
| (a) Visible sediment deposition in a stream or wetland   | • <b>Within 24 hours</b> , an oral or electronic notification.<br>• <b>Within 7 calendar days</b> , a report that contains a description of the sediment and actions taken to address the cause of the deposition. Division staff may waive the requirement for a written report on a case-by-case basis.<br>• If the stream is named on the <b>NC 303(d) list</b> as impaired for sediment-related causes, the permittee may be required to perform additional monitoring, inspections or apply more stringent practices if staff determine that additional requirements are needed to assure compliance with the federal or state impaired-waters conditions. |
| (b) Oil spills and releases of hazardous substances per Item 1(b)-(c) above  | • <b>Within 24 hours</b> , an oral or electronic notification. The notification shall include information about the date, time, nature, volume and location of the spill or release.  |
| (c) Anticipated bypasses (40 CFR 122.41(m)(3))   | • <b>A report at least ten days before the date of the bypass, if possible.</b> The report shall include an evaluation of the anticipated quality and effect of the bypass.   |
| (d) Unanticipated bypasses (40 CFR 122.41(m)(3))   | • <b>Within 24 hours</b> , an oral or electronic notification.<br>• <b>Within 7 calendar days</b> , a report that includes an evaluation of the quality and effect of the bypass.   |
| (e) Noncompliance with the conditions of this permit that may endanger health or the environment (40 CFR 122.41(k)(7)) | • <b>Within 24 hours</b> , an oral or electronic notification.<br>• <b>Within 7 calendar days</b> , a report that contains a description of the noncompliance, and its causes; the period of noncompliance, including exact dates and times, and if the noncompliance has not been corrected, the anticipated time noncompliance is expected to continue; and steps taken or planned to reduce, eliminate, and prevent recurrence of the noncompliance. (40 CFR 122.41(j)(6)).<br>• Division staff may waive the requirement for a written report on a case-by-case basis.  |

**PART II, SECTION G, ITEM (4) DRAW DOWN OF SEDIMENT BASINS FOR MAINTENANCE OR CLOSE OUT**  
Sediment basins and traps that receive runoff from drainage areas of one acre or more shall use outlet structures that withdraw water from the surface when these devices need to be drawn down for maintenance or close out unless this is infeasible. The circumstances in which it is not feasible to withdraw water from the surface shall be rare (for example, times with extended cold weather). Non-surface withdrawals from sediment basins shall be allowed only when all of the following criteria have been met:  
(a) The E&S plan authority has been provided with documentation of the non-surface withdrawal and the specific time periods or conditions in which it will occur. The non-surface withdrawal shall not commence until the E&S plan authority has approved these items,  
(b) The non-surface withdrawal has been reported as an anticipated bypass in accordance with Part III, Section C, Item 2(c) and (d) of this permit,  
(c) Dewatering discharges are treated with controls to minimize discharges of pollutants from stormwater that is removed from the sediment basin. Examples of appropriate controls include properly sited, designed and maintained dewatering tanks, wet tanks, and filtration systems,  
(d) Vegetated, upland areas of the sites or a properly designed stone pad is used to the extent feasible at the outlet of the dewatering treatment devices described in item (c) above,  
(e) Velocity dissipation devices such as check dams, and riprap are provided at the discharge points of all dewatering devices, and  
(f) Sediment removed from the dewatering treatment devices described in item (c) above is disposed of in a manner that does not cause deposition of sediment into waters of the United States.

**NCG01 SELF-INSPECTION, RECORDKEEPING AND REPORTING** EFFECTIVE: 04/01/19



CITY OF RALEIGH - PLANS AUTHORIZED FOR CONSTRUCTION

Electronic Approval: This approval is being issued electronically. This approval is valid only upon the signature of a City of Raleigh Review Officer below. The City will retain a copy of the approved plans. Any work authorized by this approval must proceed in accordance with the plans kept on file with the City. This electronic approval may not be edited once issued. Any modification to this approval once issued will invalidate this approval.

City of Raleigh Development Approval \_\_\_\_\_  
 Raleigh Water Review Officer

R:\2019\19157 - Rolesville Town Center CIVIL\04 Construction\04 - 19157\_Grading\dwg, Drainage Tables, 3/10/2022 4:40:41 PM, marc.mueller

| STORMDRAINAGE PIPE TABLE |                |             |             |        |          |          |       |
|--------------------------|----------------|-------------|-------------|--------|----------|----------|-------|
| U.S. STRUCTURE           | D.S. STRUCTURE | U.S. INVERT | D.S. INVERT | LENGTH | DIAMETER | MATERIAL | SLOPE |
| 2                        | 1              | 420.00      | 419.80      | 18.80  | 24       | HDPE     | 1.06% |
| 4                        | 3              | 421.26      | 421.00      | 43.91  | 36       | HDPE     | 0.60% |
| 5                        | 4              | 422.04      | 421.36      | 113.45 | 36       | HDPE     | 0.60% |
| 6                        | 5              | 423.35      | 422.14      | 201.82 | 36       | HDPE     | 0.60% |
| 7                        | 6              | 423.62      | 423.45      | 28.04  | 36       | HDPE     | 0.60% |
| 8                        | 7              | 425.82      | 424.94      | 88.24  | 24       | HDPE     | 1.00% |
| 9                        | 8              | 426.82      | 425.92      | 90.21  | 24       | HDPE     | 1.00% |
| 10                       | 9              | 427.59      | 426.92      | 87.14  | 24       | HDPE     | 1.00% |
| 11                       | 10             | 428.63      | 427.69      | 93.66  | 18       | HDPE     | 1.00% |
| 12                       | 11             | 429.65      | 428.73      | 91.93  | 18       | HDPE     | 1.00% |
| 13                       | 12             | 430.39      | 429.75      | 63.96  | 15       | HDPE     | 1.00% |

| STORMDRAINAGE PIPE TABLE |                |             |             |        |          |          |       |
|--------------------------|----------------|-------------|-------------|--------|----------|----------|-------|
| U.S. STRUCTURE           | D.S. STRUCTURE | U.S. INVERT | D.S. INVERT | LENGTH | DIAMETER | MATERIAL | SLOPE |
| 14                       | 13             | 430.75      | 430.49      | 25.95  | 15       | HDPE     | 1.00% |
| 15                       | 5              | 424.10      | 423.05      | 105.41 | 15       | HDPE     | 1.00% |
| 16                       | 7              | 424.61      | 423.72      | 147.77 | 24       | HDPE     | 0.60% |
| 17                       | 16             | 425.41      | 424.71      | 116.44 | 24       | HDPE     | 0.60% |
| 18                       | 17             | 428.85      | 427.77      | 107.92 | 15       | HDPE     | 1.00% |
| 19                       | 18             | 431.57      | 430.69      | 88.39  | 15       | HDPE     | 1.00% |
| 20                       | 19             | 432.50      | 431.67      | 83.01  | 15       | HDPE     | 1.00% |
| 21                       | 6              | 424.24      | 423.45      | 78.65  | 24       | HDPE     | 1.00% |
| 22                       | 21             | 424.60      | 424.34      | 26.08  | 15       | HDPE     | 1.00% |
| 23                       | 22             | 426.78      | 424.70      | 207.76 | 15       | HDPE     | 1.00% |
| 24                       | 10             | 432.22      | 430.86      | 90.55  | 15       | HDPE     | 1.50% |

| STORMDRAINAGE PIPE TABLE |                |             |             |        |          |          |       |
|--------------------------|----------------|-------------|-------------|--------|----------|----------|-------|
| U.S. STRUCTURE           | D.S. STRUCTURE | U.S. INVERT | D.S. INVERT | LENGTH | DIAMETER | MATERIAL | SLOPE |
| 27                       | 28             | 436.27      | 435.41      | 85.76  | 15       | HDPE     | 1.00% |
| 28                       | 35             | 435.31      | 434.24      | 106.92 | 15       | HDPE     | 1.00% |
| 29                       | 22             | 425.05      | 424.70      | 34.83  | 15       | HDPE     | 1.00% |
| 30                       | 17             | 426.34      | 425.51      | 137.91 | 18       | HDPE     | 0.60% |
| 31                       | 18             | 429.82      | 428.95      | 87.08  | 15       | HDPE     | 1.00% |
| 32                       | 9              | 429.50      | 428.60      | 90.23  | 15       | HDPE     | 1.00% |
| 33                       | 24             | 432.43      | 432.32      | 11.23  | 15       | HDPE     | 1.00% |
| 34                       | 17             | 428.09      | 427.77      | 32.09  | 12       | HDPE     | 1.00% |
| 35                       | 33             | 434.14      | 432.53      | 160.60 | 15       | HDPE     | 1.00% |

| STORMDRAINAGE STRUCTURE TABLE |  |                  |
|-------------------------------|--|------------------|
| STRUCTURE NAME                | INSERTION RIM ELEVATION (FLOWLINE)   | STRUCTURE TYPE   |
| 1                             | 422.45<br>INV. IN= 419.80 (2)  | 24" FES          |
| 2                             | 425.18<br>INV. OUT= 420.00 (1)   | RISER            |
| 3                             | 424.83<br>INV. IN= 421.00 (4)  | 36" FES          |
| 4                             | 428.06<br>INV. IN= 421.36 (5)<br>INV. OUT= 421.26 (3)                          | NCDOT CURB INLET |
| 5                             | 429.08<br>INV. IN= 422.14 (6)<br>INV. IN= 423.05 (15)<br>INV. OUT= 422.04 (4)  | NCDOT CURB INLET |
| 6                             | 430.99<br>INV. IN= 423.45 (7)<br>INV. IN= 423.45 (21)<br>INV. OUT= 423.35 (5)  | NCDOT CURB INLET |
| 7                             | 431.15<br>INV. IN= 424.94 (8)<br>INV. IN= 423.72 (16)<br>INV. OUT= 423.62 (6)  | NCDOT CURB INLET |
| 8                             | 433.95<br>INV. IN= 425.82 (9)<br>INV. OUT= 425.82 (7)                          | NCDOT CURB INLET |
| 9                             | 433.95<br>INV. IN= 426.92 (10)<br>INV. IN= 428.60 (32)<br>INV. OUT= 426.82 (8) | NCDOT CURB INLET |

| STORMDRAINAGE STRUCTURE TABLE |   |                  |
|-------------------------------|---|------------------|
| STRUCTURE NAME                | INSERTION RIM ELEVATION (FLOWLINE)  | STRUCTURE TYPE   |
| 10                            | 436.44<br>INV. IN= 427.69 (11)<br>INV. IN= 430.86 (24)<br>INV. OUT= 427.59 (9)                          | HDPE YARD INLET  |
| 11                            | 437.44<br>INV. IN= 428.73 (12)<br>INV. OUT= 428.63 (10)   | HDPE YARD INLET  |
| 12                            | 435.50<br>INV. IN= 429.75 (13)<br>INV. OUT= 429.65 (11)   | HDPE YARD INLET  |
| 13                            | 436.00<br>INV. IN= 430.49 (14)<br>INV. OUT= 430.39 (12)   | NCDOT CURB INLET |
| 14                            | 436.00<br>INV. OUT= 430.75 (13)   | NCDOT CURB INLET |
| 15                            | 428.50<br>INV. OUT= 424.10 (5)  | HDPE YARD INLET  |
| 16                            | 429.68<br>INV. IN= 424.71 (17)<br>INV. OUT= 424.61 (7)  | NCDOT CURB INLET |
| 17                            | 434.01<br>INV. IN= 427.77 (18)<br>INV. IN= 425.51 (30)<br>INV. IN= 427.77 (34)<br>INV. OUT= 425.41 (16) | NCDOT CURB INLET |
| 18                            | 436.04<br>INV. IN= 430.89 (19)<br>INV. IN= 428.95 (31)<br>INV. OUT= 428.85 (17)                         | NCDOT CURB INLET |

| STORMDRAINAGE STRUCTURE TABLE |   |                  |
|-------------------------------|---|------------------|
| STRUCTURE NAME                | INSERTION RIM ELEVATION (FLOWLINE)  | STRUCTURE TYPE   |
| 19                            | 437.52<br>INV. IN= 431.67 (20)<br>INV. OUT= 431.57 (18)                         | NCDOT CURB INLET |
| 20                            | 438.65<br>INV. OUT= 432.50 (19)   | NCDOT CURB INLET |
| 21                            | 431.60<br>INV. IN= 424.34 (22)<br>INV. OUT= 424.24 (6)                          | HDPE YARD INLET  |
| 22                            | 432.00<br>INV. IN= 424.70 (23)<br>INV. IN= 424.70 (29)<br>INV. OUT= 424.60 (21) | NCDOT CURB INLET |
| 23                            | 435.99<br>INV. OUT= 426.78 (22)   | NCDOT CURB INLET |
| 24                            | 437.18<br>INV. IN= 432.32 (33)<br>INV. OUT= 432.22 (10)                         | HDPE YARD INLET  |
| 27                            | 441.00<br>INV. OUT= 436.27 (28)   | HDPE YARD INLET  |
| 28                            | 441.00<br>INV. IN= 435.41 (27)<br>INV. OUT= 435.31 (35)                         | HDPE YARD INLET  |
| 29                            | 428.50<br>INV. OUT= 425.05 (22)   | HDPE YARD INLET  |

| STORMDRAINAGE STRUCTURE TABLE |   |                  |
|-------------------------------|---|------------------|
| STRUCTURE NAME                | INSERTION RIM ELEVATION (FLOWLINE)                      | STRUCTURE TYPE   |
| 30                            | 430.12<br>INV. OUT= 426.34 (17)                         | NCDOT CURB INLET |
| 31                            | 434.05<br>INV. OUT= 429.82 (18)                         | NCDOT CURB INLET |
| 32                            | 435.72<br>INV. OUT= 429.50 (9)                          | NCDOT CURB INLET |
| 33                            | 437.54<br>INV. IN= 432.53 (35)<br>INV. OUT= 432.43 (24) | NCDOT CURB INLET |
| 34                            | 430.03<br>INV. OUT= 428.09 (17)                         | HDPE YARD INLET  |
| 35                            | 441.08<br>INV. IN= 434.24 (28)<br>INV. OUT= 434.14 (33) | HDPE YARD INLET  |



**BASS, NIXON & KENNEDY, INC.**  
**CONSULTING ENGINEERS**  
 6310 CHAPEL HILL ROAD, SUITE 250, RALEIGH, NC 27607  
 TELEPHONE: (919)851-4422 FAX: (919)851-8988  
 CERTIFICATION NUMBERS: NCBELS (C-0110); NCBOLA (C-0267)

| NO. | DATE | DESCRIPTION | BY |
|-----|------|-------------|----|
|     |      |             |    |
|     |      |             |    |
**COBBLESTONE VILLAGE MIXED USE DEVELOPMENT**  
 TOWN OF ROLESVILLE, WAKE COUNTY, NORTH CAROLINA

**SHEET C3.8**

NOT RELEASED FOR CONSTRUCTION OR BID SOLICITATION



3/10/22

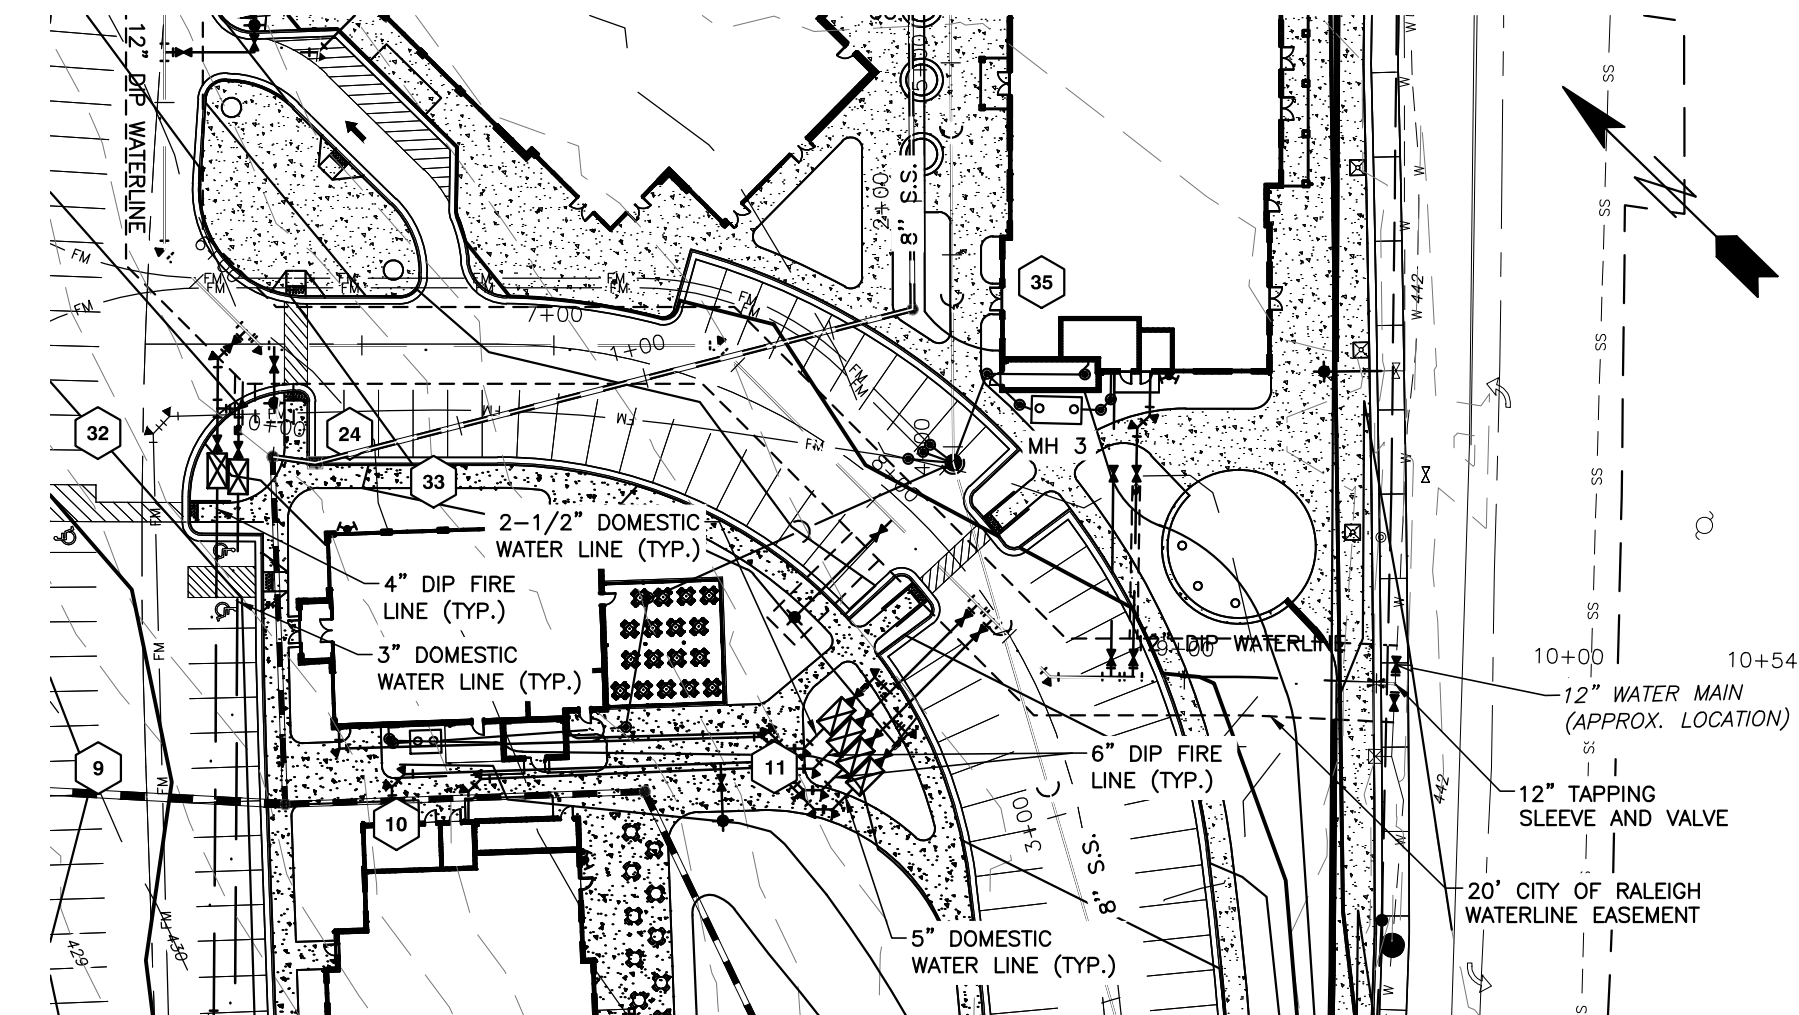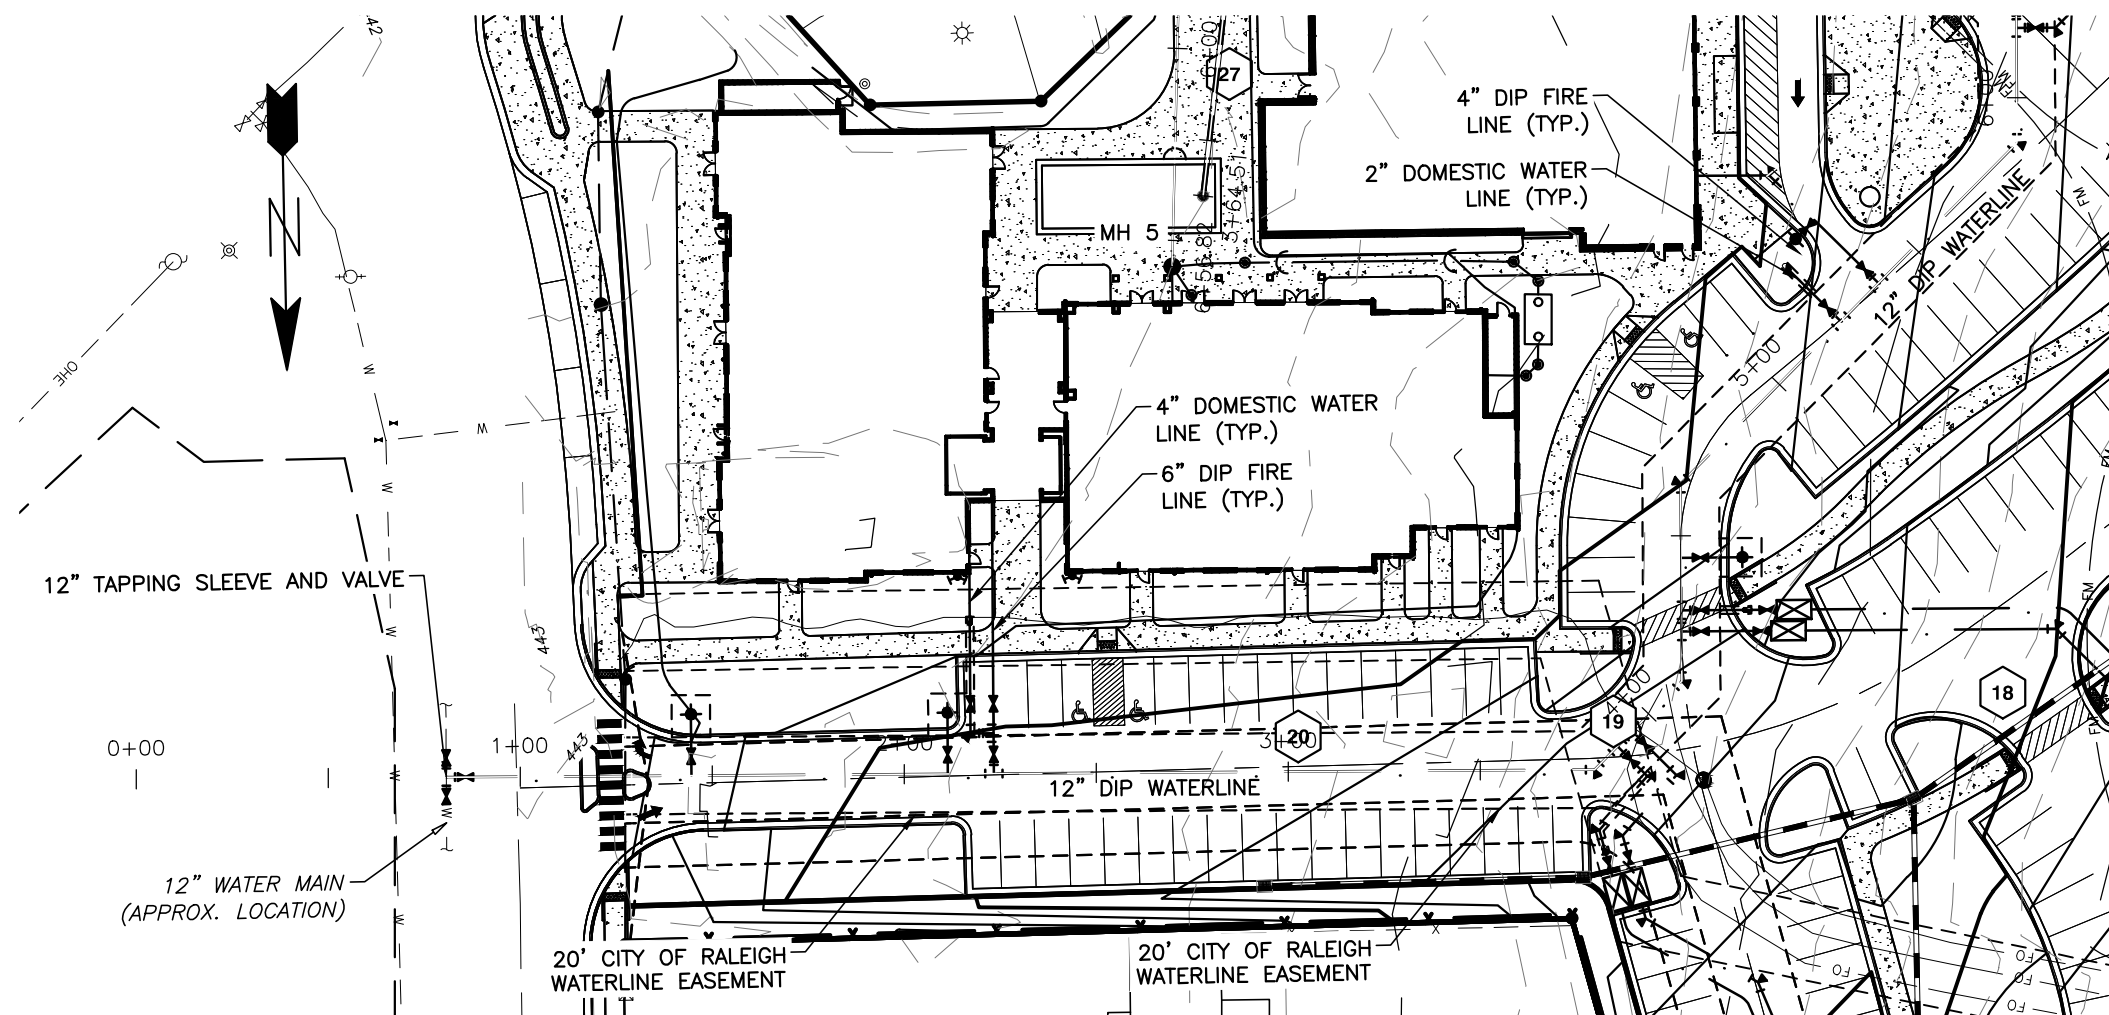


**Public**  
**Water Distribution / Extension System**  
 The City of Raleigh consents to the connection and extension of the City's public water system as shown on this plan. The material and construction methods used for this project shall conform to the standards and specifications of the City's Public Utilities Handbook.  
 City of Raleigh  
 Public Utilities Department Permit # W-3879  
 Authorization to Construct See digital signature

CITY OF RALEIGH - PLANS AUTHORIZED FOR CONSTRUCTION  
 Electronic Approval: This approval is being issued electronically. This approval is valid only upon the signature of a City of Raleigh Review Officer below. The City will retain a copy of the approved plans. Any work authorized by this approval must proceed in accordance with the plans kept on file with the City. This electronic approval may not be edited once issued. Any modification to this approval once issued will invalidate this approval.  
 City of Raleigh Development Approval \_\_\_\_\_  
 Raleigh Water Review Officer \_\_\_\_\_



**BASS, NIXON & KENNEDY, INC.**  
**CONSULTING ENGINEERS**  
 6310 CHAPEL HILL ROAD, SUITE 250, RALEIGH, NC 27607  
 TELEPHONE: (919)881-1122 FAX: (919)881-8686  
 CERTIFICATION NUMBERS: NCBELS (C-0110); NCBOLA (C-0267)

**PUBLIC WATERLINE PROFILE**

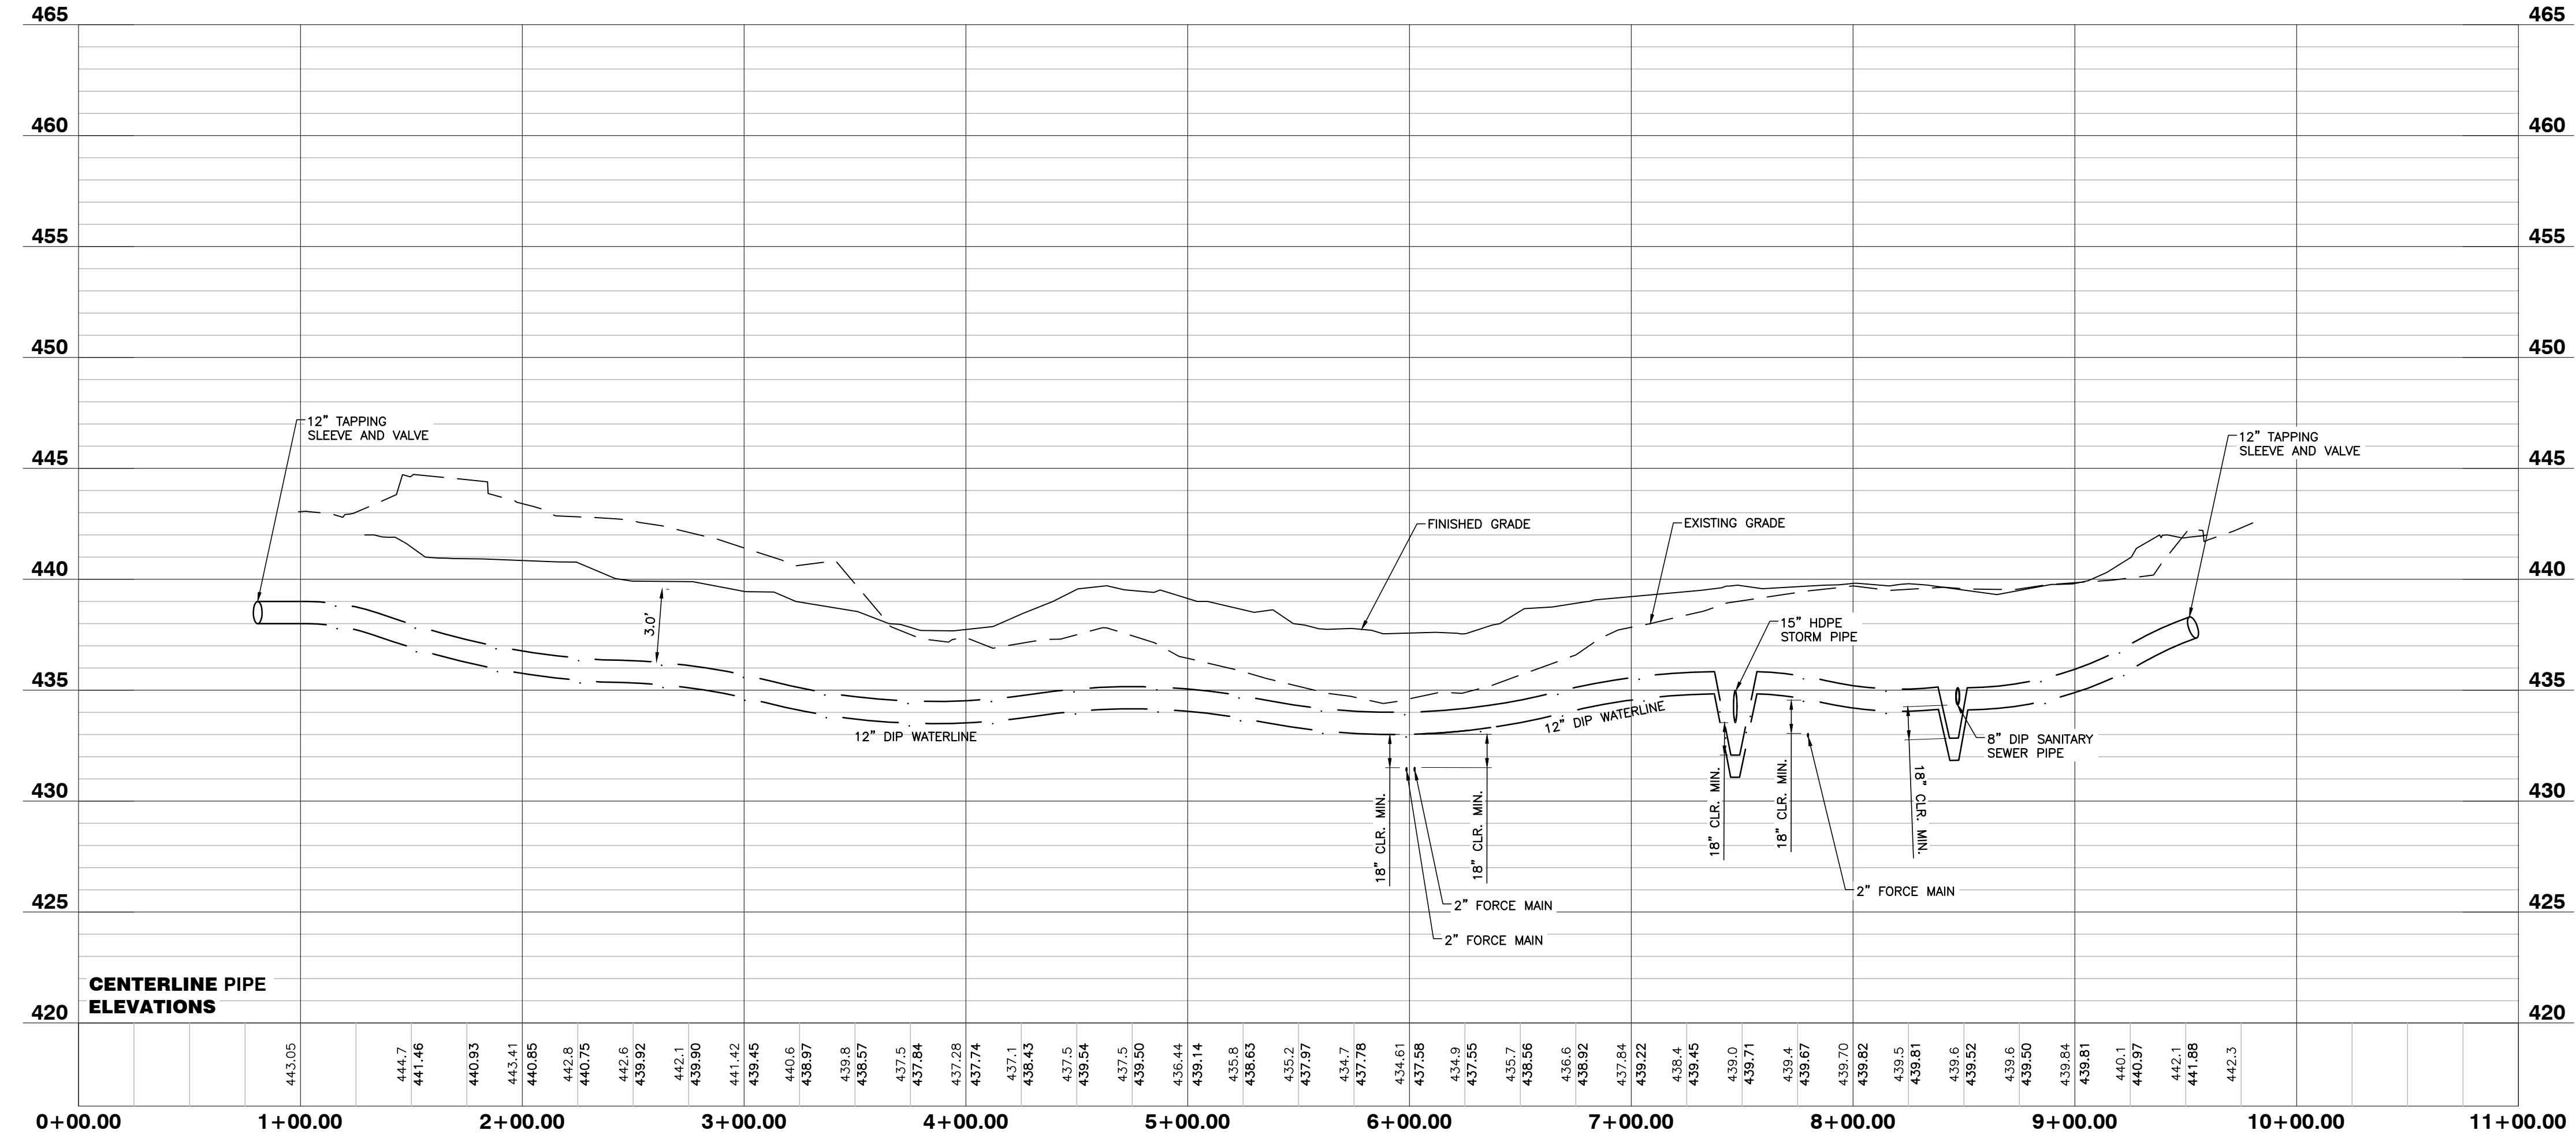

3/10/22

NO FLOODPLAINS EXIST ON-SITE

NOTE: ALL CONSTRUCTION ACTIVITY MUST BE IN ACCORDANCE WITH THE ACCEPTED POLICIES OF THE TOWN OF ROLESVILLE AND NCDOT

R:\2019\19187 - Rolesville Town Center\CIVIL\04 Construction\10 - 19187\_Data.dwg, Waterline Profile, 3/10/2022 5:05:25 PM, marc.mueller

| NO. | DATE | DESCRIPTION | BY |
|-----|------|-------------|----|
|     |      |             |    |
|     |      |             |    |
|     |      |             |    |

|  |          |          |
|--|----------|----------|
| 03-19187                                 | PROGRESS | MRM      |
| JOB NO.                                  | DATE     | DRAWN BY |
| PUBLIC WATERLINE PROFILE                 |          |          |
| SCALE: 1" = 50' H; 1" = 5' V CHK BY: MDB |          |          |

**COBBLESTONE VILLAGE**  
**MIXED USE DEVELOPMENT**  
 TOWN OF ROLESVILLE, WAKE COUNTY, NORTH CAROLINA

SHEET  
**C4.1**


NOT RELEASED FOR CONSTRUCTION OR BID SOLICITATION

**Private Sewer Collection / Extension System**  
 The City of Raleigh consents to the connection to its public sewer system and extension of the private sewer collection system as shown on this plan. The material and construction methods used for this project shall conform to the standards and specifications of the City's Public Utilities Handbook.  
 City of Raleigh  
 Public Utilities Department Permit # S-4962 (P)  
 Authorization to Construct See digital signature




**BASS, NIXON & KENNEDY, INC.**  
**CONSULTING ENGINEERS**  
 6310 CHAPEL HILL ROAD, SUITE 250, RALEIGH, NC 27607  
 TELEPHONE: (919)881-1422 FAX: (919)881-8686  
 CERTIFICATION NUMBERS: NCBELS (C-0110); NCBOLA (C-0267)

CITY OF RALEIGH - PLANS AUTHORIZED FOR CONSTRUCTION  
 Electronic Approval: This approval is being issued electronically. This approval is valid only upon the signature of a City of Raleigh Review Officer below. The City will retain a copy of the approved plans. Any work authorized by this approval must proceed in accordance with the plans kept on file with the City. This electronic approval may not be edited once issued. Any modification to this approval once issued will invalidate this approval.  
 City of Raleigh Development Approval \_\_\_\_\_  
 Raleigh Water Review Officer \_\_\_\_\_

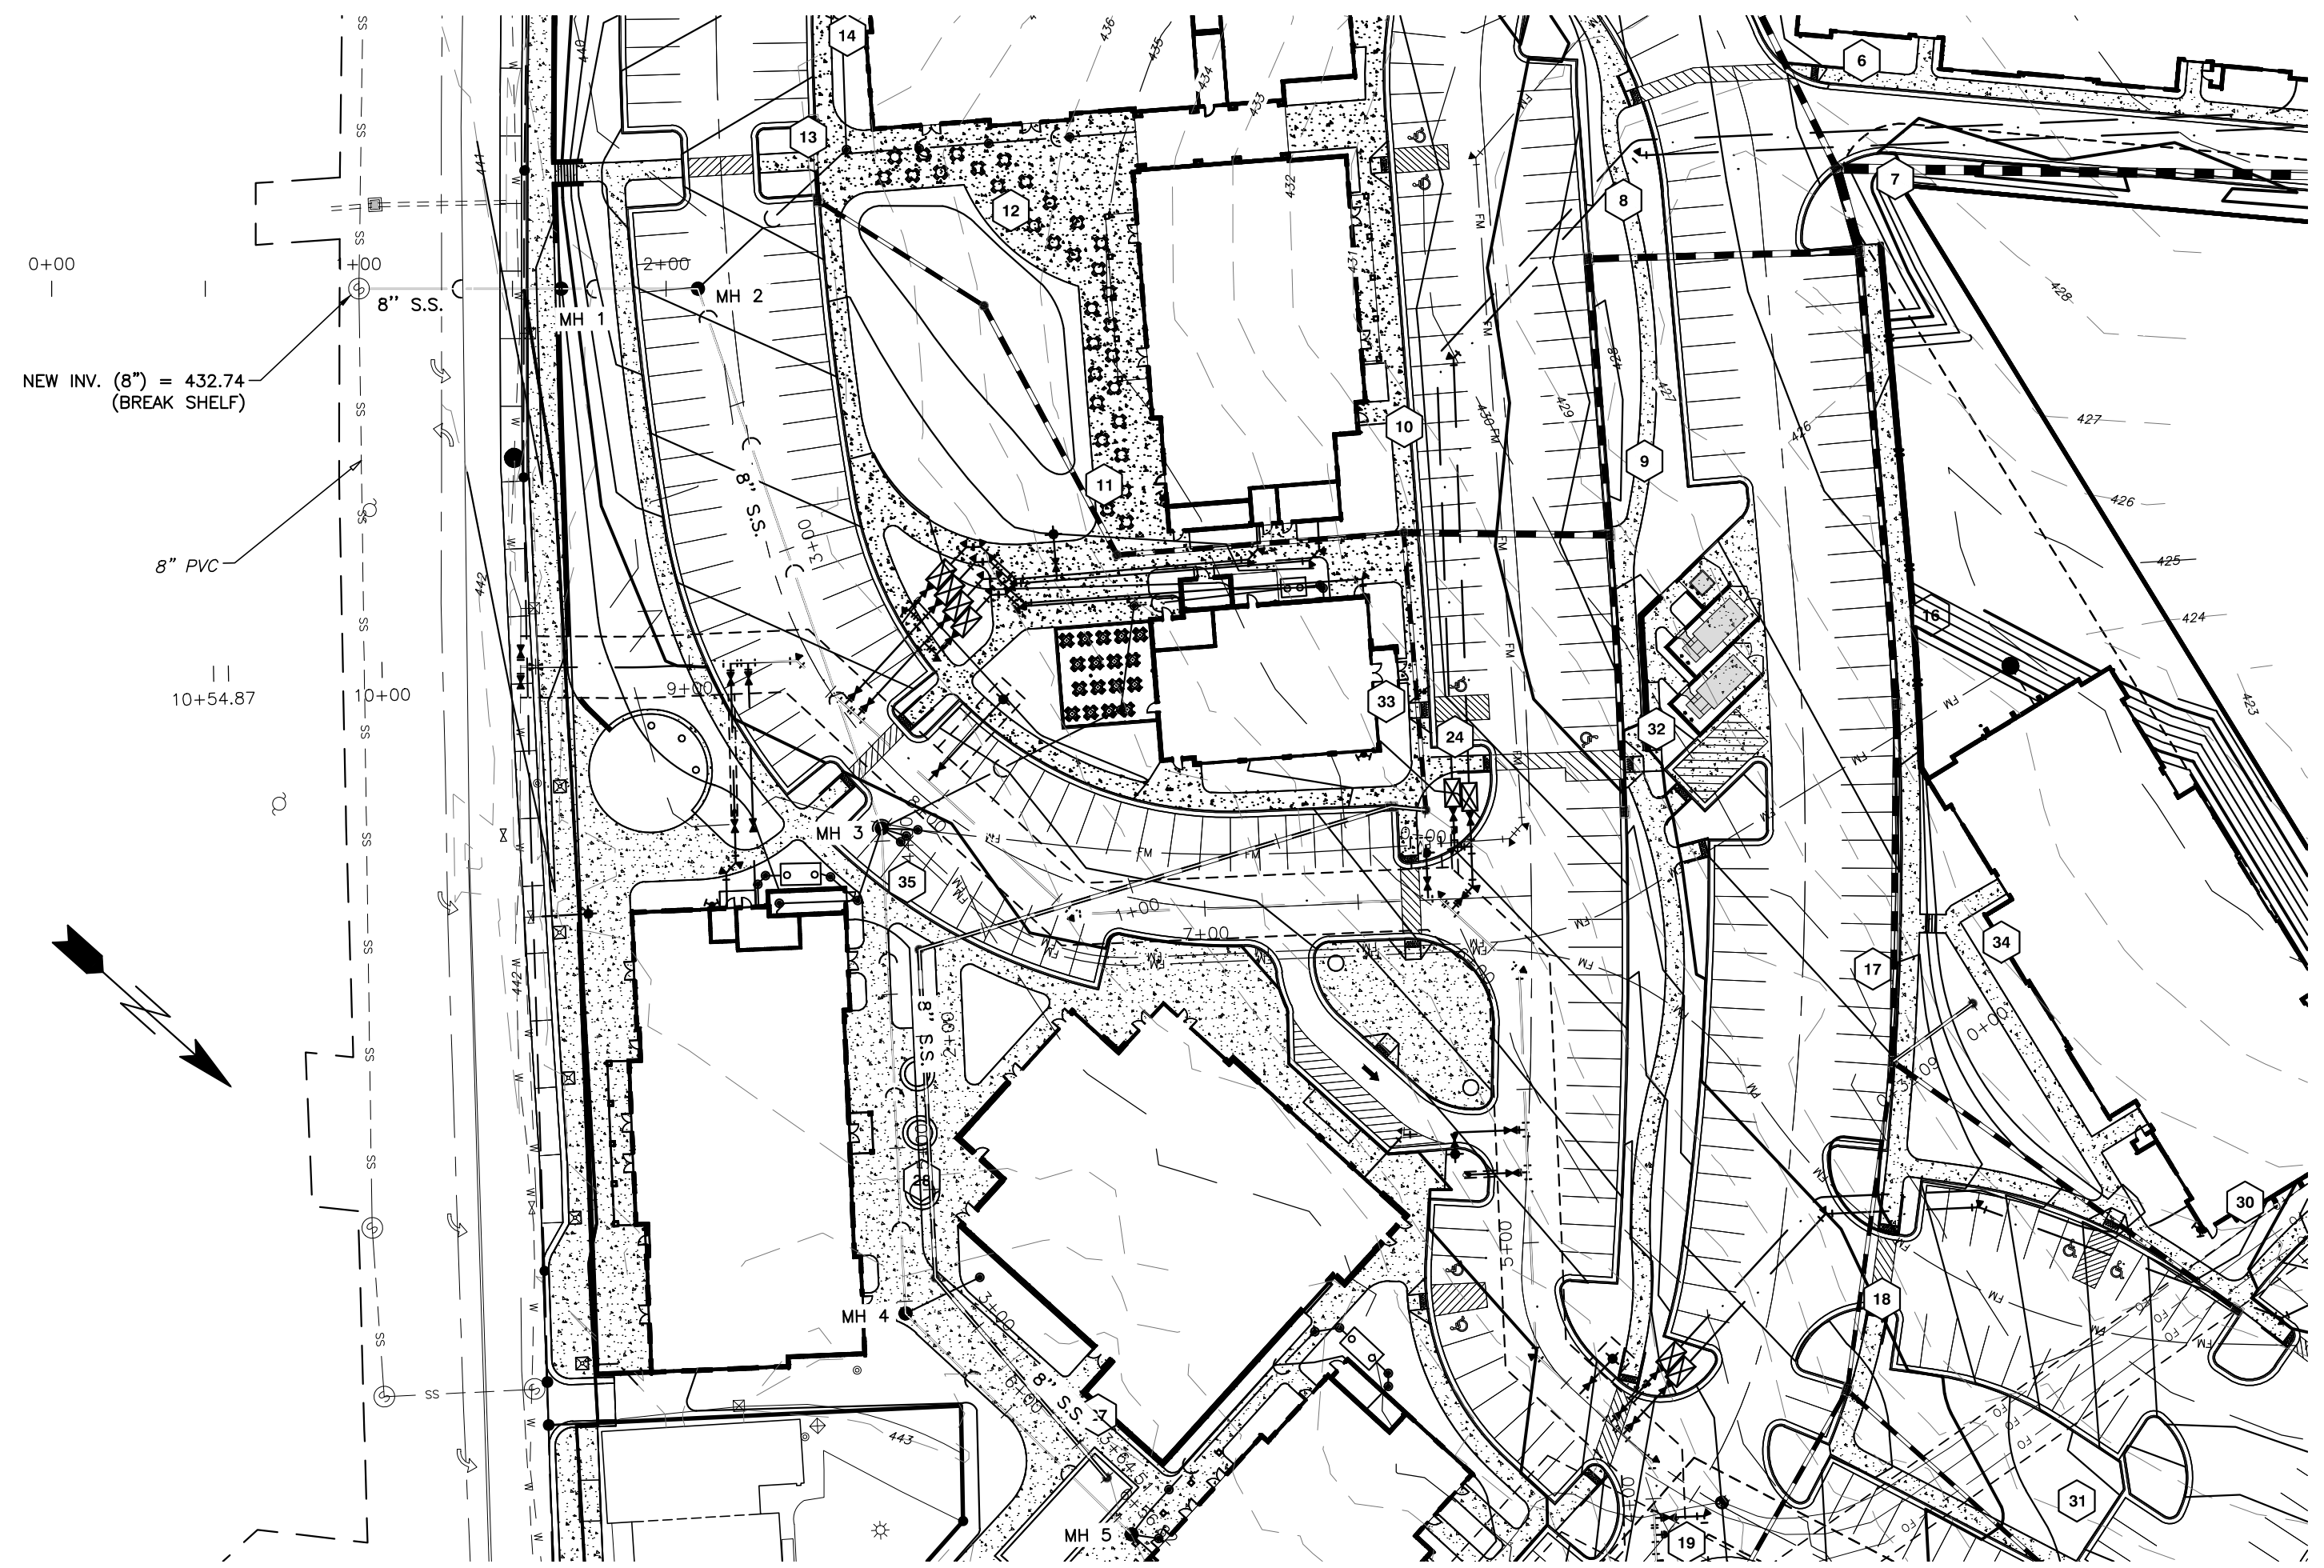

**SANITARY SEWER PROFILE**

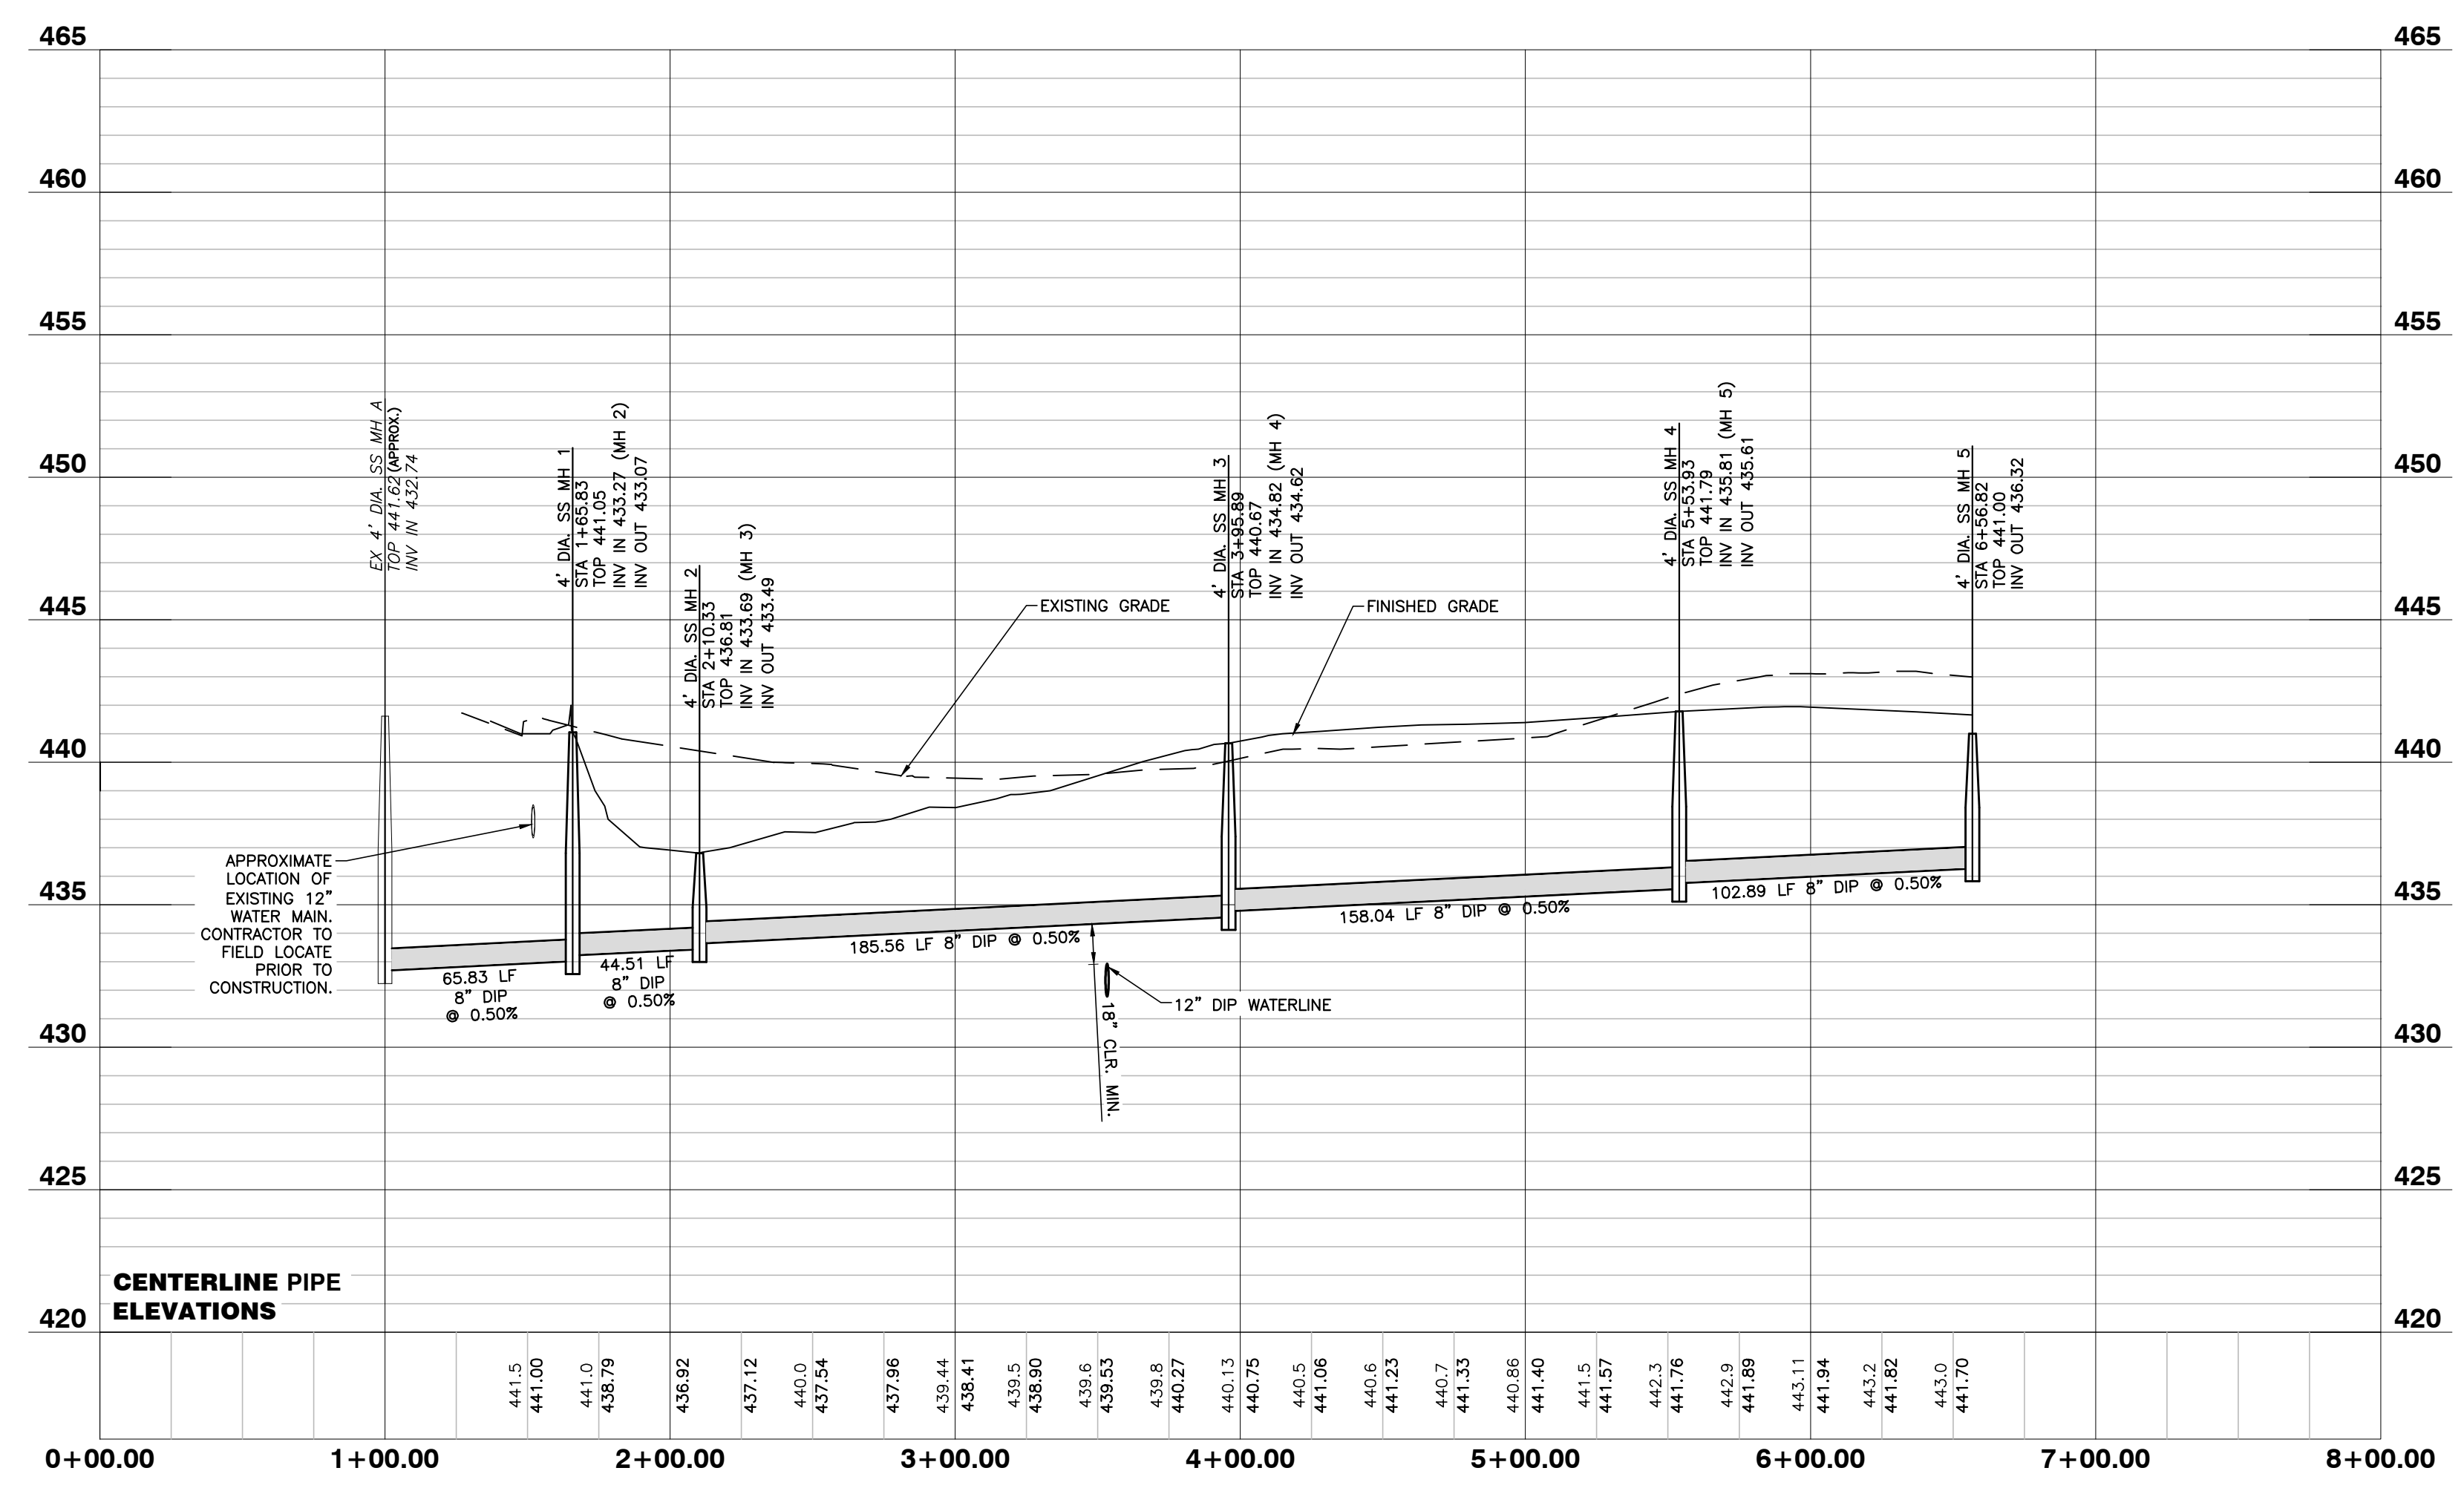

3/10/22

NO FLOODPLAINS EXIST ON-SITE


NOTE: ALL CONSTRUCTION ACTIVITY MUST BE IN ACCORDANCE WITH THE ACCEPTED POLICIES OF THE TOWN OF ROLESVILLE AND NCDOT

| NO. | DATE | DESCRIPTION | BY |
|-----|------|-------------|----|
|     |      |             |    |
|     |      |             |    |
|     |      |             |    |
|     |      |             |    |

COBBLESTONE VILLAGE MIXED USE DEVELOPMENT  
 TOWN OF ROLESVILLE, WAKE COUNTY, NORTH CAROLINA  
 SHEET C4.2

**GENERAL NOTES**

1. A/C UNITS, TRANSFORMERS AND OTHER MECHANICAL OR UTILITY EQUIPMENT, NOT SHOWN ON THE PLAN, SHALL BE SCREENED FROM VIEW EITHER BY ADJUSTING PLANTINGS SHOWN IN CLOSE PROXIMITY TO EQUIPMENT OR BY THE ADDITION OF WAX MYRTLES @ 24" HT., 5" OC (SEE GENERAL NOTES FOR EQUIPMENT ACCESSIBILITY AND PLANTING PROXIMITY, ETC.). DUMPSTER IS SCREENED FROM OFF-SITE VIEWS.
2. CONTRACTOR SHALL VERIFY LOCATION OF ALL UTILITIES PRIOR TO PLANTING.
3. MULCH SHALL BE 3" DEEP MULCH UNLESS OTHERWISE NOTED.
4. VERIFICATION OF TOTAL QUANTITIES AS SHOWN IN THE PLANT LIST AND ON THE PLAN SHALL BE THE RESPONSIBILITY OF THE LANDSCAPE CONTRACTOR. ANY DISCREPANCIES BETWEEN PLANT LIST AND PLANTING PLAN SHALL BE BROUGHT TO THE ATTENTION OF THE LANDSCAPE ARCHITECT FOR CLARIFICATION.
5. ALL TREES, SHRUBS, GROUNDCOVER, ETC. SHALL CONFORM TO ACCEPTED STANDARDS ESTABLISHED BY THE AMERICAN ASSOCIATION OF NURSERMEN.
6. ALL ROOTBALLS REMOVED FROM CONTAINERS SHALL BE SCARIFIED PRIOR TO PLANTING.
7. B&B AS LISTED UNDER "ROOT" IN THE PLANT LIST INDICATES BALLED & BURLAPPED.
8. ALL PLANTS/PLANTINGS SHALL BE MULCHED IMMEDIATELY AFTER PLANTING AND WATERED.
9. ALL PLANTS SHALL BEAR THE SAME RELATIONSHIP TO FINISHED GRADE AS THEY BORE TO PREVIOUS EXISTING GRADE (UNLESS OTHERWISE NOTED).
10. ALL TREES AND SHRUBS SHALL REQUIRE MULCH RINGS AT THEIR BASE IF LEFT WITHIN LAWN AREAS.
11. MULCH EDGES AND PROPOSED PLANTINGS SHALL NOT DISTURB ANY EXISTING GROUPS OF TREES TO REMAIN. EDGES ARE SHOWN FOR APPROXIMATION ONLY, BUT ARE TO INDICATE SMOOTH, CLEAN CURVES.
12. CULVERTS, RIP-RAP STRUCTURES, AND OTHER STORMWATER DEVICES SHALL BE SCREENED WITH EVERGREEN SHRUBS. IF STRUCTURES ARE NOT SHOWN ON THE PLAN, INSTALL WAX MYRTLES @ 24" HT., 5" OC.
13. A 2' BUMPER OVERHANG, FROM THE BACK OF CURB, SHALL BE ALLOTTED FOR MATURE SHRUBS.
14. TREE PROTECTION FENCING SHALL BE MAINTAINED UNTIL ALL SITE WORK IS COMPLETED. THE FENCING SHALL BE REMOVED PRIOR TO THE FINAL SITE INSPECTION FOR THE CERTIFICATE OF OCCUPANCY (C.O.). THE SITE SHALL BE STABILIZED AND SEEDED PRIOR TO THE ISSUANCE OF A (C.O.).
15. UNLESS OTHERWISE NOTED ON THE PLAN, ALL DISTURBED AREAS ARE TO BE SEED WITH WARM SEASON GRASS, INCLUDING PARKING LOT PERIMETERS AND PARKING LOT ISLANDS.
16. PERIMETER BUFFER AREAS ARE TO BE MULCHED TO A DEPTH OF THREE INCHES.

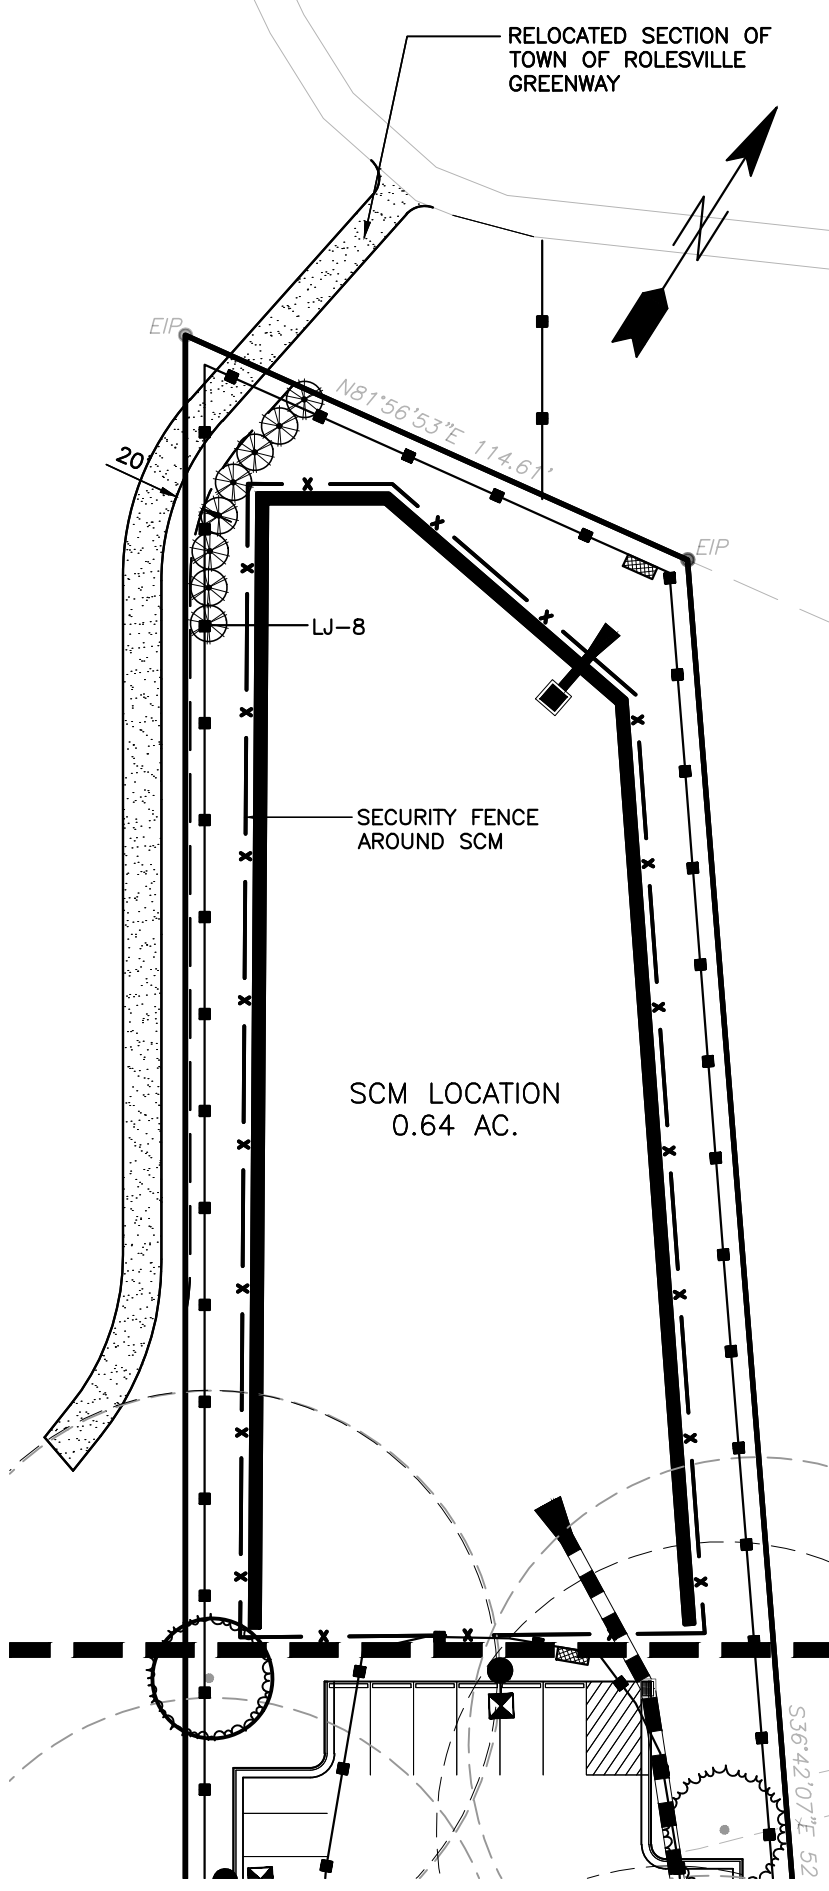

**LANDSCAPE CALCULATIONS**

**PERIMETER BUFFERS (10' TYPICAL):**  
 WEST (1) - 352 LF = 4 TREES / 100 LF = 14 TREES REQUIRED/PROVIDED  
 = 40 SHRUBS / 100 LF = 141 SHRUBS REQUIRED/PROVIDED  
 = 352 LF MIN. 6' TALL FENCE REQUIRED


**NORTH (2) - 187 LF = 4 TREES / 100 LF = 8 TREES REQUIRED/PROVIDED**  
 = 40 SHRUBS / 100 LF = 75 SHRUBS REQUIRED/PROVIDED  
 = 187 LF MIN. 6' TALL FENCE REQUIRED

**NORTHEAST (3) - 240 LF = 4 TREES / 100 LF = 10 TREES REQUIRED/PROVIDED**  
 = 40 SHRUBS / 100 LF = 96 SHRUBS REQUIRED/PROVIDED  
 = 240 LF MIN. 6' TALL FENCE REQUIRED

**EAST (4) - 247 LF = 4 TREES / 100 LF = 10 TREES REQUIRED/PROVIDED**  
 = 40 SHRUBS / 100 LF = 100 SHRUBS REQUIRED/PROVIDED  
 = 247 LF MIN. 6' TALL FENCE REQUIRED

**STREET YARDS:**  
 MAIN ST - 595 LF = 1 TREE / 50 LF = 12 TREES REQUIRED/PROVIDED  
 WEST YOUNG ST - 242 LF = 1 TREE / 50 LF = 5 TREES REQUIRED/PROVIDED

VEHICULAR USE AREA COVERAGE: 1 TREE WITHIN 60' OF EACH PARKING SPACE

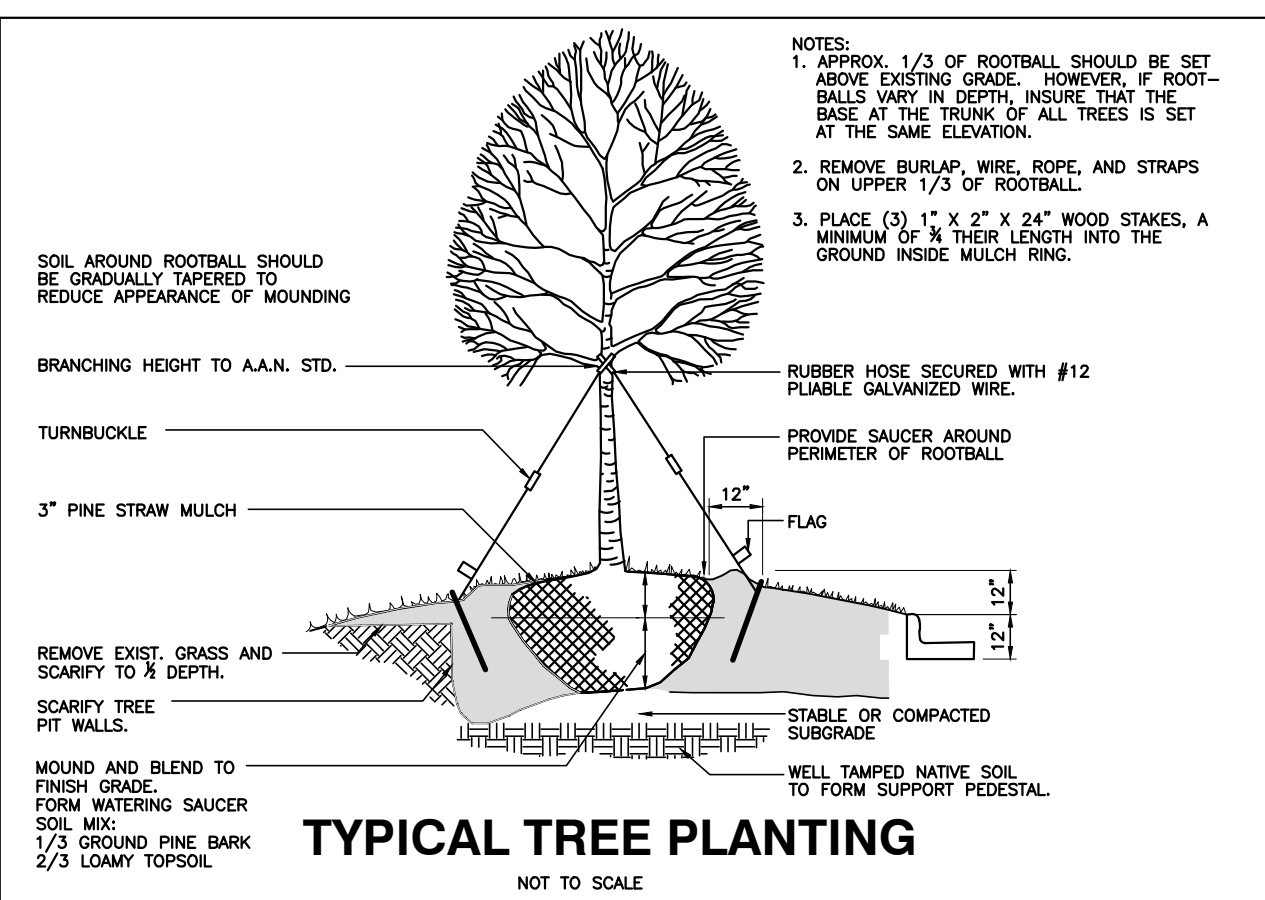


**PLANTING NOTES:**  
 LOCATE PLANTS AND PLANTING BEDS BY USING SCALED DIMENSIONS FROM STREET, PROPERTY LINES, BACK OF CURB, BUILDINGS, WALLS, ETC. ALL PLANTS SHALL MEET OR EXCEED THE MINIMUM STANDARDS SET BY THE U.S.D.A. FOR NURSERY STOCK. SPONSORED BY THE AMERICAN ASSOCIATION OF NURSERMEN, WASHINGTON, D.C. NO SUBSTITUTIONS SHALL BE PERMITTED WITHOUT WRITTEN APPROVAL FROM THE OWNER AND/OR THE LANDSCAPE ARCHITECT. SYMBOLS: B&B = BALLED & BURLAPPED; B.R. = BARE ROOT; CONT. = CONTAINER, O.C. = ON-CENTER

STREET TREE PLANTINGS TO BE COORDINATED IN CONCURRENCE WITH NCDOT STREETSCAPE IMPROVEMENT PROJECT ALONG S. MAIN AND YOUNG STREET(S).



**PLANT LIST**

| KEY                 | SCIENTIFIC NAME                     | COMMON NAME                | QUAN. | CAL  | HT  | ROOT  |
|---------------------|-------------------------------------|----------------------------|-------|------|-----|-------|
| <b>CANOPY TREES</b> |                                     |                            |       |      |     |       |
| AF                  | Acer freemanii                      | Freeman Maple              | 30    | 2.5" | 8'  | B&B   |
| AR                  | Acer rubrum 'Brandywine'            | Brandywine Red Maple       | 21    | 2.5" | 8'  | B&B   |
| JV                  | Juniperus virginiana                | Eastern Red Cedar          | 27    | 2.5" | 8'  | B&B   |
| QN                  | Quercus nuttallii                   | Nuttall Oak                | 19    | 2.5" | 8'  | B&B   |
| UP                  | Ulmus parvifolia 'Allee'            | Allee Elm                  | 6     | 2.5" | 8'  | B&B   |
| <b>SHRUBS</b>       |                                     |                            |       |      |     |       |
| CJ                  | Cleyera japonica                    | Japanese Cleyera           | 98    |      | 24" | CONT. |
| DG                  | Distylium 'Green Wave'              | Green Wave Distylium       | 31    |      | 24" | CONT. |
| IC                  | Ilex crenata 'Sky Pencil'           | Sky Pencil Holly           | 6     |      | 36" | CONT. |
| ICC                 | Ilex crenata 'Chesapeake'           | Chesapeake Holly           | 153   |      | 24" | CONT. |
| ICG                 | Ilex crenata 'Green Lustre'         | Green Lustre Japanese Holl | 120   |      | 24" | CONT. |
| JC                  | Juniperus chinensis 'Seybrook Gold' | Seybrook Gold Juniper      | 25    |      | 24" | CONT. |
| LC                  | Loropetalum chinense 'Daruma'       | Daruma Loropetalum         | 26    |      | 24" | CONT. |
| LJ                  | Ligustrum japonicum                 | Wax Ligustrum              | 98    |      | 24" | CONT. |
| OF                  | Osmanthus fragrans                  | Fragrant Tea Olive         | 142   |      | 24" | CONT. |
| VML                 | Viburnum x 'Moonlit Lace'           | Moonlit Lace Viburnum      | 186   |      | 24" | CONT. |

Please refer to comment letter for full comments on landscape plan.

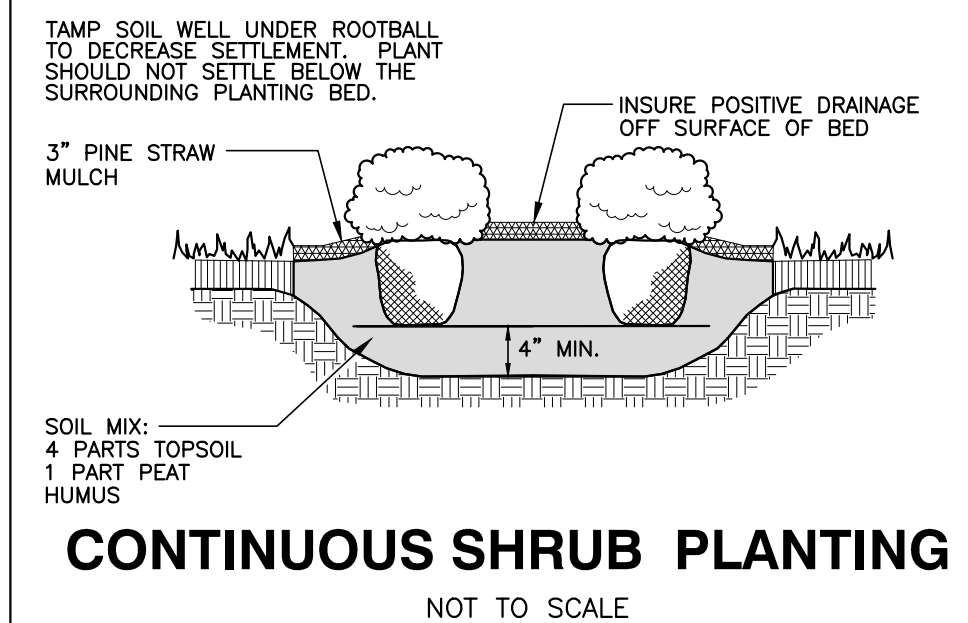

**PLANT SYMBOLS**

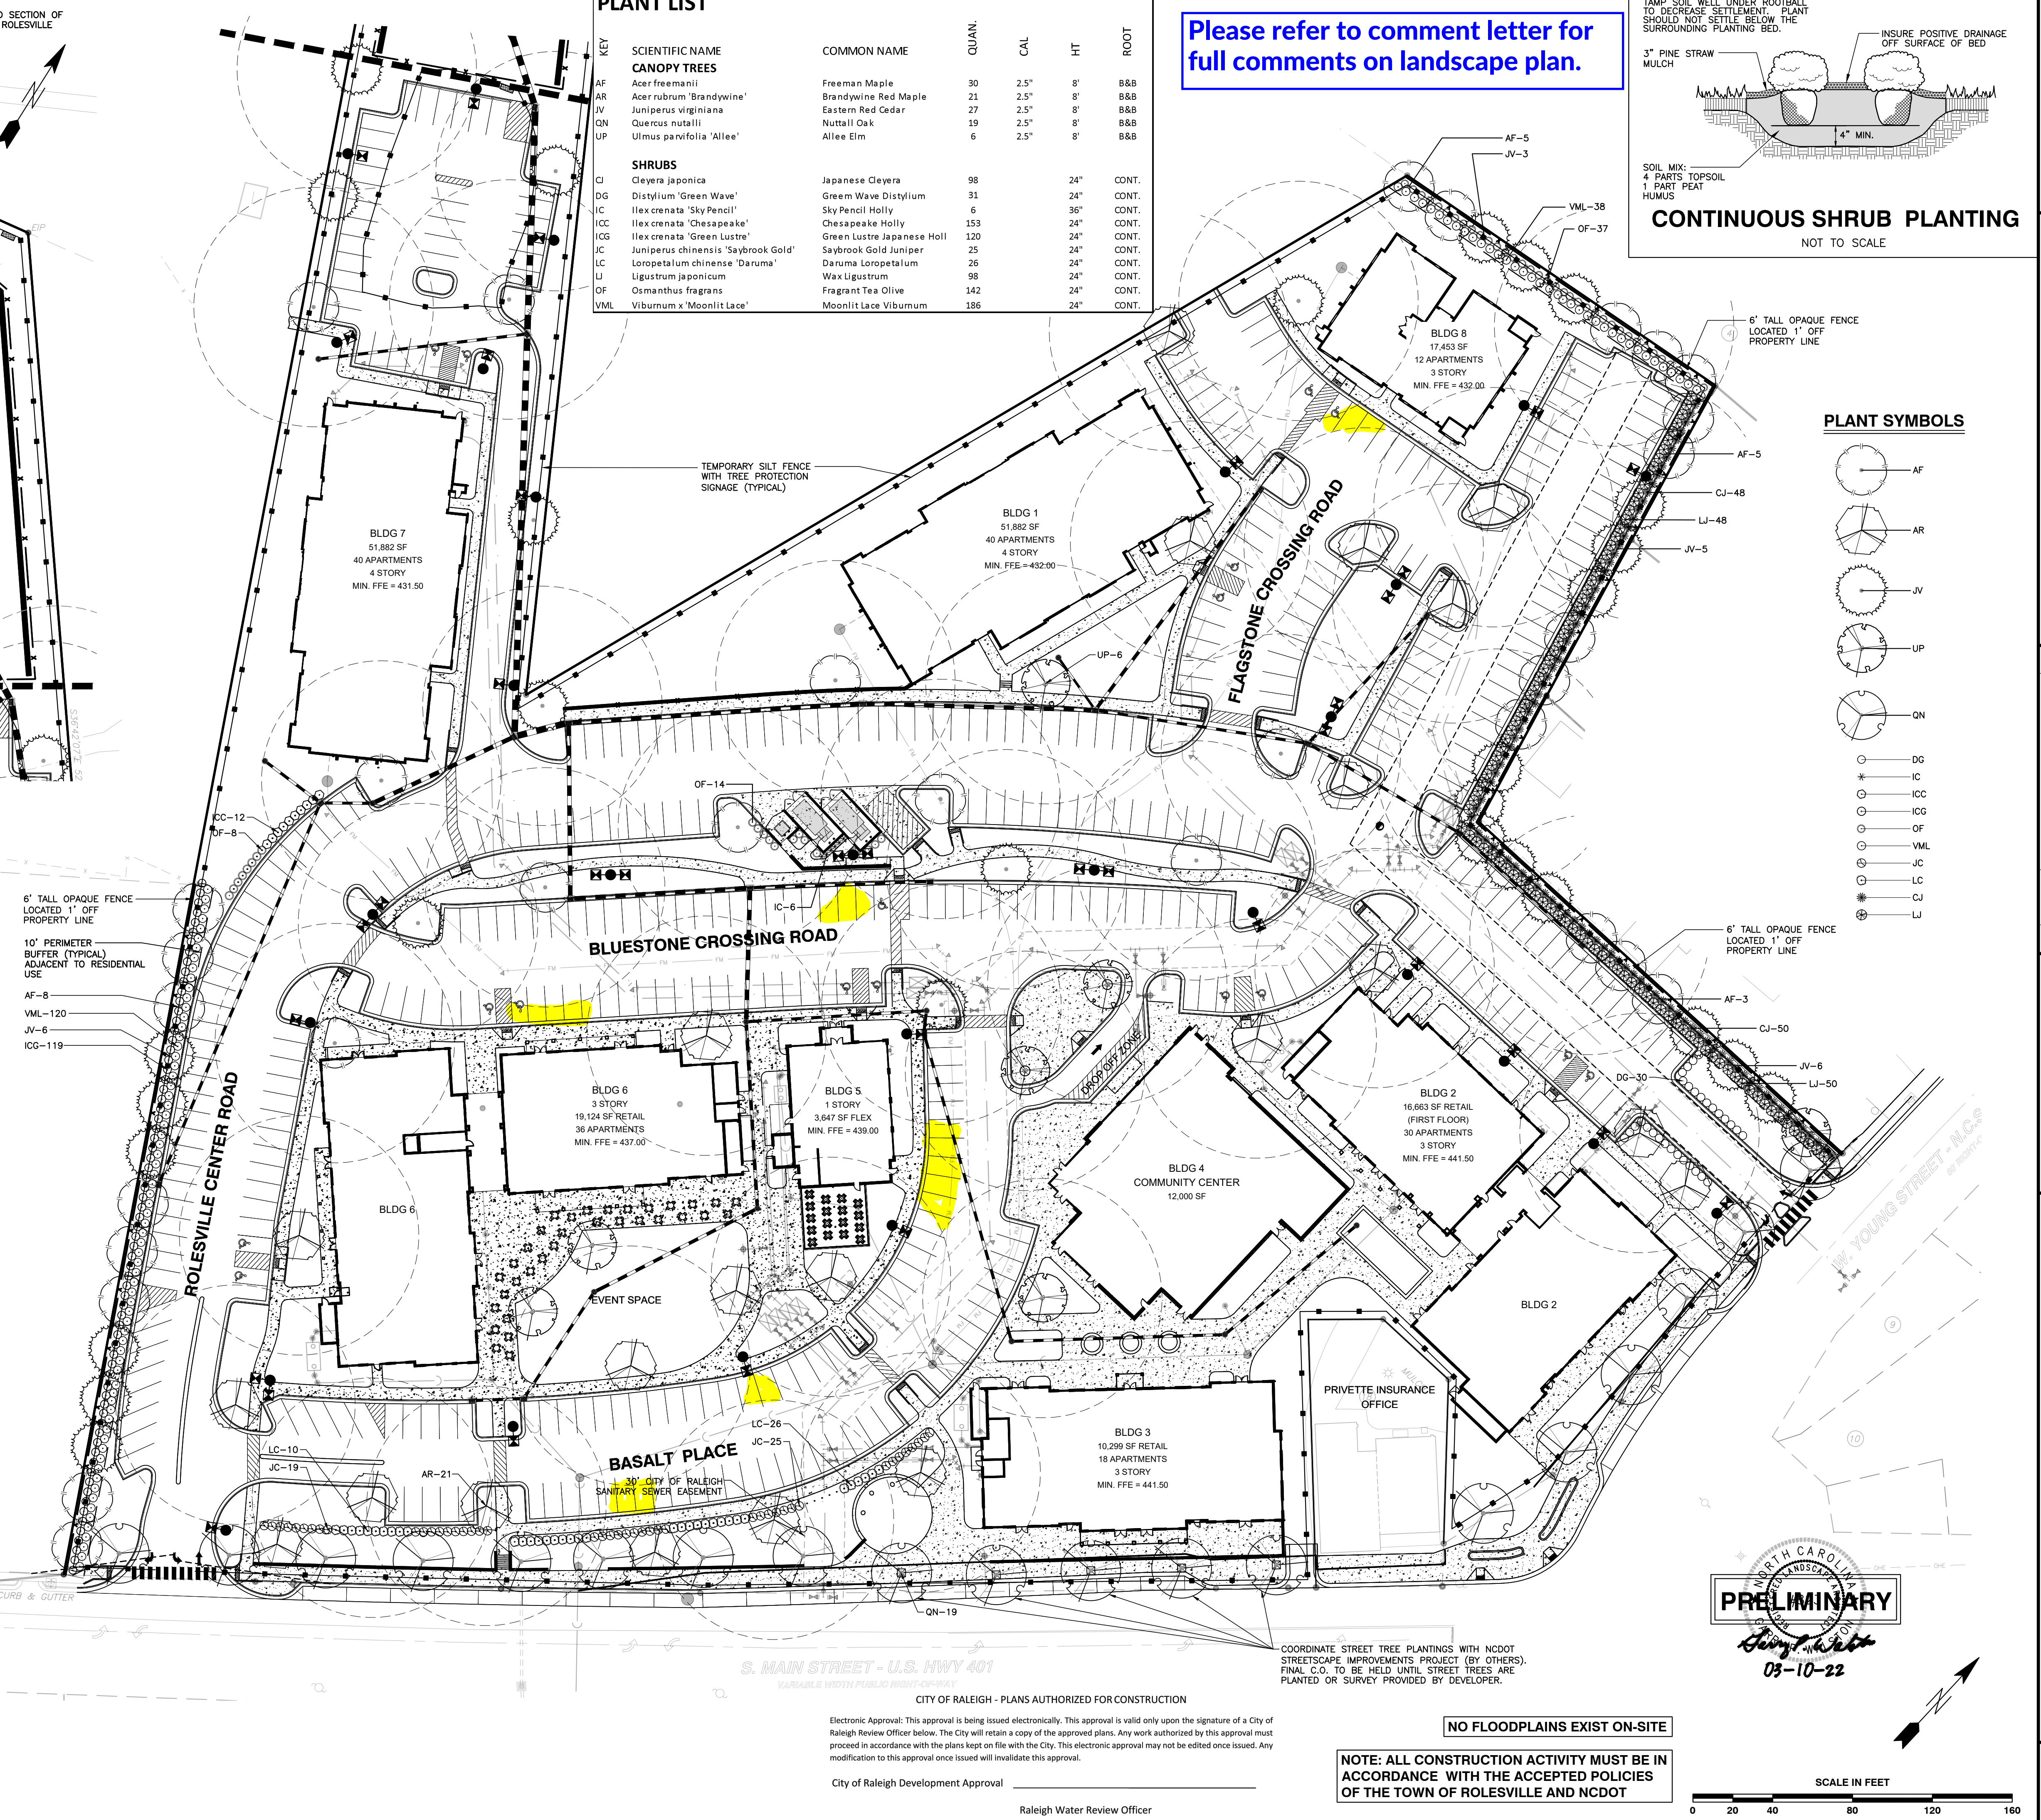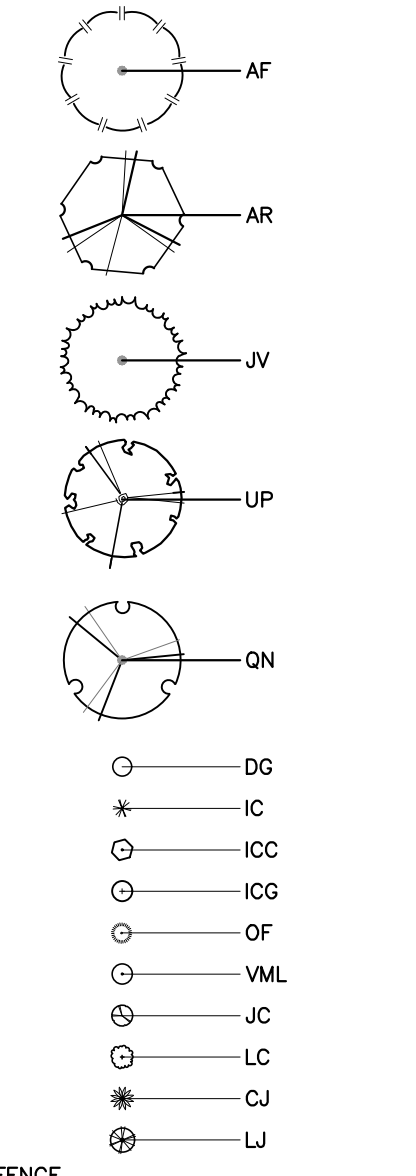


**PRELIMINARY**  
 03-10-22

COORDINATE STREET TREE PLANTINGS WITH NCDOT STREETSCAPE IMPROVEMENTS PROJECT (BY OTHERS). FINAL C.O. TO BE HELD UNTIL STREET TREES ARE PLANTED OR SURVEY PROVIDED BY DEVELOPER.

NO FLOODPLAINS EXIST ON-SITE

NOTE: ALL CONSTRUCTION ACTIVITY MUST BE IN ACCORDANCE WITH THE ACCEPTED POLICIES OF THE TOWN OF ROLESVILLE AND NCDOT

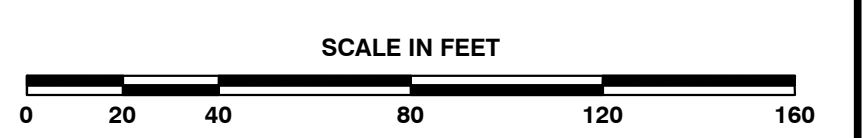

**BASS, NIXON & KENNEDY, INC.**  
 CONSULTING ENGINEERS  
 6310 CHAPEL HILL ROAD, SUITE 250, RALEIGH, NC 27607  
 TELEPHONE: (919) 881-1122 FAX: (919) 881-6666  
 CERTIFICATION NUMBERS: NCBELS (C-010); NCBOLA (C-0267)

| NO. | DATE | DESCRIPTION | BY |
|-----|------|-------------|----|
|     |      |             |    |

**COBBLESTONE VILLAGE**  
 MIXED USE DEVELOPMENT  
 TOWN OF ROLESVILLE, WAKE COUNTY, NORTH CAROLINA

LANDSCAPE PLAN  
 SCALE: 1" = 40'  
 CHK BY: GPW

R:\2021\19197 - Rolesville Town Center CIVIL\04 Construction\08 - 19197\_Landscape.dwg, Landscape Plan, 3/10/2022 5:00:31 PM, marc.mueller

NOT RELEASED FOR CONSTRUCTION OR BID SOLICITATION

Outdoor Lighting  
Shoobox LED



The energy-efficient Shoobox LED combines a decorative, contemporary style with versatility and ample lighting effect that is perfect for streets, parking lots, commercial buildings and residential communities. The Shoobox LED provides excellent color rendition along with a controlled light pattern that reduces glare and keeps the light directed only where you want it. Available in black, dark bronze, gray or white with one to four fixtures per pole.

- LED (Light Emitting Diode) 150, 220, 420, 530 watts
- Mounting heights 25', 30', 35'
- Colors Black, Bronze, Gray, White
- Poles Fiberglass (1 or 2 fixtures per pole), Decorative tapered metal, Decorative square metal

Note: 35' pole available in black or bronze only.

For additional information, visit us at [duke-energy.com/OutdoorLighting](http://duke-energy.com/OutdoorLighting) or call us toll free at 866.769.6417.




Outdoor Lighting  
Shoobox LED

Light source: LED (white)  
Replacement for\* LED Wattage 150 – 250-watt HPS and metal halide;  
LED Wattage 205 – up to 400-watt metal halide;  
LED Wattage 530 – 1,000-watt metal halide

Warm-up and restrike time: Instant on (no warm-up or restrike time)

| Wattage        | BUG Rating      | Light Pattern                        | Lumens       | Color Temp |
|----------------|-----------------|--------------------------------------|--------------|------------|
| LED 150        | B5-U0-G3        | IESNA Type V (circular)              | 19580        | 4,000K     |
| <b>LED 150</b> | <b>B3-U0-G4</b> | <b>IESNA Type IV (forward throw)</b> | <b>18459</b> |            |
| LED 150        | B2-U0-G3        | IESNA Type III (oval)                | 19006        |            |
| LED 220        | B5-U0-G3        | IESNA Type V (circular)              | 25870        |            |
| LED 220        | B3-U0-G4        | IESNA Type IV (forward throw)        | 24390        |            |
| LED 220        | B2-U0-G4        | IESNA Type III (oval)                | 25114        |            |
| LED 420        | B5-U0-G5        | IESNA Type V (circular)              | 48514        |            |
| LED 420        | B3-U0-G5        | IESNA Type IV (forward throw)        | 43765        |            |
| LED 530        | B5-U0-G5        | IESNA Type V (circular)              | 60296        |            |
| LED 530        | B3-U0-G5        | IESNA Type IV (forward throw)        | 54395        |            |



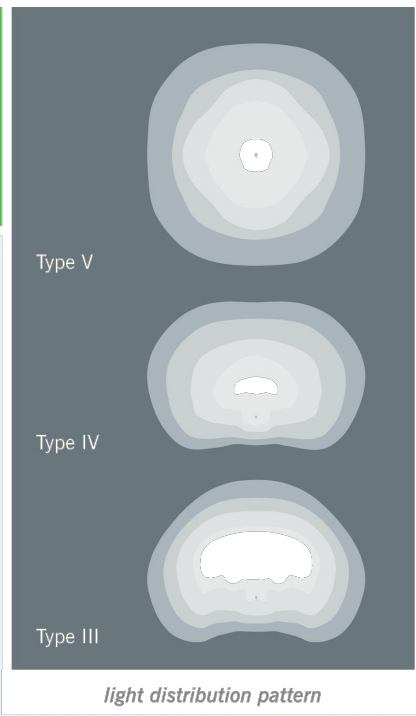


| Name                            | Mounting height | Color   |
|---------------------------------|-----------------|---|
| Round tapered decorative metal* | 35'             | Black, Bronze   |
| Decorative square metal*        | 25' and 30'     | Black, Bronze, Gray, White  |
| Fiberglass                      | 30'             | Black (1 or 2 fixtures per pole), Gray (1 or 2 fixtures per pole) |

| Features   | Benefits   |
|--|--|
| Little or no installation cost                     | Frees up capital for other projects              |
| Design services by lighting professionals included | Meets industry standards and lighting ordinances |
| Maintenance included                               | Eliminates high and unexpected repair bills      |
| Electricity included                               | Less expensive than metered service              |
| Warranty included                                  | Worry-free                                       |
| One low monthly cost on your electric bill         | Convenience and savings for you                  |
| Turnkey operation                                  | Provides hassle-free installation and service    |
| Backed by over 40 years of experience              | A name you can trust today ... and tomorrow      |

\*2" raised foundation available when required on metal poles only.

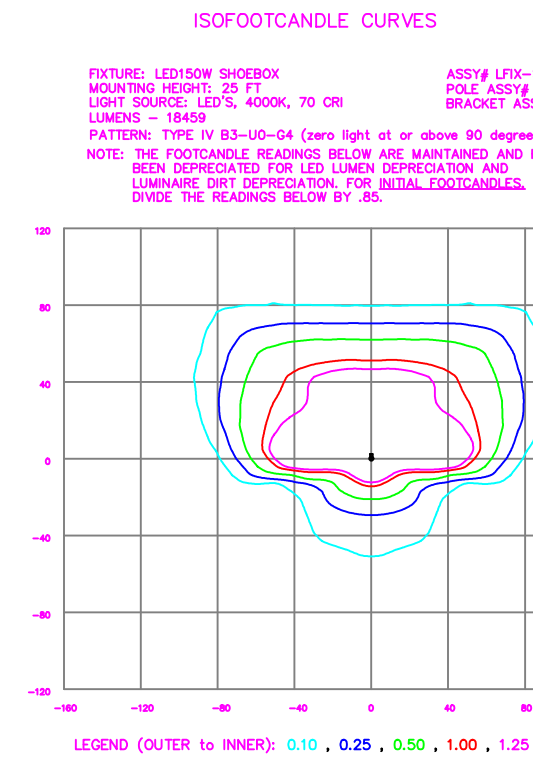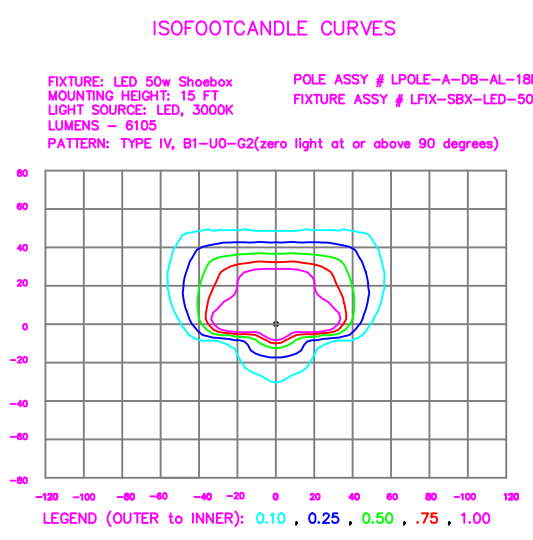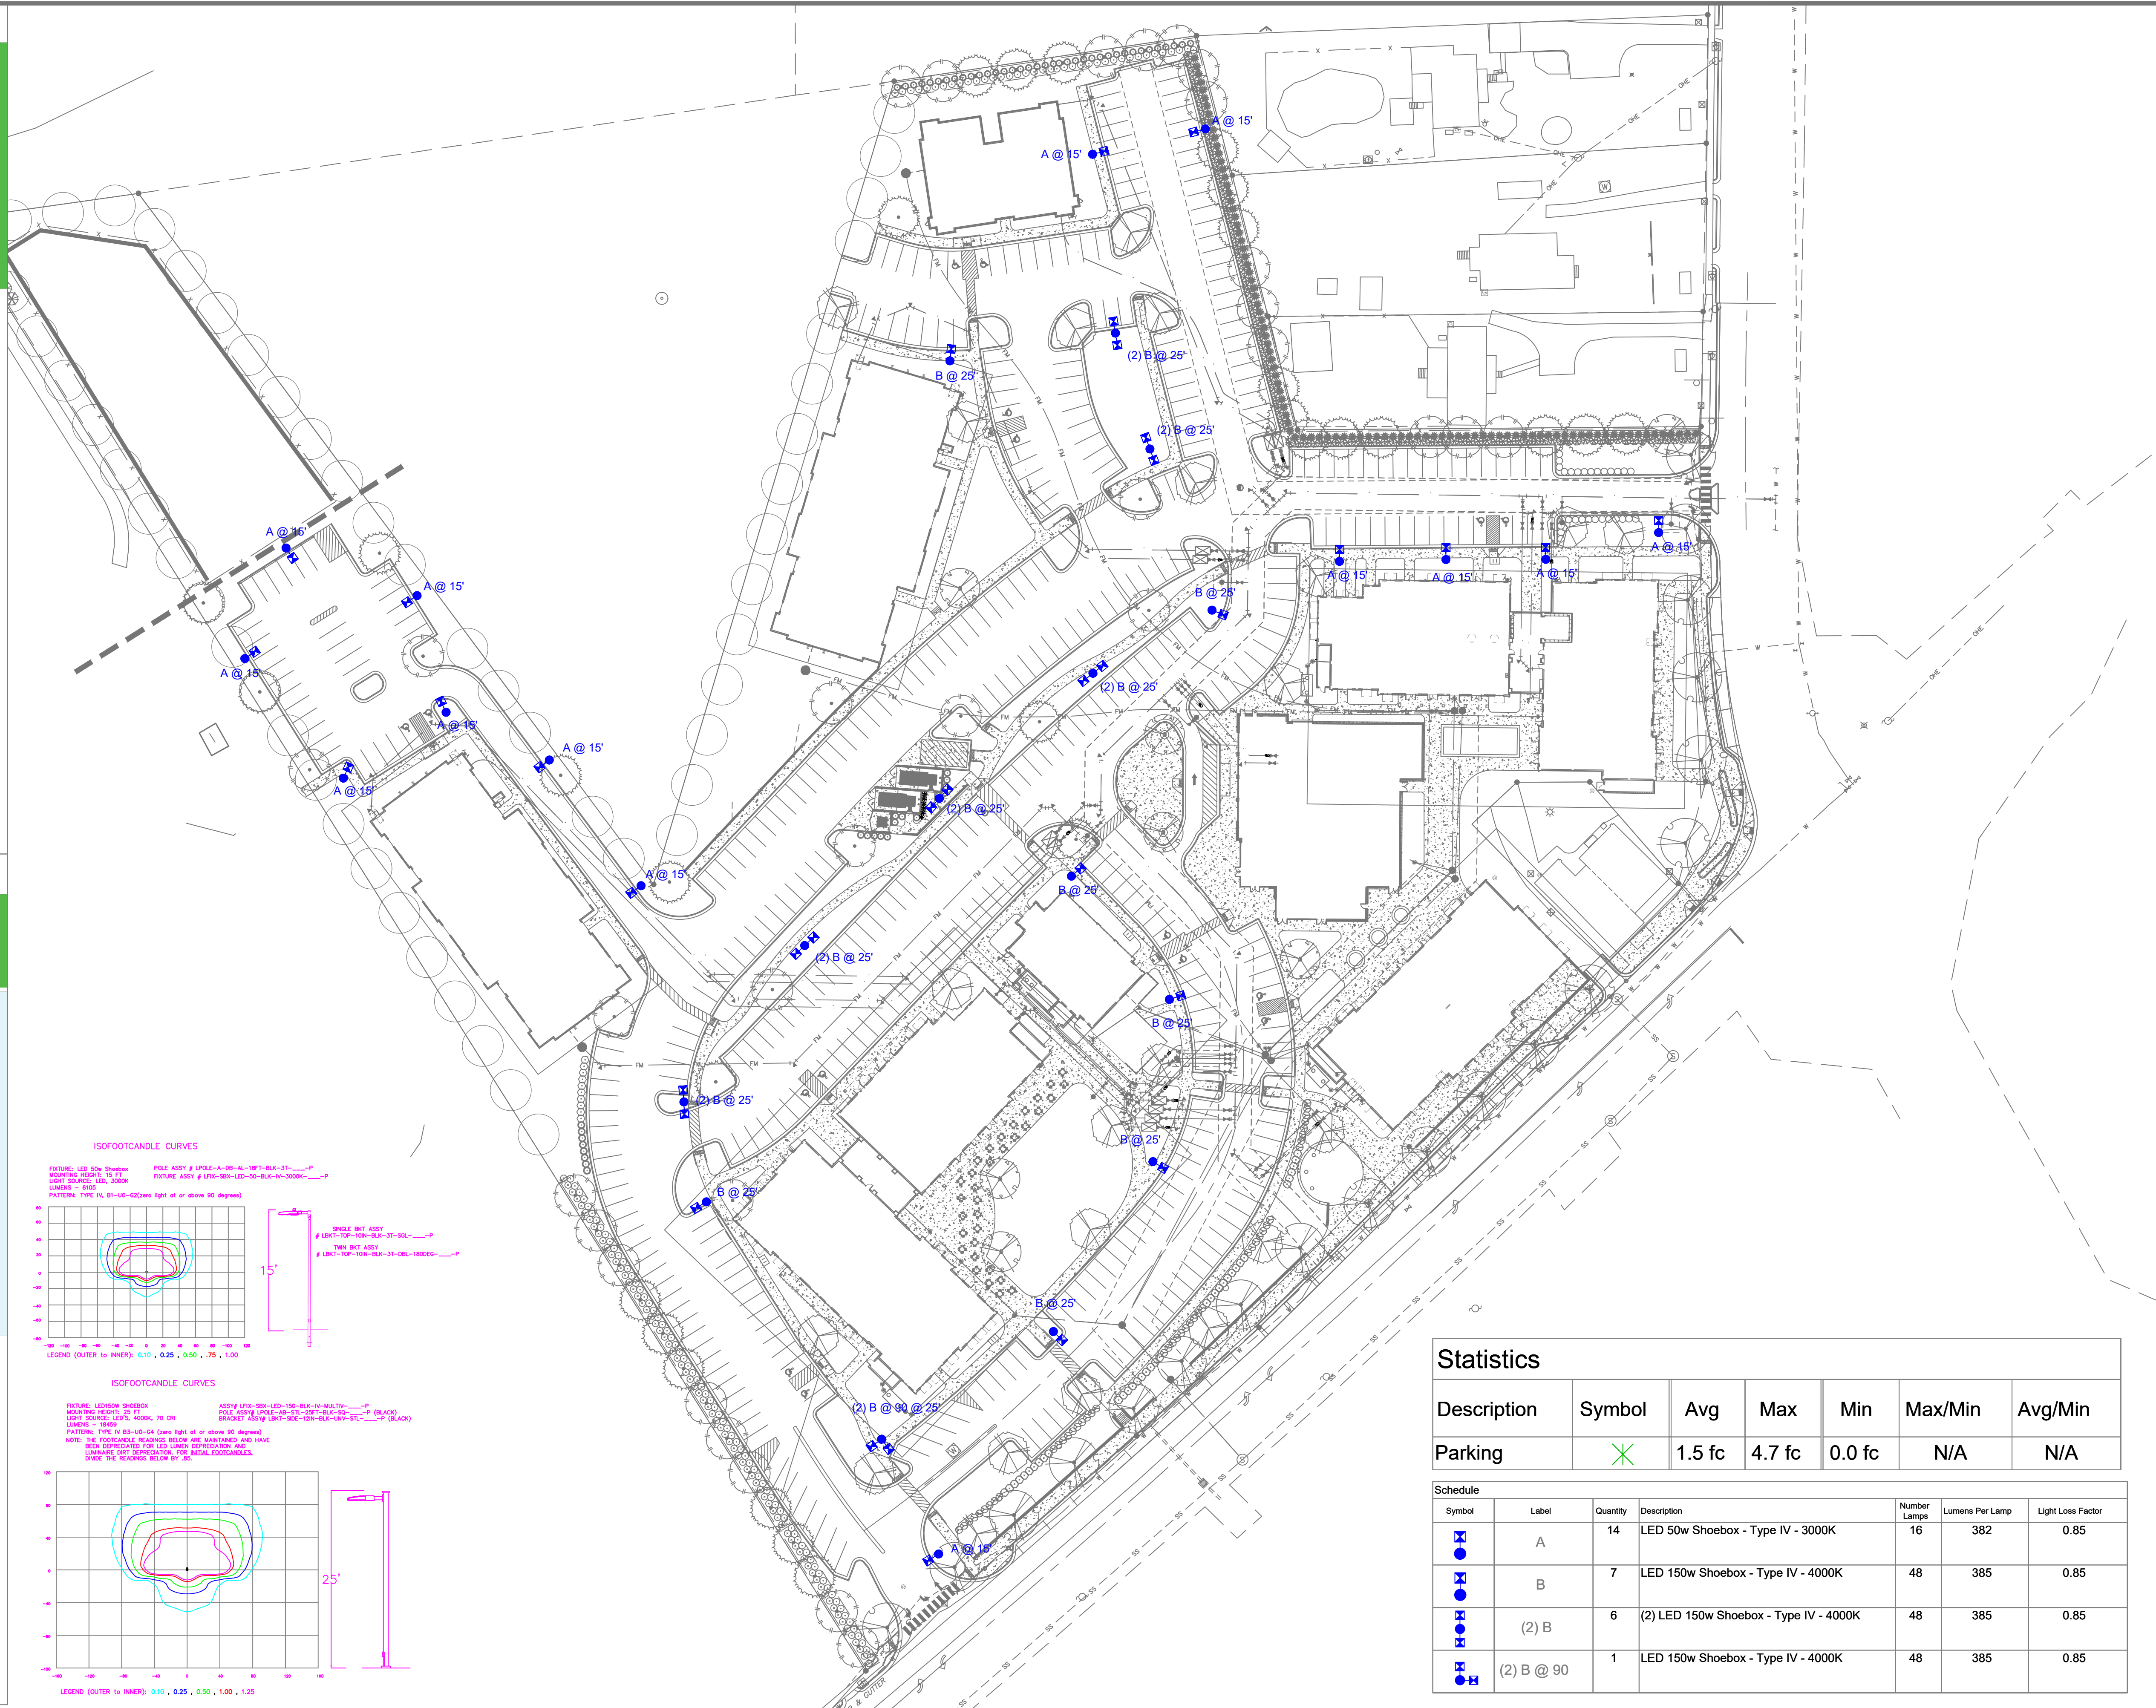

Statistics

| Description | Symbol | Avg    | Max    | Min    | Max/Min | Avg/Min |
|-------------|--------|--------|--------|--------|---------|---------|
| Parking     | X      | 1.5 fc | 4.7 fc | 0.0 fc | N/A     | N/A     |

| Symbol     | Label      | Quantity | Description                            | Number Lamps | Lumens Per Lamp | Light Loss Factor |
|------------|------------|----------|--|--------------|-----------------|-------------------|
| A          | A          | 14       | LED 50w Shoobox - Type IV - 3000K      | 16           | 382             | 0.85              |
| B          | B          | 7        | LED 150w Shoobox - Type IV - 4000K     | 48           | 385             | 0.85              |
| (2) B      | (2) B      | 6        | (2) LED 150w Shoobox - Type IV - 4000K | 48           | 385             | 0.85              |
| (2) B @ 90 | (2) B @ 90 | 1        | LED 150w Shoobox - Type IV - 4000K     | 48           | 385             | 0.85              |

Customer approval \_\_\_\_\_  
Date \_\_\_\_\_

DISTANCE CALIBRATION (INCHES)  
0 0.5 1.0 2.0 3.0 4.0

**LIGHTING DESIGN TOLERANCE**  
The calculated footcandle light levels on this lighting design are predicted values and are based on specific information that has been supplied to Duke Energy. Any inaccuracies in the supplied information, differences in luminaire installation, lighted area geometry including elevation differences, reflective properties of surrounding surfaces, obstructions (follage or otherwise) in the lighted area, or lighting from sources other than listed in this design may produce different results from the predicted values. Normal tolerances of voltage, lamp output, and ballast and luminaire manufacture will also affect results.











**PROPRIETARY & CONFIDENTIAL**  
This document together with the concepts and designs presented herein, presented as an instrument of service, is the sole property of Duke Energy, and is intended only for the specific purpose and prospective client as stated in the title block of this drawing. Any use, copying, reproduction or disclosure of the drawing, design or any information contained herein by the prospective customer or other entities, including without limitation, architects, engineers, or equipment manufacturers is hereby expressly prohibited and shall not be permitted absent prior written consent from, and payment of compensation to Duke Energy. Duke Energy disclaims any liability or responsibility for any unauthorized use of or reliance on this document.

**COBBLESTONE VILLAGE**  
Rosesville, NC  
SITE LIGHTING PLAN  
Designed by DEP LIGHTING SOLUTIONS  
Reviewed by T. Ferguson Scale 1" = 50'  
Date 02/14/2022 Size "Arch D"  
Description LED Shoobox  
Drawing No. 22-0047A Sht. 1 OF 1

| REV#  | DATE     | REVISION    | BY |
|-------|----------|-------------|----|
| Rev A | 02/14/22 | LED Shoobox | NJ |





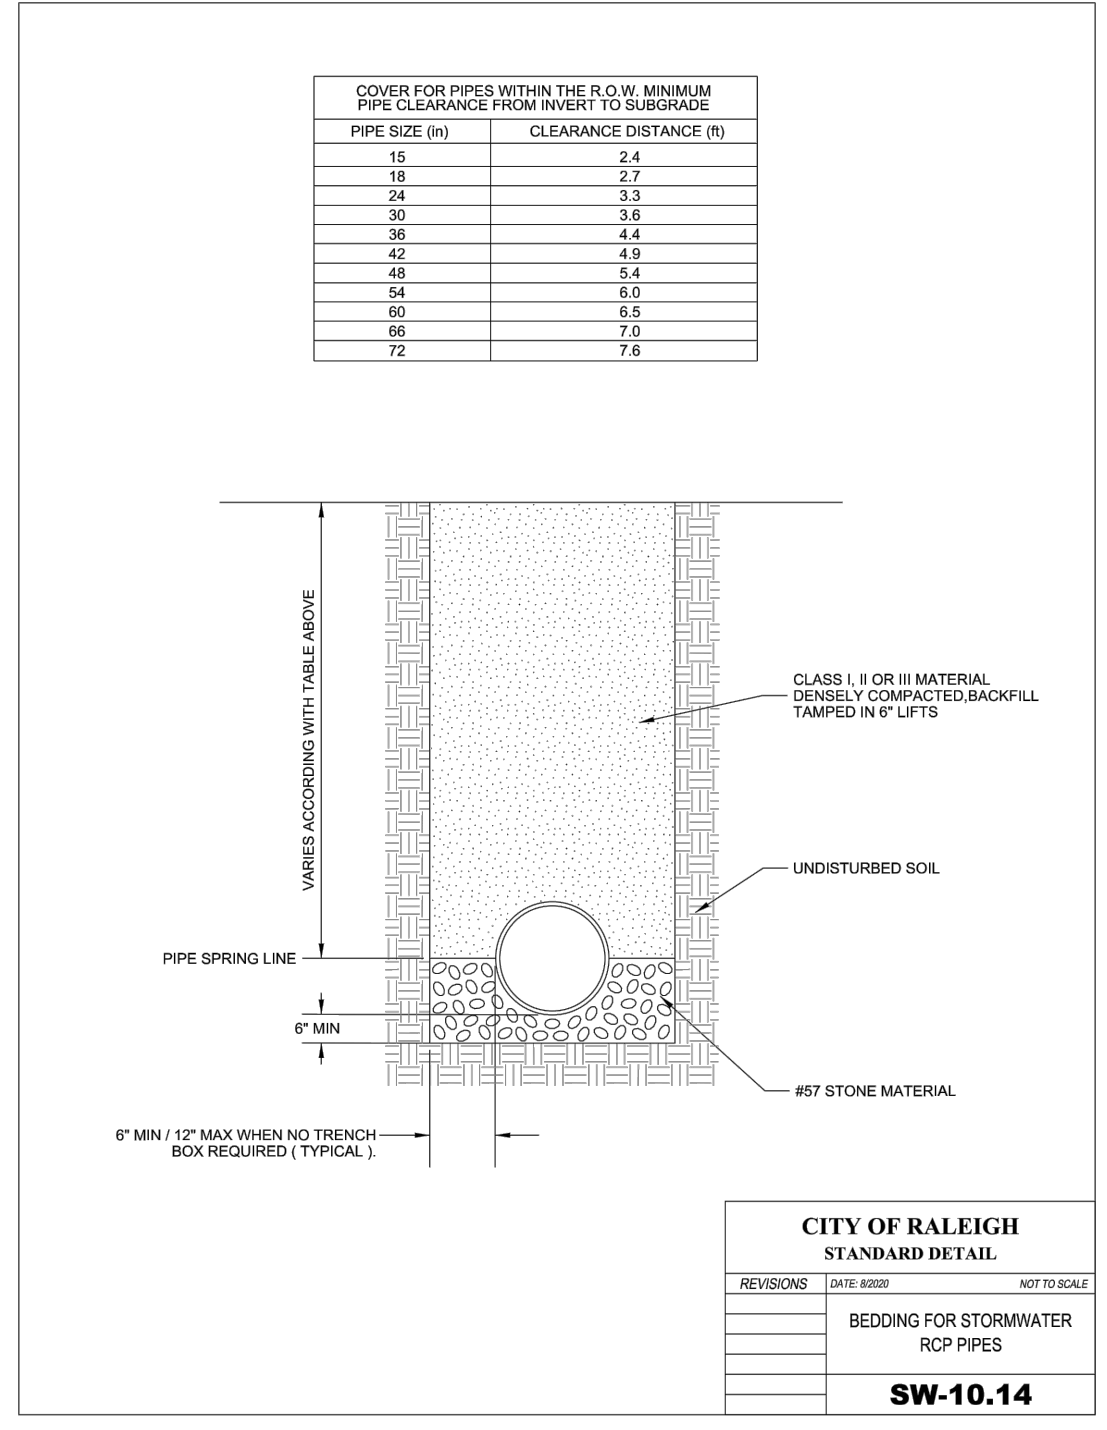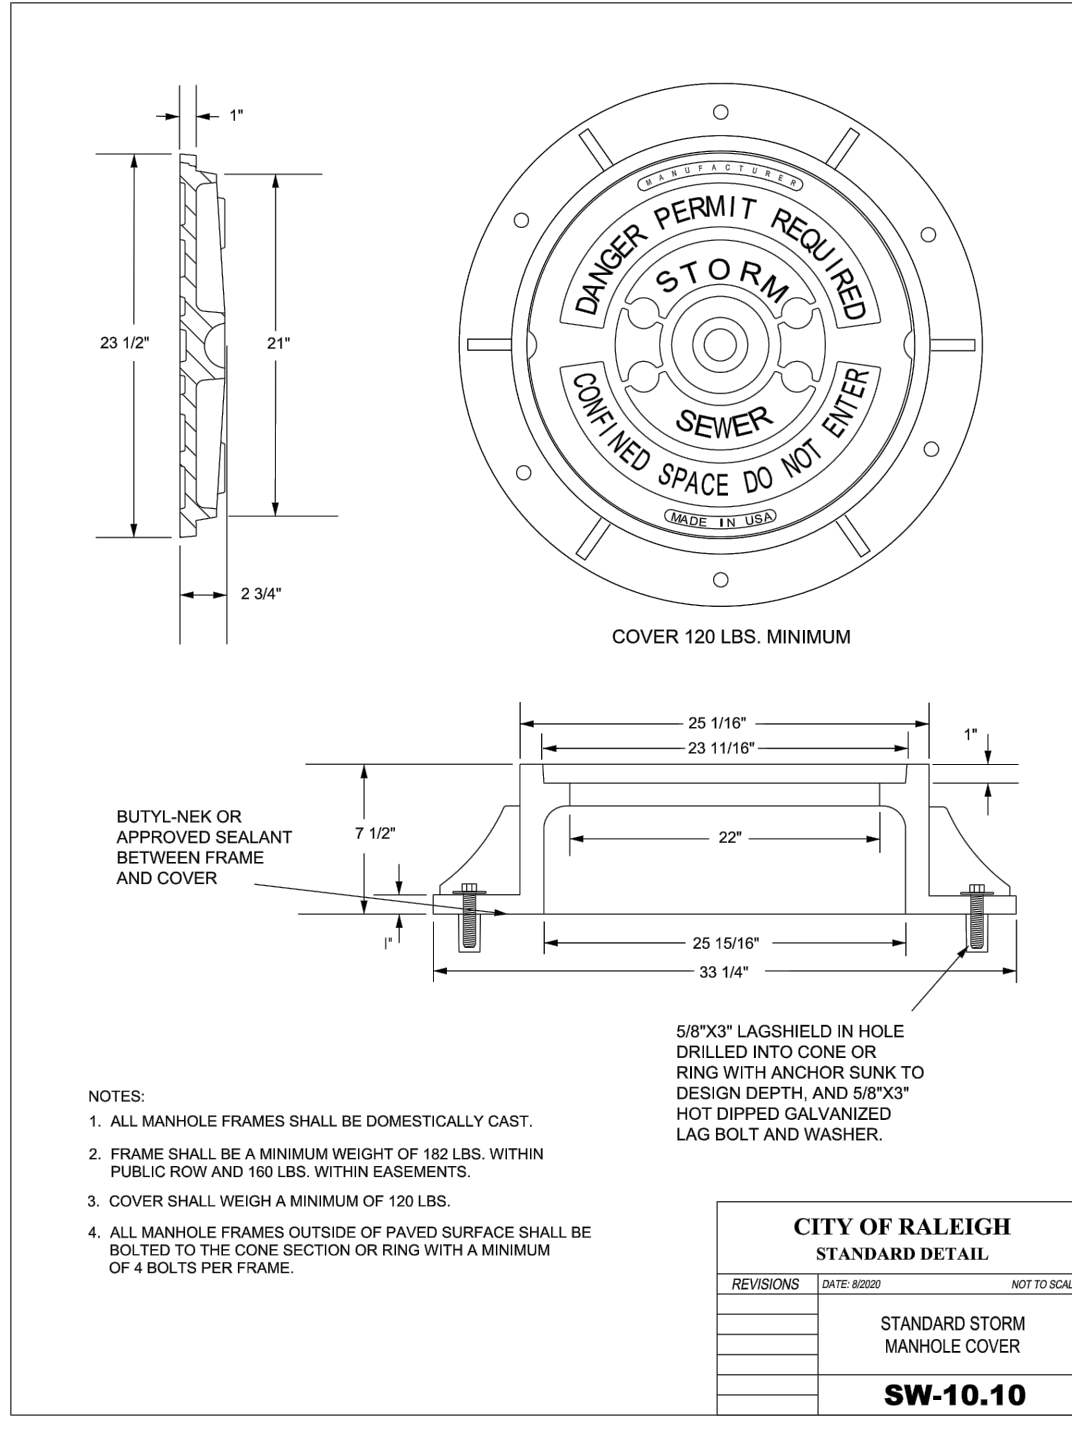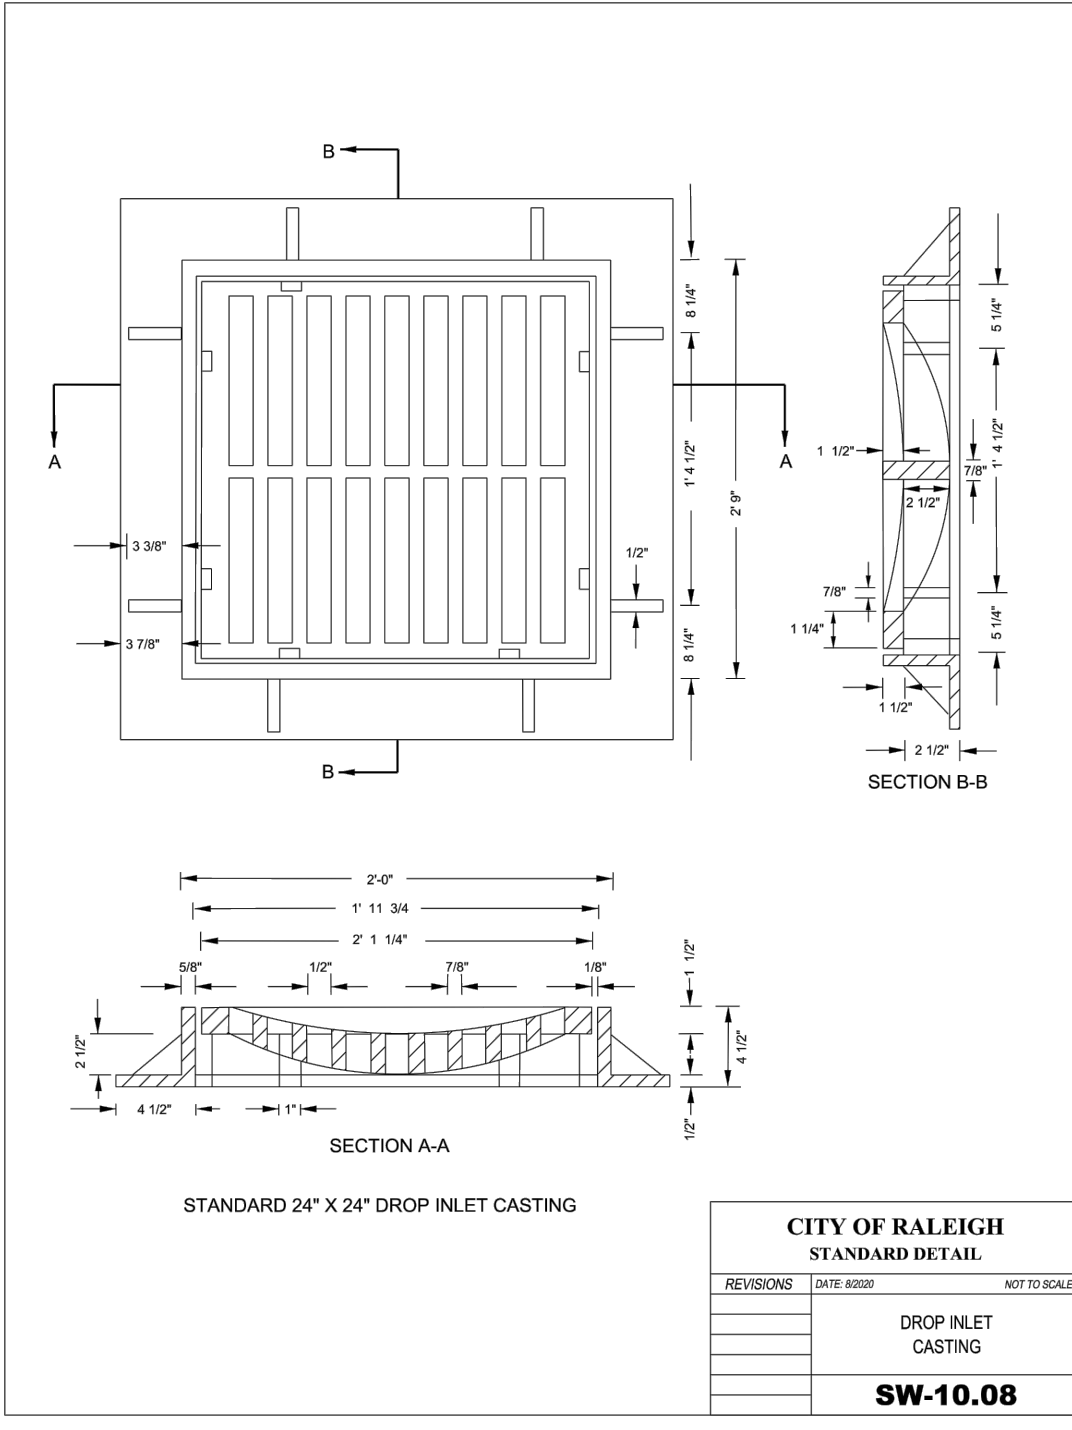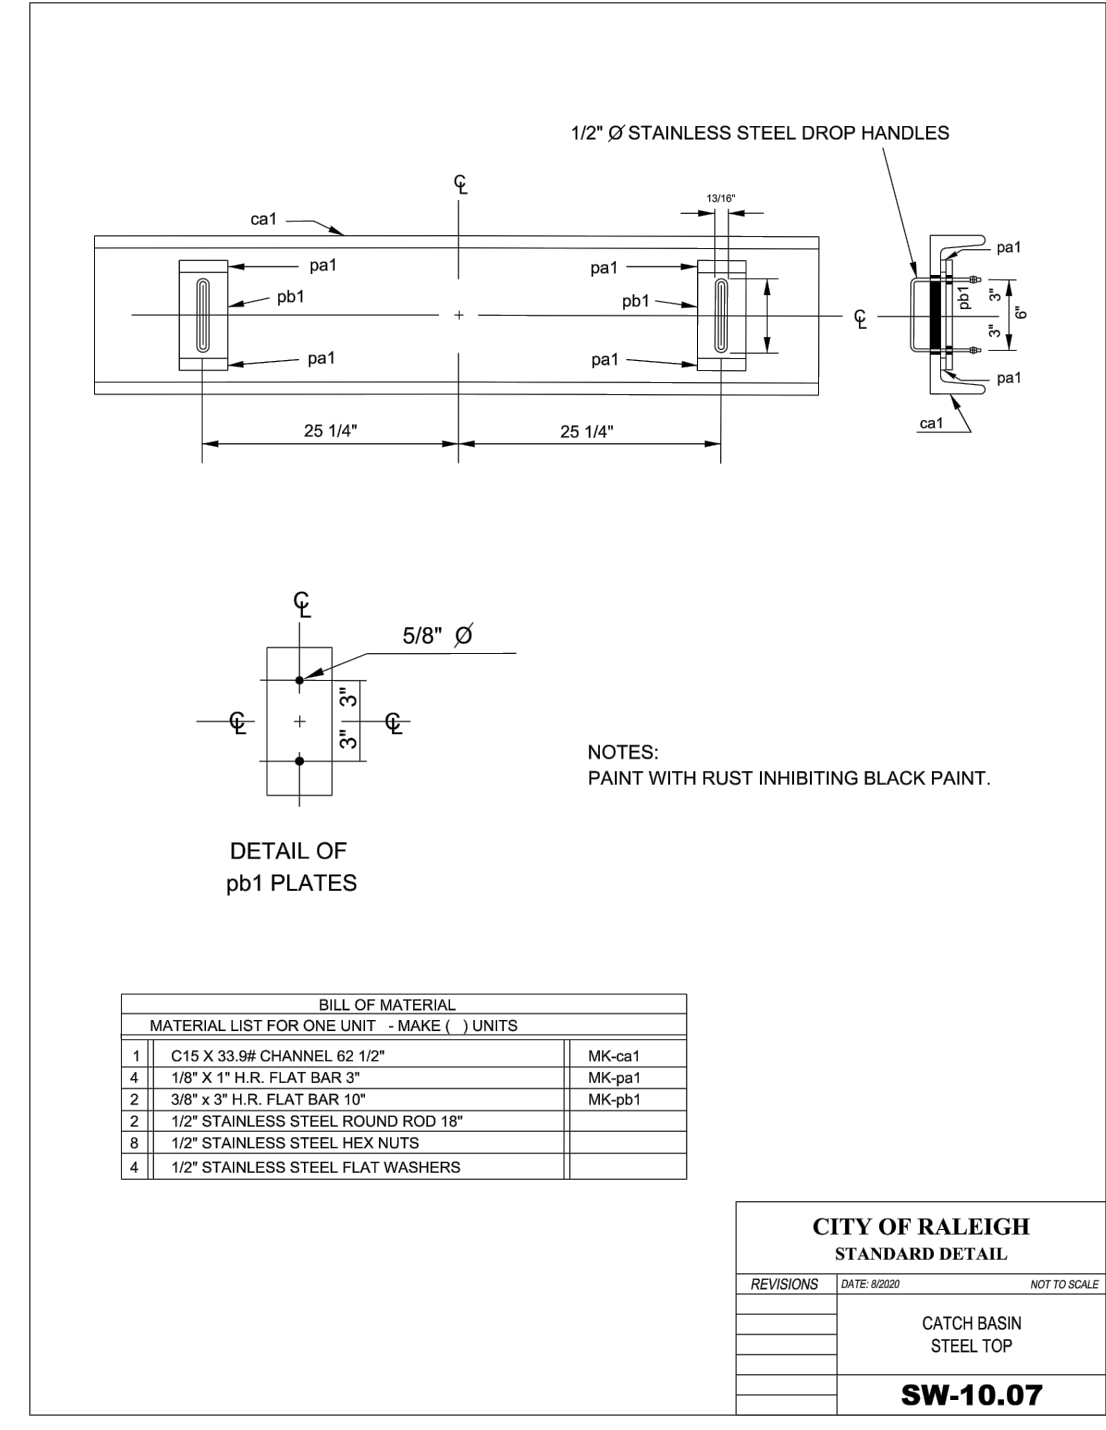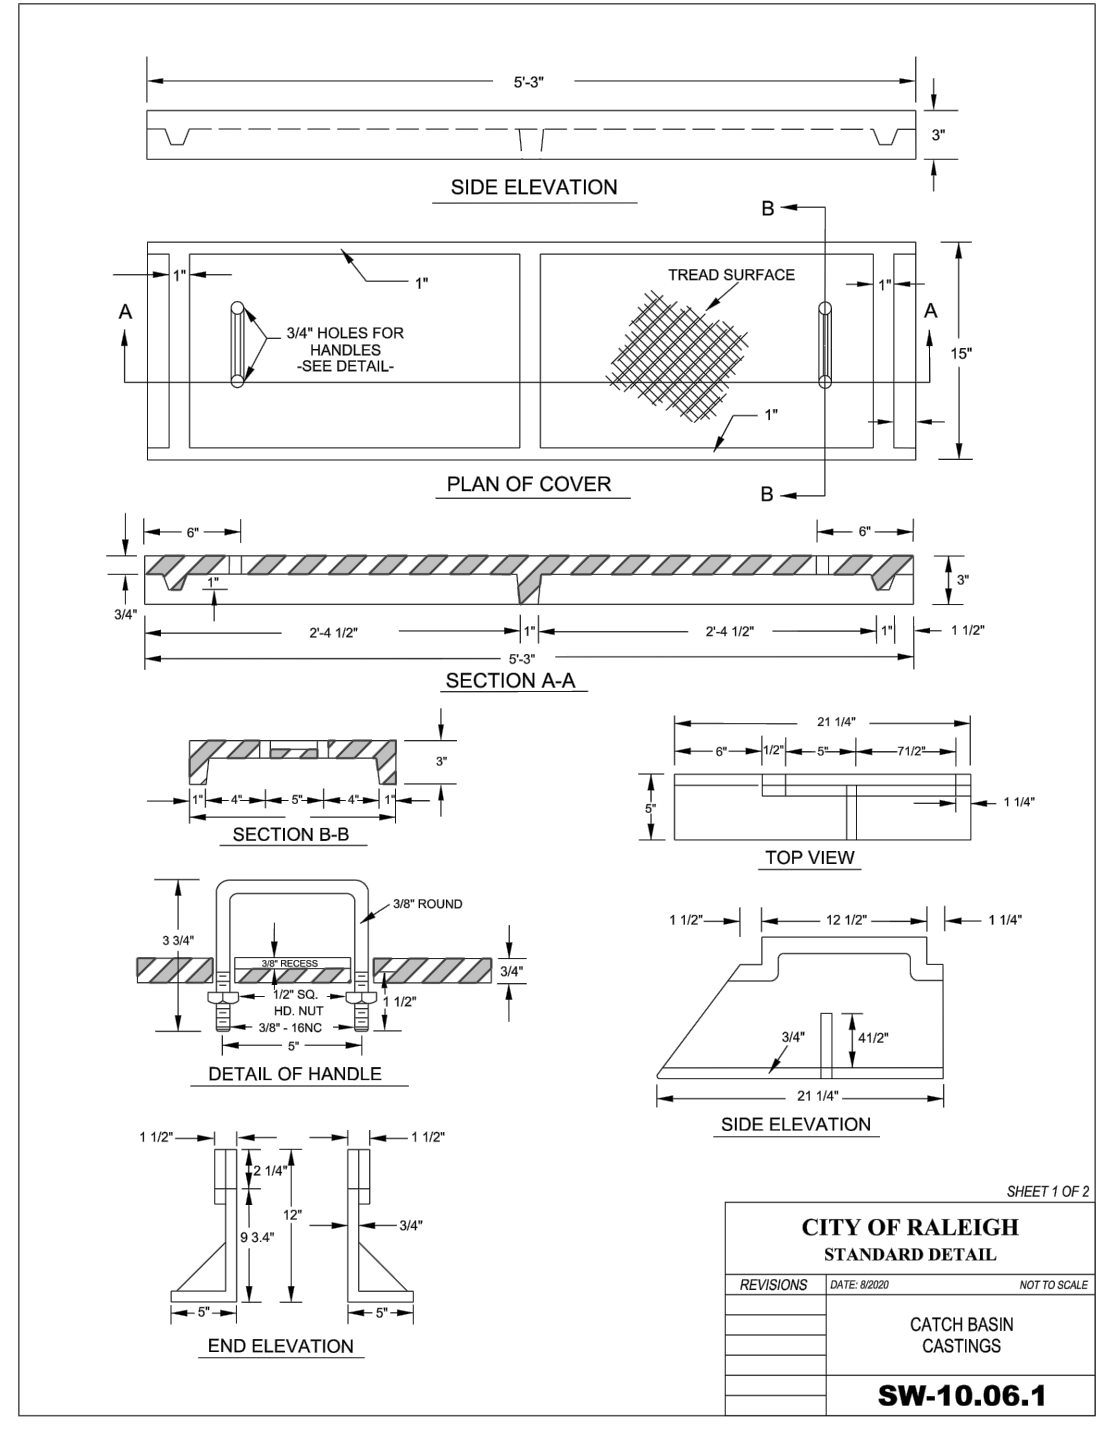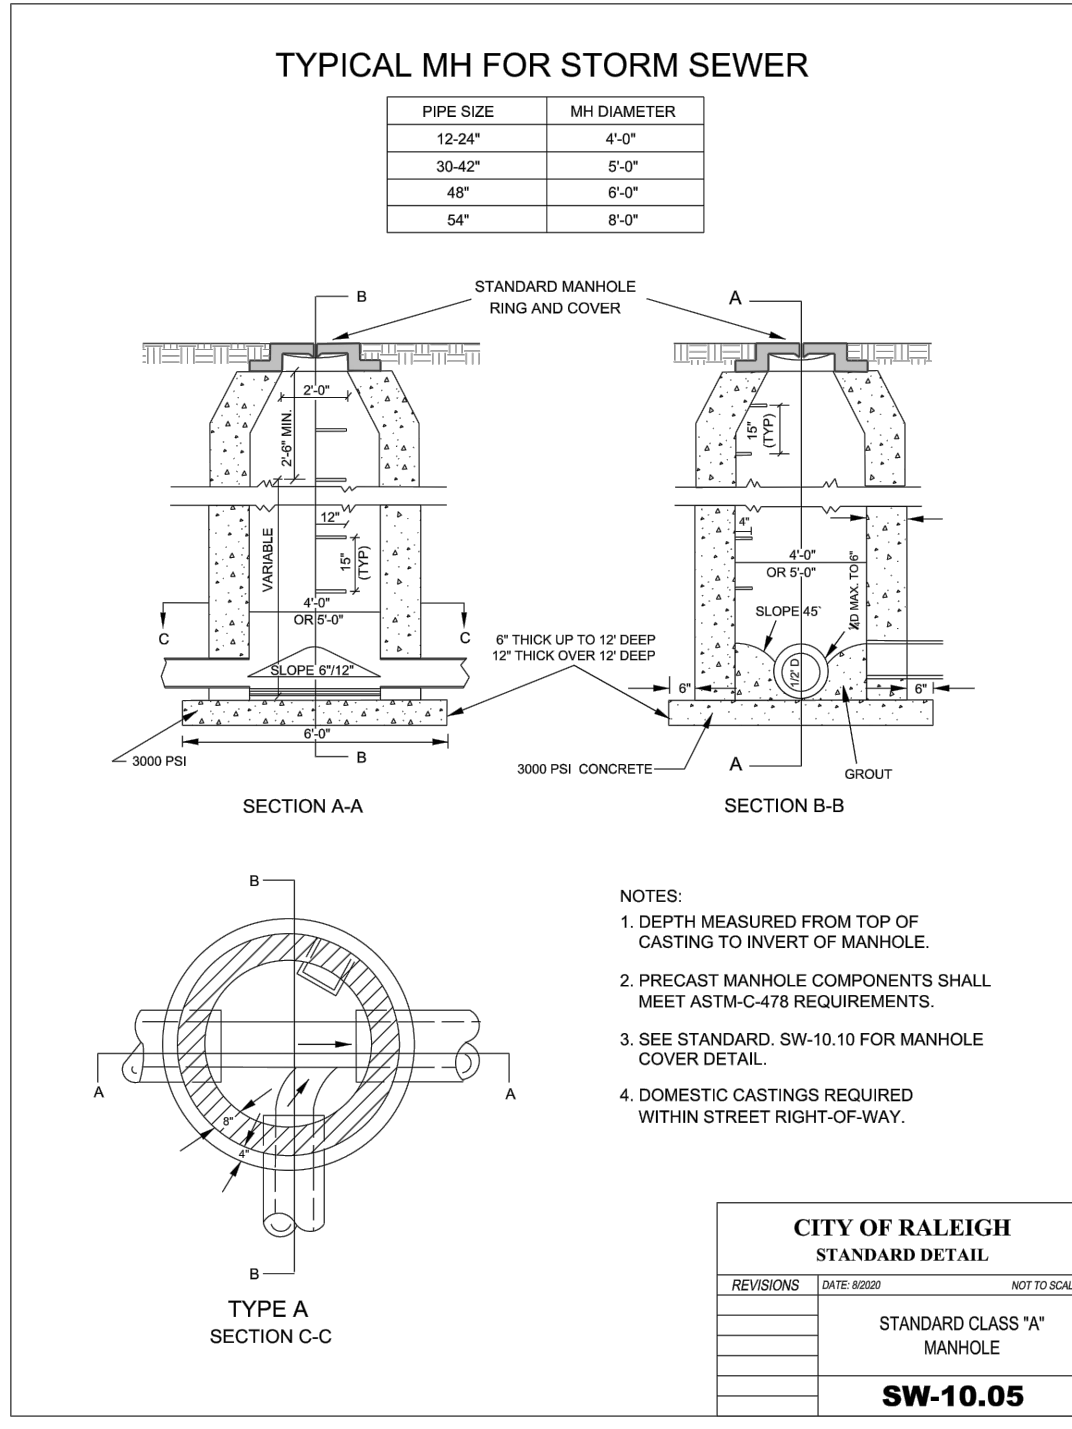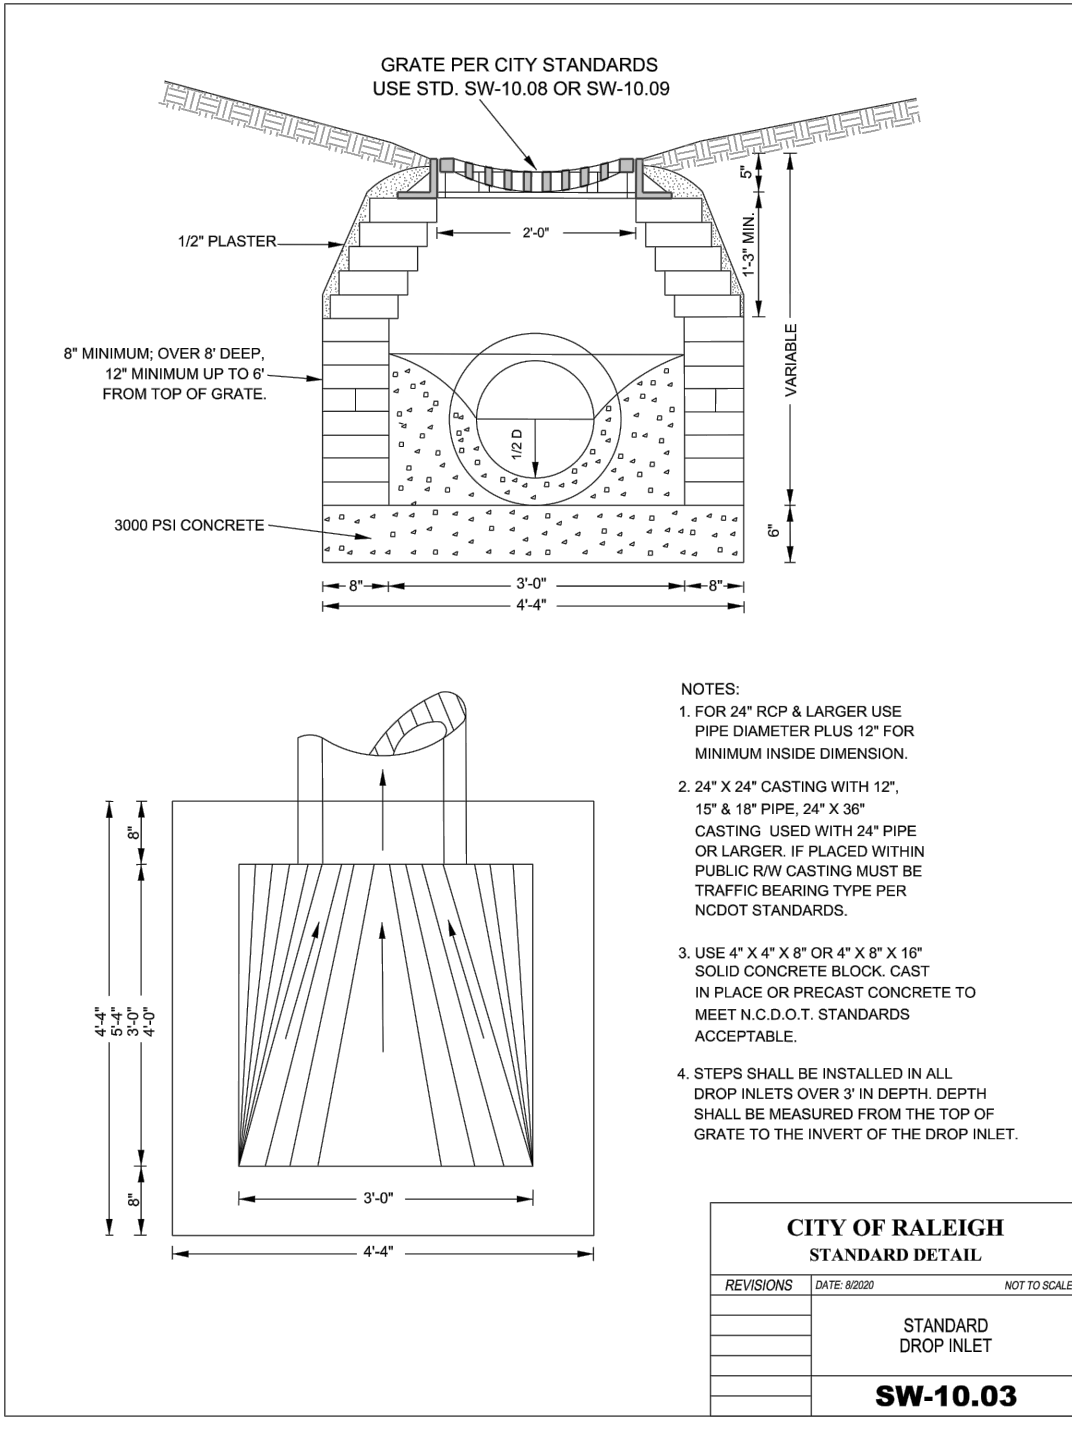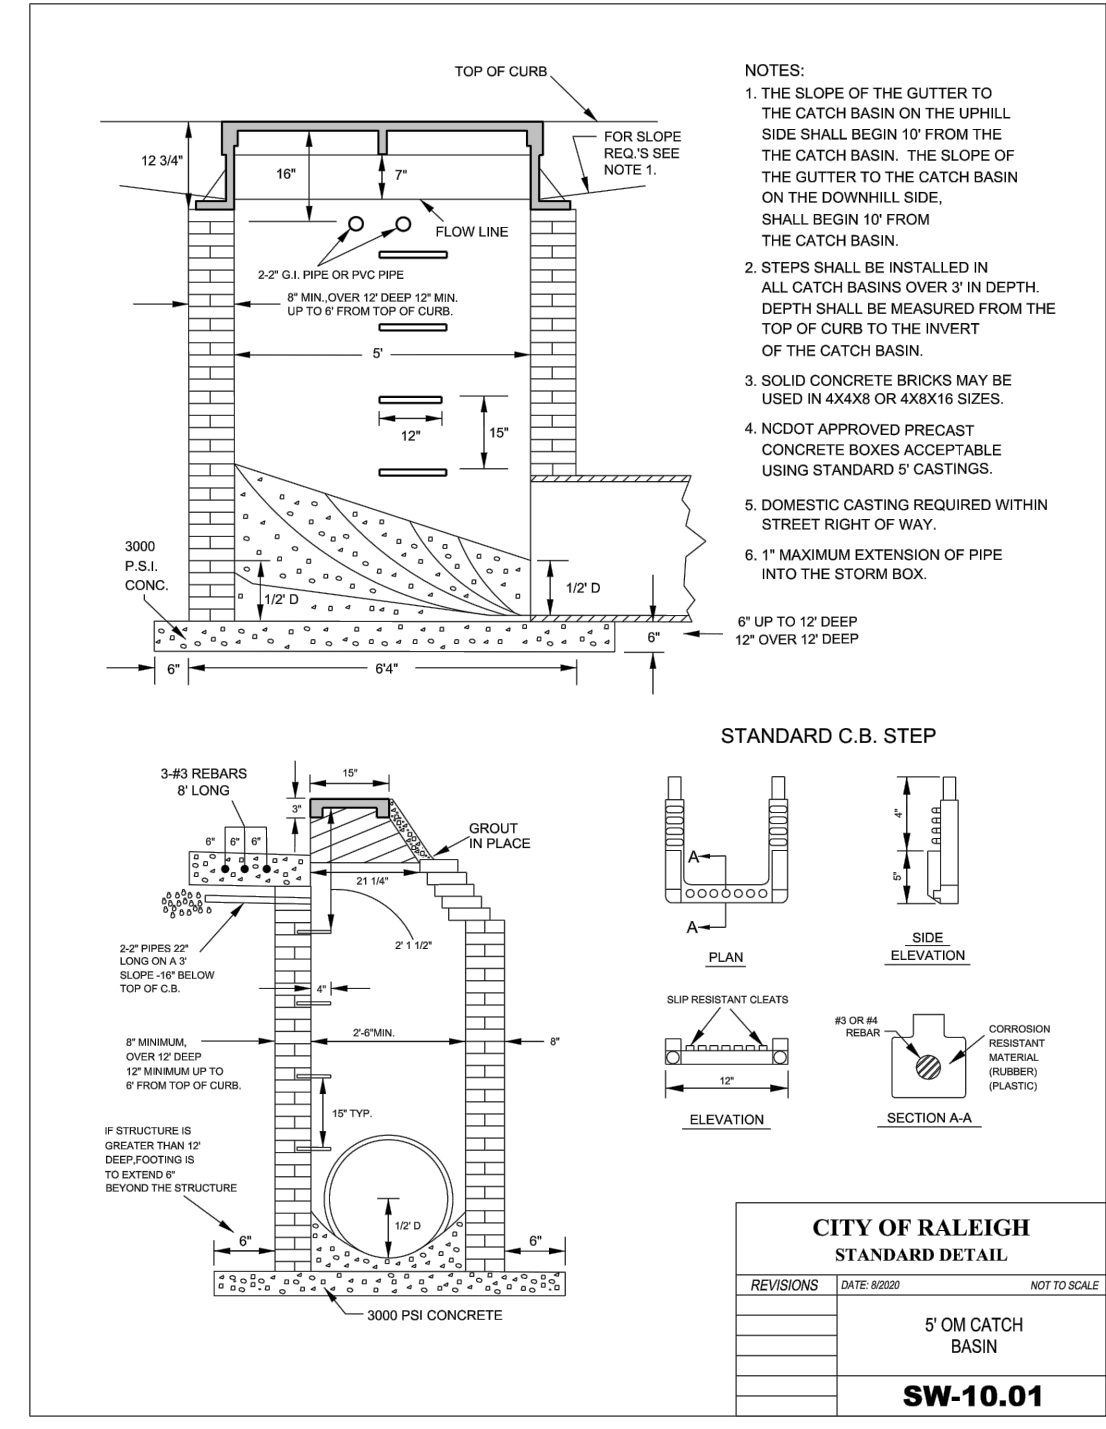

**BASS, NIXON & KENNEDY, INC.**  
**CONSULTING ENGINEERS**  
 6310 CHAPEL HILL ROAD, SUITE 250, RALEIGH, NC 27607  
 TELEPHONE: (919)811-1232 FAX: (919)811-8988  
 CERTIFICATION NUMBERS: NCBELS (C-0110); NCBOLA (C-0267)

**COBBLESTONE VILLAGE MIXED USE DEVELOPMENT**  
 TOWN OF ROLESVILLE, WAKE COUNTY, NORTH CAROLINA

**PROGRESS** MRM  
**DATE** DRAWN BY  
**JOB NO.**

**DETAILS**

**NO.** **DATE** **DESCRIPTION** **BY**

**SCALE:** N.T.S. **CHK BY:** MDB


**SHEET C5.2**

CITY OF RALEIGH - PLANS AUTHORIZED FOR CONSTRUCTION


Electronic Approval: This approval is being issued electronically. This approval is valid only upon the signature of a City of Raleigh Review Officer below. The City will retain a copy of the approved plans. Any work authorized by this approval must proceed in accordance with the plans kept on file with the City. This electronic approval may not be edited once issued. Any modification to this approval once issued will invalidate this approval.

City of Raleigh Development Approval \_\_\_\_\_

Raleigh Water Review Officer

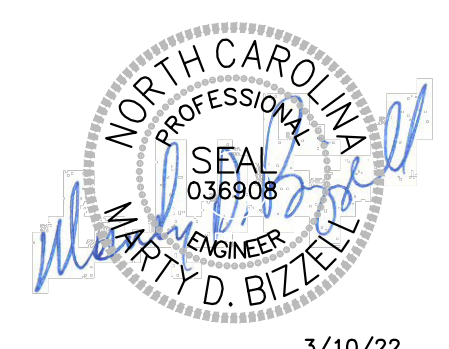


3/10/22

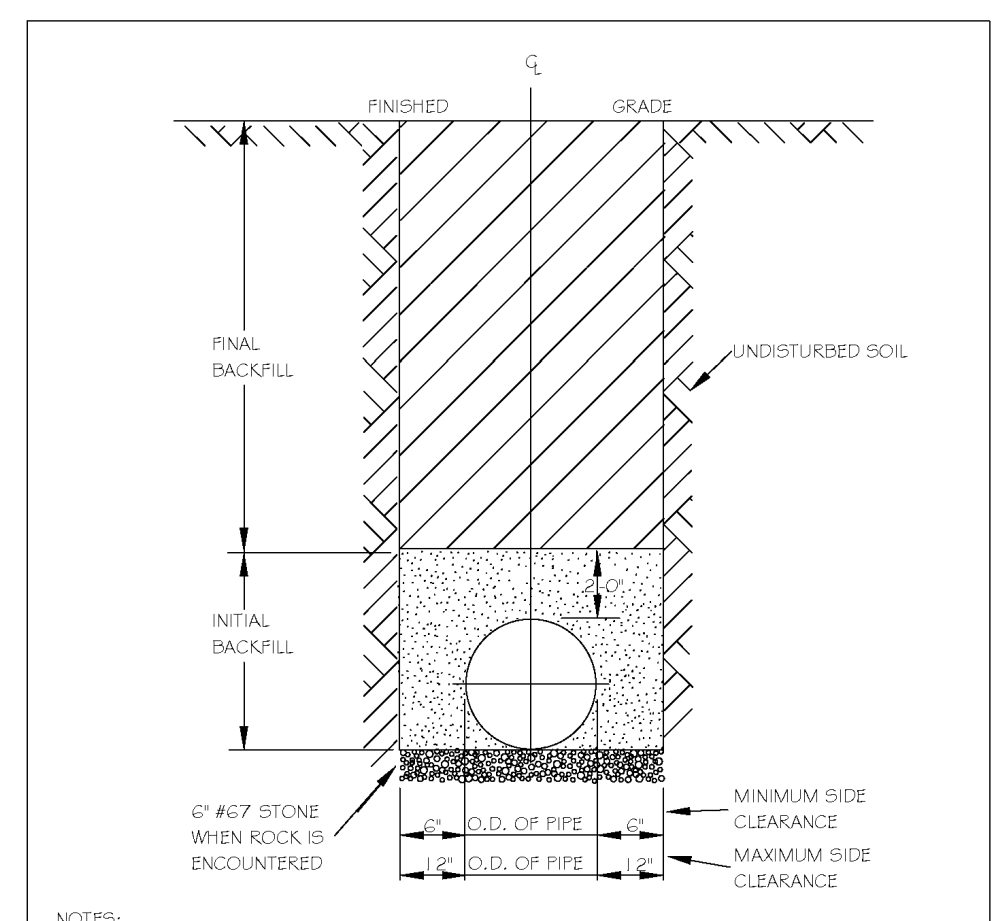


NOTES:  
 1. TRENCHES REQUIRING SHORING AND BRACING, DIMENSIONS SHALL BE TAKEN FROM THE INSIDE FACE OF THE SHORING AND BRACING.  
 2. NO ROCKS OR BOULDERS 4" OR LARGER TO BE USED IN INITIAL BACKFILL.  
 3. ALL BACKFILL MATERIAL SHALL BE SUITABLE NATIVE MATERIAL.  
 4. BACKFILL SHALL BE TAMPED IN 6" LIFTS IN TRAFFIC AREAS, 12" IN NON-TRAFFIC AREAS.  
 5. ACHIEVE 90% COMPACTION IN NON-TRAFFIC AREAS, AND 95% COMPACTION IN TRAFFIC AREAS.  
 6. IF IN BASEMENT AT TOPSOIL, AND 1" CLEAN GRIEST FILL MAY BE REQUIRED.  
 7. NO BOULDERS 6" IN DIAMETER OR GREATER ALLOWED IN FINAL BACKFILL.

| CITY OF RALEIGH<br>DEPARTMENT OF PUBLIC UTILITIES                    |           |         |           |      |
|--|-----------|---------|-----------|------|
| TRENCH BOTTOM DIMENSIONS & BACKFILLING REQUIREMENTS FOR DUCTILE IRON |           |         |           |      |
| DWG. NO.   | REVISIONS | DATE    | REVISIONS | DATE |
| S-4  | KRT       | 3-23-00 |           |      |

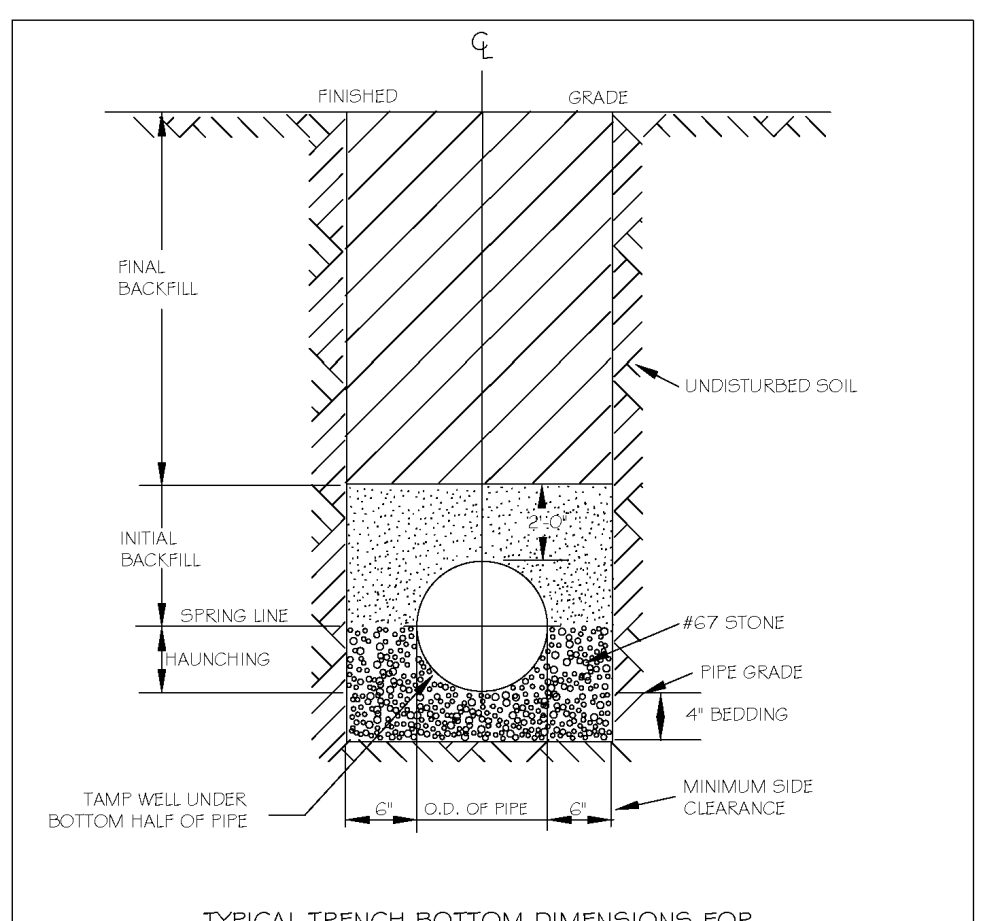


NOTES:  
 1. FOR TRENCHES REQUIRING SHORING AND BRACING, DIMENSIONS SHALL BE TAKEN FROM THE INSIDE FACE OF THE SHORING AND BRACING.  
 2. NO ROCKS OR BOULDERS 4" OR LARGER TO BE USED IN INITIAL BACKFILL.  
 3. ALL BACKFILL MATERIAL SHALL BE SUITABLE NATIVE MATERIAL.  
 4. BACKFILL SHALL BE TAMPED IN 6" LIFTS IN TRAFFIC AREAS, 12" IN NON-TRAFFIC AREAS.

| CITY OF RALEIGH<br>DEPARTMENT OF PUBLIC UTILITIES                                |           |         |           |      |
|--|-----------|---------|-----------|------|
| TRENCH BOTTOM DIMENSIONS AND BACKFILLING REQUIREMENTS FOR PVC GRAVITY SEWER MAIN |           |         |           |      |
| DWG. NO.   | REVISIONS | DATE    | REVISIONS | DATE |
| S-5  | KRT       | 3-23-00 |           |      |

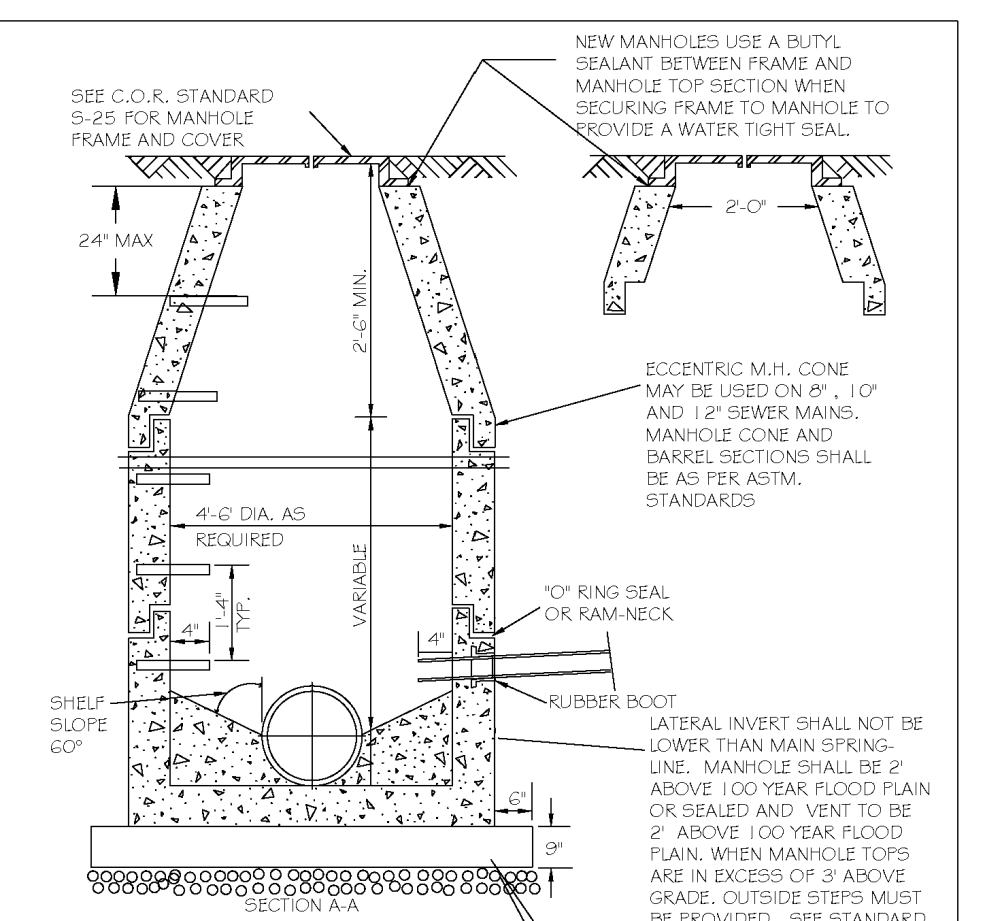


NOTES:  
 1. THE TRACER WIRE SHALL BE CONTINUOUS TO THE GREATEST EXTENT POSSIBLE. FOR GRAVITY MAIN AND OR LATERAL INSTALLATIONS LESS THAN 8 FT, THE TRACER WIRE SHALL BE ATTACHED TO THE PIPE TRACER WIRE SHALL BE ADDED AND SECURELY ATTACHED TO THE PIPE AT 10 FOOT INTERVALS. FOR GRAVITY MAIN AND OR LATERAL INSTALLATION DEEPER THAN 8 FT, THE TRACER WIRE SHALL BE INSTALLED AT A DEPTH OF 7.5 FT. THE WIRE SHALL BE PROTECTED FROM DAMAGE DURING THE COURSE OF THE WORK, NO BREAKS OR CUTS IN THE TRACER WIRE SHALL BE PERMITTED.  
 2. WHERE LATERAL TAPS ARE MADE BY SERVICE SAIDLES, THE TRACER WIRE SHALL NOT BE ALLOWED TO BE PLACED BETWEEN THE SAIDLE AND MAIN.  
 3. MANHOLE MARKERS SHALL BE PLACED ADJACENT TO MANHOLES AT THE DISCRETION OF OWNER OR OWNER'S REPRESENTATIVE.

| CITY OF RALEIGH<br>DEPARTMENT OF PUBLIC UTILITIES |           |          |           |         |
|---|-----------|----------|-----------|---------|
| STANDARD PRECAST SANITARY SEWER MANHOLE           |           |          |           |         |
| DWG. NO.  | REVISIONS | DATE     | REVISIONS | DATE    |
| S-20  | T.C.A.    | 12-31-02 | AKB       | 2-21-05 |
|   |           | AKB      | 3-30-00   | DTL     |
|   |           |          |           | 6-14-08 |

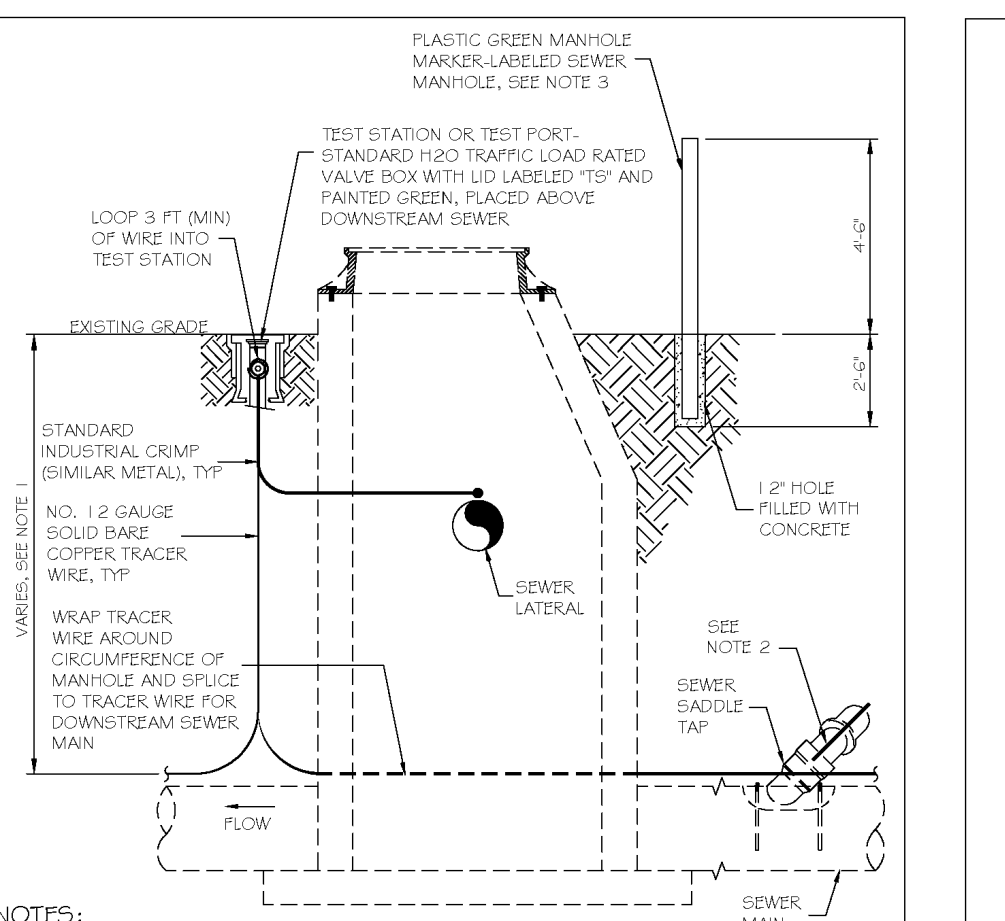


NOTES:  
 1. THE TRACER WIRE SHALL BE CONTINUOUS TO THE GREATEST EXTENT POSSIBLE. FOR GRAVITY MAIN AND OR LATERAL INSTALLATIONS LESS THAN 8 FT, THE TRACER WIRE SHALL BE ATTACHED TO THE PIPE TRACER WIRE SHALL BE ADDED AND SECURELY ATTACHED TO THE PIPE AT 10 FOOT INTERVALS. FOR GRAVITY MAIN AND OR LATERAL INSTALLATION DEEPER THAN 8 FT, THE TRACER WIRE SHALL BE INSTALLED AT A DEPTH OF 7.5 FT. THE WIRE SHALL BE PROTECTED FROM DAMAGE DURING THE COURSE OF THE WORK, NO BREAKS OR CUTS IN THE TRACER WIRE SHALL BE PERMITTED.  
 2. WHERE LATERAL TAPS ARE MADE BY SERVICE SAIDLES, THE TRACER WIRE SHALL NOT BE ALLOWED TO BE PLACED BETWEEN THE SAIDLE AND MAIN.  
 3. MANHOLE MARKERS SHALL BE PLACED ADJACENT TO MANHOLES AT THE DISCRETION OF OWNER OR OWNER'S REPRESENTATIVE.

| CITY OF RALEIGH<br>DEPARTMENT OF PUBLIC UTILITIES |           |       |           |      |
|---|-----------|-------|-----------|------|
| GRAVITY SEWER MAIN TRACER WIRE AND MANHOLE MARKER |           |       |           |      |
| DWG. NO.  | REVISIONS | DATE  | REVISIONS | DATE |
| S-20A   | W.E.      | 09-11 |           |      |

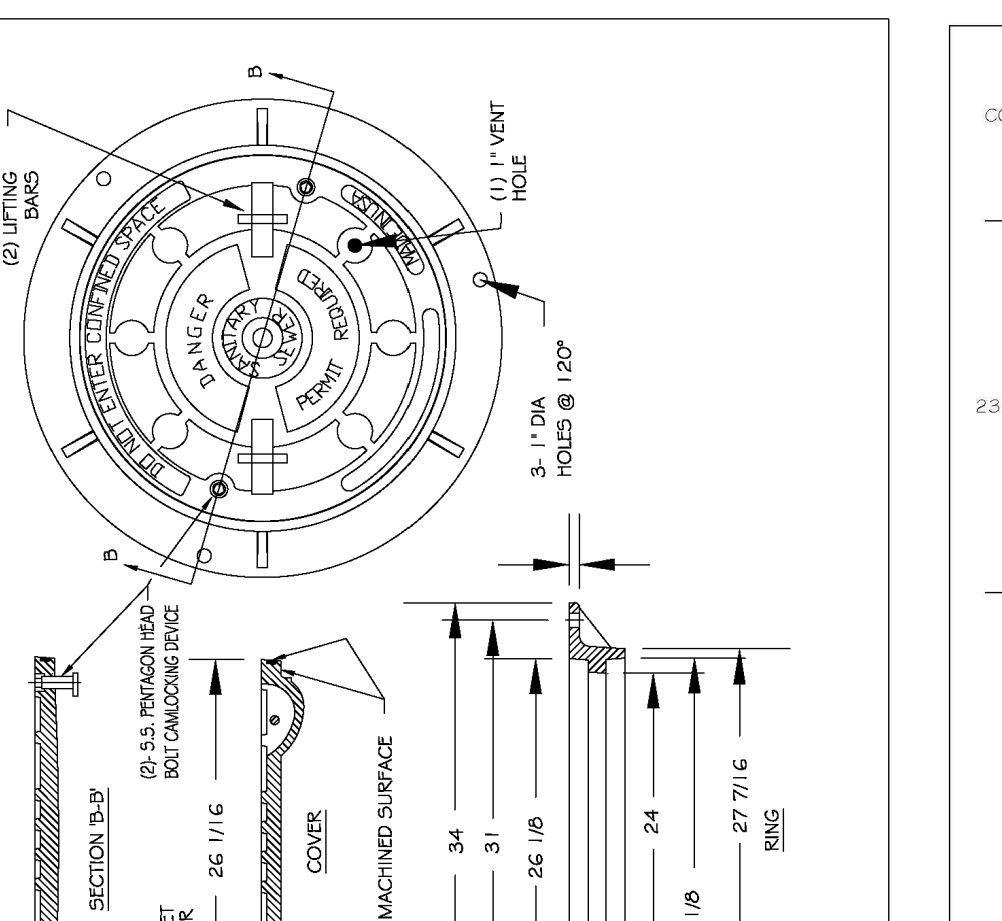


NOTES:  
 1. ALL MANHOLE FRAMES SHALL BE DOMESTICALLY CAST.  
 2. FRAME SHALL BE A MINIMUM WEIGHT OF 120 LBS. WITHIN PUBLIC ROW AND 140 LBS. WITHIN EASEMENTS.  
 3. COVER SHALL BE A MIN. OF 120 LBS. HOT DIPPED GALVANIZED LAGO BOOT AND WASHER.  
 4. ALL MANHOLE FRAMES OUTSIDE OF PAVED SURFACES SHALL BE SET TO THE CORNER SECTION OR RING WITH A MINIMUM OF 4 BOLTS PER FRAME.

| CITY OF RALEIGH<br>DEPARTMENT OF PUBLIC UTILITIES |           |        |           |         |
|---|-----------|--------|-----------|---------|
| FLAT TOP MANHOLE COVER                            |           |        |           |         |
| DWG. NO.  | REVISIONS | DATE   | REVISIONS | DATE    |
| S-25.01   | KRT       | 3-1-07 | A.B.B.    | 2-9-05  |
|   |           |        |           | 6-18-08 |

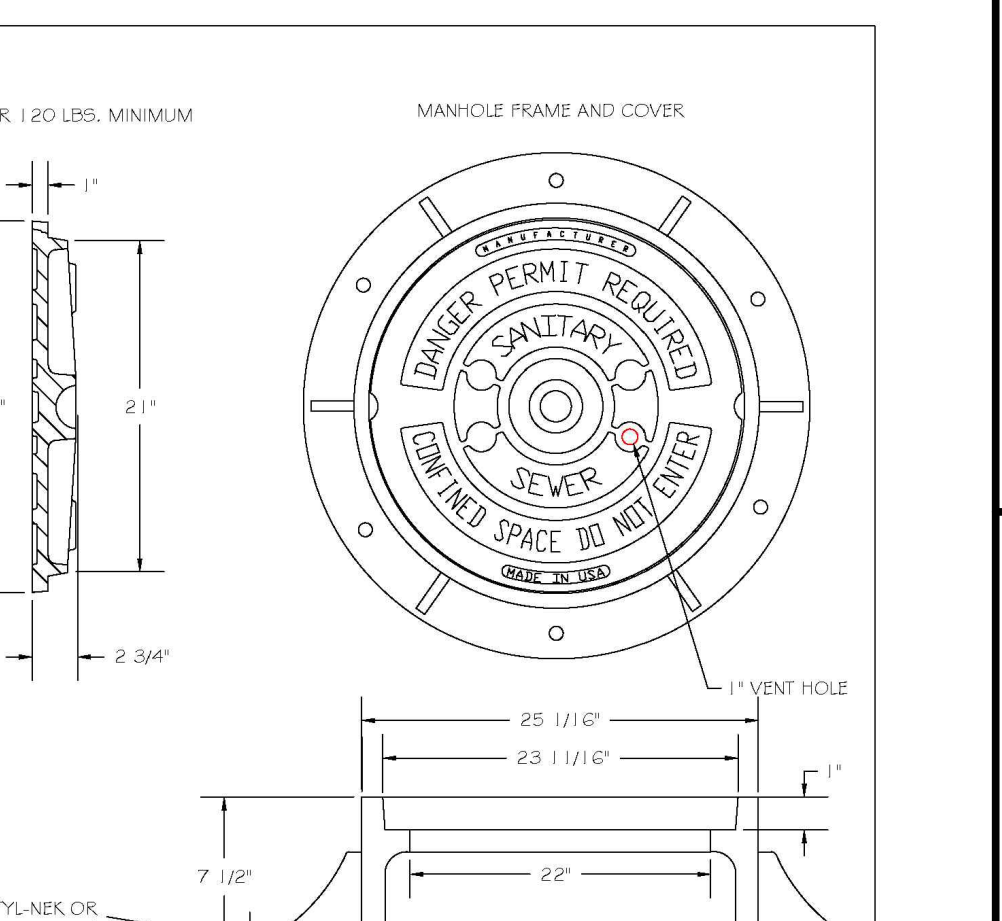


NOTES:  
 1. ALL MANHOLE FRAMES SHALL BE DOMESTICALLY CAST.  
 2. FRAME SHALL BE A MINIMUM WEIGHT OF 120 LBS. WITHIN PUBLIC ROW AND 140 LBS. WITHIN EASEMENTS.  
 3. COVER SHALL BE A MIN. OF 120 LBS. HOT DIPPED GALVANIZED LAGO BOOT AND WASHER.  
 4. ALL MANHOLE FRAMES OUTSIDE OF PAVED SURFACES SHALL BE SET TO THE CORNER SECTION OR RING WITH A MINIMUM OF 4 BOLTS PER FRAME.


| CITY OF RALEIGH<br>DEPARTMENT OF PUBLIC UTILITIES |           |        |           |         |
|---|-----------|--------|-----------|---------|
| STANDARD MANHOLE COVER                            |           |        |           |         |
| DWG. NO.  | REVISIONS | DATE   | REVISIONS | DATE    |
| S-25  | KRT       | 3-1-07 | A.B.B.    | 2-9-05  |
|   |           |        |           | 6-18-08 |

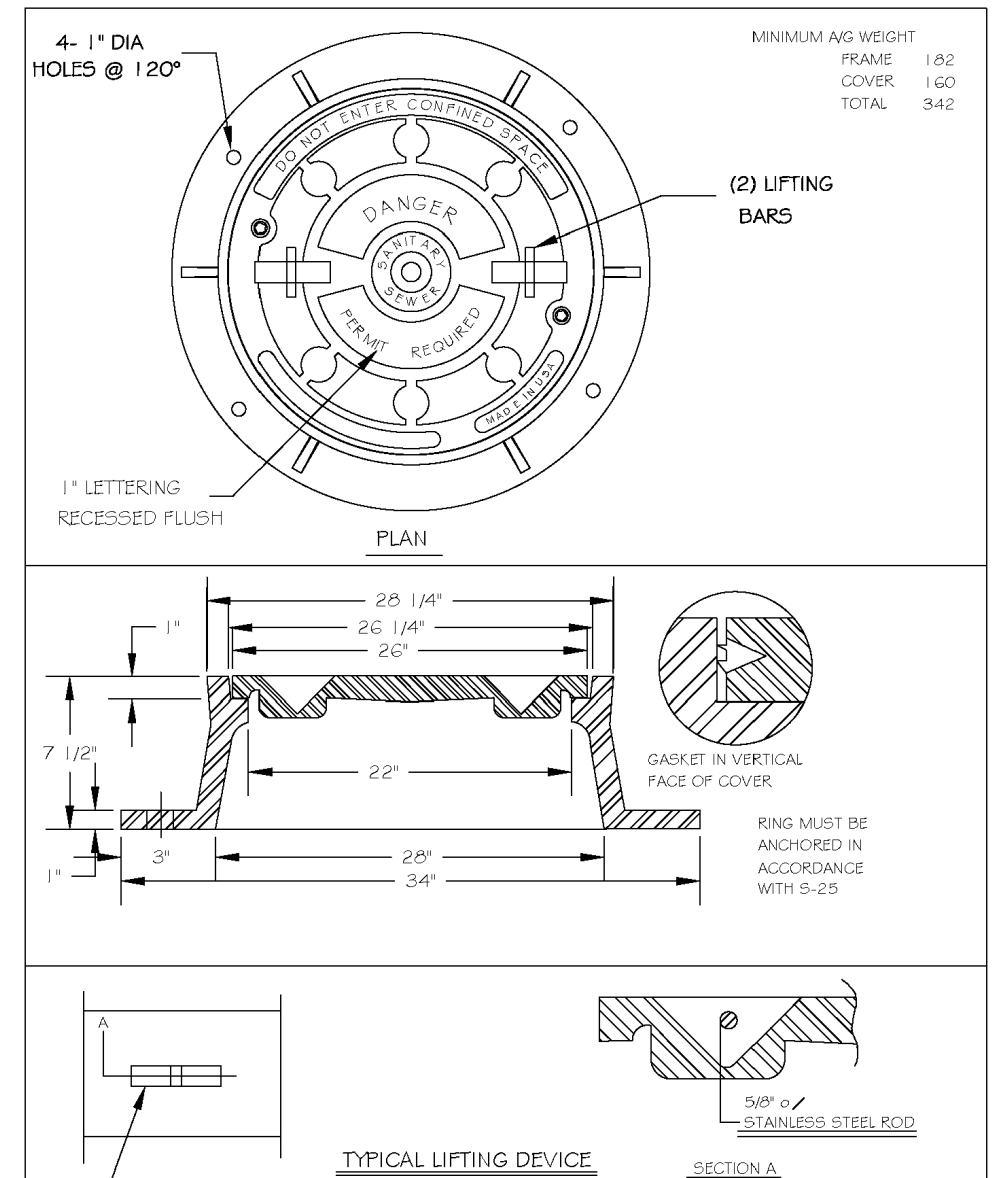


| CITY OF RALEIGH<br>DEPARTMENT OF PUBLIC UTILITIES |           |        |           |         |
|---|-----------|--------|-----------|---------|
| MANHOLE FRAME AND WATERTIGHT COVER                |           |        |           |         |
| DWG. NO.  | REVISIONS | DATE   | REVISIONS | DATE    |
| S-26  | KRT       | 3-1-07 | AKB       | 2-9-05  |
|   |           |        |           | 6-18-08 |

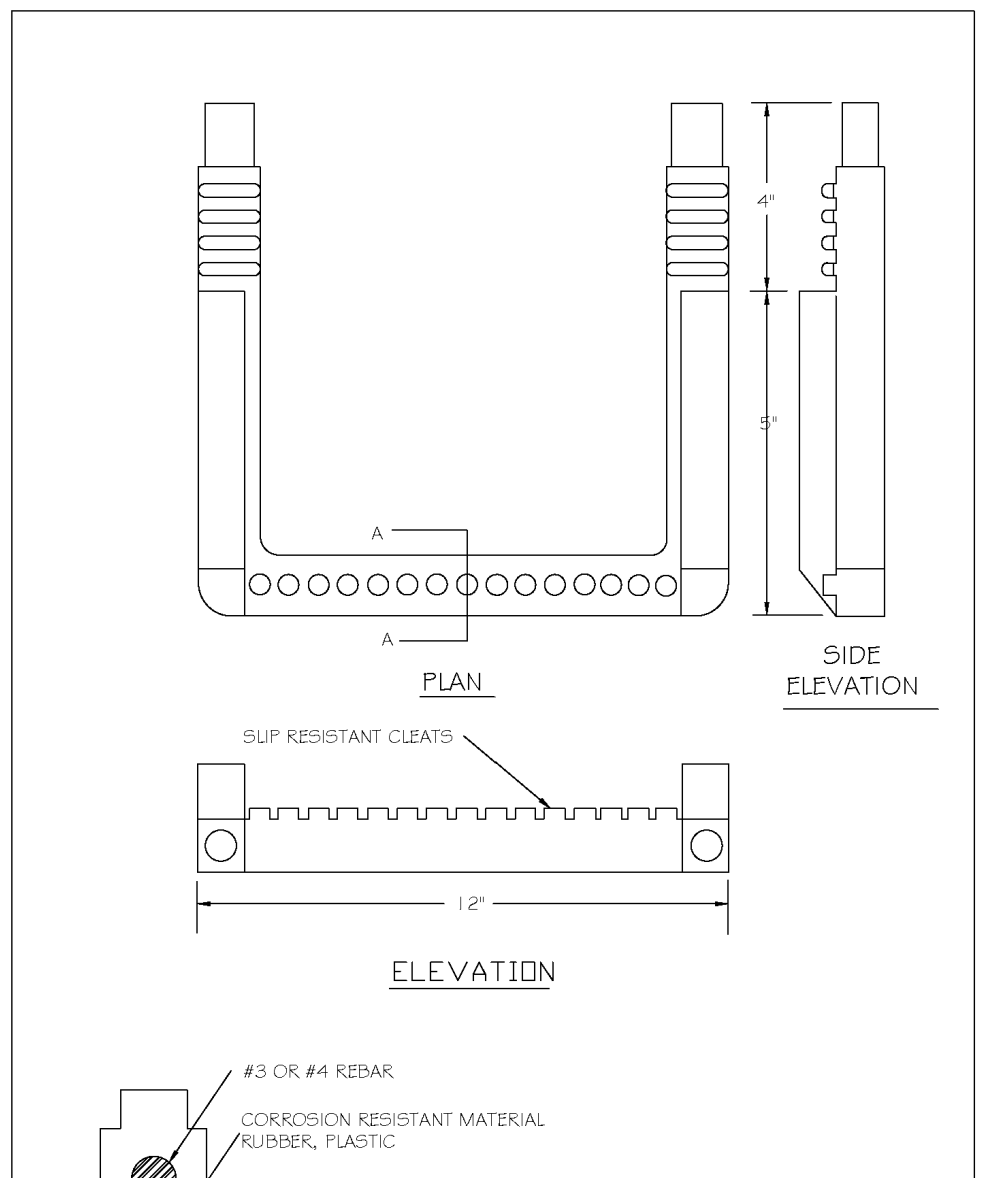


| CITY OF RALEIGH<br>DEPARTMENT OF PUBLIC UTILITIES |           |         |           |      |
|---|-----------|---------|-----------|------|
| STANDARD SLIP RESISTANT MANHOLE STEP DETAIL       |           |         |           |      |
| DWG. NO.  | REVISIONS | DATE    | REVISIONS | DATE |
| S-28  | KRT       | 3-30-00 |           |      |

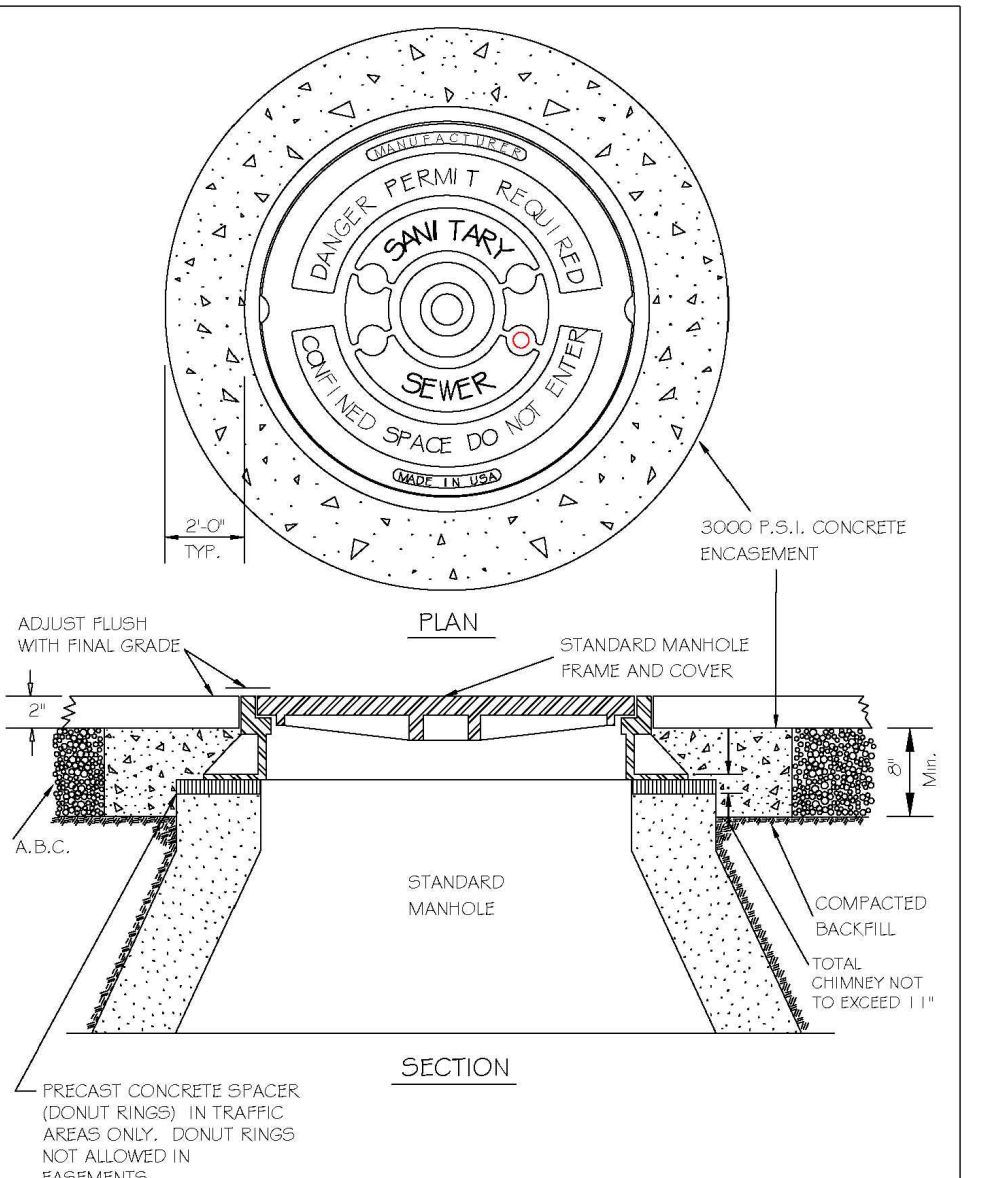


| CITY OF RALEIGH<br>DEPARTMENT OF PUBLIC UTILITIES             |           |         |           |          |
|---|-----------|---------|-----------|----------|
| STANDARD MANHOLE FRAME AND COVER DETAIL WITHIN PAVED SURFACES |           |         |           |          |
| DWG. NO.  | REVISIONS | DATE    | REVISIONS | DATE     |
| S-29  | T.C.A.    | 2-21-05 | AKB       | 3-30-00  |
|   |           |         |           | 11-28-07 |

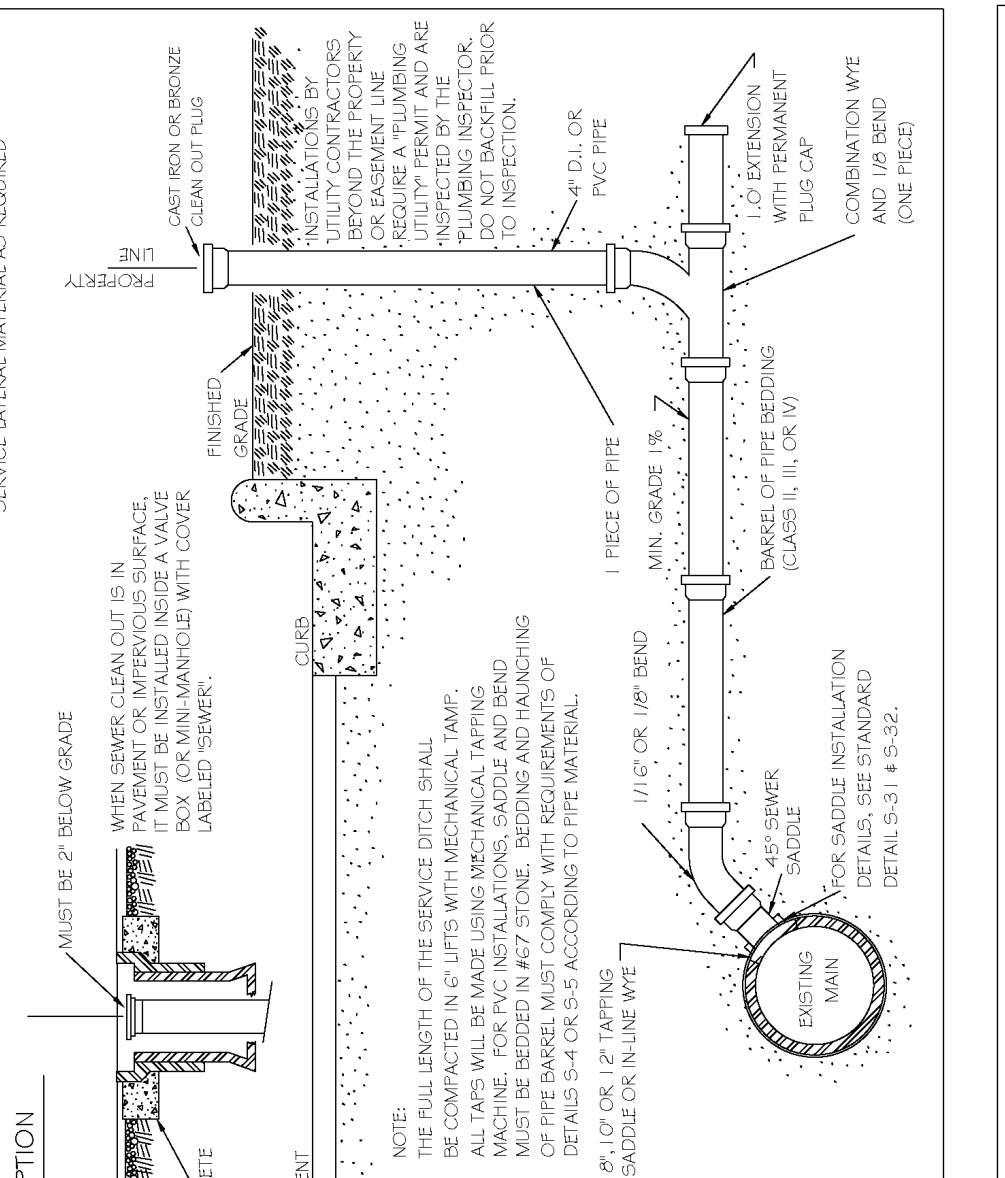

| CITY OF RALEIGH<br>DEPARTMENT OF PUBLIC UTILITIES |           |         |           |          |
|---|-----------|---------|-----------|----------|
| TYPICAL SANITARY SEWER LATERAL CONNECTION         |           |         |           |          |
| DWG. NO.  | REVISIONS | DATE    | REVISIONS | DATE     |
| S-30  | KRT       | 3-30-00 | A.B.B.    | 4-24-04  |
|   |           |         |           | 11-18-05 |

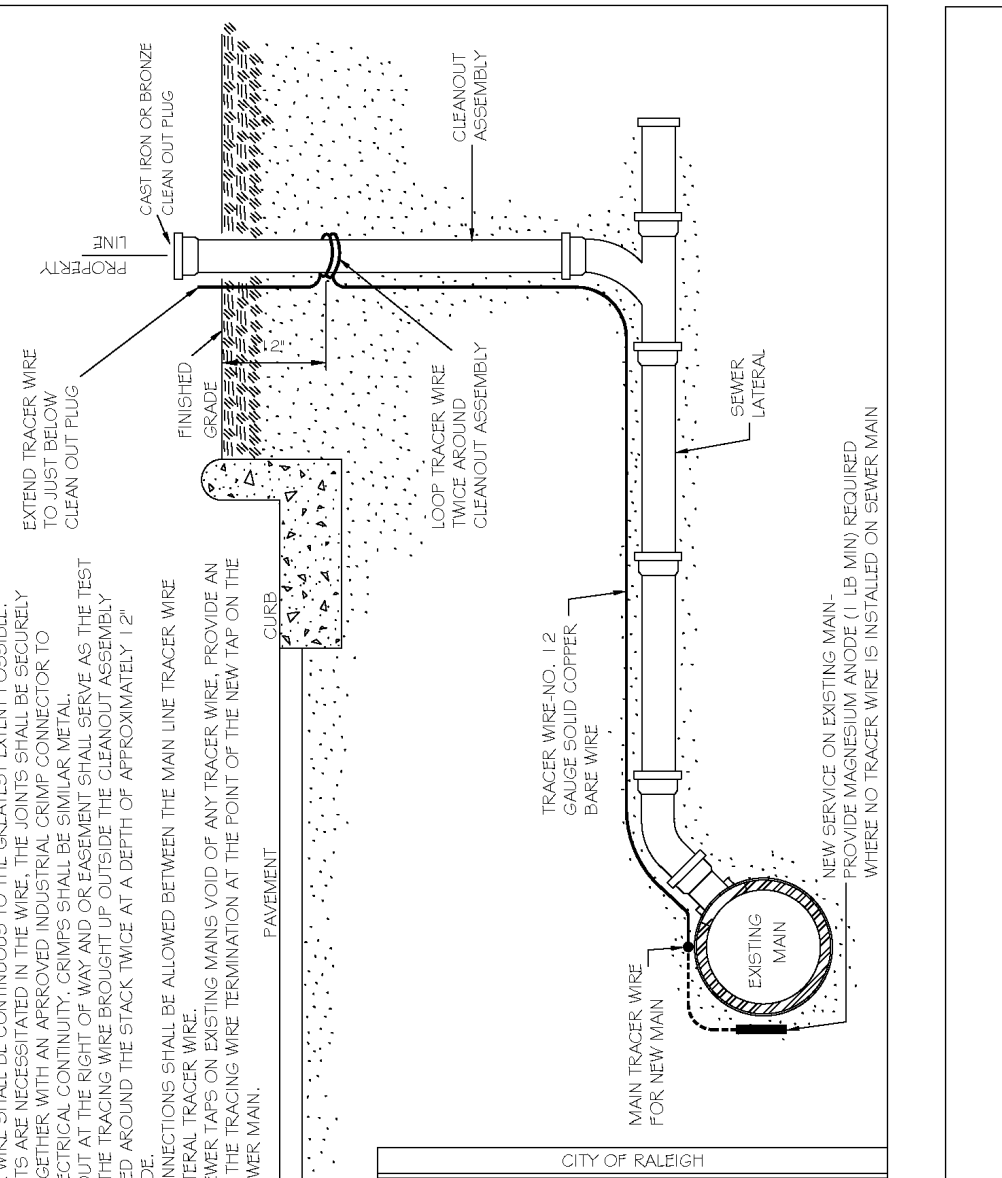


| CITY OF RALEIGH<br>DEPARTMENT OF PUBLIC UTILITIES |           |      |           |      |
|---|-----------|------|-----------|------|
| TYPICAL SANITARY SEWER LATERAL CONNECTION         |           |      |           |      |
| DWG. NO.  | REVISIONS | DATE | REVISIONS | DATE |
| S-30A   | KRT       | 3-14 |           |      |

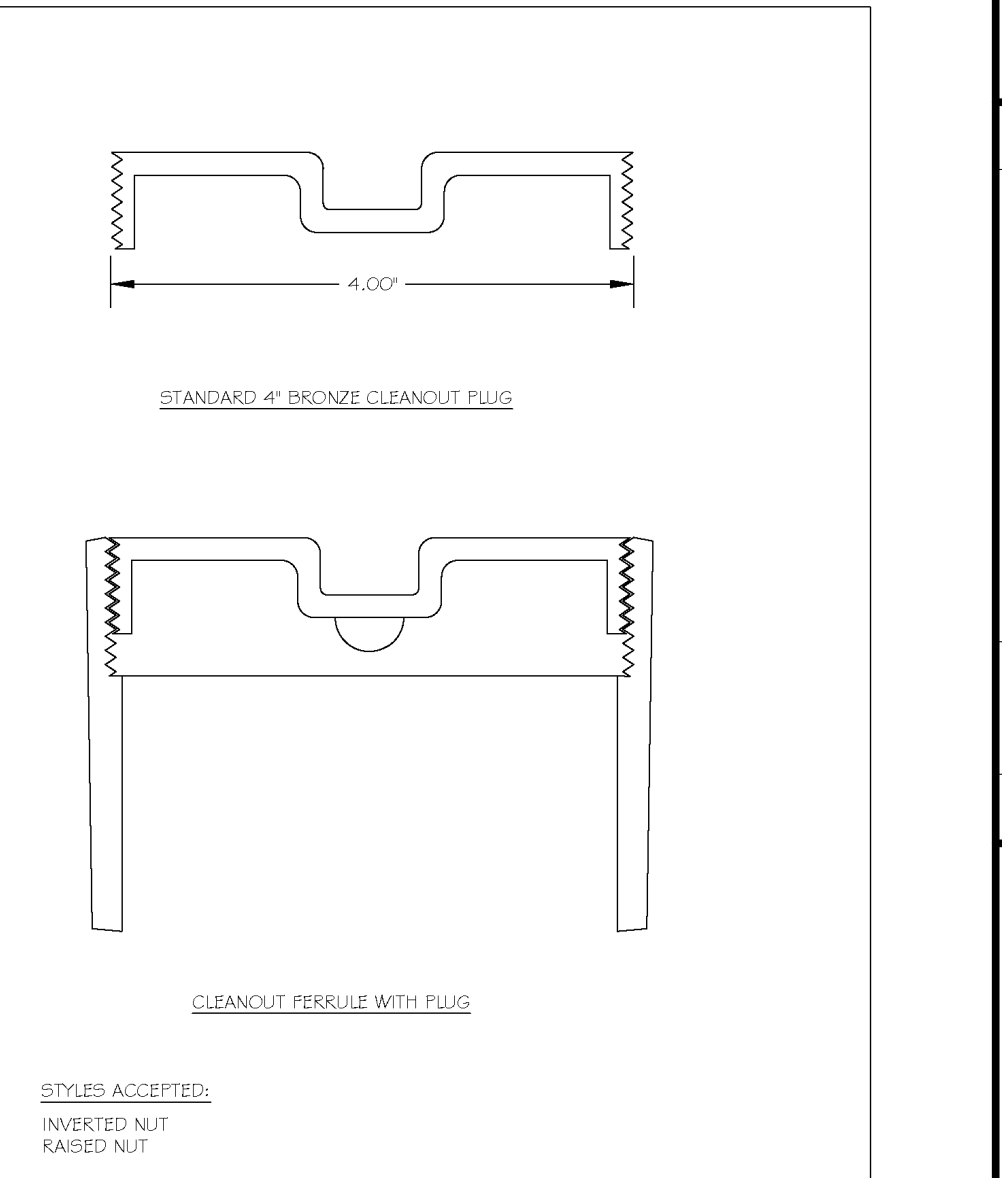


| CITY OF RALEIGH<br>DEPARTMENT OF PUBLIC UTILITIES |           |         |           |         |
|---|-----------|---------|-----------|---------|
| 4" CLEANOUT PLUG                                  |           |         |           |         |
| DWG. NO.  | REVISIONS | DATE    | REVISIONS | DATE    |
| S-34  | T.W.C.    | 3-27-05 | KRT       | 3-30-00 |




| CITY OF RALEIGH<br>DEPARTMENT OF PUBLIC UTILITIES   |           |         |           |      |
|---|-----------|---------|-----------|------|
| CONCRETE CRADLE PROTECTION FOR SEWER LINE CROSSINGS |           |         |           |      |
| DWG. NO.  | REVISIONS | DATE    | REVISIONS | DATE |
| S-49  | PH        | 2-20-00 |           |      |

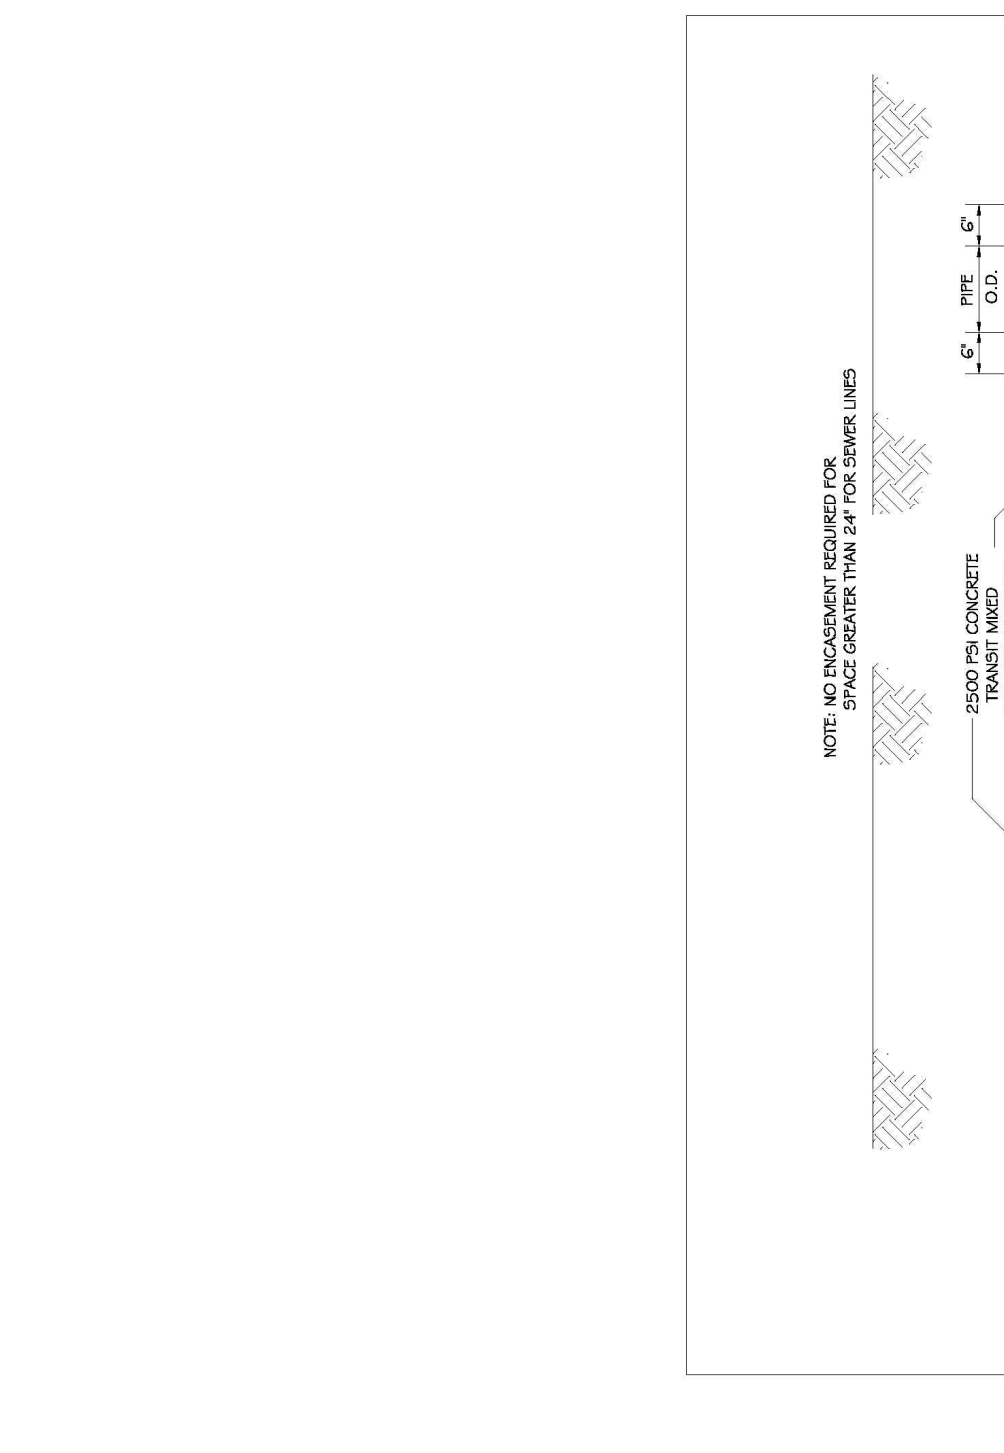


| CITY OF RALEIGH<br>DEPARTMENT OF PUBLIC UTILITIES   |           |         |           |      |
|---|-----------|---------|-----------|------|
| CONCRETE CRADLE PROTECTION FOR SEWER LINE CROSSINGS |           |         |           |      |
| DWG. NO.  | REVISIONS | DATE    | REVISIONS | DATE |
| S-49  | PH        | 2-20-00 |           |      |

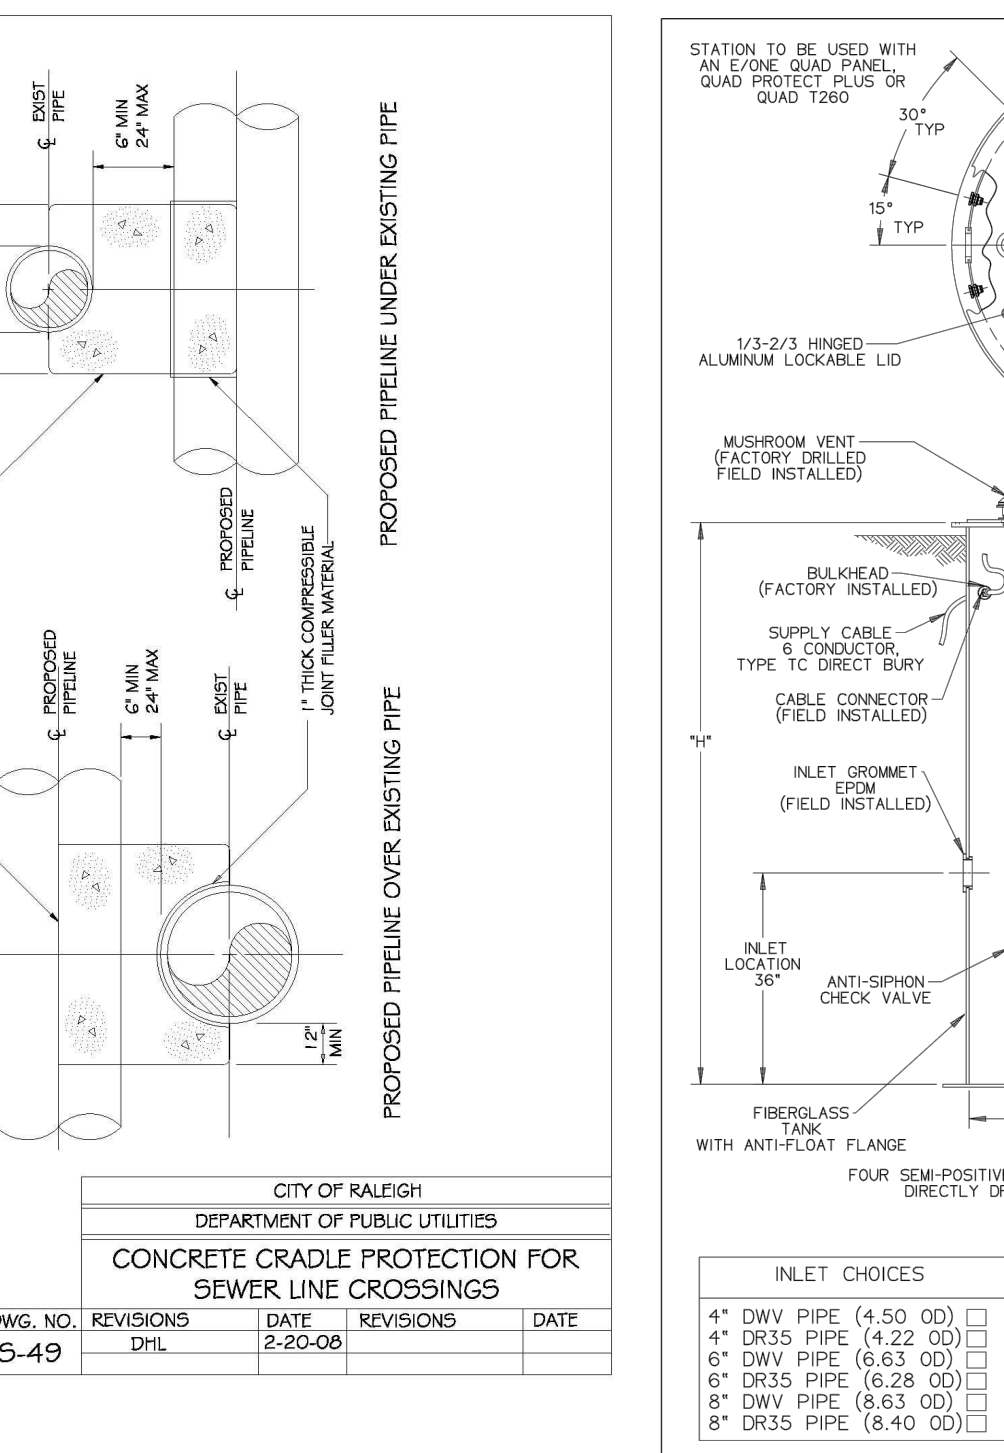


| CITY OF RALEIGH<br>DEPARTMENT OF PUBLIC UTILITIES             |           |         |           |          |
|---|-----------|---------|-----------|----------|
| STANDARD MANHOLE FRAME AND COVER DETAIL WITHIN PAVED SURFACES |           |         |           |          |
| DWG. NO.  | REVISIONS | DATE    | REVISIONS | DATE     |
| S-29  | T.C.A.    | 2-21-05 | AKB       | 3-30-00  |
|   |           |         |           | 11-28-07 |

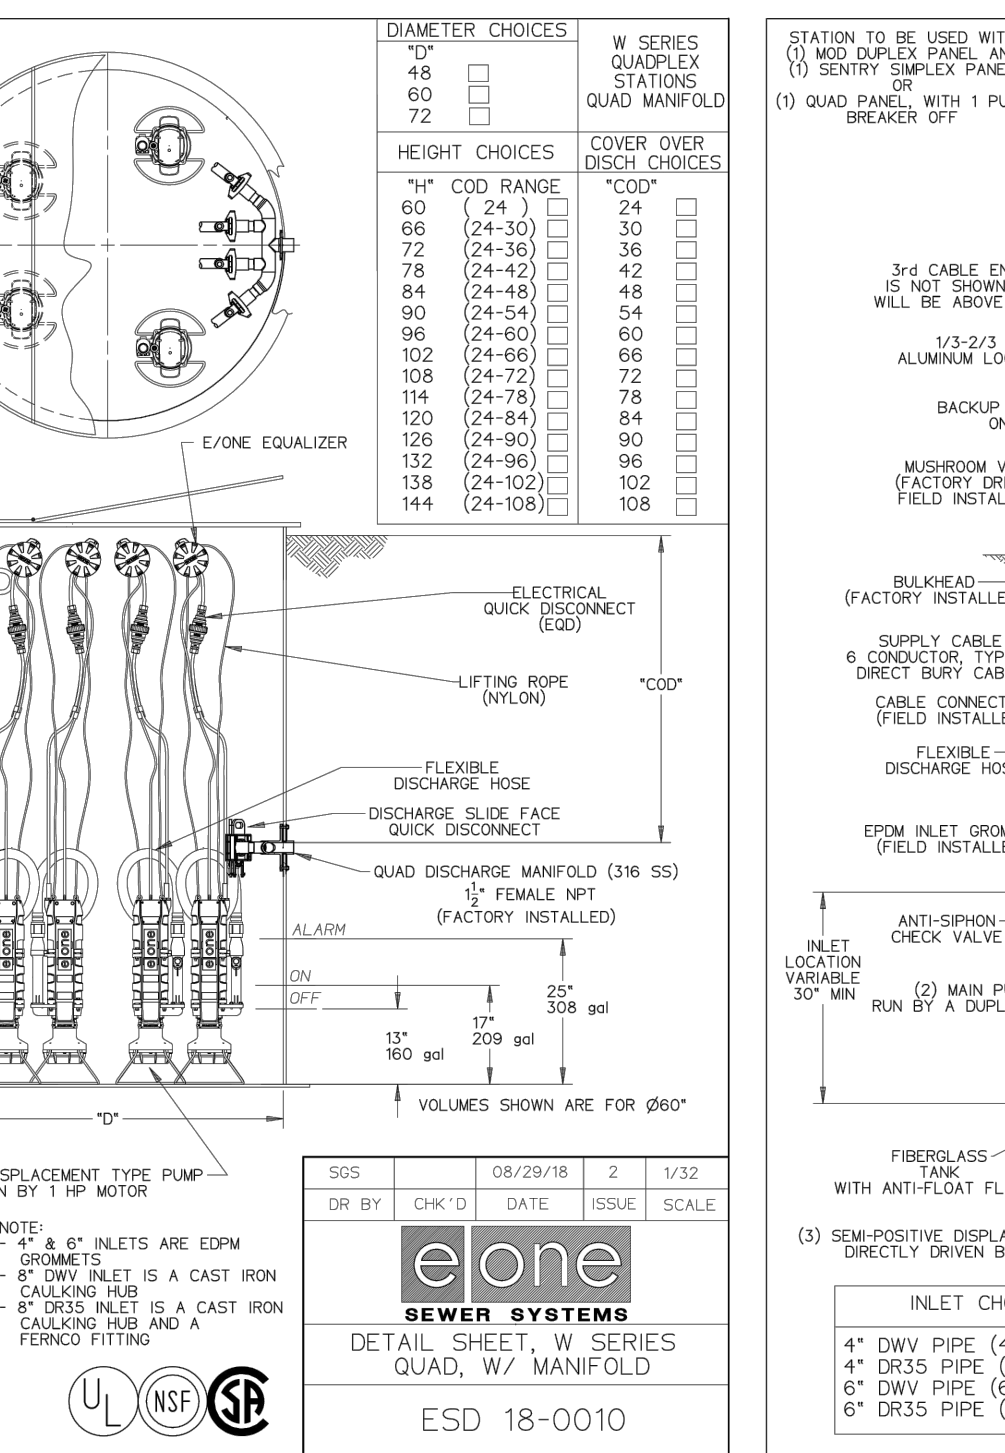

| CITY OF RALEIGH<br>DEPARTMENT OF PUBLIC UTILITIES |           |         |           |          |
|---|-----------|---------|-----------|----------|
| TYPICAL SANITARY SEWER LATERAL CONNECTION         |           |         |           |          |
| DWG. NO.  | REVISIONS | DATE    | REVISIONS | DATE     |
| S-30  | KRT       | 3-30-00 | A.B.B.    | 4-24-04  |
|   |           |         |           | 11-18-05 |

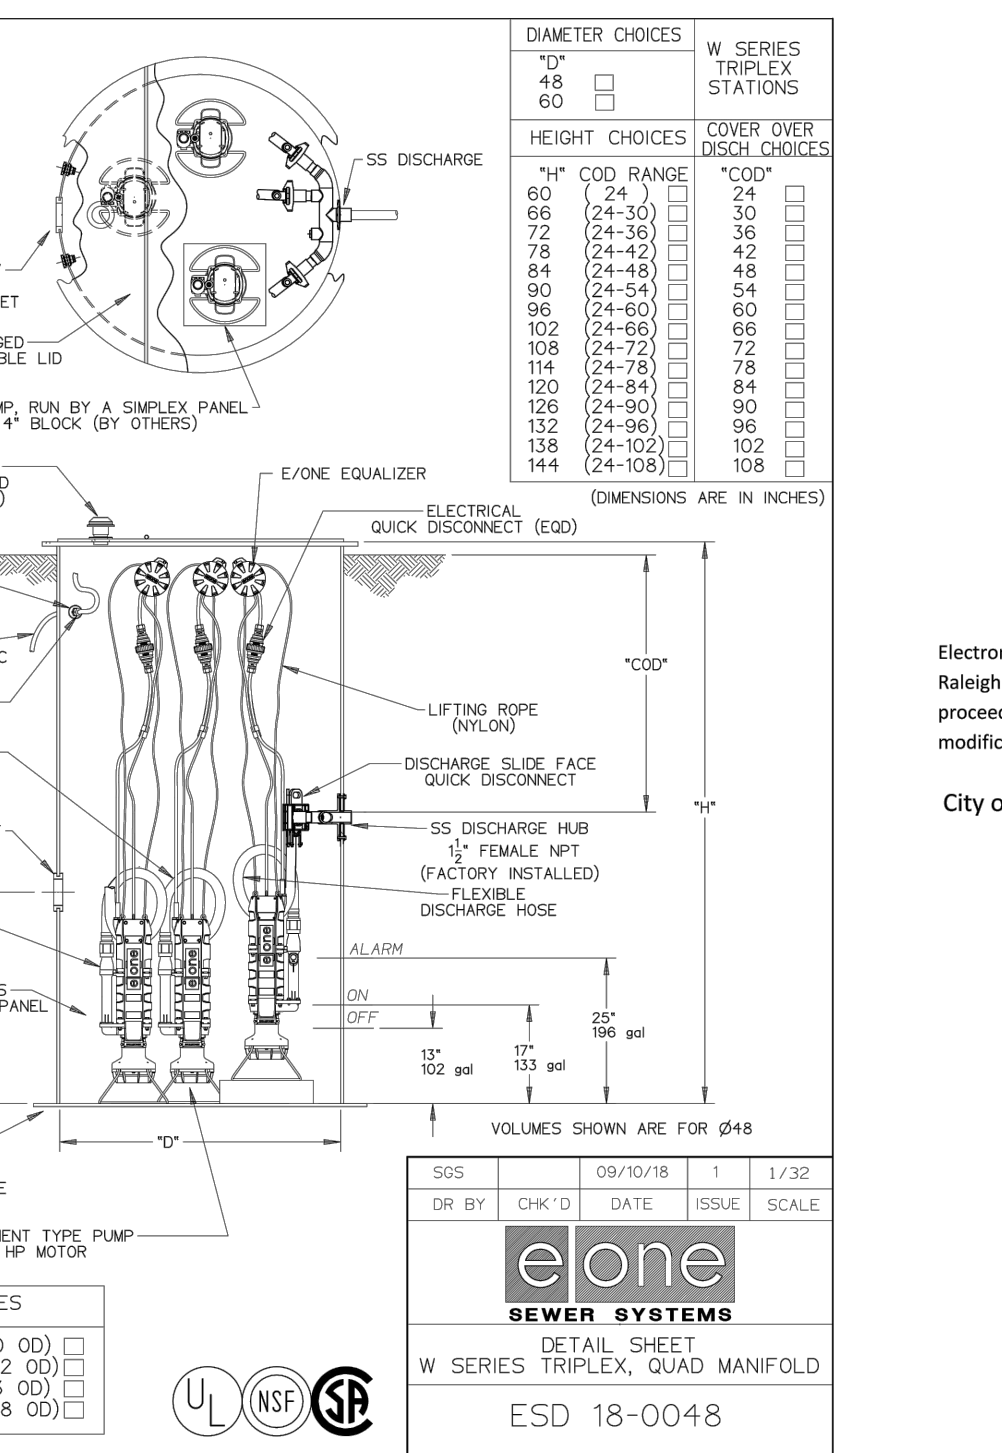

| CITY OF RALEIGH<br>DEPARTMENT OF PUBLIC UTILITIES |           |      |           |      |
|---|-----------|------|-----------|------|
| TYPICAL SANITARY SEWER LATERAL CONNECTION         |           |      |           |      |
| DWG. NO.  | REVISIONS | DATE | REVISIONS | DATE |
| S-30A   | KRT       | 3-14 |           |      |

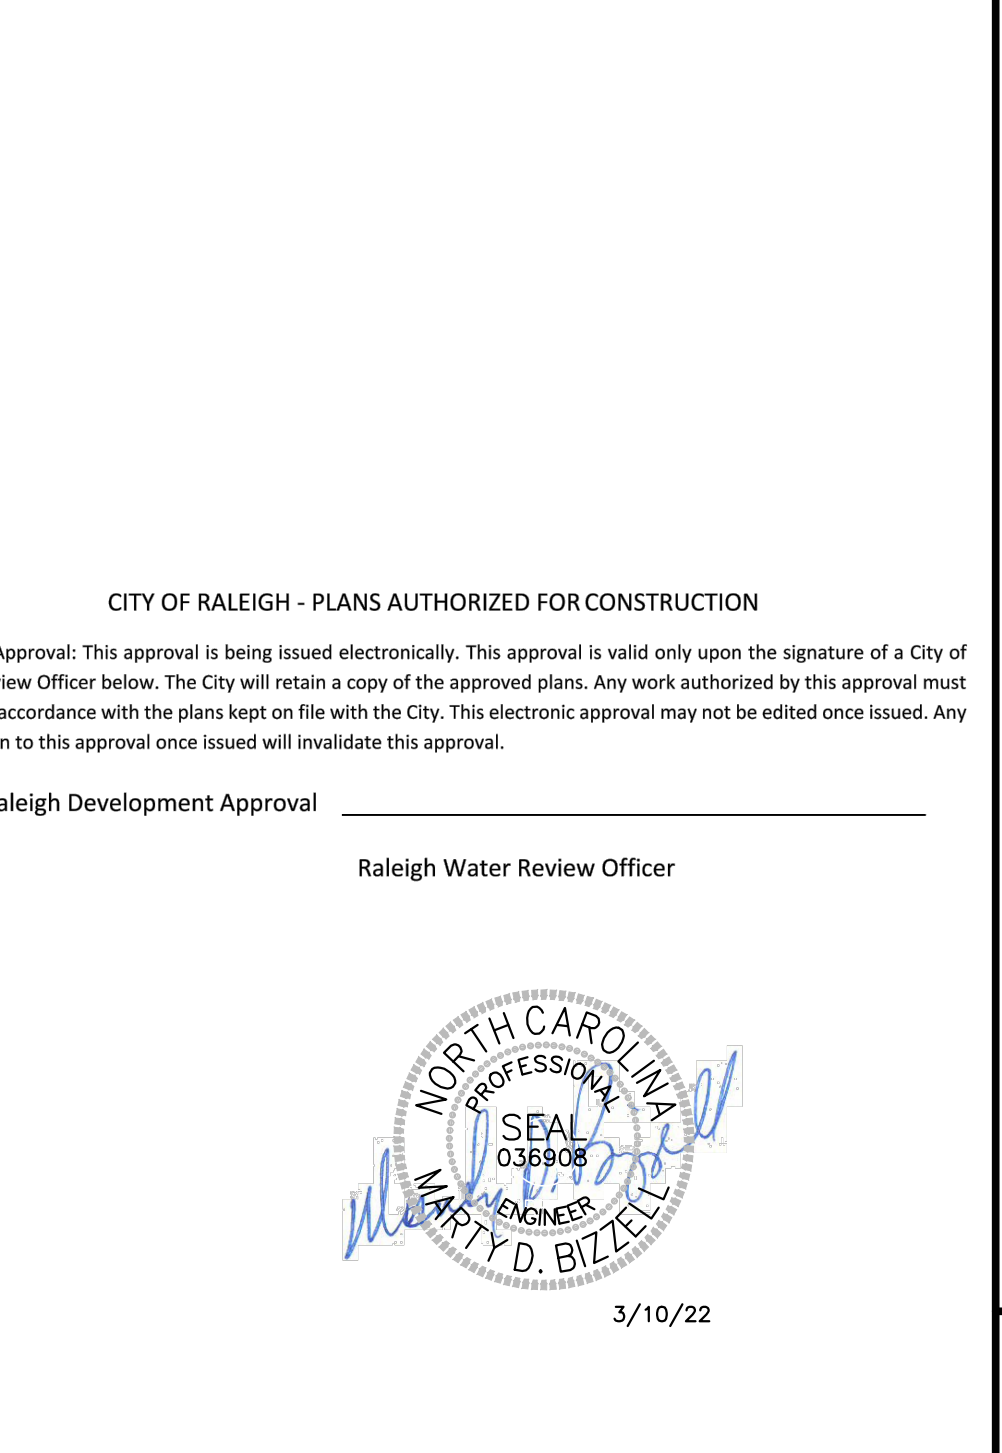

| CITY OF RALEIGH<br>DEPARTMENT OF PUBLIC UTILITIES |           |         |           |         |
|---|-----------|---------|-----------|---------|
| 4" CLEANOUT PLUG                                  |           |         |           |         |
| DWG. NO.  | REVISIONS | DATE    | REVISIONS | DATE    |
| S-34  | T.W.C.    | 3-27-05 | KRT       | 3-30-00 |

**BASS, NIXON & KENNEDY, INC.**  
**CONSULTING ENGINEERS**  
 6310 CHASE HILL ROAD, SUITE 250, RALEIGH, NC 27607  
 TELEPHONE: (919) 881-7222 FAX: (919) 881-8888  
 CERTIFICATION NUMBERS: NCBELS (C-0119); NCBOLA (C-0267)

**COBBLESTONE VILLAGE MIXED USE DEVELOPMENT**  
 TOWN OF ROLESVILLE, WAKE COUNTY, NORTH CAROLINA

**DETAILS**

SCALE: N.T.S.

CHK BY: M.B.


| NO. | DATE | DESCRIPTION | BY |
|-----|------|-------------|----|
|     |      |             |    |
|     |      |             |    |
|     |      |             |    |
|     |      |             |    |

PROGRESS DRAWN BY  
 DATE MRM  
 03-19-17 DATE

SHEET  
**C5.3**


R:\2019\19187 - Rolesville Town Center CIVIL\04 Construction\07 - 19187\_Details.dwg, C5.3, 3/10/2022 4:45:57 PM, mnc-mueller

NOT RELEASED FOR CONSTRUCTION OR BID SOLICITATION

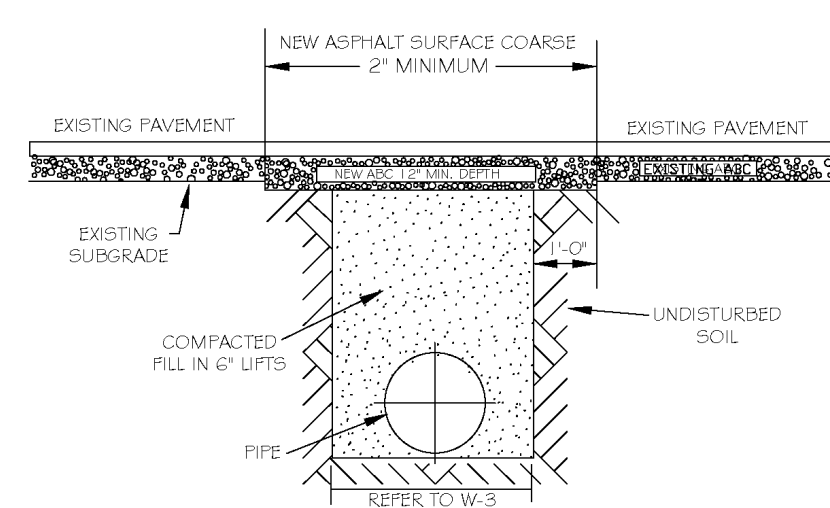


NOTES:  
 1. THE PAVEMENT CUT SHALL BE DEFINED BY A STRAIGHT EDGE AND CUT WITH AN APPROPRIATE SAW CUT MACHINE.  
 2. THE TRENCH SUBGRADE MATERIAL SHALL BE BACKFILLED WITH SUITABLE MATERIAL AND COMPACTED TO A DENSITY OF AT LEAST 95% OF THAT OBTAINED BY COMPACTING A SAMPLE OF THE MATERIAL IN ACCORDANCE WITH AASHTO T-99 AS MODIFIED BY NC DOT.  
 3. THE FINAL 1" OF FILL SHALL CONSIST OF ABC MATERIAL COMPACTED TO A DENSITY EQUAL TO 100% OF THAT OBTAINED BY COMPACTING A SAMPLE OF THE MATERIAL IN ACCORDANCE WITH AASHTO T-99 AS MODIFIED BY NC DOT.  
 4. THE ENTIRE THICKNESS VERTICAL EDGE OF CUT SHALL BE TACKED.  
 5. THE SAME DEPTH OF PAVEMENT MATERIAL WHICH EXISTS SHALL BE REINSTALLED, BUT IN NO CASE SHALL THE ASPHALT BE LESS THAN 2" THICK.  
 6. THE ASPHALT PAVEMENT MATERIAL SHALL BE INSTALLED AND COMPACTED THOROUGHLY WITH A SMOOTH DRUM ROLLER TO ACHIEVE A SMOOTH LEVEL PATCH.  
 7. REFER TO CITY OF RALEIGH STANDARDS FOR TRENCHES AND PIPE BEDDING, W-3, FOR ADDITIONAL DETAILS.  
 8. NO HAND PATCHING ALLOWED.  
 9. PAVEMENT CUTS WITH NC DOT ROW SHALL CONFORM TO THE APPROVED ON SITE ENCROACHMENT PERMIT.

| CITY OF RALEIGH                        |           | CITY OF RALEIGH                |           |
|--|-----------|--------------------------------|-----------|
| DEPARTMENT OF PUBLIC UTILITIES         |           | DEPARTMENT OF PUBLIC UTILITIES |           |
| STANDARD ASPHALT PAVEMENT PATCH DETAIL |           |                                |           |
| DWG. NO.                               | REVISIONS | DATE                           | REVISIONS |
| W-2                                    | RRH       | 3-31-00                        | A.S.B.    |
|  | D.W.C.    | 11-1-03                        | J.P.S.    |

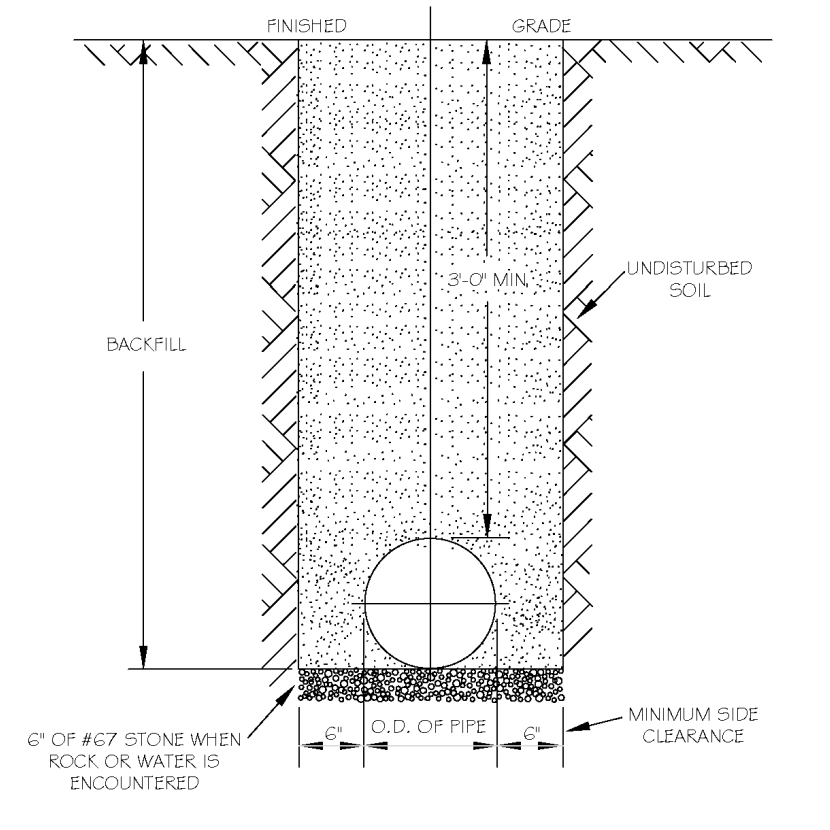


NOTES:  
 1. TRENCHES REQUIRING SHORING AND BRACING, DIMENSIONS SHALL BE TAKEN FROM THE INSIDE FACE OF THE SHORING AND BRACING.  
 2. NO ROCKS OR BouldERS 4" OR LARGER TO BE USED IN BACKFILL.  
 3. ALL BACKFILL MATERIAL SHALL BE SUITABLE NATIVE MATERIAL.  
 4. BACKFILL SHALL BE TAMPED IN 6" LIFTS.  
 5. ACHIEVE 95% COMPACTION IN BACKFILL.

| CITY OF RALEIGH   |           | CITY OF RALEIGH                |           |
|---|-----------|--------------------------------|-----------|
| DEPARTMENT OF PUBLIC UTILITIES                                    |           | DEPARTMENT OF PUBLIC UTILITIES |           |
| TRENCH BOTTOM DIMENSIONS & BACKFILL REQUIREMENTS FOR DUCTILE IRON |           |                                |           |
| DWG. NO.  | REVISIONS | DATE                           | REVISIONS |
| W-3   | RRH       | 3-31-00                        | ABA       |
|   | D.W.C.    | 3-31-00                        | J.P.S.    |

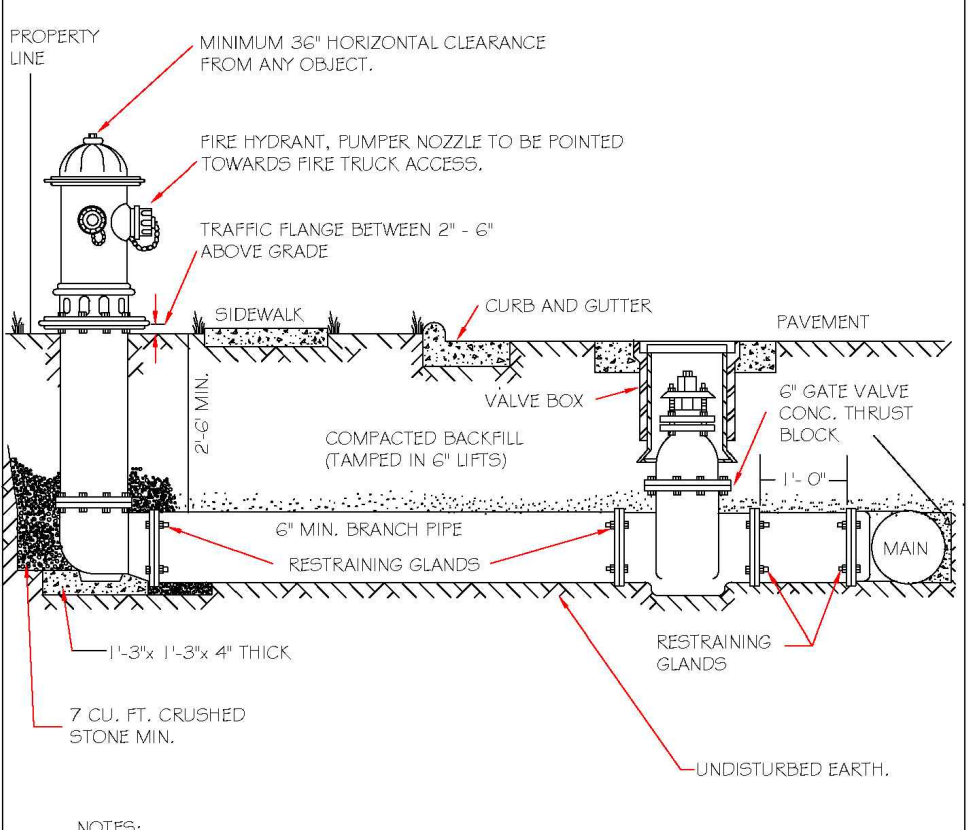


NOTES:  
 1. FIRE HYDRANT SHALL BE AS MANUFACTURED: MUELLER, AMERICAN DARLING, KENNEDY, MHI, WATERLOUS, GLOW, EAST JORDAN IRON WORKS, OR US PIPE.  
 2. BRANCH PIPE SHALL BE DUCTILE IRON ANMA C150-80.  
 3. 6" GATE VALVE SHALL BE ANMA C200-80 OPEN LEFT.  
 4. STEEL RODS AND BOLTS SHALL BE #4 HOT DIPPED GALVANIZED.  
 5. FIRE HYDRANTS WILL BE INSTALLED IN TRUE VERTICAL POSITION.  
 6. ROSS SHALL NOT BE COUPLED MORE THAN ONCE. IF THE LENGTH FROM THE VALVE TO THE HYDRANT EXCEEDS 20' THEN A MECHANICAL RESTRAINING GLAND WITH A REBAR CASE SHALL BE INSTALLED NO MORE THAN 10' FROM HYDRANT AND POURED IN CONCRETE.  
 7. FIRE HYDRANTS TO BE LOCATED IN ROW OR 2 FOOT EASEMENT ADJACENT TO ROW.

| CITY OF RALEIGH                           |           | CITY OF RALEIGH                |           |
|---|-----------|--------------------------------|-----------|
| DEPARTMENT OF PUBLIC UTILITIES            |           | DEPARTMENT OF PUBLIC UTILITIES |           |
| STANDARD FIRE HYDRANT INSTALLATION DETAIL |           |                                |           |
| DWG. NO.                                  | REVISIONS | DATE                           | REVISIONS |
| W-4                                       | ABB       | 4-6-04                         | FW        |
|   | D.W.C.    | 2-7-08                         | 2-7-08    |

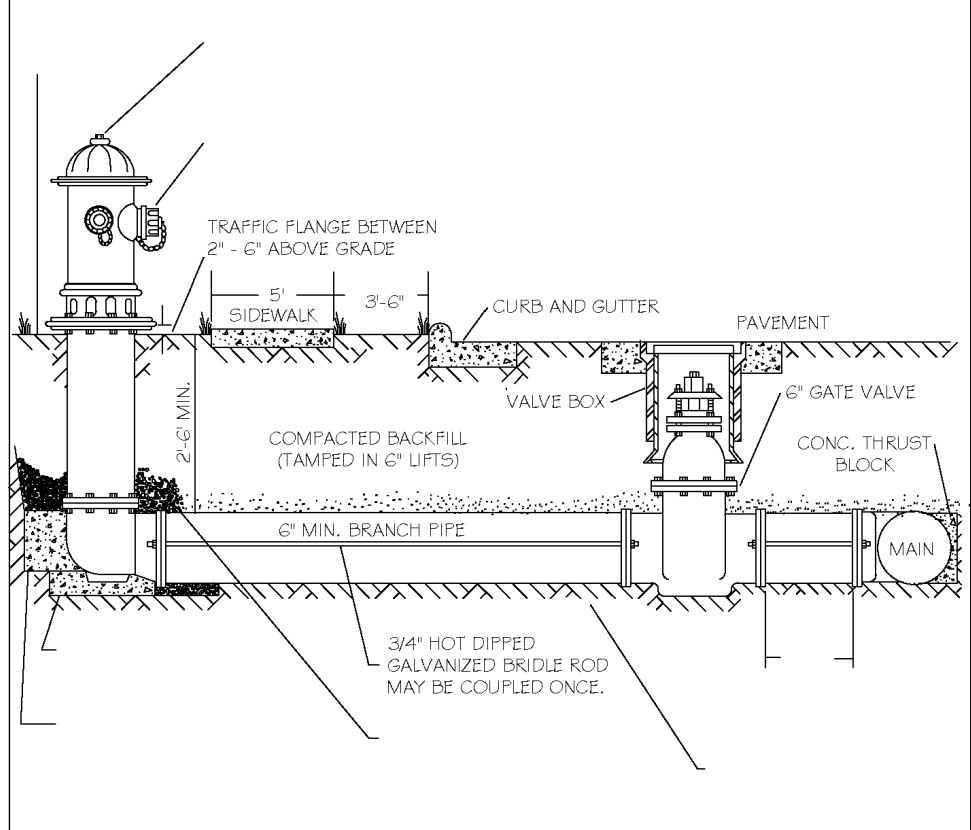


NOTES:  
 1. FIRE HYDRANT SHALL BE AS MANUFACTURED: MUELLER, AMERICAN DARLING, KENNEDY, MHI, WATERLOUS, GLOW, EAST JORDAN IRON WORKS, OR US PIPE.  
 2. BRANCH PIPE SHALL BE DUCTILE IRON ANMA C150-80.  
 3. 6" GATE VALVE SHALL BE ANMA C200-80 OPEN LEFT.  
 4. STEEL RODS AND BOLTS SHALL BE #4 HOT DIPPED GALVANIZED.  
 5. FIRE HYDRANTS WILL BE INSTALLED IN TRUE VERTICAL POSITION.  
 6. ROSS SHALL NOT BE COUPLED MORE THAN ONCE. IF THE LENGTH FROM THE VALVE TO THE HYDRANT EXCEEDS 20' THEN A MECHANICAL RESTRAINING GLAND WITH A REBAR CASE SHALL BE INSTALLED NO MORE THAN 10' FROM HYDRANT AND POURED IN CONCRETE.  
 7. FIRE HYDRANTS TO BE LOCATED IN ROW OR 2 FOOT EASEMENT ADJACENT TO ROW.

| CITY OF RALEIGH                                      |           | CITY OF RALEIGH                |           |
|--|-----------|--------------------------------|-----------|
| DEPARTMENT OF PUBLIC UTILITIES                       |           | DEPARTMENT OF PUBLIC UTILITIES |           |
| STANDARD FIRE HYDRANT WITH 5" STANDARD PUMPER NOZZLE |           |                                |           |
| DWG. NO.   | REVISIONS | DATE                           | REVISIONS |
| W-5  | RRH       | 3-1-07                         | ARR       |
|  | D.W.C.    | 3-31-00                        | D.H.L.    |

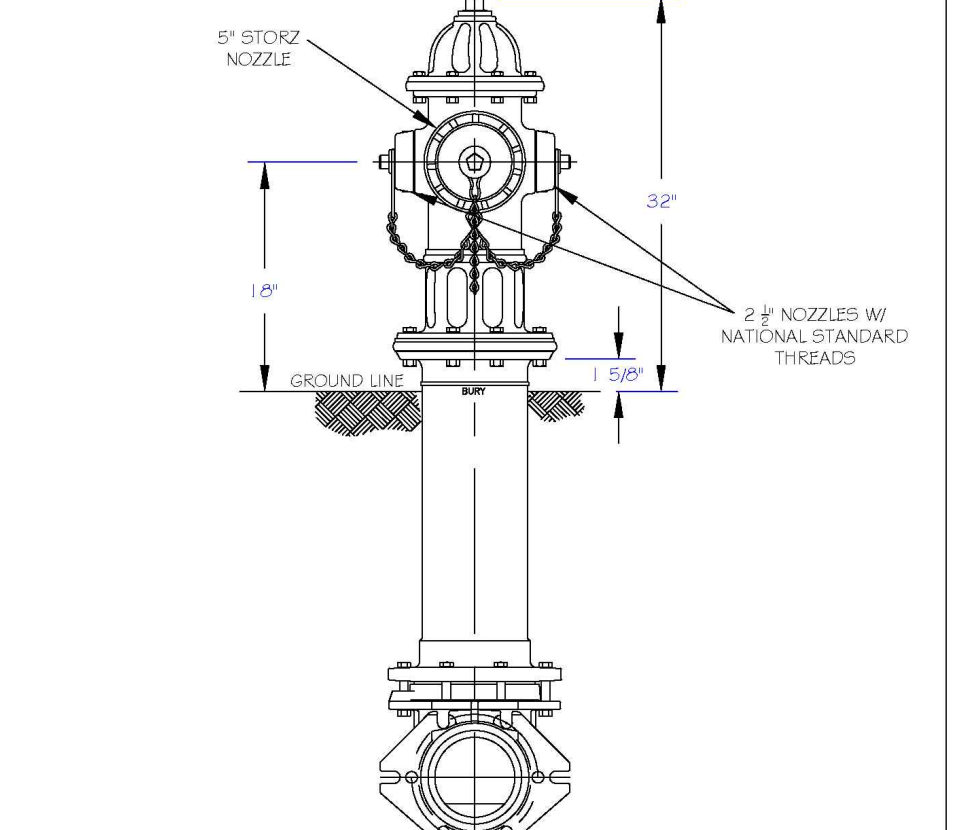


NOTES:  
 1. RALEIGH PUBLIC HYDRANTS SHALL BE PAINTED SOLID RED.  
 2. KNIGHTDALE, 4 ROLESVILLE PUBLIC HYDRANTS SHALL BE PAINTED RED W/SILVER OPERATING NUTS.  
 3. ZIEGLER PUBLIC HYDRANTS SHALL BE PAINTED RED W/SILVER BONNETS AND OPERATING NUTS.  
 4. WAKE FOREST AND GARNER, AND WENDELL PUBLIC AND PRIVATE HYDRANTS TO BE PAINTED SAFETY YELLOW W/SILVER CAPS AND OPERATING NUTS.  
 5. OPERATING NUTS ON HYDRANTS CONNECTED TO POTABLE MAINS LARGER THAN 1/2" SHALL BE PAINTED BLACK.

| CITY OF RALEIGH   |           | CITY OF RALEIGH                |           |
|---|-----------|--------------------------------|-----------|
| DEPARTMENT OF PUBLIC UTILITIES                                    |           | DEPARTMENT OF PUBLIC UTILITIES |           |
| HYDRANT OPERATING NUT AND 2 1/2" NATIONAL STANDARD OUTLET THREADS |           |                                |           |
| DWG. NO.  | REVISIONS | DATE                           | REVISIONS |
| W-6   | RRH       | 3-31-00                        | D.H.L.    |
|   | A.S.B.    | 6-13-04                        | J.P.S.    |

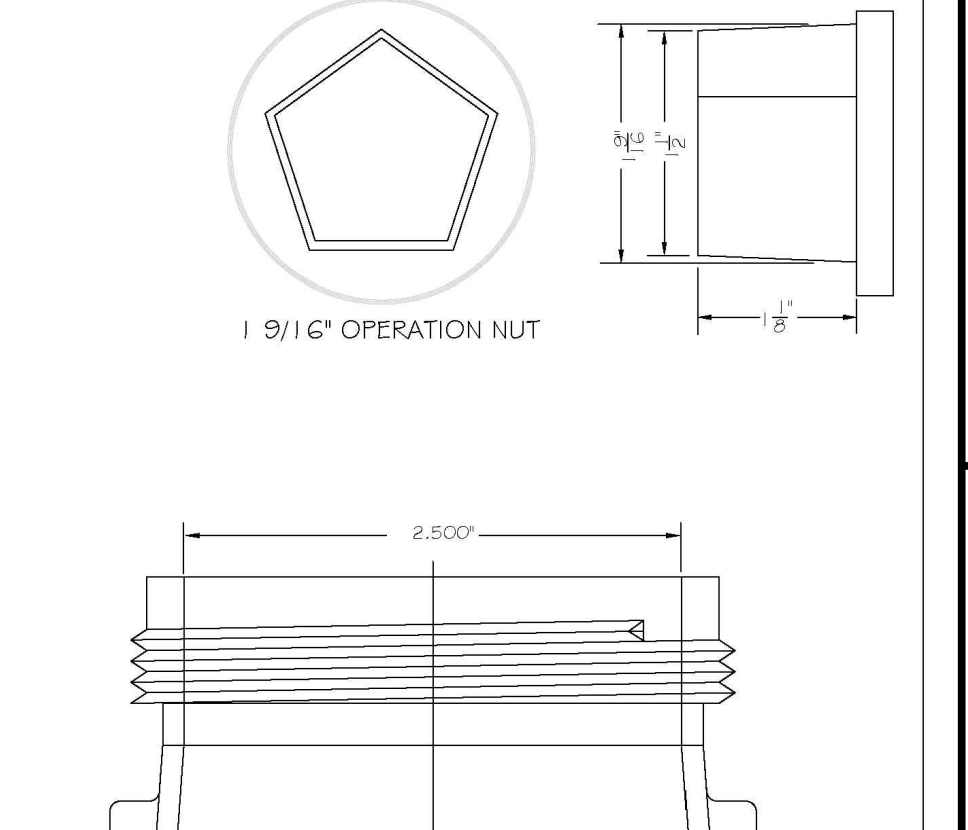


NOTES:  
 1. STEEL RODS AND BOLTS SHALL BE #4 HOT DIPPED GALVANIZED.  
 2. CONCRETE SHALL NOT CONTACT BOLTS OR ENDS OF MECHANICAL JOINT FITTINGS.  
 3. RESTRAINING MECHANICAL JOINTS TO BE USED AT ALL FITTINGS.  
 4. ALL BENDS AND INTERSECTIONS SHALL HAVE CONCRETE THRUST BLOCKING.  
 5. 3" MINIMUM COVER MUST BE MAINTAINED ON ALL WATER MAINS.

| CITY OF RALEIGH                |           | CITY OF RALEIGH                |           |
|--------------------------------|-----------|--------------------------------|-----------|
| DEPARTMENT OF PUBLIC UTILITIES |           | DEPARTMENT OF PUBLIC UTILITIES |           |
| STANDARD VERTICAL BEND         |           |                                |           |
| DWG. NO.                       | REVISIONS | DATE                           | REVISIONS |
| W-7                            | RRH       | 3-1-00                         | J.P.S.    |
|                                | D.W.C.    | 12-12-03                       |           |

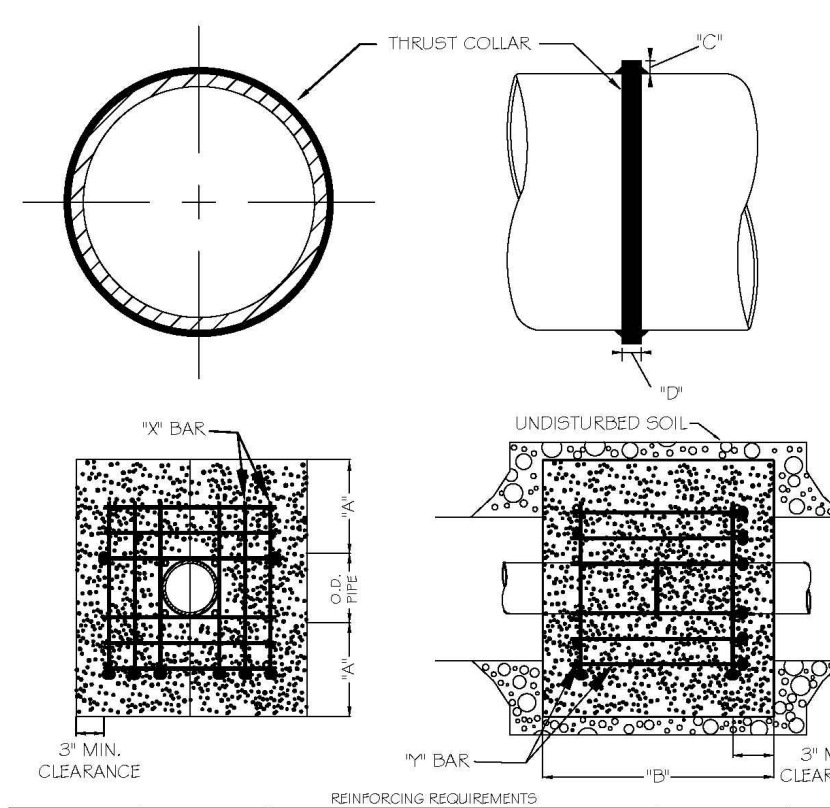


| CITY OF RALEIGH   |           | CITY OF RALEIGH                |           |
|---|-----------|--------------------------------|-----------|
| DEPARTMENT OF PUBLIC UTILITIES  |           | DEPARTMENT OF PUBLIC UTILITIES |           |
| STANDARD THRUST BLOCK INSTALLATION FOR 16" AND LARGER VALVES AND DEAD END MAINS |           |                                |           |
| DWG. NO.  | REVISIONS | DATE                           | REVISIONS |
| W-8   | RRH       | 3-1-00                         | J.P.S.    |
|   | D.W.C.    | 12-12-03                       |           |

NOTES:  
 1. SEE STANDARD DETAIL W-9 FOR THRUST BLOCK LOCATIONS.  
 2. CONCRETE SHALL BE 3000 PSI AND RANSIT MAND.  
 3. REINFORCING BARS SHALL BE DROPPED AND TIED TOGETHER.  
 4. TRENCH BOTTOM WIDTH IN VICINITY OF THRUST BLOCK INSTALLATION SHALL BE THE MINIMUM WIDTH AS SHOWN ON STANDARD DETAIL W-3.  
 5. BACKFILL TAMPED IN 6" LIFTS PER STANDARD DETAIL W-3.  
 6. THRUST COLLAR MUST BE FACTORY WELDED ON BOTH SIDES ALONG BOTH EDGES OF COLLAR AROUND CIRCUMFERENCE.

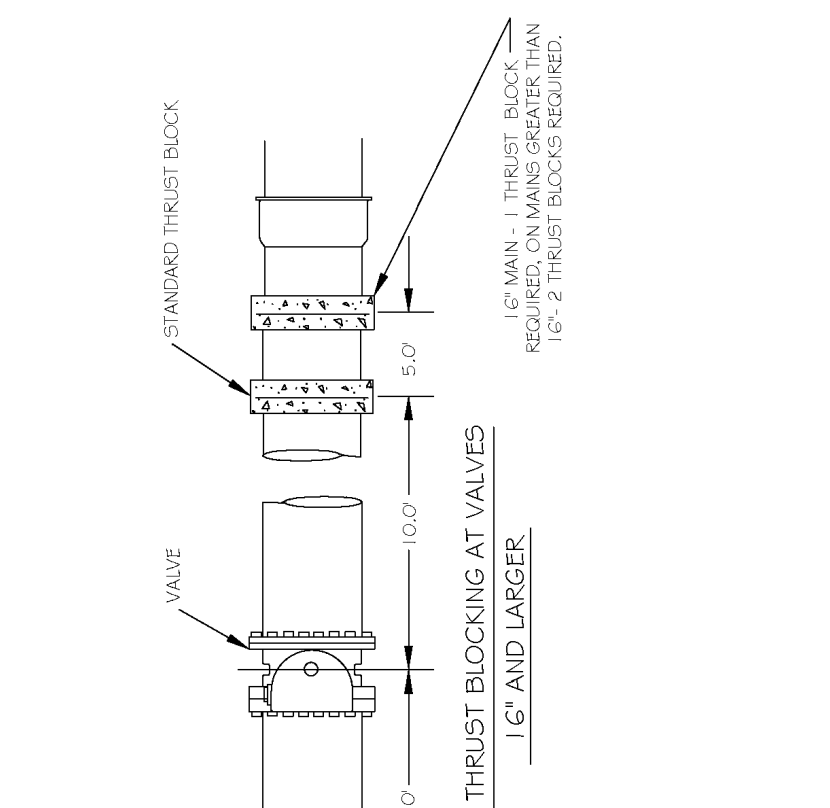

| CITY OF RALEIGH   |           | CITY OF RALEIGH                |           |
|---|-----------|--------------------------------|-----------|
| DEPARTMENT OF PUBLIC UTILITIES  |           | DEPARTMENT OF PUBLIC UTILITIES |           |
| STANDARD THRUST BLOCK INSTALLATION FOR 16" AND LARGER VALVES AND DEAD END MAINS |           |                                |           |
| DWG. NO.  | REVISIONS | DATE                           | REVISIONS |
| W-8   | RRH       | 3-1-00                         | J.P.S.    |
|   | D.W.C.    | 12-12-03                       |           |

NOTES:  
 1. SEE STANDARD DETAIL W-9 FOR THRUST BLOCK LOCATIONS.  
 2. CONCRETE SHALL BE 3000 PSI AND RANSIT MAND.  
 3. REINFORCING BARS SHALL BE DROPPED AND TIED TOGETHER.  
 4. TRENCH BOTTOM WIDTH IN VICINITY OF THRUST BLOCK INSTALLATION SHALL BE THE MINIMUM WIDTH AS SHOWN ON STANDARD DETAIL W-3.  
 5. BACKFILL TAMPED IN 6" LIFTS PER STANDARD DETAIL W-3.  
 6. THRUST COLLAR MUST BE FACTORY WELDED ON BOTH SIDES ALONG BOTH EDGES OF COLLAR AROUND CIRCUMFERENCE.

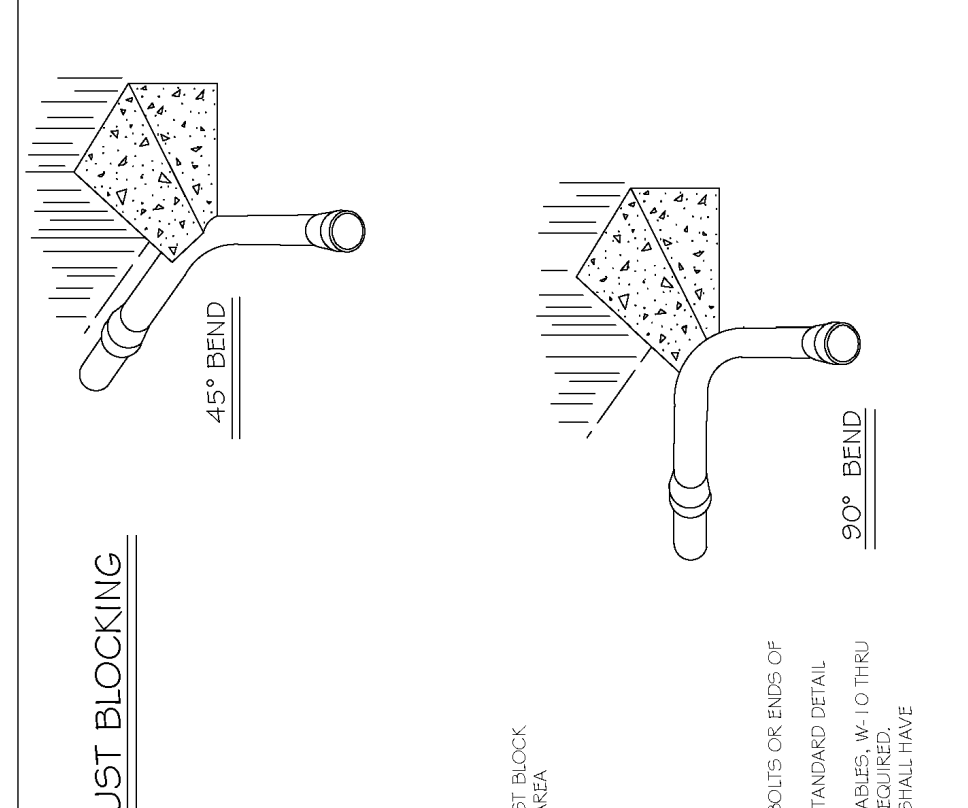

| CITY OF RALEIGH                       |           | CITY OF RALEIGH                |           |
|---------------------------------------|-----------|--------------------------------|-----------|
| DEPARTMENT OF PUBLIC UTILITIES        |           | DEPARTMENT OF PUBLIC UTILITIES |           |
| THRUST BLOCKING DESIGN QUANTITY TABLE |           |                                |           |
| DWG. NO.                              | REVISIONS | DATE                           | REVISIONS |
| W-9                                   | D.W.C.    | 3-7-99                         | D.H.L.    |
|                                       | D.W.C.    | 3-31-00                        |           |

NOTES:  
 1. POTABLE WATER MARKER TO BE BLUE IN COLOR.  
 2. POTABLE WATER MARKER TO BE LABELED "RALEIGH WATER".  
 3. TO BE SPACED ALONG CENTERLINE OF MAIN EVERY 300 FEET.  
 4. MARKERS TO BE ROUND AND 4" IN DIAMETER.

| CITY OF RALEIGH                       |           | CITY OF RALEIGH                |           |
|---------------------------------------|-----------|--------------------------------|-----------|
| DEPARTMENT OF PUBLIC UTILITIES        |           | DEPARTMENT OF PUBLIC UTILITIES |           |
| THRUST BLOCKING DESIGN QUANTITY TABLE |           |                                |           |
| DWG. NO.                              | REVISIONS | DATE                           | REVISIONS |
| W-10                                  | RRH       | 3-7-99                         | D.H.L.    |
|                                       | D.W.C.    | 3-31-00                        |           |


| CITY OF RALEIGH                       |           | CITY OF RALEIGH                |           |
|---------------------------------------|-----------|--------------------------------|-----------|
| DEPARTMENT OF PUBLIC UTILITIES        |           | DEPARTMENT OF PUBLIC UTILITIES |           |
| THRUST BLOCKING DESIGN QUANTITY TABLE |           |                                |           |
| DWG. NO.                              | REVISIONS | DATE                           | REVISIONS |
| W-10                                  | RRH       | 3-7-99                         | D.H.L.    |
|                                       | D.W.C.    | 3-31-00                        |           |

NOTES:  
 1. POTABLE WATER MARKER TO BE BLUE IN COLOR.  
 2. POTABLE WATER MARKER TO BE LABELED "RALEIGH WATER".  
 3. TO BE SPACED ALONG CENTERLINE OF MAIN EVERY 300 FEET.  
 4. MARKERS TO BE ROUND AND 4" IN DIAMETER.

| CITY OF RALEIGH                       |           | CITY OF RALEIGH                |           |
|---------------------------------------|-----------|--------------------------------|-----------|
| DEPARTMENT OF PUBLIC UTILITIES        |           | DEPARTMENT OF PUBLIC UTILITIES |           |
| THRUST BLOCKING DESIGN QUANTITY TABLE |           |                                |           |
| DWG. NO.                              | REVISIONS | DATE                           | REVISIONS |
| W-11                                  | RRH       | 3-1-07                         | ARR       |
|                                       | D.W.C.    | 3-31-00                        |           |

| CITY OF RALEIGH                       |           | CITY OF RALEIGH                |           |
|---------------------------------------|-----------|--------------------------------|-----------|
| DEPARTMENT OF PUBLIC UTILITIES        |           | DEPARTMENT OF PUBLIC UTILITIES |           |
| THRUST BLOCKING DESIGN QUANTITY TABLE |           |                                |           |
| DWG. NO.                              | REVISIONS | DATE                           | REVISIONS |
| W-11                                  | RRH       | 3-1-07                         | ARR       |
|                                       | D.W.C.    | 3-31-00                        |           |

NOTES:  
 1. CONCRETE SHALL NOT CONTACT BOLTS OR ENDS OF MECHANICAL JOINT FITTINGS.  
 2. USE STANDARD REACTION BLOCK TABLES, W-10 AND W-11 FOR AREA OF CONCRETE REQUIRED.

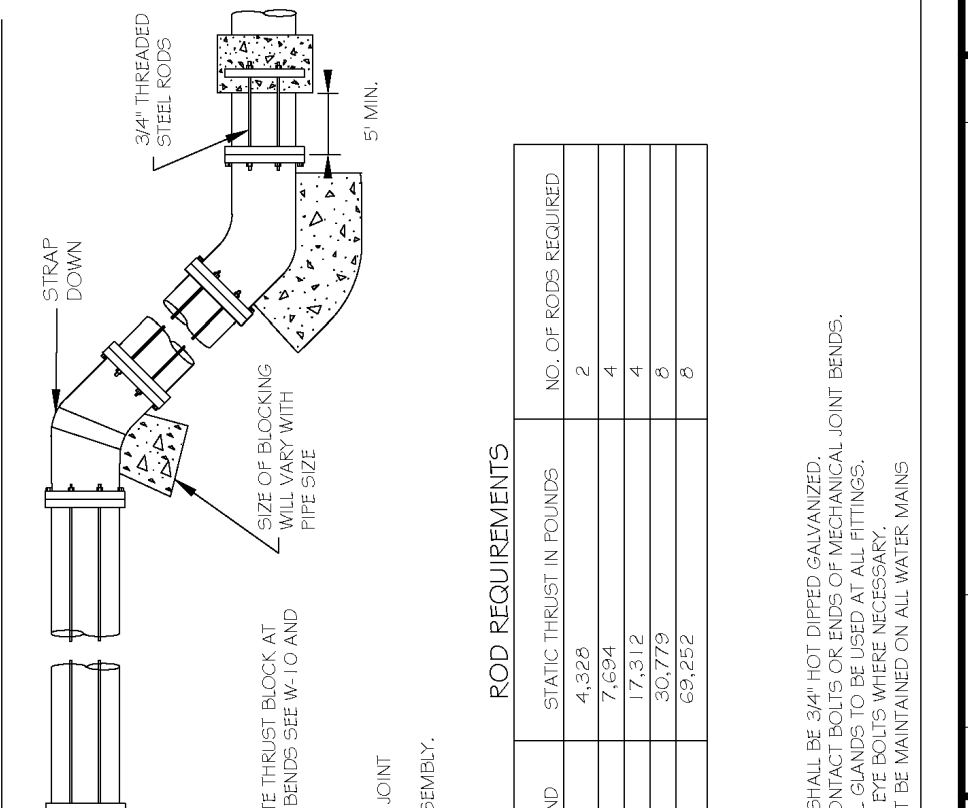

| CITY OF RALEIGH                |           | CITY OF RALEIGH                |           |
|--------------------------------|-----------|--------------------------------|-----------|
| DEPARTMENT OF PUBLIC UTILITIES |           | DEPARTMENT OF PUBLIC UTILITIES |           |
| STANDARD VERTICAL BEND         |           |                                |           |
| DWG. NO.                       | REVISIONS | DATE                           | REVISIONS |
| W-12                           | RRH       | 3-1-00                         | J.P.S.    |
|                                | D.H.L.    | 12-12-03                       |           |

NOTES:  
 1. CONCRETE SHALL NOT CONTACT BOLTS OR ENDS OF MECHANICAL JOINT FITTINGS.  
 2. USE STANDARD REACTION BLOCK TABLES, W-10 AND W-11 FOR AREA OF CONCRETE REQUIRED.



| CITY OF RALEIGH   |           | CITY OF RALEIGH                |           |
|---|-----------|--------------------------------|-----------|
| DEPARTMENT OF PUBLIC UTILITIES  |           | DEPARTMENT OF PUBLIC UTILITIES |           |
| STANDARD MAIN 4" VALVE MARKERS FOR POTABLE & REUSE WATER IN EASEMENTS |           |                                |           |
| DWG. NO.  | REVISIONS | DATE                           | REVISIONS |
| W-13  | RRH       | 3-7-99                         | D.H.L.    |
|   | D.W.C.    | 3-31-00                        |           |

NOTES:  
 1. POTABLE WATER MARKER TO BE BLUE IN COLOR.  
 2. POTABLE WATER MARKER TO BE LABELED "RALEIGH WATER".  
 3. TO BE SPACED ALONG CENTERLINE OF MAIN EVERY 300 FEET.  
 4. MARKERS TO BE ROUND AND 4" IN DIAMETER.




| CITY OF RALEIGH   |           | CITY OF RALEIGH                |           |
|---|-----------|--------------------------------|-----------|
| DEPARTMENT OF PUBLIC UTILITIES  |           | DEPARTMENT OF PUBLIC UTILITIES |           |
| STANDARD MAIN 4" VALVE MARKERS FOR POTABLE & REUSE WATER IN EASEMENTS |           |                                |           |
| DWG. NO.  | REVISIONS | DATE                           | REVISIONS |
| W-13  | RRH       | 3-7-99                         | D.H.L.    |
|   | D.W.C.    | 3-31-00                        |           |

NOTES:  
 1. POTABLE WATER MARKER TO BE BLUE IN COLOR.  
 2. POTABLE WATER MARKER TO BE LABELED "RALEIGH WATER".  
 3. TO BE SPACED ALONG CENTERLINE OF MAIN EVERY 300 FEET.  
 4. MARKERS TO BE ROUND AND 4" IN DIAMETER.




| CITY OF RALEIGH   |           | CITY OF RALEIGH                |           |
|---|-----------|--------------------------------|-----------|
| DEPARTMENT OF PUBLIC UTILITIES  |           | DEPARTMENT OF PUBLIC UTILITIES |           |
| STANDARD MAIN 4" VALVE MARKERS FOR POTABLE & REUSE WATER IN EASEMENTS |           |                                |           |
| DWG. NO.  | REVISIONS | DATE                           | REVISIONS |
| W-13  | RRH       | 3-7-99                         | D.H.L.    |
|   | D.W.C.    | 3-31-00                        |           |

NOTES:  
 1. POTABLE WATER MARKER TO BE BLUE IN COLOR.  
 2. POTABLE WATER MARKER TO BE LABELED "RALEIGH WATER".  
 3. TO BE SPACED ALONG CENTERLINE OF MAIN EVERY 300 FEET.  
 4. MARKERS TO BE ROUND AND 4" IN DIAMETER.

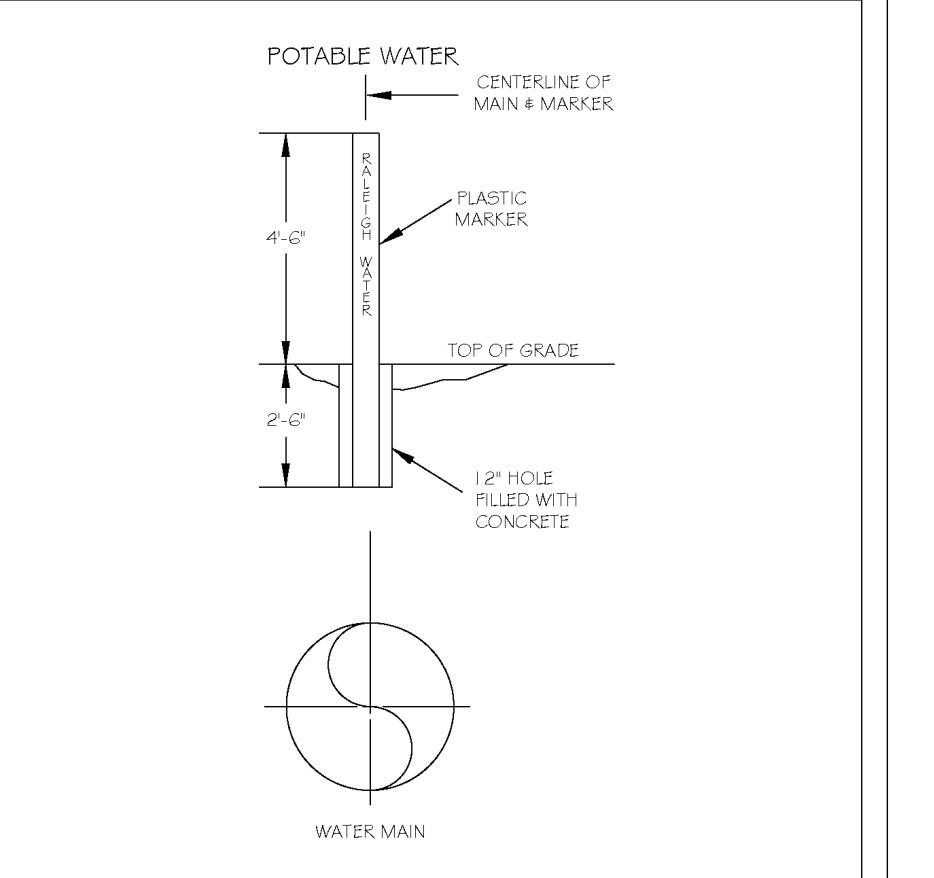

| CITY OF RALEIGH   |           | CITY OF RALEIGH                |           |
|---|-----------|--------------------------------|-----------|
| DEPARTMENT OF PUBLIC UTILITIES  |           | DEPARTMENT OF PUBLIC UTILITIES |           |
| STANDARD MAIN 4" VALVE MARKERS FOR POTABLE & REUSE WATER IN EASEMENTS |           |                                |           |
| DWG. NO.  | REVISIONS | DATE                           | REVISIONS |
| W-13  | RRH       | 3-7-99                         | D.H.L.    |
|   | D.W.C.    | 3-31-00                        |           |

NOTES:  
 1. POTABLE WATER MARKER TO BE BLUE IN COLOR.  
 2. POTABLE WATER MARKER TO BE LABELED "RALEIGH WATER".  
 3. TO BE SPACED ALONG CENTERLINE OF MAIN EVERY 300 FEET.  
 4. MARKERS TO BE ROUND AND 4" IN DIAMETER.

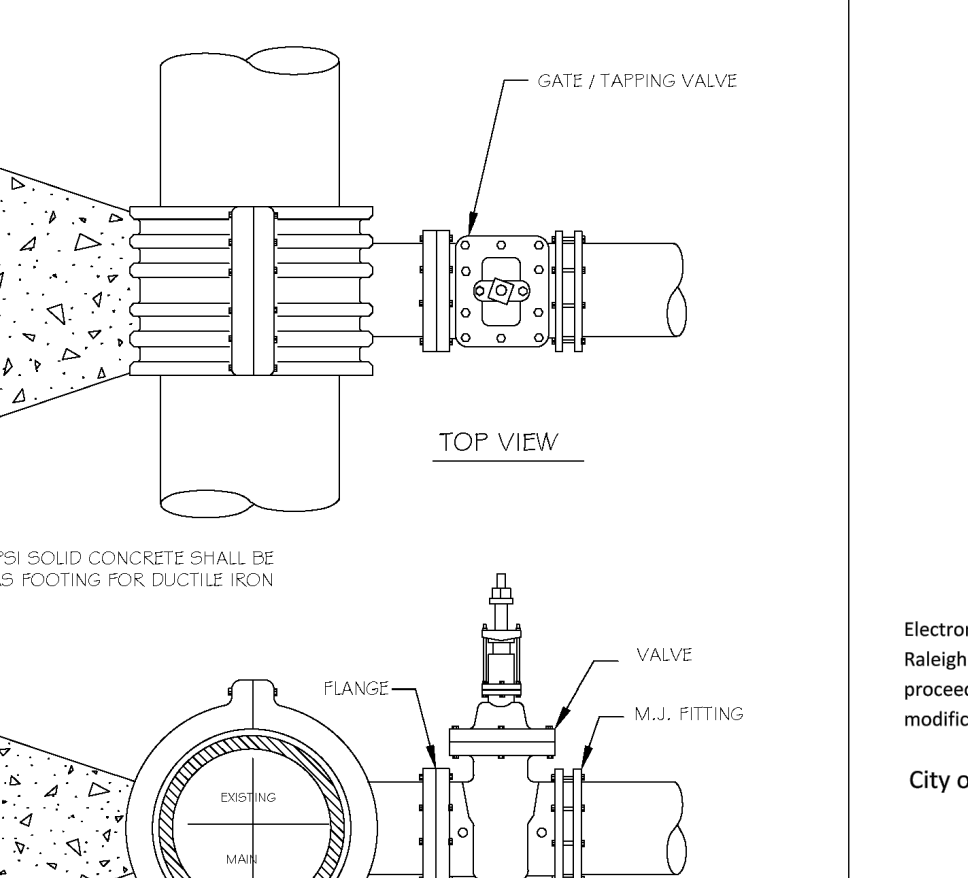

| CITY OF RALEIGH   |           | CITY OF RALEIGH                |           |
|---|-----------|--------------------------------|-----------|
| DEPARTMENT OF PUBLIC UTILITIES  |           | DEPARTMENT OF PUBLIC UTILITIES |           |
| STANDARD MAIN 4" VALVE MARKERS FOR POTABLE & REUSE WATER IN EASEMENTS |           |                                |           |
| DWG. NO.  | REVISIONS | DATE                           | REVISIONS |
| W-14  | Y.C.A.    | 2-31-09                        | RRH       |
|   | D.W.C.    | 3-7-99                         | J.P.S.    |

NOTES:  
 1. CONCRETE SHALL NOT CONTACT BOLTS OR ENDS OF MECHANICAL JOINT FITTINGS.  
 2. USE STANDARD REACTION BLOCK TABLES, W-10 AND W-11 FOR AREA OF CONCRETE REQUIRED.



| CITY OF RALEIGH   |           | CITY OF RALEIGH                |           |
|---|-----------|--------------------------------|-----------|
| DEPARTMENT OF PUBLIC UTILITIES  |           | DEPARTMENT OF PUBLIC UTILITIES |           |
| STANDARD MAIN 4" VALVE MARKERS FOR POTABLE & REUSE WATER IN EASEMENTS |           |                                |           |
| DWG. NO.  | REVISIONS | DATE                           | REVISIONS |
| W-14  | Y.C.A.    | 2-31-09                        | RRH       |
|   | D.W.C.    | 3-7-99                         | J.P.S.    |

NOTES:  
 1. CONCRETE SHALL NOT CONTACT BOLTS OR ENDS OF MECHANICAL JOINT FITTINGS.  
 2. USE STANDARD REACTION BLOCK TABLES, W-10 AND W-11 FOR AREA OF CONCRETE REQUIRED.

**BASS, NIXON & KENNEDY, INC.**  
**CONSULTING ENGINEERS**  
 6810 CHAPEL HILL ROAD, SUITE 250, RALEIGH, NC 27607  
 TELEPHONE: (919)881-4122 FAX: (919)881-6888  
 CERTIFICATION NUMBERS: NCBELS (C-0110); NCBOLA (C-0267)

| NO. | DATE | DESCRIPTION | BY |
|-----|------|-------------|----|
|     |      |             |    |
|     |      |             |    |

PROGRESS DATE DRAWN BY

03-19-17

SCALE: N.T.S.

CHK BY: MDB

DETAILS












COBBLESTONE VILLAGE MIXED USE DEVELOPMENT

TOWN OF ROLESVILLE, WAKE COUNTY, NORTH CAROLINA

NOT RELEASED FOR CONSTRUCTION OR BID SOLICITATION

SHEET C5.4

TOWN OF ROLESVILLE PROJECT NO.

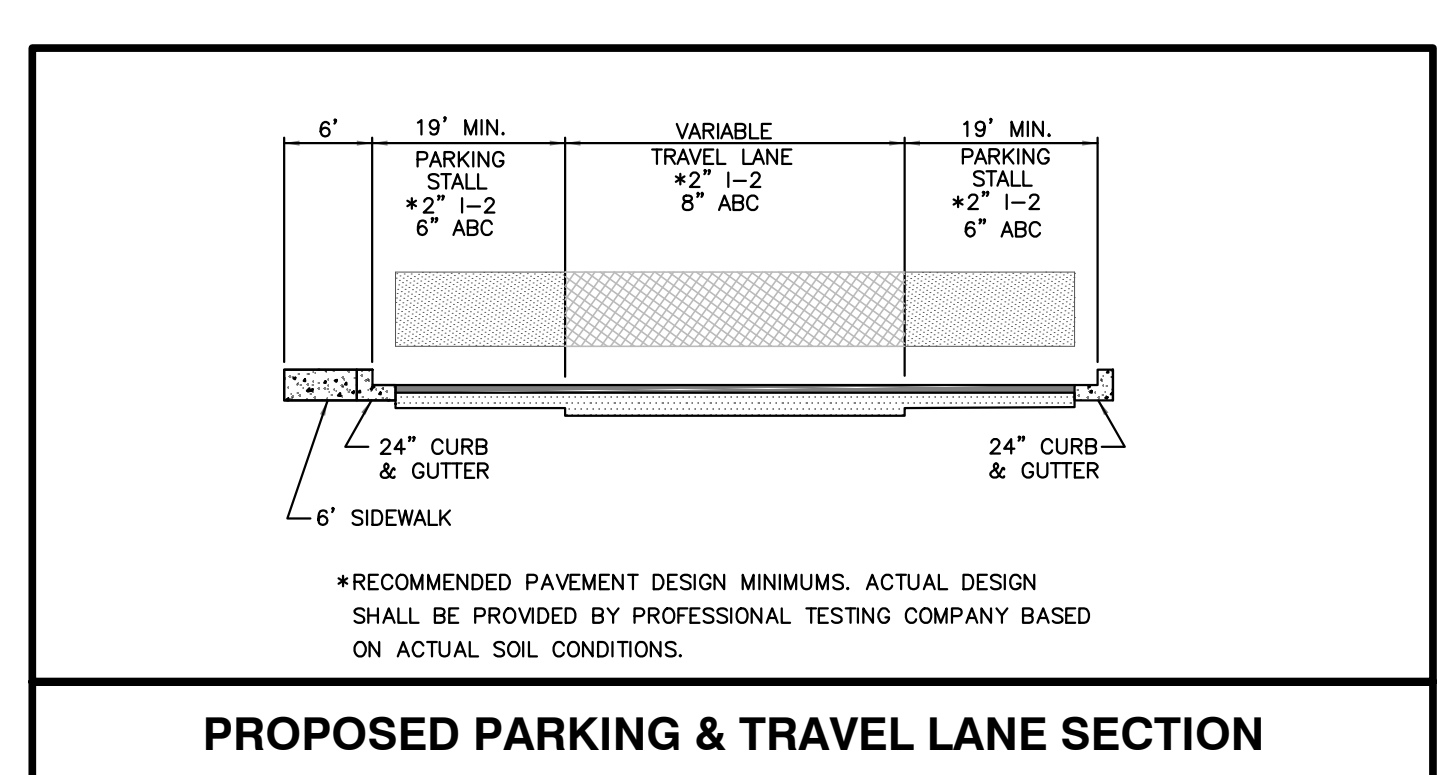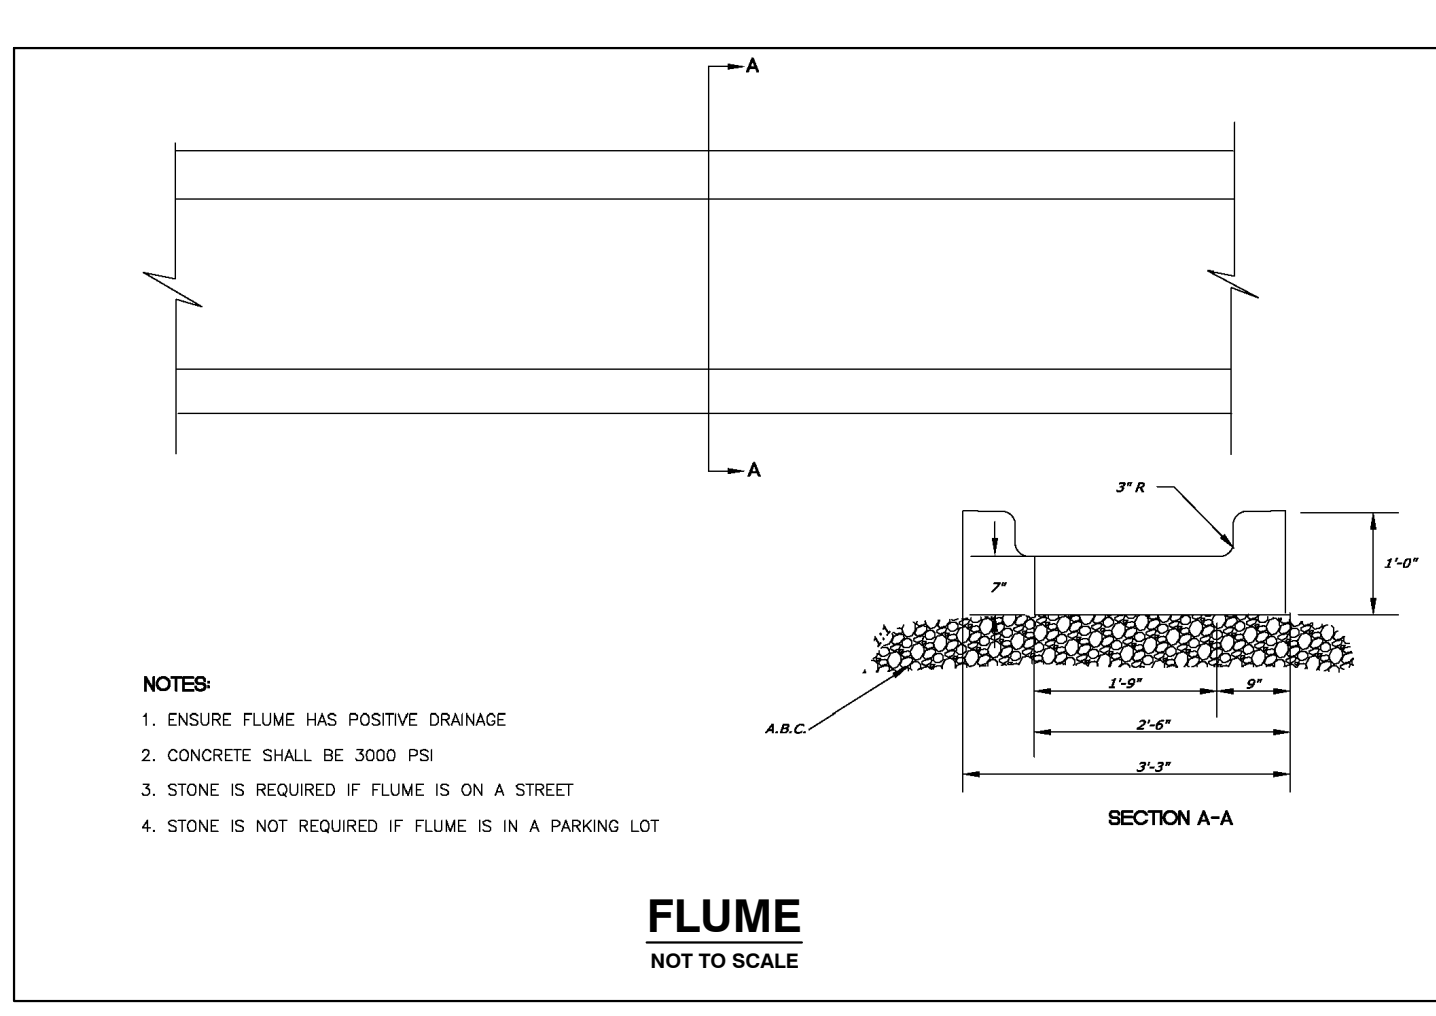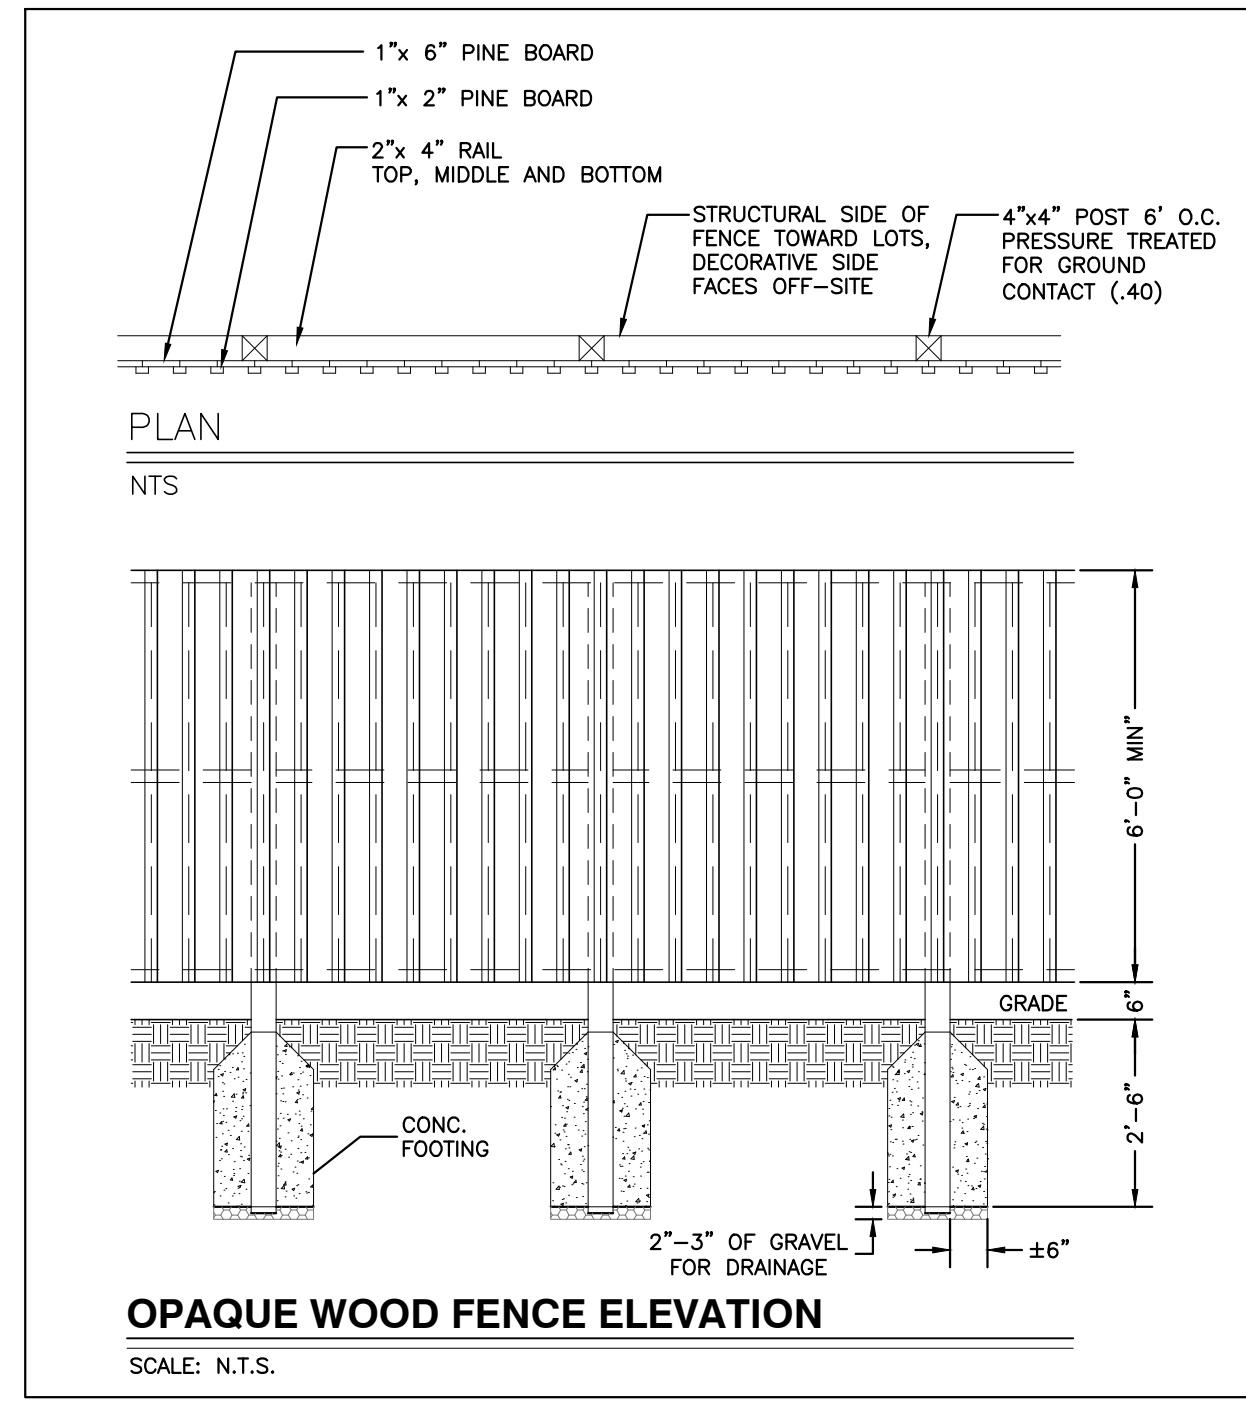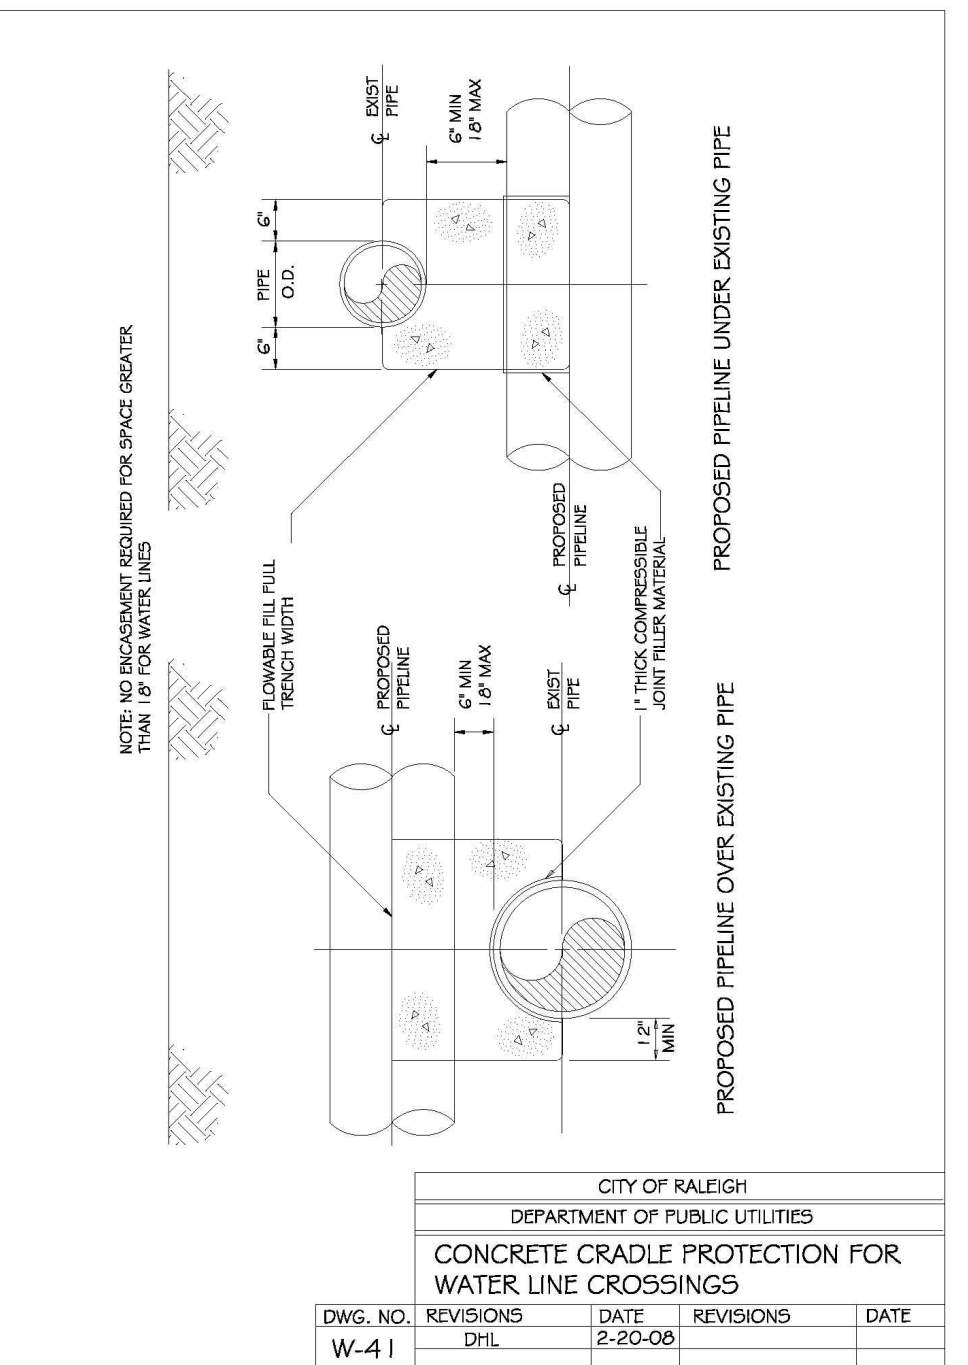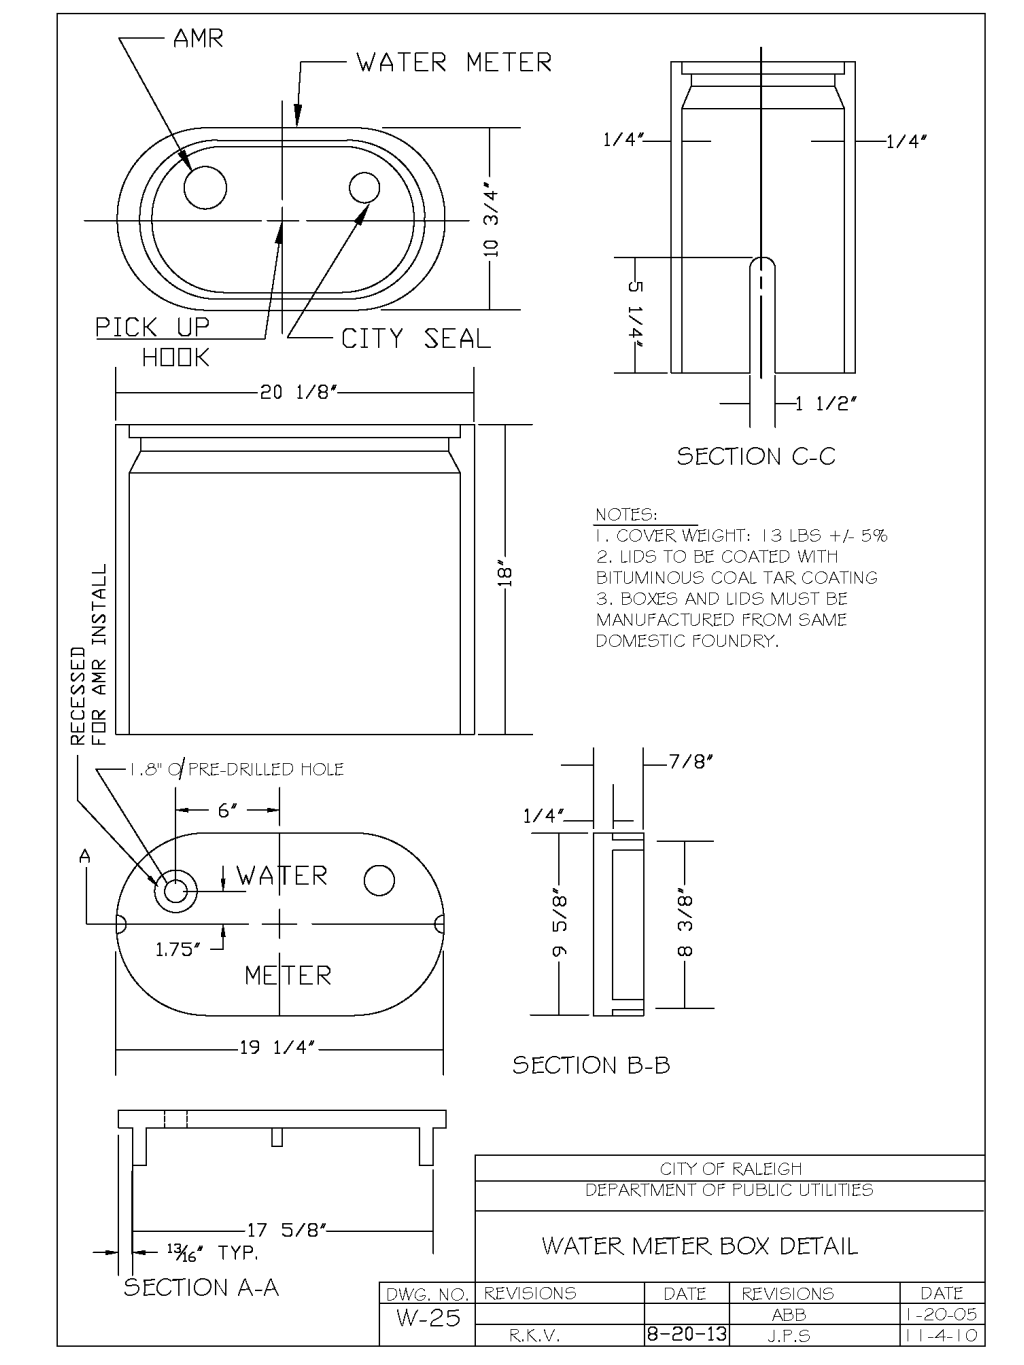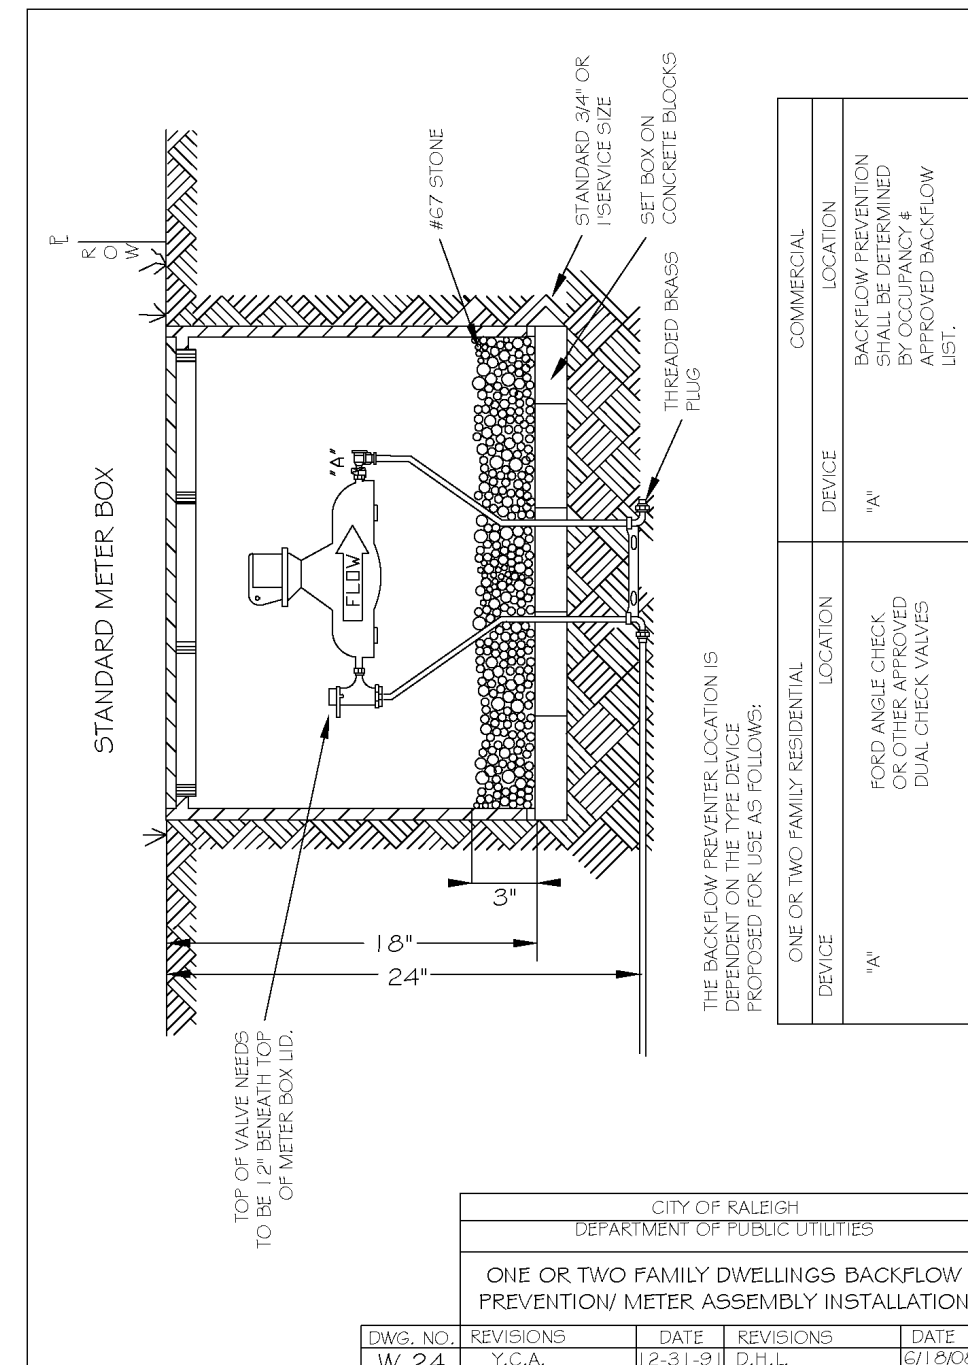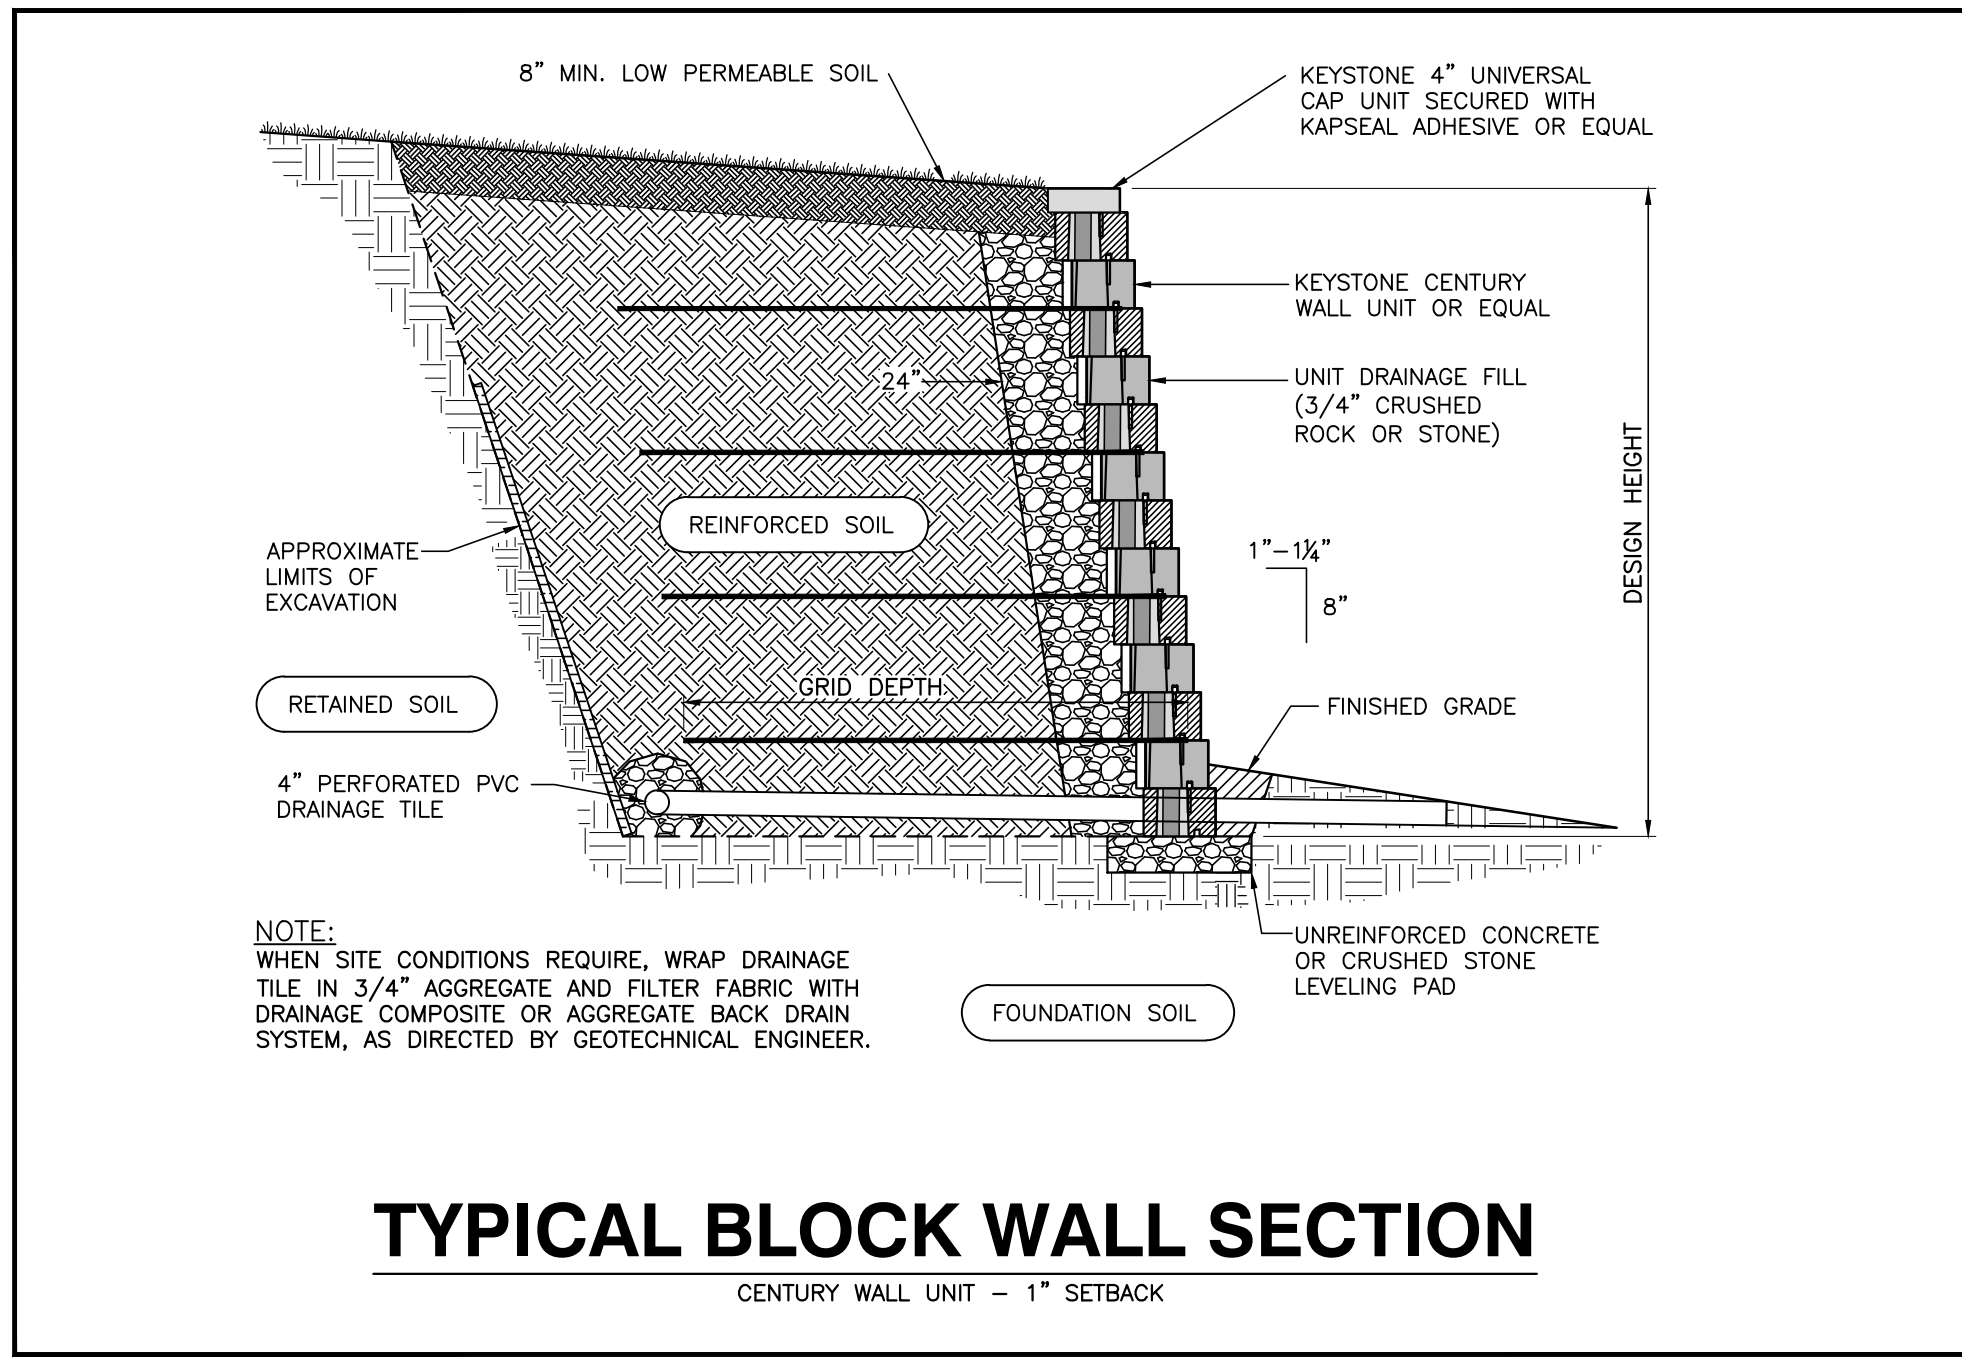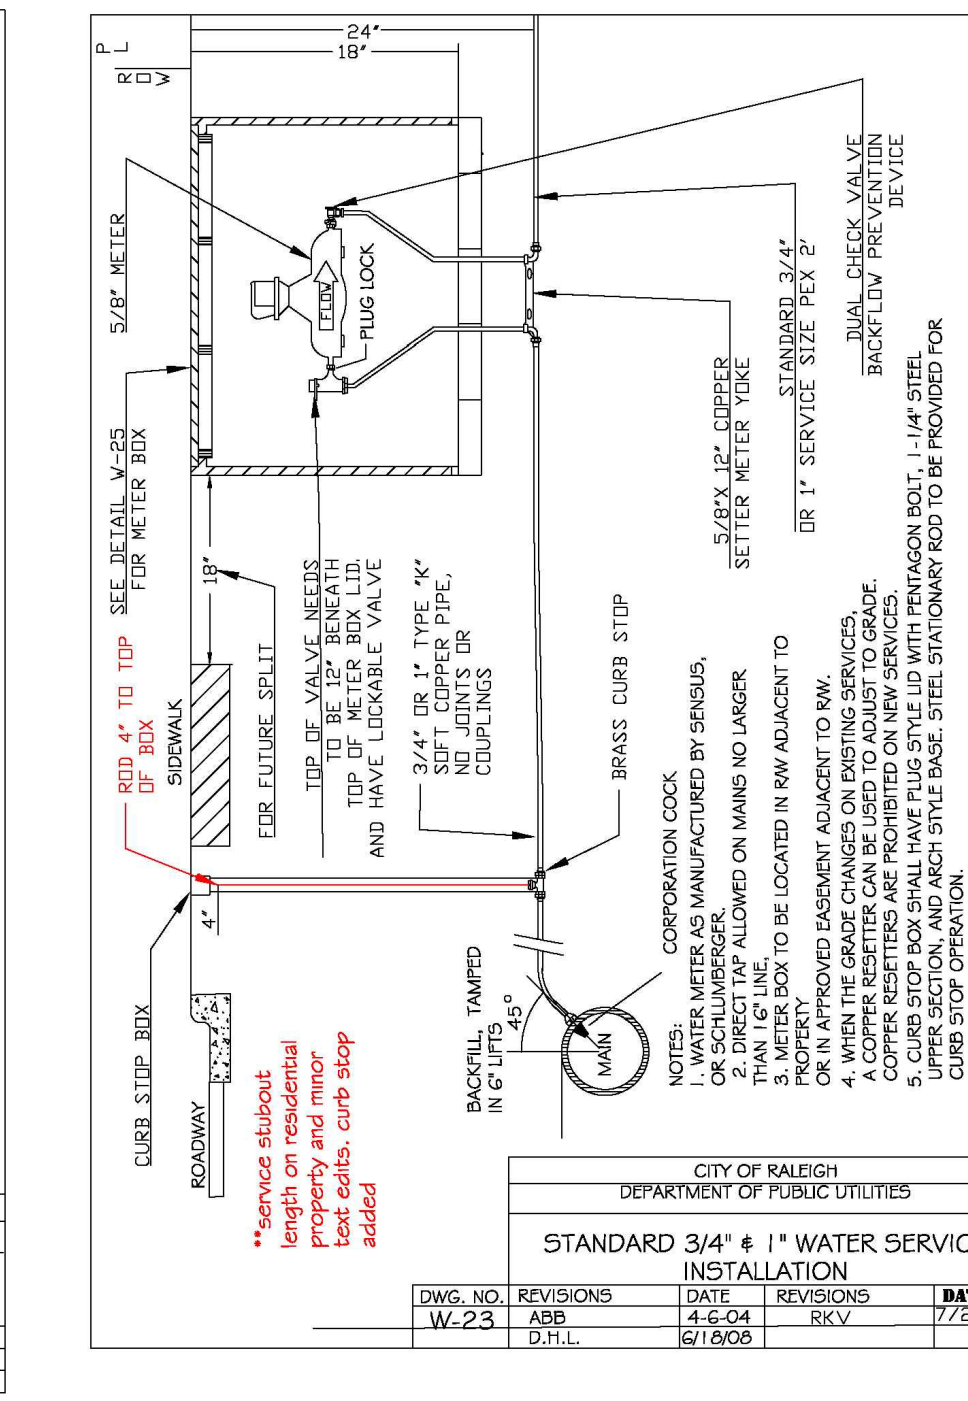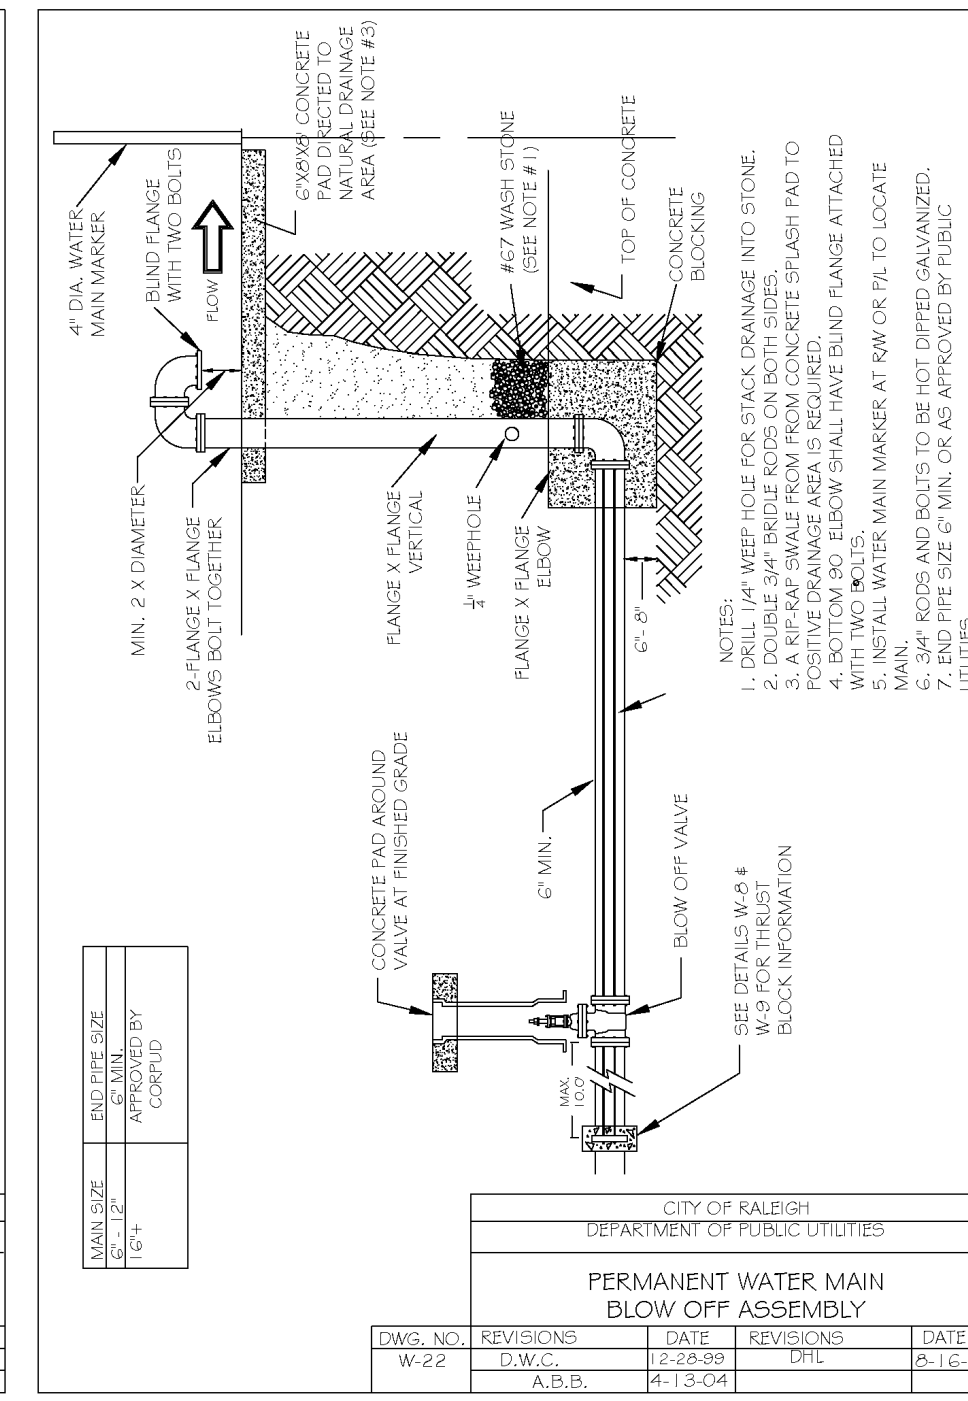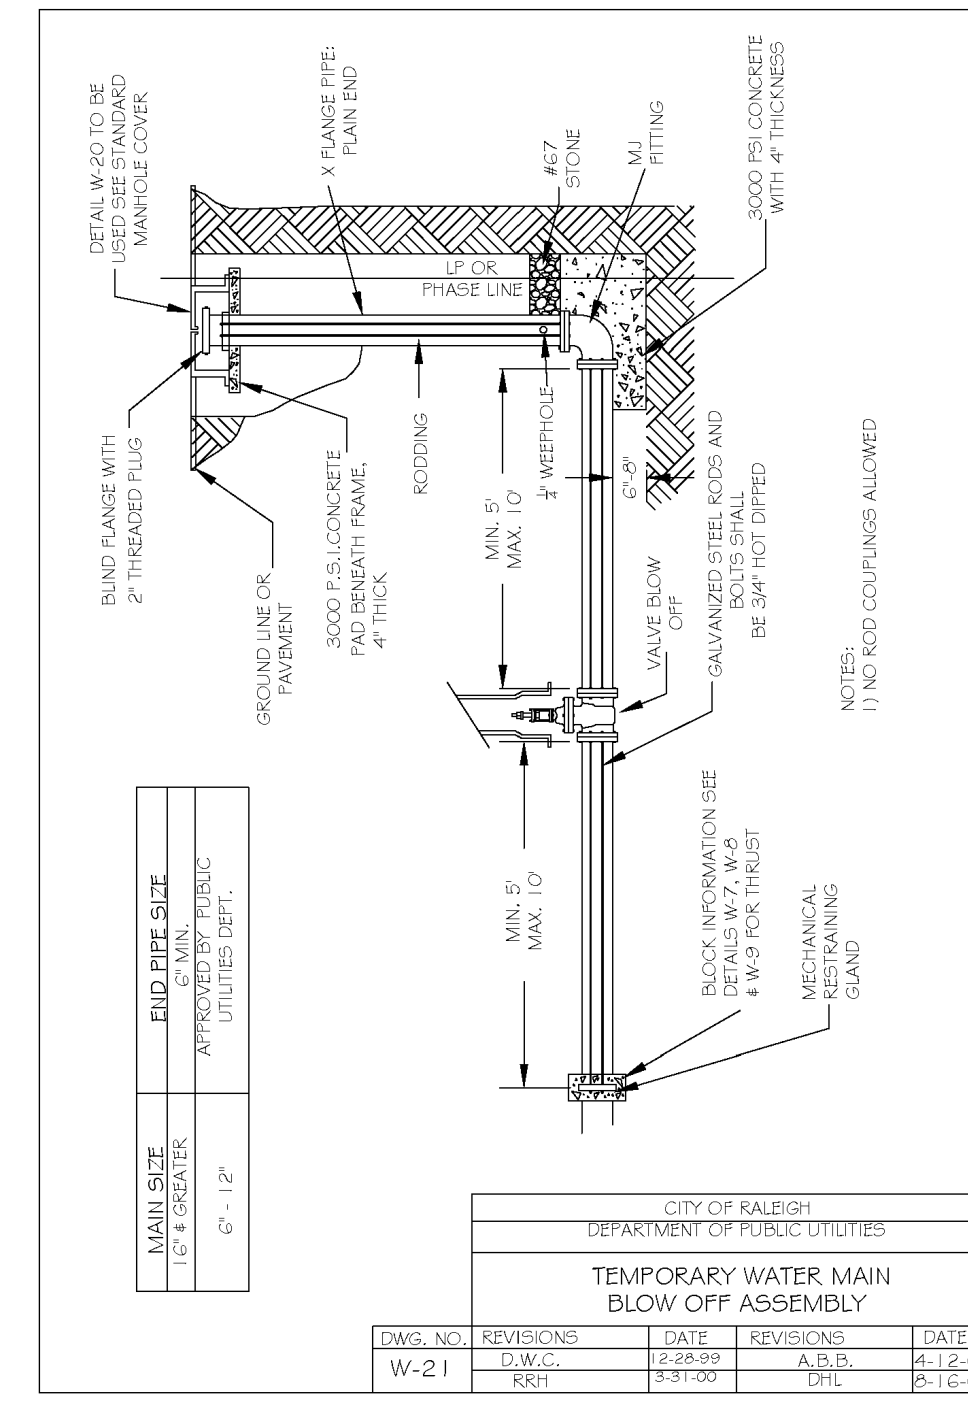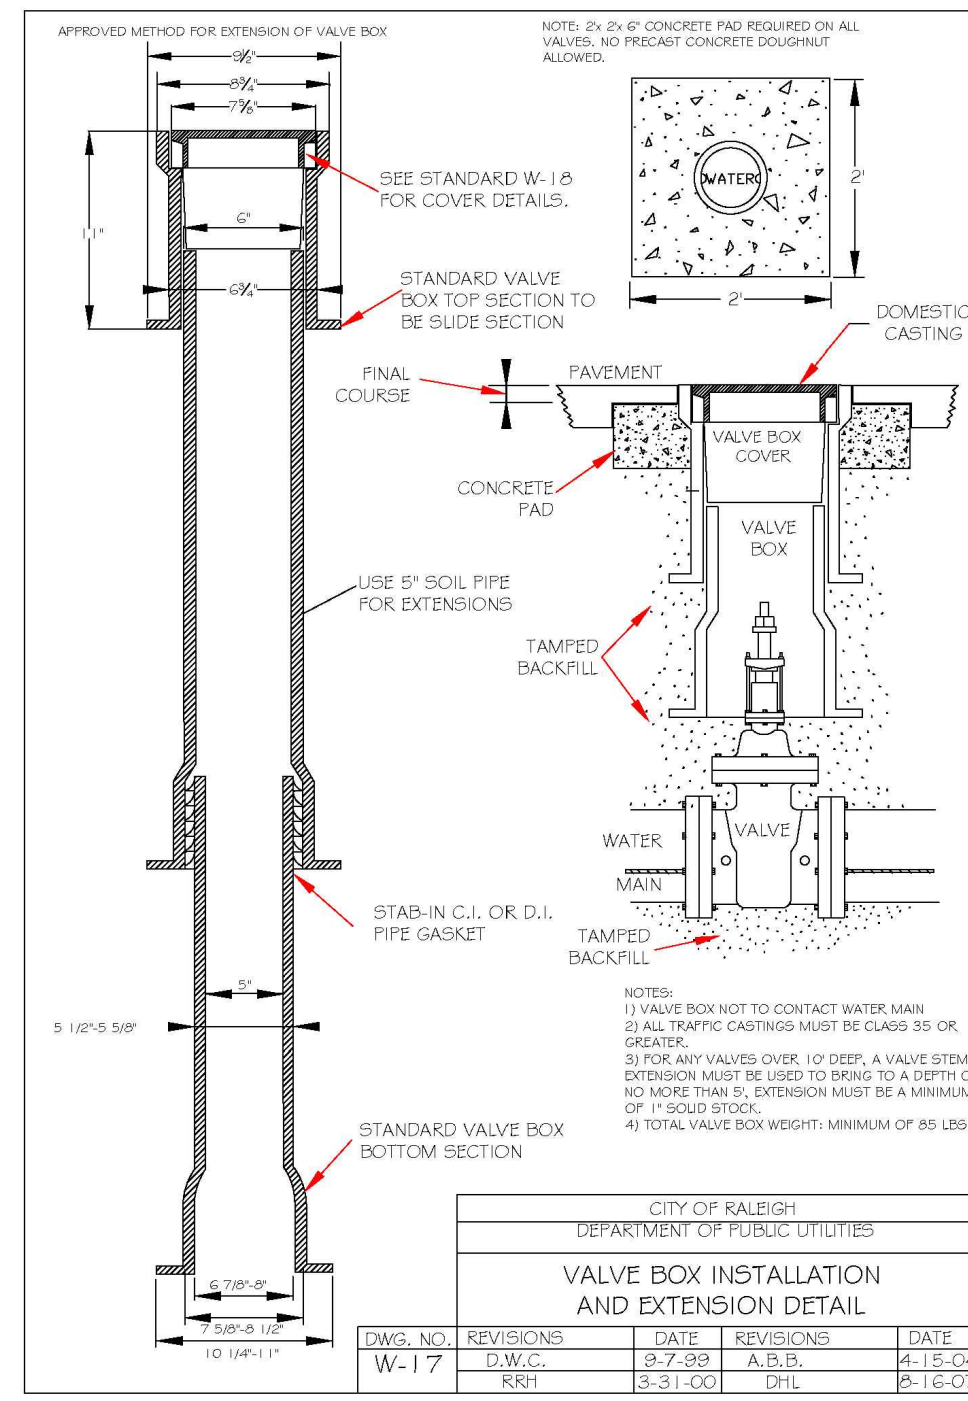

CITY OF RALEIGH - PLANS AUTHORIZED FOR CONSTRUCTION

Electronic Approval: This approval is being issued electronically. This approval is valid only upon the signature of a City of Raleigh Review Officer below. The City will retain a copy of the approved plans. Any work authorized by this approval must proceed in accordance with the plans kept on file with the City. This electronic approval may not be edited once issued. Any modification to this approval once issued will invalidate this approval.

City of Raleigh Development Approval \_\_\_\_\_

Raleigh Water Review Officer \_\_\_\_\_



**BASS, NIXON & KENNEDY, INC.**  
CONSULTING ENGINEERS  
6810 CHASE HILL ROAD, SUITE 250, RALEIGH, NC 27607  
TELEPHONE: (919)881-4242 FAX: (919)851-8686  
CERTIFICATION NUMBERS: NCBELS (C-0110); NCBOLA (C-0267)

| PROGRESS | DATE | BY       | DESCRIPTION | NO. | DATE | BY |
|----------|------|----------|-------------|-----|------|----|
| 03-1917  |      | M.R.M.   |             |     |      |    |
| JOB NO.  |      | DRAWN BY | DETAILS     |     |      |    |
|          |      | SCALE:   | N.T.S.      |     |      |    |
|          |      | CHK BY:  | MDB         |     |      |    |

**COBBLESTONE VILLAGE**  
MIXED USE DEVELOPMENT  
TOWN OF ROLESVILLE, WAKE COUNTY, NORTH CAROLINA

SHEET C5.5

TOWN OF ROLESVILLE PROJECT NO.