

ALL CONSTRUCTION SHALL BE IN ACCORDANCE WITH CURRENT TOWN OF ROLESVILLE STANDARDS AND SPECIFICATIONS

SYMBOLS AND ABBREVIATIONS

| | | | |
|--------|-----------------------------|---|---|
| ABC | AGGREGATE BASE COURSE | — | EXISTING CURB INLET |
| ALUM | ALUMINUM | □ | EXISTING GRATE INLET/YARD INLET |
| AST2 | ALUMINIZED STEEL - TYPE 2 | — | EXISTING FLARED END SECTION |
| B-B | BACK TO BACK | ⊕ | EXISTING FIRE HYDRANT |
| BOA | BLOW-OFF ASSEMBLY | — | EXISTING BLOW-OFF ASSEMBLY |
| C&G | CURB AND GUTTER | — | EXISTING GATE VALVE |
| CFS | CUBIC FEET PER SECOND | — | EXISTING REDUCER |
| CI | CURB INLET | — | EXISTING WATER METER |
| CL | CENTER LINE | — | EXISTING SAN SEWER MANHOLE |
| CMP | CORRUGATED METAL PIPE | — | EXISTING CLEAN OUT |
| CO | CLEAN OUT | — | EXISTING POWER POLE |
| COM | COMMUNICATION | — | EXISTING TELEPHONE PEDESTAL |
| CONC | CONCRETE | — | EXISTING AREA LIGHT |
| DCV | DOUBLE CHECK VALVE | — | EXISTING SIGN |
| DDCV | DOUBLE DETECTOR CHECK VALVE | — | NEW CURB INLET |
| DI | DROP INLET | — | NEW GRATE INLET/YARD INLET |
| DIP | DUCTILE IRON PIPE | — | NEW FLARED END SECTION |
| EASE | EASEMENT | — | NEW FIRE HYDRANT |
| ELEC | ELECTRIC | — | NEW BLOW-OFF ASSEMBLY |
| EX | EXISTING | — | NEW GATE VALVE |
| FES | FLARED END SECTION | — | NEW REDUCER |
| FH | FIRE HYDRANT | — | NEW WATER METER |
| FM | FORCE MAIN | — | NEW TEE |
| FT | FEET | — | NEW FLUG |
| FT/SEC | FEET PER SEC | — | NEW MANHOLE |
| GALV | GALVANIZED | — | NEW CLEAN OUT |
| GV | GATE VALVE | — | NEW SIGN |
| HDPE | HIGH DENSITY POLYETHYLENE | — | IRON PIPE |
| L | LENGTH | — | BENCHMARK |
| LF | LINEAR FEET | — | TEMP SILT FENCE |
| MH | MANHOLE | — | TEMP TREE PROTECTION FENCE |
| PAVE | PAVEMENT | — | TEMP COMBINATION SILT/TREE PROTECTION FENCE |
| PE | FINISHED PAD ELEVATION | — | TEMP DIVERSION DITCH |
| PP | POWER POLE | — | DISTURBED LIMITS |
| PVC | POLYVINYL CHLORIDE | — | STREAM |
| R | RADIUS | — | EXISTING GAS LINE |
| R/W | RIGHT-OF-WAY | — | EXISTING COMMUNICATIONS LINE |
| RED | REDUCER | — | EXISTING UNDERGROUND TELEPHONE |
| RCP | REINFORCED CONCRETE PIPE | — | EXISTING UNDERGROUND ELECTRIC |
| RPZ | REDUCED PRESSURE ZONE | — | EXISTING OVERHEAD ELECTRIC |
| SS | SANITARY SEWER | — | EXISTING WATER LINE |
| STA | STATION | — | EXISTING SANITARY SEWER FORCE MAIN |
| TDD | TEMPORARY DIVERSION DITCH | — | EXISTING SANITARY SEWER |
| TELE | TELEPHONE | — | EXISTING STORM DRAINAGE |
| TSB | TEMPORARY SEDIMENT BASIN | — | NEW STORM DRAINAGE |
| UG | UNDERGROUND | — | NEW WATER LINE |
| WCR | WHEELCHAIR RAMP | — | NEW SANITARY SEWER |
| W/L | WATER LINE | — | NEW SANITARY SEWER FORCE MAIN |
| WM | WATER METER | — | NEW GAS MAIN |
| YI | YARD INLET | — | HANDICAPPED ACCESSIBLE ROUTE |

NOTE: ALL CONSTRUCTION ACTIVITY MUST BE IN ACCORDANCE WITH THE ACCEPTED POLICIES OF THE TOWN OF ROLESVILLE AND NCDOT

SP21-01

COBBLESTONE VILLAGE


MIXED USE DEVELOPMENT

TOWN OF ROLESVILLE, WAKE COUNTY, NORTH CAROLINA

CONSTRUCTION DRAWINGS

TOWN OF ROLESVILLE PROJECT NO. CUP-SB-21-01

SITE PLAN APPLICATION NO. CUP-SB-21-01

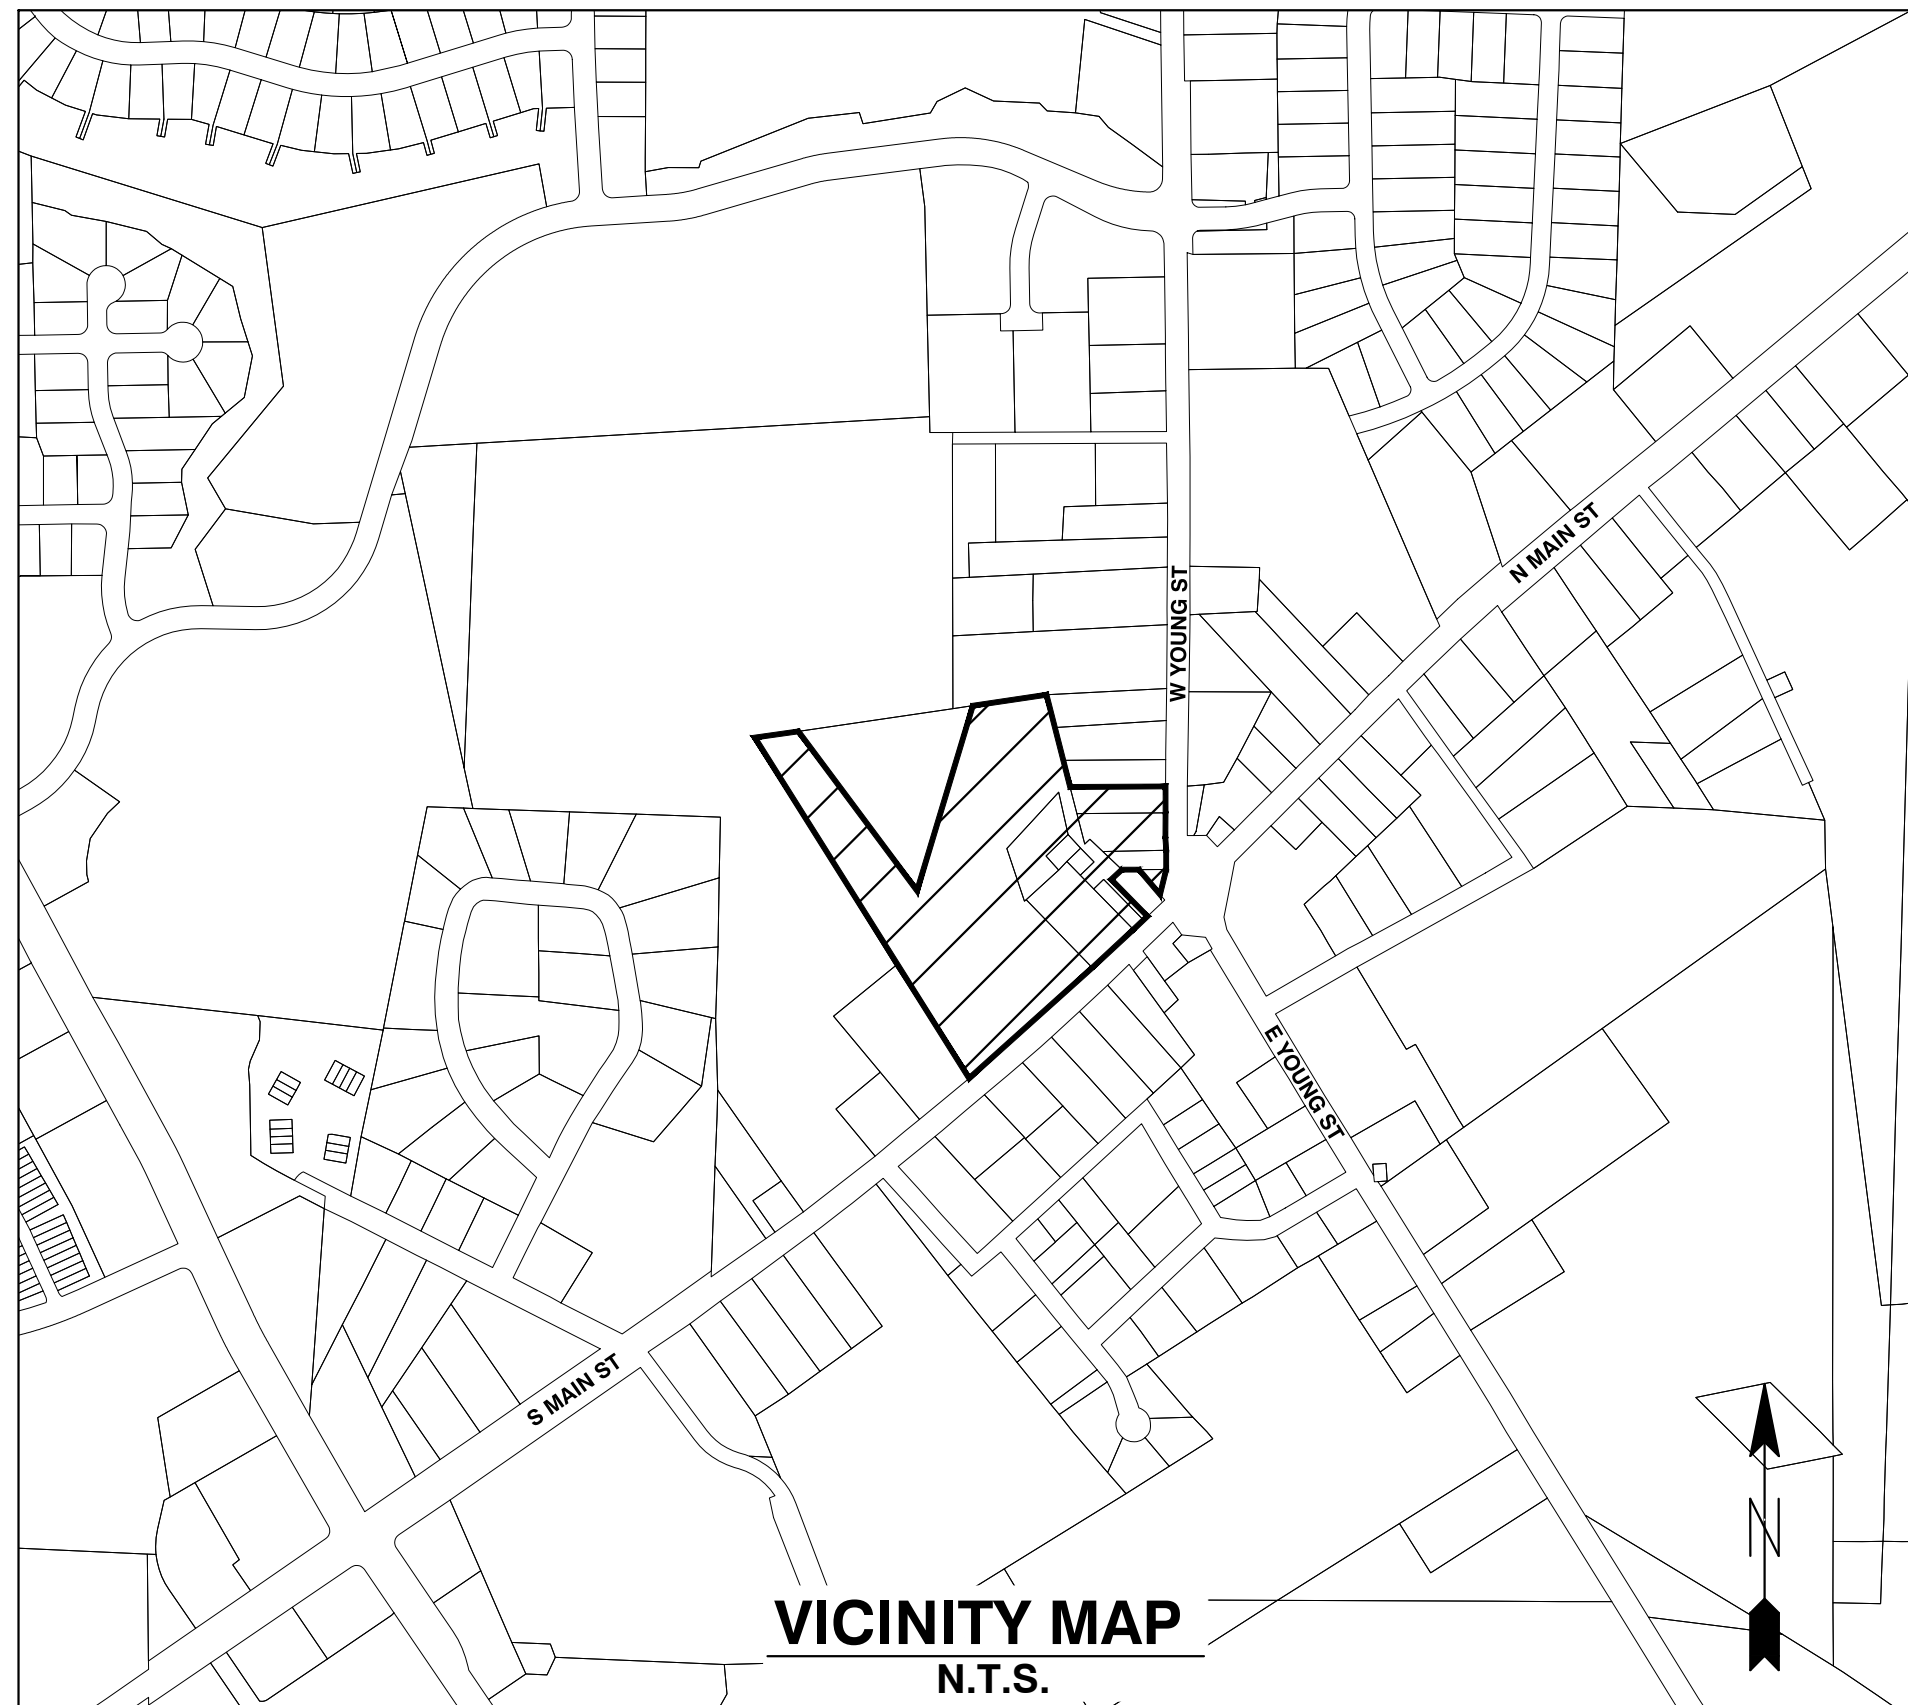

Public
Water Distribution / Extension System
 The City of Raleigh consents to the connection and extension of the City's public water system as shown on this plan. The material and construction methods used for this project shall conform to the standards and specifications of the City's Public Utilities Handbook.
 City of Raleigh
 Public Utilities Department Permit # W-3879
 Authorization to Construct See digital signature

Private
Sewer Collection / Extension System
 The City of Raleigh consents to the connection to its public sewer system and extension of the private sewer collection system as shown on this plan. The material and construction methods used for this project shall conform to the standards and specifications of the City's Public Utilities Handbook.
 City of Raleigh
 Public Utilities Department Permit # S-4962 (P)
 Authorization to Construct See digital signature

SITE PERMITTING APPROVAL

Water and Sewer Permits (if applicable)
 The City of Raleigh consents to the connection and extension of the City's Public Sewer System as shown on this plan. The material and construction methods used for this project shall conform to the standards and specifications of the City's Public Utilities Handbook. City of Raleigh Public Utilities Department Permit # W-3879
 The City of Raleigh consents to the connection and extension of the City's Public Water System as shown on this plan. The material and construction methods used for this project shall conform to the standards and specifications of the City's Public Utilities Handbook. City of Raleigh Public Utilities Department Permit # S-4962 (P)
 The City of Raleigh consents to the connection to its public sewer system and extension of the private sewer collection system as shown on this plan. The material and construction methods used for this project shall conform to the standards and specifications of the City's Public Utilities Handbook.
 City of Raleigh Public Utilities Department Permit # _____
 CITY OF RALEIGH - PLANS AUTHORIZED FOR CONSTRUCTION
 Electronic Approval: This approval is being issued electronically. This approval is valid only upon the signature of a City of Raleigh Review Officer below. The City will retain a copy of the approved plans. Any work authorized by this approval must proceed in accordance with the plans kept on file with the City. This electronic approval may not be relied upon issued. Any modification to this approval once issued will invalidate this approval.
 City of Raleigh Development Approval _____
 Raleigh Water Review Officer

OWNER:
 TOWN OF ROLESVILLE
 P.O. BOX 250
 ROLESVILLE, NC 27571-0250

DEVELOPER:
 KDM DEVELOPMENT CORPORATION
 1080 PITTSFORD VICTOR RD, STE 202
 PITTSFORD NY 14534-3805

CONTACT: KENYON BURHNAM
PHONE: 585-465-0099
EMAIL: KBURNHA2@U.ROCHESTER.EDU

SHEET INDEX

| | |
|--------|---------------------------------------|
| COVER | |
| C0.1 | EXISTING CONDITIONS & DEMOLITION PLAN |
| C1.1 | SITE PLAN |
| C2.1 | UTILITY PLAN |
| C3.1 | GRADING AND DRAINAGE PLAN |
| C3.2 | BMP DETAILS |
| C3.3 | EROSION CONTROL PLAN - STAGE 1 |
| C3.4 | EROSION CONTROL PLAN - STAGE 2 |
| C3.5 | EROSION CONTROL DETAILS |
| C3.6 | EROSION CONTROL DETAILS |
| C3.7 | NGC01 PLAN |
| C3.8 | STORM DRAINAGE PIPE & STRUCTURE TABLE |
| C4.1 | PUBLIC WATERLINE PROFILE |
| C4.2 | SANITARY SEWER PROFILE |
| L1.1 | LANDSCAPE PLAN |
| SL-101 | LIGHTING PLAN |
| C5.1 | DETAILS |
| C5.2 | DETAILS |
| C5.3 | DETAILS |
| C5.4 | DETAILS |
| C5.5 | DETAILS |
| C5.6 | DETAILS |
| A2.21 | EXTERIOR ELEVATIONS - BLDG 2 |
| A2.22 | EXTERIOR ELEVATIONS - BLDG 2 |
| A2.31 | EXTERIOR ELEVATIONS - BLDG 3 |
| A2.32 | EXTERIOR ELEVATIONS - BLDG 3 |
| A2.51 | EXTERIOR ELEVATIONS - BLDG 5 |
| A2.61 | EXTERIOR ELEVATIONS - BLDG 6 |
| A2.62 | EXTERIOR ELEVATIONS - BLDG 6 |
| A2.71 | EXTERIOR ELEVATIONS - BLDGS 1 & 7 |
| A2.72 | EXTERIOR ELEVATIONS - BLDGS 1 & 7 |
| A2.81 | EXTERIOR ELEVATIONS - BLDG 8 |

CONSTRUCTION NOTES

- ALL CONSTRUCTION SHALL BE IN ACCORDANCE WITH APPLICABLE MUNICIPALITY STANDARDS, SPECIFICATIONS, AND DETAILS. WORK IN THIS PROJECT SHALL ALSO CONFORM TO THESE PLANS, THE LATEST EDITIONS OF THE NORTH CAROLINA DEPARTMENT OF TRANSPORTATION (NCDOT) ROAD AND BRIDGE SPECIFICATIONS, THE ROAD AND BRIDGE STANDARDS, THE NORTH CAROLINA EROSION AND SEDIMENT CONTROL HANDBOOK, THE NORTH CAROLINA EROSION AND SEDIMENT CONTROL REGULATIONS, THE FINAL GEOTECHNICAL REPORT, AND GENERAL DESIGN STANDARDS. IN THE EVENT OF CONFLICT BETWEEN ANY OF THESE STANDARDS, SPECIFICATIONS, OR PLANS, THE MOST STRINGENT SHALL GOVERN.
- THE CONTRACTOR SHALL BE SOLELY RESPONSIBLE FOR TRENCH SAFETY DURING ALL PHASES OF CONSTRUCTION.
- THE LOCATION AND SIZE OF EXISTING UTILITIES AS SHOWN IS APPROXIMATE ONLY. THE CONTRACTOR IS RESPONSIBLE FOR HORIZONTALLY AND VERTICALLY LOCATING AND PROTECTING ALL PUBLIC OR PRIVATE UTILITIES WHICH LIE IN OR ADJACENT TO THE CONSTRUCTION SITE. AT LEAST 48 HOURS PRIOR TO ANY DEMOLITION, GRADING, OR CONSTRUCTION ACTIVITY, THE CONTRACTOR SHALL NOTIFY THE NORTH CAROLINA ONE-CALL UTILITIES LOCATION SERVICE (1-800-632-4949) FOR PROPER IDENTIFICATION OF EXISTING UTILITIES WITHIN THE SITE.
- THE CONTRACTOR SHALL SALVAGE AND PROTECT ALL EXISTING POWER POLES, SIGNS, MANHOLES, TELEPHONE RISERS, WATER VALVES, ETC. DURING ALL CONSTRUCTION PHASES. THE CONTRACTOR SHALL REPAIR, AT HIS OWN EXPENSE, ANY EXISTING UTILITIES DAMAGED DURING CONSTRUCTION.
- TRAFFIC CONTROL ON PUBLIC STREETS SHALL BE IN CONFORMANCE WITH THE TRAFFIC CONTROL PLAN, THE MANUAL OF UNIFORM TRAFFIC CONTROL DEVICES, AND AS FURTHER DIRECTED BY CITY AND STATE INSPECTORS.
- ANY DISCREPANCIES FOUND BETWEEN THE DRAWINGS AND SPECIFICATIONS AND SITE CONDITIONS OR ANY INCONSISTENCIES OR AMBIGUITIES IN DRAWINGS OR SPECIFICATIONS SHALL BE IMMEDIATELY REPORTED TO THE ENGINEER, IN WRITING, WHO SHALL PROMPTLY ADDRESS SUCH INCONSISTENCIES OR AMBIGUITIES. WORK DONE BY THE CONTRACTOR AFTER HIS DISCOVERY OF SUCH DISCREPANCIES, INCONSISTENCIES, OR AMBIGUITIES SHALL BE DONE AT THE CONTRACTOR'S RISK.
- A PRE-CONSTRUCTION CONFERENCE SHALL BE HELD PRIOR TO THE START OF CONSTRUCTION. THE CONTRACTOR SHALL ARRANGE THE MEETING WITH THE CITY ENGINEERING DIVISION.
- CONTRACTOR IS RESPONSIBLE FOR VERIFYING ALL REQUIRED PERMITS AND APPROVALS PRIOR TO COMMENCING CONSTRUCTION.
- ALL AREAS SHALL BE GRADED FOR POSITIVE DRAINAGE, AND AS SHOWN ON THESE PLANS, THE CONTRACTOR SHALL MAINTAIN ADEQUATE SITE DRAINAGE DURING ALL PHASES OF CONSTRUCTION. THE CONTRACTOR SHALL USE SILT FENCES (OR OTHER METHODS APPROVED BY THE ENGINEER AND APPLICABLE MUNICIPALITY) AS REQUIRED TO PREVENT SILT AND CONSTRUCTION DEBRIS FROM FLOWING ONTO ADJACENT PROPERTIES. CONTRACTOR SHALL COMPLY WITH ALL APPLICABLE FEDERAL, STATE, OR LOCAL EROSION, CONSERVATION, AND SILTATION ORDINANCES. CONTRACTOR SHALL REMOVE ALL TEMPORARY EROSION CONTROL DEVICES UPON COMPLETION OF PERMANENT DRAINAGE FACILITIES AND THE ESTABLISHMENT OF A STAND OF GRASS OR OTHER GROWTH TO PREVENT EROSION.
- THE CONTRACTOR SHALL CLEAR AND GRUB THE SITE AND PLACE, COMPACT, AND MOISTURE CONDITION ALL FILL PER THE PROJECT GEOTECHNICAL ENGINEER'S SPECIFICATIONS. THE FILL MATERIAL TO BE USED SHALL BE APPROVED BY THE GEOTECHNICAL ENGINEER PRIOR TO PLACEMENT.
- MATERIALS USED TO CONSTRUCT EMBANKMENTS FOR ANY PURPOSE, BACKFILL AROUND DRAINAGE STRUCTURES, OR IN UTILITY TRENCHES FOR ANY OTHER DEPRESSION REQUIRING FILL OR BACKFILL SHALL BE COMPACTED TO 95% OF MAXIMUM DENSITY AS DETERMINED BY THE STANDARD PROCTOR TEST AS SET OUT IN ASTM STANDARD D998. STONE BACKFILL SHALL BE COMPACTED TO 95% MAXIMUM DENSITY AS DETERMINED BY THE MODIFIED PROCTOR TEST AS SET OUT IN ASTM STANDARD D1557. THE CONTRACTOR SHALL, PRIOR TO ANY OPERATIONS INVOLVING FILLING OR BACKFILLING, SUBMIT THE RESULTS OF THE PROCTOR TEST TOGETHER WITH A CERTIFICATION THAT THE SOIL TESTED IS REPRESENTATIVE OF THE MATERIALS TO BE USED ON THE PROJECT. TESTS SHALL BE CONDUCTED BY A CERTIFIED MATERIALS TESTING LABORATORY AND THE CERTIFICATIONS MADE BY A LICENSED PROFESSIONAL ENGINEER REPRESENTING THE LABORATORY.
- PROPOSED CONTOURS AND GUTTER GRADIENTS ARE APPROXIMATE. PROPOSED SPOT ELEVATIONS AND ROADWAY PROFILES/SUPERELEVATIONS ARE TO BE USED IN CASE OF DISCREPANCY.
- THE CONTRACTOR SHALL REVIEW, VERIFY AND COORDINATE ALL DIMENSIONS SHOWN ON PLANS, INCLUDING THE HORIZONTAL AND VERTICAL LOCATION OF CURB INLETS AND GRATE INLETS AND ALL UTILITIES CROSSING THE STORM SEWER PRIOR TO STARTING PROJECT.
- ALL CURB JOINTS SHALL EXTEND THROUGH THE CURB. MINIMUM LENGTH OF OFFSET JOINTS AT RADIUS POINTS IS 1.5 FEET. ALL JOINTS SHALL BE SEALED WITH JOINT SEALANT.
- ALL HANDICAP RAMPING, STRIPING, AND PAVEMENT MARKINGS SHALL CONFORM TO ADA REQUIREMENTS AND THE NORTH CAROLINA STATE BUILDING CODE, VOL. 1-C ACCESSIBILITY CODE.
- OWNER SHALL PROVIDE FENCING AND OTHER SAFETY MEASURES NECESSARY IN AND AROUND ANY PROPOSED STORMWATER MANAGEMENT MEASURES (PONDS, WETLANDS, ETC.) OBTAINING PROPER PERMITS SHALL BE THE RESPONSIBILITY OF THE OWNER.
- RETAINING WALLS EXCEEDING 30 INCHES IN HEIGHT SHALL INCLUDE FALL PROTECTION IN THE FORM OF A HANDRAIL OR FENCING ON THE HIGH SIDE OF THE RETAINING WALL.
- PROPER COMPACTION OF ALL FILL SOILS PLACED ON SITE SHALL BE THE RESPONSIBILITY OF THE CONTRACTOR. COMPACTION SHALL BE ADEQUATE TO SUPPORT THE PROPOSED USE OF AREAS IN WHICH FILL SOILS ARE PLACED. THE CONTRACTOR SHALL HIRE A GEOTECHNICAL ENGINEER TO TEST AND VERIFY THAT COMPACTION IS ADEQUATE FOR THE PROPOSED USE OF THE AREA OF FILL PLACEMENT.
- ALL ASPECTS OF THIS PROJECT SHALL BE IN FULL COMPLIANCE WITH CURRENT ADA STANDARDS. IF THE CONTRACTOR NOTES ANY ASPECTS OF THE PROJECT WHICH ARE NOT IN COMPLIANCE, THE ENGINEER SHALL BE NOTIFIED PRIOR TO ANY FURTHER WORK BEING PERFORMED. ANY WORK PERFORMED AFTER THE CONTRACTOR NOTES SUCH A NON COMPLIANCE IS SUBJECT TO REMOVAL AND REPAIR AT THE CONTRACTOR'S EXPENSE.
- THE CONTRACTOR OR OWNER SHALL EMPLOY A GEOTECHNICAL ENGINEER TO TEST ALL EMBANKMENTS AND FILL PLACEMENT FOR PROPER COMPACTION. PROPER COMPACTION SHALL BE PER THE GEOTECHNICAL ENGINEER'S RECOMMENDATIONS OR THESE PLANS, WHICHEVER IS MORE STRINGENT. EMBANKMENTS FOR PONDS SHALL BE PLACED IN 6 INCH LOOSE LAYERS AND SHALL BE COMPACTED TO A DENSITY OF NO LESS THAN 95% OF THE STANDARD PROCTOR MAXIMUM DENSITY AT A MOISTURE CONTENT OF 4% OR TWO PERCENTAGE POINTS OF THE OPTIMUM MOISTURE CONTENT IN ACCORDANCE WITH ASTM D998. THE CONTRACTOR SHALL TAKE PHOTOGRAPHS OF THE OUTLET STRUCTURE AT ALL AT ALL PHASES OF INSTALLATION AND SHALL RETAIN WITH GEOTECHNICAL TESTING DATA. THE CONTRACTOR SHALL ALSO RETAIN ALL SHIPPING RECORDS AND SPECIFICATIONS FOR THE OUTLET STRUCTURE MATERIALS AND STRUCTURES. ALL OF THE ABOVE DATA MAY BE REQUIRED AS PART OF THE MUNICIPALITY AS-BUILT PROCESS AND SHALL BE MADE AVAILABLE TO THE ENGINEER UPON REQUEST. THE CONTRACTOR AND OWNER SHALL HAVE DOCUMENTATION OF THESE TESTS AVAILABLE UPON REQUEST.
- RETAINING WALLS SHOWN HEREIN SHALL BE DESIGNED BY A QUALIFIED PROFESSIONAL ENGINEER WITH EXPERIENCE DESIGNING RETAINING WALLS. AT LEAST 14 DAYS PRIOR TO BEGINNING CONSTRUCTION OF RETAINING WALLS, THE CONTRACTOR SHALL CONTACT THE OWNER'S GEOTECHNICAL ENGINEER TO SCHEDULE AND COORDINATE ALL APPROPRIATE INSPECTIONS, TESTING, AND VERIFICATION NECESSARY DURING RETAINING WALL CONSTRUCTION. THE GEOTECHNICAL ENGINEER SHALL PROVIDE CONTINUOUS INSPECTION, TESTING AND VERIFICATION FOR THE DURATION OF RETAINING WALL CONSTRUCTION. PROPER SCHEDULING, EXECUTION, AND RECORD KEEPING FOR ALL REQUIRED INSPECTIONS, TESTING, AND VERIFICATION SHALL BE THE RESPONSIBILITY OF THE CONTRACTOR. SUCH RECORDS SHALL BE RETAINED AND SHALL BE PROVIDED TO THE OWNER AND BASS, NIXON & KENNEDY, INC. ALL MONITORING, TESTING, AND VERIFICATION SHALL CONFORM TO THE MOST RECENT VERSION OF THE NC BUILDING CODE CHAPTER 18, SECTION 1806 OR THE WALL DESIGN ENGINEER'S SPECIFICATIONS, WHICHEVER IS MORE STRINGENT.



QUANTITY SUMMARY

| | |
|---------------------------|------|
| PHASE NUMBER(S) | 1 |
| NUMBER OF LOT(S) | 1 |
| LOT NUMBER(S) BY PHASE | N/A |
| NUMBER OF UNITS | 180 |
| LIVABLE BUILDINGS | 6 |
| OPEN SPACE (AC) | 3.48 |
| NUMBER OF OPEN SPACE LOTS | N/A |
| PUBLIC WATER (LF) | 875 |
| PRIVATE SEWER (LF) | 550 |
| PUBLIC STREET (LF) | 0 |
| PUBLIC SIDEWALK (LF) | 255 |

ENGINEER:



BASS, NIXON & KENNEDY, INC.
CONSULTING ENGINEERS
 6310 CHAPEL HILL ROAD, SUITE 250
 RALEIGH, NORTH CAROLINA 27607
 TELEPHONE: (919) 851-4422
 FAX: (919) 851-8968

CERTIFICATION NUMBERS: NCBELS (C-0110)
NCBOLA (C-0267)

CONTACT: MARTY D. BIZZELL, PE, CPESC
EMAIL: Marty.Bizzell@BNKinc.com



EROSION CONTROL, STORMWATER AND FLOODPLAIN MANAGEMENT

APPROVED
 EROSION CONTROL S-_____
 STORMWATER MGMT. S-_____
 FLOOD STUDY S-_____
 DATE _____


CONTACT: MARTY D. BIZZELL, PE, CPESC
EMAIL: Marty.Bizzell@BNKinc.com

ENVIRONMENTAL CONSULTANT SIGNATURE

CITY OF RALEIGH - PLANS AUTHORIZED FOR CONSTRUCTION

Electronic Approval: This approval is being issued electronically. This approval is valid only upon the signature of a City of Raleigh Review Officer below. The City will retain a copy of the approved plans. Any work authorized by this approval must proceed in accordance with the plans kept on file with the City. This electronic approval may not be edited once issued. Any modification to this approval once issued will invalidate this approval.


City of Raleigh Development Approval _____
Raleigh Water Review Officer _____

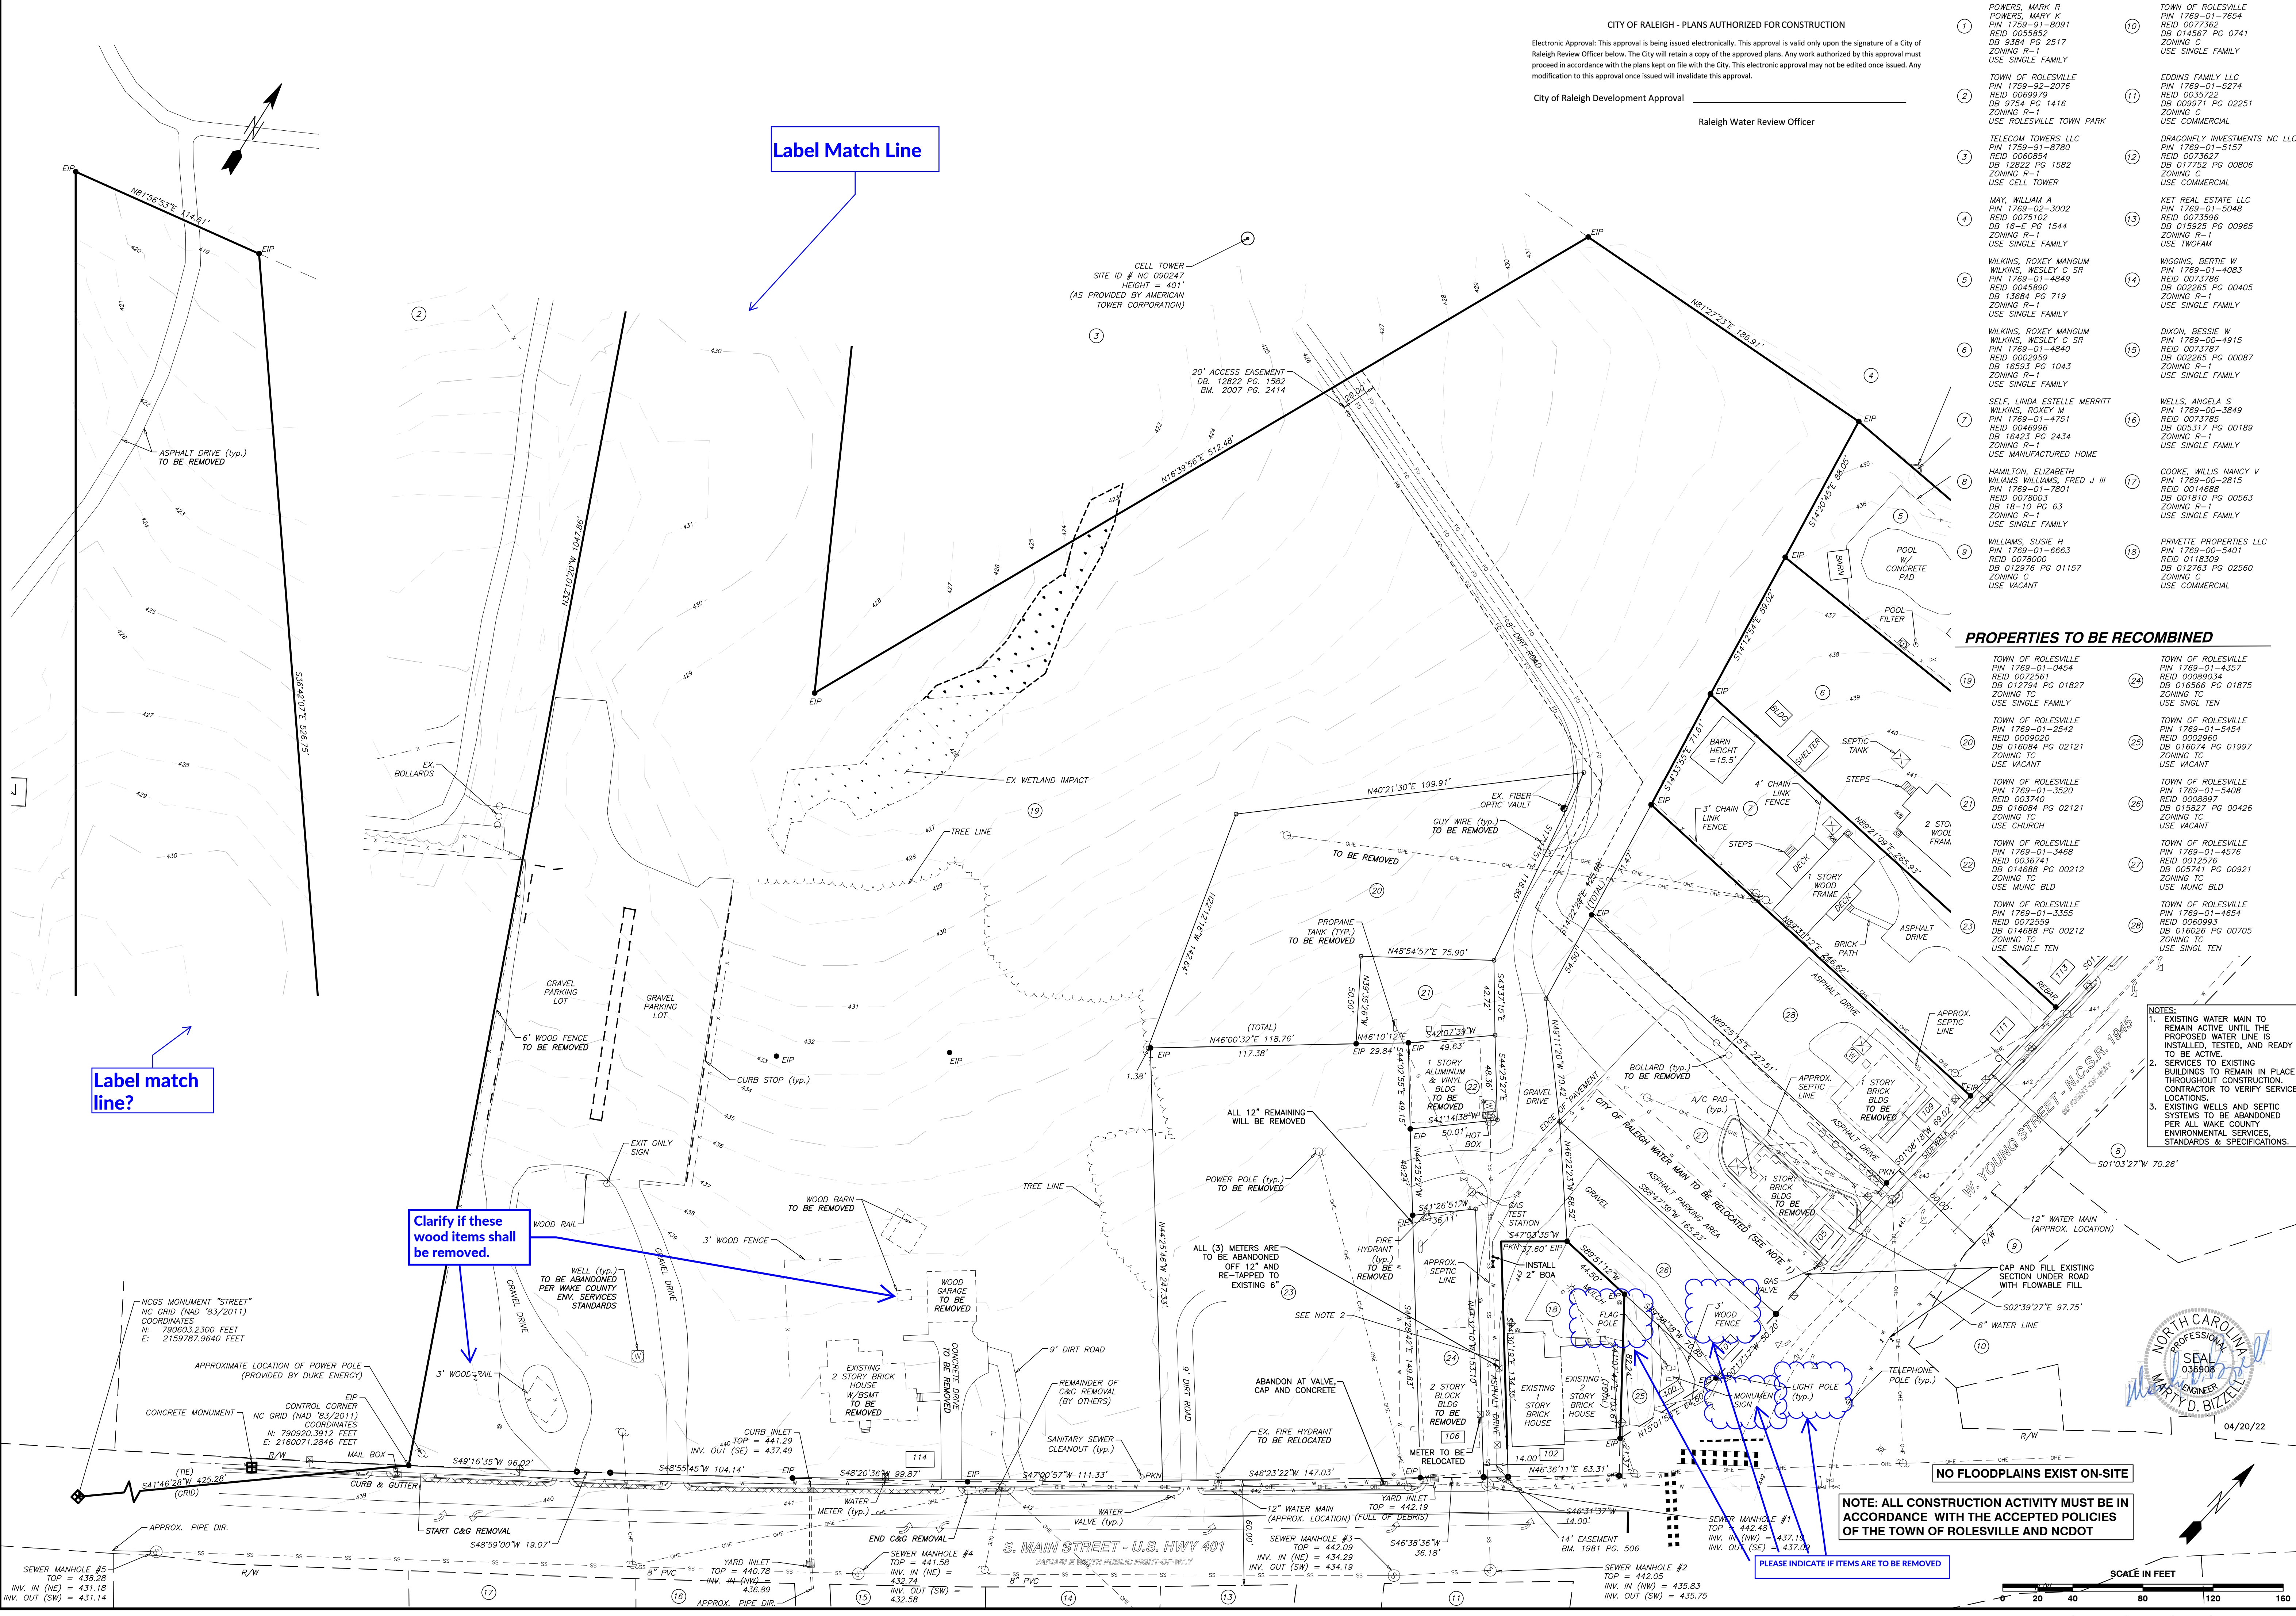

PROPERTIES TO BE RECOMBINED

| | | | |
|----|--|----|--|
| 19 | TOWN OF ROLESVILLE PIN 1769-01-0454 REID 0026961 DB 012794 PG 01827 ZONING TC USE SINGLE FAMILY | 24 | TOWN OF ROLESVILLE PIN 1769-01-4357 REID 0026954 DB 016566 PG 01875 ZONING TC USE SINGL TEN |
| 20 | TOWN OF ROLESVILLE PIN 1769-01-2542 REID 0009020 DB 016084 PG 02121 ZONING TC USE VACANT | 25 | TOWN OF ROLESVILLE PIN 1769-01-5454 REID 0009060 DB 016074 PG 01997 ZONING TC USE VACANT |
| 21 | TOWN OF ROLESVILLE PIN 1769-01-3520 REID 003740 DB 016084 PG 02121 ZONING TC USE CHURCH | 26 | TOWN OF ROLESVILLE PIN 1769-01-5408 REID 0008897 DB 016827 PG 00426 ZONING TC USE VACANT |
| 22 | TOWN OF ROLESVILLE PIN 1769-01-3468 REID 0036741 DB 014688 PG 00212 ZONING TC USE MUNC BLD | 27 | TOWN OF ROLESVILLE PIN 1769-01-4576 REID 0012576 DB 005741 PG 00921 ZONING TC USE MUNC BLD |
| 23 | TOWN OF ROLESVILLE PIN 1769-01-3468 REID 0036741 DB 014688 PG 00212 ZONING TC USE SINGLE TEN | 28 | TOWN OF ROLESVILLE PIN 1769-01-4654 REID 0006993 DB 016026 PG 00705 ZONING TC USE SINGL TEN |


- NOTES:
- EXISTING WATER MAIN TO REMAIN ACTIVE UNTIL THE PROPOSED WATER LINE IS INSTALLED, TESTED, AND READY TO BE ACTIVE.
 - SERVICES TO EXISTING BUILDINGS TO REMAIN IN PLACE THROUGHOUT CONSTRUCTION. CONTRACTOR TO VERIFY SERVICE LOCATIONS.
 - EXISTING WELLS AND SEPTIC SYSTEMS TO BE ABANDONED PER ALL WAKE COUNTY ENVIRONMENTAL SERVICES, STANDARDS & SPECIFICATIONS.

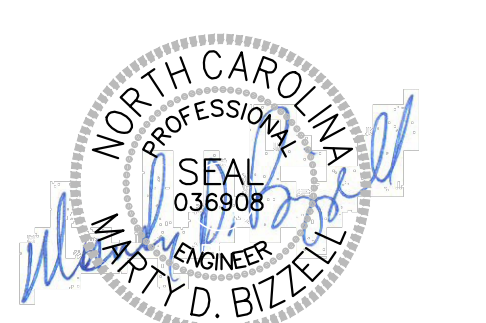

NO FLOODPLAINS EXIST ON-SITE

NOTE: ALL CONSTRUCTION ACTIVITY MUST BE IN ACCORDANCE WITH THE ACCEPTED POLICIES OF THE TOWN OF ROLESVILLE AND NCDOT

PLEASE INDICATE IF ITEMS ARE TO BE REMOVED

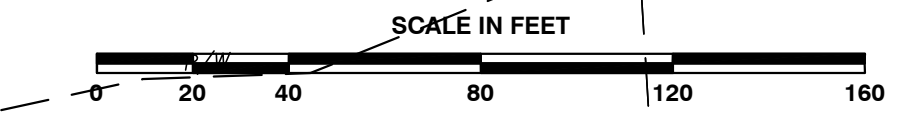

BASS, NIXON & KENNEDY, INC.
CONSULTING ENGINEERS
6310 CHAPEL HILL ROAD, SUITE 250, RALEIGH, NC 27607
TELEPHONE: (919) 881-4422 FAX: (919) 881-6886
CERTIFICATION NUMBERS: NCBELS (C-0110); NCBOLA (C-0267)

COBBLESTONE VILLAGE
MIXED USE DEVELOPMENT
TOWN OF ROLESVILLE, WAKE COUNTY, NORTH CAROLINA

SHEET **C0.1**

TOWN OF ROLESVILLE PROJECT NO. _____

| NO. | DATE | DESCRIPTION | BY |
|-----|------|-------------|----|
| | | | |
| | | | |
PROGRESS: MRN
DATE: 03-19-17
DRAWN BY: JRM
CHECKED BY: MDB
SCALE: 1" = 40'

NOT RELEASED FOR CONSTRUCTION OR BID SOLICITATION




BASS, NIXON & KENNEDY, INC.
CONSULTING ENGINEERS
 6310 CHAPEL HILL ROAD, SUITE 250, RALEIGH, NC 27607
 TELEPHONE: (919)851-1122 FAX: (919)851-8686
 CERTIFICATION NUMBERS: NCBELS (C-0110); NCBOLA (C-0267)

| PROGRESS | DATE | NO. | DATE | DESCRIPTION | BY |
|----------|------|-----|------|-------------|----|
| 03-19187 | | | | | |

COBBLESTONE VILLAGE
MIXED USE DEVELOPMENT
 TOWN OF ROLESVILLE, WAKE COUNTY, NORTH CAROLINA
 NOT RELEASED FOR CONSTRUCTION OR BID SOLICITATION

- CONDITIONS OF APPROVAL:**
1. TECHNICAL REVIEW COMMITTEE APPROVAL AND ISSUANCE OF REQUIRED PERMITS FROM ALL AGENCIES MUST BE ACHIEVED AND SUBMITTED FOR REVIEW AND RECORD RETENTION PRIOR TO FINAL SIGNATURE AND APPROVAL OF THE SITE PLAN.
 2. CROSS-CONNECTION ACCESS TO ONE OF THE THREE ADJACENT PROPERTIES TO THE EAST ALONG W. YOUNG STREET (111, 113, AND 115 W. YOUNG STREET) FOR FUTURE DEVELOPMENT WILL BE PROVIDED.
 3. BEST EFFORTS WILL BE MADE FOR GREENWAY ACCESS ACROSS THE TELECOM TOWERS, LLC SITE FOR PEDESTRIAN TRAFFIC FROM OVERFLOW PARKING SITE LOCATED AT THE TERMINUS OF SCARBORO STREET IN MAIN STREET PARK.
 4. BASED UPON TESTIMONY REGARDING SHARED PARKING IN A MIXED-USE DEVELOPMENT, A 15% PARKING REDUCTION IS GRANTED RESULTING IN 467 REQUIRED SPACES.
 5. A MAXIMUM HEIGHT OF 60 FEET IS APPROVED PER THE BUILDING HEIGHT DESIGN ALTERNATIVE FOR THE SITE AS SHOWN ON THE SITE PLAN, PROVIDED ALL OTHER APPLICABLE STANDARDS ACCORDING TO THE LDO ARE MET.

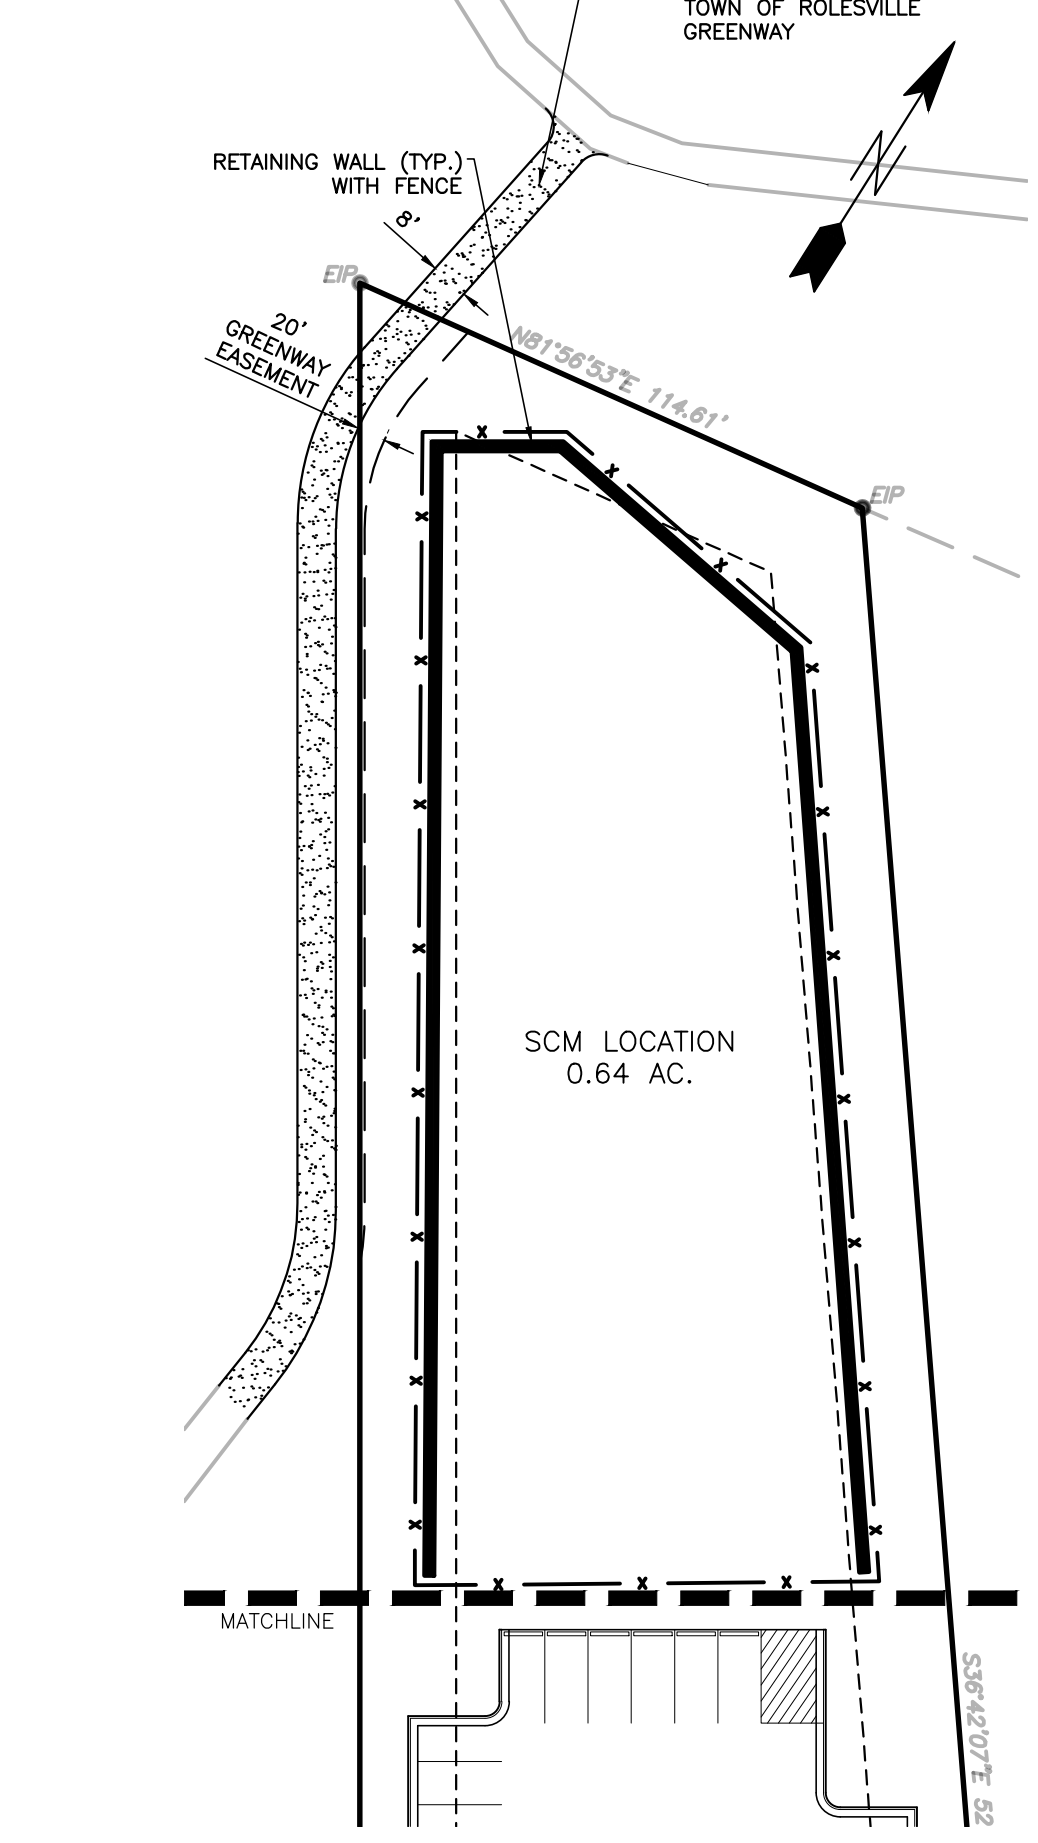


CITY OF RALEIGH - PLANS AUTHORIZED FOR CONSTRUCTION

Electronic Approval: This approval is being issued electronically. This approval is valid only upon the signature of a City of Raleigh Review Officer below. The City will retain a copy of the approved plans. Any work authorized by this approval must proceed in accordance with the plans kept on file with the City. This electronic approval may not be edited once issued. Any modification to this approval once issued will invalidate this approval.


City of Raleigh Development Approval _____
 Raleigh Water Review Officer _____

OVERALL SITE DATA

| | |
|--|--|
| SITE AREA | 10.96 AC (477,418 SF±) |
| P.I.N. | 1769-01-0454, 1769-01-4357, 1769-01-3355 1769-01-3468, 1769-01-2542, 1769-01-3520 1769-01-4654, 1769-01-5454, 1769-01-5408, 1769-01-4576 |
| ZONING DISTRICT: | TOWN CENTER (TC) RESIDENTIAL, MIXED USE |
| OPEN SPACE AREA: | 3.48 AC |
| IMPERVIOUS AREA: | 7.48 AC |
| IMPERVIOUS AREA (%): | 68% |
| APARTMENT MIX | |
| 1 BEDROOM | 112 UNITS |
| 2 BEDROOM | 64 UNITS |
| TOTAL APARTMENTS | 176 UNITS |
| RESIDENTIAL DENSITY: | 16.06 UNITS/ACRE |
| RETAIL/COMMERCIAL: | 49,830 SQUARE FEET |
| MUNICIPAL FLEX SPACE: | 15,900 SQUARE FEET |
| TOTAL: | 65,730 SQUARE FEET |
| EVENT SPACE: | 0.44 ACRES/ 18,976 SQUARE FEET |
| PARKING REQUIREMENTS PER TC DISTRICT DEVELOPMENT STANDARDS | |
| MIXED USE RESIDENTIAL: 2.0 SPACES PER UNIT | 176 x 2 = 352 SPACES REQUIRED |
| MIXED USE NON-RESIDENTIAL: 3 SPACES PER 1000 GSF | 65,730/1000 x 3 = 197 SPACES REQUIRED |
| TOTAL PARKING REQUIRED/PROVIDED: | 549 SPACES REQUIRED/ 468 PROVIDED |
| 5% OF ON STREET PARKING MAY BE COUNTED AS REQUIRED PARKING (28 ALLOWED/ 24 PROVIDED) | |
| 15% PARKING REDUCTION ALLOWED FOR SHARED PARKING: 549 x .85 = 467 REQUIRED | |
| BUILDING 1: | 51,882 SF APARTMENTS |
| BUILDING 2: | 16,641 SF RETAIL |
| BUILDING 3: | 11,405 SF RETAIL |
| BUILDING 4: | 15,900 SF MUNICIPAL |
| BUILDING 5: | 3,816 FLEX |
| BUILDING 6: | 18,148 SF RETAIL |
| BUILDING 7: | 51,882 SF APARTMENTS |
| BUILDING 8: | 17,453 SF APARTMENTS |

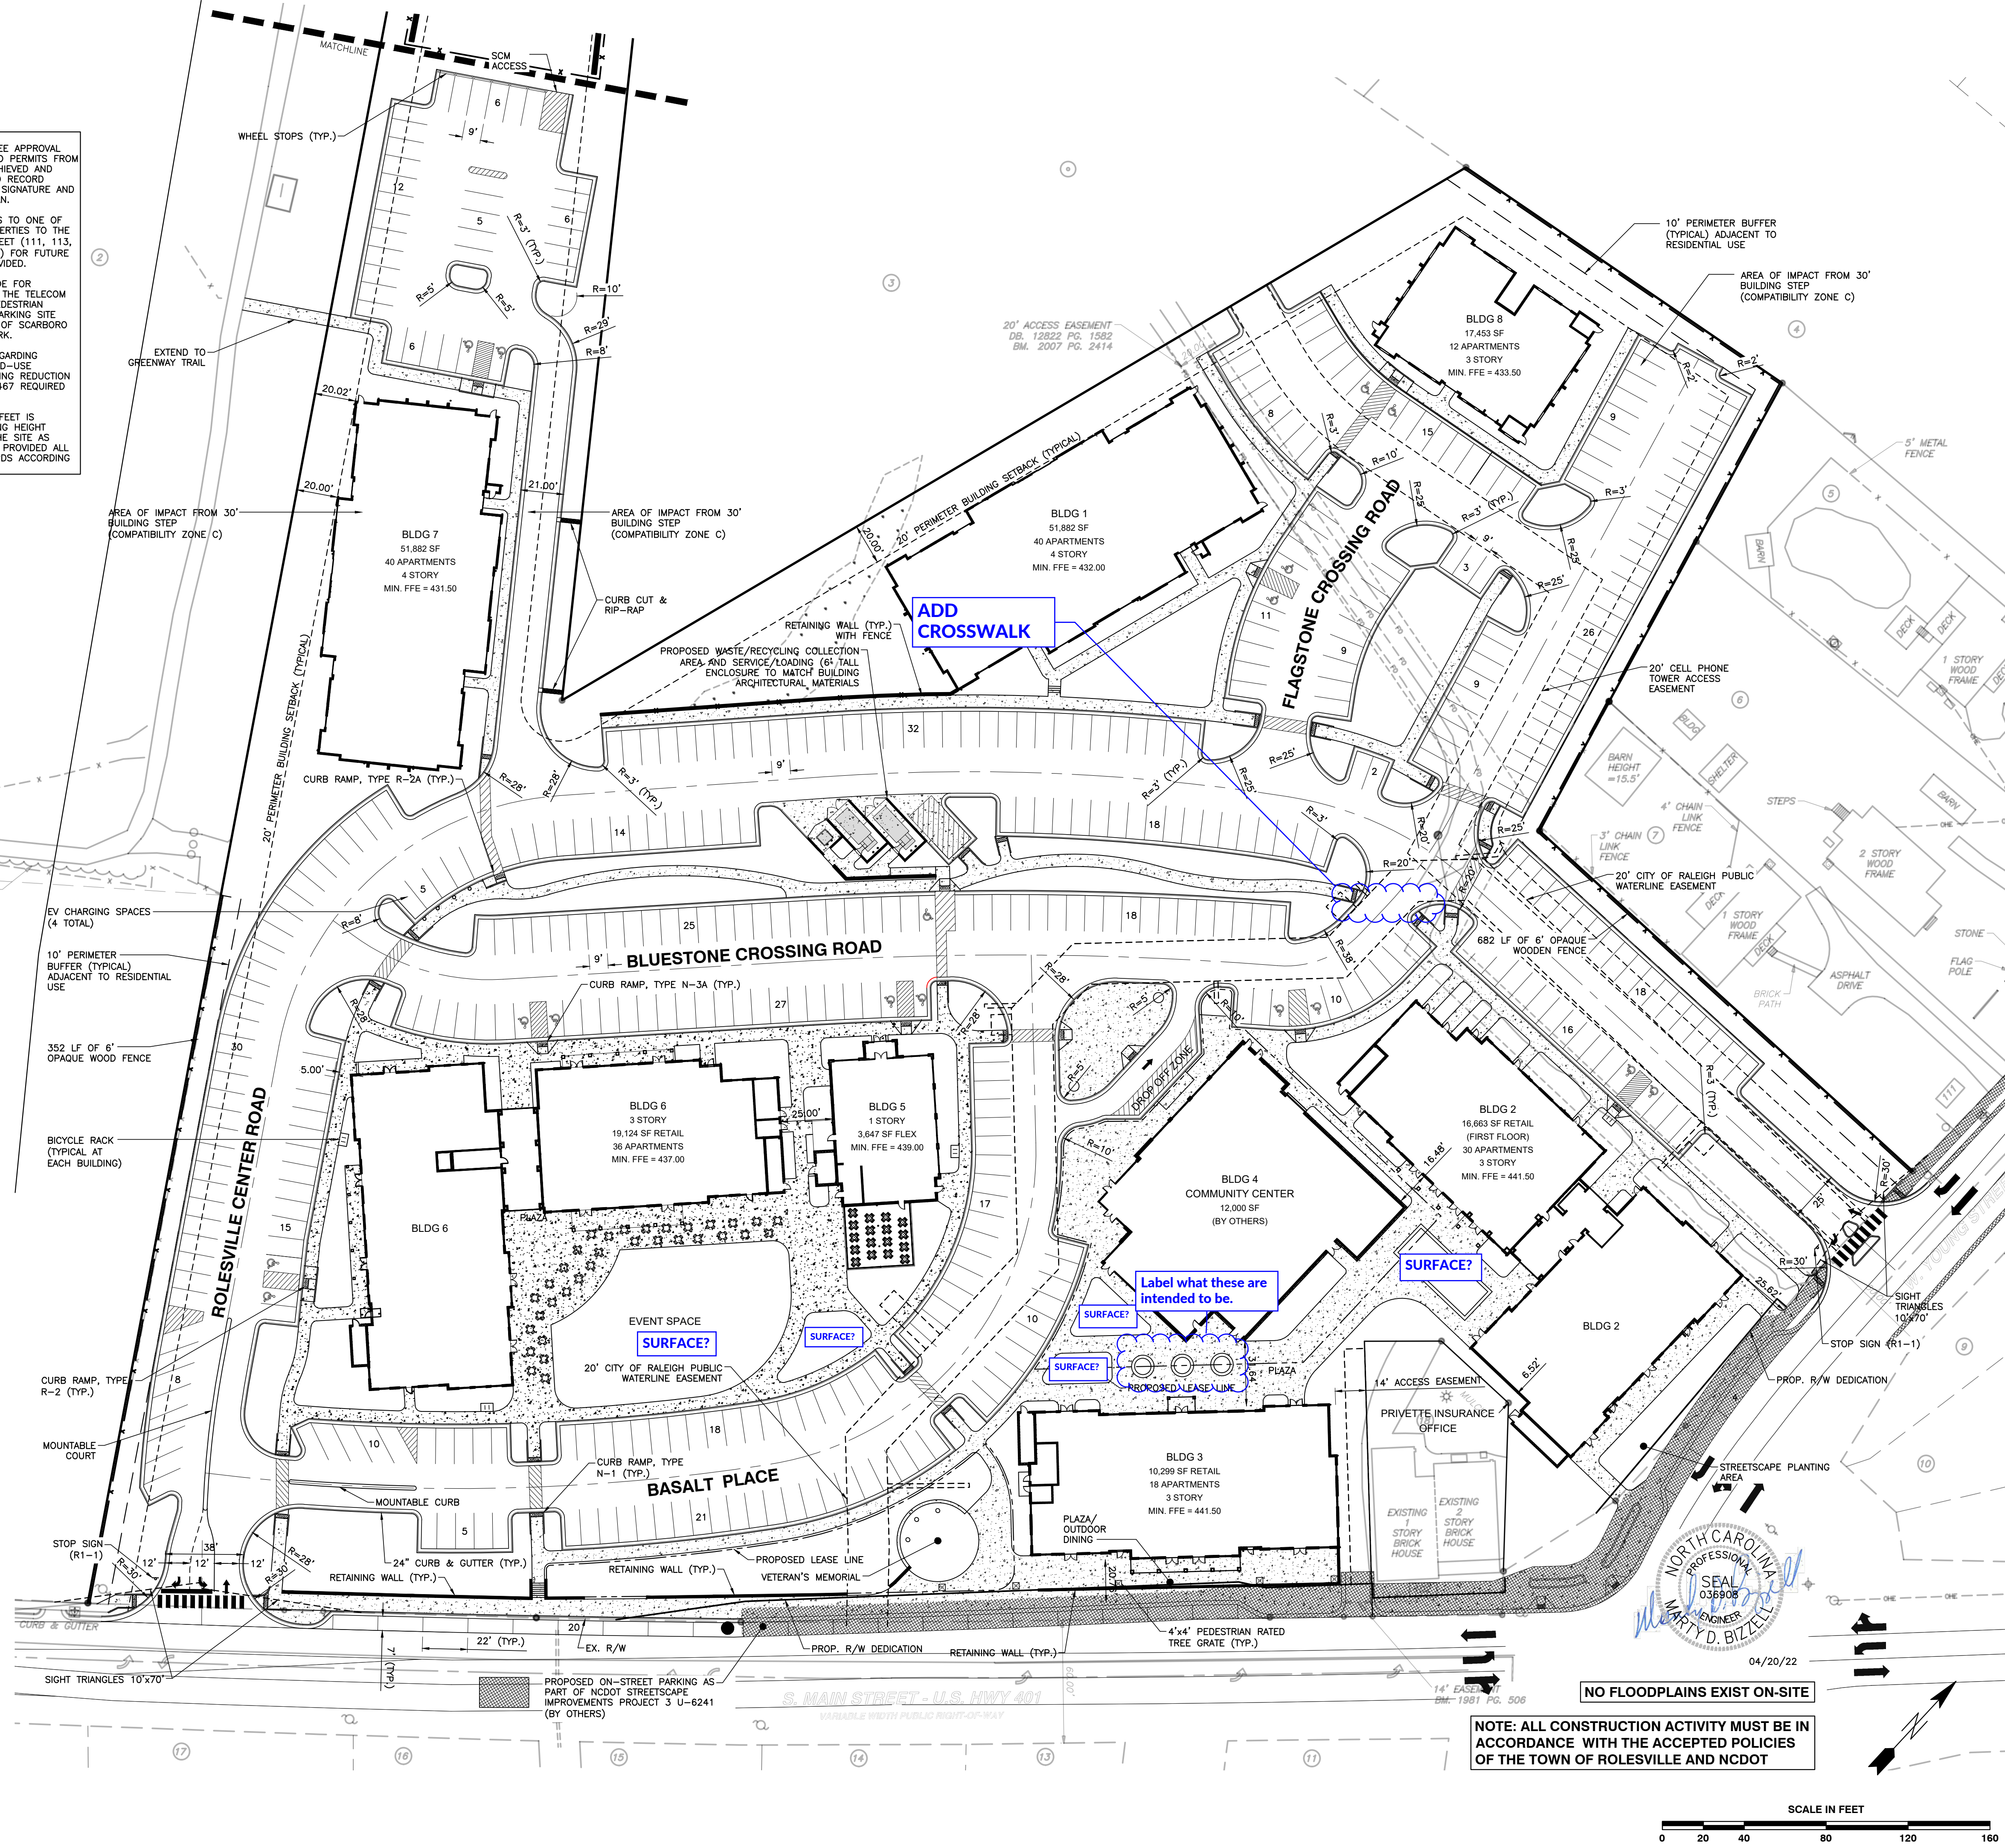

NOTE: ALL CONSTRUCTION ACTIVITY MUST BE IN ACCORDANCE WITH THE ACCEPTED POLICIES OF THE TOWN OF ROLESVILLE AND NCDOT

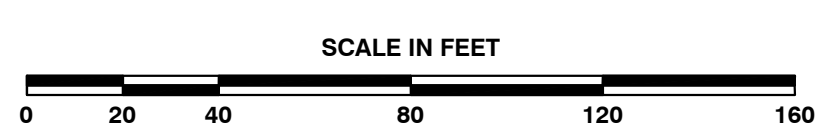

R:\2021\19187 - Rolesville Town Center\CIVIL\04 Construction\02 - 19187_Site.dwg, Site Plan, 4/20/2022, 2:27:44 PM, maric.muller

SHEET C1.1

TOWN OF ROLESVILLE PROJECT NO.

CITY OF RALEIGH - PLANS AUTHORIZED FOR CONSTRUCTION

Electronic Approval: This approval is being issued electronically. This approval is valid only upon the signature of a City of Raleigh Review Officer below. The City will retain a copy of the approved plans. Any work authorized by this approval must proceed in accordance with the plans kept on file with the City. This electronic approval may not be edited once issued. Any modification to this approval once issued will invalidate this approval.

City of Raleigh Development Approval _____
Raleigh Water Review Officer _____

Public
Water Distribution / Extension System
The City of Raleigh consents to the connection and extension of the City's public water system as shown on this plan. The material and construction methods used for this project shall conform to the standards and specifications of the City's Public Utilities Handbook.

City of Raleigh
Public Utilities Department Permit # W-3879
Authorization to Construct See digital signature

Private
Sewer Collection / Extension System
The City of Raleigh consents to the connection to its public sewer system and extension of the private sewer collection system as shown on this plan. The material and construction methods used for this project shall conform to the standards and specifications of the City's Public Utilities Handbook.

City of Raleigh
Public Utilities Department Permit # S-4962 (P)
Authorization to Construct See digital signature


ATTENTION CONTRACTORS
The Construction Contractor responsible for the extension of water, sewer, and/or reuse, as approved in these plans, is responsible for contacting the Public Utilities Department at (919) 996-4540 at least twenty four hours prior to beginning any of their construction.

Failure to notify both City Departments in advance of beginning construction, will result in the issuance of monetary fines, and require reinstallation of any water or sewer facilities not inspected as a result of this notification failure.

Failure to call for Inspection, Install a Downstream Plug, have Permitted Plans on the Jobsite, or any other Violation of City of Raleigh Standards will result in a Fine and Possible Exclusion from future work in the City of Raleigh.


- STANDARD UTILITY NOTES (as applicable):**
- All materials & construction methods shall be in accordance with City of Raleigh design standards, details & specifications (reference: CORPUD Handbook, current edition)
 - Utility separation requirements:
 - A distance of 100' shall be maintained between sanitary sewer & any private or public water supply source such as an impounded reservoir used as a source of drinking water. If adequate lateral separation cannot be achieved, ferrous sanitary sewer pipe shall be specified & installed to watertight specifications. However, the minimum separation shall not be less than 25' from a private well or 50' from a public well
 - When installing water &/or sewer mains, the horizontal separation between utilities shall be 10'. If this separation cannot be maintained due to existing conditions, the variation allowed is the water main in a separate trench with the elevation of the water main at least 18" above the top of the sewer & must be approved by the Public Utilities Director. All distances are measured from outside diameter to outside diameter
 - Where it is impossible to obtain proper separation, or anytime a sanitary sewer passes over a watermain, DIP materials or steel encasement extended 10' on each side of crossing must be specified & installed to watertight specifications
 - 5.0' minimum horizontal separation is required between all sanitary sewer & storm sewer facilities, unless DIP material is specified for sanitary sewer
 - Maintain 18" min. vertical separation at all watermain & RCP storm drain crossings; maintain 24" min. vertical separation at all sanitary sewer & RCP storm drain crossings. Where adequate separations cannot be achieved, specify DIP materials & a concrete cradle having 6" min. clearance (per CORPUD details W-41 & S-49)
 - All other underground utilities shall cross water & sewer facilities with 18" min. vertical separation required
 - Any necessary field revisions are subject to review & approval of an amended plan &/or profile by the City of Raleigh Public Utilities Department prior to construction
 - Contractor shall maintain continuous water & sewer service to existing residences & businesses throughout construction of project. Any necessary service interruptions shall be preceded by a 24 hour advance notice to the City of Raleigh Public Utilities Department
 - 3.0' minimum cover is required on all water mains & sewer force mains. 4.0' minimum cover is required on all reuse mains
 - It is the developer's responsibility to abandon or remove existing water & sewer services not being used in redevelopment of a site unless otherwise directed by the City of Raleigh Public Utilities Department. This includes abandoning tap at main & removal of service from ROW or easement per CORPUD Handbook procedure
 - Install 3/4" copper* water services with meters located at ROW or within a 2'x2' Watertight Easement immediately adjacent **NOTE: It is the applicant's responsibility to properly size the water service for each connection to provide adequate flow & pressure**
 - Install 4" PVC* sewer services @ 1.0% minimum grade with cleanouts located at ROW or easement line & spaced every 75 linear feet maximum
 - Pressure reducing valves are required on all water services exceeding 80 psi; backwater valves are required on all sanitary sewer services having building drains lower than 1.0' above the next upstream manhole
 - All environmental permits applicable to the project must be obtained from NCDWQ, USACE &/or FEMA for any riparian buffer, wetland &/or floodplain impacts (respectively) prior to construction.
 - NCDOT / Railroad Encroachment Agreements are required for any utility work (including main extensions & service taps) within state or railroad ROW prior to construction
 - Grease Interceptor / Oil Water Separator sizing calculations & installation specifications shall be approved by the CORPUD IFC Program Coordinator prior to issuance of a Building Permit. Contact Tim Besley at (919) 996-2334 or timothy.besley@raleighnc.gov for more information
 - Cross-connection control protection devices are required based on degree of health hazard involved as listed in Appendix-B of the Rules Governing Public Water Systems in North Carolina. These guidelines are the minimum requirements. The devices shall meet American Society of Sanitary Engineering (ASSE) standards or be on the University of Southern California approval list. The devices shall be installed and tested (both initial and periodic testing thereafter) in accordance with the manufacturer's recommendations or the local cross-connection control program, whichever is more stringent. Contact Joanie Hartley at (919) 996-5923 or joanie.hartley@raleighnc.gov for more information

- NOTES:**
- FOR BUILDING SEWER PLUMBING THE FURTHEST MAIN UNDER SLAB UPSET 1.5' BELOW FFE.
 - BACKFLOW PREVENTERS TO BE LOCATED INSIDE OF BUILDINGS 2, 3, 4, 5, & 6.

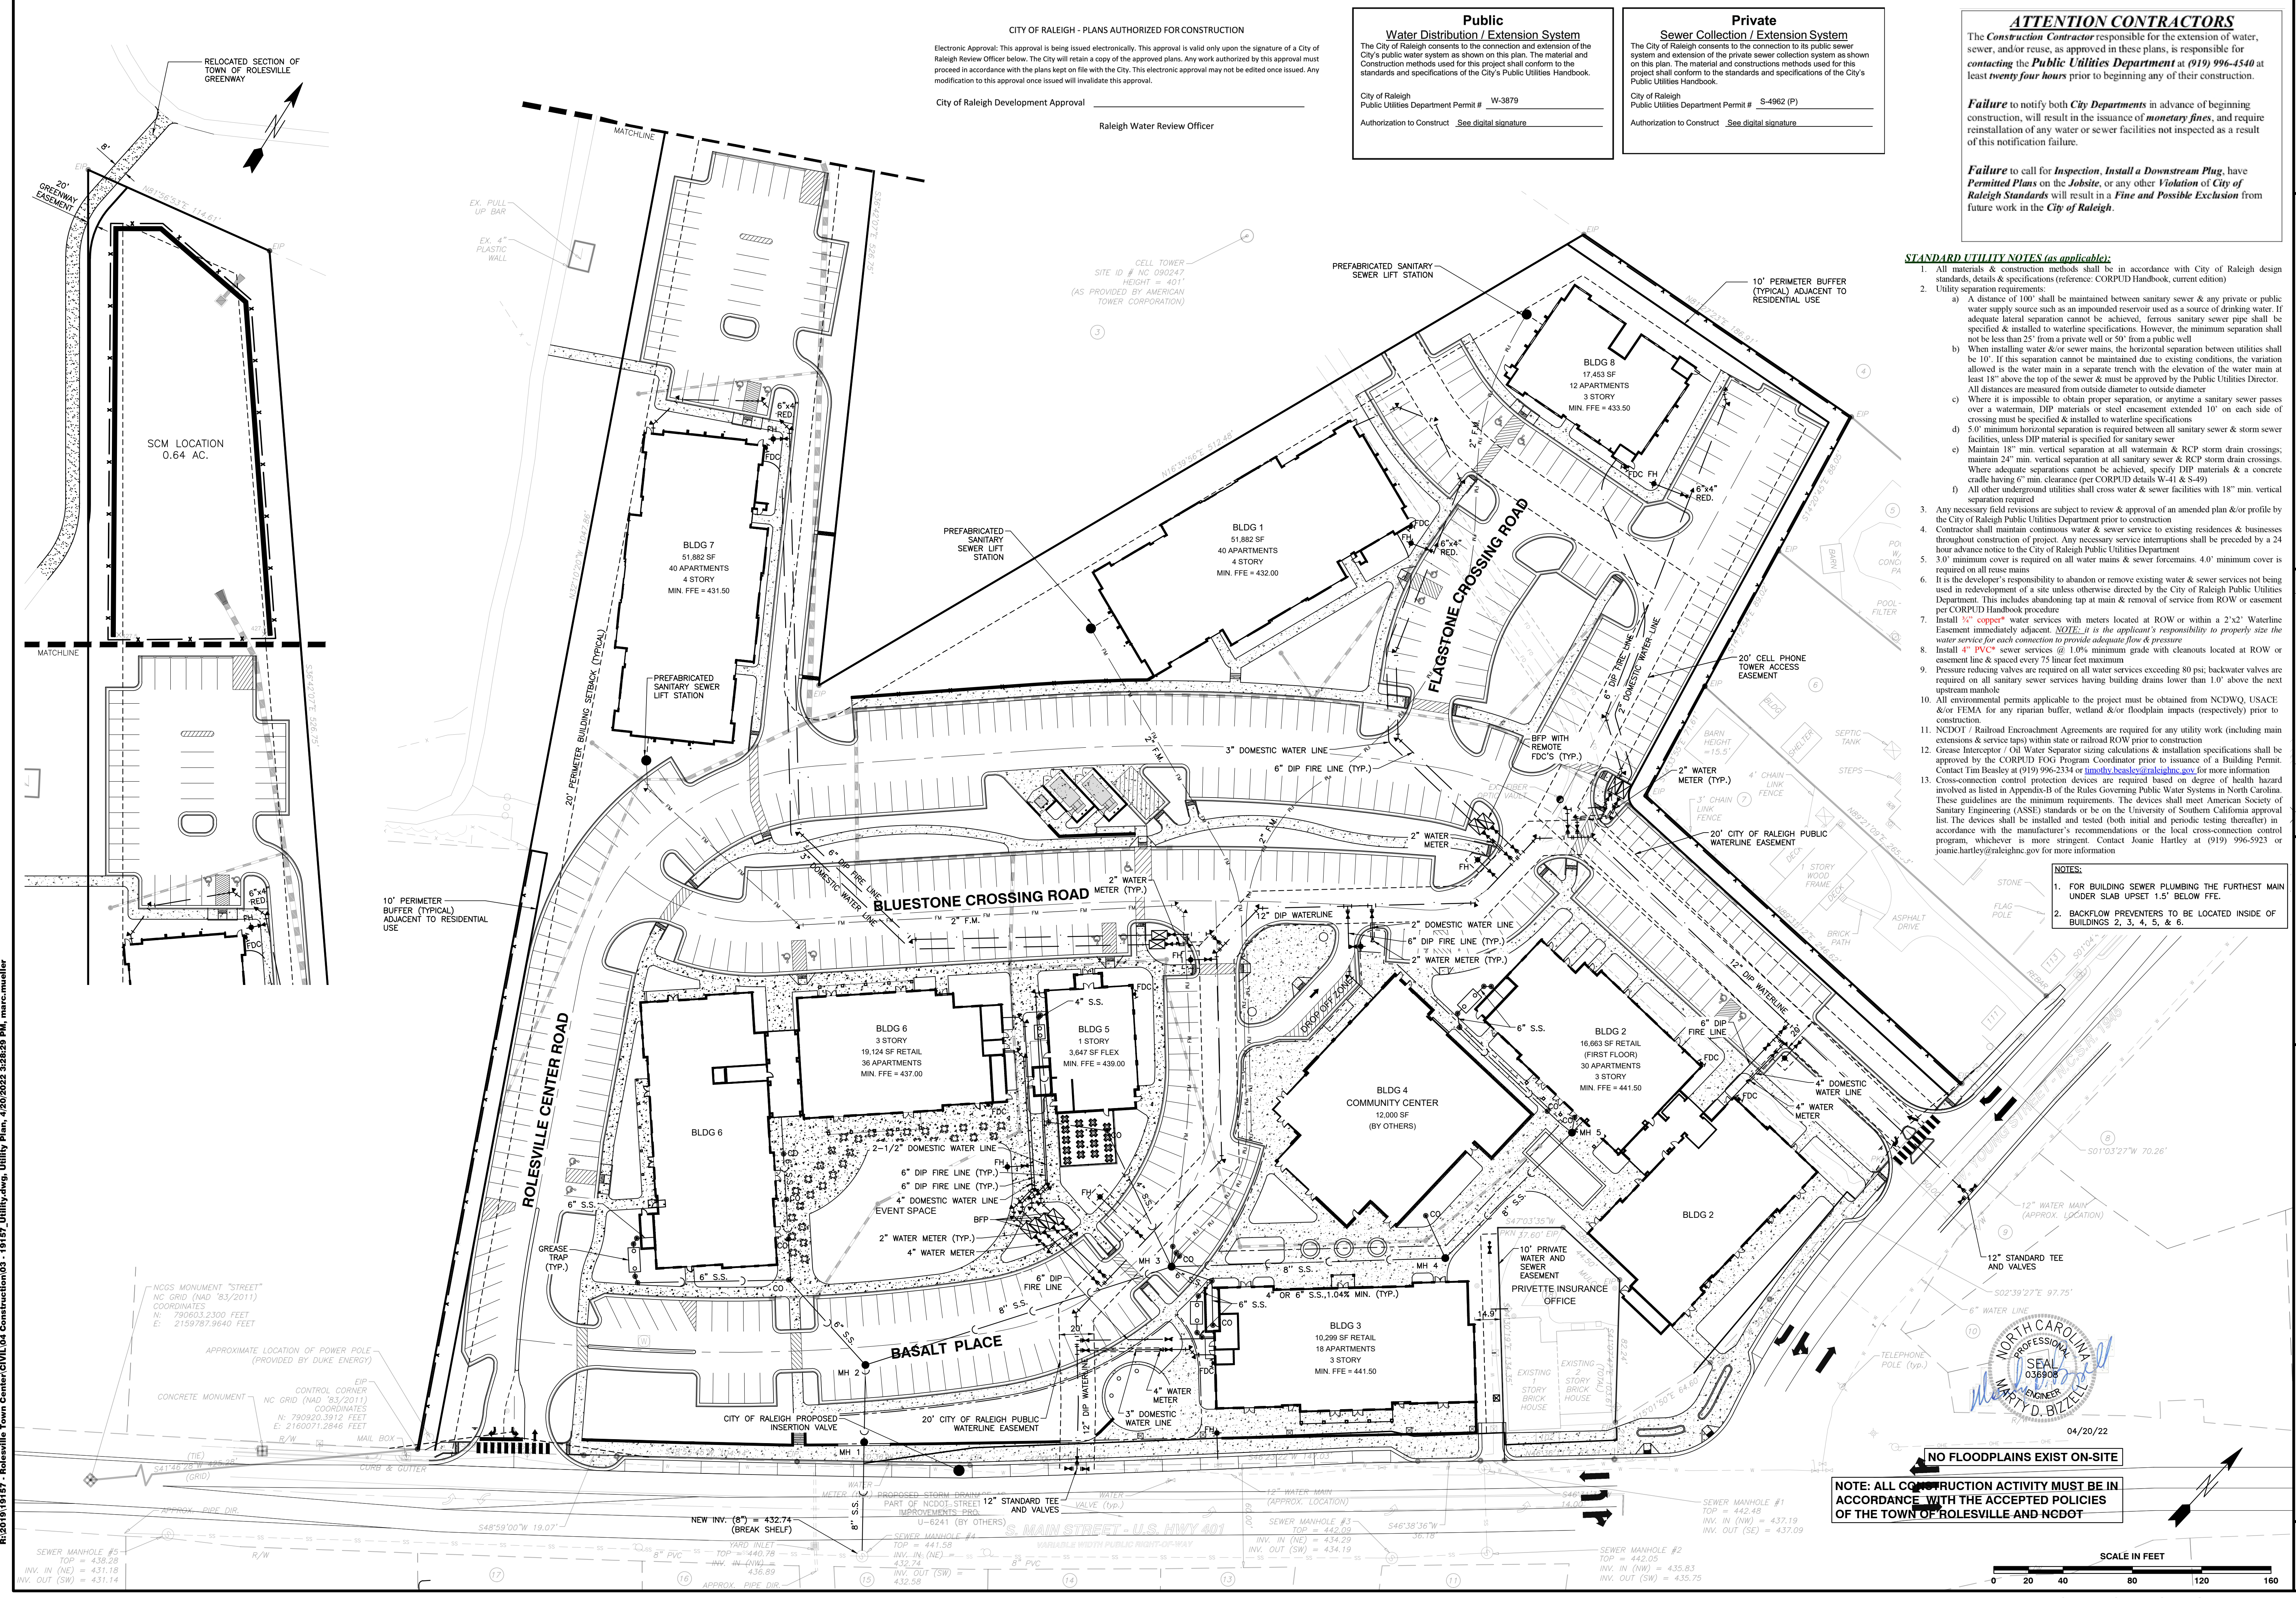

NO FLOODPLAINS EXIST ON-SITE

NOTE: ALL CONSTRUCTION ACTIVITY MUST BE IN ACCORDANCE WITH THE ACCEPTED POLICIES OF THE TOWN OF ROLESVILLE AND NCDOT

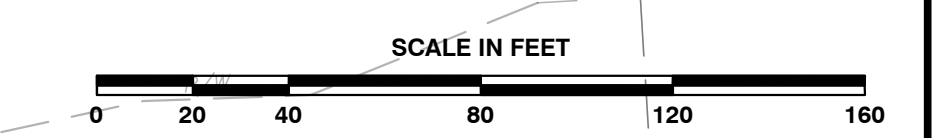

BASS, NIXON & KENNEDY, INC.
CONSULTING ENGINEERS
6310 CHAPEL HILL ROAD, SUITE 250, RALEIGH, NC 27607
TELEPHONE: (919) 981-4422 FAX: (919) 981-6966
CERTIFICATION NUMBERS: NCBELS (C-010); NCBOLA (C-0267)

COBBLESTONE VILLAGE MIXED USE DEVELOPMENT
TOWN OF ROLESVILLE, WAKE COUNTY, NORTH CAROLINA

UTILITY PLAN

DATE: 04/20/22
SCALE: 1" = 40'

NO. DATE DESCRIPTION REVISIONS

03-19187 JOB NO. 03-19187 PROJECT

MRN DRAWN BY
DATE
DATE

CHK BY: MDB

SHEET C2.1

TOWN OF ROLESVILLE PROJECT NO.

NOT RELEASED FOR CONSTRUCTION OR BID SOLICITATION


CITY OF RALEIGH - PLANS AUTHORIZED FOR CONSTRUCTION

Electronic Approval: This approval is being issued electronically. This approval is valid only upon the signature of a City of Raleigh Review Officer below. The City will retain a copy of the approved plans. Any work authorized by this approval must proceed in accordance with the plans kept on file with the City. This electronic approval may not be edited once issued. Any modification to this approval once issued will invalidate this approval.

City of Raleigh Development Approval _____
 Raleigh Water Review Officer _____

| Structure | d _s (ft) | Velocity (fps) | Length (ft) | Width (ft) | Depth (in) | Type | d ₅₀ |
|-----------|------------------------|-------------------|----------------|---------------|---------------|-----------|-----------------|
| FES 1 | 2.00 | 7.4 | 12 | 6 | 22 | Class 'B' | 6" - 13" |
| FES 3 | 3.00 | 6.5 | 18 | 9 | 22 | Class 'B' | 6" - 13" |

* Per NYDOT Dissipator Schedule Fig. 1

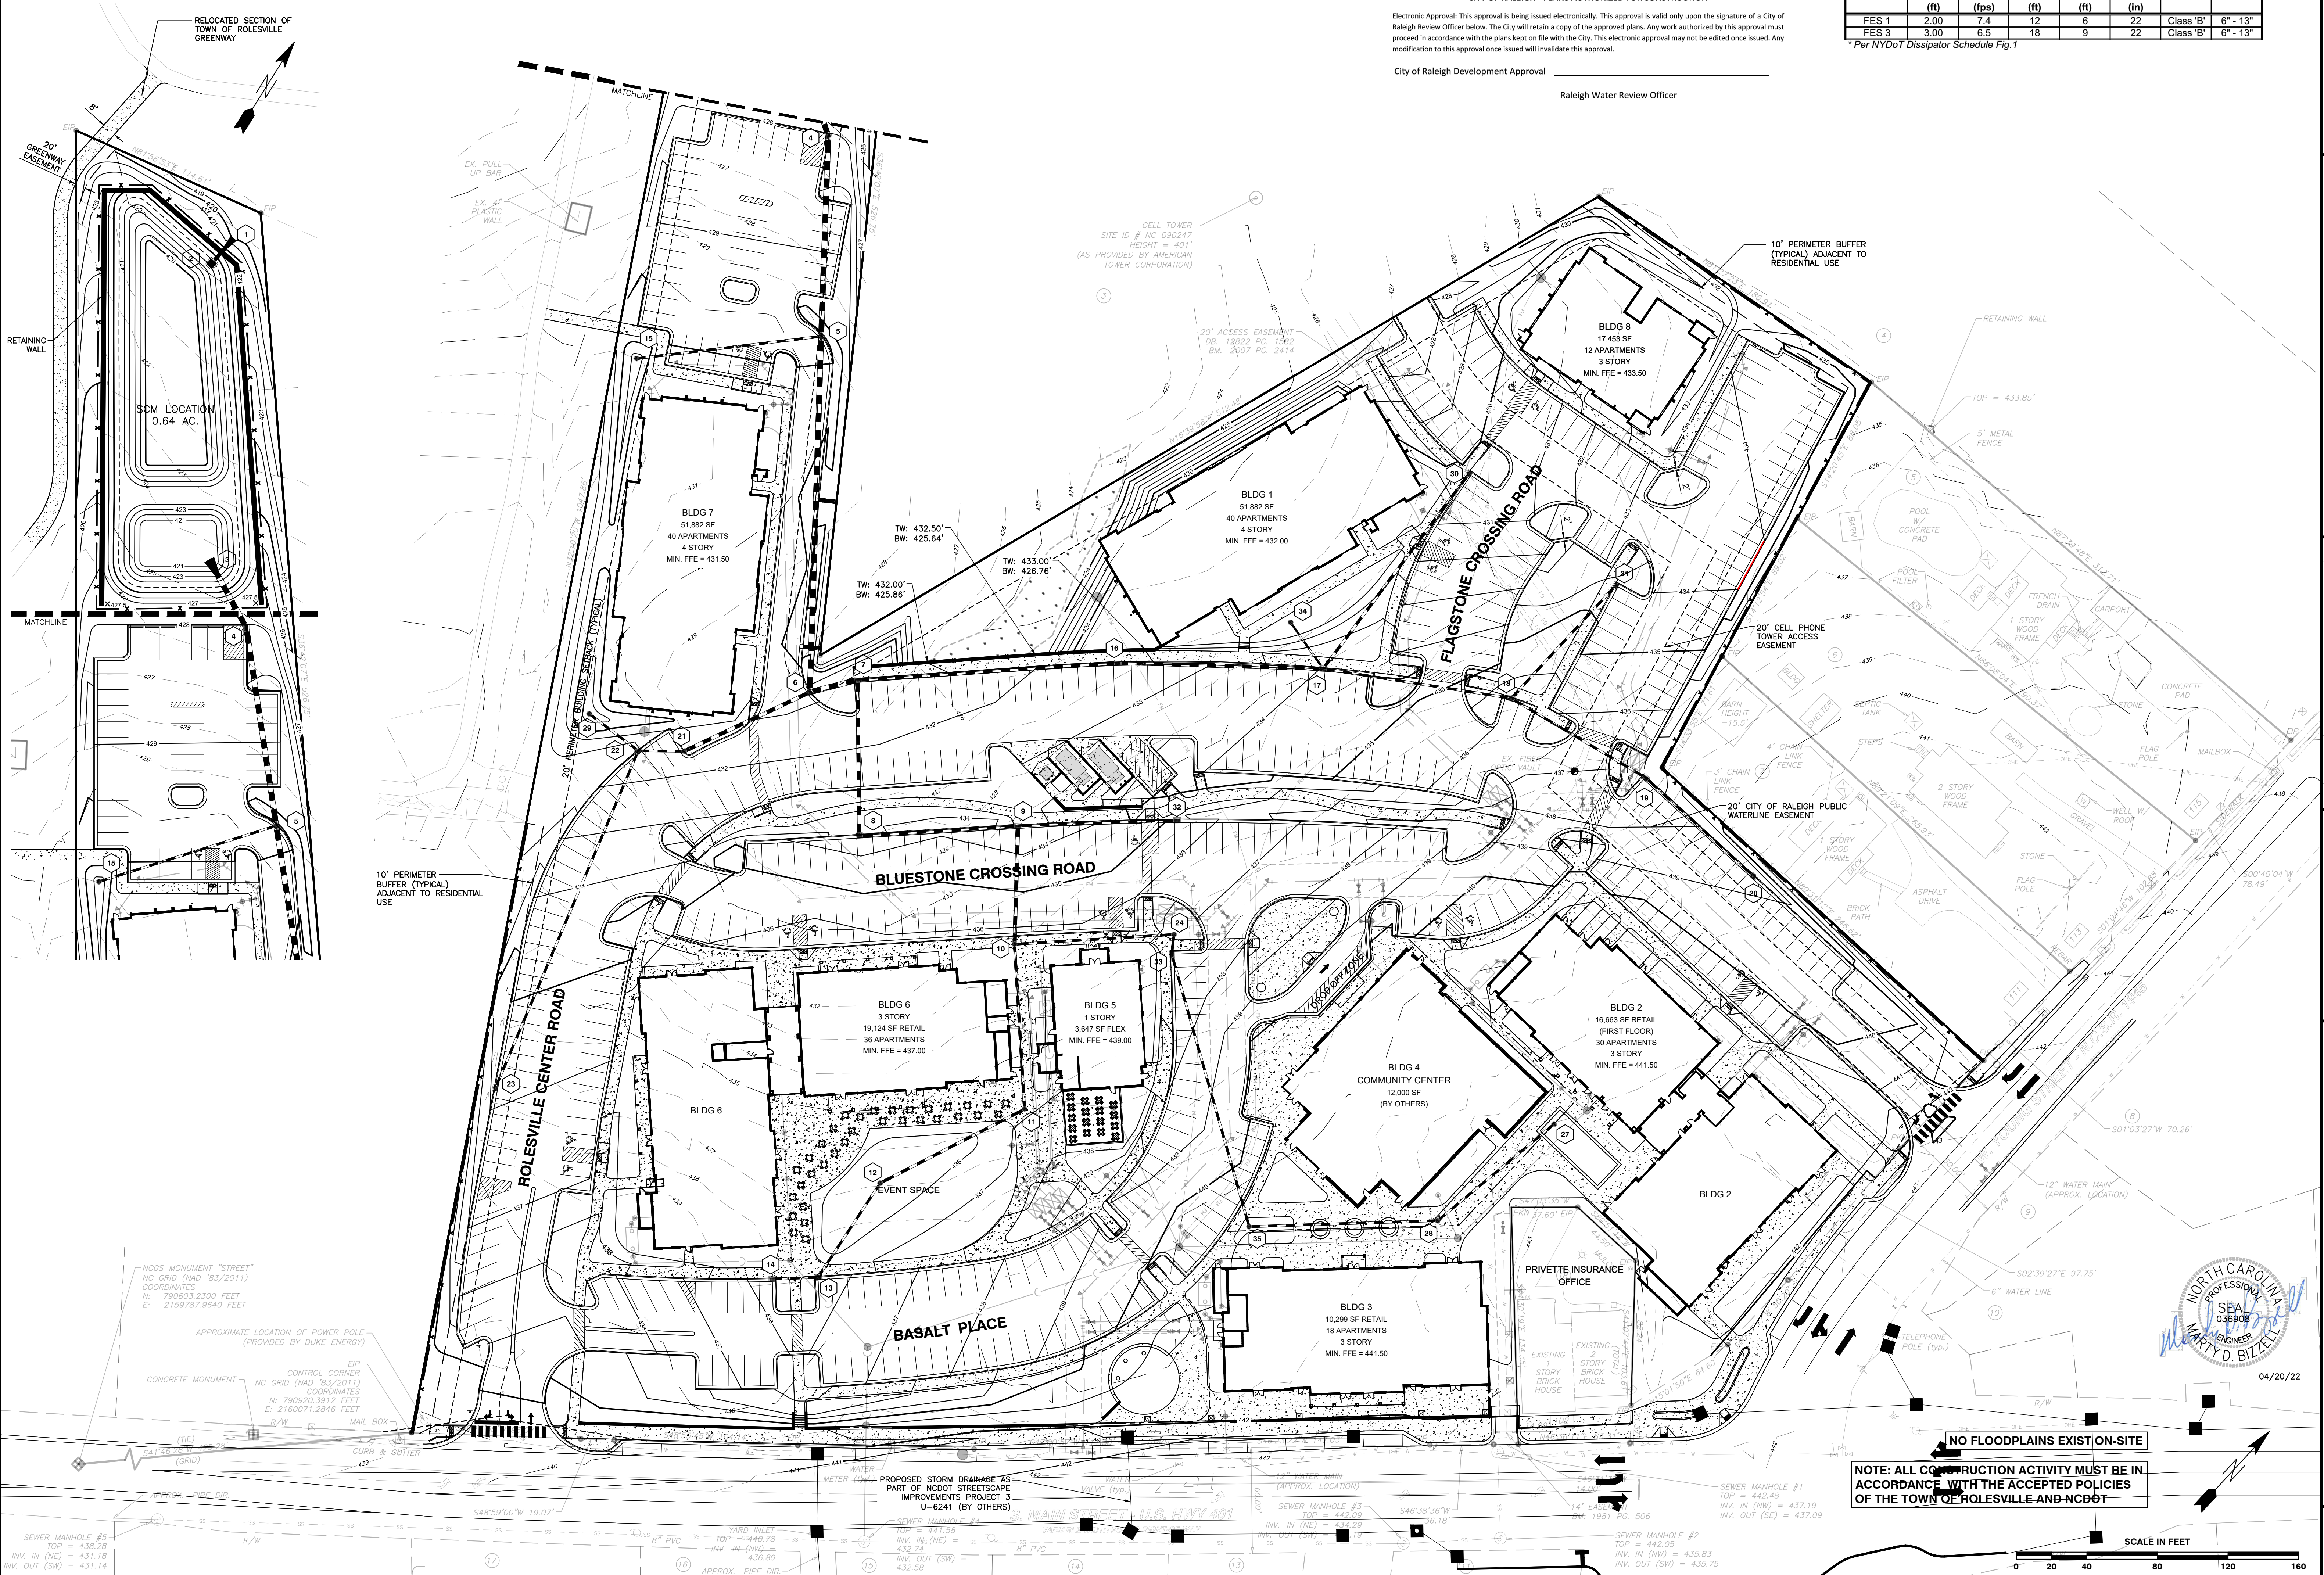

BANK

BASS, NIXON & KENNEDY, INC.
 CONSULTING ENGINEERS
 6310 CHAPEL HILL ROAD, SUITE 950, RALEIGH, NC 27607
 TELEPHONE: (919)881-1422 FAX: (919)881-8686
 CERTIFICATION NUMBERS: NCBELS (C-0110); NCBOLA (C-0267)

| NO. | DATE | DESCRIPTION | BY |
|-----|------|-------------|----|
| | | | |
| | | | |
| | | | |


GRADING PLAN
 SCALE: 1" = 40'
 CHK BY: MDB

COBBLESTONE VILLAGE
 MIXED USE DEVELOPMENT
 TOWN OF ROLESVILLE, WAKE COUNTY, NORTH CAROLINA

SHEET C3.1

NOT RELEASED FOR CONSTRUCTION OR BID SOLICITATION

R:\2019\19187 - Rolesville Town Center\CIVIL\04 Construction\04 - 19187_Grading\dwg, Grading Plan, 4/20/2022 2:29:48 PM, marc.mueller

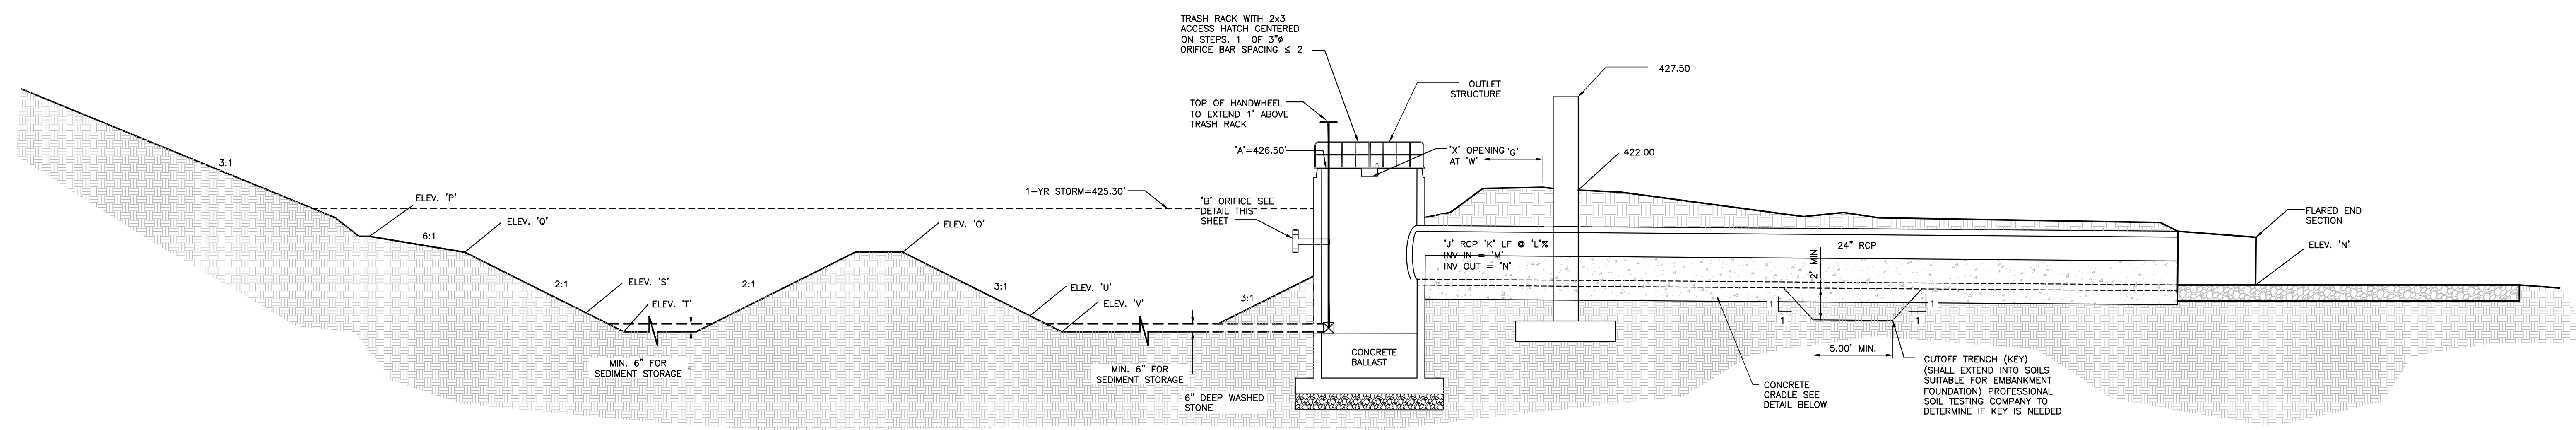


CROSS-SECTION OF WET POND A-A

NTS

BOUYANCY CALCULATIONS FOR RISER/BARREL
COBBLESTONE VILLAGE
WET POND - SCM

| | |
|--|---------|
| Square Riser Inside Length (ft): | 4.0 |
| Riser Wall Thickness (in): | 6 |
| Pond Bottom Elevation (ft): | 420.00 |
| Riser Crest Elevation (ft): | 426.50 |
| Density of Riser Mat (lb/cf): | 150.00 |
| Pipe Inside Diameter (in): | 24 |
| Pipe Wall Thickness (in): | 3 |
| Length of Pipe Exposed (ft): | 1.00 |
| Density H ₂ O (lb/cf): | 62.40 |
| Volume H ₂ O Displaced by Riser (cf): | 131.63 |
| Weight H ₂ O Displaced by Riser (lb): | 8213.40 |
| Volume H ₂ O Displaced by Pipe (cf): | 4.91 |
| Weight H ₂ O Displaced by Pipe (lb): | 306.31 |
| Total Uplift Force (lb): | 8519.71 |
| Weight of Riser (lb): | 4,144 |
| Weight of Pipe (lb): | 285.07 |
| Pipe/Riser Downward Force (lb): | 4408.82 |





| | |
|----------------------------------|--------|
| Ballast Concrete: | |
| Minimum Factor of Safety: | 1.2 |
| Required ballast thickness (in): | 37.02 |
| Provided Ballast Thickness (in): | 40 |
| Total Downward Force (lb): | 10,692 |
| Provided Factor of Safety: | 1.25 |

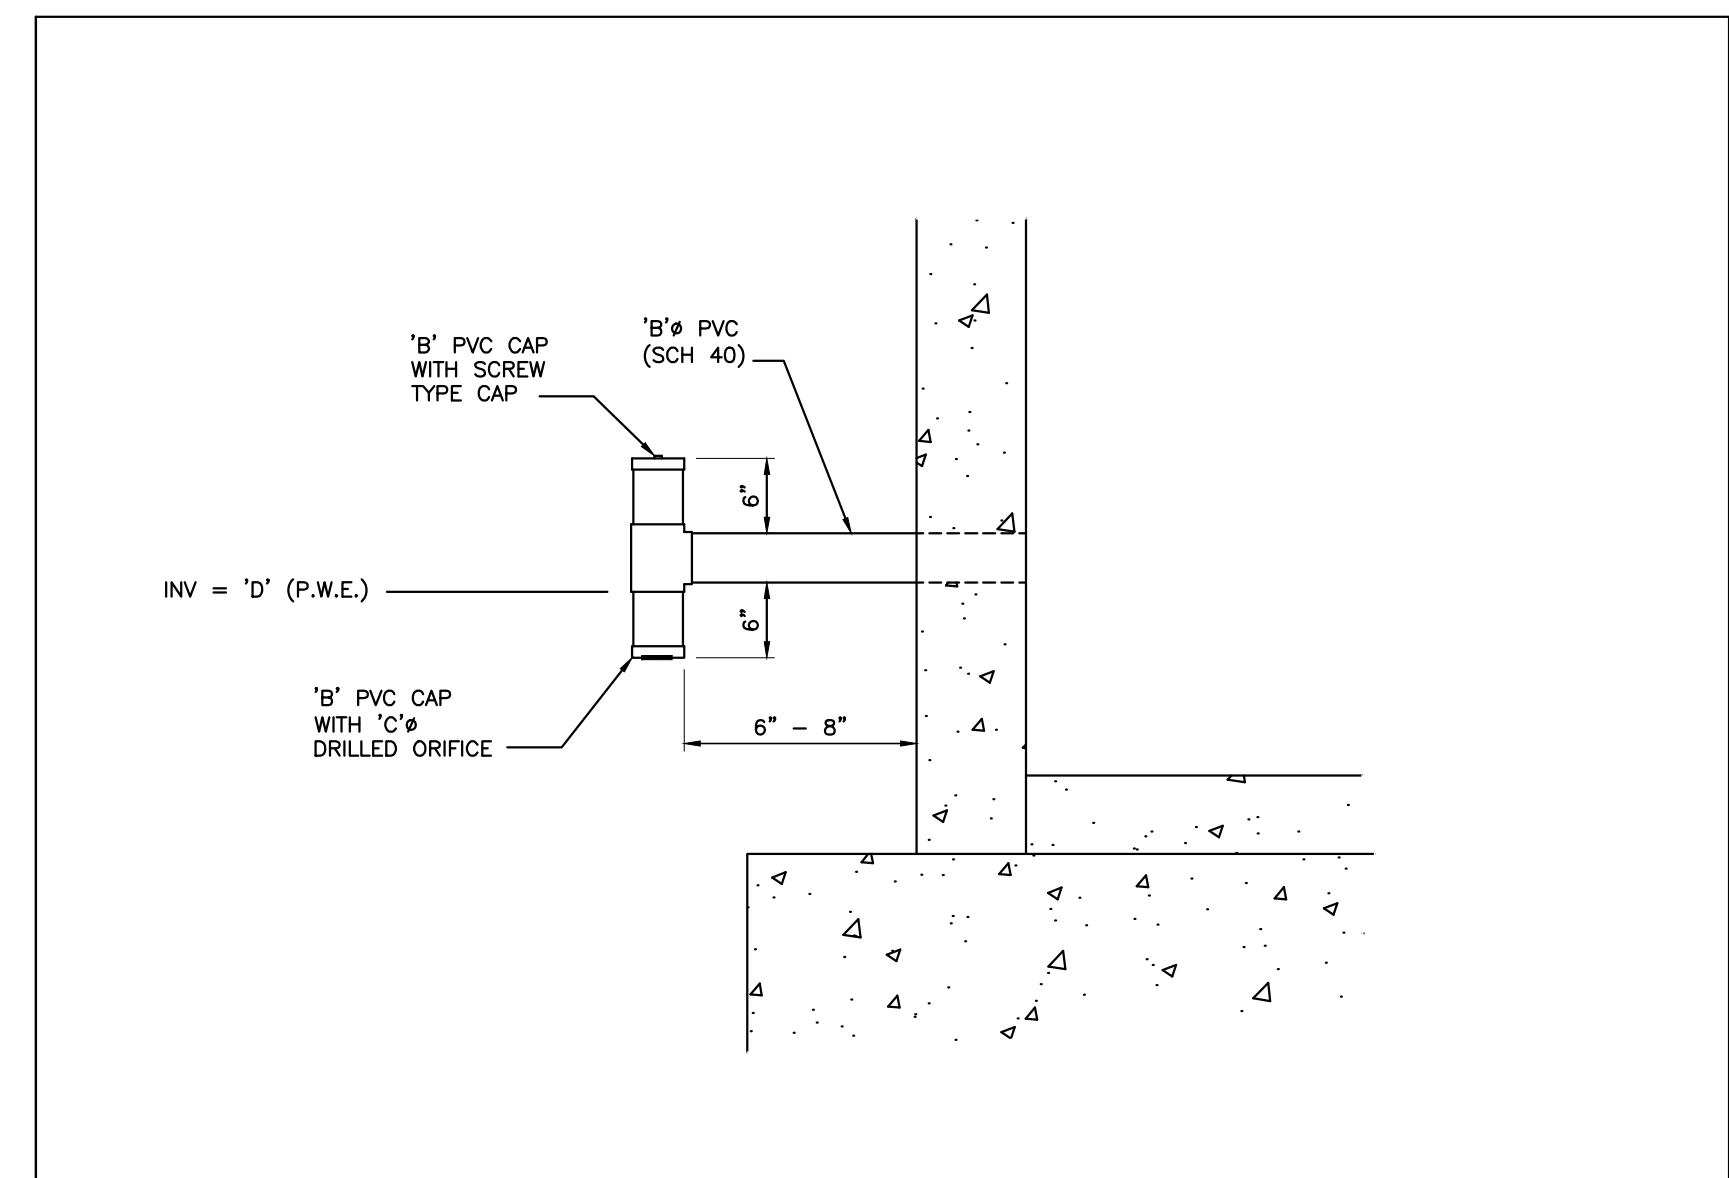

POND LEGEND - SCM

| Description | Design | As-Built |
|--|-----------|----------|
| A Top of Riser | 426.50 ft | |
| B Diameter of PVC Drawdown Pipe | 4 in | |
| C Drawdown Orifice Opening | 2.5 in | |
| D Drawdown Pipe Elevation / Permanent Pool | 424.50 ft | |
| E Inside Bottom Riser Elevation | 420.00 ft | |
| F Outlet Structure Size | 4ft x 4ft | |
| G Top of Berm Width | 10 ft | |
| H Top of Dam | 428.00 ft | |
| I Ballast Thickness | 40 in | |
| J Size of Outlet Pipe | 24 in | |
| K Length of Outlet Pipe | 18 ft | |
| L Slope of Outlet Pipe | 2.78 % | |
| M Invert in Outlet Pipe | 420.00 ft | |
| N Invert Out Outlet Pipe | 419.80 ft | |
| O Top Elevation Forebay Berm | 424.00 ft | |
| P Elevation Top of Litoral Shelf | 425.00 ft | |
| Q Elevation Bottom of Litoral Shelf | 424.00 ft | |
| R Slope of Litoral Shelf | 6:1 | |
| S Sediment Cleanout Elevation Forbay | 422.00 ft | |
| T Bottom Elevation Forebay | 421.00 ft | |
| U Sediment Cleanout Elevation Permanent Pool | 421.00 ft | |
| V Bottom Elevation Permanent Pool | 420.00 ft | |
| W Elevation Secondary Weir | 426.20 ft | |
| X Width Secondary Weir | 12 in | |

Special Instructions
 Place Drawdown pipe opposite of outlet pipe and ensure a minimum of 12" clearance between drawdown pipe opening and ground elevation to allow for proper drainage. Place secondary weir above drawdown pipe on same side of outlet structure.

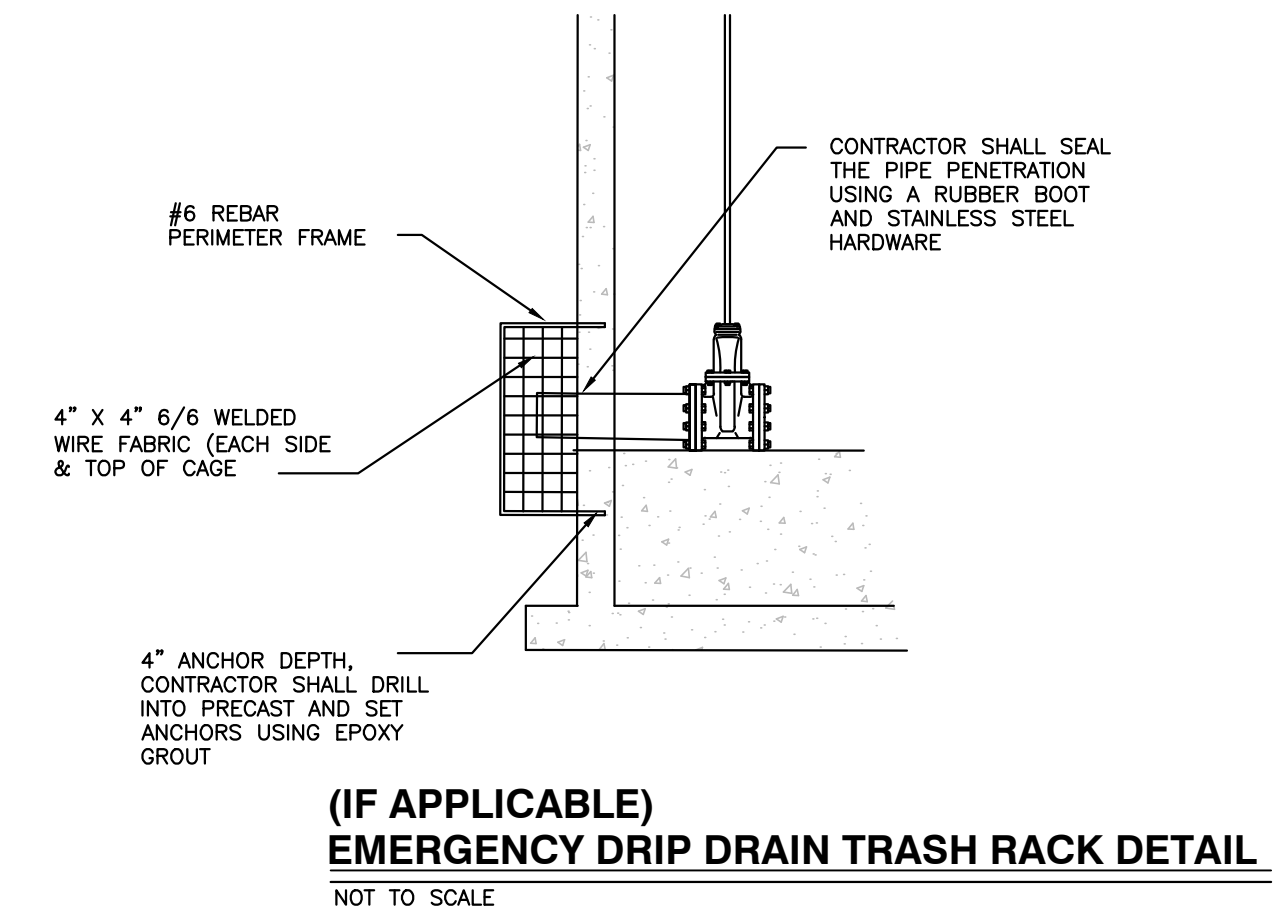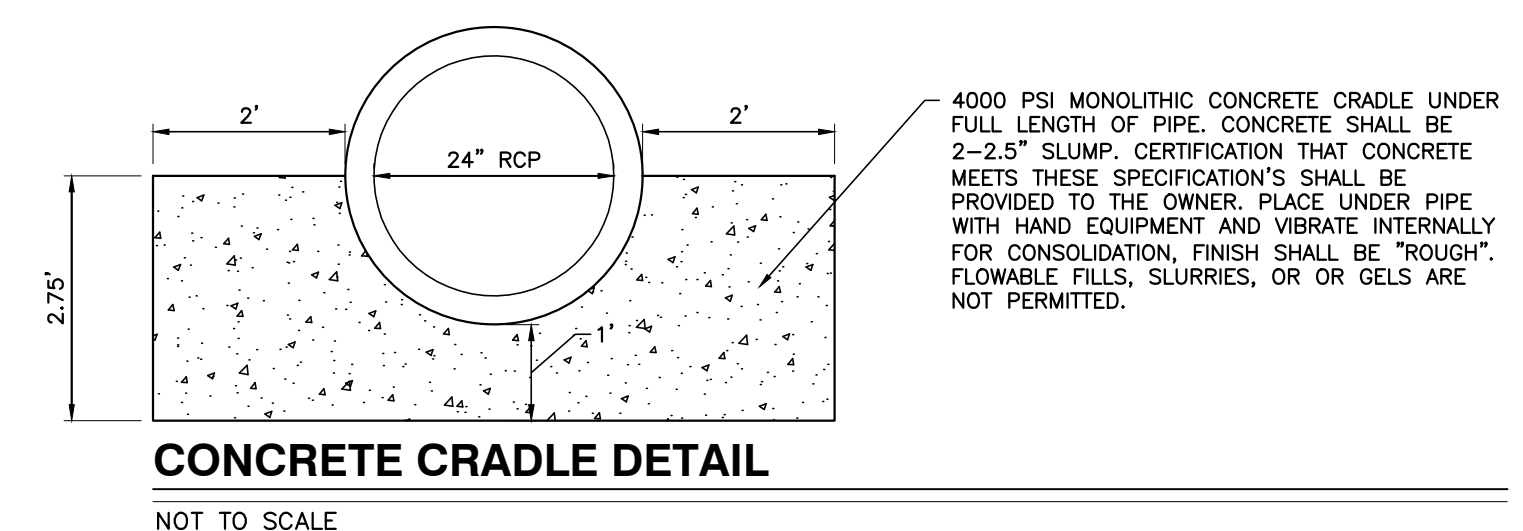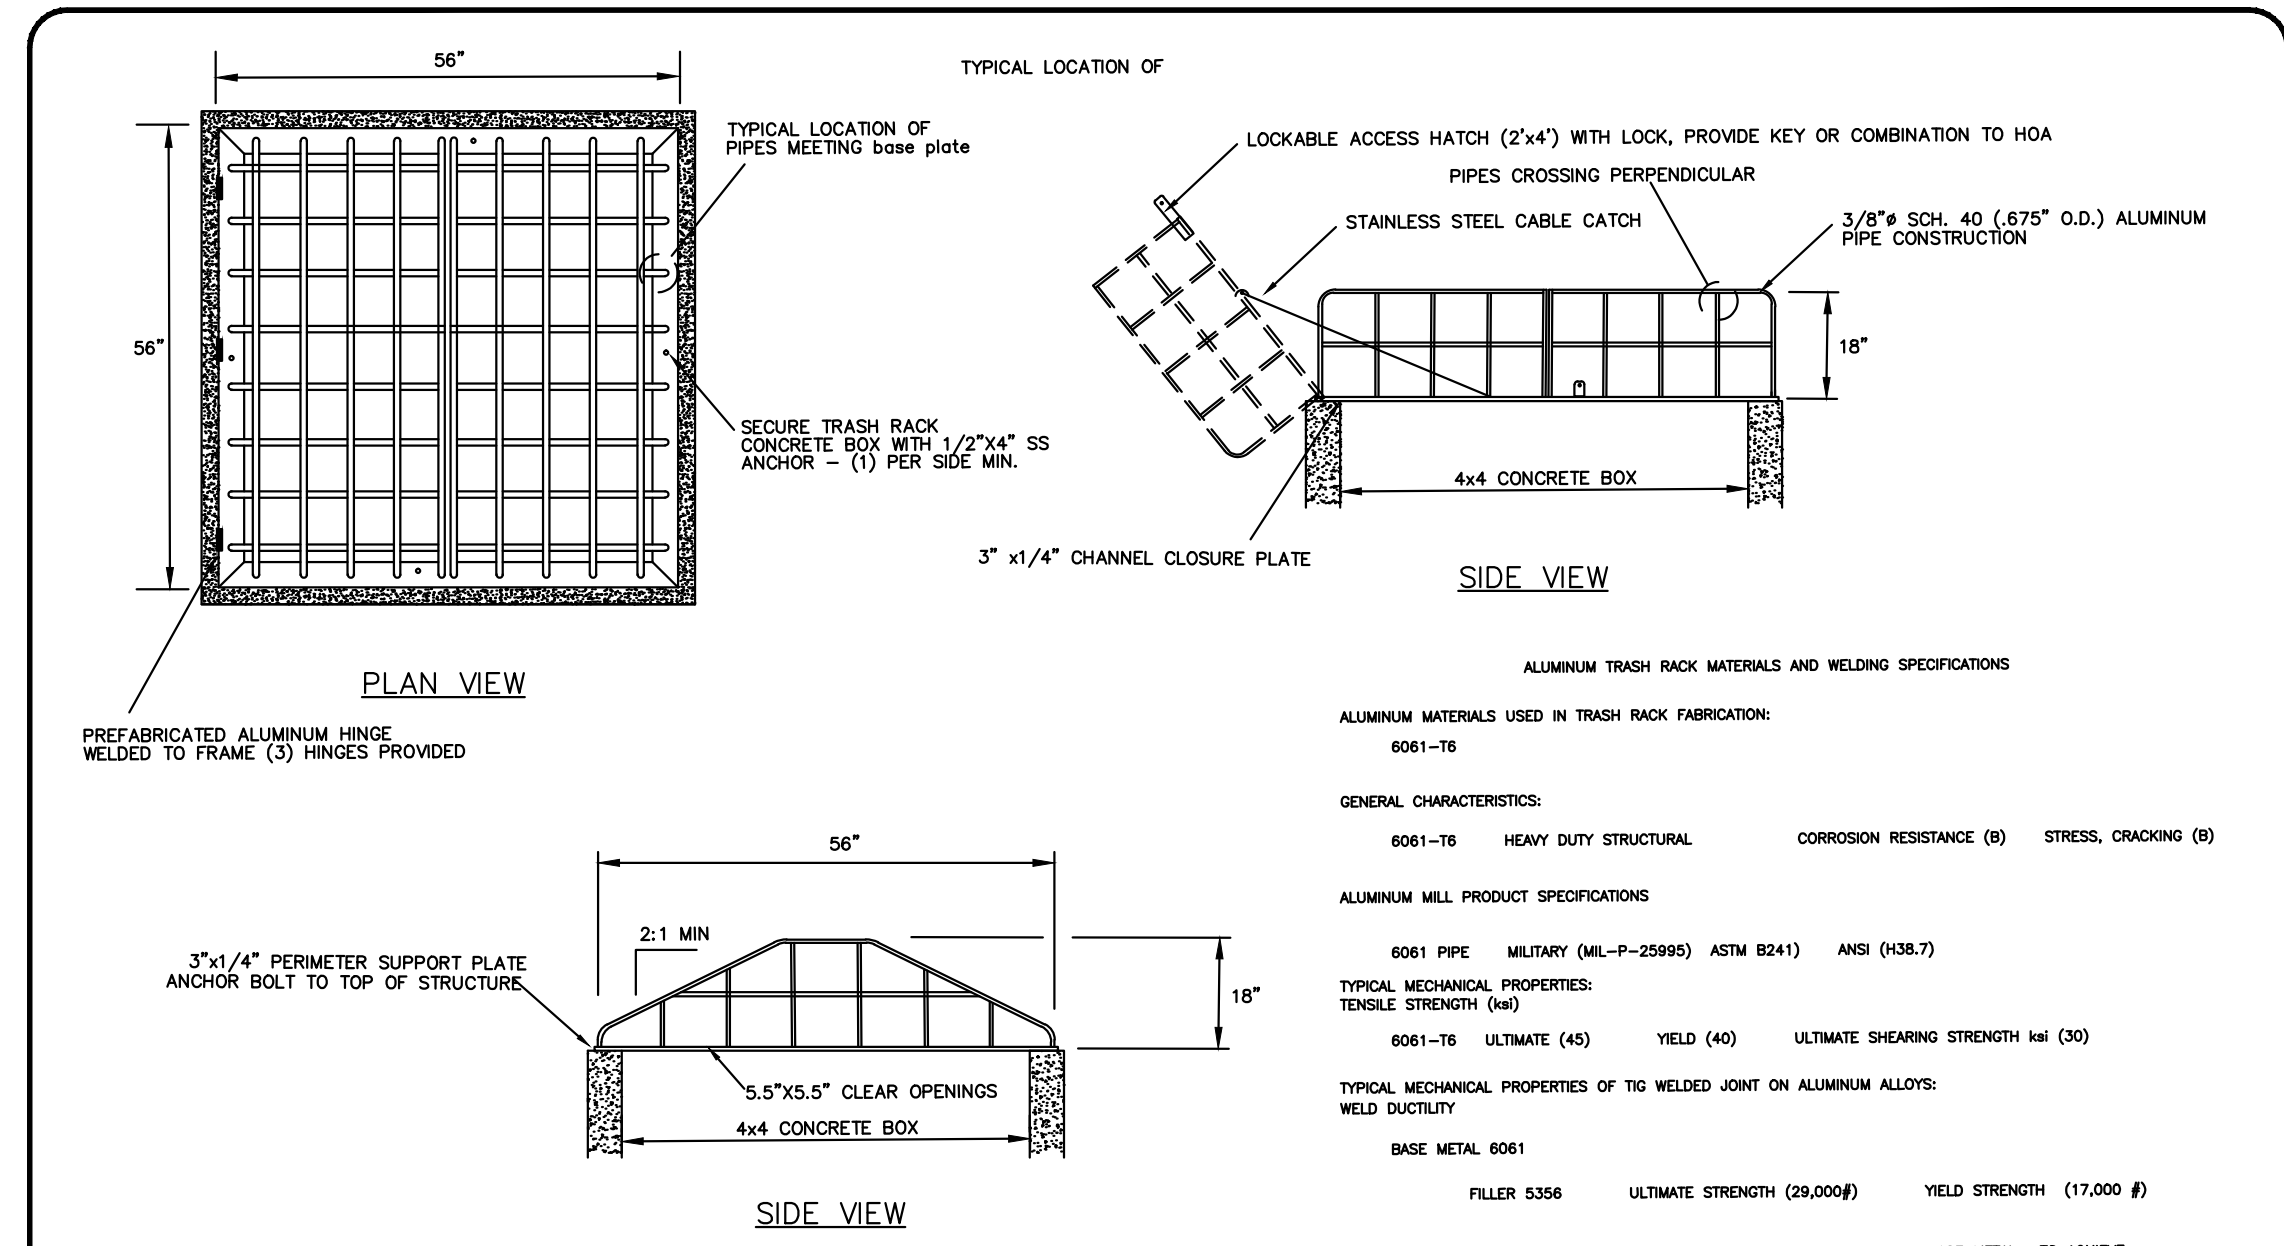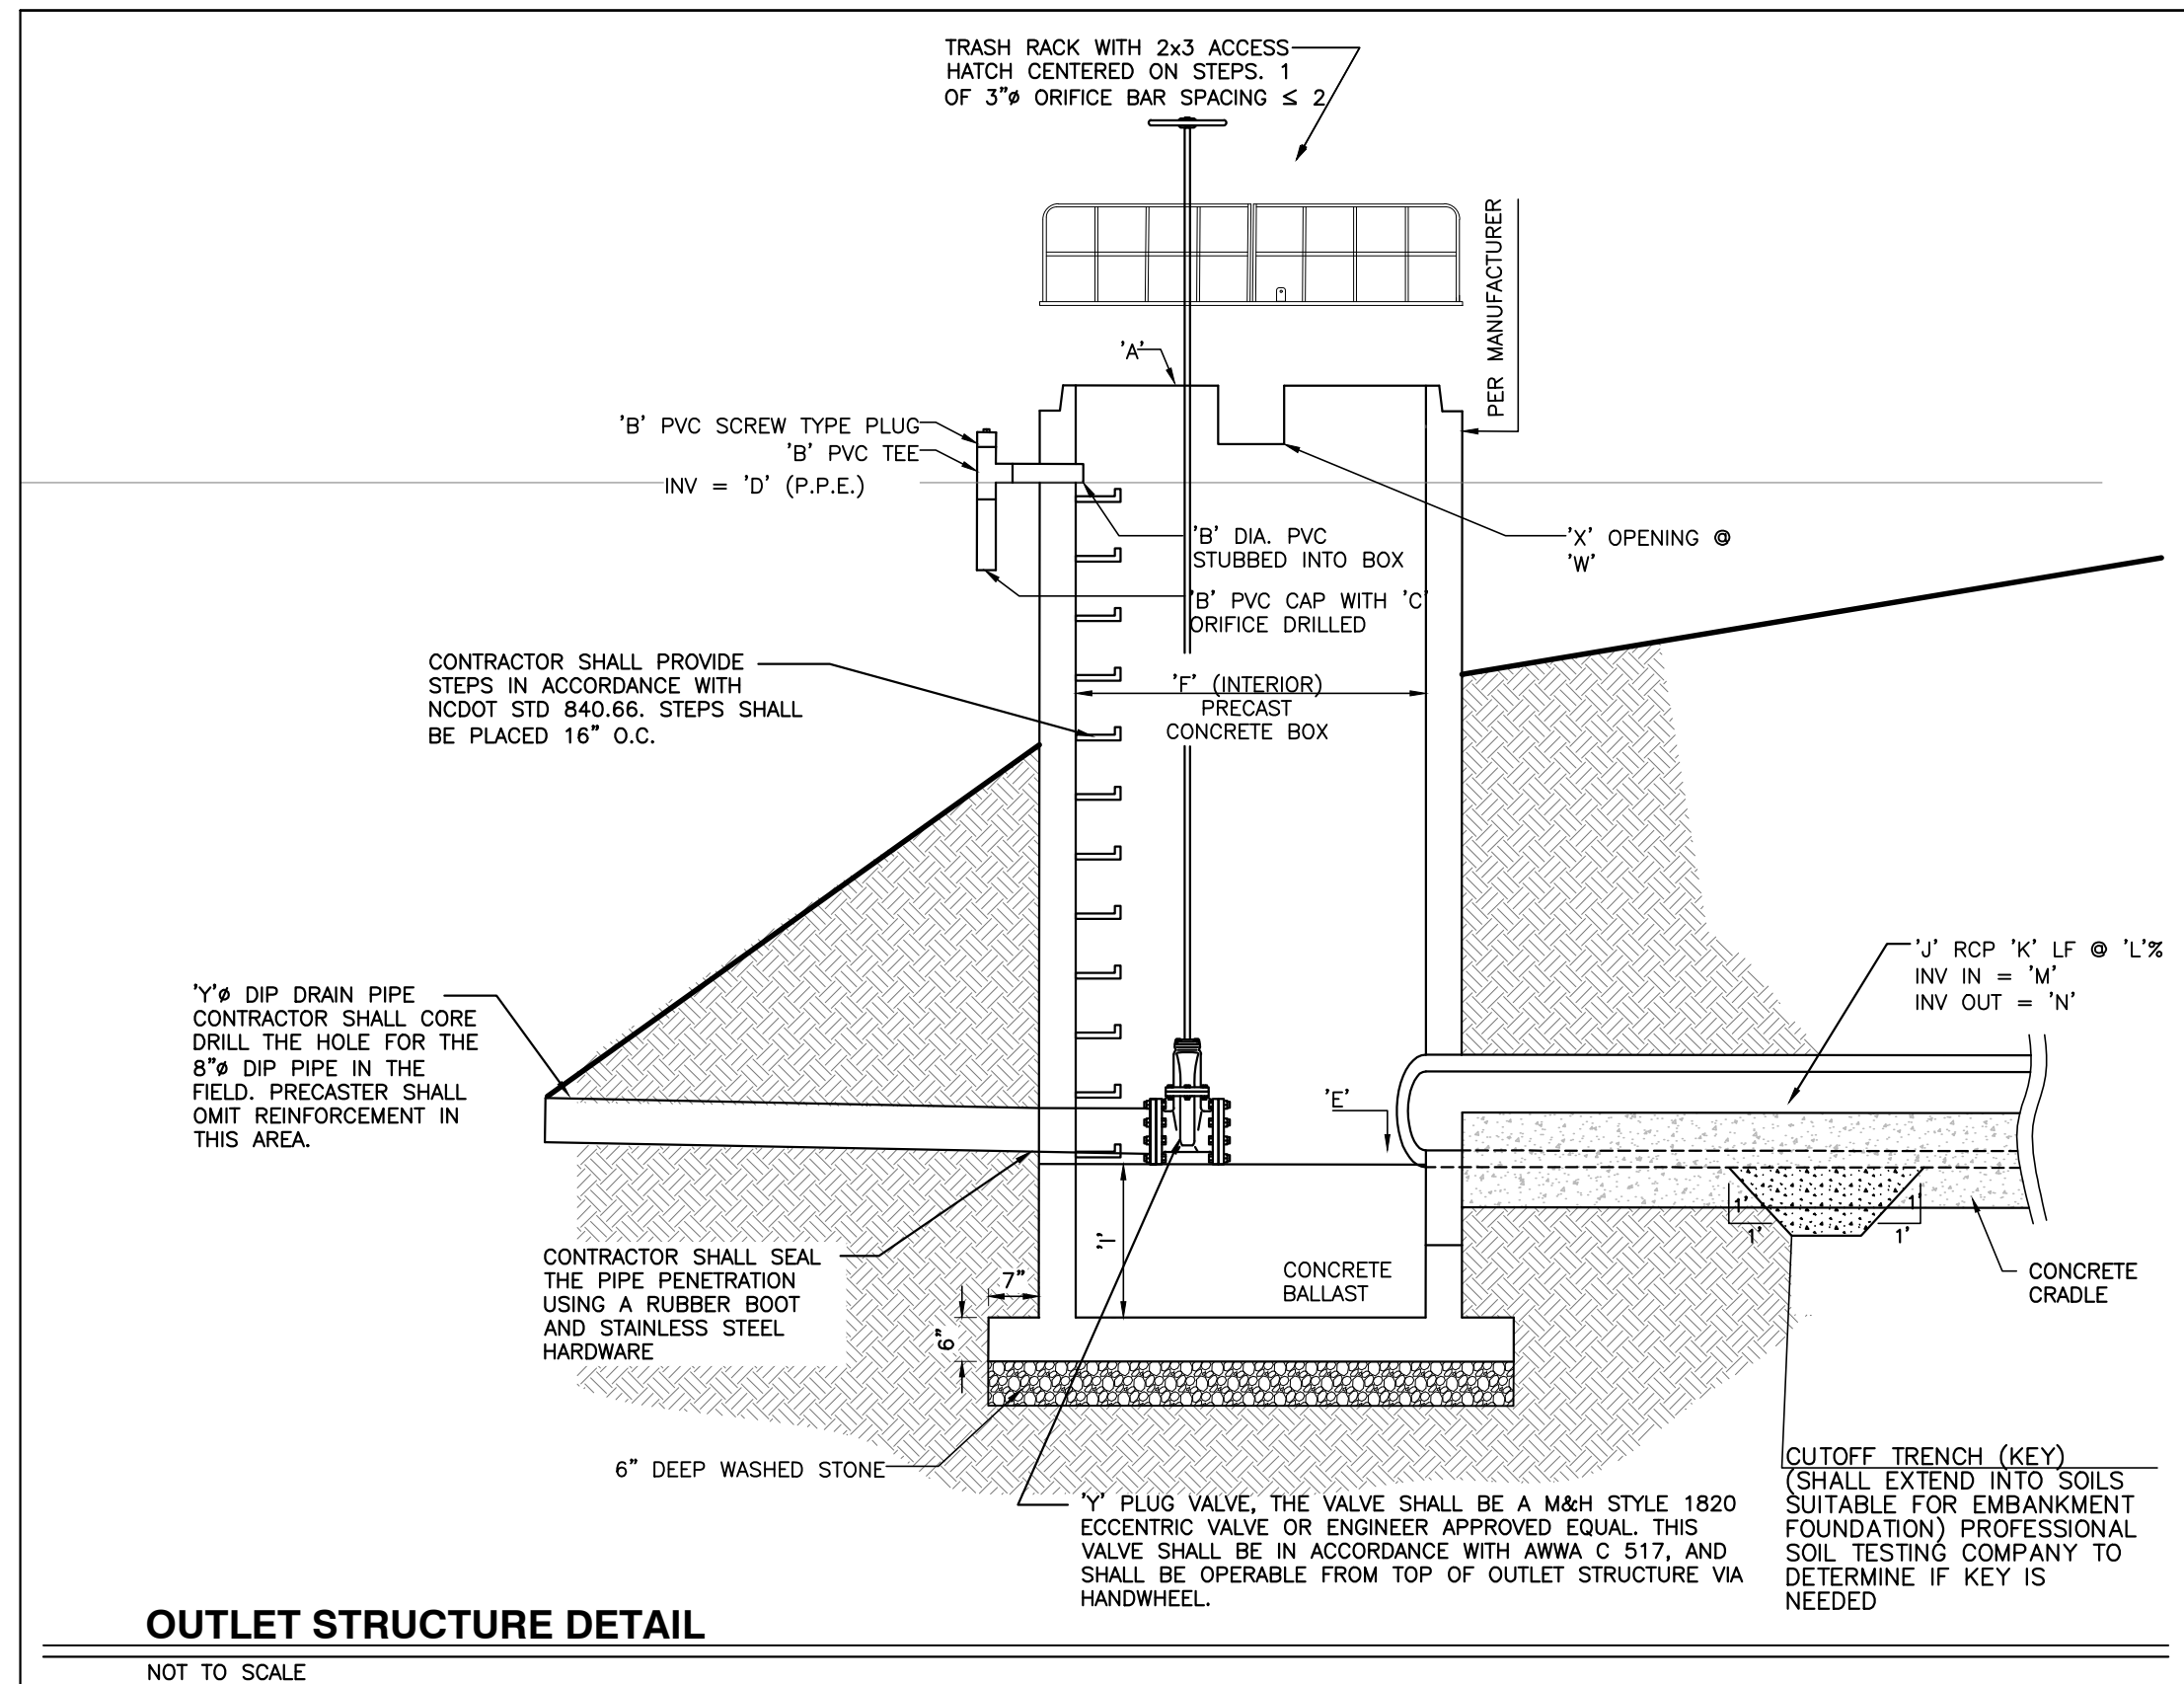

CITY OF RALEIGH - PLANS AUTHORIZED FOR CONSTRUCTION

Electronic Approval: This approval is being issued electronically. This approval is valid only upon the signature of a City of Raleigh Review Officer below. The City will retain a copy of the approved plans. Any work authorized by this approval must proceed in accordance with the plans kept on file with the City. This electronic approval may not be edited once issued. Any modification to this approval once issued will invalidate this approval.

City of Raleigh Development Approval _____

Raleigh Water Review Officer _____

04/20/22

NO FLOODPLAINS EXIST ON-SITE

NOTE: ALL CONSTRUCTION ACTIVITY MUST BE IN ACCORDANCE WITH THE ACCEPTED POLICIES OF THE TOWN OF ROLESVILLE AND NCDOT

| NO. | DATE | DESCRIPTION | BY |
|-----|------|-------------|----|
| | | | |

BMP DETAILS

SCALE: N.T.S. CHK BY: MDB

COBBLESTONE VILLAGE MIXED USE DEVELOPMENT

TOWN OF ROLESVILLE, WAKE COUNTY, NORTH CAROLINA

CONSTRUCTION SEQUENCE - STAGE 1

- ONCE THE EROSION AND SEDIMENT CONTROL PLAN APPROVAL AND NCG01 CERTIFICATE OF COVERAGE ARE OBTAINED, SCHEDULE A PRECONSTRUCTION CONFERENCE WITH THE ENVIRONMENTAL CONSULTANT, OBTAIN A LAND-DISTURBING PERMIT.
- INSTALL GRAVEL CONSTRUCTION PAD, TEMPORARY DIVERSIONS, SILT FENCE, SKIMMER SEDIMENT BASINS AND OTHER MEASURES AS SHOWN ON THE APPROVED PLAN. CLEAR ONLY AS NECESSARY TO INSTALL THESE DEVICES. SEED TEMPORARY DIVERSIONS, BERMS AND BASINS IMMEDIATELY AFTER CONSTRUCTION.
- CALL ENVIRONMENTAL CONSULTANT FOR AN ONSITE INSPECTION BY THE ENVIRONMENTAL CONSULTANT TO OBTAIN A CERTIFICATE OF COMPLIANCE.
- BEGIN CLEARING AND GRUBBING. MAINTAIN DEVICES AS NEEDED. ROUGH GRADE SITE.
- STABILIZE SITE AS AREAS ARE BROUGHT UP TO FINISH GRADE WITH VEGETATION, PAVING, DITCH LININGS, ETC. SEED AND MULCH DENUDEED AREAS PER GROUND STABILIZATION TIME FRAMES.
- STABILIZE SITE AS AREAS ARE BROUGHT UP TO FINISH GRADE WITH VEGETATION, ALLEY PAVING, DITCH LININGS, ETC. SEED AND MULCH DENUDEED AREAS PER GROUND STABILIZATION TIME FRAMES.
- CALL ENVIRONMENTAL CONSULTANT FOR AN ONSITE INSPECTION BY THE ENVIRONMENTAL CONSULTANT PRIOR TO THE REMOVAL OF SKIMMER SEDIMENT BASIN #1.
- CONTINUE TO SOIL EROSION PLAN STAGE 2 ONCE SKIMMER BASIN #1 HAS BEEN REMOVED.

NOTE: WAKE COUNTY MUST GRANT PERMISSION TO CONVERT THE SEDIMENT BASIN OVER TO THE STORMWATER USE PRIOR TO COMPLETING ANY RELATED WORK.
TOTAL DISTURBED AREA = 11.0 AC

DENUDED AREA = 10.96 AC

REQUIRED WAKE COUNTY BASIN REMOVAL AND/OR CONVERSION SEQUENCE

- SCHEDULE A SITE MEETING WITH THE ENVIRONMENTAL CONSULTANT TO DETERMINE IF A BASIN CAN BE REMOVED OR CONVERTED TO A PERMANENT STORMWATER POND, INSTALL SILT FENCING OR OTHER TEMPORARY EROSION CONTROL MEASURES AS NEEDED PRIOR TO REMOVAL OF THE BASIN.
- UTILIZE OUTLET STRUCTURES THAT WITHDRAW WATER FROM THE SEDIMENT BASIN SURFACE FOR DRAW DOWN OF WATER IN BASIN FOR MAINTENANCE OR CLOSE OUT UNLESS INFEASIBLE. SEE REQUIREMENTS OF NCG01 PERMIT PART I, SECTION C, ITEM (4) ENTITLED "DRAW DOWN OF SEDIMENT BASINS FOR MAINTENANCE OR CLOSE OUT" AND REFER TO WAKE COUNTY "FILTER BAG FOR DEWATERING ACTIVITIES" CONSTRUCTION DETAIL.
- REMOVE BASIN(S) AND ASSOCIATED TEMPORARY DIVERSION DITCHES, IF CULVERT PIPES NEED TO BE EXTENDED, PERFORM THIS OPERATION AT THIS TIME. FINE GRADE AREA IN PREPARATION FOR SEEDING.
- PERFORM SEEDBED PREPARATION, SEED, MULCH AND ASPHALT TACK ANY RESULTING BARE AREAS IMMEDIATELY.
- INSTALL VELOCITY DISSIPATORS AND/OR LEVEL SPREADERS AS REQUIRED ON THE EROSION CONTROL PLAN.
- WHEN SITE IS FULLY STABILIZED, CALL ENVIRONMENTAL CONSULTANT FOR APPROVAL OF REMOVING REMAINING TEMPORARY EROSION CONTROL MEASURES AND ADVISE ON WHEN SITE CAN BE ISSUED A CERTIFICATE OF COMPLETION. NOTE: A MEETING SHOULD ALSO BE SCHEDULED WITH THE ENVIRONMENTAL CONSULTANT TO DETERMINE WHEN A BASIN MAY BE CONVERTED FOR STORMWATER USE. SOME MUNICIPALITIES MAY ALSO REQUIRE THIS.

SEDIMENT BASIN SUMMARY CHART

| Sediment Basin Number | 1 | 2 | 3 |
|----------------------------|-------------------------|-------------------------|------------------------|
| Drainage Area (Acres) | 3.42 | 4.61 | 0.6 |
| Orifice (ft) | (0.5)(7.22)(3.42)=12.35 | (0.5)(7.22)(4.61)=16.64 | (0.5)(7.22)(0.60)=2.17 |
| Weir Size (ft) | 10 x 1.5 | 10 x 1.5 | 10 x 1.5 |
| Surface Area Required (SF) | (435)(12.35)=5,372 | (435)(16.64)=7,238 | (435)(2.17)=944 |
| Volume Required (CF) | (1800)(3.42)=6,156 | (1800)(4.61)=8,298 | (1800)(0.60)=1,080 |
| Dimensions (ft) | see plans | see plans | see plans |
| Surface Area Provided (SF) | 5,400 | 10,640 | 1,584 |
| Volume Provided (CF) | 13,572 | 27,636 | 2,563 |
| Skimmer Size | 4" | 4" | 3" |
| Orifice Radius | 0.5" | 0.5" | 0.25 |
| Orifice Diameter | 1.0" | 1.25" | 0.5 |
| Drawdown Time (days) | 4.62 | 3.98 | 3.74 |
| Number of Baffles | 3 | 3 | 3 |

DITCH/CHANNEL CALCULATIONS

| DIVERSION DITCH ID | LENGTH (LF) | DA (Ac) | Q10 (CFS) | SLOPE (%) | V10 (FPS) | LINER* | PERMISSIBLE SHEAR STRESS (PSF) | CALCULATED SHEAR STRESS (PSF) |
|--------------------|-------------|---------|-----------|-----------|-----------|--------|--------------------------------|-------------------------------|
| DV-1 | 296 | 1.02 | 2.34 | 2.00 | 2.01 | SC150 | 2.00 | 0.78 |
| DV-2 | 495 | 1.00 | 2.30 | 2.60 | 2.29 | SC150 | 2.00 | 0.84 |
| DV-3 | 442 | 0.52 | 1.19 | 1.80 | 0.92 | SC150 | 1.80 | 0.29 |
| DV-4 | 167 | 0.08 | 0.13 | 2.90 | 0.96 | SC150 | 1.80 | 0.38 |

*NAG = NORTH AMERICAN GREEN OR EQUIVALENT

CITY OF RALEIGH - PLANS AUTHORIZED FOR CONSTRUCTION

Electronic Approval: This approval is being issued electronically. This approval is valid only upon the signature of a City of Raleigh Review Officer below. The City will retain a copy of the approved plans. Any work authorized by this approval must proceed in accordance with the plans kept on file with the City. This electronic approval may not be edited once issued. Any modification to this approval once issued will invalidate this approval.

City of Raleigh Development Approval _____
Raleigh Water Review Officer _____

Skimmer Basin #1

Okay

- 3.42 Drainage Area (Acres)
- 16.64 Peak Flow from 10-year Storm (cfs)
- 6156 Required Volume (ft³)
- 6372 Required Surface Area (ft²)
- 51.8 Suggested Width (ft)
- 103.7 Suggested Length (ft)
- 54 Trial Top Width at Spillway Invert (ft)
- 100 Trial Top Length at Spillway Invert (ft)
- 2 Trial Side Slope Ratio Z:1
- 3 Trial Depth (ft) (2 to 3.5 feet above grade)
- 48 Bottom Width (ft)
- 48 Bottom Length (ft)
- 3606 Bottom Area (ft²)
- 1572 Actual Volume (ft³)
- 5400 Actual Surface Area (ft²)
- 10 Trial Weir Length (ft)
- 0.75 Suggested Trial Depth of Flow (ft)
- 30.0 Spillway Capacity (cfs)

Skimmer Basin #2

Okay

- 4.61 Drainage Area (Acres)
- 16.64 Peak Flow from 10-year Storm (cfs)
- 8298 Required Volume (ft³)
- 7238 Required Surface Area (ft²)
- 60.2 Suggested Width (ft)
- 120.3 Suggested Length (ft)
- 56 Trial Top Width at Spillway Invert (ft)
- 190 Trial Top Length at Spillway Invert (ft)
- 2 Trial Side Slope Ratio Z:1
- 3 Trial Depth (ft) (2 to 3.5 feet above grade)
- 44 Bottom Width (ft)
- 178 Bottom Length (ft)
- 3606 Bottom Area (ft²)
- 2763 Actual Volume (ft³)
- 10640 Actual Surface Area (ft²)
- 20 Trial Weir Length (ft)
- 0.75 Suggested Trial Depth of Flow (ft)
- 39.0 Spillway Capacity (cfs)


Skimmer Basin #3

Okay

- 0.6 Drainage Area (Acres)
- 2.17 Peak Flow from 10-year Storm (cfs)
- 1080 Required Volume (ft³)
- 944 Required Surface Area (ft²)
- 21.7 Suggested Width (ft)
- 43.4 Suggested Length (ft)
- 33 Trial Top Width at Spillway Invert (ft)
- 48 Trial Top Length at Spillway Invert (ft)
- 2 Trial Side Slope Ratio Z:1
- 2 Trial Depth (ft) (2 to 3.5 feet above grade)
- 25 Bottom Width (ft)
- 40 Bottom Length (ft)
- 1000 Bottom Area (ft²)
- 2563 Actual Volume (ft³)
- 1584 Actual Surface Area (ft²)
- 10 Trial Weir Length (ft)
- 0.75 Suggested Trial Depth of Flow (ft)
- 19.3 Spillway Capacity (cfs)

Skimmer Size (Inches)

- 0.333 Head on Skimmer (feet)
- 1.25 Orifice Size (1/4 inch increments)
- 4.62 Dewatering Time (days)
- Required 3 to 5 days for Wake County

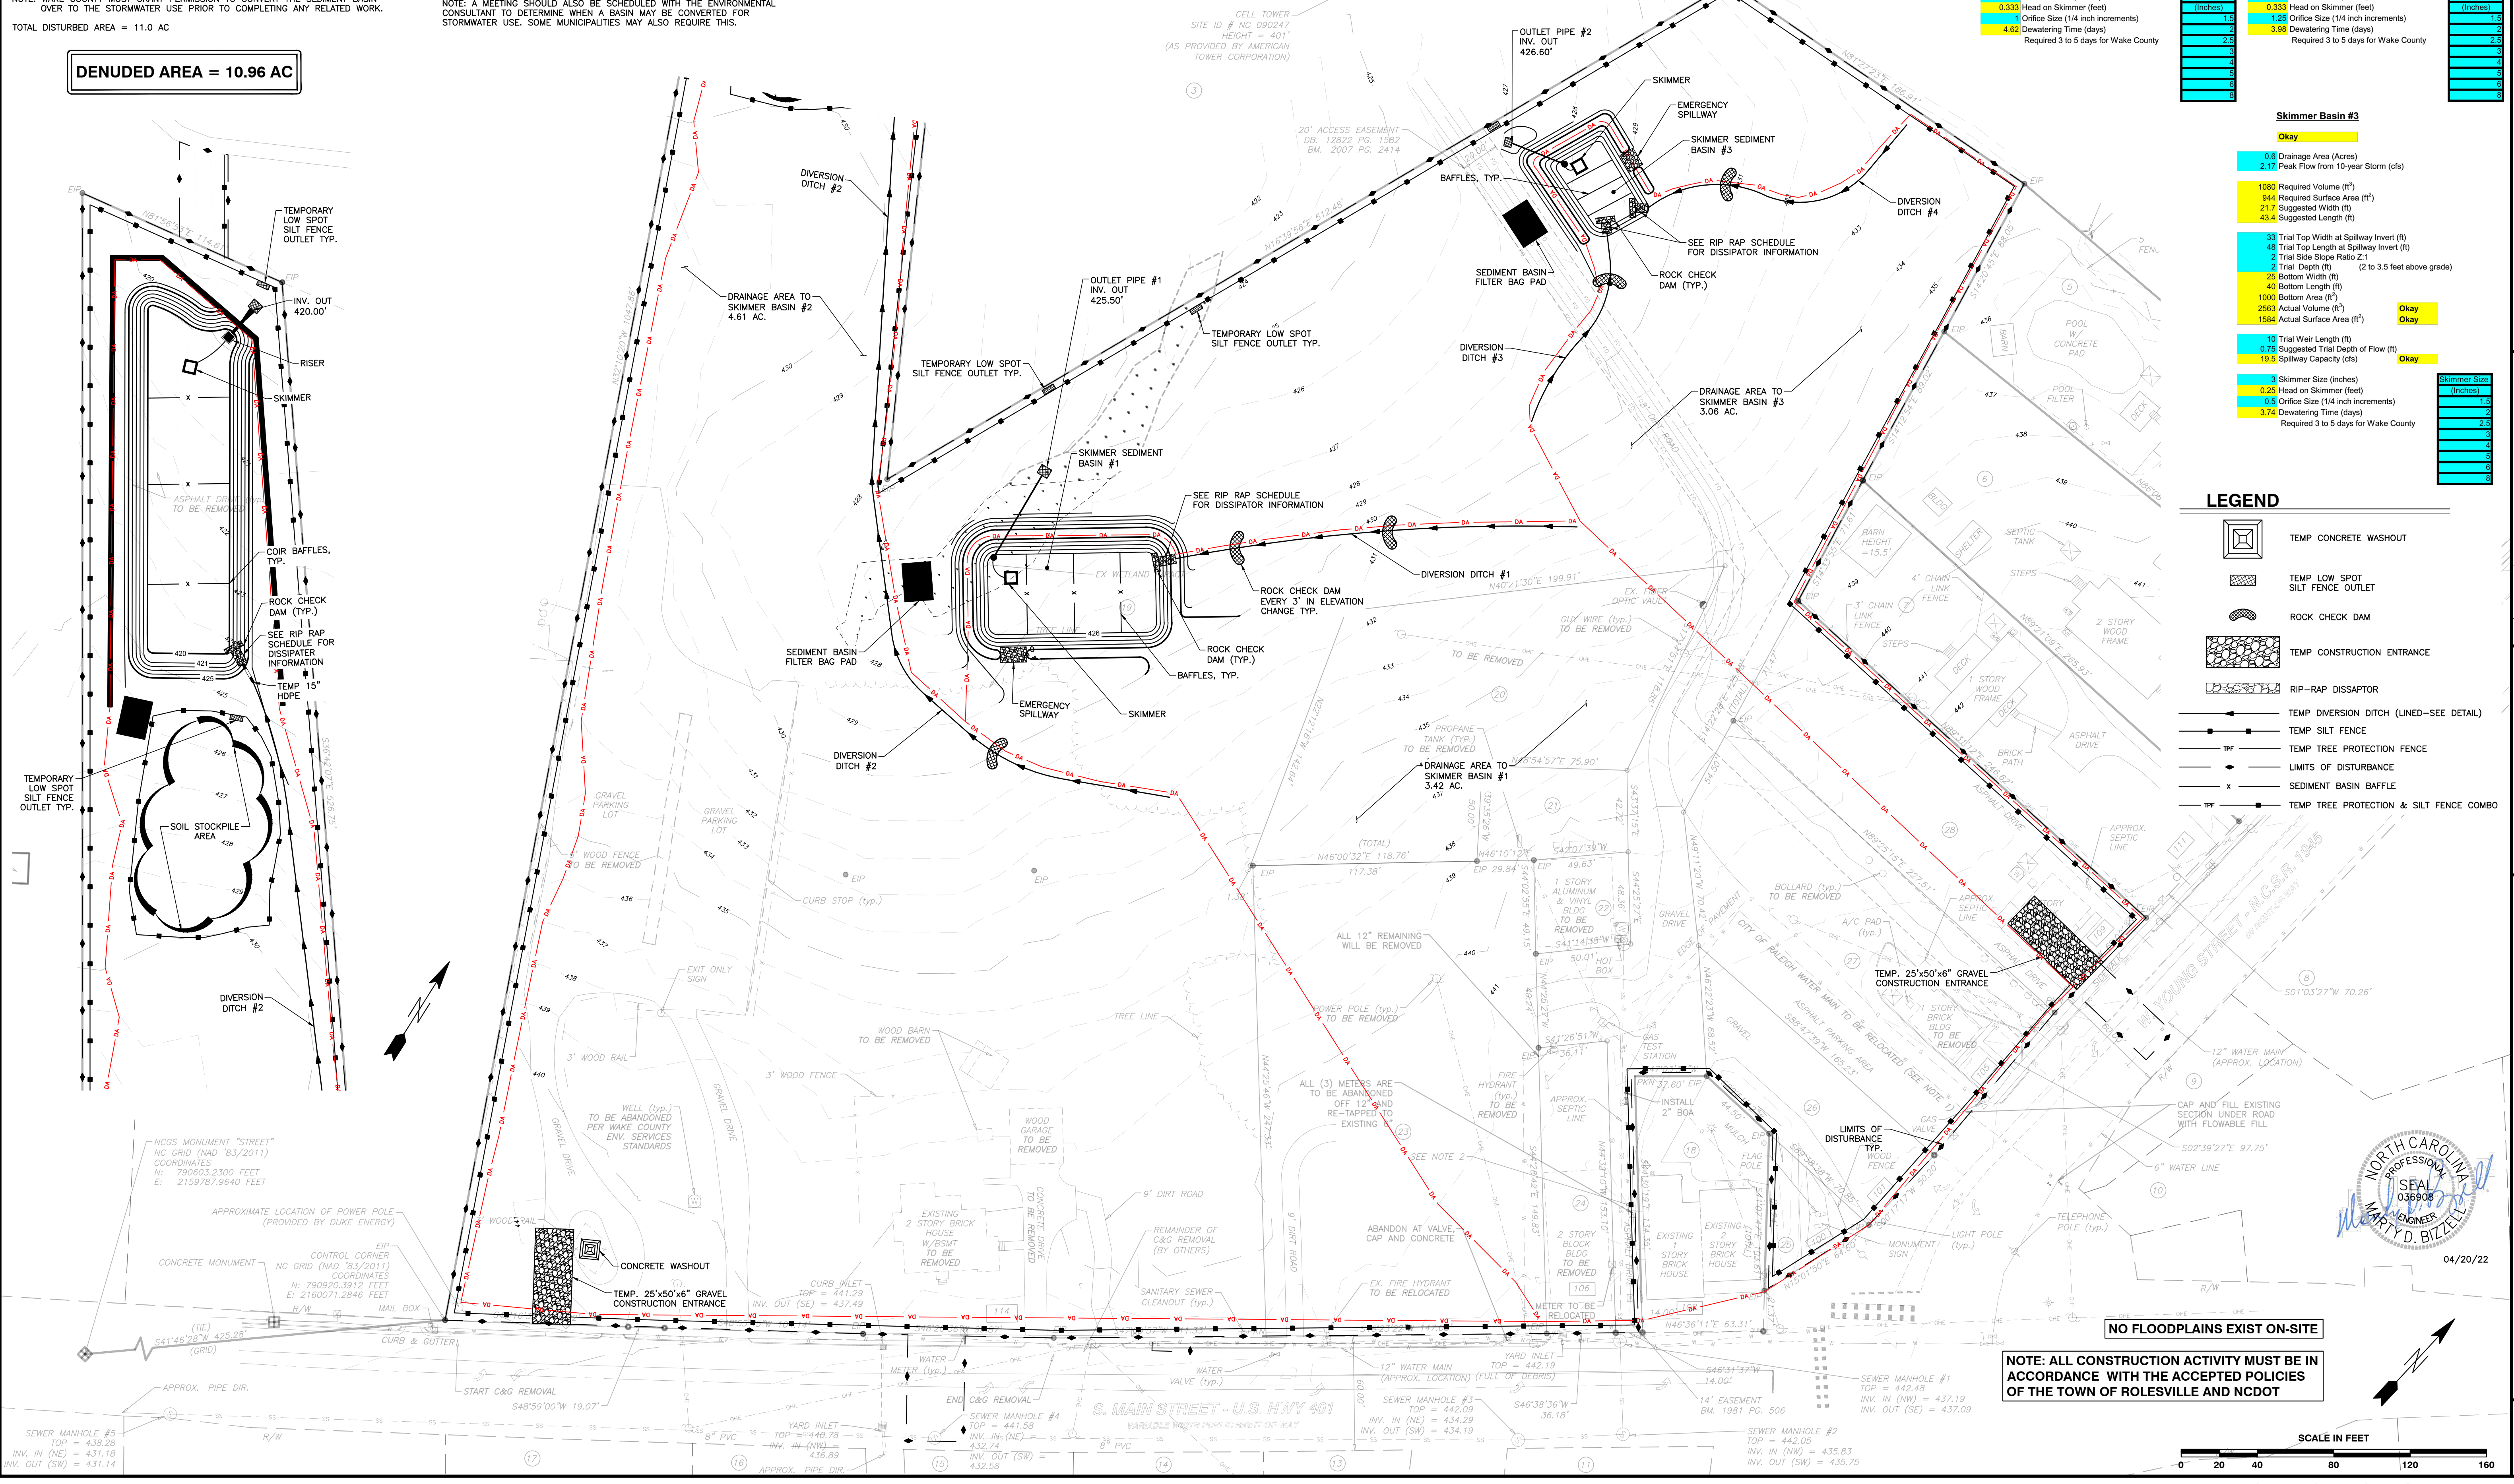

LEGEND

- TEMP CONCRETE WASHOUT
- TEMP LOW SPOT SILT FENCE OUTLET
- ROCK CHECK DAM
- TEMP CONSTRUCTION ENTRANCE
- RIP-RAP DISSIPATOR
- TEMP DIVERSION DITCH (LINED-SEE DETAIL)
- TEMP SILT FENCE
- TEMP TREE PROTECTION FENCE
- LIMITS OF DISTURBANCE
- SEDIMENT BASIN BAFFLE
- TEMP TREE PROTECTION & SILT FENCE COMBO

NOTE: ALL CONSTRUCTION ACTIVITY MUST BE IN ACCORDANCE WITH THE ACCEPTED POLICIES OF THE TOWN OF ROLESVILLE AND NCDOT

SCALE IN FEET
0 20 40 80 120 160

BASS, NIXON & KENNEDY, INC.
CONSULTING ENGINEERS
6310 CHARLETTOWN ROAD, SUITE 250, RALEIGH, NC 27607
TELEPHONE: (919)881-4422 FAX: (919)881-6866
CERTIFICATION NUMBERS: NCBELS (C-0110); NCBOLA (C-0267)

COBBLESTONE VILLAGE MIXED USE DEVELOPMENT
TOWN OF ROLESVILLE, WAKE COUNTY, NORTH CAROLINA

EROSION CONTROL PLAN - STAGE 1

DATE: 04/20/22
SCALE: 1" = 40'

NO. DATE DESCRIPTION REVISIONS

03-19187 PROGRESS MRM
JOB NO. DATE DRAWN BY
04/20/22 DATE CHECKED BY: MDB

SHEET C3.3

TOWN OF ROLESVILLE PROJECT NO.

NOT RELEASED FOR CONSTRUCTION OR BID SOLICITATION

CONSTRUCTION SEQUENCE - STAGE 2

- BEGIN CONSTRUCTION OF ALL BUILDINGS.
 - STABILIZE SITE AS NEW DISTURBED AREAS ARE BROUGHT UP TO FINISH GRADE WITH VEGETATION, PAVING, DITCH LININGS, ETC. SEED AND MULCH DENuded AREAS PER GROUND STABILIZATION TIME FRAMES.
 - WHEN CONSTRUCTION OF PARKING LOTS ARE COMPLETE AND ALL AREAS ARE STABILIZED COMPLETELY, CALL ENVIRONMENTAL CONSULTANT FOR AN INSPECTION.
 - IF THE SITE IS APPROVED, REMOVE TEMPORARY DIVERSIONS, SILT FENCE, SEDIMENT BASINS, ETC., AND SEED OUT OR STABILIZE ANY RESULTING BARE AREAS. ALL REMAINING PERMANENT EROSION CONTROL DEVICES, SUCH AS VELOCITY DISSIPATORS, SHOULD NOW BE INSTALLED.
 - WHEN VEGETATION HAS BECOME ESTABLISHED, CALL FOR A FINAL SITE INSPECTION BY THE ENVIRONMENTAL CONSULTANT, OBTAIN A CERTIFICATE OF COMPLETION.
- NOTE: WAKE COUNTY MUST GRANT PERMISSION TO CONVERT THE SEDIMENT BASIN OVER TO THE STORMWATER USE PRIOR TO COMPLETING ANY RELATED WORK.
- TOTAL DISTURBED AREA = 10.96 AC
- ENVIRONMENTAL CONSULTANT: JEEVAN NEUPANE (919-819-8907)

REQUIRED WAKE COUNTY BASIN REMOVAL AND/OR CONVERSION SEQUENCE

- SCHEDULE A SITE MEETING WITH THE ENVIRONMENTAL CONSULTANT TO DETERMINE IF A BASIN CAN BE REMOVED OR CONVERTED TO A PERMANENT STORMWATER POND. INSTALL SILT FENCING OR OTHER TEMPORARY EROSION CONTROL MEASURES AS NEEDED PRIOR TO REMOVAL OF THE BASIN.
- UTILIZE OUTLET STRUCTURES THAT WITHDRAW WATER FROM THE SEDIMENT BASIN SURFACE FOR DRAW DOWN OF WATER IN BASIN FOR MAINTENANCE OR CLOSE OUT UNLESS INFEASIBLE. SEE REQUIREMENTS OF NCG01 PERMIT PART II, SECTION C, ITEM (4) ENTITLED "DRAW DOWN OF SEDIMENT BASINS FOR MAINTENANCE OR CLOSE OUT" AND REFER TO WAKE COUNTY "FILTER BAG FOR DEWATERING ACTIVITIES" CONSTRUCTION DETAIL.
- REMOVE BASIN(S) AND ASSOCIATED TEMPORARY DIVERSION DITCHES. IF CULVERT PIPES NEED TO BE EXTENDED, PERFORM THIS OPERATION AT THIS TIME. FINE GRADE AREA IN PREPARATION FOR SEEDING.
- PERFORM SEEDBED PREPARATION, SEED, MULCH AND ASPHALT TACK ANY RESULTING BARE AREAS IMMEDIATELY.
- INSTALL VELOCITY DISSIPATORS AND/OR LEVEL SPREADERS AS REQUIRED ON THE EROSION CONTROL PLAN.
- WHEN SITE IS FULLY STABILIZED, CALL ENVIRONMENTAL CONSULTANT FOR APPROVAL OF REMOVING REMAINING TEMPORARY EROSION CONTROL MEASURES AND ADVICE ON WHEN SITE CAN BE ISSUED A CERTIFICATE OF COMPLETION. NOTE: A MEETING SHOULD ALSO BE SCHEDULED WITH THE ENVIRONMENTAL CONSULTANT TO DETERMINE WHEN A BASIN MAY BE CONVERTED FOR STORMWATER USE. SOME MUNICIPALITIES MAY ALSO REQUIRE THIS.

Skimmer Basin #2

| | |
|--|------|
| 6.99 Drainage Area (Acres) | Okay |
| 25.23 Peak Flow from 10-year Storm (cfs) | |
| 12582 Required Volume (ft ³) | |
| 10975 Required Surface Area (ft ²) | |
| 74.1 Suggested Width (ft) | |
| 148.2 Suggested Length (ft) | |
| 58 Trial Top Width at Spillway Invert (ft) | |
| 190 Trial Top Length at Spillway Invert (ft) | |
| 2 Trial Side Slope Ratio 2:1 | |
| 3 Trial Depth (ft) (2 to 3.5 feet above grade) | |
| 46 Bottom Width (ft) | |
| 178 Bottom Length (ft) | |
| 8188 Bottom Area (ft ²) | |
| 28740 Actual Volume (ft ³) | Okay |
| 11020 Trial Weir Length (ft) | Okay |
| 0.75 Suggested Trial Depth of Flow (ft) | Okay |
| 39.9 Spillway Capacity (cfs) | Okay |
| 4 Skimmer Size (Inches) | |
| 0.333 Head on Skimmer (feet) | |
| 156 Orifice Size (1/4 inch increments) | |
| 4.20 Dewatering Time (days) | |

| Skimmer Size (Inches) |
|-----------------------|
| 1 |
| 2 |
| 3 |
| 4 |
| 5 |
| 6 |
| 8 |
| 10 |
| 12 |
| 15 |
| 18 |
| 24 |
| 30 |
| 36 |
| 48 |
| 60 |
| 72 |
| 96 |
| 120 |

SEDIMENT BASIN SUMMARY CHART

| Sediment Basin Number | 1 | 2 |
|----------------------------|------------------------|-------------------------|
| Drainage Area (Acres) | 1.74 | 6.99 |
| Drainage Area (sq. ft) | 75,000 | 300,000 |
| Q10(cfs) | (0.5)(7.22)(1.74)=0.28 | (0.5)(7.22)(6.99)=25.23 |
| Weir Size (ft) | 10 x 1.5 | 10 x 1.5 |
| Surface Area Required (SF) | (435)(6.23)=2,732 | (435)(25.23)=10,975 |
| Volume Required (CF) | (1800)(1.74)=3,132 | (1800)(6.99)=12,582 |
| Dimensions (ft) | see plans | see plans |
| Surface Area Provided (SF) | 2,800 | 11,000 |
| Volume Provided (CF) | 5,646 | 27,900 |
| Skimmer Size | 4" | 4" |
| Orifice Radius | 0.4" | 0.75" |
| Orifice Diameter | 0.75" | 1.5" |
| Drawdown Time (Days) | 4.18 | 4.2 |
| Number of Basins | 3 | 3 |

DITCH/CHANNEL CALCULATIONS

| DIVERSION DITCH ID | LENGTH (LF) | DA (Ac) | Q10 (CFS) | SLOPE (%) | V10 (FPS) | LINER * | PERMISSIBLE SHEAR STRESS (PSF) | CALCULATED SHEAR STRESS (PSF) |
|--------------------|-------------|---------|-----------|-----------|-----------|---------|--------------------------------|-------------------------------|
| DV-1 | 296 | 1.02 | 2.34 | 2.00 | 2.01 | SC150 | 2.00 | 0.78 |
| DV-2 | 495 | 1.00 | 2.30 | 2.60 | 2.29 | SC150 | 2.00 | 0.94 |
| DV-3 | 442 | 0.52 | 1.19 | 1.80 | 0.92 | SC150 | 1.80 | 0.29 |
| DV-4 | 167 | 0.06 | 0.13 | 2.90 | 0.96 | SC150 | 1.80 | 0.38 |

* NAG = NORTH AMERICAN GREEN OR EQUIVALENT

LEGEND


- TEMP CONSTRUCTION ENTRANCE
- TEMP LOW SPOT SILT FENCE OUTLET
- TEMP INLET PROTECTION
- RIP-RAP DISSIPATOR
- TEMP SILT FENCE
- TEMP TREE PROTECTION FENCE
- LIMITS OF DISTURBANCE
- SEDIMENT BASIN BAFFLE
- TEMP TREE PROTECTION & SILT FENCE COMBO

CITY OF RALEIGH - PLANS AUTHORIZED FOR CONSTRUCTION

Electronic Approval: This approval is being issued electronically. This approval is valid only upon the signature of a City of Raleigh Review Officer below. The City will retain a copy of the approved plans. Any work authorized by this approval must proceed in accordance with the plans kept on file with the City. This electronic approval may not be edited once issued. Any modification to this approval once issued will invalidate this approval.

City of Raleigh Development Approval

Raleigh Water Review Officer

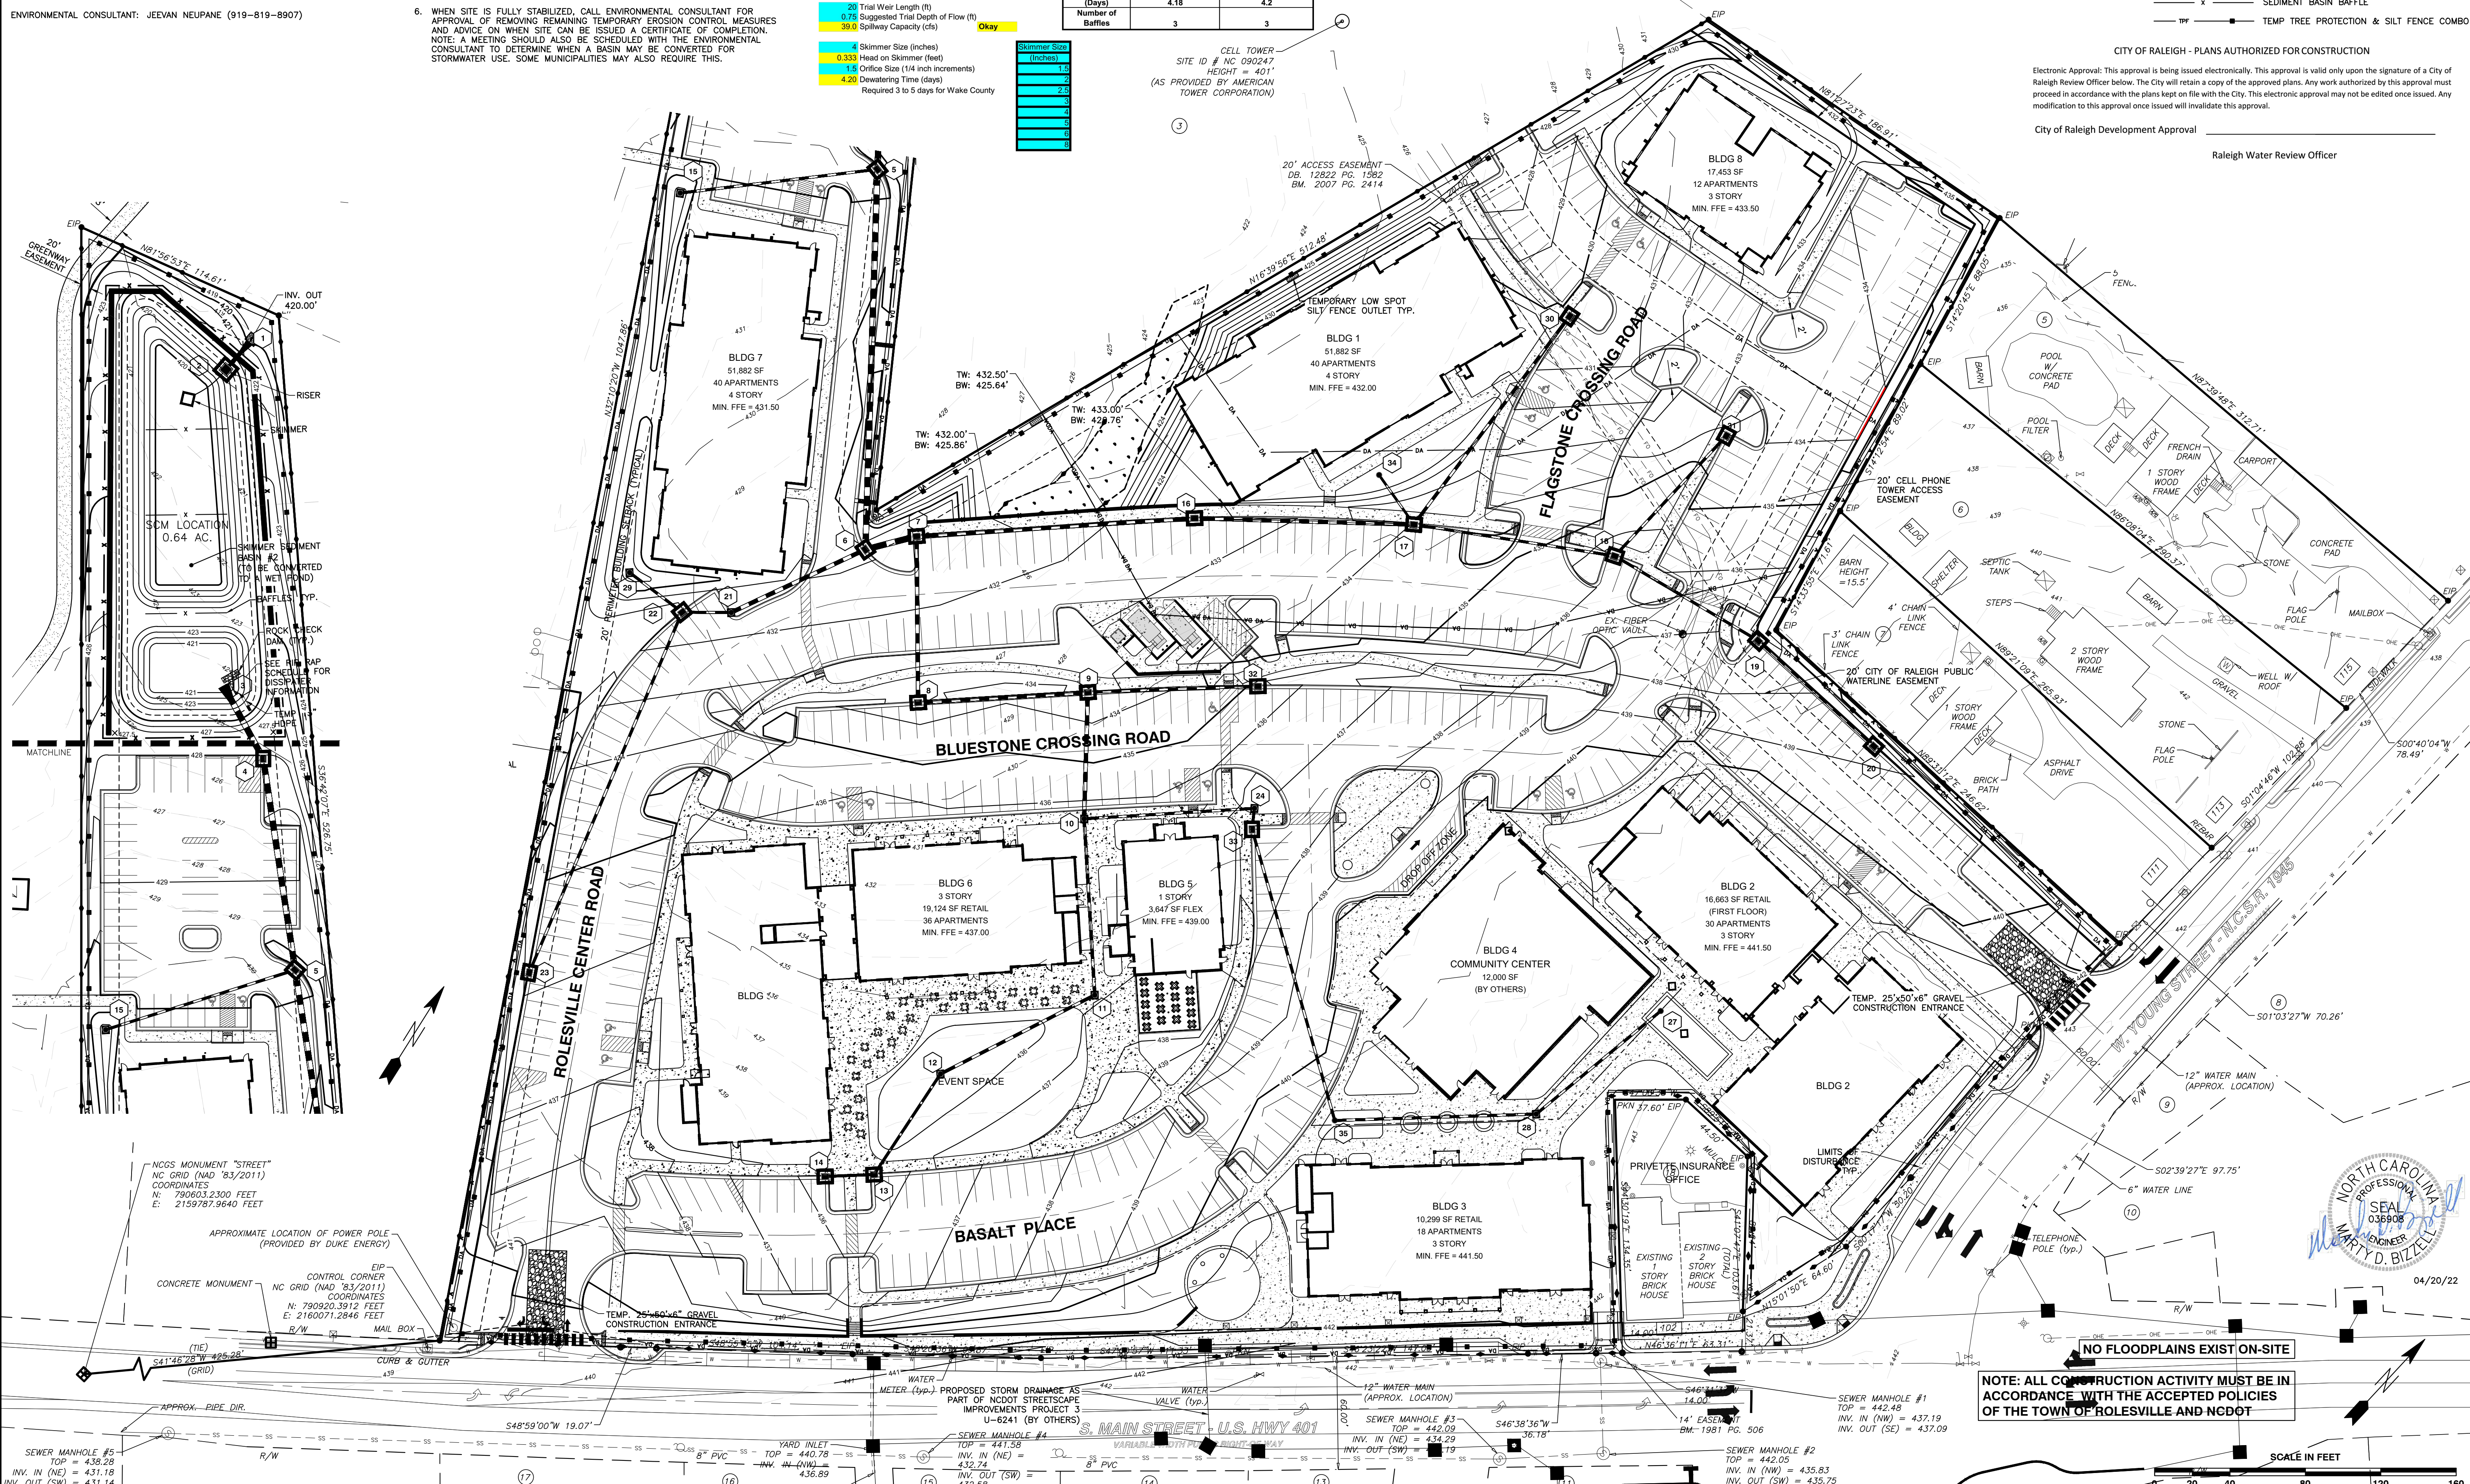


BASS, NIXON & KENNEDY, INC.
CONSULTING ENGINEERS
 6310 CHAPEL HILL ROAD, SUITE 250, RALEIGH, NC 27607
 TELEPHONE: (919)851-1122 FAX: (919)851-8686
 CERTIFICATION NUMBERS: NCBELS (C-0110); NCBOLA (C-0267)

| NO. | DATE | DESCRIPTION | BY |
|-----|------|-------------|----|
| | | | |
| | | | |
| | | | |

03-19157 PROGRESS MRN
 JOB NO. DATE DRAWN BY
EROSION CONTROL PLAN - STAGE 2
 SCALE: 1" = 40'
 CHK BY: MDB










COBBLESTONE VILLAGE MIXED USE DEVELOPMENT
 TOWN OF ROLESVILLE, WAKE COUNTY, NORTH CAROLINA

NOT RELEASED FOR CONSTRUCTION OR BID SOLICITATION

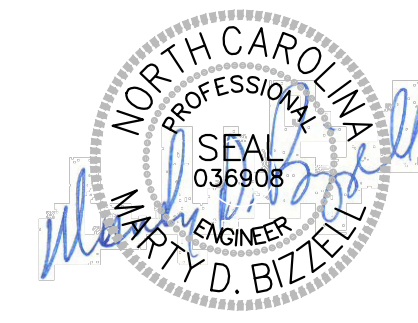

NOTE: ALL CONSTRUCTION ACTIVITY MUST BE IN ACCORDANCE WITH THE ACCEPTED POLICIES OF THE TOWN OF ROLESVILLE AND NCDOT

R:\2019\19157 - Rolesville Town Center\CIVIL\04_Construction\06 - 19157_Erosion Control Phase 2.dwg, Erosion Control Phase 2, 4/20/2022 3:23:40 PM, marc.mueller

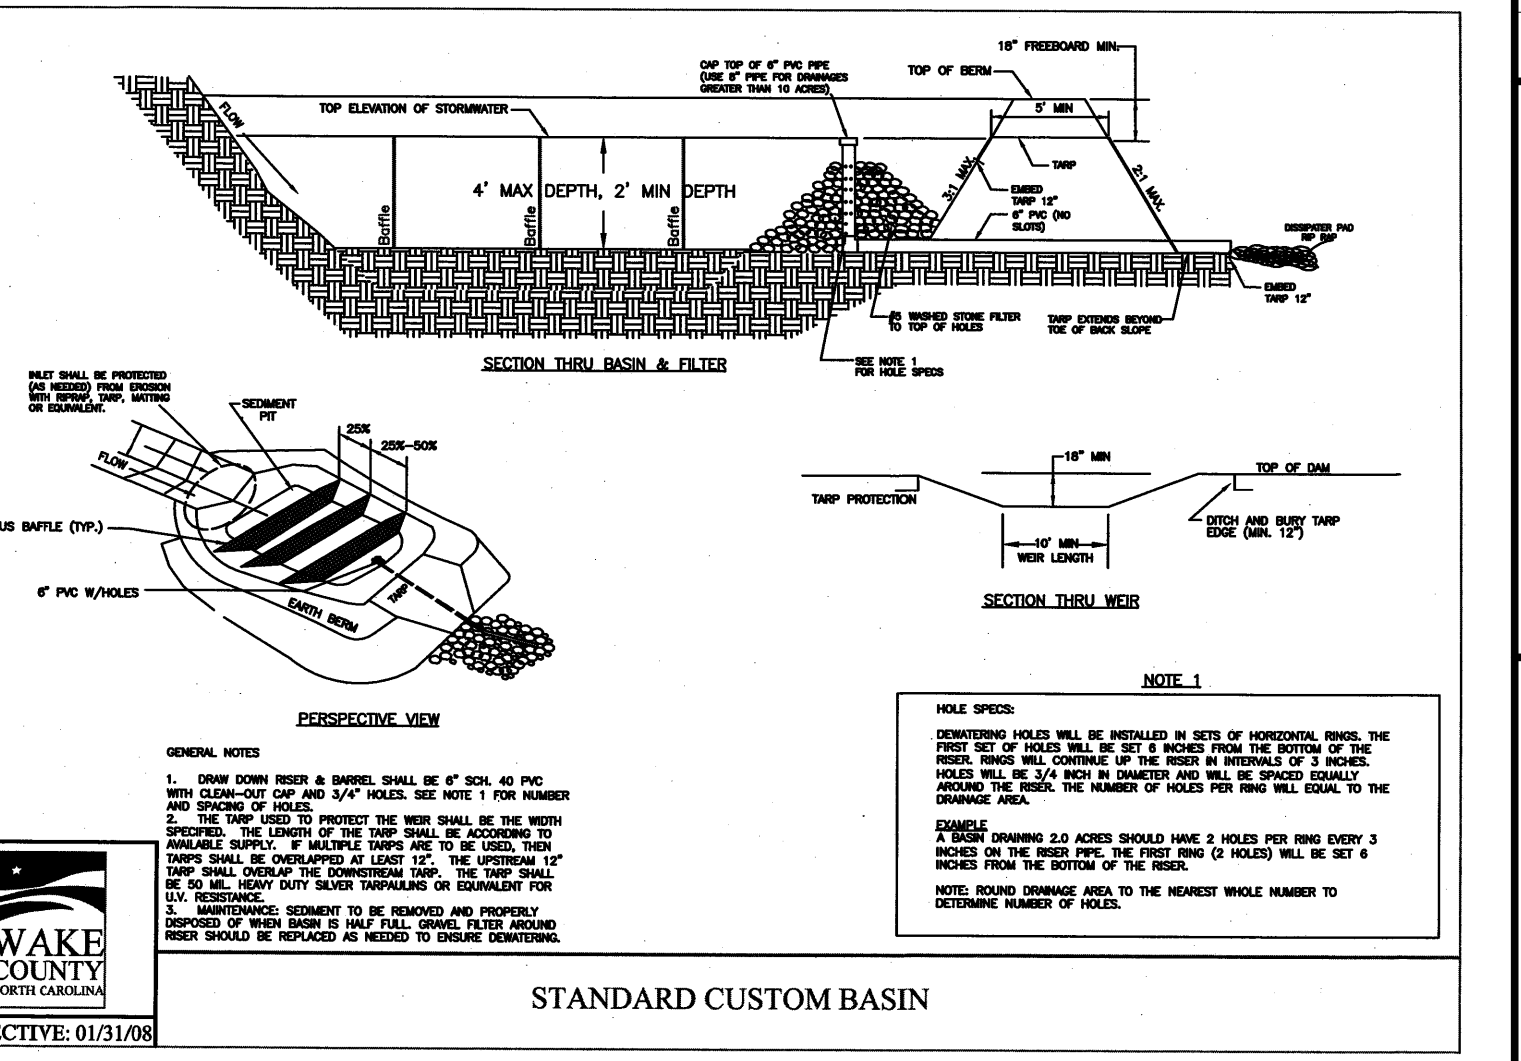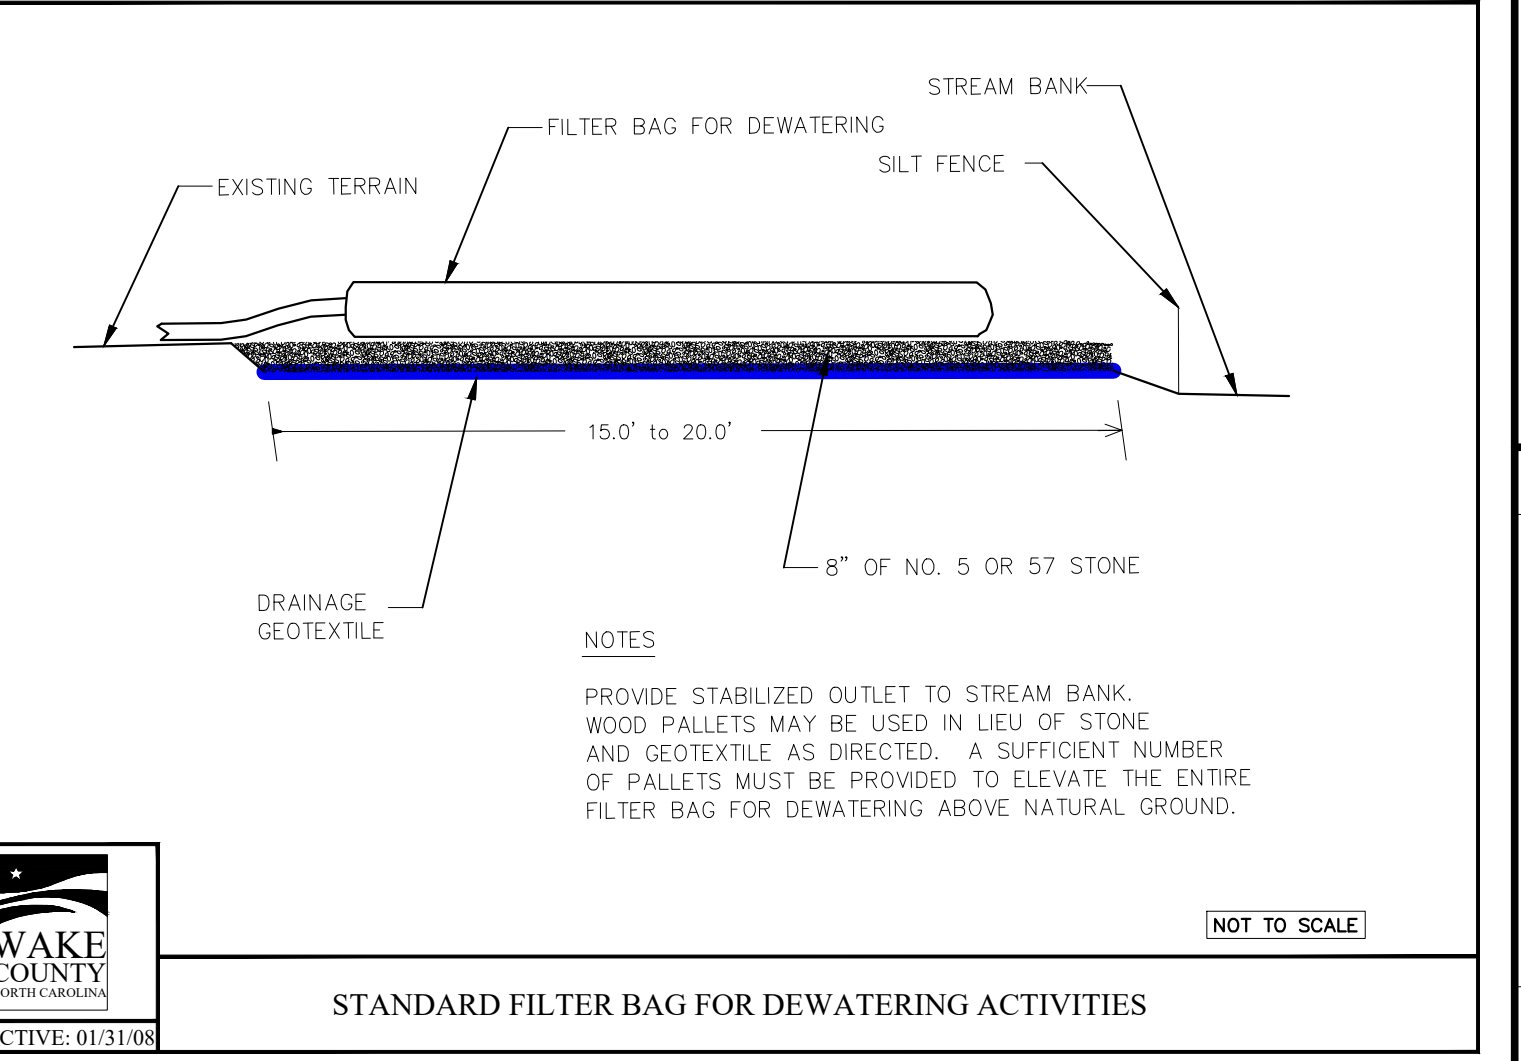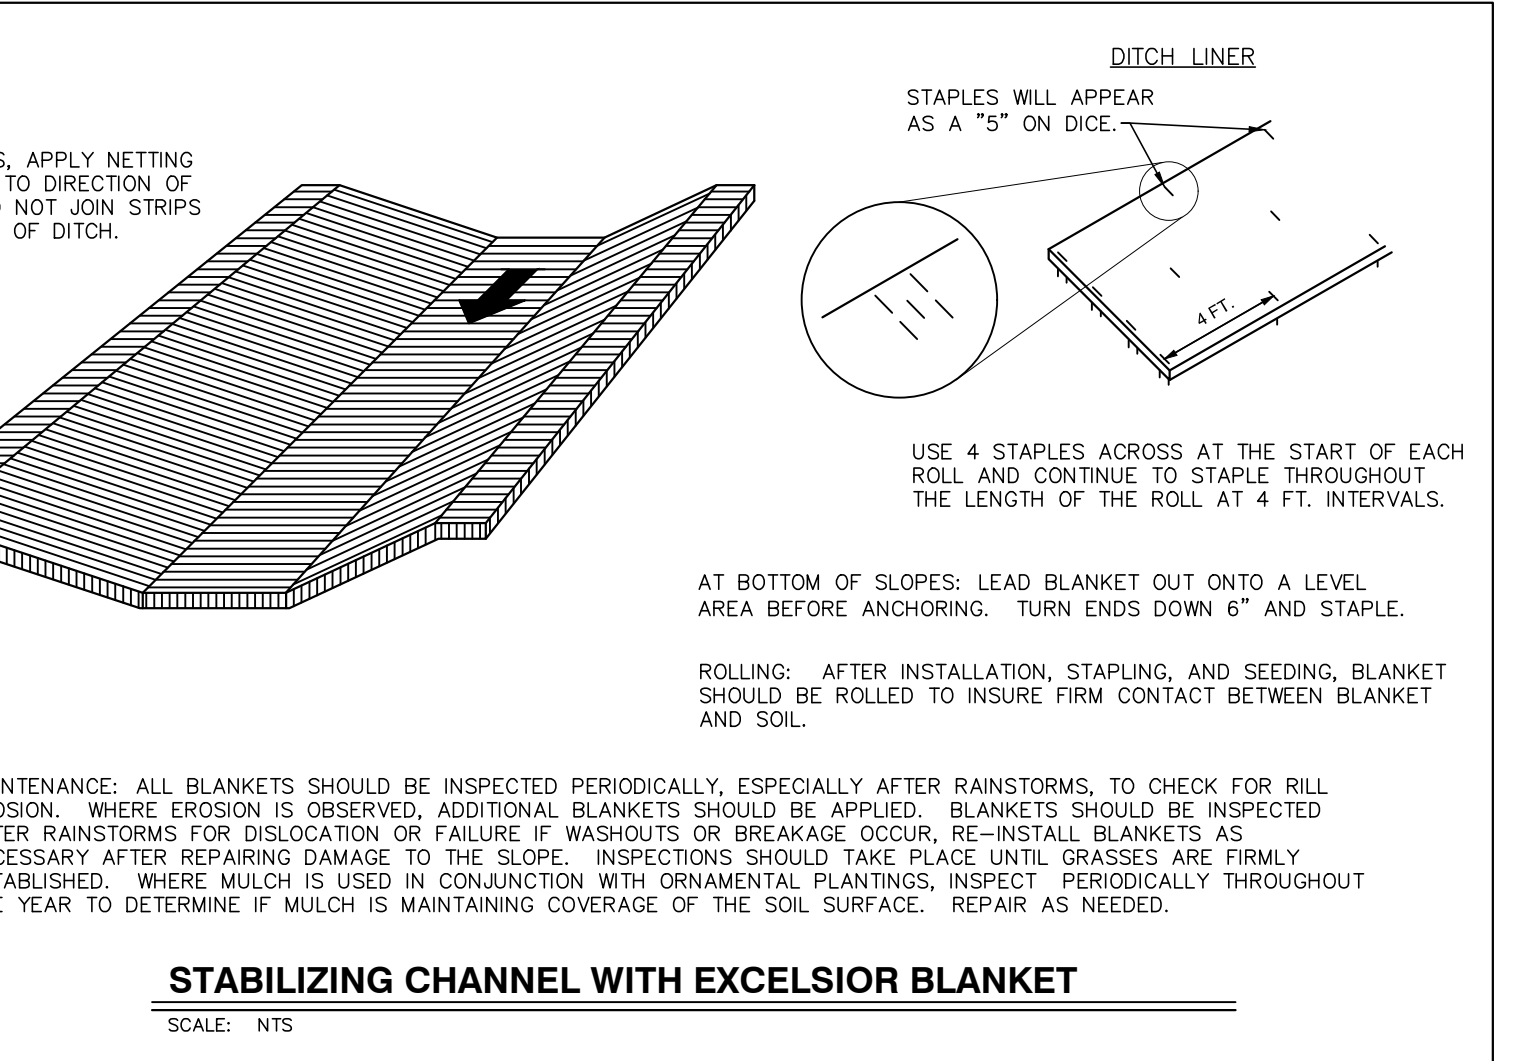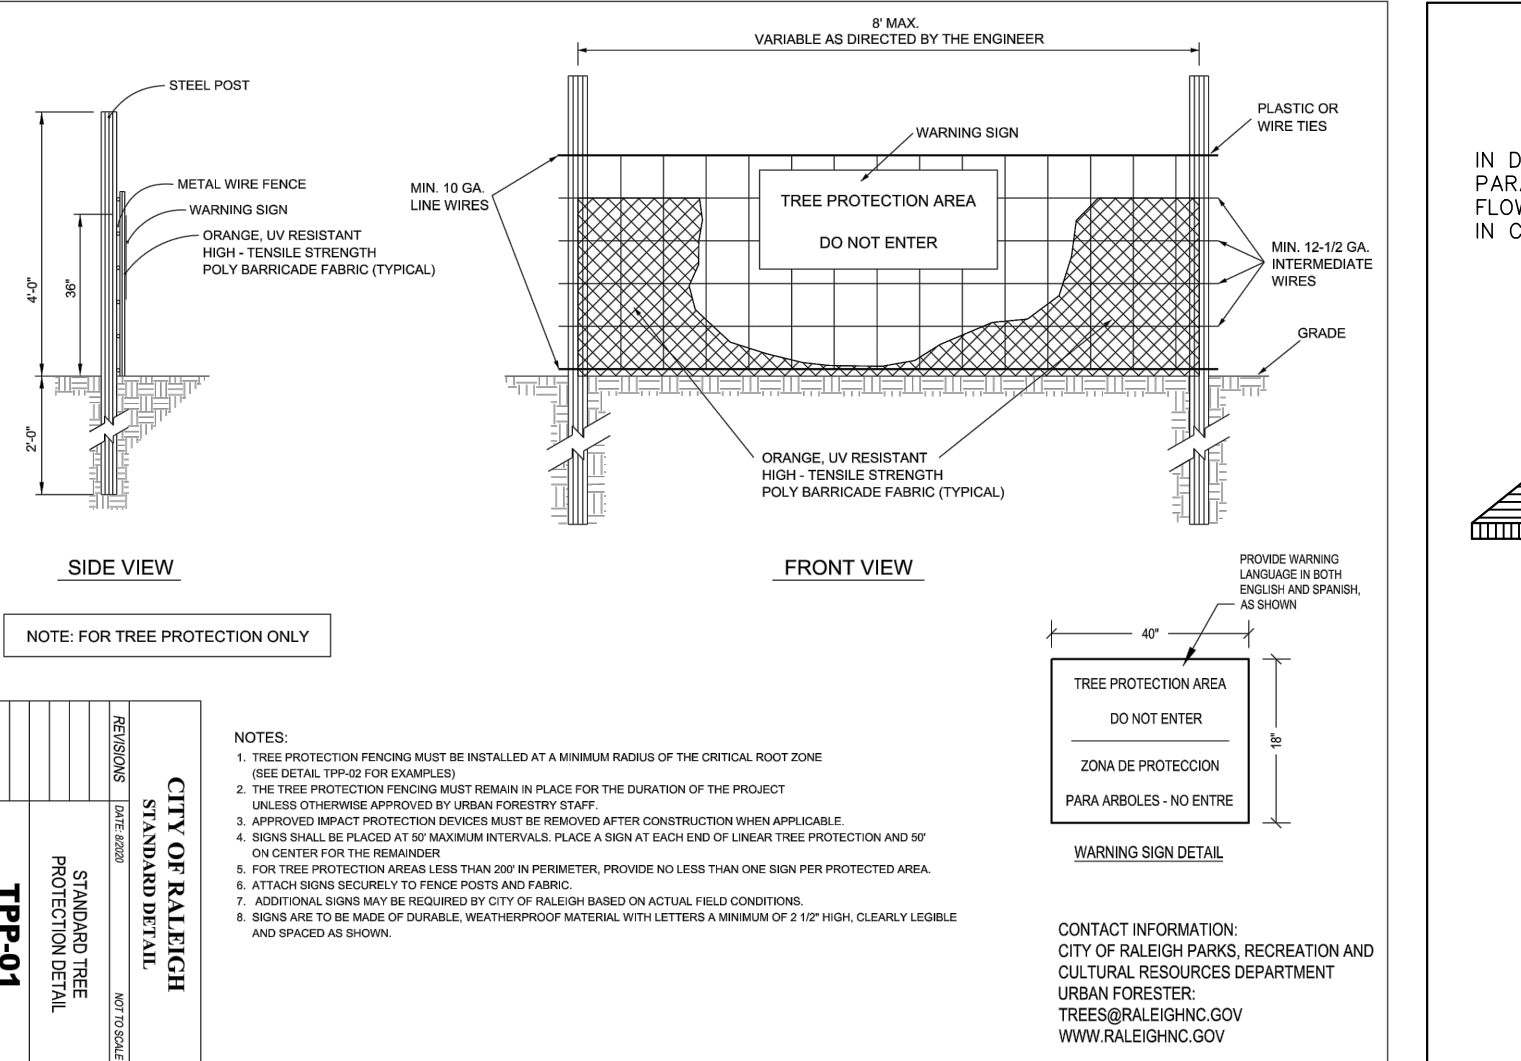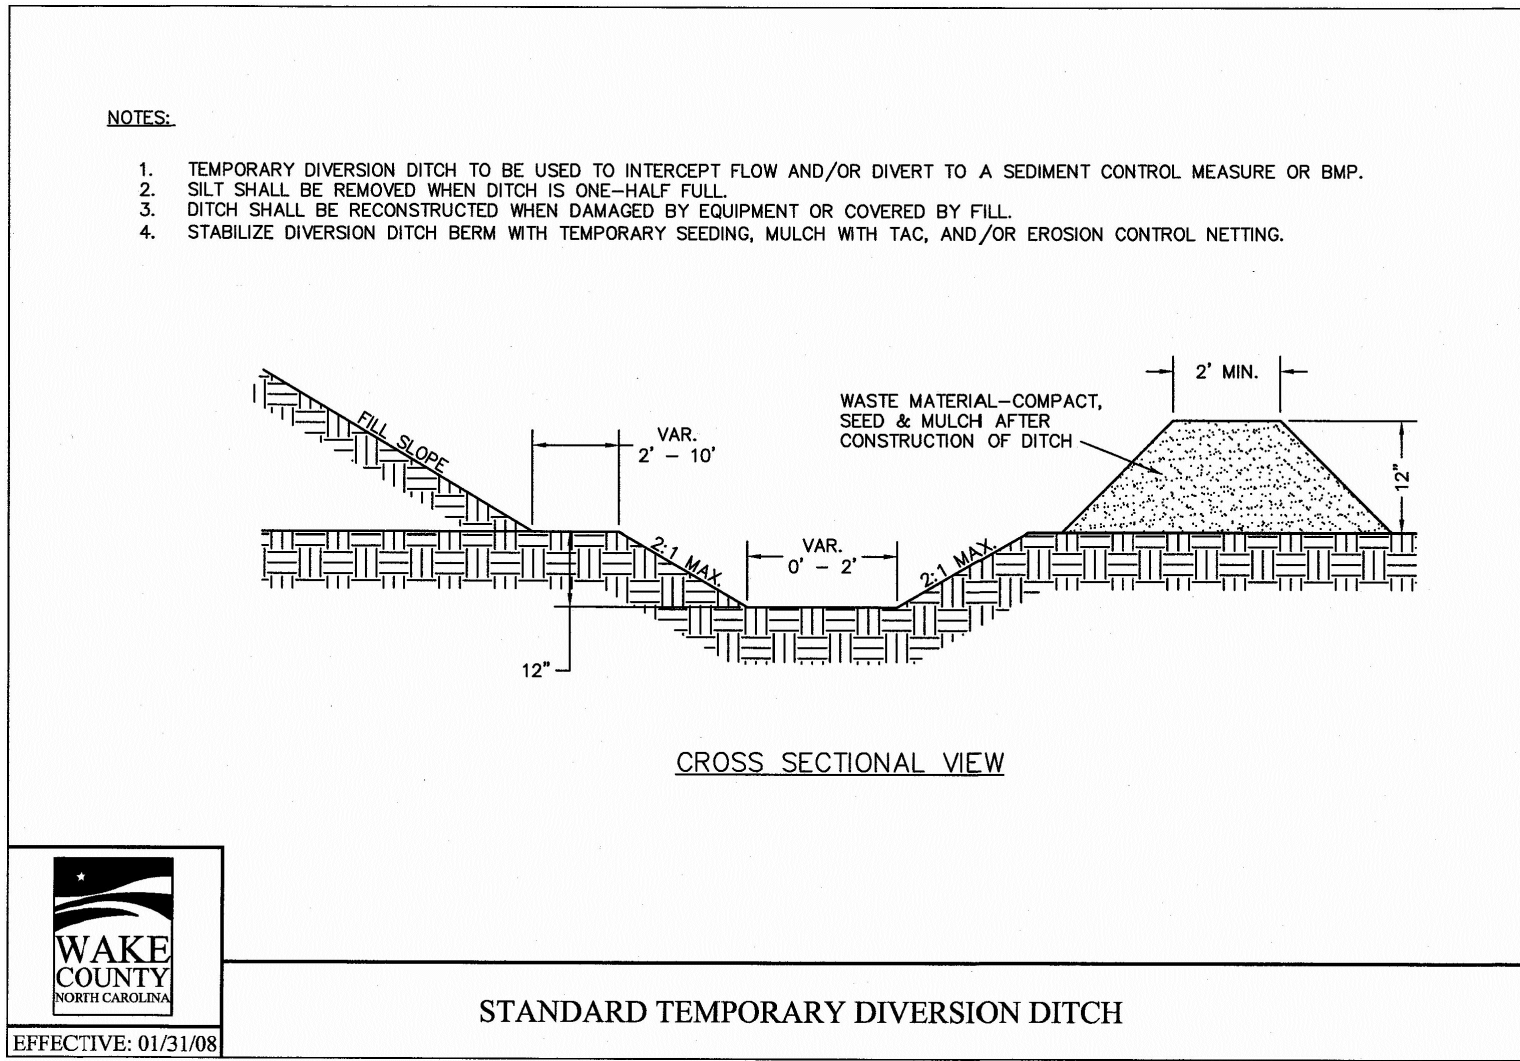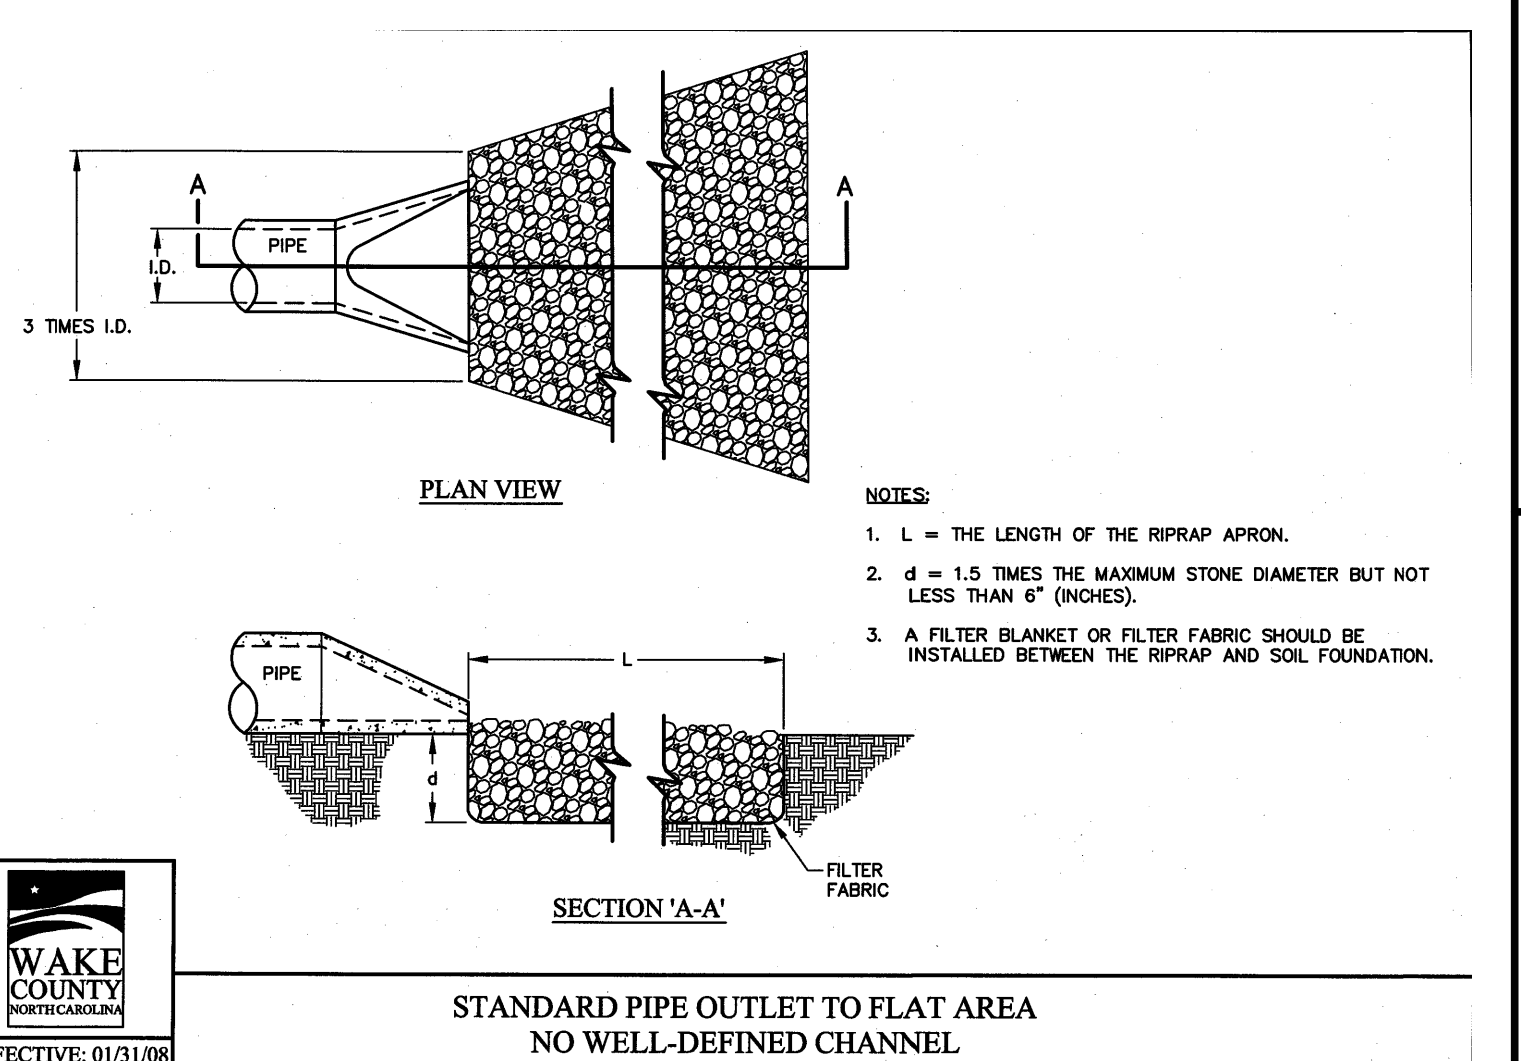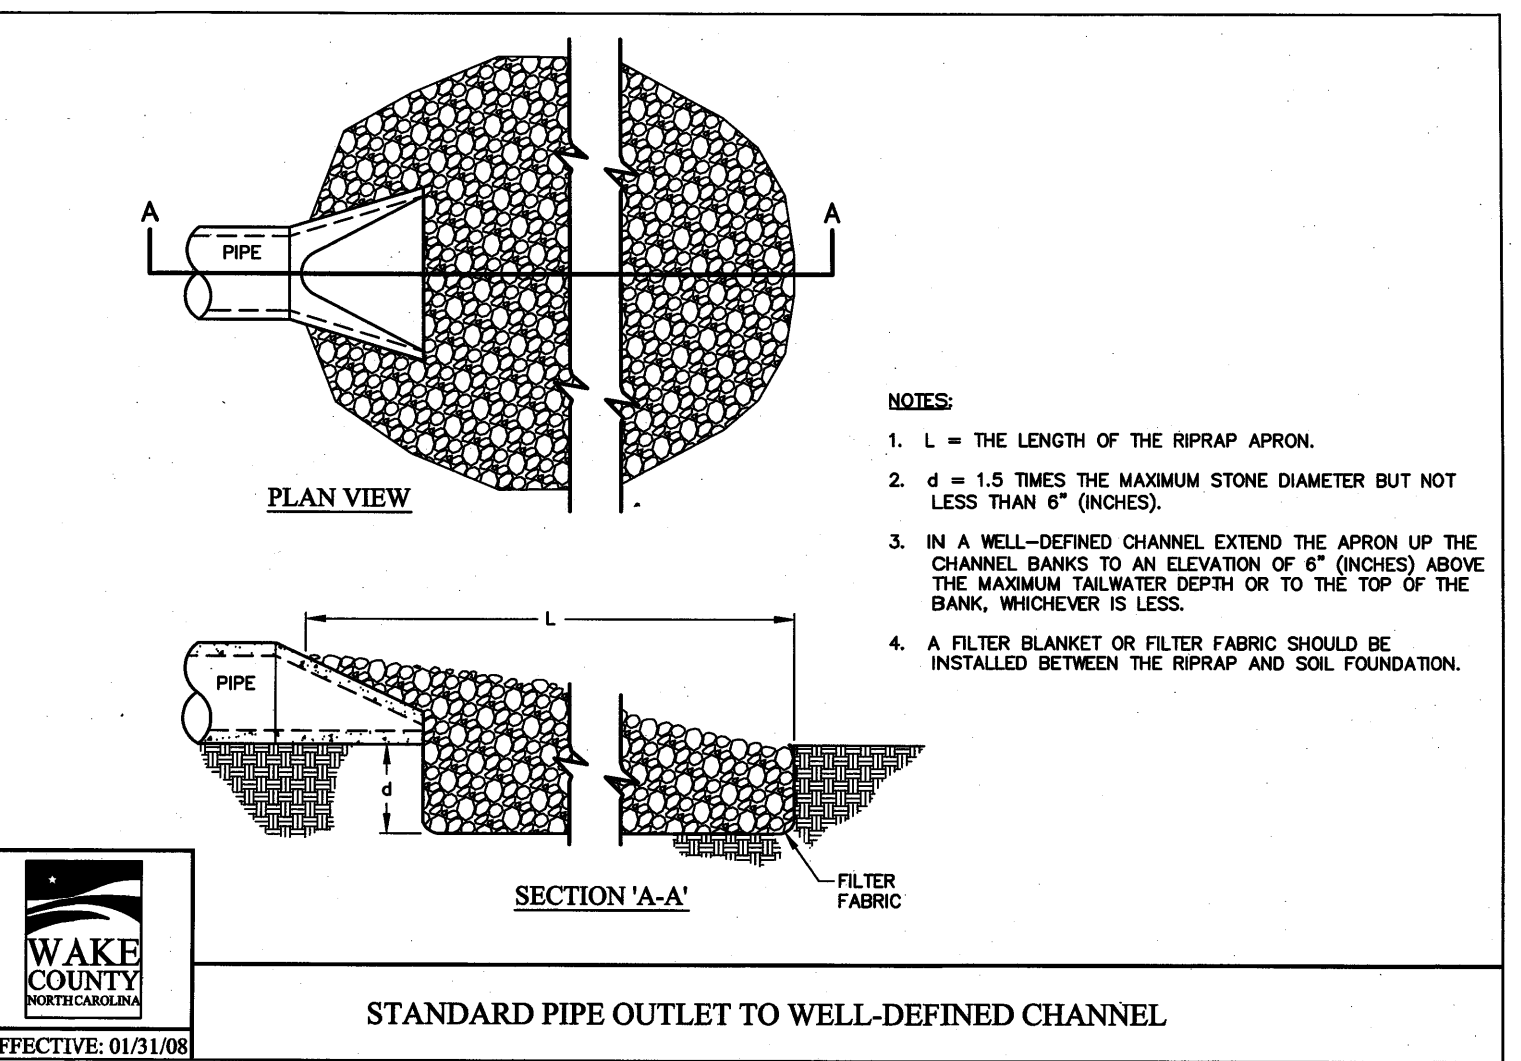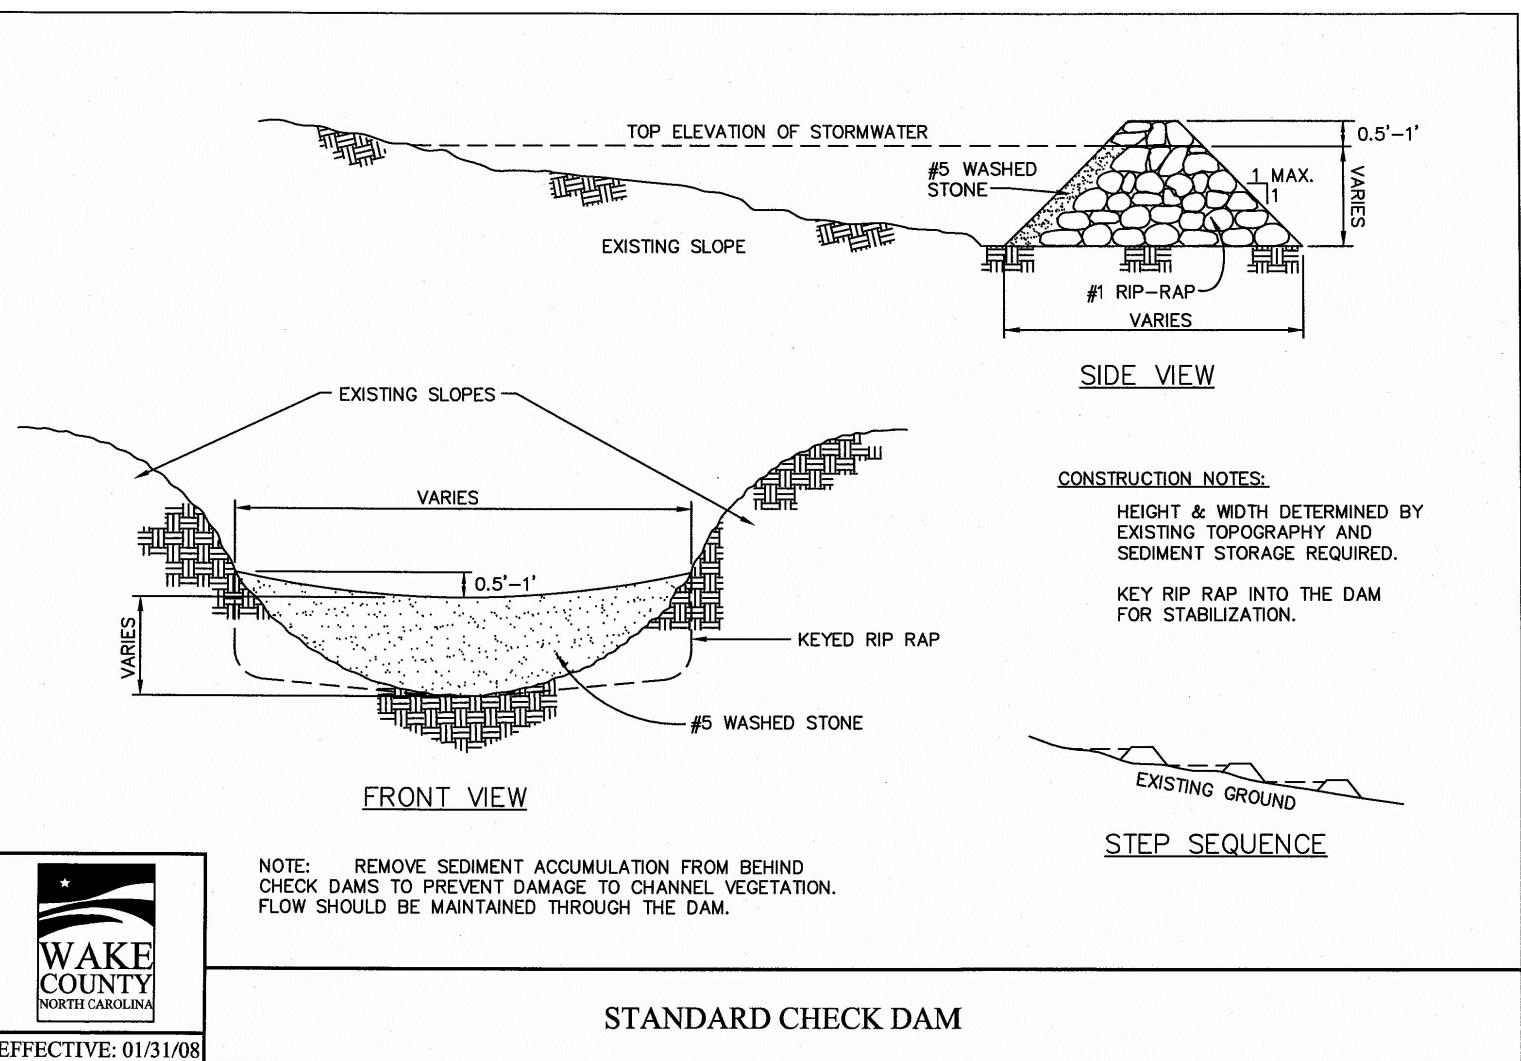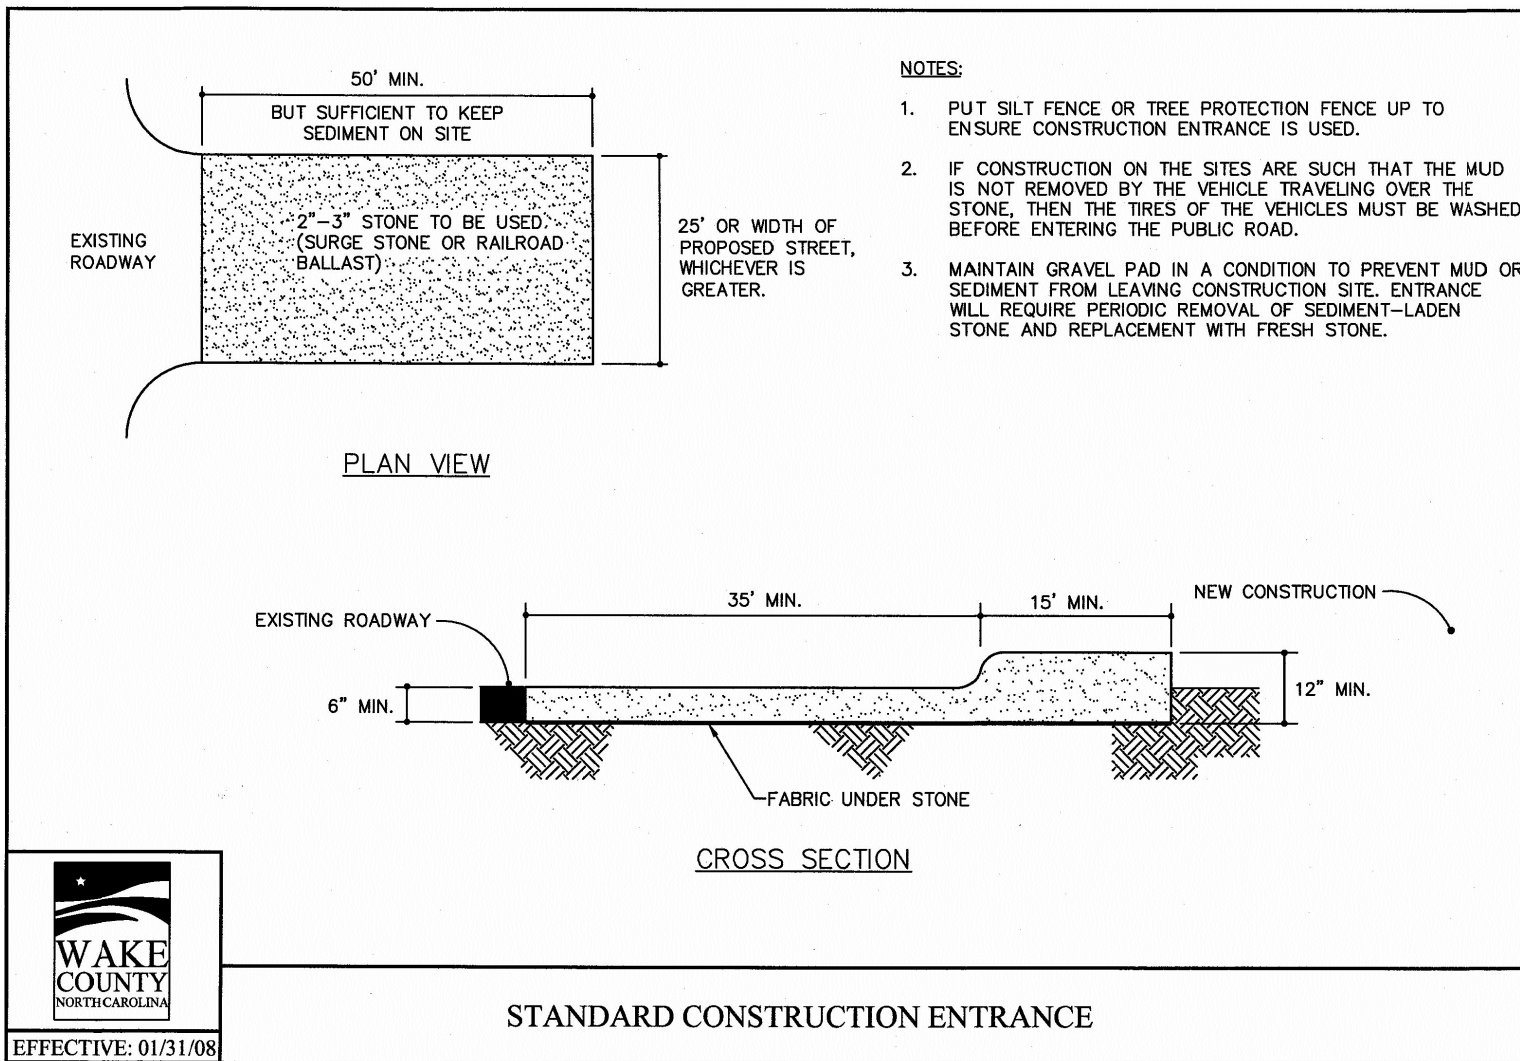

BASS, NIXON & KENNEDY, INC.
CONSULTING ENGINEERS
 6310 CHARL HILL ROAD, SUITE 250, RALEIGH, NC 27607
 TELEPHONE: (919) 881-1122 FAX: (919) 881-6888
 CERTIFICATION NUMBERS: NCBELS (C-0110); NCBOLA (C-0267)

COBBLESTONE VILLAGE MIXED USE DEVELOPMENT
 TOWN OF ROLESVILLE, WAKE COUNTY, NORTH CAROLINA

PROGRESS: MRM
 DATE: DRAWN BY:
 JOB NO.: EROSION CONTROL DETAILS
 SCALE: N.T.S.
 CHK BY: MDB

| NO. | DATE | DESCRIPTION | BY |
|-----|------|-------------|----|
| | | | |
| | | | |
| | | | |

SHEET C3.5


R:\2019\19157 - Rolesville Town Center\CIVIL\04 Construction\07 - 19157_Details.dwg, CS3, 4/20/2022 3:39:17 PM, mrmc-muelter

CITY OF RALEIGH - PLANS AUTHORIZED FOR CONSTRUCTION



Electronic Approval: This approval is being issued electronically. This approval is valid only upon the signature of a City of Raleigh Review Officer below. The City will retain a copy of the approved plans. Any work authorized by this approval must proceed in accordance with the plans kept on file with the City. This electronic approval may not be edited once issued. Any modification to this approval once issued will invalidate this approval.

City of Raleigh Development Approval _____



Raleigh Water Review Officer _____

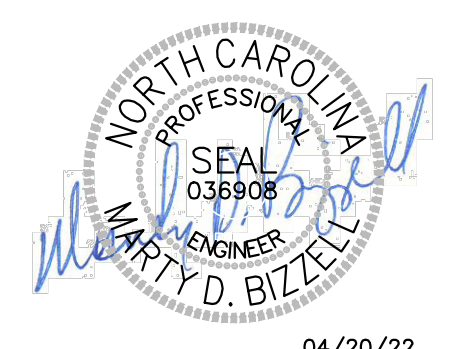



04/20/22

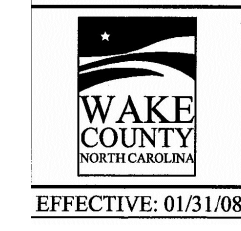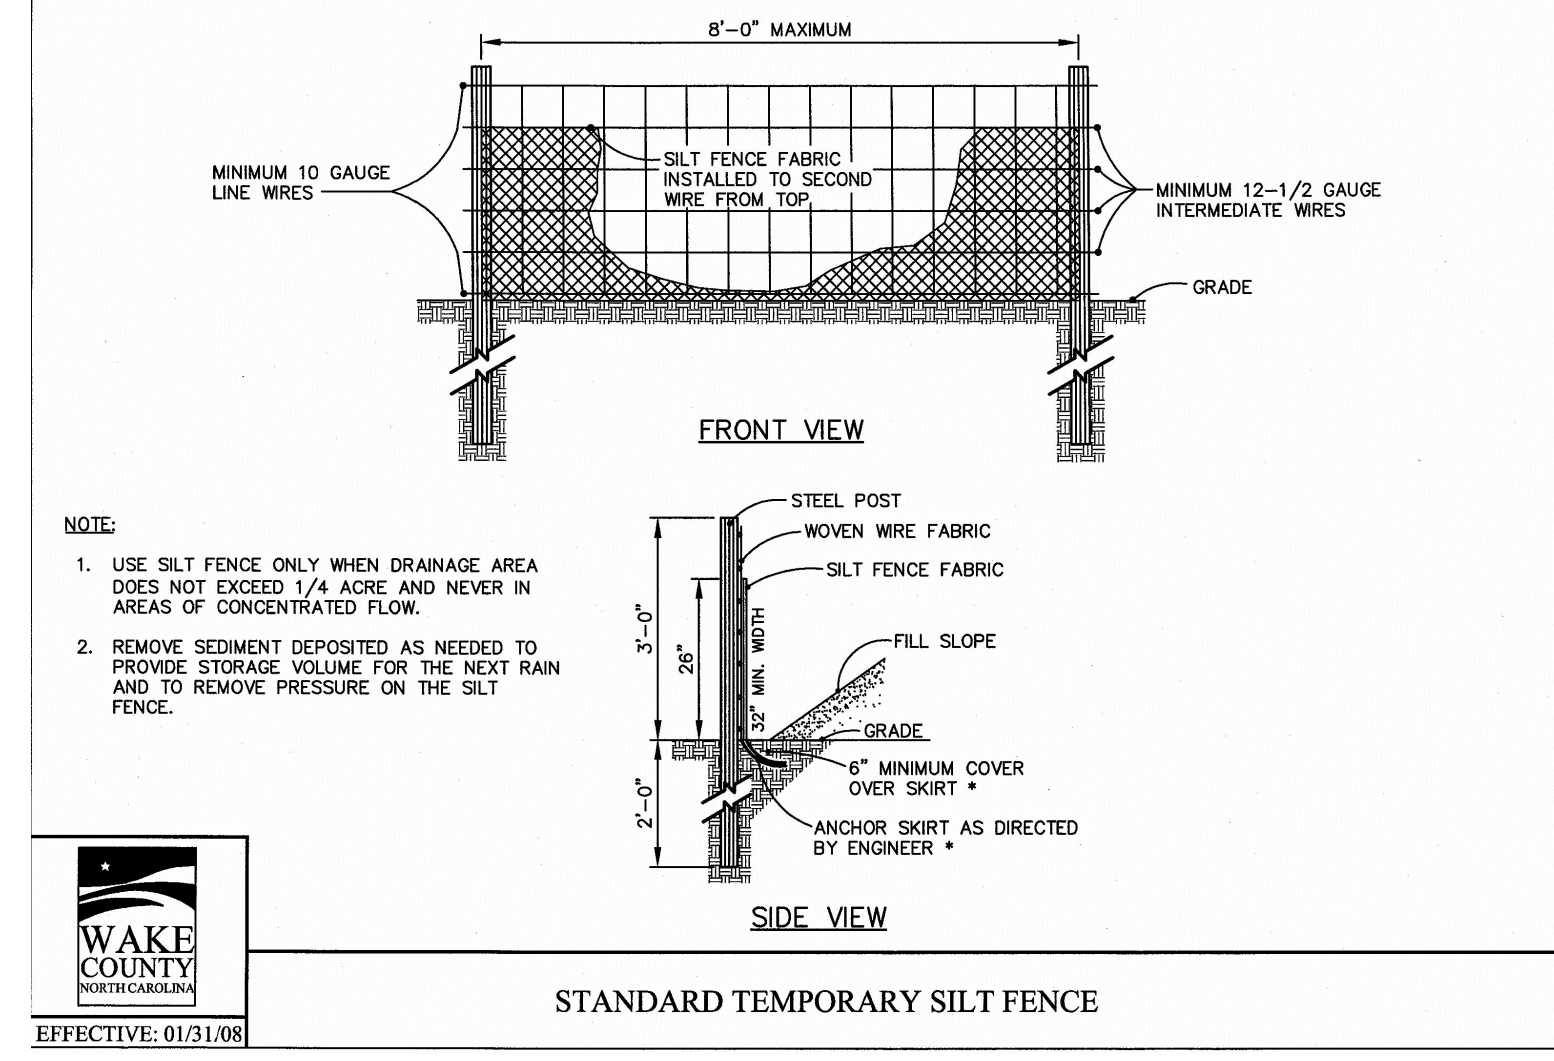



STANDARD TEMPORARY SILT FENCE

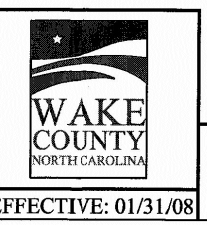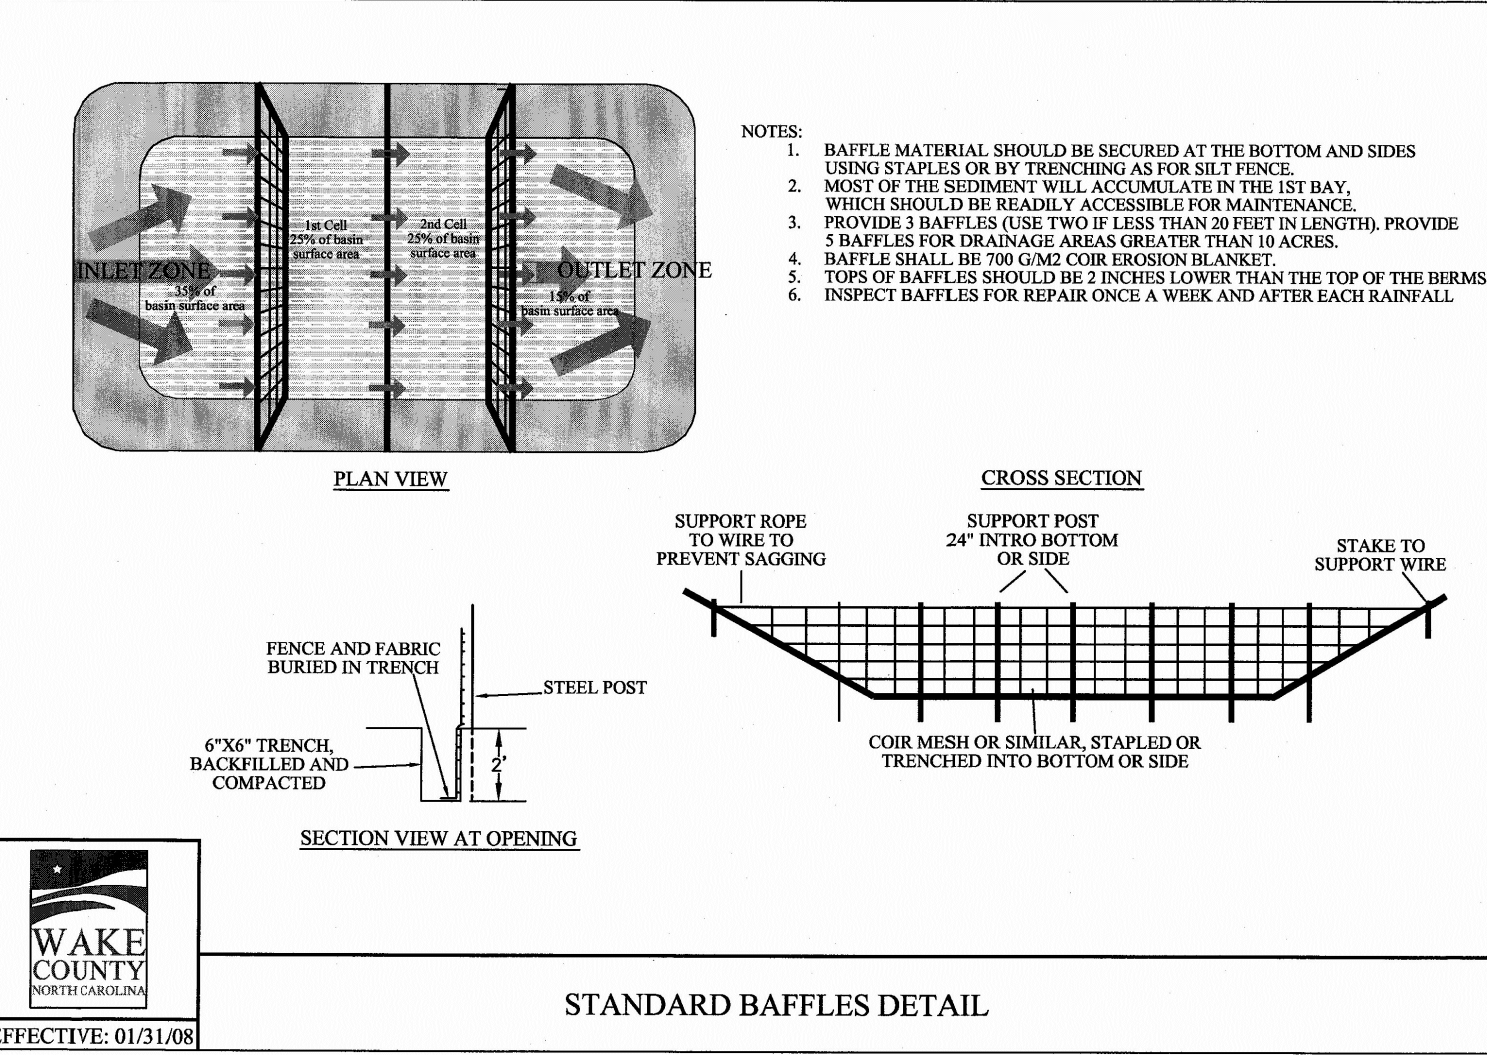



STANDARD BAFFLES DETAIL

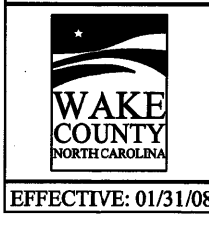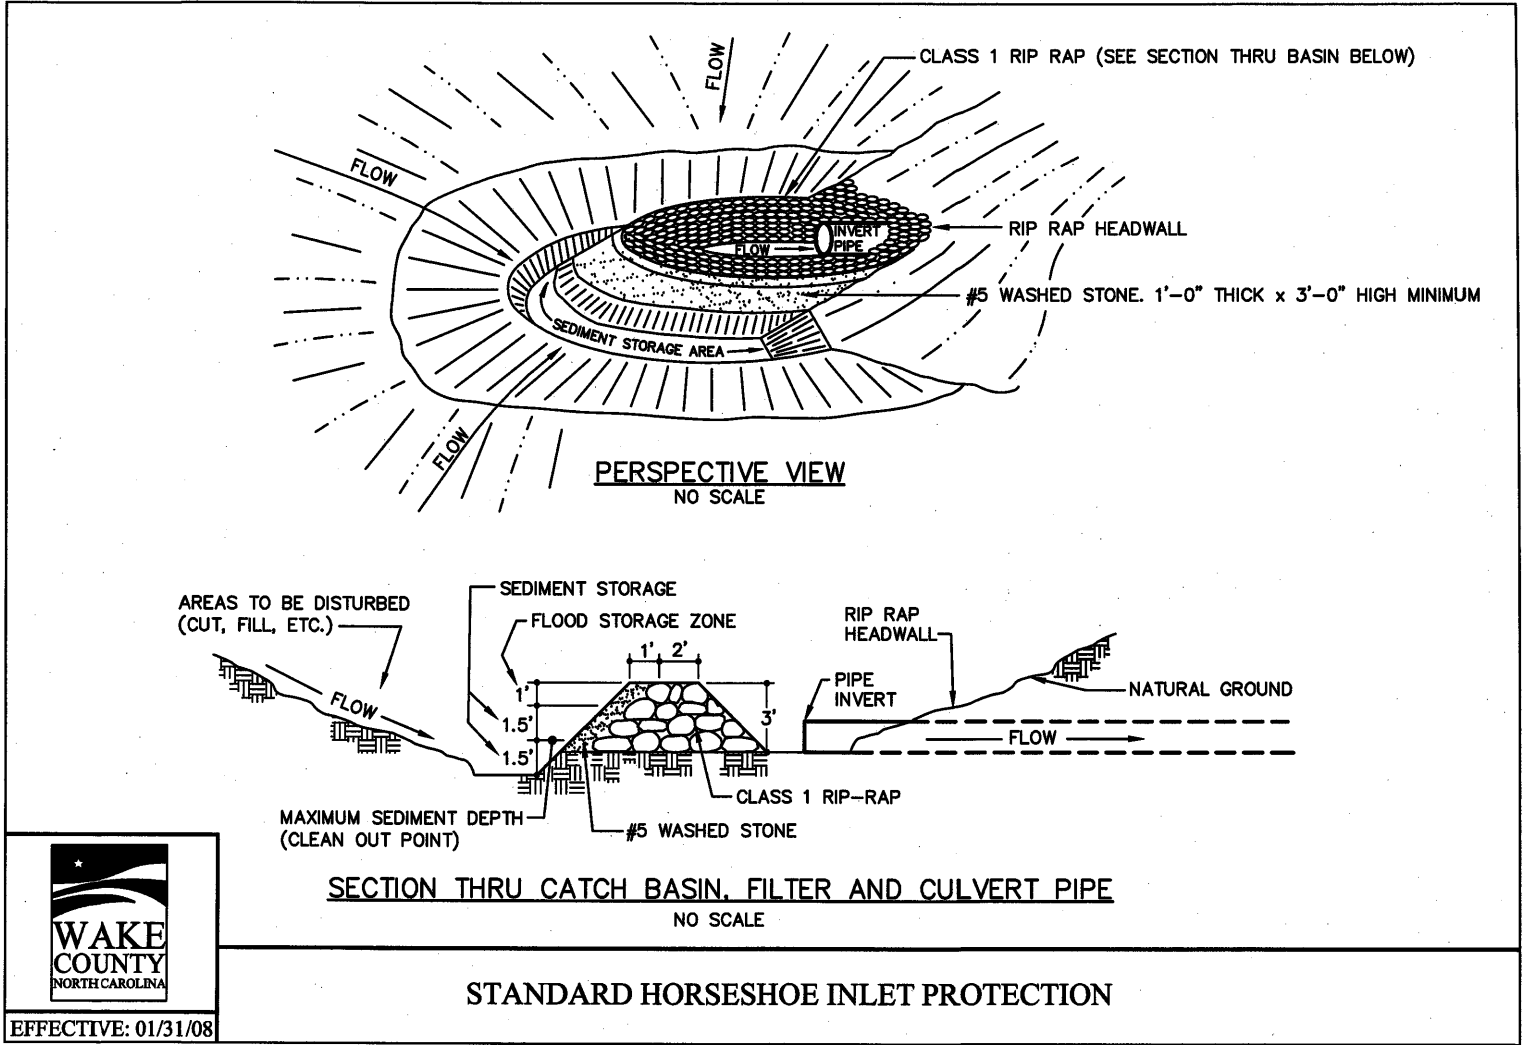



STANDARD HORSESHOE INLET PROTECTION

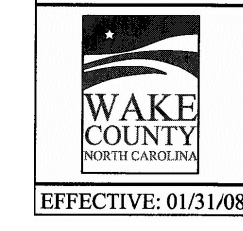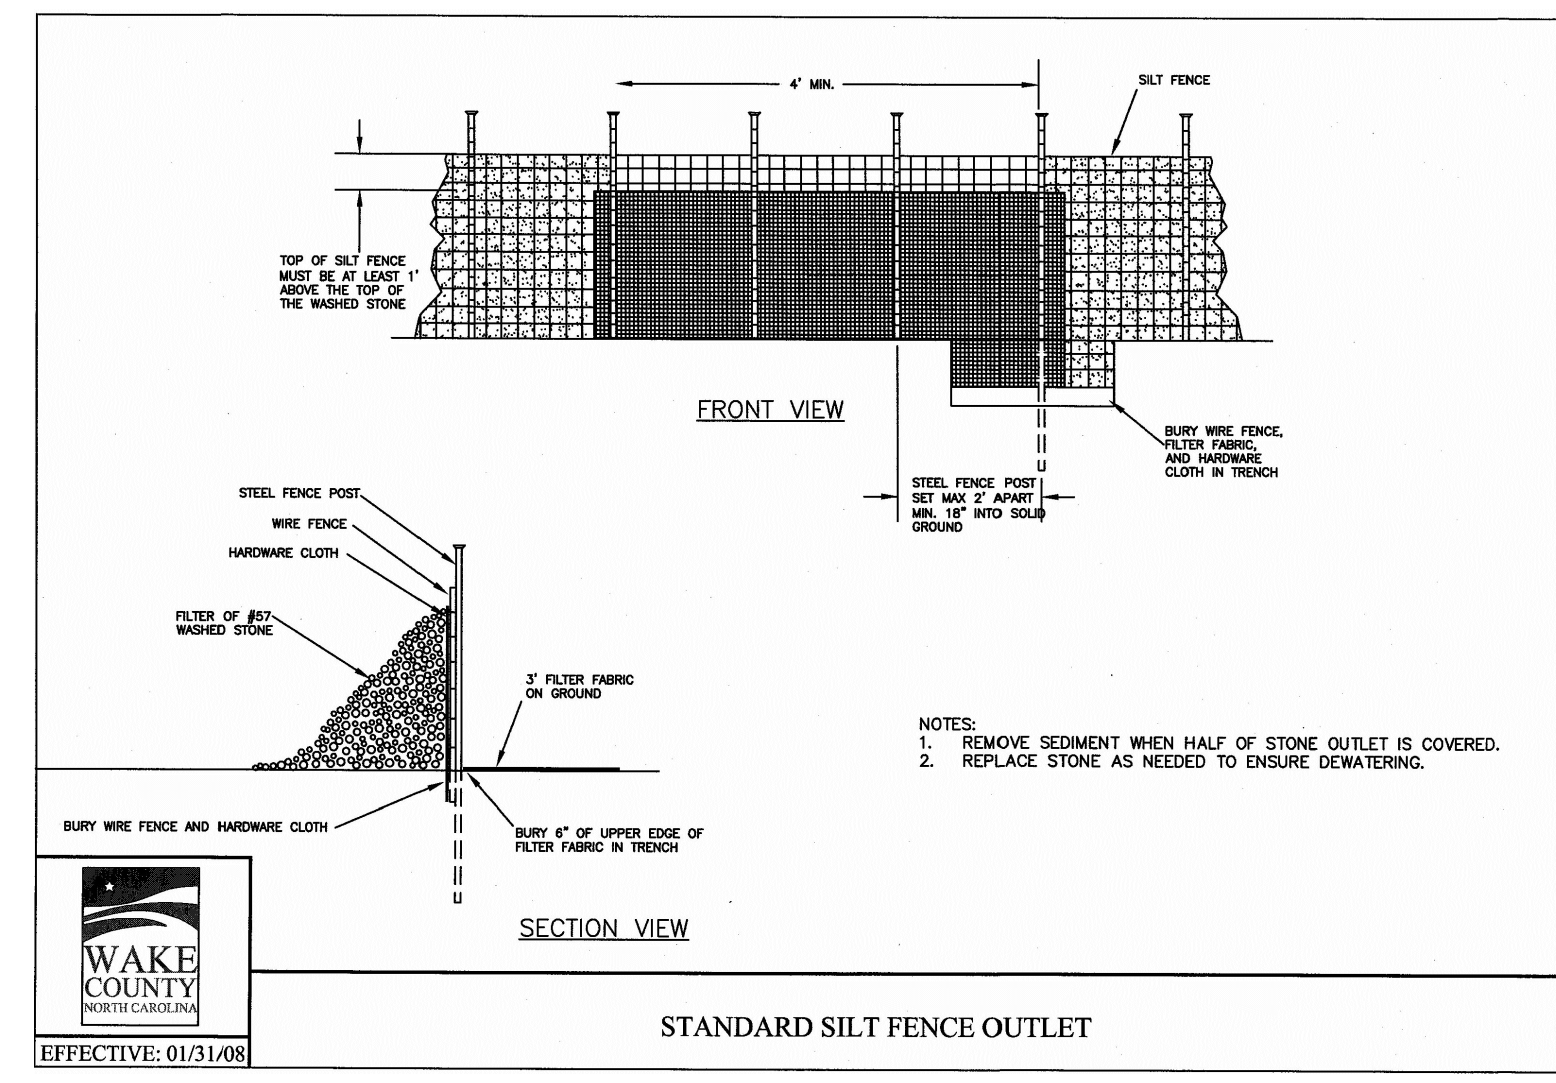

STANDARD SILT FENCE OUTLET

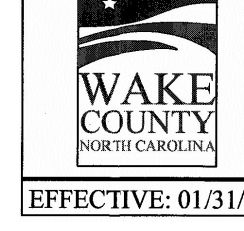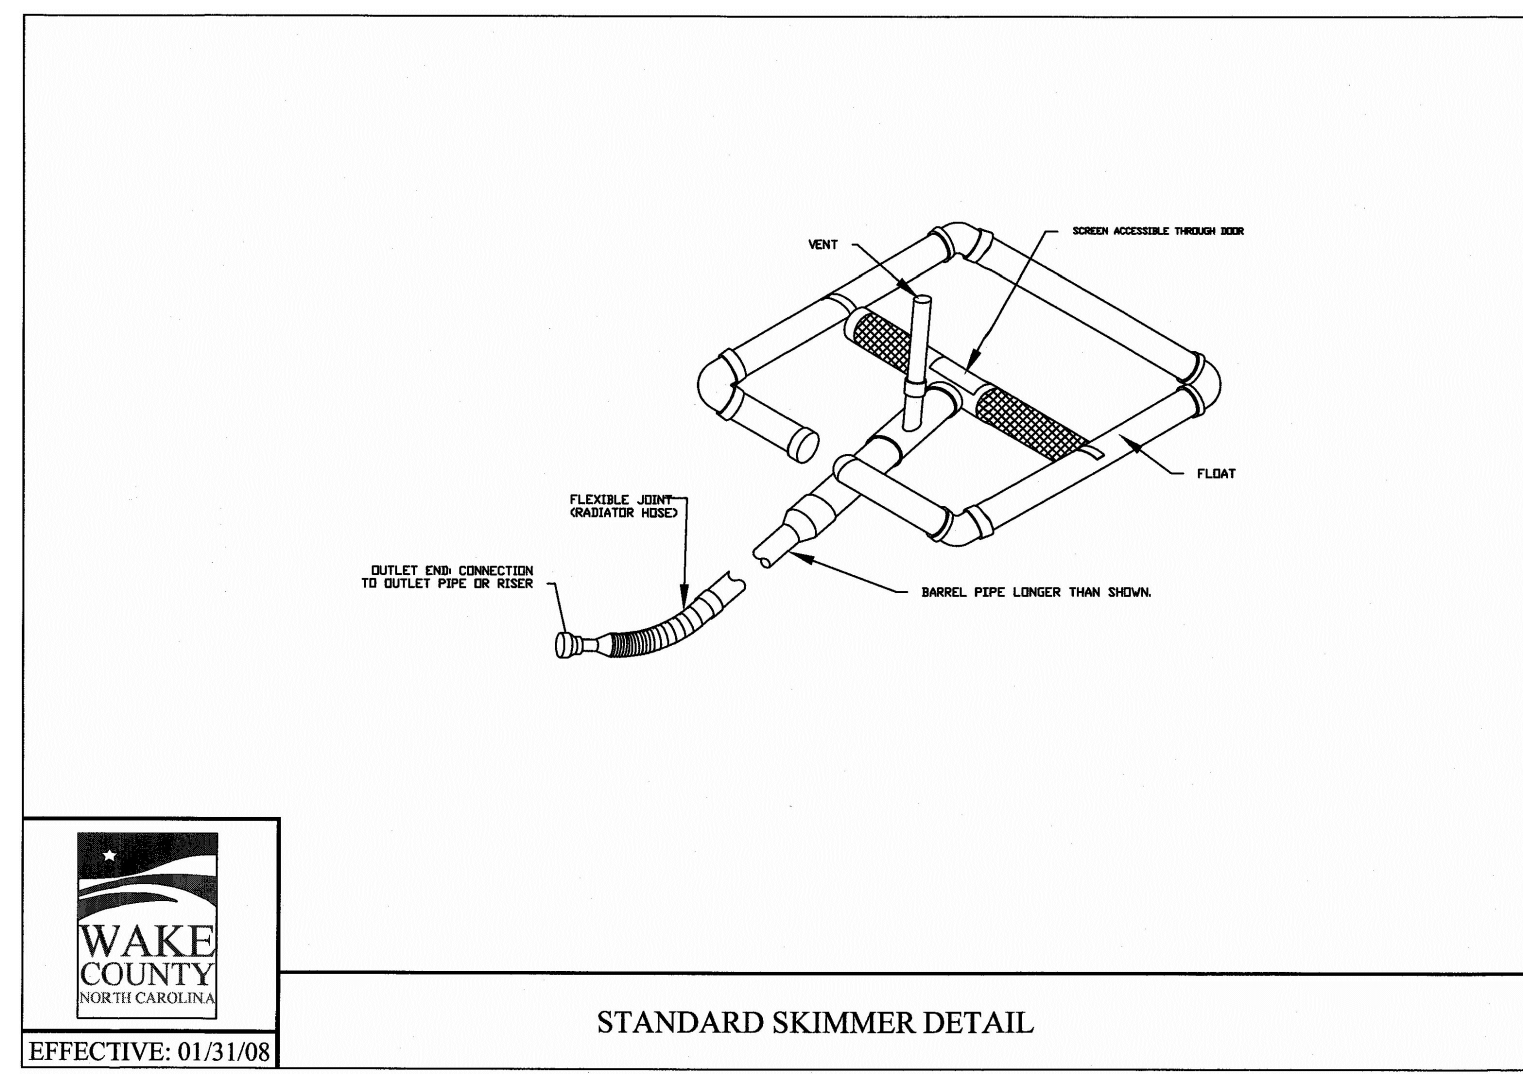



STANDARD SKIMMER DETAIL

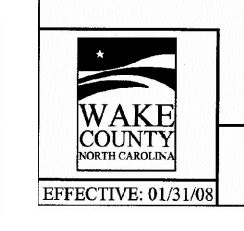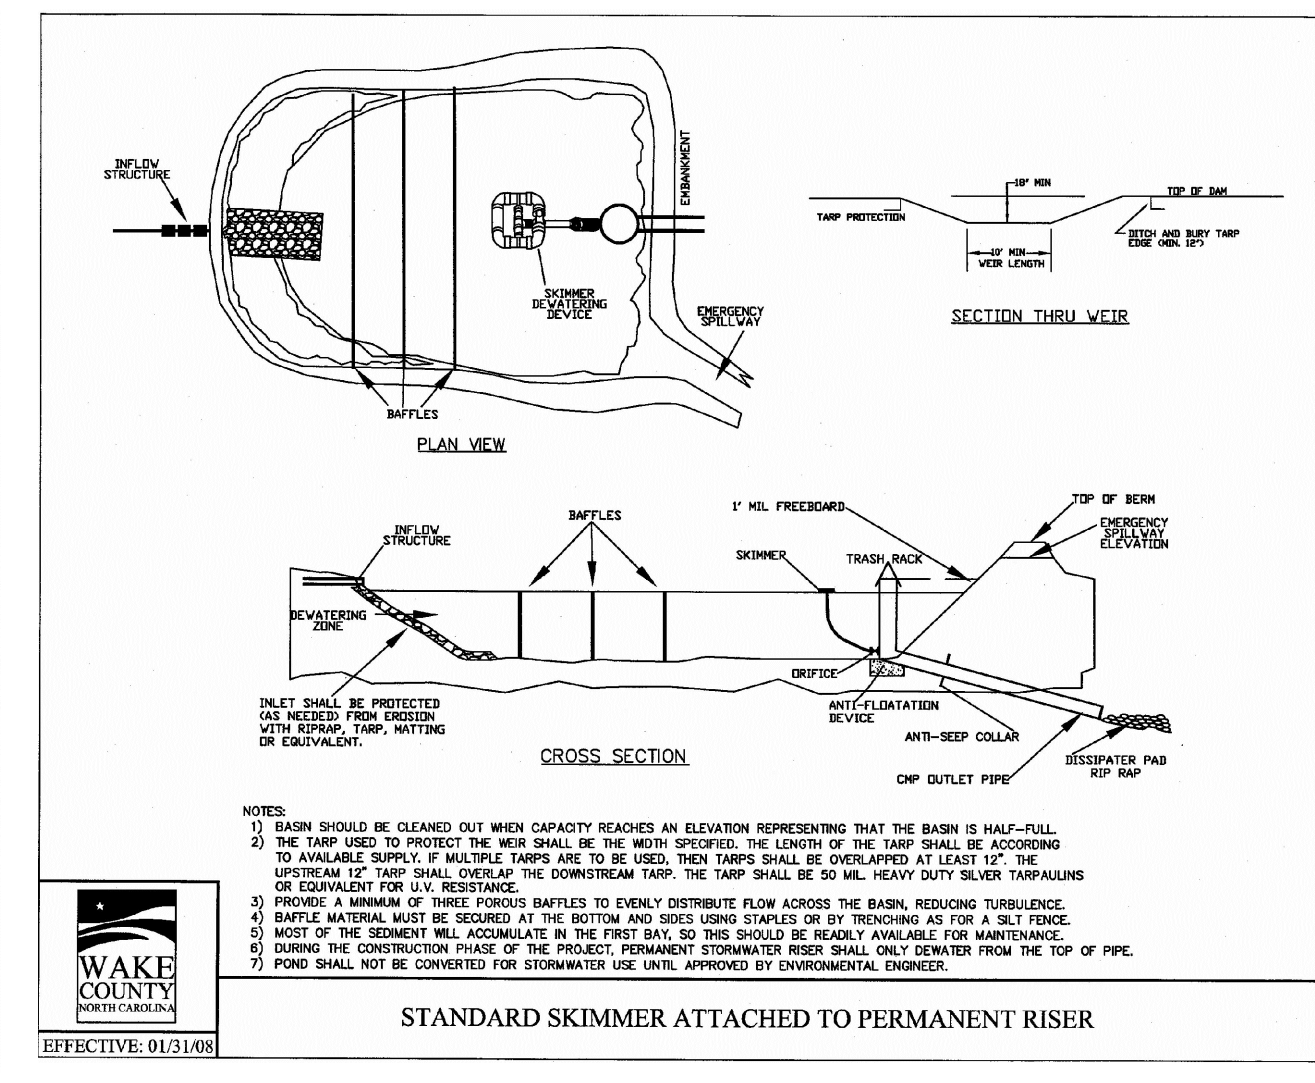



STANDARD SKIMMER ATTACHED TO PERMANENT RISER

SEEDING INFORMATION:

Table with columns for Seeding Schedule, Permanent Seeding, and Temporary Seeding. It lists dates, types of seeds (e.g., Tall Fescue, Lespedeza), and planting rates (e.g., 200 lbs/acre).

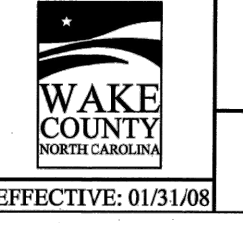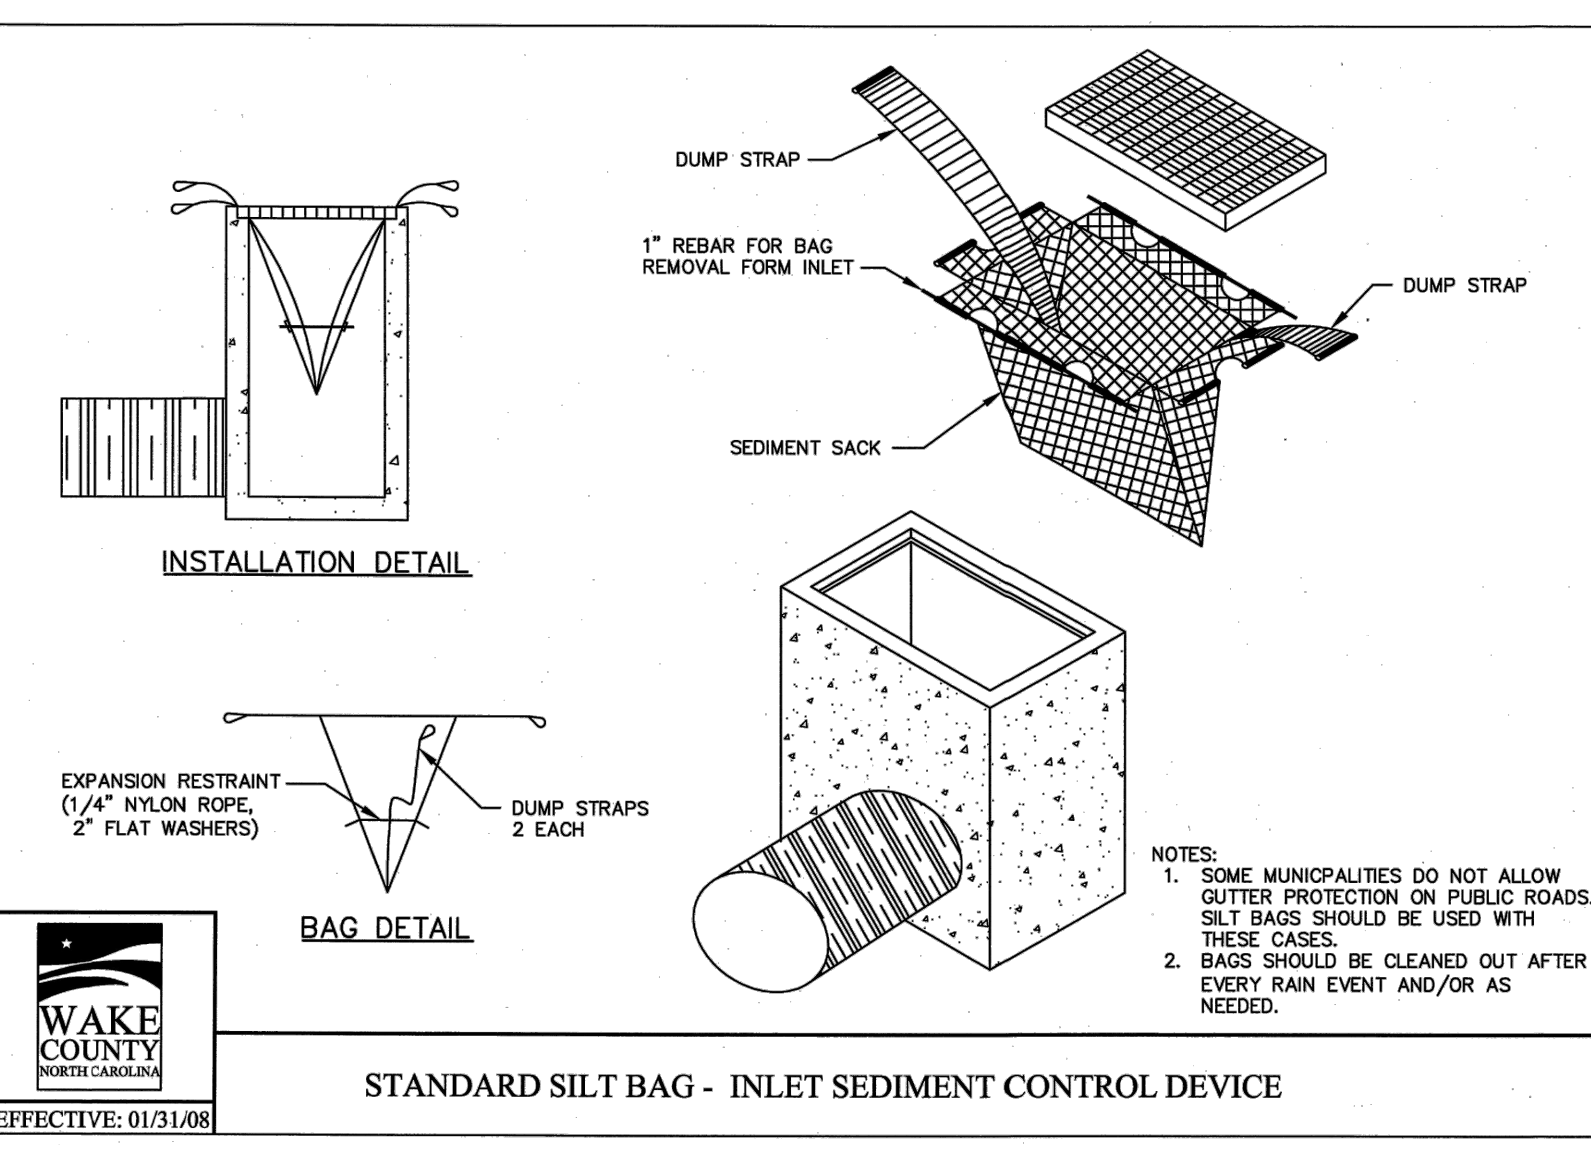

STANDARD SILT BAG - INLET SEDIMENT CONTROL DEVICE

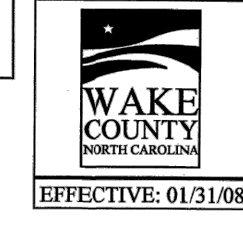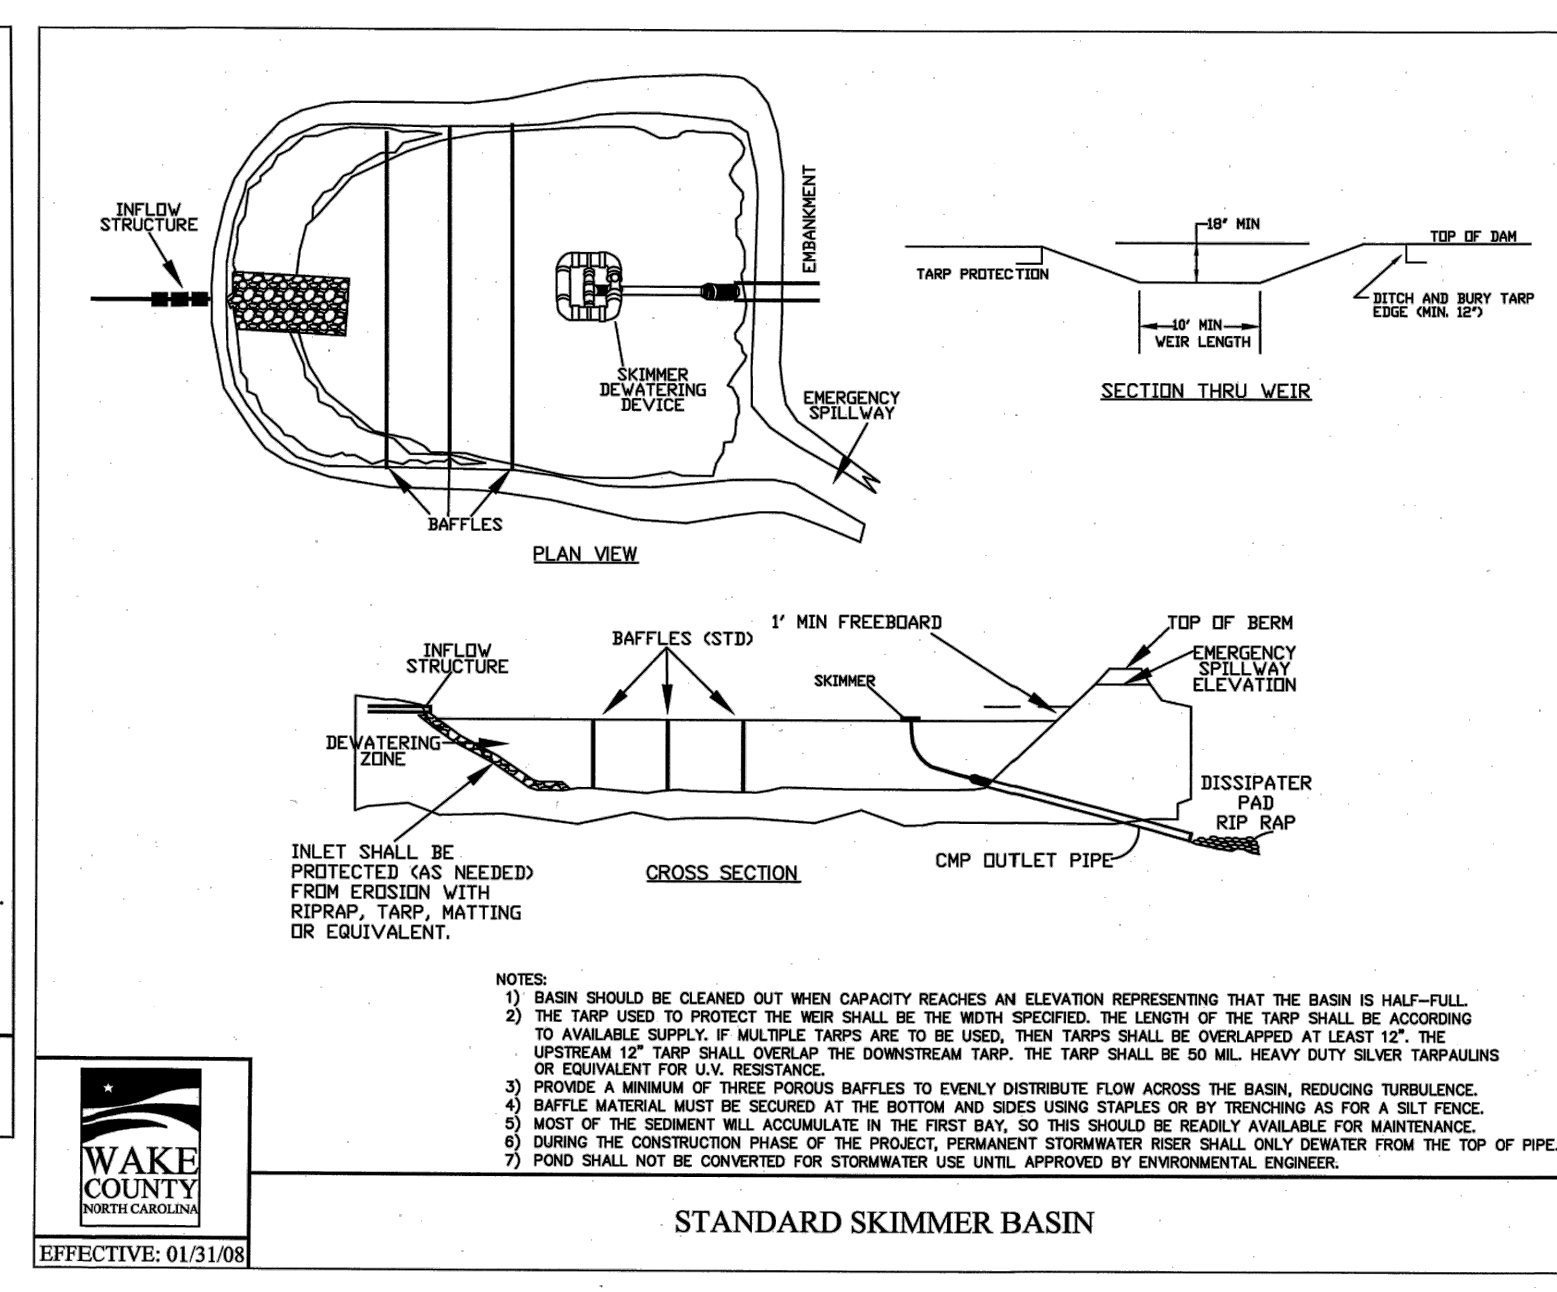

STANDARD SKIMMER BASIN

CITY OF RALEIGH - PLANS AUTHORIZED FOR CONSTRUCTION

Electronic Approval: This approval is being issued electronically. This approval is valid only upon the signature of a City of Raleigh Review Officer below. The City will retain a copy of the approved plans. Any work authorized by this approval must proceed in accordance with the plans kept on file with the City. This electronic approval may not be edited once issued. Any modification to this approval once issued will invalidate this approval.

City of Raleigh Development Approval

Raleigh Water Review Officer



04/20/22

Vertical sidebar containing the BNK logo, company name 'BASS, NIXON & KENNEDY, INC.', address '6310 CHAPEL HILL ROAD, SUITE 250, RALEIGH, NC 27607', phone '(919) 881-4422', and fax '(919) 881-8986'. It also includes a table for revisions with columns for 'NO.', 'DATE', 'DESCRIPTION', and 'BY'. At the bottom, it lists 'COBBLESTONE VILLAGE MIXED USE DEVELOPMENT' and 'TOWN OF ROLESVILLE, WAKE COUNTY, NORTH CAROLINA'.

R:\2019\19187 - Rolesville Town Center\CIVIL\04 Construction\07 - 19187_Details.dwg, CS3, 4/20/2022 3:39:58 PM, mnc-muellet

NOT RELEASED FOR CONSTRUCTION OR BID SOLICITATION

Table with 3 columns: NO., DATE, DESCRIPTION. Row 1: 1, 03/19/17, PROGRESS DATE. Row 2: 2, 03/19/17, DRAWN BY. Row 3: 3, 03/19/17, JOB NO. Row 4: 4, 03/19/17, NCG01 PLAN. Row 5: 5, 03/19/17, CHK BY: MDB. Row 6: 6, 03/19/17, SCALE: N.T.S. Row 7: 7, 03/19/17, TOWN OF ROLESVILLE, WAKE COUNTY, NORTH CAROLINA. Row 8: 8, 03/19/17, MIXED USE DEVELOPMENT. Row 9: 9, 03/19/17, VILLAGE. Row 10: 10, 03/19/17, COBLESTONE. Row 11: 11, 03/19/17, SHEET. Row 12: 12, 03/19/17, C3.7.

Table with 3 columns: MRM, DATE, DRAWN BY. Row 1: 03-1917, PROGRESS DATE, NCG01 PLAN. Row 2: 03-1917, DRAWN BY, NCG01 PLAN. Row 3: 03-1917, JOB NO., NCG01 PLAN. Row 4: 03-1917, CHK BY: MDB. Row 5: 03-1917, SCALE: N.T.S. Row 6: 03-1917, TOWN OF ROLESVILLE, WAKE COUNTY, NORTH CAROLINA. Row 7: 03-1917, MIXED USE DEVELOPMENT. Row 8: 03-1917, VILLAGE. Row 9: 03-1917, COBLESTONE. Row 10: 03-1917, SHEET. Row 11: 03-1917, C3.7.

CITY OF RALEIGH - PLANS AUTHORIZED FOR CONSTRUCTION Electronic Approval: This approval is being issued electronically. This approval is valid only upon the signature of a City of Raleigh Review Officer below. The City will retain a copy of the approved plans. Any work authorized by this approval must be used in accordance with the plans kept on file with the City. This electronic approval may not be edited once issued. Any modification to this approval once issued will invalidate this approval. City of Raleigh Development Approval _____ Raleigh Water Review Officer



GROUND STABILIZATION AND MATERIALS HANDLING PRACTICES FOR COMPLIANCE WITH THE NCG01 CONSTRUCTION GENERAL PERMIT

Table: Temporary and Permanent Groundcover*. Columns: SITE AREA DESCRIPTION, STABILIZATION, TIMEFRAME EXCEPTIONS. Rows: Perimeter dikes, seals, ditches, slopes; High Quality Water (HQW) Zones; Slopes steeper than 2:1; Slopes 3:1 or flatter; All other areas with slopes flatter than 4:1.

*For Falls Lake watershed, in disturbed areas where grading activities are incomplete, provide temporary groundcover no later than seven (7) days for slopes steeper than 3:1; ten (10) days for slopes equal to or flatter than 3:1; fourteen (14) days for areas with no slope.

Table: GROUND STABILIZATION SPECIFICATION. Columns: Temporary Stabilization, Permanent Stabilization. Rows: Temporary grass seed covered with straw or other mulches and tackifiers; Hydroseeding; Rolled erosion control products with or without temporary grass seed; Appropriately applied straw or other mulch with plastic sheeting.

POLYACRYLAMIDES (PAMS) AND FLOCCULANTS 1. Select flocculants that are appropriate for the soils being exposed during construction, selecting from the NC DWR List of Approved PAMS/Flocculants. 2. Apply flocculants at or before the inlets to Erosion and Sediment Control Measures. 3. Apply flocculants at the concentrations specified in the NC DWR List of Approved PAMS/Flocculants and in accordance with the manufacturer's instructions. 4. Provide ponding area for containment of treated Stormwater before discharging off-site. 5. Store flocculants in leak-proof containers that are kept under storm-resistant cover or surrounded by secondary containment structures.




EQUIPMENT AND VEHICLE MAINTENANCE 1. Maintain vehicles and equipment to prevent discharge of fluids. 2. Provide drip pans under any stored equipment. 3. Identify leaks and repair as soon as feasible, or remove leaking equipment from the project. 4. Collect all spent fluids, store in separate containers and properly dispose as hazardous waste (recycle when possible). 5. Remove leaking vehicles and construction equipment from service until the problem has been corrected. 6. Bring used fuels, lubricants, coolants, hydraulic fluids and other petroleum products to a recycling or disposal center that handles these materials.

LITTER, BUILDING MATERIAL AND LAND CLEARING WASTE 1. Never bury or burn waste. Place litter and debris in approved waste containers. 2. Provide a sufficient number of waste containers on site to manage the quantity of waste produced. 3. Locate waste containers at least 50 feet away from storm drain inlets and surface waters unless no other alternatives are reasonably available. 4. Locate waste containers on areas that do not receive substantial amounts of runoff from upland areas and does not drain directly to a storm drain, stream or wetland. 5. Cover waste containers at the end of each workday and before storm events. Repair or replace damaged waste containers. 6. Anchor all lightweight items in waste containers during times of high winds. 7. Empty waste containers as needed to prevent overflow. 8. Dispose waste off-site at an approved disposal facility.

PAINT AND OTHER LIQUID WASTE 1. Do not dump paint and other liquid waste into storm drains, streams or wetlands. 2. Locate paint washouts at least 50 feet away from storm drain inlets and surface waters unless no other alternatives are reasonably available. 3. Contain liquid wastes in a controlled area. 4. Containment must be labeled, sized and placed appropriately for the needs of site. 5. Prevent the discharge of soaps, solvents, detergents and other liquid wastes from construction sites.

PORTABLE TOILETS 1. Install portable toilets on level ground, at least 50 feet away from storm drains, streams or wetlands unless there is no alternative reasonably available. If 50 foot offset is not attainable, provide relocation of portable toilet behind silt fence or place on a gravel pad and surround with sand bags. 2. Provide staking or anchoring of portable toilets during periods of high winds or in high foot traffic areas. 3. Monitor portable toilets for leaking and properly dispose of any leaked material. Utilize a licensed sanitary waste hauler to remove leaking portable toilets and replace with properly operating unit.

EARTHEN STOCKPILE MANAGEMENT 1. Show stockpile locations on plans. Locate earthen-material stockpile areas at least 50 feet away from storm drain inlets, sediment basins, perimeter sediment controls and surface waters unless it can be shown no other alternatives are reasonably available. 2. Protect stockpile with silt fence installed along toe of slope with a minimum offset of five feet from the toe of stockpile. 3. Provide stable stone access point when feasible. 4. Stabilize stockpile within the timeframes provided on this sheet and in accordance with the approved plan and any additional requirements. Soil stabilization is defined as vegetative, physical or chemical coverage techniques that will restrain accelerated erosion on disturbed soils for temporary or permanent control needs.

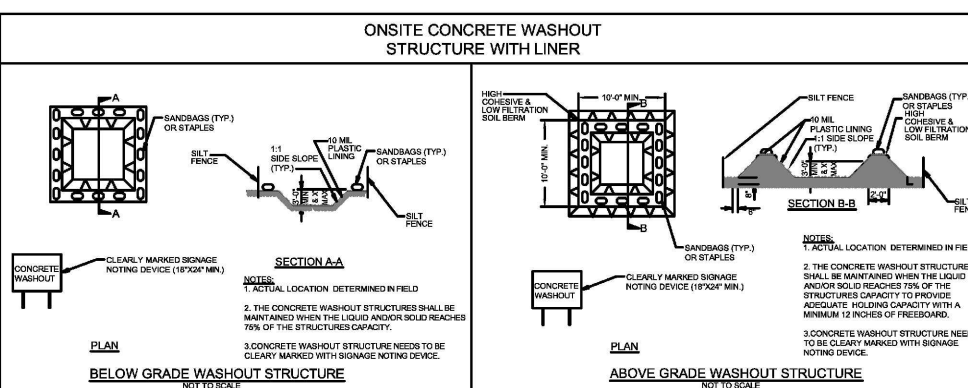

CONCRETE WASHOUTS 1. Do not discharge concrete or cement slurry from the site. 2. Dispose of, or recycle settled, hardened concrete residue in accordance with local and state solid waste regulations and at an approved facility. 3. Manage washout from mortar mixers in accordance with the above item and in addition place the mixer and associated materials on impervious barrier and within lot perimeter silt fence. 4. Install temporary concrete washouts per local requirements, where applicable. If an alternate method or product is to be used, contact your approval authority for review and approval. If local standard details are not available, use one of the two types of temporary concrete washouts provided on this detail. 5. Do not use concrete washouts for dewatering or storing defective curb or sidewalk sections. Stormwater accumulated within the washout may not be pumped into or discharged to the storm drain system or receiving surface waters. Liquid waste must be pumped out and removed from project. 6. Locate washouts at least 50 feet from storm drain inlets and surface waters unless it can be shown that no other alternatives are reasonably available. At a minimum, install protection of storm drain inlet(s) closest to the washout which could receive spills or overflow. 7. Locate washouts in an easily accessible area, on level ground and install a stone entrance pad in front of the washout. Additional controls may be required by the approving authority. 8. Install at least one sign directing concrete trucks to the washout within the project limits. Post signage on the washout itself to identify this location. 9. Remove leavings from the washout when at approximately 75% capacity to limit overflow events. Replace the tarp, sand bags or other temporary structural components when no longer functional. When utilizing alternative or proprietary products, follow manufacturer's instructions. 10. At the completion of the concrete work, remove remaining leavings and dispose of in an approved disposal facility. Fill pit, if applicable, and stabilize any disturbance caused by removal of washout.

HERBICIDES, PESTICIDES AND RODENTICIDES 1. Store and apply herbicides, pesticides and rodenticides in accordance with label restrictions. 2. Store herbicides, pesticides and rodenticides in their original containers with the label, which lists directions for use, ingredients and first aid steps in case of accidental poisoning. 3. Do not store herbicides, pesticides and rodenticides in areas where flooding is possible or where they may spill or leak into wells, stormwater drains, ground water or surface water. If a spill occurs, clean area immediately. 4. Do not stockpile these materials on-site.

HAZARDOUS AND TOXIC WASTE 1. Create designated hazardous waste collection areas on-site. 2. Place hazardous waste containers under cover or in secondary containment. 3. Do not store hazardous chemicals, drums or bagged materials directly on the ground.

NCG01 GROUND STABILIZATION AND MATERIALS HANDLING EFFECTIVE: 03/01/19

Table: PART III SELF-INSPECTION, RECORDKEEPING AND REPORTING. SECTION A: SELF-INSPECTION. Columns: Inspect, Frequency (during normal business hours), Inspection records must include. Rows: (1) Rain gauge maintained in good working order; (2) E&S Measures; (3) Stormwater discharge outfalls (DOCs); (4) Perimeter of site; (5) Streams or wetlands on-site (where accessible); (6) Ground stabilization measures.

Table: PART III SELF-INSPECTION, RECORDKEEPING AND REPORTING. SECTION B: RECORDKEEPING. Columns: Item to Document, Documentation Requirements. Rows: (a) E&S Plan Documentation; (b) A phase of grading has been completed; (c) Ground cover is located and installed in accordance with the approved E&S plan; (d) The maintenance and repair requirements for all E&S measures; (e) Corrective actions have been taken to E&S measures.

Table: PART III SELF-INSPECTION, RECORDKEEPING AND REPORTING. SECTION C: REPORTING. Columns: Occurrence, Reporting Timeframes (After Discovery) and Other Requirements. Rows: (a) Visible sediment deposition in a stream or wetland; (b) Oil spills and releases of hazardous substances per Item 1(b)-(c) above; (c) Anticipated bypasses (40 CFR 122.41(m)(3)); (d) Unanticipated bypasses (40 CFR 122.41(m)(3)); (e) Noncompliance with the conditions of this permit that may endanger health or the environment (40 CFR 122.41(k)(7)).

PART II, SECTION G, ITEM (4) DRAW DOWN OF SEDIMENT BASINS FOR MAINTENANCE OR CLOSE OUT Sediment basins and traps that receive runoff from drainage areas of one acre or more shall use outlet structures that withdraw water from the surface when these devices need to be drawn down for maintenance or close out unless this is infeasible. The circumstances in which it is not feasible to withdraw water from the surface shall be rare (for example, times with extended cold weather). Non-surface withdrawals from sediment basins shall be allowed only when all of the following criteria have been met: (a) The E&S plan authority has been provided with documentation of the non-surface withdrawal and the specific time periods or conditions in which it will occur. The non-surface withdrawal shall not commence until the E&S plan authority has approved these items, (b) The non-surface withdrawal has been reported as an anticipated bypass in accordance with Part III, Section C, Item 2(c) and (d) of this permit, (c) Dewatering discharges are treated with controls to minimize discharges of pollutants from stormwater that is removed from the sediment basin. Examples of appropriate controls include properly sited, designed and maintained dewatering tanks, wet tanks, and filtration systems, (d) Vegetated, upland areas of the sites or a properly designed stone pad is used to the extent feasible at the outlet of the dewatering treatment devices described in item (c) above, (e) Velocity dissipation devices such as check dams, and riprap are provided at all discharge points of all dewatering devices, and (f) Sediment removed from the dewatering treatment devices described in item (c) above is disposed of in a manner that does not cause deposition of sediment into waters of the United States.

NCG01 SELF-INSPECTION, RECORDKEEPING AND REPORTING EFFECTIVE: 04/01/19

CITY OF RALEIGH - PLANS AUTHORIZED FOR CONSTRUCTION

Electronic Approval: This approval is being issued electronically. This approval is valid only upon the signature of a City of Raleigh Review Officer below. The City will retain a copy of the approved plans. Any work authorized by this approval must proceed in accordance with the plans kept on file with the City. This electronic approval may not be edited once issued. Any modification to this approval once issued will invalidate this approval.

City of Raleigh Development Approval _____
 Raleigh Water Review Officer



BASS, NIXON & KENNEDY, INC.
CONSULTING ENGINEERS
 6310 CHAPEL HILL ROAD, SUITE 250, RALEIGH, NC 27607
 TELEPHONE: (919) 851-4422 FAX: (919) 851-6986
 CERTIFICATION NUMBERS: NCBELS (C-0110); NCBOLA (C-0267)

| STORMDRAINAGE PIPE TABLE | | | | | | | |
|--------------------------|----------------|-------------|-------------|--------|----------|----------|-------|
| U.S. STRUCTURE | D.S. STRUCTURE | U.S. INVERT | D.S. INVERT | LENGTH | DIAMETER | MATERIAL | SLOPE |
| 2 | 1 | 420.00 | 419.80 | 18.80 | 24 | HDPE | 1.06% |
| 4 | 3 | 421.26 | 421.00 | 43.91 | 36 | HDPE | 0.60% |
| 5 | 4 | 422.04 | 421.36 | 113.45 | 36 | HDPE | 0.60% |
| 6 | 5 | 423.35 | 422.14 | 201.82 | 36 | HDPE | 0.60% |
| 7 | 6 | 423.62 | 423.45 | 28.04 | 36 | HDPE | 0.60% |
| 8 | 7 | 425.82 | 424.94 | 88.24 | 24 | HDPE | 1.00% |
| 9 | 8 | 426.82 | 425.92 | 90.21 | 24 | HDPE | 1.00% |
| 10 | 9 | 427.59 | 426.92 | 87.14 | 24 | HDPE | 1.00% |
| 11 | 10 | 428.63 | 427.69 | 93.66 | 18 | HDPE | 1.00% |
| 12 | 11 | 429.65 | 428.73 | 91.93 | 18 | HDPE | 1.00% |
| 13 | 12 | 430.39 | 429.75 | 63.96 | 15 | HDPE | 1.00% |

| STORMDRAINAGE PIPE TABLE | | | | | | | |
|--------------------------|----------------|-------------|-------------|--------|----------|----------|-------|
| U.S. STRUCTURE | D.S. STRUCTURE | U.S. INVERT | D.S. INVERT | LENGTH | DIAMETER | MATERIAL | SLOPE |
| 14 | 13 | 430.75 | 430.49 | 25.95 | 15 | HDPE | 1.00% |
| 15 | 5 | 424.10 | 423.05 | 105.41 | 15 | HDPE | 1.00% |
| 16 | 7 | 424.61 | 423.72 | 147.77 | 24 | HDPE | 0.60% |
| 17 | 16 | 425.41 | 424.71 | 116.44 | 24 | HDPE | 0.60% |
| 18 | 17 | 428.85 | 427.77 | 107.92 | 15 | HDPE | 1.00% |
| 19 | 18 | 431.57 | 430.69 | 88.39 | 15 | HDPE | 1.00% |
| 20 | 19 | 432.50 | 431.67 | 83.01 | 15 | HDPE | 1.00% |
| 21 | 6 | 424.24 | 423.45 | 78.65 | 24 | HDPE | 1.00% |
| 22 | 21 | 424.60 | 424.34 | 26.08 | 15 | HDPE | 1.00% |
| 23 | 22 | 426.78 | 424.70 | 207.76 | 15 | HDPE | 1.00% |
| 24 | 10 | 432.22 | 430.86 | 90.55 | 15 | HDPE | 1.50% |

| STORMDRAINAGE PIPE TABLE | | | | | | | |
|--------------------------|----------------|-------------|-------------|--------|----------|----------|-------|
| U.S. STRUCTURE | D.S. STRUCTURE | U.S. INVERT | D.S. INVERT | LENGTH | DIAMETER | MATERIAL | SLOPE |
| 27 | 28 | 436.27 | 435.41 | 85.76 | 15 | HDPE | 1.00% |
| 28 | 35 | 435.31 | 434.24 | 106.92 | 15 | HDPE | 1.00% |
| 29 | 22 | 425.05 | 424.70 | 34.83 | 15 | HDPE | 1.00% |
| 30 | 17 | 426.34 | 425.51 | 137.91 | 18 | HDPE | 0.60% |
| 31 | 18 | 429.82 | 428.95 | 87.08 | 15 | HDPE | 1.00% |
| 32 | 9 | 429.50 | 428.60 | 90.23 | 15 | HDPE | 1.00% |
| 33 | 24 | 432.43 | 432.32 | 11.23 | 15 | HDPE | 1.00% |
| 34 | 17 | 428.09 | 427.77 | 32.09 | 12 | HDPE | 1.00% |
| 35 | 33 | 434.14 | 432.53 | 160.60 | 15 | HDPE | 1.00% |

| STORMDRAINAGE STRUCTURE TABLE | | |
|-------------------------------|--|------------------|
| STRUCTURE NAME | INSERTION RIM ELEVATION (FLOWLINE) | STRUCTURE TYPE |
| 1 | 422.45 INV. IN= 419.80 (2) | 24" FES |
| 2 | 425.18 INV. OUT= 420.00 (1) | RISER |
| 3 | 424.83 INV. IN= 421.00 (4) | 36" FES |
| 4 | 428.06 INV. IN= 421.36 (5) INV. OUT= 421.26 (3) | NCDOT CURB INLET |
| 5 | 429.08 INV. IN= 422.14 (6) INV. IN= 423.05 (15) INV. OUT= 422.04 (4) | NCDOT CURB INLET |
| 6 | 430.99 INV. IN= 423.45 (7) INV. IN= 423.45 (21) INV. OUT= 423.35 (5) | NCDOT CURB INLET |
| 7 | 431.15 INV. IN= 424.94 (8) INV. IN= 423.72 (16) INV. OUT= 423.62 (6) | NCDOT CURB INLET |
| 8 | 433.95 INV. IN= 425.82 (9) INV. OUT= 425.82 (7) | NCDOT CURB INLET |
| 9 | 433.95 INV. IN= 426.92 (10) INV. IN= 428.60 (32) INV. OUT= 426.82 (8) | NCDOT CURB INLET |

| STORMDRAINAGE STRUCTURE TABLE | | |
|-------------------------------|---|------------------|
| STRUCTURE NAME | INSERTION RIM ELEVATION (FLOWLINE) | STRUCTURE TYPE |
| 10 | 436.44 INV. IN= 427.69 (11) INV. IN= 430.86 (24) INV. OUT= 427.59 (9) | HDPE YARD INLET |
| 11 | 437.44 INV. IN= 428.73 (12) INV. OUT= 428.63 (10) | HDPE YARD INLET |
| 12 | 435.50 INV. IN= 429.75 (13) INV. OUT= 429.65 (11) | HDPE YARD INLET |
| 13 | 436.00 INV. IN= 430.49 (14) INV. OUT= 430.39 (12) | NCDOT CURB INLET |
| 14 | 436.00 INV. OUT= 430.75 (13) | NCDOT CURB INLET |
| 15 | 428.50 INV. OUT= 424.10 (5) | HDPE YARD INLET |
| 16 | 429.68 INV. IN= 424.71 (17) INV. OUT= 424.61 (7) | NCDOT CURB INLET |
| 17 | 434.01 INV. IN= 427.77 (18) INV. IN= 425.51 (30) INV. IN= 427.77 (34) INV. OUT= 425.41 (16) | NCDOT CURB INLET |
| 18 | 436.04 INV. IN= 430.89 (19) INV. IN= 428.95 (31) INV. OUT= 428.85 (17) | NCDOT CURB INLET |

| STORMDRAINAGE STRUCTURE TABLE | | |
|-------------------------------|---|------------------|
| STRUCTURE NAME | INSERTION RIM ELEVATION (FLOWLINE) | STRUCTURE TYPE |
| 19 | 437.52 INV. IN= 431.67 (20) INV. OUT= 431.57 (18) | NCDOT CURB INLET |
| 20 | 438.65 INV. OUT= 432.50 (19) | NCDOT CURB INLET |
| 21 | 431.60 INV. IN= 424.34 (22) INV. OUT= 424.24 (6) | HDPE YARD INLET |
| 22 | 432.00 INV. IN= 424.70 (23) INV. IN= 424.70 (29) INV. OUT= 424.60 (21) | NCDOT CURB INLET |
| 23 | 435.99 INV. OUT= 426.78 (22) | NCDOT CURB INLET |
| 24 | 437.18 INV. IN= 432.32 (33) INV. OUT= 432.22 (10) | HDPE YARD INLET |
| 27 | 441.00 INV. OUT= 436.27 (28) | HDPE YARD INLET |
| 28 | 441.00 INV. IN= 435.41 (27) INV. OUT= 435.31 (35) | HDPE YARD INLET |
| 29 | 428.50 INV. OUT= 425.05 (22) | HDPE YARD INLET |

| STORMDRAINAGE STRUCTURE TABLE | | |
|-------------------------------|---|------------------|
| STRUCTURE NAME | INSERTION RIM ELEVATION (FLOWLINE) | STRUCTURE TYPE |
| 30 | 430.12 INV. OUT= 426.34 (17) | NCDOT CURB INLET |
| 31 | 434.05 INV. OUT= 429.82 (18) | NCDOT CURB INLET |
| 32 | 435.72 INV. OUT= 429.50 (9) | NCDOT CURB INLET |
| 33 | 437.87 INV. IN= 432.53 (35) INV. OUT= 432.43 (24) | NCDOT CURB INLET |
| 34 | 430.03 INV. OUT= 428.09 (17) | HDPE YARD INLET |
| 35 | 441.08 INV. IN= 434.24 (28) INV. OUT= 434.14 (33) | HDPE YARD INLET |

| NO. | DATE | DESCRIPTION | BY |
|-----|------|-------------|----|
| | | | |
| | | | |


03-19157
 JOB NO. _____
 DATE _____
 DRAWN BY _____
STORM DRAINAGE PIPE & STRUCTURE TABLE
 SCALE: _____
 CHK BY: MDB



04/20/22

COBBLESTONE VILLAGE MIXED USE DEVELOPMENT
 TOWN OF ROLESVILLE, WAKE COUNTY, NORTH CAROLINA

SHEET **C3.8**

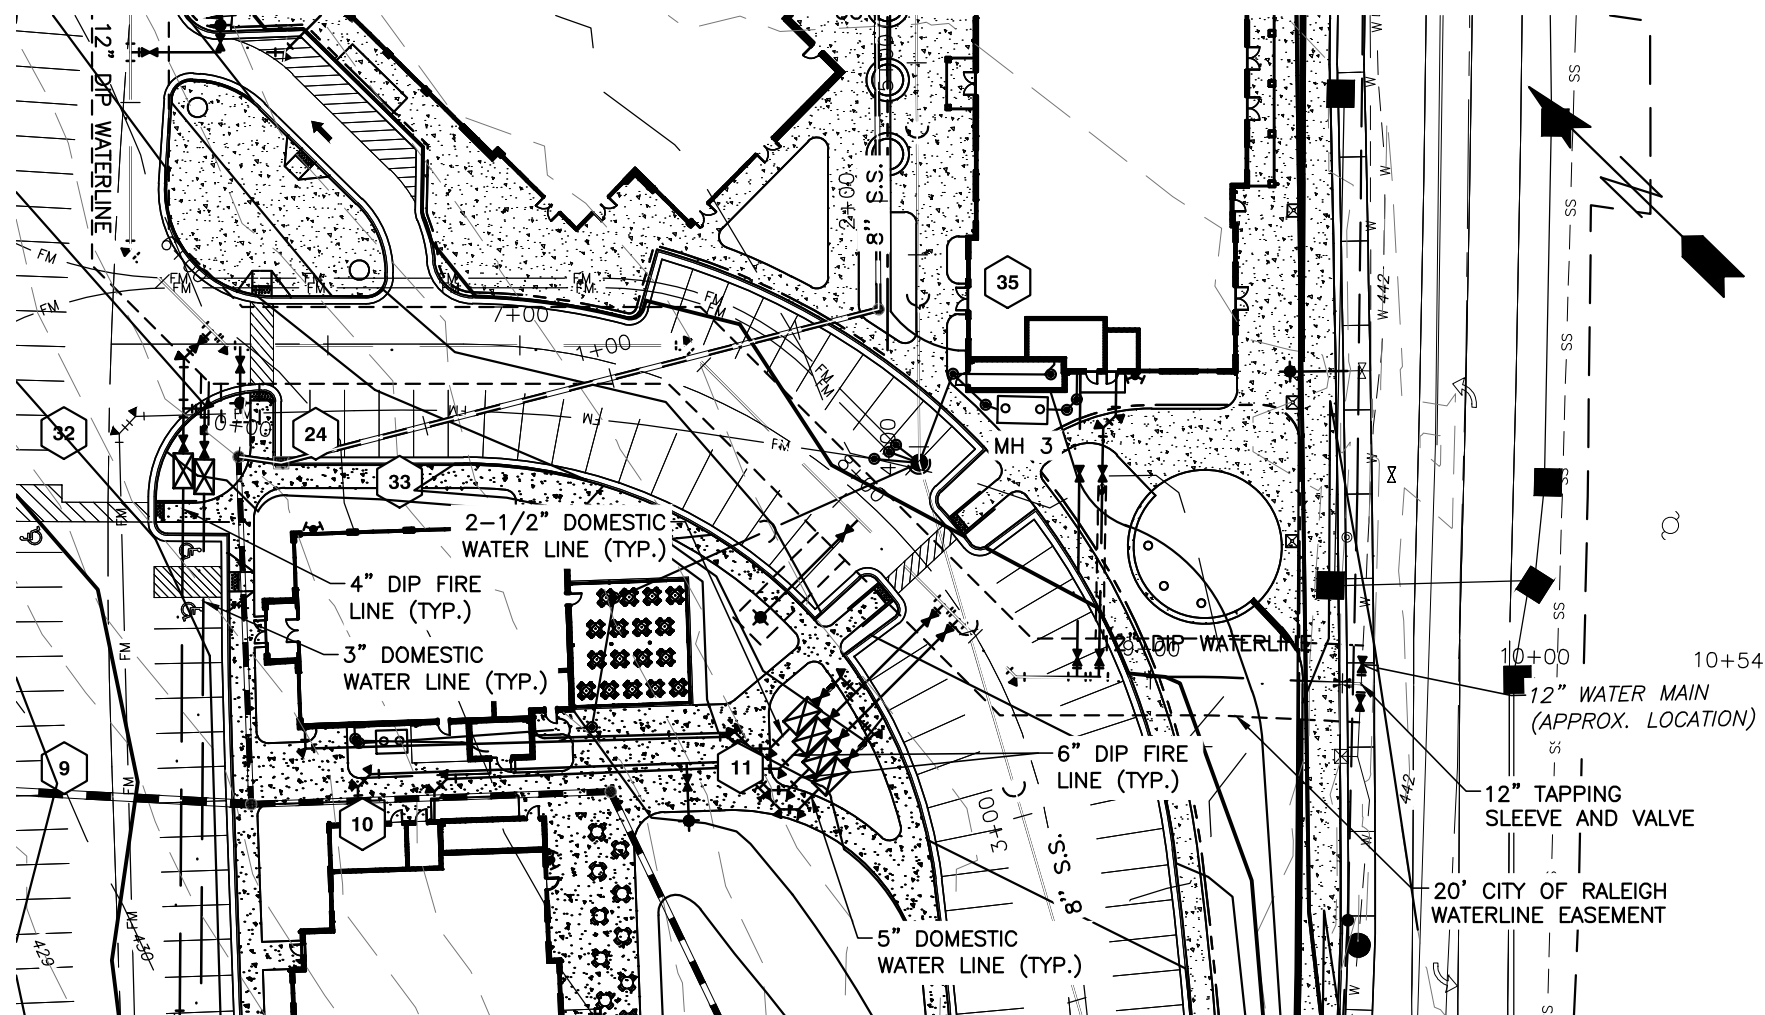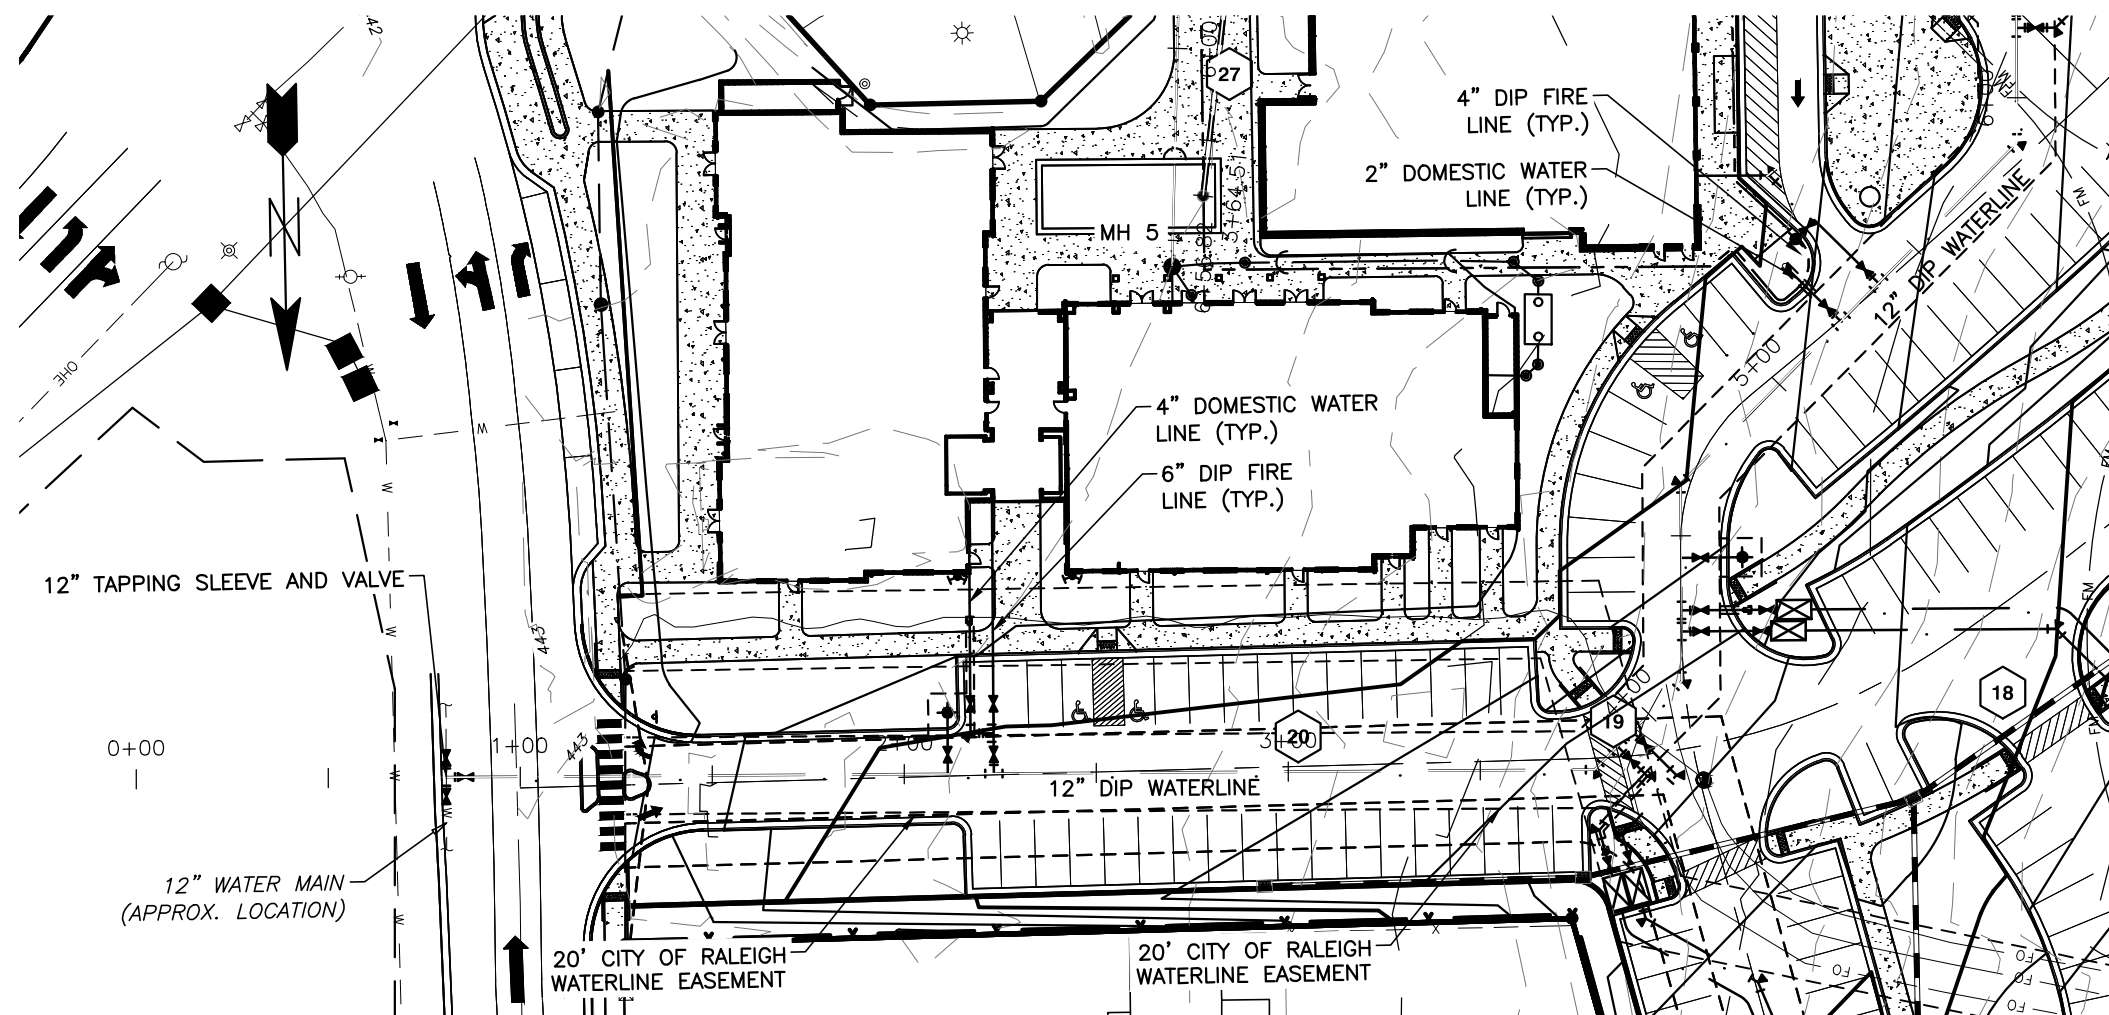

Public
Water Distribution / Extension System
 The City of Raleigh consents to the connection and extension of the City's public water system as shown on this plan. The material and Construction methods used for this project shall conform to the standards and specifications of the City's Public Utilities Handbook.
 City of Raleigh
 Public Utilities Department Permit # W-3879
 Authorization to Construct See digital signature

CITY OF RALEIGH - PLANS AUTHORIZED FOR CONSTRUCTION
 Electronic Approval: This approval is being issued electronically. This approval is valid only upon the signature of a City of Raleigh Review Officer below. The City will retain a copy of the approved plans. Any work authorized by this approval must proceed in accordance with the plans kept on file with the City. This electronic approval may not be edited once issued. Any modification to this approval once issued will invalidate this approval.
 City of Raleigh Development Approval _____
 Raleigh Water Review Officer _____



BASS, NIXON & KENNEDY, INC.
CONSULTING ENGINEERS
 6310 CHAPEL HILL ROAD, SUITE 250, RALEIGH, NC 27607
 TELEPHONE: (919)881-1122 FAX: (919)881-8686
 CERTIFICATION NUMBERS: NCBELS (C-0110); NCBOLA (C-0267)


| NO. | DATE | DESCRIPTION | BY |
|-----|------|-------------|----|
| | | | |
| | | | |

| | | |
|--|----------|----------|
| 03-19157 | PROGRESS | MRM |
| JOB NO. | DATE | DRAWN BY |
| PUBLIC WATERLINE PROFILE | | |
| SCALE: 1" = 50' H; 1" = 5' V CHK BY: MDB | | |

COBBLESTONE VILLAGE
MIXED USE DEVELOPMENT
 TOWN OF ROLESVILLE, WAKE COUNTY, NORTH CAROLINA

SHEET
C4.1


PUBLIC WATERLINE PROFILE

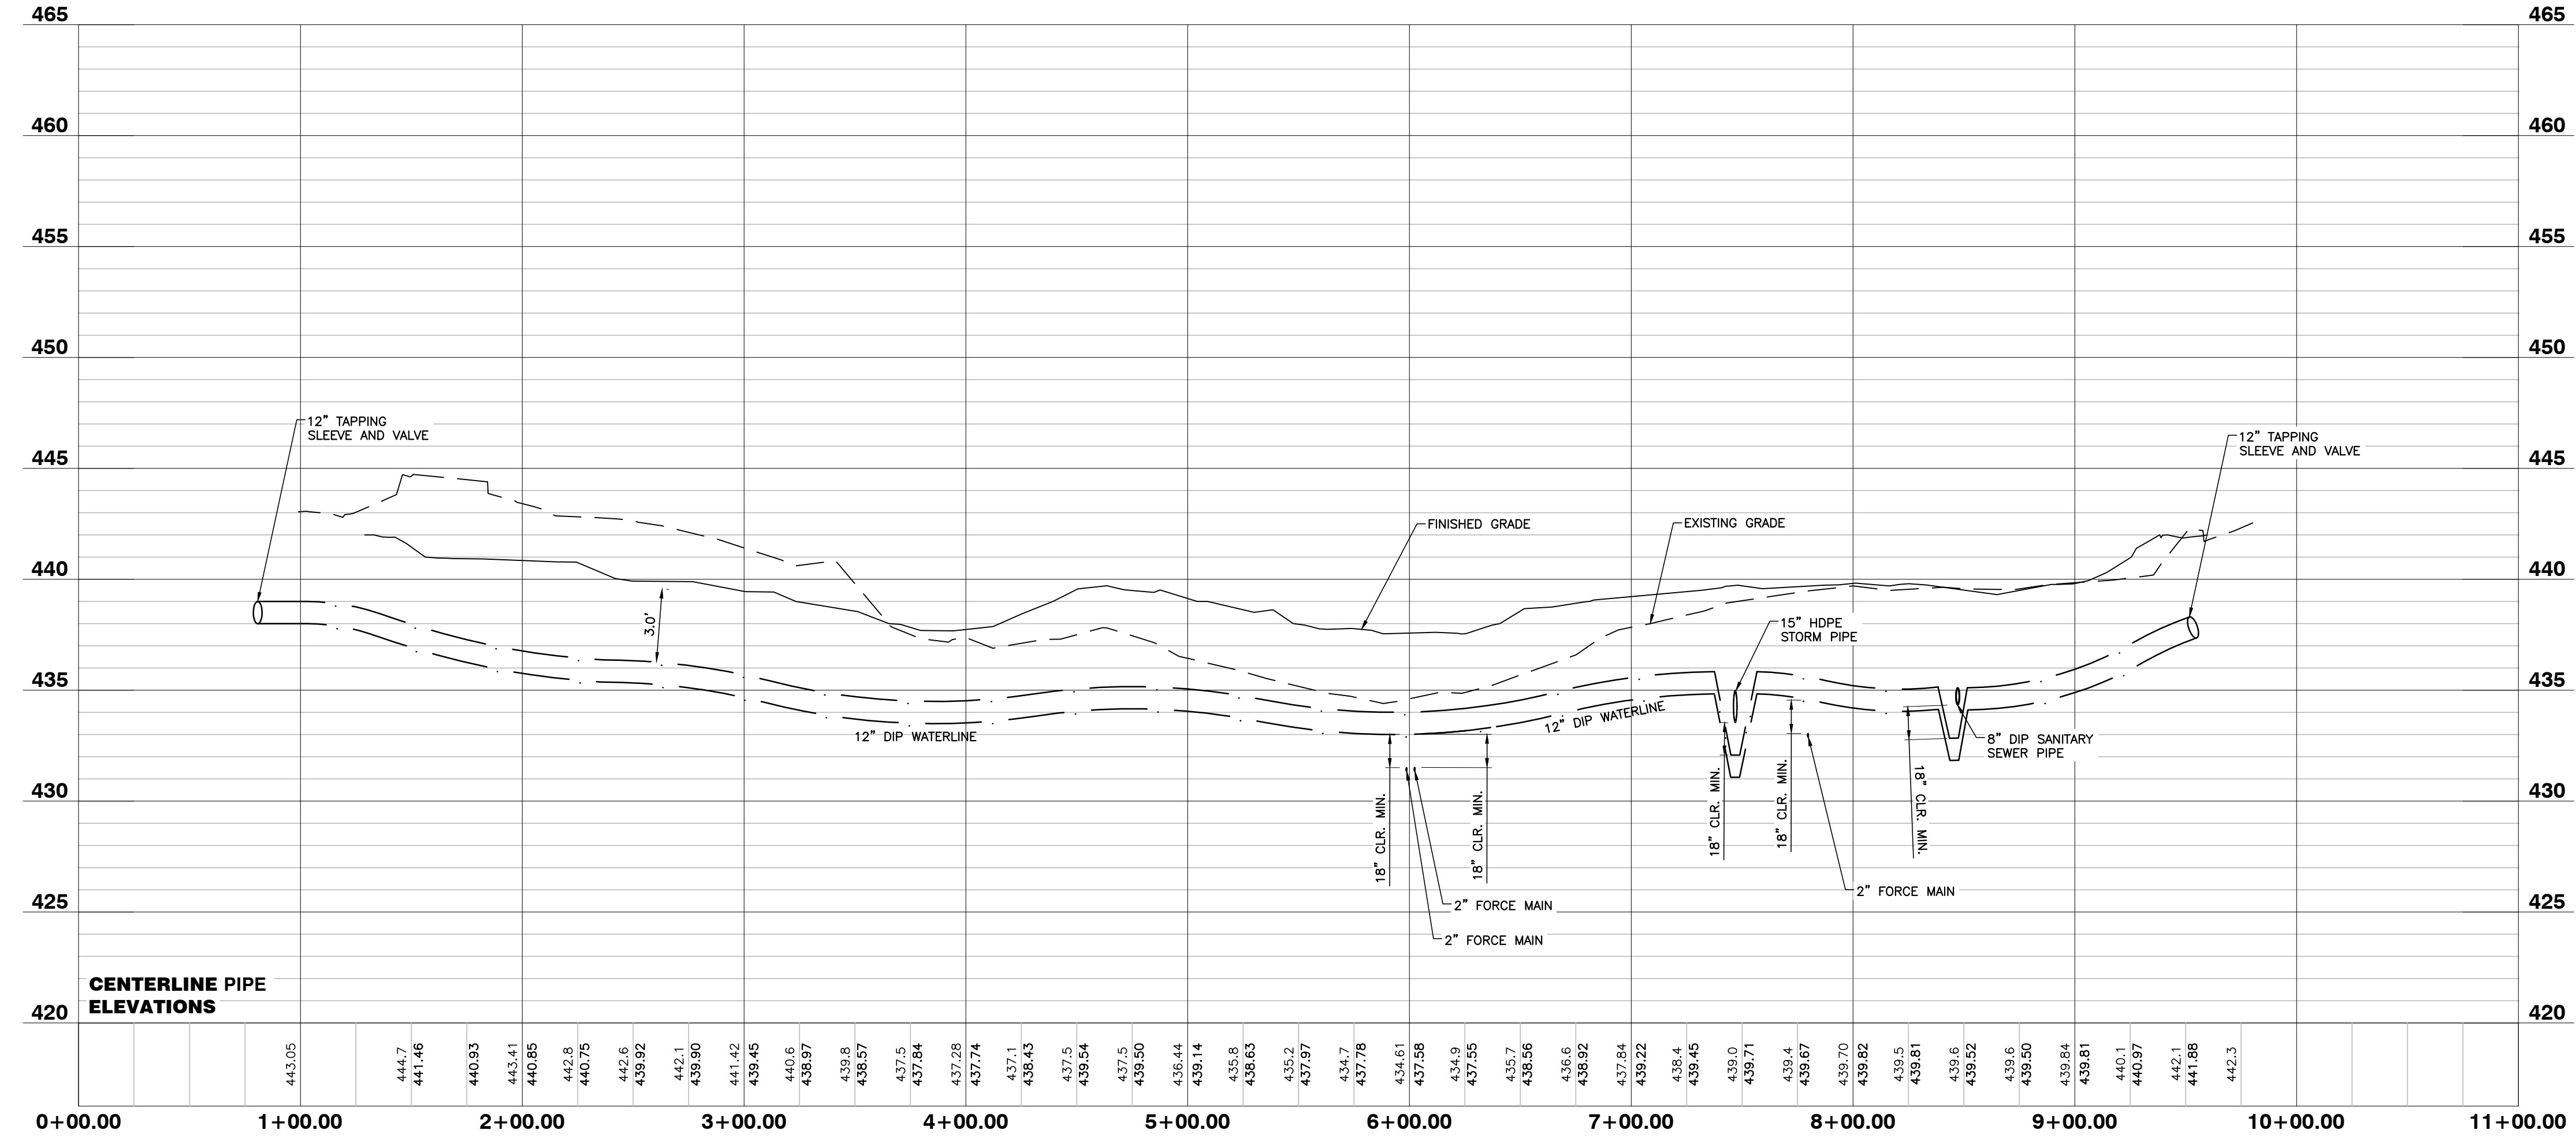

04/20/22

NO FLOODPLAINS EXIST ON-SITE

NOTE: ALL CONSTRUCTION ACTIVITY MUST BE IN ACCORDANCE WITH THE ACCEPTED POLICIES OF THE TOWN OF ROLESVILLE AND NCDOT

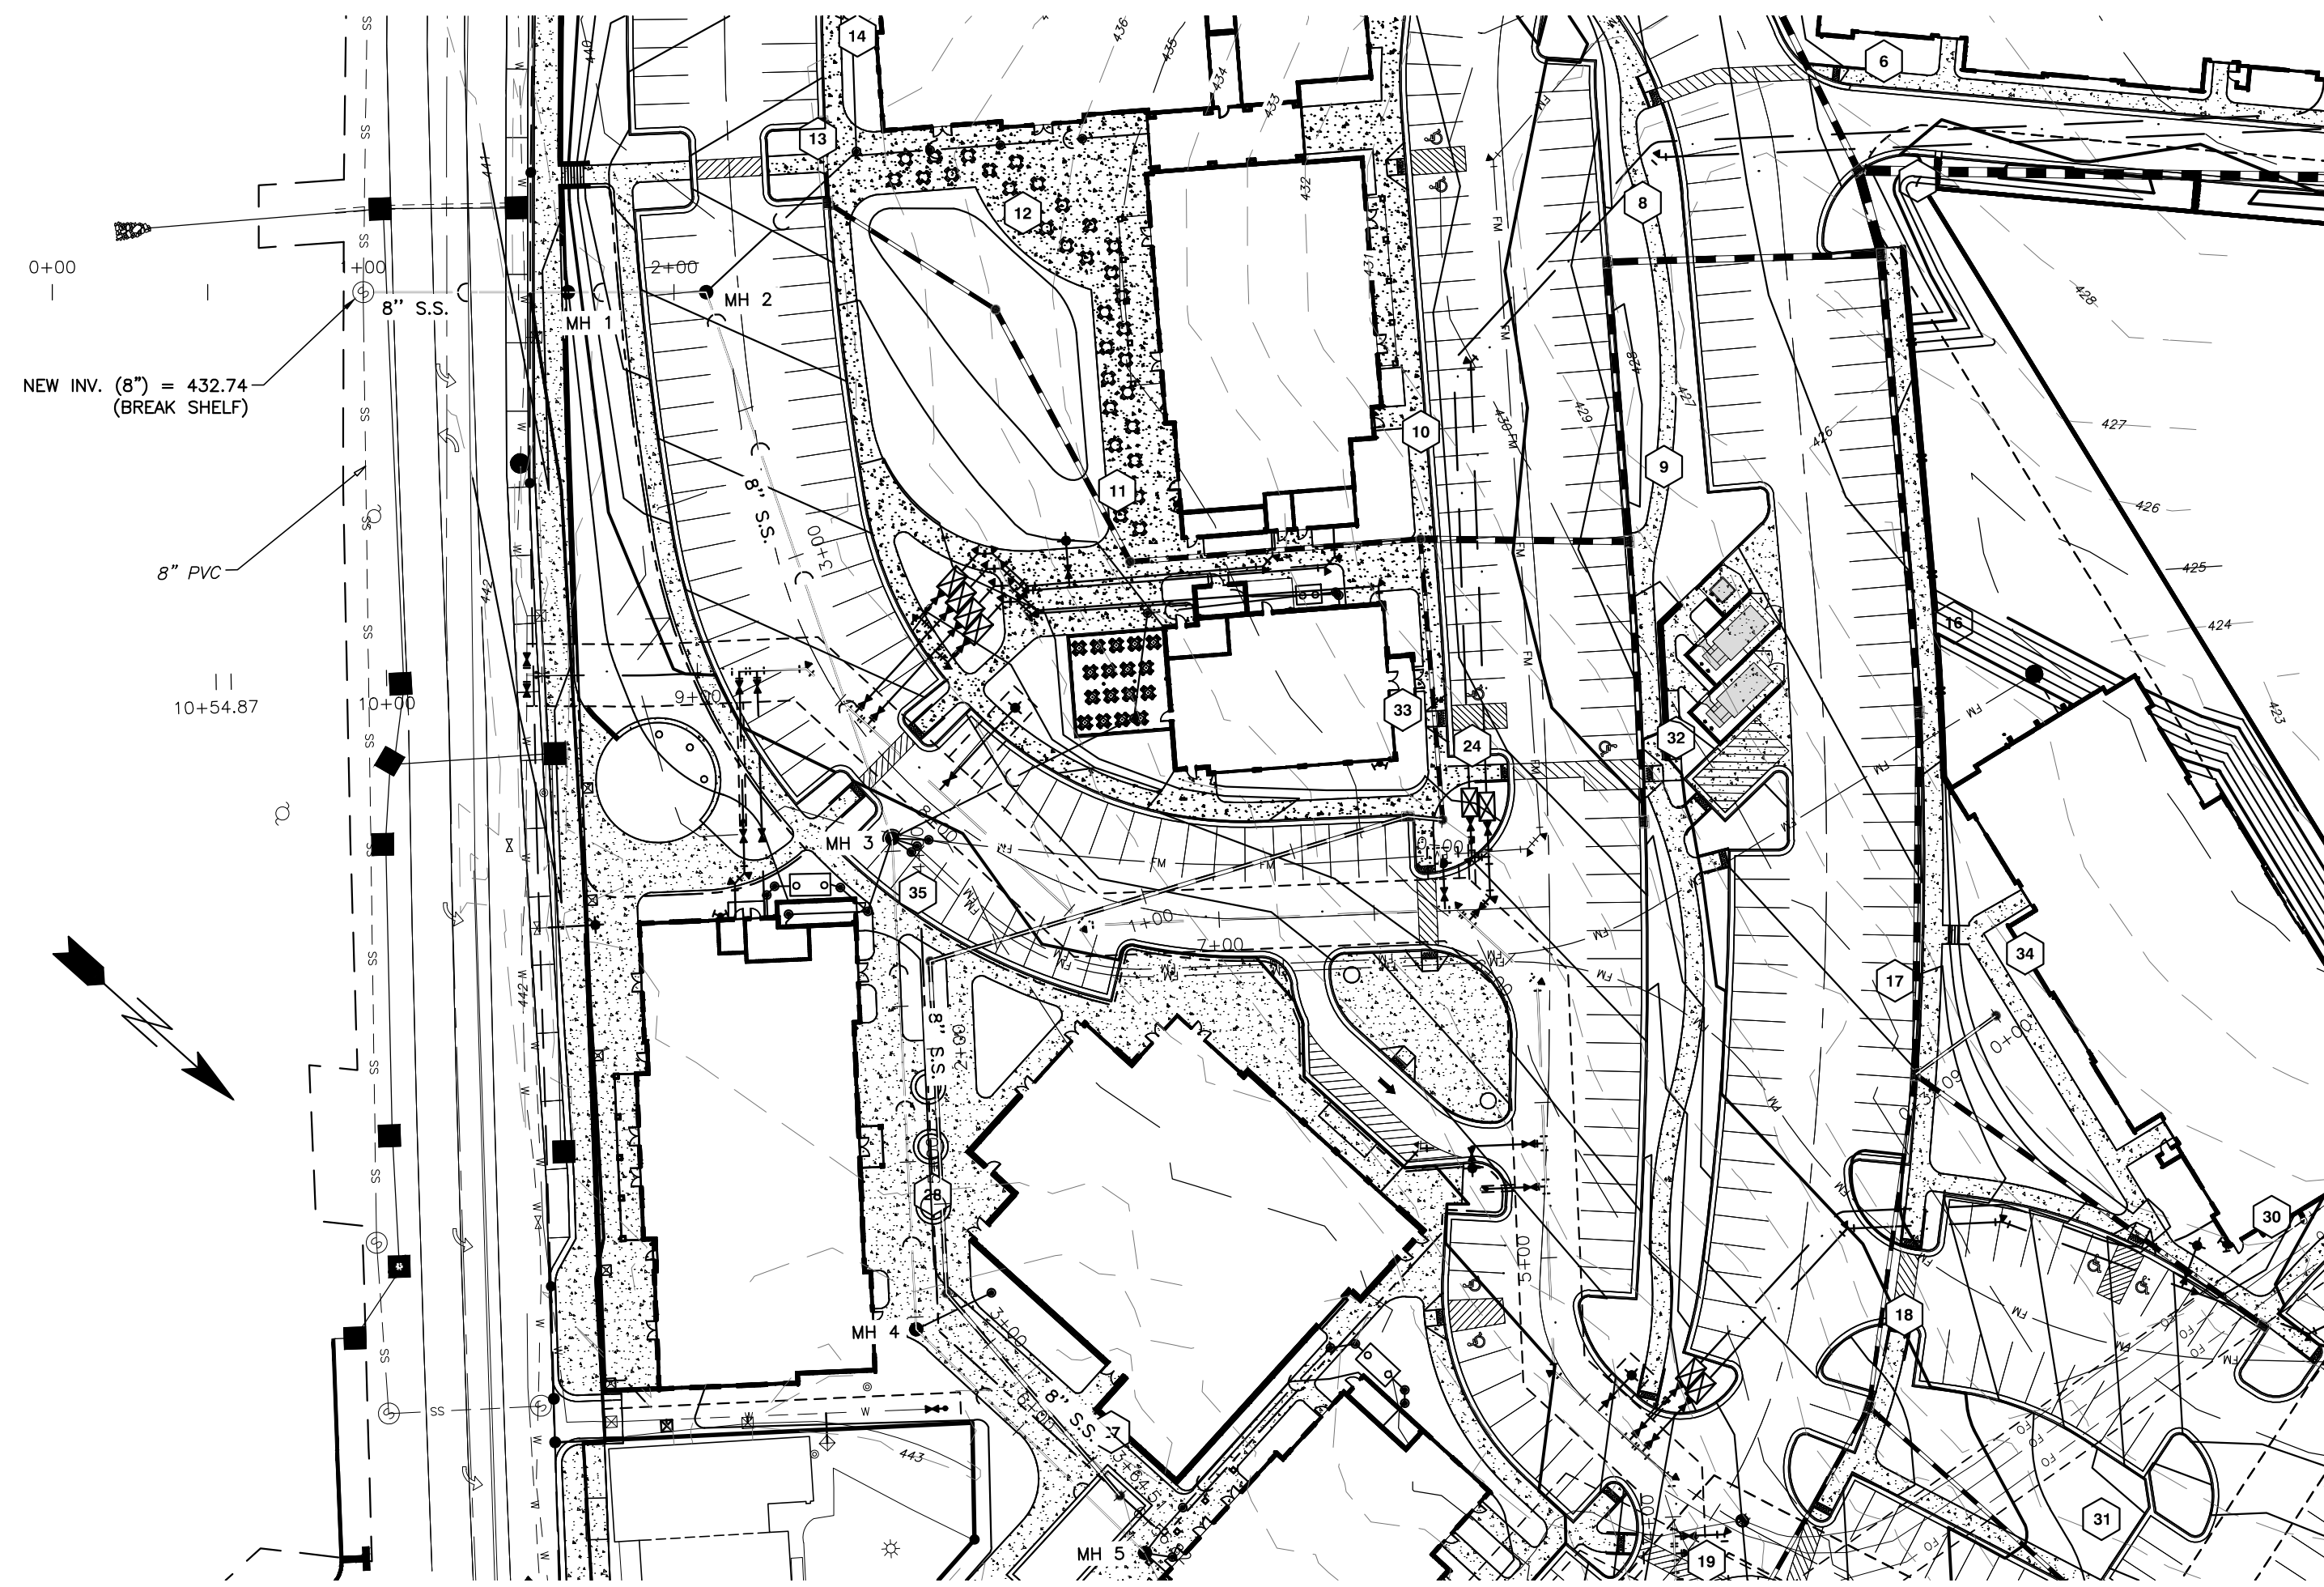

Private Sewer Collection / Extension System
 The City of Raleigh consents to the connection to its public sewer system and extension of the private sewer collection system as shown on this plan. The material and construction methods used for this project shall conform to the standards and specifications of the City's Public Utilities Handbook.
 City of Raleigh
 Public Utilities Department Permit # S-4962 (P)
 Authorization to Construct See digital signature

CITY OF RALEIGH - PLANS AUTHORIZED FOR CONSTRUCTION
 Electronic Approval: This approval is being issued electronically. This approval is valid only upon the signature of a City of Raleigh Review Officer below. The City will retain a copy of the approved plans. Any work authorized by this approval must proceed in accordance with the plans kept on file with the City. This electronic approval may not be edited once issued. Any modification to this approval once issued will invalidate this approval.
 City of Raleigh Development Approval _____
 Raleigh Water Review Officer _____



BASS, NIXON & KENNEDY, INC.
CONSULTING ENGINEERS
 6310 CHAPEL HILL ROAD, SUITE 250, RALEIGH, NC 27607
 TELEPHONE: (919)881-4422 FAX: (919)881-8686
 CERTIFICATION NUMBERS: NCBELS (C-0110); NCBOLA (C-0267)

| NO. | DATE | DESCRIPTION | BY |
|-----|------|-------------|----|
| | | | |
| | | | |
| | | | |


03-19157 PROGRESS MRM
 JOB NO. DATE DRAWN BY
SANITARY SEWER PROFILE
 SCALE: 1" = 50' H; 1" = 5' V CHK BY: MDB

COBBLESTONE VILLAGE
MIXED USE DEVELOPMENT
 TOWN OF ROLESVILLE, WAKE COUNTY, NORTH CAROLINA

SHEET
C4.2

NOT RELEASED FOR CONSTRUCTION OR BID SOLICITATION

SANITARY SEWER PROFILE

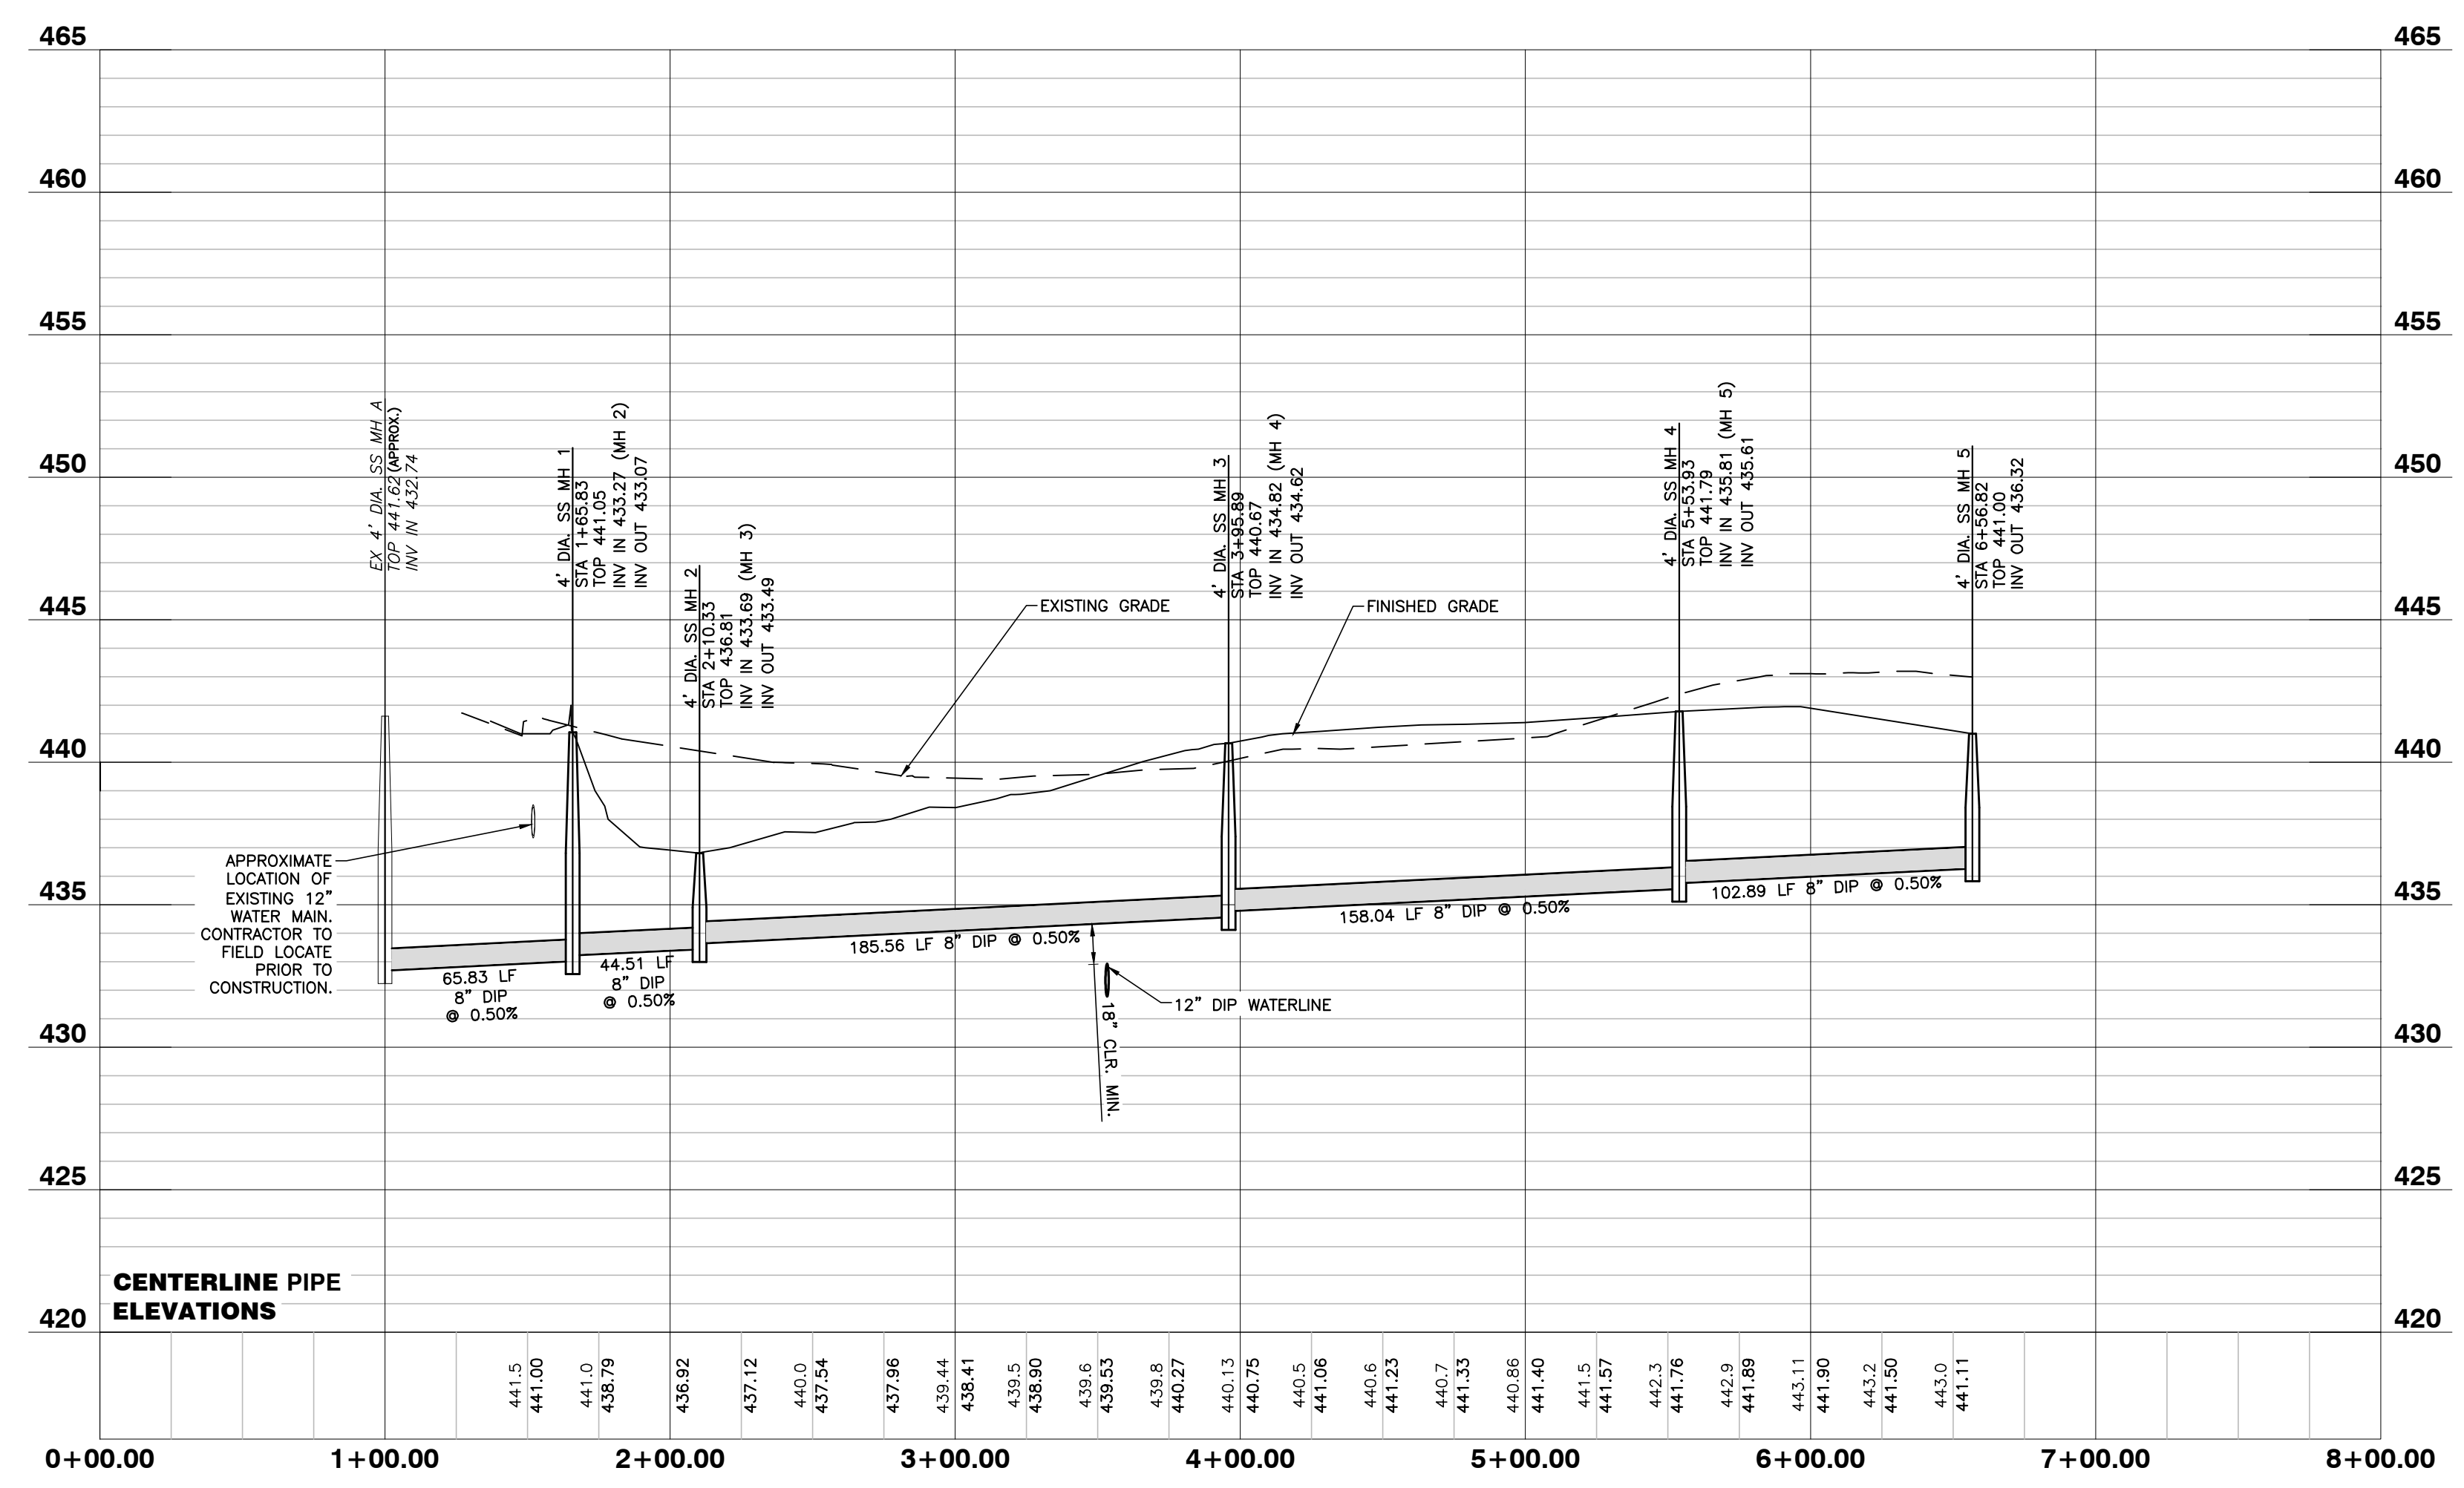


04/20/22

NO FLOODPLAINS EXIST ON-SITE

NOTE: ALL CONSTRUCTION ACTIVITY MUST BE IN ACCORDANCE WITH THE ACCEPTED POLICIES OF THE TOWN OF ROLESVILLE AND NCDOT


GENERAL NOTES

1. A/C UNITS, TRANSFORMERS AND OTHER MECHANICAL OR UTILITY EQUIPMENT, NOT SHOWN ON THE PLAN, SHALL BE SCREENED FROM VIEW EITHER BY ADJUSTING PLANTINGS SHOWN IN CLOSE PROXIMITY TO EQUIPMENT OR BY THE ADDITION OF WAX MYRTLES @ 24" HT., 5" OC (SEE GENERAL NOTES FOR EQUIPMENT ACCESSIBILITY AND PLANTING PROXIMITY, ETC.). DUMPSTER IS SCREENED FROM OFF-SITE VIEWS.
2. CONTRACTOR SHALL VERIFY LOCATION OF ALL UTILITIES PRIOR TO PLANTING.
3. MULCH SHALL BE 3" DEEP MULCH UNLESS OTHERWISE NOTED.
4. VERIFICATION OF TOTAL QUANTITIES AS SHOWN IN THE PLANT LIST AND ON THE PLAN SHALL BE THE RESPONSIBILITY OF THE LANDSCAPE CONTRACTOR. ANY DISCREPANCIES BETWEEN PLANT LIST AND PLANTING PLAN SHALL BE BROUGHT TO THE ATTENTION OF THE LANDSCAPE ARCHITECT FOR CLARIFICATION.
5. ALL TREES, SHRUBS, GROUNDCOVER, ETC. SHALL CONFORM TO ACCEPTED STANDARDS ESTABLISHED BY THE AMERICAN ASSOCIATION OF NURSERMEN.
6. ALL ROOTBALLS REMOVED FROM CONTAINERS SHALL BE SCARIFIED PRIOR TO PLANTING.
7. B&B AS LISTED UNDER "ROOT" IN THE PLANT LIST INDICATES BALLED & BURLAPPED.
8. ALL PLANTS/PLANTINGS SHALL BE MULCHED IMMEDIATELY AFTER PLANTING AND WATERED.
9. ALL PLANTS SHALL BEAR THE SAME RELATIONSHIP TO FINISHED GRADE AS THEY BORE TO PREVIOUS EXISTING GRADE (UNLESS OTHERWISE NOTED).
10. ALL TREES AND SHRUBS SHALL REQUIRE MULCH RINGS AT THEIR BASE IF LEFT WITHIN LAWN AREAS.
11. MULCH EDGES AND PROPOSED PLANTINGS SHALL NOT DISTURB ANY EXISTING GROUPS OF TREES TO REMAIN. EDGES ARE SHOWN FOR APPROXIMATION ONLY, BUT ARE TO INDICATE SMOOTH, CLEAN CURVES.
12. CULVERTS, RIP-RAP STRUCTURES, AND OTHER STORMWATER DEVICES SHALL BE SCREENED WITH EVERGREEN SHRUBS. IF STRUCTURES ARE NOT SHOWN ON THE PLAN, INSTALL WAX MYRTLES @ 24" HT., 5" OC.
13. A 2' BUMPER OVERHANG, FROM THE BACK OF CURB, SHALL BE ALLOTTED FOR MATURE SHRUBS.
14. TREE PROTECTION FENCING SHALL BE MAINTAINED UNTIL ALL SITE WORK IS COMPLETED. THE FENCING SHALL BE REMOVED PRIOR TO THE FINAL SITE INSPECTION FOR THE CERTIFICATE OF OCCUPANCY (C.O.). THE SITE SHALL BE STABILIZED AND SEEDED PRIOR TO THE ISSUANCE OF A (C.O.).
15. UNLESS OTHERWISE NOTED ON THE PLAN, ALL DISTURBED AREAS ARE TO BE SEED WITH WARM SEASON GRASS, INCLUDING PARKING LOT PERIMETERS AND PARKING LOT ISLANDS.
16. PERIMETER BUFFER AREAS ARE TO BE MULCHED TO A DEPTH OF THREE INCHES.

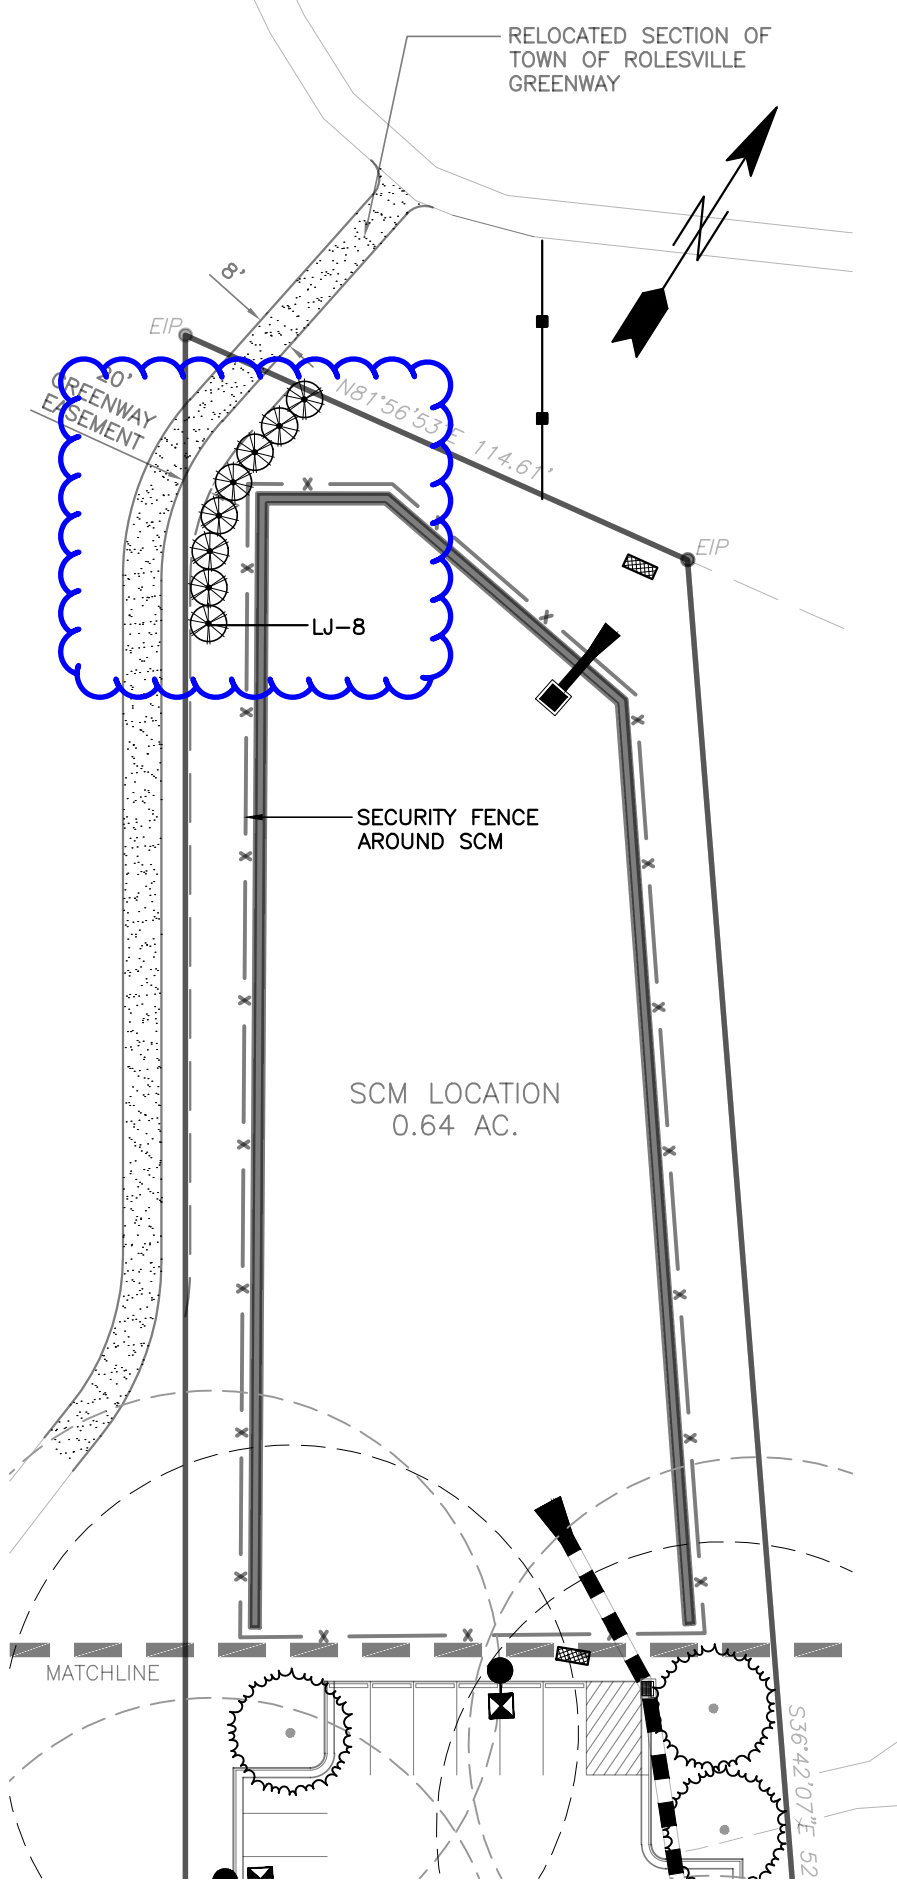

PLANT LIST

| KEY | SCIENTIFIC NAME | COMMON NAME | QUAN. | CAL. | HT. | ROOT | USE |
|---------------------|-------------------------------------|----------------------------|-------|------|-----|-------|---------------|
| CANOPY TREES | | | | | | | |
| AF | Acer freemanii | Freeman Maple | 32 | 2.5" | 8' | B&B | Buffer/VUA |
| AR | Acer rubrum 'Brandywine' | Brandywine Red Maple | 24 | 2.5" | 8' | B&B | VUA |
| JV | Juniperus virginiana | Eastern Red Cedar | 29 | 2.5" | 8' | B&B | Buffer/VUA |
| QN | Quercus nuttallii | Nuttall Oak | 19 | 2.5" | 8' | B&B | Street Tree |
| UP | Ulmus parvifolia 'Allee' | Allee Elm | 7 | 2.5" | 8' | B&B | VUA |
| SHRUBS | | | | | | | |
| CJ | Cleyera japonica | Japanese Cleyera | 98 | | 24" | CONT. | Buffer |
| DG | Distylium 'Green Wave' | Green Wave Distylium | 30 | | 24" | CONT. | VUA |
| IC | Ilex crenata 'Sky Pencil' | Sky Pencil Holly | 6 | | 36" | CONT. | Dumpster |
| ICG | Ilex crenata 'Chesapeake' | Chesapeake Holly | 10 | | 24" | CONT. | VUA Screen |
| ICG | Ilex crenata 'Green Lustre' | Green Lustre Japanese Holl | 119 | | 24" | CONT. | Buffer |
| JC | Juniperus chinensis 'Sawbrook Gold' | Sawbrook Gold Juniper | 44 | | 24" | CONT. | VUA Screen |
| LJ | Loropetalum chinense 'Daruma' | Daruma Loropetalum | 36 | | 24" | CONT. | VUA Screen |
| LJ | Ligustrum japonicum | Wax Ligustrum | 98 | | 24" | CONT. | Buffer |
| OF | Osmanthus fragrans | Fragrant Tea Olive | 51 | | 24" | CONT. | Buffer/Screen |
| VML | Viburnum x 'Moonlit Lace' | Moonlit Lace Viburnum | 158 | | 24" | CONT. | Buffer |

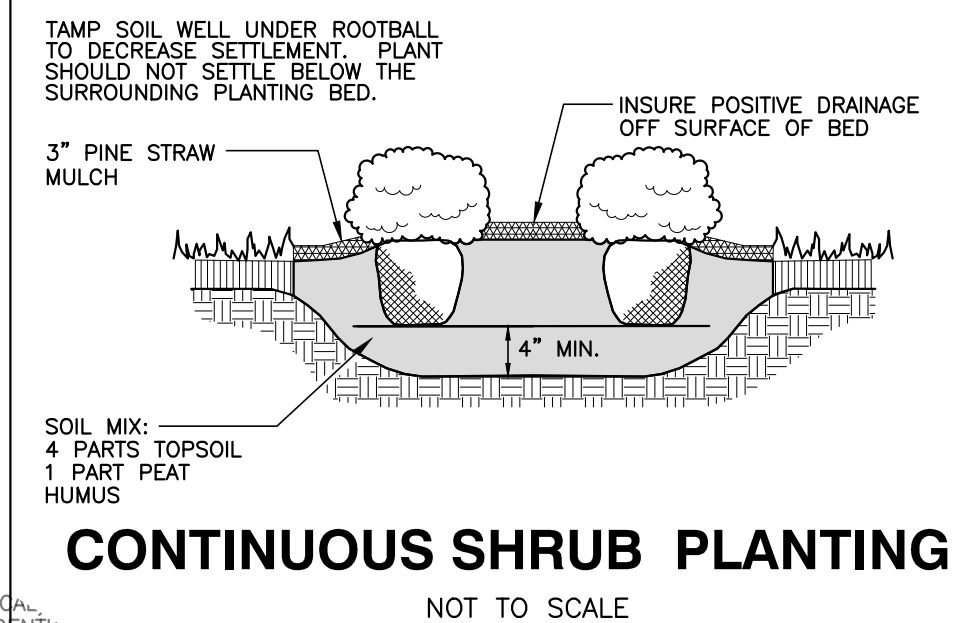

CONTINUOUS SHRUB PLANTING
NOT TO SCALE

LANDSCAPE CALCULATIONS

PERIMETER BUFFERS (10' TYPICAL):
 WEST (1) - 352 LF = 4 TREES / 100 LF = 14 TREES REQUIRED/PROVIDED
 = 40 SHRUBS / 100 LF = 141 SHRUBS REQUIRED/PROVIDED
 = 352 LF MIN. 6' TALL FENCE REQUIRED

**NORTH (2) - 187 LF = 4 TREES / 100 LF = 8 TREES REQUIRED/PROVIDED
 = 40 SHRUBS / 100 LF = 75 SHRUBS REQUIRED/PROVIDED
 = 187 LF MIN. 6' TALL FENCE REQUIRED**



**NORTHEAST (3) - 240 LF = 4 TREES / 100 LF = 10 TREES REQUIRED/PROVIDED
 = 40 SHRUBS / 100 LF = 96 SHRUBS REQUIRED/PROVIDED
 = 240 LF MIN. 6' TALL FENCE REQUIRED**

**EAST (4) - 247 LF = 4 TREES / 100 LF = 10 TREES REQUIRED/PROVIDED
 = 40 SHRUBS / 100 LF = 100 SHRUBS REQUIRED/PROVIDED
 = 247 LF MIN. 6' TALL FENCE REQUIRED**

STREET YARDS:
 MAIN ST - 595 LF = 1 TREE / 50 LF = 12 TREES REQUIRED/PROVIDED
 WEST YOUNG ST - 242 LF = 1 TREE / 50 LF = 5 TREES REQUIRED/PROVIDED

VEHICULAR USE AREA COVERAGE: 1 TREE WITHIN 60' OF EACH PARKING SPACE


PLANT SYMBOLS

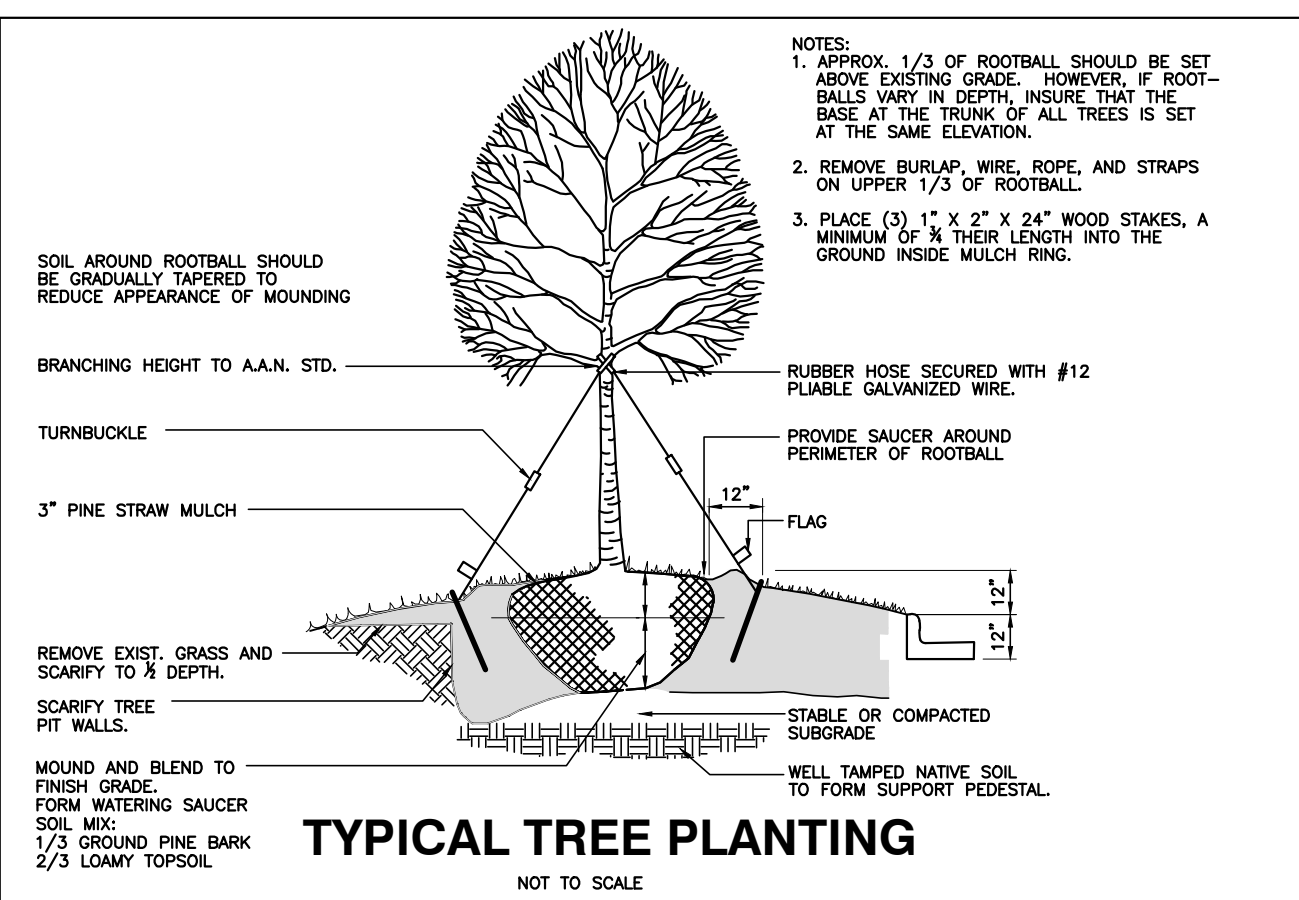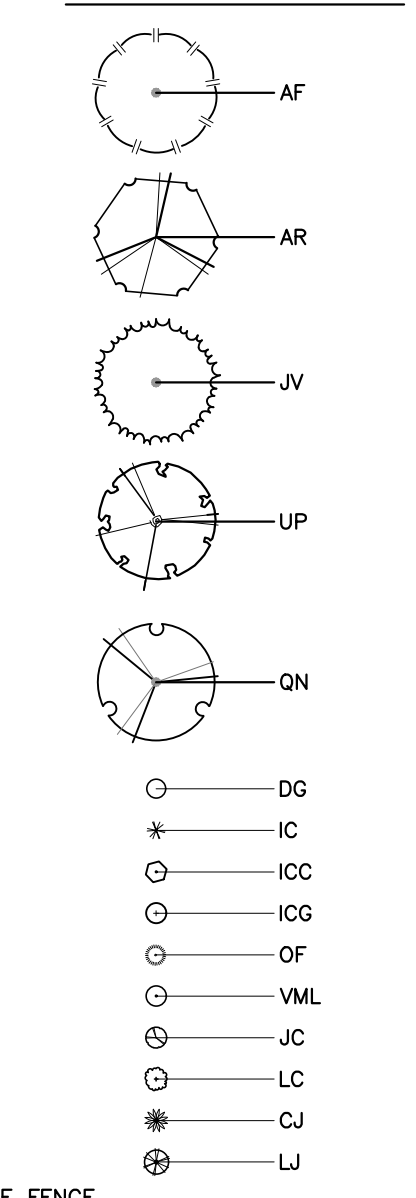

TYPICAL TREE PLANTING
NOT TO SCALE

PLANTING NOTES:
 LOCATE PLANTS AND PLANTING BEDS BY USING SCALED DIMENSIONS FROM STREET, PROPERTY LINES, BACK OF CURB, BUILDINGS, WALLS, ETC. ALL PLANTS SHALL MEET OR EXCEED THE MINIMUM STANDARDS SET BY THE U.S.D.A. FOR NURSERY STOCK. SPONSORED BY THE AMERICAN ASSOCIATION OF NURSERMEN, INC., WASHINGTON, D.C. NO SUBSTITUTIONS SHALL BE PERMITTED WITHOUT WRITTEN APPROVAL FROM THE OWNER AND/OR THE LANDSCAPE ARCHITECT. SYMBOLS: B&B = BALLED & BURLAPPED; B.R. = BARE ROOT; CONT. = CONTAINER, O.C. = ON-CENTER

STREET TREE PLANTINGS TO BE COORDINATED IN CONCURRENCE WITH NCDOT STREETSCAPE IMPROVEMENT PROJECT ALONG S. MAIN AND YOUNG STREET(S).

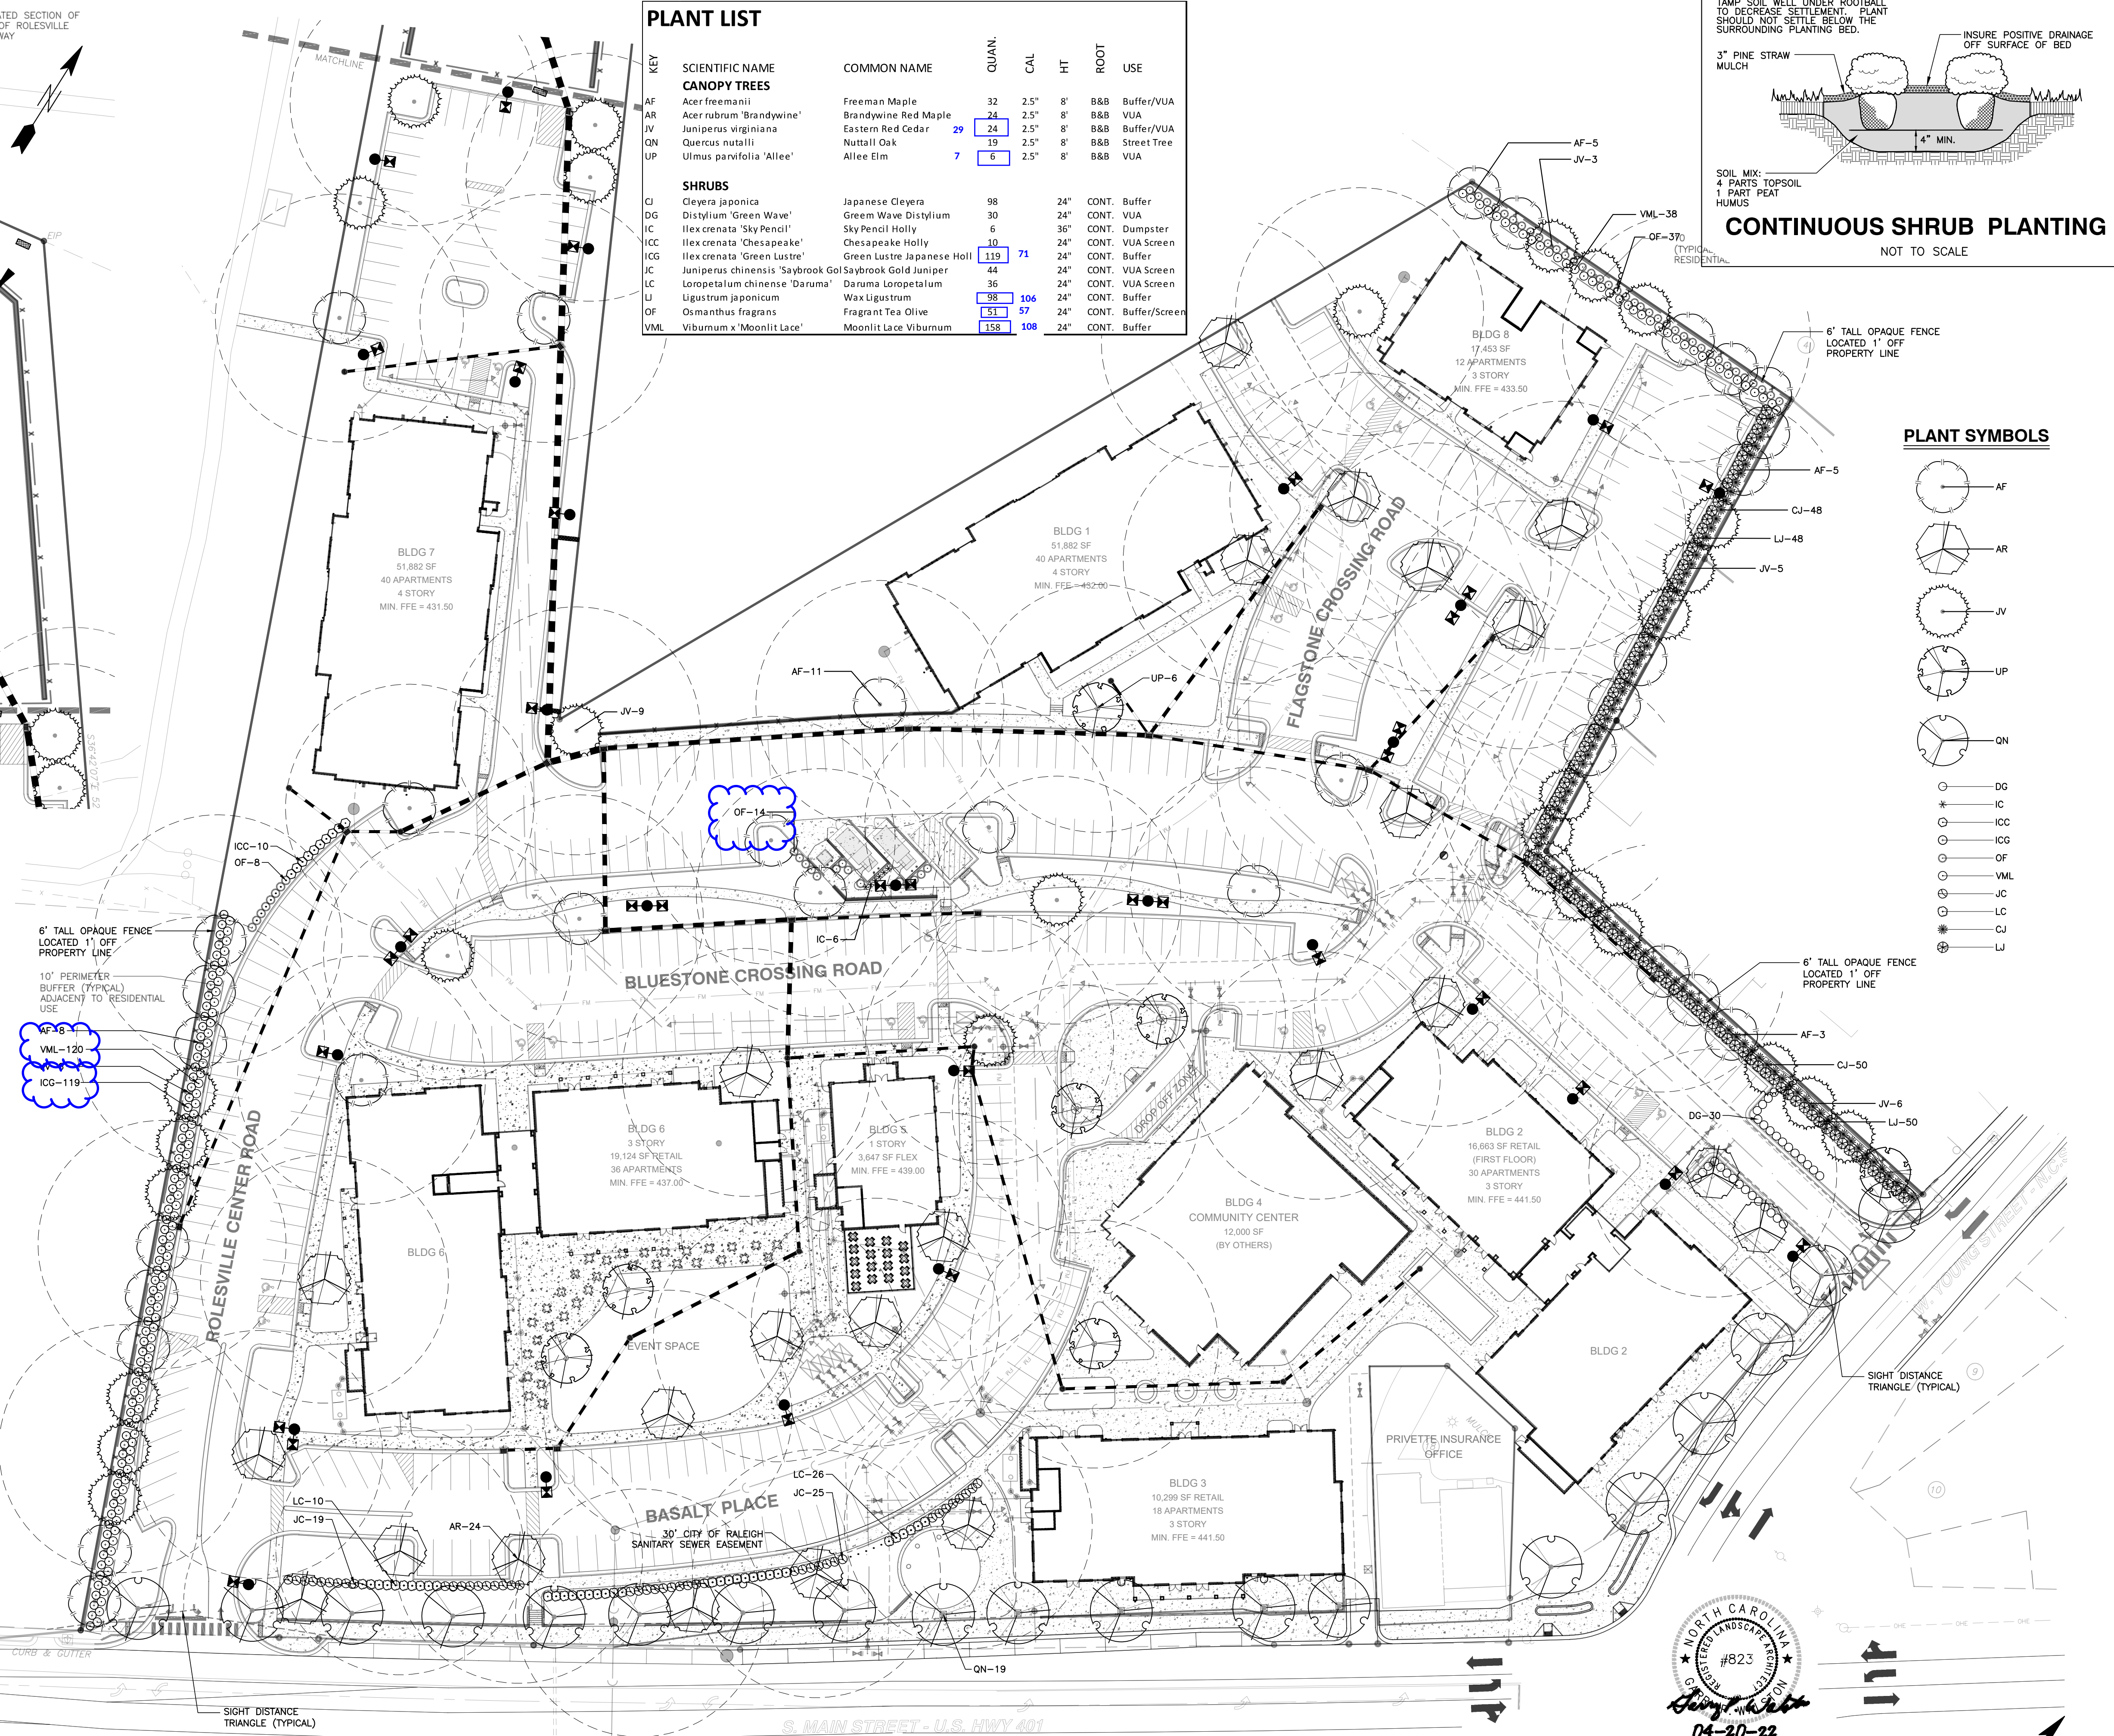


CITY OF RALEIGH - PLANS AUTHORIZED FOR CONSTRUCTION

Electronic Approval: This approval is being issued electronically. This approval is valid only upon the signature of a City of Raleigh Water Review Officer below. The City will retain a copy of the approved plans. Any work authorized by this approval must proceed in accordance with the plans kept on file with the City. This electronic approval may not be edited once issued. Any modification to this approval once issued will invalidate this approval.

City of Raleigh Development Approval _____
 Raleigh Water Review Officer

NO FLOODPLAINS EXIST ON-SITE

NOTE: ALL CONSTRUCTION ACTIVITY MUST BE IN ACCORDANCE WITH THE ACCEPTED POLICIES OF THE TOWN OF ROLESVILLE AND NCDOT

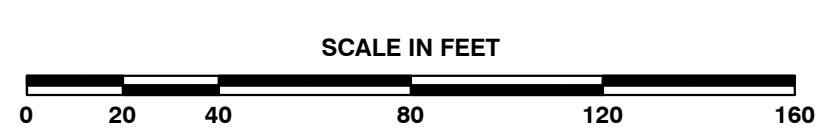

BASS, NIXON & KENNEDY, INC.
CONSULTING ENGINEERS
 6310 CHARLETTOWN ROAD, SUITE 250, RALEIGH, NC 27607
 TELEPHONE: (919)881-1122 FAX: (919)881-8686
 CERTIFICATION NUMBERS: NCBELS (C-010); NCBOLA (C-0267)

| NO. | DATE | DESCRIPTION | BY | REVISIONS |
|-----|----------|------------------|-----|-----------|
| 2 | 04-20-22 | PER TOR COMMENTS | GW | |
| 1 | 5-28-21 | PER TOR COMMENTS | LAK | |

LANDSCAPE PLAN
 SCALE: 1" = 40'

COBBLESTONE VILLAGE
MIXED USE DEVELOPMENT
 TOWN OF ROLESVILLE, WAKE COUNTY, NORTH CAROLINA

SHEET L1.1

TOWN OF ROLESVILLE PROJECT NO.

NOT RELEASED FOR CONSTRUCTION OR BID SOLICITATION

Outdoor Lighting
Shoobox LED



The energy-efficient Shoobox LED combines a decorative, contemporary style with versatility and ample lighting effect that is perfect for streets, parking lots, commercial buildings and residential communities. The Shoobox LED provides excellent color rendition along with a controlled light pattern that reduces glare and keeps the light directed only where you want it. Available in black, dark bronze, gray or white with one to four fixtures per pole.

- LED (Light Emitting Diode)
 - 150, 220, 420, 530 watts
 - Mounting heights
 - 25', 30', 35'
 - Colors
 - Black
 - Bronze
 - Gray
 - White
 - Poles
 - Fiberglass (1 or 2 fixtures per pole)
 - Decorative tapered metal
 - Decorative square metal
- Note: 35' pole available in black or bronze only.

For additional information, visit us at duke-energy.com/OutdoorLighting or call us toll free at 866.769.6417.




Outdoor Lighting
Shoobox LED

Light source: LED (white)
Replacement for* LED Wattage 150 – 250-watt HPS and metal halide;
LED Wattage 205 – up to 400-watt metal halide;
LED Wattage 530 – 1,000-watt metal halide

Warm-up and restrike time: Instant on (no warm-up or restrike time)

| Wattage | BUG Rating | Light Pattern | Lumens | Color Temp |
|----------------|-----------------|--------------------------------------|--------------|------------|
| LED 150 | B5-U0-G3 | IESNA Type V (circular) | 19580 | 4,000K |
| LED 150 | B3-U0-G4 | IESNA Type IV (forward throw) | 18459 | |
| LED 150 | B2-U0-G3 | IESNA Type III (oval) | 19006 | |
| LED 220 | B5-U0-G3 | IESNA Type V (circular) | 25870 | |
| LED 220 | B3-U0-G4 | IESNA Type IV (forward throw) | 24390 | |
| LED 220 | B2-U0-G4 | IESNA Type III (oval) | 25114 | |
| LED 420 | B5-U0-G5 | IESNA Type V (circular) | 48514 | |
| LED 420 | B3-U0-G5 | IESNA Type IV (forward throw) | 43765 | |
| LED 530 | B5-U0-G5 | IESNA Type V (circular) | 60296 | |
| LED 530 | B3-U0-G5 | IESNA Type IV (forward throw) | 54395 | |



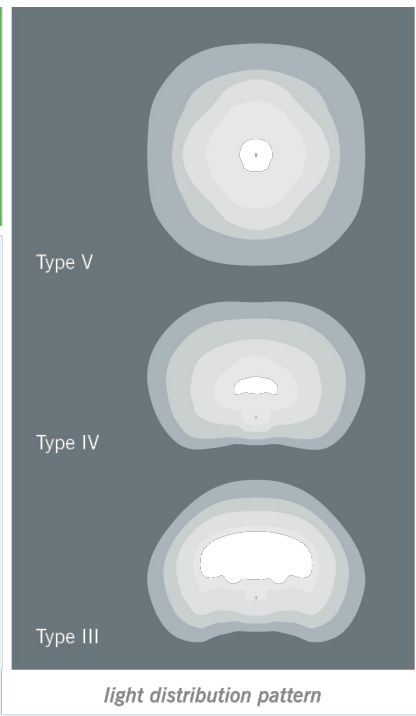


Poles available:

| Name | Mounting height | Color |
|---------------------------------|-----------------|---|
| Round tapered decorative metal* | 35' | Black Bronze |
| Decorative square metal* | 25' and 30' | Black Bronze White |
| Fiberglass | 30' | Black (1 or 2 fixtures per pole) Gray (1 or 2 fixtures per pole) |

| Features | Benefits |
|--|--|
| Little or no installation cost | Frees up capital for other projects |
| Design services by lighting professionals included | Meets industry standards and lighting ordinances |
| Maintenance included | Eliminates high and unexpected repair bills |
| Electricity included | Less expensive than metered service |
| Warranty included | Worry-free |
| One low monthly cost on your electric bill | Convenience and savings for you |
| Turnkey operation | Provides hassle-free installation and service |
| Backed by over 40 years of experience | A name you can trust today ... and tomorrow |

*2" raised foundation available when required on metal poles only.

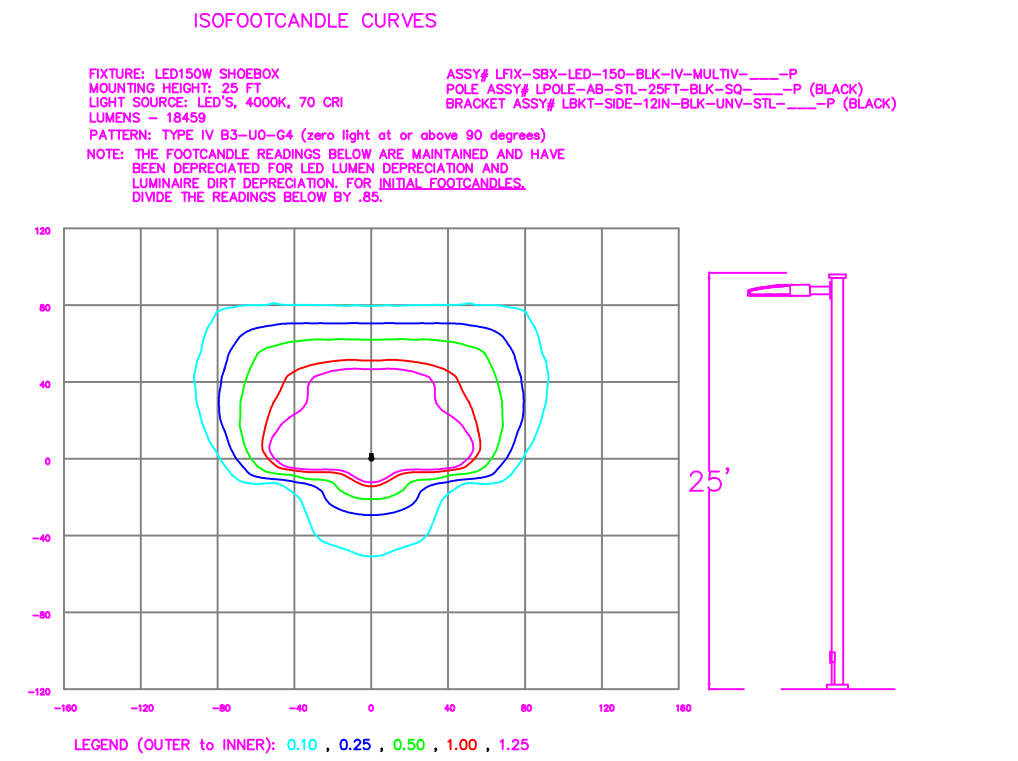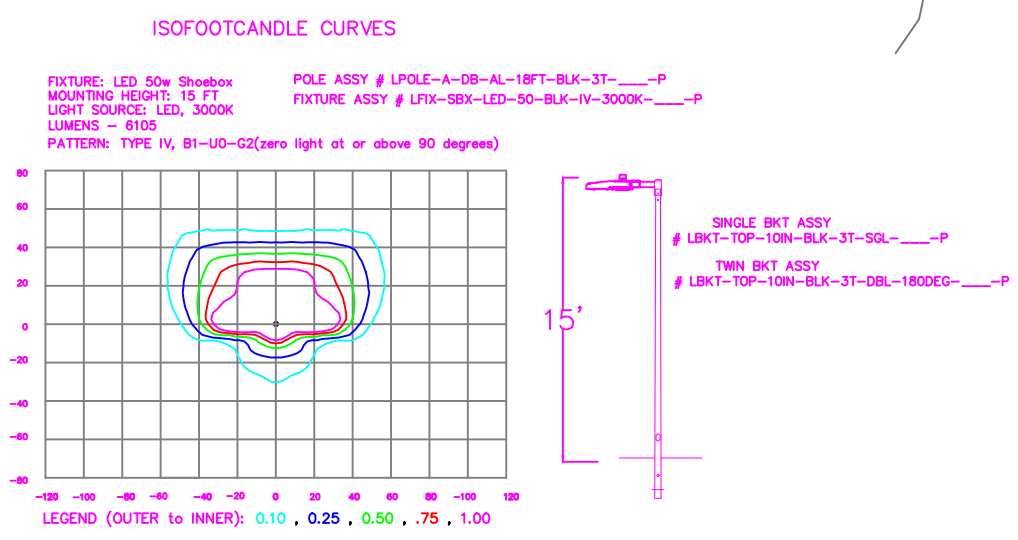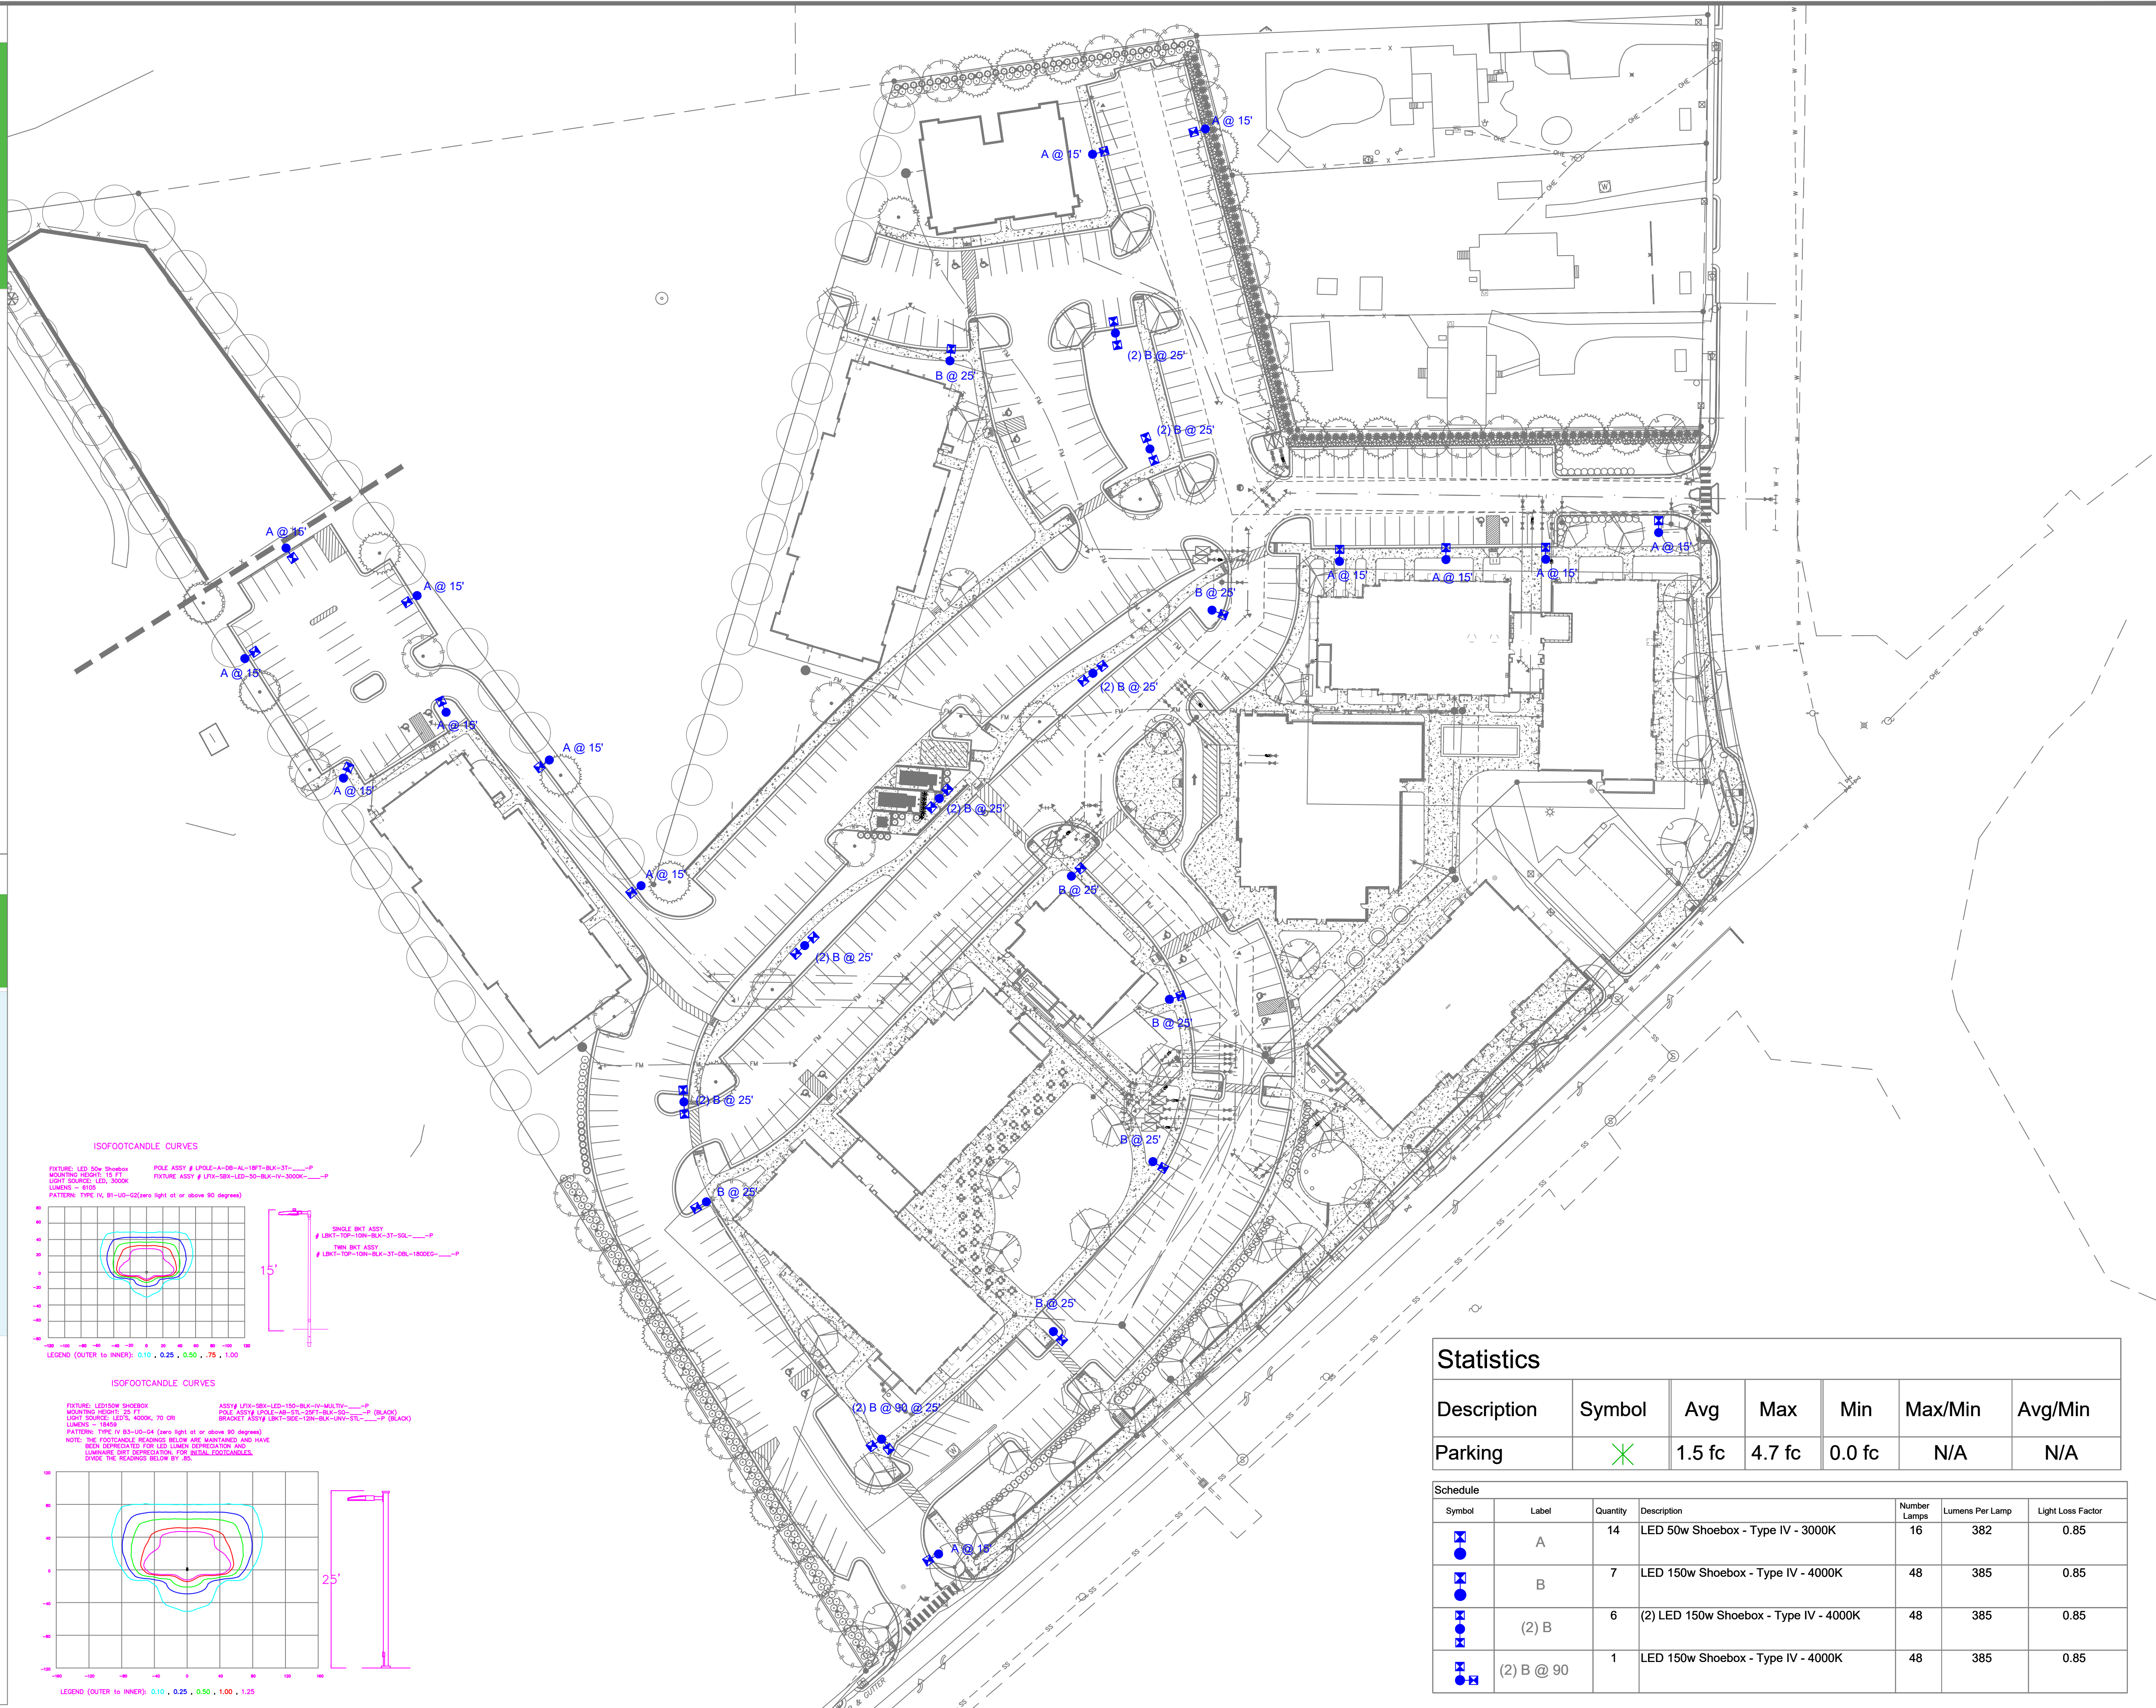

Statistics


| Description | Symbol | Avg | Max | Min | Max/Min | Avg/Min |
|-------------|--------|--------|--------|--------|---------|---------|
| Parking | X | 1.5 fc | 4.7 fc | 0.0 fc | N/A | N/A |

| Symbol | Label | Quantity | Description | Number Lamps | Lumens Per Lamp | Light Loss Factor |
|------------|------------|----------|--|--------------|-----------------|-------------------|
| A | A | 14 | LED 50w Shoobox - Type IV - 3000K | 16 | 382 | 0.85 |
| B | B | 7 | LED 150w Shoobox - Type IV - 4000K | 48 | 385 | 0.85 |
| (2) B | (2) B | 6 | (2) LED 150w Shoobox - Type IV - 4000K | 48 | 385 | 0.85 |
| (2) B @ 90 | (2) B @ 90 | 1 | LED 150w Shoobox - Type IV - 4000K | 48 | 385 | 0.85 |

Customer approval _____
Date _____

DISTANCE CALIBRATION (INCHES)
0 0.5 1.0 2.0 3.0 4.0





LIGHTING DESIGN TOLERANCE
The calculated footcandle light levels on this lighting design are predicted values and are based on specific information that has been supplied to Duke Energy. Any inaccuracies in the supplied information, differences in luminaire installation, lighted area geometry including elevation differences, reflective properties of surrounding surfaces, obstructions (foliage or otherwise) in the lighted area, or lighting from sources other than listed in this design may produce different results from the predicted values. Normal tolerances of voltage, lamp output, and ballast and luminaire manufacture will also affect results.

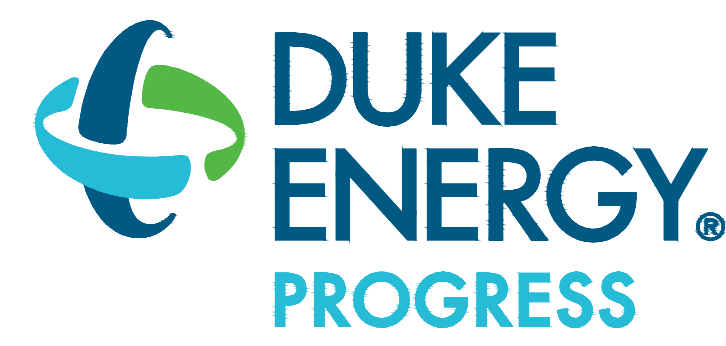

PROPRIETARY & CONFIDENTIAL
This document together with the concepts and designs presented herein, presented as an instrument of service, is the sole property of Duke Energy, and is intended only for the specific purpose and prospective client as stated in the title block of this drawing. Any use, copying, reproduction or disclosure of the drawing, design or any information contained herein by the prospective customer or other entities, including without limitation, architects, engineers, or equipment manufacturers is hereby expressly prohibited and shall not be permitted absent prior written consent from, and payment of compensation to Duke Energy. Duke Energy disclaims any liability or responsibility for any unauthorized use of or reliance on this document.

COBBLESTONE VILLAGE
Rosesville, NC
SITE LIGHTING PLAN
Designed by DEP LIGHTING SOLUTIONS
Reviewed by T. Ferguson Scale 1" = 50'
Date 02/14/2022 Size Arch D
Description LED Shoobox
Drawing No. 22-0047A Sht. 1 OF 1






| REV# | DATE | REVISION | BY |
|-------|----------|-------------|----|
| Rev A | 02/14/22 | LED Shoobox | NJ |

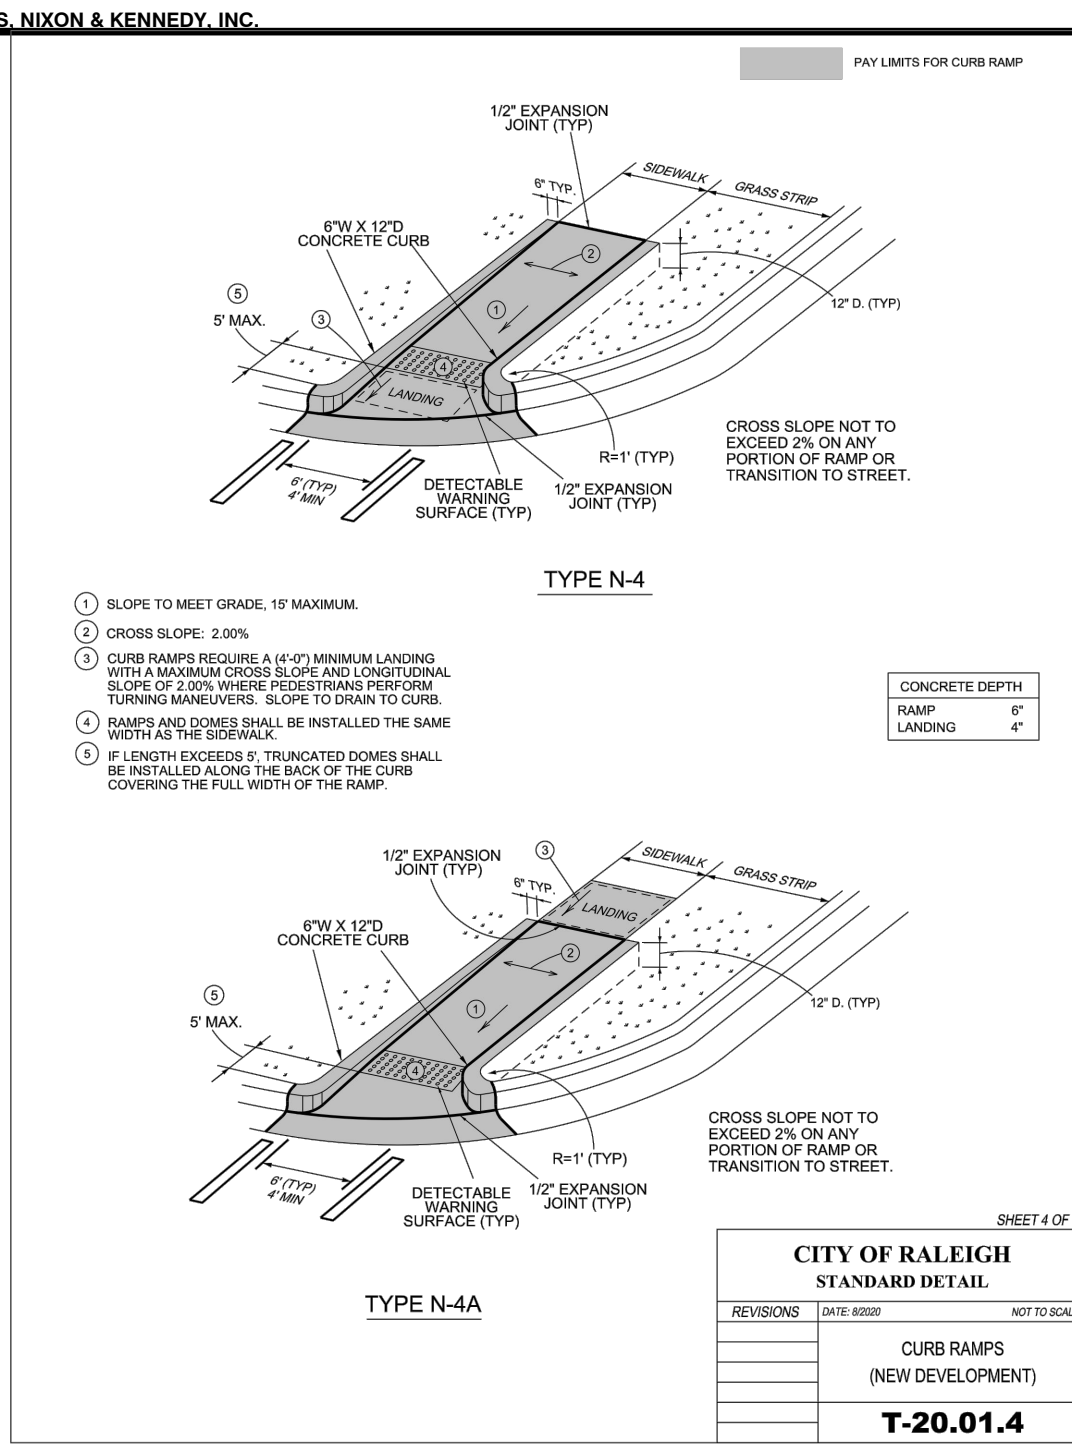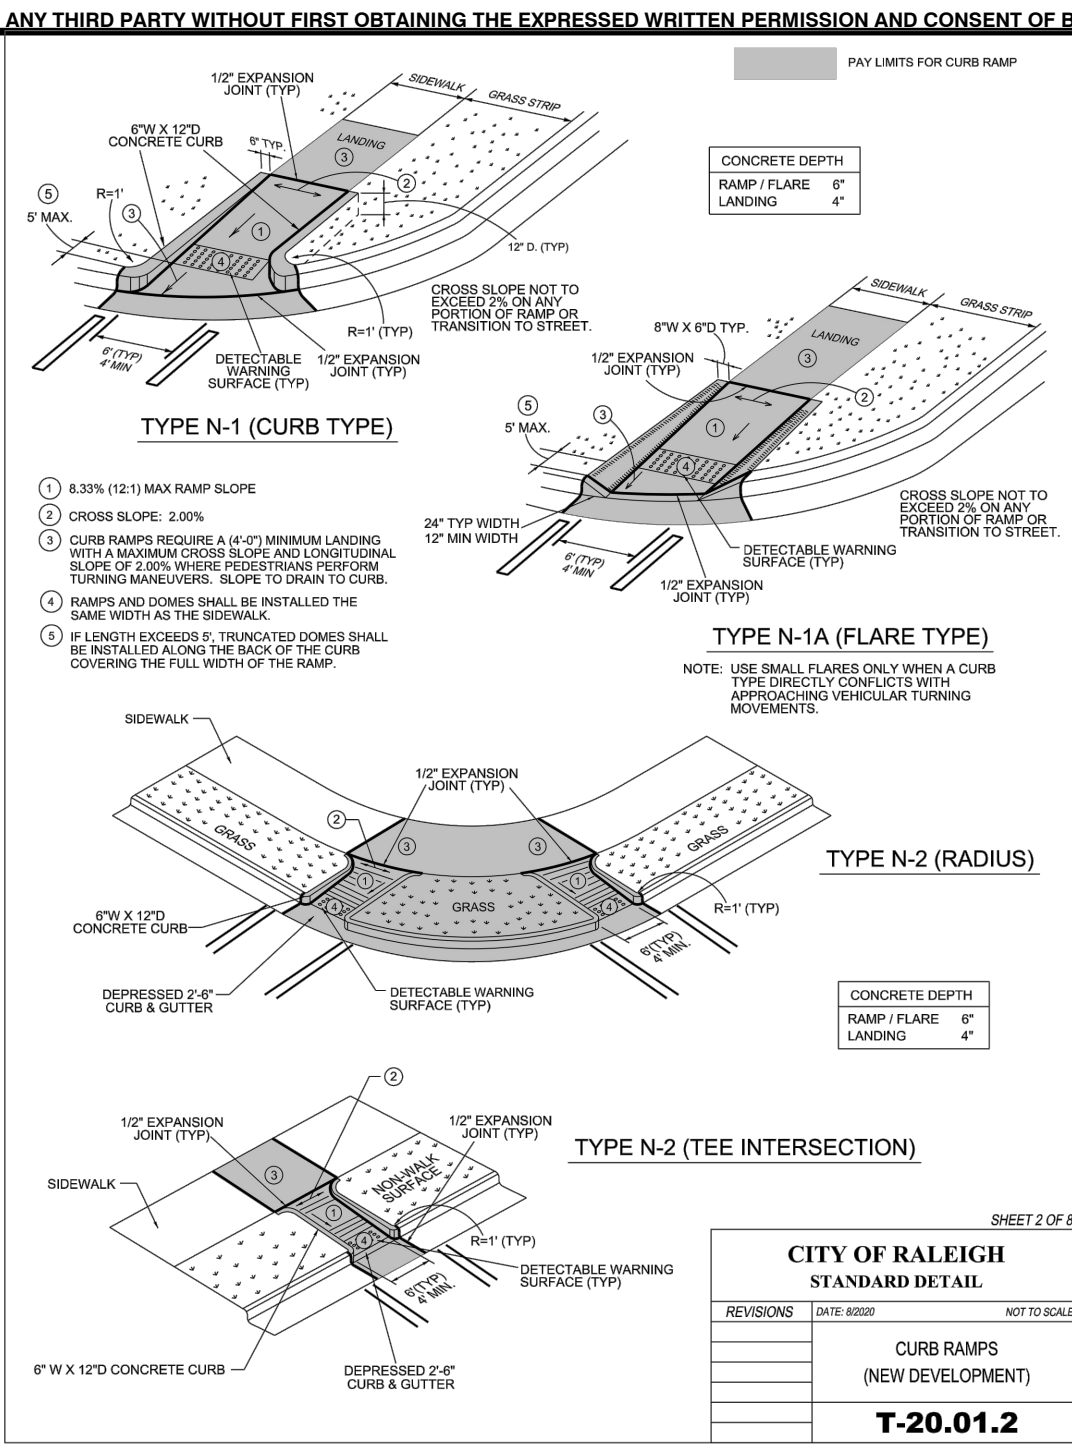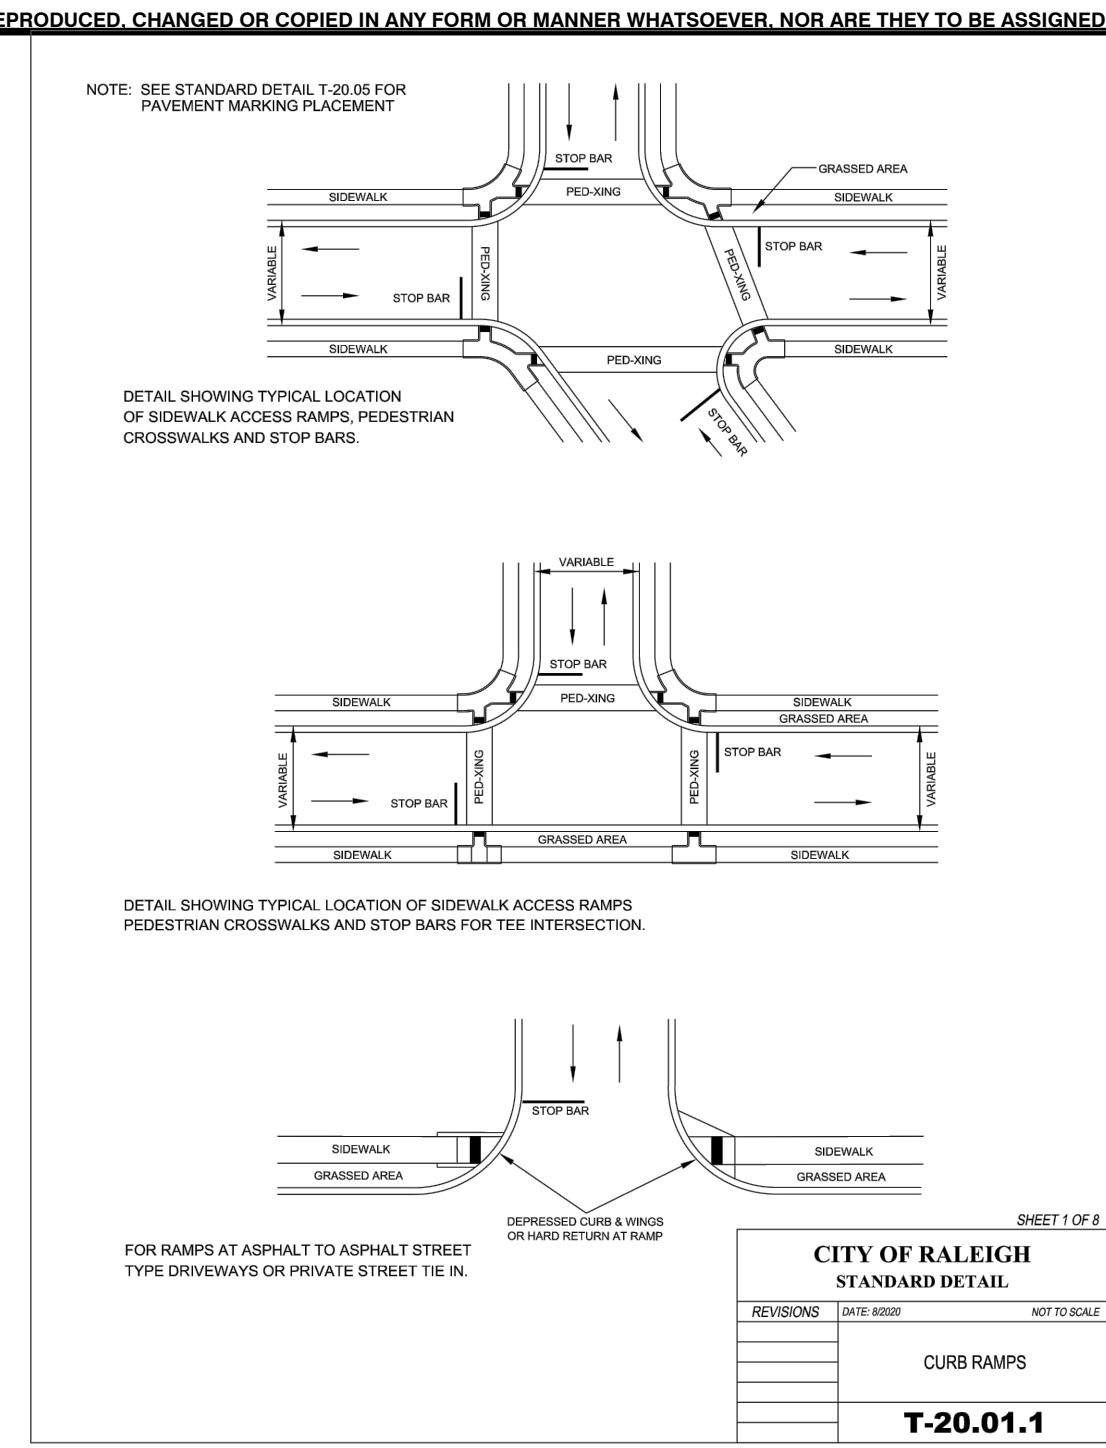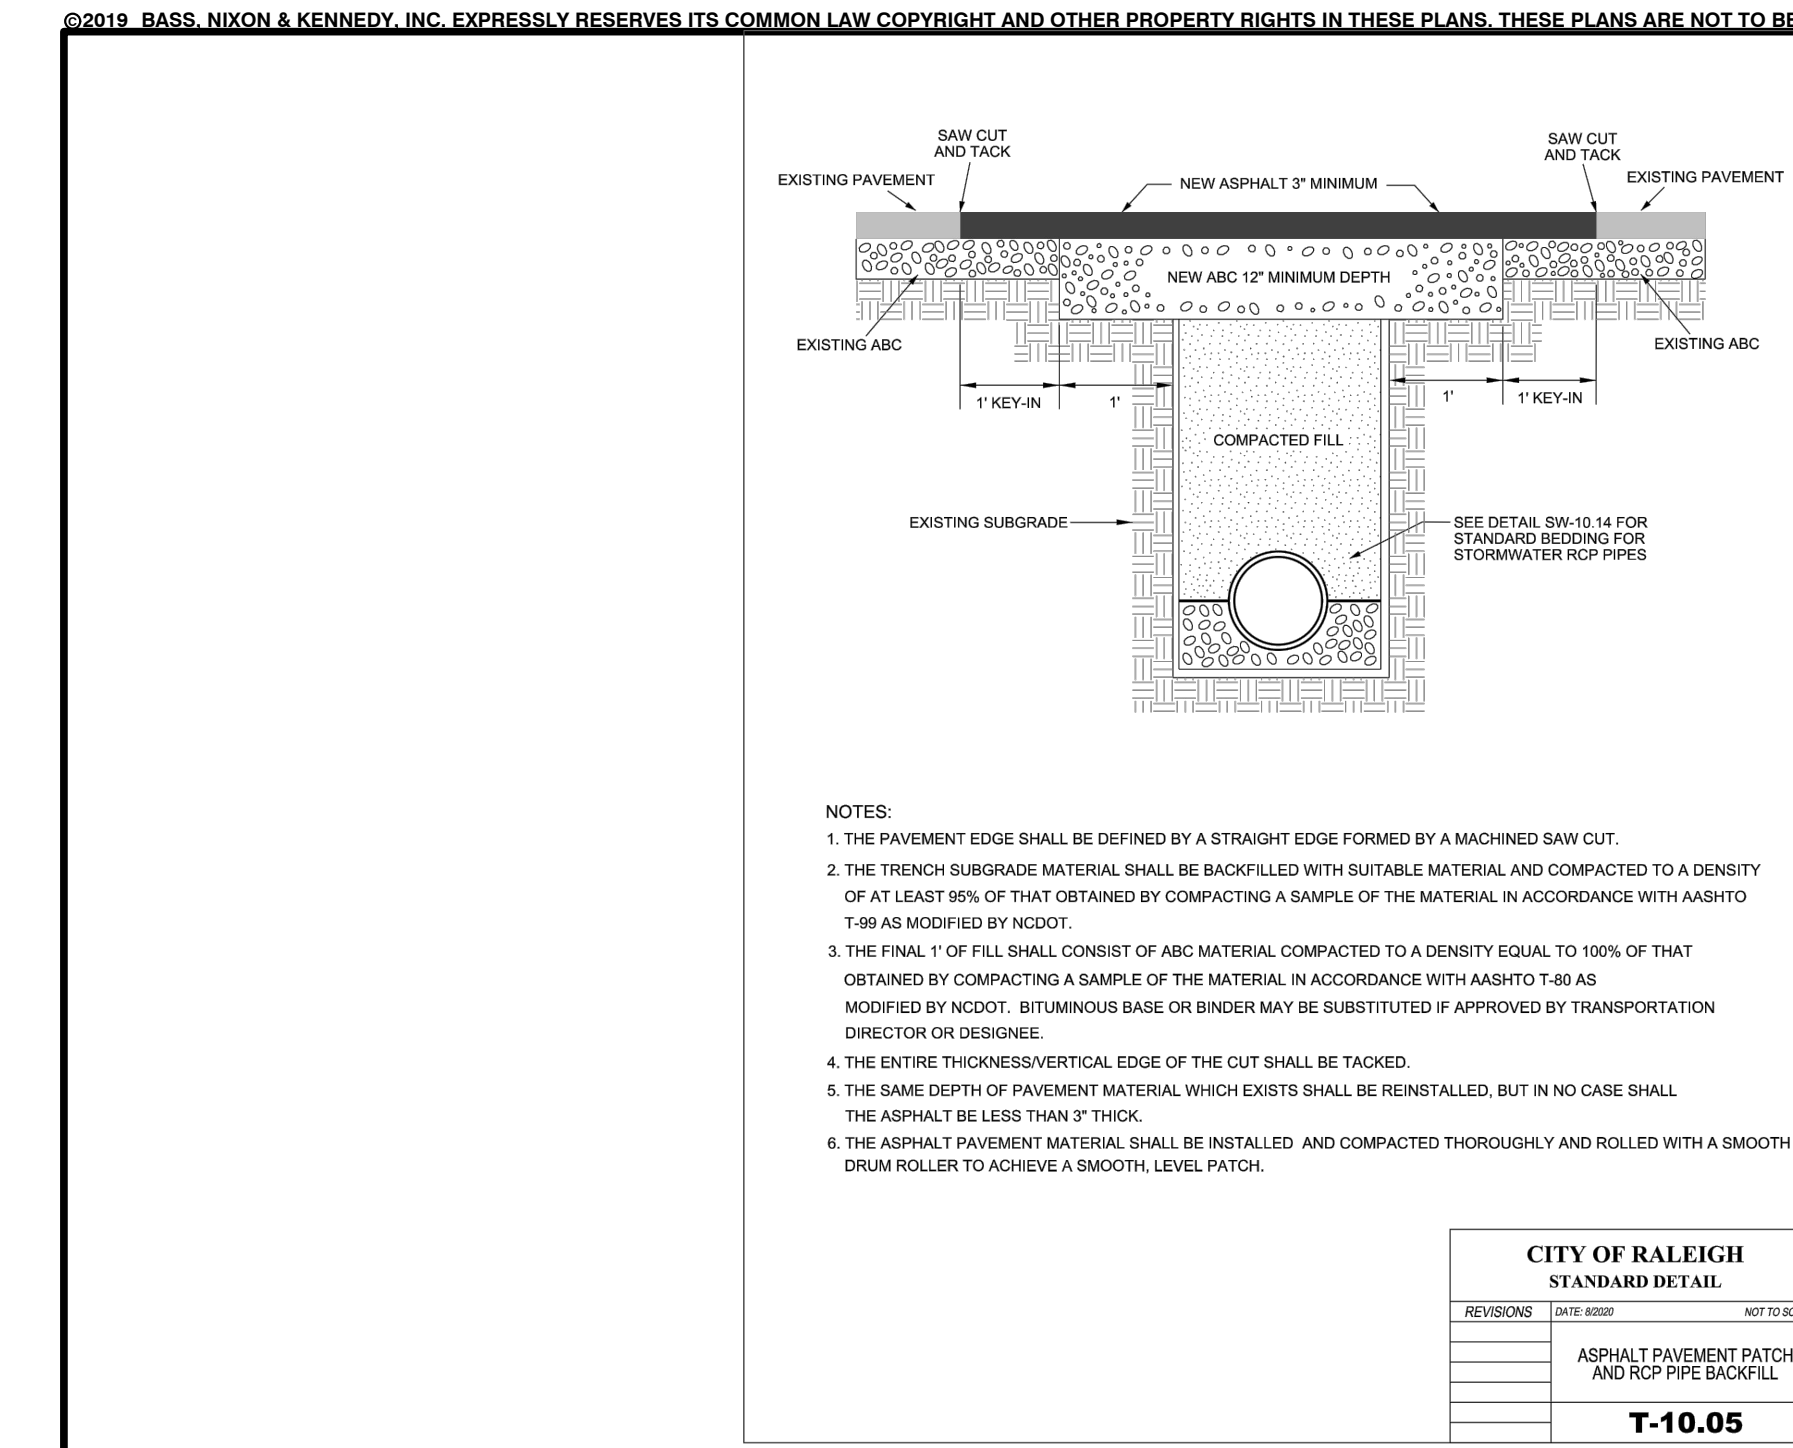

CITY OF RALEIGH CURB RAMPS GENERAL NOTES

- CITY OF RALEIGH STANDARD CURB RAMPS HAVE BEEN DEVELOPED IN ACCORDANCE WITH THE AMERICANS WITH DISABILITIES ACT (ADA) AND PUBLIC RIGHT OF WAY ACCESS GUIDELINES (PROWAG).
- CURB RAMPS SHALL BE PROVIDED AT LOCATIONS AS SHOWN ON THE PLANS OR AS DIRECTED BY THE ENGINEER. SIDEWALK ACCESS RAMPS SHALL BE LOCATED AS INDICATED IN THE DETAIL, HOWEVER, THE LOCATION MAY BE ADJUSTED IN COORDINATION WITH THE CITY OF RALEIGH WHERE EXISTING LIGHT POLES, FIRE HYDRANTS, DROP INLETS, ETC. AFFECT PLACEMENT.
- DOUBLE WHEELCHAIR RAMPS ARE TO BE INSTALLED AT ALL PUBLIC STREET INTERSECTIONS WHERE SIDEWALK IS REQUIRED.
- THE WALKING SURFACE SHALL BE SLIP RESISTANT. THE COLOR FOR THE DETECTABLE WARNING AREA SHALL BE YELLOW FOR CONTRAST.
- NO SLOPE ON THE SIDEWALK ACCESS RAMP SHALL EXCEED 1" (2:1) IN RELATIONSHIP TO THE GRADE OF THE STREET.
- IN NO CASE SHALL THE WIDTH OF THE SIDEWALK ACCESS RAMP BE LESS THAN 48" ALL RAMPS SHALL BE INSTALLED THE SAME WIDTH AS THE SIDEWALK.
- USE CLASS A (3000 PSI) CONCRETE WITH A SIDEWALK FINISH IN ORDER TO OBTAIN A ROUGH NONSKID SURFACE.
- A 1/2" EXPANSION JOINT INSTALLED FULL DEPTH WILL BE REQUIRED WHERE THE CONCRETE SIDEWALK ACCESS RAMP JOINS THE CURB AND ALSO WHERE NEW CONCRETE ABUTS EXISTING CONCRETE.
- CURB RAMPS SHOULD BE PLACED PARALLEL TO THE DIRECTION OF TRAVEL.

CITY OF RALEIGH STANDARD DETAIL
 T-20.01.8
 CURB RAMP NOTES

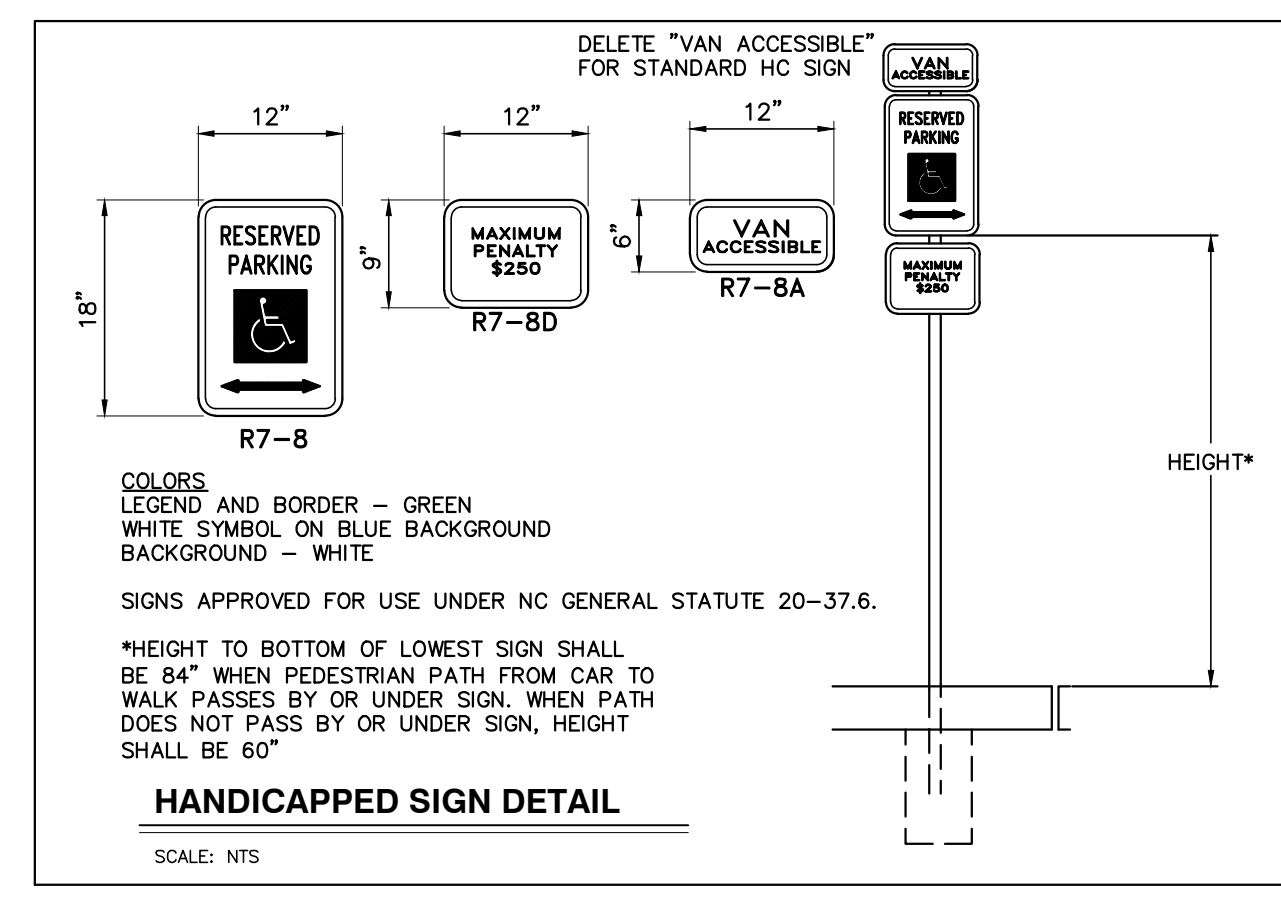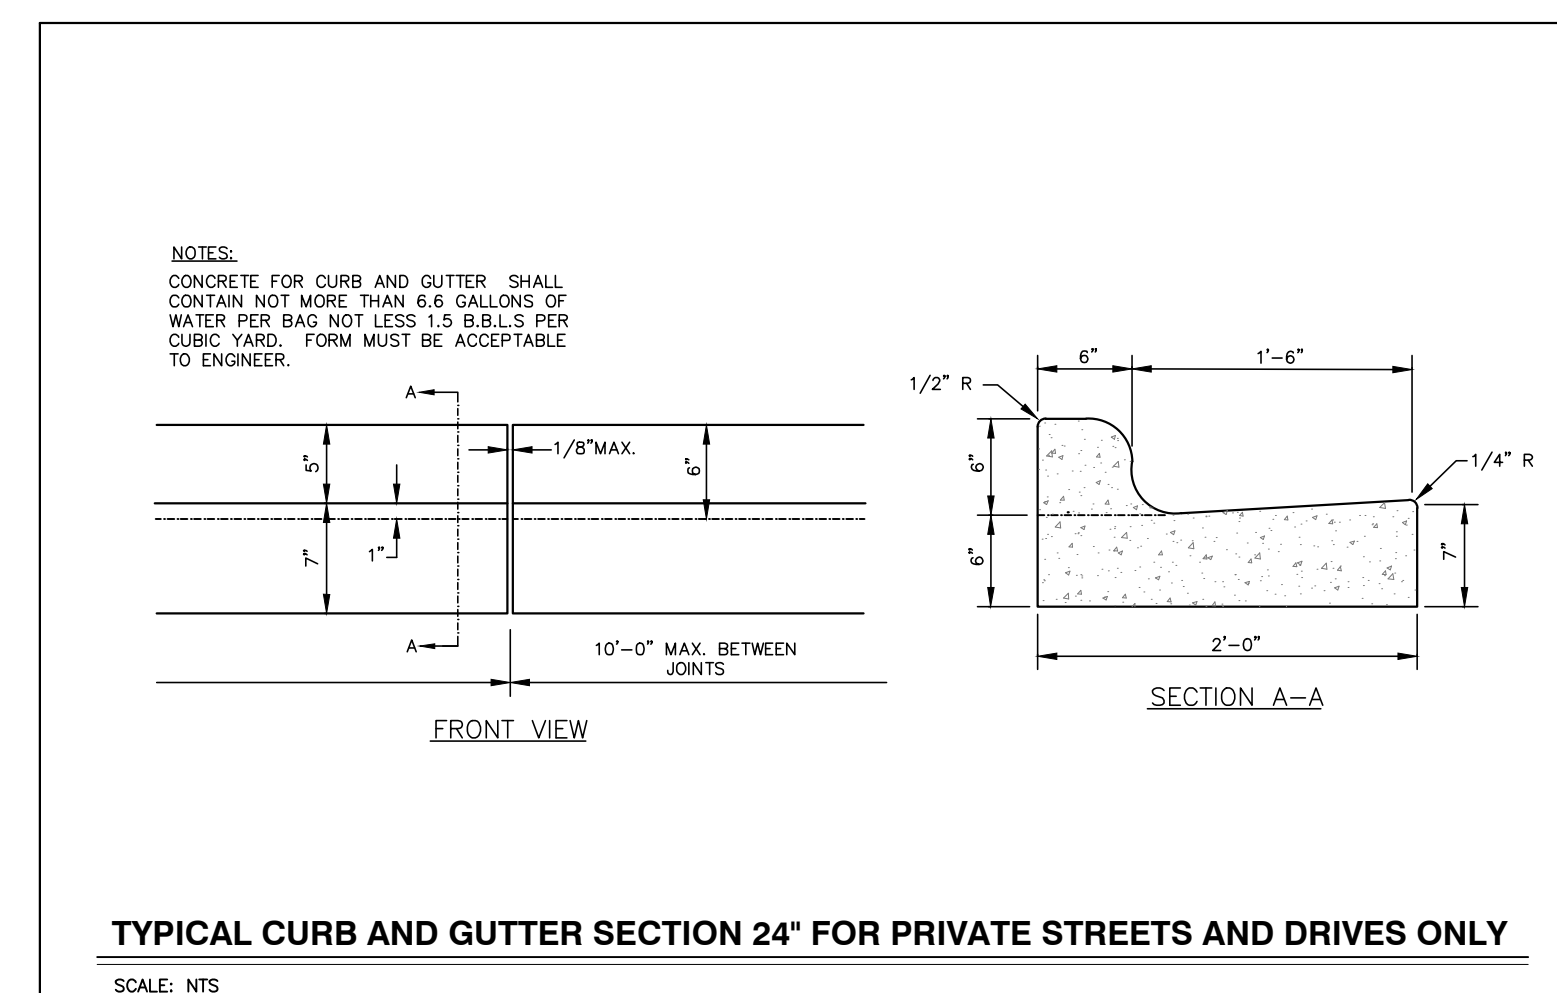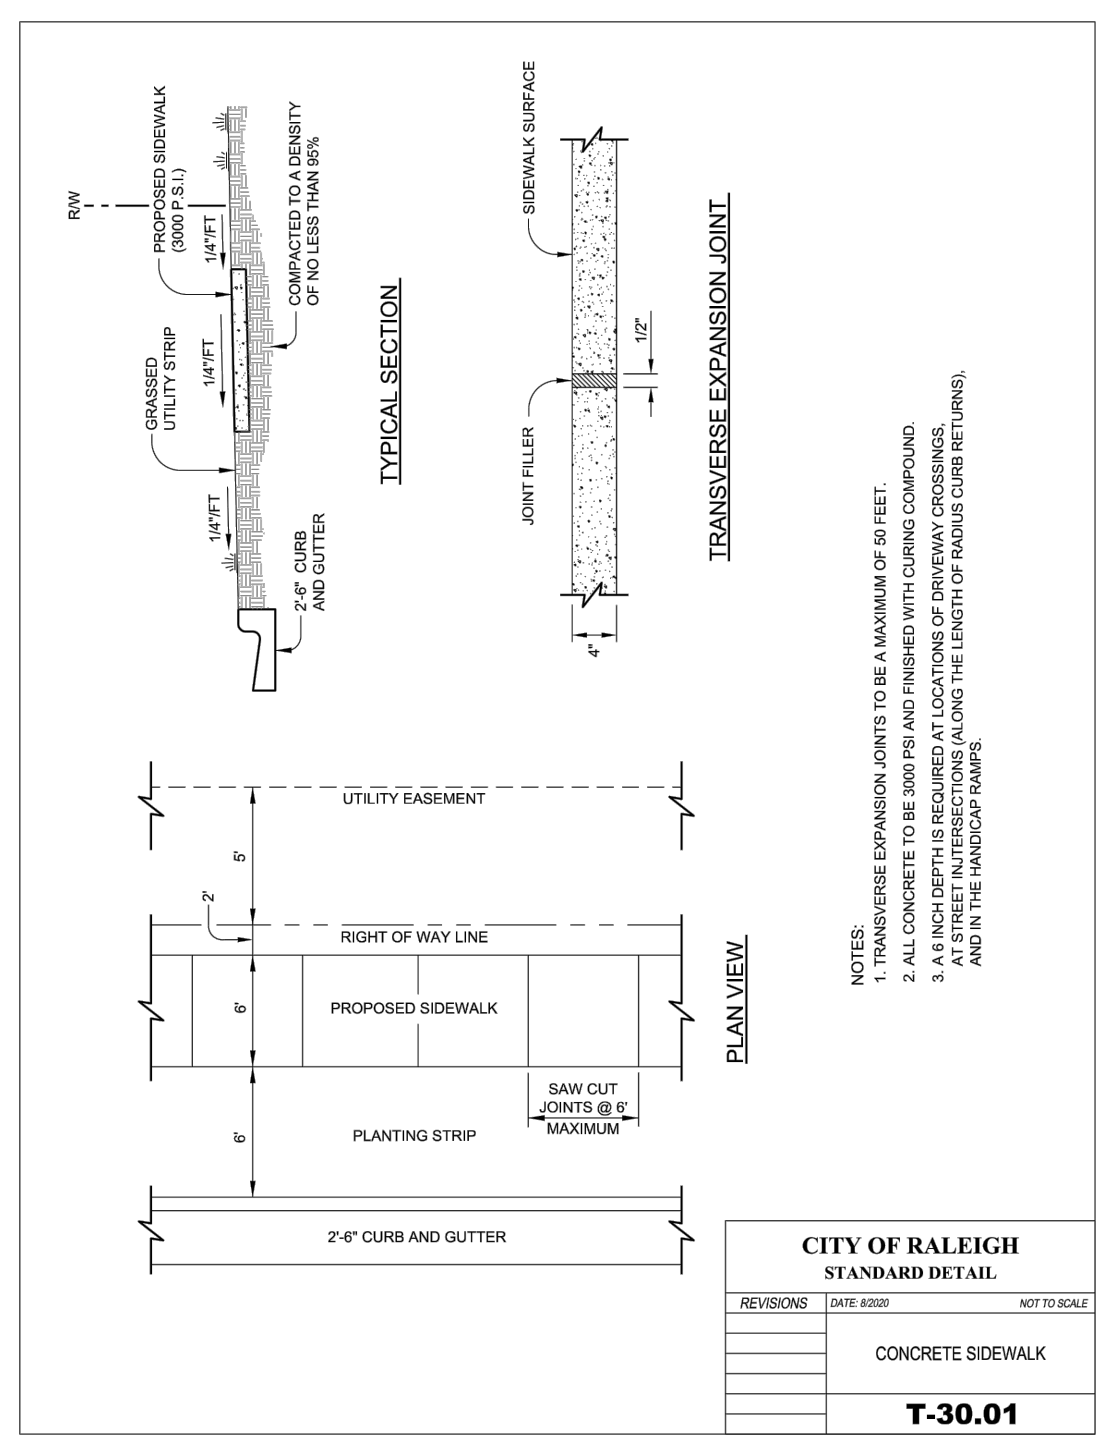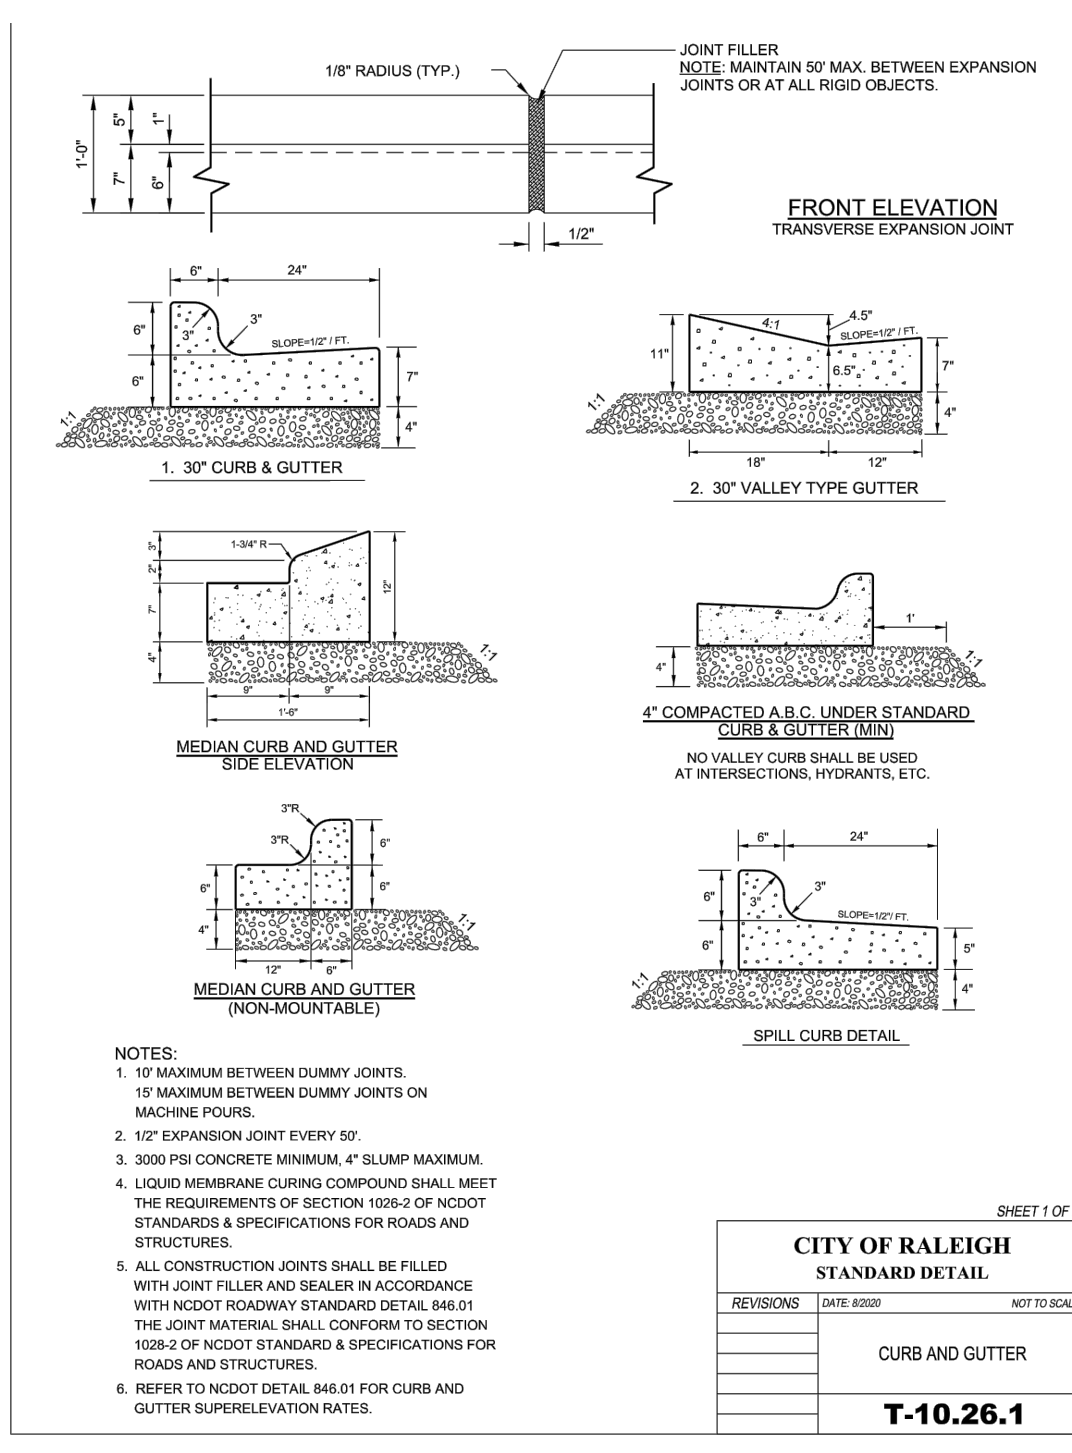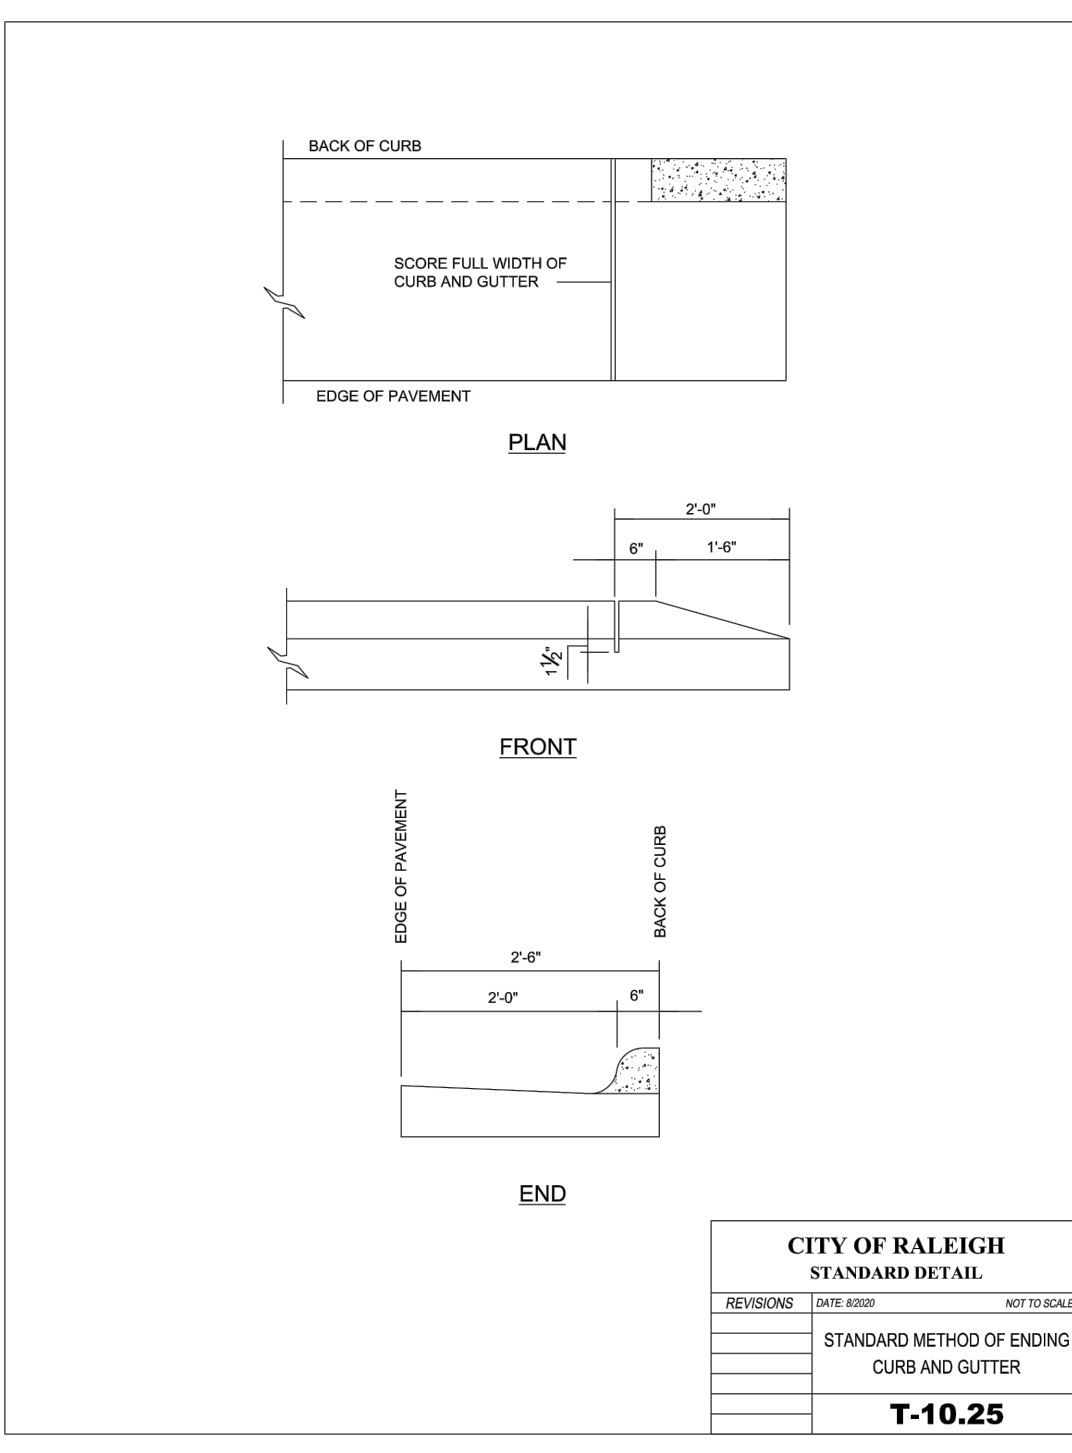

CITY OF RALEIGH - PLANS AUTHORIZED FOR CONSTRUCTION

Electronic Approval: This approval is being issued electronically. This approval is valid only upon the signature of a City of Raleigh Review Officer below. The City will retain a copy of the approved plans. Any work authorized by this approval must proceed in accordance with the plans kept on file with the City. This electronic approval may not be edited once issued. Any modification to this approval once issued will invalidate this approval.

City of Raleigh Development Approval _____
 Raleigh Water Review Officer _____

04/20/22



BASS, NIXON & KENNEDY, INC.
 CONSULTING ENGINEERS
 6310 CHAPEL HILL ROAD, SUITE 250, RALEIGH, NC 27607
 TELEPHONE: (919)817-1232 FAX: (919)817-8686
 CERTIFICATION NUMBERS: NCBELS (C-0110); NCBOLA (C-0267)

| NO. | DATE | DESCRIPTION | BY |
|-----|------|-------------|----|
| | | | |
| | | | |
| | | | |

COBBLESTONE VILLAGE MIXED USE DEVELOPMENT
 TOWN OF ROLESVILLE, WAKE COUNTY, NORTH CAROLINA

PROGRESS MRN
 DATE DRAWN BY
 JOB NO.

DETAILS

SCALE: N.T.S. CHK BY: MDB

SHEET C5.1

| NO. | DATE | DESCRIPTION | BY |
|-----|------|-------------|----|
| | | | |
| | | | |
| | | | |

ROADWAY STANDARD DRAWING FOR CONCRETE CATCH BASIN 12" THRU 54" PIPE

GENERAL NOTES:
 USE CLASS "B" CONCRETE THROUGHOUT.
 PROVIDE ALL CATCH BASINS OVER 3'-6" IN DEPTH WITH STEPS 12" ON CENTER. USE STEPS WHICH COMPLY WITH STD. DRAWING 840.66.
 OPTIONAL CONSTRUCTION - MONOLITHIC POUR, 2" KEYWAY, OR #4 BAR DOWELS AT 12" CENTERS AS DIRECTED BY THE ENGINEER.
 USE FORMS FOR THE CONSTRUCTION OF THE BOTTOM SLAB.
 IF REINFORCED CONCRETE PIPE IS SET IN BOTTOM SLAB OF BOX, ADD TO SLAB AS SHOWN ON STD. NO. 840.00.
 USE TYPE "E", "F" AND "G" GRATES UNLESS OTHERWISE INDICATED.
 FOR 8'-0" IN HEIGHT OR LESS USE 6" WALLS AND BOTTOM SLAB, OVER 8'-0" TO 16'-0" IN HEIGHT USE 8" WALLS AND BOTTOM SLAB. ADJUST QUANTITIES ACCORDINGLY.
 CONSTRUCT WITH PIPE GRINGS MATCHING.
 CHAMFER ALL EXPOSED CORNERS 1".
 DRAWING NOT TO SCALE.

STATE OF NORTH CAROLINA
 DEPT. OF TRANSPORTATION
 DIVISION OF HIGHWAYS
 RALEIGH, N. C.

CITY OF RALEIGH
 STANDARD DETAIL
 STANDARD DROP INLET
 SW-10.03

CITY OF RALEIGH
 STANDARD DETAIL
 STANDARD CLASS "I" MANHOLE
 SW-10.05

CITY OF RALEIGH
 STANDARD DETAIL
 CATCH BASIN CASTINGS
 SW-10.06.1

SHEET 1 OF 2
840.02

TYPICAL MH FOR STORM SEWER

| PIPE SIZE | MH DIAMETER |
|-----------|-------------|
| 12" & 18" | 4'-0" |
| 24" | 5'-0" |
| 30" | 6'-0" |
| 36" | 7'-0" |

NOTES:
 1. FOR 24" RCP & LARGER USE PIPE DIAMETER PLUS 12" FOR MINIMUM INSIDE DIMENSION.
 2. 24" & 30" CASTING WITH 12", 15" & 18" PIPE, 24" X 30" CASTING USED WITH 24" PIPE OR LARGER IF PLACED WITHIN PUBLIC RW CASTING MUST BE TRAFFIC BEARING TYPE PER NC DOT STANDARDS.
 3. USE 4" X 4" X 8" OR 4" X 8" X 8" SOLID CONCRETE BLOCK CAST IN PLACE OR PRECAST CONCRETE TO MEET N.C.D.O.T. STANDARDS ACCEPTABLE.
 4. STEPS SHALL BE INSTALLED IN ALL DROP INLETS OVER 3' IN DEPTH. STEPS SHALL BE MEASURED FROM THE TOP OF GRATE TO THE INVERT OF THE DROP INLET.

CITY OF RALEIGH
 STANDARD DETAIL
 STANDARD STORM MANHOLE COVER
 SW-10.08

CITY OF RALEIGH
 STANDARD DETAIL
 STANDARD STORM MANHOLE COVER
 SW-10.10

CITY OF RALEIGH
 STANDARD DETAIL
 STANDARD STORM MANHOLE COVER
 SW-10.14

ROADWAY STANDARD DRAWING FOR CONCRETE CATCH BASIN 12" THRU 54" PIPE

MINIMUM DIMENSIONS AND QUANTITIES FOR CONCRETE CATCH BASIN (BASED ON MIN. HEIGHT, N, WITH NO RISER) *

| PIPE DIA. | DIMENSIONS OF BOX AND PIPE | | | | COVER DIMENSION | | BARS-U | | | BARS-V | | | BARS-W | | | TOTAL REBAR LBS. | CU. YDS. CONC. IN BOX FOR WITHIN ONE PIPE | | | C.M. R.C. |
|-----------|----------------------------|-------|--------|-------------|-----------------|-------|--------|--------|-----|--------|-----|--------|--------|--------|----------|------------------|---|---------------------|--|-----------|
| | SPAN | WIDTH | HEIGHT | MIN. HEIGHT | E | F | NO. | LENGTH | NO. | LENGTH | NO. | LENGTH | NO. | LENGTH | TOP SLAB | | BOTTOM SLAB | FOR WITHIN ONE PIPE | | |
| 12" | 3'-0" | 2'-2" | 2'-9" | 2'-9" | 3'-0" | 3'-0" | 4 | 1'-5" | 2 | 3'-0" | 3 | 3'-0" | 3 | 3'-0" | 0.235 | 0.272 | 0.015 | 0.026 | | |
| 15" | 3'-0" | 2'-2" | 3'-0" | 3'-0" | 3'-0" | 3'-0" | 4 | 1'-5" | 2 | 3'-0" | 3 | 3'-0" | 3 | 3'-0" | 0.235 | 0.269 | 0.023 | 0.036 | | |
| 18" | 3'-0" | 2'-2" | 3'-3" | 3'-3" | 3'-0" | 3'-0" | 4 | 1'-5" | 2 | 3'-0" | 3 | 3'-0" | 3 | 3'-0" | 0.235 | 0.267 | 0.033 | 0.049 | | |
| 24" | 3'-0" | 2'-2" | 3'-9" | 3'-9" | 3'-0" | 3'-0" | 4 | 1'-5" | 2 | 3'-0" | 3 | 3'-0" | 3 | 3'-0" | 0.235 | 0.261 | 0.059 | 0.085 | | |
| 30" | 3'-0" | 2'-2" | 3'-11" | 3'-11" | 4'-3" | 4'-3" | 4 | 1'-5" | 2 | 3'-0" | 3 | 3'-0" | 3 | 3'-0" | 0.235 | 0.251 | 0.092 | 0.127 | | |
| 36" | 3'-0" | 2'-2" | 3'-10" | 3'-10" | 4'-9" | 4'-9" | 4 | 1'-5" | 2 | 3'-0" | 3 | 3'-0" | 3 | 3'-0" | 0.235 | 0.239 | 0.114 | 0.178 | | |
| 42" | 3'-0" | 2'-2" | 4'-6" | 4'-6" | 5'-3" | 5'-3" | 4 | 1'-5" | 2 | 2'-11" | 3 | 2'-11" | 3 | 2'-11" | 0.112 | 0.318 | 0.138 | 0.243 | | |
| 48" | 3'-0" | 2'-2" | 5'-0" | 5'-0" | 5'-9" | 5'-9" | 4 | 2'-3" | 3 | 2'-11" | 3 | 2'-11" | 3 | 2'-11" | 0.148 | 0.352 | 0.202 | 0.317 | | |
| 54" | 3'-0" | 2'-2" | 5'-7" | 5'-7" | 6'-3" | 6'-3" | 4 | 2'-10" | 5 | 2'-11" | 3 | 2'-11" | 4 | 2'-11" | 0.180 | 0.388 | 0.287 | 0.401 | | |

* RISER HAS .228 CUBIC YARDS OF CONCRETE PER FOOT HEIGHT

STATE OF NORTH CAROLINA
 DEPT. OF TRANSPORTATION
 DIVISION OF HIGHWAYS
 RALEIGH, N. C.

CITY OF RALEIGH
 STANDARD DETAIL
 DROP INLET CASTING
 SW-10.08

CITY OF RALEIGH
 STANDARD DETAIL
 STANDARD STORM MANHOLE COVER
 SW-10.10

CITY OF RALEIGH
 STANDARD DETAIL
 STANDARD STORM MANHOLE COVER
 SW-10.14

SHEET 2 OF 2
840.02

ROADWAY STANDARD DRAWING FOR FRAME, GRATES, AND HOOD FOR USE ON STANDARD CATCH BASIN

NOTE: USE TYPE "E", "F" AND "G" GRATE UNLESS OTHERWISE NOTED.

ALIGN FRAME WITH INSIDE EDGE OF WALL TO ALLOW FOR VERTICAL ADJUSTMENT

STATE OF NORTH CAROLINA
 DEPT. OF TRANSPORTATION
 DIVISION OF HIGHWAYS
 RALEIGH, N. C.

CITY OF RALEIGH
 STANDARD DETAIL
 STANDARD CATCH BASIN FRAME, GRATES, AND HOOD
 SW-10.03

ROADWAY STANDARD DRAWING FOR FRAME, GRATES, AND HOOD FOR USE ON STANDARD CATCH BASIN

DETAIL SHOWING TYPES OF GRATES USE ACCORDING TO WATER FLOW.

STATE OF NORTH CAROLINA
 DEPT. OF TRANSPORTATION
 DIVISION OF HIGHWAYS
 RALEIGH, N. C.

CITY OF RALEIGH
 STANDARD DETAIL
 STANDARD CATCH BASIN FRAME, GRATES, AND HOOD
 SW-10.03

ROADWAY STANDARD DRAWING FOR FRAME, GRATES, AND HOOD FOR USE ON STANDARD CATCH BASIN

STATE OF NORTH CAROLINA
 DEPT. OF TRANSPORTATION
 DIVISION OF HIGHWAYS
 RALEIGH, N. C.

CITY OF RALEIGH
 STANDARD DETAIL
 STANDARD CATCH BASIN CASTINGS
 SW-10.06.1

ROADWAY STANDARD DRAWING FOR FRAME, GRATES, AND HOOD FOR USE ON STANDARD CATCH BASIN

COVER 120 LBS. MINIMUM

STATE OF NORTH CAROLINA
 DEPT. OF TRANSPORTATION
 DIVISION OF HIGHWAYS
 RALEIGH, N. C.


CITY OF RALEIGH
 STANDARD DETAIL
 STANDARD STORM MANHOLE COVER
 SW-10.10

CITY OF RALEIGH
 STANDARD DETAIL
 STANDARD STORM MANHOLE COVER
 SW-10.14

ROADWAY STANDARD DRAWING FOR FRAME, GRATES, AND HOOD FOR USE ON STANDARD CATCH BASIN


STATE OF NORTH CAROLINA
 DEPT. OF TRANSPORTATION
 DIVISION OF HIGHWAYS
 RALEIGH, N. C.

CITY OF RALEIGH
 STANDARD DETAIL
 STANDARD CATCH BASIN FRAME, GRATES, AND HOOD
 SW-10.03

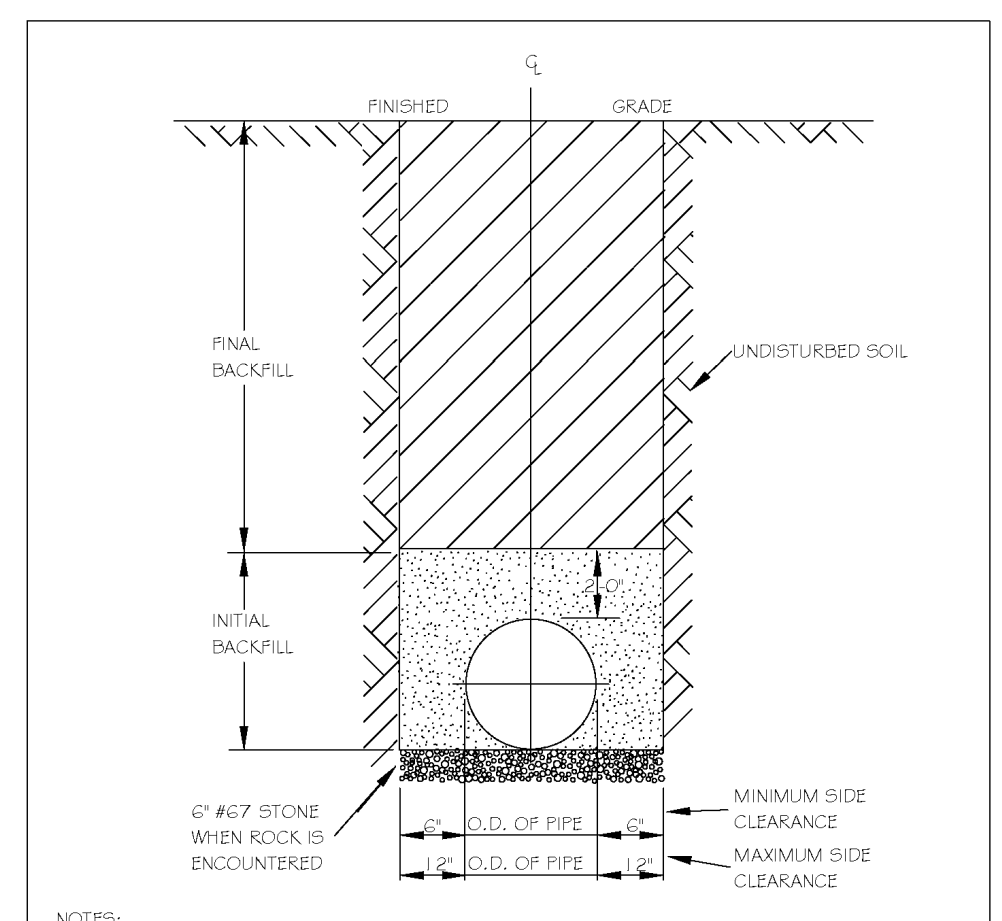


NOTES:
 1. TRENCHES REQUIRING SHORING AND BRACING, DIMENSIONS SHALL BE TAKEN FROM THE INSIDE FACE OF THE SHORING AND BRACING.
 2. NO ROCKS OR BOULDERS 4" OR LARGER TO BE USED IN INITIAL BACKFILL.
 3. ALL BACKFILL MATERIAL SHALL BE SUITABLE NATIVE MATERIAL.
 4. BACKFILL SHALL BE TAMPED IN 6" LIFTS IN TRAFFIC AREAS, 12" IN NON-TRAFFIC AREAS.
 5. ACHIEVE 90% COMPACTION IN NON-TRAFFIC AREAS, AND 95% COMPACTION IN TRAFFIC AREAS.
 6. IF IN BASEMENT AT TOPSOIL, AND 1" CLEAN GRIEST FILL MAY BE REQUIRED.
 7. NO BOULDERS 6" IN DIAMETER OR GREATER ALLOWED IN FINAL BACKFILL.

| CITY OF RALEIGH DEPARTMENT OF PUBLIC UTILITIES | | | | |
|--|-----------|---------|-----------|------|
| TRENCH BOTTOM DIMENSIONS & BACKFILLING REQUIREMENTS FOR DUCTILE IRON | | | | |
| DWG. NO. | REVISIONS | DATE | REVISIONS | DATE |
| S-4 | KRT | 3-23-00 | | |

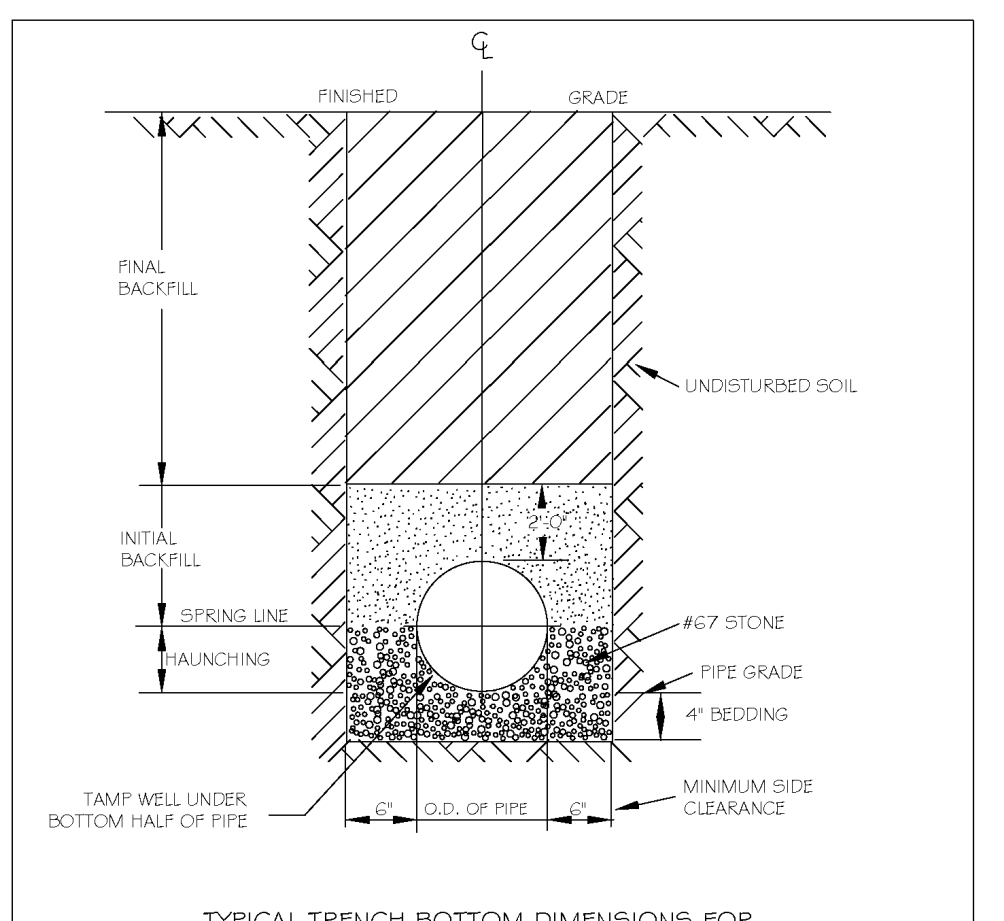


NOTES:
 1. FOR TRENCHES REQUIRING SHORING AND BRACING, DIMENSIONS SHALL BE TAKEN FROM THE INSIDE FACE OF THE SHORING AND BRACING.
 2. NO ROCKS OR BOULDERS 4" OR LARGER TO BE USED IN INITIAL BACKFILL.
 3. ALL BACKFILL MATERIAL SHALL BE SUITABLE NATIVE MATERIAL.
 4. BACKFILL SHALL BE TAMPED IN 6" LIFTS IN TRAFFIC AREAS, 12" IN NON-TRAFFIC AREAS.

| CITY OF RALEIGH DEPARTMENT OF PUBLIC UTILITIES | | | | |
|--|-----------|---------|-----------|------|
| TRENCH BOTTOM DIMENSIONS AND BACKFILLING REQUIREMENTS FOR PVC GRAVITY SEWER MAIN | | | | |
| DWG. NO. | REVISIONS | DATE | REVISIONS | DATE |
| S-5 | KRT | 3-23-00 | | |

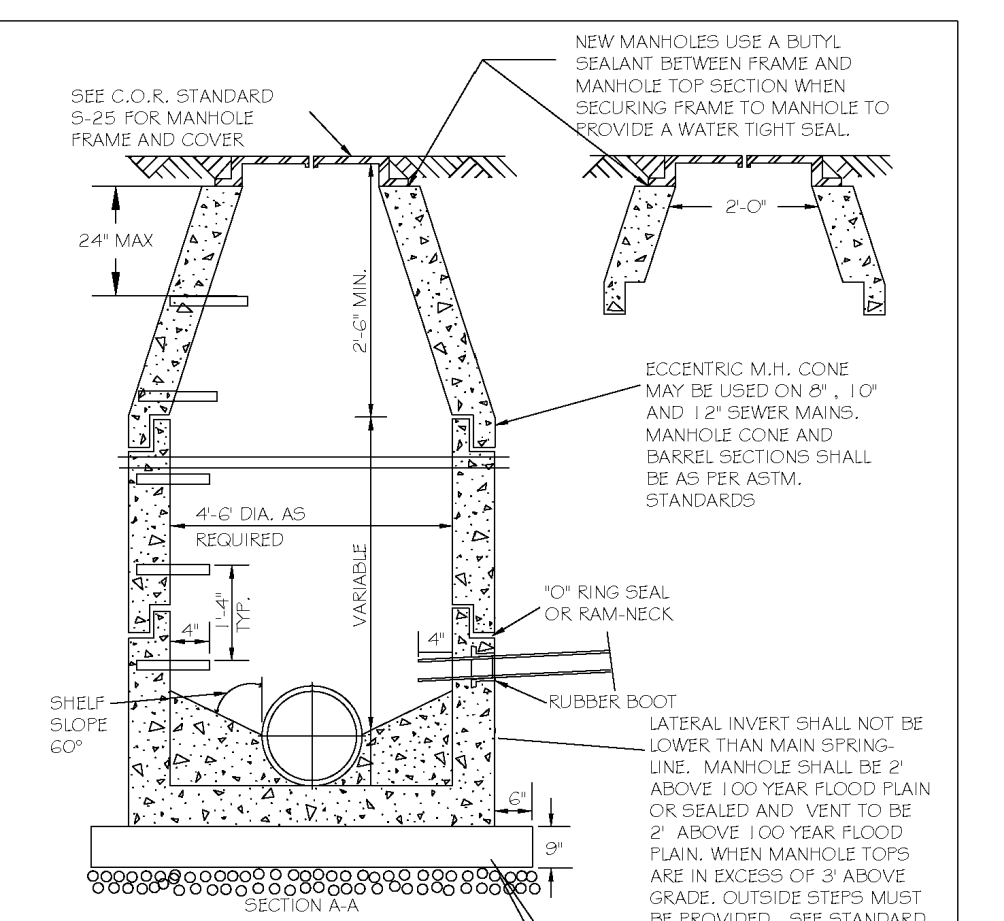


NOTES:
 1. THE TRACER WIRE SHALL BE CONTINUOUS TO THE GREATEST EXTENT POSSIBLE. FOR GRAVITY MAIN AND OR LATERAL INSTALLATIONS LESS THAN 8' FT, THE TRACER WIRE SHALL BE ATTACHED TO THE PIPE TRACER WIRE SHALL BE ADJACENT TO THE PIPE AT 10 FOOT INTERVALS. FOR GRAVITY MAIN AND OR LATERAL INSTALLATION DEEPER THAN 8' FT, THE TRACER WIRE SHALL BE INSTALLED AT A DEPTH OF 7.5 FT. THE WIRE SHALL BE PROTECTED FROM DAMAGE DURING THE COURSE OF THE WORK. NO BREAKS OF CUTS IN THE TRACER WIRE SHALL BE PERMITTED.
 2. WHERE LATERAL TAPS ARE MADE BY SERVICE SAIDLES, THE TRACER WIRE SHALL NOT BE ALLOWED TO BE PLACED BETWEEN THE SAIDLE AND MAIN.
 3. MANHOLE MARKERS SHALL BE PLACED ADJACENT TO MANHOLES AT THE DISCRETION OF OWNER OR OWNER'S REPRESENTATIVE.

| CITY OF RALEIGH DEPARTMENT OF PUBLIC UTILITIES | | | | |
|---|-----------|----------|-----------|---------|
| STANDARD PRECAST SANITARY SEWER MANHOLE | | | | |
| DWG. NO. | REVISIONS | DATE | REVISIONS | DATE |
| S-20 | T.C.A. | 12-31-02 | AKB | 2-21-05 |
| | KRT | 3-30-00 | D.H.L. | 6-14-08 |

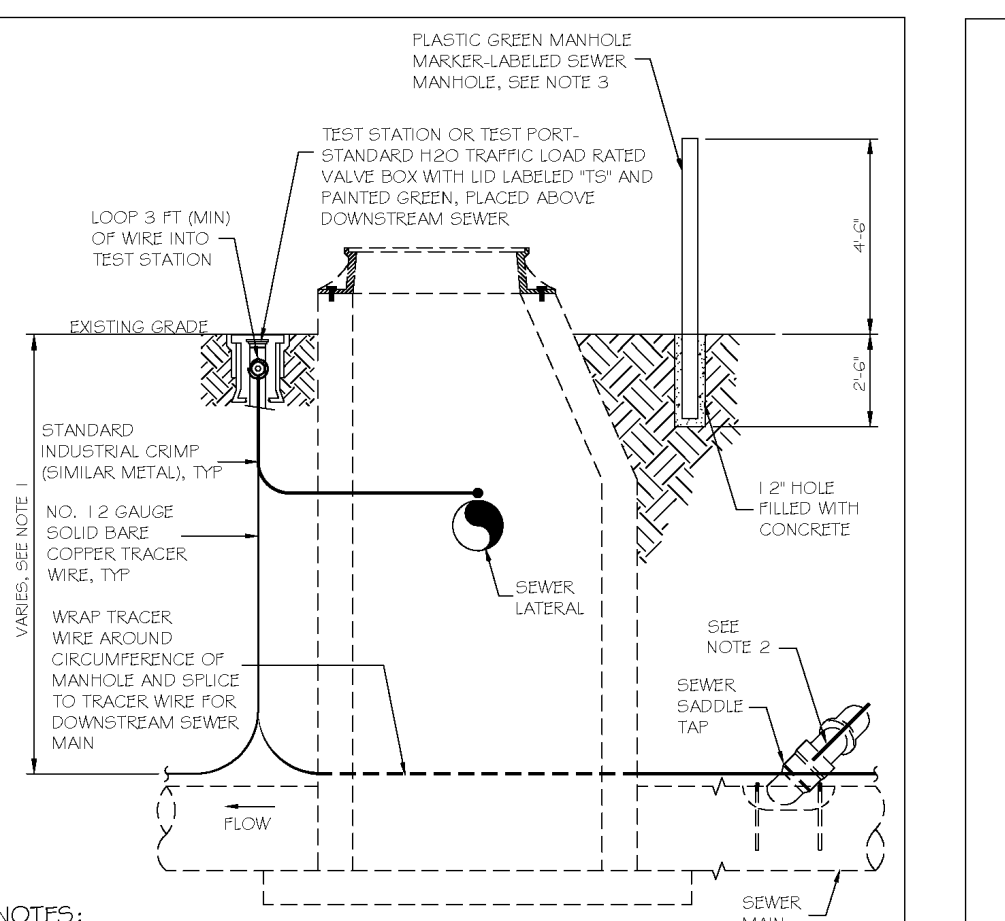


NOTES:
 1. THE TRACER WIRE SHALL BE CONTINUOUS TO THE GREATEST EXTENT POSSIBLE. FOR GRAVITY MAIN AND OR LATERAL INSTALLATIONS LESS THAN 8' FT, THE TRACER WIRE SHALL BE ATTACHED TO THE PIPE TRACER WIRE SHALL BE ADJACENT TO THE PIPE AT 10 FOOT INTERVALS. FOR GRAVITY MAIN AND OR LATERAL INSTALLATION DEEPER THAN 8' FT, THE TRACER WIRE SHALL BE INSTALLED AT A DEPTH OF 7.5 FT. THE WIRE SHALL BE PROTECTED FROM DAMAGE DURING THE COURSE OF THE WORK. NO BREAKS OF CUTS IN THE TRACER WIRE SHALL BE PERMITTED.
 2. WHERE LATERAL TAPS ARE MADE BY SERVICE SAIDLES, THE TRACER WIRE SHALL NOT BE ALLOWED TO BE PLACED BETWEEN THE SAIDLE AND MAIN.
 3. MANHOLE MARKERS SHALL BE PLACED ADJACENT TO MANHOLES AT THE DISCRETION OF OWNER OR OWNER'S REPRESENTATIVE.

| CITY OF RALEIGH DEPARTMENT OF PUBLIC UTILITIES | | | | |
|---|-----------|-------|-----------|------|
| GRAVITY SEWER MAIN TRACER WIRE AND MANHOLE MARKER | | | | |
| DWG. NO. | REVISIONS | DATE | REVISIONS | DATE |
| S-20A | W.E. | 09-11 | | |

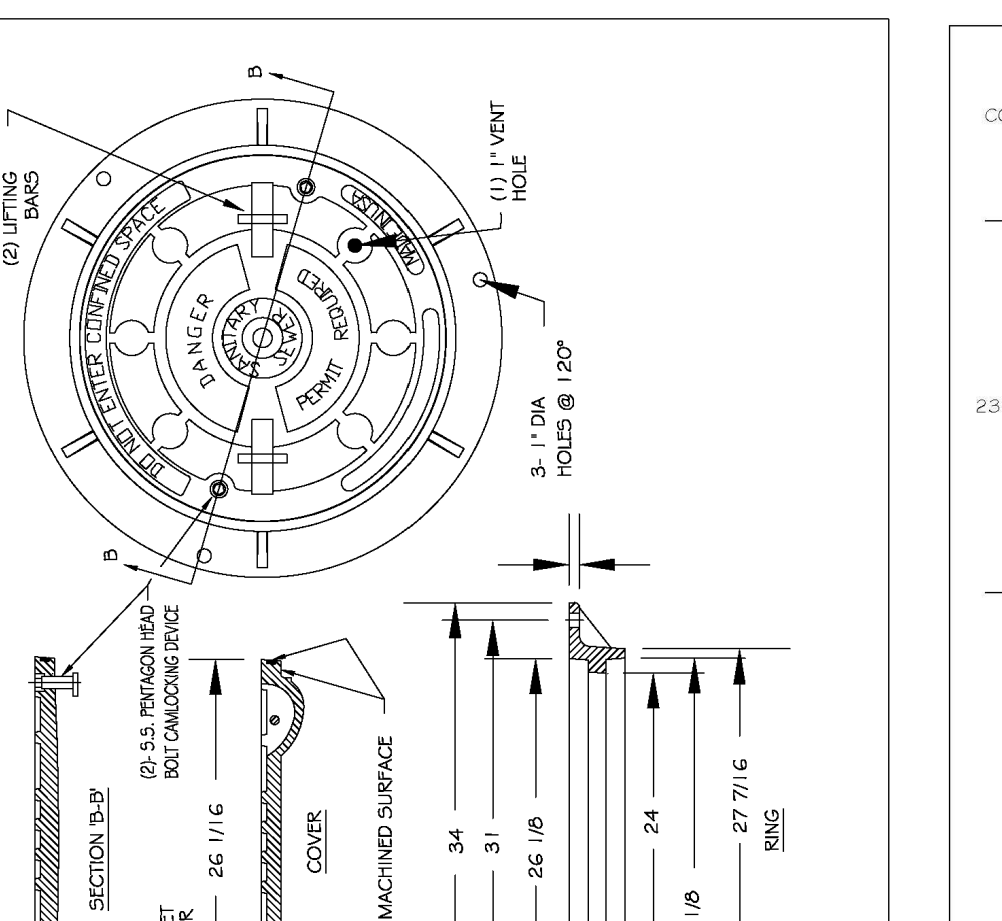


NOTES:
 1. ALL MANHOLE FRAMES SHALL BE DOMESTICALLY CAST.
 2. FRAME SHALL BE A MINIMUM WEIGHT OF 120 LBS. WITHIN PUBLIC ROW AND 140 LBS. WITHIN EASEMENTS.
 3. COVER SHALL BEIGH A MIN. OF 120 LBS. HOT DIPPED GALVANIZED LAGO BOOT AND WASHER.
 4. ALL MANHOLE FRAMES OUTSIDE OF PAVED SURFACES SHALL BE COATED TO THE CORE SECTION OR RING WITH A MINIMUM OF 4 BOLTS PER FRAME.

| CITY OF RALEIGH DEPARTMENT OF PUBLIC UTILITIES | | | | |
|---|-----------|---------|-----------|---------|
| FLAT TOP MANHOLE COVER | | | | |
| DWG. NO. | REVISIONS | DATE | REVISIONS | DATE |
| S-25.01 | KRT | 3-1-07 | A.B.B. | 2-9-05 |
| | KRT | 3-30-00 | D.H.L. | 6-18-08 |

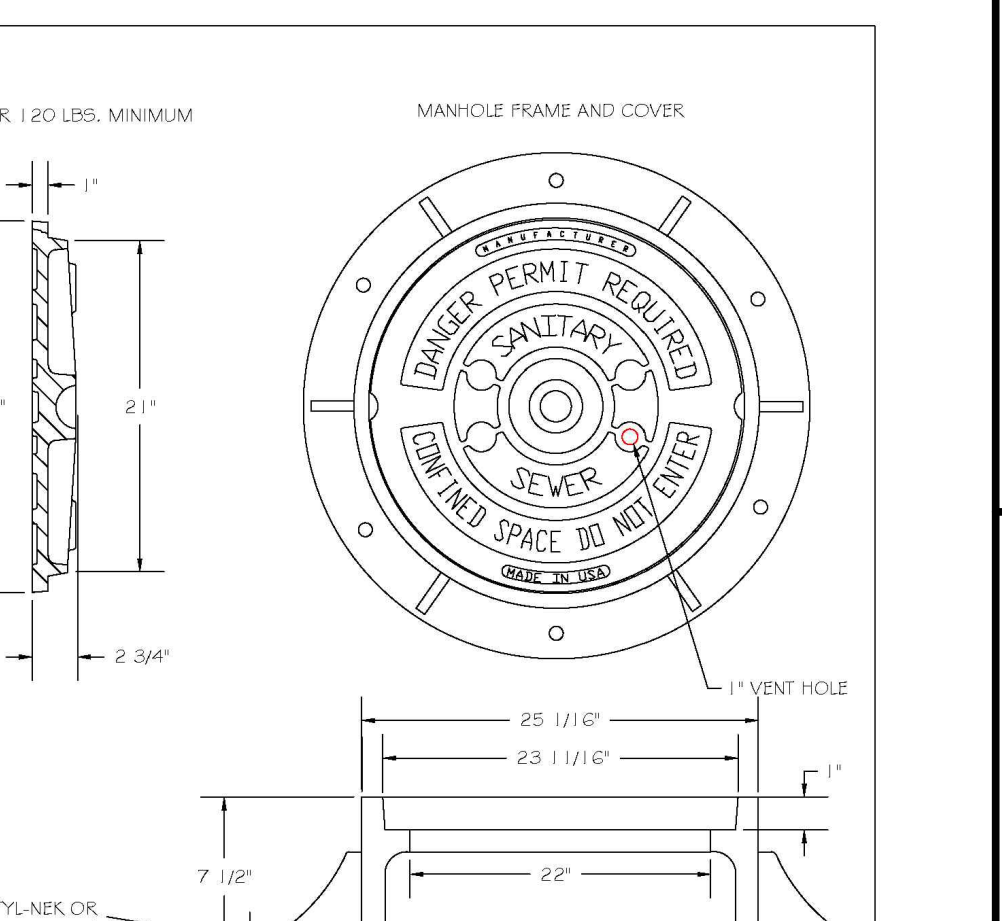


NOTES:
 1. ALL MANHOLE FRAMES SHALL BE DOMESTICALLY CAST.
 2. FRAME SHALL BE A MINIMUM WEIGHT OF 120 LBS. WITHIN PUBLIC ROW AND 140 LBS. WITHIN EASEMENTS.
 3. COVER SHALL BEIGH A MIN. OF 120 LBS. HOT DIPPED GALVANIZED LAGO BOOT AND WASHER.
 4. ALL MANHOLE FRAMES OUTSIDE OF PAVED SURFACES SHALL BE COATED TO THE CORE SECTION OR RING WITH A MINIMUM OF 4 BOLTS PER FRAME.


| CITY OF RALEIGH DEPARTMENT OF PUBLIC UTILITIES | | | | |
|---|-----------|---------|-----------|---------|
| STANDARD MANHOLE COVER | | | | |
| DWG. NO. | REVISIONS | DATE | REVISIONS | DATE |
| S-25 | KRT | 3-1-07 | A.B.B. | 2-9-05 |
| | KRT | 3-30-00 | D.H.L. | 6-18-08 |

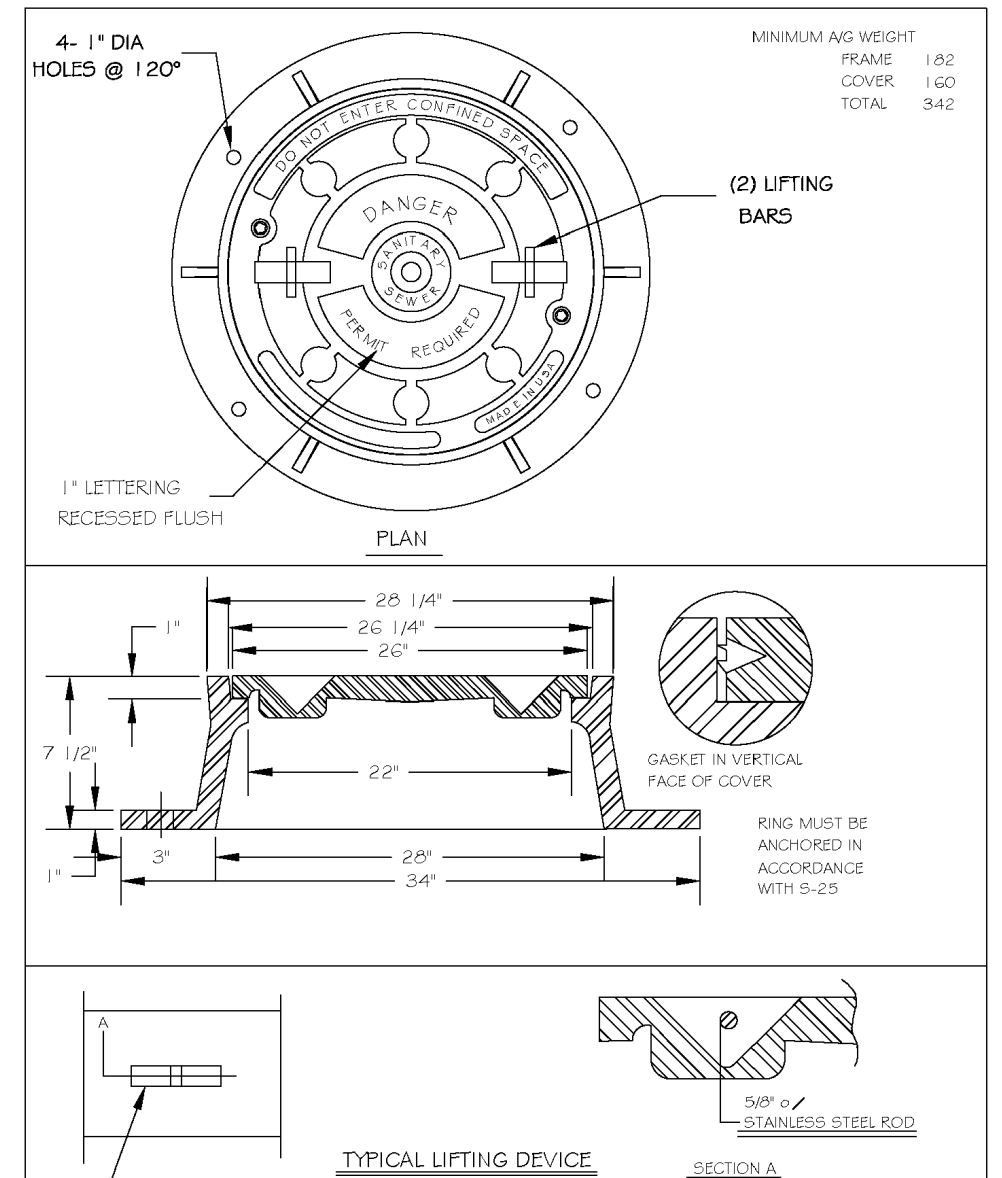


| CITY OF RALEIGH DEPARTMENT OF PUBLIC UTILITIES | | | | |
|---|-----------|---------|-----------|---------|
| MANHOLE FRAME AND WATERTIGHT COVER | | | | |
| DWG. NO. | REVISIONS | DATE | REVISIONS | DATE |
| S-26 | KRT | 3-1-07 | AKB | 2-23-05 |
| | KRT | 3-30-00 | D.H.L. | 6-18-08 |

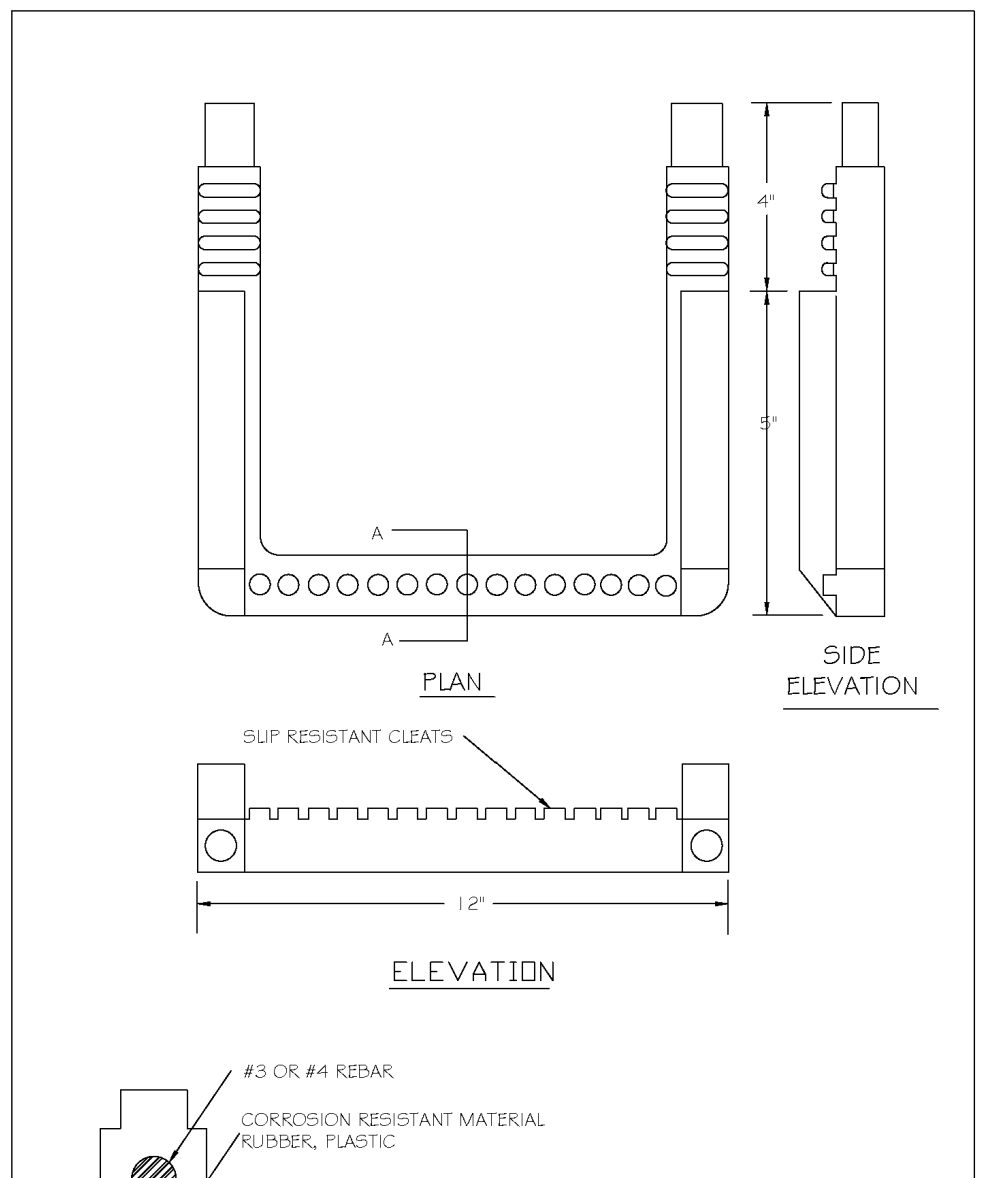


| CITY OF RALEIGH DEPARTMENT OF PUBLIC UTILITIES | | | | |
|---|-----------|---------|-----------|------|
| STANDARD SLIP RESISTANT MANHOLE STEP DETAIL | | | | |
| DWG. NO. | REVISIONS | DATE | REVISIONS | DATE |
| S-28 | KRT | 3-30-00 | | |

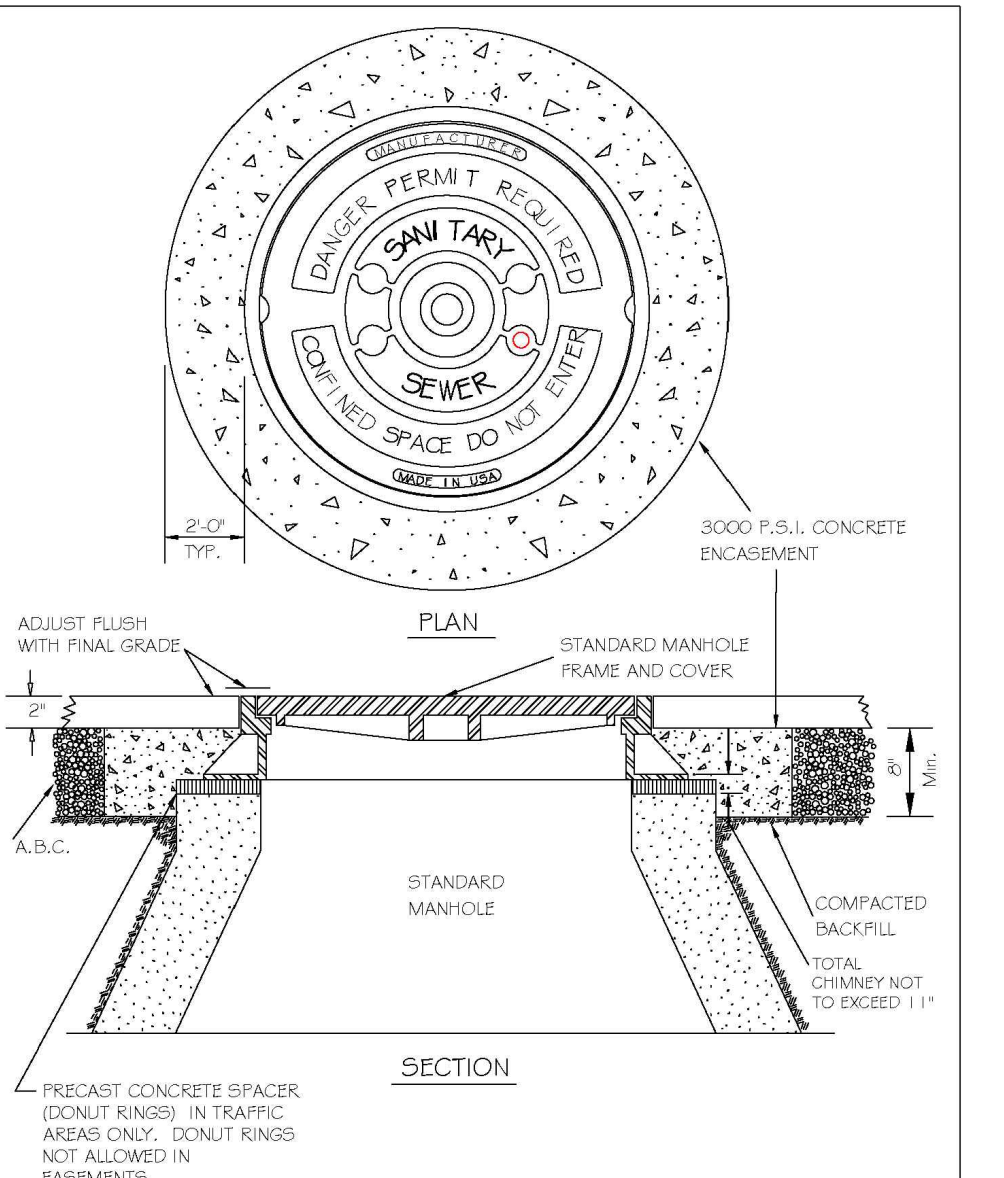


| CITY OF RALEIGH DEPARTMENT OF PUBLIC UTILITIES | | | | |
|---|-----------|---------|-----------|----------|
| STANDARD MANHOLE FRAME AND COVER DETAIL WITHIN PAVED SURFACES | | | | |
| DWG. NO. | REVISIONS | DATE | REVISIONS | DATE |
| S-29 | T.C.A. | 2-21-05 | AKB | 3-30-00 |
| | KRT | 3-30-00 | D.H.L. | 11-28-07 |

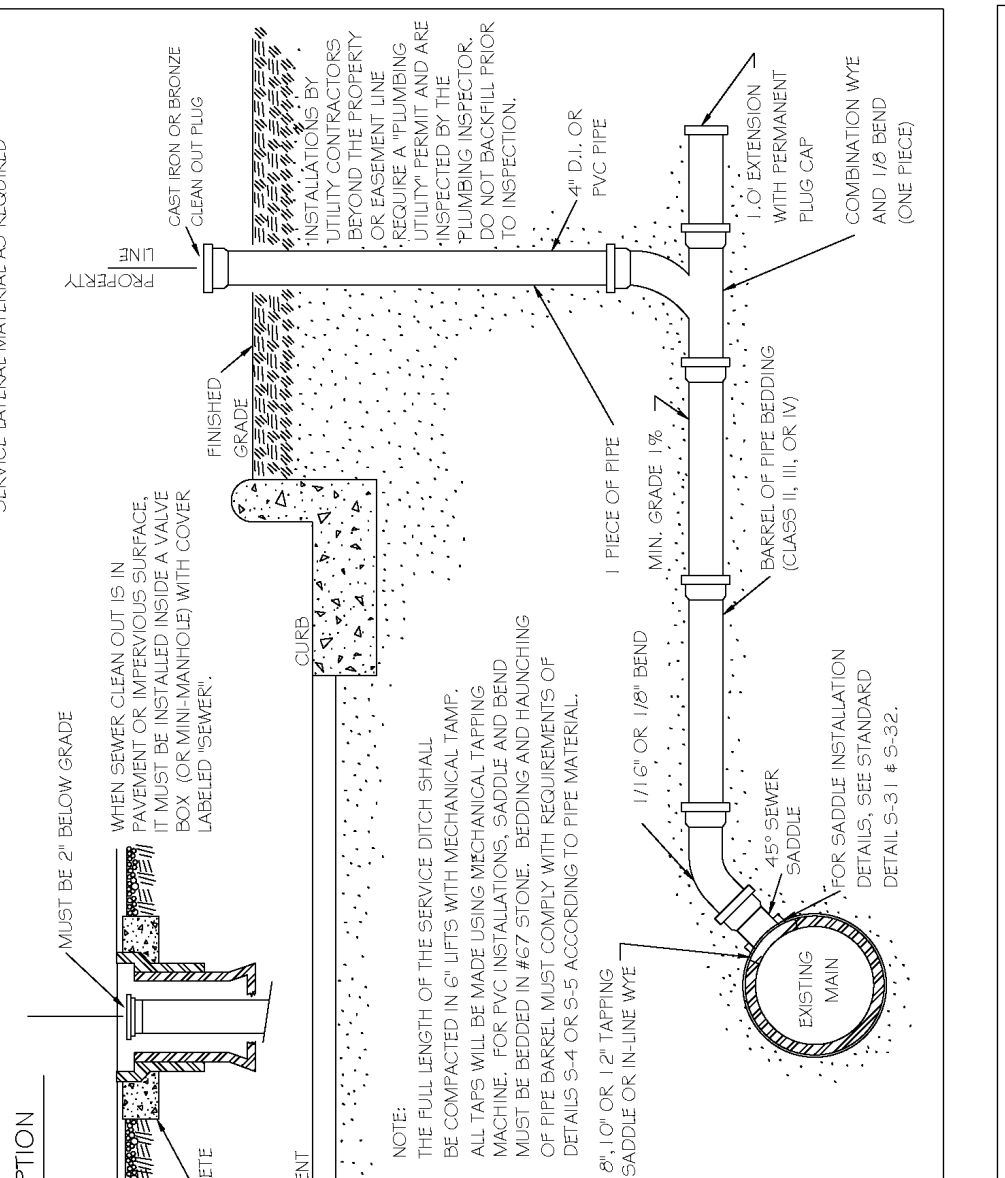

| CITY OF RALEIGH DEPARTMENT OF PUBLIC UTILITIES | | | | |
|---|-----------|---------|-----------|----------|
| TYPICAL SANITARY SEWER LATERAL CONNECTION | | | | |
| DWG. NO. | REVISIONS | DATE | REVISIONS | DATE |
| S-30 | T.C.A. | 8-30 | A.B.B. | 4-24-04 |
| | KRT | 3-30-00 | D.H.L. | 11-18-03 |

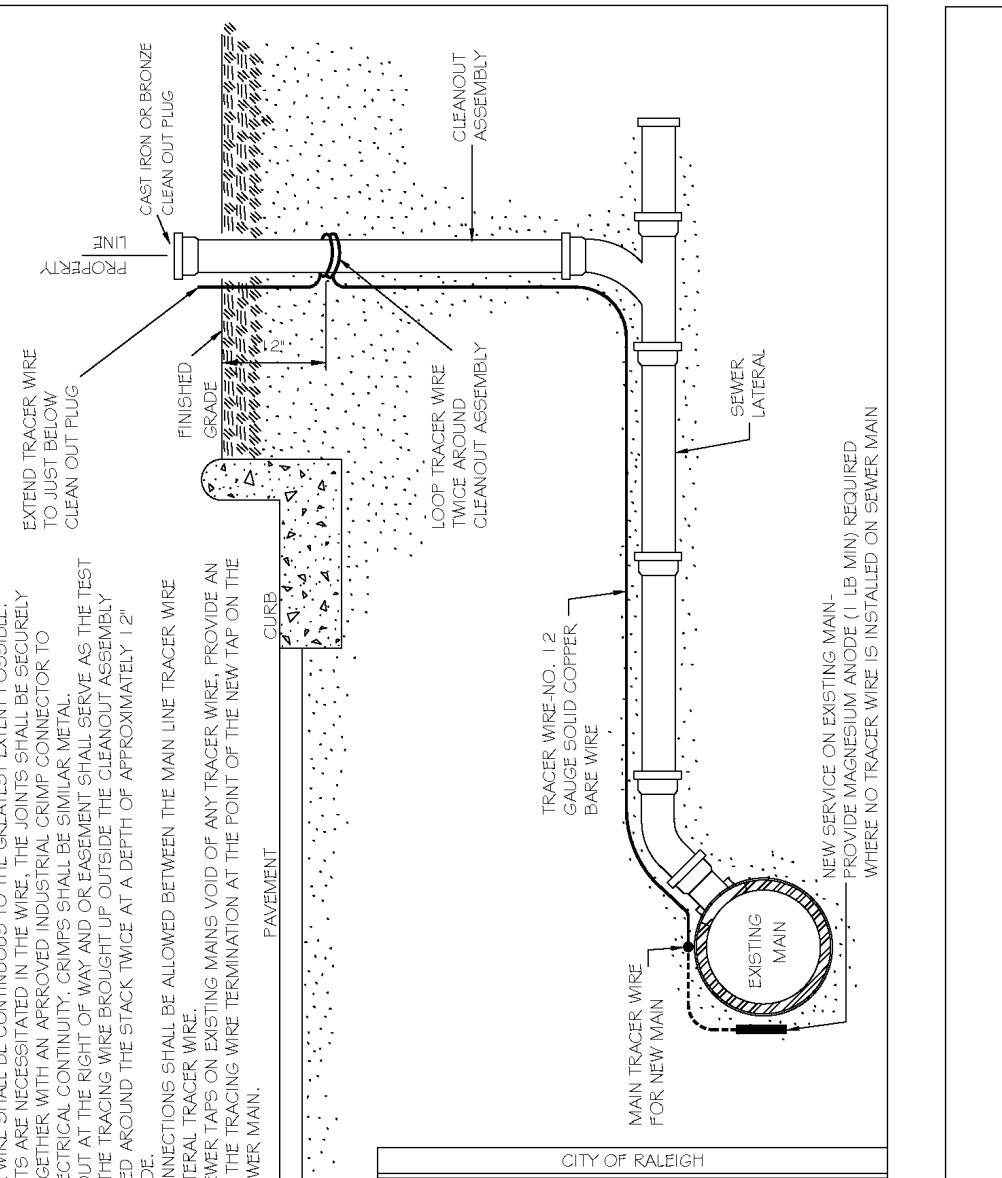


| CITY OF RALEIGH DEPARTMENT OF PUBLIC UTILITIES | | | | |
|---|-----------|---------|-----------|----------|
| TYPICAL SANITARY SEWER LATERAL CONNECTION | | | | |
| DWG. NO. | REVISIONS | DATE | REVISIONS | DATE |
| S-30A | T.C.A. | 3-14 | A.B.B. | 4-24-04 |
| | KRT | 3-30-00 | D.H.L. | 11-18-03 |

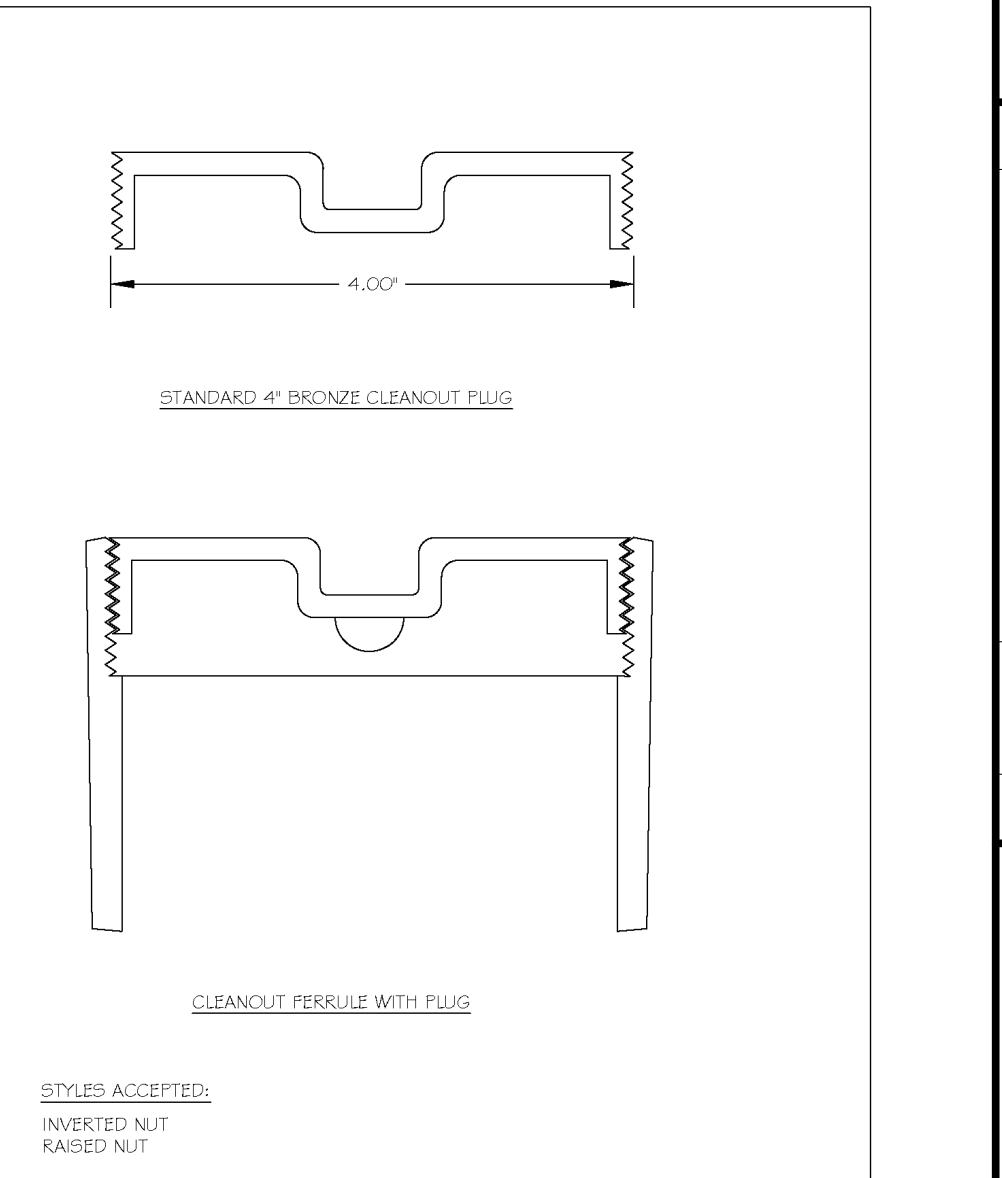


| CITY OF RALEIGH DEPARTMENT OF PUBLIC UTILITIES | | | | |
|---|-----------|---------|-----------|---------|
| 4\"/> | | | | |
| DWG. NO. | REVISIONS | DATE | REVISIONS | DATE |
| S-34 | T.W.C. | 3-27-05 | KRT | 3-30-00 |




| CITY OF RALEIGH DEPARTMENT OF PUBLIC UTILITIES | | | | |
|---|-----------|---------|-----------|------|
| CONCRETE CRADLE PROTECTION FOR SEWER LINE CROSSINGS | | | | |
| DWG. NO. | REVISIONS | DATE | REVISIONS | DATE |
| S-49 | PH | 2-20-00 | | |

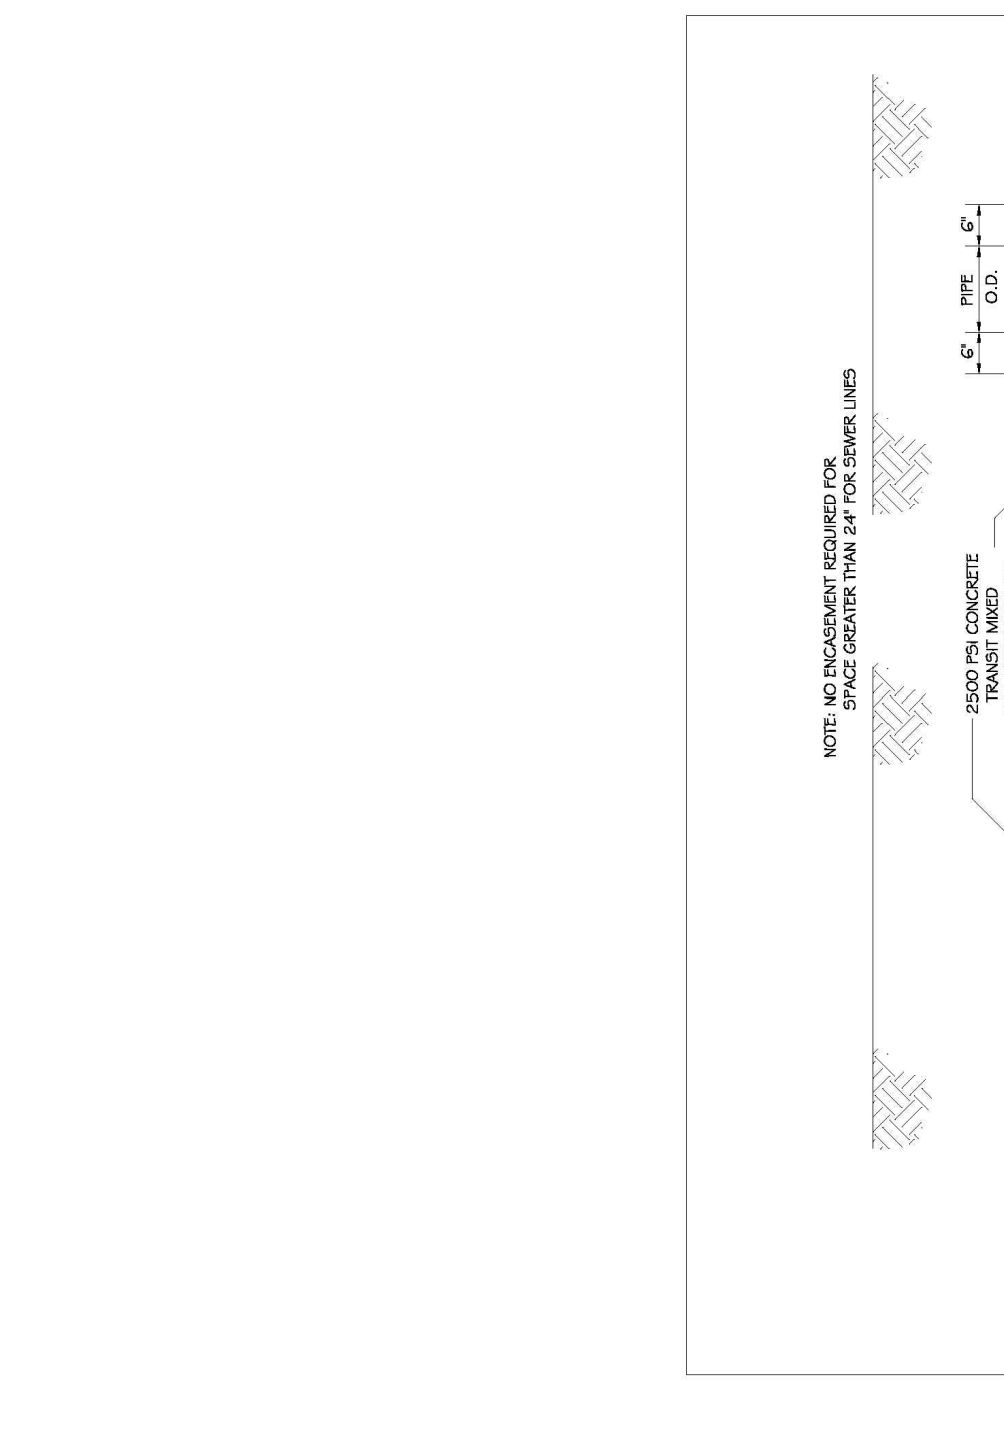


| CITY OF RALEIGH DEPARTMENT OF PUBLIC UTILITIES | | | | |
|---|-----------|---------|-----------|------|
| CONCRETE CRADLE PROTECTION FOR SEWER LINE CROSSINGS | | | | |
| DWG. NO. | REVISIONS | DATE | REVISIONS | DATE |
| S-49 | PH | 2-20-00 | | |

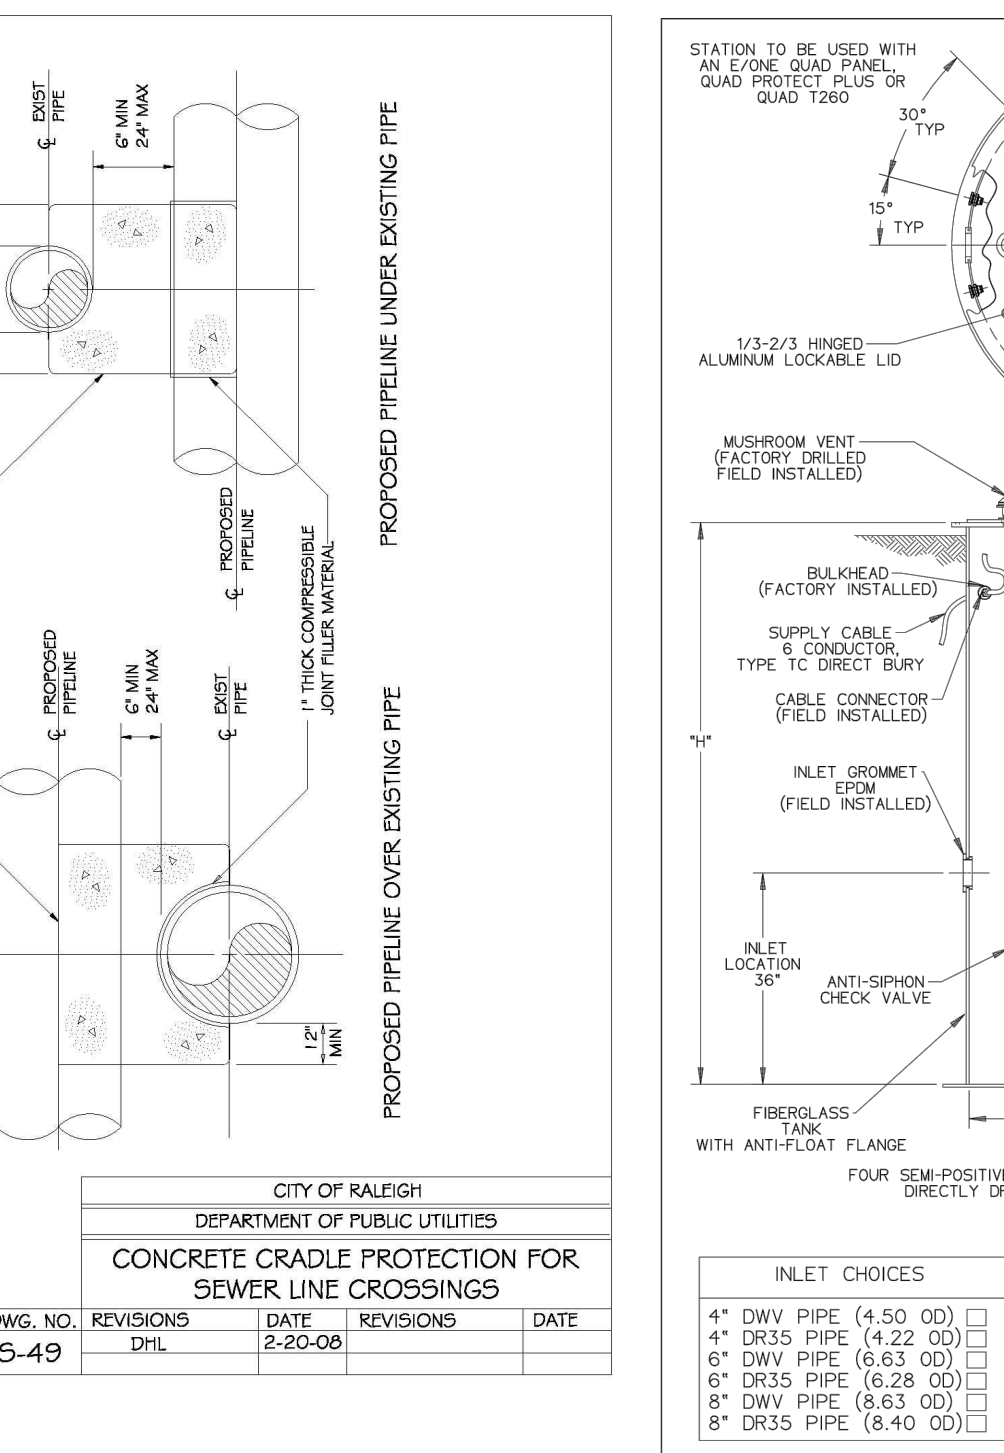


| CITY OF RALEIGH DEPARTMENT OF PUBLIC UTILITIES | | | | |
|---|-----------|---------|-----------|----------|
| QUAD MANHOLE | | | | |
| DWG. NO. | REVISIONS | DATE | REVISIONS | DATE |
| S-50 | T.C.A. | 8-30 | A.B.B. | 4-24-04 |
| | KRT | 3-30-00 | D.H.L. | 11-18-03 |

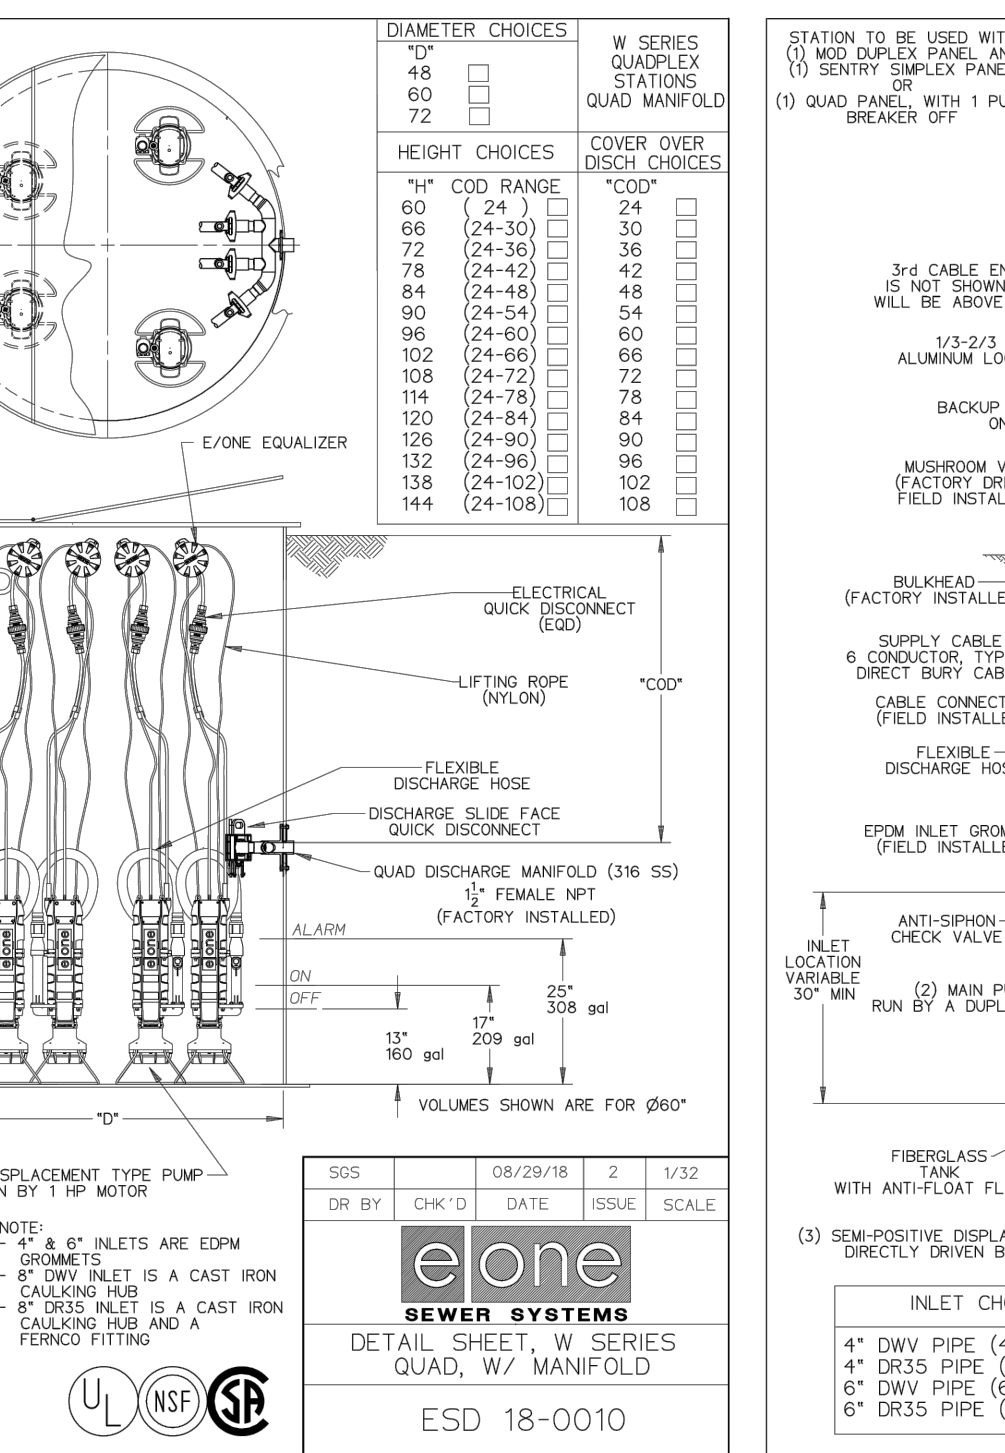

| CITY OF RALEIGH DEPARTMENT OF PUBLIC UTILITIES | | | | |
|---|-----------|---------|-----------|----------|
| QUAD MANHOLE | | | | |
| DWG. NO. | REVISIONS | DATE | REVISIONS | DATE |
| S-50 | T.C.A. | 8-30 | A.B.B. | 4-24-04 |
| | KRT | 3-30-00 | D.H.L. | 11-18-03 |

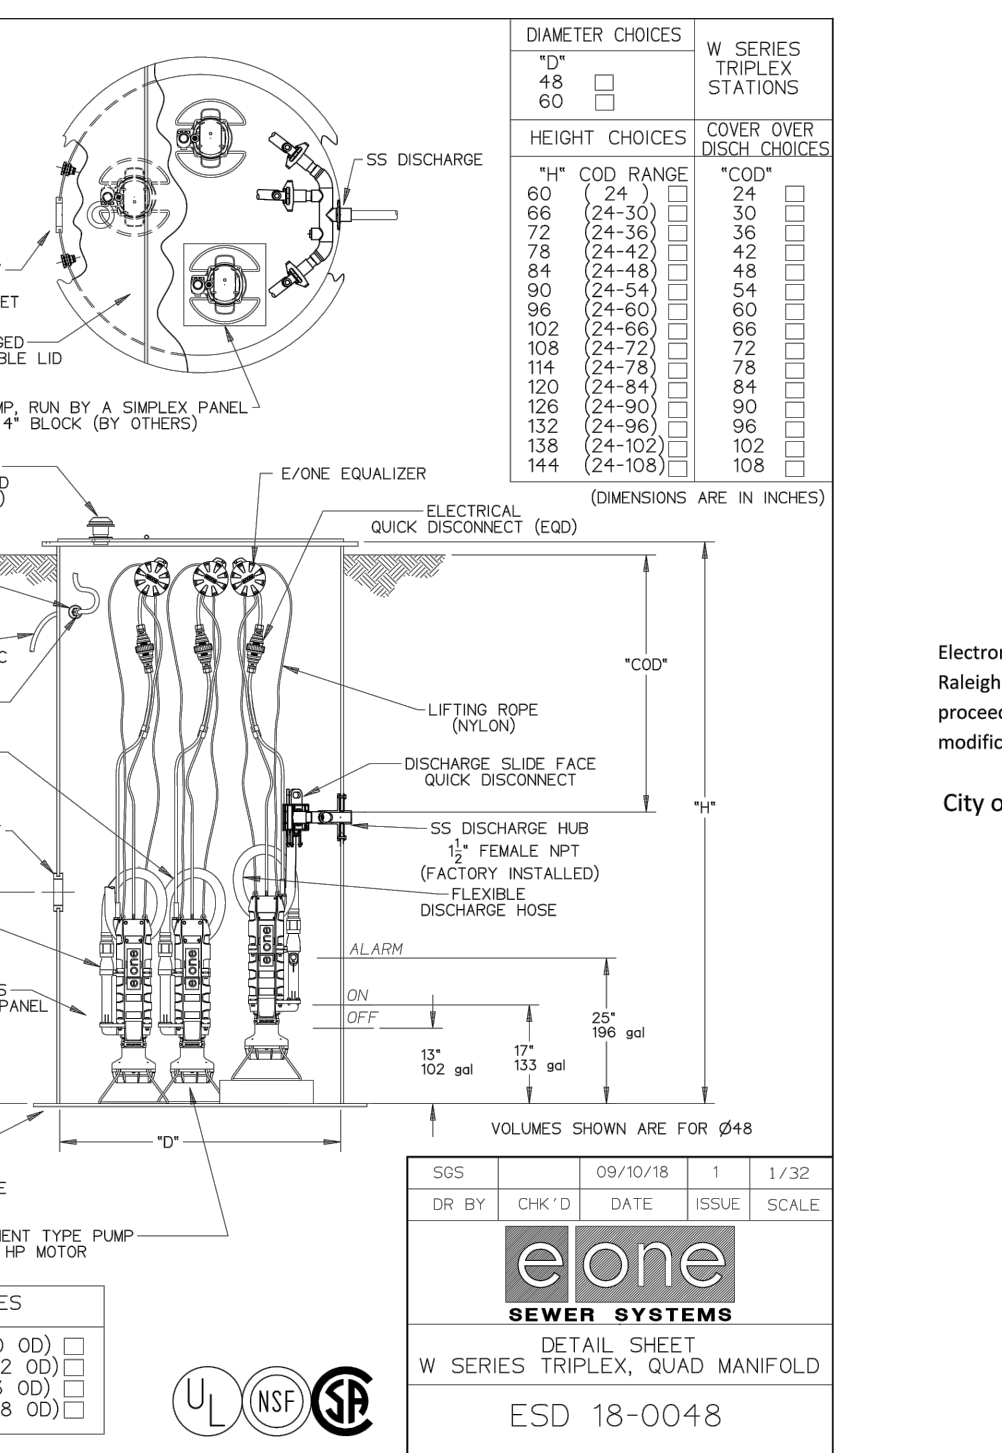

| CITY OF RALEIGH DEPARTMENT OF PUBLIC UTILITIES | | | | |
|---|-----------|---------|-----------|----------|
| QUAD MANHOLE | | | | |
| DWG. NO. | REVISIONS | DATE | REVISIONS | DATE |
| S-50 | T.C.A. | 8-30 | A.B.B. | 4-24-04 |
| | KRT | 3-30-00 | D.H.L. | 11-18-03 |

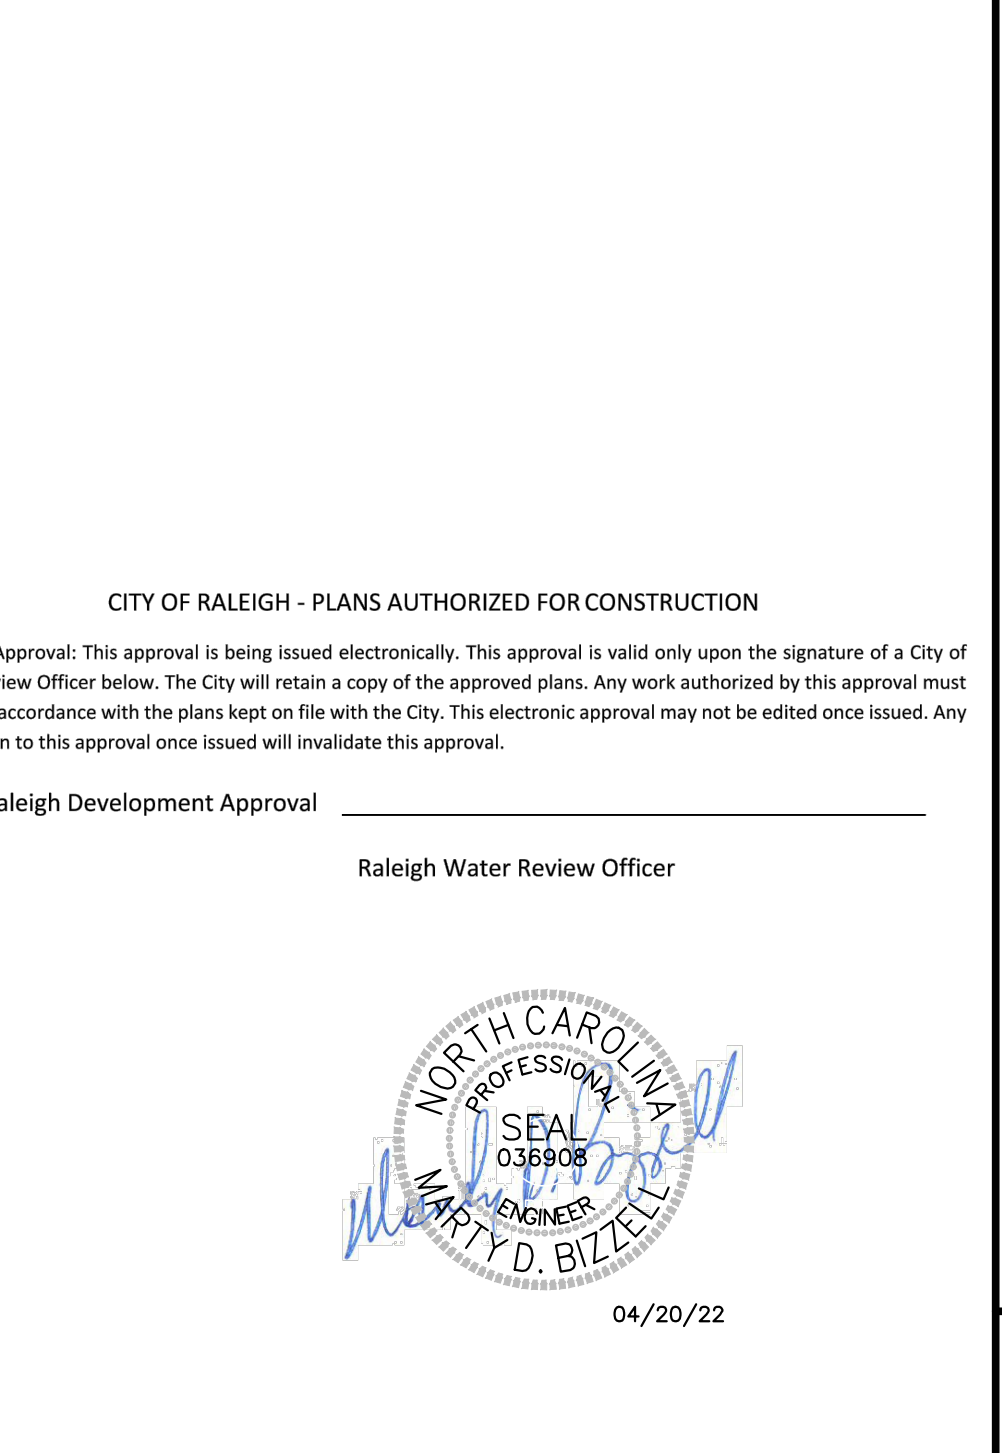

| CITY OF RALEIGH DEPARTMENT OF PUBLIC UTILITIES | | | | |
|---|-----------|---------|-----------|----------|
| QUAD MANHOLE | | | | |
| DWG. NO. | REVISIONS | DATE | REVISIONS | DATE |
| S-50 | T.C.A. | 8-30 | A.B.B. | 4-24-04 |
| | KRT | 3-30-00 | D.H.L. | 11-18-03 |

BASS, NIXON & KENNEDY, INC.
CONSULTING ENGINEERS
 6310 CHASE HILL ROAD, SUITE 250, RALEIGH, NC 27607
 TELEPHONE: (919) 871-7272 FAX: (919) 871-6886
 CERTIFICATION NUMBERS: NCBELS (C-0119); NCBOLA (C-0267)

COBBLESTONE VILLAGE MIXED USE DEVELOPMENT
 TOWN OF ROLESVILLE, WAKE COUNTY, NORTH CAROLINA

DETAILS

SCALE: N.T.S.

| NO. | DATE | DESCRIPTION | BY |
|-----|------|-------------|----|
| | | | |
| | | | |
| | | | |

MRM
 DRAWN BY
 DATE
 CHECK BY: MDB


PROGRESS
 DATE
 JOB NO.

NORTH CAROLINA
 PROFESSIONAL
 SEAL
 036908
 ENGINEER
 W. D. BIZELL

04/20/22


R:\2019\19187 - Rolesville Town Center CIVIL\04 Construction\07 - 19187_Details.dwg, CS-3, 4/20/2022 3:41:42 PM, mnc-mueller

NOT RELEASED FOR CONSTRUCTION OR BID SOLICITATION

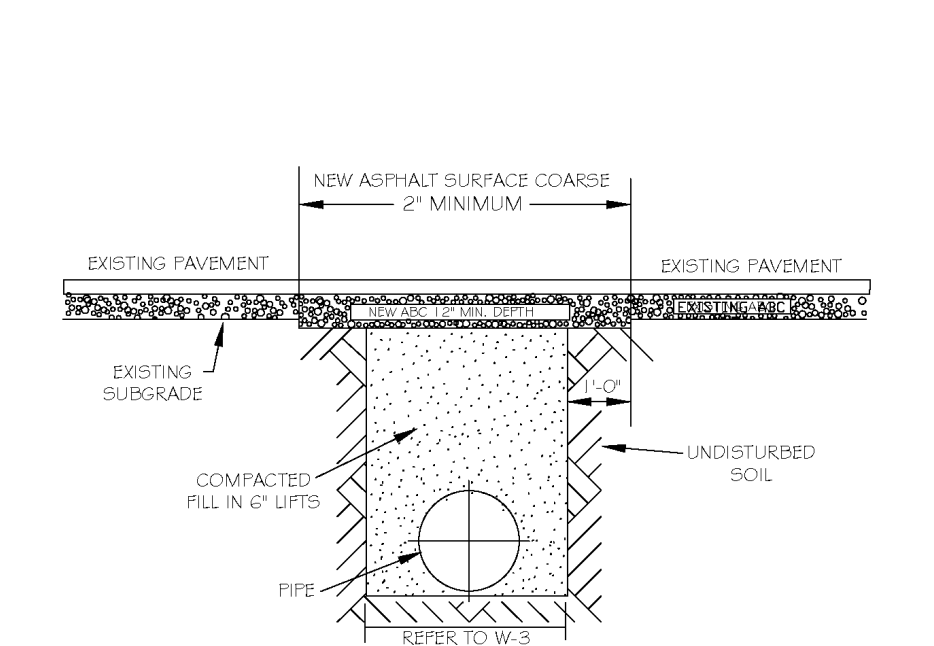


NOTES:
 1. THE PAVEMENT CUT SHALL BE DEFINED BY A STRAIGHT EDGE AND CUT WITH AN APPROPRIATE SAW CUT MACHINE.
 2. THE TRENCH SUBGRADE MATERIAL SHALL BE BACKFILLED WITH SUITABLE MATERIAL AND COMPACTED TO A DENSITY OF AT LEAST 95% OF THAT OBTAINED BY COMPACTING A SAMPLE OF THE MATERIAL IN ACCORDANCE WITH AASHTO T-99 AS MODIFIED BY NC DOT.
 3. THE FINAL 1" OF FILL SHALL CONSIST OF ABC MATERIAL COMPACTED TO A DENSITY EQUAL TO 100% OF THAT OBTAINED BY COMPACTING A SAMPLE OF THE MATERIAL IN ACCORDANCE WITH AASHTO T-99 AS MODIFIED BY NC DOT.
 4. THE ENTIRE THICKNESS VERTICAL EDGE OF CUT SHALL BE TACKED.
 5. THE SAME DEPTH OF PAVEMENT MATERIAL WHICH EXISTS SHALL BE REINSTALLED, BUT IN NO CASE SHALL THE ASPHALT BE LESS THAN 2" THICK.
 6. THE ASPHALT PAVEMENT MATERIAL SHALL BE INSTALLED AND COMPACTED THOROUGHLY WITH A SMOOTH DRUM ROLLER TO ACHIEVE A SMOOTH LEVEL PATCH.
 7. REFER TO CITY OF RALEIGH STANDARDS FOR TRENCHES AND PIPE BEDDING, W-3, FOR ADDITIONAL DETAILS.
 8. NO HAND PATCHING ALLOWED.
 9. PAVEMENT CUTS WITH NC DOT ROW SHALL CONFORM TO THE APPROVED ON SITE ENCROACHMENT PERMIT.

| CITY OF RALEIGH DEPARTMENT OF PUBLIC UTILITIES | | | | | |
|---|-----------|---------|-----------|----------|--|
| STANDARD ASPHALT PAVEMENT PATCH DETAIL | | | | | |
| DWG. NO. | REVISIONS | DATE | REVISIONS | DATE | |
| W-2 | KRH | 3-31-00 | A.S.B. | 4-16-04 | |
| | D.W.C. | 11-1-89 | J.P.S. | 10-29-10 | |

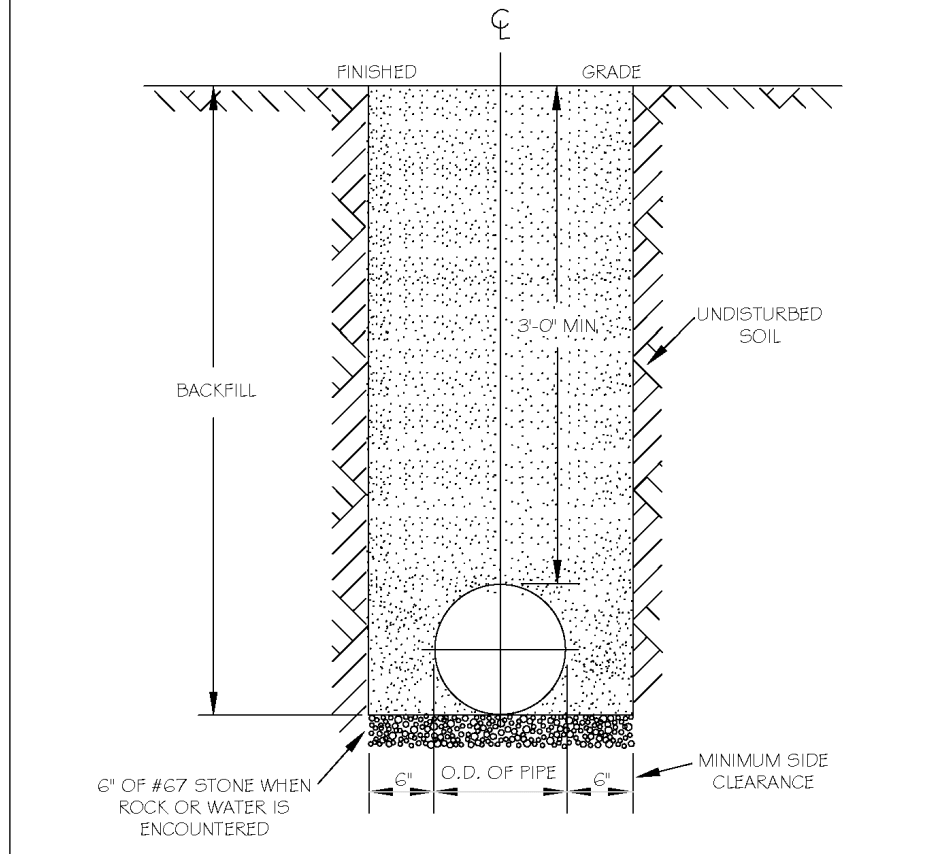


NOTES:
 1. TRENCHES REQUIRING SHORING AND BRACING, DIMENSIONS SHALL BE TAKEN FROM THE INSIDE FACE OF THE SHORING AND BRACING.
 2. NO ROCKS OR BouldERS 4" OR LARGER TO BE USED IN BACKFILL.
 3. ALL BACKFILL MATERIAL SHALL BE SUITABLE NATIVE MATERIAL.
 4. BACKFILL SHALL BE TAMPED IN 6" LIFTS.
 5. ACHIEVE 95% COMPACTION IN BACKFILL.

| CITY OF RALEIGH DEPARTMENT OF PUBLIC UTILITIES | | | | | |
|---|-----------|---------|-----------|----------|--|
| TRENCH BOTTOM DIMENSIONS & BACKFILL REQUIREMENTS FOR DUCTILE IRON | | | | | |
| DWG. NO. | REVISIONS | DATE | REVISIONS | DATE | |
| W-3 | KRH | 3-31-00 | ABR | 2-15-09 | |
| | D.W.C. | 3-31-00 | J.P.S. | 10-29-10 | |

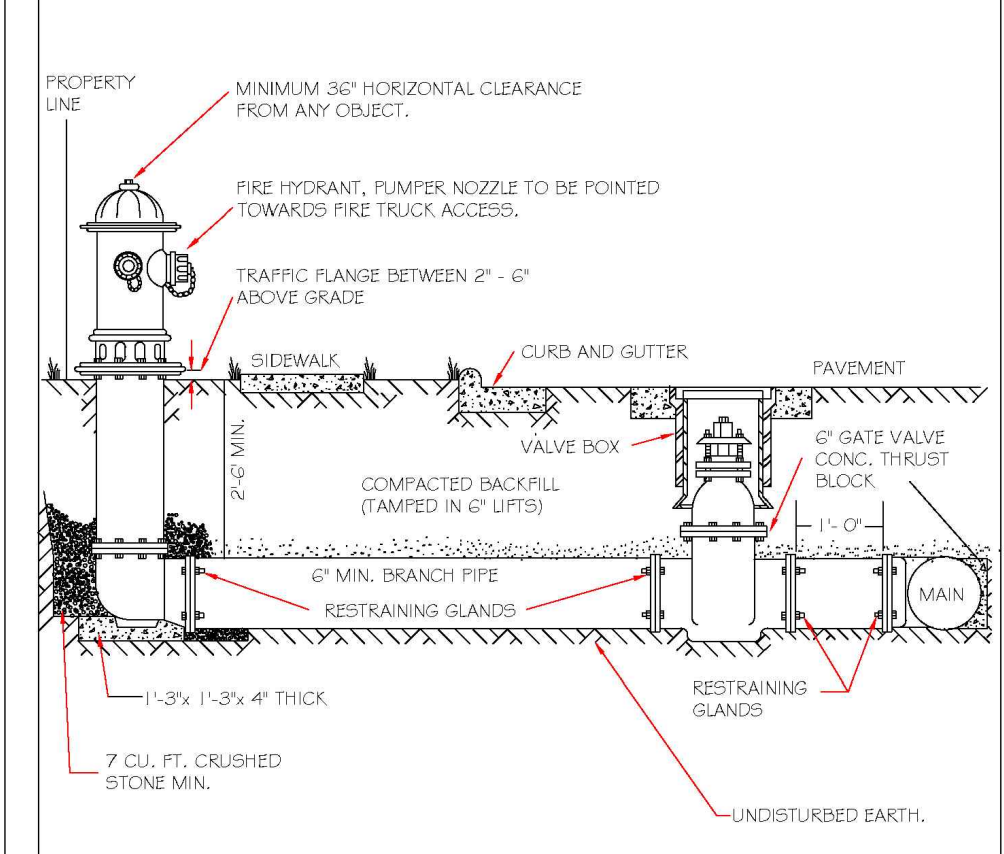


NOTES:
 1. FIRE HYDRANT SHALL BE AS MANUFACTURED: MUELLER, AMERICAN DARLING, KENNEDY, MHI, WATERLOUS, GLOW, EAST JORDAN IRON WORKS, OR US PIPE.
 2. BRANCH PIPE SHALL BE DUCTILE IRON ANMA C150-80.
 3. 6" GATE VALVE SHALL BE ANMA C200-80 OPEN LEFT.
 4. STEEL RODS AND BOLTS SHALL BE #4 HOT DIPPED GALVANIZED.
 5. FIRE HYDRANTS WILL BE INSTALLED IN TRUE VERTICAL POSITION.
 6. ROSS SHALL NOT BE COUPLED MORE THAN ONCE. IF THE LENGTH FROM THE VALVE TO THE HYDRANT EXCEEDS 20' THEN A MECHANICAL RESTRAINING GLAND WITH A REBAR CASE SHALL BE INSTALLED NO MORE THAN 10' FROM HYDRANT AND POURED IN CONCRETE.
 7. FIRE HYDRANTS TO BE LOCATED IN ROW OR 2 FOOT EASEMENT ADJACENT TO ROW.
 8. FIRE HYDRANTS TO BE LOCATED IN ROW OR 2 FOOT EASEMENT ADJACENT TO ROW.

| CITY OF RALEIGH DEPARTMENT OF PUBLIC UTILITIES | | | | | |
|---|-----------|---------|-----------|----------|--|
| STANDARD FIRE HYDRANT INSTALLATION DETAIL | | | | | |
| DWG. NO. | REVISIONS | DATE | REVISIONS | DATE | |
| W-4 | ABB | 4-6-04 | FW | 2-17-09 | |
| | D.W.C. | 2-17-09 | J.P.S. | 10-29-10 | |

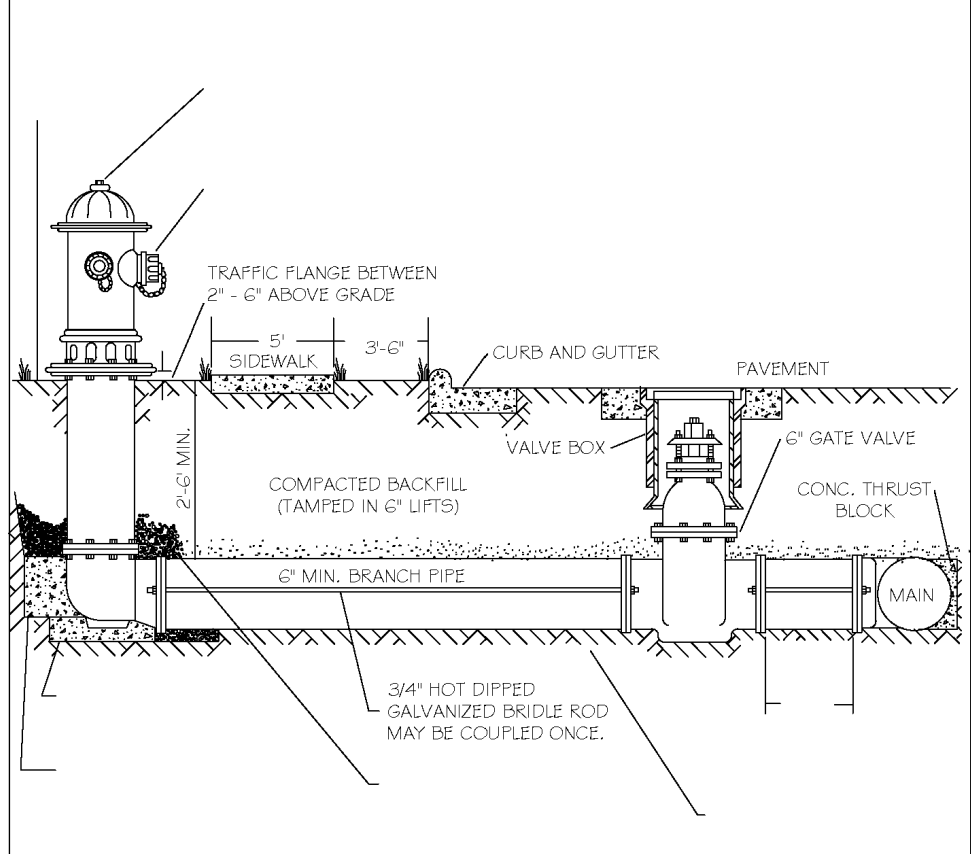



NOTES:
 1. FIRE HYDRANT SHALL BE AS MANUFACTURED: MUELLER, AMERICAN DARLING, KENNEDY, MHI, WATERLOUS, GLOW, EAST JORDAN IRON WORKS, OR US PIPE.
 2. BRANCH PIPE SHALL BE DUCTILE IRON ANMA C150-80.
 3. 6" GATE VALVE SHALL BE ANMA C200-80 OPEN LEFT.
 4. STEEL RODS AND BOLTS SHALL BE #4 HOT DIPPED GALVANIZED.
 5. FIRE HYDRANTS WILL BE INSTALLED IN TRUE VERTICAL POSITION.
 6. ROSS SHALL NOT BE COUPLED MORE THAN ONCE. IF THE LENGTH FROM THE VALVE TO THE HYDRANT EXCEEDS 20' THEN A MECHANICAL RESTRAINING GLAND WITH A REBAR CASE SHALL BE INSTALLED NO MORE THAN 10' FROM HYDRANT AND POURED IN CONCRETE.
 7. FIRE HYDRANTS TO BE LOCATED IN ROW OR 2 FOOT EASEMENT ADJACENT TO ROW.
 8. FIRE HYDRANTS TO BE LOCATED IN ROW OR 2 FOOT EASEMENT ADJACENT TO ROW.

| CITY OF RALEIGH DEPARTMENT OF PUBLIC UTILITIES | | | | | |
|--|-----------|--------|-----------|------|--|
| STANDARD FIRE HYDRANT WITH 5" STANDARD PUMP NOZZLE | | | | | |
| DWG. NO. | REVISIONS | DATE | REVISIONS | DATE | |
| W-4-0 | ABB | 4-6-04 | | | |

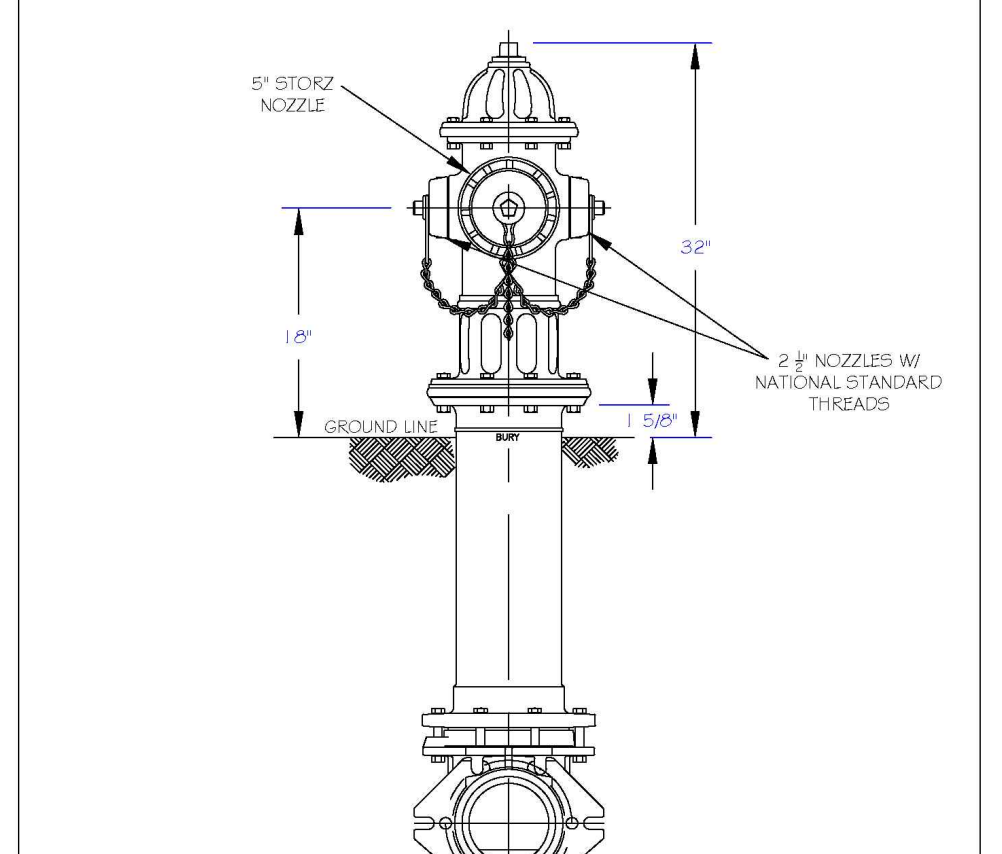


NOTES:
 1. RALEIGH PUBLIC HYDRANTS SHALL BE PAINTED SOLID RED.
 2. KNIGHTDALE, 4 ROLESVILLE PUBLIC HYDRANTS SHALL BE PAINTED RED W/SILVER OPERATING NUTS.
 3. ZIEGLER PUBLIC HYDRANTS SHALL BE PAINTED RED W/SILVER BONNETS AND OPERATING NUTS.
 4. WAKE FOREST AND GARNER, AND WENDELL PUBLIC AND PRIVATE HYDRANTS TO BE PAINTED SAFETY YELLOW W/SILVER CAPS AND OPERATING NUTS.
 5. OPERATING NUTS ON HYDRANTS CONNECTED TO PUBLIC MAINS LARGER THAN 1/2" SHALL BE PAINTED BLACK.

| CITY OF RALEIGH DEPARTMENT OF PUBLIC UTILITIES | | | | | |
|--|-----------|---------|-----------|---------|--|
| STANDARD FIRE HYDRANT WITH 5" STANDARD PUMP NOZZLE | | | | | |
| DWG. NO. | REVISIONS | DATE | REVISIONS | DATE | |
| W-5 | KRH | 3-1-07 | ABR | 2-21-09 | |
| | D.W.C. | 3-31-00 | DHL | 2-18-09 | |

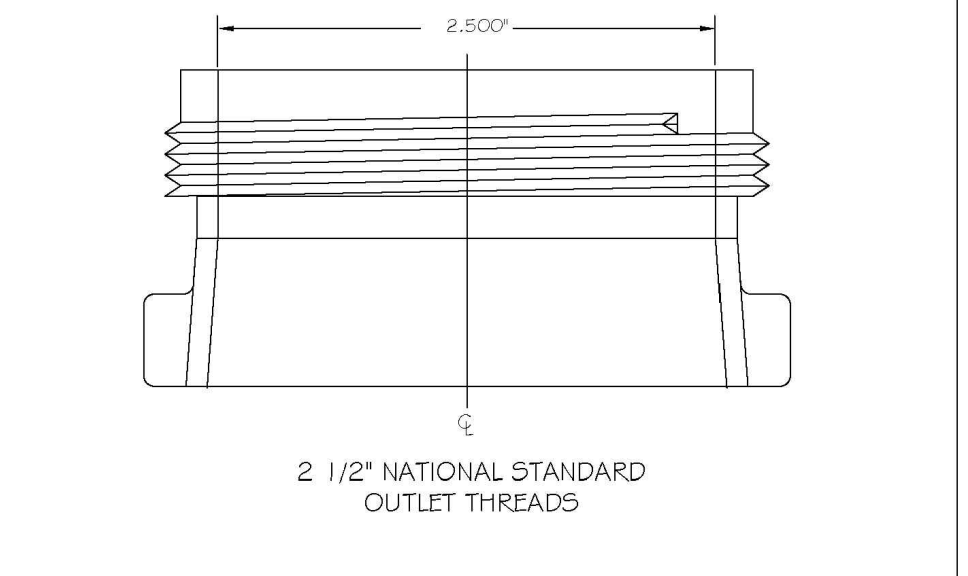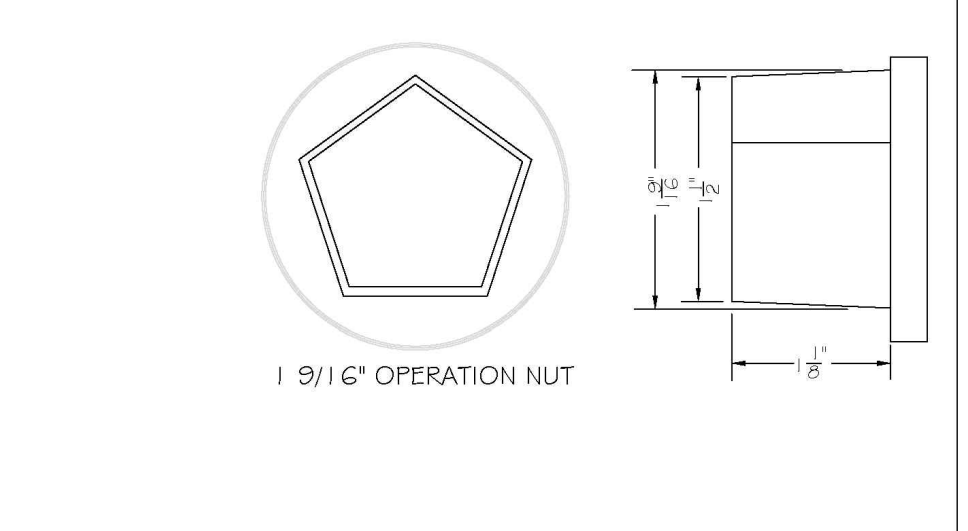


| CITY OF RALEIGH DEPARTMENT OF PUBLIC UTILITIES | | | | | |
|---|-----------|---------|-----------|----------|--|
| HYDRANT OPERATING NUT AND 2 1/2" NATIONAL STANDARD OUTLET THREADS | | | | | |
| DWG. NO. | REVISIONS | DATE | REVISIONS | DATE | |
| W-6 | KRH | 3-31-00 | DHL | 2-18-09 | |
| | A.S.B. | 4-13-04 | J.P.S. | 11-11-10 | |

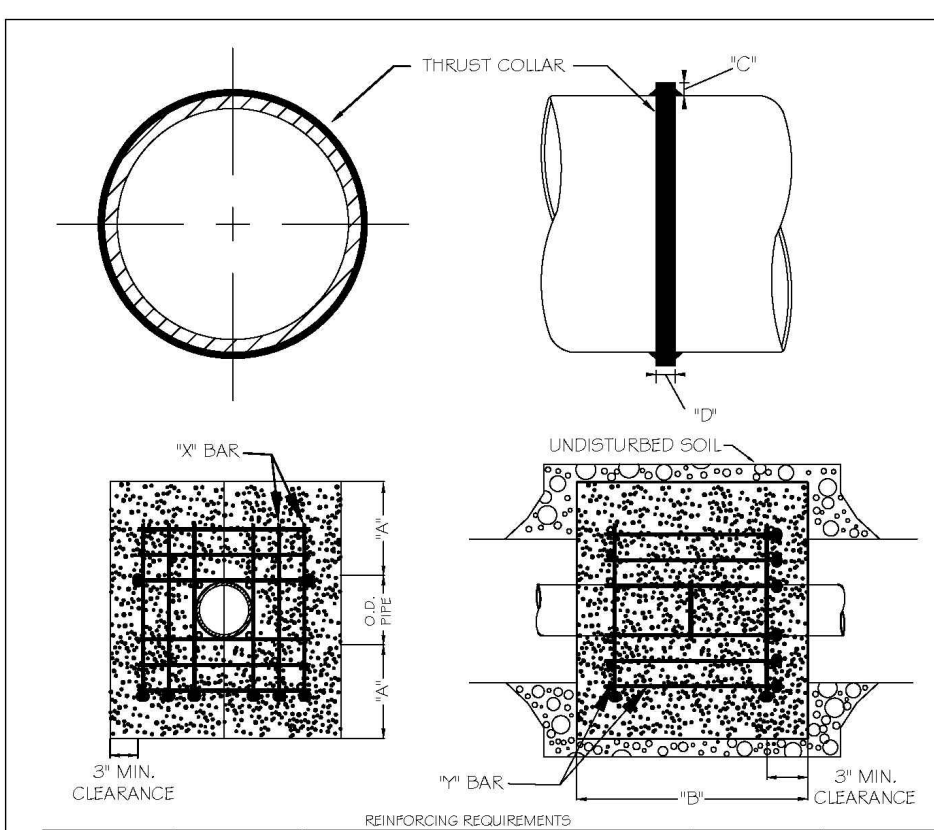


| CITY OF RALEIGH DEPARTMENT OF PUBLIC UTILITIES | | | | | |
|---|-----------|----------|-----------|----------|--|
| STANDARD THRUST BLOCK INSTALLATION FOR 16" AND LARGER VALVES AND DEAD END MAINS | | | | | |
| DWG. NO. | REVISIONS | DATE | REVISIONS | DATE | |
| W-7 | KRH | 3-1-00 | J.P.S. | 11-11-10 | |
| | D.W.C. | 11-12-03 | | | |

NOTES:
 1. SEE STANDARD DETAIL W-9 FOR THRUST BLOCK LOCATIONS.
 2. CONCRETE SHALL BE 3000 PSI AND RANSIT MAND.
 3. REINFORCING BARS SHALL BE DROPPED AND TIED TOGETHER.
 4. TRENCH BOTTOM WIDTH IN VICINITY OF THRUST BLOCK INSTALLATION SHALL BE THE MINIMUM WIDTH AS SHOWN ON STANDARD DETAIL W-3.
 5. BACKFILL TAMPED IN 6" LIFTS PER STANDARD DETAIL W-3.
 6. THRUST COLLARS MUST BE FACTORY WELDED ON BOTH SIDES ALONG BOTH EDGES OF COLLAR AND AROUND CIRCUMFERENCE.

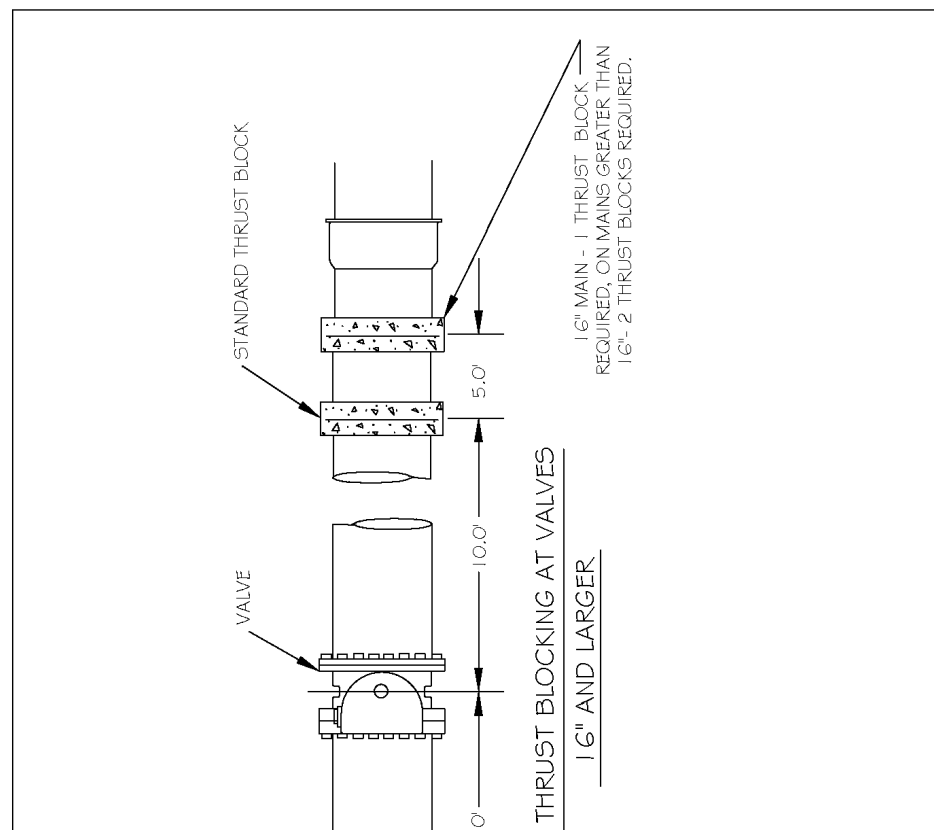


| CITY OF RALEIGH DEPARTMENT OF PUBLIC UTILITIES | | | | | |
|---|-----------|---------|-----------|---------|--|
| THRUST BLOCKING DESIGN DATA FOR WATER MAINS | | | | | |
| DWG. NO. | REVISIONS | DATE | REVISIONS | DATE | |
| W-8 | T.G.A. | 4-29-02 | KRH | 3-31-00 | |

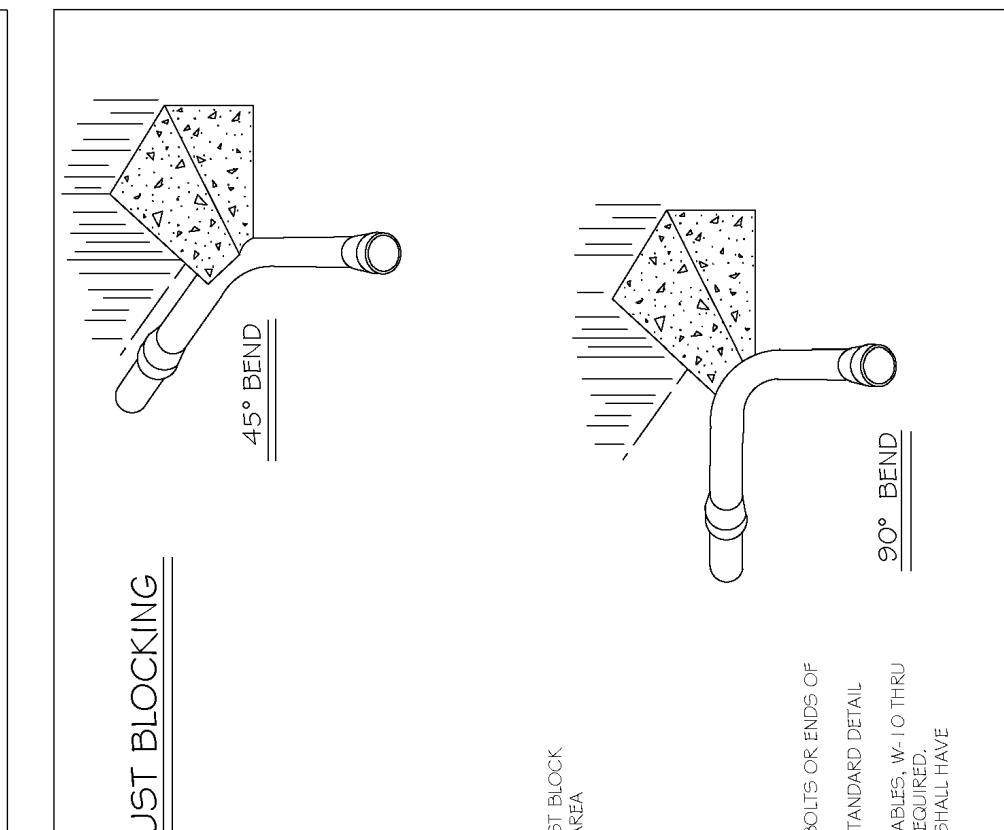

| CITY OF RALEIGH DEPARTMENT OF PUBLIC UTILITIES | | | | | |
|---|-----------|--------|-----------|---------|--|
| STANDARD THRUST BLOCKING VIEWS | | | | | |
| DWG. NO. | REVISIONS | DATE | REVISIONS | DATE | |
| W-9 | D.W.C. | 3-7-99 | D.L.L. | 6-18-08 | |

| CITY OF RALEIGH DEPARTMENT OF PUBLIC UTILITIES | | | | | |
|---|-----------|---------|-----------|------|--|
| THRUST BLOCKING DESIGN QUANTITY TABLE | | | | | |
| DWG. NO. | REVISIONS | DATE | REVISIONS | DATE | |
| W-10 | D.W.C. | 8-23-99 | | | |

| CITY OF RALEIGH DEPARTMENT OF PUBLIC UTILITIES | | | | | |
|---|-----------|---------|-----------|------|--|
| THRUST BLOCKING DESIGN QUANTITY TABLE | | | | | |
| DWG. NO. | REVISIONS | DATE | REVISIONS | DATE | |
| W-11 | D.W.C. | 8-23-99 | | | |

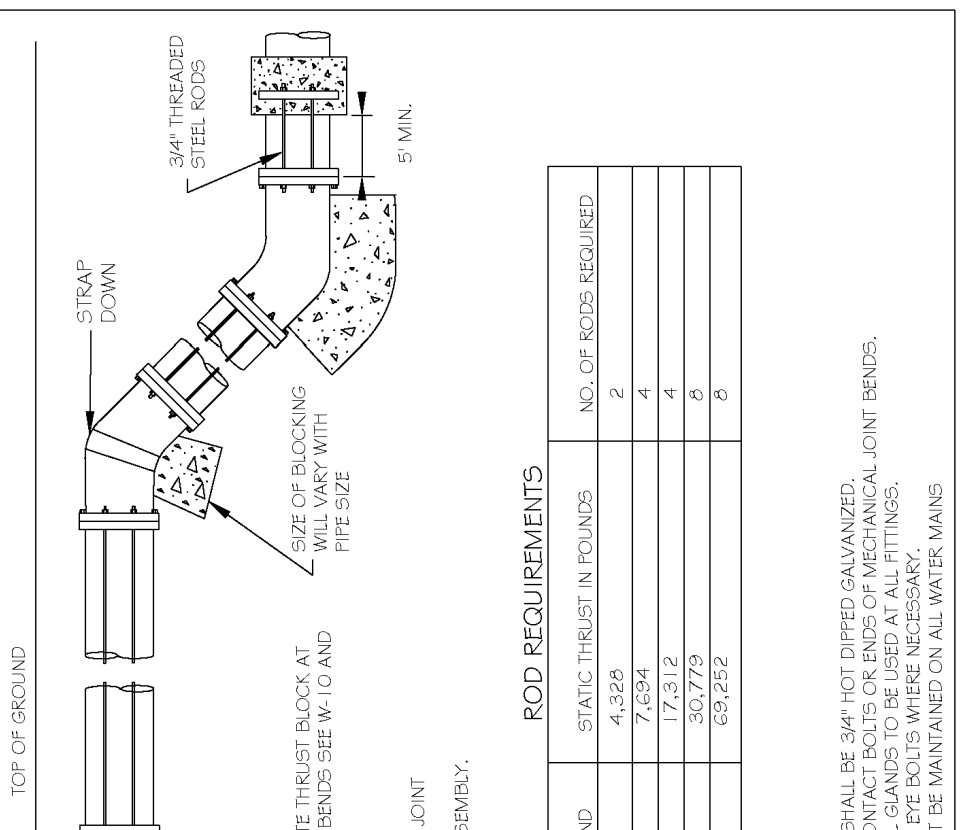

| CITY OF RALEIGH DEPARTMENT OF PUBLIC UTILITIES | | | | | |
|---|-----------|--------|-----------|----------|--|
| STANDARD VERTICAL BEND | | | | | |
| DWG. NO. | REVISIONS | DATE | REVISIONS | DATE | |
| W-12 | KRH | 6-6-04 | D.H.L. | 11-11-10 | |




| CITY OF RALEIGH DEPARTMENT OF PUBLIC UTILITIES | | | | | |
|--|-----------|---------|-----------|----------|--|
| STANDARD MAIN 4 VALVE MARKERS FOR POTABLE & REUSE WATER IN EASEMENTS | | | | | |
| DWG. NO. | REVISIONS | DATE | REVISIONS | DATE | |
| W-13 | KRH | 3-31-00 | J.P.S. | 11-11-10 | |


NOTES:
 1. POTABLE WATER MARKER TO BE BLUE IN COLOR.
 2. POTABLE WATER MARKER TO BE LABELED "RALEIGH WATER".
 3. TO BE SPACED ALONG CENTERLINE OF MAIN EVERY 300 FEET.
 4. MARKERS TO BE ROUND AND 4" IN DIAMETER.




| CITY OF RALEIGH DEPARTMENT OF PUBLIC UTILITIES | | | | | |
|---|-----------|---------|-----------|----------|--|
| 4" - 24" STANDARD TAPPING SLEEVE AND VALVE ASSEMBLY | | | | | |
| DWG. NO. | REVISIONS | DATE | REVISIONS | DATE | |
| W-14 | Y.C.A. | 2-31-91 | KRH | 3-31-00 | |
| | D.W.C. | 9-7-99 | J.P.S. | 11-11-10 | |

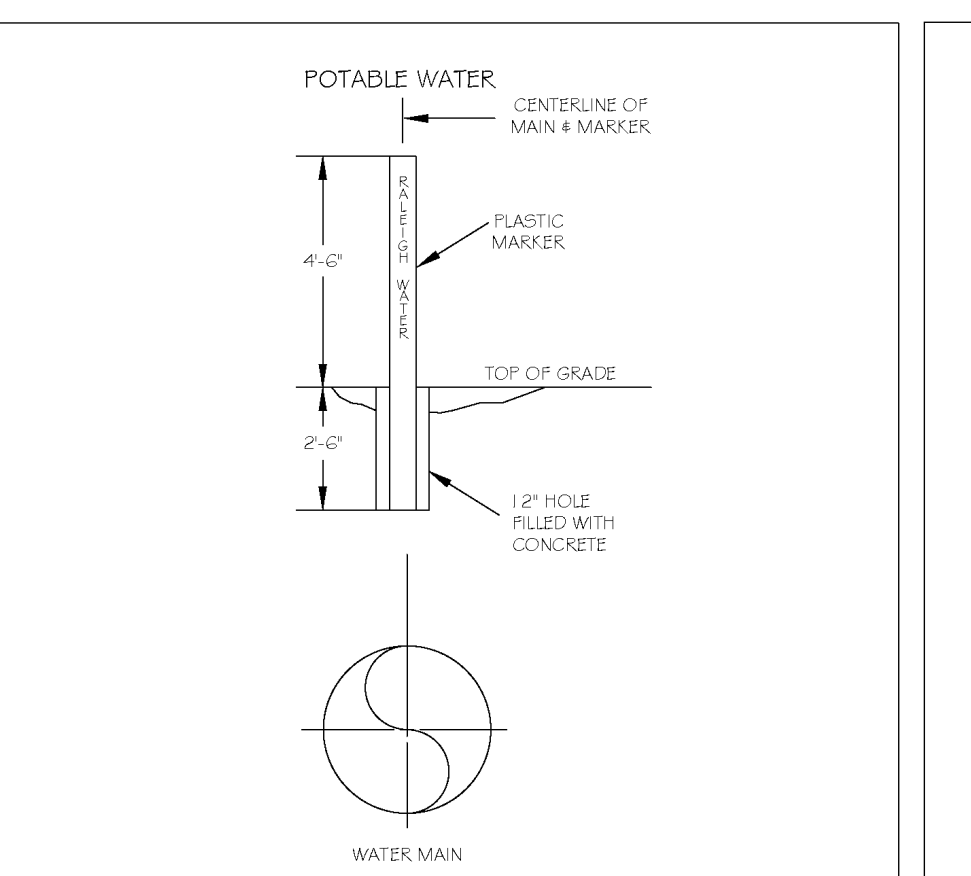

NOTES:
 1. CONCRETE SHALL NOT CONTACT BOLTS OR ENDS OF MECHANICAL JOINT FITTINGS.
 2. USE STANDARD REACTION BLOCK TABLES, W-10 AND W-11 FOR AREA OF CONCRETE REQUIRED.

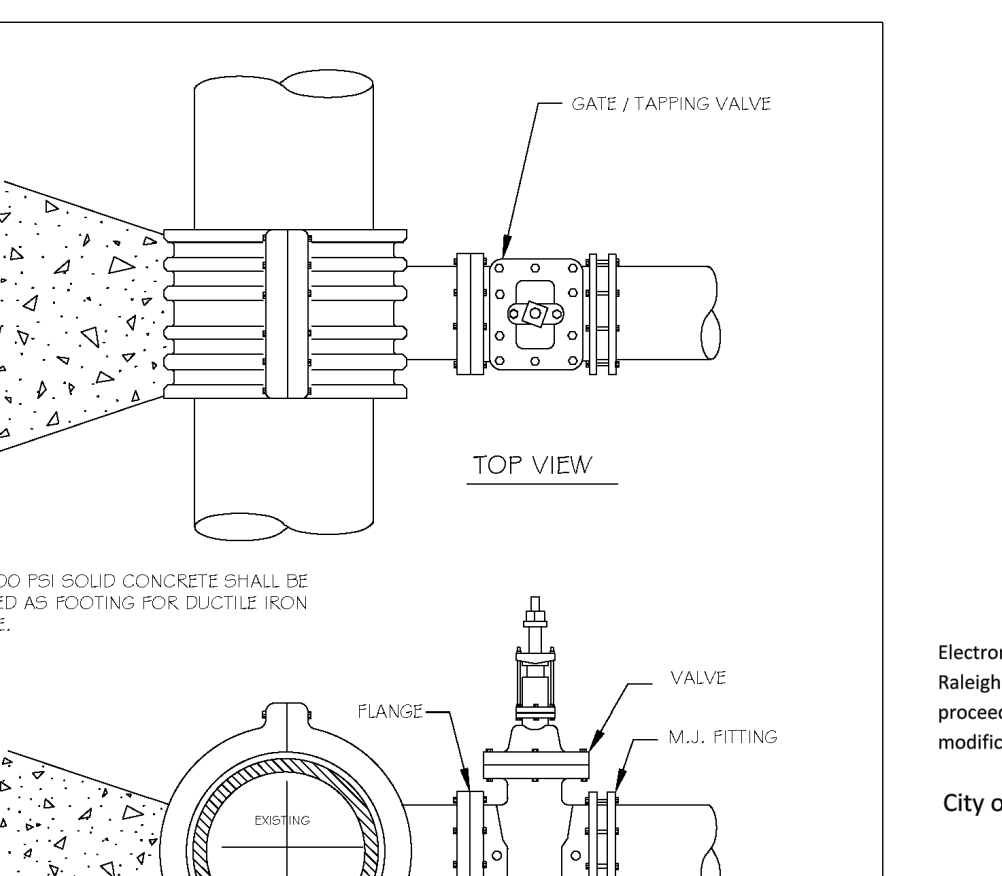

NOTES:
 1. CONCRETE SHALL NOT CONTACT BOLTS OR ENDS OF MECHANICAL JOINT FITTINGS.
 2. USE STANDARD REACTION BLOCK TABLES, W-10 AND W-11 FOR AREA OF CONCRETE REQUIRED.

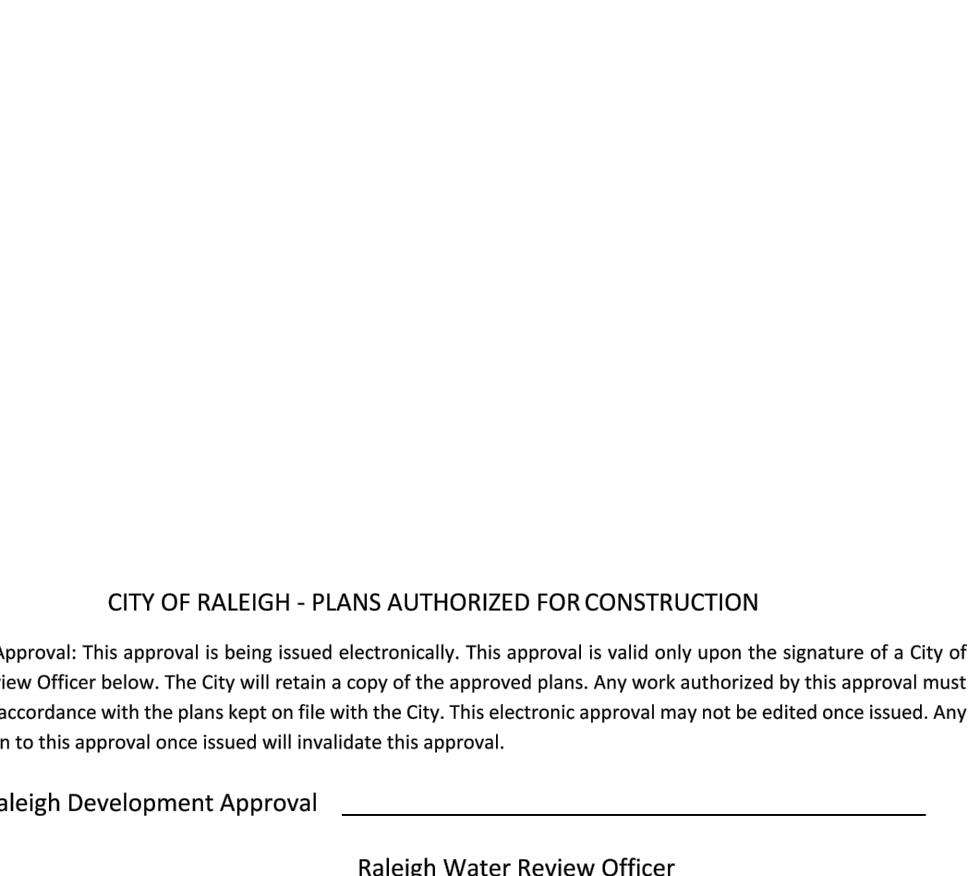

NOTES:
 1. CONCRETE SHALL NOT CONTACT BOLTS OR ENDS OF MECHANICAL JOINT FITTINGS.
 2. USE STANDARD REACTION BLOCK TABLES, W-10 AND W-11 FOR AREA OF CONCRETE REQUIRED.

BASS, NIXON & KENNEDY, INC.
CONSULTING ENGINEERS
 6810 CHAPEL HILL ROAD, SUITE 250, RALEIGH, NC 27607
 TELEPHONE: (919)851-1122 FAX: (919)851-8686
 CERTIFICATION NUMBERS: NCBELS (C-0110); NCBOLA (C-0267)

| NO. | DATE | DESCRIPTION | BY |
|-----|------|-------------|----|
| | | | |
| | | | |











COBBLESTONE VILLAGE MIXED USE DEVELOPMENT
 TOWN OF ROLESVILLE, WAKE COUNTY, NORTH CAROLINA

PROGRESS DRAWN BY
 DATE: 03-19-17
 JOB NO. 19157

DETAILS
 SCALE: N.T.S.
 CHK BY: MDB

PROFESSIONAL SEAL
 NORTH CAROLINA
 MARY D. BIZELL
 ENGINEER
 036908

04/20/22

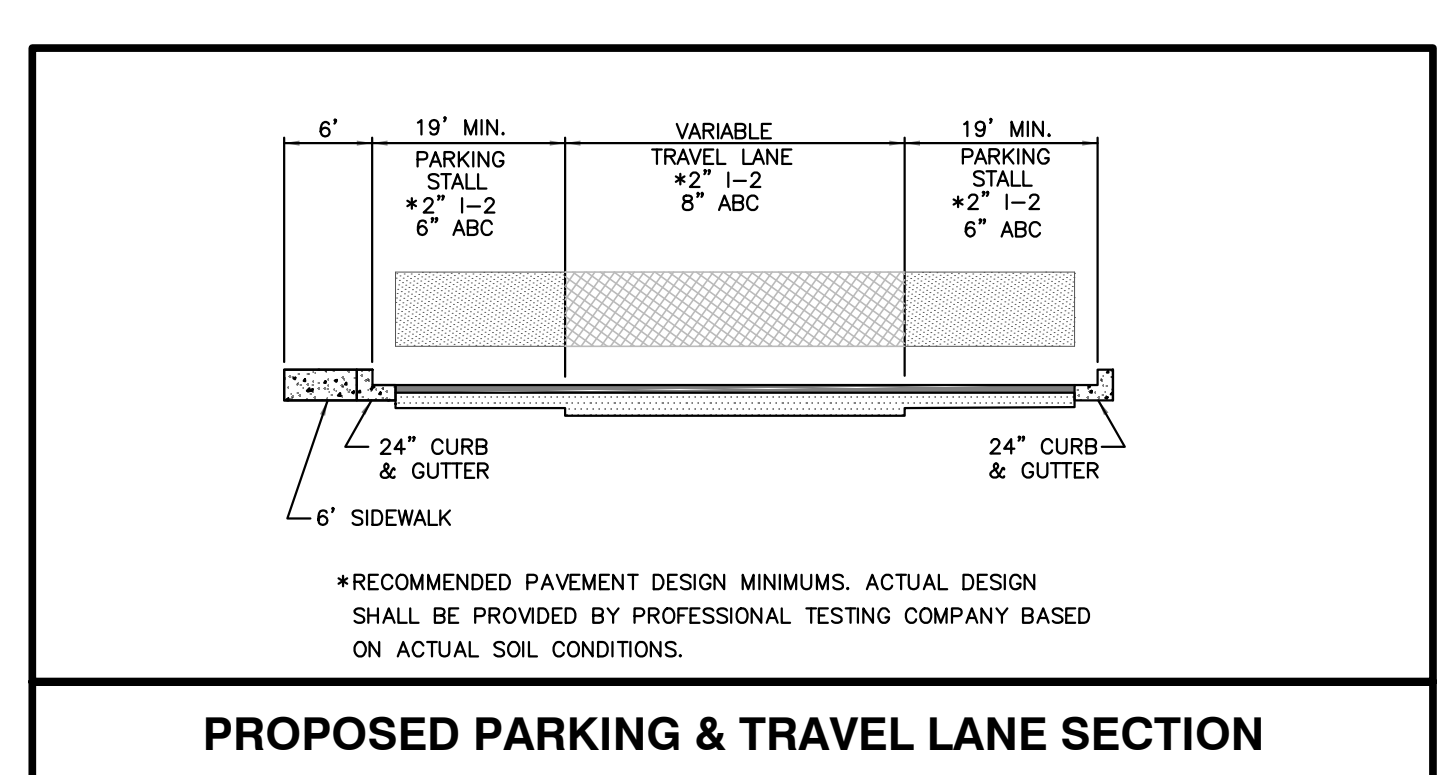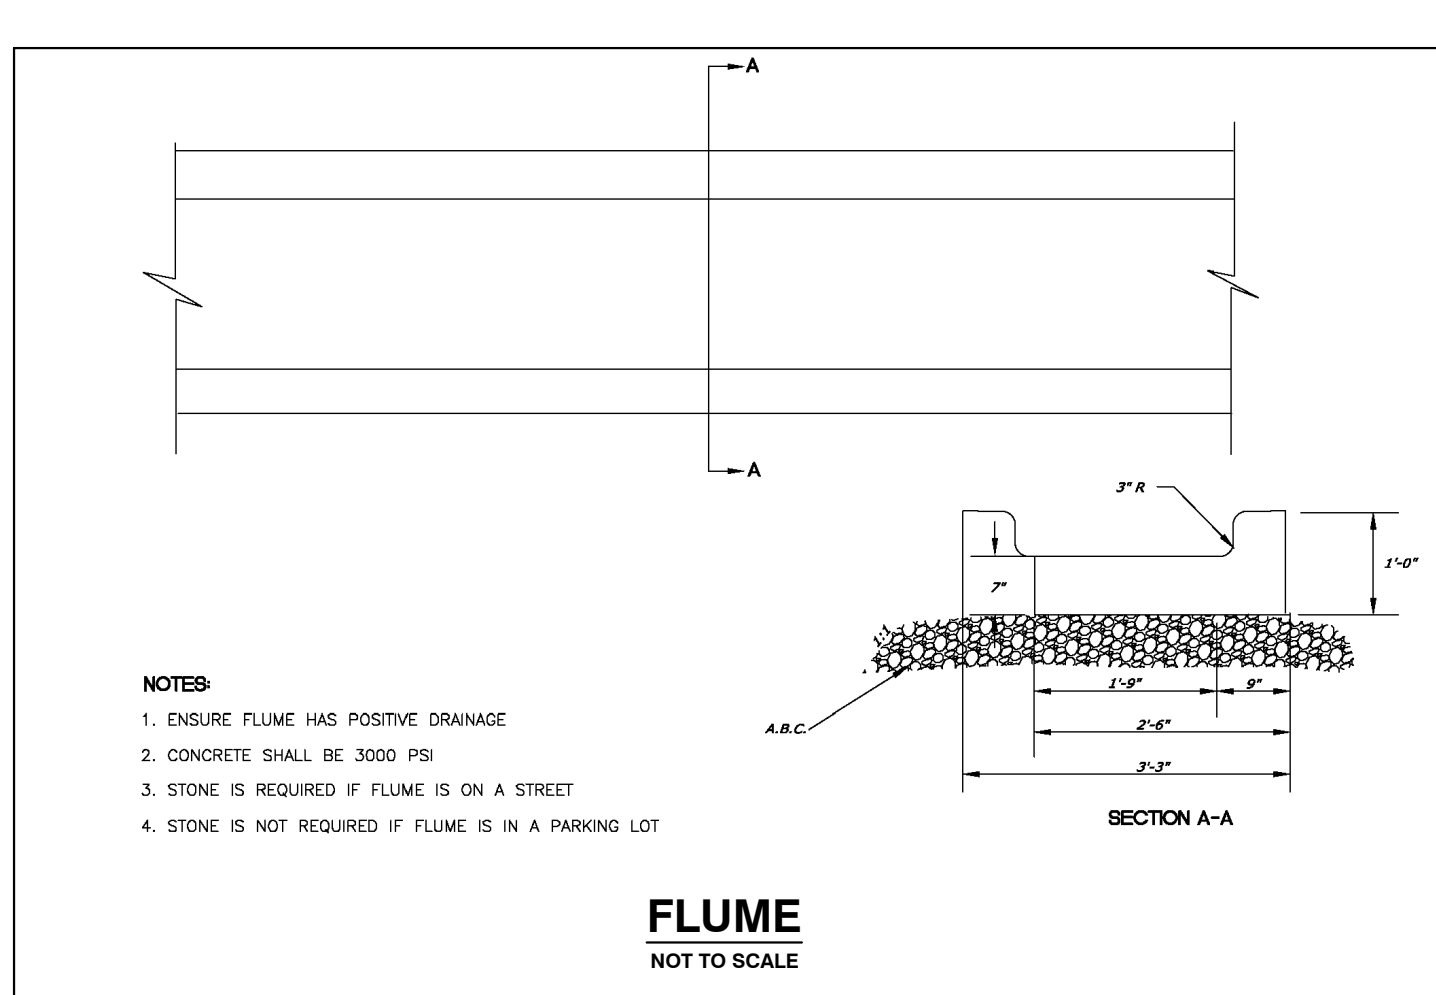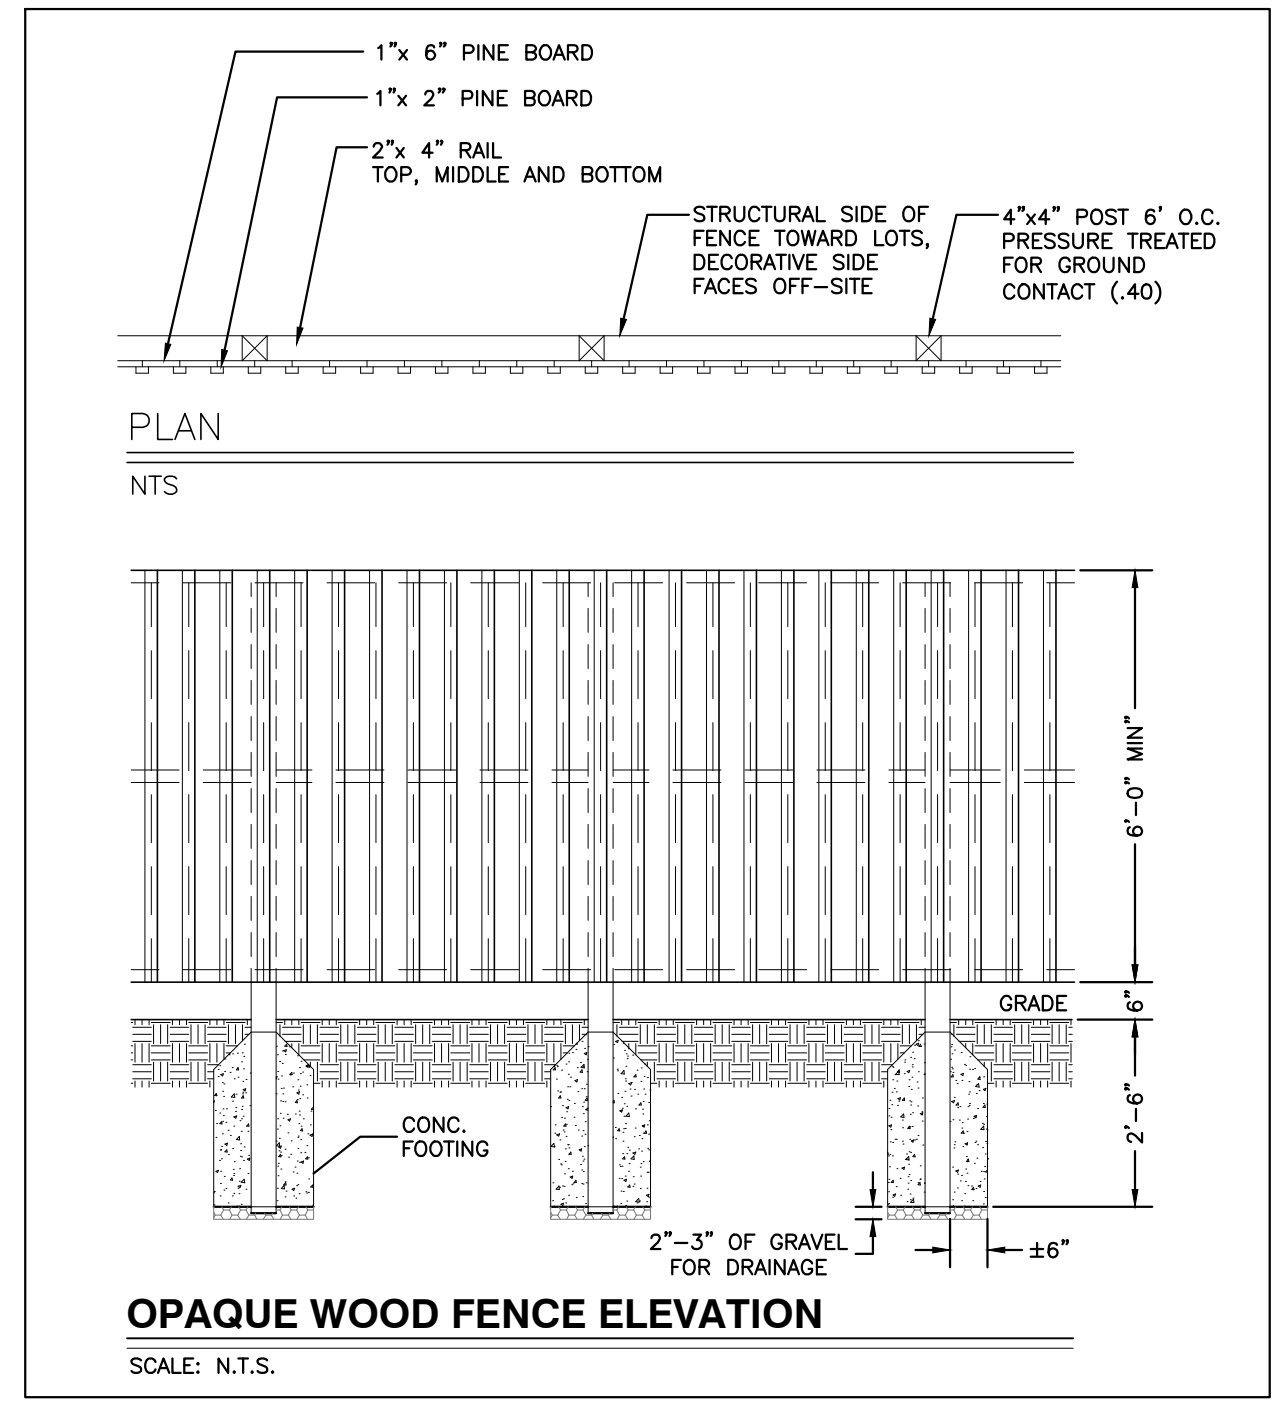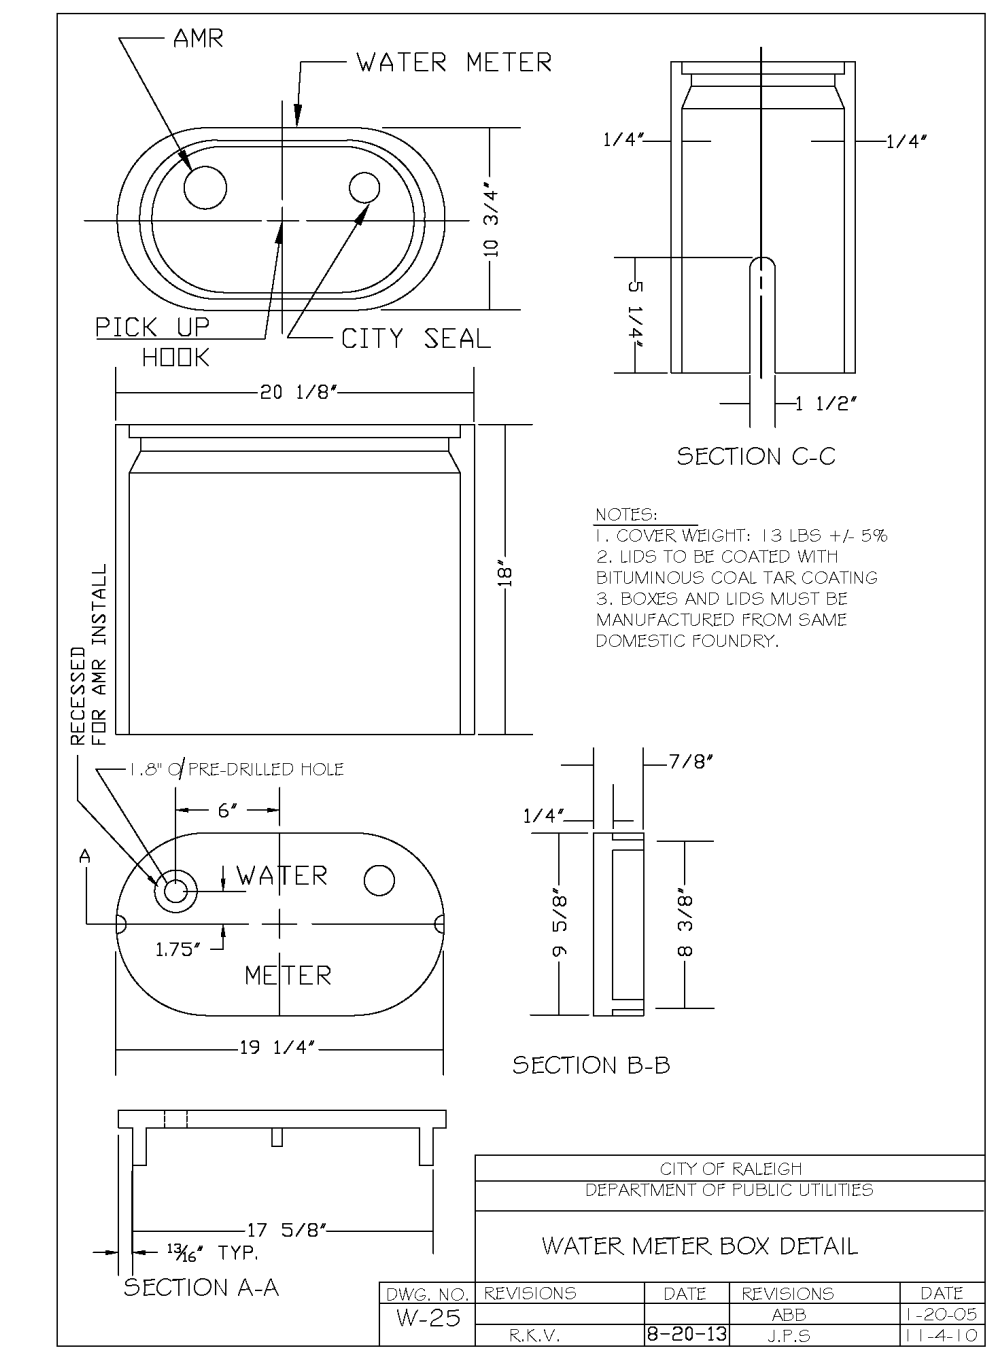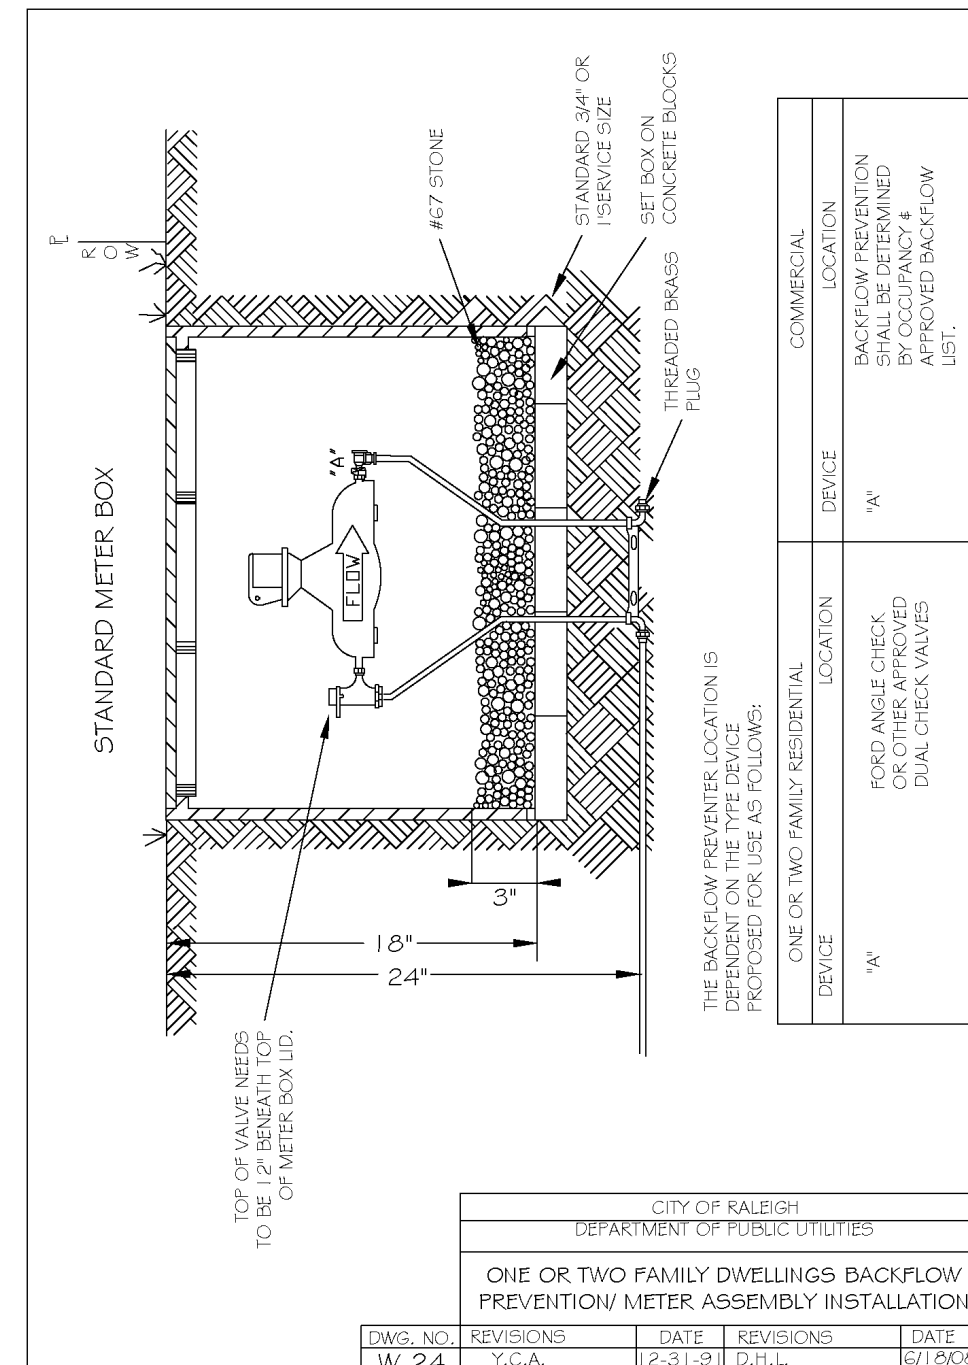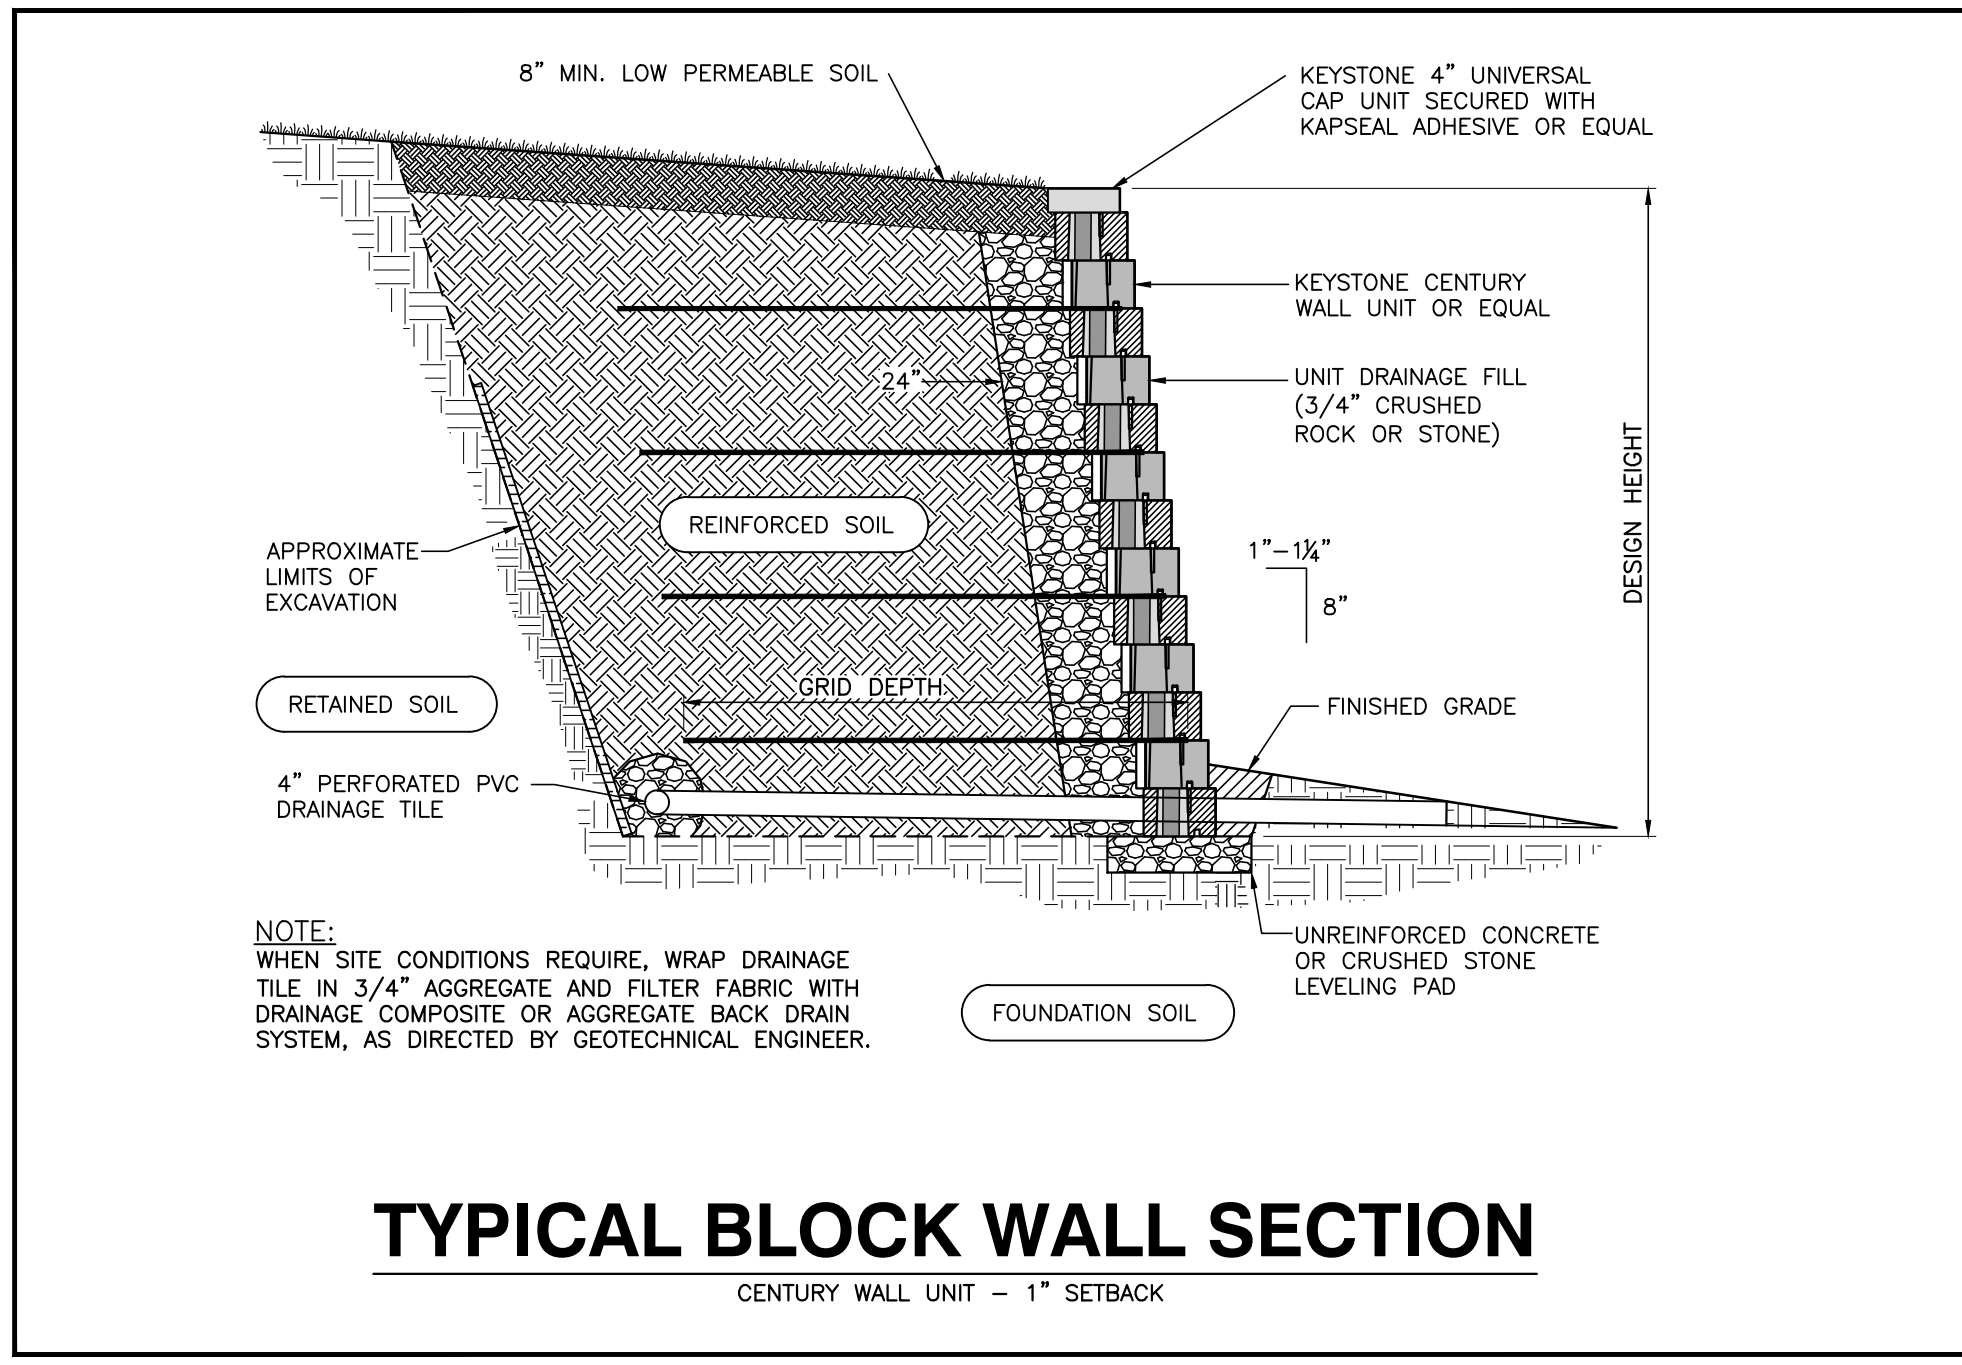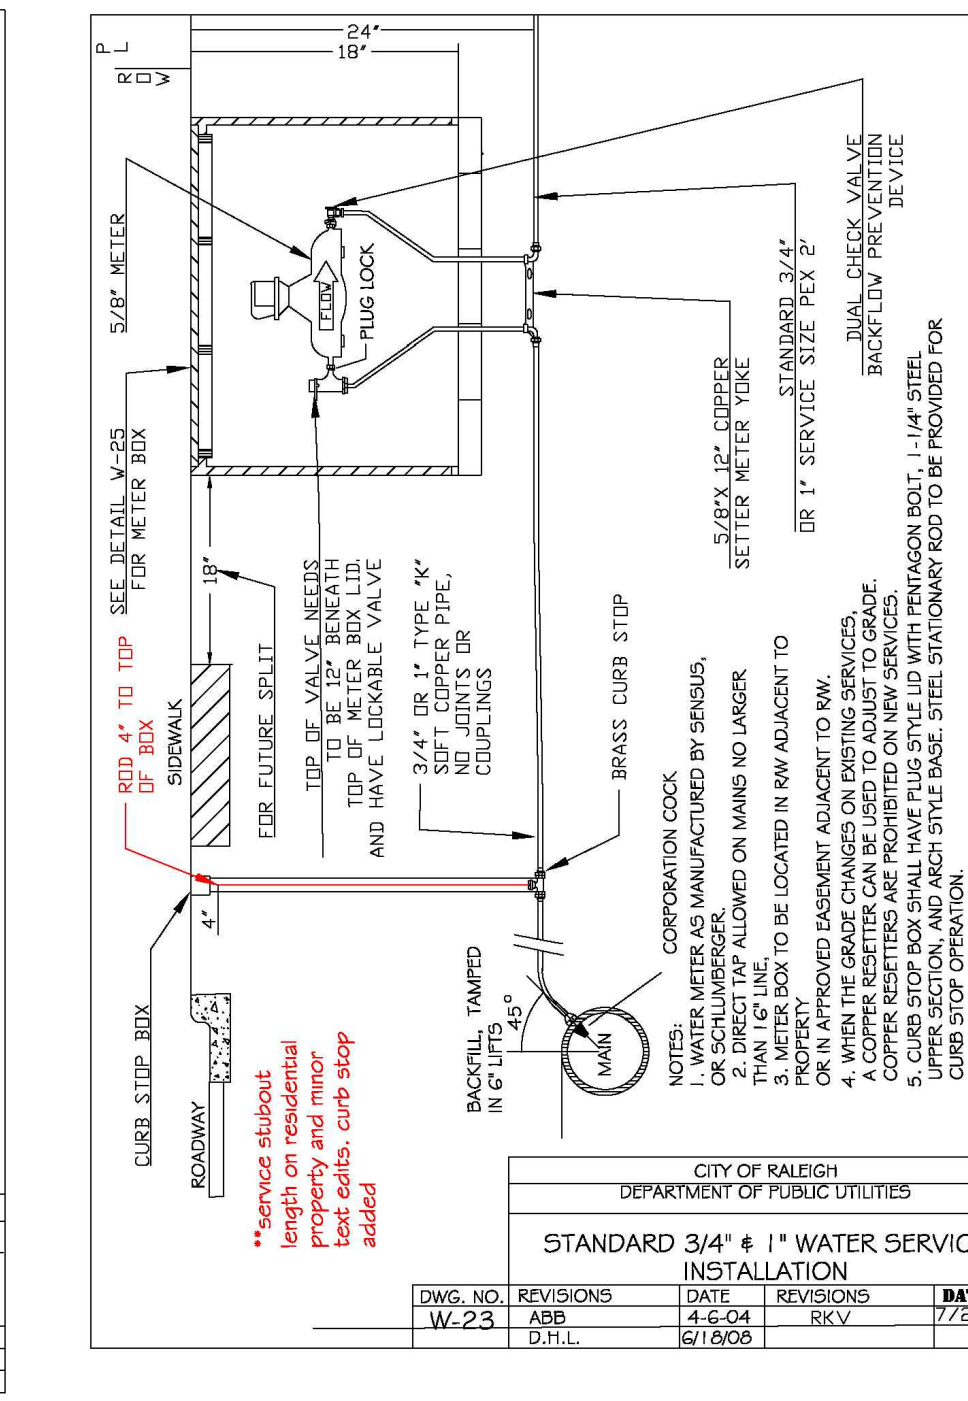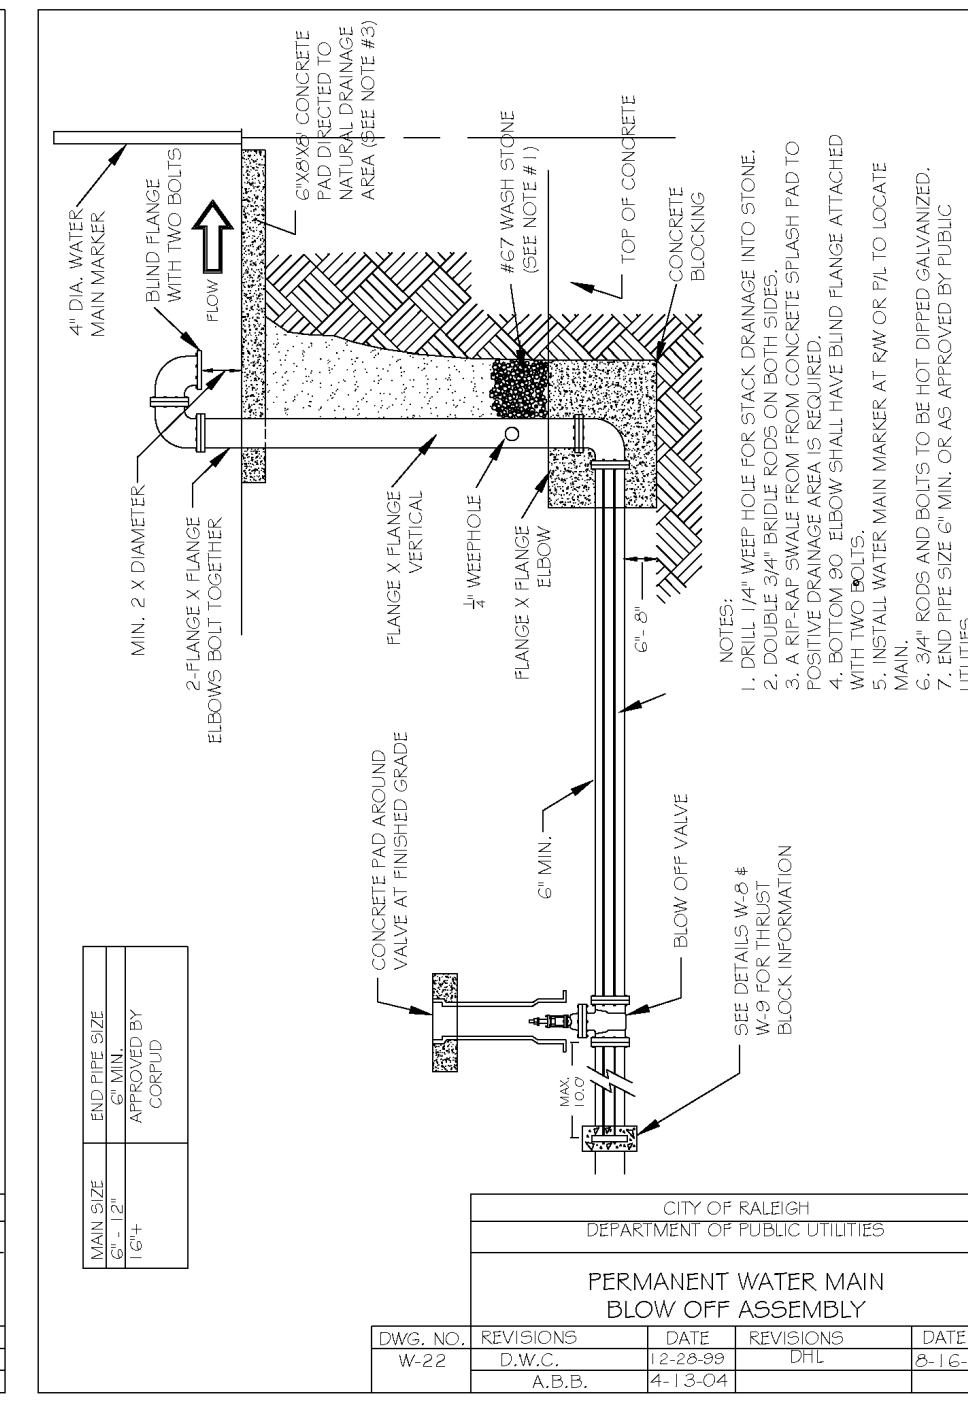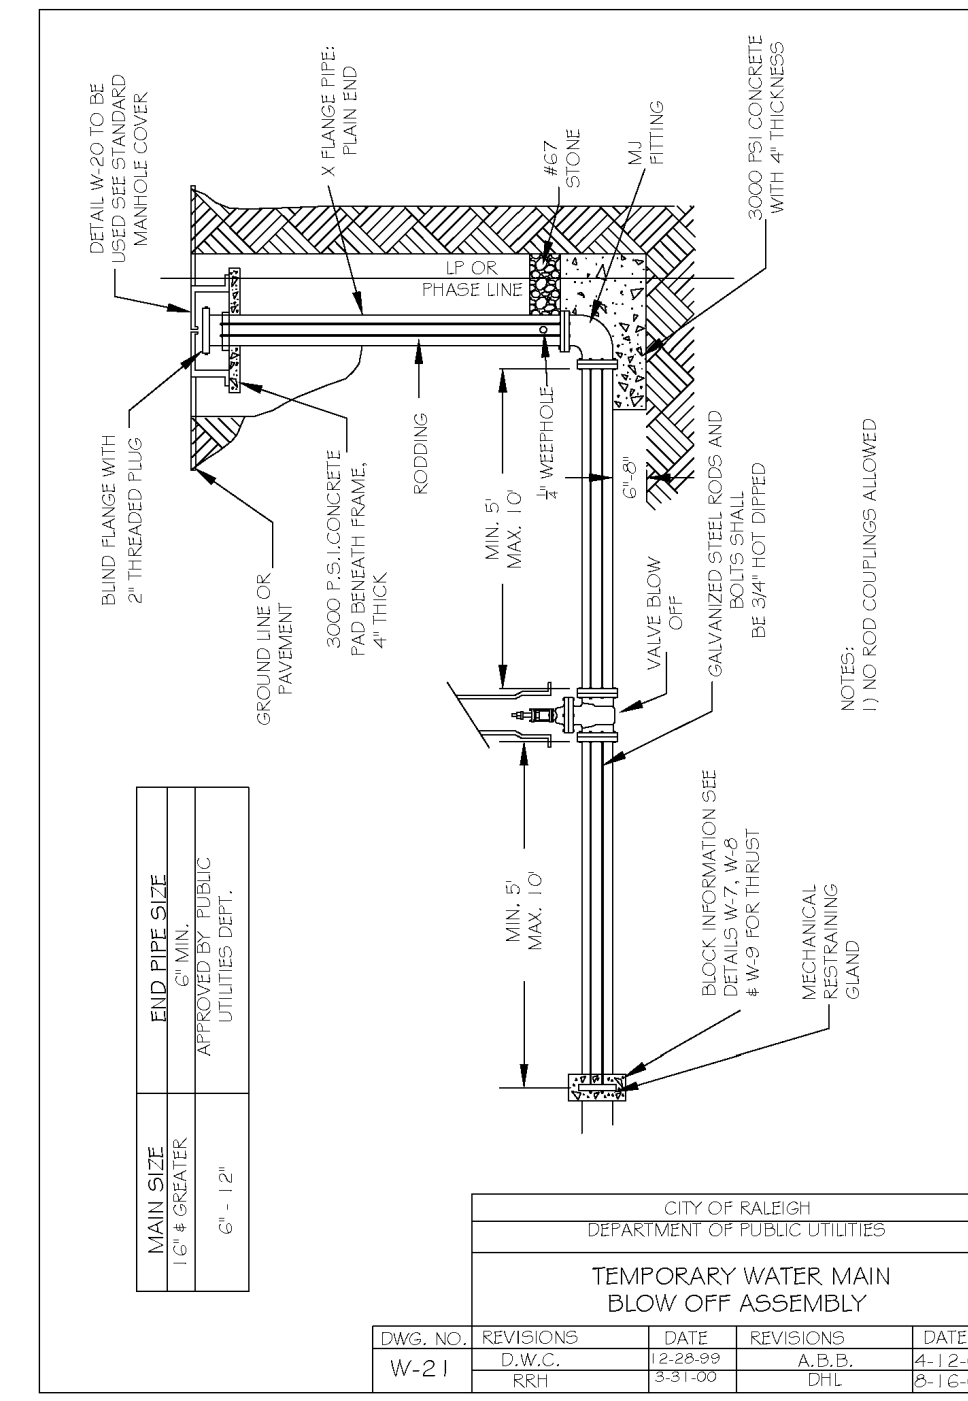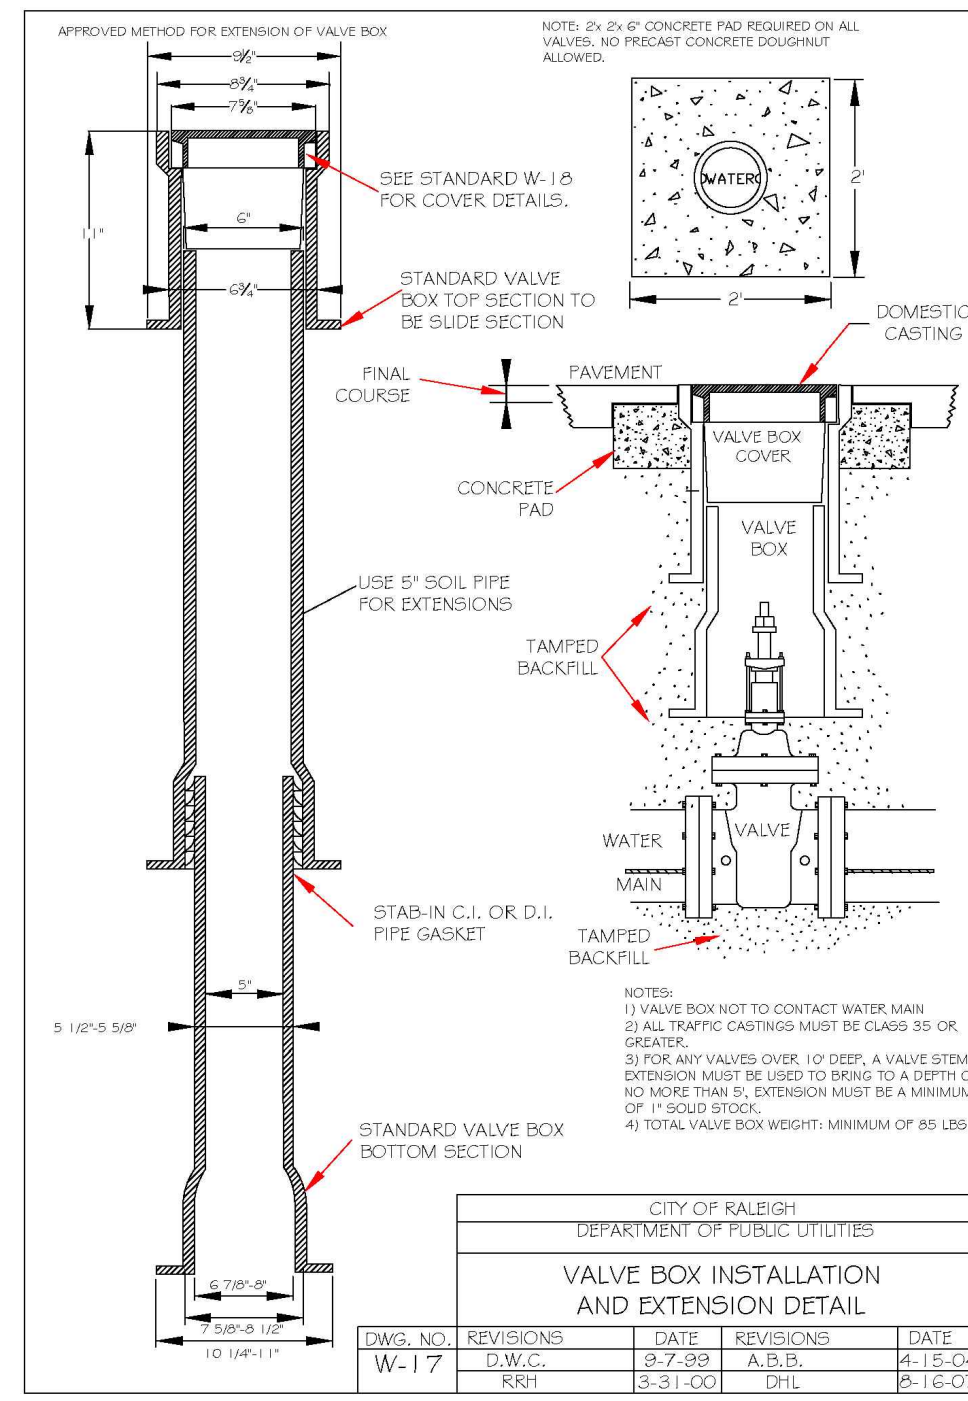

CITY OF RALEIGH - PLANS AUTHORIZED FOR CONSTRUCTION

Electronic Approval: This approval is being issued electronically. This approval is valid only upon the signature of a City of Raleigh Review Officer below. The City will retain a copy of the approved plans. Any work authorized by this approval must proceed in accordance with the plans kept on file with the City. This electronic approval may not be edited once issued. Any modification to this approval once issued will invalidate this approval.

City of Raleigh Development Approval _____

Raleigh Water Review Officer _____



04/20/22


BASS, NIXON & KENNEDY, INC.
CONSULTING ENGINEERS
6810 CHAPEL HILL ROAD, SUITE 250, RALEIGH, NC 27607
TELEPHONE: (919)881-4242 FAX: (919)881-6888
CERTIFICATION NUMBERS: NCBELS (C-0110); NCBOLA (C-0267)

| PROGRESS | MRI | DATE | DRAWN BY | NO. | DATE | DESCRIPTION | BY |
|----------|-----|------|----------|-----|------|-------------|----|
| 03-1917 | | | | | | | |
| JOB NO. | | | | | | | |

COBBLESTONE VILLAGE
MIXED USE DEVELOPMENT
TOWN OF ROLESVILLE, WAKE COUNTY, NORTH CAROLINA

SCALE: N.T.S. CHK BY: MDB


SHEET C5.5

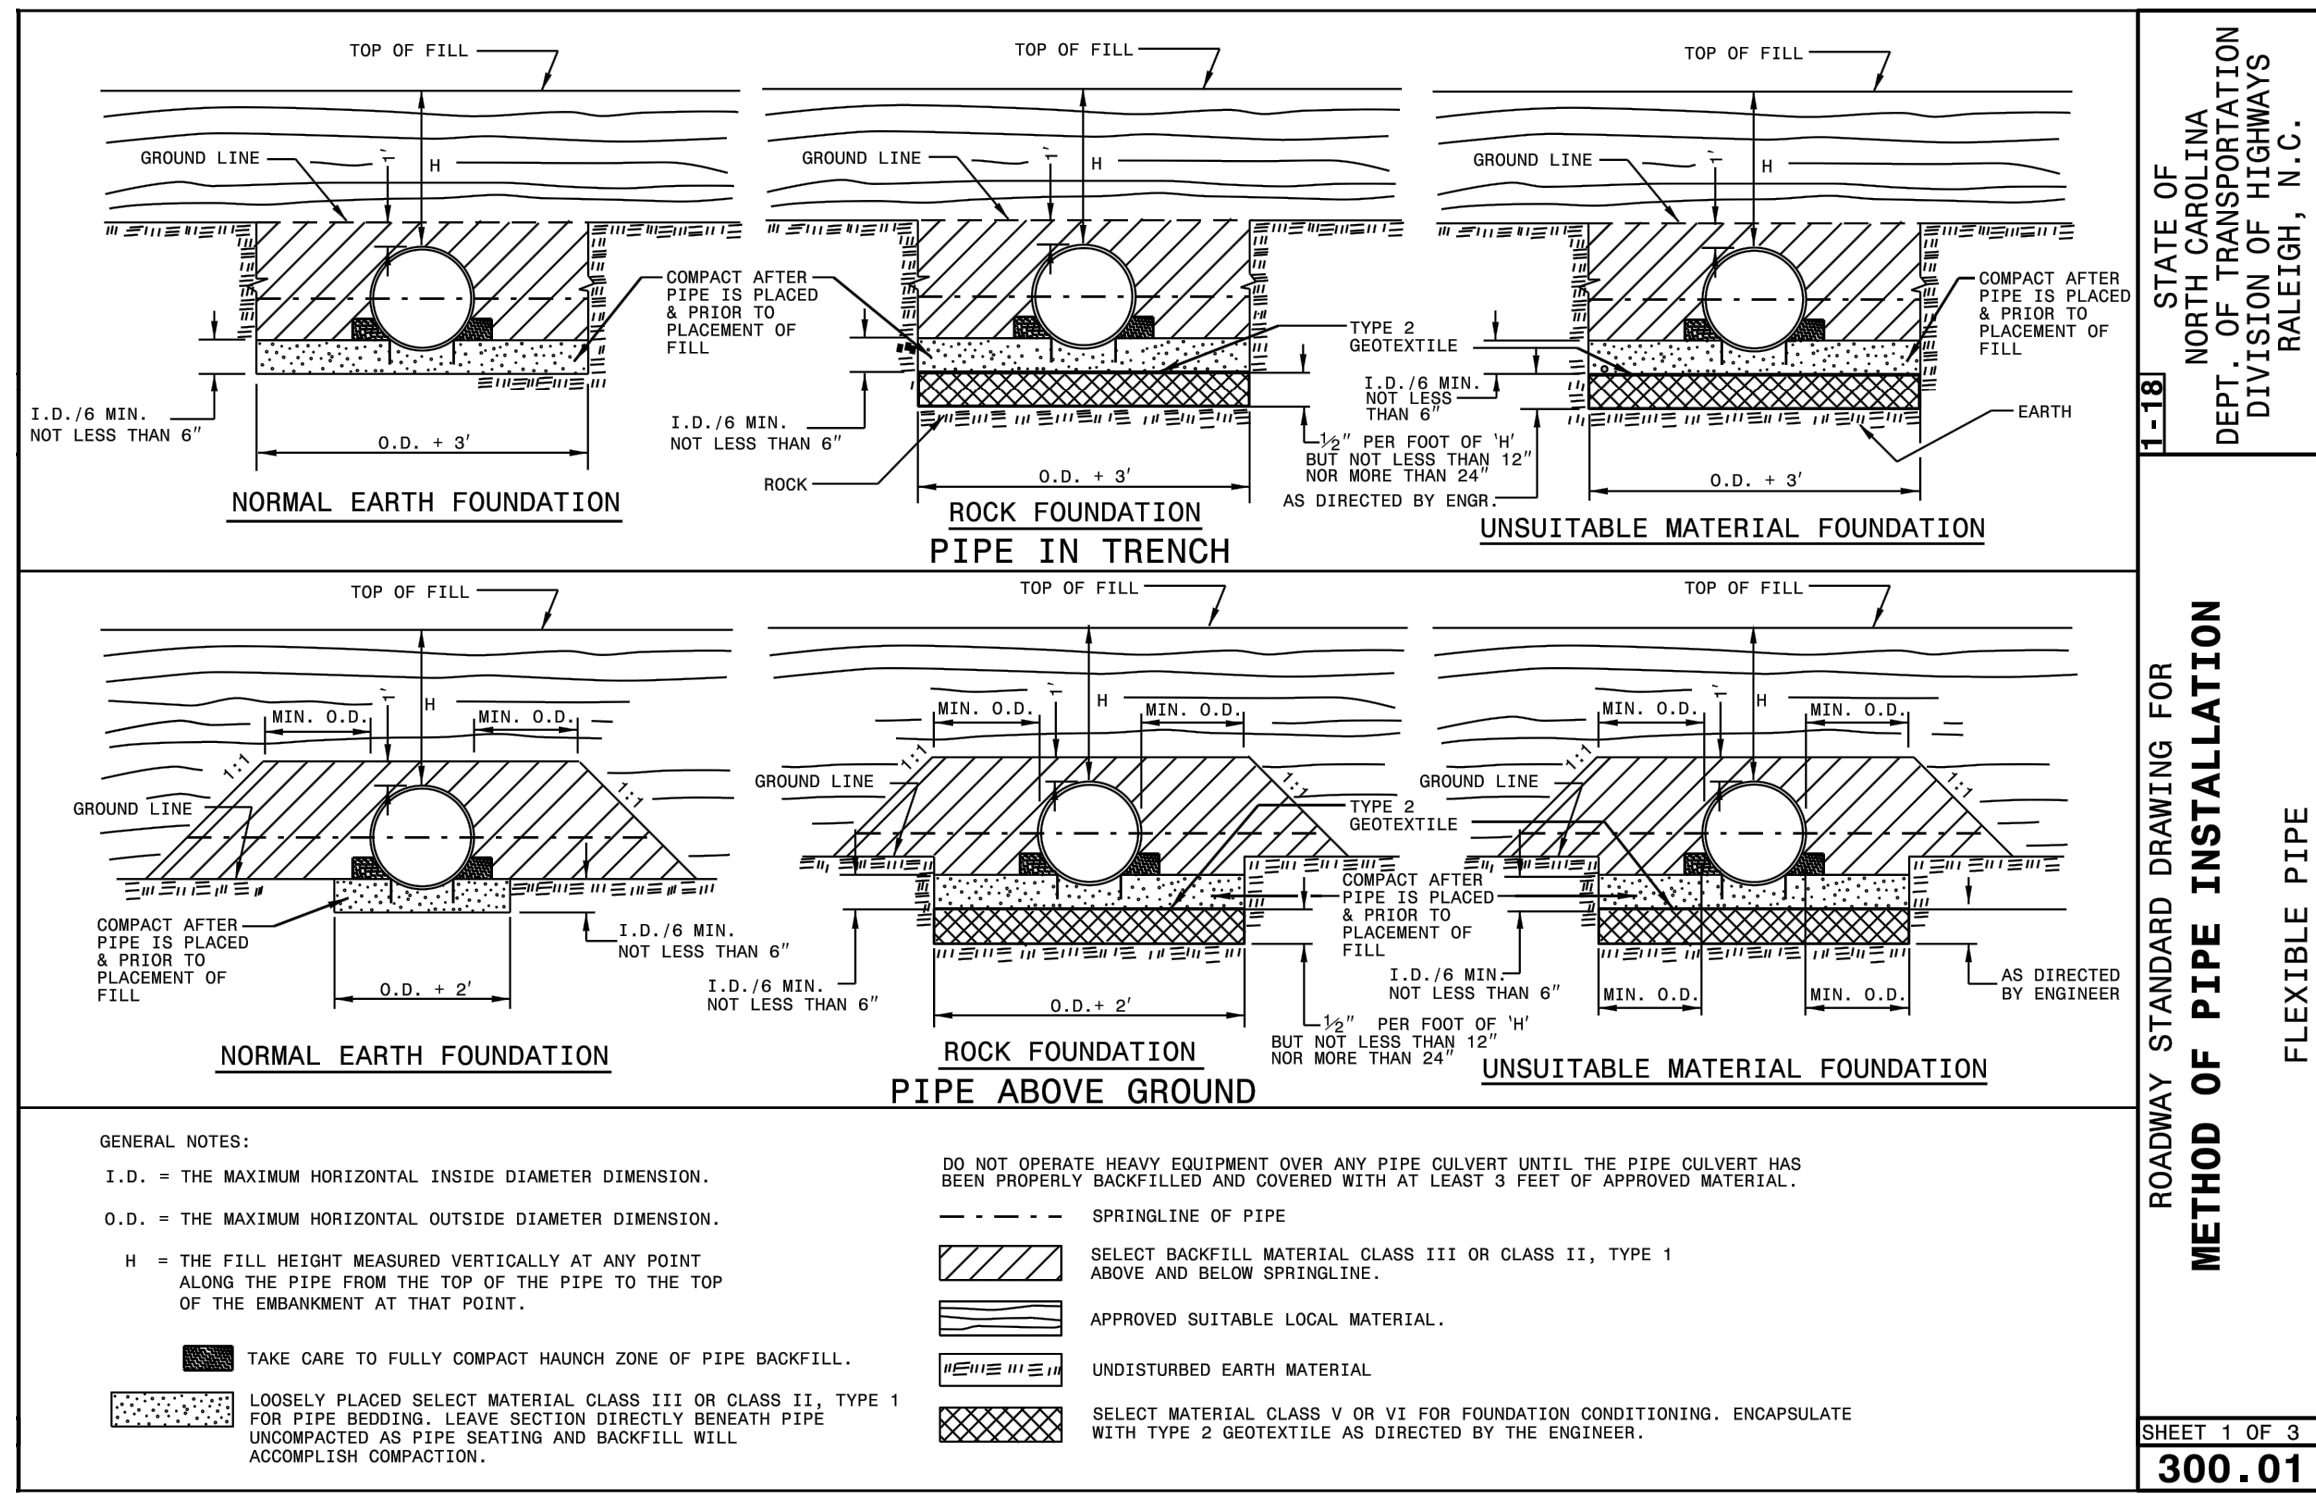

1-18
STATE OF NORTH CAROLINA
DEPT. OF TRANSPORTATION
DIVISION OF HIGHWAYS
RALEIGH, N.C.

ROADWAY STANDARD DRAWING FOR
METHOD OF PIPE INSTALLATION
FLEXIBLE PIPE

SHEET 1 OF 3
300.01

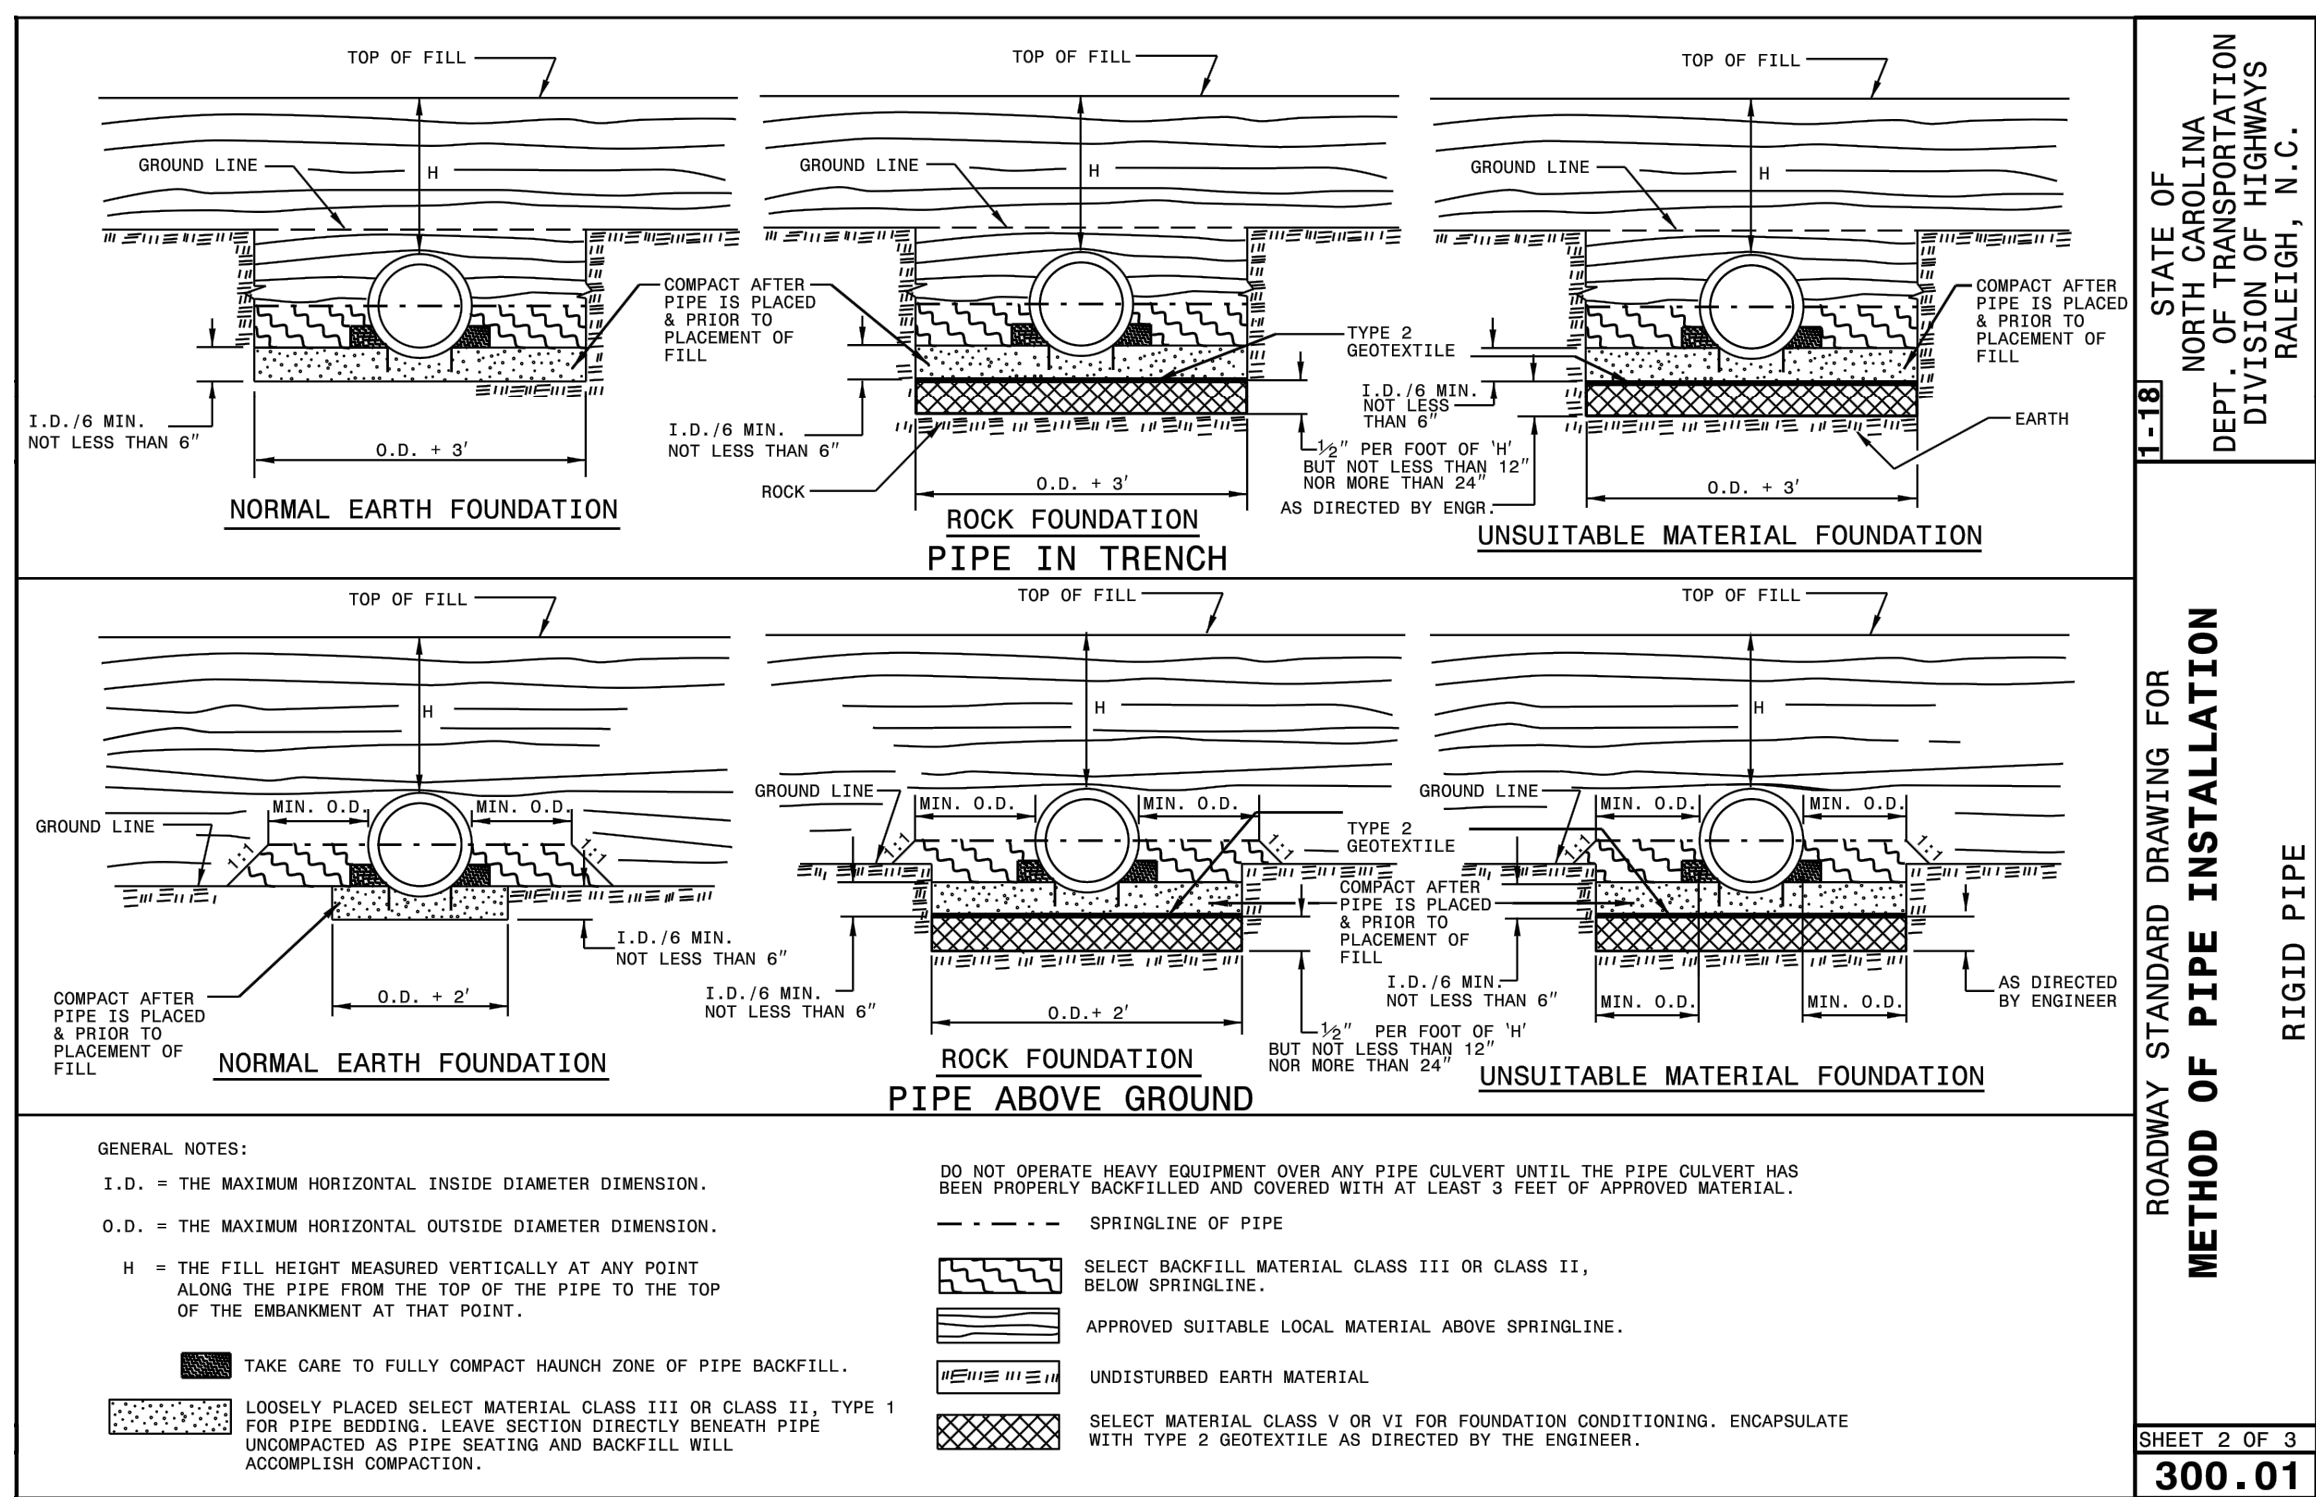

1-18
STATE OF NORTH CAROLINA
DEPT. OF TRANSPORTATION
DIVISION OF HIGHWAYS
RALEIGH, N.C.

ROADWAY STANDARD DRAWING FOR
METHOD OF PIPE INSTALLATION
RIGID PIPE

SHEET 2 OF 3
300.01

FLEXIBLE PIPE

| Round Corrugated Steel Pipe 2 2/3 x 1/2 corrugation ** | | | | | | Round Corrugated Aluminum Pipe 2 2/3 x 1/2 corrugation ** | | | | | | | | | |
|---|------------------------|--------------------------------|-----|-----|-----|--|------------------------|--------------------------------|----|-----|-----|-----|-----|-----|---|
| Diameter (inches) | Minimum cover (inches) | Maximum Height of Cover (feet) | | | | Diameter (inches) | Minimum cover (inches) | Maximum Height of Cover (feet) | | | | | | | |
| | | (G) | 16 | 14 | 12 | 10 | 8 | | | (G) | 16 | 14 | 12 | 10 | 8 |
| 12 | 12 | 204 | 256 | | | | | 12 | 12 | 123 | 155 | 218 | 281 | 344 | |
| 15 | 12 | 162 | 204 | | | | | 15 | 12 | 98 | 123 | 174 | 224 | 275 | |
| 18 | 12 | 135 | 169 | 239 | | | | 18 | 12 | 81 | 102 | 144 | 187 | 228 | |
| 21 | 12 | 115 | 145 | 204 | | | | 21 | 12 | 69 | 87 | 123 | 160 | 195 | |
| 24 | 12 | 100 | 126 | 178 | | | | 24 | 12 | 60 | 76 | 108 | 139 | 171 | |
| 30 | 12 | 79 | 100 | 142 | | | | 27 | 12 | 67 | 95 | 123 | 151 | | |
| 36 | 12 | 65 | 83 | 117 | 152 | | | 30 | 12 | 60 | 85 | 111 | 136 | | |
| 42 | 12 | 55 | 70 | 100 | 130 | 160 | | 36 | 12 | 50 | 71 | 92 | 113 | | |
| 48 | 12 | 48 | 61 | 87 | 113 | 139 | | 42 | 12 | 60 | 78 | 96 | | | |
| 54 | 12 | 42 | 54 | 77 | 100 | 123 | | 48 | 12 | 52 | 68 | 84 | | | |
| 60 | 12 | 38 | 49 | 71 | 90 | 111 | | 54 | 12 | 46 | 50 | 74 | | | |
| 66 | 12 | 34 | 44 | 65 | 81 | 100 | | 60 | 12 | 42 | 46 | 62 | | | |
| 72 | 12 | 31 | 41 | 61 | 74 | 91 | | 66 | 12 | 40 | 44 | 58 | | | |
| 78 | 12 | 28 | 38 | 57 | 71 | 81 | | 72 | 12 | 38 | 42 | 54 | | | |
| 84 | 12 | 26 | 36 | 54 | 69 | | | | | | | | | | |

** FOR DIFFERENT CORRUGATIONS AND ARCH PIPES REFER TO ROADWAY DESIGN MANUAL OR MANUFACTURERS SPECIFICATION.

RIGID PIPE

RCP - * (Minimum fill) 1' for Class IV & Class V
2' for Class III & Class II

* (Maximum fill) 10' - Class II pipe
20' - Class III pipe
30' - Class IV pipe
40' - Class V pipe

(For fills > 40' & < 80' use LRFD Direct Design Method)

NOTES: FILL HEIGHTS SHOWN WERE CALCULATED USING AASHTO LRFD BRIDGE DESIGN SPECIFICATIONS

1' MINIMUM COVER FOR ALL SIDE DRAIN PIPE IN ACCORDANCE WITH THE STANDARD SPECIFICATIONS

1-18
STATE OF NORTH CAROLINA
DEPT. OF TRANSPORTATION
DIVISION OF HIGHWAYS
RALEIGH, N.C.

ROADWAY STANDARD DRAWING FOR
METHOD OF PIPE INSTALLATION
FILL HEIGHT TABLES



SHEET 3 OF 3
300.01

CITY OF RALEIGH - PLANS AUTHORIZED FOR CONSTRUCTION

Electronic Approval: This approval is being issued electronically. This approval is valid only upon the signature of a City of Raleigh Review Officer below. The City will retain a copy of the approved plans. Any work authorized by this approval must proceed in accordance with the plans kept on file with the City. This electronic approval may not be edited once issued. Any modification to this approval once issued will invalidate this approval.

City of Raleigh Development Approval _____

Raleigh Water Review Officer

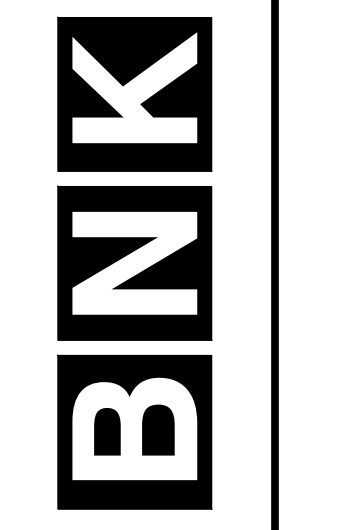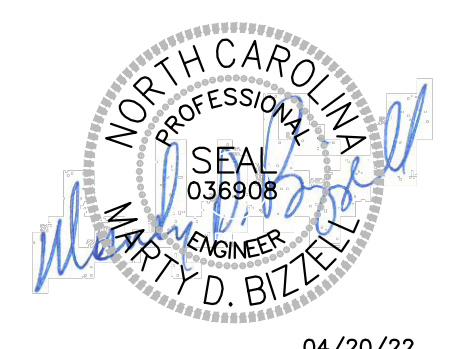

BASS, NIXON & KENNEDY, INC.
CONSULTING ENGINEERS
6310 CHAPEL HILL ROAD, SUITE 250, RALEIGH, NC 27607
TELEPHONE: (919)881-4242 FAX: (919)881-6868
CERTIFICATION NUMBERS: NCBELS (C-0110); NCBOLA (C-0267)

| NO. | DATE | DESCRIPTION | BY |
|-----|------|-------------|----|
| | | | |
| | | | |
PROGRESS MRM
DATE DRAWN BY

JOB NO.

DETAILS

SCALE: N.T.S.

CHK BY: MDB

CITY OF RALEIGH - PLANS AUTHORIZED FOR CONSTRUCTION

COBBLESTONE VILLAGE MIXED USE DEVELOPMENT
TOWN OF ROLESVILLE, WAKE COUNTY, NORTH CAROLINA

SHEET C5.6