


EROSION CONTROL / MASS GRADING / SANITARY SEWER RELOCATION FOR WALLBROOK

CD 22-02
REVISION - V1

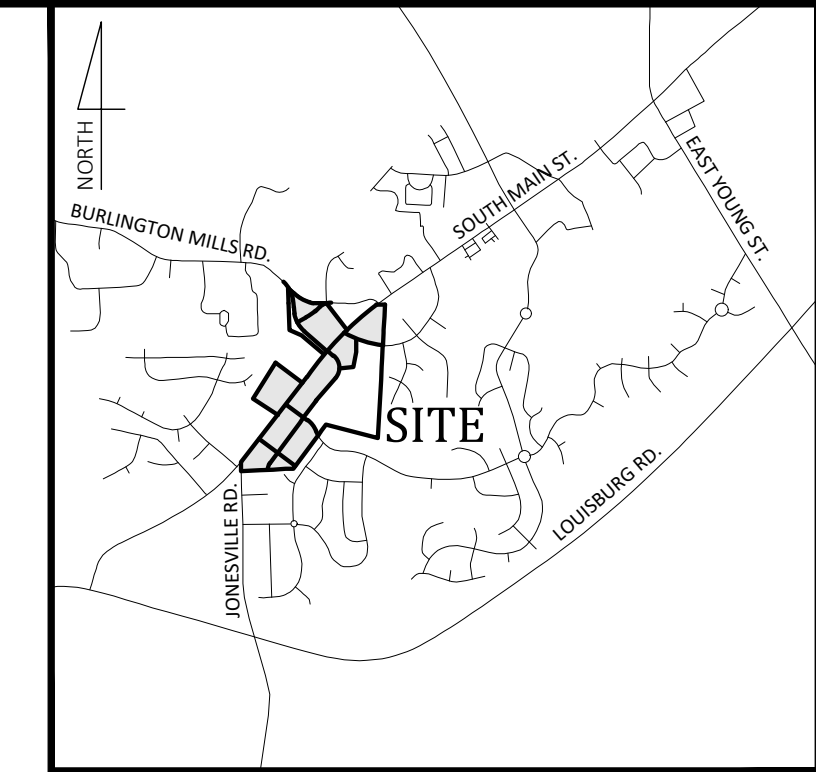

Vicinity Map
NOT TO SCALE

Main St. / US 401 Business, Town of Rolesville, Wake County, North Carolina

Project No.: CD 22-02

- Final Drawing -
Issued for Permit
Review Purposes Only

REVISIONS:

CROSLAND
SOUTHEAST



COVER
WALLBROOK
MASS GRADING / EROSION CONTROL /
SANITARY SEWER RELOCATION
Town of Rolesville Project No. CD 22-02
Rolesville, Wake County, North Carolina

ARK
CONSULTING
GROUP PLLC
ENGINEERS & PLANNERS
2755-B Charles Blvd
Raleigh, NC 27658
(919) 558-0888
www.arkconsultinggroup.com



Project Manager: BCF
Drawn By: DLC
Checked By: STA
Project Number: 21089
Drawing Number: D-1219-EC


C0.1

Date: April 1, 2022

Sheet Index

#	Title
C0.1	Cover
C0.2	Legend & Notes
C0.3	Tree Preservation Plan
C1.0	Demo / Clearing Plan
C1.1	Erosion Control / Mass Grading Plan - Shopping Center (Lots 1 - 4)
C1.2	Erosion Control / Mass Grading Plan - Wallbrook Drive & Lot 5
C1.3	Erosion Control / Mass Grading Plan - Paris Tract (Lots 9, 10, & 11)
C1.4	Erosion Control / Mass Grading Plan - MBW Tract (Lots 12, 13, & 14)
C1.5	Erosion Control / Mass Grading Plan - Lots 7 & 8
C2.0	Sanitary Sewer Relocation - Plan/Profile
C2.1	Sanitary Sewer Details
C3.1	Details - Erosion Control
C3.2	Details - Erosion Control
REF	Survey - Johnson, Mirmiran & Thompson (4 Sheets)

Lot acreages vary from the revised Preliminary Plat (PR21-04). Please update

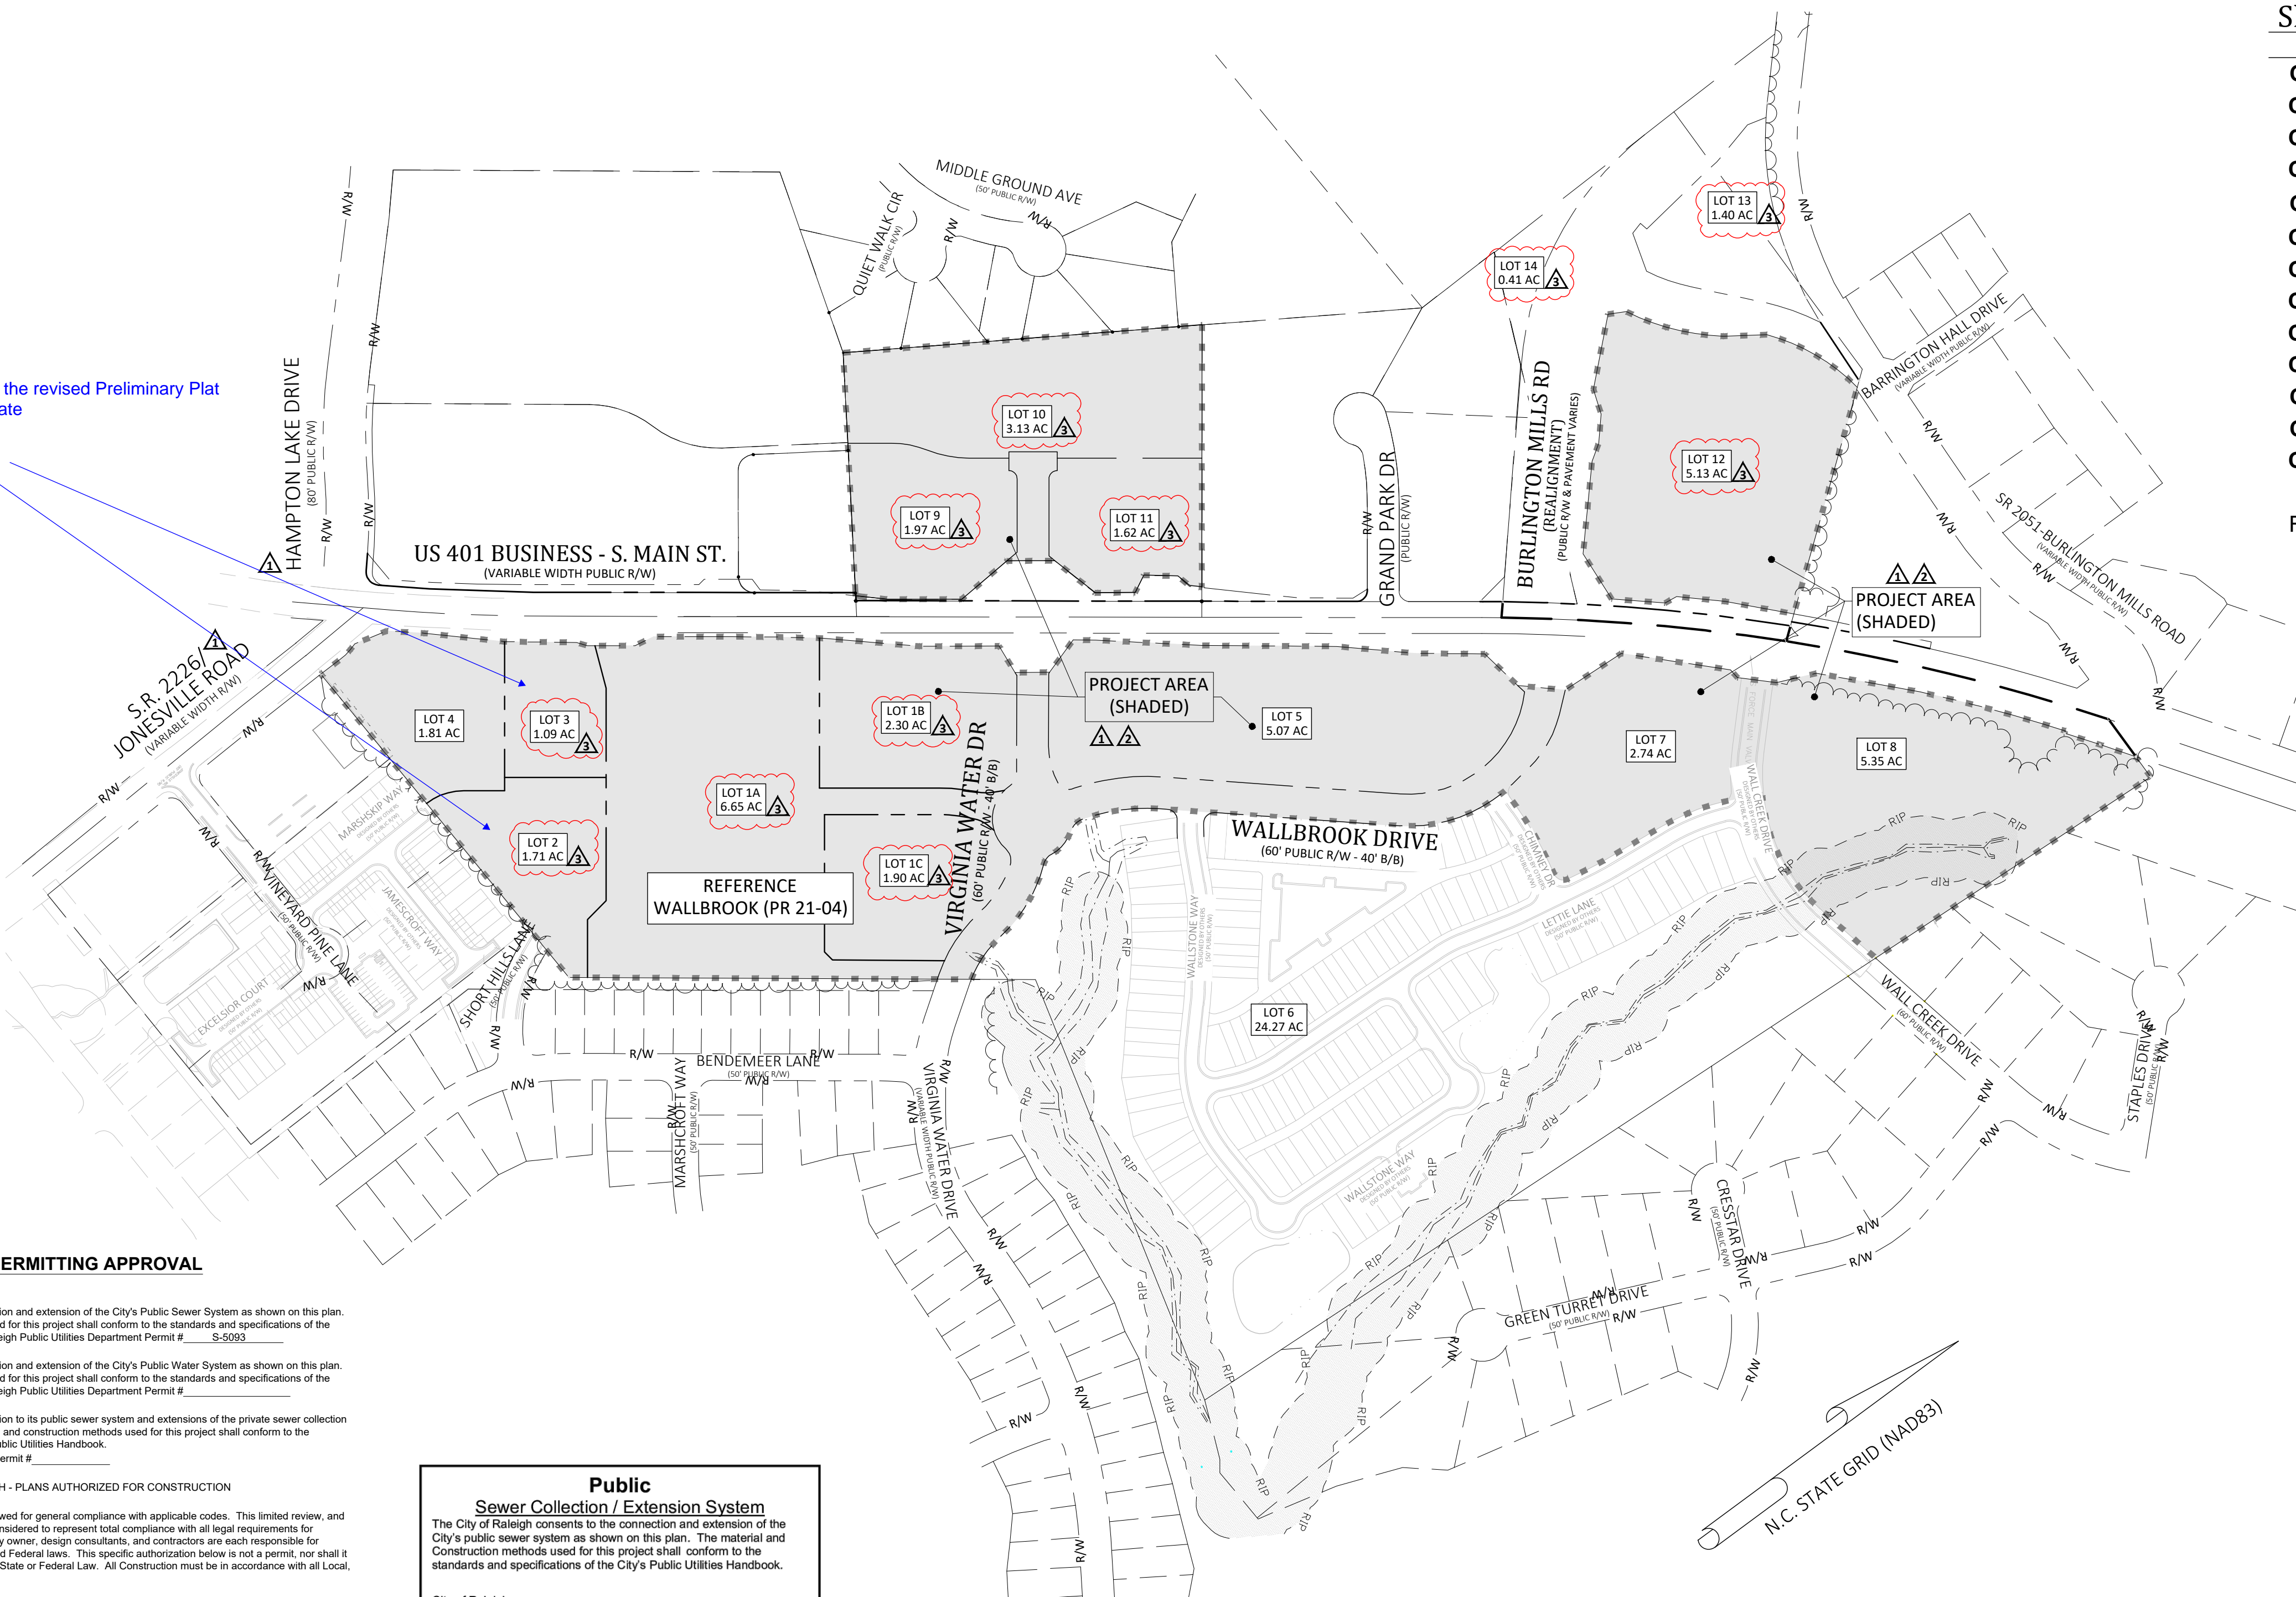

Site Data

PIN NUMBERS:	1758-45-8905, 1758-56-8976, 1758-46-7822, 1758-58-2090, 1758-48-9229
REAL ESTATE ID:	76667, 76635, 224130, 224145, 92211
CURRENT ZONING:	GC-CZ
ACREAGE IN TOTAL TRACT:	57.35 ACRES
ACREAGE IN PUBLIC R/W:	2.83 ACRES
TOTAL ACREAGE DISTURBED:	41.85 ACRES
WATERSHED:	Lower Neuse
RIVER BASIN:	Neuse
CURRENT USE:	VACANT / WOODED
PROPOSED USE(S):	NON-RESIDENTIAL COMMERCIAL/RETAIL
LOTS IN DEVELOPMENT:	LOTS 1, 2, 3, 4, 5, 7, 8, A, B, C, D
TREE PRESERVATION AREA:	2.34 ACRES

Update Lot Names accordingly



KNOW WHAT'S BELOW
CALL BEFORE YOU DIG!
1-800-4-A-SHEDS
WWW.811.ORG

SITE PERMITTING APPROVAL

Water and Sewer Permits (if applicable)
The City of Raleigh consents to the connection and extension of the City's Public Sewer System as shown on this plan. The material and construction methods used for this project shall conform to the standards and specifications of the City's Public Utilities Handbook. City of Raleigh Public Utilities Department Permit # S-5093

The City of Raleigh consents to the connection and extension of the City's Public Water System as shown on this plan. The material and construction methods used for this project shall conform to the standards and specifications of the City's Public Utilities Handbook. City of Raleigh Public Utilities Department Permit #

The City of Raleigh consents to the connection to its public sewer system and extensions of the private sewer collection system as shown on this plan. The material and construction methods used for this project shall conform to the standards and specifications of the City's Public Utilities Handbook. City of Raleigh Public Utilities Department Permit #

CITY OF RALEIGH - PLANS AUTHORIZED FOR CONSTRUCTION

Plans for the proposed use have been reviewed for general compliance with applicable codes. This limited review, and authorization for construction is not to be considered to represent total compliance with all legal requirements for development and construction. The property owner, design consultants, and contractors are each responsible for compliance with all applicable City, State and Federal laws. This specific authorization below is not a permit, nor shall it be construed to permit any violation of City, State or Federal Law. All construction must be in accordance with all Local, State, and Federal Rules and Regulations.

Electronic Approval: This approval is being issued electronically. This approval is valid only upon the signature of a City of Raleigh Review Officer below. The City will retain a copy of the approved plans. Any work authorized by this approval must proceed in accordance with the plans kept on file with the City. This electronic approval may not be relied upon if issued. Any modification to this approval once issued will invalidate this approval.

City of Raleigh Development Approval
City of Raleigh Review Officer

Public Sewer Collection / Extension System
The City of Raleigh consents to the connection and extension of the City's public sewer system as shown on this plan. The material and construction methods used for this project shall conform to the standards and specifications of the City's Public Utilities Handbook.

City of Raleigh
Public Utilities Department Permit # S-5093

Authorization to Construct _____
Date _____

200' 0 100' 200'
SCALE 1 inch = 200 ft

APPROVED FOR COMPLIANCE
Case # _____ Project _____
By: _____ Date _____
These plans have been approved for compliance with the Town Code of Ordinance, LDO, and Standard Specifications and Construction Details, subject to statements & conditions hereby incorporated by reference.

EROSION AND SEDIMENT CONTROL
APPROVED PLAN
DATE _____
PERMIT NO. S-_____
Wake County Environmental Services
Sedimentation & Erosion Control
919-856-7400

ENVIRONMENTAL CONSULTANT SIGNATURE _____

Date: April 1, 2022

GROUND STABILIZATION AND MATERIALS HANDLING PRACTICES FOR COMPLIANCE WITH THE NCGO1 CONSTRUCTION GENERAL PERMIT

Table with 3 columns: Site Area Description, Required Ground Stabilization Timeframes, and Timeframe variations. Rows include Perimeter dikes, High Quality Water (HQW) Zones, Slopes steeper than 3:1, Slopes 3:1 to 4:1, and Areas with slopes flatter than 4:1.

Note: After the permanent cessation of construction activities, any areas within temporary ground stabilization shall be converted to permanent ground stabilization as soon as practicable but in no case longer than 90 calendar days after the last land disturbing activity.

Table with 2 columns: Temporary Stabilization and Permanent Stabilization. Lists methods like hydroseeding, mulch, and erosion control products.

- POLYACRYLAMIDES (PAMS) AND FLOCCULANTS
1. Select flocculants that are appropriate for the soils being exposed during construction...


- EQUIPMENT AND VEHICLE MAINTENANCE
1. Maintain vehicles and equipment to prevent discharge of fluids.
2. Provide drip pans under any stored equipment.

- LITTER, BUILDING MATERIAL AND LAND CLEARING WASTE
1. Provide a sufficient number and size of waste containers (e.g. dumpster, trash receptacle) on site to contain construction and domestic wastes.

- PAINT AND OTHER LIQUID WASTE
1. Do not dump paint and other liquid waste into storm drains, streams or wetlands.

- PORTABLE TOILETS
1. Install portable toilets on level ground, at least 50 feet away from storm drains, streams or wetlands unless there is no alternative reasonably available.


- EARTHEN STOCKPILE MANAGEMENT
1. Show stockpile locations on plans. Locate earthen-material stockpile areas at least 50 feet away from storm drain inlets, sediment basins, perimeter sediment controls and surface waters unless it can be shown no other alternatives are reasonably available.

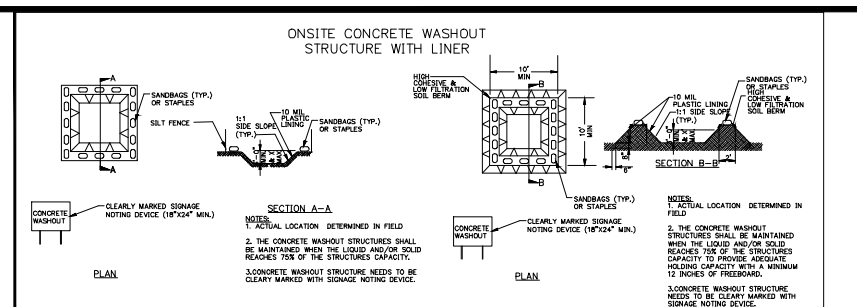

- CONCRETE WASHOUTS
1. Do not discharge concrete or cement slurry from the site.
2. Dispose of, or recycle settled, hardened concrete residue in accordance with local and state solid waste regulations and at an approved facility.

- HERBICIDES, PESTICIDES AND RODENTICIDES
1. Store and apply herbicides, pesticides and rodenticides in accordance with label restrictions.

- HAZARDOUS AND TOXIC WASTE
1. Create designated hazardous waste collection areas on-site.

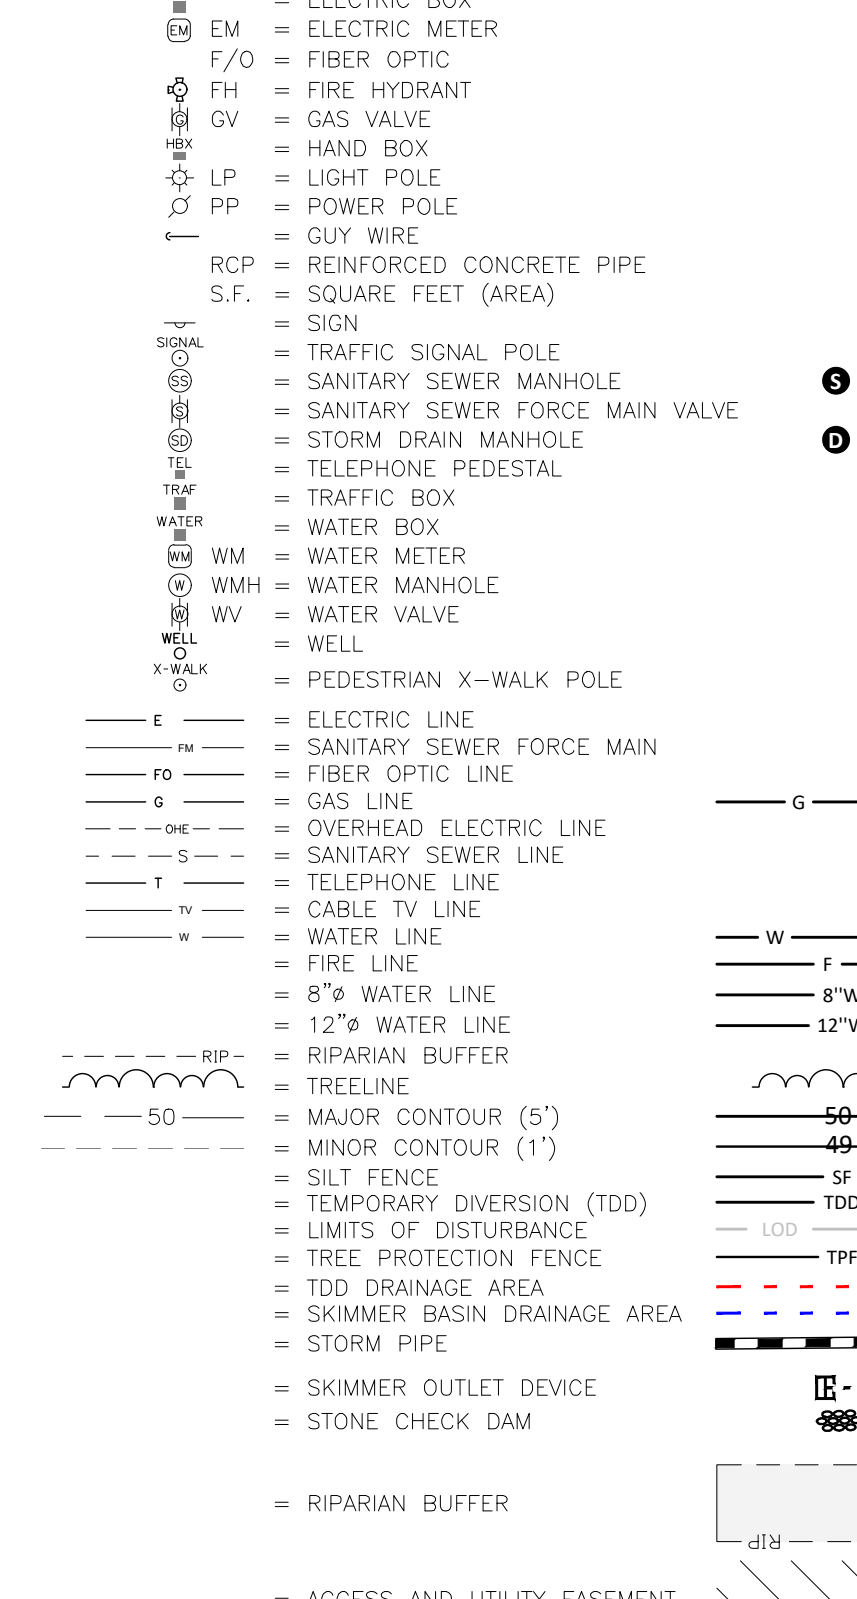

Demolition Notes:

- 1. CONTRACTOR SHALL CONTACT NORTH CAROLINA ONE-CALL CENTER (NC 811) BY DIALING 811 OR 1-800-632-4949 AT LEAST 72 HOURS IN ADVANCE OF ANY LAND DISTURBING ACTIVITY OR DIGGING AND HAVE ALL UNDERGROUND UTILITIES LOCATED PRIOR TO EXCAVATING OR TRENCHING.

Basin Removal Sequence:

- 1. SCHEDULE A SITE MEETING WITH THE ENVIRONMENTAL CONSULTANT TO DETERMINE IF A BASIN CAN BE REMOVED. INSTALL SILT FENCING OR OTHER TEMPORARY EROSION CONTROL MEASURES AS NEEDED PRIOR TO REMOVAL OF THE BASIN.

ATTENTION CONTRACTORS

The Construction Contractor responsible for the extension of water, sewer, and/or reuse, as approved in these plans, is responsible for contacting the Public Utilities Department at (919) 996-4540 at least twenty four hours prior to beginning any of their construction.

Failure to notify both City Departments in advance of beginning construction, will result in the issuance of monetary fines, and require reinstallation of any water or sewer facilities not inspected as a result of this notification failure.

Failure to call for Inspection, Install a Downstream Plug, have Permitted Plans on the Jobsite, or any other Violation of City of Raleigh Standards will result in a Fine and Possible Exclusion from future work in the City of Raleigh.

NCG01 GROUND STABILIZATION AND MATERIALS HANDLING

EFFECTIVE: 04/01/19

Table with 3 columns: Inspect, Frequency, and How often records must be made. Rows include Rain gauge maintenance, E&S Measure, Stormwater discharge, Perimeter dike, Streams or wetlands, and Erosion stabilization measures.

Table with 2 columns: Item to Document and Documentation Requirements. Rows include E&S Plan Documentation, Ground cover, Stormwater discharge, Perimeter dike, Streams or wetlands, and Erosion stabilization measures.

Table with 2 columns: Occurrence that must be reported and Reporting Timeframes (After Discovery) and Other Requirements. Rows include Occurrences that must be reported, Reporting Timeframes, and Other Requirements.

NCG01 SELF-INSPECTION, RECORDKEEPING AND REPORTING

EFFECTIVE: 04/01/19

Erosion Control Provisions:

- 1. NO PERSON MAY INITIATE A LAND DISTURBING ACTIVITY BEFORE NOTIFYING WAKE COUNTY WATERSHED MANAGEMENT OF THE DATE THAT THE LAND DISTURBING ACTIVITY WILL BEGIN.

Construction Sequence:

- 1. EROSION AND SEDIMENT CONTROL (E&S) PERMIT AND A CERTIFICATE OF COVERAGE (COC) MUST BE OBTAINED BEFORE ANY LAND DISTURBING ACTIVITIES OCCUR.

Final Drawing - Issued for Permit Review Purposes Only. Includes revision table and project information.

LEGEND AND NOTES WALLBROOK MASS GRADING / EROSION CONTROL / SANITARY SEWER RELOCATION. Includes project location and contact information.

ARK CONSULTING ENGINEERS & PLANNERS. Includes company logo and contact information.

Professional Engineer Seal for JEEVAN NEUPANE, State of North Carolina, License No. 12123.

Project Information: Project Manager: BCF, Drawn By: DLC, Checked By: STA, Project Number: 21089, Drawing Number: D-1219-EC, Date: April 1, 2022.

C0.2

LEGEND

TREE PRESERVATION AREA

- SURVEY WILL BE COMPLETED FOR TREES 6" DBH MIN. NOTING SIZE, SPECIES AND LOCATION
- SURVEY TO BE INCLUDED WITH SUBSEQUENT CONSTRUCTION DRAWING SUBMITTALS
- PRESERVATION AREA TO BE RECORDED AS PERMANENT EASEMENT ON FINAL PLAT

TREE PRESERVATION AREA AS BUFFER

- GENERAL HEALTH OF BUFFER TO BE ASSESSED BY ARBORIST WITH REPORT AND PHOTOS PROVIDED AT CONSTRUCTION DRAWING SUBMITTAL

TREE REPLACEMENT CALCULATION AREA (BUFFER AREAS TO BE CLEARED)

- REPLACEMENT RATIO = 1:1


DECIDUOUS TREE

- TO QUALIFY FOR REPLACEMENT, TREE MUST BE HEALTHY AND MEASURE AT LEAST 18" DIAMETER AT BREAST HEIGHT (DBH)
- REPLACEMENT = 2" MIN. CALIPER

EVERGREEN TREE

- TO QUALIFY FOR REPLACEMENT, TREE MUST BE HEALTHY AND MEASURE AT LEAST 20" DBH
- REPLACEMENT = 8" MIN. HEIGHT

TREE PROTECTION FENCE

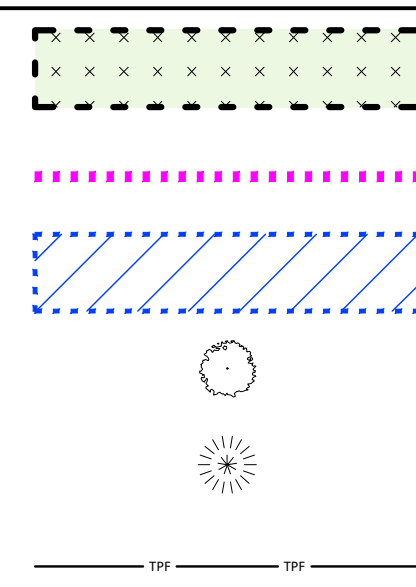

Update as per new lot layout

OVERALL TREE PRESERVATION AREA


Wallbrook + Paris + MBW	Area (SF)	Acres	
GROSS ACREAGE		69.37	
TREE PRESERVATION AREA REQUIRED		6.94	10.00%
TREE PRESERVATION AREA PROVIDED	389,426.9	8.94	12.89%
QUALIFYING REPLACEMENT DECIDUOUS			15
QUALIFYING REPLACEMENT EVERGREEN			8

TREE PRESERVATION AREA

Wallbrook	Area (SF)	Acres	
Lot 1A (Publix)	289,488.0	6.65	
Lot 1B	100,018.8	2.30	
Lot 1C	82,590.5	1.90	
Lot 2	74,702.8	1.71	
Lot 3	47,515.5	1.09	
Lot 4	78,725.4	1.81	
Lot 5 (Boat Tract)	220,767.8	5.07	
Lot 6 (Townhomes)	876,206.2	20.11	
Lot 7	119,306.6	2.74	
Lot 8	232,868.9	5.35	
Right-of-Way (Future)	290,799.5	6.68	
WALLBROOK GROSS ACREAGE		55.39	
TREE PRESERVATION AREA	373,027.4	8.56	15.46%
QUALIFYING REPLACEMENT DECIDUOUS			12
QUALIFYING REPLACEMENT EVERGREEN			8

Paris Tract	Area (SF)	Acres	
Lot 9	86,013.5	1.97	
Lot 10	136,382.3	3.13	
Lot 11	70,406.6	1.62	
Right-of-Way (Future)	13,978.4	0.32	
PARIS TRACT GROSS ACREAGE		7.04	
TREE PRESERVATION AREA	16,399.5	0.38	5.35%
QUALIFYING REPLACEMENT DECIDUOUS			2
QUALIFYING REPLACEMENT EVERGREEN			0

MBW Tract	Area (SF)	Acres	
Lot 12	223,658.5	5.13	
Lot 13	60,807.1	1.40	
Lot 14	17,893.2	0.41	
MBW GROSS ACREAGE		6.94	
TREE PRESERVATION AREA	0.0	0.00	0.00%
QUALIFYING REPLACEMENT DECIDUOUS			1
QUALIFYING REPLACEMENT EVERGREEN			0

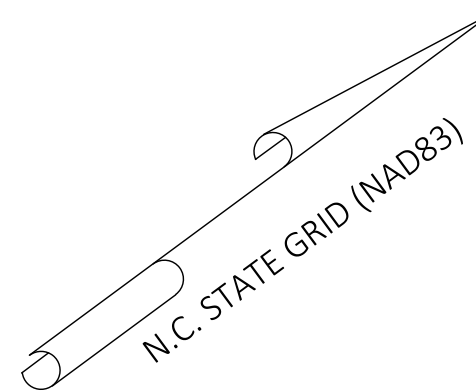

- Final Drawing -
Issued for Permit
Review Purposes Only

REVISIONS:

#	DATE	DESCRIPTION
1	15-JUN-23	REVISED PER OWNER COMMENTS
2	12-JUL-23	REVISED PER TOR & WAKE COUNTY COMMENTS
3	1-FEB-24	REVISED PER OWNER COMMENTS



TREE PRESERVATION PLAN
WALLBROOK
MASS GRADING / EROSION CONTROL /
SANITARY SEWER RELOCATION
Town of Rolesville Project No. CD 22-02
Rolesville, Wake County, North Carolina




NC License: P-1159
ARK CONSULTING GROUP PLLC
ENGINEERS & PLANNERS
2755-B Charles Blvd
Raleigh, NC 27608
(754) 558-0888
www.arkconsultinggroup.com

Project Manager: BCF
Drawn By: DLC
Checked By: STA
Project Number: 21089
Drawing Number: D-1219-EC

C0.3

Date: April 1, 2022

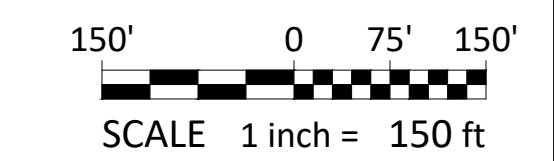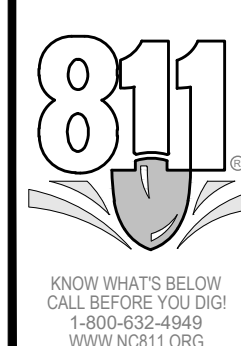

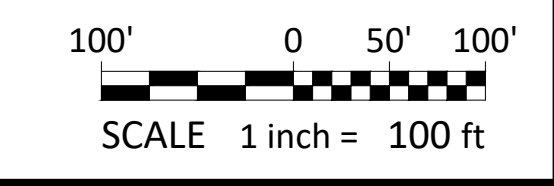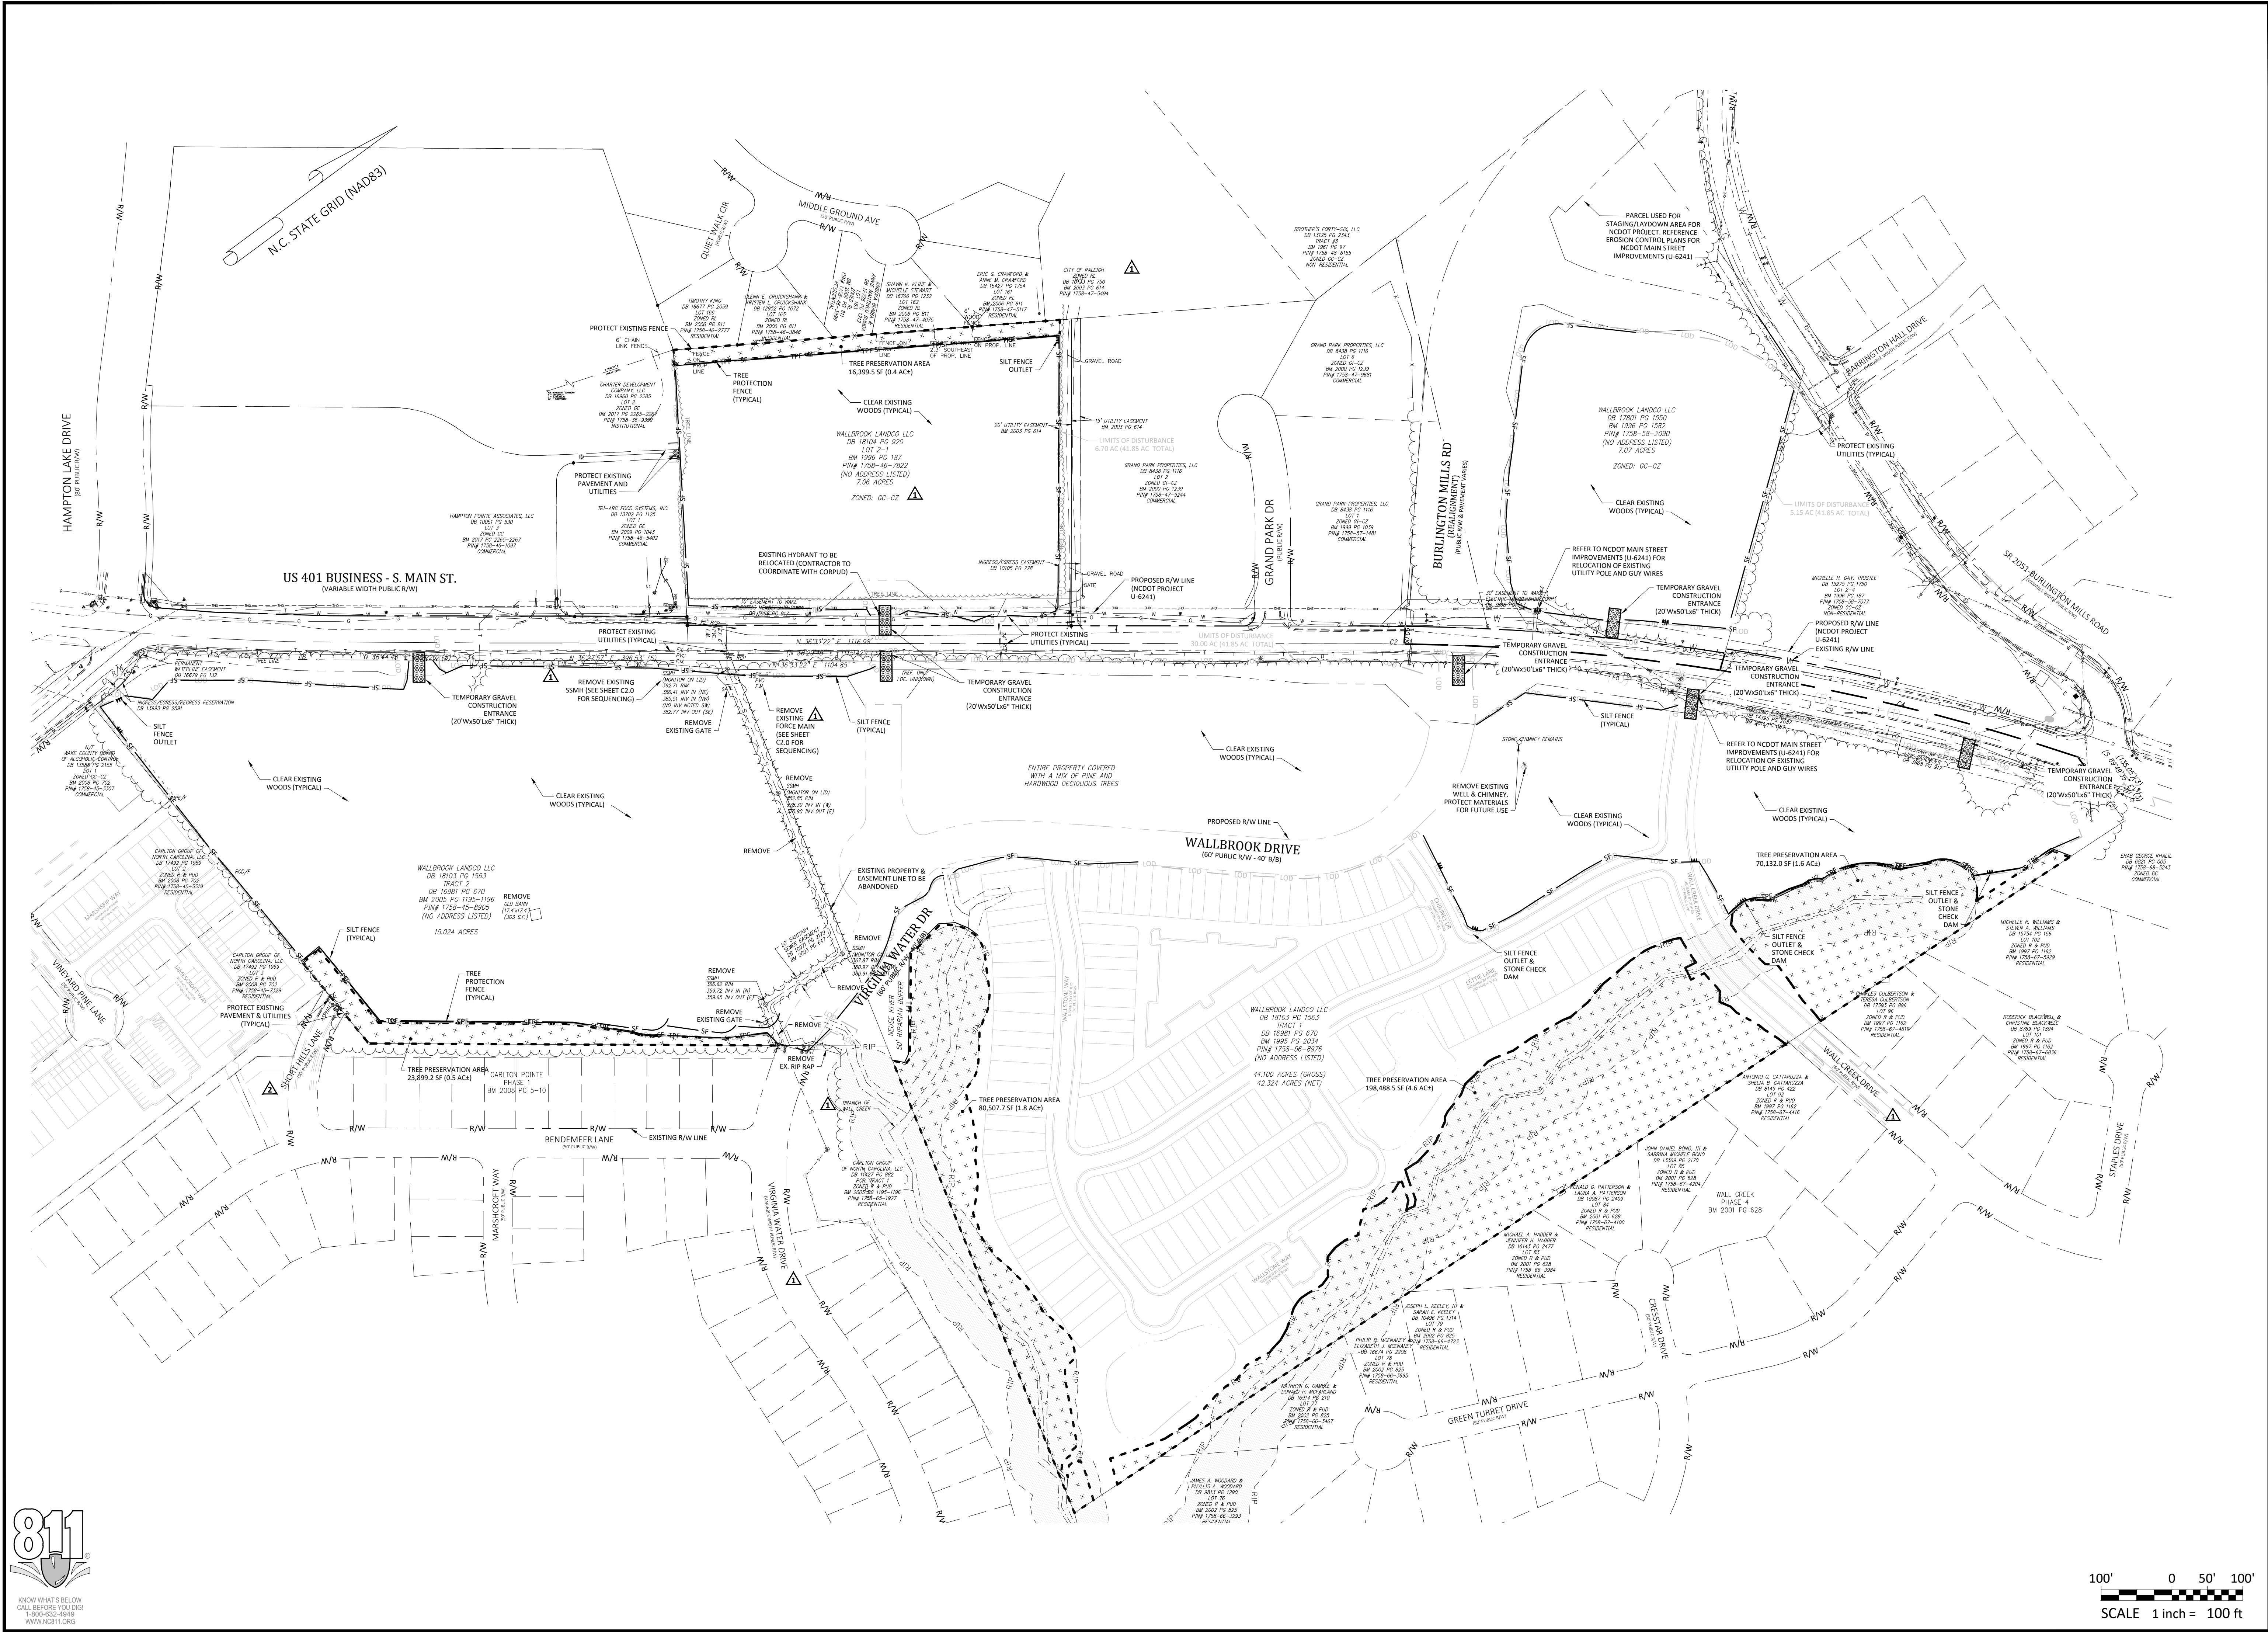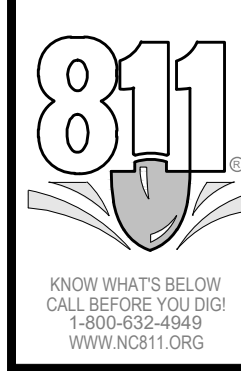

- Final Drawing -
Issued for Permit
Review Purposes Only

NO.	DATE	DESCRIPTION
1	11-15-2023	REVISED PER OWNER COMMENTS
2	12-21-2023	REVISED PER TOR & WAKE COUNTY COMMENTS
3	1-15-2024	REVISED PER TOR & WAKE COUNTY COMMENTS




DEMO / CLEARING PLAN
WALLBROOK
MASS GRADING / EROSION CONTROL /
SANITARY SEWER RELOCATION
Town of Rolesville Project No. CD 22-02
Rolesville, Wake County, North Carolina


NC License: P-1109
ARK CONSULTING GROUP PLLC
ENGINEERS & PLANNERS
2755-B Charles Blvd.
Raleigh, NC 27658
(919) 558-0888
www.arkconsultinggroup.com

Project Manager:	BCF
Drawn By:	DLC
Checked By:	STA
Project Number:	21089
Drawing Number:	D-1219-EC


C1.0
Date: April 1, 2022

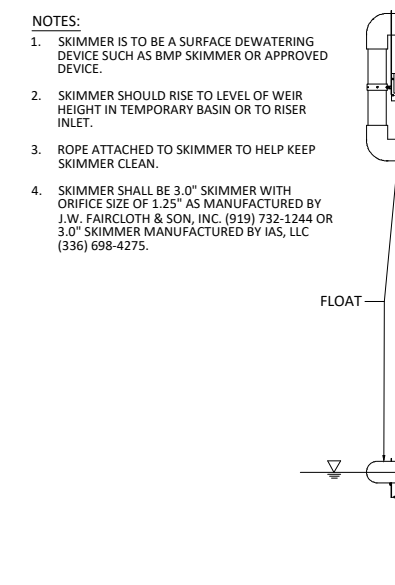


SKIMMER DISCHARGE SYSTEM WITH OUTLET STRUCTURE FOR SSB-1

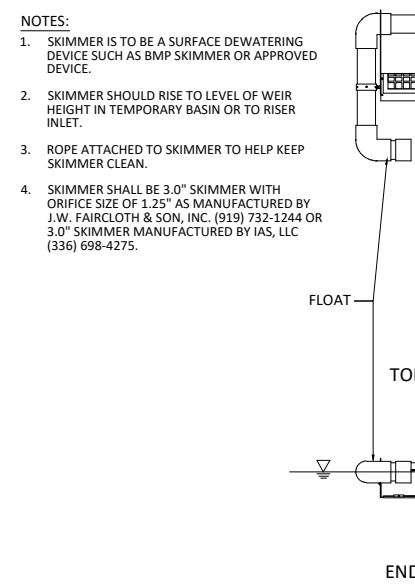



SKIMMER DISCHARGE SYSTEM WITH OUTLET STRUCTURE FOR SSB-2

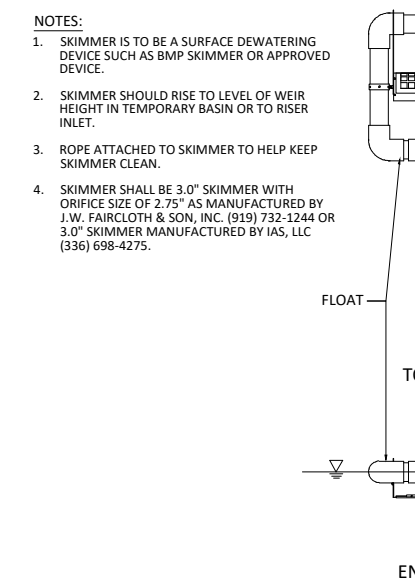

SKIMMER DISCHARGE SYSTEM WITH OUTLET STRUCTURE FOR TSB-1

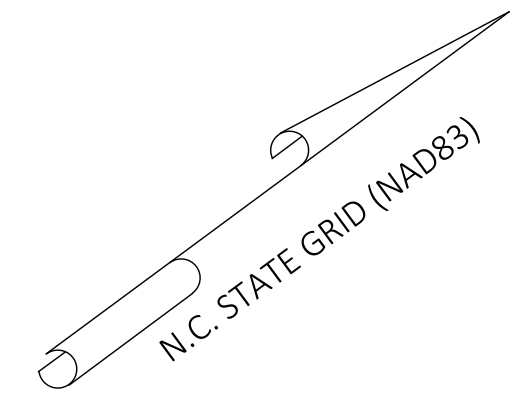

US 401 BUSINESS - S. MAIN ST.
(VARIABLE WIDTH PUBLIC R/W)

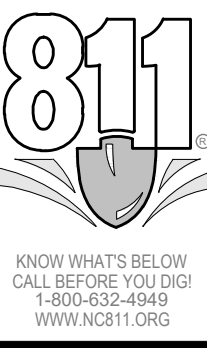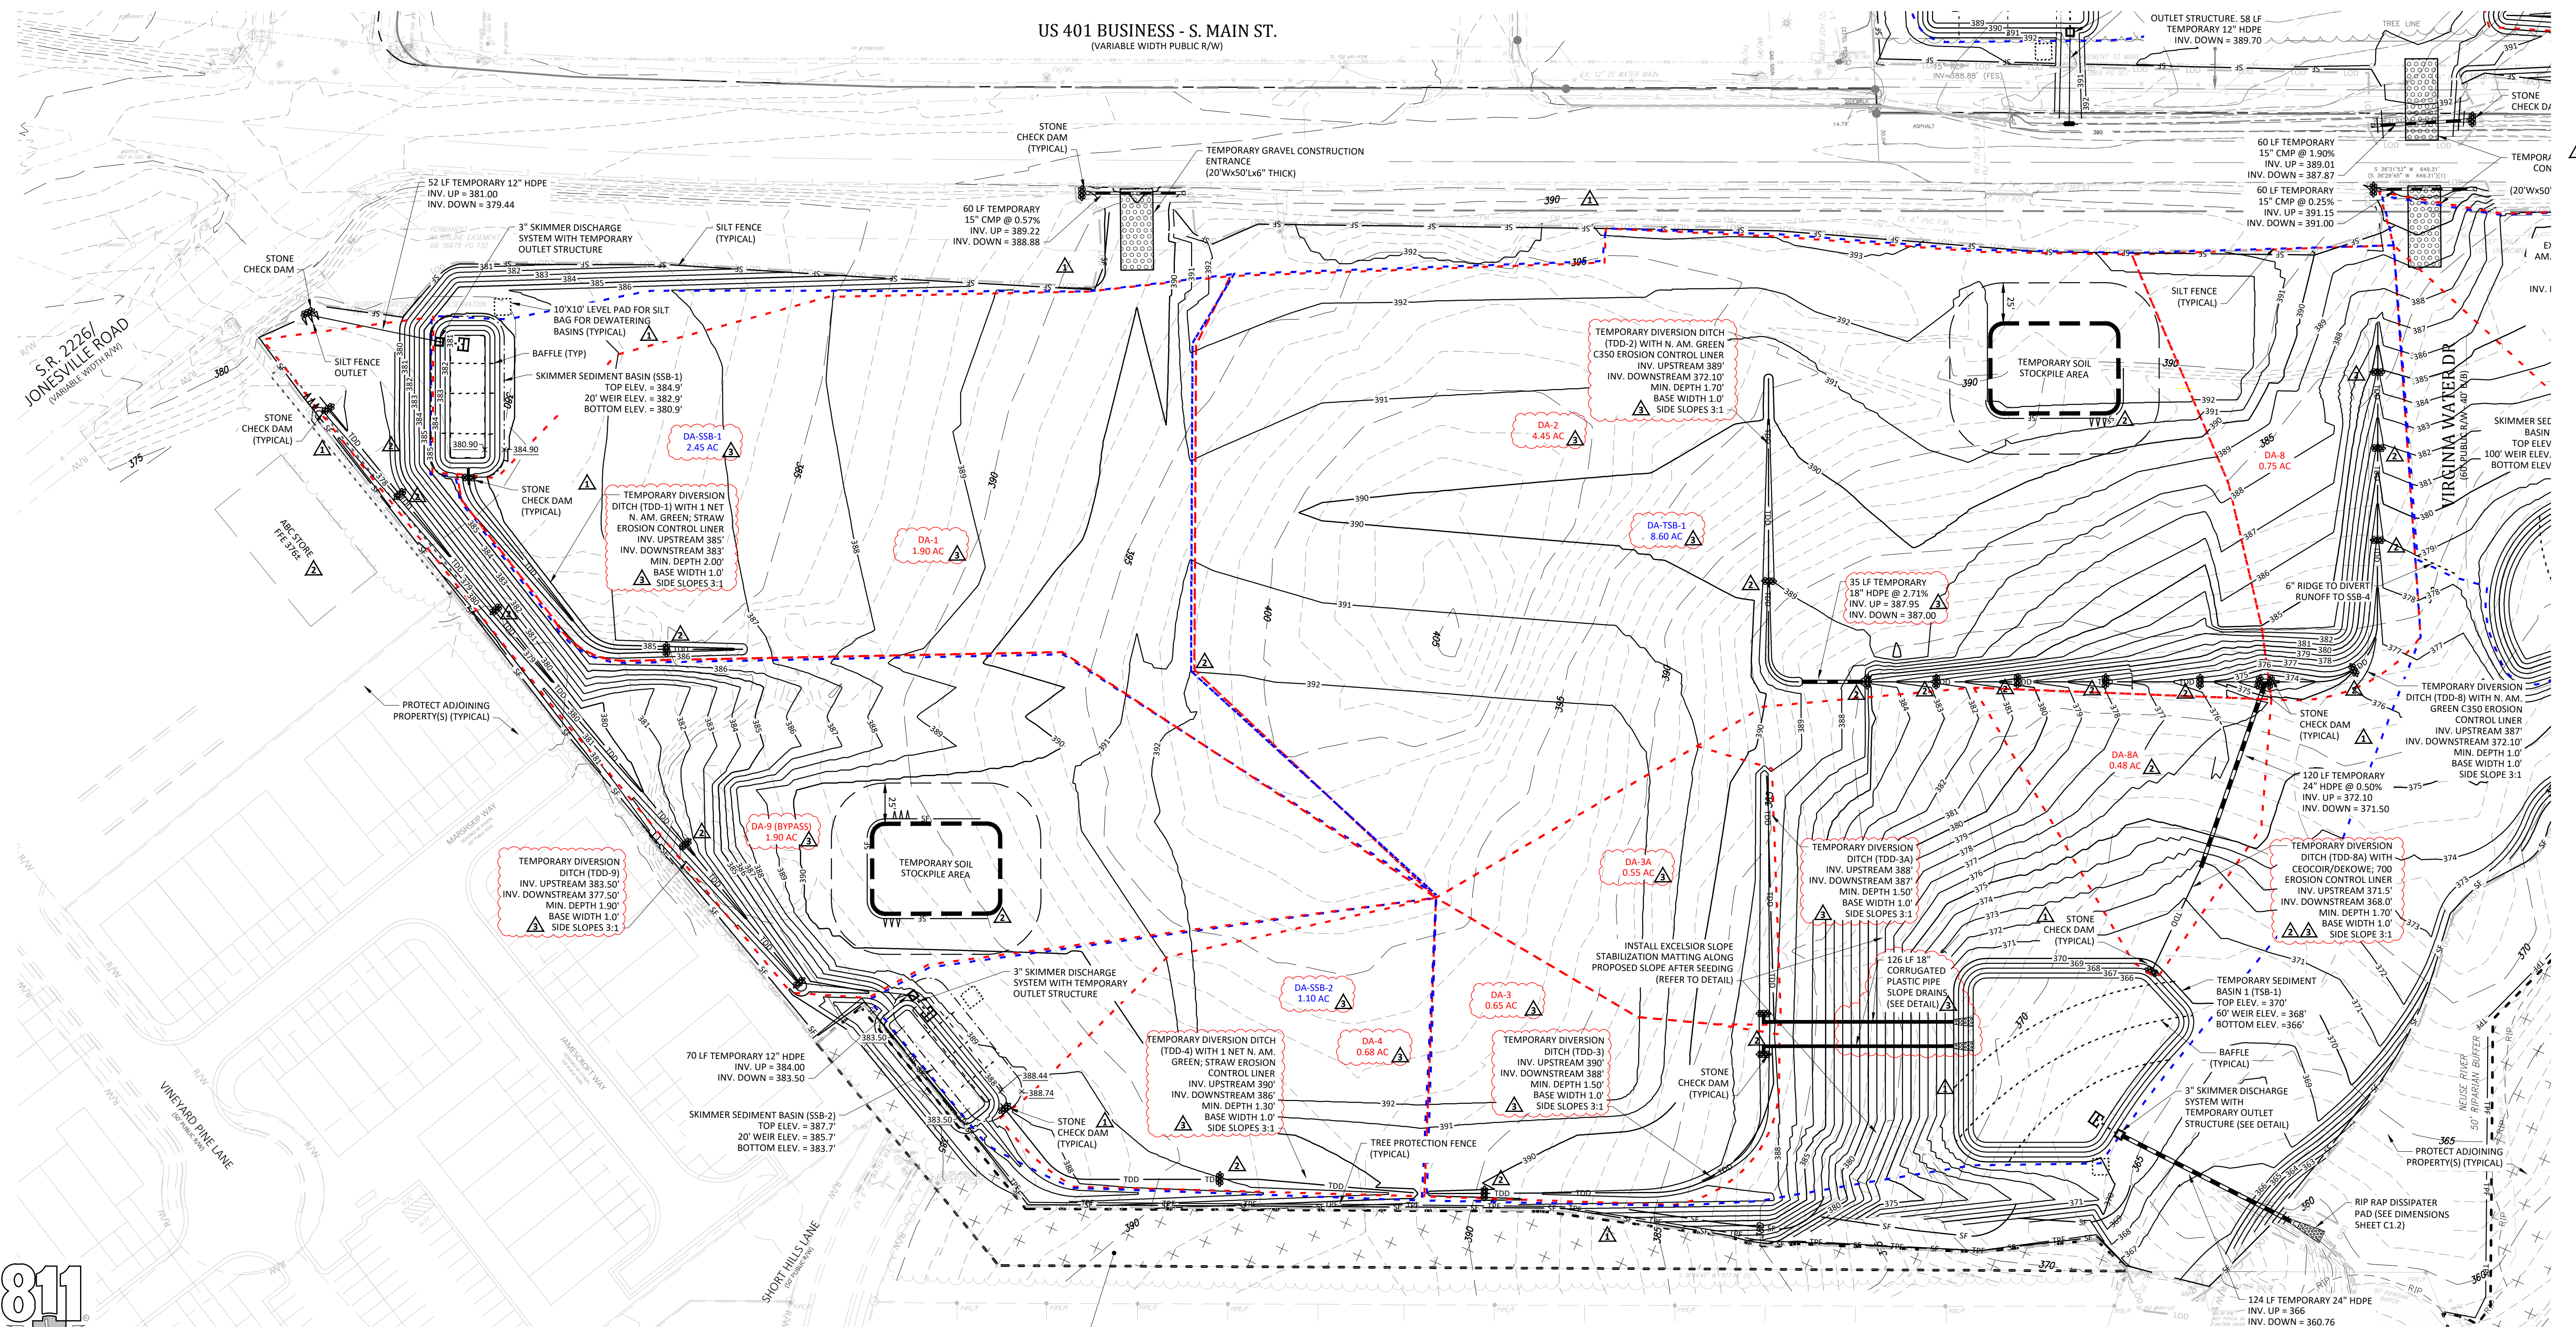

- Final Drawing -
Issued for Permit
Review Purposes Only

REVISIONS:

#	DATE	DESCRIPTION
1	11-FEB-23	REVISED PER OWNER COMMENTS
2	22-JUL-23	REVISED PER TOR & WAKE COUNTY COMMENTS
3	15-JUN-23	REVISED PER TOR & WAKE COUNTY COMMENTS



MASS GRADING PLAN - SHOPPING CENTER (LOTS 1-4)

WALLBROOK
MASS GRADING / EROSION CONTROL /
SANITARY SEWER RELOCATION

Town of Rolesville Project No. CD 22-02
Rolesville, Wake County, North Carolina

NC License: P-1199


ARK CONSULTING GROUP PLLC
ENGINEERS & PLANNERS



2755-B Churchs Road
Raleigh, NC 27658
(919) 858-0888
www.arkconsultinggroup.com

Project Manager: BCF
Drawn By: DLC
Checked By: STA
Project Number: 21089
Drawing Number: D-1219-EC

C1.1

Date: April 1, 2022

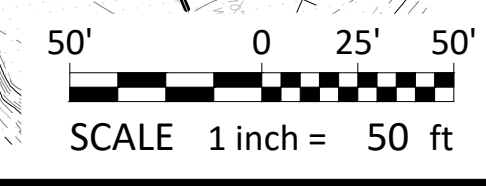

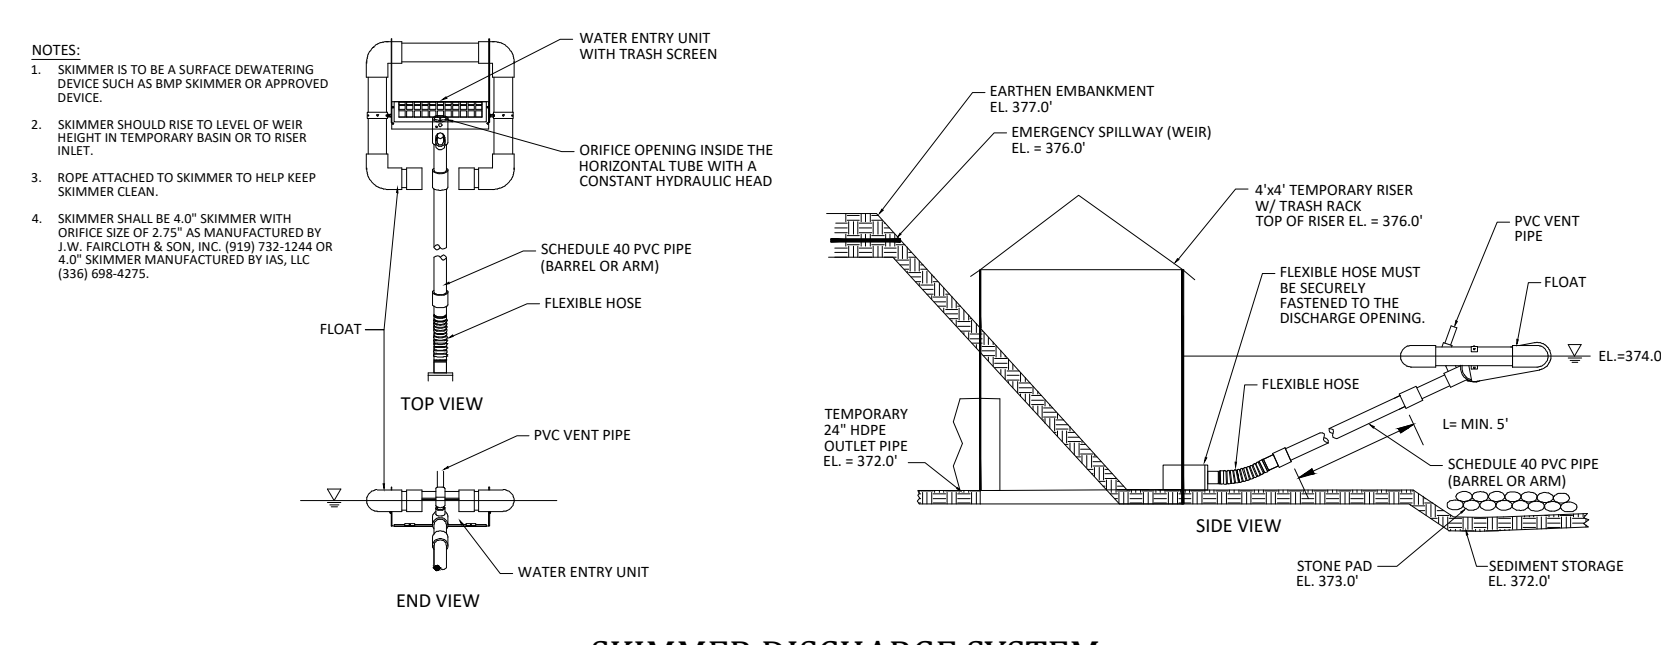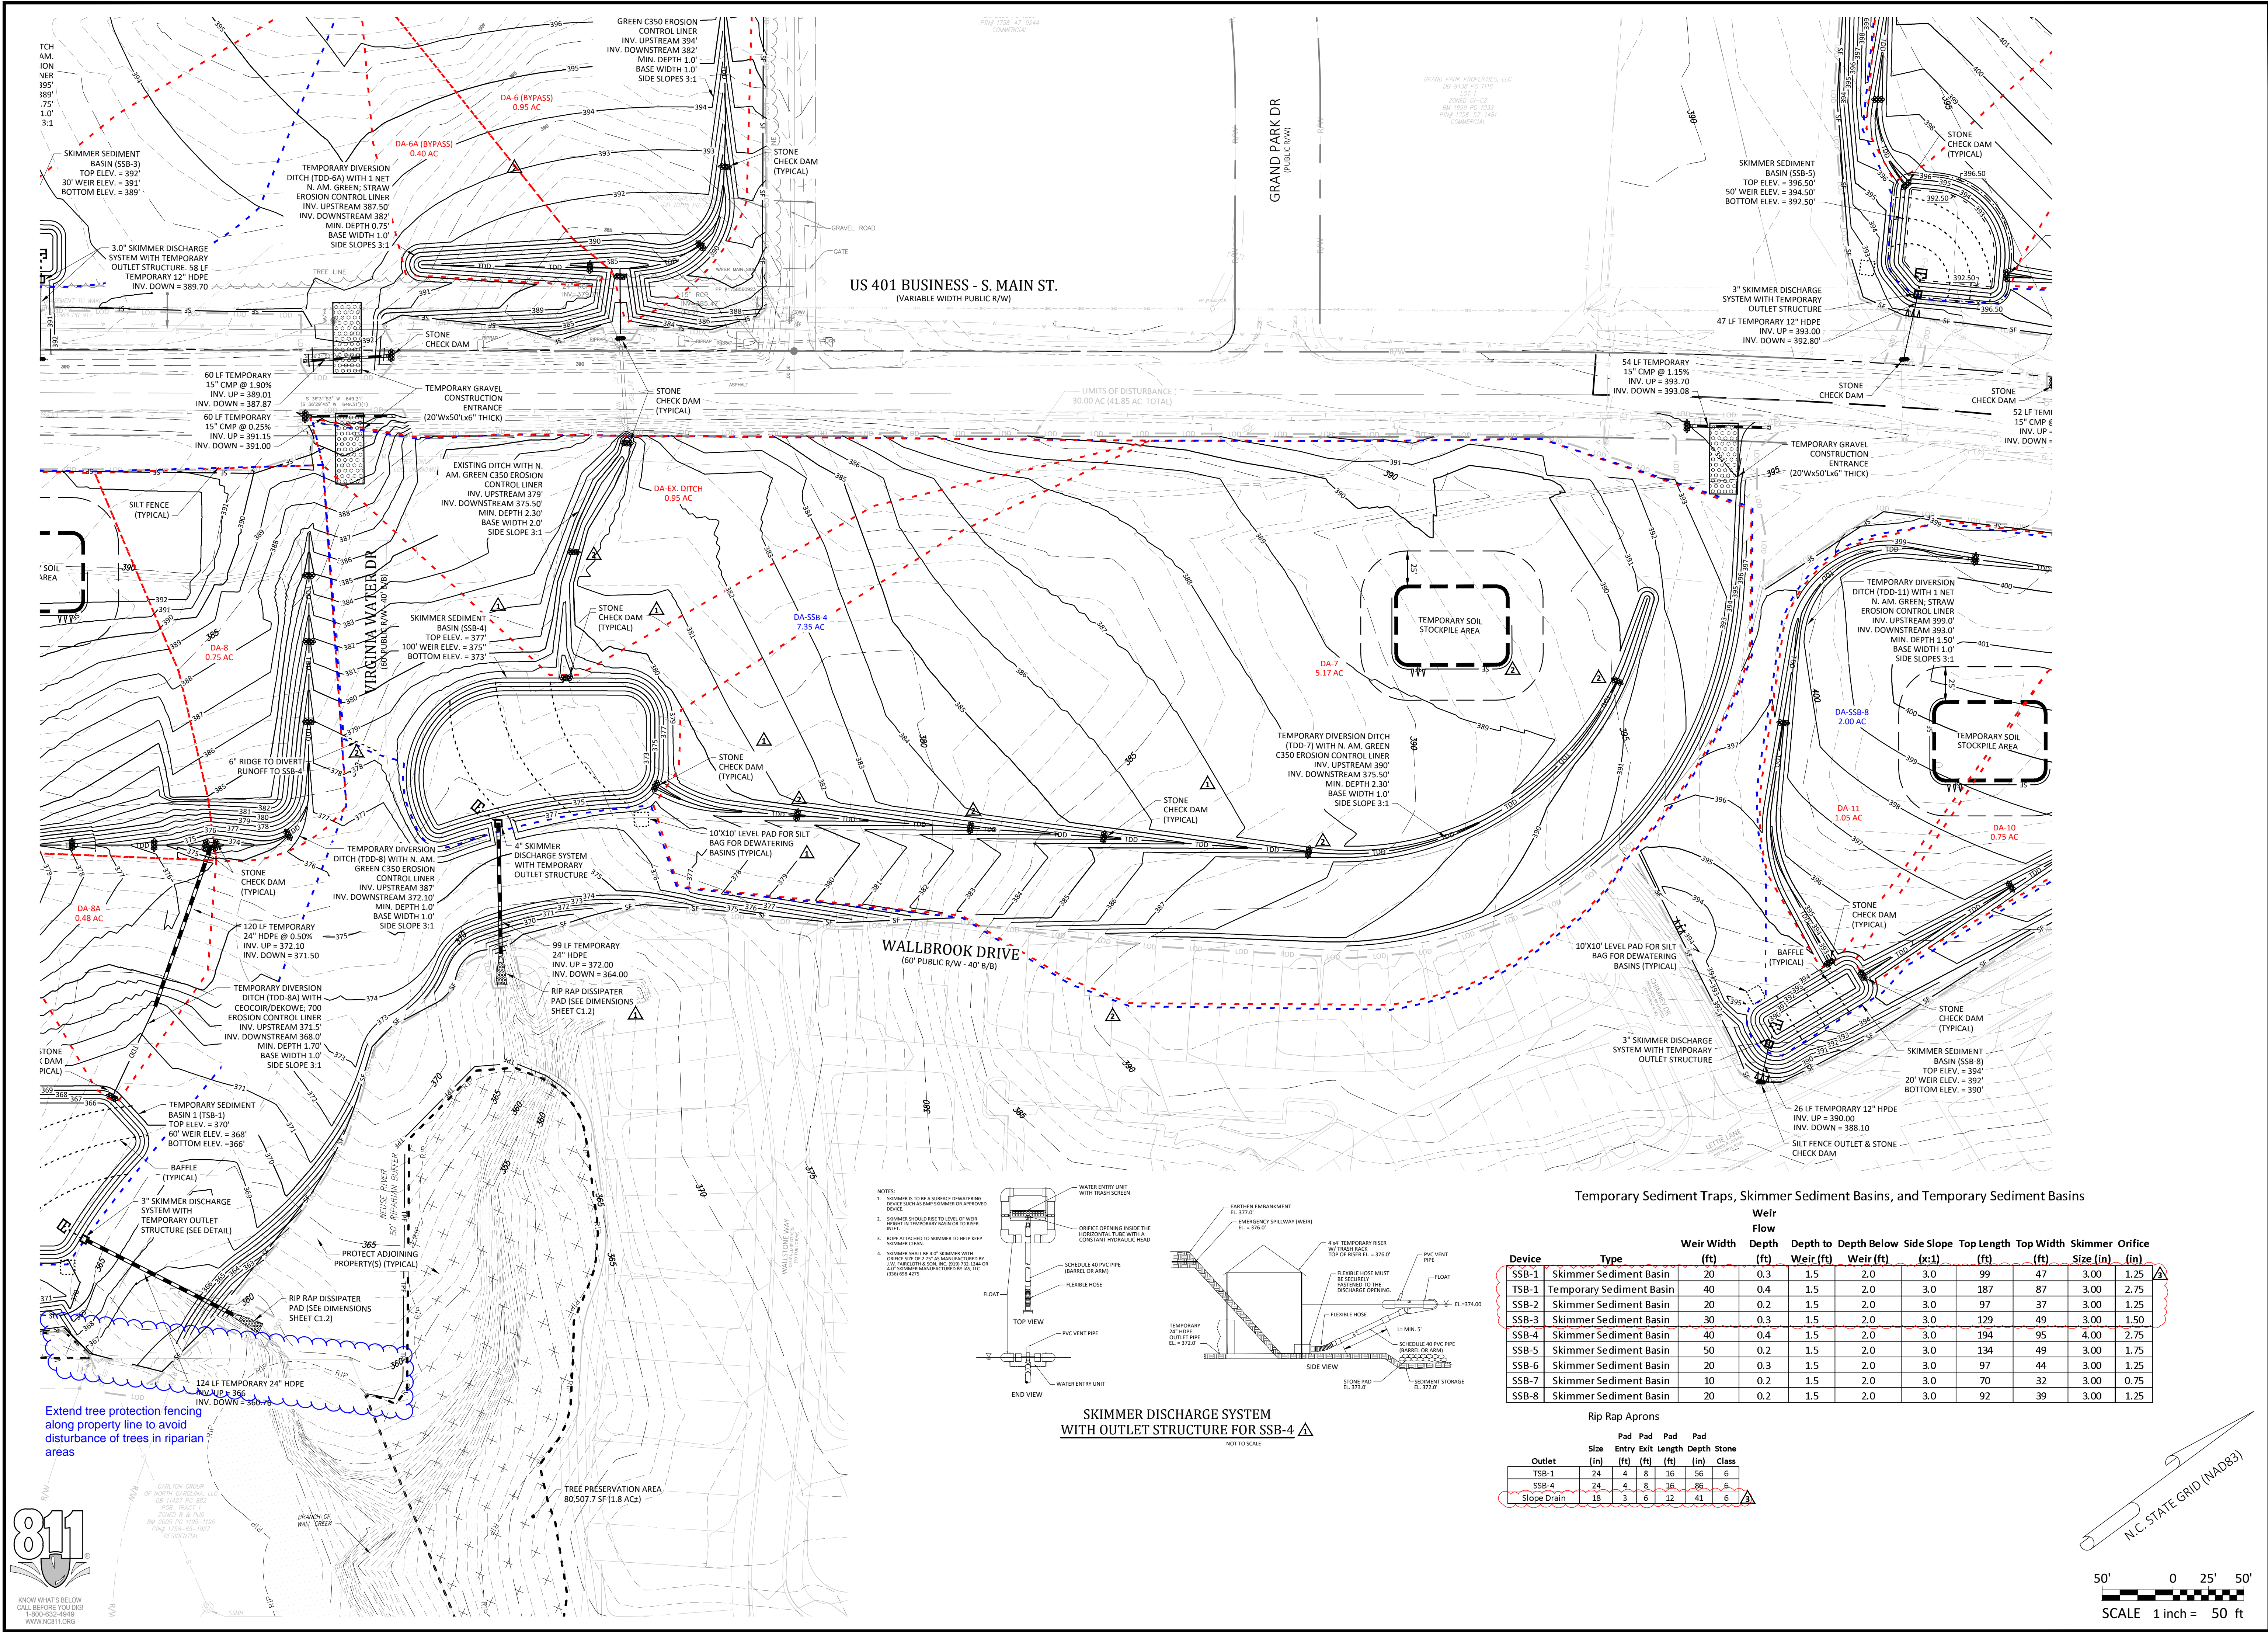

Temporary Sediment Traps, Skimmer Sediment Basins, and Temporary Sediment Basins

Device	Type	Weir Width (ft)	Weir Depth (ft)	Depth Below Weir (ft)		Side Slope (x:1)	Top Length (ft)	Top Width (ft)	Skimmer Orifice	
				Depth (ft)	Depth (ft)				Size (in)	Spacing (in)
SSB-1	Skimmer Sediment Basin	20	0.3	1.5	2.0	3.0	99	47	3.00	1.25
TSB-1	Temporary Sediment Basin	40	0.4	1.5	2.0	3.0	187	87	3.00	2.75
SSB-2	Skimmer Sediment Basin	20	0.2	1.5	2.0	3.0	97	37	3.00	1.25
SSB-3	Skimmer Sediment Basin	30	0.3	1.5	2.0	3.0	129	49	3.00	1.50
SSB-4	Skimmer Sediment Basin	40	0.4	1.5	2.0	3.0	194	95	4.00	2.75
SSB-5	Skimmer Sediment Basin	50	0.2	1.5	2.0	3.0	134	49	3.00	1.75
SSB-6	Skimmer Sediment Basin	20	0.3	1.5	2.0	3.0	97	44	3.00	1.25
SSB-7	Skimmer Sediment Basin	10	0.2	1.5	2.0	3.0	70	32	3.00	0.75
SSB-8	Skimmer Sediment Basin	20	0.2	1.5	2.0	3.0	92	39	3.00	1.25

Outlet	Size (in)	Pad Entry (ft)	Pad Exit (ft)	Pad Length (ft)	Pad Depth (ft)	Stone Class
TSB-1	24	4	8	16	56	6
SSB-4	24	4	8	16	86	6
Slope Drain	18	3	6	12	41	6

- Final Drawing -
Issued for Permit
Review Purposes Only

REVISIONS:

#	DATE	DESCRIPTION
1	11-15-JUN-23	REVISED PER TOS & WAKE COUNTY COMMENTS
2	12-21-JUL-23	REVISED PER TOS & WAKE COUNTY COMMENTS
3	1-FEB-24	REVISED PER OWNER COMMENTS

CROSLAND SOUTHEAST




MASS GRADING - WALLBROOK DRIVE / LOT 5
WALLBROOK
MASS GRADING / EROSION CONTROL /
SANITARY SEWER RELOCATION
 Town of Rolesville Project No. CD 22-02
 Rolesville, Wake County, North Carolina

ARK CONSULTING GROUP PLLC
 ENGINEERS & PLANNERS
 2755-B Chapel Hill Rd.
 Raleigh, NC 27688
 (919) 876-0888
 www.arkconsultinggroup.com

Project Manager: BCF
 Drawn By: DLC
 Checked By: STA
 Project Number: 21089
 Drawing Number: D-1219-EC

C1.2
 Date: April 1, 2022

Device ID	Device Type	Add'l Flow (cfs)**	Disturbed Area (AC)	Tc (min)	Intensity (in/hr)*	C	Qreq (cfs)	Up Invert	Down Invert	Length (ft)	Base Width (ft)	Left Slope (x:1)	Right Slope (x:1)	Flow Depth (ft)	Manning's n	Slope (ft/ft)	Wetted Area (sf)	Wetted Perimeter (ft)	Hydraulic Radius (ft)	Velocity (ft/s)	Qa (cfs)	Qa-Qreq?	(lbs/ft ²)	Liner Type	Allowable Shear Stress, τ (lbs/ft ²)
TDD-1	Temporary Diversion	0	1.90	5	7.18	0.5	6.82	385	383	225	1	3	3	2.02	0.020	0.00889	14.28	8.23	1.73	0.48	6.82	Yes	1.12102182	N. Am. Green; Straw; 1 nets	1.55
TDD-2	Temporary Diversion	0	4.45	5	7.18	0.5	15.98	389	372	480	1	3	3	1.68	0.020	0.03542	10.20	7.88	1.29	1.57	15.98	Yes	3.722902183	North Am. Green C350; Bare soil	3
TDD-3	Temporary Diversion	0	0.65	5	7.18	0.5	2.33	390	387	330	1	3	3	1.39	0.020	0.00909	7.17	7.61	1.04	0.33	2.33	Yes	0.787559626	N. Am. Green; Straw; 1 nets	1.55
TDD-3A	Temporary Diversion	0	0.55	5	7.18	0.5	1.97	388	387	152	1	3	3	1.46	0.020	0.00658	7.90	7.68	1.03	0.25	1.97	Yes	0.601397066	N. Am. Green; Straw; 1 nets	1.55
TDD-4	Temporary Diversion	0	0.68	5	7.18	0.5	2.44	390	386	260	1	3	3	1.18	0.020	0.01538	5.33	7.44	0.72	0.46	2.44	Yes	1.129058959	N. Am. Green; Straw; 1 nets	1.55
TDD-5	Temporary Diversion	0	3.50	5	7.18	0.5	12.57	395	389	915	1	3	3	2.77	0.020	0.06056	25.80	9.17	2.81	0.49	12.57	Yes	1.133788189	N. Am. Green; Straw; 1 nets	1.55
TDD-6	Temporary Diversion	0	0.95	5	7.18	0.5	3.41	394	382	270	1	3	3	0.91	0.020	0.04444	3.41	7.27	0.47	1.00	3.41	Yes	2.531233515	North Am. Green C350; Bare soil	3
TDD-6A	Temporary Diversion	0	0.40	5	7.18	0.5	1.44	387.5	382	140	1	3	3	0.70	0.020	0.03929	2.17	7.16	0.30	0.66	1.44	Yes	1.71749551	N. Am. Green; Straw; 1 nets	1.55
TDD-7	Temporary Diversion	0	5.17	5	7.18	0.5	18.56	389	375.5	790	1	3	3	2.28	0.020	0.01709	17.84	8.53	2.09	1.04	18.56	Yes	2.428362949	North Am. Green C350; Bare soil	3
Ex. Ditch	Temporary Diversion	22.5	0.95	5	7.18	0.5	0.194	379	375.5	180	2	3	3	2.34	0.020	0.01944	21.15	9.61	2.20	1.23	25.91	Yes	2.842311197	North Am. Green C350; Bare soil	3
TDD-8	Temporary Diversion	0.0	0.75	5	7.18	0.5	2.69	387	372	280	1	3	3	0.79	0.020	0.06357	2.64	7.20	0.37	1.02	2.69	Yes	2.625893726	North Am. Green C350; Bare soil	3
TDD-8A	Temporary Diversion	18.7	0.48	5	7.18	0.5	20.39	371.5	368	72	1	3	3	1.64	0.020	0.04861	9.74	7.84	1.24	2.09	20.39	Yes	4.984271435	Geocor/Dekow; 700	4.46
TDD-9	Temporary Diversion	0.0	1.90	5	7.18	0.5	6.82	383.5	377.5	510	1	3	3	1.84	0.020	0.01176	11.95	8.03	1.49	0.57	6.82	Yes	1.347752524	N. Am. Green; Straw; 1 nets	1.55
TDD-10	Temporary Diversion	0.0	0.75	5	7.18	0.5	2.69	399	393	320	1	3	3	1.14	0.020	0.01875	5.01	7.42	0.68	0.54	2.69	Yes	1.329241862	N. Am. Green; Straw; 1 nets	1.55
TDD-11	Temporary Diversion	0.0	1.05	5	7.18	0.5	3.77	399	393	475	1	3	3	1.46	0.020	0.01263	7.87	7.67	1.03	0.48	3.77	Yes	1.152416199	N. Am. Green; Straw; 1 nets	1.55
TDD-12	Temporary Diversion	0.0	0.60	5	7.18	0.5	2.15	398	389	200	1	3	3	0.77	0.020	0.04500	2.56	7.20	0.36	0.84	2.15	Yes	2.167621783	North Am. Green C350; Bare soil	3
TDD-13	Temporary Diversion	0.0	1.50	5	7.18	0.5	5.39	394	389	300	1	3	3	1.50	0.020	0.01667	8.27	7.71	1.07	0.65	5.39	Yes	1.56258756	N. Am. Green; Straw; 1 nets	1.55
TDD-14	Temporary Diversion	0.0	0.65	5	7.18	0.5	2.33	393	392	70	1	3	3	1.19	0.020	0.01429	5.42	7.45	0.73	0.43	2.33	Yes	1.058984487	N. Am. Green; Straw; 1 nets	1.55
TDD-15	Temporary Diversion	0.0	1.40	5	7.18	0.5	5.03	409	394	505	1	3	3	1.20	0.020	0.02970	5.54	7.46	0.74	0.91	5.03	Yes	2.228858608	North Am. Green C350; Bare soil	3
TDD-16	Temporary Diversion	0.0	2.00	5	7.18	0.5	7.18	408	394	600	1	3	3	1.48	0.020	0.02333	8.03	7.69	1.04	0.89	7.18	Yes	2.151294143	North Am. Green C350; Bare soil	3

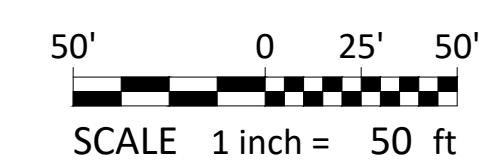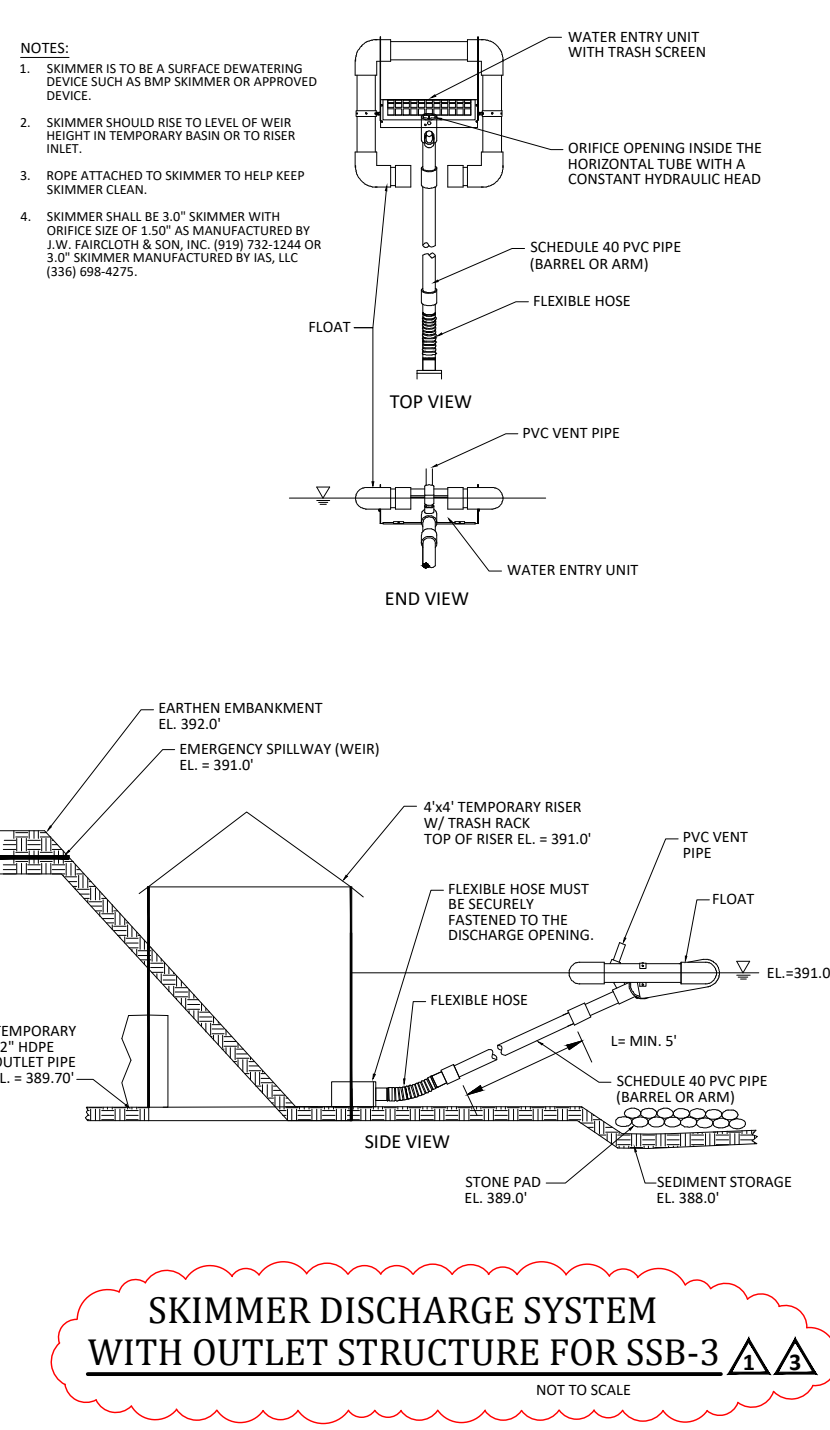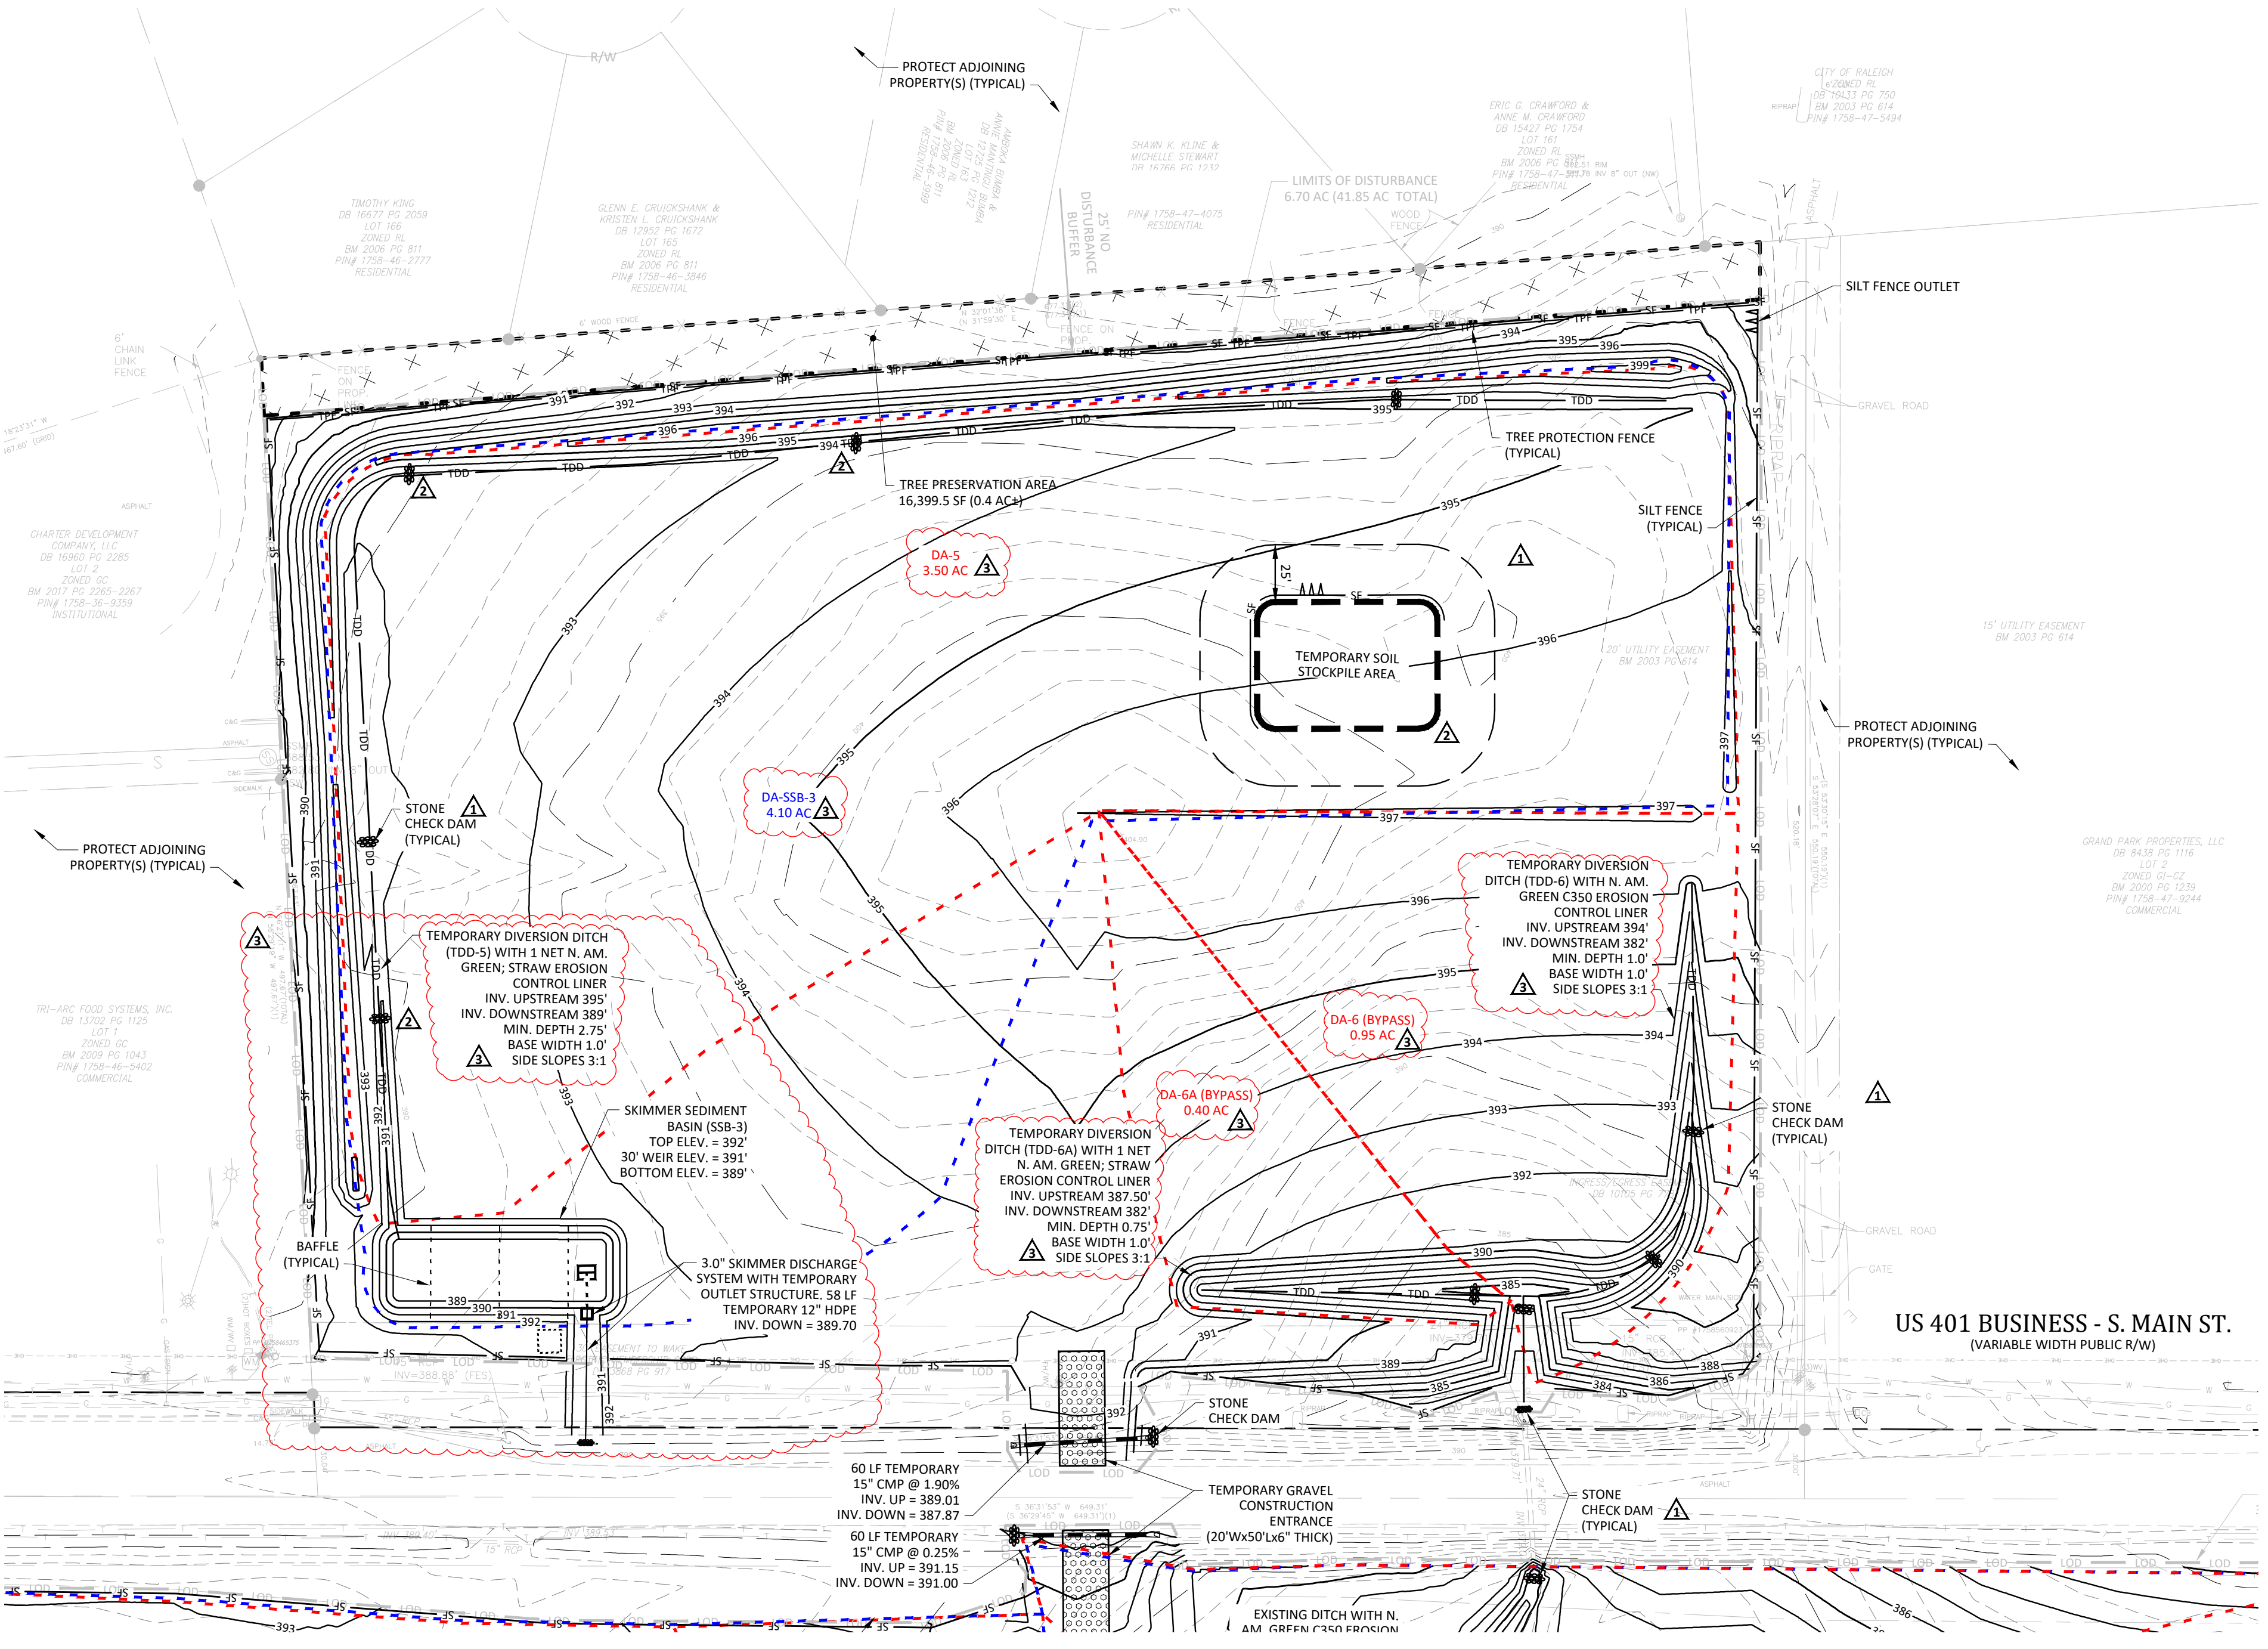

- Final Drawing -
Issued for Permit
Review Purposes Only

REVISIONS:

#	DATE	DESCRIPTION
1	15-JUN-22	REVISED PER OWNER COMMENTS
2	22-JUL-22	REVISED PER TOR & WAKE COUNTY COMMENTS
3	1-FEB-23	REVISED PER OWNER COMMENTS



MASS GRADING - PARIS TRACT (LOTS 9, 10, & 11)
WALLBROOK
MASS GRADING / EROSION CONTROL /
SANITARY SEWER RELOCATION
 Town of Rolesville Project No. CD 22-02
 Rolesville, Wake County, North Carolina

NC License: P-1109

ARK CONSULTING GROUP PLLC
 ENGINEERS & PLANNERS

2755-B Charles Blvd.
 Cary, NC 27588
 (252) 558-0888
 www.arkconsultinggroup.com




2/1/2023

Project Manager: BCF
 Drawn By: DLC
 Checked By: STA
 Project Number: 21089
 Drawing Number: D-1219-EC


C1.3

Date: April 1, 2022



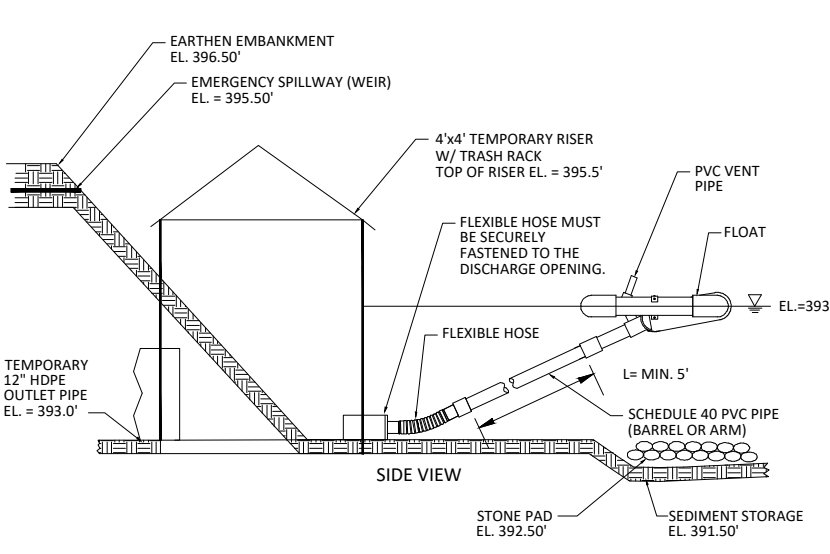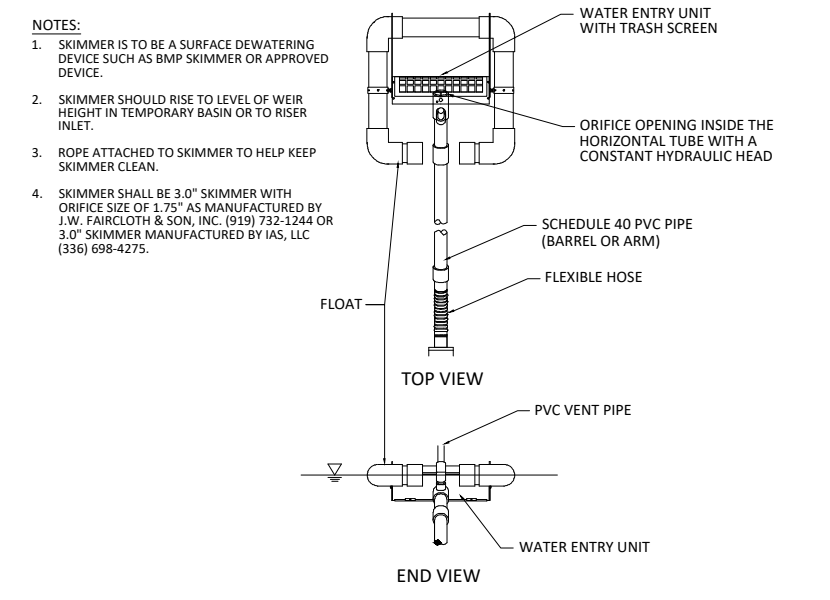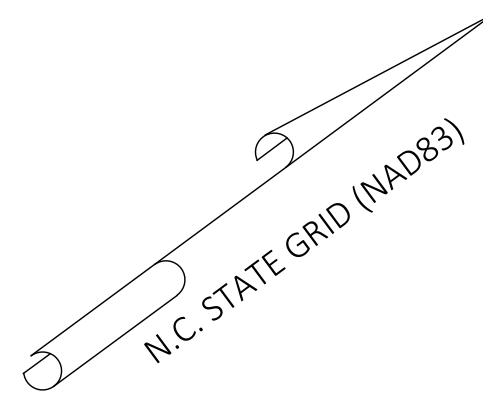

SKIMMER DISCHARGE SYSTEM WITH OUTLET STRUCTURE FOR SSB-5
NOT TO SCALE

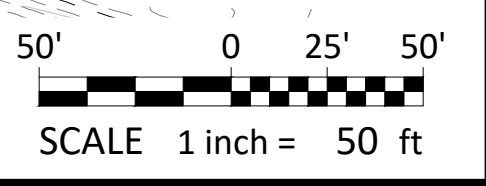

- Final Drawing -
Issued for Permit
Review Purposes Only

#	DATE	DESCRIPTION
1	1-FEB-23	REVISED PER OWNER COMMENTS
2	12-JUL-23	REVISED PER TOR & WAKE COUNTY COMMENTS
3	15-JUN-23	REVISED PER TOR & WAKE COUNTY COMMENTS




MASS GRADING - MBW TRACT (LOTS 12, 13, & 14)
WALLBROOK
MASS GRADING / EROSION CONTROL /
SANITARY SEWER RELOCATION
Town of Rolesville Project No. CD 22-02
Rolesville, Wake County, North Carolina

NC License: P-1129
ARK CONSULTING GROUP PLLC
ENGINEERS & PLANNERS
2755 B Church's Blvd.
Raleigh, NC 27658
(919) 558-0888
www.arkconsultinggroup.com



Project Manager: BCF
Drawn By: DLC
Checked By: STA
Project Number: 21089
Drawing Number: D-1219-EC

C1.4



Date: April 1, 2022

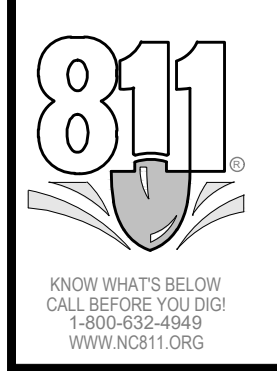



DATE PLOTTED: 4/1/2022 10:58:11 AM
PLOTTER: HP DesignJet T1100e
SCALE: 1/8" = 1'-0"
SHEET: 1 OF 1
PROJECT: MASS GRADING - WALLBROOK - FINAL UTILITY PLAN
DRAWN BY: BCF
CHECKED BY: STA
DATE: 4/1/2022

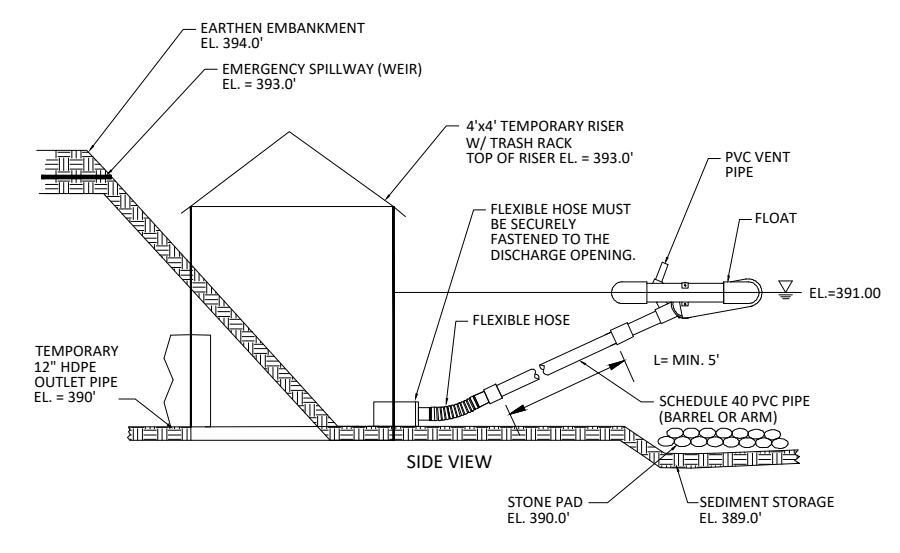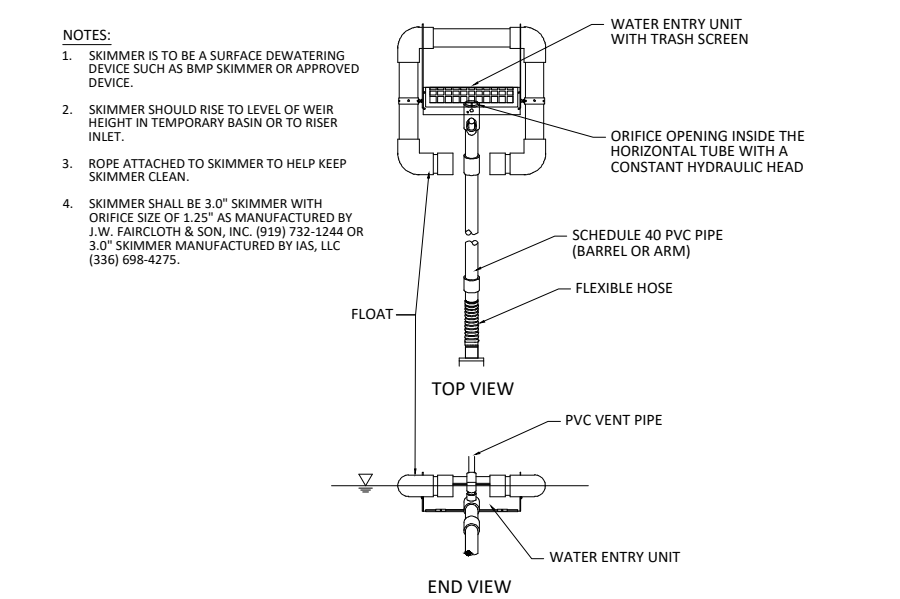



SKIMMER DISCHARGE SYSTEM WITH OUTLET STRUCTURE FOR SSB-8
NOT TO SCALE

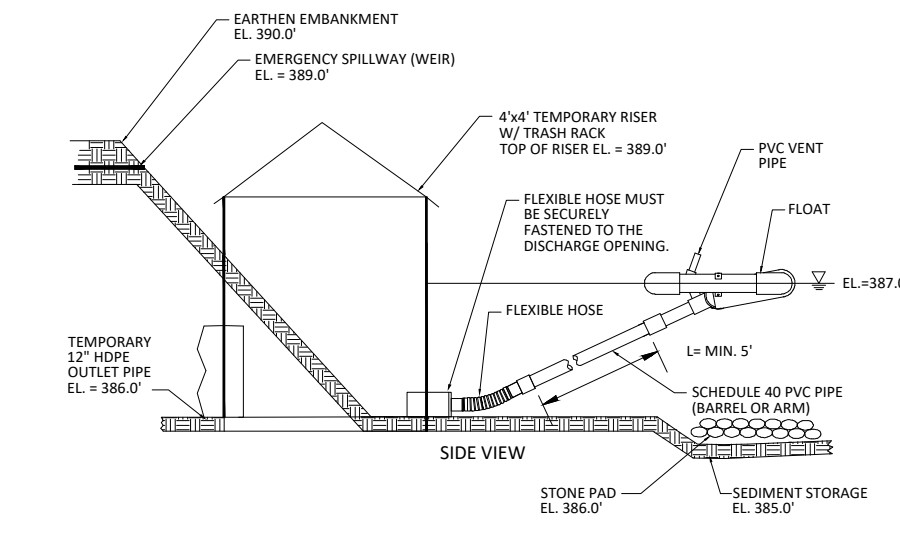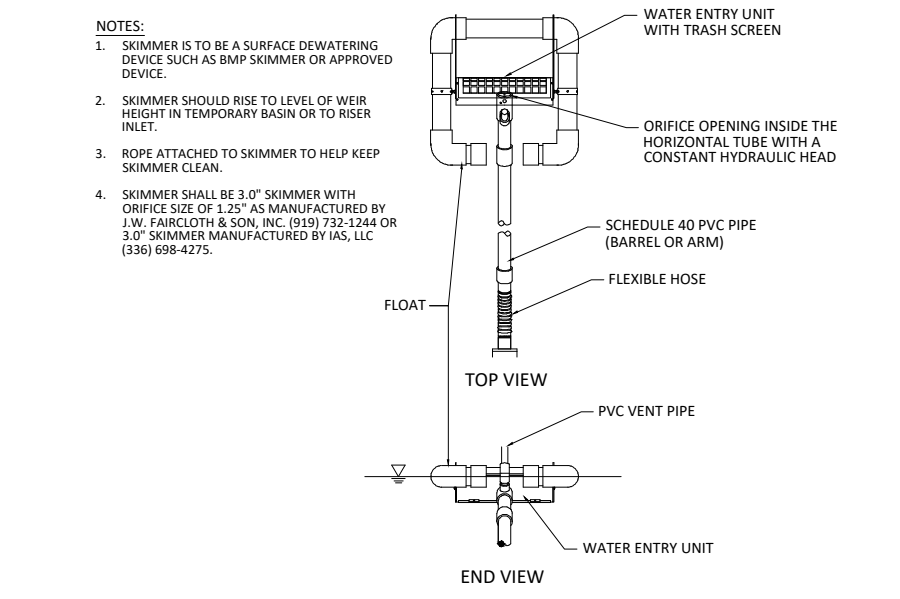

SKIMMER DISCHARGE SYSTEM WITH OUTLET STRUCTURE FOR SSB-6
NOT TO SCALE

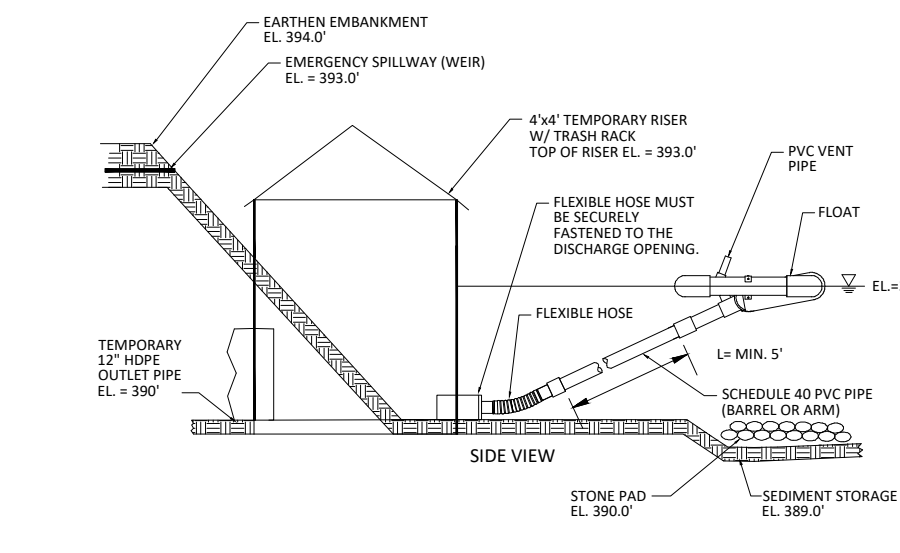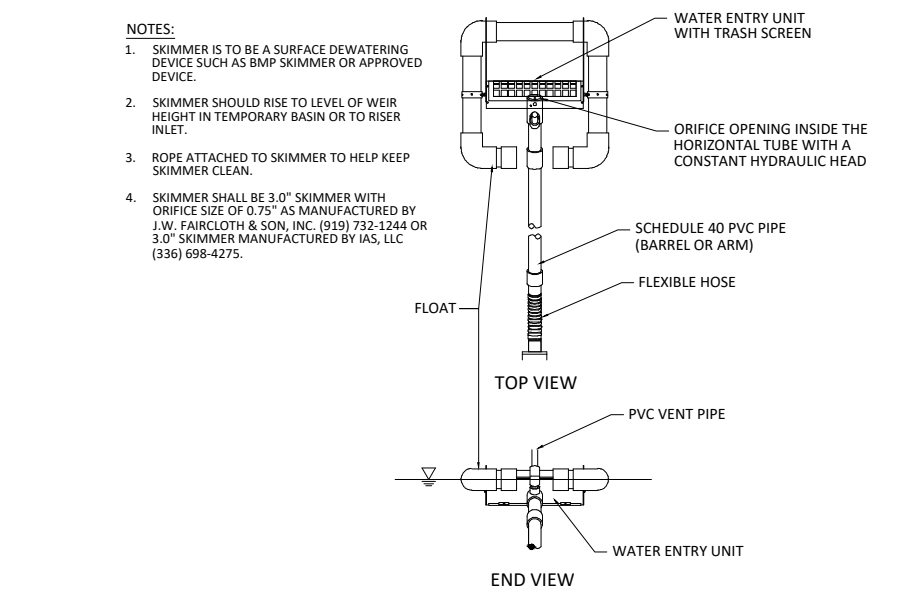

SKIMMER DISCHARGE SYSTEM WITH OUTLET STRUCTURE FOR SSB-7
NOT TO SCALE

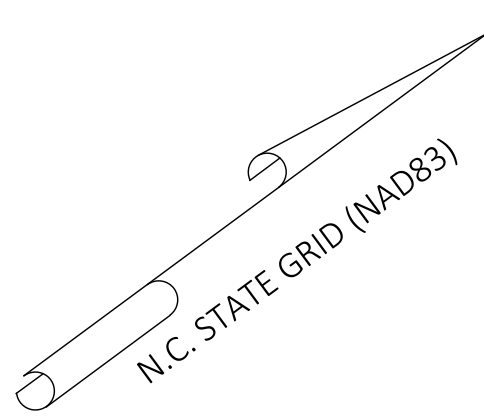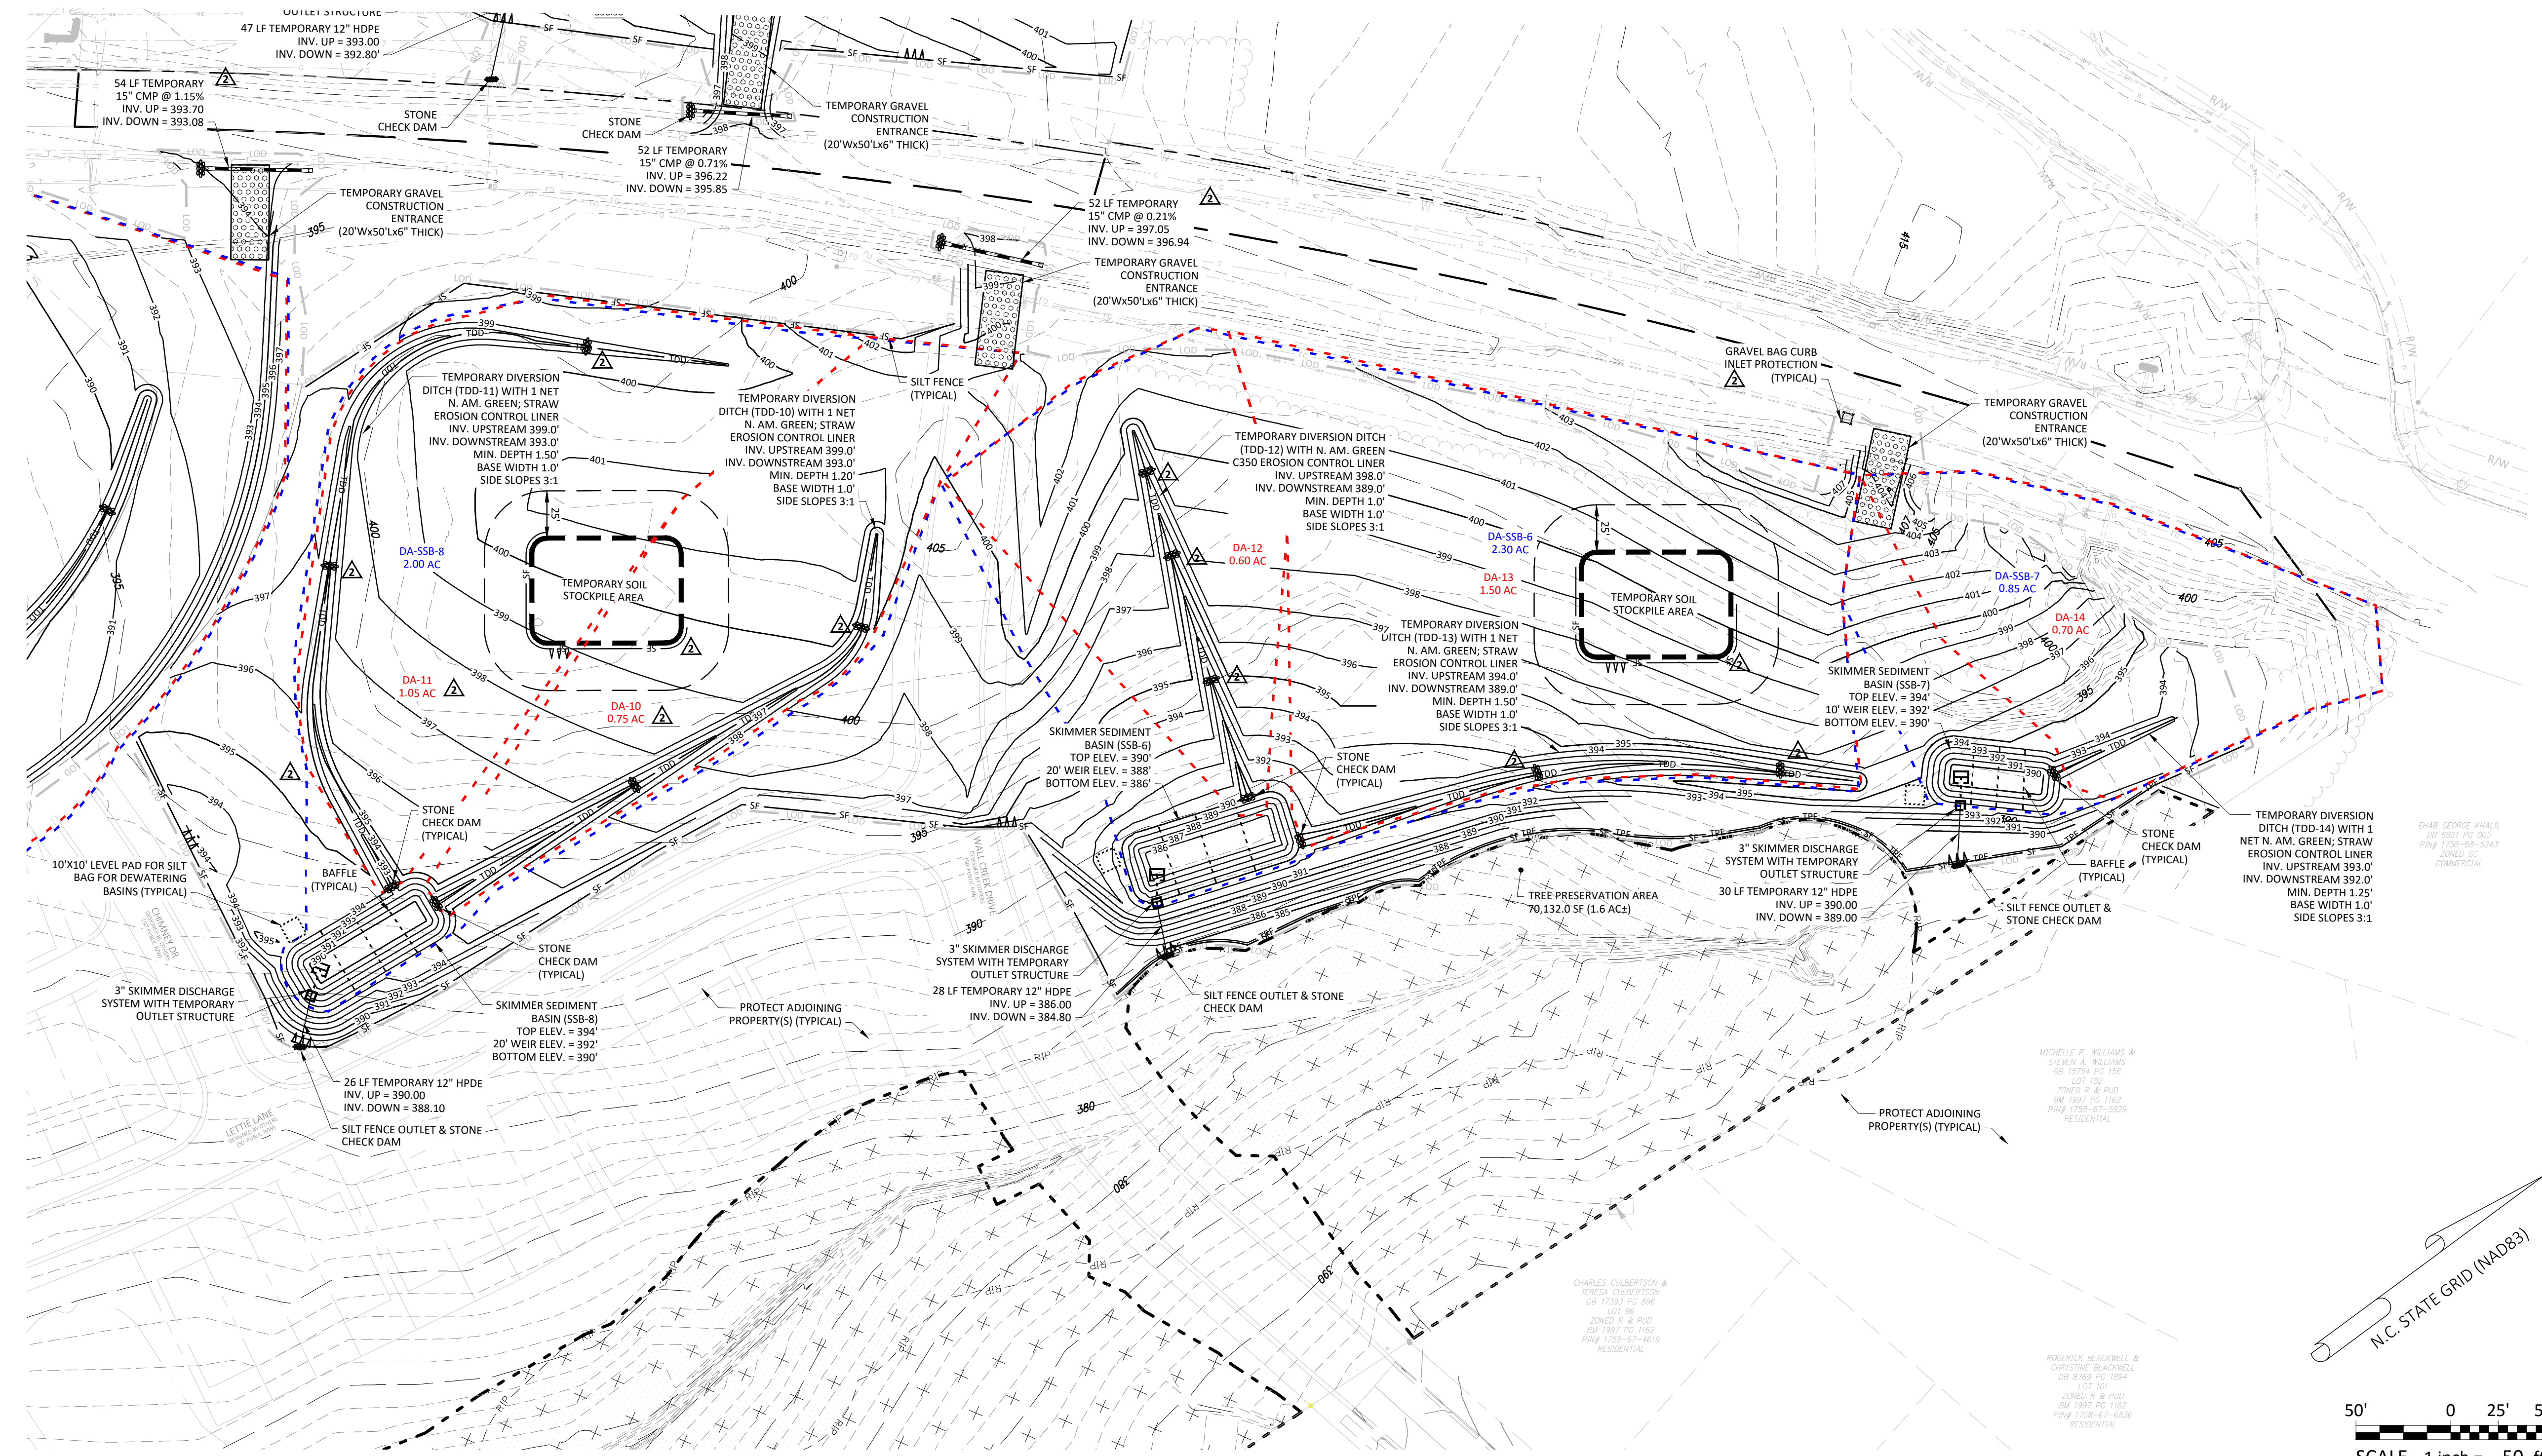

- Final Drawing -
Issued for Permit
Review Purposes Only

REVISIONS:

#	DATE	DESCRIPTION
1	1-FEB-23	REVISED PER OWNER COMMENTS
2	12-JUL-23	REVISED PER TOR & WAKE COUNTY COMMENTS
3	15-JUN-23	REVISED PER TOR & WAKE COUNTY COMMENTS



MASS GRADING - LOTS 7 & 8
WALLBROOK
MASS GRADING / EROSION CONTROL /
SANITARY SEWER RELOCATION
Town of Rolesville Project No. CD 22-02
Rolesville, Wake County, North Carolina

NC License: P-1109
ARK CONSULTING GROUP PLLC
ENGINEERS & PLANNERS

2755-B Charles Blvd.
Raleigh, NC 27658
(919) 858-0888
www.arkconsultinggroup.com

2/1/2023


Professional Engineer Seal for Matthew C. Faboudy, No. 10000, State of North Carolina.

Project Manager: BCF
Drawn By: DLC
Checked By: STA
Project Number: 21089
Drawing Number: D-1219-EC

C1.5

Date: April 1, 2022



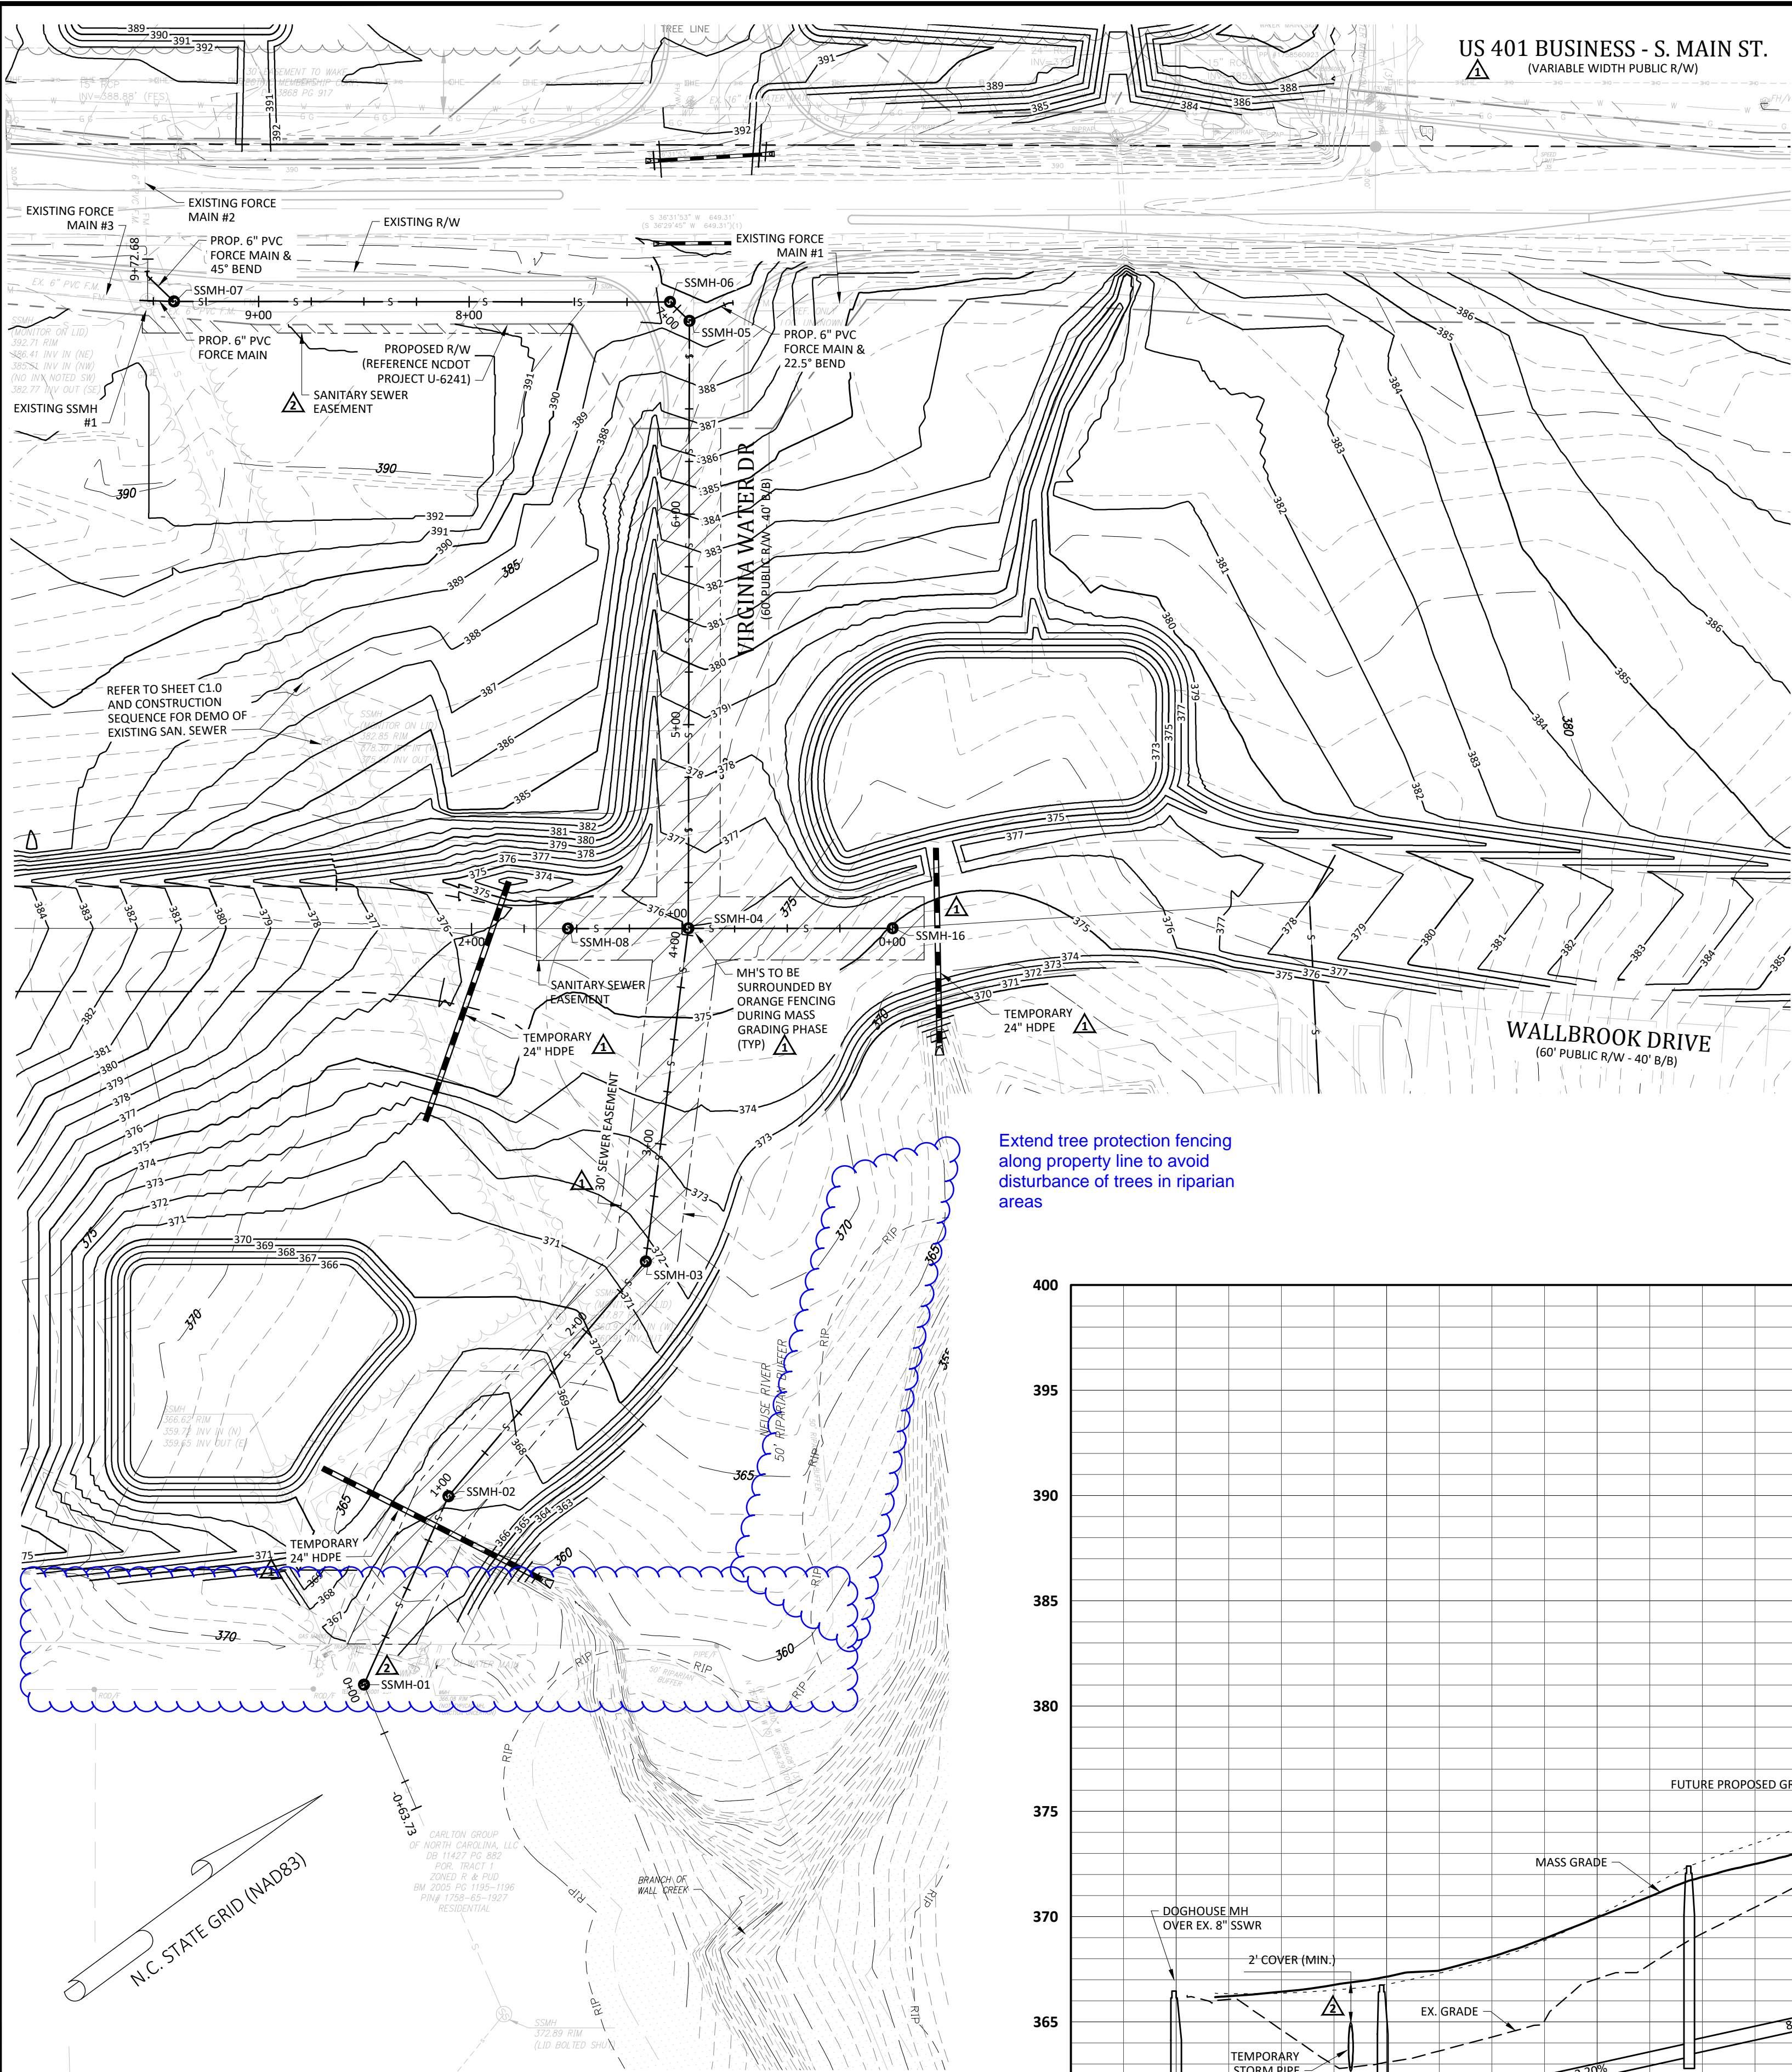

ATTENTION CONTRACTORS

The Construction Contractor responsible for the extension of water, sewer, and/or reuse, as approved in these plans, is responsible for contacting the Public Utilities Department at (919) 996-4540 at least twenty four hours prior to beginning any of their construction.

Failure to notify both City Departments in advance of beginning construction, will result in the issuance of monetary fines, and require reinstallation of any water or sewer facilities not inspected as a result of this notification failure.

Failure to call for Inspection, Install a Downstream Plug, have Permitted Plans on the Jobsite, or any other Violation of City of Raleigh Standards will result in a Fine and Possible Exclusion from future work in the City of Raleigh.

Public Sewer Collection / Extension System



The City of Raleigh consents to the connection and extension of the City's public sewer system as shown on this plan. The material and construction methods used for this project shall conform to the standards and specifications of the City's Public Utilities Handbook.

City of Raleigh
Public Utilities Department Permit # S-5093

Authorization to Construct _____

Date _____

Extend tree protection fencing along property line to avoid disturbance of trees in riparian areas

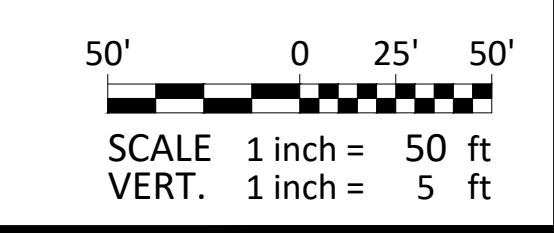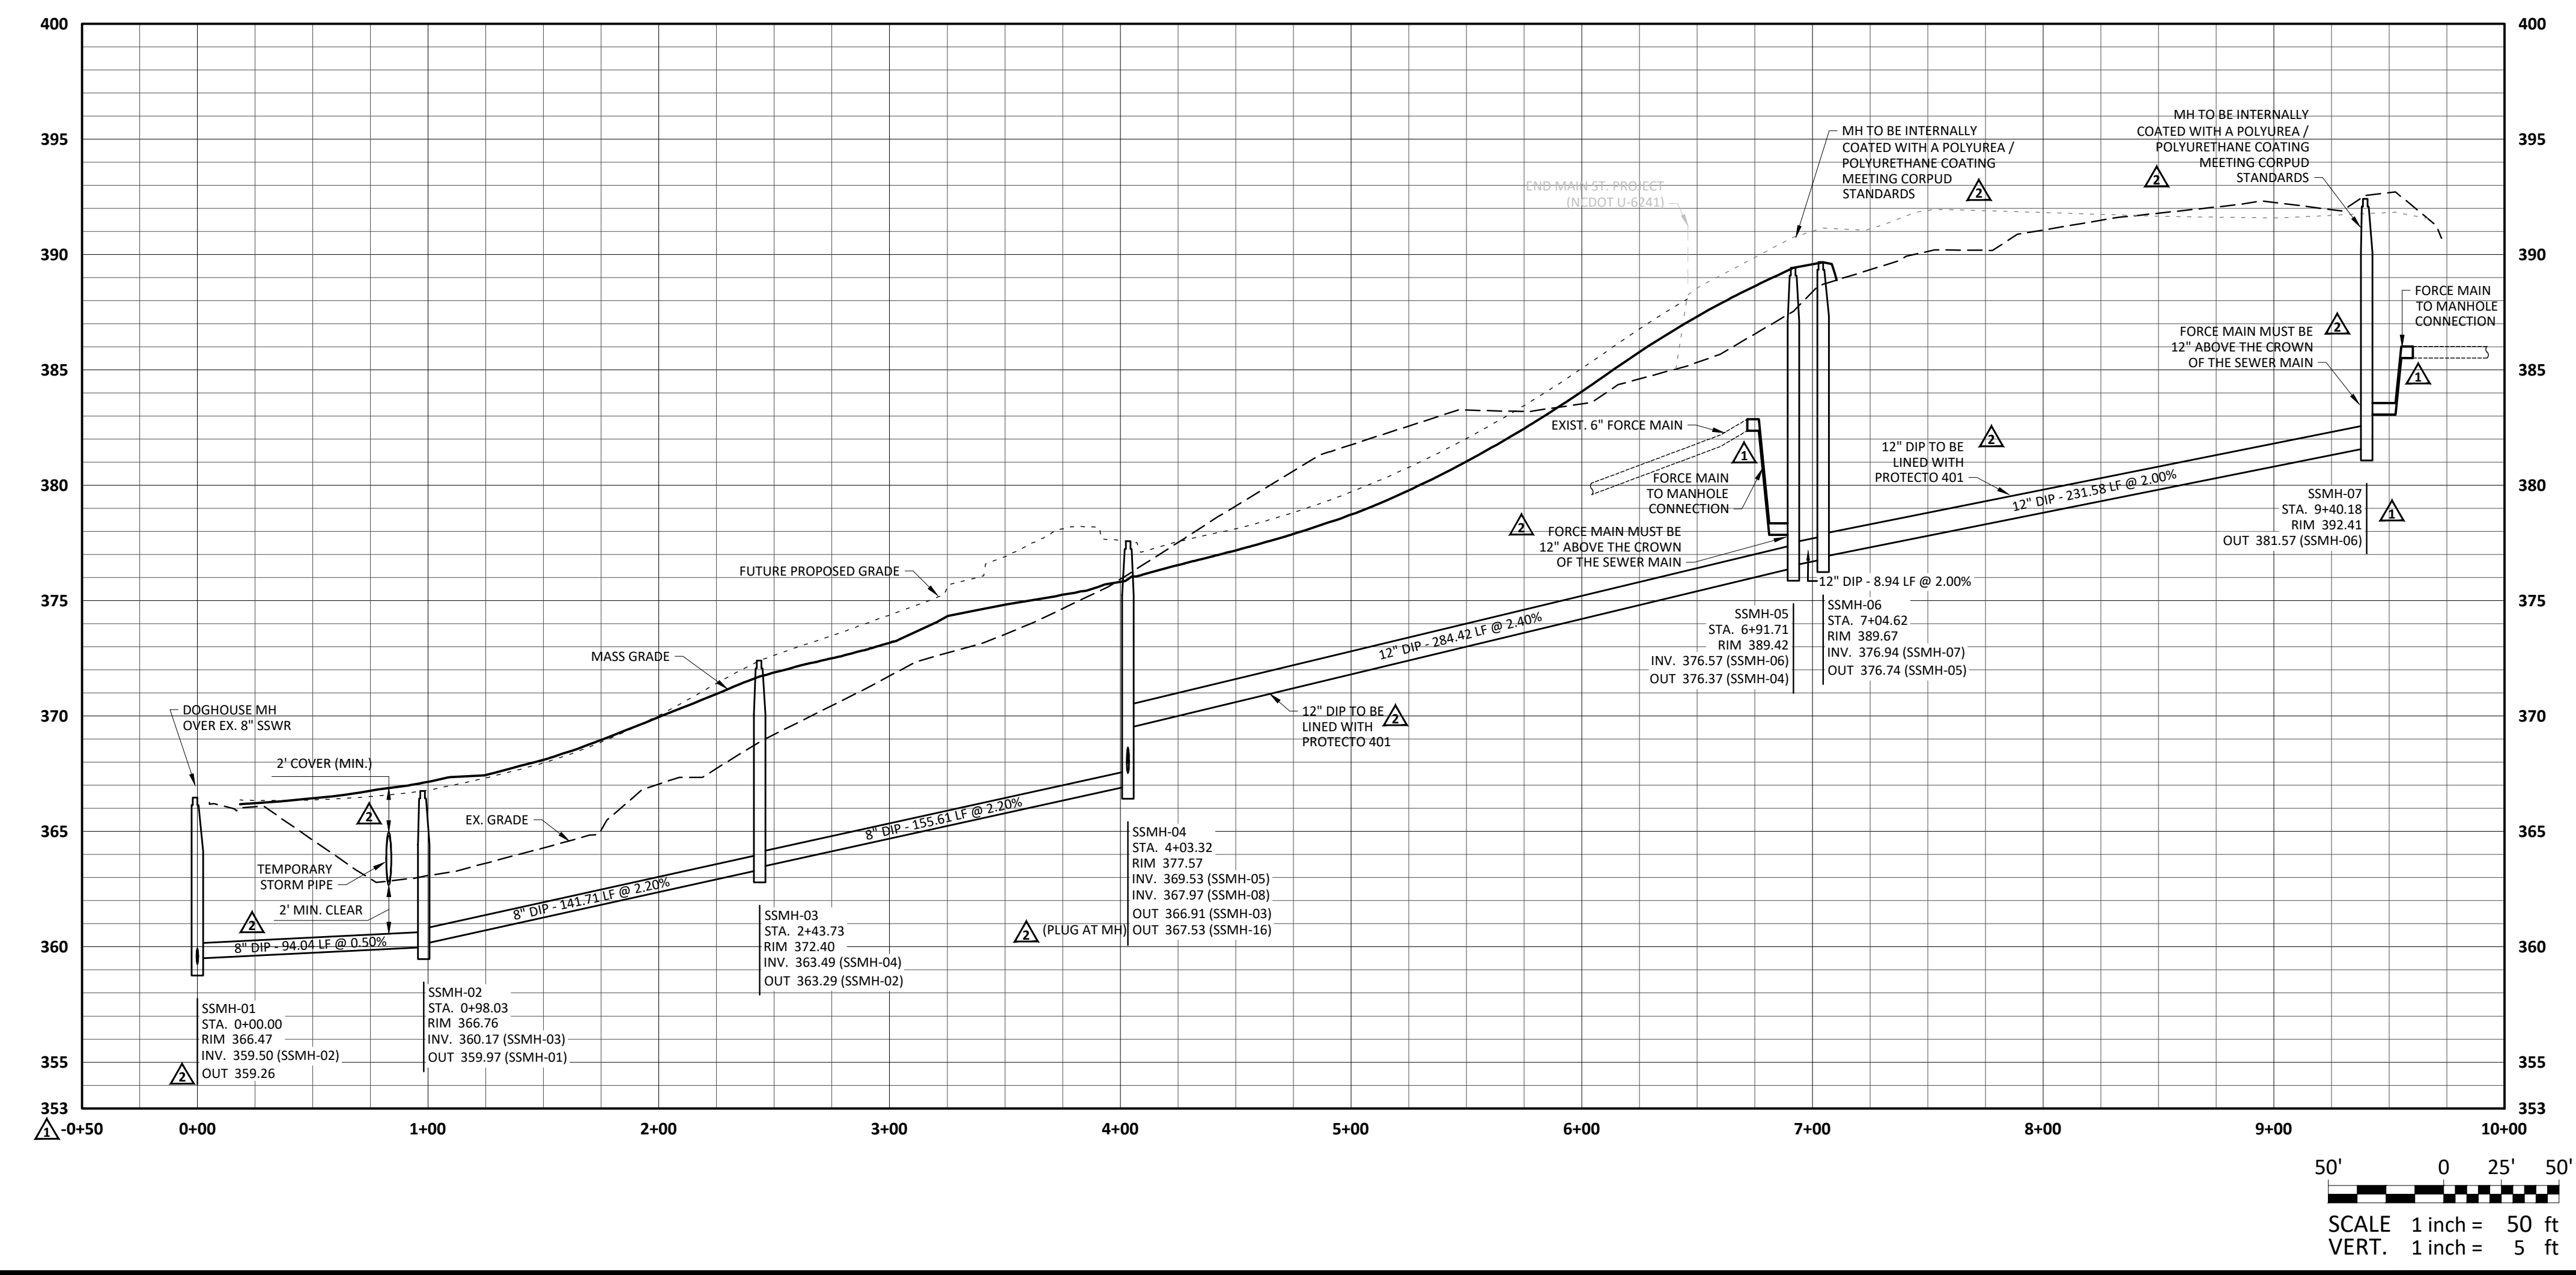


General Notes:

- CONTRACTOR SHALL CONTACT NORTH CAROLINA ONE-CALL CENTER, INC. (NC ONE-CALL) AT 811 TO HAVE ALL UNDERGROUND UTILITIES LOCATED AT LEAST 72 HOURS PRIOR TO EXCAVATING OR TRENCHING.
- ALL REQUIRED IMPROVEMENTS SHALL CONFORM TO THE CITY OF RALEIGH PUBLIC UTILITIES HANDBOOK, EFFECTIVE JANUARY 21, 2014.
- CONTRACTOR SHALL NOTIFY THE TOWN OF ROLESVILLE AND THE NC DEPARTMENT OF TRANSPORTATION, 72 HOURS PRIOR TO CLOSURE OF ROADWAY AND CUTTING PAVEMENT IN ROADWAY RIGHT-OF-WAY.
- CONTRACTOR SHALL SUBMIT SHOP DRAWINGS TO ENGINEER FOR MATERIALS TO BE USED IN THE CONSTRUCTION OF UTILITY IMPROVEMENTS. SHOP DRAWINGS SHALL BE REVIEWED AND APPROVED BY THE ENGINEER PRIOR TO ORDERING MATERIALS.
- LOCATION OF ALL EXISTING AND PROPOSED UTILITIES ARE APPROXIMATE AND MUST BE CONFIRMED INDEPENDENTLY WITH UTILITY OWNERS PRIOR TO COMMENCEMENT OF ANY CONSTRUCTION OR EXCAVATION. UTILITY SERVICE CONNECTION POINTS SHALL BE CONFIRMED INDEPENDENTLY BY THE CONTRACTOR IN THE FIELD PRIOR TO THE COMMENCEMENT OF CONSTRUCTION. DISCREPANCIES SHALL BE REPORTED IMMEDIATELY IN WRITING TO ENGINEER. CONSTRUCTION SHALL COMMENCE BEGINNING AT THE LOWEST INVERT (POINT OF CONNECTION) AND PROGRESS UPSTREAM. PROPOSED INTERFACE POINTS (CROSSINGS) WITH EXISTING UNDERGROUND UTILITIES SHALL BE FIELD VERIFIED BY TEST PIT PRIOR TO COMMENCEMENT OF CONSTRUCTION.
- ALL UTILITIES AND SERVICES INCLUDING BUT NOT LIMITED TO GAS, WATER, ELECTRIC, SANITARY AND STORM SEWER, TELEPHONE, CABLE, FIBER OPTIC CABLE WITHIN THE LIMITS OF DISTURBANCE SHALL BE VERTICALLY AND HORIZONTALLY LOCATED. THE CONTRACTOR SHALL COMPLY WITH THE REQUIREMENTS OF THE APPLICABLE UTILITY NOTIFICATION SYSTEM TO LOCATE ALL THE UNDERGROUND UTILITIES. THE CONTRACTOR IS RESPONSIBLE FOR REPAIRS OF DAMAGE TO ANY EXISTING UTILITIES DURING CONSTRUCTION AT NO COST TO THE OWNER.
- IT IS THE RESPONSIBILITY OF THE CONTRACTOR TO REVIEW ALL OF THE DRAWINGS AND SPECIFICATIONS ASSOCIATED WITH THE PROJECT WORK SCOPE PRIOR TO THE INITIATION OF CONSTRUCTION. SHOULD THE CONTRACTOR FIND A CONFLICT WITH THE DOCUMENTS RELATIVE TO THE SPECIFICATIONS OR THE RELATIVE CODES, IT IS THE CONTRACTOR'S RESPONSIBILITY TO NOTIFY THE PROJECT ENGINEER OF RECORD IN WRITING PRIOR TO COMMENCING CONSTRUCTION. FAILURE BY THE CONTRACTOR TO NOTIFY THE PROJECT ENGINEER SHALL CONSTITUTE ACCEPTANCE OF FULL RESPONSIBILITY BY THE CONTRACTOR TO COMPLETE THE SCOPE OF WORK AS DEFINED BY THE DRAWINGS AND IN FULL COMPLIANCE WITH LOCAL AND STATE REGULATIONS AND CODES.
- THE CONTRACTOR SHALL FAMILIARIZE THEMSELVES WITH CITY OF RALEIGH REQUIREMENTS AND IS RESPONSIBLE FOR ALL COORDINATION REGARDING UTILITY INSTALLATION AS IDENTIFIED OR REQUIRED FOR THE PROJECT.
- NO SEWER SERVICE SHALL BE PROVIDED WITHIN THIS PROJECT UNTIL ALL MAINS HAVE BEEN INSTALLED AND ACCEPTED FOR MAINTENANCE BY THE CITY OF RALEIGH.

Sanitary Sewer Construction Sequence:

- CONTRACTOR SHALL VERIFY EXISTING INVERT ELEVATIONS PRIOR TO BEGINNING CONSTRUCTION. NOTIFY DESIGN ENGINEER OF ANY DISCREPANCIES PRIOR TO BEGINNING SANITARY SEWER INSTALLATION.
- INSTALL DOGHOUSE SSMH-1, LEAVING THE EXISTING SANITARY SEWER MAIN IN SERVICE. EXISTING MAIN SHALL NOT BE CUT UNTIL ACCEPTANCE OF NEW MAIN IN ITS ENTIRETY.
- INSTALL NEW SANITARY SEWER MAIN FROM SSMH-1 UP TO SSMH-5. PERFORM SATISFACTORY VACUUM AND AIR TESTING OF NEW SANITARY SYSTEM BETWEEN SSMH-1 AND SSMH-5.
- INSTALL PIPE STUB WITH CAP OUT OF SSMH-4 TOWARDS SSMH-8 AND SSMH-13. INSTALLATION OF MAIN TOWARDS SSMH-8 AND SSMH-13 SHALL NOT OCCUR UNTIL AFTER THE COMPLETION OF THE TIE-IN OF EXISTING FORCE MAIN #3 TO SSMH-7.
- UPON COMPLETION OF SATISFACTORY VACUUM AND AIR TESTING OF NEW SANITARY SEWER BETWEEN SSMH-1 AND SSMH-5, COORDINATE WITH THE CITY OF RALEIGH TO CUT EXISTING MAIN THROUGH SSMH-5 TO FACILITATE FLOW FROM NEW SANITARY SEWER SYSTEM THROUGH SSMH-5.
- COORDINATE WITH THE CITY OF RALEIGH TO ABANDON THE EXISTING FORCE MAIN #1 CONNECTION TO THE EXISTING SSMH-1 AND PERFORM THE TIE-IN OF THE EXISTING FORCE MAIN #1 TO SSMH-5. TIE-IN SHALL BE PERFORMED DURING A LOW-FLOW PERIOD.
- UPON COMPLETION OF THE TIE-IN OF EXISTING FORCE MAIN #1 TO SSMH-5, REMOVE THE REMAINDER OF EXISTING FORCE MAIN #1 AND INSTALL NEW SANITARY SEWER FROM SSMH-5 UP TO SSMH-7. PERFORM SATISFACTORY VACUUM AND AIR TESTING OF NEW SANITARY SYSTEM BETWEEN SSMH-5 AND SSMH-7.
- UPON COMPLETION OF SATISFACTORY VACUUM AND AIR TESTING OF NEW SANITARY SEWER BETWEEN SSMH-5 AND SSMH-7, COORDINATE WITH THE CITY OF RALEIGH TO CONNECT THE EXISTING FORCE MAIN #2 TO SSMH-7. TIE-IN SHALL BE PERFORMED DURING A LOW-FLOW PERIOD.
- UPON COMPLETION OF THE TIE-IN OF EXISTING FORCE MAIN #2 TO SSMH-7, COORDINATE WITH THE CITY OF RALEIGH FOR THE REMOVAL OF THE EXISTING SSMH-1 AND PERFORM THE TIE-IN OF THE EXISTING FORCE MAIN #3 TO SSMH-7.
- UPON COMPLETION OF THE TIE-IN OF THE EXISTING FORCE MAIN #3 TO SSMH-7, REMOVAL OF THE REMAINDER OF THE EXISTING GRAVITY SANITARY SEWER BETWEEN EXISTING SSMH-1 AND PROPOSED SSMH-5 MAY BE PERFORMED.

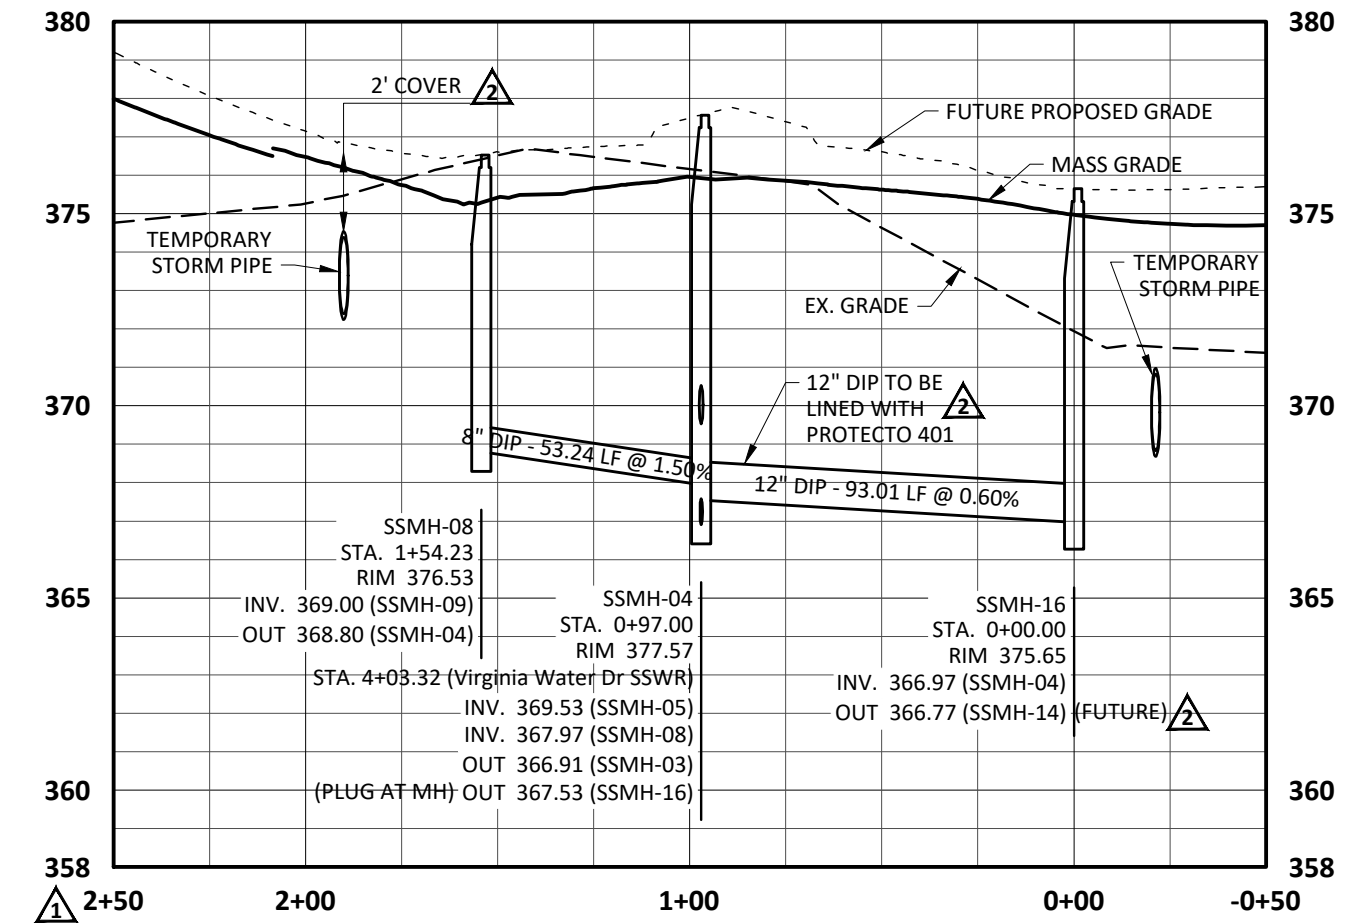

- Final Drawing -
Issued for Permit
Review Purposes Only

REVISIONS:

#	DATE	DESCRIPTION
1	1-FEB-23	REVISED PER OWNER COMMENTS
2	12-JUL-23	REVISED PER TOR & WAKE COUNTY COMMENTS
3	15-JUN-23	REVISED PER TOR & WAKE COUNTY COMMENTS

CROSLAND SOUTHEAST

PLAN/PROFILE - SANITARY SEWER RELOCATION

WALLBROOK

MASS GRADING / EROSION CONTROL / SANITARY SEWER RELOCATION

Town of Rolesville Project No. CD 22-02
Rolesville, Wake County, North Carolina













ARK CONSULTING GROUP PLLC
ENGINEERS & PLANNERS
2755-B Charles Blvd
Raleigh, NC 27608
(757) 558-0888
www.arkconsultinggroup.com

NC License: P-1109

Project Manager: BCF
Checked By: DLC
Drawn By: STA
Project Number: 21089
Drawing Number: D-1219-EC

C2.0

Date: April 1, 2022

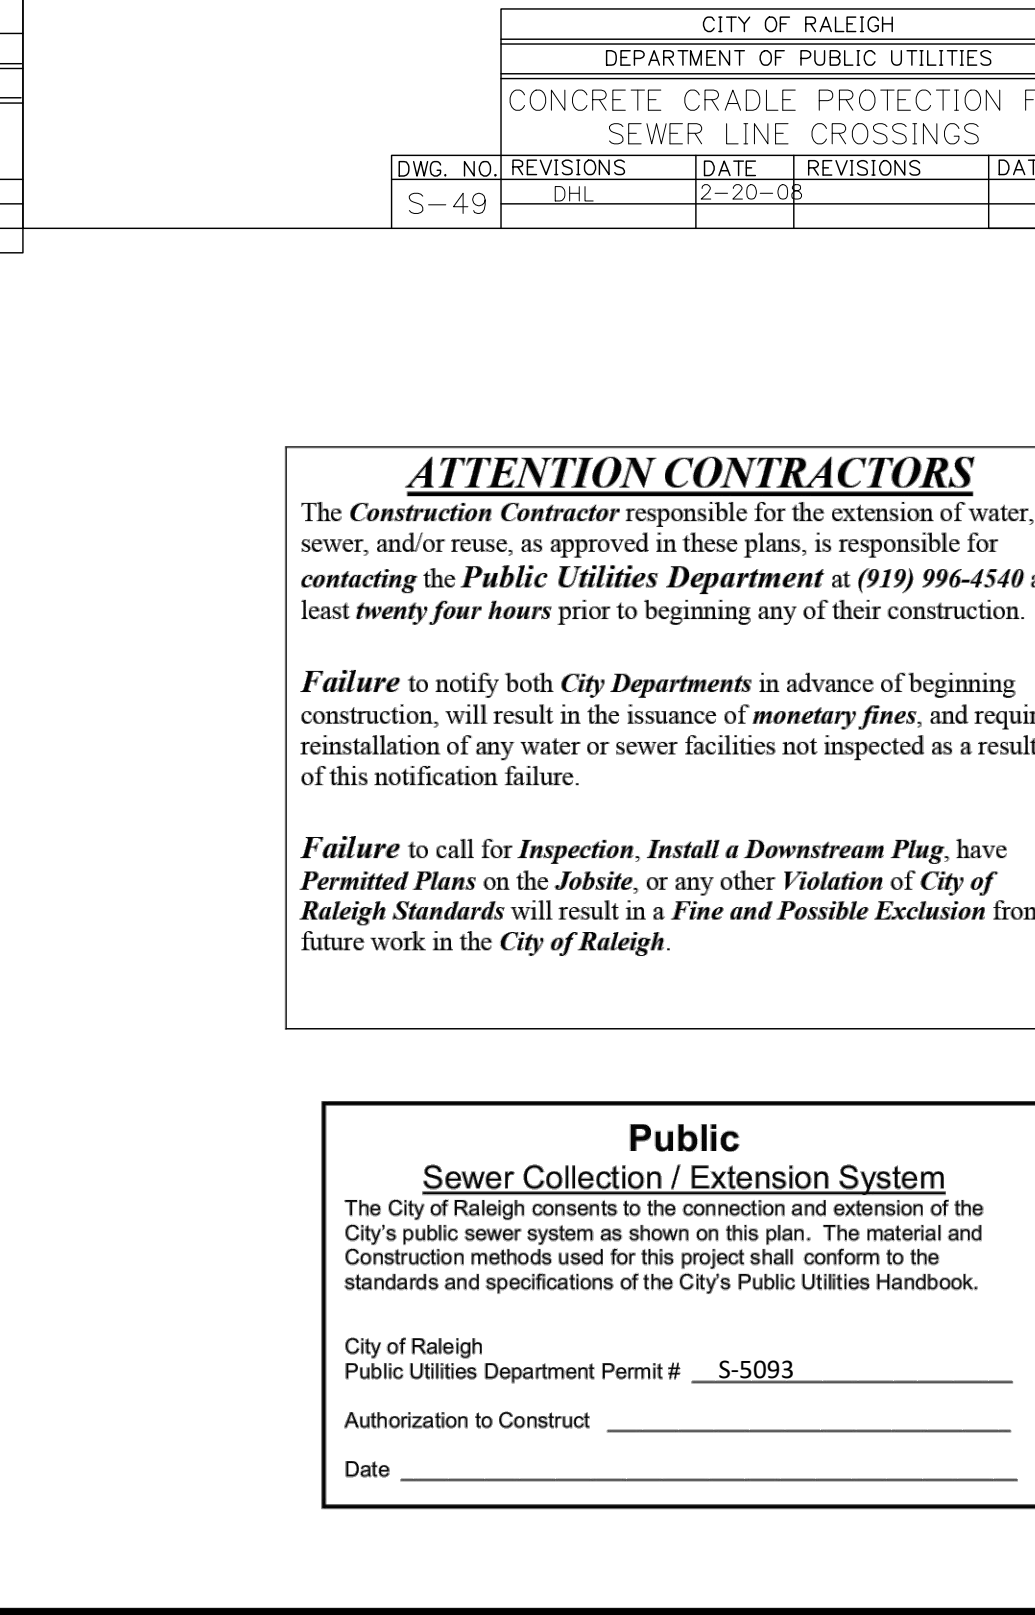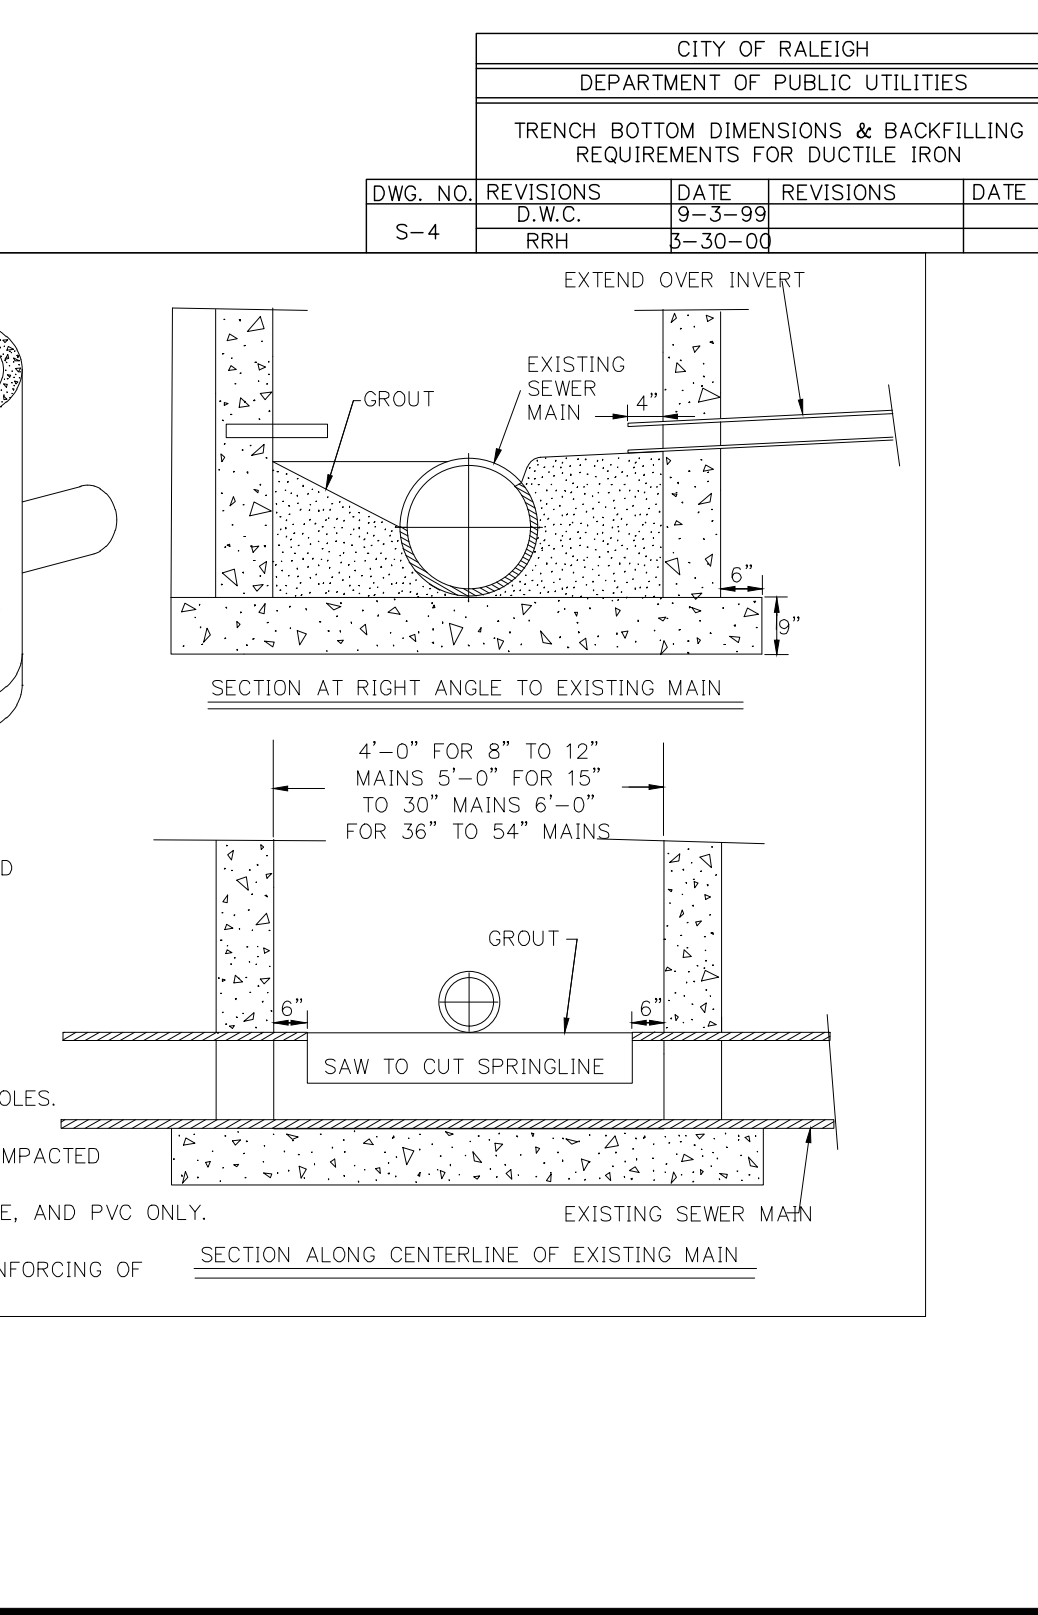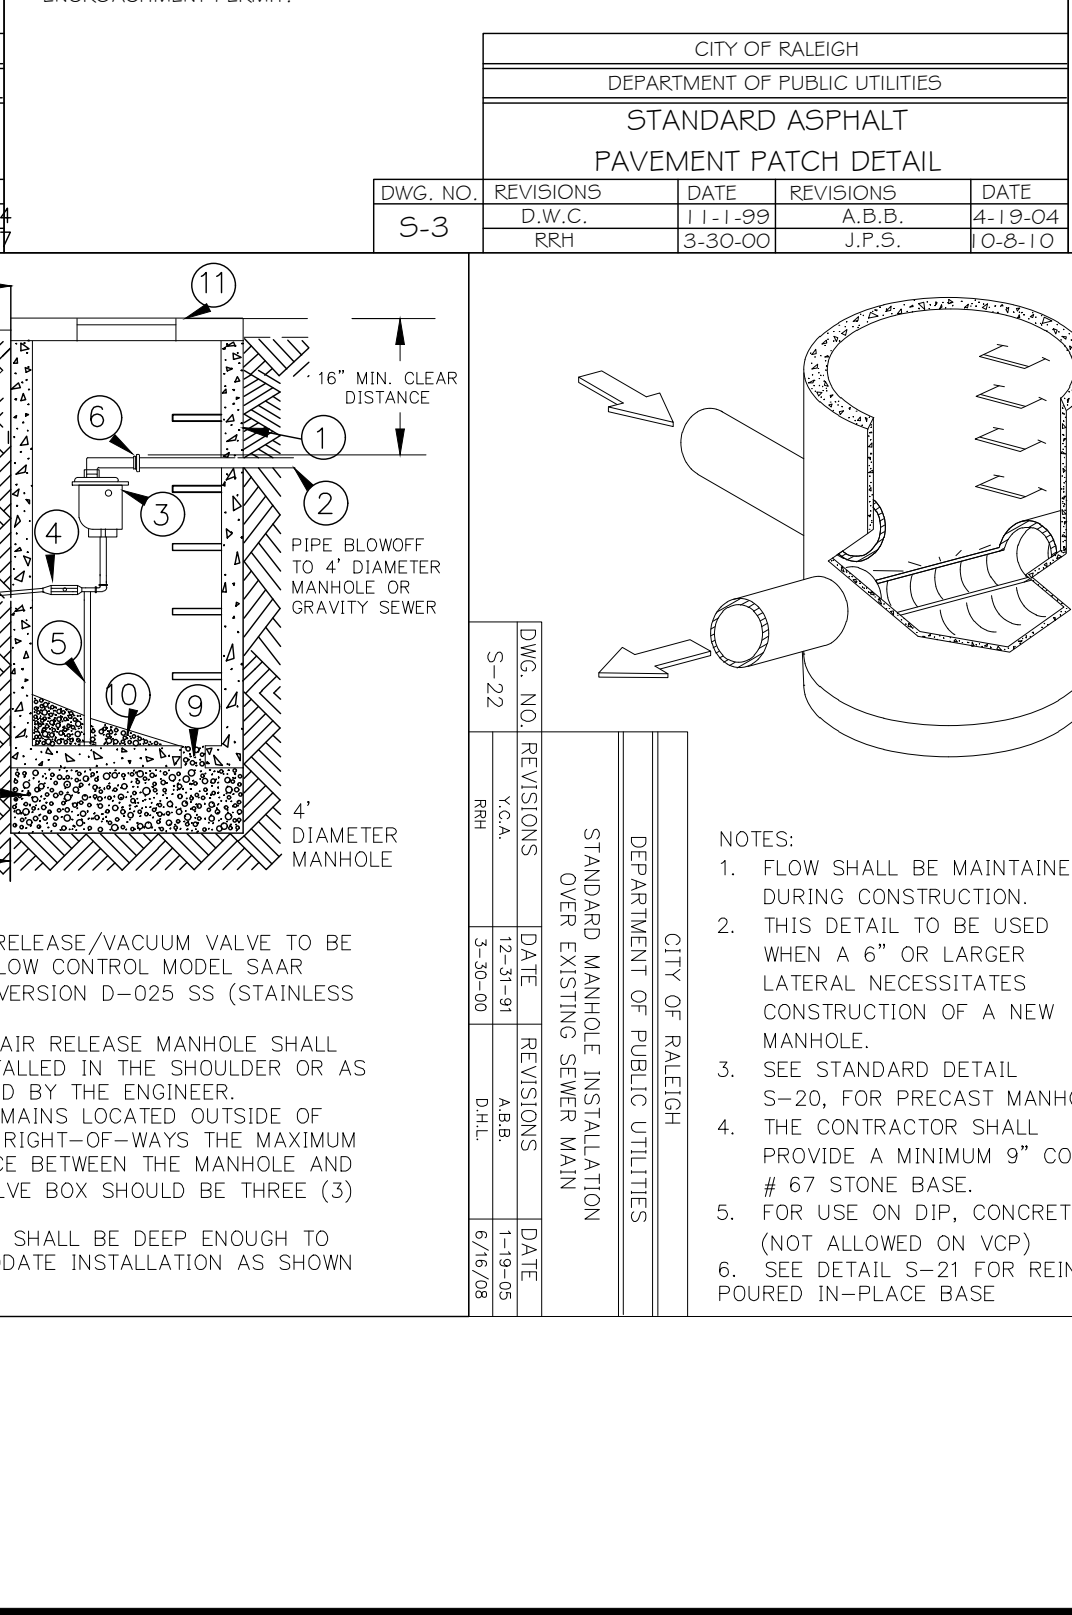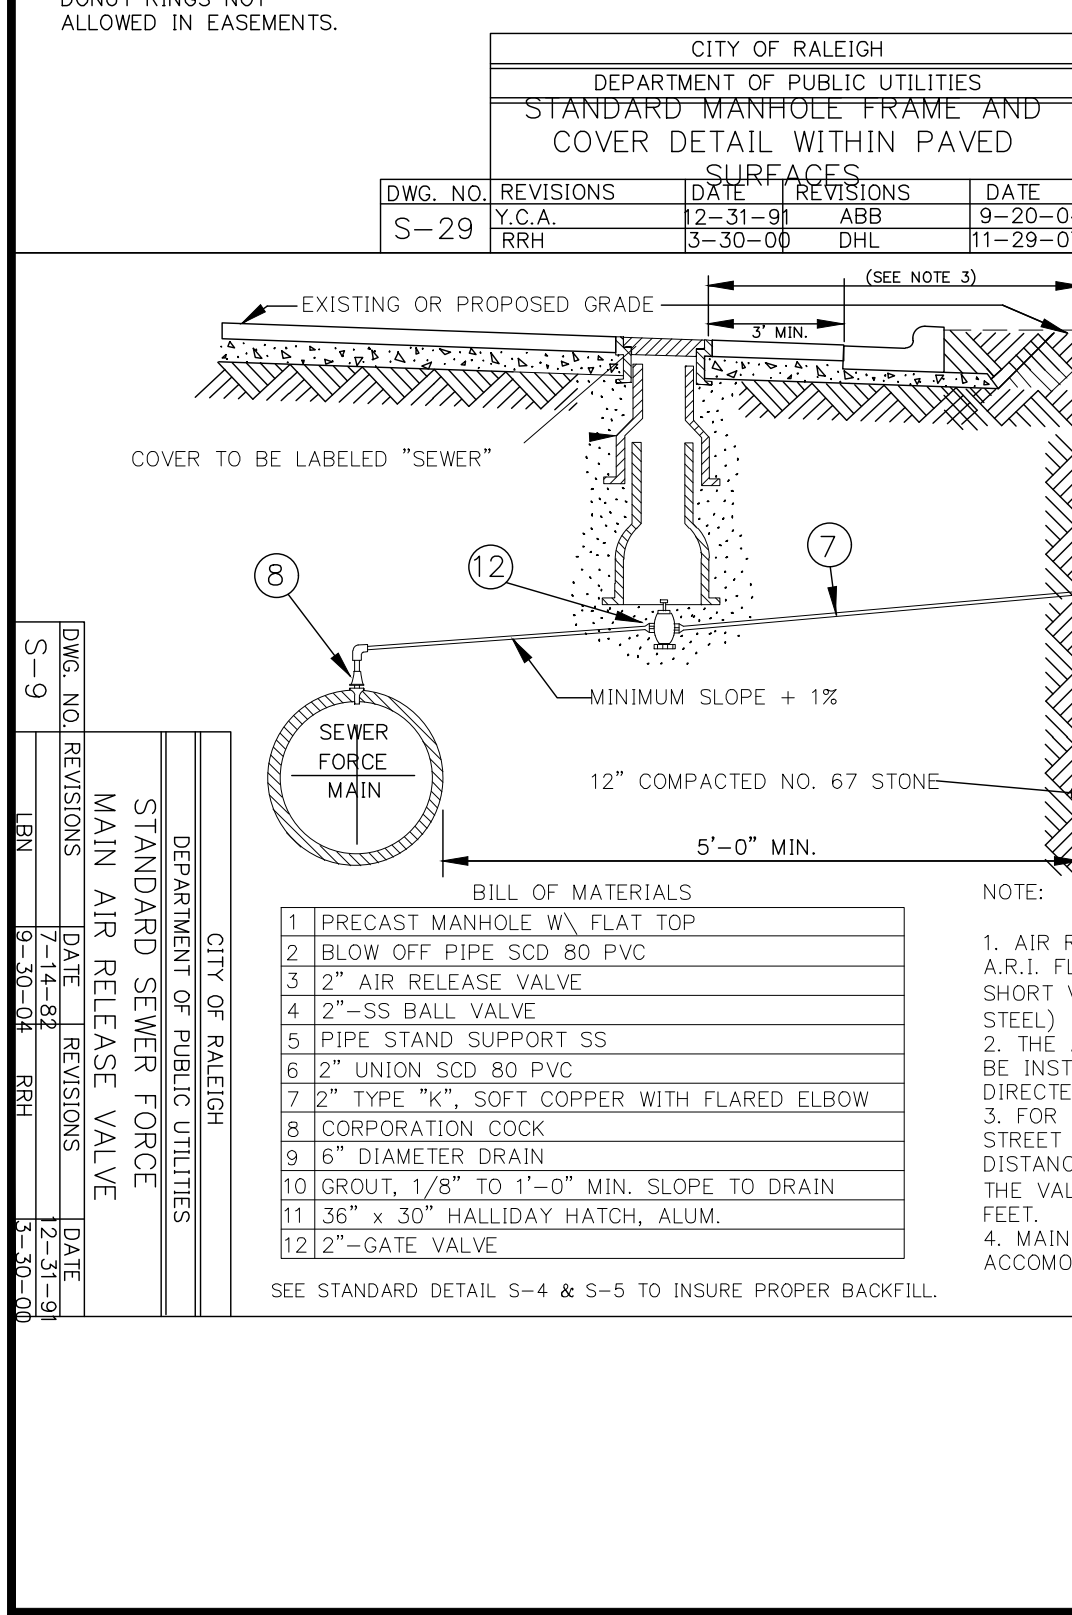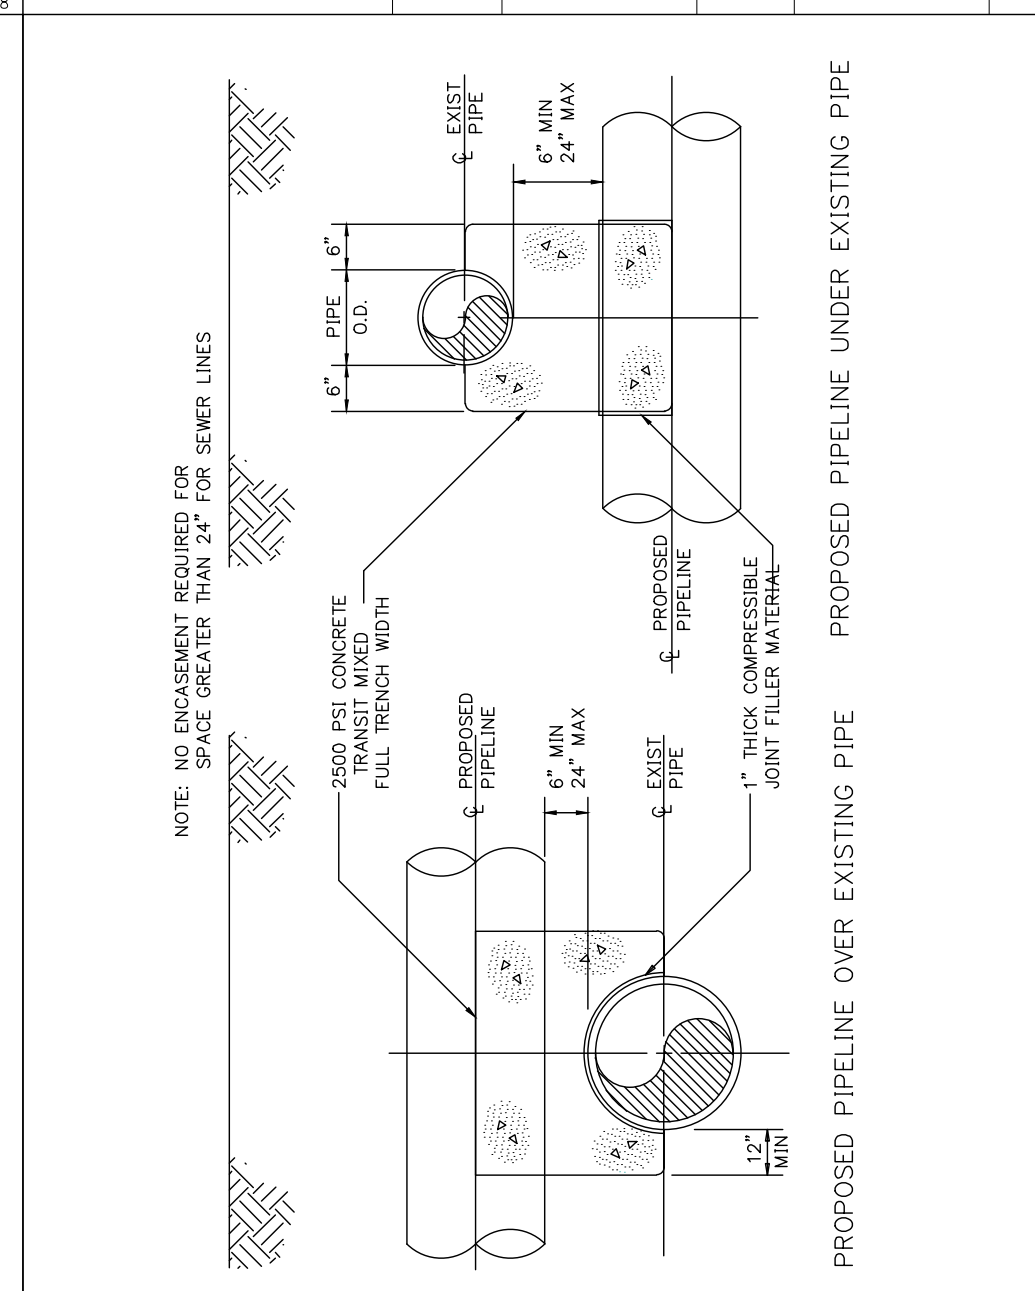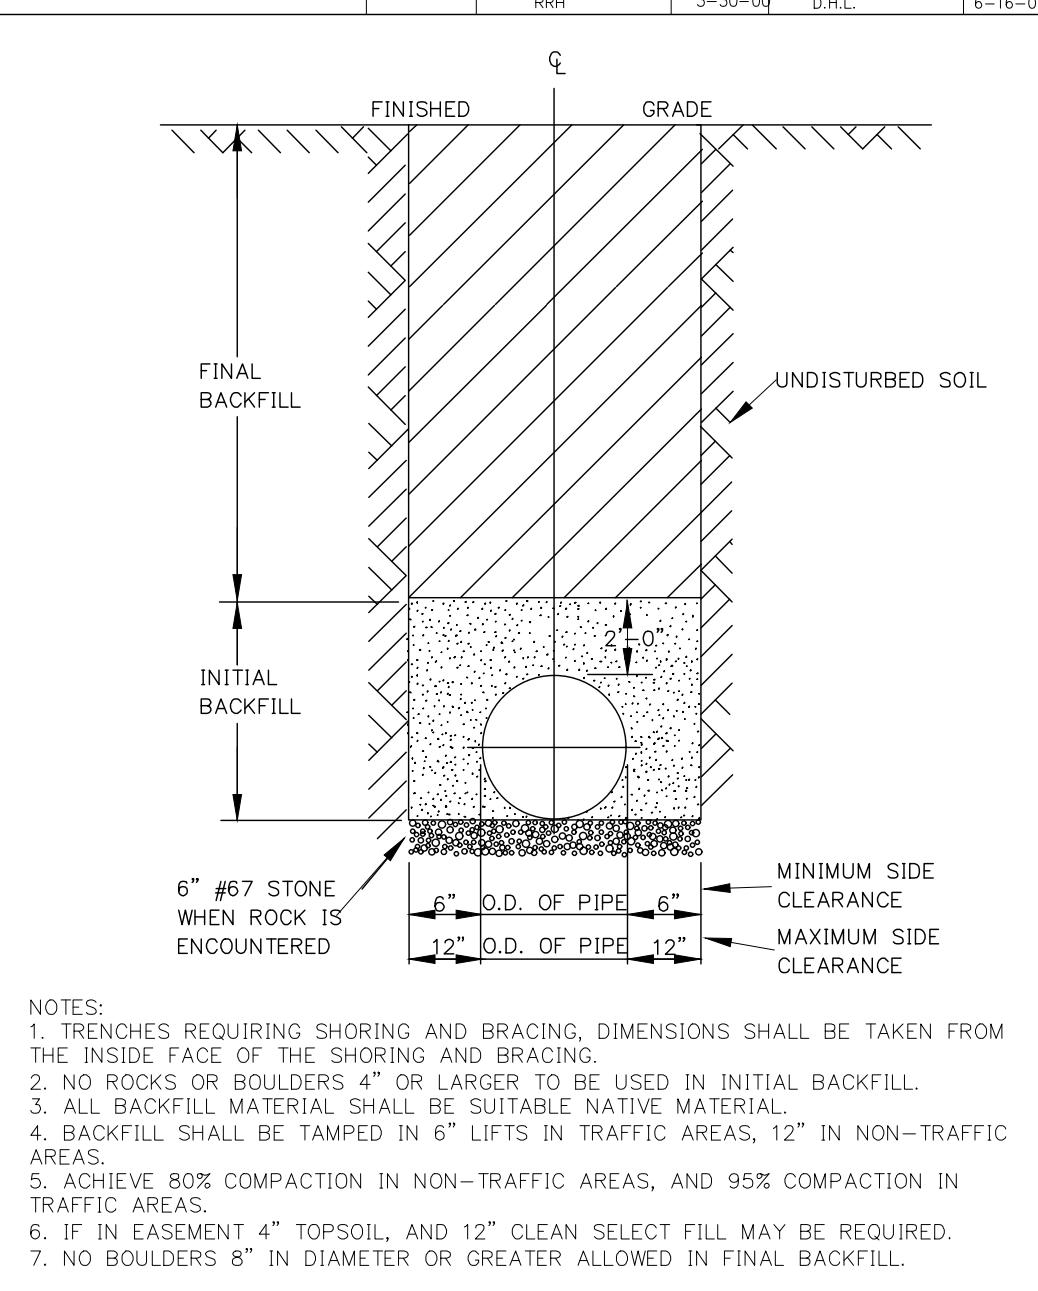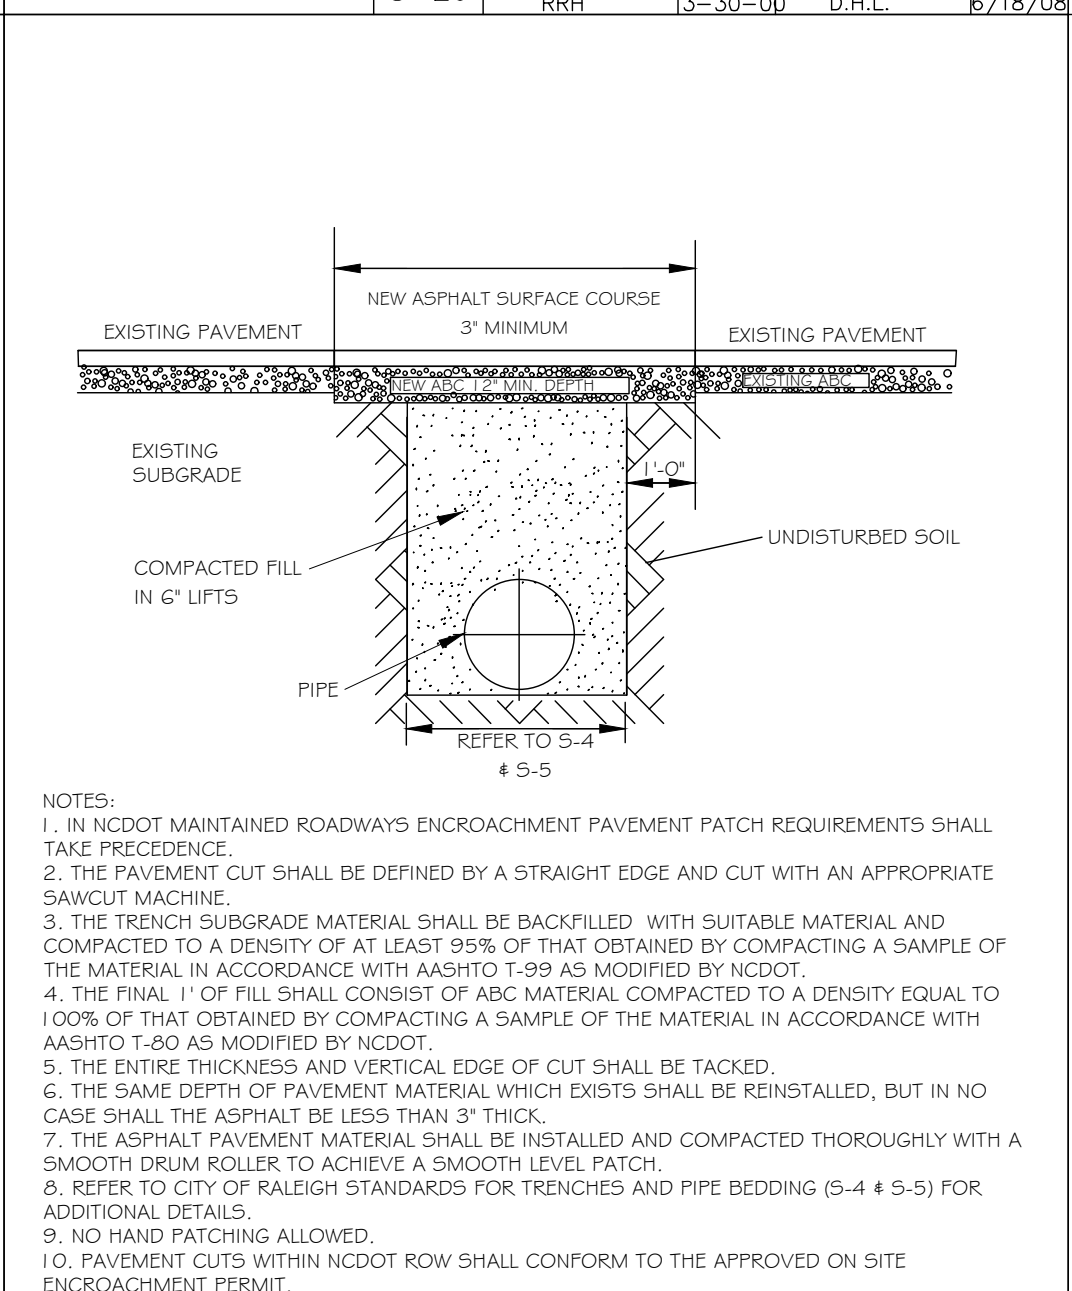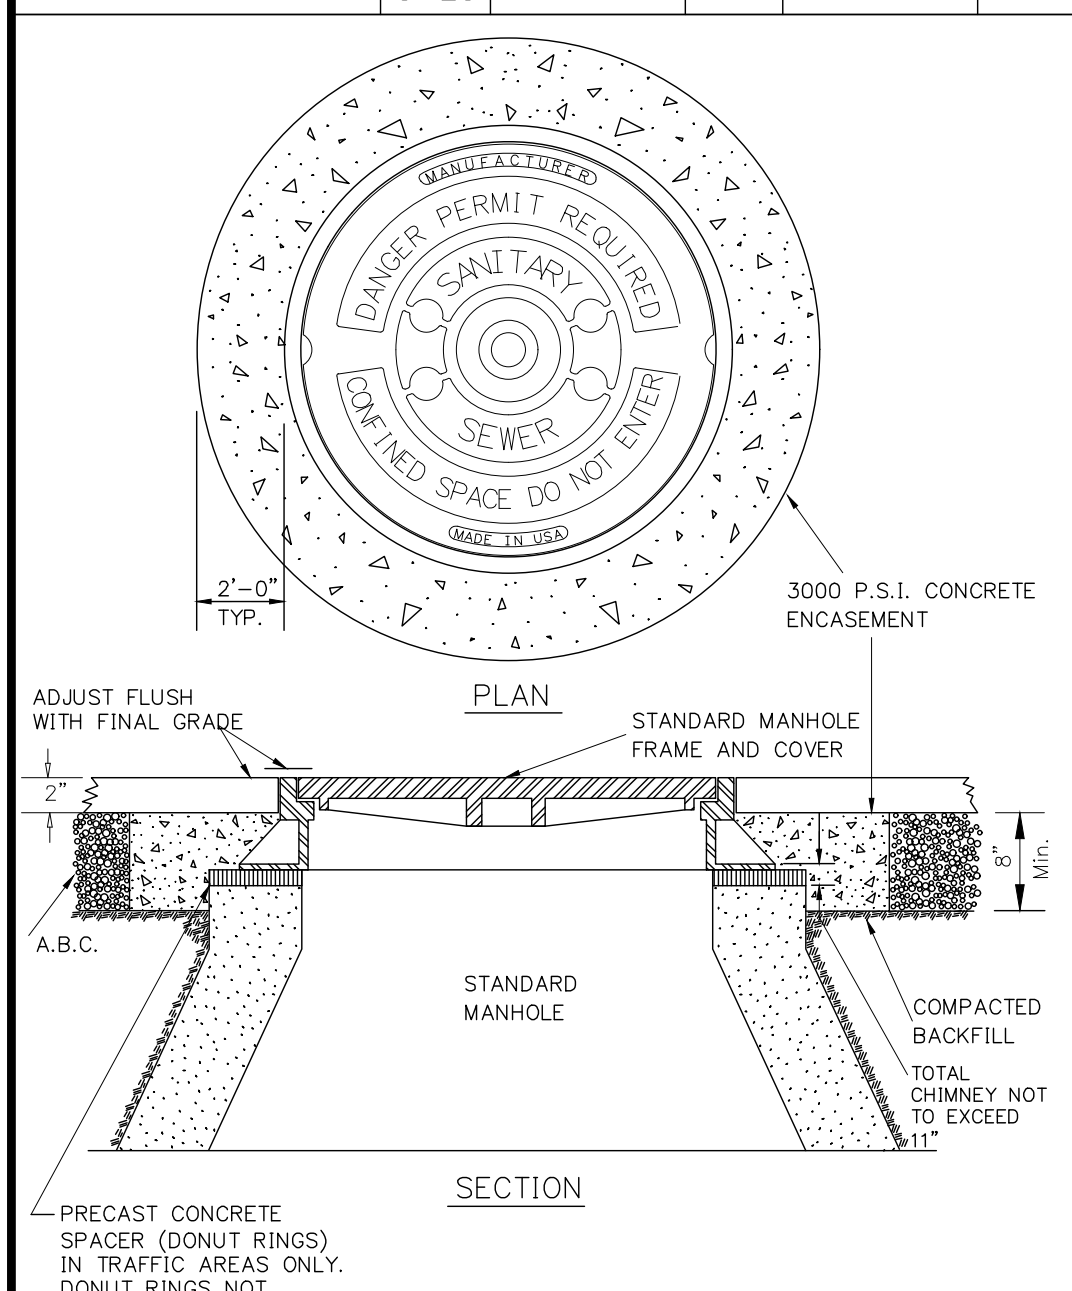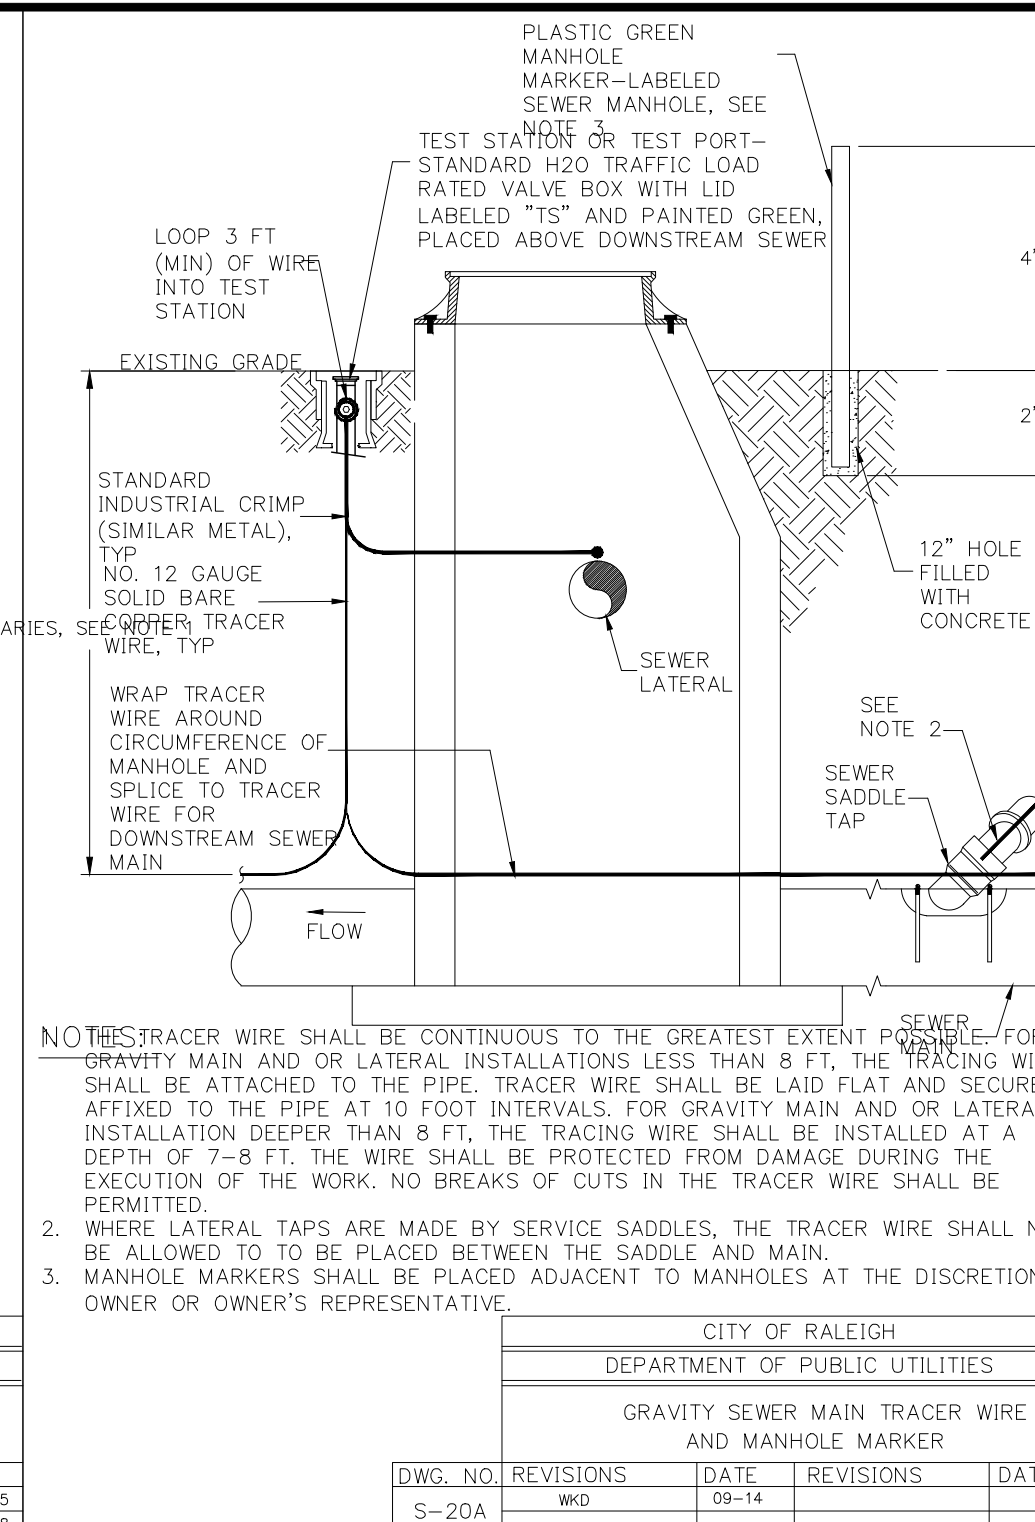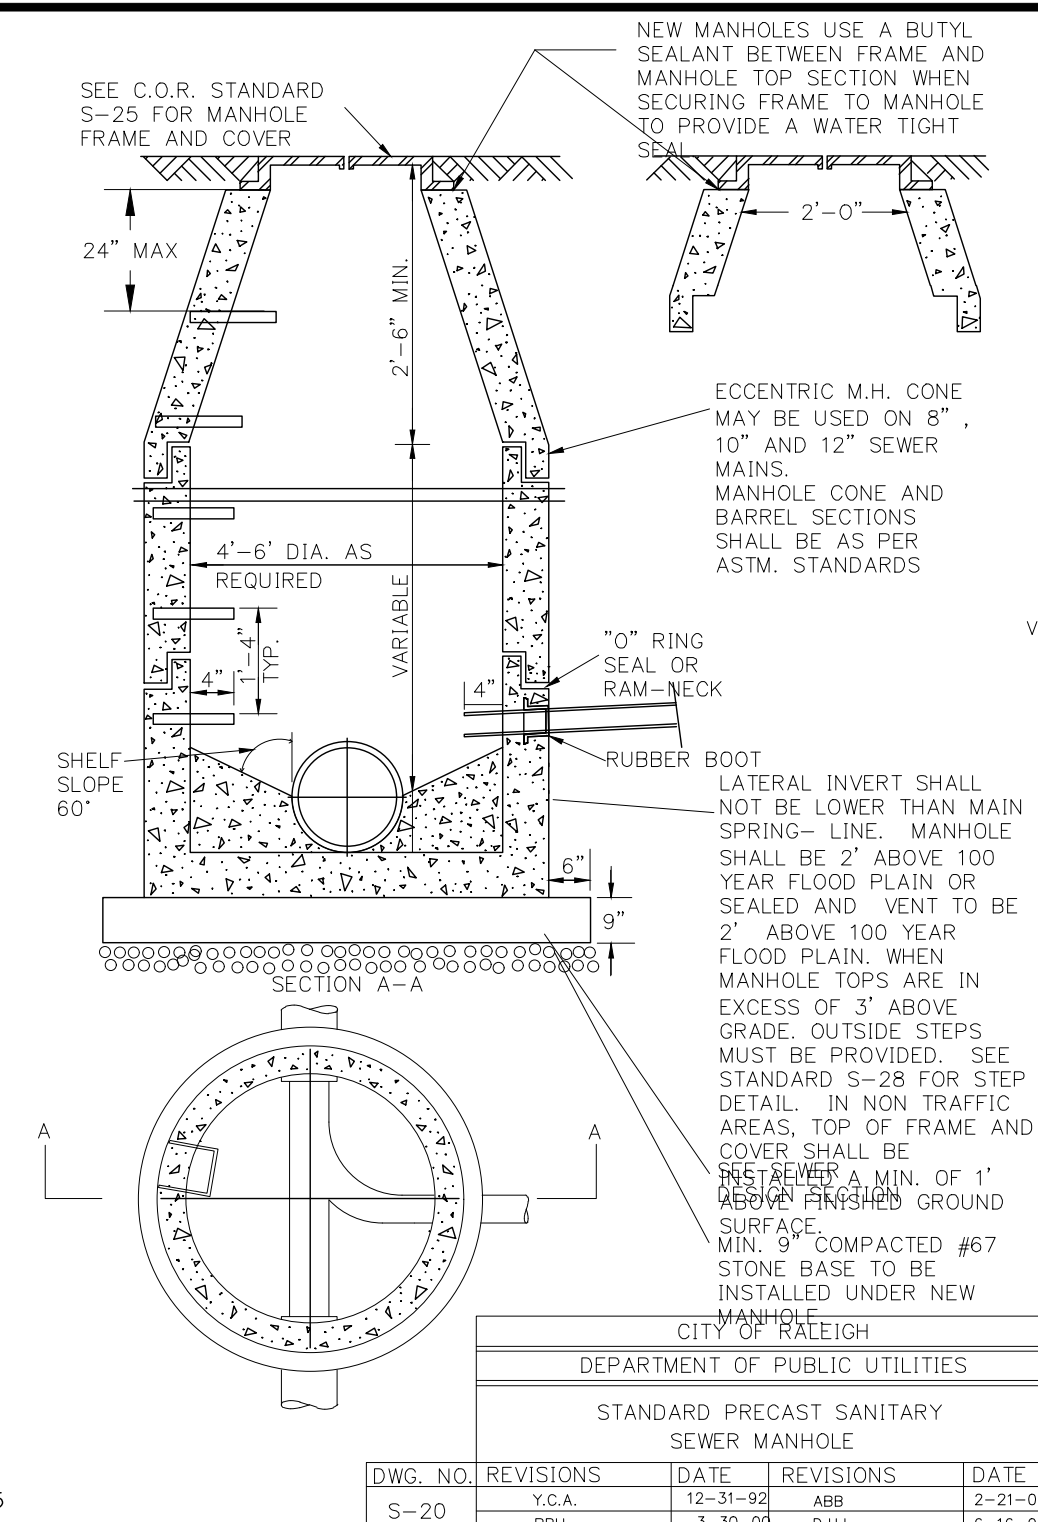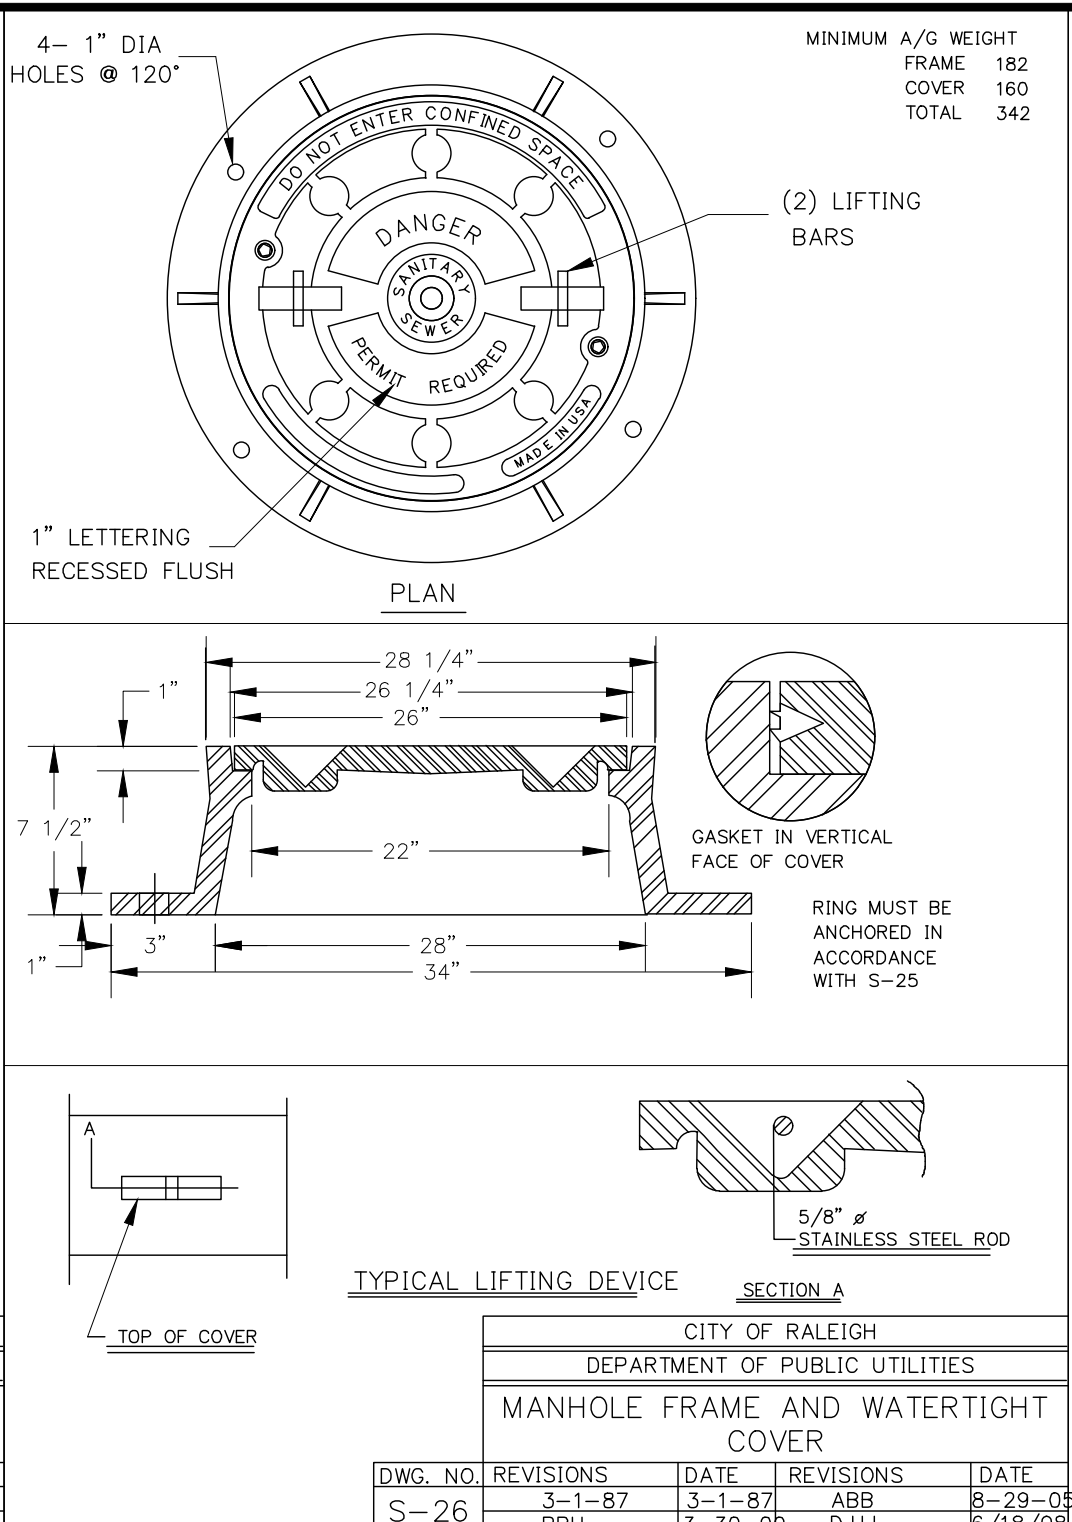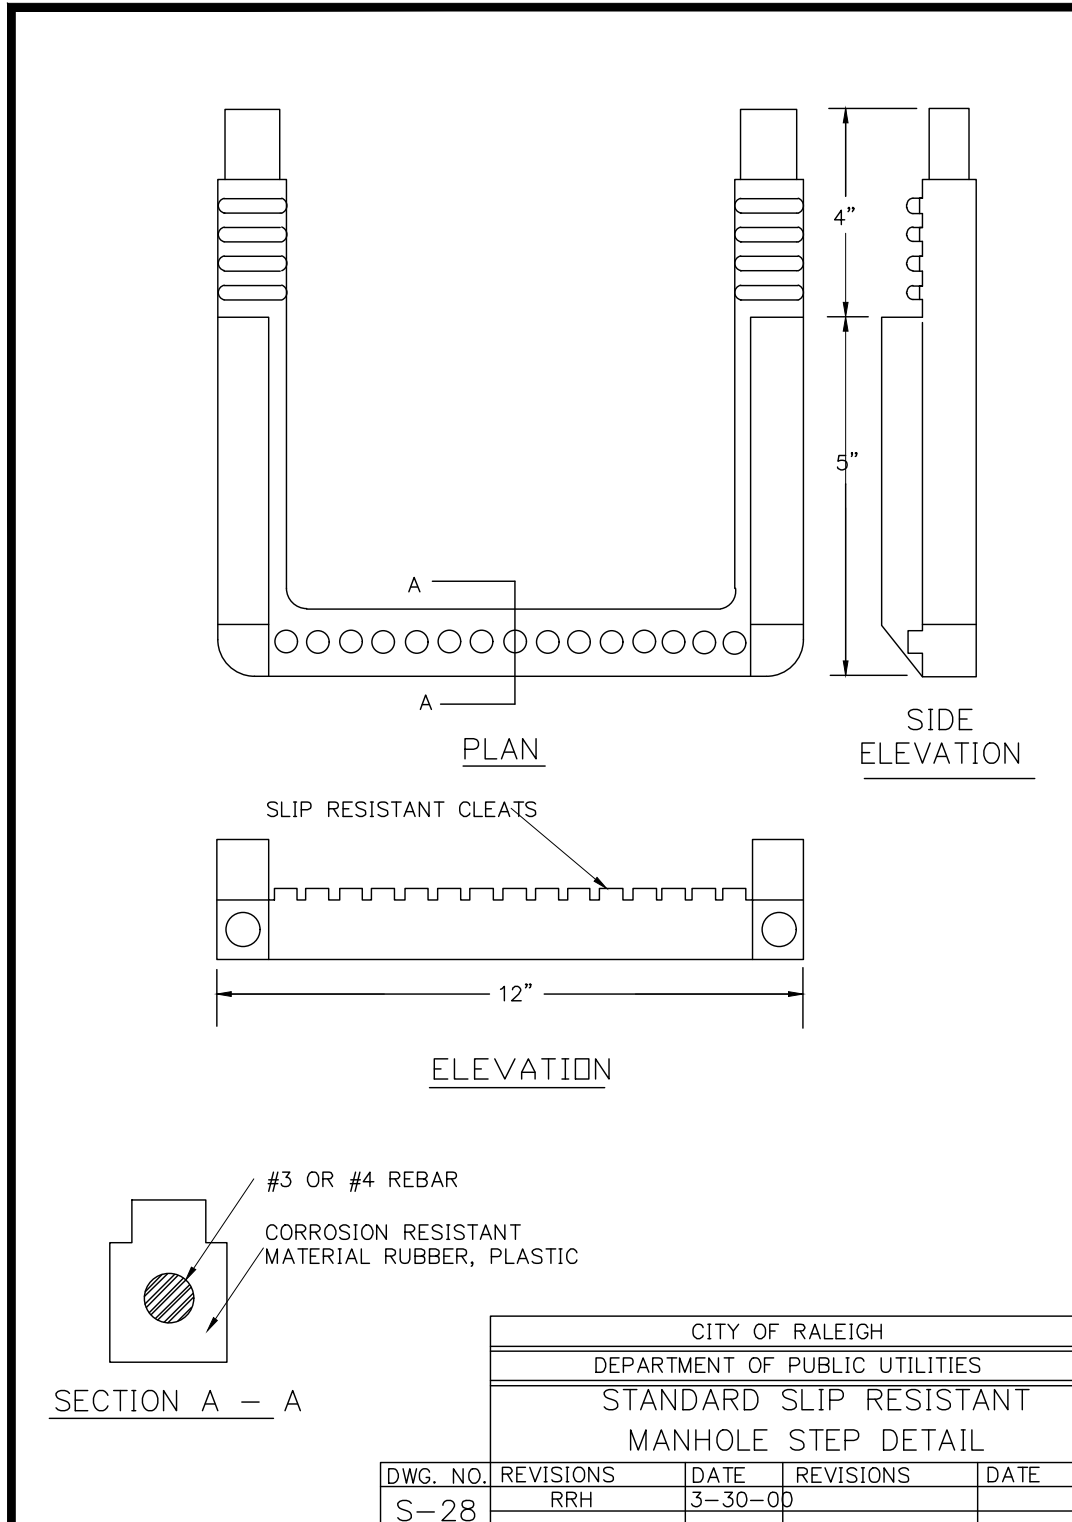

DWG. NO.	REVISIONS	DATE	REVISIONS	DATE
S-28	RRH	3-30-00		

DWG. NO.	REVISIONS	DATE	REVISIONS	DATE
S-26	Y.C.A.	3-1-87	ABB	8-28-03
	RRH	3-30-00	CPH/L	8/18/09

DWG. NO.	REVISIONS	DATE	REVISIONS	DATE
S-20	Y.C.A.	12-31-92	ABB	2-21-03
	RRH	3-30-00	DHL	6-15-09

DWG. NO.	REVISIONS	DATE	REVISIONS	DATE
S-20A	RRH	09-14		

SITE PERMITTING APPROVAL

The City of Raleigh consents to the connection and extension of the City's Public Sewer System as shown on this plan. The material and Construction methods used for this project shall conform to the standards and specifications of the City's Public Utilities Handbook. City of Raleigh Public Utilities Department Permit # S-5093.

The City of Raleigh consents to the connection and extension of the City's Public Water System as shown on this plan. The material and Construction methods used for this project shall conform to the standards and specifications of the City's Public Utilities Handbook. City of Raleigh Public Utilities Department Permit # S-5093.

The City of Raleigh consents to the connection to its public sewer system and extensions of the private sewer collection system as shown on this plan. The material and construction methods used for this project shall conform to the standards and specifications of the City's Public Utilities Handbook.

City of Raleigh - PLANS AUTHORIZED FOR CONSTRUCTION

Plans for the proposed use have been reviewed for general compliance with applicable codes. This limited review, and authorization for construction is not to be considered to represent total compliance with all legal requirements for development and construction. The property owner, design consultants, and contractors are each responsible for compliance with all applicable City, State and Federal laws. This specific authorization below is not a permit, nor shall it be construed to permit any violation of City, State or Federal Law. All Construction must be in accordance with all Local, State, and Federal Rules and Regulations.

Electronic Approval: This approval is being issued electronically. This approval is valid only upon the signature of a City of Raleigh Review Officer below. The City will retain a copy of the approved plans. Any work authorized by this approval must proceed in accordance with the plans kept on file with the City. This electronic approval may not be edited once issued. Any modification to this approval once issued will invalidate this approval.

City of Raleigh Development Approval: _____
City of Raleigh Review Officer: _____

CORPUD Standard Utility Notes:

- ALL MATERIALS & CONSTRUCTION METHODS SHALL BE IN ACCORDANCE WITH CITY OF RALEIGH DESIGN STANDARDS, DETAILS & SPECIFICATIONS (REFERENCE: CORPUD HANDBOOK)
- UTILITY SEPARATION REQUIREMENTS:
 - A DISTANCE OF 100' SHALL BE MAINTAINED BETWEEN SANITARY SEWER & ANY PRIVATE OR PUBLIC WATER SUPPLY SOURCE SUCH AS AN IMPOUNDED RESERVOIR USED AS A SOURCE OF DRINKING WATER. IF ADEQUATE LATER SEPARATION CANNOT BE ACHIEVED, FERROUS SANITARY SEWER PIPE SHALL BE SPECIFIED & INSTALLED TO WATERLINE SPECIFICATIONS. HOWEVER, THE MINIMUM SEPARATION SHALL NOT BE LESS THAN 25' FROM A PRIVATE WELL OR 50' FROM A PUBLIC WELL.
 - WHEN INSTALLING WATER &/OR SEWER MAINS, THE HORIZONTAL SEPARATION BETWEEN UTILITIES SHALL BE 10'. IF THIS SEPARATION CANNOT BE MAINTAINED DUE TO EXISTING CONDITIONS, THE VARIATION ALLOWED IS THE WATER MAIN IN A SEPARATE TRENCH WITH THE ELEVATION OF THE WATER MAIN AT LEAST 18" ABOVE THE TOP OF THE SEWER & MUST BE APPROVED BY THE PUBLIC UTILITIES DIRECTOR.
 - WHERE IT IS IMPOSSIBLE TO OBTAIN PROPER SEPARATION, OR ANYTIME A SANITARY SEWER PASSES OVER A WATER MAIN, DIP MATERIALS OR STEEL ENCASEMENT EXTENDED 10" ON EACH SIDE OF CROSSING MUST BE SPECIFIED & INSTALLED TO WATERLINE SPECIFICATIONS.
 - 5.0' MINIMUM HORIZONTAL SEPARATION IS REQUIRED BETWEEN ALL SANITARY SEWER & STORM SEWER FACILITIES, UNLESS DIP MATERIAL IS SPECIFIED FOR SANITARY SEWER.
 - MAINTAIN 18" MIN. VERTICAL SEPARATION AT ALL WATER MAIN & RCP STORM DRAIN CROSSINGS; MAINTAIN 24" MIN. VERTICAL SEPARATION AT ALL SANITARY SEWER & RCP STORM DRAIN CROSSINGS. WHERE ADEQUATE SEPARATIONS CANNOT BE ACHIEVED, SPECIFY DIP MATERIALS & A CONCRETE CRADLE HAVING 6" MIN. CLEARANCE (PER CORPUD DETAILS W-41 & S-49).
 - ALL OTHER UNDERGROUND UTILITIES SHALL CROSS WATER & SEWER FACILITIES WITH 18" MIN. VERTICAL SEPARATION REQUIRED.
- ANY NECESSARY FIELD REVISIONS ARE SUBJECT TO REVIEW & APPROVAL OF AN AMENDED PLAN &/OR PROFILE BY CORPUD PRIOR TO CONSTRUCTION.
- CONTRACTOR SHALL MAINTAIN CONTINUOUS WATER & SEWER SERVICE TO EXISTING RESIDENCES & BUSINESSES THROUGHOUT CONSTRUCTION OF PROJECT. ANY NECESSARY SERVICE INTERRUPTIONS SHALL BE PRECEDED BY A 24 HOUR ADVANCE NOTICE TO CORPUD.
- 3.0' MINIMUM COVER IS REQUIRED ON ALL WATER MAINS & SEWER FORCE MAINS. 4.0' MINIMUM COVER IS REQUIRED ON ALL REUSE MAINS.
- IT IS THE DEVELOPER'S RESPONSIBILITY TO ABANDON OR REMOVE EXISTING WATER & SEWER SERVICES NOT BEING USED IN REDEVELOPMENT OF A SITE UNLESS OTHERWISE DIRECTED BY CORPUD. THIS INCLUDES ABANDONING TAP AT MAIN & REMOVAL OF SERVIC FROM ROW OR EASEMENT PER CORPUD HANDBOOK PROCEDURE.
- INSTALL PVC WATER SERVICES WITH METERS LOCATED AT ROW OR WITHIN A 2' X 2' WATERLINE EASEMENT IMMEDIATELY ADJACENT.
- INSTALL PVC SEWER SERVICES @ 1.0% MINIMUM GRADE WITH CLEANOUTS LOCATED AT ROW OR EASEMENT LINE & SPACED EVERY 75 LINEAR FEET MAXIMUM.
- PRESSURE REDUCING VALVES ARE REQUIRED ON ALL WATER SERVICES EXCEEDING 80 PSI; BACKWATER VALVES ARE REQUIRED ON ALL SANITARY SEWER SERVICES HAVING BUILDING DRAINS LOWER THAN 1.0' ABOVE THE NEXT UPSTREAM MANHOLE.
- ALL ENVIRONMENTAL PERMITS APPLICABLE TO THE PROJECT MUST BE OBTAINED FROM NCDWQ, USACE &/OR FEMA FOR ANY RIPARIAN BUFFER, WETLAND &/OR FLOODPLAIN IMPACTS PRIOR TO CONSTRUCTION.
- NCDOT / RAILROAD ENCROACHMENT AGREEMENTS ARE REQUIRED FOR ANY UTILITY WORK (INCLUDING MAIN EXTENSIONS & SERVICE TAPS) WITHIN STATE OR RAILROAD ROW PRIOR TO CONSTRUCTION.
- GREASE INTERCEPTOR / OIL WATER SEPARATOR SIZING CALCULATIONS & INSTALLATION SPECIFICATIONS SHALL BE APPROVED BY THE CORPUD FOG PROGRAM COORDINATOR PRIOR TO ISSUANCE OF A BUILDING PERMIT. CONTACT TIM BEASLEY AT (919) 996-2334 OR TIMOTHY.BEASLEY@RALEIGHNC.GOV FOR MORE INFORMATION.
- CROSS-CONNECTION CONTROL PROTECTION DEVICES ARE REQUIRED BASED ON DEGREE OF HEALTH HAZARD INVOLVED AS LISTED IN APPENDIX-B OF THE RULES GOVERNING PUBLIC WATER SYSTEMS IN NC. THESE GUIDELINES ARE THE MINIMUM REQUIREMENTS. THE DEVICES SHALL MEET AMERICAN SOCIETY SANITARY ENGINEERING (ASSE) STANDARDS OR BE ON THE UNIVERSITY OF SOUTHERN CALIFORNIA APPROVAL LIST. THE DEVICES SHALL BE INSTALLED AND TESTED (BOTH INITIAL AND PERIODIC TESTING THEREAFTER) IN ACCORDANCE WITH THE MANUFACTURERS RECOMMENDATIONS OR THE LOCAL CROSS-CONNECTION CONTROL PROGRAM, WHICHEVER IS MORE STRINGENT. CONTACT JOANIE HARTLEY AT (919) 996-5923 OR JOANIE.HARTLEY@RALEIGHNC.GOV FOR MORE INFORMATION.

ATTENTION CONTRACTORS

The Construction Contractor responsible for the extension of water, sewer, and/or reuse, as approved in these plans, is responsible for contacting the Public Utilities Department at (919) 996-4540 at least twenty four hours prior to beginning any of their construction.

Failure to notify both City Departments in advance of beginning construction, will result in the issuance of monetary fines, and require reinstallation of any water or sewer facilities not inspected as a result of this notification failure.

Failure to call for inspection, Install a Downstream Plug, have Permitted Plans on the Jobite, or any other Violation of City of Raleigh Standards will result in a Fine and Possible Exclusion from future work in the City of Raleigh.

Public Sewer Collection / Extension System

The City of Raleigh consents to the connection and extension of the City's public sewer system as shown on this plan. The material and Construction methods used for this project shall conform to the standards and specifications of the City's Public Utilities Handbook.

City of Raleigh
Public Utilities Department Permit # S-5093

Authorization to Construct _____
Date _____

- Final Drawing -
Issued for Permit
Review Purposes Only


CROSLAND SOUTHEAST

SANITARY SEWER RELOCATION - DETAILS
WALLBROOK
MASS GRADING / EROSION CONTROL /
SANITARY SEWER RELOCATION
Town of Rolesville Project No. CD 22-02
Rolesville, Wake County, North Carolina

Project Manager: BCF
Drawn By: DCL
Checked By: STG
Project Number: 1089
Drawing Number: D-1219-EC

C2.1


Date: April 1, 2022

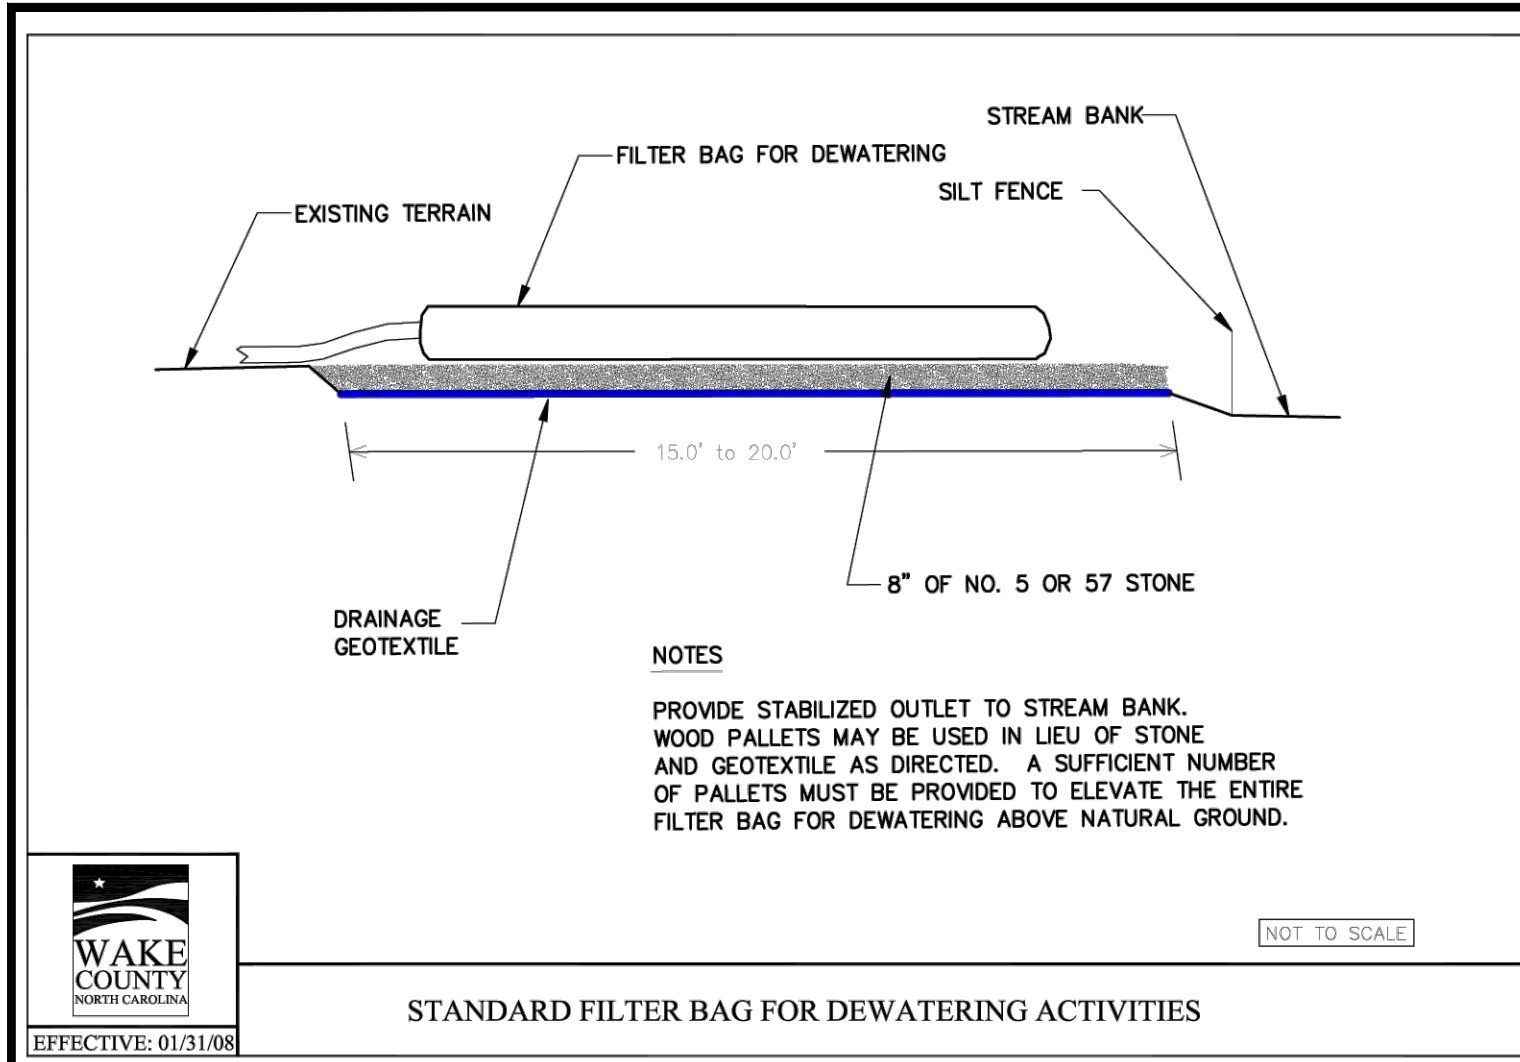

STANDARD FILTER BAG FOR DEWATERING ACTIVITIES


EFFECTIVE: 01/31/08

NOT TO SCALE

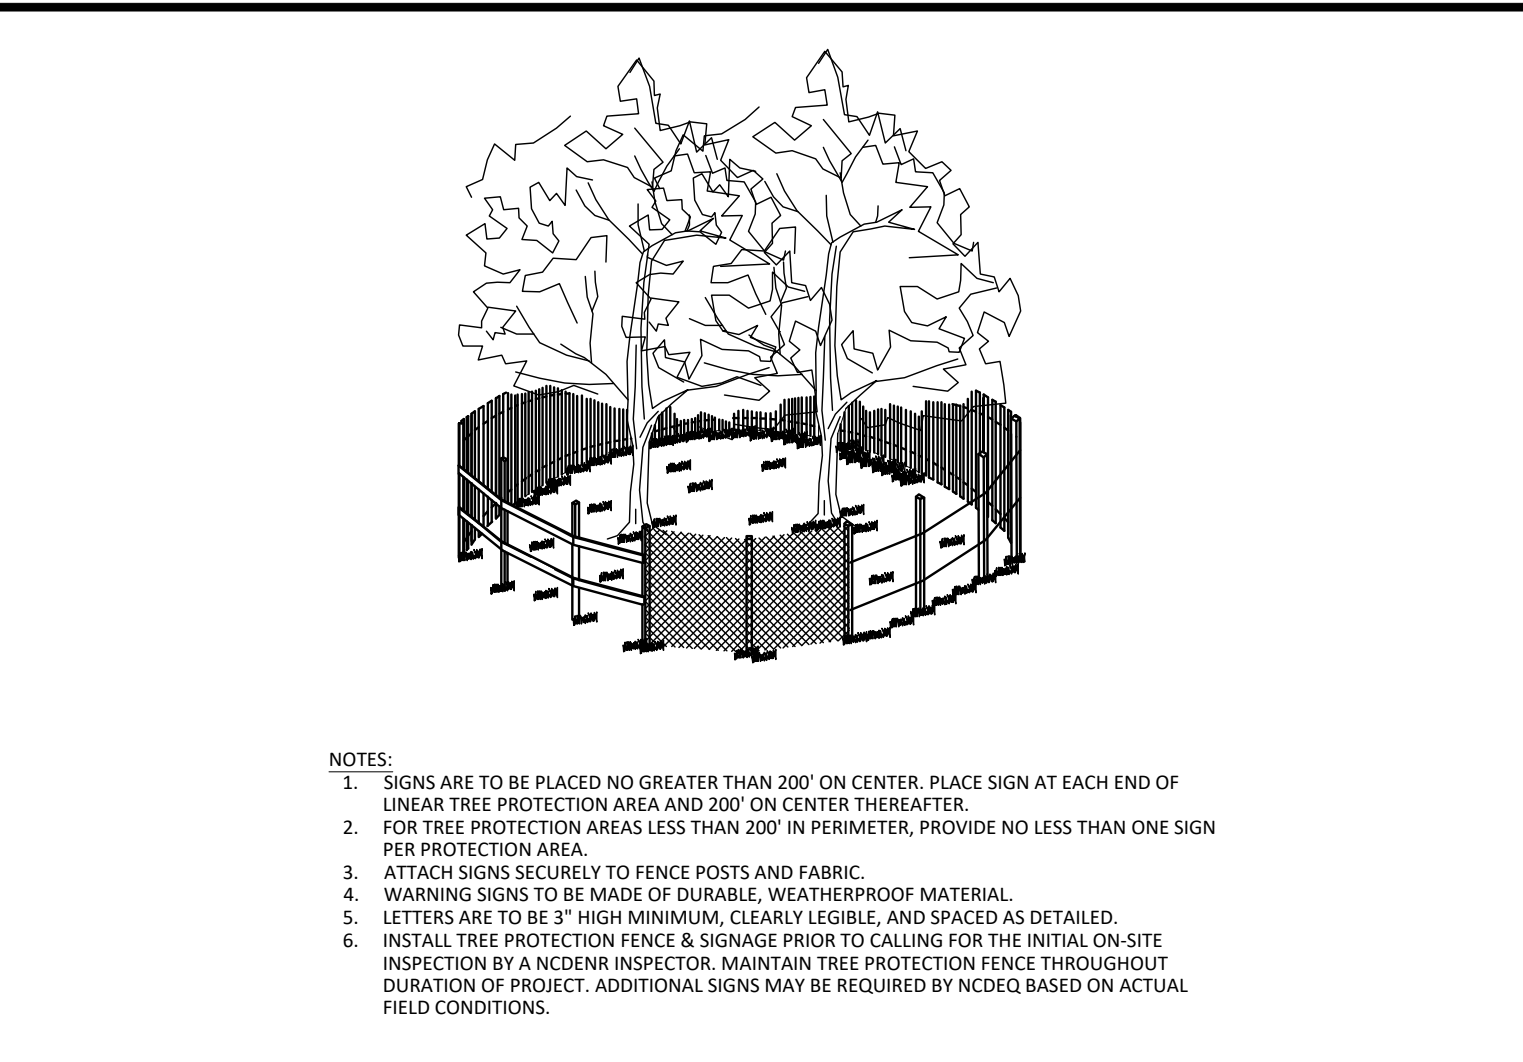


STANDARD SKIMMER ATTACHED TO PERMANENT RISER

EFFECTIVE: 01/31/08

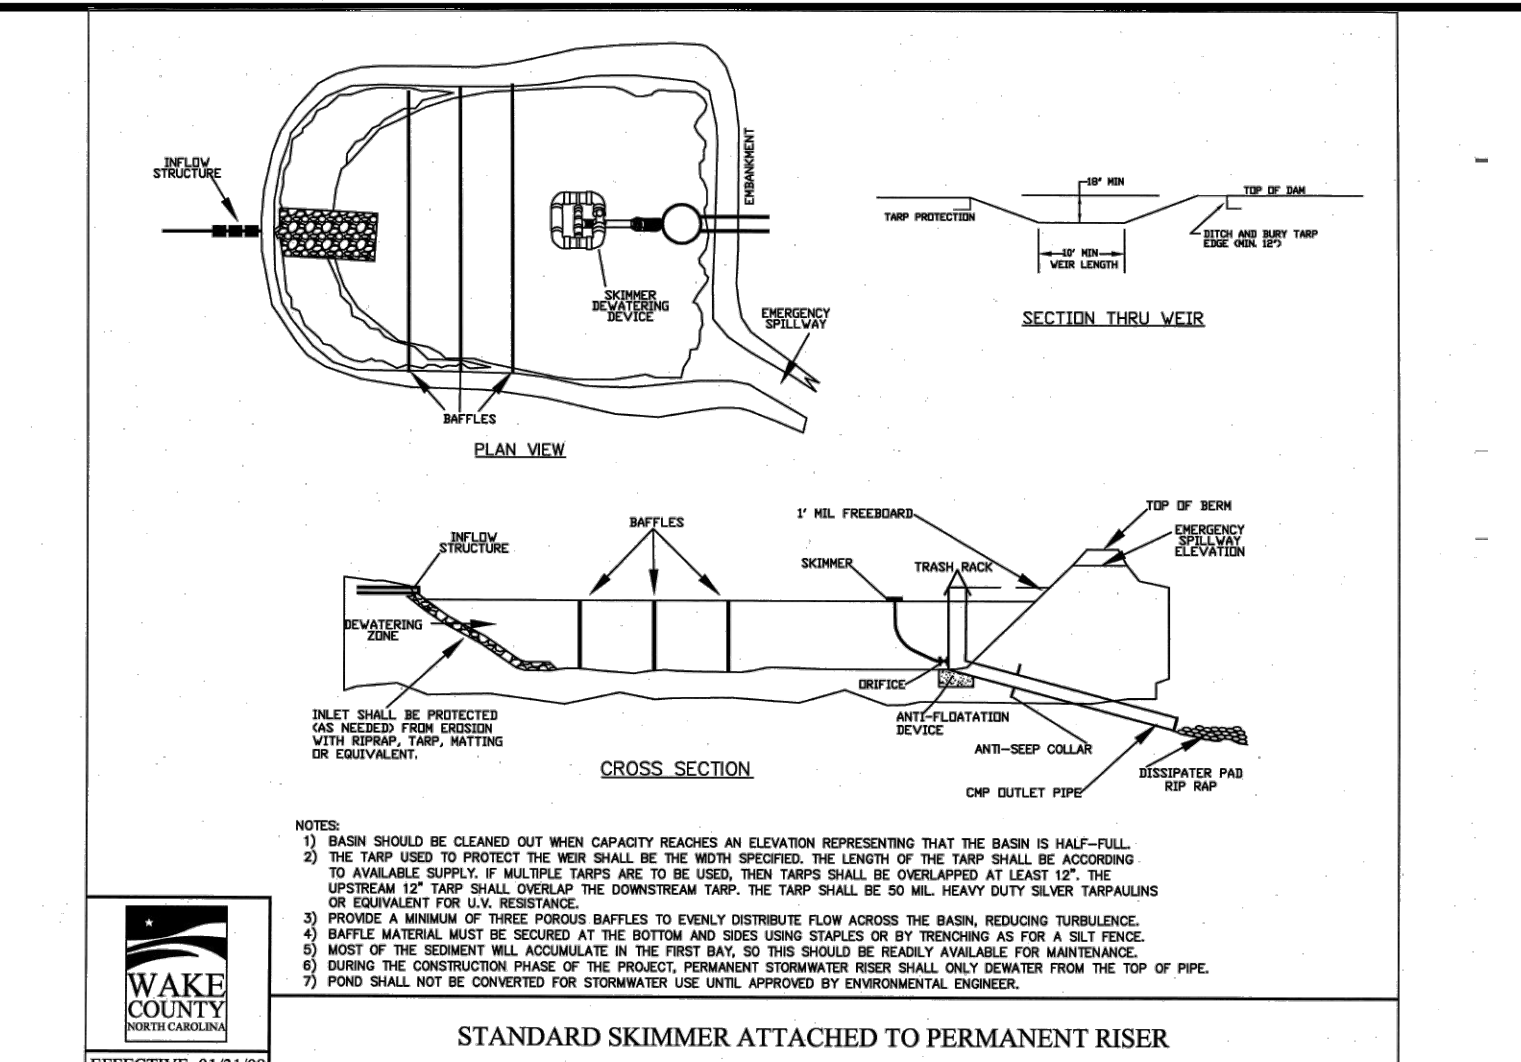


STANDARD SKIMMER BASIN

EFFECTIVE: 01/31/08

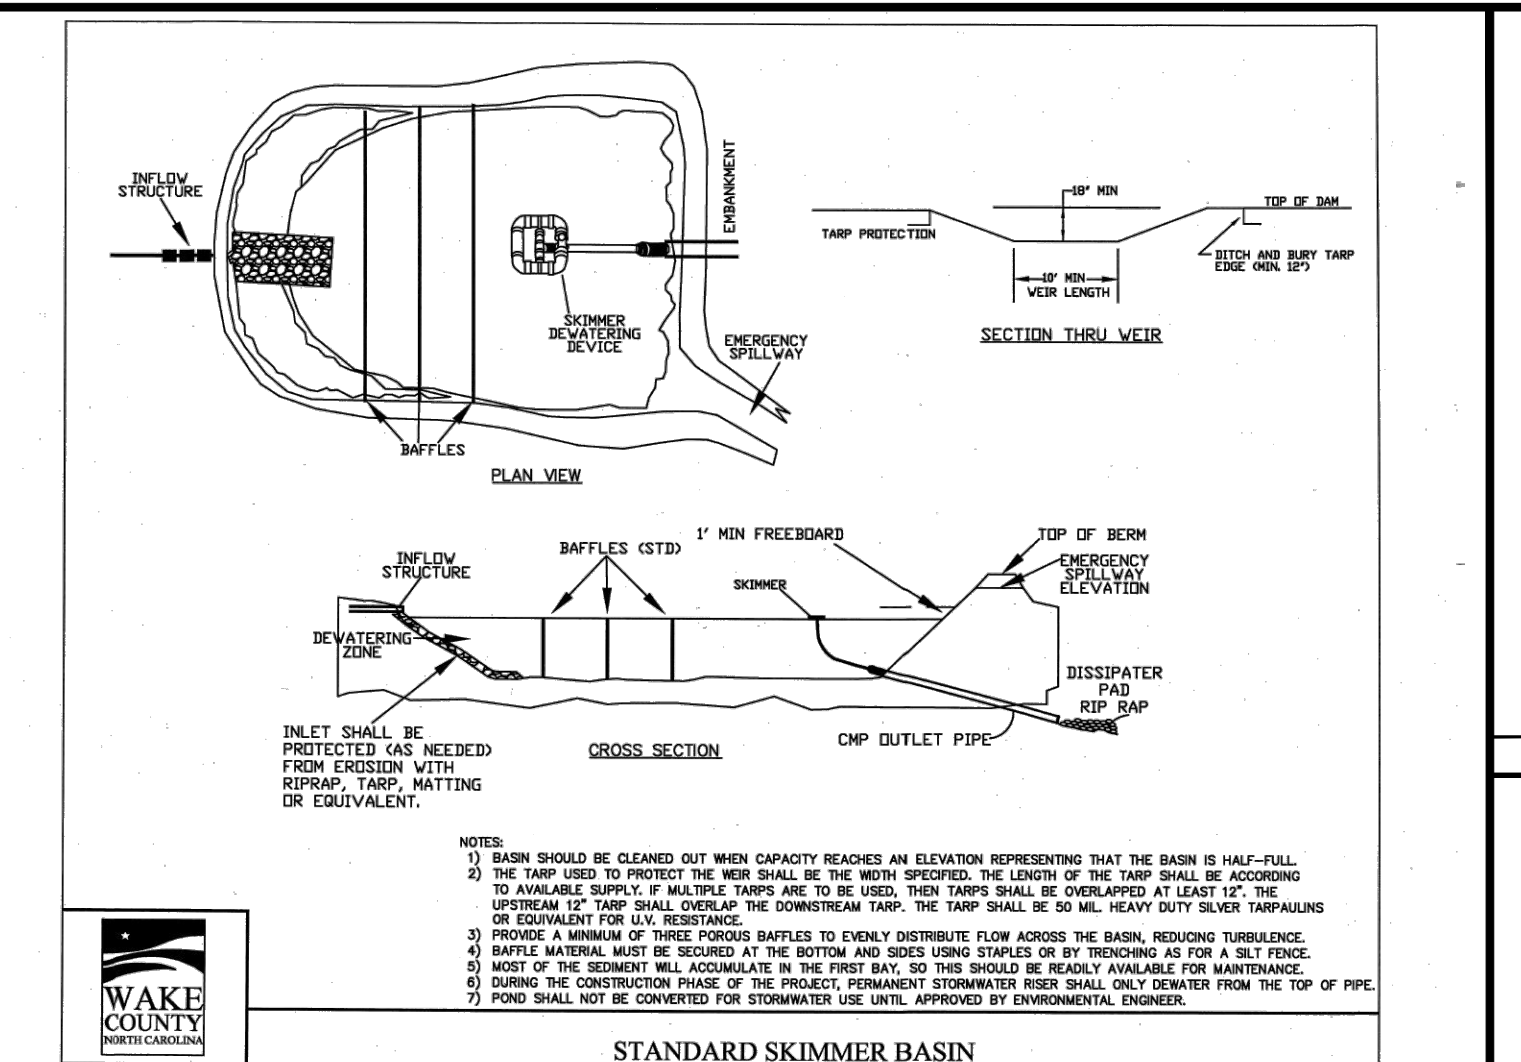


STANDARD BAFFLES DETAIL

EFFECTIVE: 01/31/08

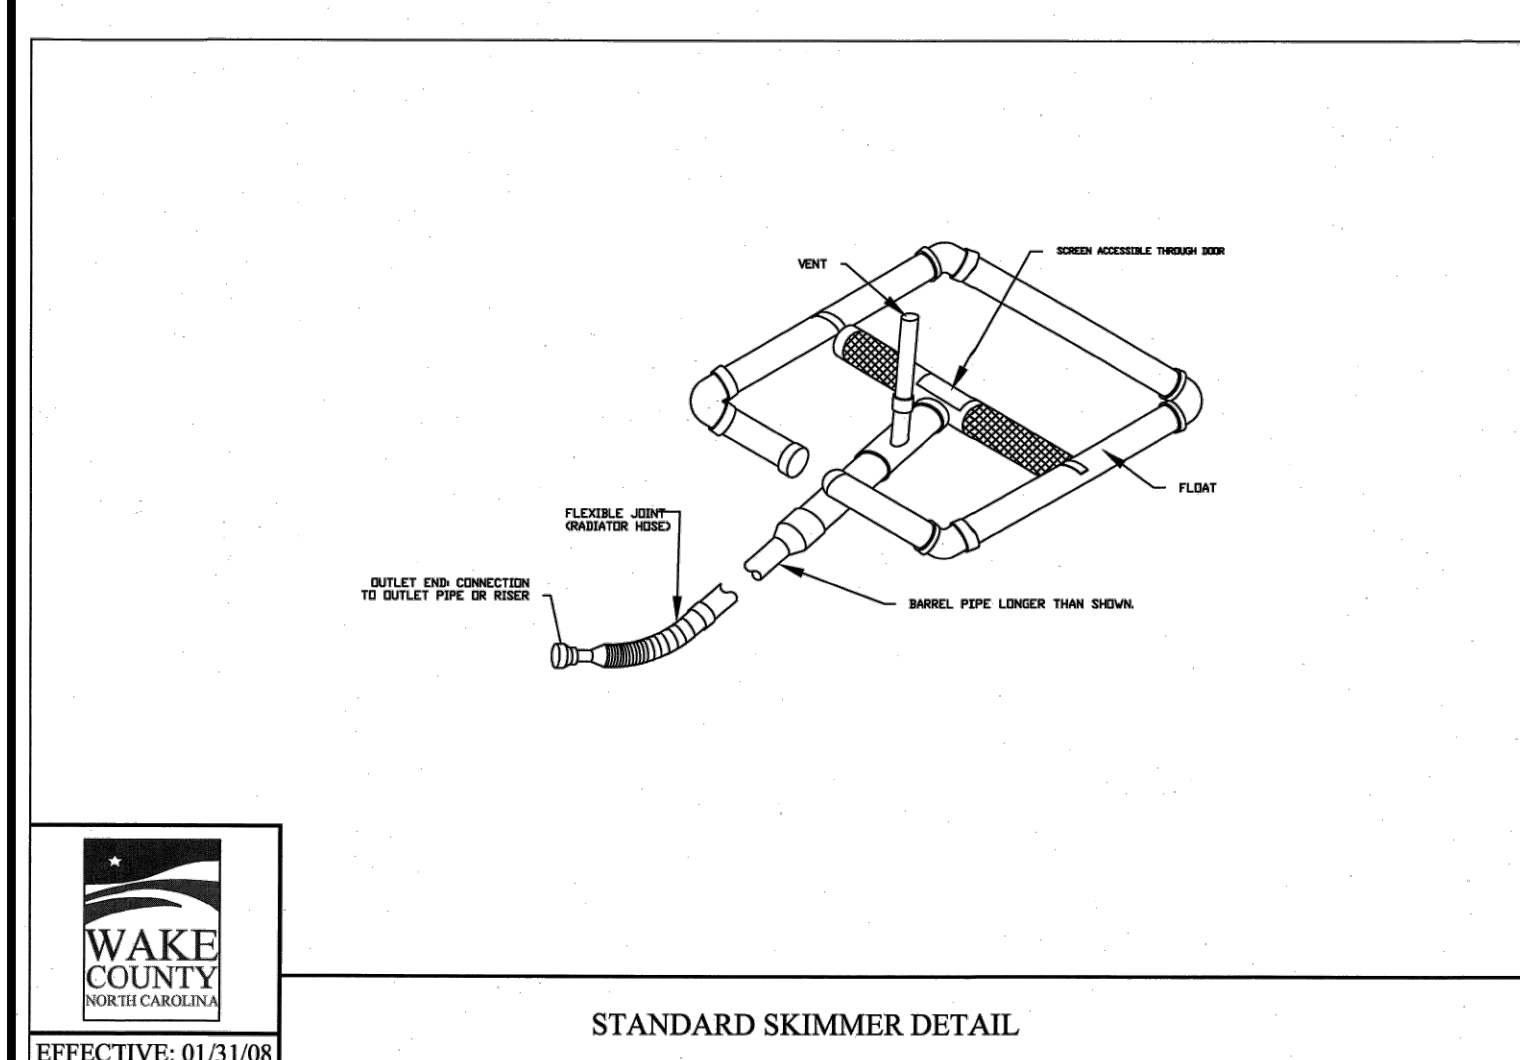


STANDARD SKIMMER DETAIL

EFFECTIVE: 01/31/08

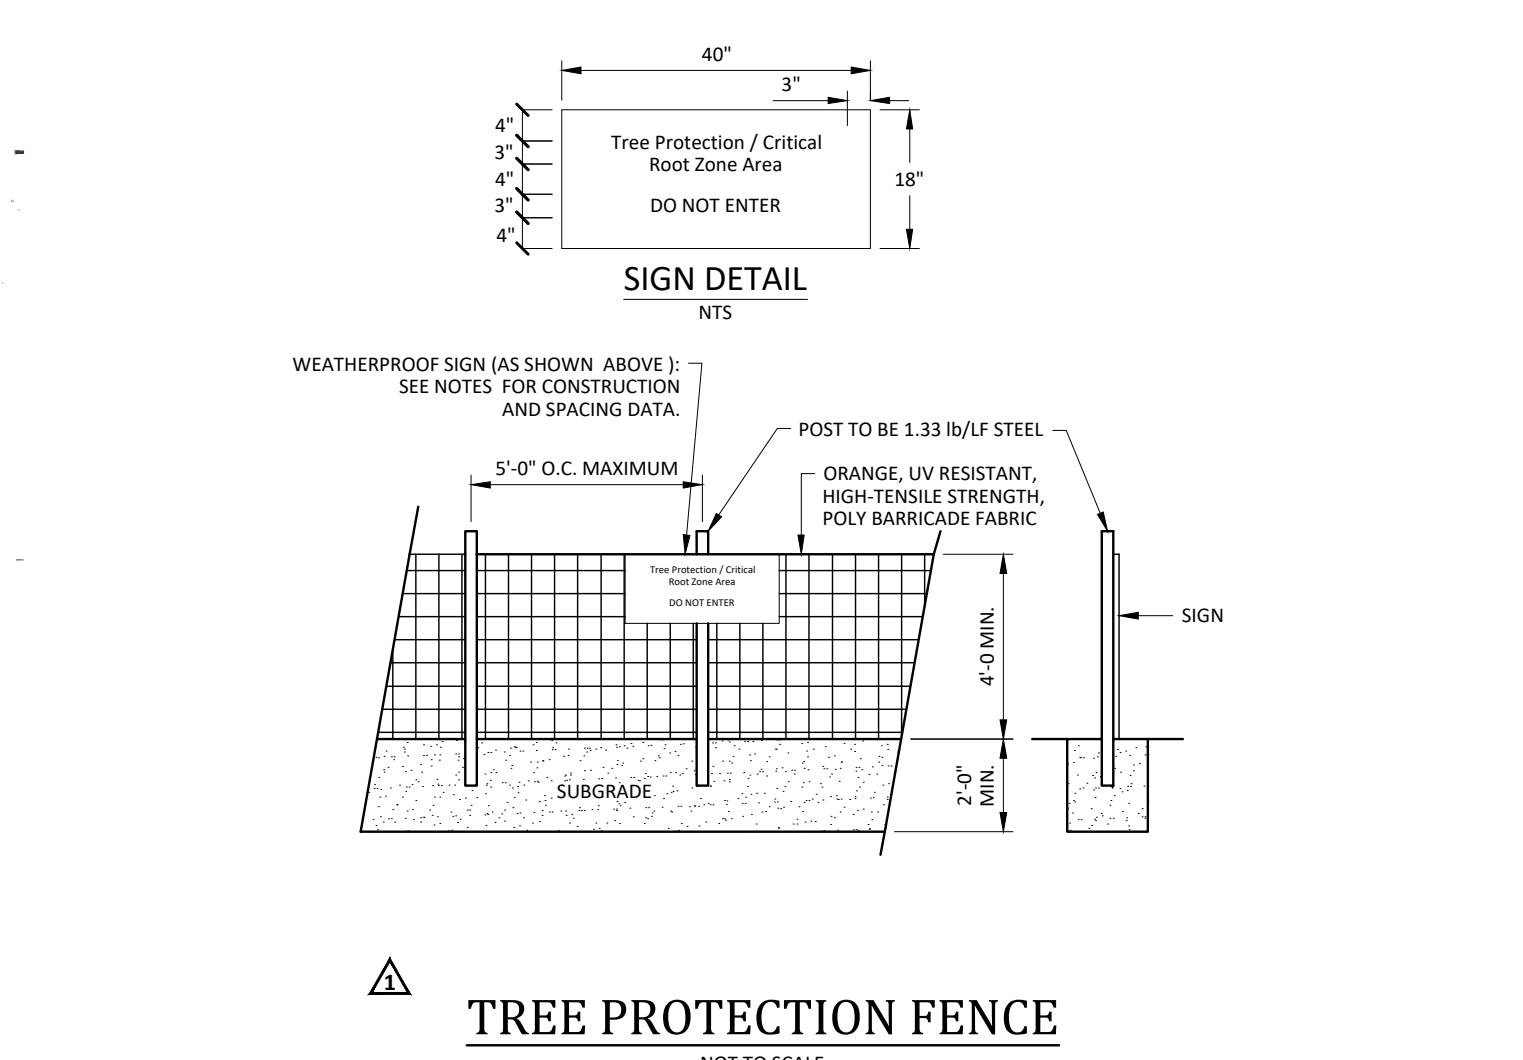


TREE PROTECTION FENCE

NOT TO SCALE

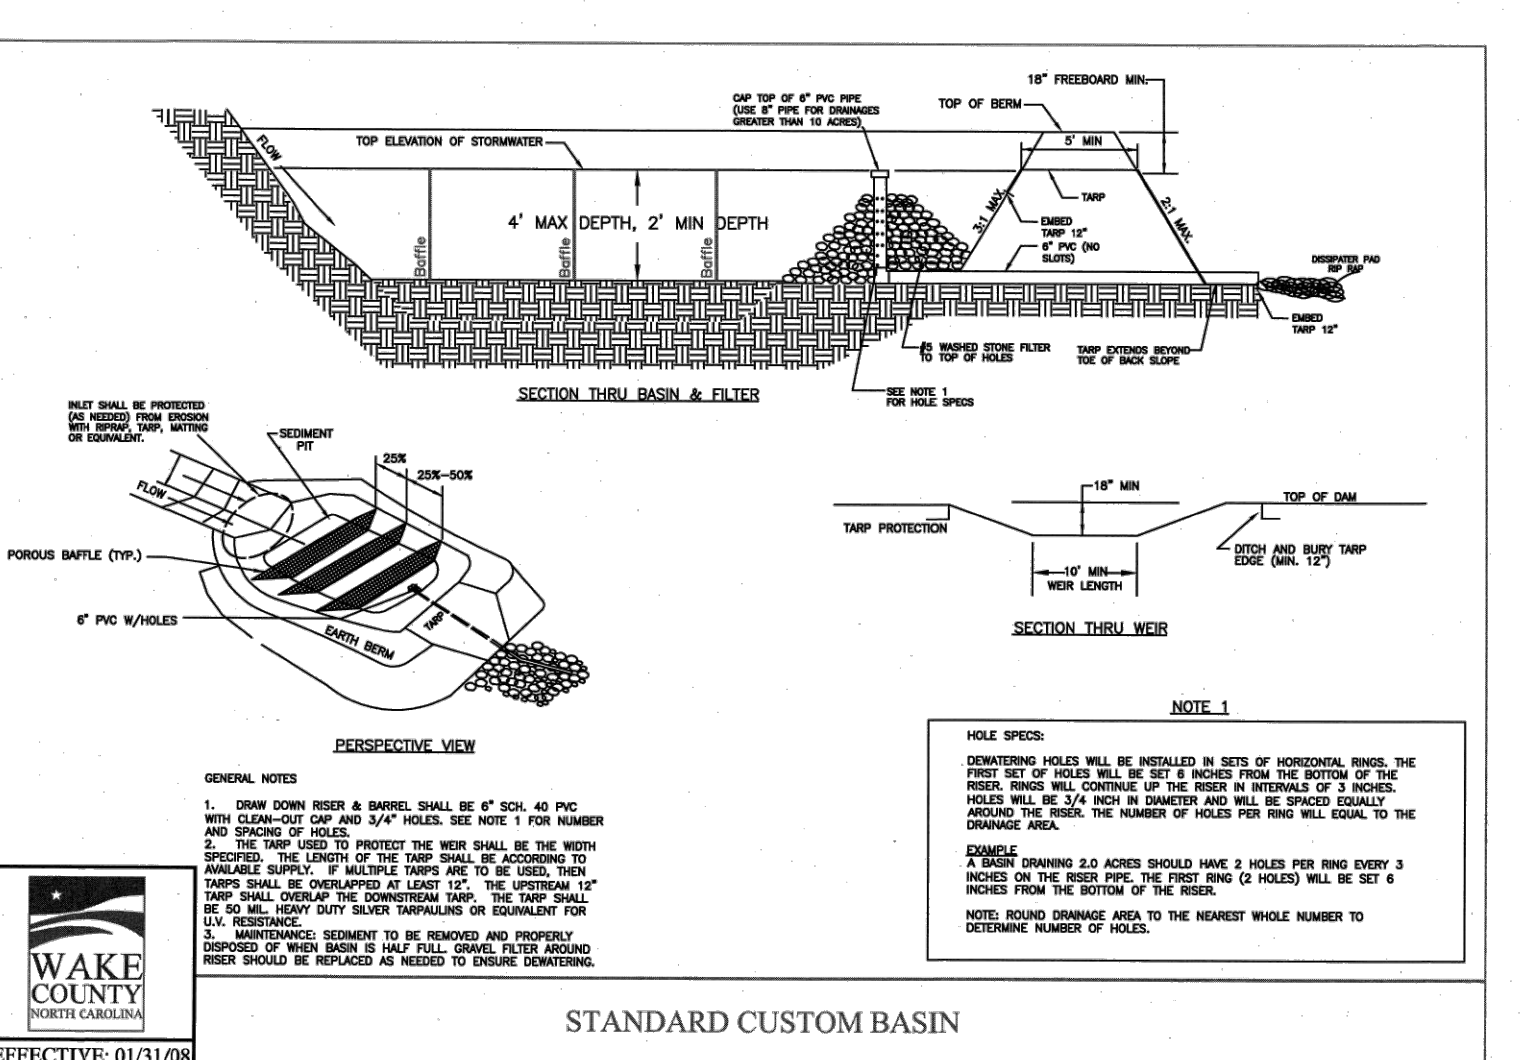


STANDARD CUSTOM BASIN

EFFECTIVE: 01/31/08

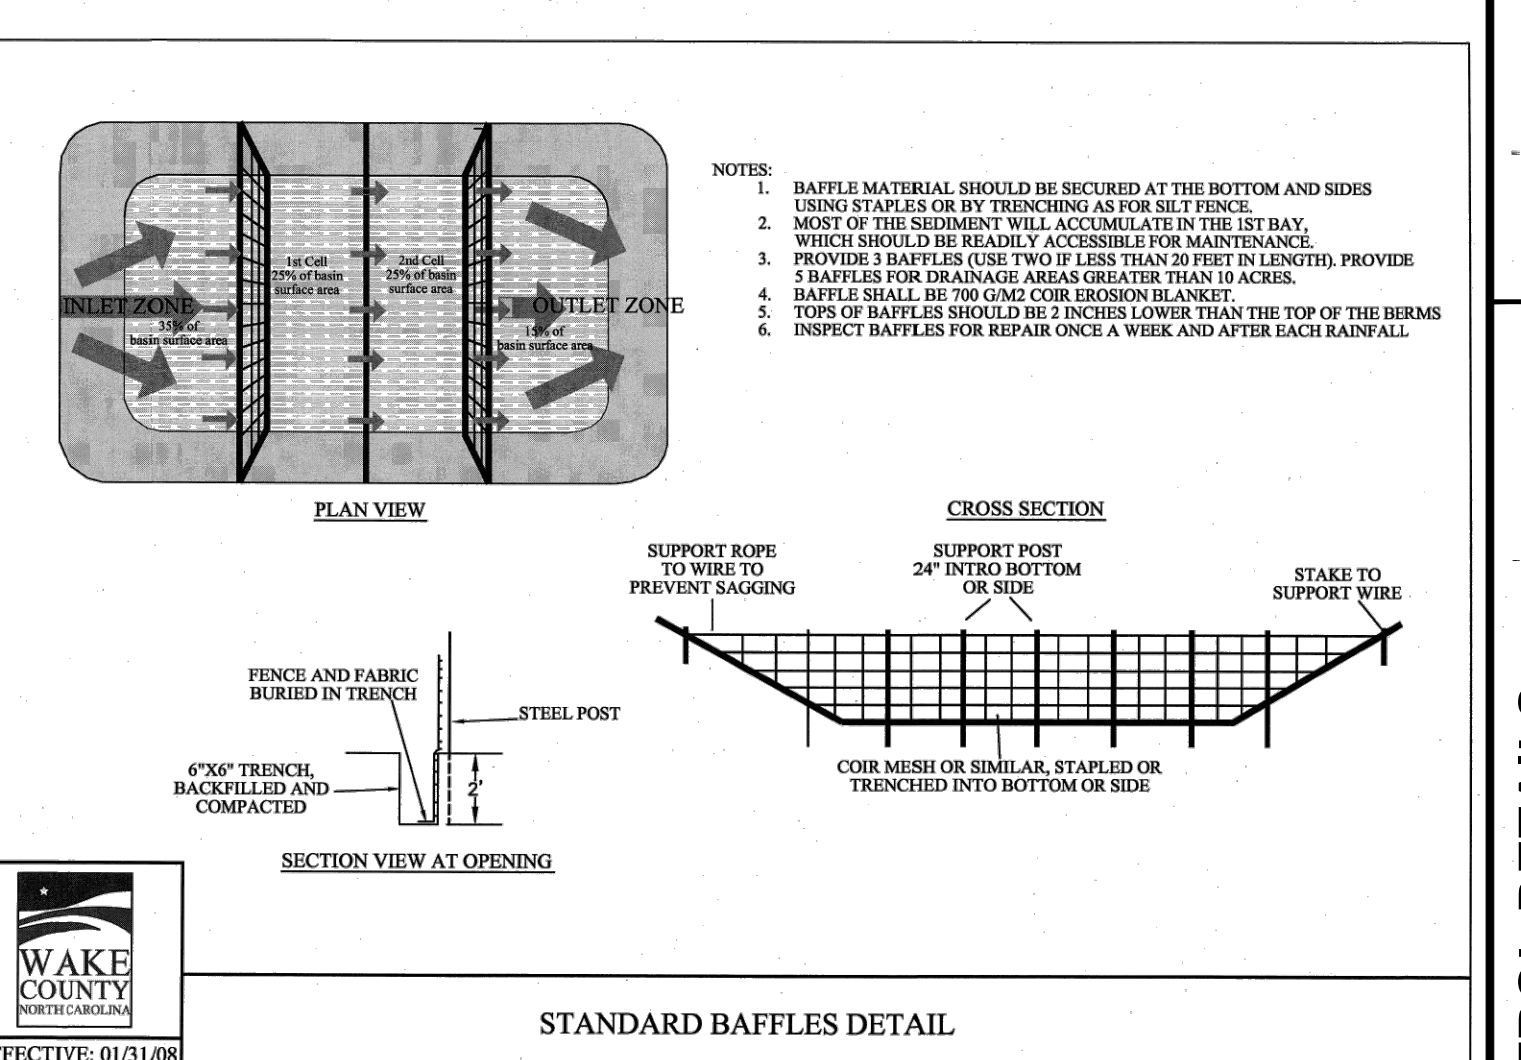

STANDARD BAFFLES DETAIL

EFFECTIVE: 01/31/08

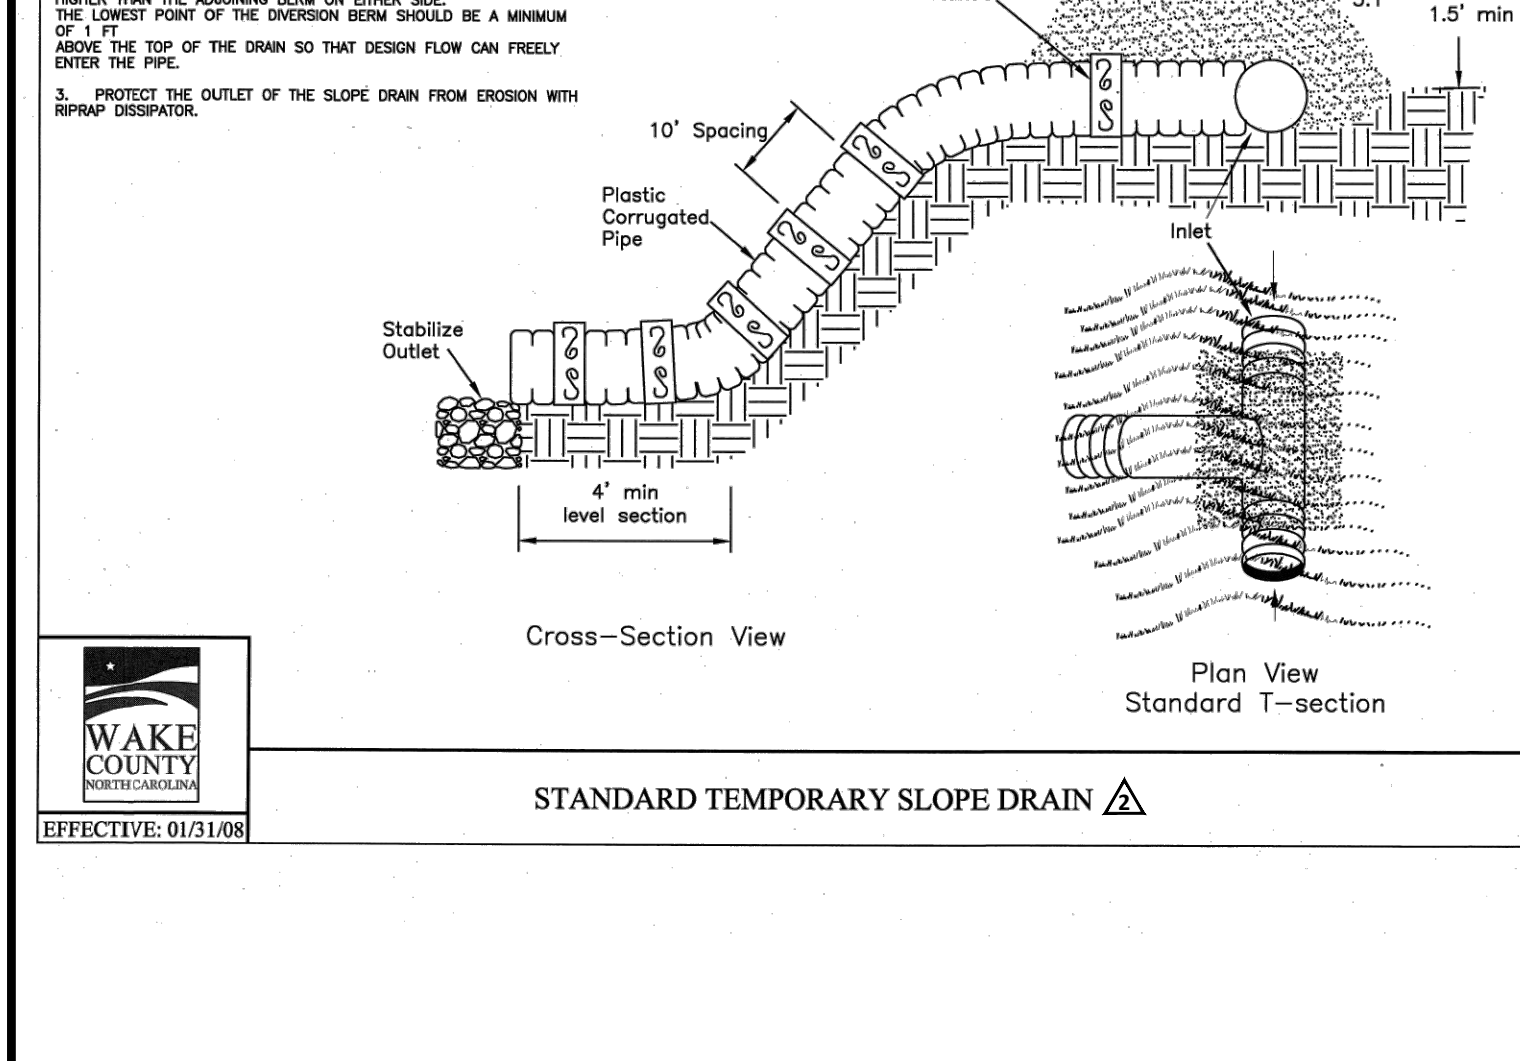

STANDARD TEMPORARY SLOPE DRAIN

EFFECTIVE: 01/31/08

- Final Drawing -
Issued for Permit
Review Purposes Only

REVISIONS:

#	DATE	DESCRIPTION
1	1-FEB-23	REVISED PER OWNER COMMENTS
2	12-JUL-22	REVISED PER TOR & WAKE COUNTY COMMENTS
3	15-JUN-22	REVISED PER TOR & WAKE COUNTY COMMENTS

CROSLAND SOUTHEAST

EROSION CONTROL DETAILS

WALLBROOK
MASS GRADING / EROSION CONTROL /
SANITARY SEWER RELOCATION
 Town of Rolesville Project No. CD 22-02
 Rolesville, Wake County, North Carolina

NC License: P-1199
ARK CONSULTING GROUP PLLC
 ENGINEERS & PLANNERS
 2755-B Charles Blvd.
 Cary, NC 27588
 (919) 558-0888
 www.arkconsultinggroup.com

Professional Engineer Seal:
 NORTH CAROLINA PROFESSIONAL ENGINEER
 ARK CONSULTING GROUP PLLC
 2/17/2023

Project Manager: BCF
 Drawn By: DLC
 Checked By: STA
 Project Number: 21089
 Drawing Number: D-1219-EC

C3.2

Date: April 1, 2022