
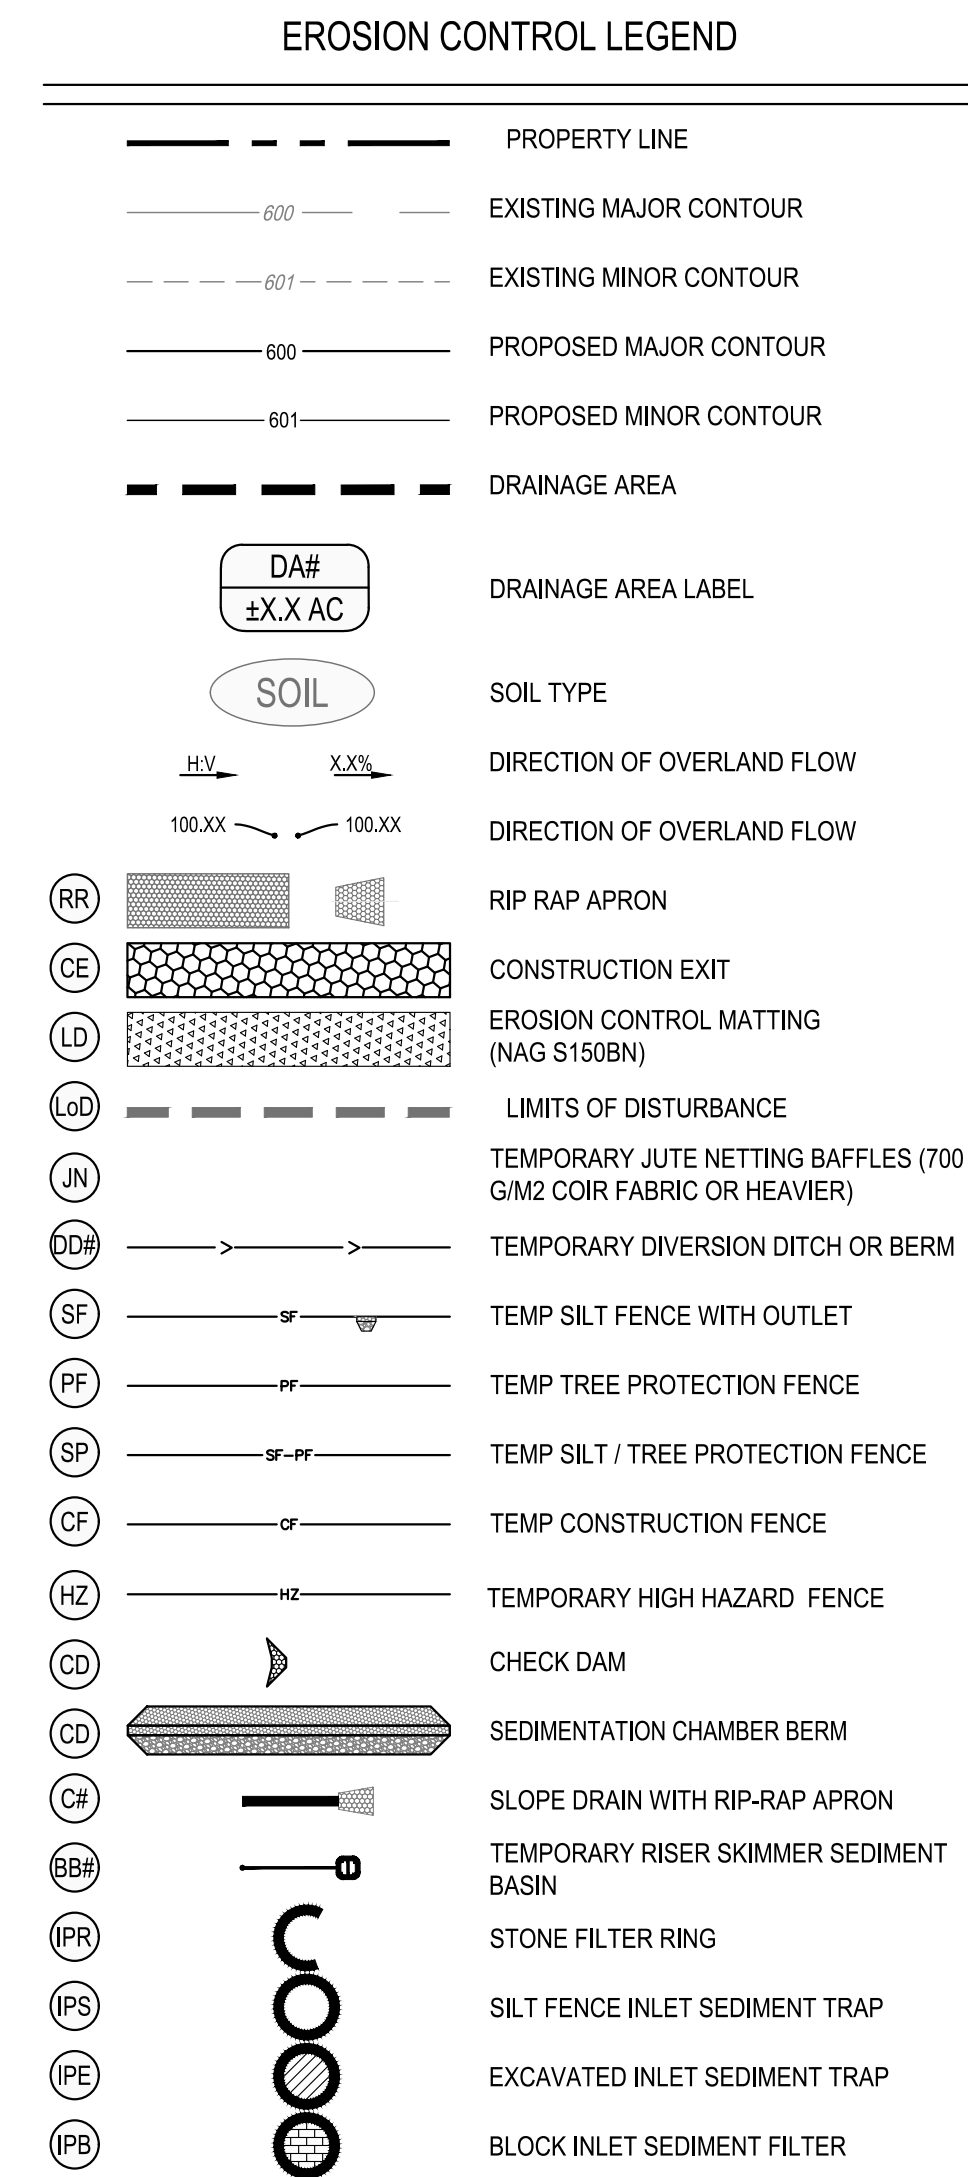


Know what's below.
Call before you dig.

 PRELIMINARY NOT FOR CONSTRUCTION FILE NUMBER: 8430-03 DATE: 06/01/2023 C5-1	ENLARGED PHASE 1 EROSION CONTROL PLAN (1 OF 6)	PARKER RIDGE 82 SCHOOL STREET ROLESVILLE / NORTH CAROLINA / 27571	LENNAR CORPORAION 1100 PERIMETER PARK DRIVE, SUITE 112 MORRISVILLE / NORTH CAROLINA / 27660	 5440 WADE PARK BLVD, SUITE 102 RALEIGH NC 27607 WWW.BGEINC.COM NC LICENSE #C-4397 ©2023	DESIGNED BY: DF/CD	DRAWN BY: DF/JWM	REVIEWED BY: DF	△ △ △ △	06/01/2023	REV 04/03/2023	INITIAL SUBMITTAL	PER TOWN OF ROLESVILLE COMMENT
---	--	---	--	--	--------------------	------------------	-----------------	---	------------	----------------	-------------------	--------------------------------

s:\NCAP\projects\Lennar\8430-03 - Lennar - school street - rolesville\03 - DWG\plansheets\On-Site\C5-0 - EROS-PH1.dwg Layout: C5-2 ENLARGED PHASE 1 EROSION CONTROL PLAN (2 OF 6) Plotted: 6/12/2023 1:30:58 PM

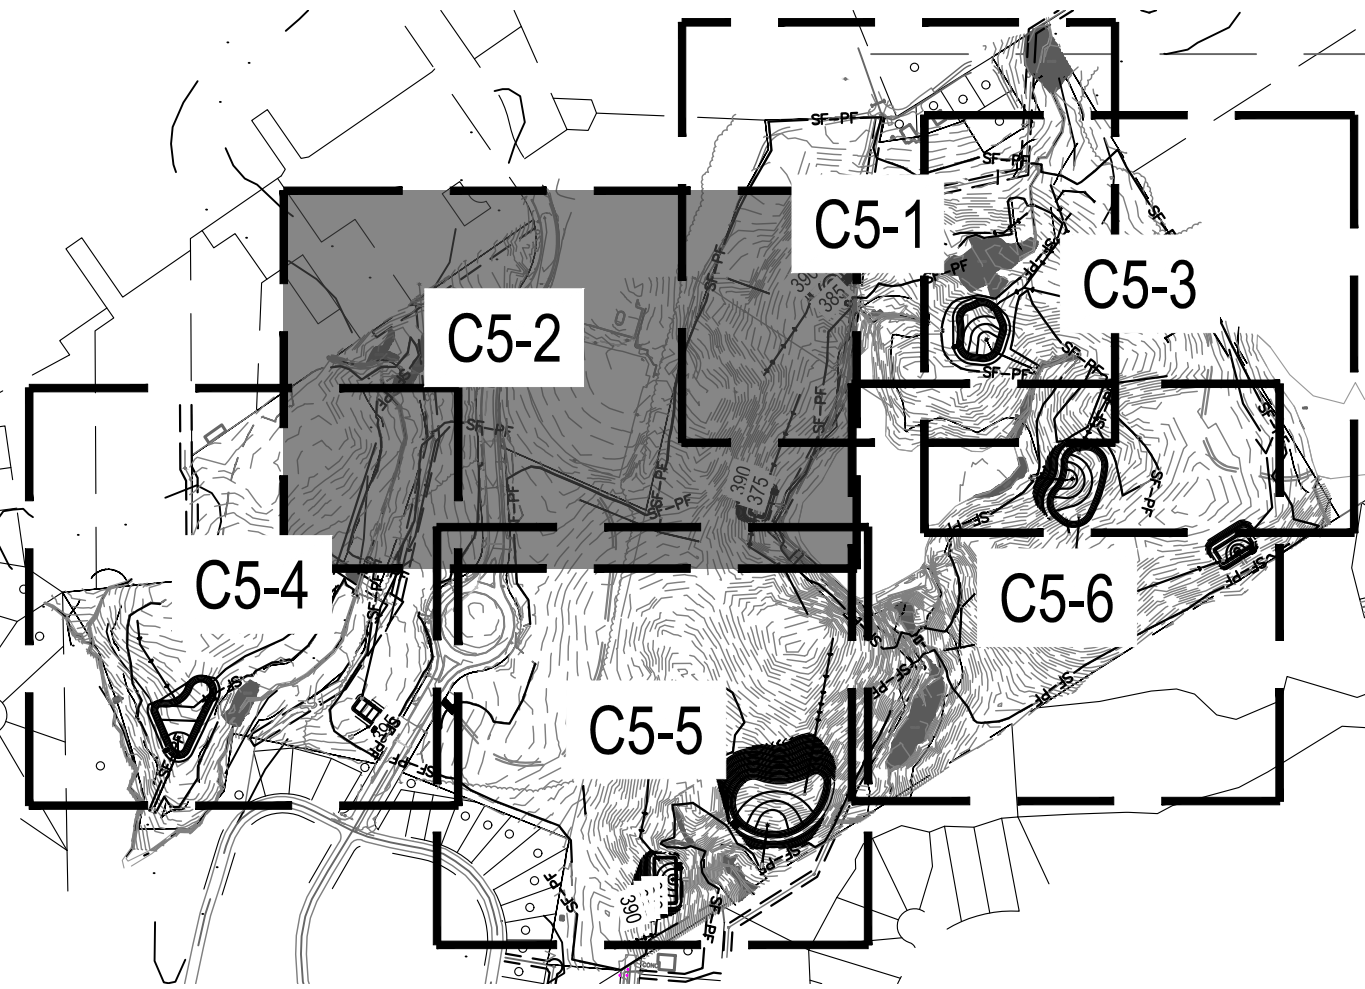

DESIGNED BY: DF/CD	
DRAWN BY: DF/JWM	
REVIEWED BY: DF	
PER TOWN OF ROLESVILLE COMMENT	
06/01/2023	REV 04/03/2023
INITIAL SUBMITTAL	

5440 WADE PARK BLVD, SUITE 102
RALEIGH NC 27607
WWW.BCEINC.COM
NC LICENSE #C-4397

LENNAR
CORPORAION
1100 PERIMETER PARK DRIVE, SUITE 112
MORRISVILLE / NORTH CAROLINA / 27560

PARKER RIDGE
82 SCHOOL STREET
ROLESVILLE / NORTH CAROLINA / 27571


ENLARGED PHASE 1
EROSION CONTROL
PLAN (2 OF 6)

NOT FOR
CONSTRUCTION

FILE NUMBER:
8430-03

DATE: 06/01/2023

C5-2

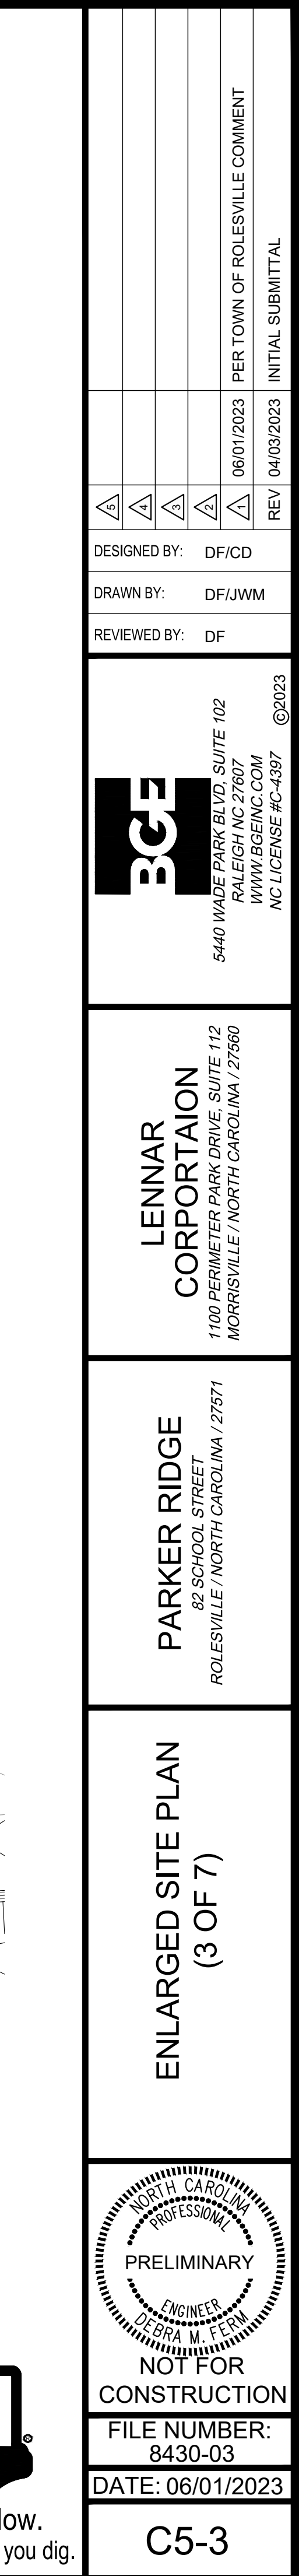



The topographic map shows the study area with six sampling locations marked: C5-1, C5-2, C5-3, C5-4, C5-5, and C5-6. C5-5 is a large central area, while the others are smaller points. The map includes contour lines, a grid, and various geographical features like roads and buildings.




 NOT FOR
 CONSTRUCTION
 FILE NUMBER:
 8430-03
 DATE: 06/01/2023
 C5-5

ENLARGED PHASE 1
EROSION CONTROL
PLAN (5 OF 6)


PARKER RIDGE
82 SCHOOL STREET
ROLESVILLE / NORTH CAROLINA / 27571

LENNAR
CORPORAION
1100 PERIMETER PARK DRIVE, SUITE 112
MORRISVILLE / NORTH CAROLINA / 27560

BGE
5440 WADE PARK BLVD, SUITE 102
RALEIGH NC 27607
WWW.BGEINC.COM
NC LICENSE #C-4397

△			
△			
△	06/01/2023	PER TOWN OF ROLESVILLE COMMENT	
REV	04/03/2023	INITIAL SUBMITTAL	

Where trees are slated for preservation, Critical Root Zones as well as Tree Protection Fencing shall be shown

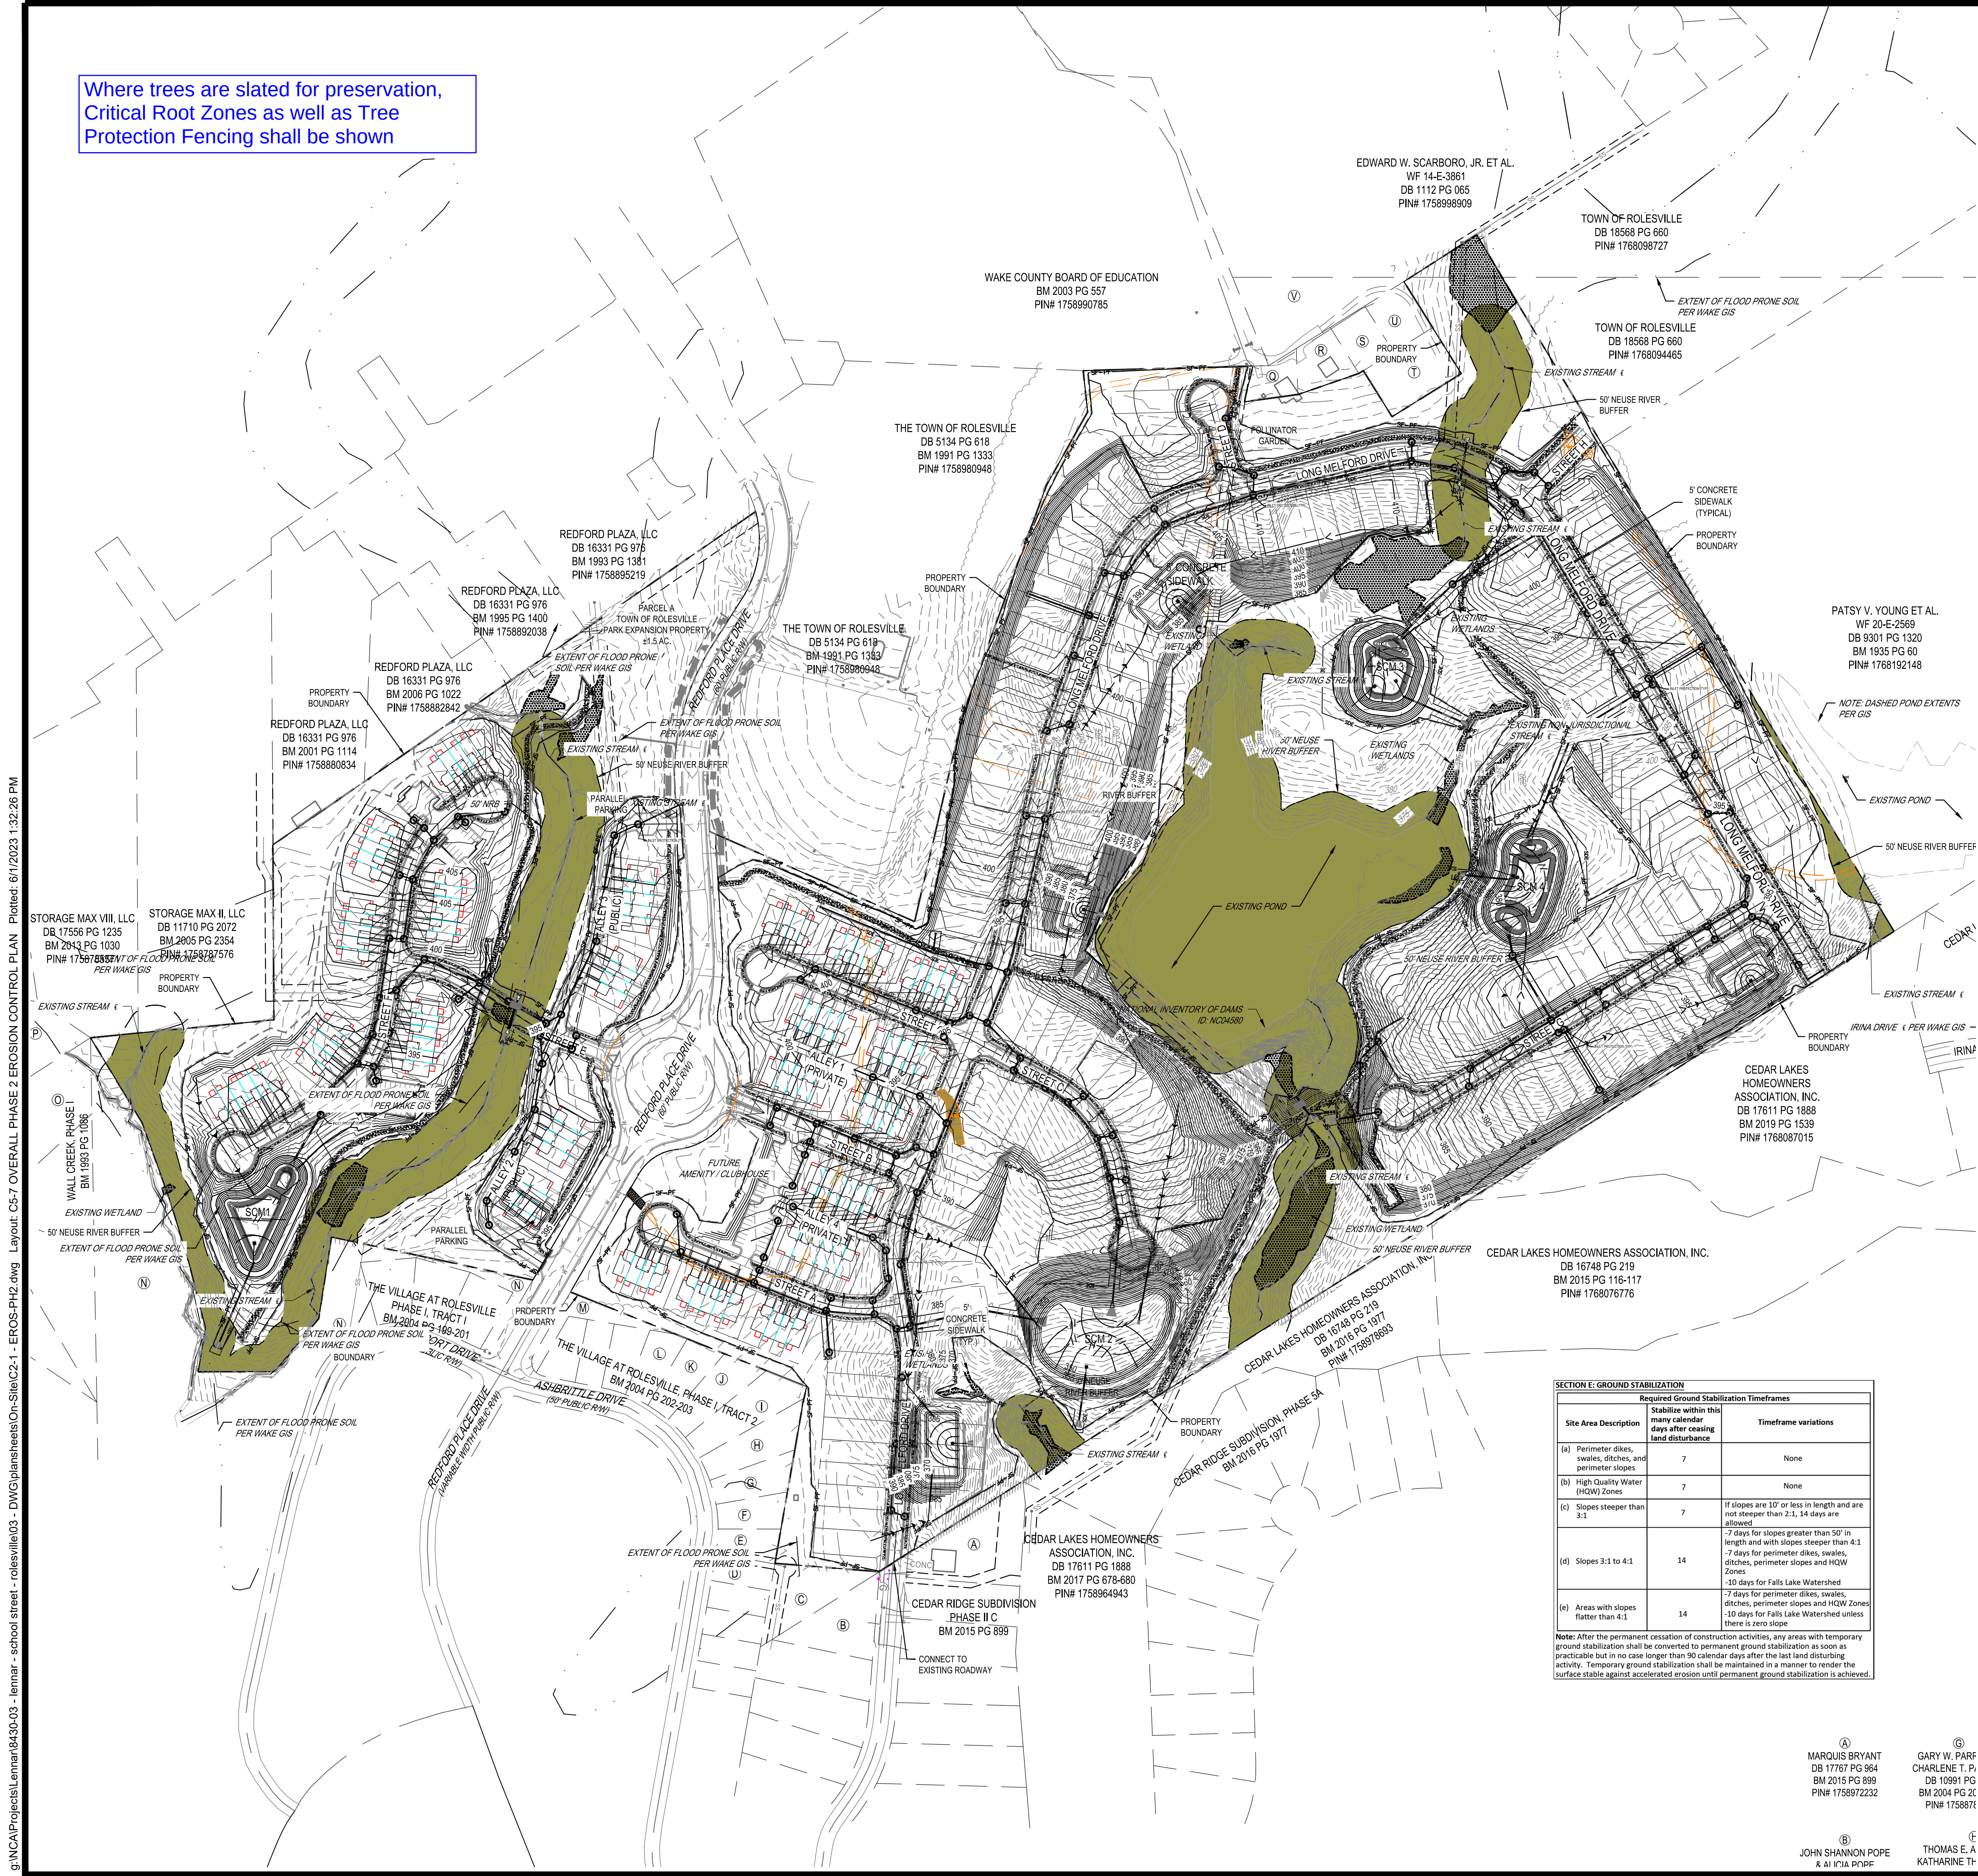

EROSION CONTROL LEGEND

	PROPERTY LINE
	EXISTING MAJOR CONTOUR
	EXISTING MINOR CONTOUR
	PROPOSED MAJOR CONTOUR
	PROPOSED MINOR CONTOUR
	DRAINAGE AREA
	DRAINAGE AREA LABEL
	SOIL TYPE
	DIRECTION OF OVERLAND FLOW
	RIP RAP APRON
	CONSTRUCTION EXIT
	EROSION CONTROL MATTING (NAG S150)
	LIMITS OF DISTURBANCE
	TEMPORARY JUTE NETTING BAFFLES (700 G/M2 COIR FABRIC OR HEAVIER)
	TEMPORARY DIVERSION DITCH OR BERM
	TEMP SILT FENCE WITH OUTLET
	TEMP TREE PROTECTION FENCE
	TEMP SILT / TREE PROTECTION FENCE
	TEMP CONSTRUCTION FENCE
	TEMPORARY HIGH HAZARD FENCE
	CHECK DAM
	SEDIMENTATION CHAMBER BERM
	SLOPE DRAIN WITH RIP-RAP APRON
	TEMPORARY RISER SKIMMER SEDIMENT BASIN
	STONE FILTER RING
	SILT FENCE INLET SEDIMENT TRAP
	EXCAVATED INLET SEDIMENT TRAP
	BLOCK INLET SEDIMENT FILTER

GENERAL EROSION CONTROL CONSTRUCTION SEQUENCE

THE FOLLOWING CONSTRUCTION SEQUENCE IS FURNISHED AS A GENERAL GUIDE FOR PREPARATION OF A SEQUENCE OF CONSTRUCTION EVENTS. ADDITIONS, DELETIONS, AND MODIFICATIONS SHOULD BE MADE AS APPROPRIATE.

- PHASE 1:
- OBTAIN GRADING/ EROSION CONTROL PLAN APPROVAL FROM THE CITY OF CHARLOTTE ENGINEERING DEPARTMENT.
 - THE CONTRACTOR SHALL SET UP AN ON-SITE PRE-CONSTRUCTION CONFERENCE WITH CITY EROSION CONTROL INSPECTOR TO DISCUSS EROSION CONTROL MEASURES. FAILURE TO SCHEDULE SUCH CONFERENCE 48 HOURS PRIOR TO ANY LAND DISTURBING ACTIVITY IS A VIOLATION AND IS SUBJECT TO FINE.
 - INSTALL SWPPP SIGN AND TEMPORARY CONSTRUCTION ENTRANCE.
 - CONTRACTOR TO INSTALL CONSTRUCTION ENTRANCE, SILT FENCE AND INLET PROTECTION AS SHOWN ON PLANS, CLEARING ONLY AS NECESSARY TO INSTALL THESE DEVICES.
 - SCHEDULE AN ON-SITE INSPECTION BY CITY INSPECTOR. WHEN APPROVED, INSPECTOR ISSUES THE GRADING PERMIT AND CLEARING AND GRUBBING MAY BEGIN.
 - THE CONTRACTOR SHALL DILIGENTLY AND CONTINUOUSLY MAINTAIN ALL EROSION CONTROL DEVICES AND STRUCTURES.
- PHASE 2:
- BEGIN EARTHWORK/GRADING ACTIVITIES. MAINTAIN AND VERTICALLY ADJUST ALL INLET PROTECTION DEVICES, DITCHES, AND SILT FENCE THROUGHOUT GRADING ACTIVITIES TO MAINTAIN DRAINAGE PATTERNS. CONTRACTOR TO ENSURE ALL EROSION CONTROL MEASURES DO NOT ADVERSELY AFFECT CONSTRUCTABILITY OF PROJECT.
 - AS EARTHWORK ALLOWS, BEGIN INSTALLING STORM DRAINAGE STRUCTURES AND UTILITIES. AS STORM DRAINAGE IS INSTALLED, CONTRACTOR SHALL PLACE INLET PROTECTION ON ALL STORM STRUCTURES. NO PIPES SHALL BE LEFT EXPOSED AT THE CLOSE OF BUSINESS EACH DAY.
 - DILIGENTLY AND CONTINUOUSLY MAINTAIN ALL EROSION CONTROL DEVICES AND STRUCTURES TO MINIMIZE EROSION. THE CONTRACTOR SHALL MAINTAIN CLOSE CONTACT WITH THE CITY INSPECTOR SO THAT PERIODIC INSPECTIONS CAN BE PERFORMED AT APPROPRIATE STAGES OF CONSTRUCTION.
 - GRADED SLOPES AND FILLS ARE TO BE PLANTED OR PROVIDED WITH PROTECTIVE COVER SUFFICIENT TO RESTRAIN EROSION WITHIN 7 CALENDAR DAYS AFTER THE COMPLETION OF ANY PHASE OF GRADING. ALL AREAS UPON WHICH NO FURTHER LAND DISTURBING ACTIVITY WILL BE UNDERTAKEN ARE TO BE PLANTED OR PROVIDED WITH PROTECTIVE COVER WITHIN 14 CALENDAR DAYS.
 - ALL EROSION CONTROL MEASURES SHALL BE CONSTRUCTED IN ACCORDANCE WITH THE N.C. EROSION AND SEDIMENT CONTROL PLANNING AND DESIGN MANUAL, U.S. DEPT. OF AGRICULTURE, CITY OF CHARLOTTE EROSION CONTROL ORDINANCE, AND THE CHARLOTTE LAND DEVELOPMENT STANDARDS MANUAL.
 - AS AREAS ARE BROUGHT TO FINISHED GRADE, CONTRACTOR TO INSTALL FINAL GRASSING AND STABILIZE ALL SLOPES PER THE EROSION CONTROL NOTES AND DETAILS AND LANDSCAPE PLAN AND DETAILS.
 - CONTRACTOR SHALL COORDINATE WITH THE EROSION CONTROL INSPECTOR PRIOR TO REMOVAL OF EROSION CONTROL MEASURES.

TOTAL DISTURBED AREA
±59.6 ACRES



0 75' 150' 300'
SCALE: 1" = 150'

(A) MARQUIS BRYANT
DB 17787 PG 964
BM 2015 PG 889
PIN# 175897232

(G) GARY W. PARF
CHARLENE T. P.
DB 10991 PG
BM 2004 PG 22
PIN# 1758876

(B) JOHN SHANNON POPE
& ALICIA POPE

(E) THOMAS E. A
KATHARINE TH

SECTION E: GROUND STABILIZATION		
Site Area Description	Required Ground Stabilization Timeframes	
	Stabilize within this many calendar days after ceasing land disturbance	Timeframe variations
(a) Perimeter dikes, swales, ditches, and perimeter slopes.	7	None
(b) High Quality Water (HQW) Zones	7	None
(c) Slopes steeper than 3:1	7	If slopes are 10' or less in length and are not steeper than 2:1, 14 days are allowed - 7 days for slopes greater than 50' in length and with slopes steeper than 4:1 - 7 days for perimeter dikes, swales, ditches, perimeter slopes and HQW Zones - 10 days for Falls Lake Watershed - 7 days for perimeter dikes, swales, ditches, perimeter slopes and HQW Zones - 10 days for Falls Lake Watershed unless there is zero slope
(d) Slopes 3:1 to 4:1	14	
(e) Areas with slopes flatter than 4:1	14	

Note: After the permanent cessation of construction activities, any areas with temporary ground stabilization shall be converted to permanent ground stabilization as soon as practicable but in no case longer than 90 calendar days after the last land disturbing activity. Temporary ground stabilization shall be maintained in a manner to render the surface stable against accelerated erosion until permanent ground stabilization is achieved.

DESIGNED BY: DF/CD
DRAWN BY: DF/JWM
REVIEWED BY: DF

06/01/2023
04/03/2023
REV

PER TOWN OF ROLESVILLE COMMENT
INITIAL SUBMITTAL

BCE

5440 WADE PARK BLVD, SUITE 102
RALEIGH NC 27607
WWW.BCEINC.COM
NC LICENSE #C-4397

LENNAR
CORPORAION

1100 PERIMETER PARK DRIVE, SUITE 112
MORRISVILLE / NORTH CAROLINA / 27560

OVERALL PHASE 2 EROSION
CONTROL PLAN

82 SCHOOL STREET
ROLESVILLE / NORTH CAROLINA / 27571

PRELIMINARY

ENGINEER
FEDERA M. FERRIS

NOT FOR
CONSTRUCTION

FILE NUMBER:
8430-03


DATE: 06/01/2023

C5-7

g:\NCAP\Projects\Lennar\8430-03 - DWG\plansheets\On-Site\C2-1 - EROS-PH2.dwg Layout: C5-8 ENLARGED PHASE 2 EROSION CONTROL PLAN (1 OF 6) Plotted: 6/12/2023 1:32:42 PM




ROLESVILLE
2'G 618
1'G 1333
980948

BM 2003 PG 567
PIN# 175890785

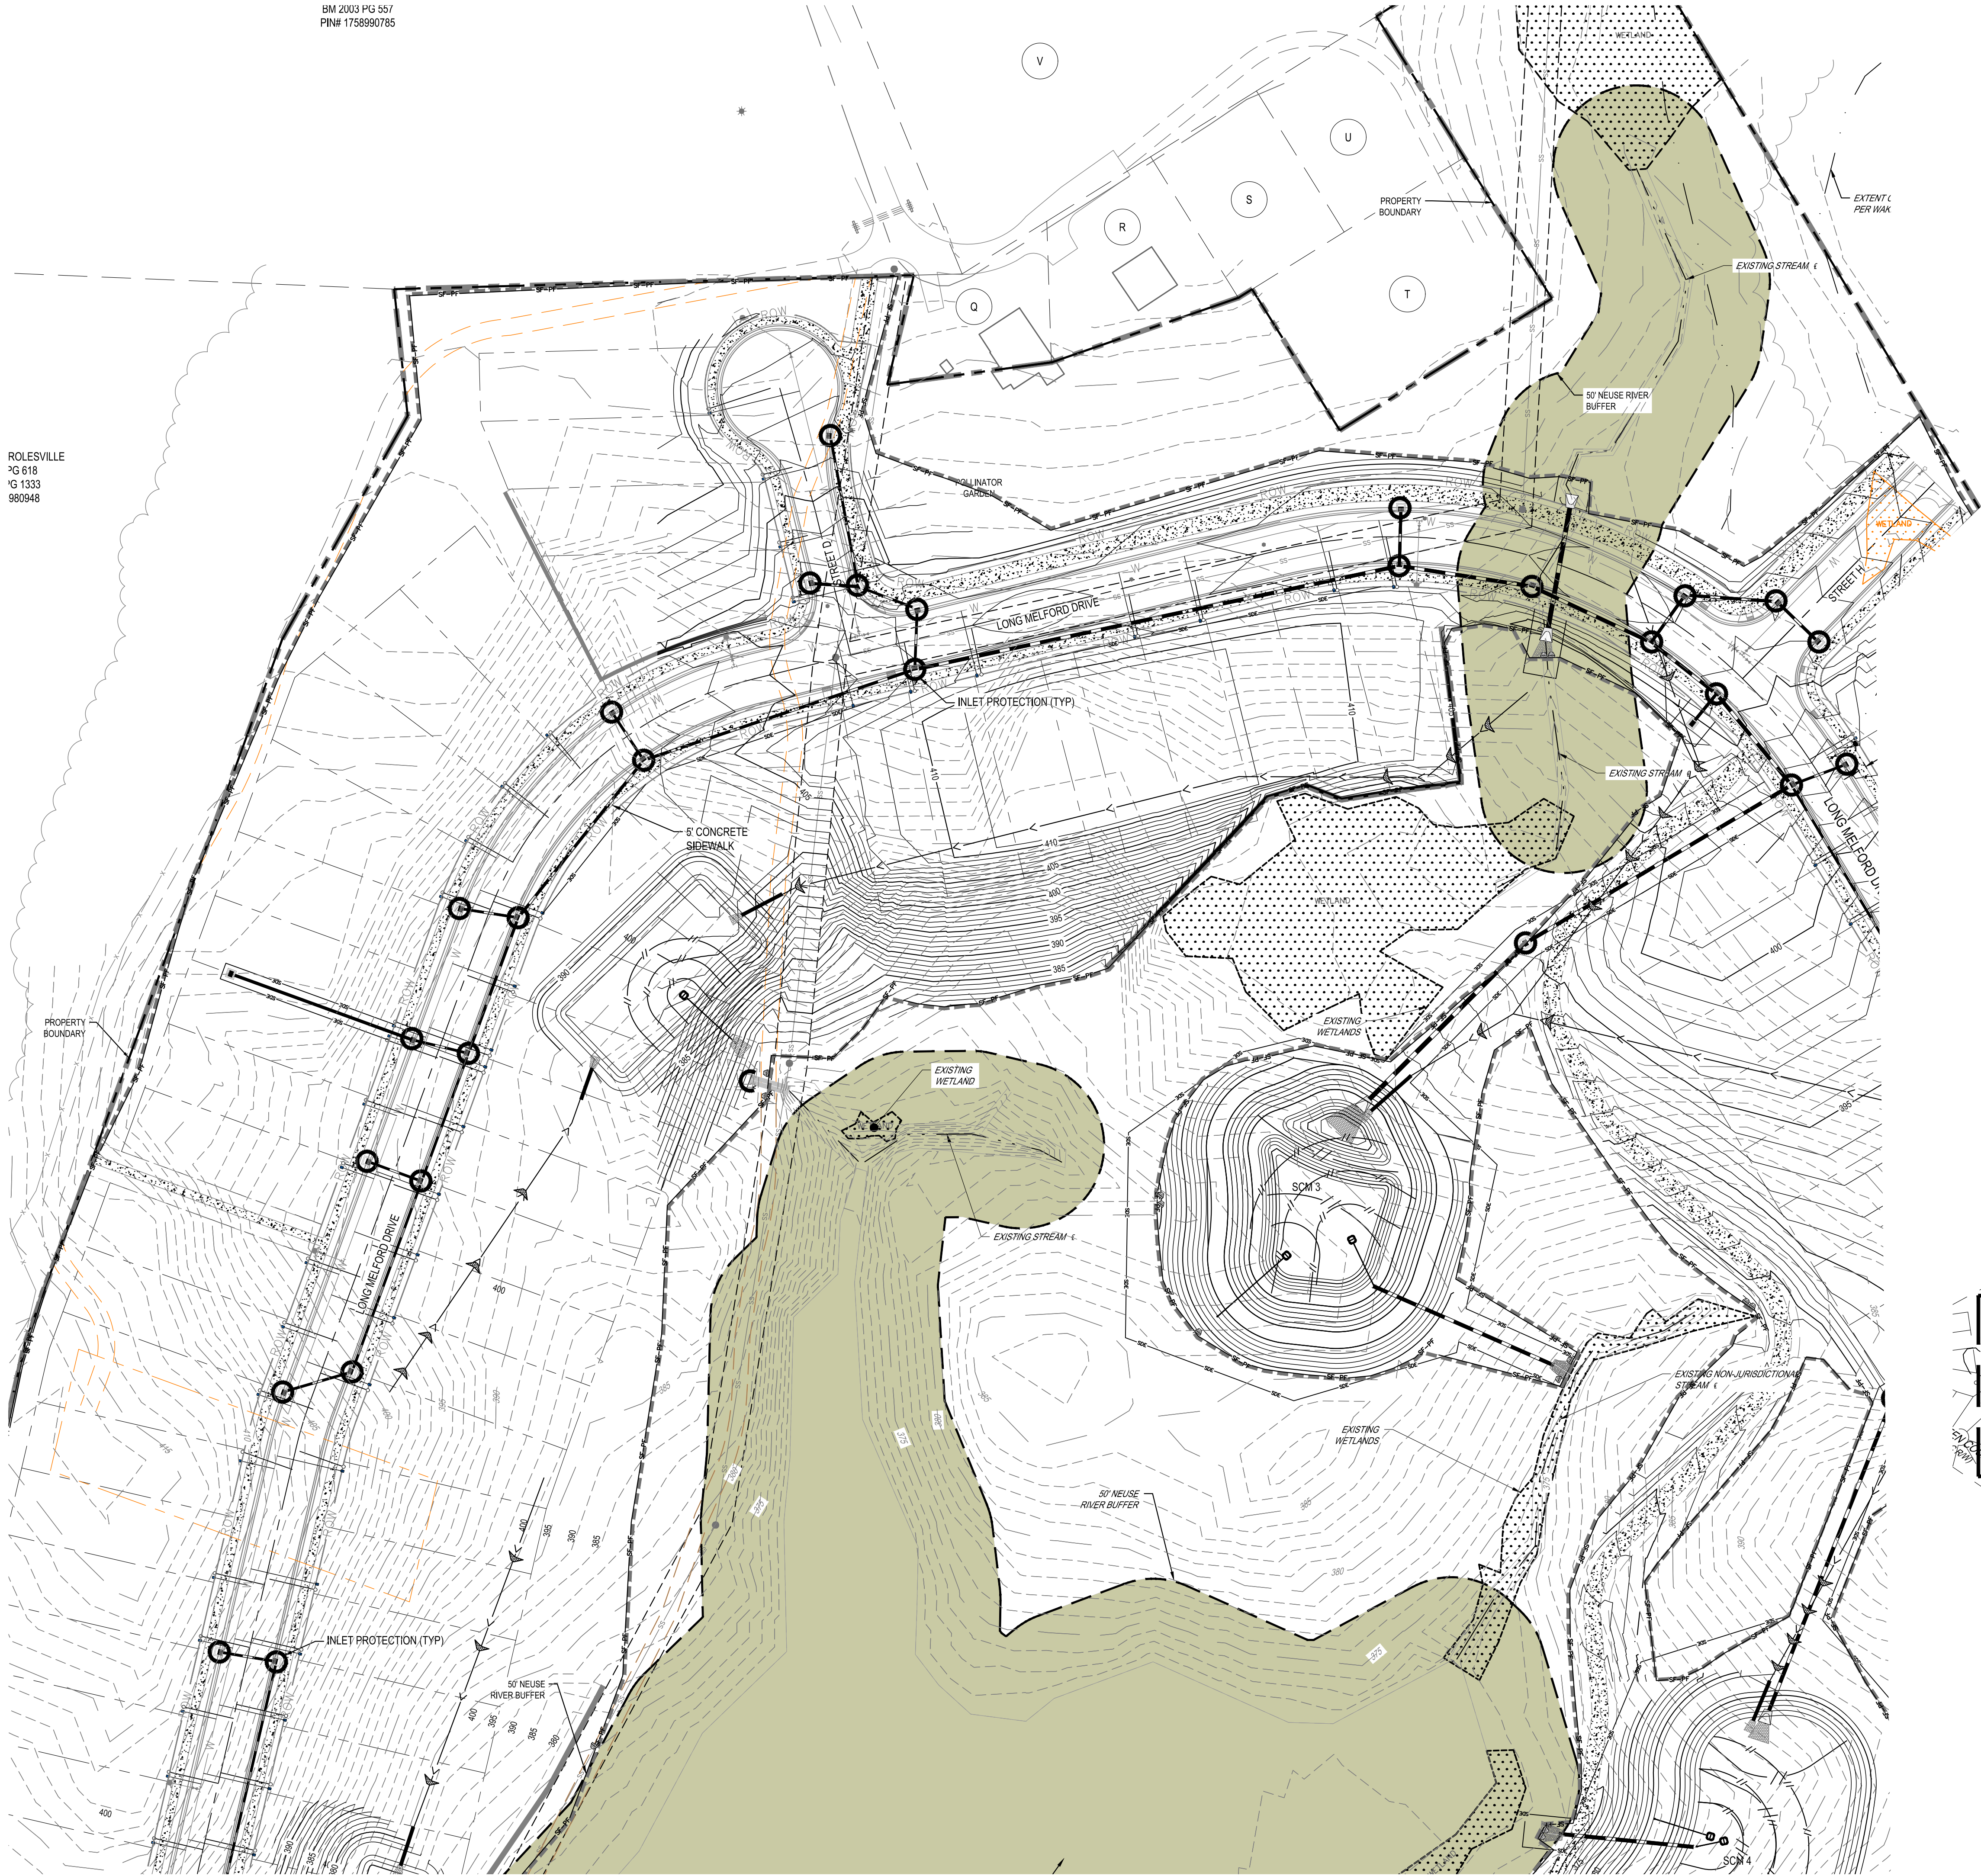

SECTION E: GROUND STABILIZATION		
Site Area Description	Required Ground Stabilization Timeframes	
	Stabilize within this many calendar days after ceasing land disturbance	Timeframe variations
(a) Perimeter dikes, swales, ditches, and perimeter slopes	7	None
(b) High Quality Water (HQP) Zones	7	None
(c) Slopes steeper than 3:1	7	If slopes are 10' or less in length and are not steeper than 2:1, 14 days are allowed -7 days for slopes greater than 50' in length and with slopes steeper than 4:1 -7 days for perimeter dikes, swales, ditches, perimeter slopes and HQW Zones -10 days for Falls Lake Watershed
(d) Slopes 3:1 to 4:1	14	-7 days for perimeter dikes, swales, ditches, perimeter slopes and HQW Zones -10 days for Falls Lake Watershed unless there is zero slope
(e) Areas with slopes flatter than 4:1	14	-7 days for perimeter dikes, swales, ditches, perimeter slopes and HQW Zones -10 days for Falls Lake Watershed unless there is zero slope

Note: After the permanent cessation of construction activities, any areas with temporary ground stabilization shall be converted to permanent ground stabilization as soon as practicable but in no case longer than 90 calendar days after the last land disturbing activity. Temporary ground stabilization shall be maintained in a manner to render the surface stable against accelerated erosion until permanent ground stabilization is achieved.

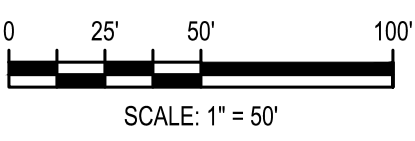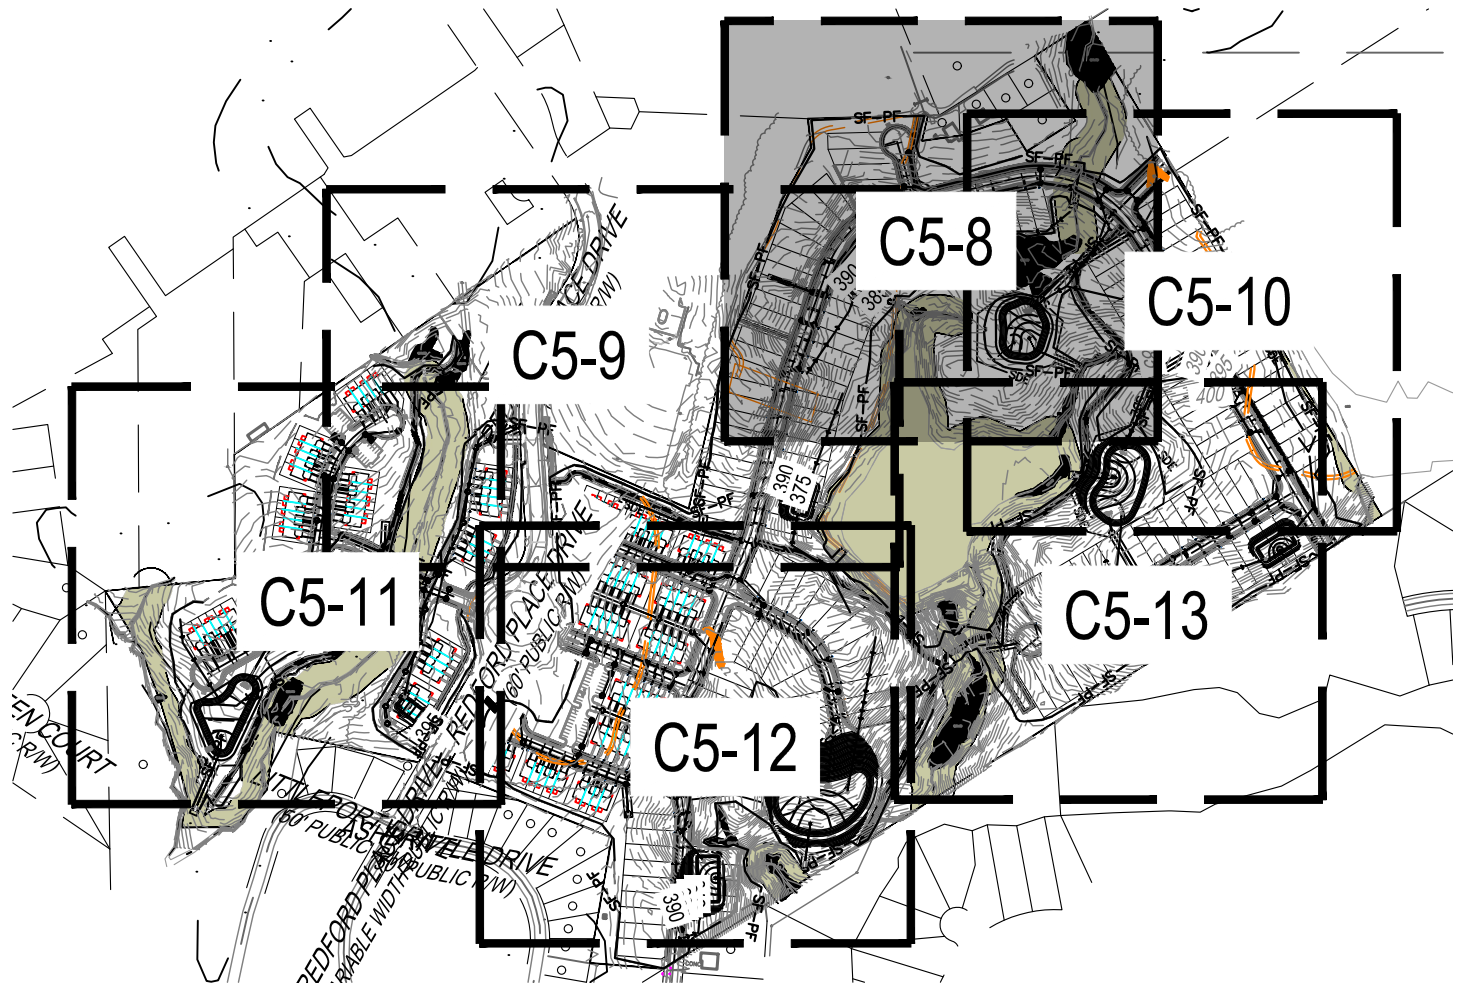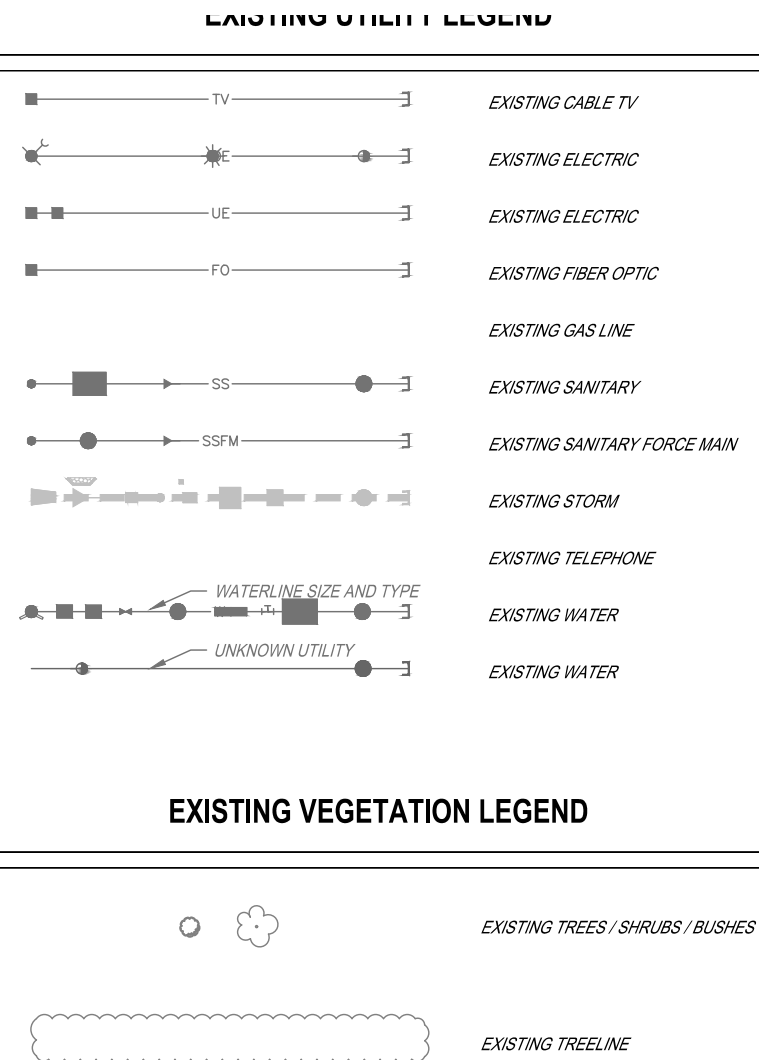

Know what's below.
Call before you dig.

DESIGNED BY: DF/CD
DRAWN BY: DF/JWM
REVIEWED BY: DF

LENNA
CORPORAION

5440 WADE PARK BLVD, SUITE 102
RALEIGH NC 27607
WWW.BGEINC.COM
NC LICENSE #C-4397

PARKER RIDGE

82 SCHOOL STREET
ROLESVILLE / NORTH CAROLINA / 27571

ENLARGED PHASE 2
EROSION CONTROL
PLAN (1 OF 6)

PRELIMINARY


ENGINEER
PEDRA M. FERRER
NOT FOR
CONSTRUCTION

FILE NUMBER:
8430-03
DATE: 06/01/2023

C5-8


06/01/2023
REV 04/03/2023
PER TOWN OF ROLESVILLE COMMENT
INITIAL SUBMITTAL

g:\NCAP\Projects\Lennar\8430-03 - Dwg\plansheets\On-Site\c2-1 - EROS-PH2.dwg Layout: C5-9 ENLARGED PHASE 2 EROSION CONTROL PLAN (2 OF 6) Plotted: 6/12/2023 1:32:58 PM

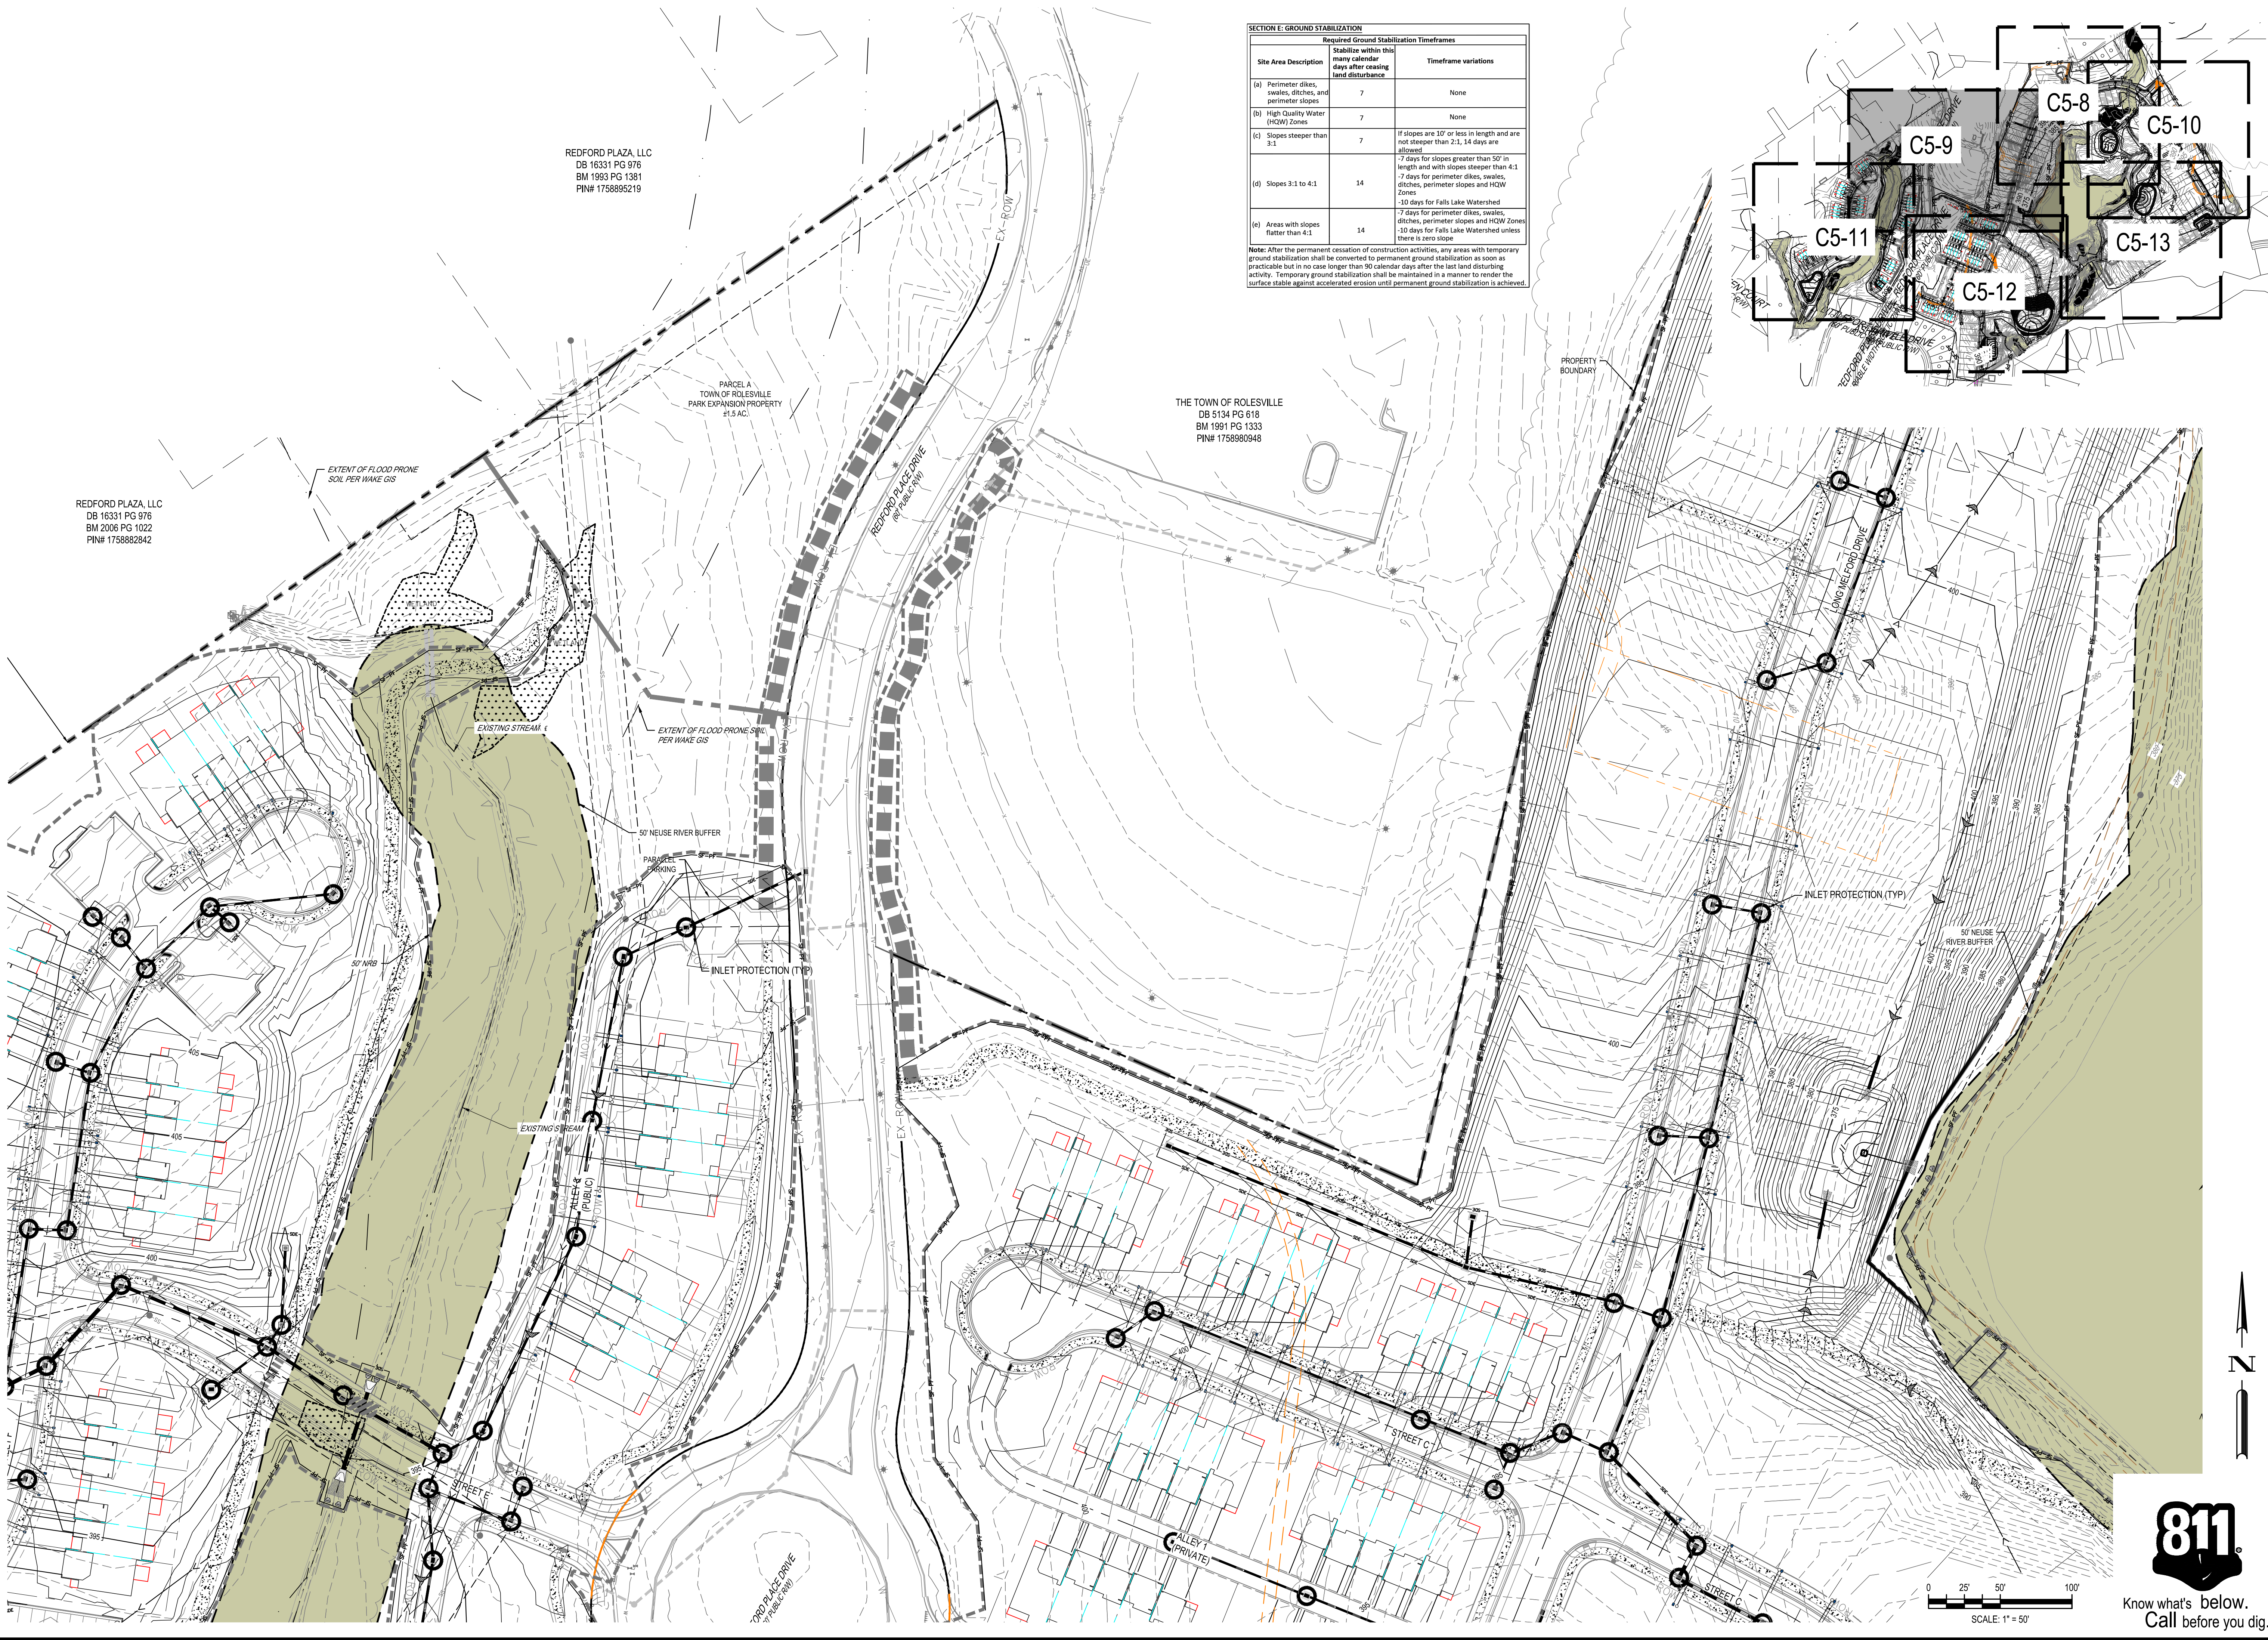

SECTION E: GROUND STABILIZATION		
Site Area Description	Required Ground Stabilization Timeframes	
	Stabilize within this many calendar days after ceasing land disturbance	Timeframe variations
(a) Perimeter dikes, swales, ditches, and perimeter slopes	7	None
(b) High Quality Water (H2O) Zones	7	None
(c) Slopes steeper than 3:1	7	If slopes are 10' or less in length and are not steeper than 2:1, 14 days are allowed -7 days for slopes greater than 50' in length and with slopes steeper than 4:1 -7 days for perimeter dikes, swales, ditches, perimeter slopes and H2O Zones -10 days for Falls Lake Watershed
(d) Slopes 3:1 to 4:1	14	-7 days for perimeter dikes, swales, ditches, perimeter slopes and H2O Zones -10 days for Falls Lake Watershed unless there is zero slope
(e) Areas with slopes flatter than 4:1	14	-7 days for perimeter dikes, swales, ditches, perimeter slopes and H2O Zones -10 days for Falls Lake Watershed unless there is zero slope

Note: After the permanent cessation of construction activities, any areas with temporary ground stabilization shall be converted to permanent ground stabilization as soon as practicable but in no case longer than 90 calendar days after the last land disturbing activity. Temporary ground stabilization shall be maintained in a manner to render the surface stable against accelerated erosion until permanent ground stabilization is achieved.

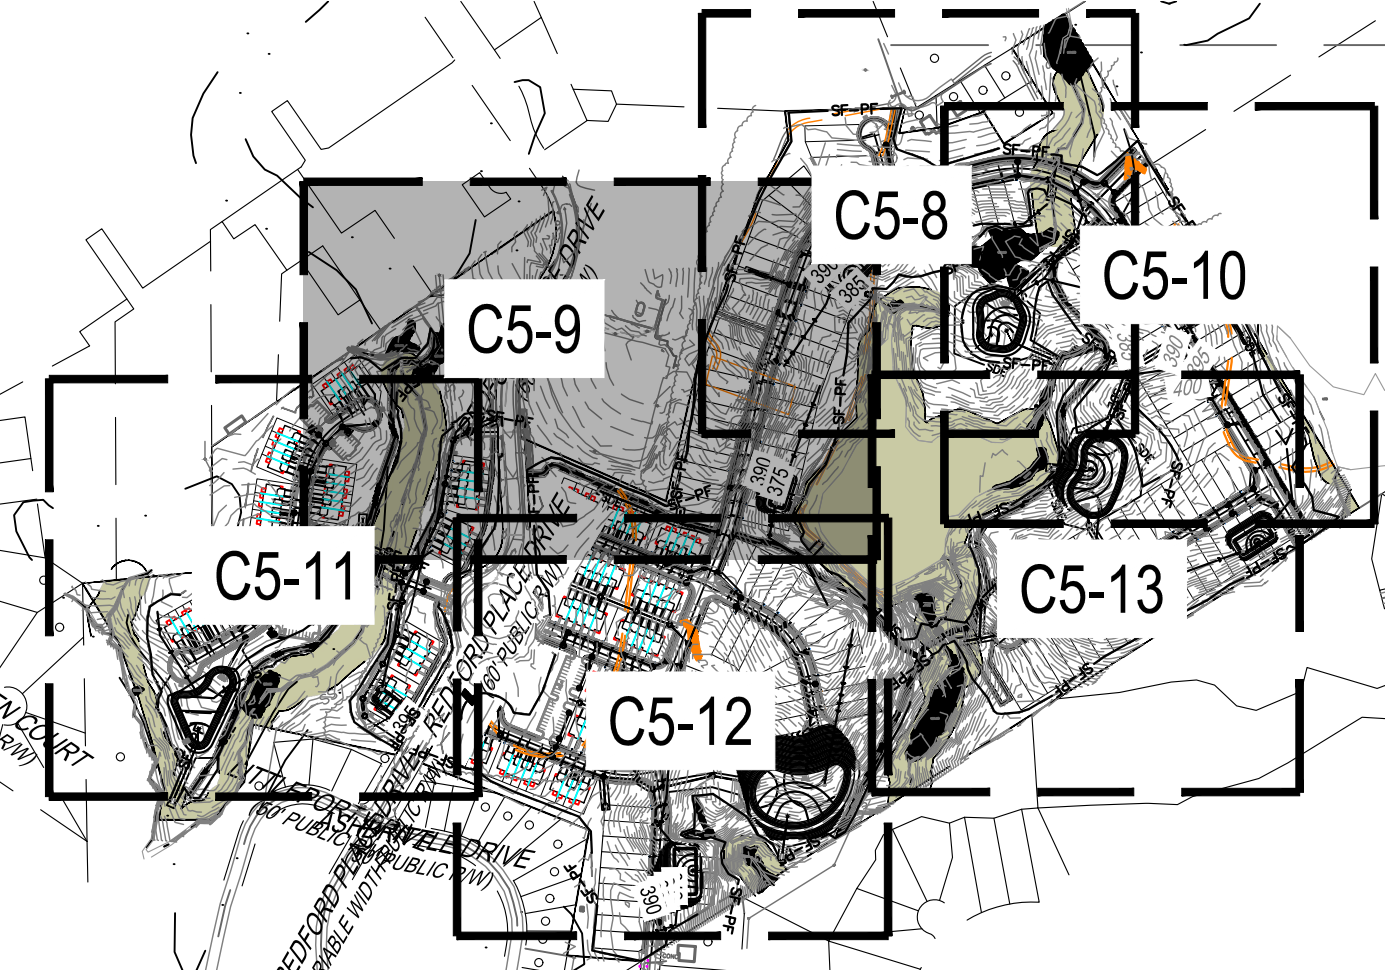

REDFORD PLAZA, LLC
DB 16331 PG 976
BM 2006 PG 1022
PIN# 175882842

REDFORD PLAZA, LLC
DB 16331 PG 976
BM 1993 PG 1381
PIN# 1758895219

PARCEL A
TOWN OF ROLESVILLE
PARK EXPANSION PROPERTY
±1.5 AC.

THE TOWN OF ROLESVILLE
DB 5134 PG 618
BM 1991 PG 1333
PIN# 1758909948

DESIGNED BY: DF/CD

DRAWN BY: DF/JWM

REVIEWED BY: DF

5440 WADE PARK BLVD, SUITE 102

RALEIGH NC 27607

WWW.BCEINC.COM

NC LICENSE #C-4397

LENARR

CORPORAION

1100 PERIMETER PARK DRIVE, SUITE 112

MORRISVILLE / NORTH CAROLINA / 27560

ENLARGED PHASE 2

EROSION CONTROL

PLAN (2 OF 6)

82 SCHOOL STREET

ROLESVILLE / NORTH CAROLINA / 27571

811

Know what's below.

Call before you dig.

PRELIMINARY

NOT FOR CONSTRUCTION

FILE NUMBER: 8430-03

DATE: 06/01/2023

C5-9




g:\NCAP\Projects\Lennar\8430-03 - DWG\plansheets\On-Site\C2.1 - EROS-PHZ.dwg Layout: C5-10 ENLARGED PHASE 2 EROSION CONTROL PLAN (3 OF 6) Plotted: 6/1/2023 1:33:12 PM



PATSY V. YOUNG ET AL.
WF 20-E-2569
DB 9301 PG 1320
BM 1935 PG 60
PIN# 1768192148

SECTION E: GROUND STABILIZATION		
Site Area Description	Required Ground Stabilization Timeframes	
	Stabilize within this many calendar days after ceasing land disturbance	Timeframe variations
(a) Perimeter dikes, swales, ditches, and perimeter slopes	7	None
(b) High Quality Water (HQP) Zones	7	None
(c) Slopes steeper than 3:1	7	If slopes are 10' or less in length and are not steeper than 2:1, 14 days are allowed
(d) Slopes 3:1 to 4:1	14	-7 days for slopes greater than 50' in length and with slopes steeper than 4:1 -7 days for perimeter dikes, swales, ditches, perimeter slopes and HQW Zones -10 days for Falls Lake Watershed
(e) Areas with slopes flatter than 4:1	14	-7 days for perimeter dikes, swales, ditches, perimeter slopes and HQW Zones -10 days for Falls Lake Watershed unless there is zero slope

Note: After the permanent cessation of construction activities, any areas with temporary ground stabilization shall be converted to permanent ground stabilization as soon as practicable but in no case longer than 90 calendar days after the last land disturbing activity. Temporary ground stabilization shall be maintained in a manner to render the surface stable against accelerated erosion until permanent ground stabilization is achieved.

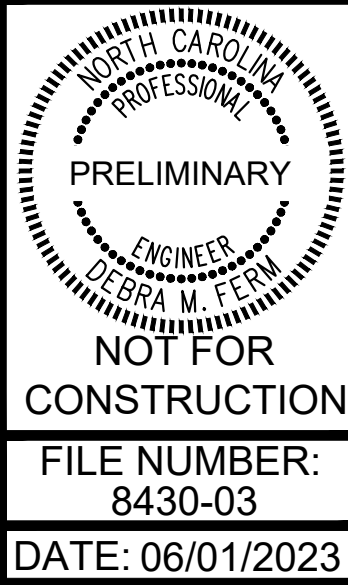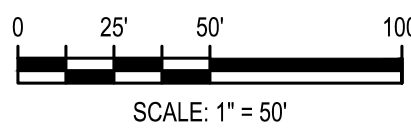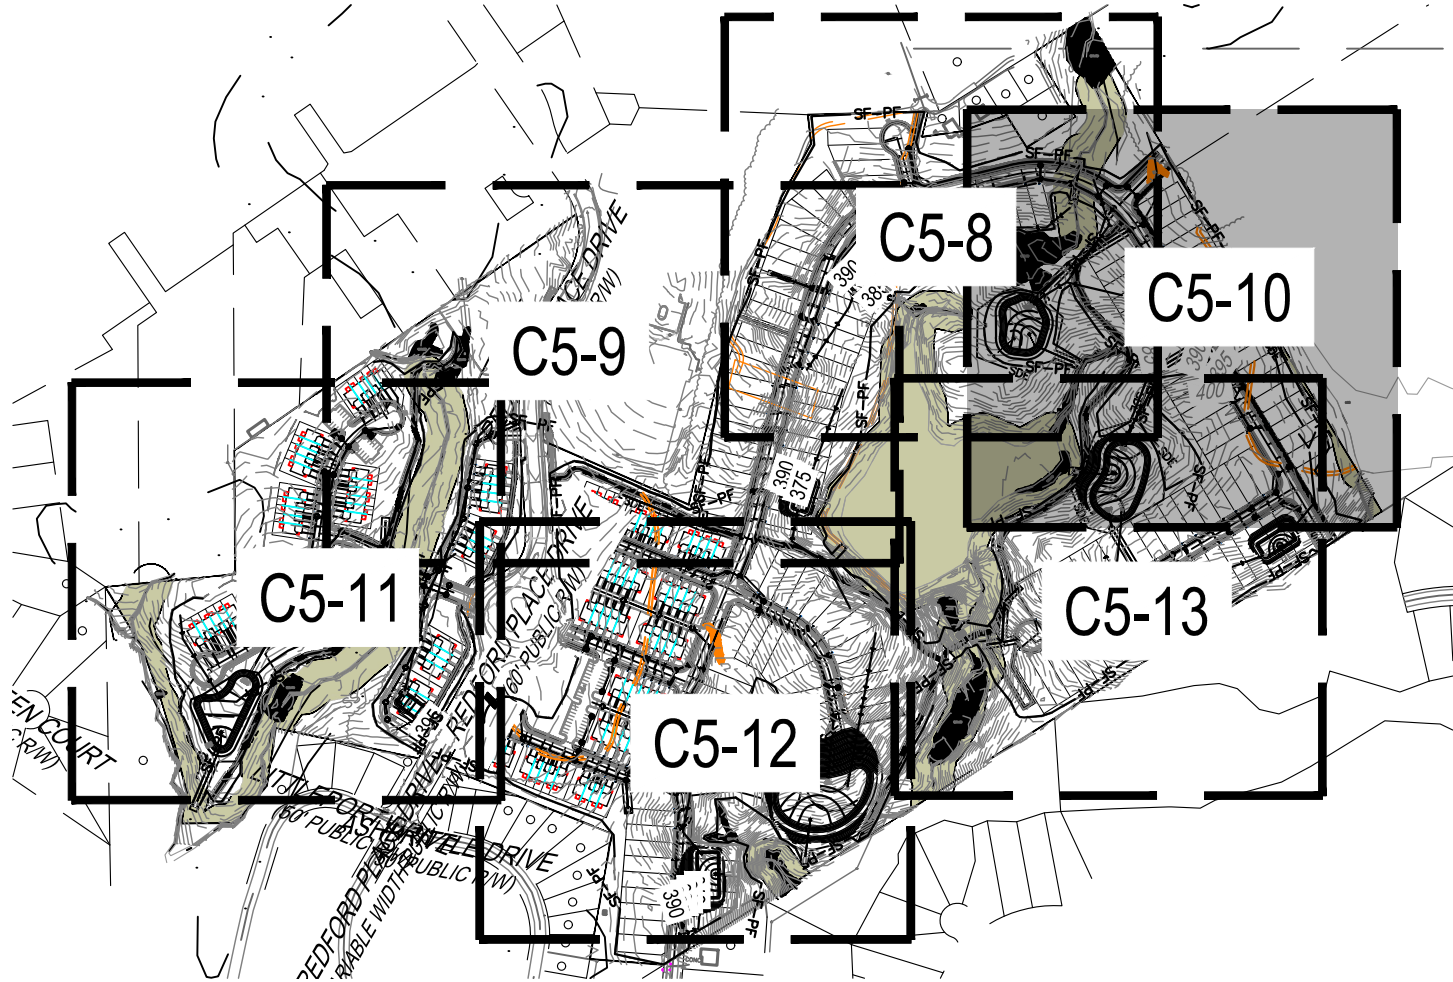

ENLARGED SITE PLAN
(3 OF 7)

PARKER RIDGE
82 SCHOOL STREET
ROLESVILLE / NORTH CAROLINA / 27571

LENNAR
CORPORAION
1100 PERIMETER PARK DRIVE, SUITE 112
MORRISVILLE / NORTH CAROLINA / 27560

BCE
5440 WADE PARK BLVD, SUITE 102
RALEIGH NC 27607
WWW.BCEINC.COM
NC LICENSE #C-4397

DESIGNED BY: DF/CD
DRAWN BY: DF/JWM
REVIEWED BY: DF



REV	04/03/2023	INITIAL SUBMITTAL
06/01/2023	PER TOWN OF ROLESVILLE COMMENT	

g:\NCAP\Projects\Lennar\8430-03 - Lennar - school street - rolesville\03 - DWG\plansheets\On-Site\C2-1 - EROS-PH2.dwg Layout: C5-11 ENLARGED PHASE 2 EROSION CONTROL PLAN (4 OF 6) Plotted: 6/1/2023 1:33:29 PM




SECTION E: GROUND STABILIZATION		
Site Area Description	Required Ground Stabilization Timeframes	
	Stabilize within this many calendar days after ceasing land disturbance	Timeframe variations
(a) Perimeter dikes, swales, ditches, and perimeter slopes	7	None
(b) High Quality Water (HQP) Zones	7	None
(c) Slopes steeper than 3:1	7	If slopes are 10' or less in length and are not steeper than 2:1, 14 days are allowed. -7 days for slopes greater than 50' in length and with slopes steeper than 4:1 -7 days for perimeter dikes, swales, ditches, perimeter slopes and HQW Zones -10 days for Falls Lake Watershed
(d) Slopes 3:1 to 4:1	14	-7 days for perimeter dikes, swales, ditches, perimeter slopes and HQW Zones -10 days for Falls Lake Watershed unless there is zero slope
(e) Areas with slopes flatter than 4:1	14	-7 days for perimeter dikes, swales, ditches, perimeter slopes and HQW Zones -10 days for Falls Lake Watershed unless there is zero slope

Note: After the permanent cessation of construction activities, any areas with temporary ground stabilization shall be converted to permanent ground stabilization as soon as practicable but in no case longer than 90 calendar days after the last land disturbing activity. Temporary ground stabilization shall be maintained in a manner to render the surface stable against accelerated erosion until permanent ground stabilization is achieved.

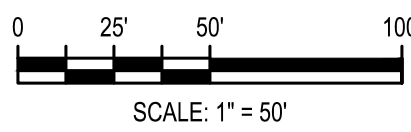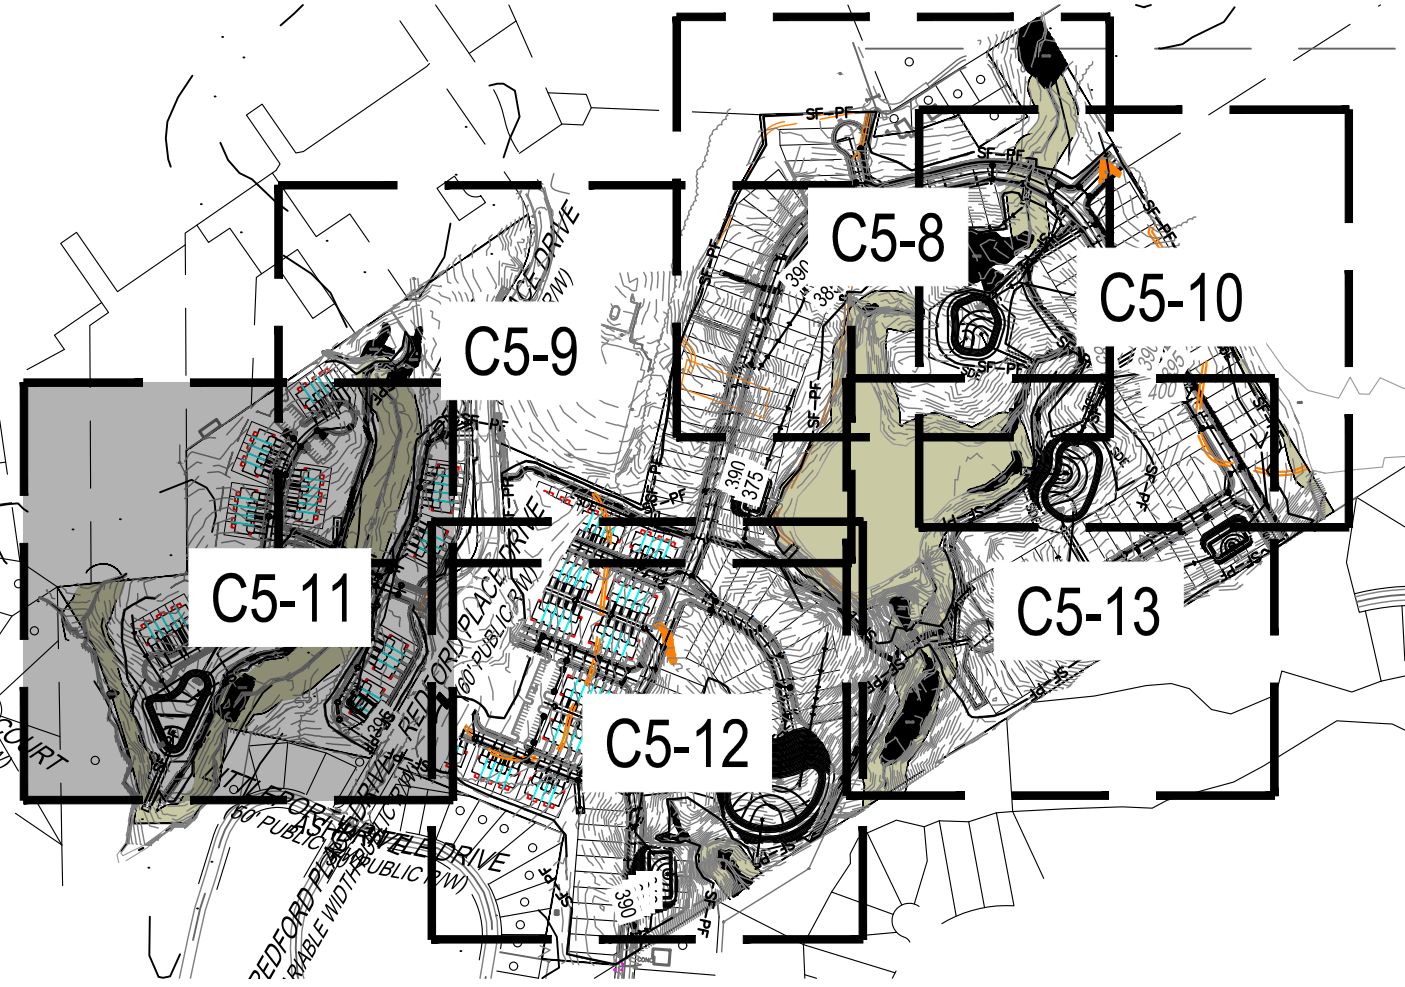

Know what's below.
Call before you dig.

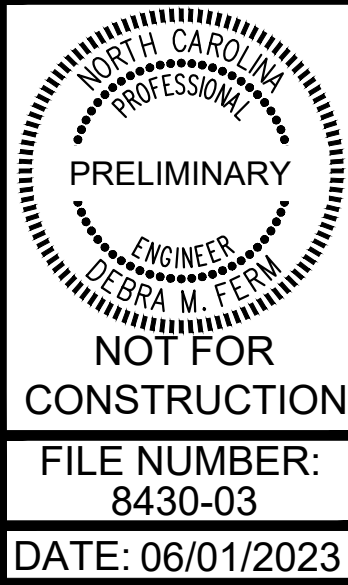

ENLARGED PHASE 2
EROSION CONTROL
PLAN (4 OF 6)

PARKER RIDGE
82 SCHOOL STREET
ROLESVILLE / NORTH CAROLINA / 27571

LENNAR
CORPORAION
1100 PERIMETER PARK DRIVE, SUITE 112
MORRISVILLE / NORTH CAROLINA / 27560


BCE
5440 WADE PARK BLVD, SUITE 102
RALEIGH NC 27607
WWW.BCEINC.COM
NC LICENSE #C-4397

DESIGNED BY: DF/CD
DRAWN BY: DF/JWM
REVIEWED BY: DF

06/01/2023 PER TOWN OF ROLESVILLE COMMENT
04/03/2023 INITIAL SUBMITTAL
REV



C5-11

g:\NCAP\Projects\Lennar\8430-03 - DWG\plansheets\On-Site\C2-1 - EROS-PH2.dwg Layout: C5-12 ENLARGED PHASE 2 EROSION CONTROL PLAN (5 OF 6) Plotted: 6/1/2023 1:33:42 PM

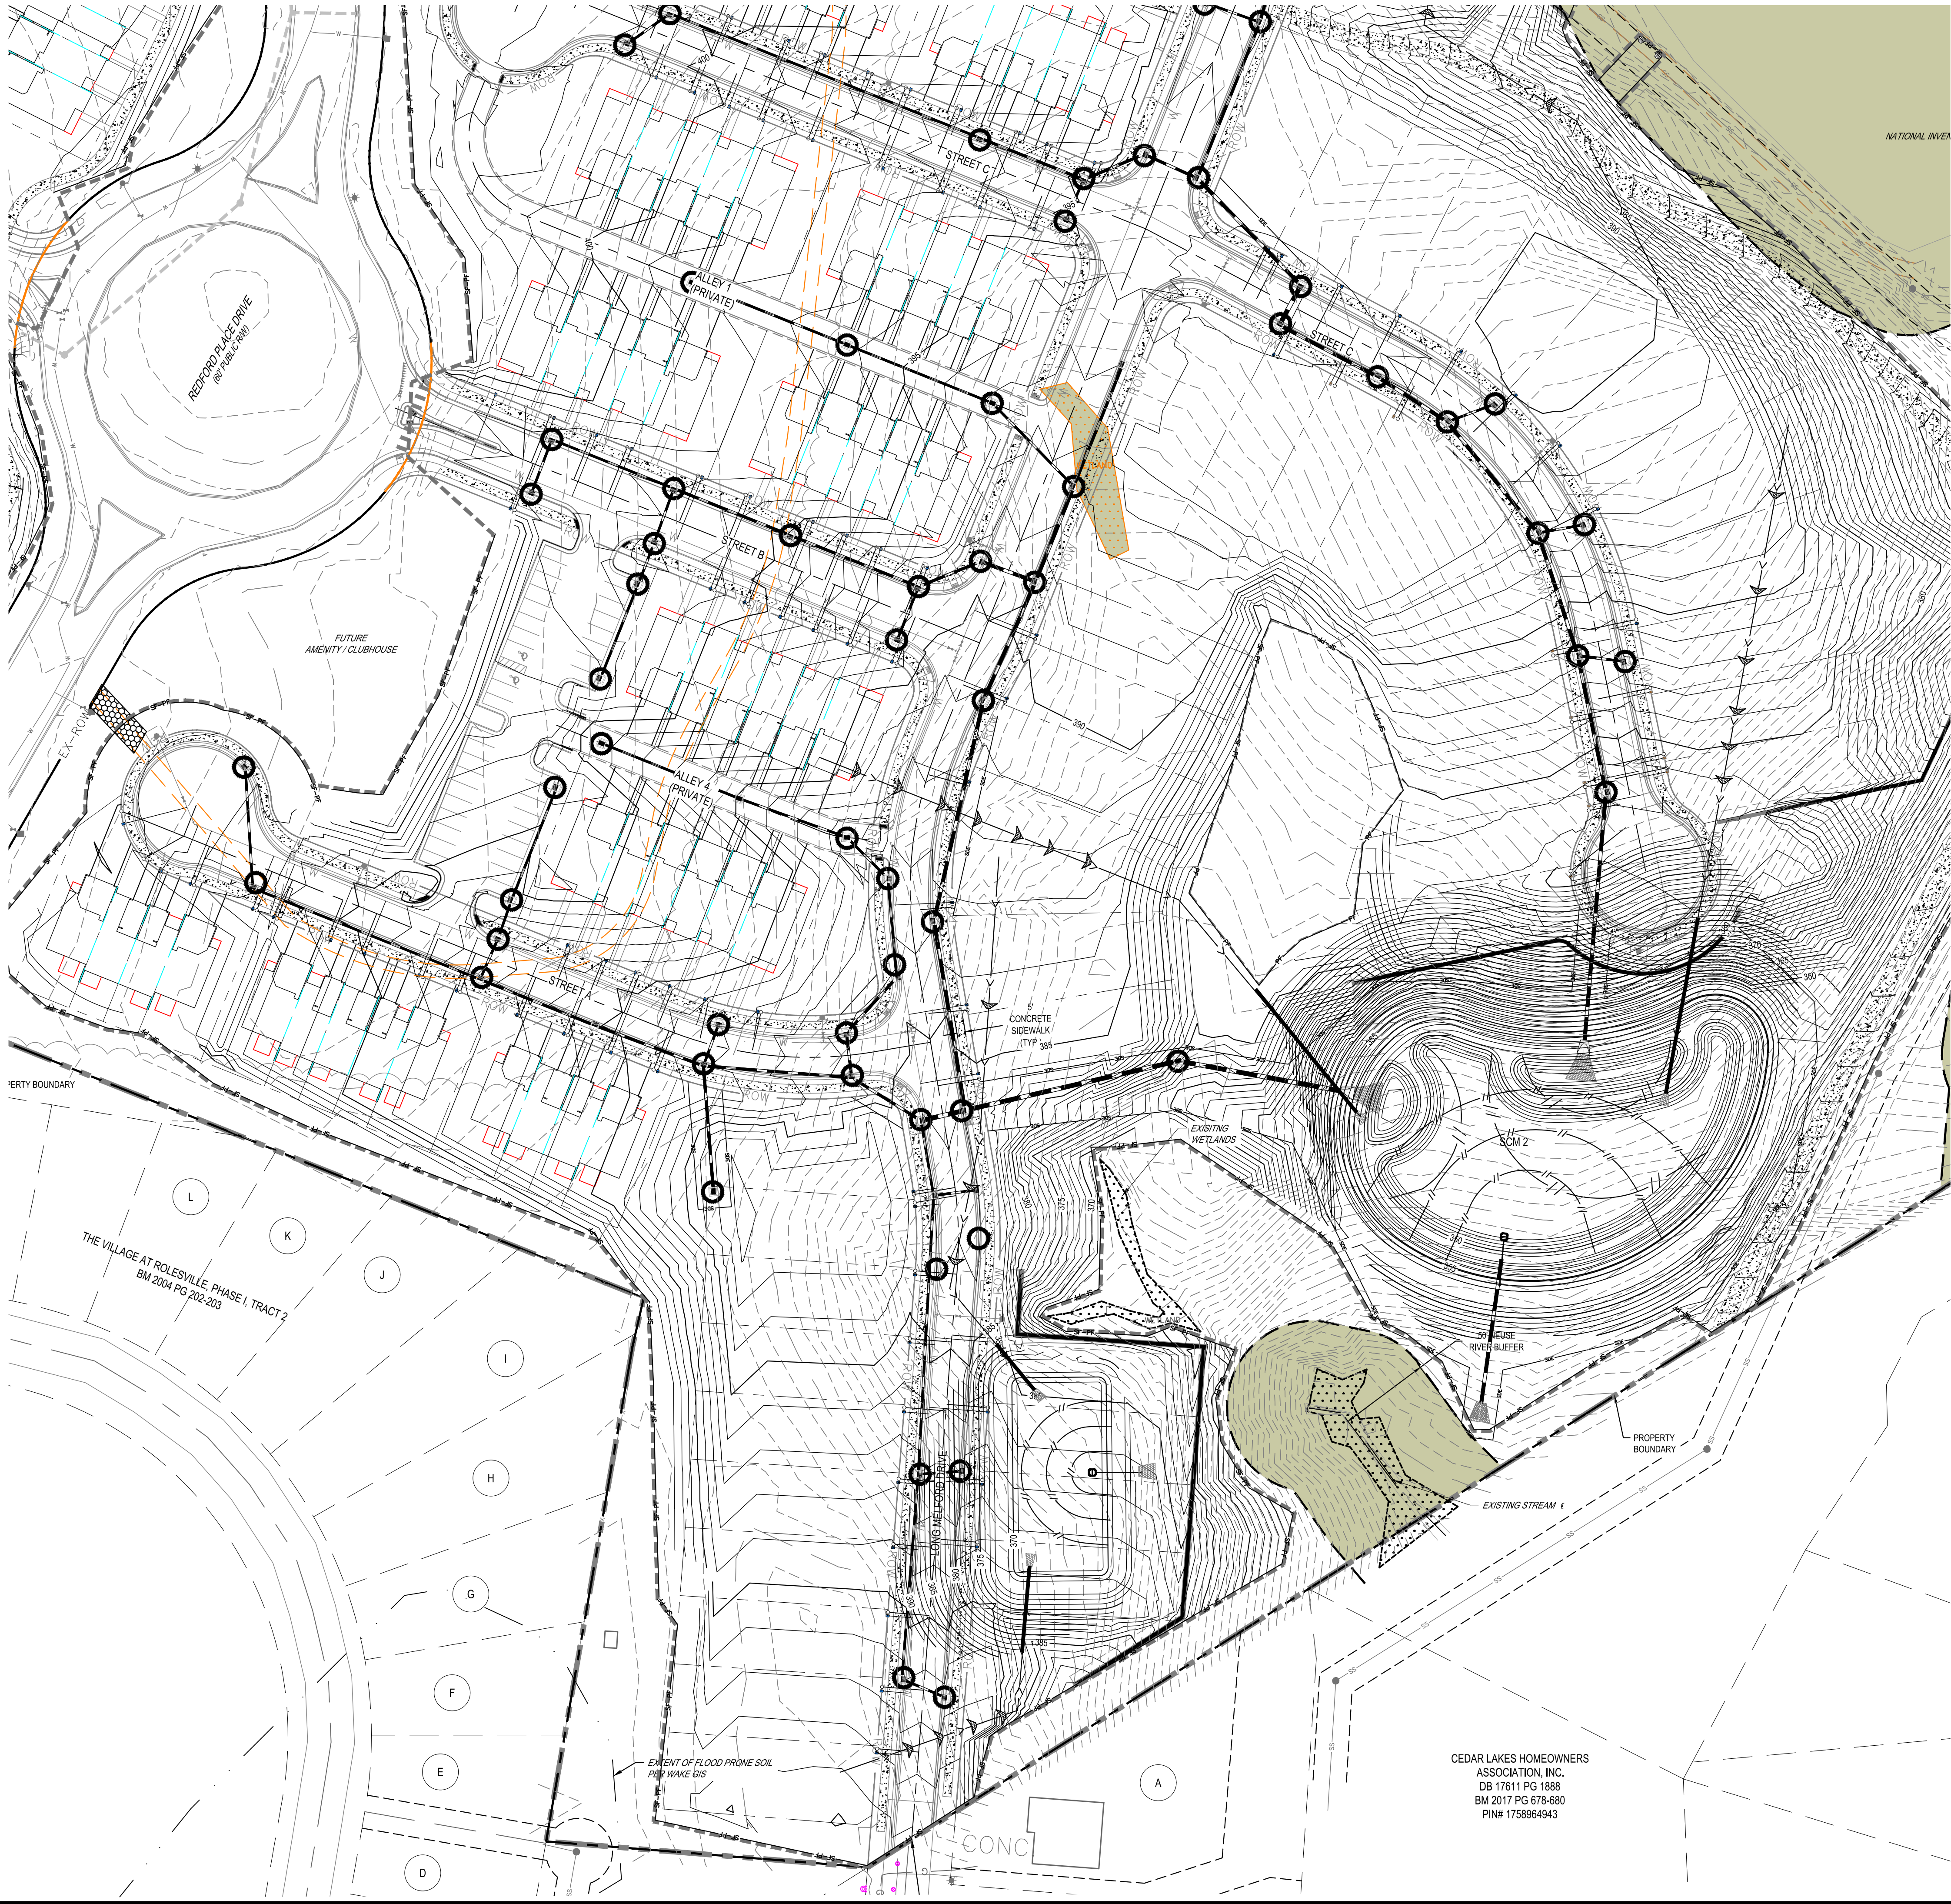

SECTION E: GROUND STABILIZATION		
Site Area Description	Required Ground Stabilization Timeframes	
	Stabilize within this many calendar days after ceasing land disturbance	Timeframe variations
(a) Perimeter dikes, swales, ditches, and perimeter slopes	7	None
(b) High Quality Water (HQW) Zones	7	None
(c) Slopes steeper than 3:1	7	If slopes are 10' or less in length and are not steeper than 2:1, 14 days are allowed
(d) Slopes 3:1 to 4:1	14	-7 days for slopes greater than 50' in length and with slopes steeper than 4:1 -7 days for perimeter dikes, swales, ditches, perimeter slopes and HQW Zones -10 days for Falls Lake Watershed
(e) Areas with slopes flatter than 4:1	14	-7 days for perimeter dikes, swales, ditches, perimeter slopes and HQW Zones -10 days for Falls Lake Watershed unless there is zero slope

Note: After the permanent cessation of construction activities, any areas with temporary ground stabilization shall be converted to permanent ground stabilization as soon as practicable but in no case longer than 90 calendar days after the last land disturbing activity. Temporary ground stabilization shall be maintained in a manner to render the surface stable against accelerated erosion until permanent ground stabilization is achieved.

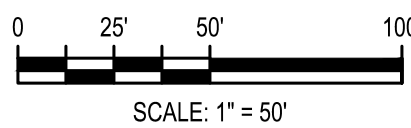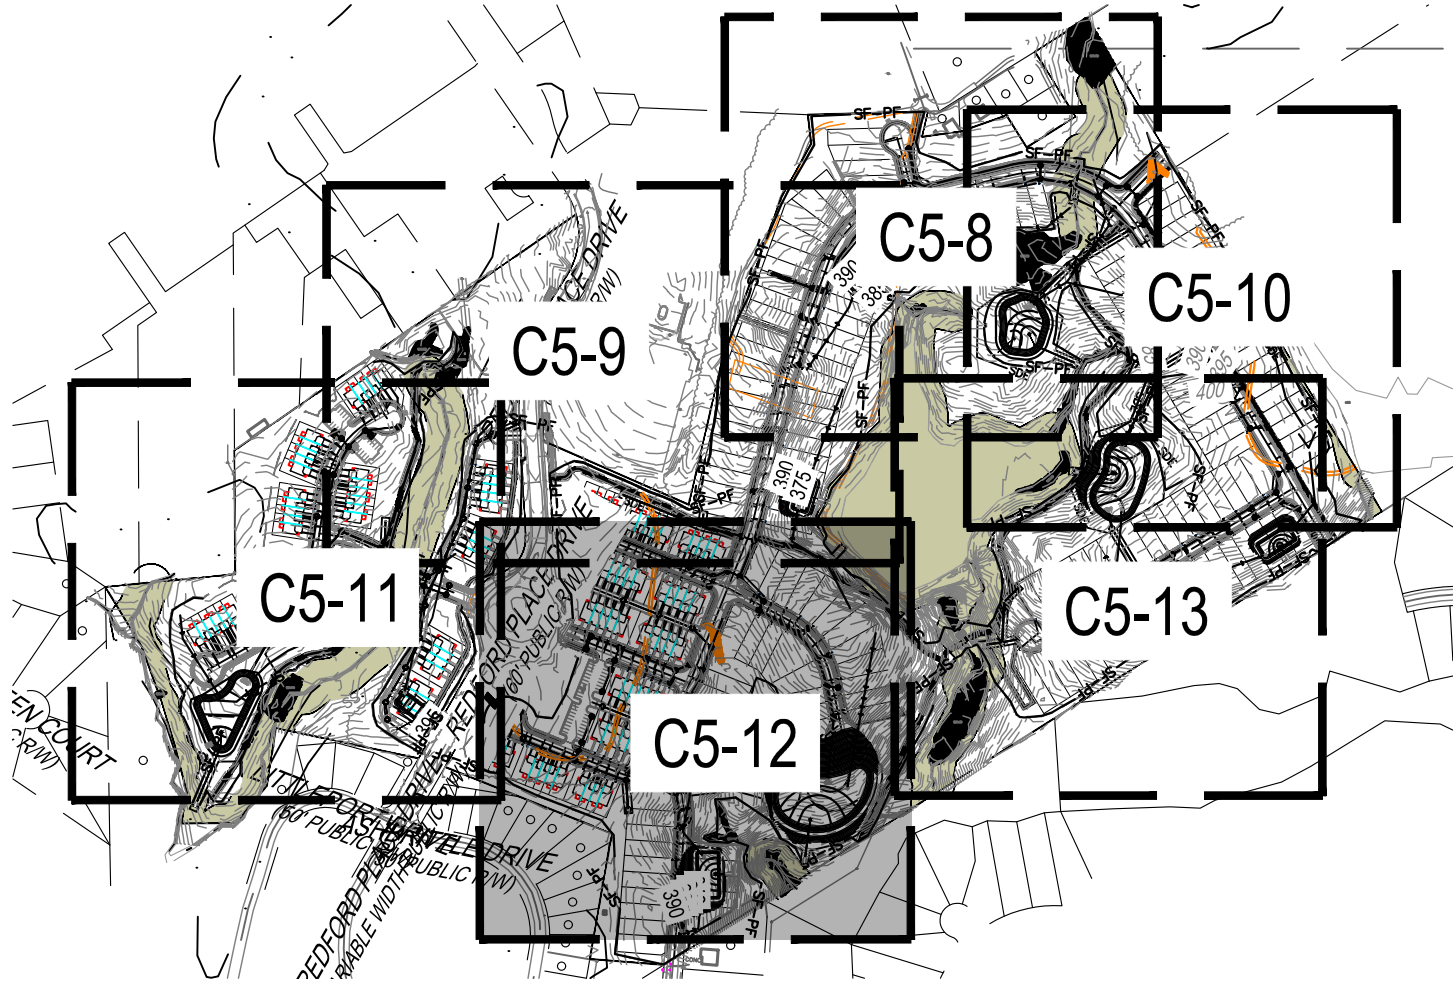

PRELIMINARY

ENGINEER

DEBRA M. FERNANDEZ

NOT FOR CONSTRUCTION

FILE NUMBER:

8430-03

DATE:

06/01/2023

C5-12

PARKER RIDGE
82 SCHOOL STREET
ROLESVILLE / NORTH CAROLINA / 27571

LENNAR
CORPORAION
1100 PERIMETER PARK DRIVE, SUITE 112
MORRISVILLE / NORTH CAROLINA / 27560

BCE

5440 WADE PARK BLVD, SUITE 102
RALEIGH NC 27607
WWW.BCEINC.COM
NC LICENSE #C-4397

DESIGNED BY: DF/CD
DRAWN BY: DF/JWM
REVIEWED BY: DF

REV 04/03/2023 INITIAL SUBMITTAL

06/01/2023 PER TOWN OF ROLESVILLE COMMENT

