
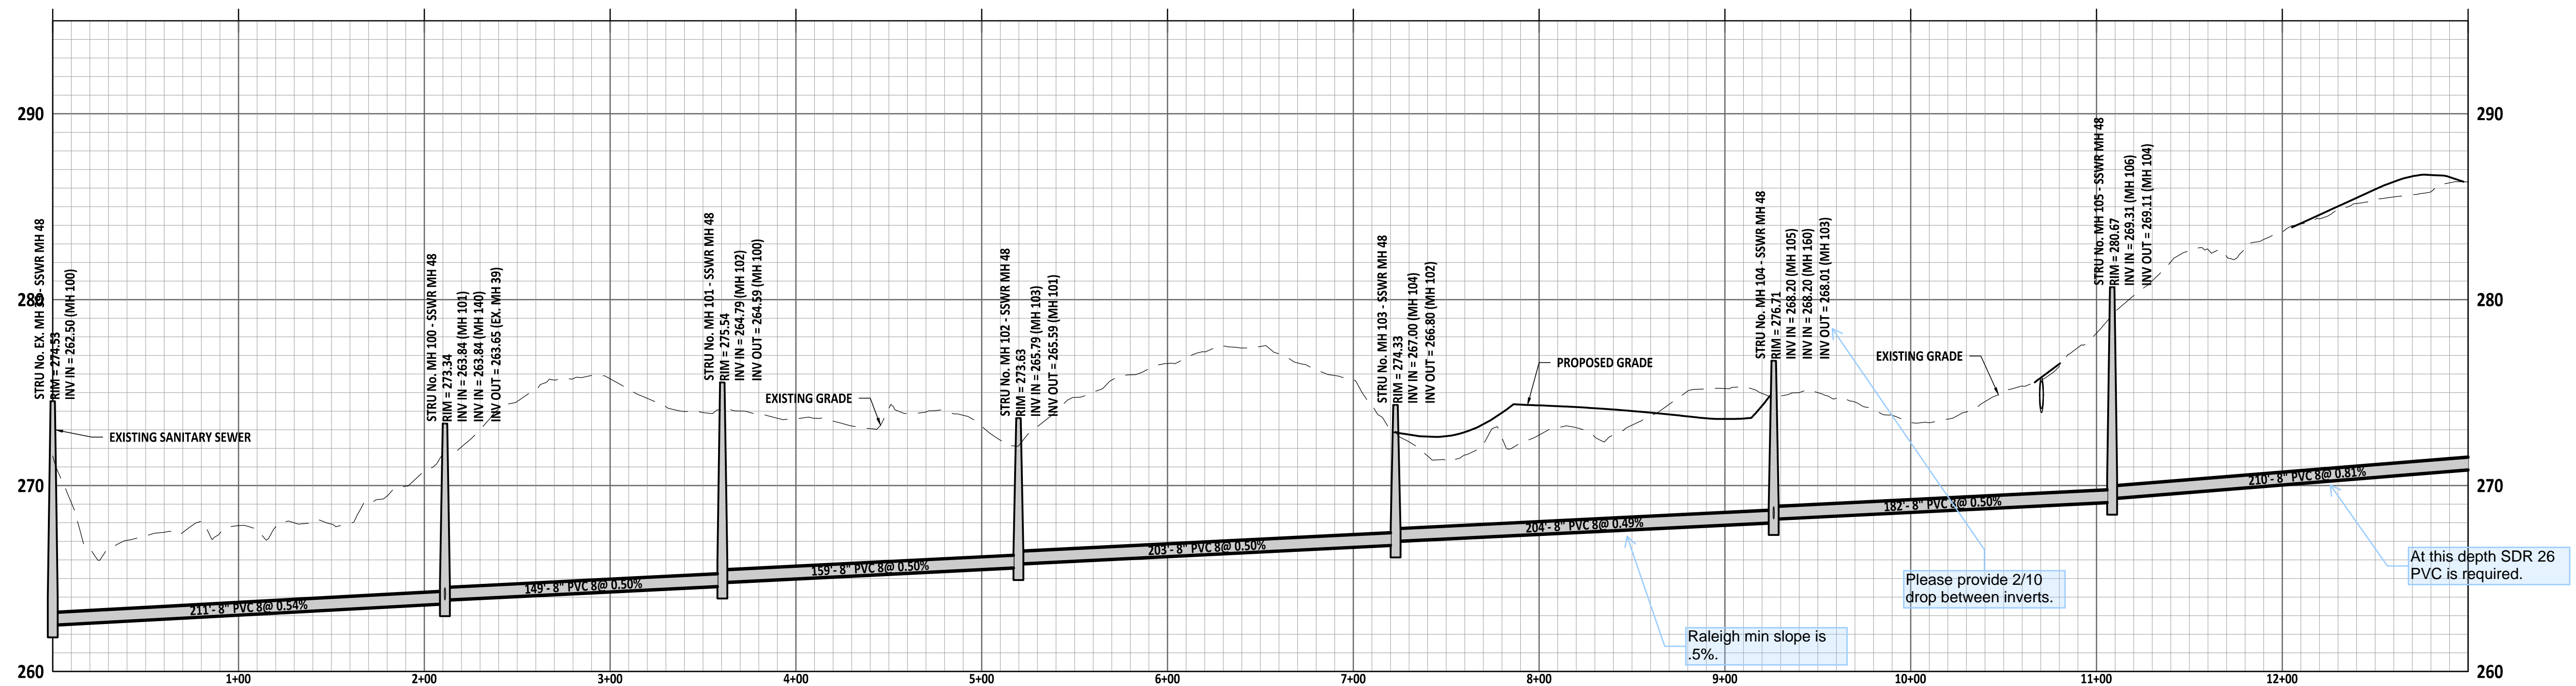


EX. MH# 39 TO MH# 105

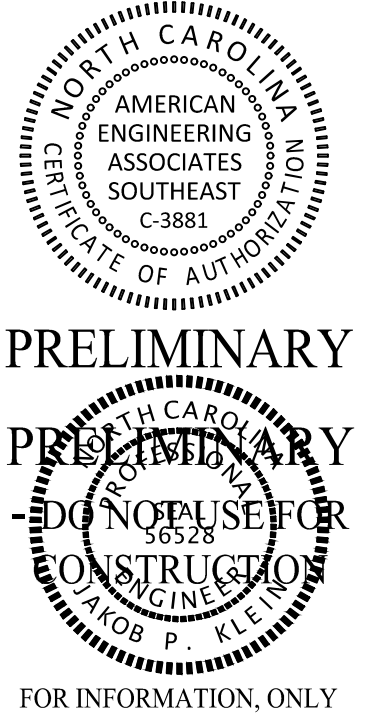

AMERICAN
Engineering

American Engineering Associates - Southeast, P.A.
4020 Westchase Boulevard, Suite 450
Raleigh, NC 27607 919-468-1101

[illegible]

STIPULATION FOR REUSE

THIS DRAWING WAS PREPARED FOR USE ON THE SPECIFIC SITE, NAMED HEREON, CONTEMPORANEOUSLY WITH ITS ISSUE DATE AS LISTED, HEREON, AND IT IS NOT SUITABLE FOR USE ON A DIFFERENT PROJECT SITE OR AT A LATER TIME. USE OF THIS DRAWING FOR REFERENCE OR EXAMPLE ON ANOTHER PROJECT REQUIRES THE SERVICES OF PROPERLY LICENSED ARCHITECTS AND ENGINEERS. REPRODUCTION OF THIS DRAWING FOR REUSE ON ANOTHER PROJECT IS NOT AUTHORIZED AND MAY BE CONTRARY TO THE LAW.

MERRITT RESERVE
CU-200 PLAN & PROFILE
ROLESVILLE RD
WAKE COUNTY NC 27312

BOOK NUMBER:	23-0004
CHECKED BY:	BH
DRAWN BY:	DH/RC/SM/GE/MA/LL/JB
DATE:	04/14/2025
SHEET TITLE:	

**CU-200 PLAN
& PROFILE**

SHEET NO.: _ _ _ _





North Carolina 811
www.nc811.org

*** 3 Days Before Digging ***
North Carolina 811
811 or 1-800-632-4949
Remote Ticket Entry
<http://nc811.org/remoteticketentry.htm>

PROJECT NUMBER = PSP-24-07

Please call out all MH dia. If more than 12' installation depth, MHs must be 5' dia. If greater than 20' MHs must be 6' dia.

MH# 100 TO MH# 143

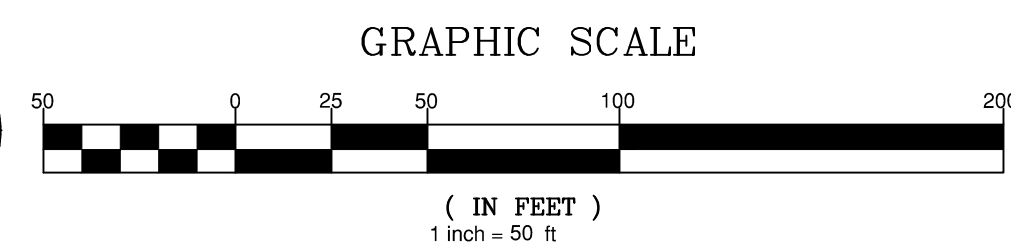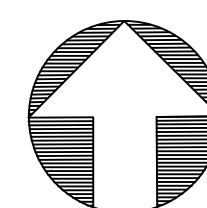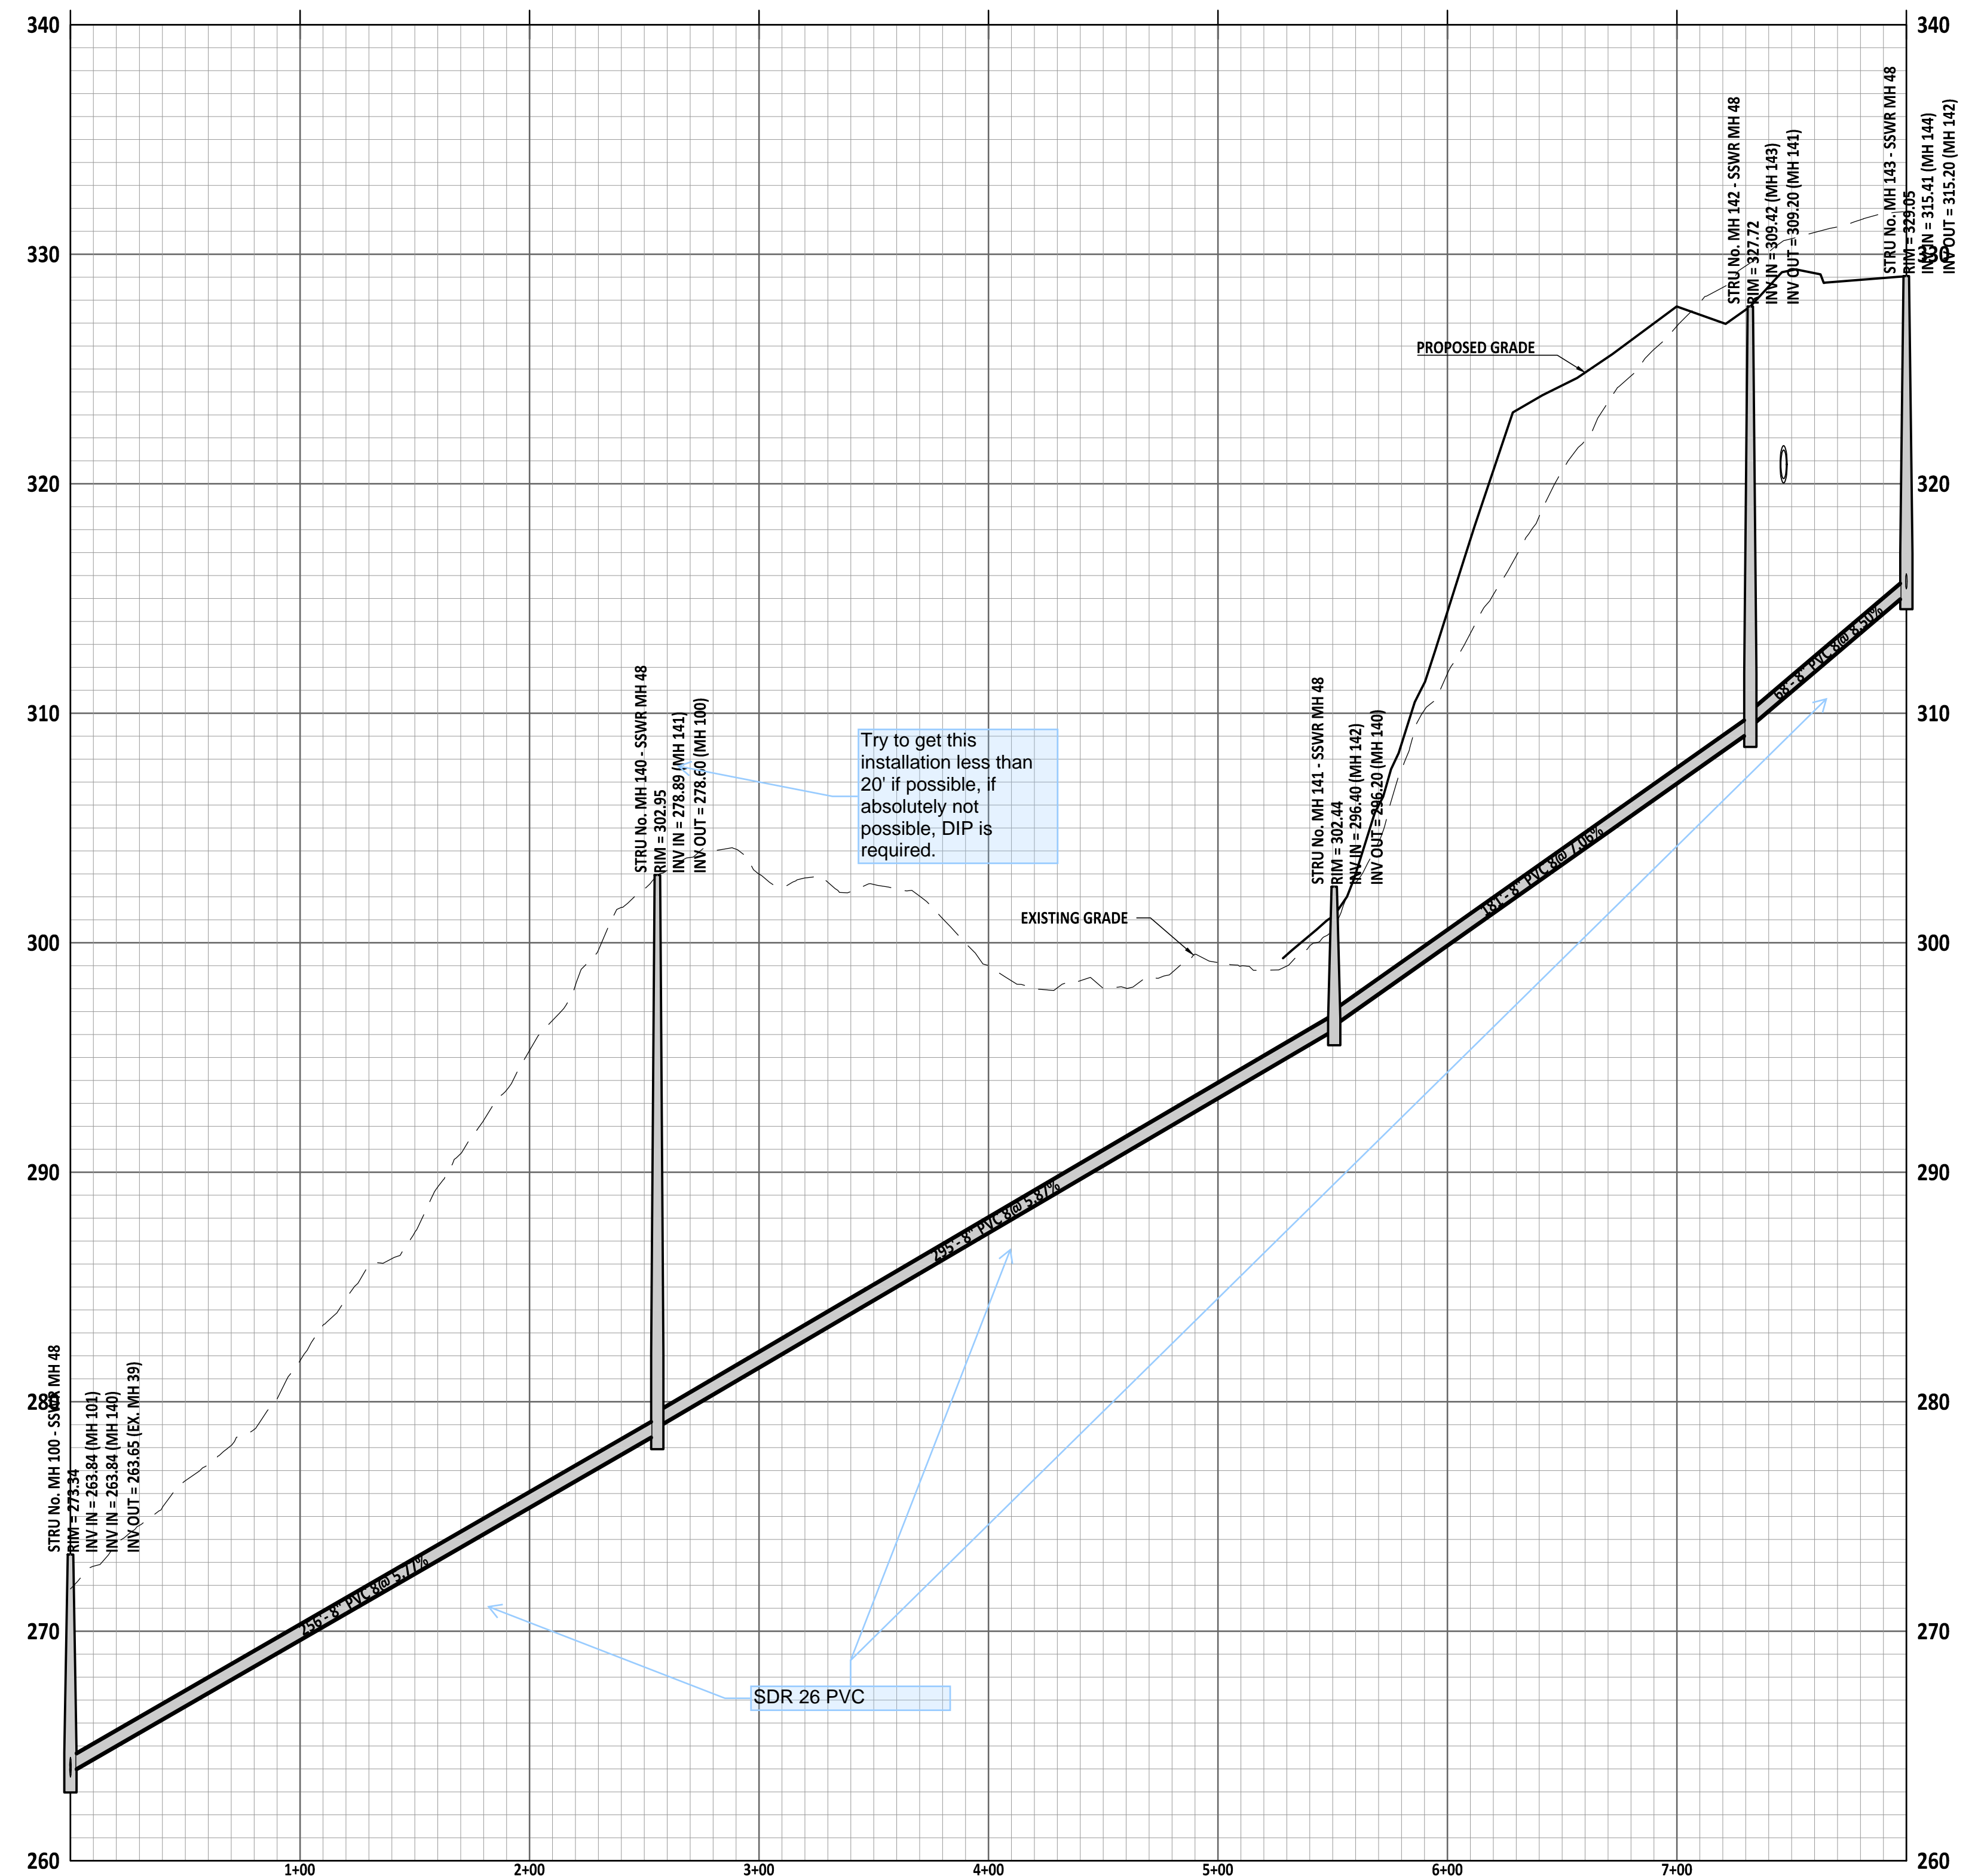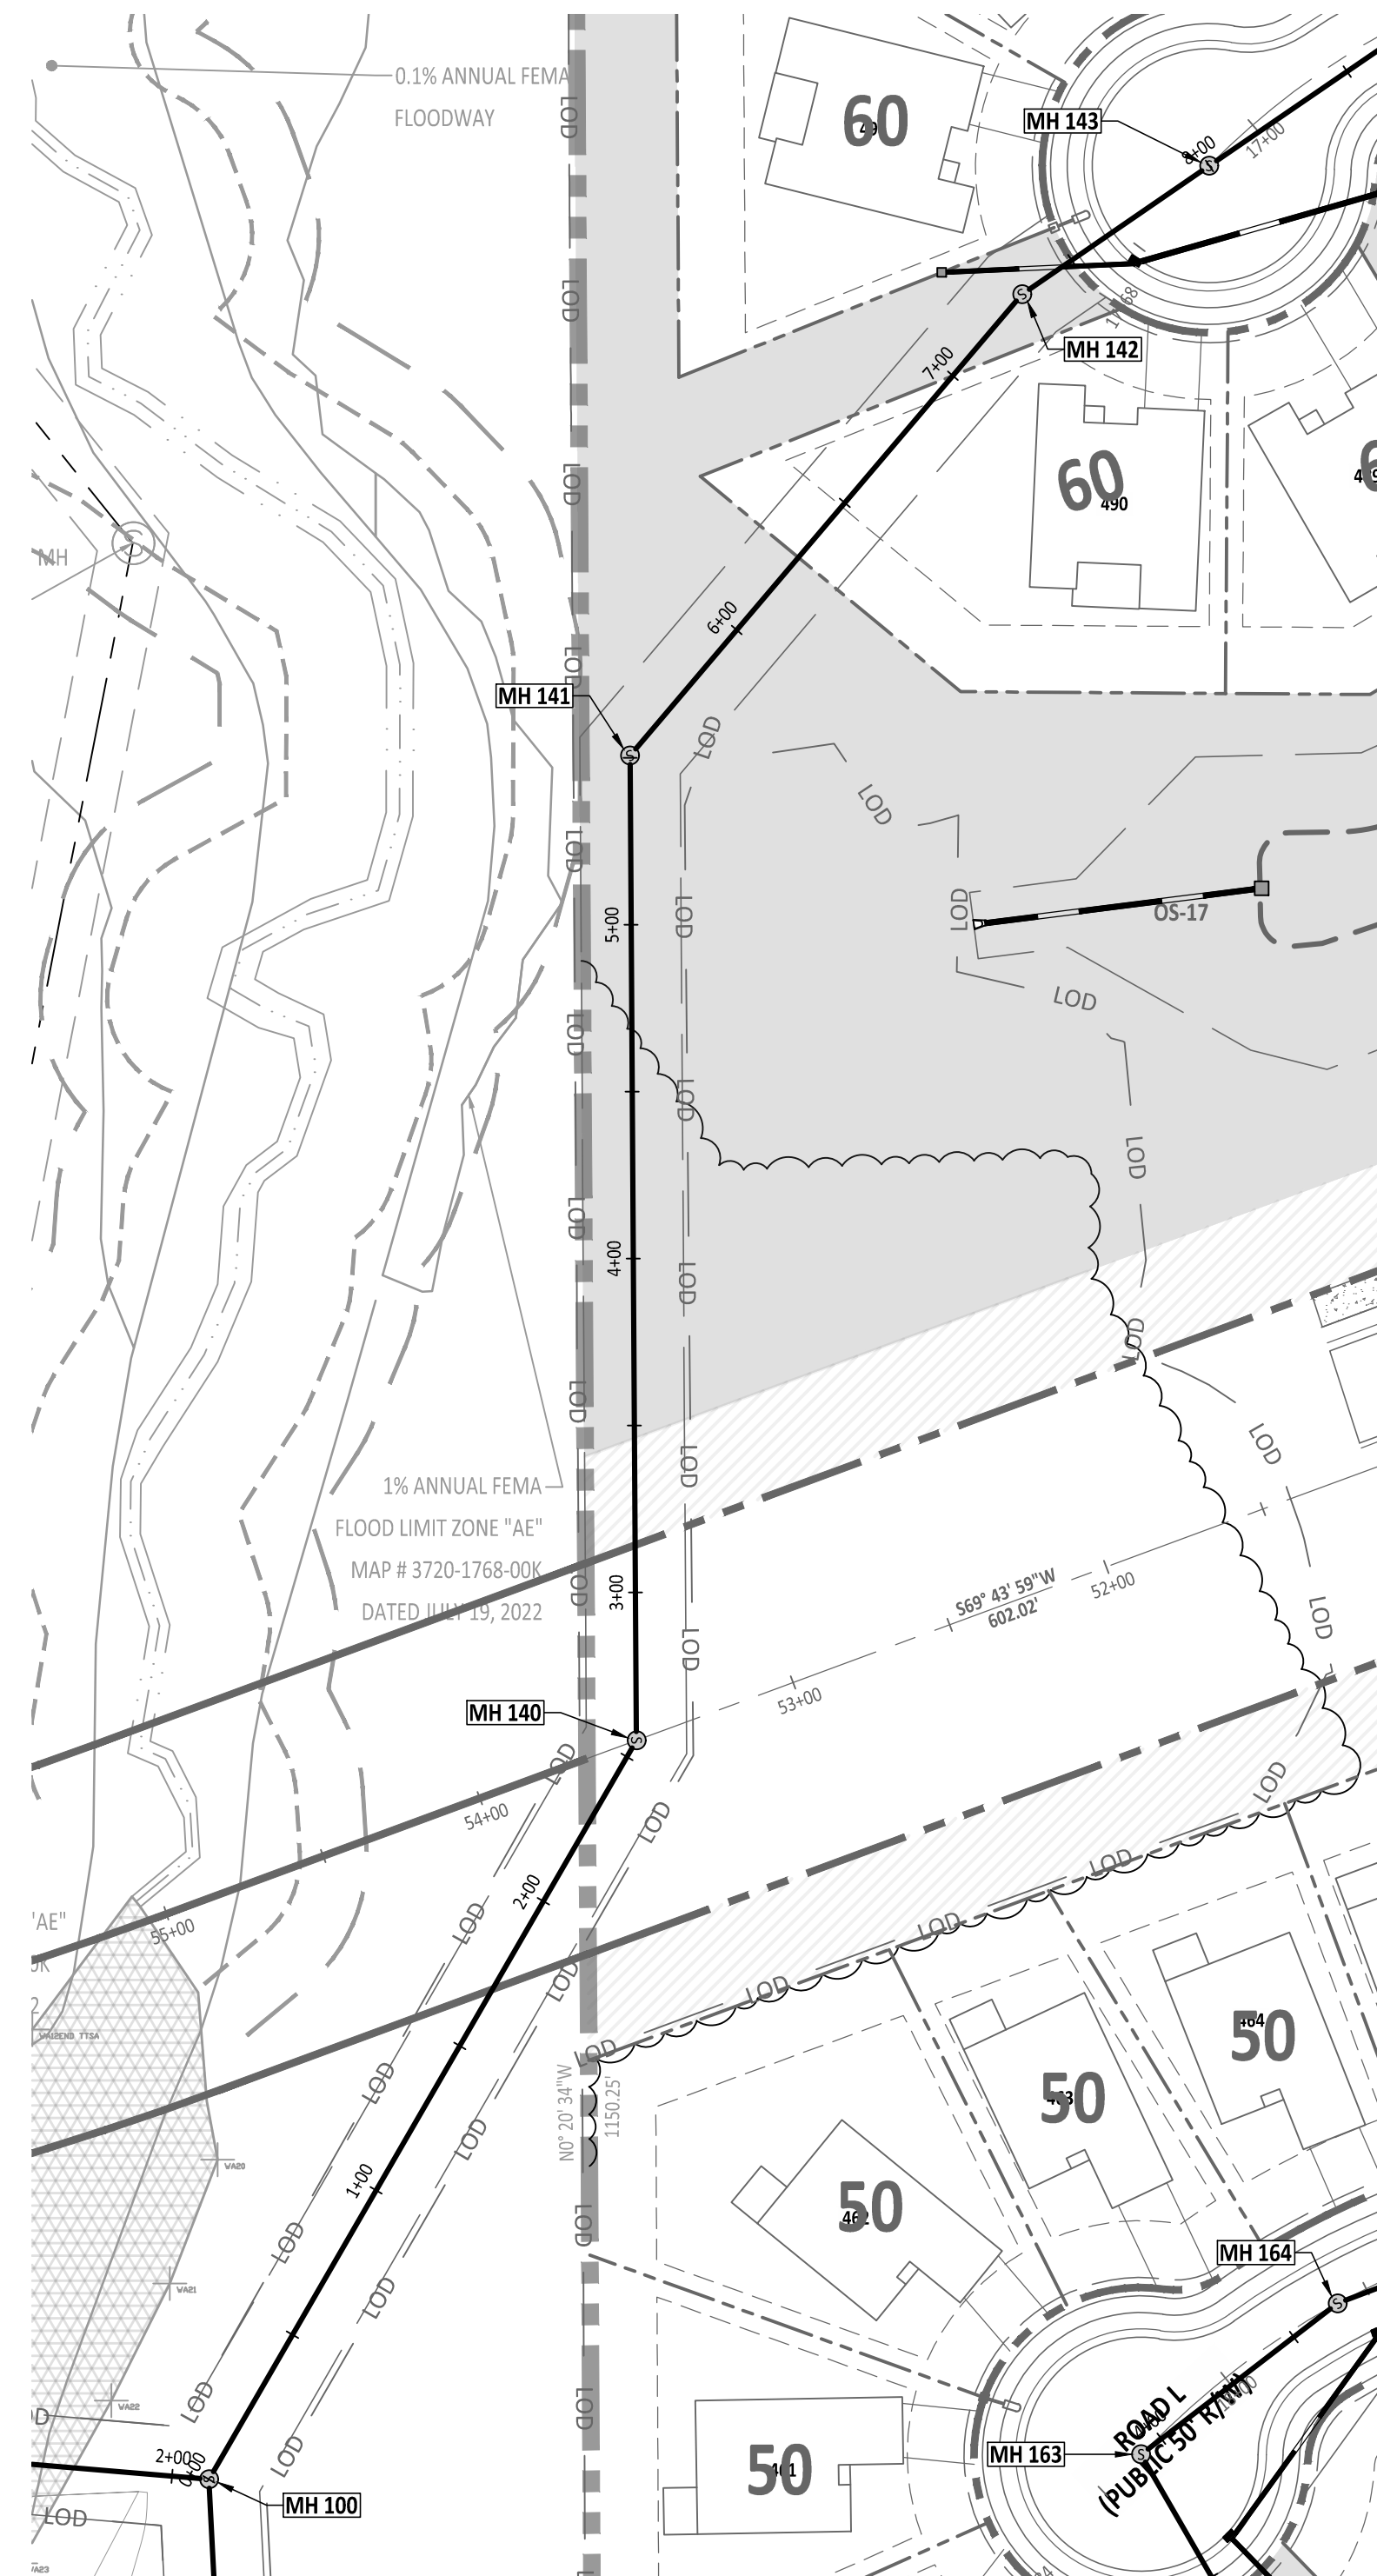

GRAPHIC SCALE

(IN FEET)
1 inch = 50 ft


North Carolina 811
www.nc.811.org
*** 3 Days Before Digging ***
North Carolina 811
811 or 1-800-632-4949
Remote Ticket Entry
<http://nc811.org/remoteticketentry.htm>

*** 3 Days Before Digging ***
North Carolina 811
811 or 1-800-632-4949
Remote Ticket Entry
<http://nc811.org/remoteticketentry.htm>



AMERICAN
Engineering

American Engineering Associates - Southeast, P.A.
4020 Westchase Boulevard, Suite 450
Raleigh, NC 27607 919-469-1101

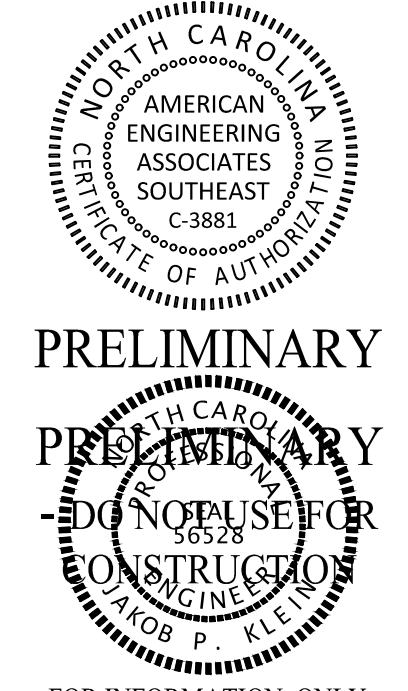

PRELIMINARY

PRELIMINARY
-DO NOT USE FOR
56528

FOR INFORMATION, ONLY

[illegible]

STIPULATION FOR REUSE

THIS DRAWING WAS PREPARED FOR USE ON THE SPECIFIC SITE, NAMED HEREON, CONTEMPORANEOUSLY WITH ITS ISSUE DATE AS LISTED, HEREON, AND IT IS NOT SUITABLE FOR USE ON A DIFFERENT PROJECT SITE OR AT A LATER TIME. USE OF THIS DRAWING FOR REFERENCE OR EXAMPLE ON ANOTHER PROJECT REQUIRES THE SERVICES OF PROPERLY LICENSED ARCHITECTS AND ENGINEERS. REPRODUCTION OF THIS DRAWING FOR REUSE ON ANOTHER PROJECT IS NOT AUTHORIZED AND MAY BE CONTRARY TO THE LAW.

MERRITT RESERVE
CU-202 PLAN & PROFILE
ROLESVILLE RD
WAKE COUNTY NC 27312

JOB NUMBER:	23-0004
CHECKED BY:	BH
DRAWN BY:	DH/RC/SM/GE/MA/LL/JB
DATE:	04/14/2025

**CU-202 PLAN
& PROFILE**

SHEET NO.:

PROJECT NUMBER = PSP-24-07

