

SANITARY STRUCTURE SCHEDULE								
STRUCTURE #	RIM	INV IN	INV OUT	DESCRIPTION				
A-10	380.00	INV IN = 372.32' (6")		PROP. CONNECTION TO EX. SAN. CLEANOUT				
A-20	381.33	INV IN = 375.34' (6")	INV OUT = 375.34 (6")	PROP. 6" SAN. CLEANOUT				
A-30	385.66	INV IN = 378.71' (6")	INV OUT = 378.71 (6")	PROP. 6" SAN. CLEANOUT				
A-40	386.65	INV IN = 381.78' (6")	INV OUT = 381.78 (6")	PROP. 6" SAN. CLEANOUT				
A-50	388.07	INV IN = 383.51' (6")	INV OUT = 383.51 (6")	PROP. 6" SAN. CLEANOUT				
A-60			INV OUT = 384.00 (6")	PROP. SANITARY SEWER BUILDING CONNECTION				

	SANITARY PIPE SCHEDULE									
OUT	FROM	FROM INV	то	TO INV	PIPE LENGTH	SLOPE (%)	DIAMETER (IN.)	MATERIA		
	A-10	372.32'	A-20	375.34'	43'	6.94%	6"	PVC Pipe		
	A-20	375.34'	A-30	378.71'	49'	6.94%	6"	PVC Pipe		
	A-30	378.71'	A-40	381.78'	44'	6.94%	6"	PVC Pipe		
	A-40	381.78'	A-50	383.51'	25'	6.94%	6"	PVC Pipe		
CTION	A-50	383.51'	A-60	384.00'	7'	6.94%	6"	PVC Pipe		



# **REVISIONS**

REV	DATE	COMMENT	DRAWNDI
KEV	DATE	COMMENT	CHECKED BY
1	7/1/24	TRC COMMENTS	CJAC
'	//1/24	TRC COMMENTS	OAK
2	9/2/25	/25 TRC COMMENTS	
	9/2/23	TIC COMMENTS	OAK



Call before you dig. **ALWAYS CALL 811** 

It's fast. It's free. It's the law.

#### PERMIT SET

THIS DRAWING IS INTENDED FOR MUNICIPAL AND/OR AGENCY REVIEW AND APPROVAL. IT IS NOT INTENDED AS A CONSTRUCTIC DOCUMENT UNLESS INDICATED OTHERWISE.

P-CIVL-UTIL

PROJECT No.: DRAWN BY: RS/JE/CC **CHECKED BY:** 

PROJECT:

CAD I.D.:

## SITE DEVELOPMENT

## **PLANS**

CHASE



PROPOSED DEVELOPMENT

**S MAIN ST & VIRGINIA WATER DR ROLESVILLE, NC 27587 WAKE COUNTY** 



4130 PARKLAKE AVENUE, SUITE 20 RALEIGH, NC 27612 Phone: (919) 578-9000

NC@BohlerEng.com



SHEET TITLE:


UTILITY PLAN

THIS PLAN TO BE UTILIZED FOR **UTILITIES PURPOSES ONLY** 

SCALE: 1" = 20'

C-501

**REVISION 2 - 9/2/25** 

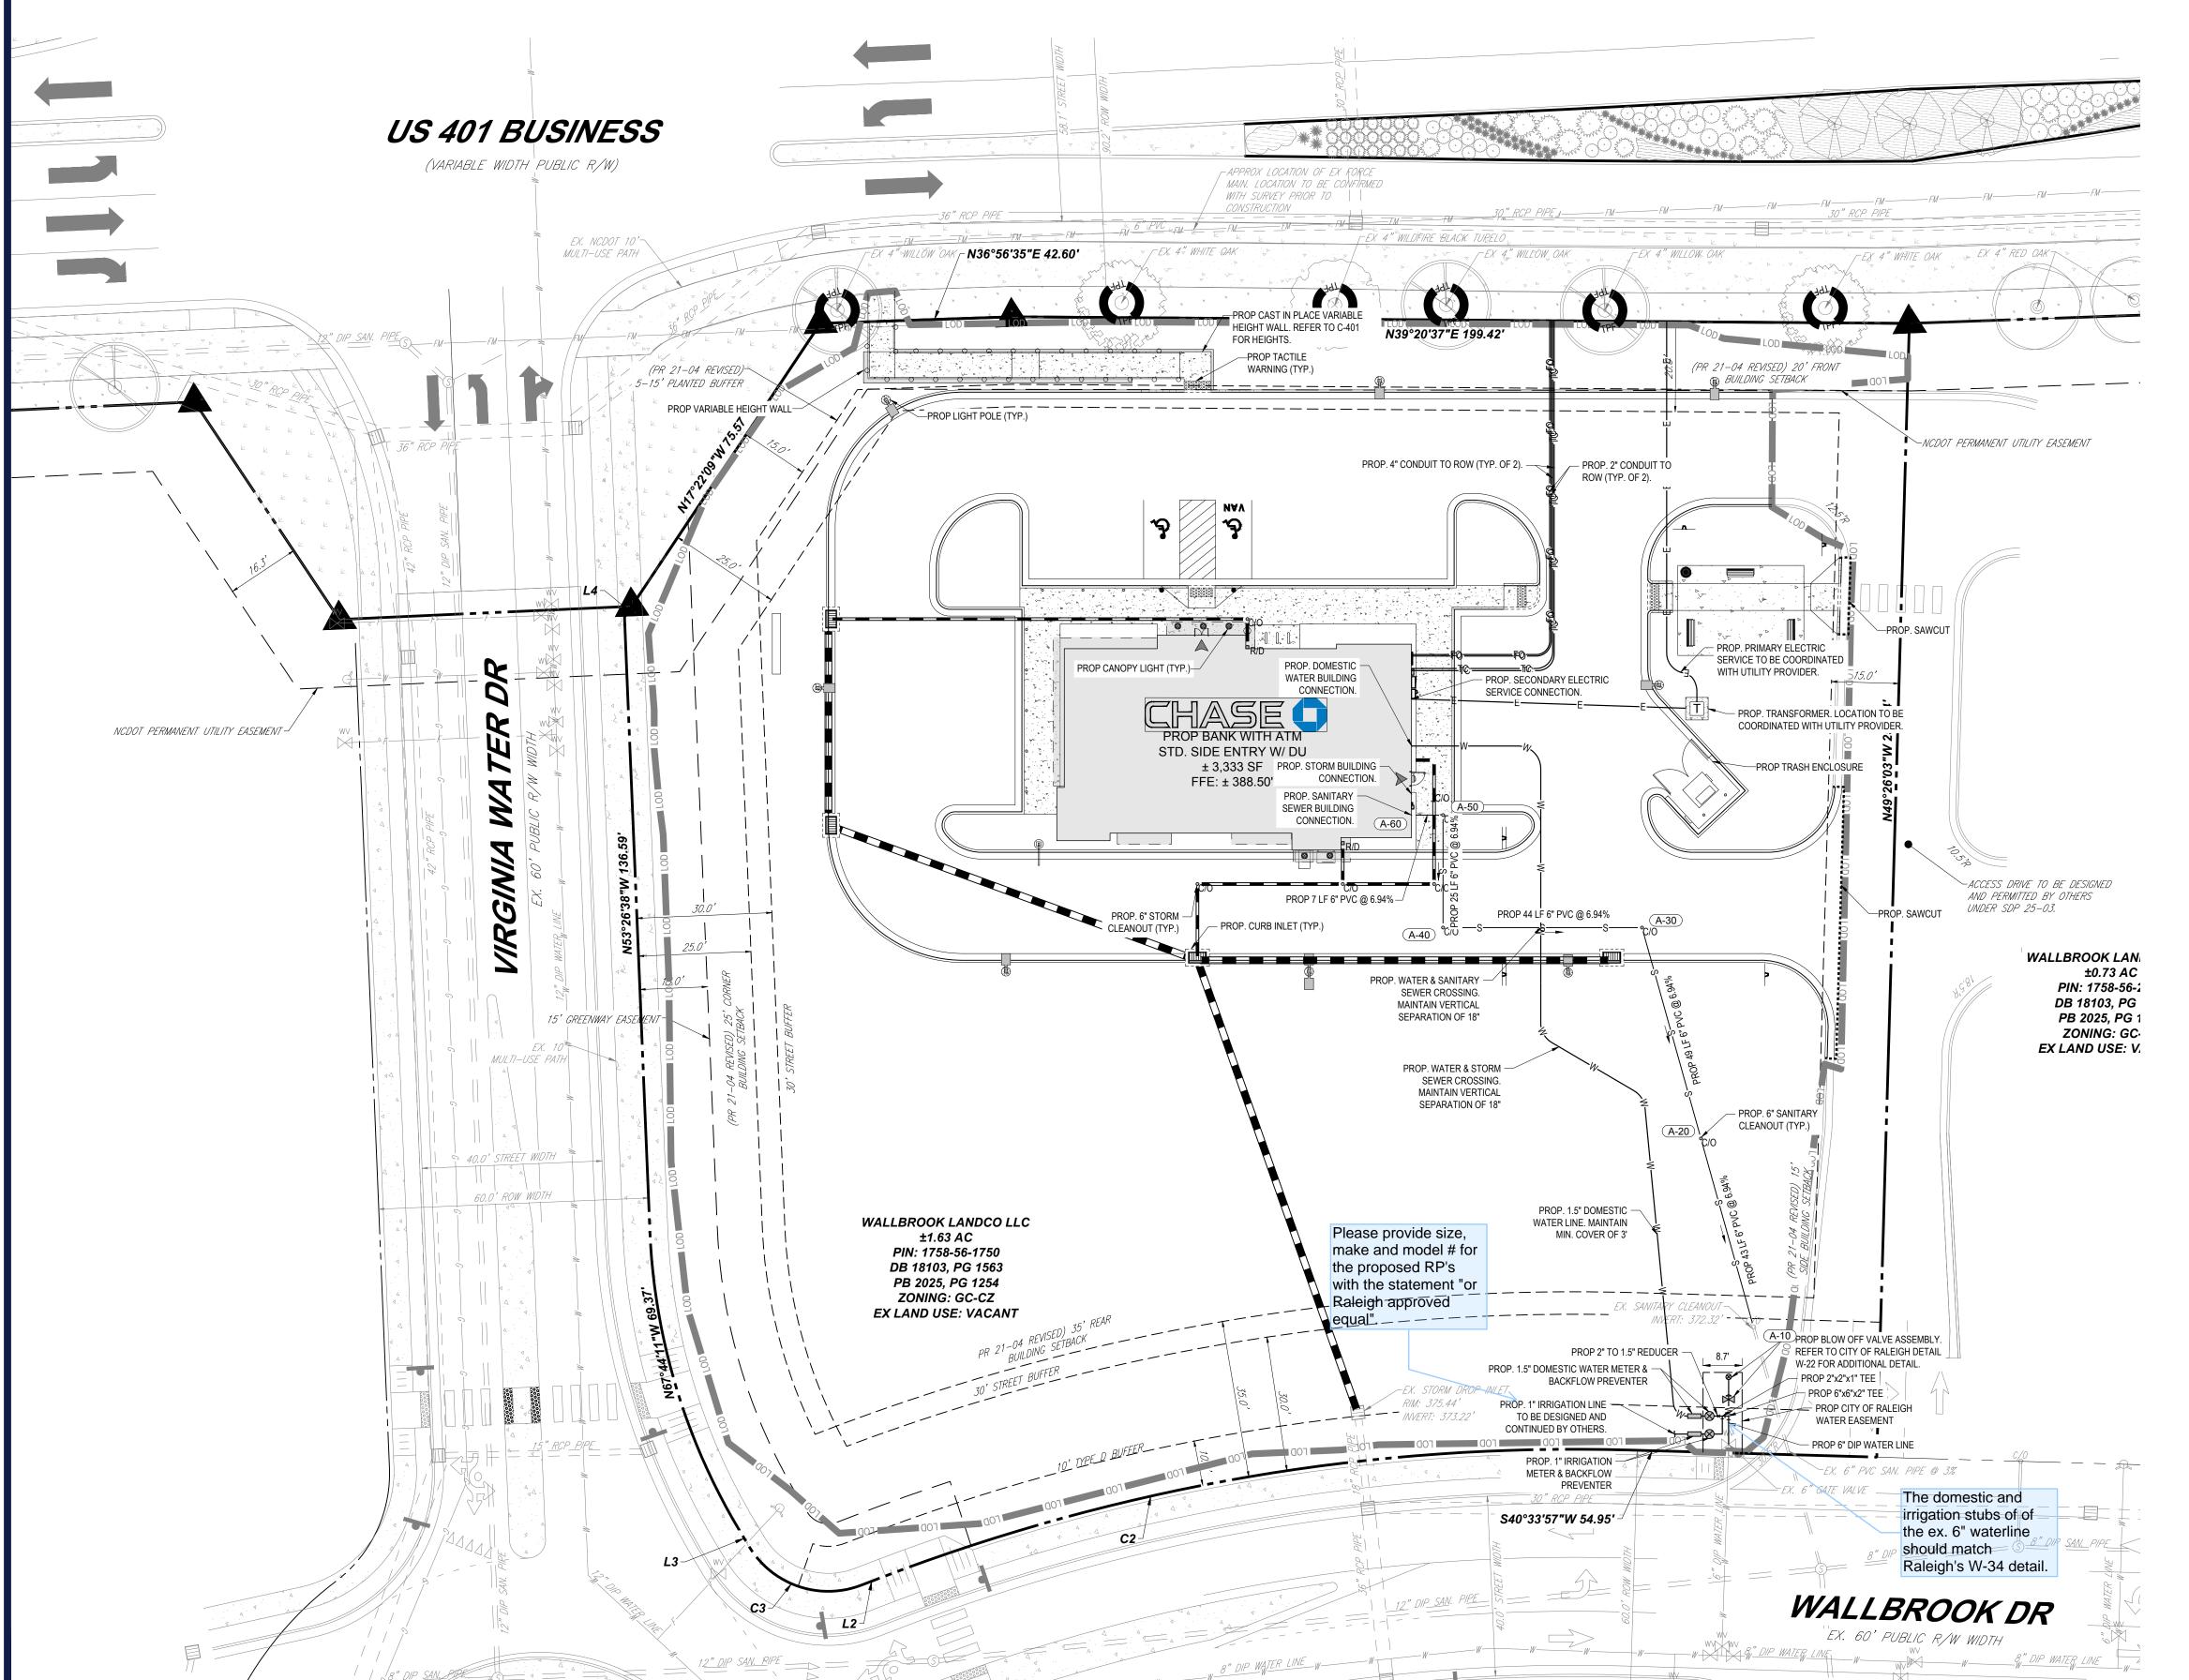

#### **CITY OF RALEIGH STANDARD UTILITY NOTES:**

- 1. ALL MATERIALS & CONSTRUCTION METHODS SHALL BE IN ACCORDANCE WITH CITY OF RALEIGH DESIGN STANDARDS, DETAILS & SPECIFICATIONS (REFERENCE: CORPUD HANDBOOK, CURRENT EDITION) 2. UTILITY SEPARATION REQUIREMENTS:
- A DISTANCE OF 100' SHALL BE MAINTAINED BETWEEN SANITARY SEWER & ANY PRIVATE OR PUBLIC WATER SUPPLY SOURCE SUCH AS AN IMPOUNDED RESERVOIR USED AS A SOURCE OF DRINKING WATER. IF ADEQUATE LATERAL SEPARATION CANNOT BE ACHIEVED, FERROUS SANITARY SEWER PIPE SHALL BE SPECIFIED & INSTALLED TO WATERLINE SPECIFICATIONS. HOWEVER, THE MINIMUM SEPARATION SHALL NOT BE LESS THAN 25' FROM A PRIVATE WELL OR 50' FROM
- A PUBLIC WELL. WHEN INSTALLING WATER &/OR SEWER MAINS, THE HORIZONTAL SEPARATION BETWEEN UTILITIES SHALL BE 10'. IF THIS SEPARATION CANNOT BE MAINTAINED DUE TO EXISTING CONDITIONS, THE VARIATION ALLOWED IS THE WATER MAIN IN A SEPARATE TRENCH WITH THE ELEVATION OF THE WATER MAIN AT LEAST 18" ABOVE THE TOP OF THE SEWER & MUST BE APPROVED BY THE PUBLIC UTILITIES DIRECTOR. ALL DISTANCES ARE MEASURED FROM OUTSIDE DIAMETER TO OUTSIDE
- 2.3. WHERE IT IS IMPOSSIBLE TO OBTAIN PROPER SEPARATION. OR ANYTIME A SANITARY SEWER PASSES OVER A WATERMAIN. DIP MATERIALS OR STEEL ENCASEMENT EXTENDED 10' ON EACH SIDE OF CROSSING MUST BE SPECIFIED & INSTALLED TO
- 5.0' MINIMUM HORIZONTAL SEPARATION IS REQUIRED BETWEEN ALL SANITARY SEWER & STORM SEWER FACILITIES, UNLESS DIP MATERIAL IS SPECIFIED FOR SANITARY SEWER MAINTAIN 18" MIN. VERTICAL SEPARATION AT ALL WATERMAIN & RCP STORM DRAIN CROSSINGS; MAINTAIN 18" MIN.

VERTICAL SEPARATION AT ALL SANITARY SEWER & RCP STORM DRAIN CROSSINGS. WHERE ADEQUATE SEPARATIONS

- CANNOT BE ACHIEVED, SPECIFY DIP MATERIALS & A CONCRETE CRADLE HAVING 6" MIN. CLEARANCE (PER CORPUD DETAILS ALL OTHER UNDERGROUND UTILITIES SHALL CROSS WATER & SEWER FACILITIES WITH 18" MIN. VERTICAL SEPARATION REQUIRED.
- 3. ANY NECESSARY FIELD REVISIONS ARE SUBJECT TO REVIEW & APPROVAL OF AN AMENDED PLAN &/OR PROFILE BY THE CITY OF RALEIGH PUBLIC UTILITIES DEPARTMENT PRIOR TO CONSTRUCTION. 4. DEVELOPER SHALL PROVIDE 30 DAYS ADVANCE WRITTEN NOTICE TO OWNER FOR ANY WORK REQUIRED WITHIN AN EXISTING
- CITY OF RALEIGH UTILITY EASEMENT TRAVERSING PRIVATE PROPERTY. 5. CONTRACTOR SHALL MAINTAIN CONTINUOUS WATER & SEWER SERVICE TO EXISTING RESIDENCES & BUSINESSES THROUGHOUT CONSTRUCTION OF PROJECT. ANY NECESSARY SERVICE INTERRUPTIONS SHALL BE PRECEDED BY A 24-HOUR
- ADVANCE NOTICE TO THE CITY OF RALEIGH PUBLIC UTILITIES DEPARTMENT. 6. SEWER BYPASS PUMPING - A BYPASS PLAN SEALED BY AN NC PROFESSIONAL ENGINEER SHALL BE PROVIDED TO RALEIGH
- WATER PRIOR TO PUMPING OPERATIONS FOR APPROVAL. THE OPERATIONS AND EQUIPMENT SHALL COMPLY WITH THE PUBLIC
- 7. 3.0' MINIMUM COVER IS REQUIRED ON ALL WATER MAINS & SEWER FORCE MAINS. 4.0' MINIMUM COVER IS REQUIRED ON ALL
- 8. IT IS THE DEVELOPER'S RESPONSIBILITY TO ABANDON OR REMOVE EXISTING WATER & SEWER SERVICES NOT BEING USED IN REDEVELOPMENT OF A SITE UNLESS OTHERWISE DIRECTED BY THE CITY OF RALEIGH PUBLIC UTILITIES DEPARTMENT. THIS
- INCLUDES ABANDONING TAP AT MAIN & REMOVAL OF SERVICE FROM ROW OR EASEMENT PER CORPUD HANDBOOK PROCEDURE. 9. INSTALL 1.5" COPPER\* WATER SERVICES WITH METERS LOCATED AT ROW OR WITHIN A 2'X2' WATERLINE EASEMENT IMMEDIATELY ADJACENT. NOTE: IT IS THE APPLICANT'S RESPONSIBILITY TO PROPERLY SIZE THE WATER SERVICE FOR EACH
- CONNECTION TO PROVIDE ADEQUATE FLOW & PRESSURE 10. INSTALL 6" PVC\* SEWER SERVICES @ 1.0% MINIMUM GRADE WITH CLEANOUTS LOCATED AT ROW OR EASEMENT LINE & SPACED
- EVERY 75 LINEAR FEET MAXIMUM. 11. PRESSURE REDUCING VALVES ARE REQUIRED ON ALL WATER SERVICES EXCEEDING 80 PSI; BACKWATER VALVES ARE
- REQUIRED ON ALL SANITARY SEWER SERVICES HAVING BUILDING DRAINS LOWER THAN 1.0' ABOVE THE NEXT UPSTREAM
- 12. ALL ENVIRONMENTAL PERMITS APPLICABLE TO THE PROJECT MUST BE OBTAINED FROM NCDWQ, USACE &/OR FEMA FOR ANY RIPARIAN BUFFER, WETLAND &/OR FLOODPLAIN IMPACTS (RESPECTIVELY) PRIOR TO CONSTRUCTION.
- 13. NCDOT / RAILROAD ENCROACHMENT AGREEMENTS ARE REQUIRED FOR ANY UTILITY WORK (INCLUDING MAIN EXTENSIONS & SERVICE TAPS) WITHIN STATE OR RAILROAD ROW PRIOR TO CONSTRUCTION.
- 14. GREASE INTERCEPTOR / OIL WATER SEPARATOR SIZING CALCULATIONS & INSTALLATION SPECIFICATIONS SHALL BE APPROVED BY THE RW FOG PROGRAM COORDINATOR PRIOR TO ISSUANCE OF A UC AND/OR BUILDING PERMIT. CONTACT (919) 996-4516 OR FOG@RALEIGHNC.GOV FOR MORE INFORMATION.
- 15. CROSS-CONNECTION CONTROL PROTECTION DEVICES ARE REQUIRED BASED ON THE DEGREE OF HEALTH HAZARD INVOLVED AS LISTED IN APPENDIX B OF THE RULES GOVERNING PUBLIC WATER SYSTEMS IN NORTH CAROLINA. 16. THE DEVICES SHALL MEET THE AMERICAN SOCIETY OF SANITARY ENGINEERING (SAAE) STANDARDS AND BE ON THE UNIVERSITY
- OF SOUTHERN CALIFORNIA APPROVAL LIST. 17. THE DEVICE AND INSTALLATION SHALL MEET THE GUIDELINES OF APPENDIX A – GUIDELINES AND REQUIREMENTS FOR THE CROSS CONNECTION PROGRAM IN RALEIGH'S SERVICE AREA.
- 18. THE DEVICES SHALL BE INSTALLED AND TESTED (BOTH, INITIAL AND PERIODIC TESTING THEREAFTER) IN ACCORDANCE WITH
- THE MANUFACTURER'S RECOMMENDATIONS OR THE LOCAL CROSS CONNECTION CONTROL PROGRAM. WHICHEVER IS MORE STRINGENT. CONTACT CROSS.CONNECTION@RALEIGHNC.GOV FOR MORE INFORMATION.

19. NOTICE FOR PROJECTS THAT INVOLVE AN OVERSIZED MAIN OR URBAN MAIN REPLACEMENT. ANY CITY REIMBURSEMENT GREATER THAN \$250,000.00 MUST UNDERGO THE PUBLIC BIDDING PROCESS.