

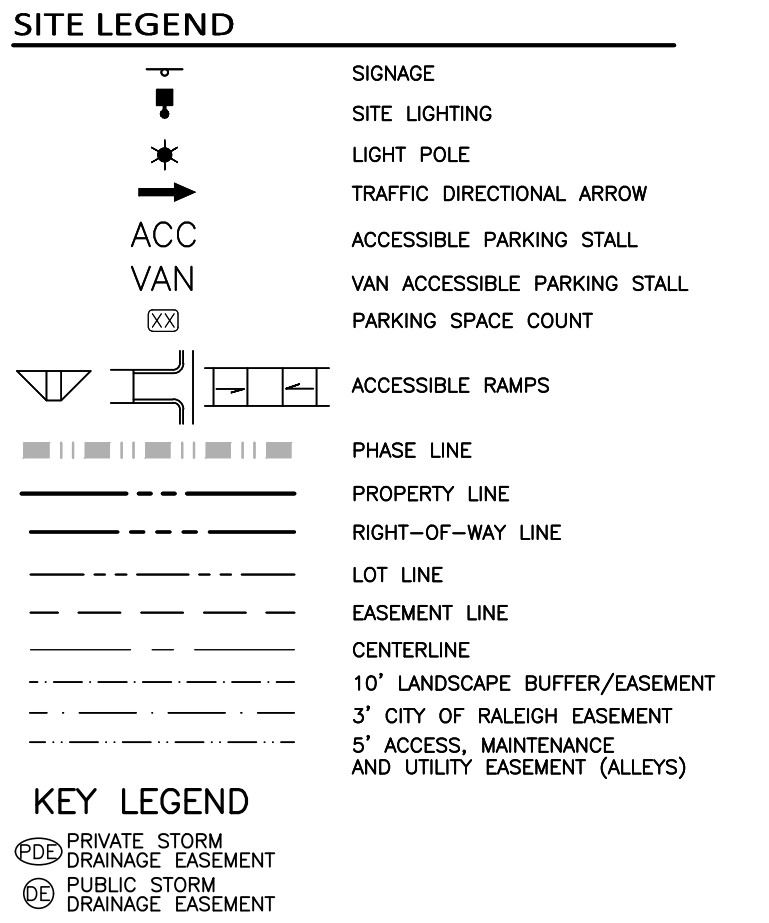
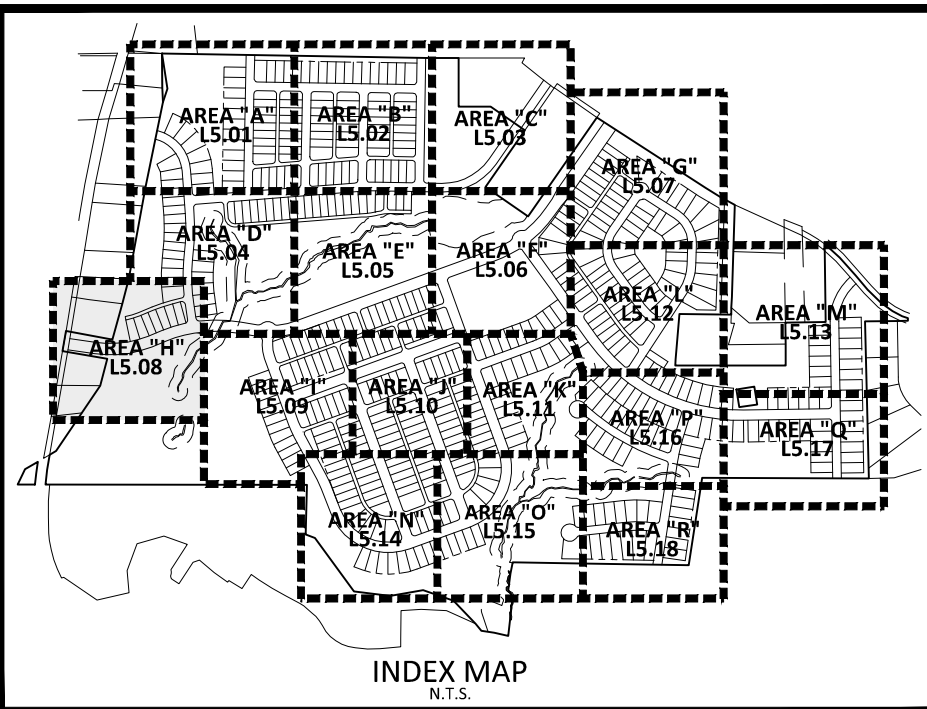


X:\Projects\AGN23001\04-Production\Engineering\Construction Drawings\Current Drawings\AGN23001-L5.08.dwg, 6/27/2025, 12:38:07 PM, Shabrum Muhammadzadeh

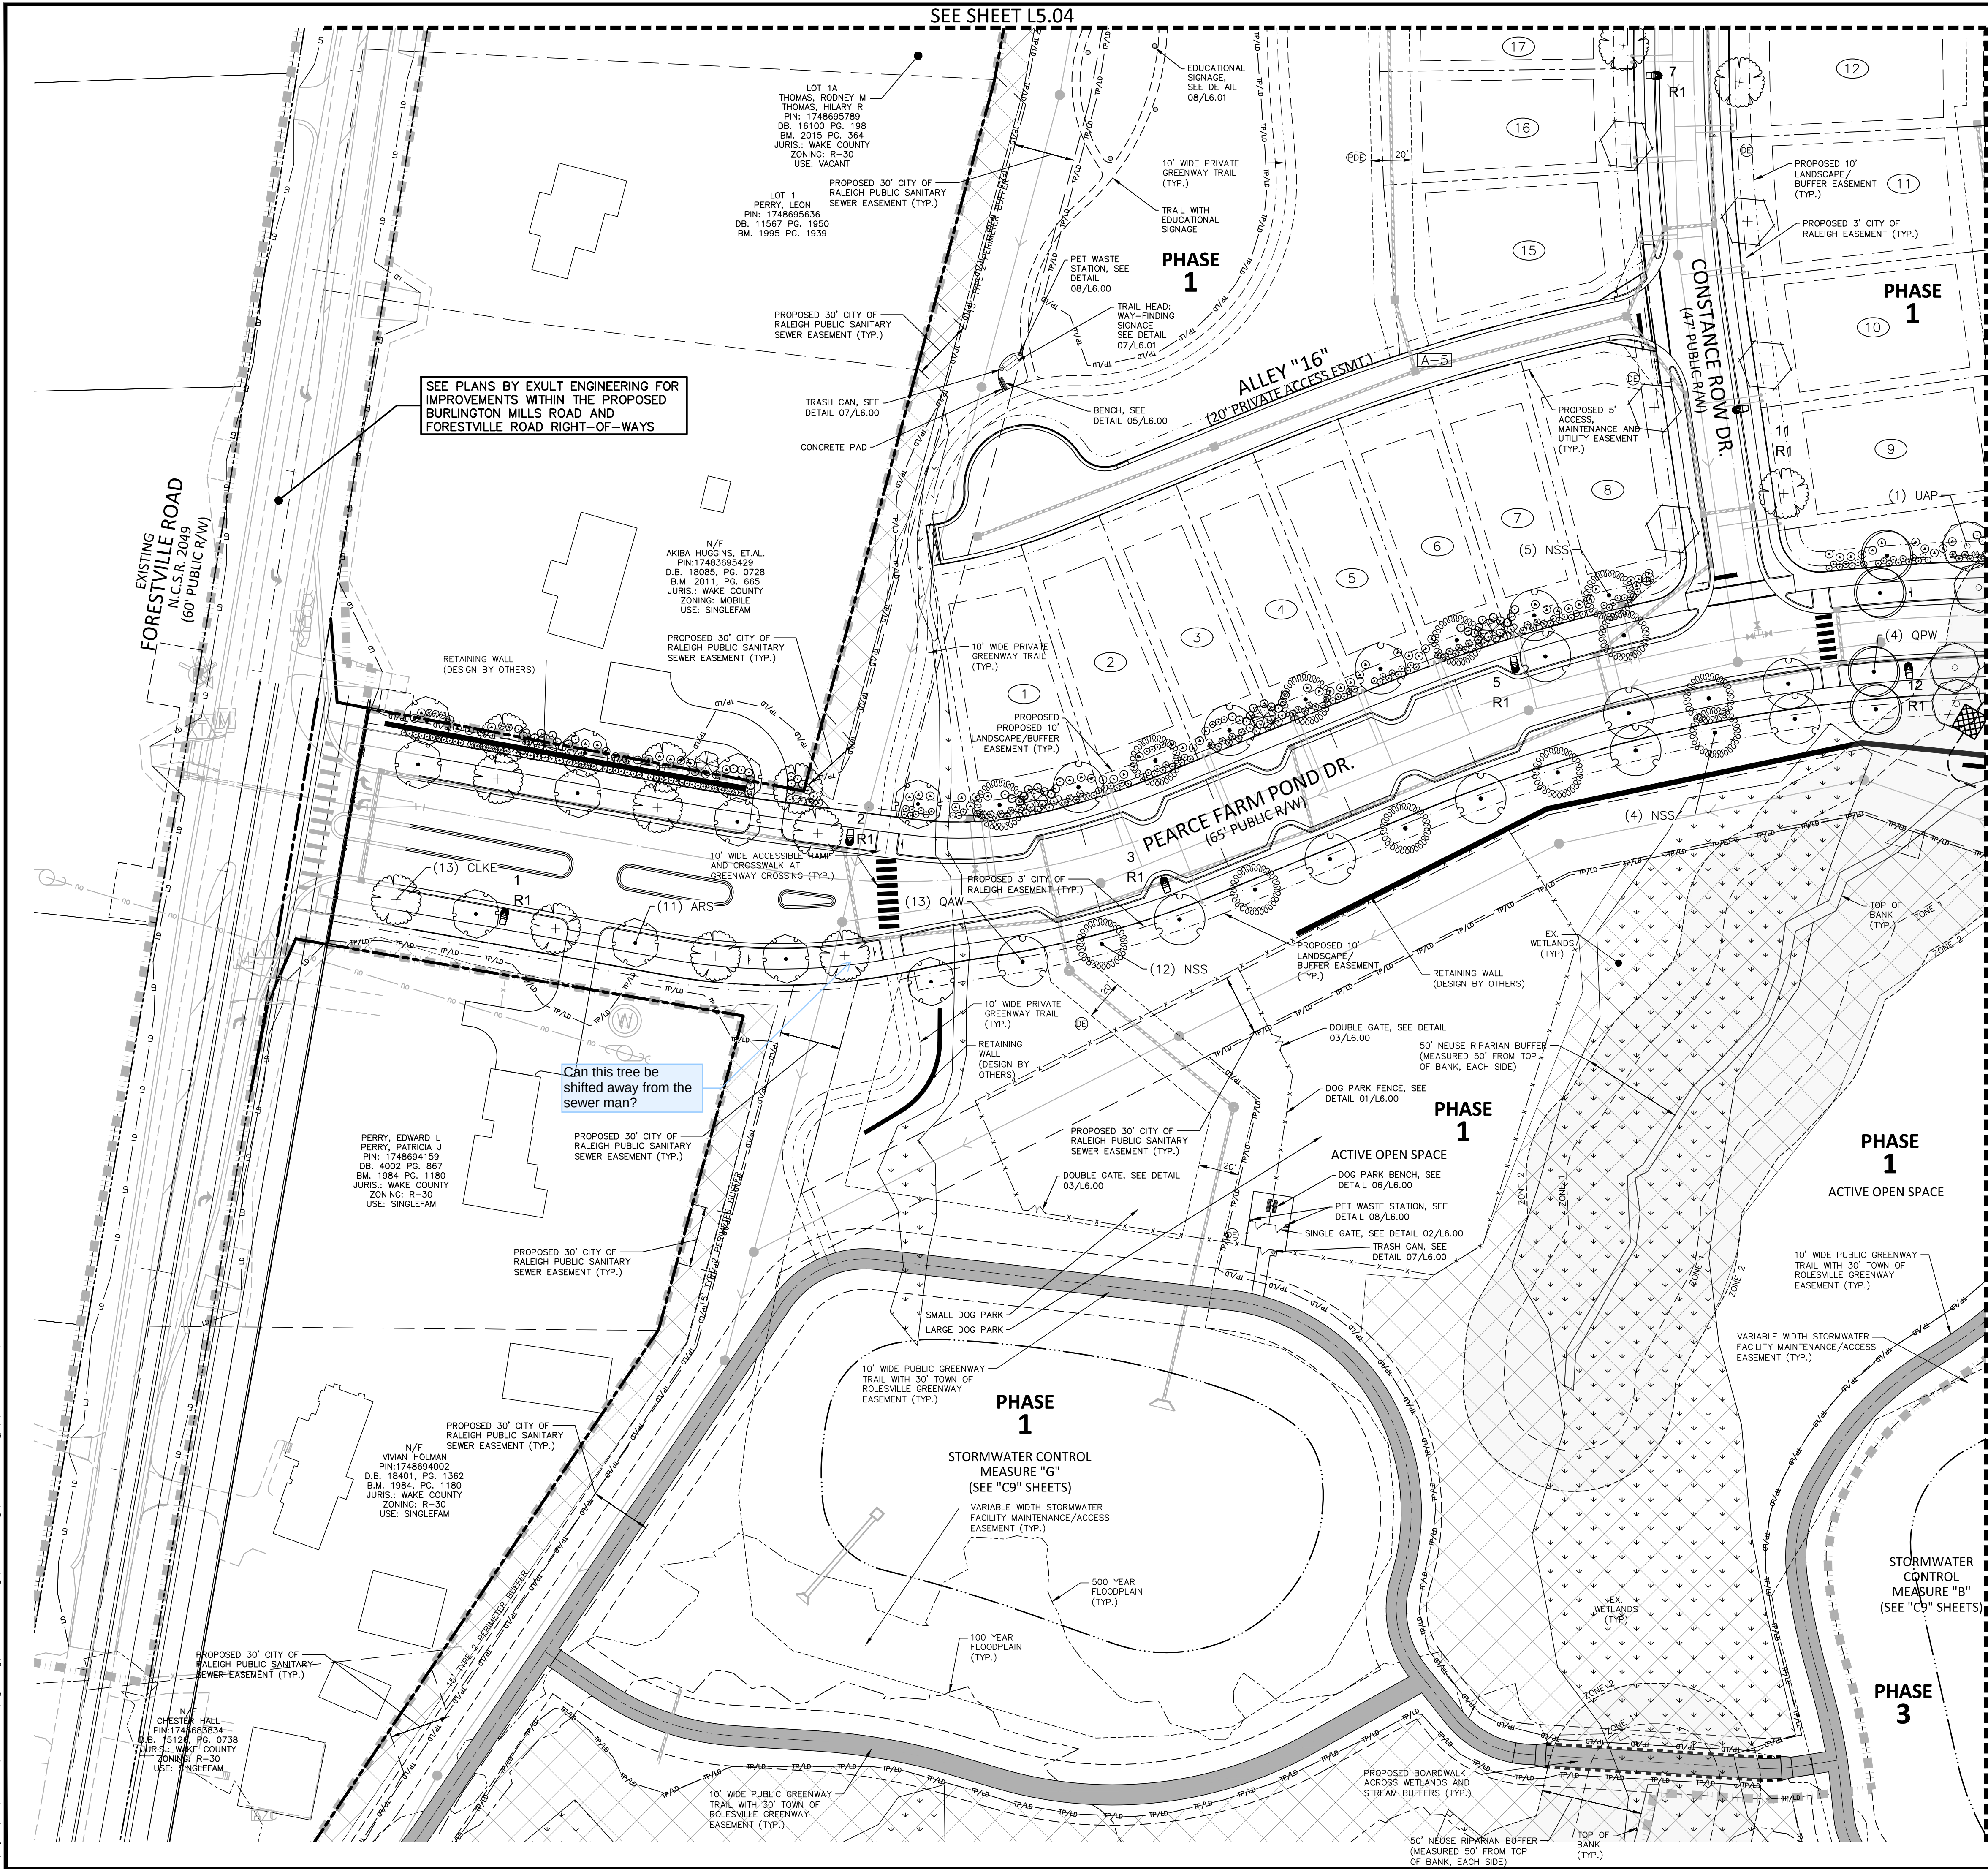

PLANT SCHEDULE AREA 'H'

SYMBOL	CODE	BOTANICAL / COMMON NAME
CANOPY TREES		
ARS	ARS	ACER RUBRUM 'SUMMER RED' / SUMMER RED RED MAPLE
CLKE	CLKE	CLADRASTIS KENTUKEA / YELLOWWOOD
LTT	LTT	LIRIODENDRON TULIPIFERA / TULIP TREE
NSS	NSS	NYSSA SYLVATICA / BLACK GUM
QAW	QAW	QUERCUS ALBA / WHITE OAK
QPW	QPW	QUERCUS PHELLOS / WILLOW OAK
UAP	UAP	ULMUS AMERICANA 'PRINCETON' / AMERICAN ELM

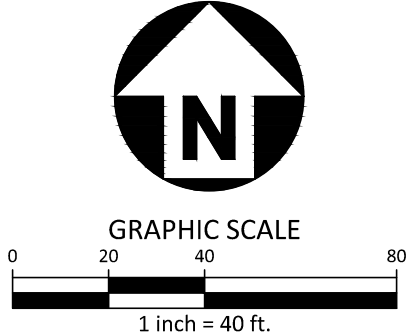

McADAMS
The John R. McAdams Company, Inc.
2905 Meridian Parkway
Durham, NC 27713
phone 919. 361. 5000
fax 919. 361. 2269
license number: C-0293, C-187
www.mcadamsco.com

CLIENT
ALLIANCE GROUP OF NC, LLC
7208 FALLS OF NEUSE RD, SUITE 101
RALEIGH, NORTH CAROLINA 27615
CONTACT: JACOB ANDERSON
PHONE: 919. 239. 9486



PEARCE FARM - PHASES 1-3
CONSTRUCTION DRAWINGS - PACKAGE 1
BURLINGTON MILLS ROAD
TOWN OF ROLESVILLE, NORTH CAROLINA

CID-24-08



REVISIONS

NO.	DATE	REVISION
1	02.03.2025	REVISED PER TOWN, CITY AND COUNTY COMMENTS
2	04.01.2025	REVISED PER TOWN, CITY AND COUNTY COMMENTS
3	06.02.2025	REVISED PER TOWN, CITY AND COUNTY COMMENTS

PLAN INFORMATION

PROJECT NO.	AGN23001
FILENAME	AGN23001-L51
CHECKED BY	JMH
DRAWN BY	SMO
SCALE	1"=40'
DATE	12.02.2024

SHEET
LANDSCAPE PLAN
AREA "H"
L5.08

FINAL DRAWING - NOT RELEASED FOR CONSTRUCTION