


NO.	DATE	REVISIONS
1	2024-03-23	REVISED STORM IN BEAR WAYS OF LOTS 204-207 TO FLOW THROUGH FIGHTING BULL DRIVE
2	2024-03-23	REVISED PHASE LINES
3	2024-03-24	REVISED STORM PIPE DATA FROM STORM STRUCTURES LOT TO LOT COMMENTS ON STORM DRAINAGE
4	2024-03-28	REVISED STORM PIPE DATA FROM STORM STRUCTURES LOT TO LOT COMMENTS ON STORM DRAINAGE
5	2024-04-05	REVISED POND GRADING ON LOTS 115-112 AND 217-260
6	2024-04-01	UPDATED DATA PROFILE FOR PRELIMINARY DRIVE AND HEAD WAY CONNECTION TO PRELIMINARY DRIVE
7	2024-04-19	10' STORM AND SANITARY RELATED TO REVISED OUTFALL
8	2024-04-29	10' STORM AND SANITARY RELATED TO REVISED OUTFALL

PRESERVE AT JONES DAIRY - CENTRAL CONSTRUCTION DRAWINGS
 ROLESVILLE, NC
DRAINAGE PLAN - CENTRAL

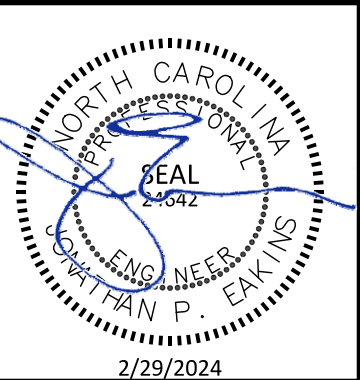

PROJECT NO.:	---
DESIGN BY:	JPE
DRAWN BY:	RSF
SCALE:	1"=50'
DATE:	2023-01-27
SHEET NO.:	C5.2