




The Nau Company
 Consulting Civil Engineers
 PO Box 810, Rolesville, NC 27571
 919-435-6395
 NCBELS License P-0751

CLIENT:
 PRESERVE AT JONES DAIRY, LLC
 10534 ARNOLD PALMER DRIVE
 RALEIGH, NC 27617 919-491-0761

NO.	DATE	REVISIONS
1	2023-03-23	REVISED STORM IN REAR YARDS OF LOTS 200-207 TO FLOW THROUGH FIGHTING BULL DRIVE
2	2023-03-24	REVISED PHASE LINES
3	2023-03-24	REVISED STORM PIPE DATA FROM STORM STRUCTURES LOT TO 200
4	2023-03-28	REVISED POND GRADING AND BEYOND PER TOWN REVIEW
5	2023-05-05	COMMENTS ON STORM DRAINAGE
6	2023-08-01	UPDATED ROAD PROFILE FOR FIGHTING BULL DRIVE AND HEAD WAY CONNECTION TO FIGHTING BULL DRIVE
7	2024-01-19	STORM AND SANITARY RELATED TO REVISED LOT 105, 204, 2
8	2024-02-29	

PRESERVE AT JONES DAIRY - CENTRAL CONSTRUCTION DRAWINGS
 ROLESVILLE, NC
 DRAINAGE PLAN - EAST

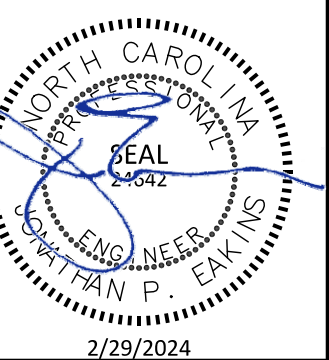

PROJECT NO:	---
DESIGN BY:	JPE
DRAWN BY:	RSF
SCALE:	1"=50'
DATE:	2023-01-27
SHEET NO:	C5.4

1. This stormwater network was updated to reflect changes in the stormwater network.

3. This Pipe was flattened considerably and now the HGL is out of the pipe

5. The Pipe run from structure 318 to 366 does not match the pipe size in the storm calculations. Verify and correct the pipe size and be sure it has adequate cover.

3. This Pipe was flattened considerably and now the HGL is out of the pipe

THIS STORM NETWORK IS PART OF THE AVERETTE ROAD WIDENING CD SUBMITTAL. FINAL STORM STRUCTURE AND PIPE SPECIFICATIONS ARE IN COORDINATION WITH NCDOT AND ARE SUBJECT TO CHANGE FROM WHAT IS SHOWN ON THESE PLANS.

4. All highlighted runs of pipe were updated. Include all updated pipe and structures in the revision cloud. Typ.

4. Fix text overlap.

