


V1 - REZ-24-02

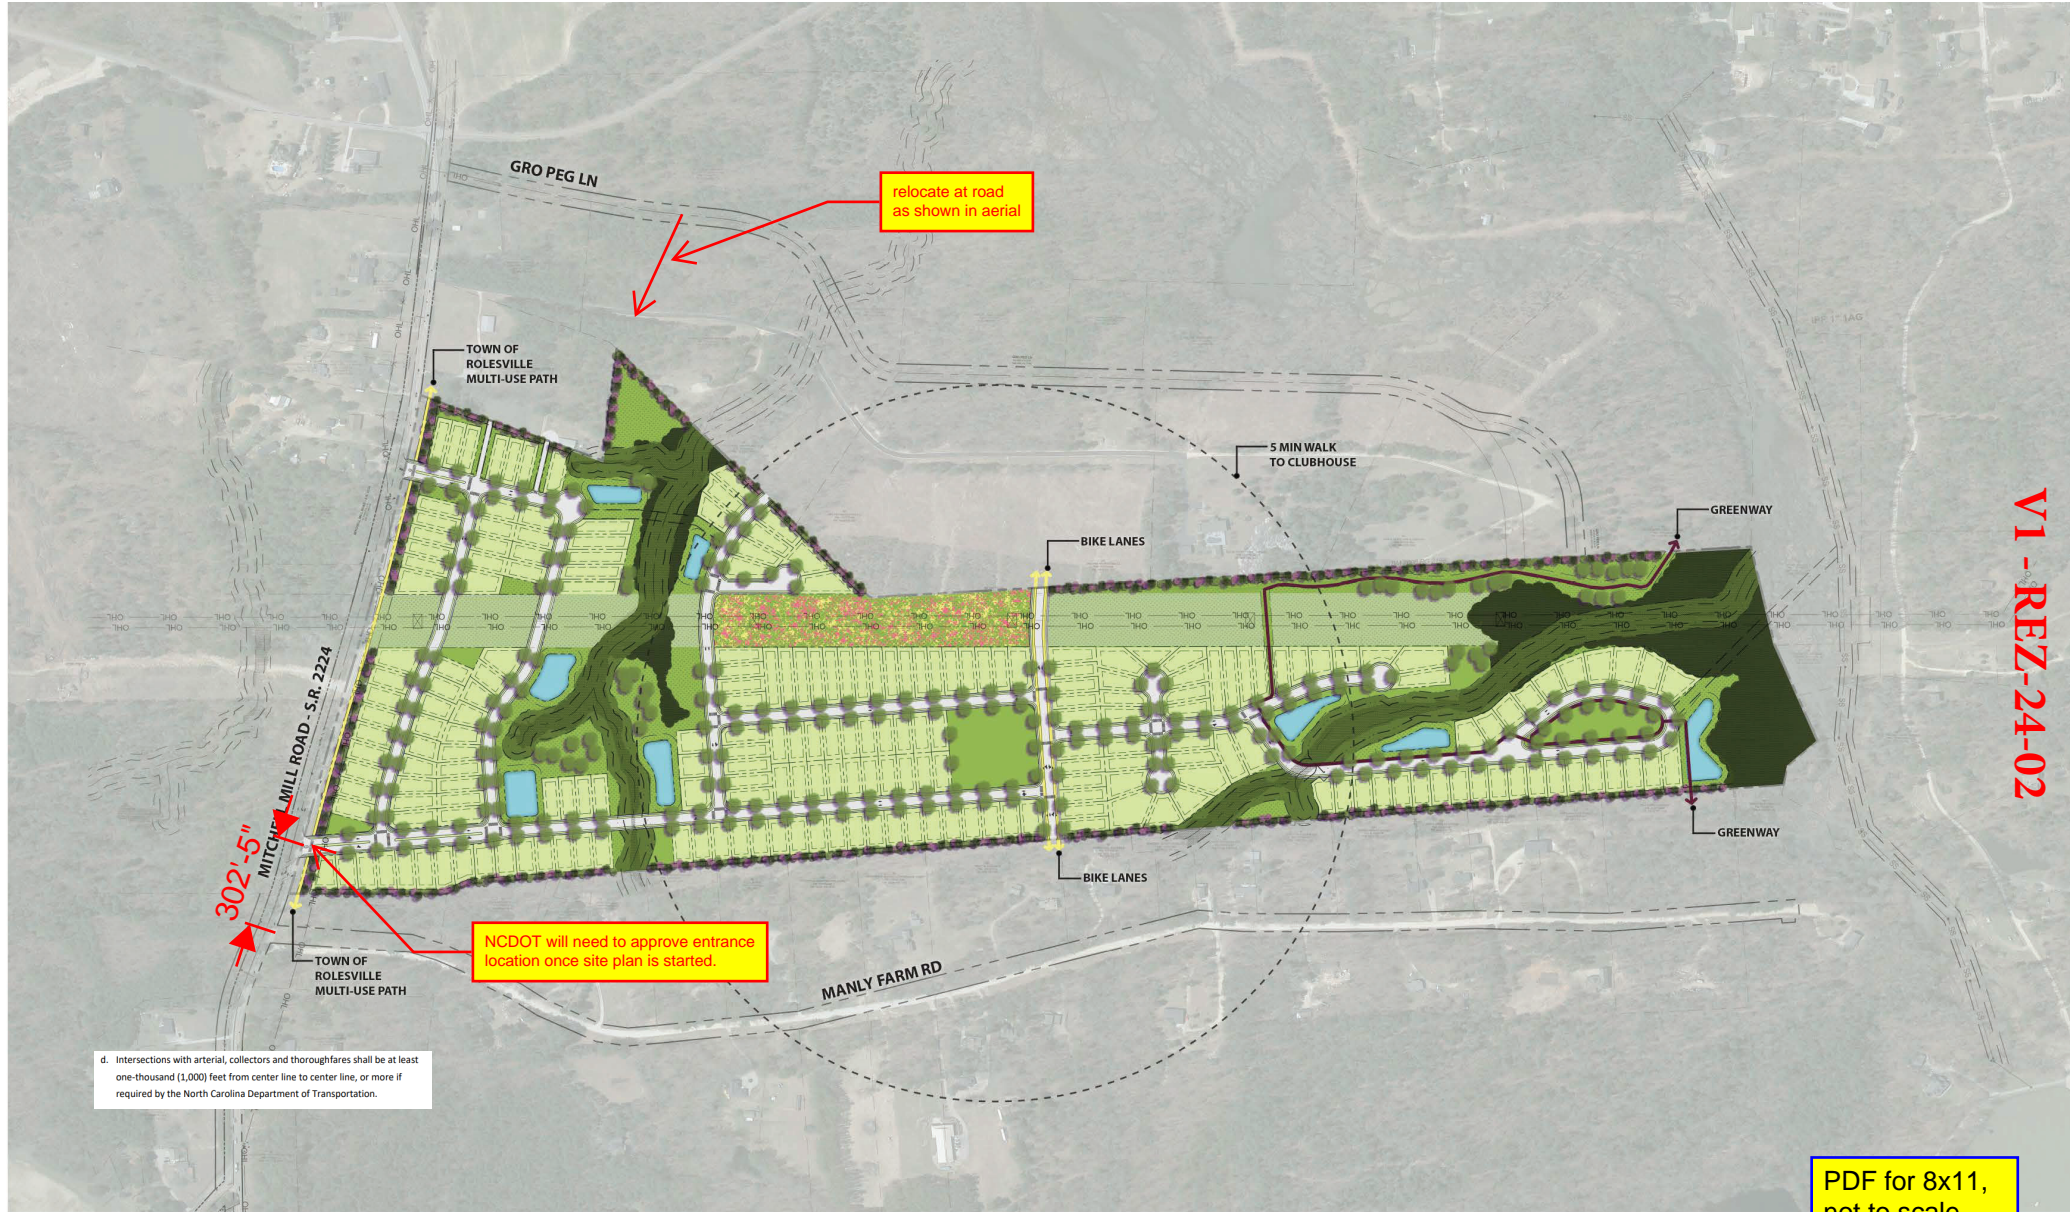

d. Intersections with arterial, collectors and thoroughfares shall be at least one-thousand (1,000) feet from center line to center line, or more if required by the North Carolina Department of Transportation.