

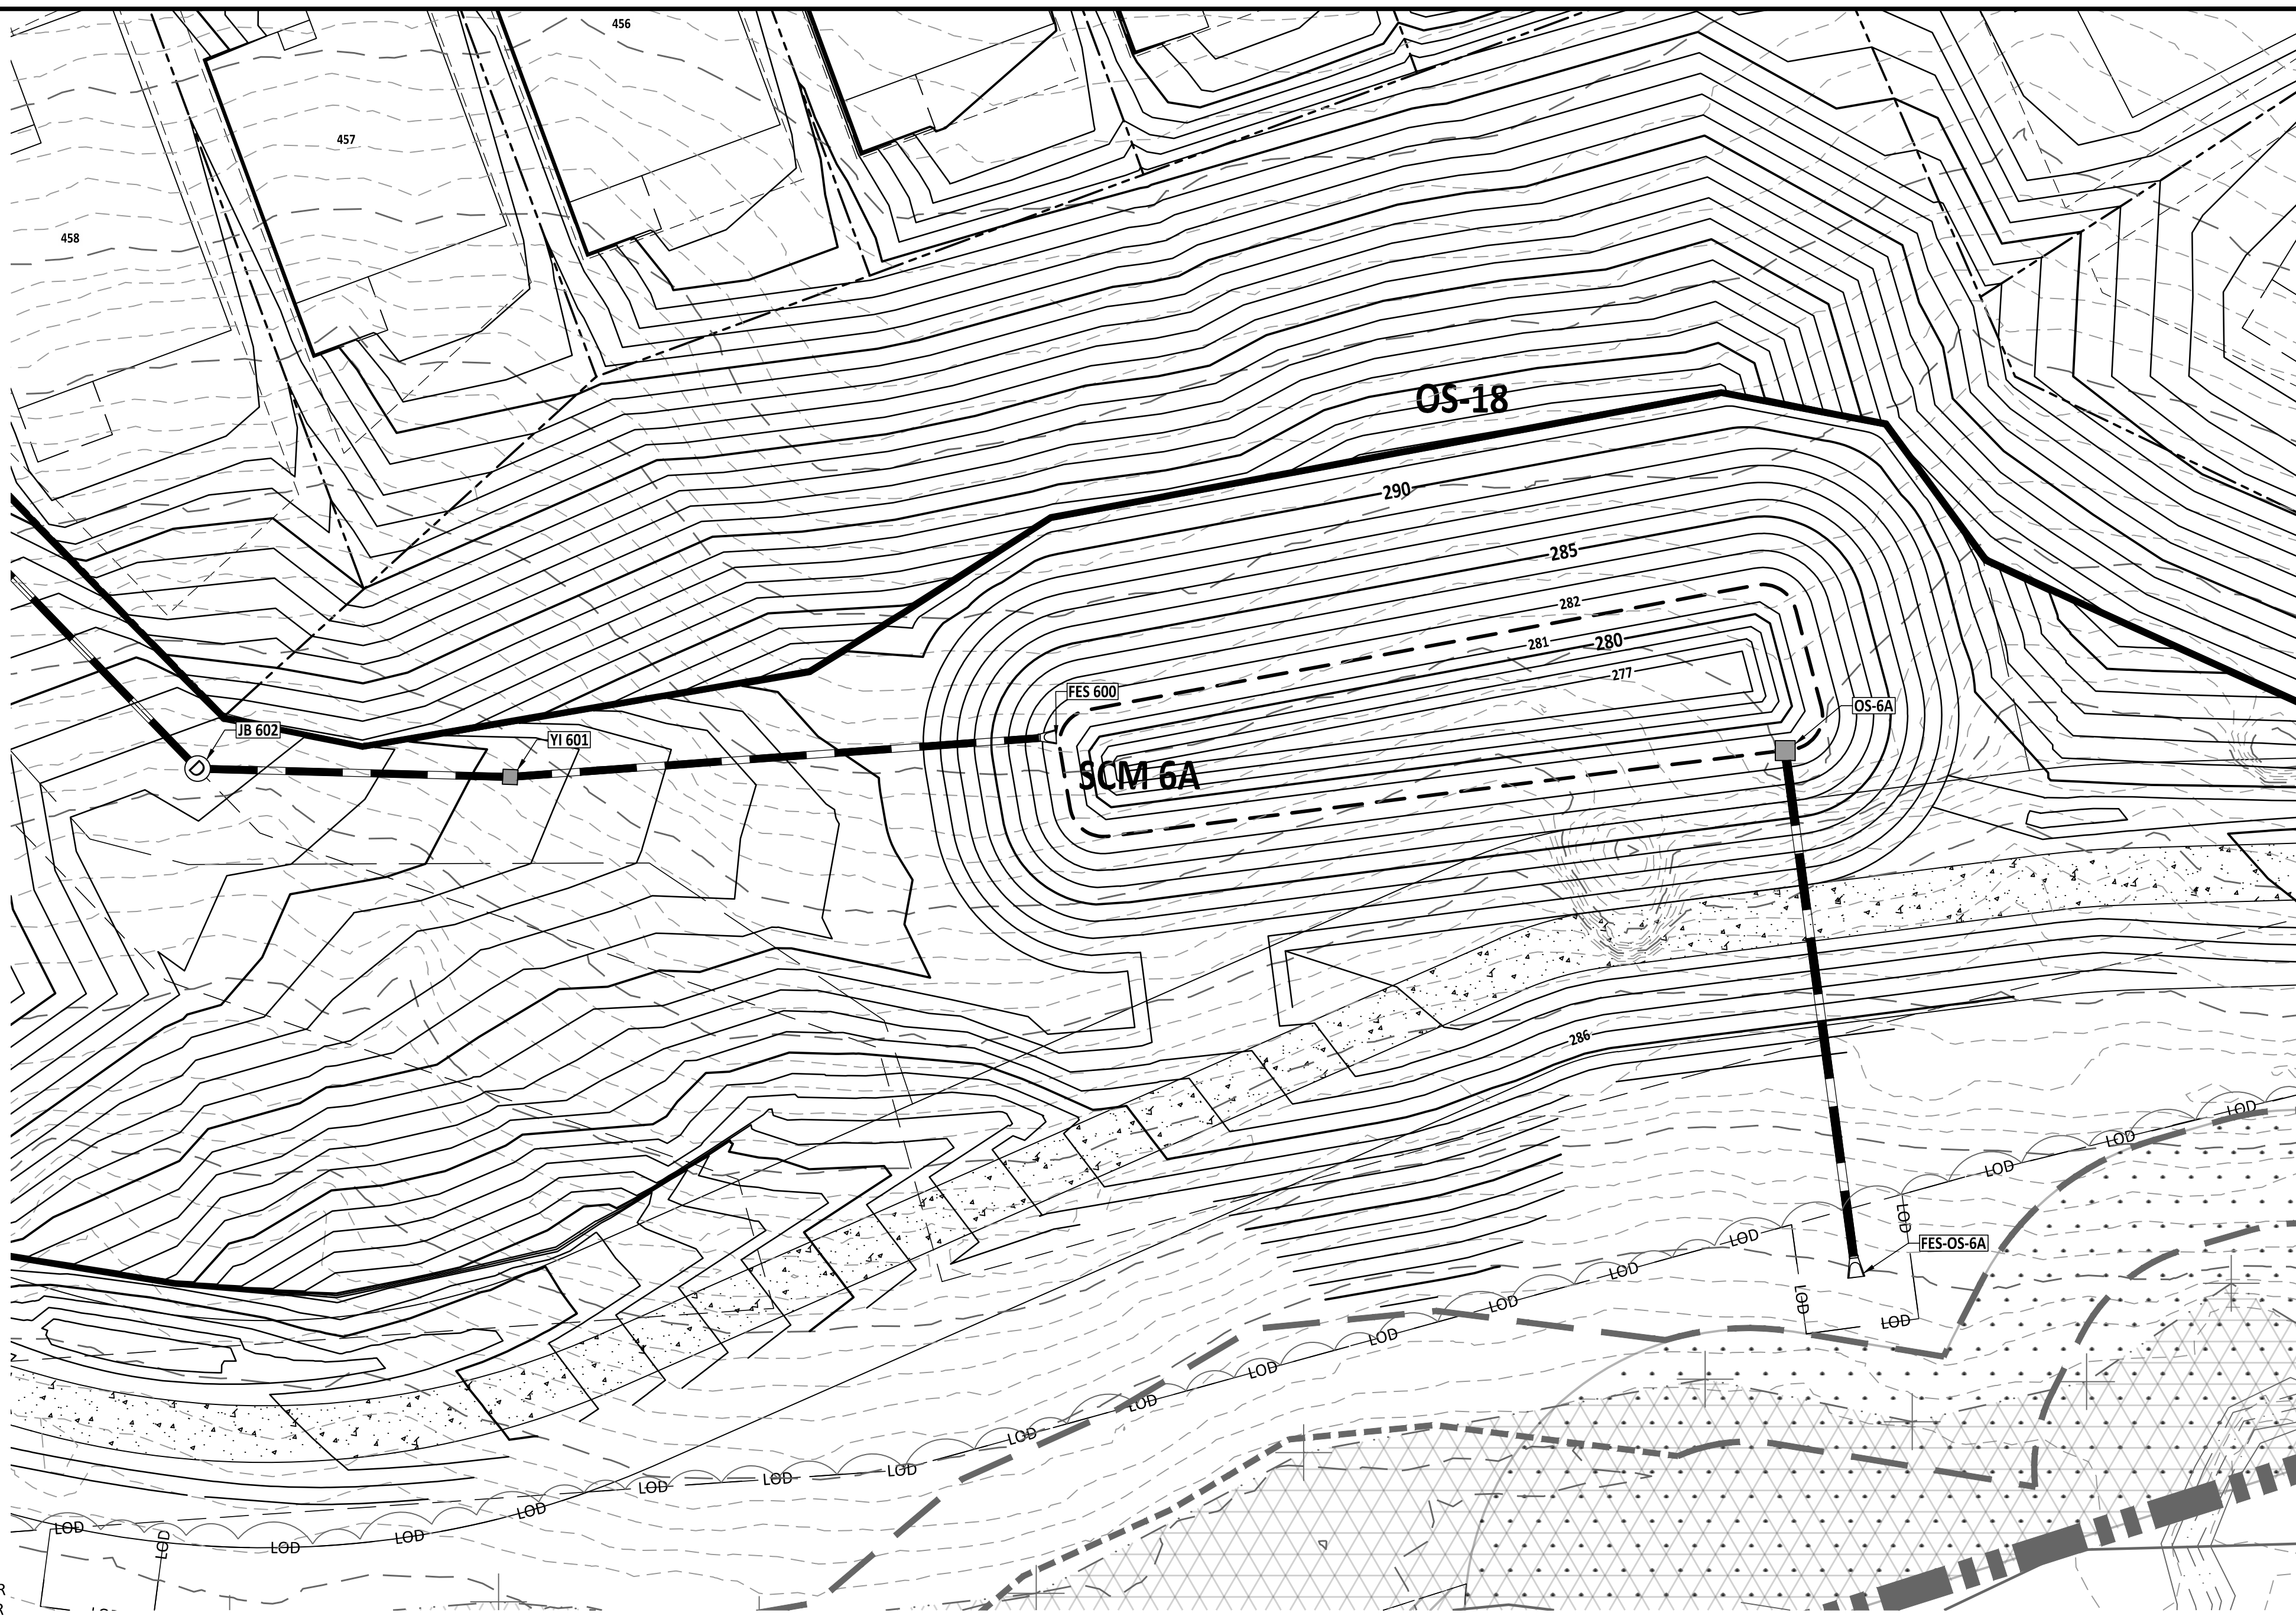
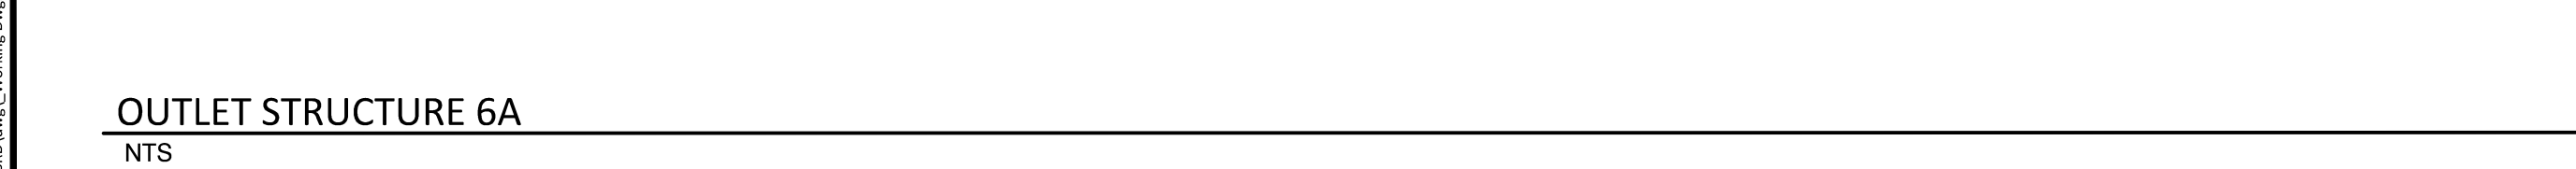
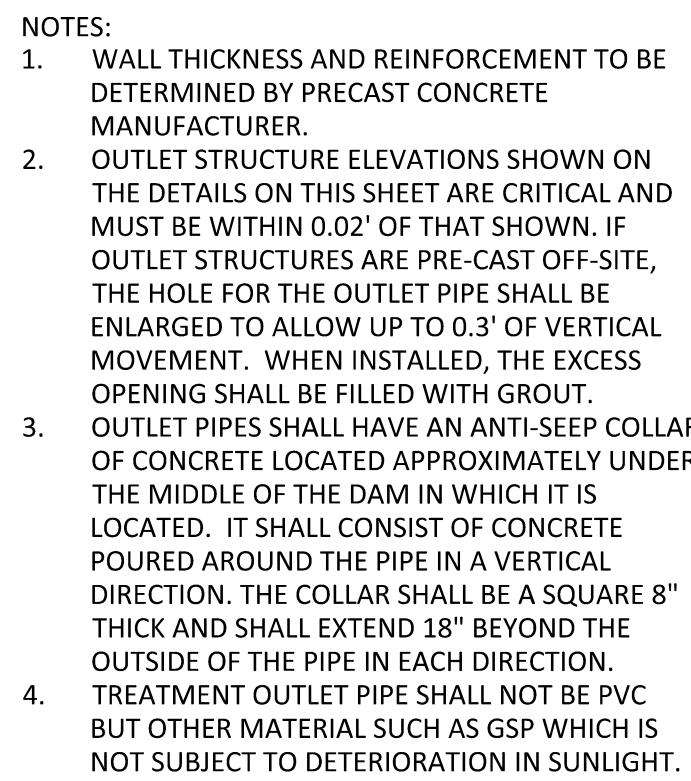


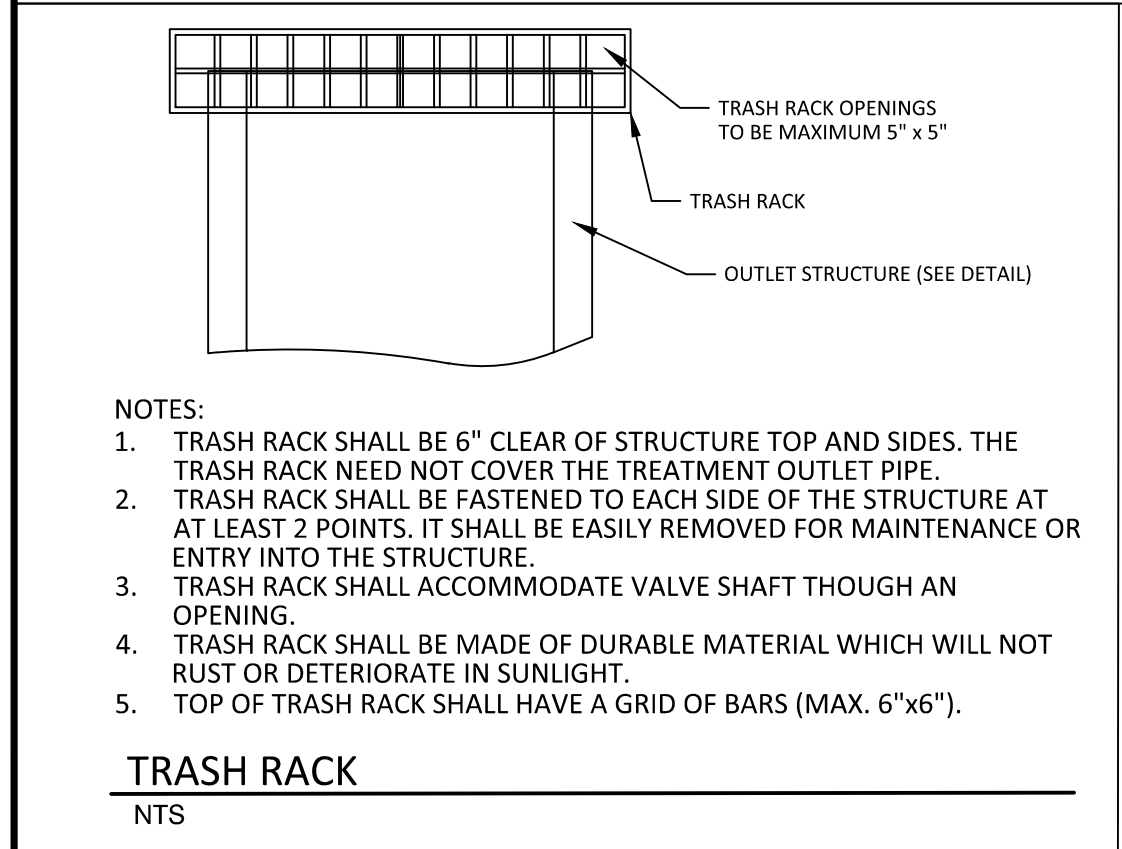


SCM 6A PLAN VIEW

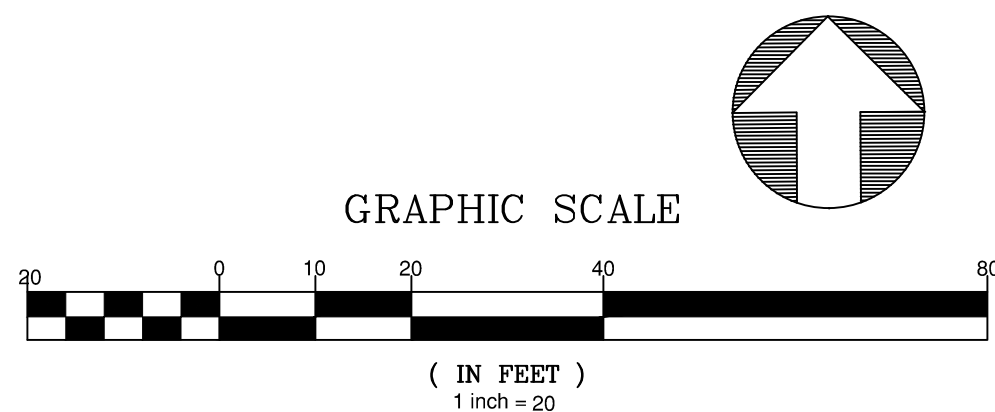

PLANT LIST VEGETATED SHELF PLANT SCHEDULE:			
VEGETATED SHELF (HERB.)			
EF	EUPATORIUM FISTULOSUM	JOE PYE WEED	4-6" POT @ 3' SPACING
HC	HIBISCUS COCCINEA	SCARLET ROSE MALLOW	4-6" POT @ 3' SPACING
CG	CHELONE GLABRA	WHITE TURTLEHEAD	4-6" POT @ 3' SPACING
LC	LOBELIA CARDINALIS	CARDINAL FLOWER	4-6" POT @ 3' SPACING

LANDSCAPE PLAN:
VEGETATED SHELF= 3172 sf (USE 793 PLANTS FROM LIST ABOVE)
USE EQUAL NUMBER OF PLANTS FROM LIST ABOVE

CALCULATION: 50 PLANTS PER 200 SF

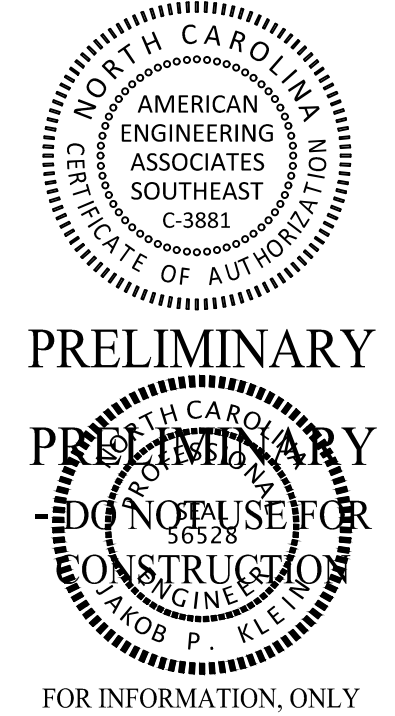[illegible]

STIPULATION FOR REUSE

THIS DRAWING WAS PREPARED FOR USE ON THE SPECIFIC SITE, NAMED HEREON, CONTEMPORANEOUSLY WITH ITS ISSUE DATE AS LISTED, HEREON, AND IT IS NOT SUITABLE FOR USE ON A DIFFERENT PROJECT SITE OR AT A LATER TIME. USE OF THIS DRAWING FOR REFERENCE OR EXAMPLE ON ANOTHER PROJECT REQUIRES THE SERVICES OF PROPERLY LICENSED ARCHITECTS AND ENGINEERS. REPRODUCTION OF THIS DRAWING FOR REUSE ON ANOTHER PROJECT IS NOT AUTHORIZED AND MAY BE CONTRARY TO THE LAW.







SCM 6A DETAIL
ROLESVILLE RD
WAKE COUNTY NC 27312

JOB NUMBER:	23-0004
CHECKED BY:	BI
DRAWN BY:	DH/RC/SM/GE/MA/LL/JH
DATE:	05/01/2023
SHEET TITLE:	

SCM 6A DETAIL

SHEET NO.:
CG-409

Z:\shelby\23-0004 Merritt Property\8807.dwg, Working Drawn(Sheet)Construction Set(US), CG, 407 SCM 6B-7 Detail.dwg
23-05-01

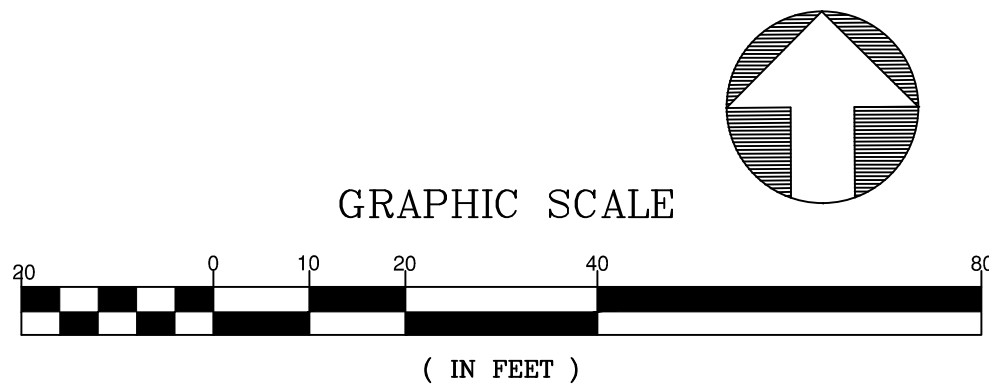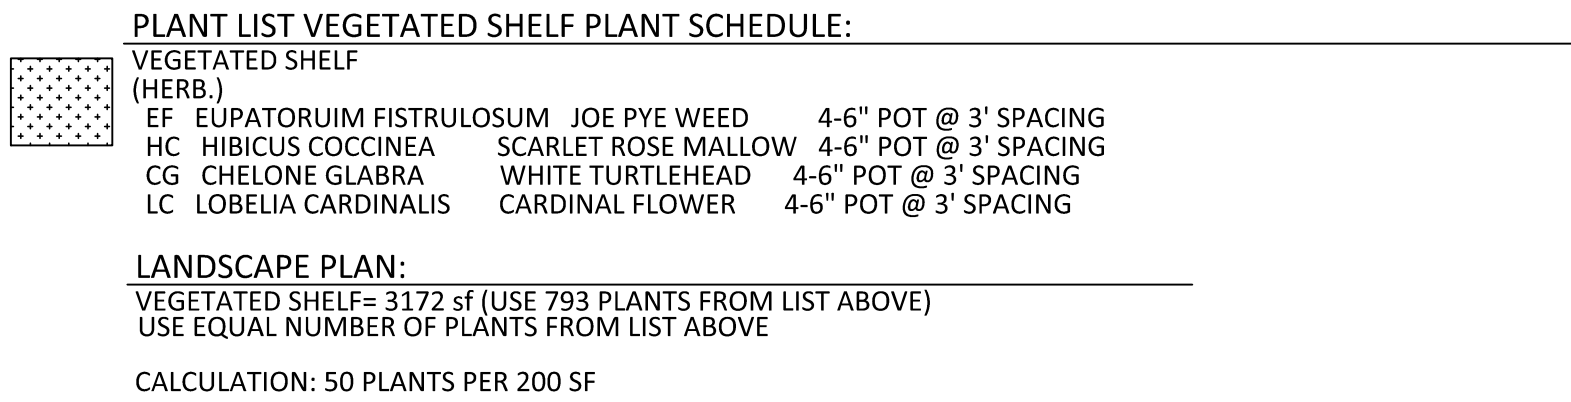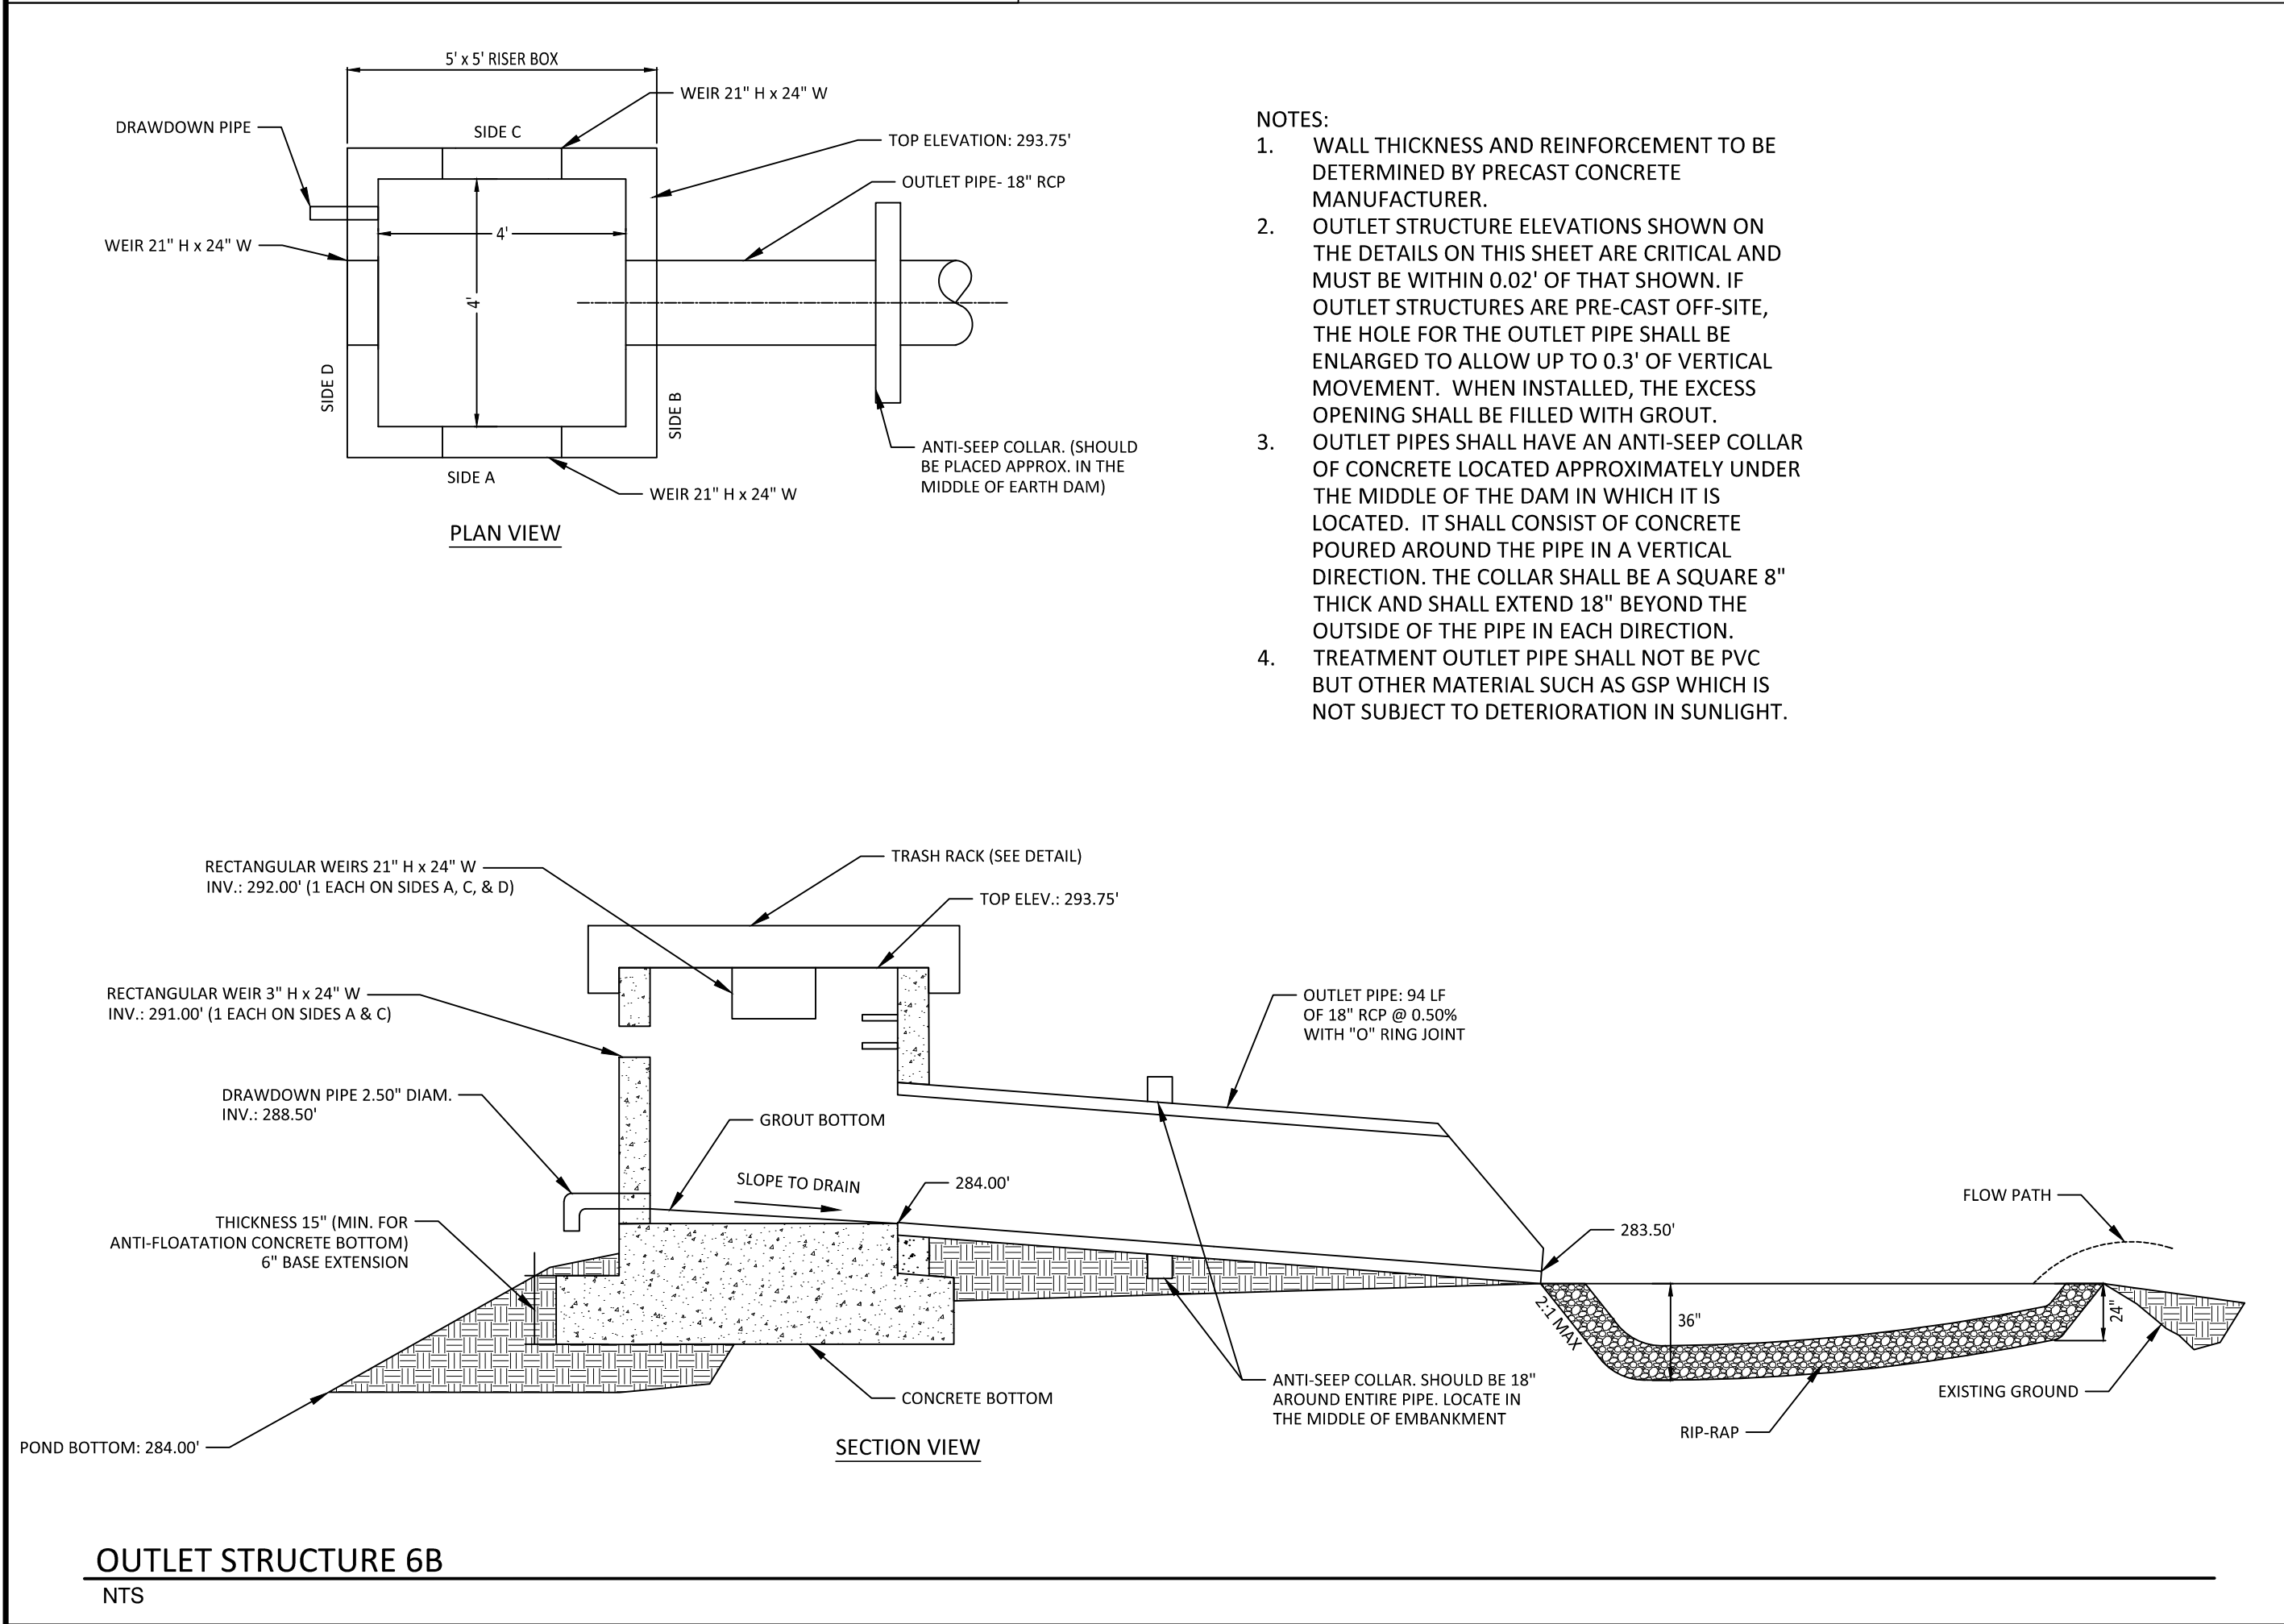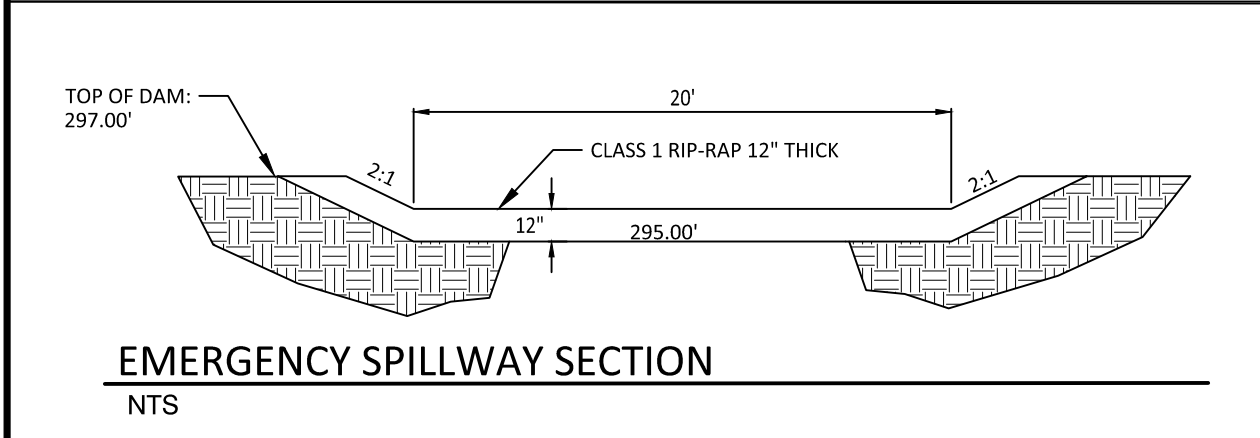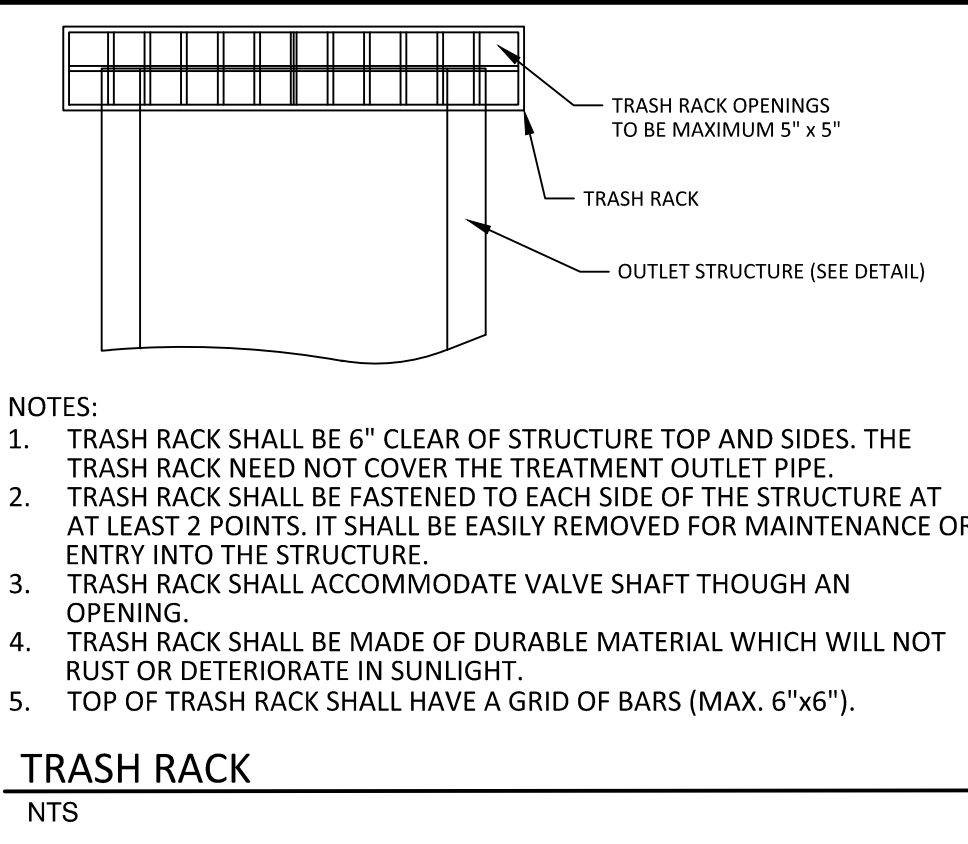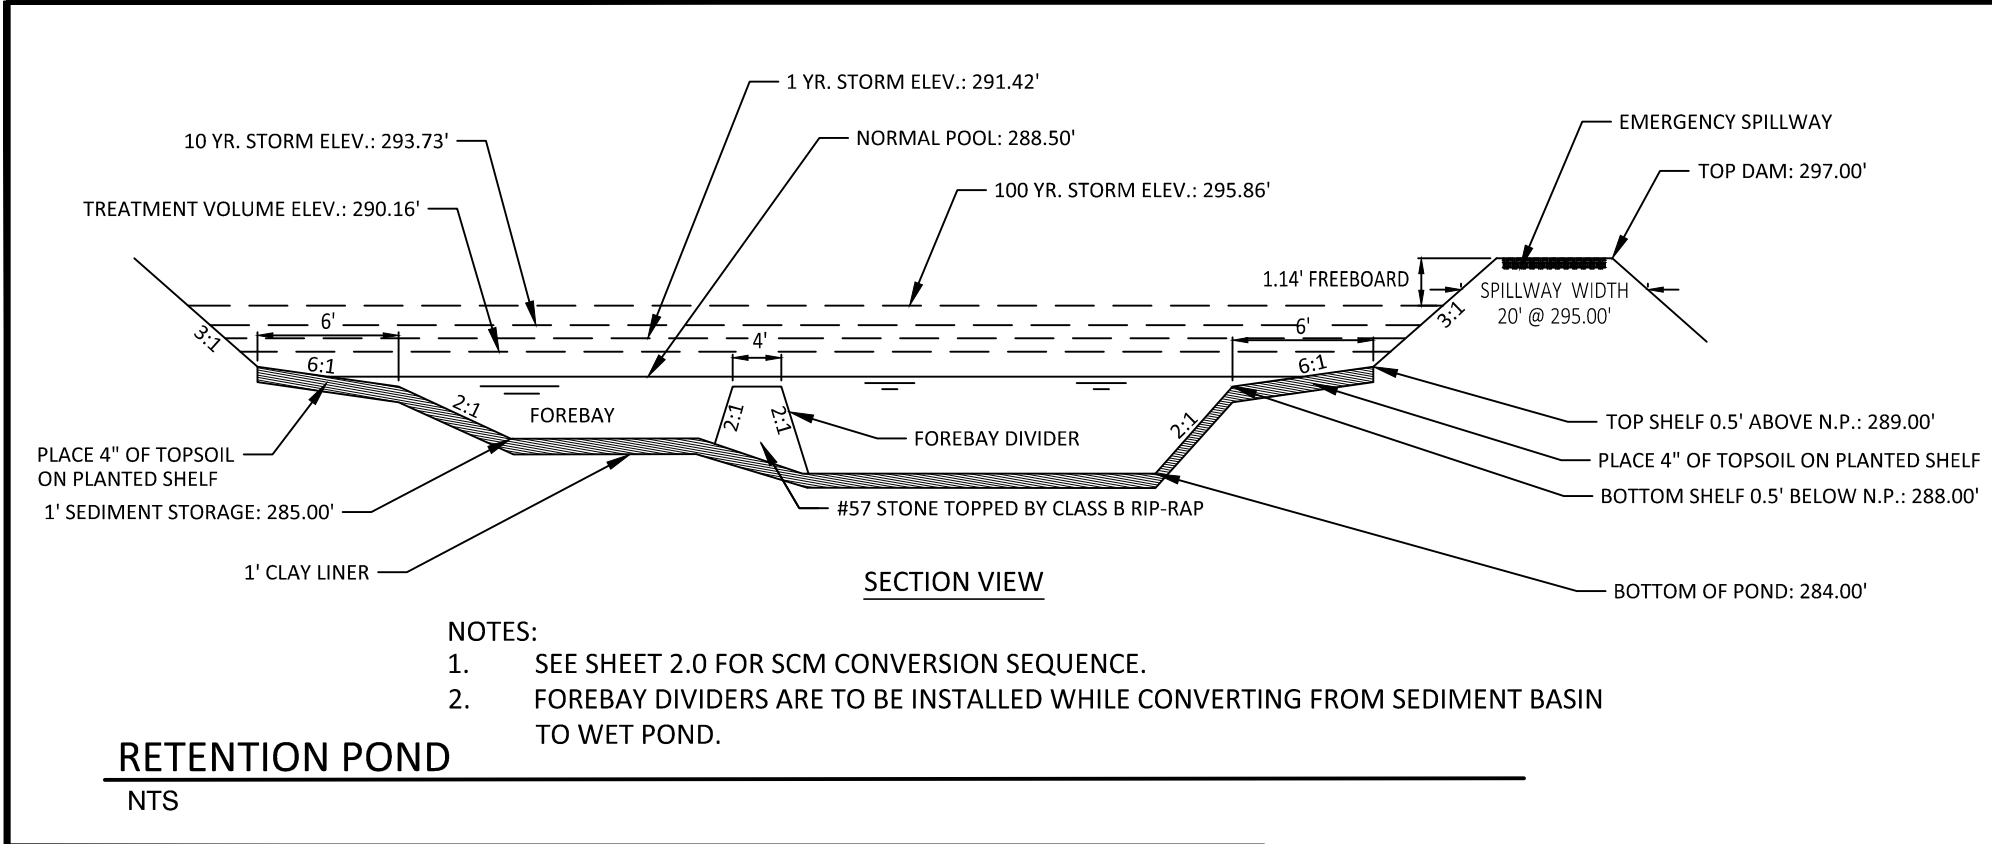

PRELIMINARY
PRELIMINARY
DO NOT USE FOR
CONSTRUCTION
FOR INFORMATION, ONLY

NO.	DATE	REVISION




STIPULATION FOR REUSE
THIS DRAWING WAS PREPARED FOR USE ON THE SPECIFIC SITE, NAMED HEREON, CONTEMPORANEOUSLY WITH ITS ISSUE DATE AS LISTED, HEREON, AND IT IS NOT SUITABLE FOR USE ON A DIFFERENT PROJECT SITE OR AT A LATER TIME. USE OF THIS DRAWING FOR REFERENCE OR EXAMPLE ON ANOTHER PROJECT REQUIRES THE SERVICES OF PROPERLY LICENSED ARCHITECTS AND ENGINEERS. REPRODUCTION OF THIS DRAWING FOR REUSE ON ANOTHER PROJECT IS NOT AUTHORIZED AND MAY BE CONTRARY TO THE LAW.

MERRITT RESERVE
SCM 6B DETAIL
ROLESVILLE RD
WAKE COUNTY NC 27312

JOB NUMBER: 23-0004
CHECKED BY: BH
DRAWN BY: DH/RC/SM/GE/MA/LL/JB
DATE: 05/01/2025
SHEET TITLE:

SCM 6B DETAIL


SHEET NO.:
CG-410

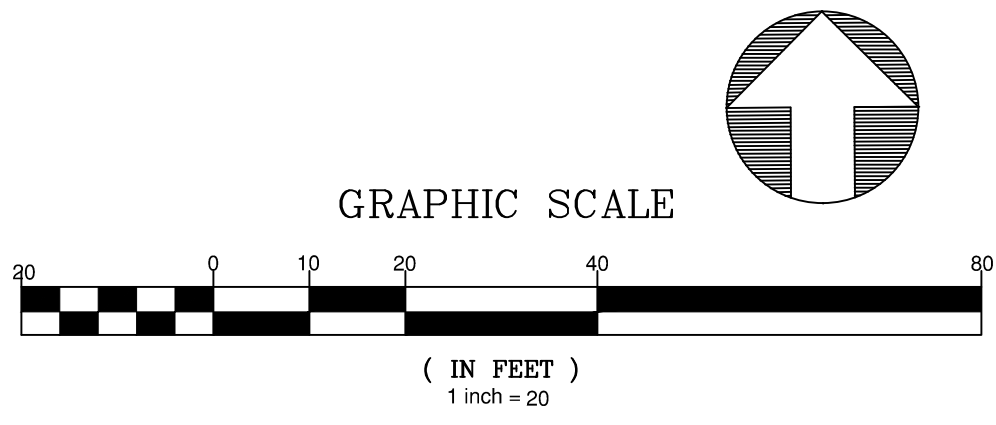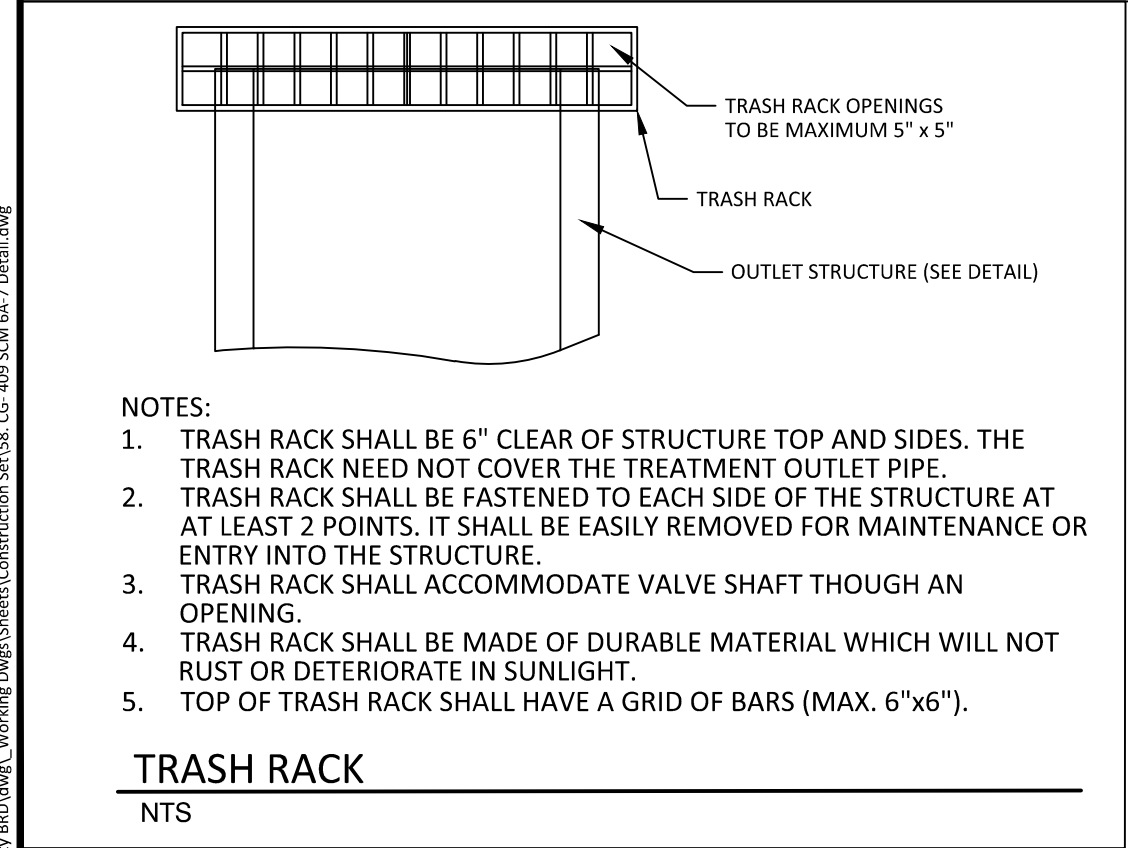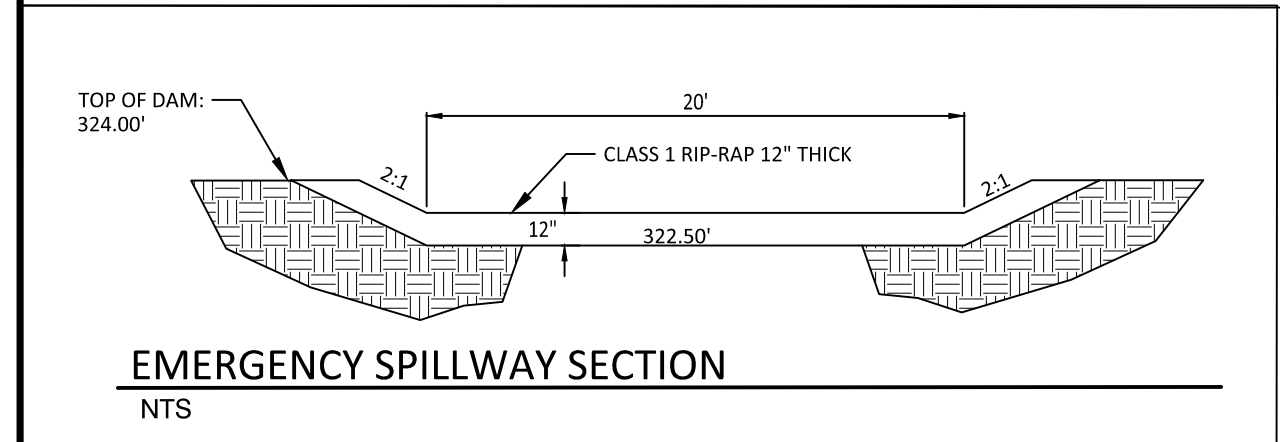

PLANT LIST VEGETATED SHELF PLANT SCHEDULE:			
VEGETATED SHELF (HERB.)			
EF	EUPATORIUM FISTULOSUM	JOE PYE WEED	4-6" POT @ 3' SPACING
HC	HIBISCUS COCCINEA	SCARLET ROSE MALLOW	4-6" POT @ 3' SPACING
CG	CHELONE GLABRA	WHITE TURTLEHEAD	4-6" POT @ 3' SPACING
LC	LOBELIA CARDINALIS	CARDINAL FLOWER	4-6" POT @ 3' SPACING

LANDSCAPE PLAN:
VEGETATED SHELF= 3172 sf (USE 793 PLANTS FROM LIST ABOVE)
USE EQUAL NUMBER OF PLANTS FROM LIST ABOVE

CALCULATION: 50 PLANTS PER 200 SF

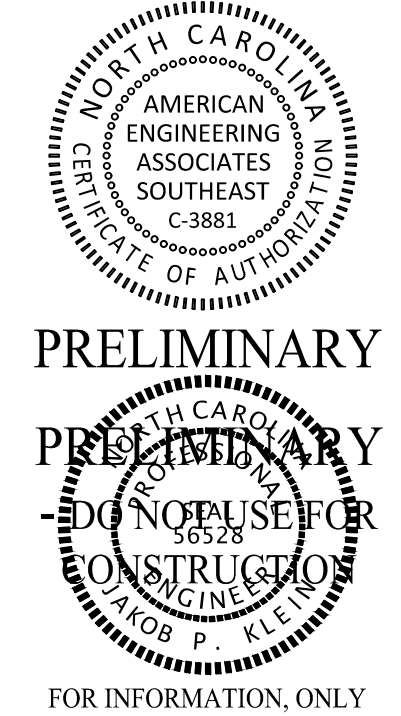[illegible]

STIPULATION FOR REUSE

THIS DRAWING WAS PREPARED FOR USE ON THE SPECIFIC SITE, NAMED HEREON, CONTEMPORANEOUSLY WITH ITS ISSUE DATE AS LISTED, HEREON, AND IT IS NOT SUITABLE FOR USE ON A DIFFERENT PROJECT SITE OR AT A LATER TIME. USE OF THIS DRAWING FOR REFERENCE OR EXAMPLE ON ANOTHER PROJECT REQUIRES THE SERVICES OF PROPERLY LICENSED ARCHITECTS AND ENGINEERS. REPRODUCTION OF THIS DRAWING FOR REUSE ON ANOTHER PROJECT IS NOT AUTHORIZED AND MAY BE CONTRARY TO THE LAW.




MERRITT RESERVE
CG411_SCM 7
DETAIL
ROLESVILLE RD
WAKE COUNTY NC 27312

JOB NUMBER:	23-0004
CHECKED BY:	BH
DRAWN BY:	DH/RC/SM/GE/MA/LL/JB
DATE:	05/01/2025
SHEET TITLE:	

**CG411_SCM 7
DETAIL**

SHEET NO.:



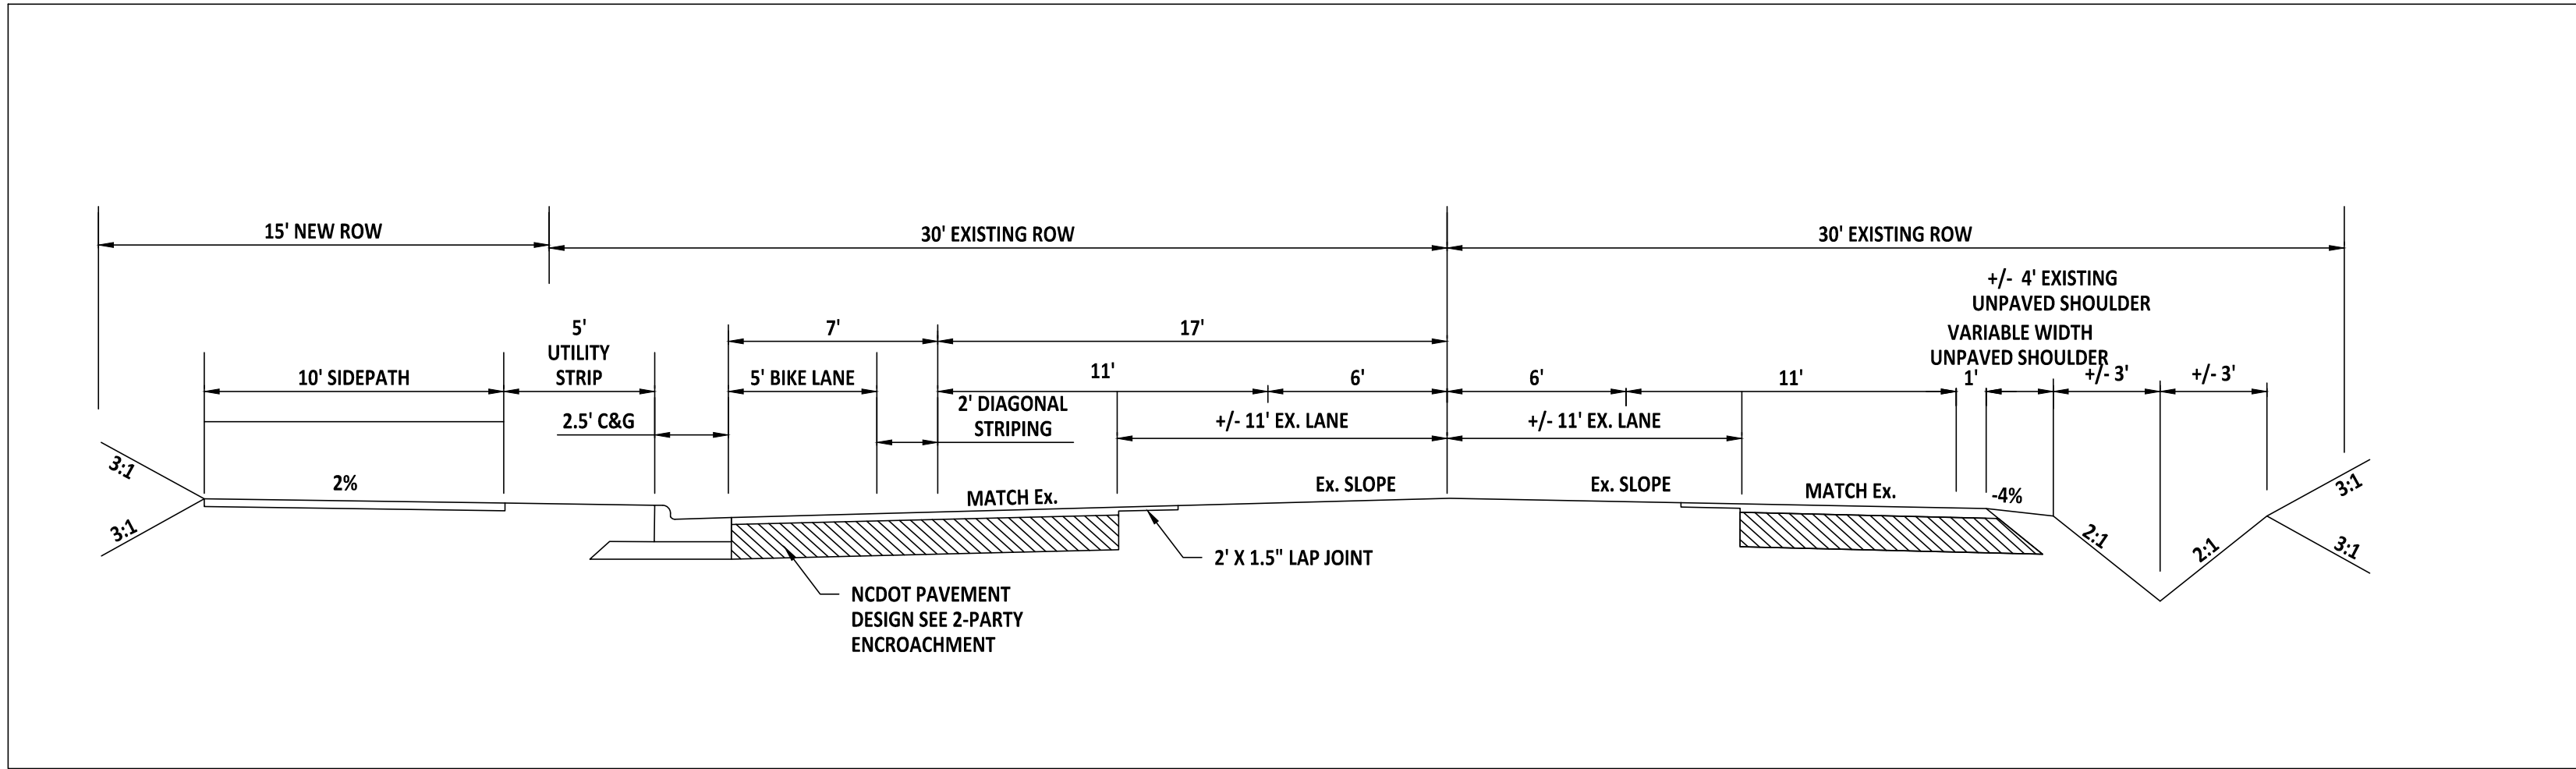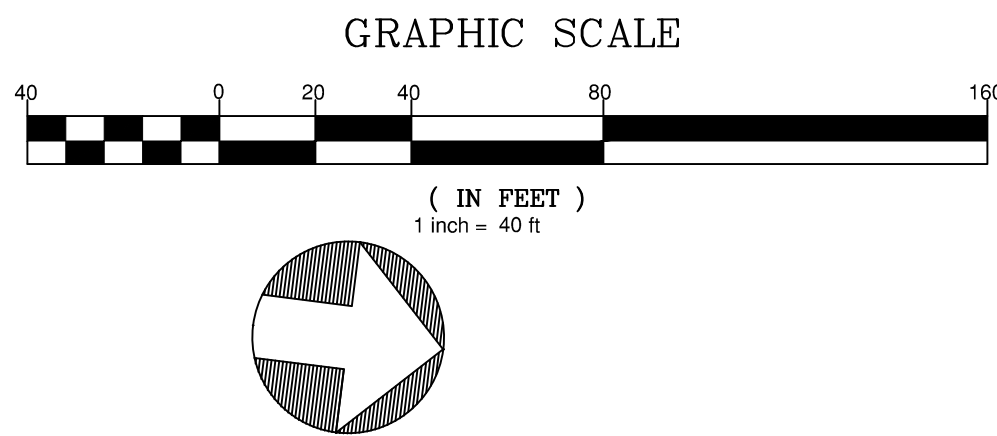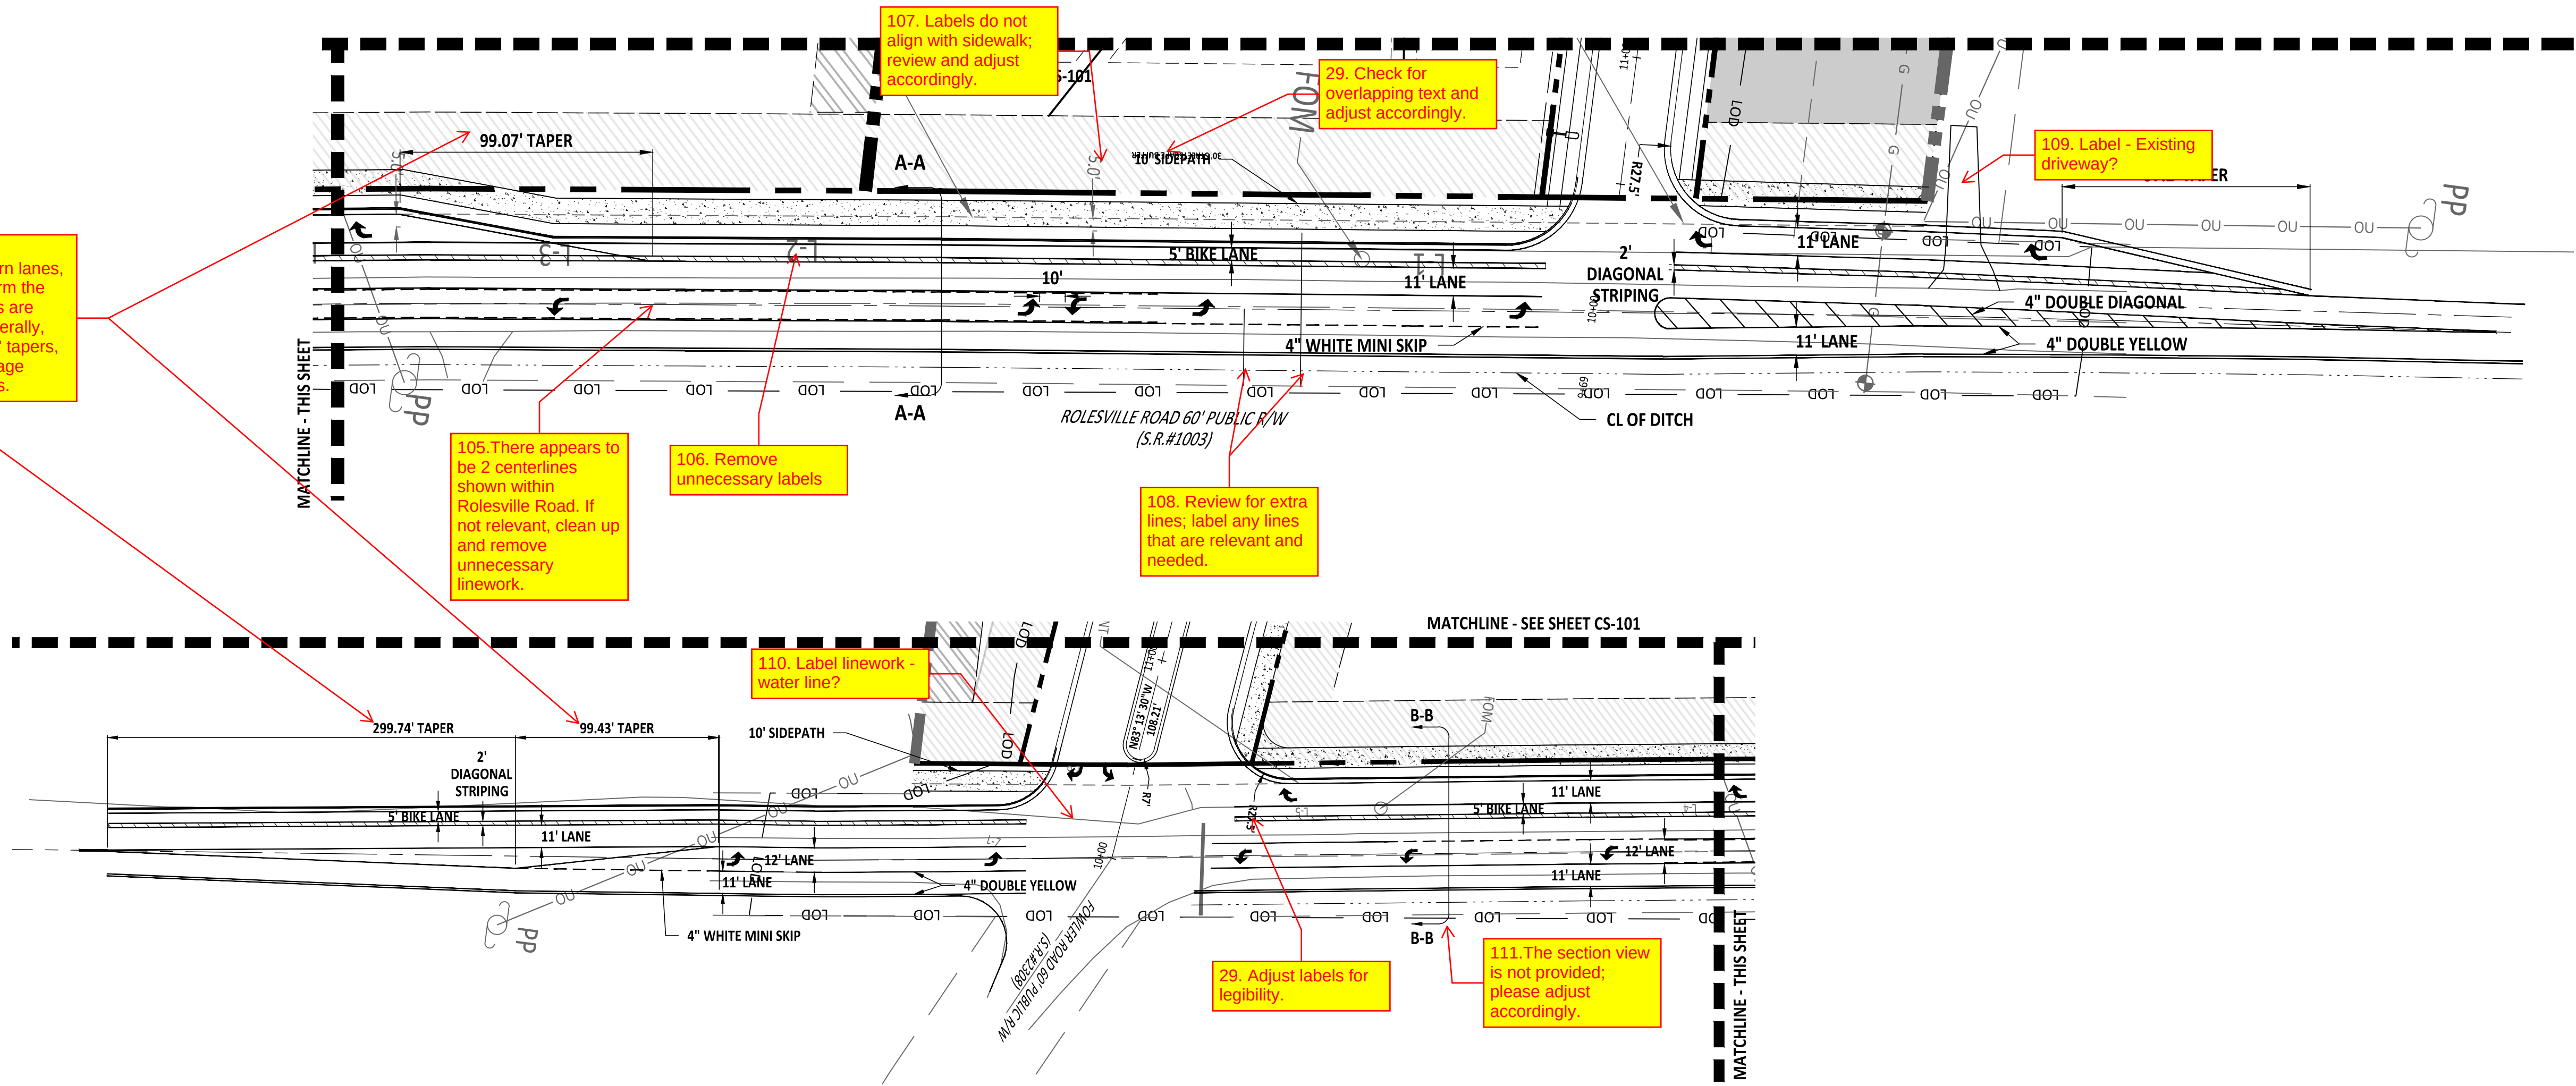

ROLESVILLE ROAD TYPICAL
SECTION A-A
NTS

112. Consider renaming to a more clarifying sheet title like "Rolesville Road Striping Plan"

Is there a reason the striping plan is coming first / before the existing conditions and proposed improvements?

NO.	DATE	REVISION	DESCRIPTION
1	02-03-25	FIRST REVISION SET	

STIPULATION FOR REUSE
THIS DRAWING WAS PREPARED FOR USE ON THE SPECIFIC SITE, NAMED HEREON, CONTEMPORANEOUSLY WITH ITS ISSUE DATE AS LISTED, HEREON, AND IT IS NOT SUITABLE FOR USE ON A DIFFERENT PROJECT SITE OR AT A LATER TIME. USE OF THIS DRAWING FOR REFERENCE OR EXAMPLE ON ANOTHER PROJECT REQUIRES THE SERVICES OF PROPERLY LICENSED ARCHITECTS AND ENGINEERS. REPRODUCTION OF THIS DRAWING FOR REUSE ON ANOTHER PROJECT IS NOT AUTHORIZED AND MAY BE CONTRARY TO THE LAW.

MERRITT RESERVE
CT-300
-STRIPING
PLAN
ROLESVILLE RD
WAKE COUNTY NC 27312

JOB NUMBER: 23-0004
CHECKED BY: BH
DRAWN BY: DH/RC/SM/GE/MA/LL/JB
DATE: 05/01/2025

SHEET TITLE:
CT-300
-STRIPING
PLAN

SHEET NO.:


PRELIMINARY
DO NOT USE FOR

FOR INFORMATION, ONLY

[illegible]

THIS DRAWING WAS PREPARED FOR USE ON THE SPECIFIC SITE, NAMED HEREON CONTEMPORANEOUSLY WITH ITS ISSUANCE DATE AS LISTED, HEREON. AND IT IS NOT SUITABLE FOR USE ON A DIFFERENT PROJECT SITE OR AT A LATER TIME. USE OF THIS DRAWING FOR REFERENCE OR EXAMPLE ON ANOTHER PROJECT REQUIRES THE SERVICES OF PROPERLY LICENSED ARCHITECTS AND ENGINEERS. REPRODUCTION OF THIS DRAWING FOR REUSE ON ANOTHER PROJECT IS NOT AUTHORIZED AND MAY BE CONTRARY TO THE LAW.


SHEET NO.:

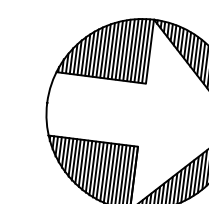




115. Label existing and proposed water line size and material.

PROJECT NUMBER = PSP-24-07




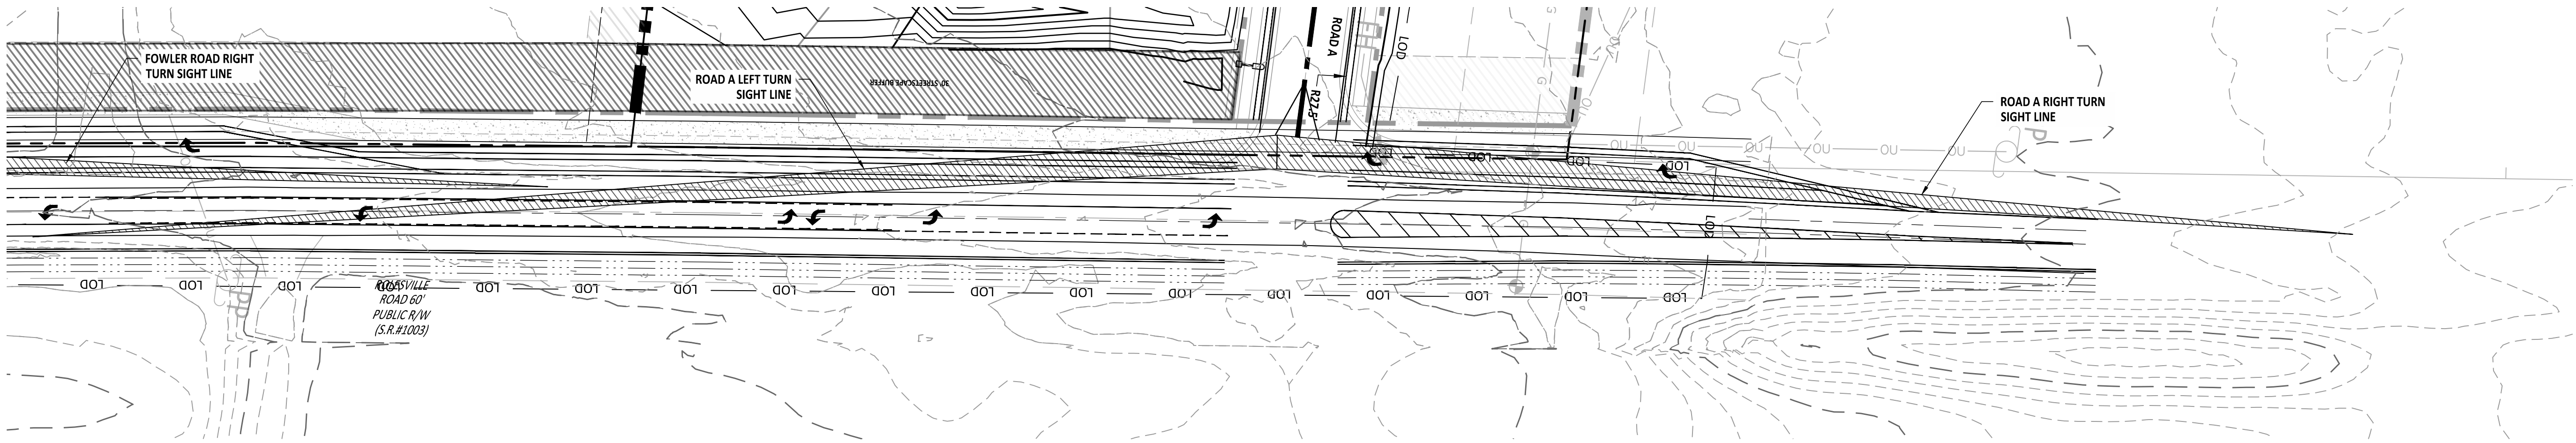

ROAD A & ROLESVILLE RD INTERSECTION SIGHT LINE PLAN

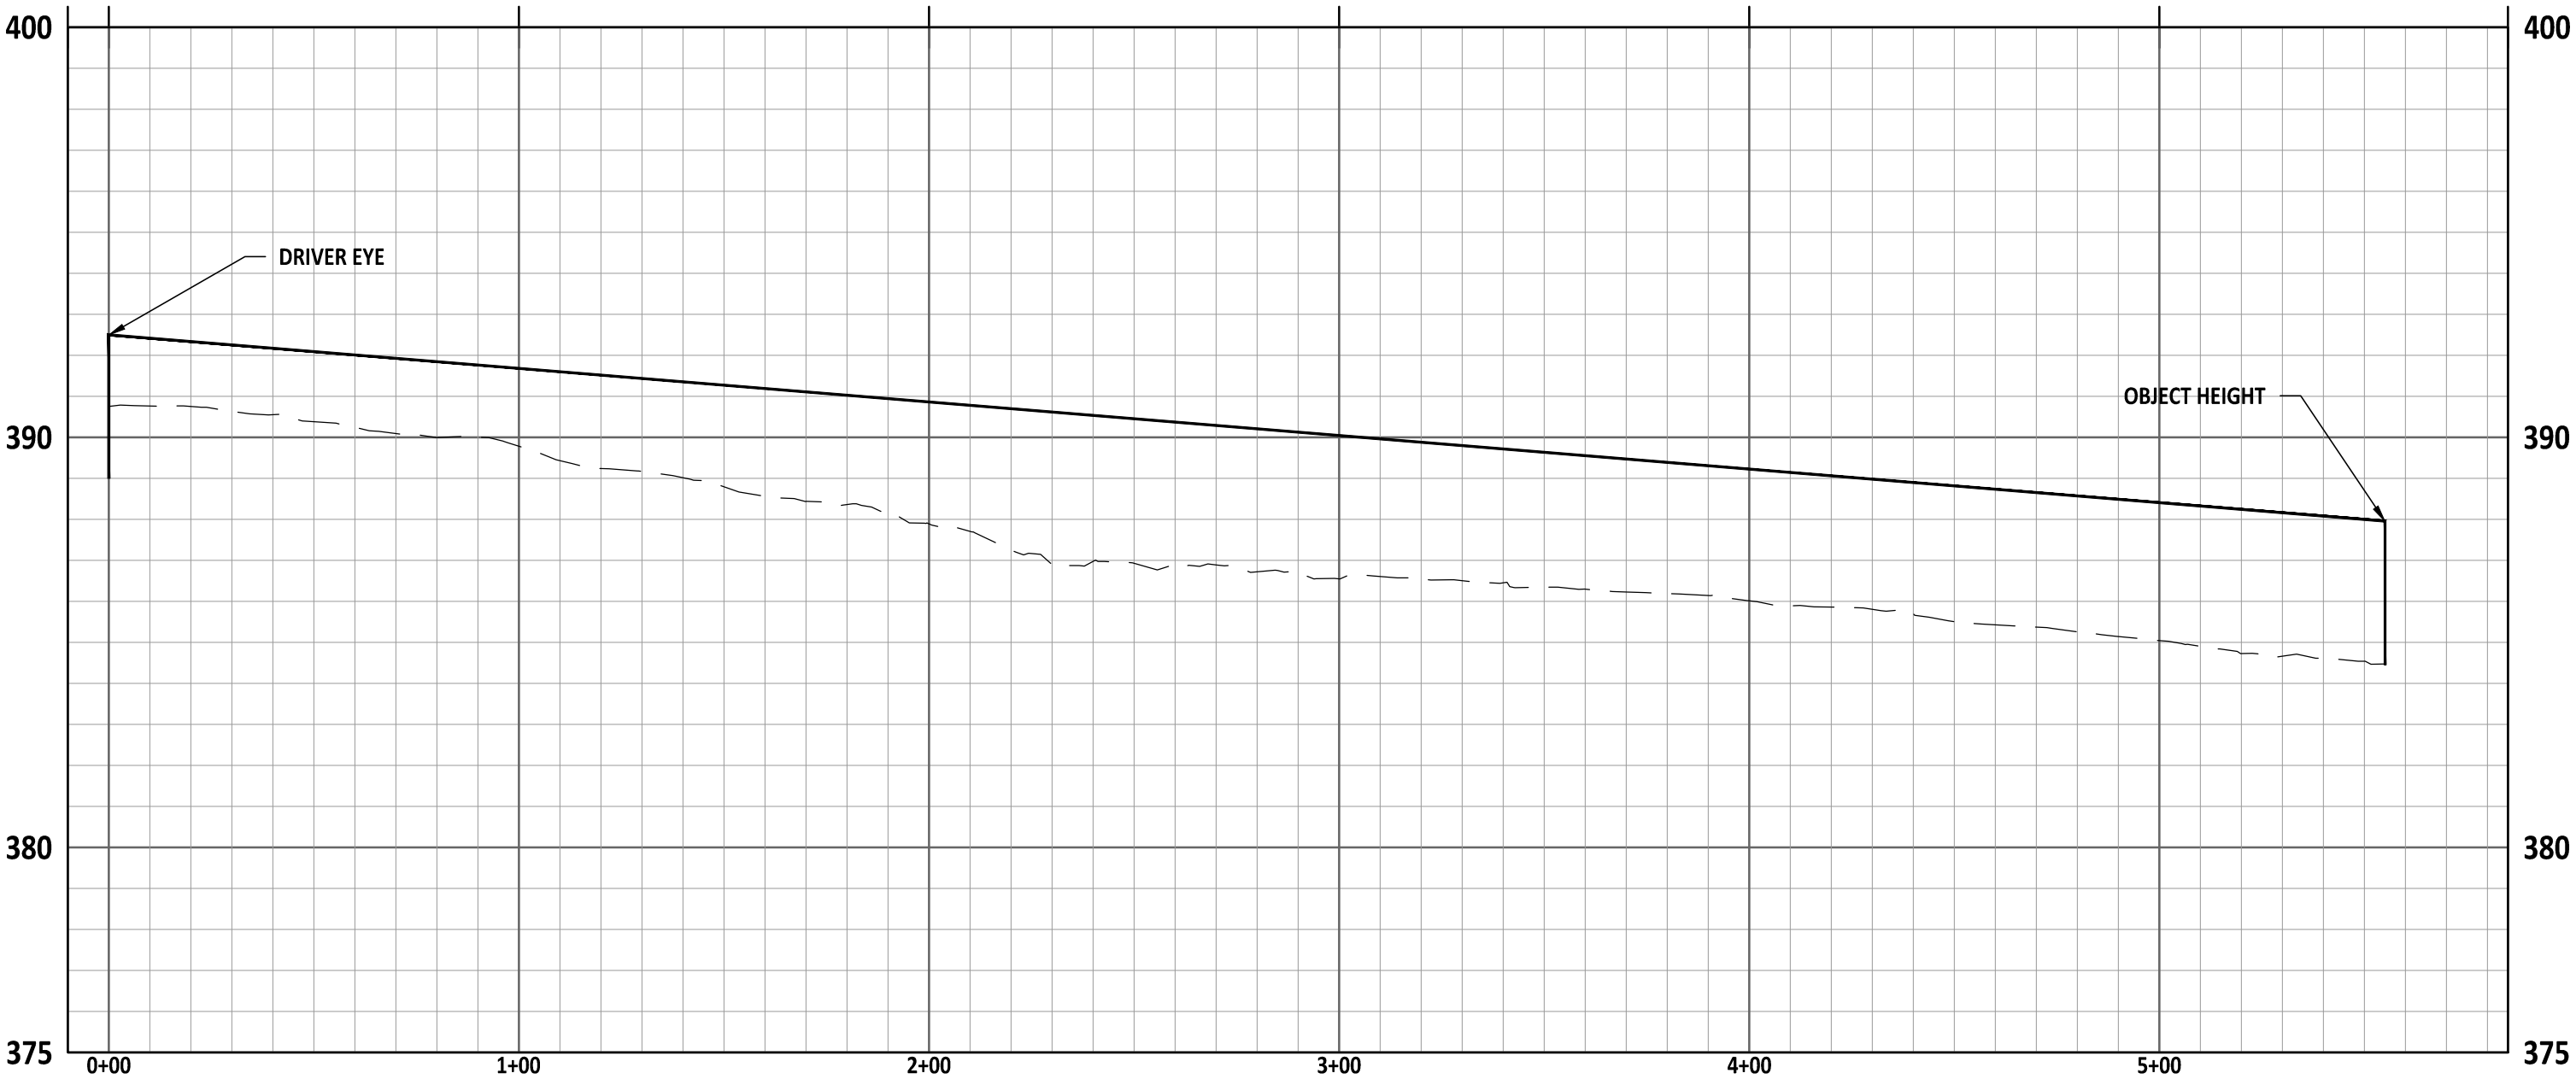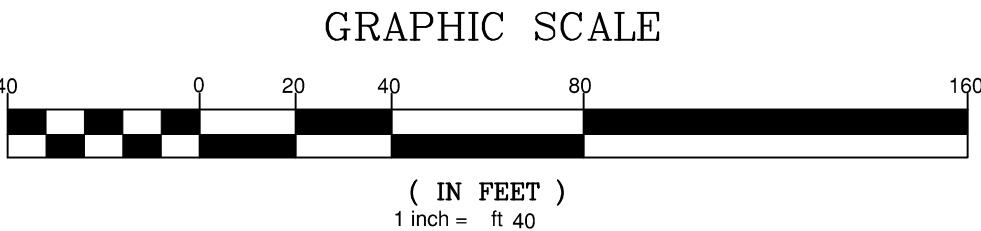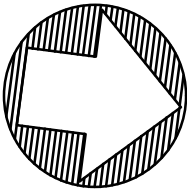

ROAD A LEFT TURN LOOKING RIGHT SIGHT LINE PROFILE

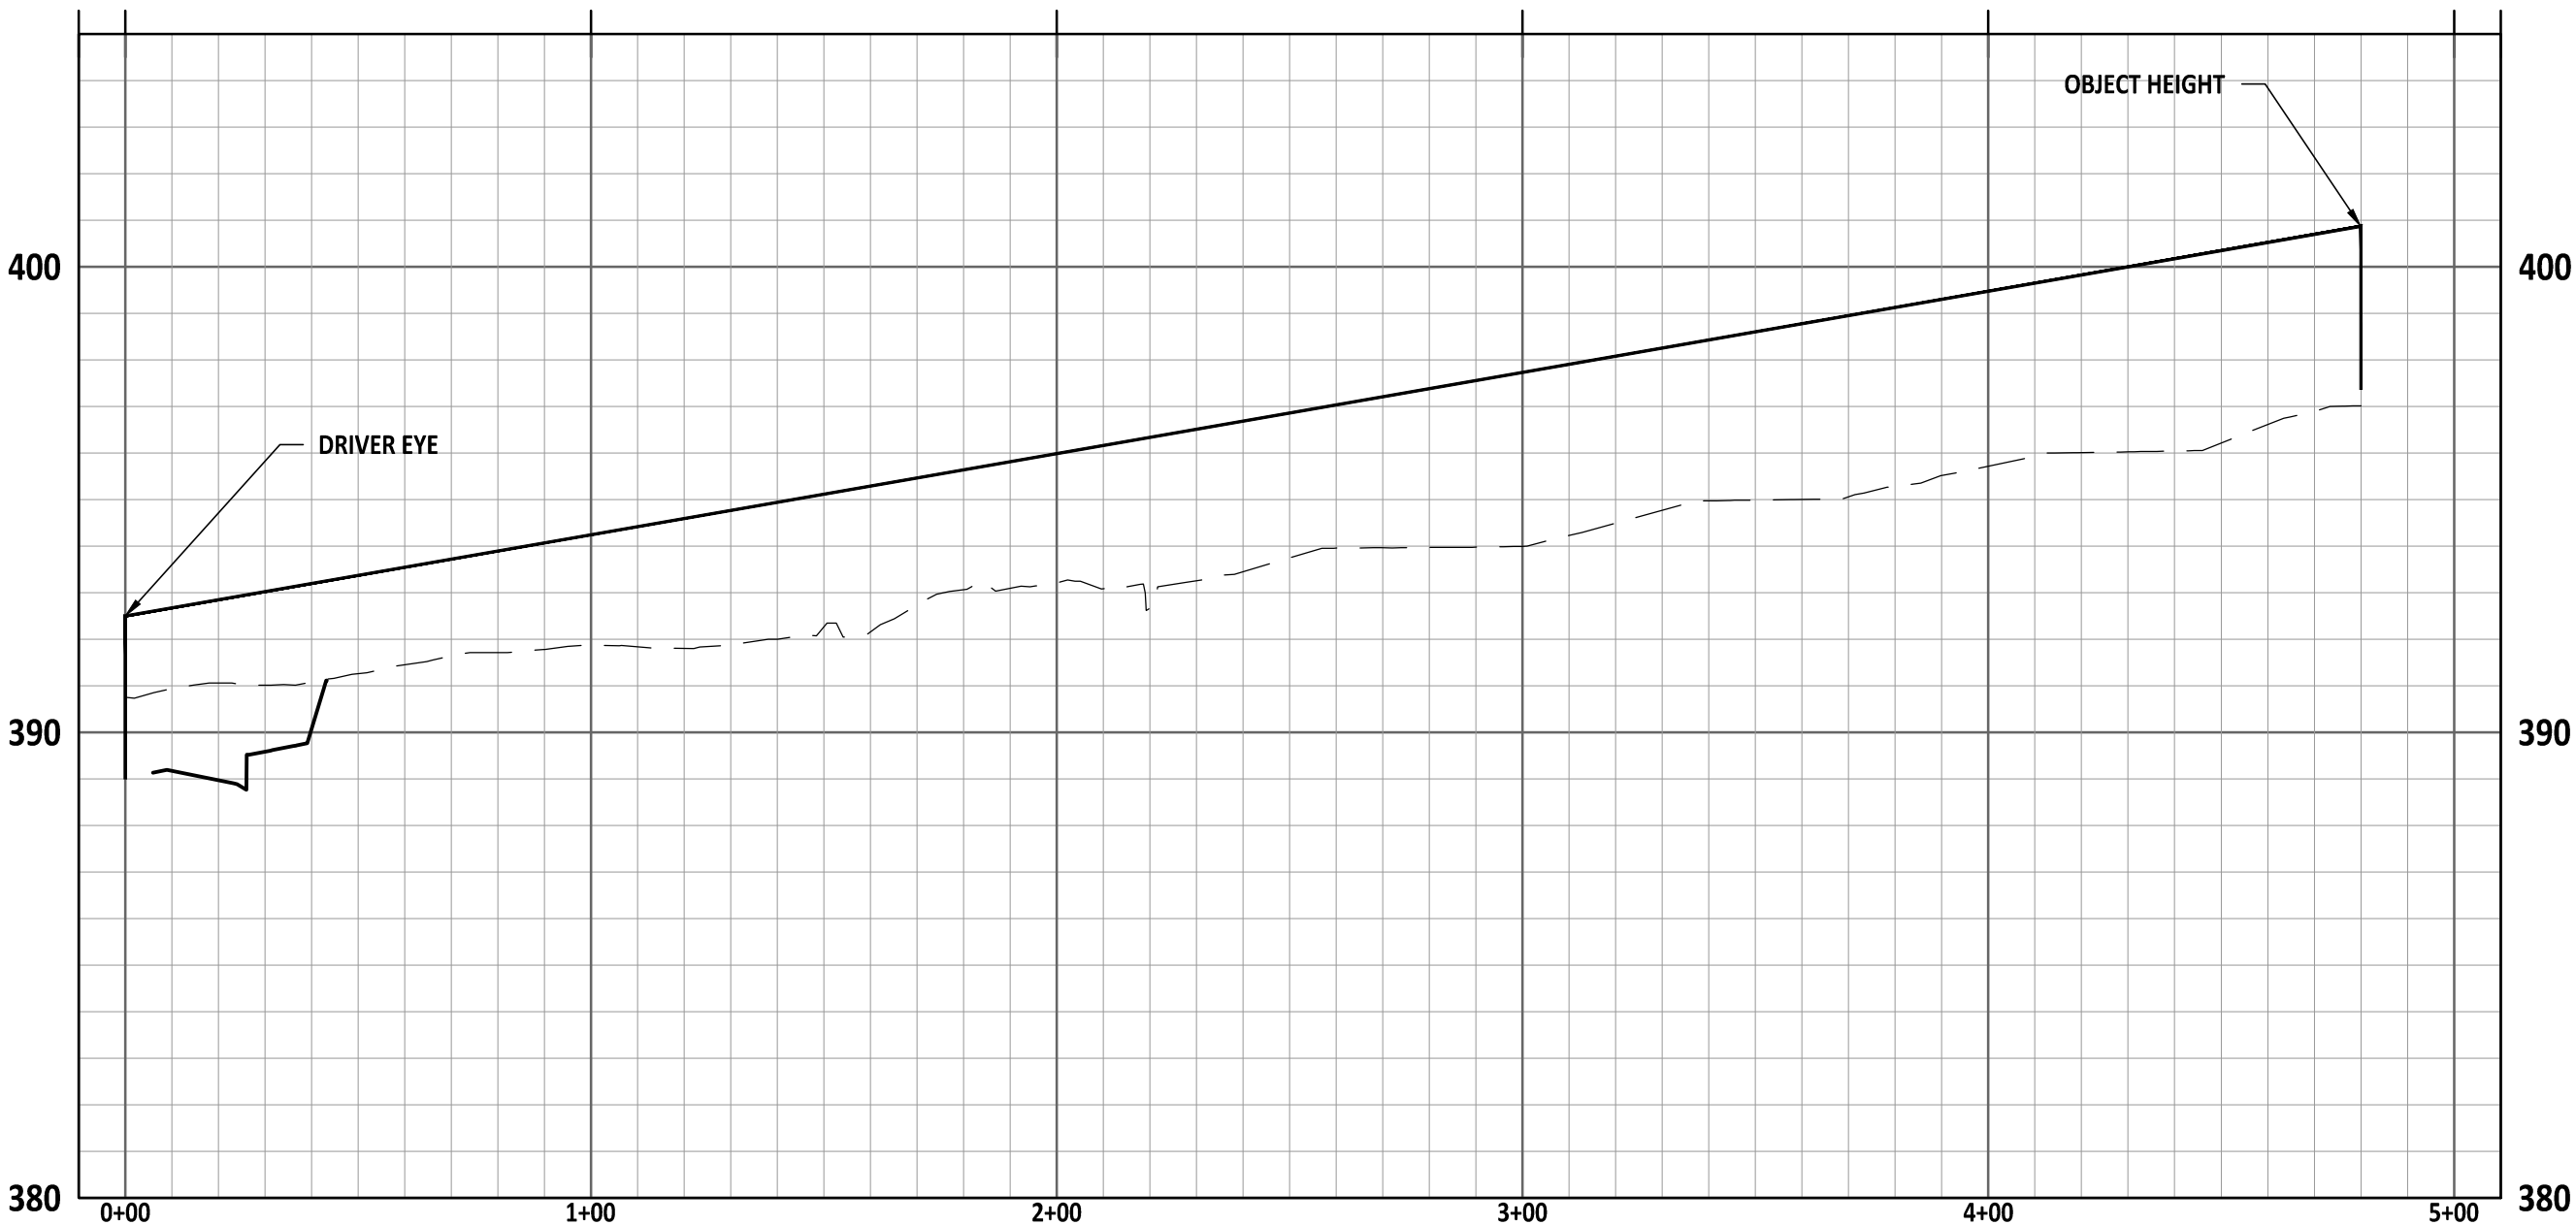

ROAD A RIGHT TURN LOOKING LEFT SIGHT LINE PROFILE

NO.	DATE	REVISION
1	02-03-25	FIRST REVISION SET

STIPULATION FOR REUSE
THIS DRAWING WAS PREPARED FOR USE ON THE SPECIFIC SITE, NAMED HEREON, CONTEMPORANEOUSLY WITH ITS ISSUE DATE AS LISTED, HEREON, AND IT IS NOT SUITABLE FOR USE ON A DIFFERENT PROJECT SITE OR AT A LATER TIME. USE OF THIS DRAWING FOR REFERENCE OR EXAMPLE ON ANOTHER PROJECT REQUIRES THE SERVICES OF PROPERLY LICENSED ARCHITECTS AND ENGINEERS. REPRODUCTION OF THIS DRAWING FOR REUSE ON ANOTHER PROJECT IS NOT AUTHORIZED AND MAY BE CONTRARY TO THE LAW.



MERRITT RESERVE
ROAD A SIGHT
PLAN & PROFILE
ROLESVILLE RD
WAKE COUNTY NC 27312

JOB NUMBER: 23-0004
CHECKED BY: BH
DRAWN BY: DH/RC/SM/GE/MA/LL/JB
DATE: 05/01/2025

SHEET TITLE:
**ROAD A
SIGHT PLAN
& PROFILE**

SHEET NO.:
CT-201

PLANT SCHEDULE LP-101							
SYMBOL	CODE	BOTANICAL / COMMON NAME	CAL	CONT	SIZE	QTY	REMARKS
TREES							
	KOE PAN	Koelreuteria paniculata / Golden Rain Tree	2" Cal.	B&B	8' Height Min.	42	Single Straight Leader
	NYS SYL	Nyssa sylvatica / Tupelo	2" Cal.	B&B	8' Height Min.	11	Single Straight Leader
	QUE FAL	Quercus falcata / Southern Red Oak	2" Cal.	B&B	8' Height Min.	37	Single Straight Leader
	QUE NUT	Quercus nuttallii / Nuttall Oak	2" Cal.	B&B	8' Height Min.	29	Single Straight Leader
	ULM NEW	Ulmus americana 'New Harmony' / New Harmony American Elm	2" Cal.	B&B	8' Height Min.	21	Single Straight Leader

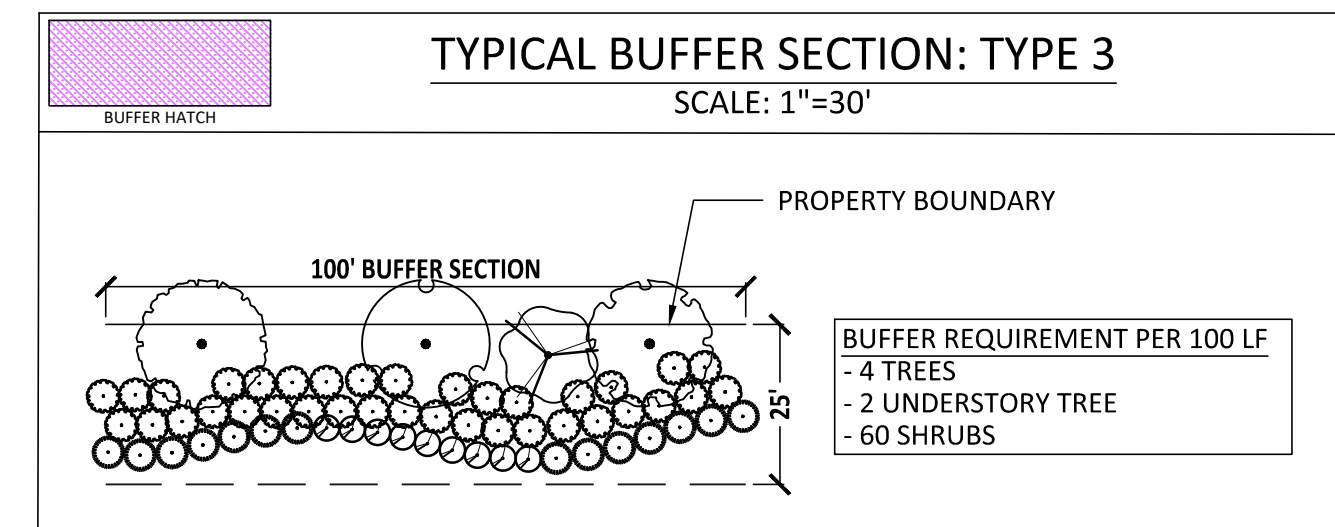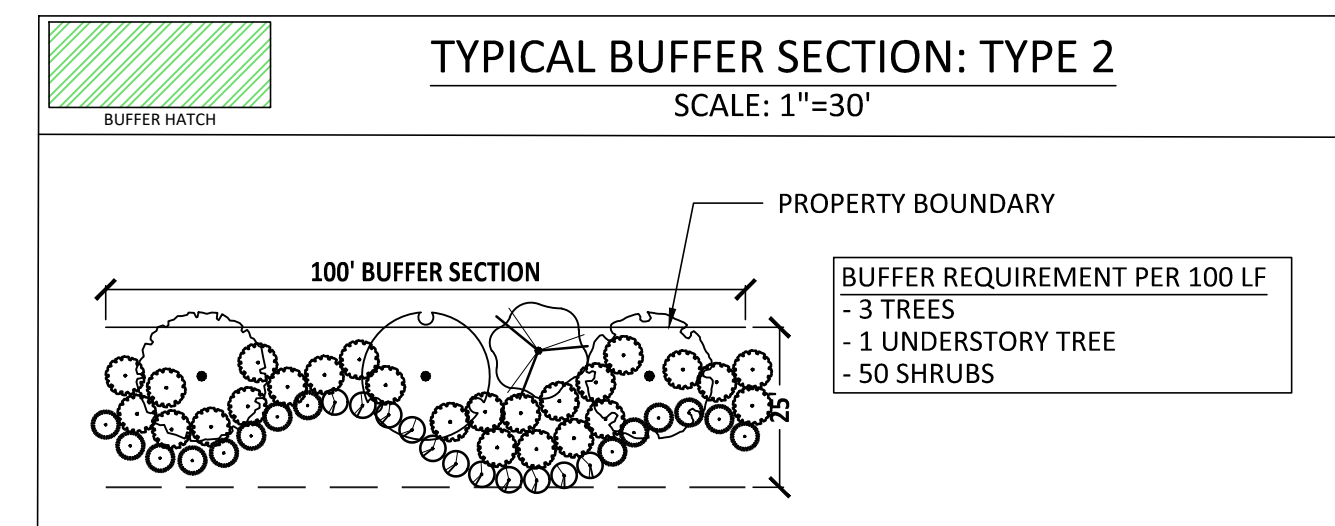

121. Ensure street trees do not conflict with utilities and/or driveways. This comment applies to all landscape plans.

COMMERCIAL/RETAIL 3.29 AC



**AMERICAN
Engineering**

American Engineering Associates - Southeast, P.A.
4020 Westchase Boulevard, Suite 450
Raleigh, NC 27607
919-469-1101



PRELIMINARY
 PRELIMINARY
 DO NOT USE FOR
 CONSTRUCTION
 LAUREN E. DICKSON
 FOR INFORMATION, ONLY

[illegible]

STIPULATION FOR REUSE

THIS DRAWING WAS PREPARED FOR USE ON THE SPECIFIC SITE, NAMED HEREON, CONTEMPORANEOUSLY WITH ITS ISSUANCE AS LISTED, HEREON, AND IT IS NOT SUITABLE FOR USE ON A DIFFERENT PROJECT SITE OR AT A LATER TIME. USE OF THIS DRAWING FOR REFERENCE OR EXAMPLE ON ANOTHER PROJECT REQUIRES THE SERVICES OF PROPERLY LICENSED ARCHITECTS AND ENGINEERS. REPRODUCTION OF THIS DRAWING FOR REUSE ON ANOTHER PROJECT IS NOT AUTHORIZED AND MAY BE CONTRARY TO THE LAW.



MERRITT RESERVE

ROLESVILLE RD
WAKE COUNTY NC 27312

JOB NUMBER:	23-0004
CHECKED BY:	BH
DRAWN BY:	DH/RC/SM/GE/MA/LL/JB
DATE:	05/01/2025
SHEET TITLE:	

LANDSCAPE PLAN

SHEET NO.: **LP-101**

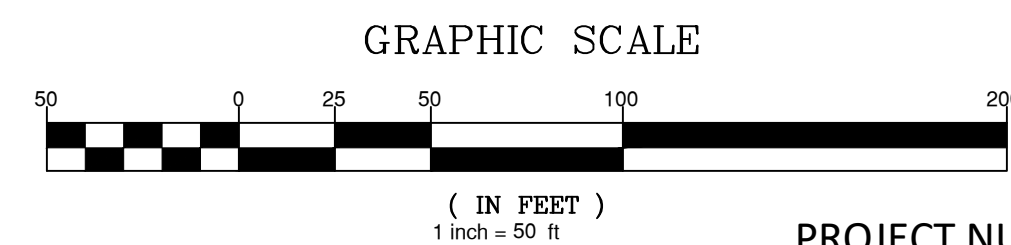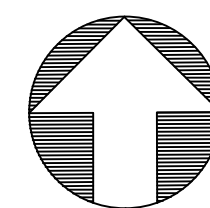

PROJECT NUMBER = PSP-YR-XX





PRELIMINARY
DO NOT USE FOR
CONSTRUCTION

FOR INFORMATION, ONLY

[illegible]

STIPULATION FOR REUSE


THIS DRAWING WAS PREPARED FOR USE ON THE SPECIFIC SITE, NAMED HEREON, CONTEMPORANEOUSLY WITH ITS ISSUE DATE AS LISTED, HEREON. AND IT IS NOT SUITABLE FOR USE ON A DIFFERENT PROJECT SITE OR AT A LATER TIME. USE OF THIS DRAWING FOR REFERENCE OR EXAMPLE ON ANOTHER PROJECT REQUIRES THE SERVICES OF PROPERLY LICENSED ARCHITECTS AND ENGINEERS. REPRODUCTION OF THIS DRAWING FOR REUSE ON ANOTHER PROJECT IS NOT AUTHORIZED AND MAY BE CONTRARY TO THE LAW.

ROLESVILLE RD
WAKE COUNTY NC 27312



SHEET TITLE:

SHEET NO :

LP-102

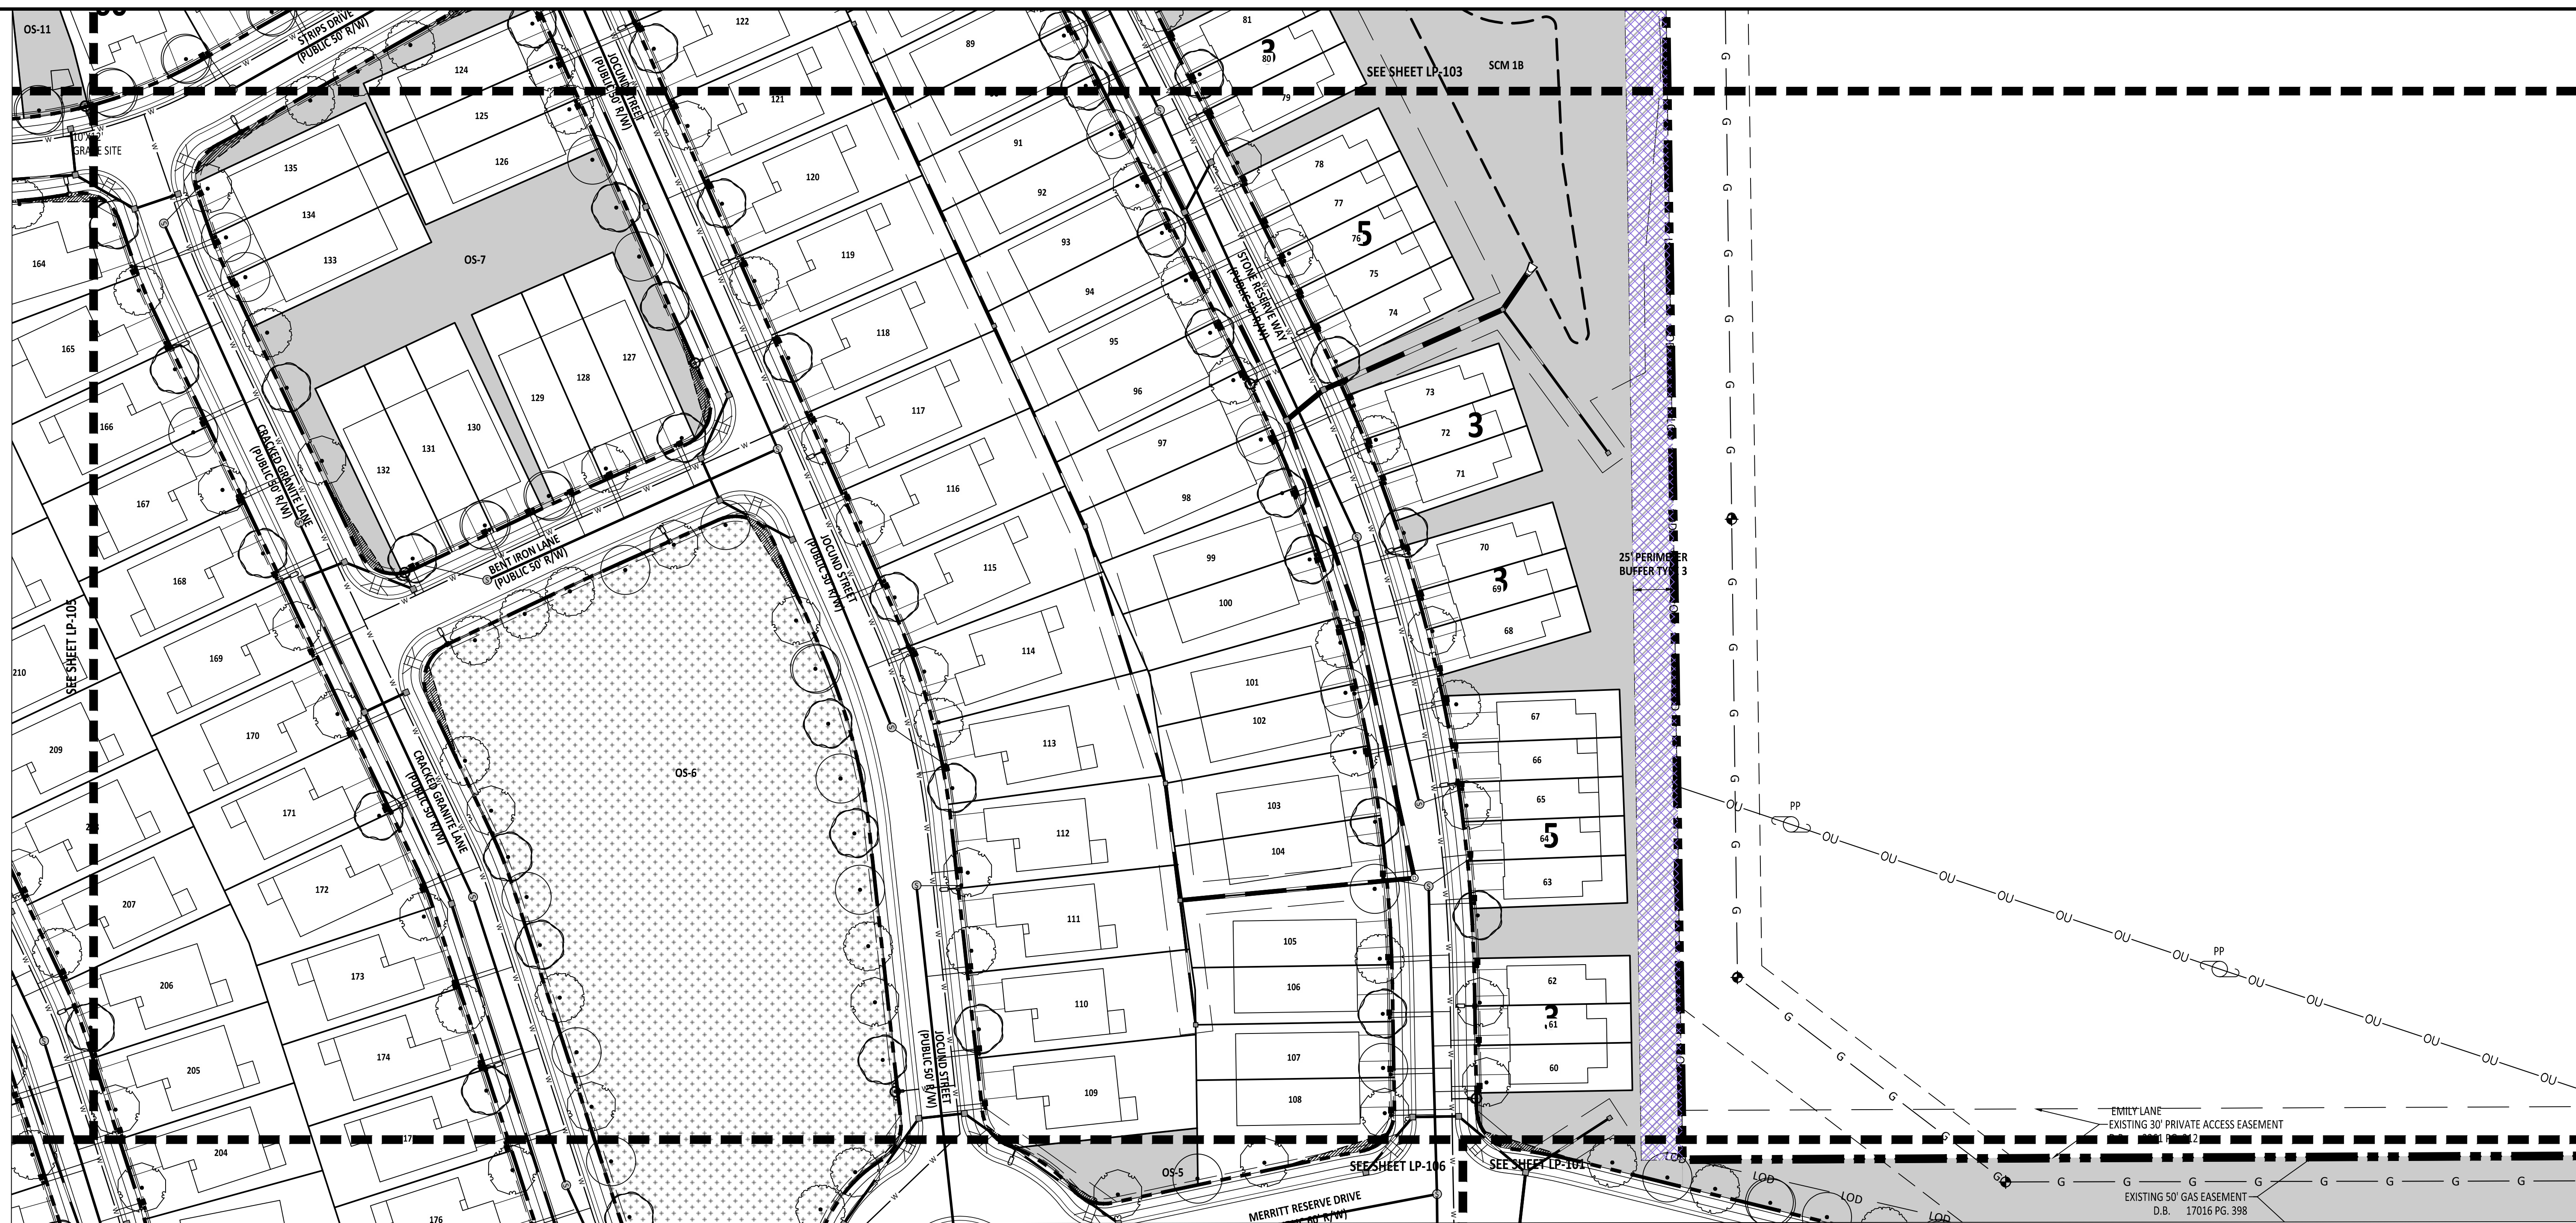

CODE	BOTANICAL / COMMON NAME	CAL	CONT	SIZE	QTY	DETAIL	REMARKS
TREES							
KOE PAN	Koelreuteria paniculata / Golden Rain Tree	2" Cal.	B&B	8' Height Min.	19		Single Straight Leader
NYS SYL	Nyssa sylvatica / Tupelo	2" Cal.	B&B	8' Height Min.	16		Single Straight Leader
QUE FAL	Quercus falcata / Southern Red Oak	2" Cal.	B&B	8' Height Min.	4		Single Straight Leader
QUE NUT	Quercus nuttallii / Nuttall Oak	2" Cal.	B&B	8' Height Min.	29		Single Straight Leader
ULM NEW	Ulmus americana 'New Harmony' / New Harmony American Elm	2" Cal.	B&B	8' Height Min.	28		Single Straight Leader

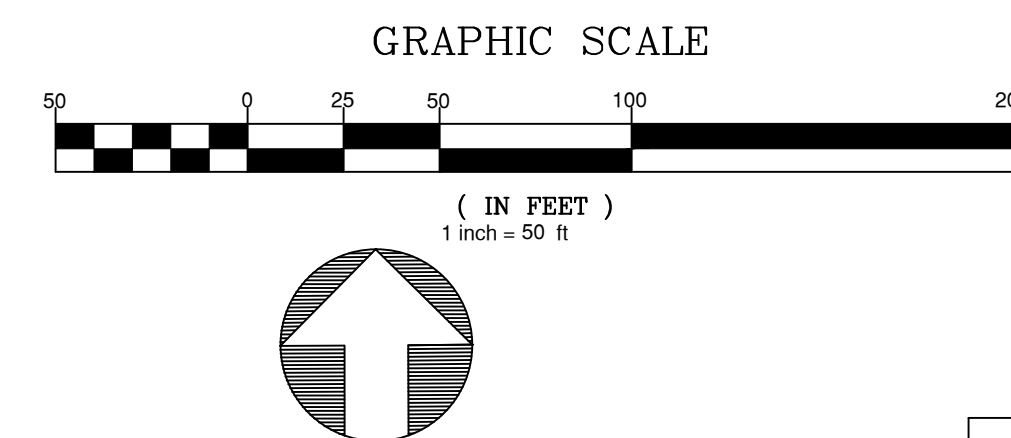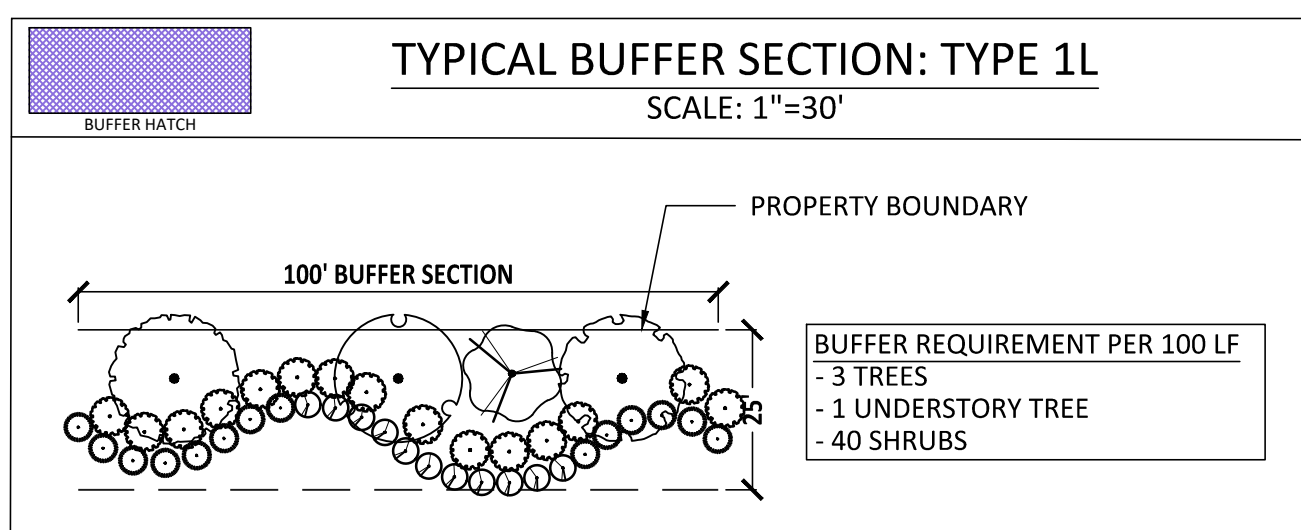

North Carolina 811
www.nc811.org

*** 3 Days Before Digging ***

North Carolina 811
811 or 1-800-632-4949

Remote Ticket Entry
<http://nc811.org/remoteticketentry.htm>



PROJECT NUMBER = PSP-YR-XX

FOR INFORMATION, ONLY

CODE	BOTANICAL / COMMON NAME	CAL	CONT	SIZE	QTY	REMARKS
TREES						
KOE PAN	Koelreuteria paniculata / Golden Rain Tree	2" Cal.	B&B	8' Height Min.	22	Single Straight Leader
NYS SVL	Nyssa sylvatica / Tupelo	2" Cal.	B&B	8' Height Min.	22	Single Straight Leader
QUE FAL	Quercus falcata / Southern Red Oak	2" Cal.	B&B	8' Height Min.	16	Single Straight Leader
QUE NUT	Quercus nuttallii / Nuttall Oak	2" Cal.	B&B	8' Height Min.	18	Single Straight Leader
ULM NEW	Ulmus americana 'New Harmony' / New Harmony American Elm	2" Cal.	B&B	8' Height Min.	22	Single Straight Leader

Diagram illustrating the 100' Buffer Section and Buffer Requirement per 100 LF:

- 100' BUFFER SECTION
- PROPERTY BOUNDARY
- BUFFER REQUIREMENT PER 100 LF:
 - 3 TREES
 - 1 UNDERSTORY TREE
 - 40 SHRUBS

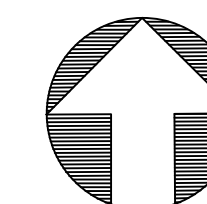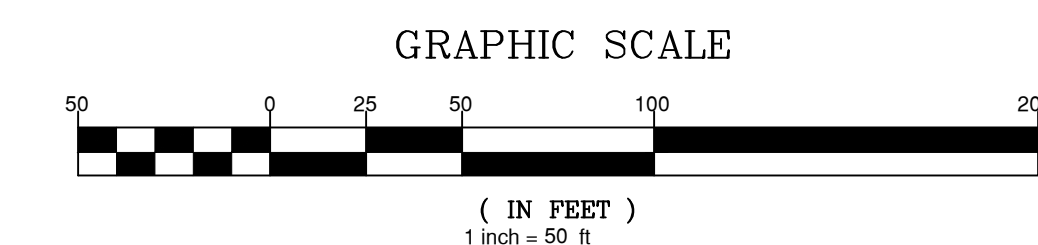

NO.	DATE	REVISION:
-----	------	-----------

STIPULATION FOR REUSE

THIS DRAWING WAS PREPARED FOR USE ON THE SPECIFIC SITE, NAMED HEREON, CONTEMPORANEOUSLY WITH ITS ISSUE DATE AS LISTED, HEREON, AND IT IS NOT SUITABLE FOR USE ON A DIFFERENT PROJECT SITE OR AT A LATER TIME. USE OF THIS DRAWING FOR REFERENCE OR EXAMPLE ON ANOTHER PROJECT REQUIRES THE SERVICES OF PROPERLY LICENSED ARCHITECTS AND ENGINEERS. REPRODUCTION OF THIS DRAWING FOR REUSE ON ANOTHER PROJECT IS NOT AUTHORIZED AND MAY BE CONTRARY TO THE LAW.

MERRITT RESERVE

ROLESVILLE RD
WAKE COUNTY NC 27312

JOB NUMBER:	23-0004
CHECKED BY:	BH
DRAWN BY:	DH/RC/SM/GE/MA/LL/JB
DATE:	05/01/2025

LANDSCAPE PLAN




SHEET NO.: **LP-103**

North Carolina 811
www.nc811.org

*** 3 Days Before Digging ***
North Carolina 811
811 or 1-800-632-4949
Remote Ticket Entry
<http://nc811.org/remoteticketentry.htm>

PROJECT NUMBER = PSP-YR-XX

PLANT SCHEDULE						
CODE	BOTANICAL / COMMON NAME	CAL	CONT	SIZE	QTY	REMARKS
TREES						
KOE PAN	Koelreuteria paniculata / Golden Rain Tree	2" Cal.	B&B	8' Height Min.	220	Single Straight Leader
NYS SYL	Nyssa sylvatica / Tupelo	2" Cal.	B&B	8' Height Min.	100	Single Straight Leader
QUE FAL	Quercus falcata / Southern Red Oak	2" Cal.	B&B	8' Height Min.	153	Single Straight Leader
QUE NUT	Quercus nuttallii / Nuttall Oak	2" Cal.	B&B	8' Height Min.	215	Single Straight Leader
ULM NEW	Ulmus americana 'New Harmony' / New Harmony American Elm	2" Cal.	B&B	8' Height Min.	220	Single Straight Leader

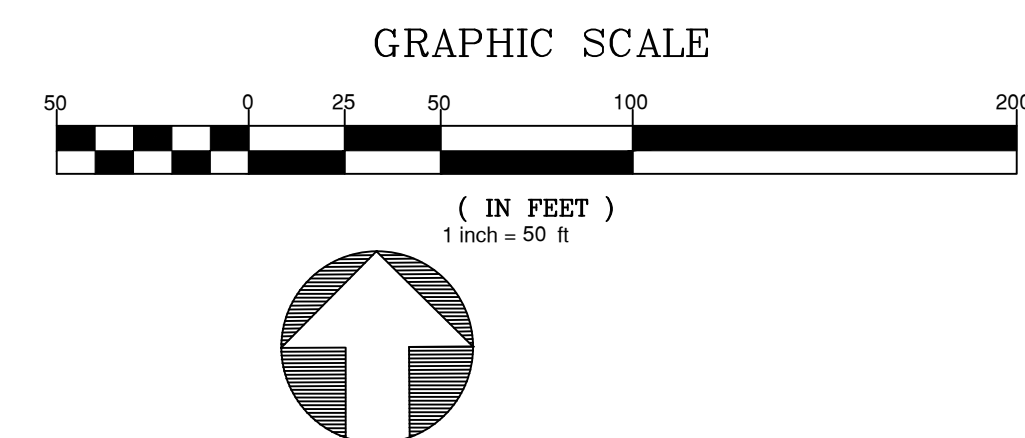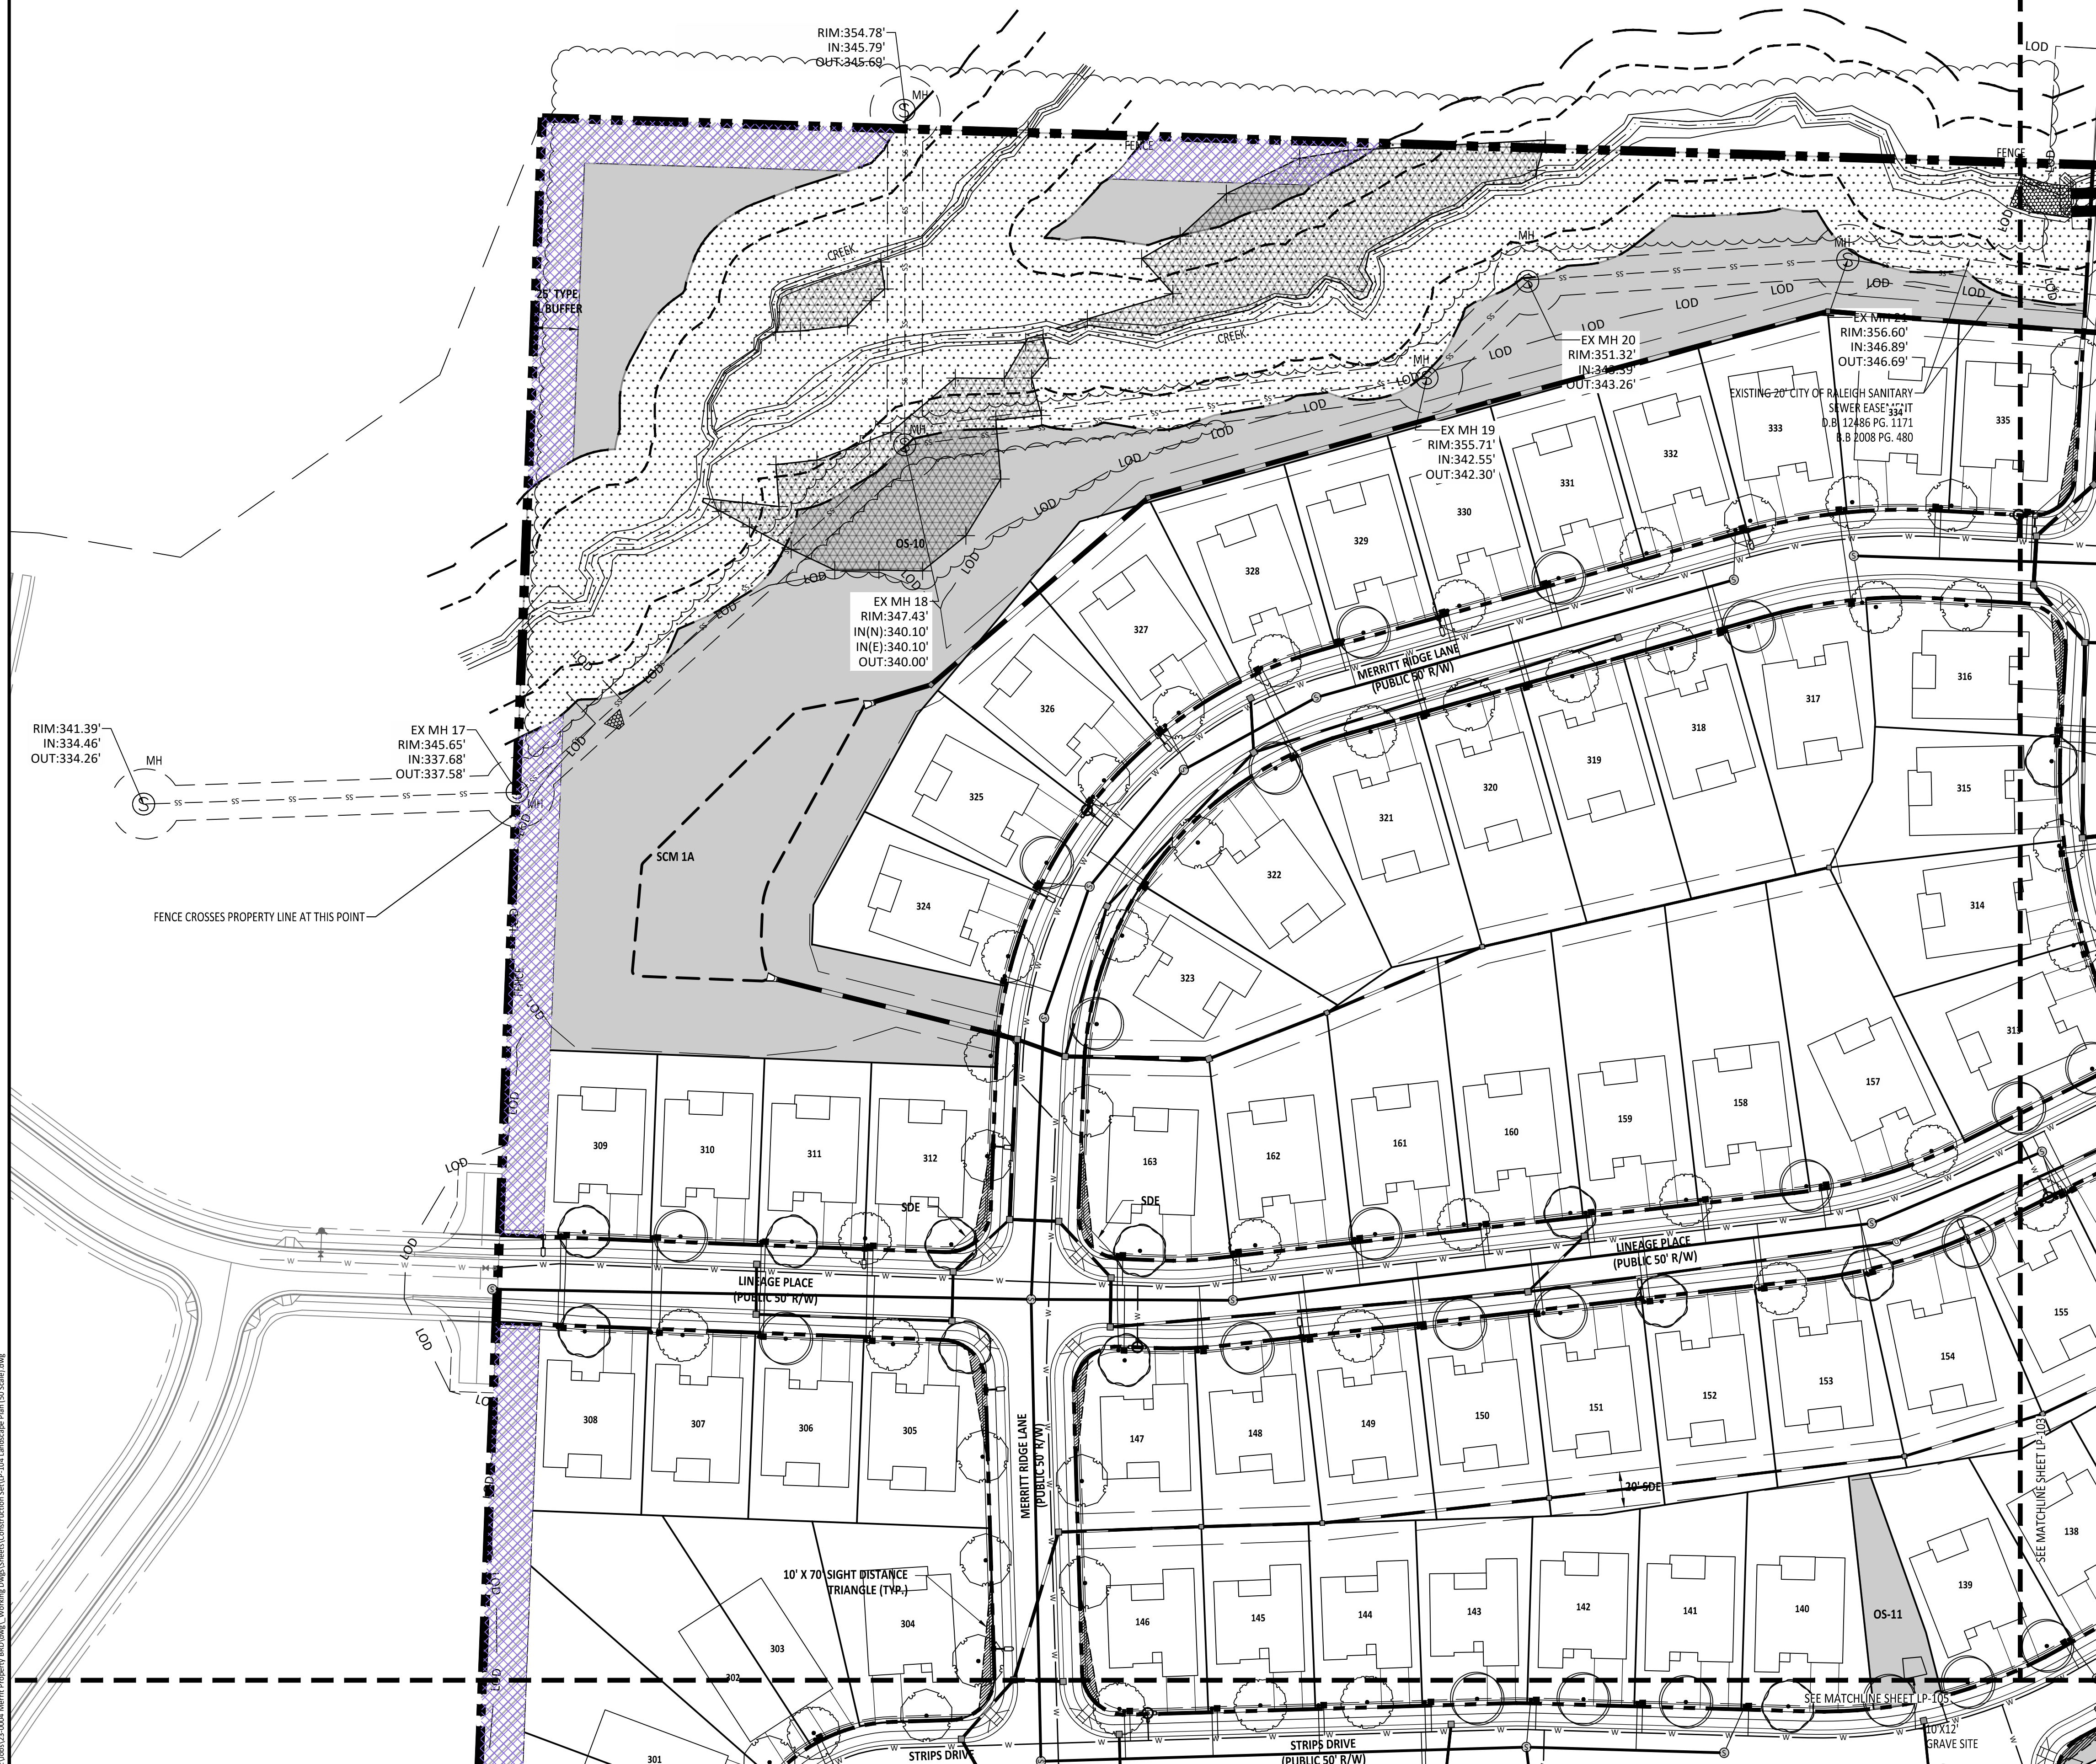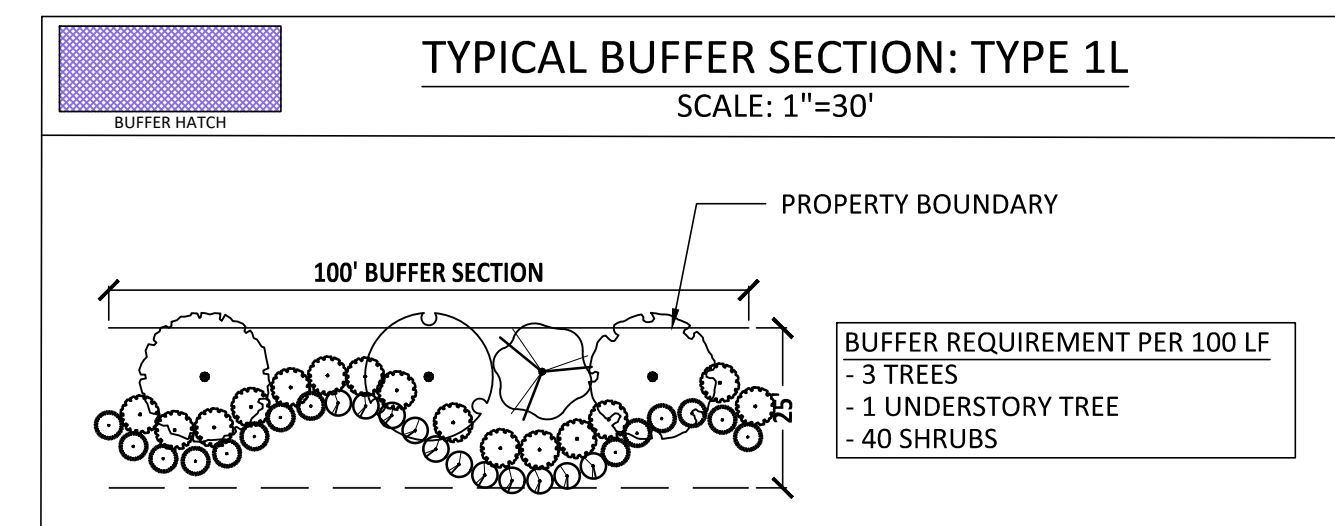

PROJECT NUMBER = PSP-YR-XX

North Carolina 811
www.nc811.org
*** 3 Days Before Digging ***
North Carolina 811
811 or 1-800-632-4949
Remote Ticket Entry
<http://nc811.org/remoteticketentry.htm>

MERRITT RESERVE

ROLESVILLE RD
WAKE COUNTY NC 27312

DB NUMBER:	23-0004
CHECKED BY:	BH
DRAWN BY:	DH/RC/SM/GE/MA/LL/JB
DATE:	05/01/2025
SHEET TITLE:	


LANDSCAPE PLAN

SHEET NO.: **LP-104**

[illegible]

STIPULATION FOR REUSE

THIS DRAWING WAS PREPARED FOR USE ON THE SPECIFIC SITE, NAMED HEREON, CONTEMPORANEOUSLY WITH ITS ISSUE DATE AS LISTED, HEREON, AND IT IS NOT SUITABLE FOR USE ON A DIFFERENT PROJECT SITE OR AT A LATER TIME. USE OF THIS DRAWING FOR REFERENCE OR EXAMPLE ON ANOTHER PROJECT REQUIRES THE SERVICES OF PROPERLY LICENSED ARCHITECTS AND ENGINEERS. REPRODUCTION OF THIS DRAWING FOR REUSE ON ANOTHER PROJECT IS NOT AUTHORIZED AND MAY BE CONTRARY TO THE LAW.

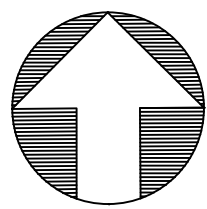2025-05-01

PROJECT NUMBER = PSP-YR-XX

STIPULATION FOR REUSE

THIS DRAWING WAS PREPARED FOR USE ON THE SPECIFIC SITE, NAMED HEREON, CONTEMPORANEOUSLY WITH ITS ISSUE DATE AS LISTED, HEREON, AND IT IS NOT SUITABLE FOR USE ON A DIFFERENT PROJECT SITE OR AT A LATER TIME. USE OF THIS DRAWING FOR REFERENCE OR EXAMPLE ON ANOTHER PROJECT REQUIRES THE SERVICES OF PROPERLY LICENSED ARCHITECTS AND ENGINEERS. REPRODUCTION OF THIS DRAWING FOR REUSE ON ANOTHER PROJECT IS NOT AUTHORIZED AND MAY BE CONTRARY TO THE LAW.


MERRITT RESERVE
ROLESVILLE RD
WAKE COUNTY NC 27312

JOB NUMBER:	23-0004
CHECKED BY:	BH
DRAWN BY:	DH/RC/SM/GE/MA/LL/JB
DATE:	05/01/2025
SHEET TITLE:	

LANDSCAPE PLAN

SHEET NO.: **LP-105**

PLANT SCHEDULE LP-105						
CODE	BOTANICAL / COMMON NAME	CAL	CONT	SIZE	QTY	REMARKS
TREES						
KOE PAIN	Koelreuteria paniculata / Golden Rain Tree	2" Cal.	B&B	8' Height Min.	18	Single Straight Leader
NYS SYL	Nyssa sylvatica / Tupelo	2" Cal.	B&B	8' Height Min.	4	Single Straight Leader
QUE FAL	Quercus falcata / Southern Red Oak	2" Cal.	B&B	8' Height Min.	7	Single Straight Leader
QUE NUT	Quercus nuttallii / Nuttall Oak	2" Cal.	B&B	8' Height Min.	19	Single Straight Leader
ULM NEW	Ulmus americana 'New Harmony' / New Harmony American Elm	2" Cal.	B&B	8' Height Min.	25	Single Straight Leader

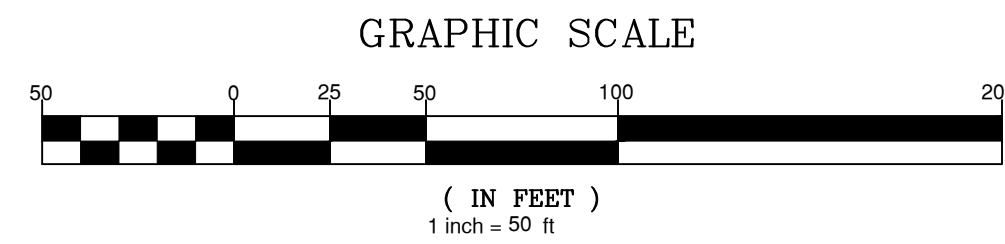

*** 3 Days Before Digging ***
North Carolina 811
811 or 1-800-632-4949
Remote Ticket Entry
<http://nc811.org/remoteticketentry.htm>

PRELIMINARY
DO NOT USE FOR

FOR INFORMATION, ONLY

[illegible]

STIPULATION FOR REUSE

THIS DRAWING WAS PREPARED FOR USE ON THE SPECIFIC SITE, NAMED HEREON, CONTEMPORANEOUSLY WITH ITS ISSUANCE DATE AS LISTED, HEREON, AND IT IS NOT SUITABLE FOR USE ON A DIFFERENT PROJECT SITE OR AT A LATER TIME. USE OF THIS DRAWING FOR REFERENCE OR EXAMINATION ON ANOTHER PROJECT REQUIRES THE SERVICES OF PROPERLY LICENSED ARCHITECTS AND ENGINEERS. REPRODUCTION OF THIS DRAWING FOR REUSE ON ANOTHER PROJECT IS NOT AUTHORIZED AND MAY BE CONTRARY TO THE LAW.

MERRITT RESERVE

ROLESVILLE RD
WAKE COUNTY NC 27312

JOB NUMBER: 23-0004

CHECKED BY: BH

DRAWN BY: DH/RC/SM/GE/MA/LL/JB






DATE: 05/01/2025

SHEET TITLE:

LANDSCAPE PLAN

SHEET NO.: _____


LP-107

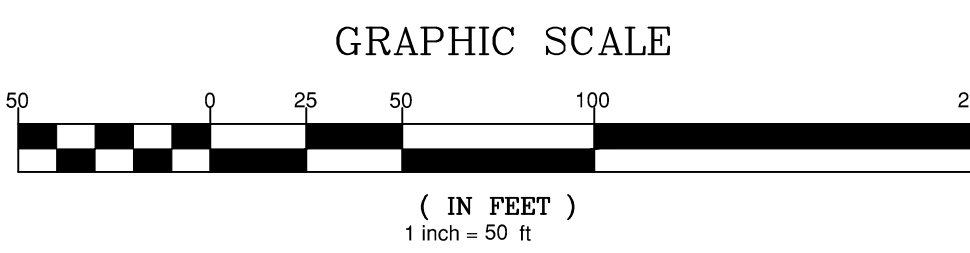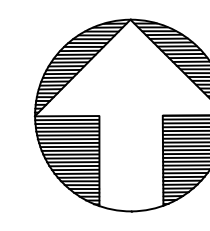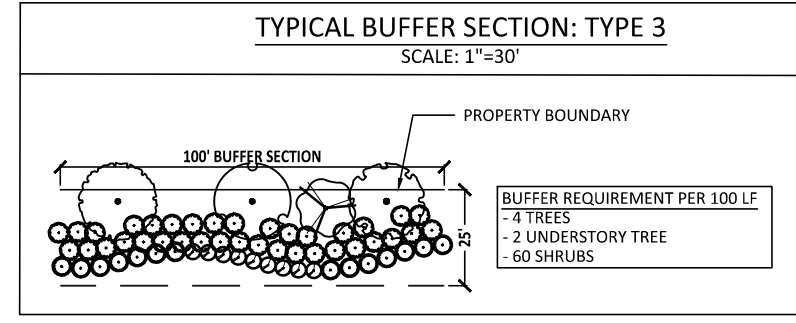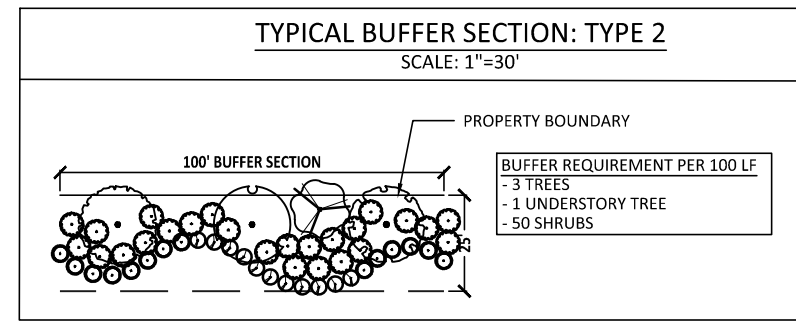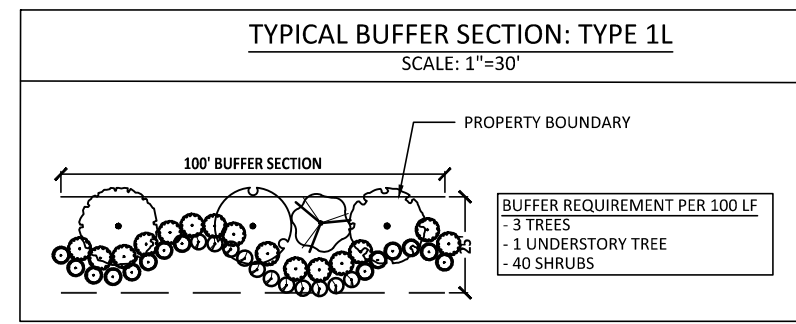


PLANT SCHEDULE LP-107

CODE	BOTANICAL / COMMON NAME	CAL	CONT	SIZE	QTY	REMARKS
TREES						
KOE PAN	Koelreuteria paniculata / Golden Rain Tree	2" Cal.	B&B	8' Height Min.	30	Single Straight Leader
NYS SYL	Nyssa sylvatica / Tupelo	2" Cal.	B&B	8' Height Min.	26	Single Straight Leader
QUE FAL	Quercus falcata / Southern Red Oak	2" Cal.	B&B	8' Height Min.	23	Single Straight Leader
QUE NUT	Quercus nuttallii / Nuttall Oak	2" Cal.	B&B	8' Height Min.	27	Single Straight Leader
ULM NEW	Ulmus americana 'New Harmony' / New Harmony American Elm	2" Cal.	B&B	8' Height Min.	27	Single Straight Leader


PROJECT NUMBER = PSP-YR-XX

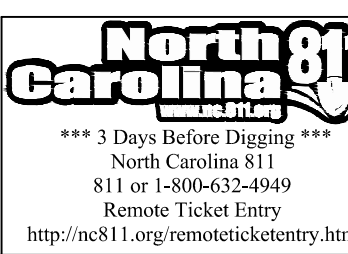

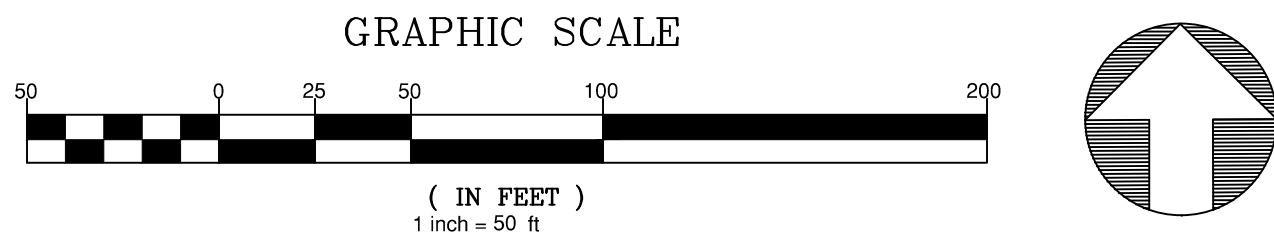


PROJECT NUMBER = PSP-YR-XX

1. All plant material shall conform with the standards set forth by the American Association of Nurserymen, American Standard for Nursery Stock, ANSI Z60.1.
2. Locate all existing utilities prior to installation of plant material. Notify owner of any discrepancies between field conditions and those shown on the plan.
3. Contractor engaged in landscape installation shall be a landscape contractor registered in the state of North Carolina.
4. Tree protection fence shall be maintained on site until all site work and the final site inspection is completed. The fencing shall be removed prior to the certificate of occupancy (CO) inspection is scheduled.
5. Verification of total quantities as shown on the plant list shall be the responsibility of the contractor.
6. All plant groupings shall be mulched as one bed. 3" of triple shredded hardwood mulch shall be used around all plantings.
7. Apply pre-emergent herbicide to all new planting beds at manufacturer's recommended rate prior to installation of mulch.
8. Establish positive drainage in all planting beds and away from buildings.
9. Do not install plant material in impervious soils, (i.e. holes which, when filled with water, do not completely drain within two hours.)
10. Lawn areas shall be seeded with Riviera or Sunstar Bermuda grass 95% coverage (based on a per square yard sample) shall be attained prior to final inspection. All 3:1 slopes shall be stabilized with biodegradable erosion control matting. See detail sheet seeding schedule.
11. General contractor shall be responsible for keeping all equipment & subcontractors away from seeded areas. If damage occurs to newly seeded areas, the contractor shall be responsible for regrading and reseeding immediately at no additional cost to the owner. Contractor shall water and maintain those areas until they are at 95% coverage at final completion.
12. Install permanent seeding along all roadside ditches and channels within construction limits of project. See erosion control plans for additional information.
13. Areas damaged from plant relocation or other activities of landscape contractor to be reseeded and established at no additional cost to the owner.
14. Mulch and no-mow mixes shall be replenished as needed, especially after heavy rain events. If no-mow mix germinates at a rate of less than 90%, other species shall be removed and the area re-seeded.
15. Contractor is responsible for importing, testing, and preparing the soil on site per the recommendations of a soil test.
16. Plants shall be watered at least 2 times per week unless soil is moist based on core sample or moisture meter reading. Water more frequently during establishment.
17. Remove (either manually or with pesticide treatment) all weeds in mulch areas, plant beds, tree rings, and hardscape areas, including but not limited to nutcase, grasses, invasive plants, and any non-desirable plant material. This treatment shall occur monthly until the end of the warranty / maintenance period.
18. Mulch line smooth continuous curves.
19. All trees not within a plant bed to be treated with a 6-ft diameter mulch ring (typ).
20. All foundation trees are to be planted a minimum of 8' away from building wall. Notify Landscape Architect of any discrepancies.
21. When possible, planting shall be installed between September 1 - June 30th and in favorable weather conditions. When planting must be performed outside of specified date, plants must be watered on a regular basis to ensure viability.

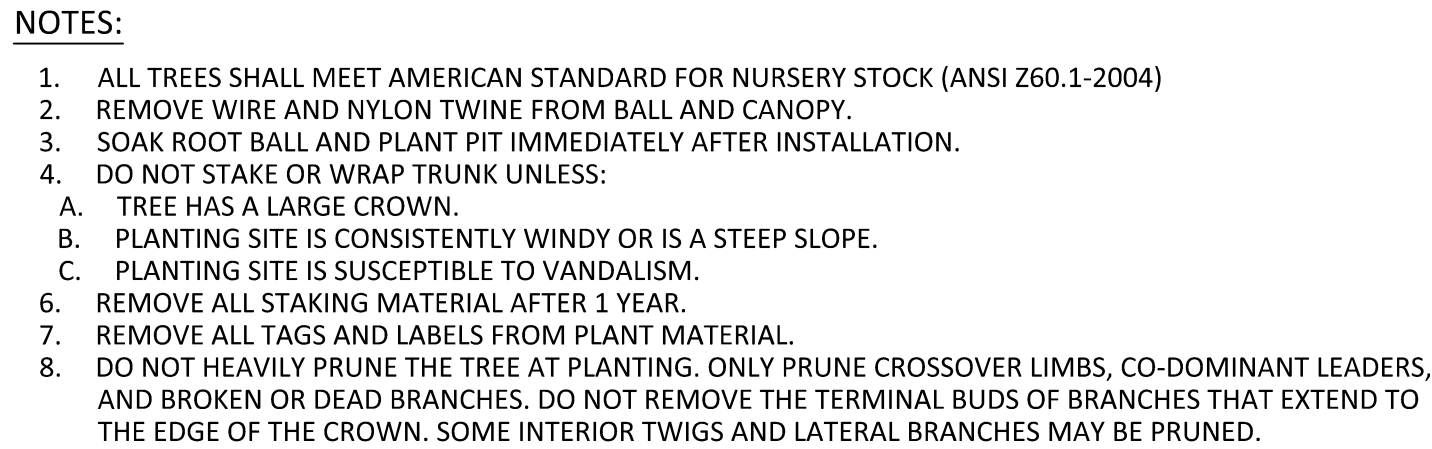

NOT TO SCALE

P-RE-R-R230004-01

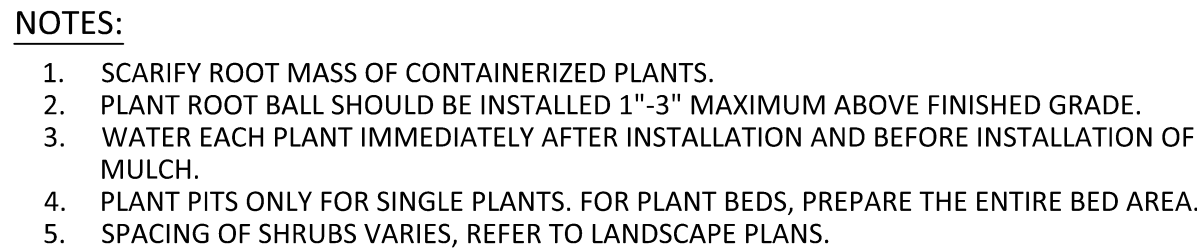

NOT TO SCALE

P-RE-R-R230004-02

[illegible]

THIS DRAWING WAS PREPARED FOR USE ON THE SPECIFIC SITE, NAMED HEREON, CONTEMPORANEOUSLY WITH ITS ISSUE DATE AS LISTED, HEREON, AND IT IS NOT SUITABLE FOR USE ON A DIFFERENT PROJECT SITE OR AT A LATER TIME. USE OF THIS DRAWING FOR REFERENCE OR EXAMPLE ON ANOTHER PROJECT REQUIRES THE SERVICES OF PROPERLY LICENSED ARCHITECTS AND ENGINEERS. REPRODUCTION OF THIS DRAWING FOR REUSE ON ANOTHER PROJECT IS NOT AUTHORIZED AND MAY BE CONTRARY TO THE LAW.

ROLESVILLE RD
WAKE COUNTY NC 27312

JOB NUMBER:	23-0004
CHECKED BY:	BH
DRAWN BY:	DH/RC/SM/GE/MA/LL/JB
DATE:	05/01/2025

SHEET NO.:

LP-500






MATCHLINE TO SHEET 2

NO.	DATE	REVISION	BY

LIGHTING DESIGN TOLERANCE
The calculated footcandle light levels in this lighting design are predicted values and are based on specific information that has been supplied to Duke Energy. Any inaccuracies in the supplied information, differences in luminaire installation, lighted area geometry including elevation differences, reflective properties of surrounding surfaces, obstructions (foliage or otherwise) in the lighted area, or lighting from sources other than listed in this design may produce different results from the predicted values. Normal tolerances of voltage, lamp output, and ballast and luminaire manufacture will also affect results.

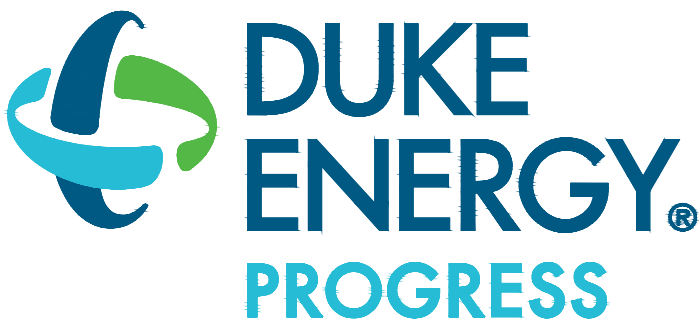


PROPRIETARY & CONFIDENTIAL
This document together with the concepts and designs presented herein, presented as an instrument of service, is the sole property of Duke Energy, and is intended only for the specific purpose and prospective client as stated in the title block of this drawing. Any use, copying, reproduction or disclosure of the drawing, design or any information contained herein by the prospective customer or other entities, including without limitation, architects, engineers, or equipment manufacturers is hereby expressly prohibited and shall not be permitted absent prior written consent from, and payment of compensation to Duke Energy. Duke Energy disclaims any liability or responsibility for any unauthorized use of or reliance on this document.

MERRITT SUBDIVISION			
ROLESVILLE, NC			
STREET LIGHTING ARRANGEMENT			
Designed by	DUKE ENERGY PROGRESS LIGHTING SOLUTIONS		
Reviewed by	A. Herrera	Scale	1" = 100'
Date	4/16/2025	Size	Drawing size "D"
Description	LED Roadway		
Drawing No.	25-0160	Sht.	1 OF 3


MATCHLINE TO SHEET 1

MATCHLINE TO SHEET 3

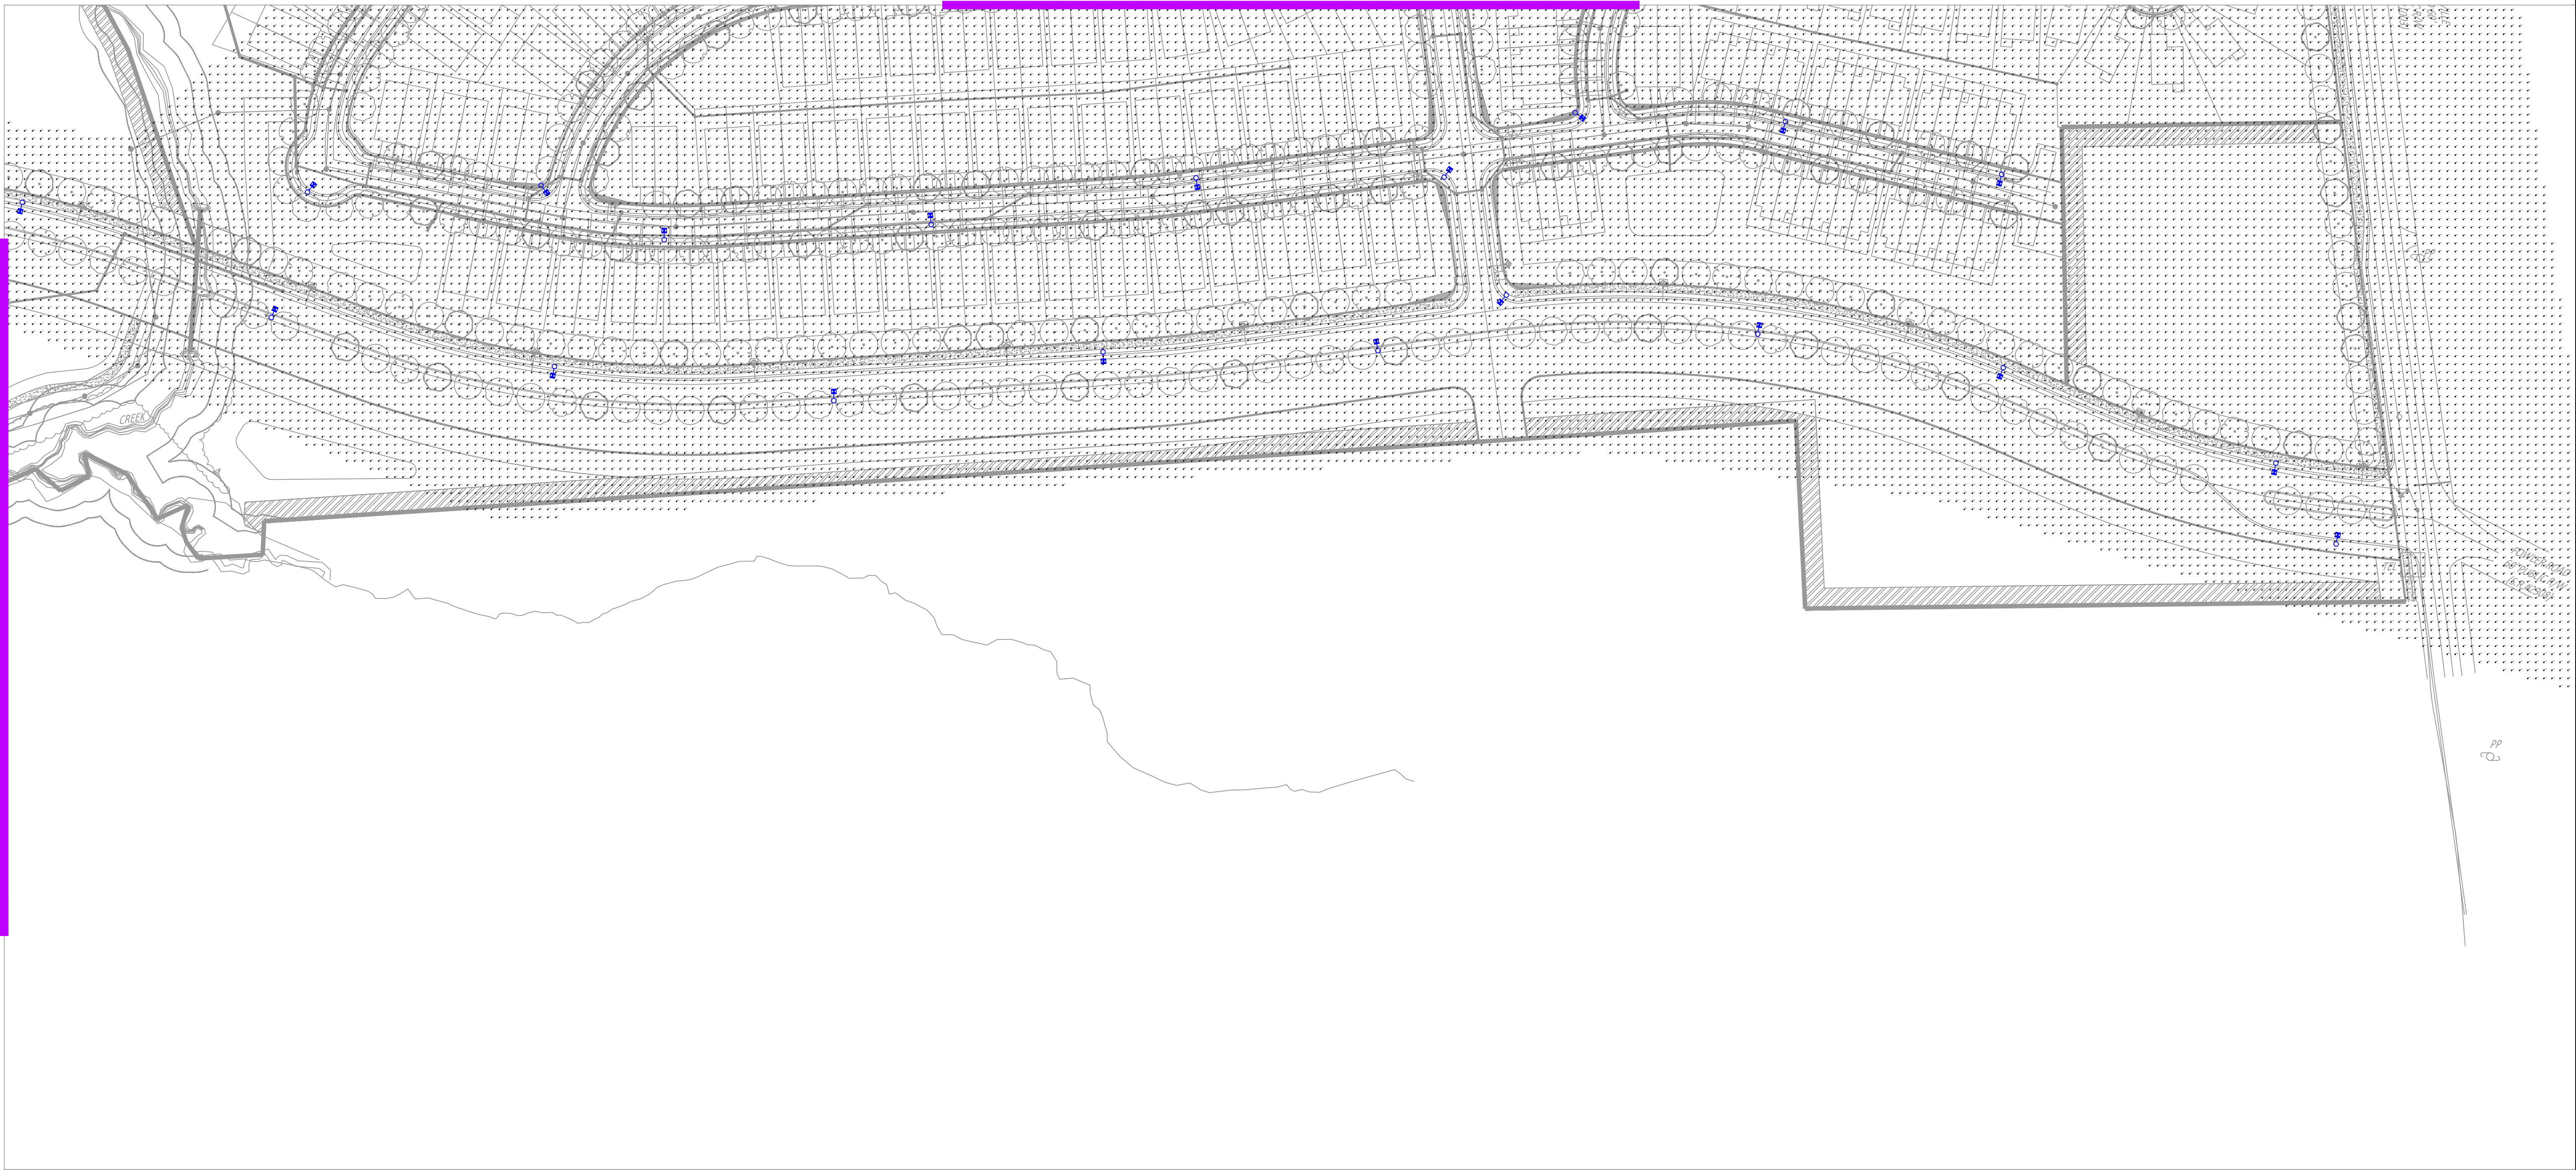


NO.	DATE	REVISION	BY

LIGHTING DESIGN TOLERANCE
The calculated footcandle light levels in this lighting design are predicted values and are based on specific information that has been supplied to Duke Energy. Any inaccuracies in the supplied information, differences in luminaire installation, lighted area geometry including elevation differences, reflective properties of surrounding surfaces, obstructions (foliage or otherwise) in the lighted area, or lighting from sources other than listed in this design may produce different results from the predicted values. Normal tolerances of voltage, lamp output, and ballast and luminaire manufacture will also affect results.

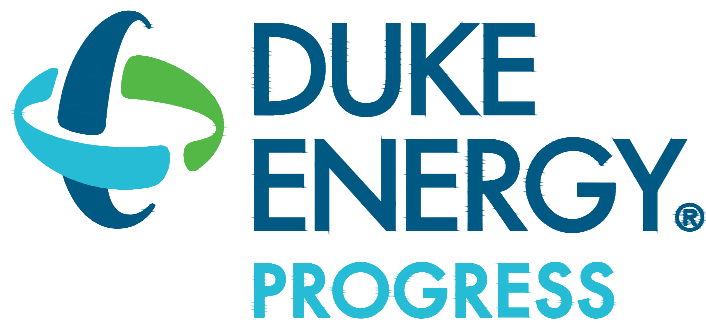

PROPRIETARY & CONFIDENTIAL
This document together with the concepts and designs presented herein, presented as an instrument of service, is the sole property of Duke Energy, and is intended only for the specific purpose and prospective client as stated in the title block of this drawing. Any use, copying, reproduction or disclosure of the drawing, design or any information contained herein by the prospective customer or other entities, including without limitation, architects, engineers, or equipment manufacturers is hereby expressly prohibited and shall not be permitted absent prior written consent from, and payment of compensation to Duke Energy. Duke Energy disclaims any liability or responsibility for any unauthorized use of or reliance on this document.

MERRITT SUBDIVISION			
ROLESVILLE, NC			
STREET LIGHTING ARRANGEMENT			
Designed by	DUKE ENERGY PROGRESS LIGHTING SOLUTIONS		
Reviewed by	A. Herrera	Scale	1" = 100'
Date	4/16/2025	Size	Drawing size "D"
Description	LED Roadway		
Drawing No.	25-0160	Sht.	2 OF 3

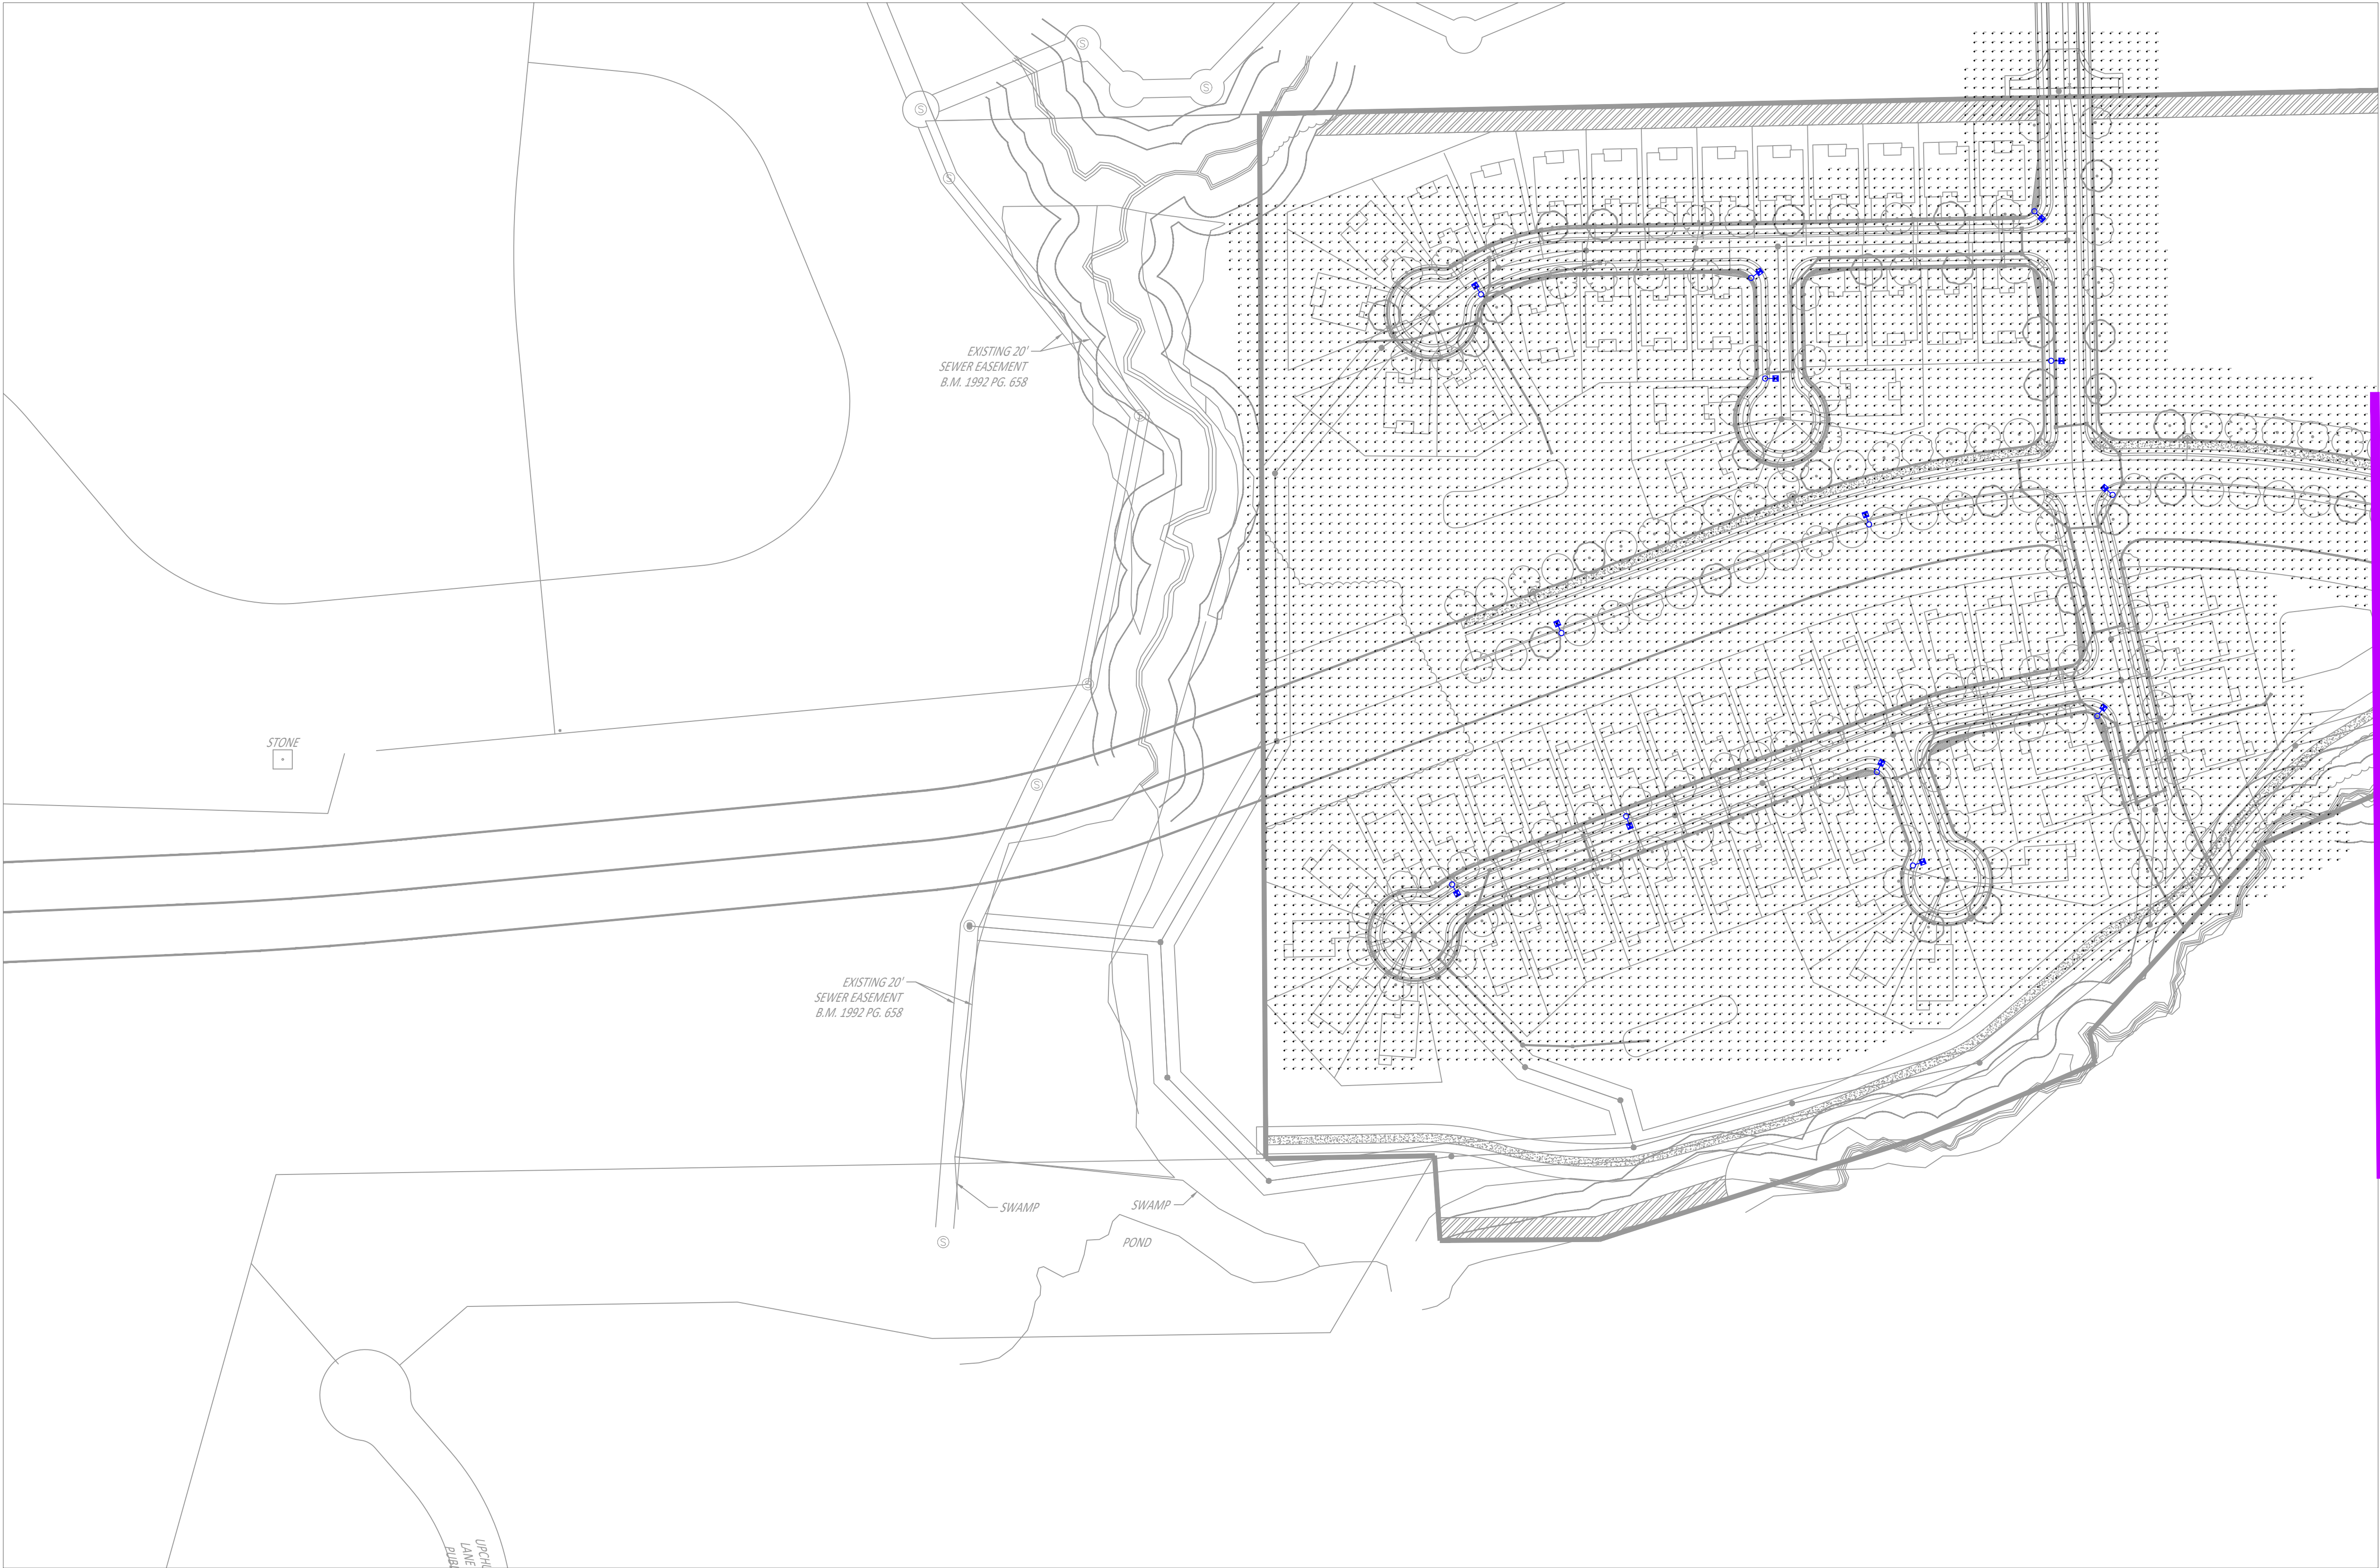

MATCHLINE TO SHEET 2



MICRO LED ROADWAY
(Meets Dark Sky Criteria)

Outdoor Lighting

LED (Light-emitting diode)	53 lumens
Mounting height	20', 25', 35'
Color	3000K Black
Pole	Standard Metal Wood
Applications	Neighborhoods Parks Streets

Light source: LED (white)
Wattage: 50 watts 70 watts
Lumens: 5,232 ~ 8,170
Light pattern:IESNA Type II, V
IESNA cutoff classification: Full cutoff
BULB rating: Type II = B1U002 (50w) B1U002 (70w)
Type II = B1U001
Type V = B1U001 (50w only)
Color temperature: 3,000K


POLE AVAILABLE	MOUNTING HEIGHT	COLOR
Fiberpost	20', 30', 35'	Black (additional cost)
Wood	25', 30', 35'	Standard
Metal (Special conditions)	25', 30', 35'	Galvanized

FEATURES	BENEFITS
Turnkey operation	Provides hassle-free installation and service
Little or no installation cost	Frees up capital for other projects
Design services by lighting professionals included	Meets industry standards and lighting ordinances
Maintenance, electricity & warranty included	Eliminates high and unexpected repair bills
One low monthly cost on your electric bill	Convenience and savings for you

For additional information, contact us at ODL.Carelines@duke-energy.com.

 **DUKE ENERGY** PROGRESS
BUILDING A SUSTAINABLE ENERGY FUTURE™

©2022 Duke Energy Corporation. 220286 SEP 1902

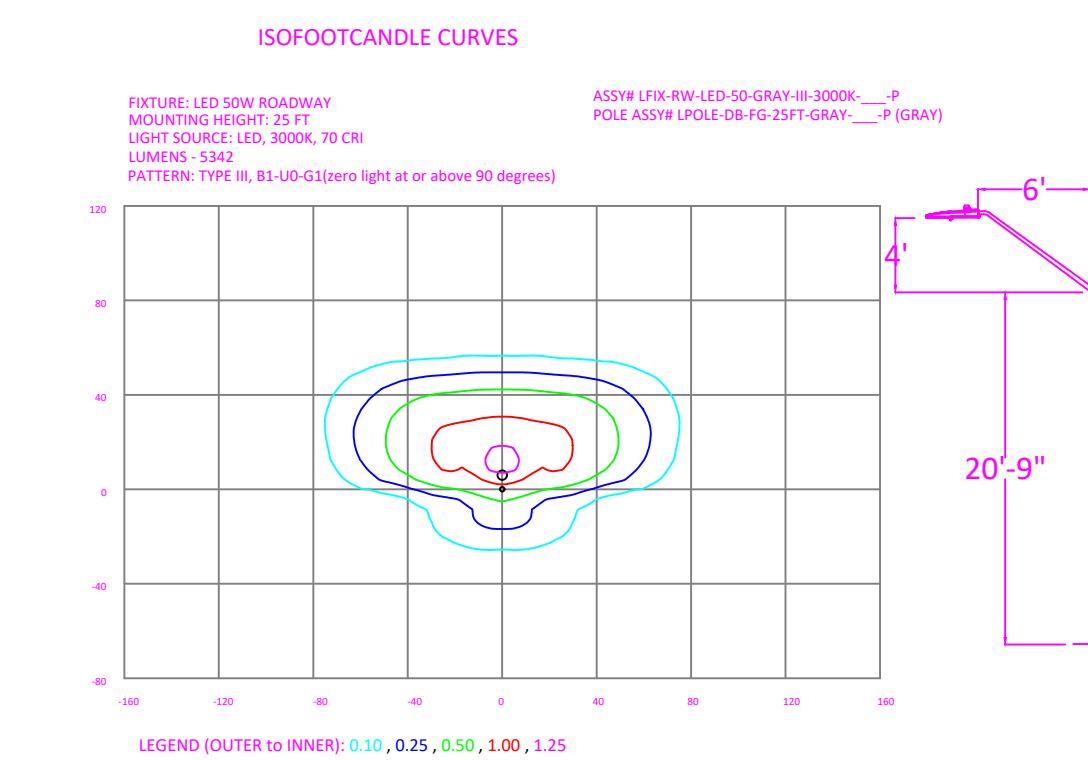


Schedule						
Symbol	Label	Quantity	Description	Number Lamps	Lumens Per Lamp	Light Loss Factor
	A	71	LED 50w Roadway - Type III - 3000K	1	5312	0.85

NO.	DATE	REVISION	BY

LIGHTING DESIGN TOLERANCE

The calculated footcandle light levels in this lighting design are predicted values and are based on specific information that has been supplied to Duke Energy. Any inaccuracies in the supplied information, differences in luminaire installation, lighted area geometry including elevation differences, reflective properties of surrounding surfaces, obstructions (foliage or otherwise) in the lighted area, or lighting from sources other than listed in this design may produce different results from the predicted values. Normal tolerances of voltage, lamp output, and ballast and luminaire manufacture will also affect results.

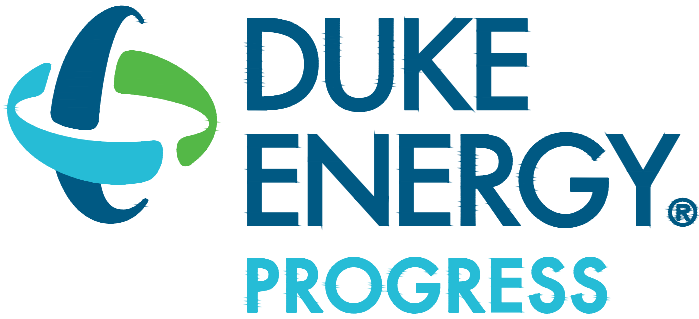

PROPRIETARY & CONFIDENTIAL

This document together with the concepts and designs presented herein, presented as an instrument of service, is the sole property of Duke Energy, and is intended only for the specific purpose and prospective client as stated in the title block of this drawing. Any use, copying, reproduction or disclosure of the drawing, design or any information contained herein by the prospective customer or other entities, including without limitation, architects, engineers, or equipment manufacturers is hereby expressly prohibited and shall not be permitted absent prior written consent from, and payment of compensation to Duke Energy. Duke Energy disclaims any liability or responsibility for any unauthorized use of or reliance on this document.

MERRITT SUBDIVISION		
ROLESVILLE, NC		
STREET LIGHTING ARRANGEMENT		
Designed by	DUKE ENERGY PROGRESS LIGHTING SOLUTIONS	
Reviewed by	A. Herrera	Scale 1" = 100'
Date	4/16/2025	Size Drawing size "D"
Description	LED Roadway	
Drawing No.	25-0160	Sht. 3 OF 3