

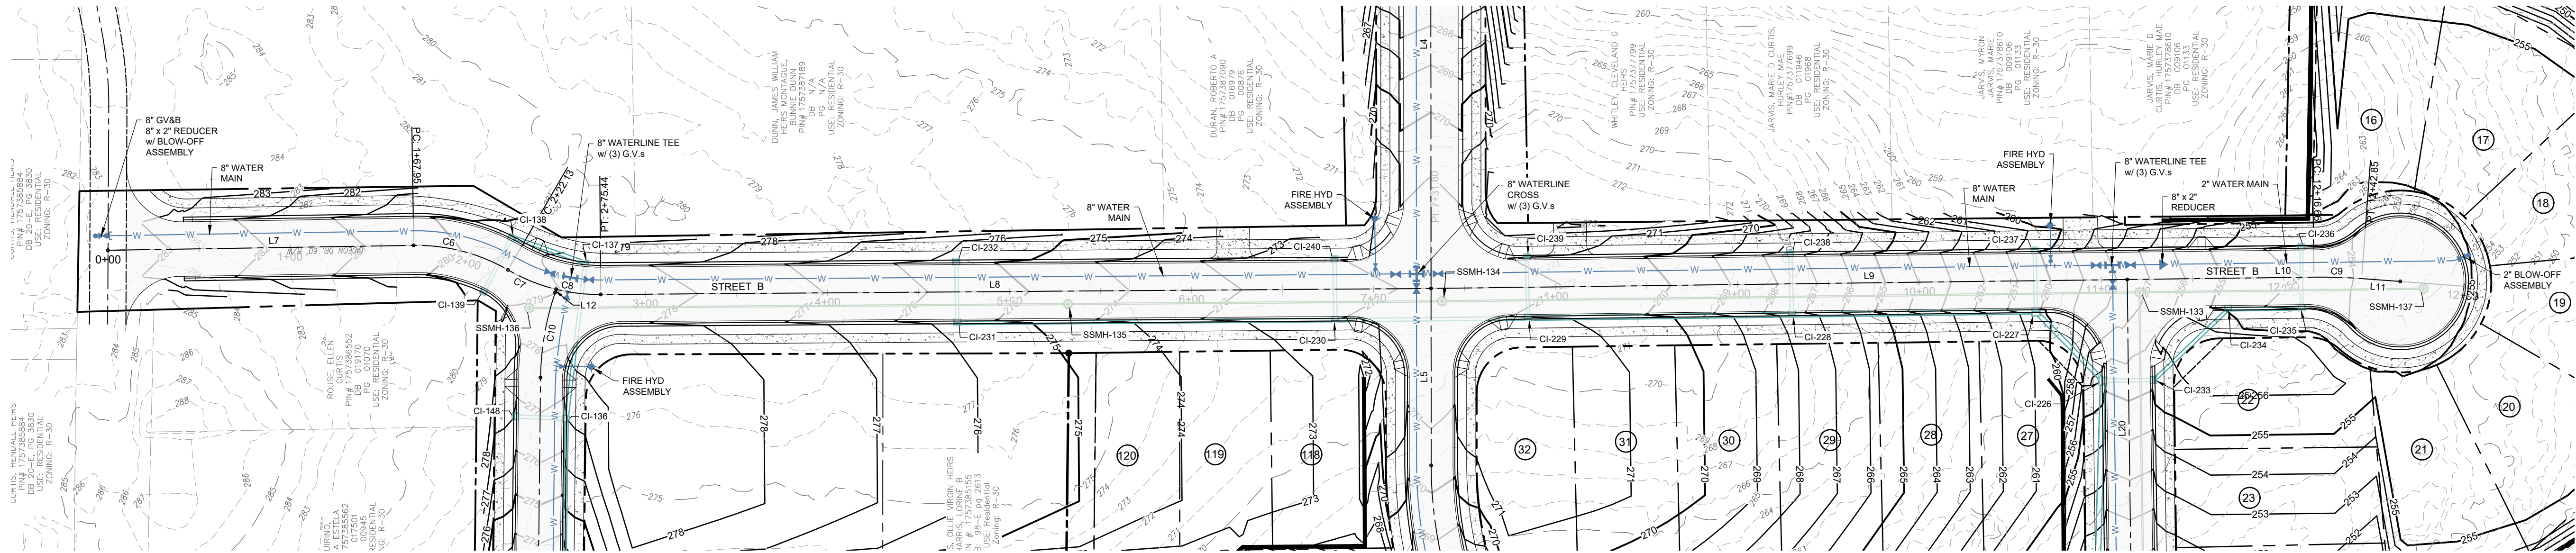


File Location: C:\Users\BryanHarris\OneDrive\Documents\Harris Creek Farm - Jonesville\Engineering\DWG\Construction\Plans\63 Street A Plan & Profile.dwg

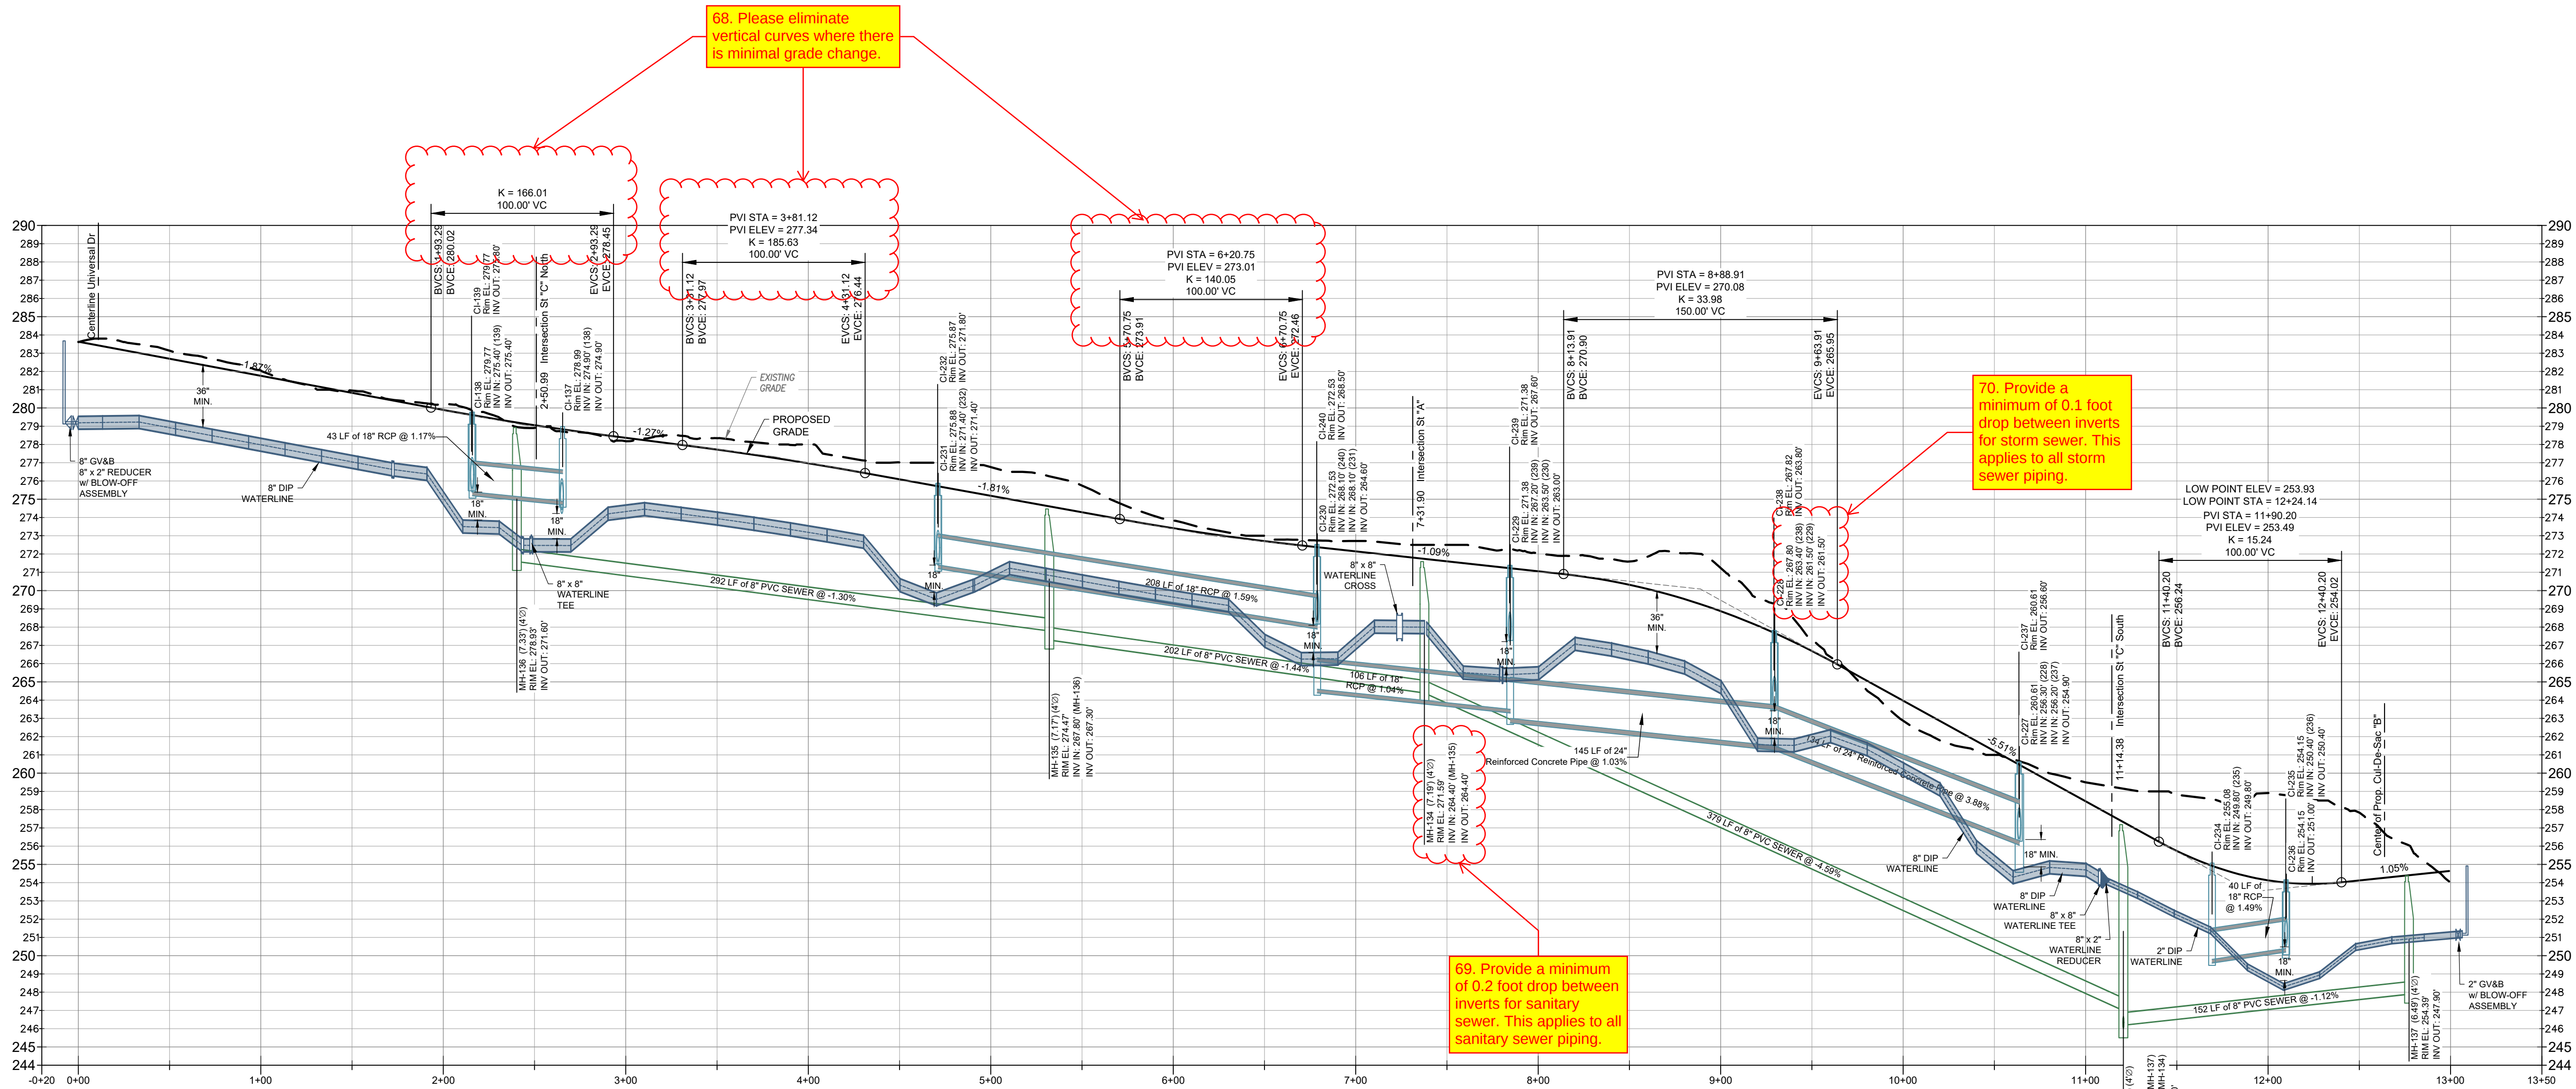


STREET "B" PLAN VIEW

NOTES:
1. SEE SHEET 14 - SITE PLAN Data & Details FOR STREET CENTERLINE LINE AND CURVE DATA.

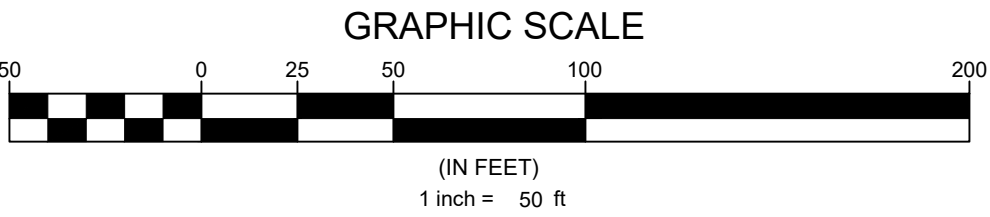

STREET "B" PROFILE VIEW

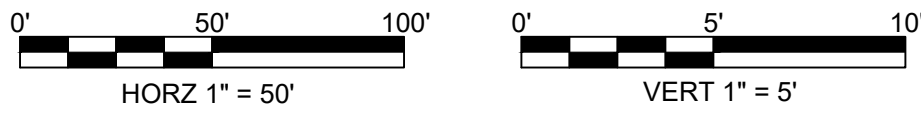

N.C. UNDERGROUND UTILITIES
811
3 DAYS BEFORE DIGGING CALL
TOLL FREE 811 or (800)632-4949
A ONE CALL SYSTEM FOR COMMUNITY AND JOB SAFETY

Developer
THE CSC GROUP
CONTRIBUTE TO THE SUCCESS OF LOCAL COMMUNITY
10030 Green Level Church Rd, Suite 802 #149: Cary, NC 27519

Engineer
QUANTECH ENGINEERING
Firm # F-1517
15000 Weston Parkway
Cary, N.C. 27513
(919) 996-9455

Surveyor

Jurisdiction / Municipality
Rolesville
Town of Rolesville
502 Southtown Cir
Rolesville, NC 27571
Phone: 919-554-6517
PSP-24-05

Other Consultants

Sheet map:

Seal:
PROFESSIONAL ENGINEER
NORTH CAROLINA
SEAL
53676
BRYAN A. HARRIS

FINAL DRAWING - FOR REVIEW PURPOSES ONLY

Issued / Print Date: 2025-May-30 (17:49)
File Name: 53 Street A Plan & Profile.dwg

Last Saved by: Tim Newsome
Drawn by: TAN

Project:
HARRIS CREEK FARMS
CID-25-??


Issued for: PROGRESS DRAWINGS
DO NOT USE FOR CONSTRUCTION

No.	Date	Description
-----	------	-------------


Sheet Title:
STREET B PLAN & PROFILE

Sheet #:

File Location: C:\Users\BryanHarris\Quantech\Engineering - Documents\Harris Creek Farm - Jonesville\Engineering - DWG\Construction Plans\63 Street A - Plan & Profile.dwg


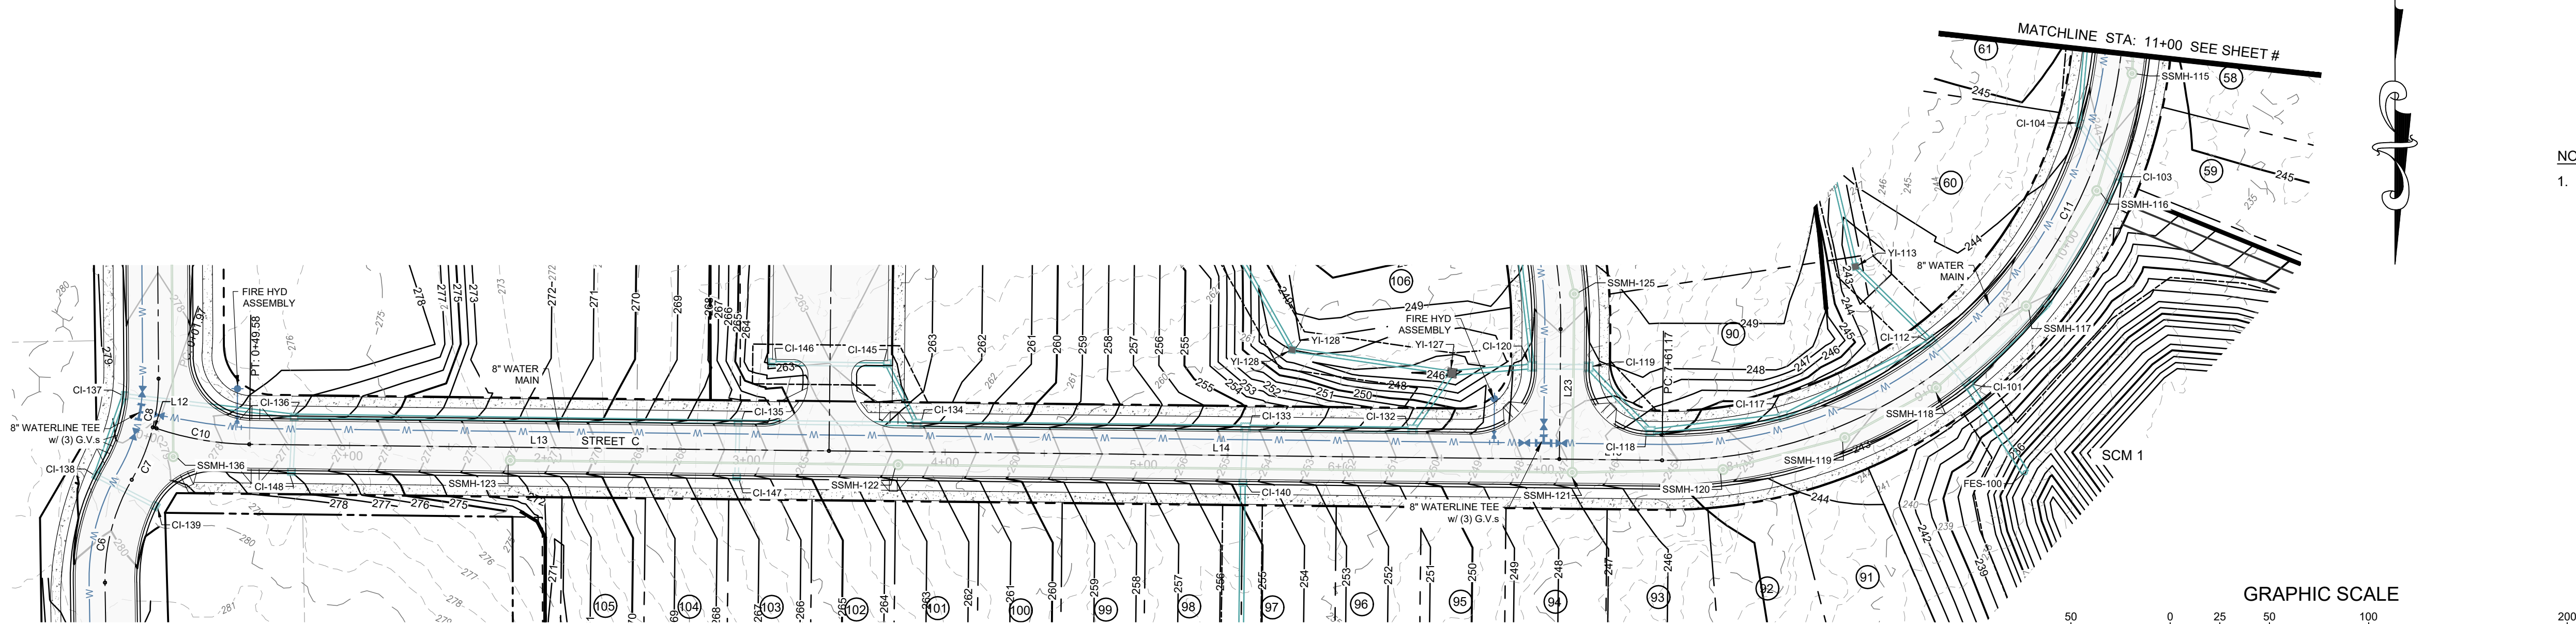


STREET "C" PLAN VIEW STA: 0+00 - 11+00

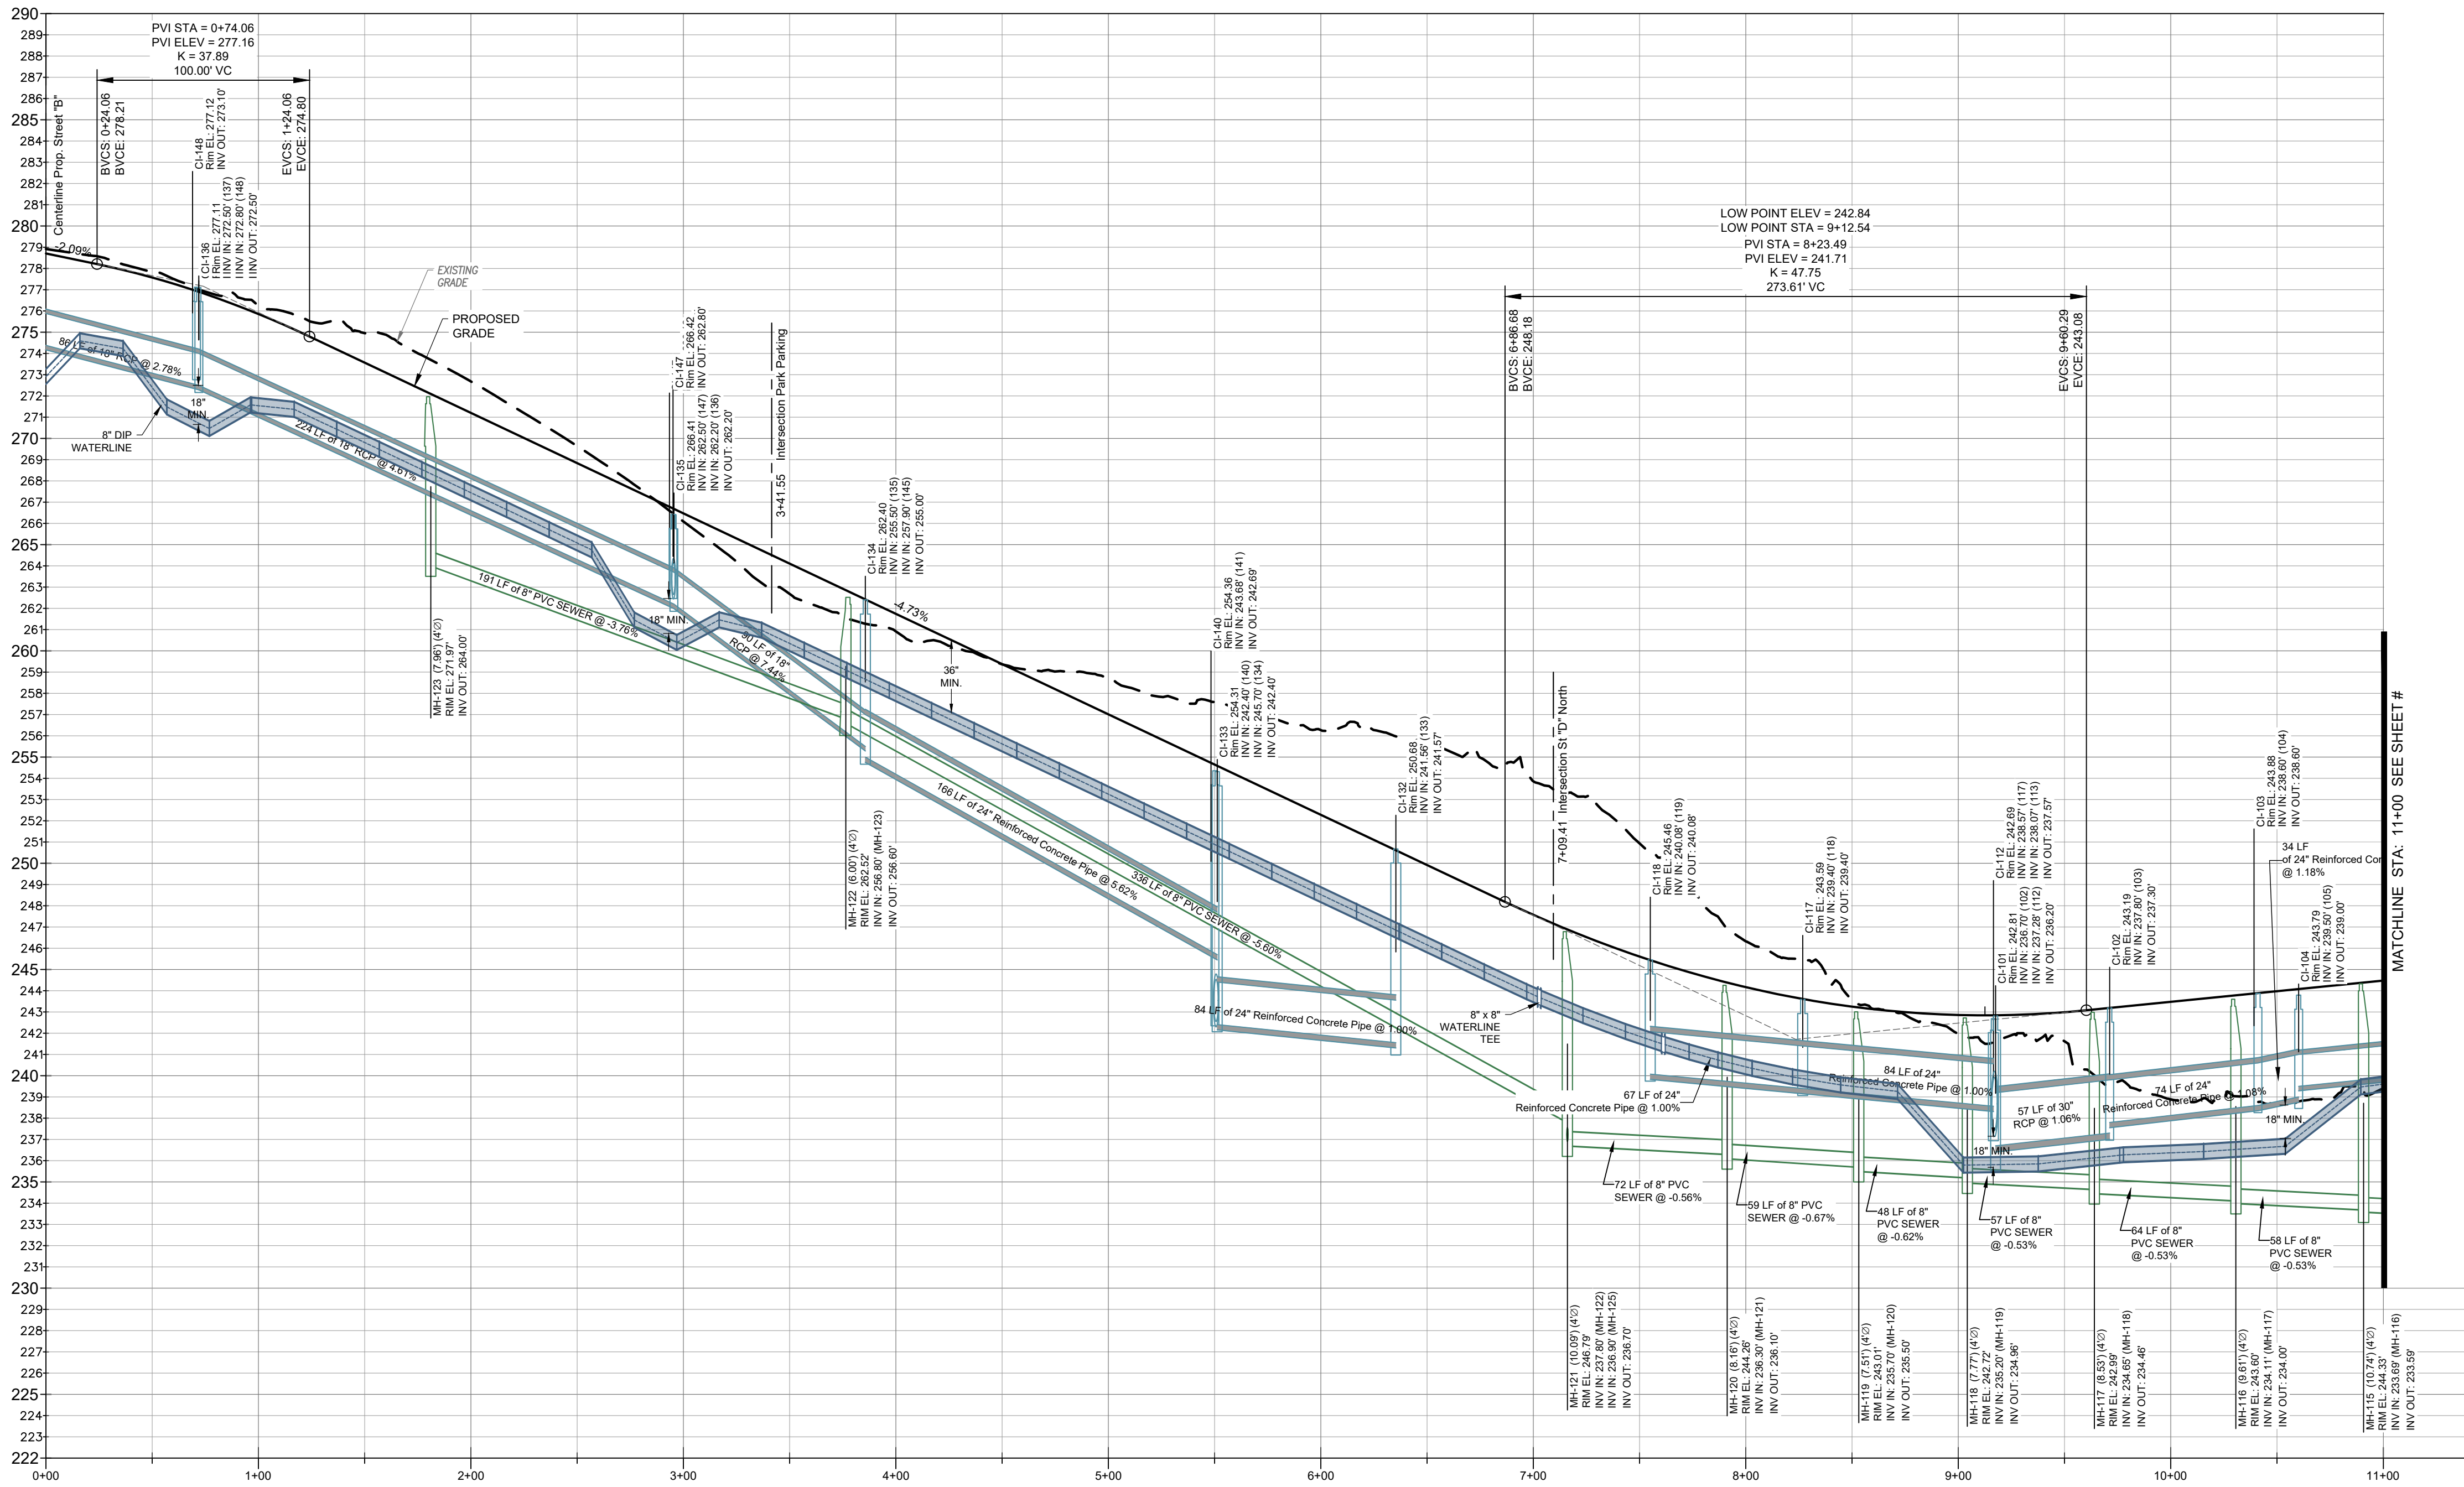

STREET "C" PROFILE VIEW STA: 0+00 - 11+00

- NOTES:
- SEE SHEET 14 - SITE PLAN Data & Details FOR STREET CENTERLINE LINE AND CURVE DATA.

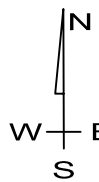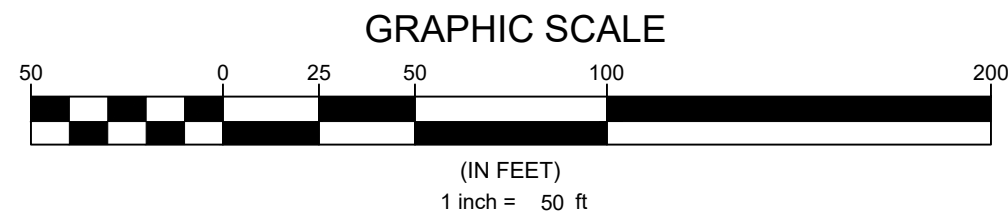

Developer



10030 Green Level Church Rd, Suite 802 #149: Cary, NC 27519

Engineer



Firm # F-1517

15000 Weston Parkway
Cary, N.C. 27513
(919) 996-9455

Surveyor

Jurisdiction / Municipality

Town of Rolesville
502 Southtown Cir
Rolesville, NC 27571
Phone: 919-554-6517
PSP-24-05

Other Consultants

Sheet map:

Seal:



FINAL DRAWING - FOR
REVIEW PURPOSES ONLY

Issued / Print Date: 2025-May-30 (17:50)
File Name: 53 Street A Plan & Profile.dwg

Last Saved by: Tim Newsome
Drawn by: TAN

Project:

**HARRIS CREEK
FARMS**

CID-25-??

Issued for: PROGRESS DRAWINGS
DO NOT USE FOR
CONSTRUCTION

REVISIONS

No. Date Description

Sheet Title:

**STREET C PLAN &
PROFILE 0+00 -
11+00**


Sheet #:

55


N.C. UNDERGROUND UTILITIES

3 DAYS BEFORE DIGGING CALL
TOLL FREE 811 or (800)632-4949



A ONE CALL SYSTEM FOR COMMUNITY AND JOB SAFETY

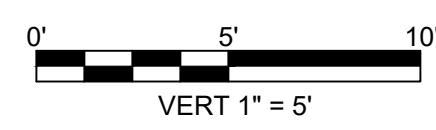


File Location: C:\Users\BryanHarris\Quantech\Engineering - Documents\Harris Creek Farm - Jonesville\Engineering\DWG\Construction\Plans\63 Street A Plan & Profile.dwg

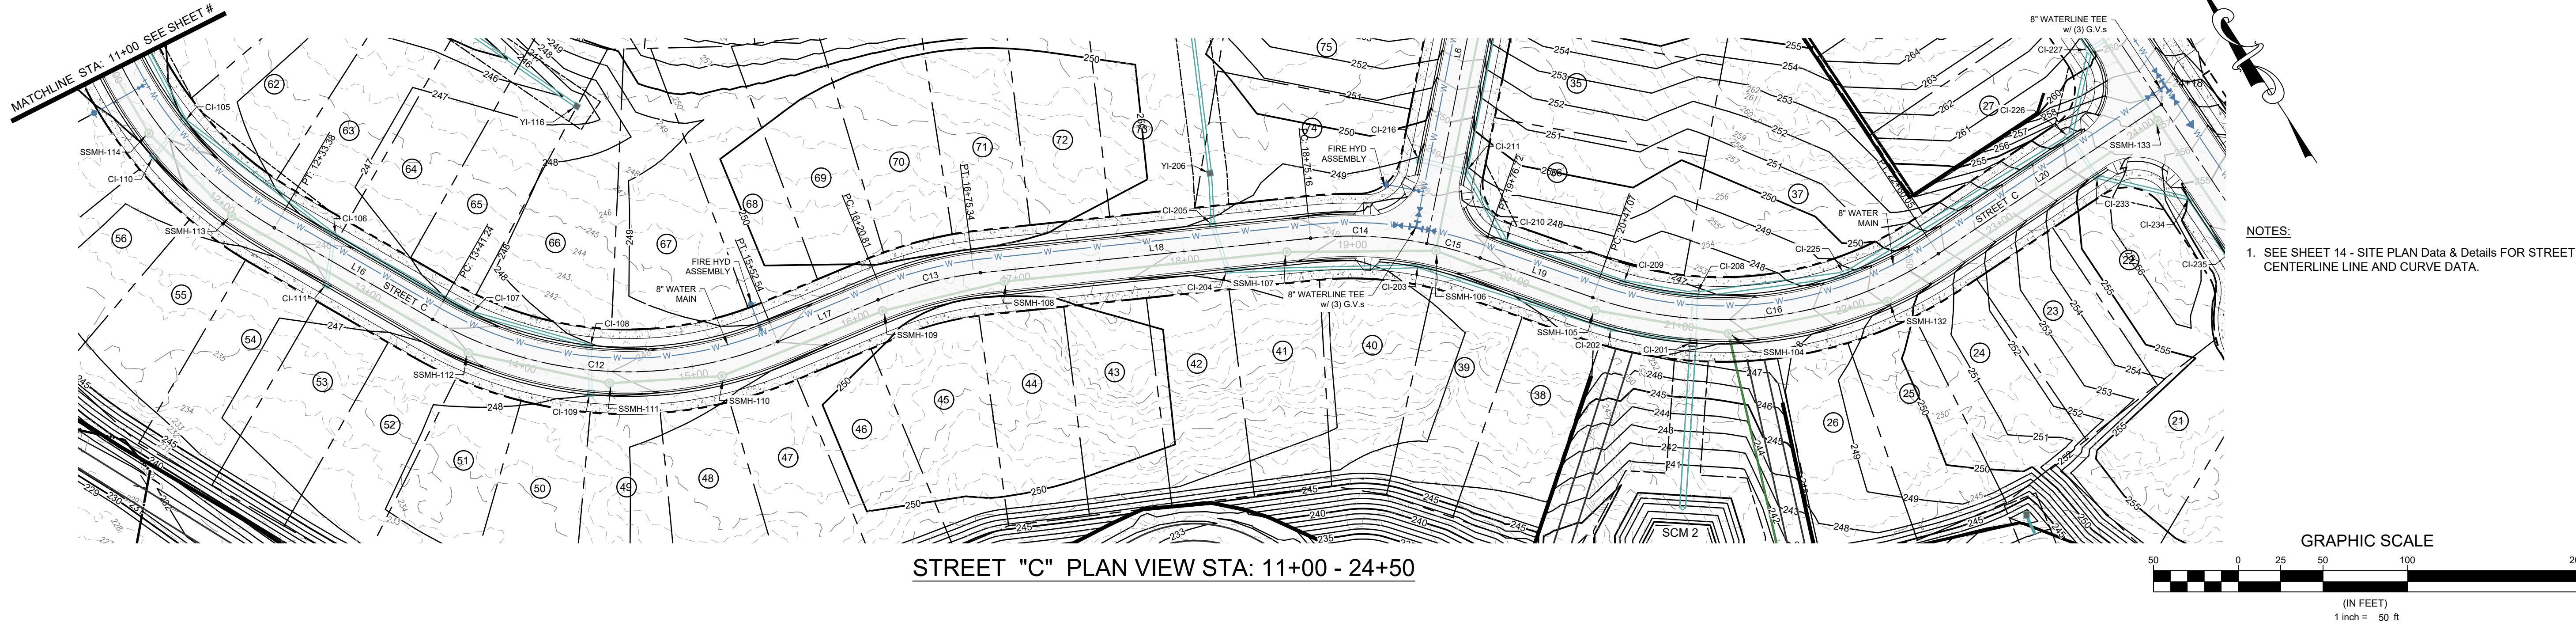

NOTES:
1. SEE SHEET 14 - SITE PLAN Data & Details FOR STREET CENTERLINE LINE AND CURVE DATA.

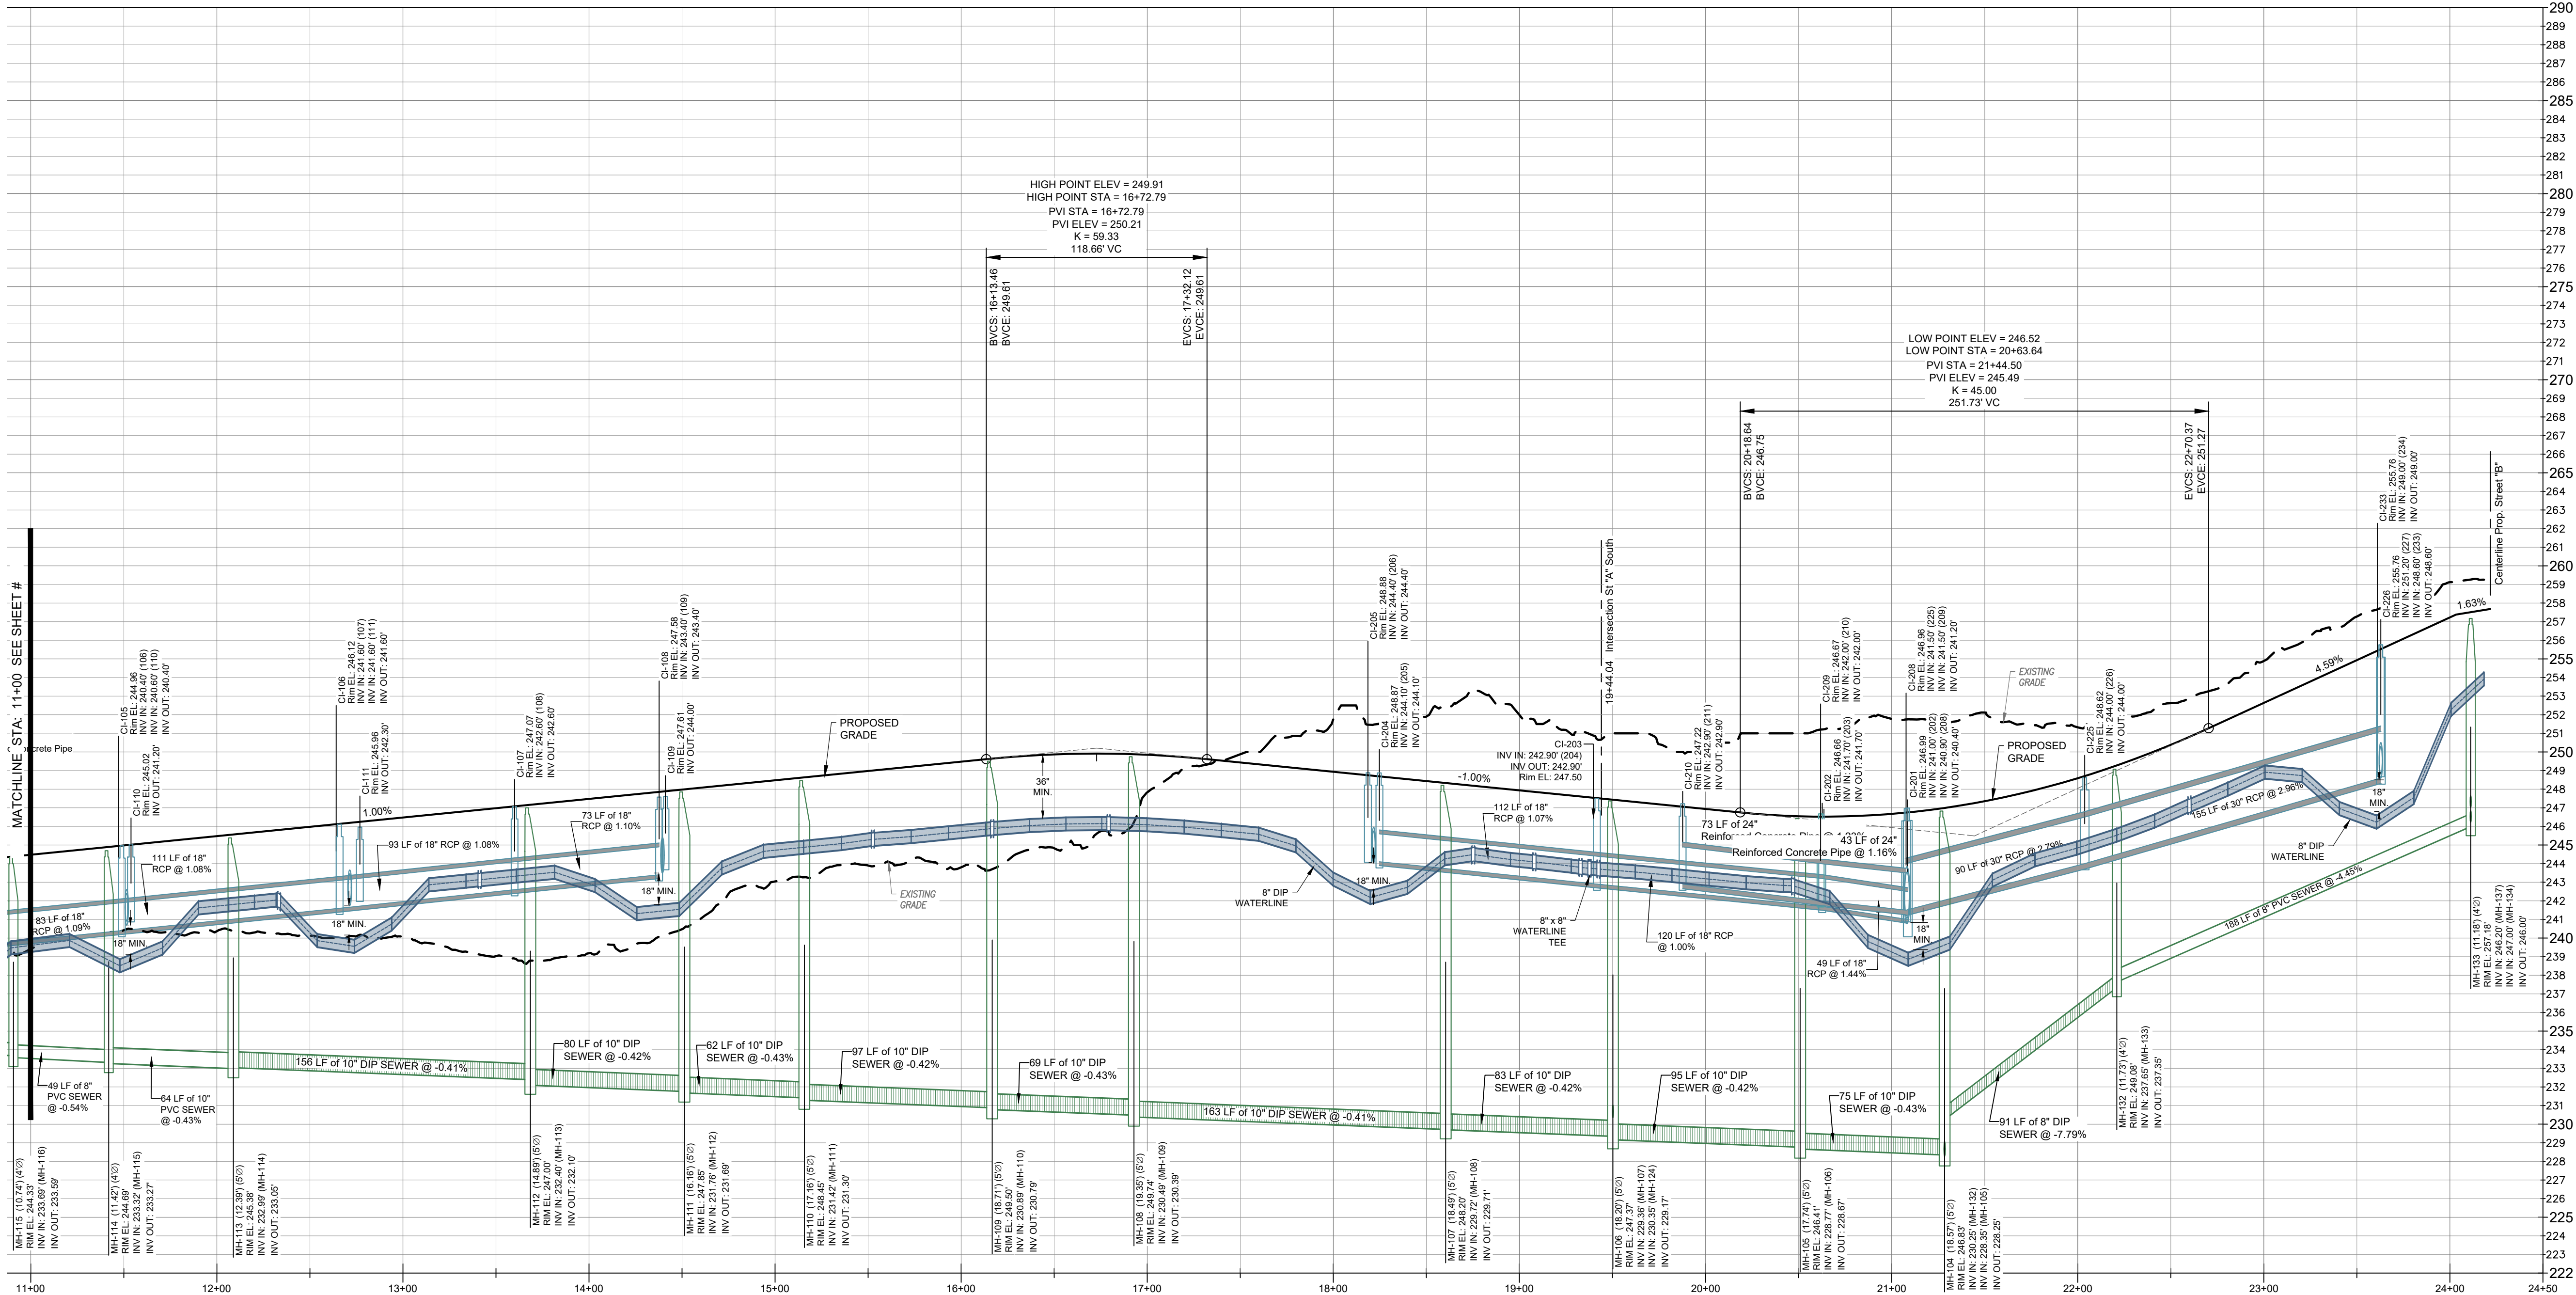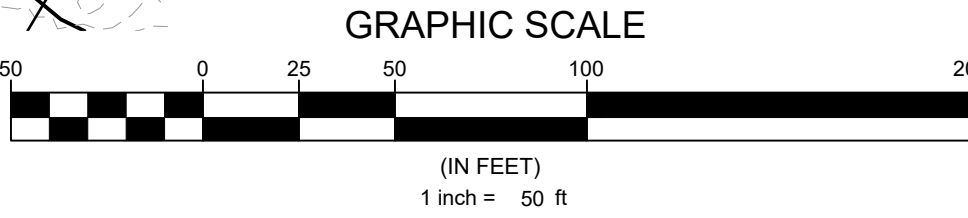

STREET "C" PROFILE VIEW STA: 11+00 - 24+50

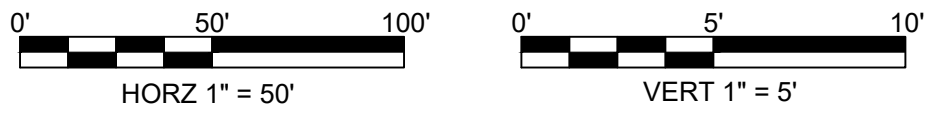

N.C. UNDERGROUND UTILITIES
811
3 DAYS BEFORE DIGGING CALL
TOLL FREE 811 or (800)632-4949
A ONE CALL SYSTEM FOR COMMUNITY AND JOB SAFETY

Developer

**THE CSC GROUP**
CONTRIBUTE TO THE SUCCESS OF LOCAL COMMUNITY
10030 Green Level Church Rd, Suite 802 #149, Cary, NC 27519

Engineer

**QUANTECH ENGINEERING**
Firm # F-1517
15000 Weston Parkway
Cary, N.C. 27513
(919) 996-9455

Surveyor


Jurisdiction / Municipality

**Rolesville**
Town of Rolesville
502 Southtown Cir
Rolesville, NC 27571
Phone: 919-554-6517
PSP-24-05

Other Consultants

Sheet map:

Seal:

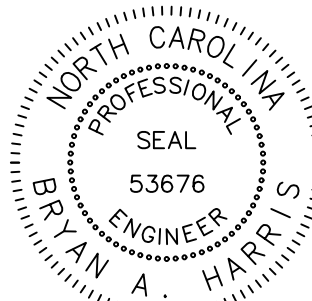

FINAL DRAWING - FOR REVIEW PURPOSES ONLY

Issued / Print Date: 2025-May-30 (17:50)
File Name: 53 Street A Plan & Profile.dwg

Last Saved by: Tim Newsome
Drawn by: TAN

Project:

HARRIS CREEK FARMS
CID-25-??

Issued for: PROGRESS DRAWINGS
DO NOT USE FOR CONSTRUCTION

REVISIONS








No.	Date	Description
-----	------	-------------

Sheet Title:









STREET C PLAN & PROFILE 11+00 - 24+50

Sheet #:

56

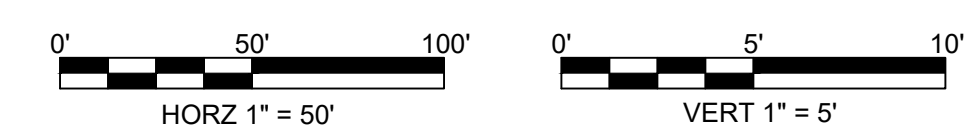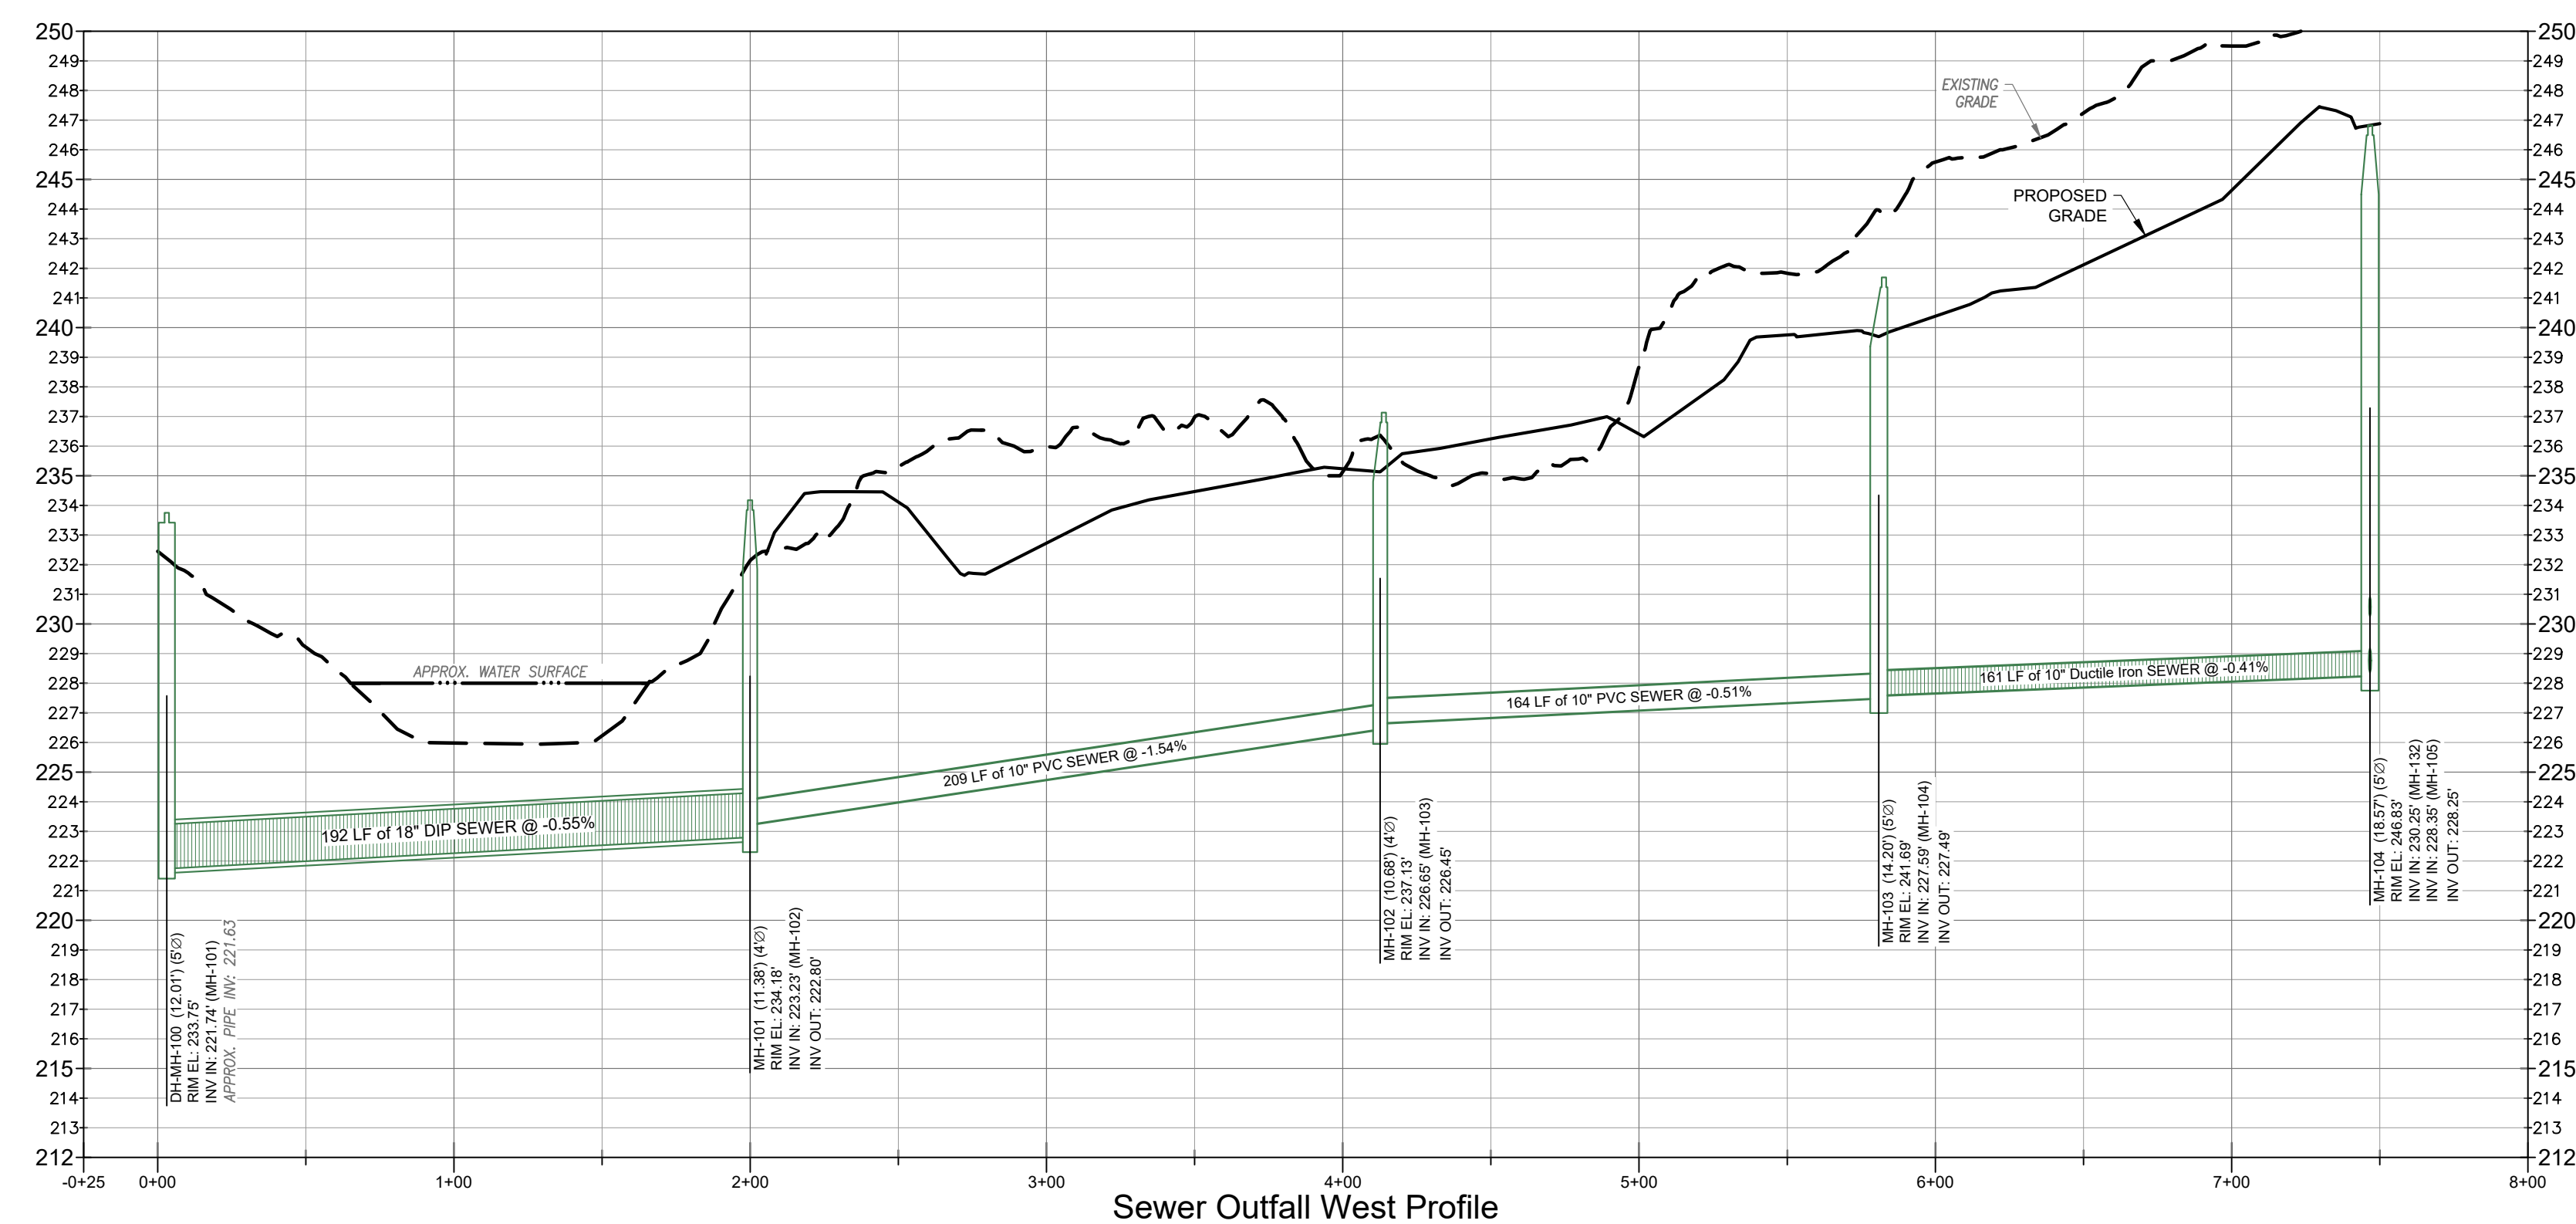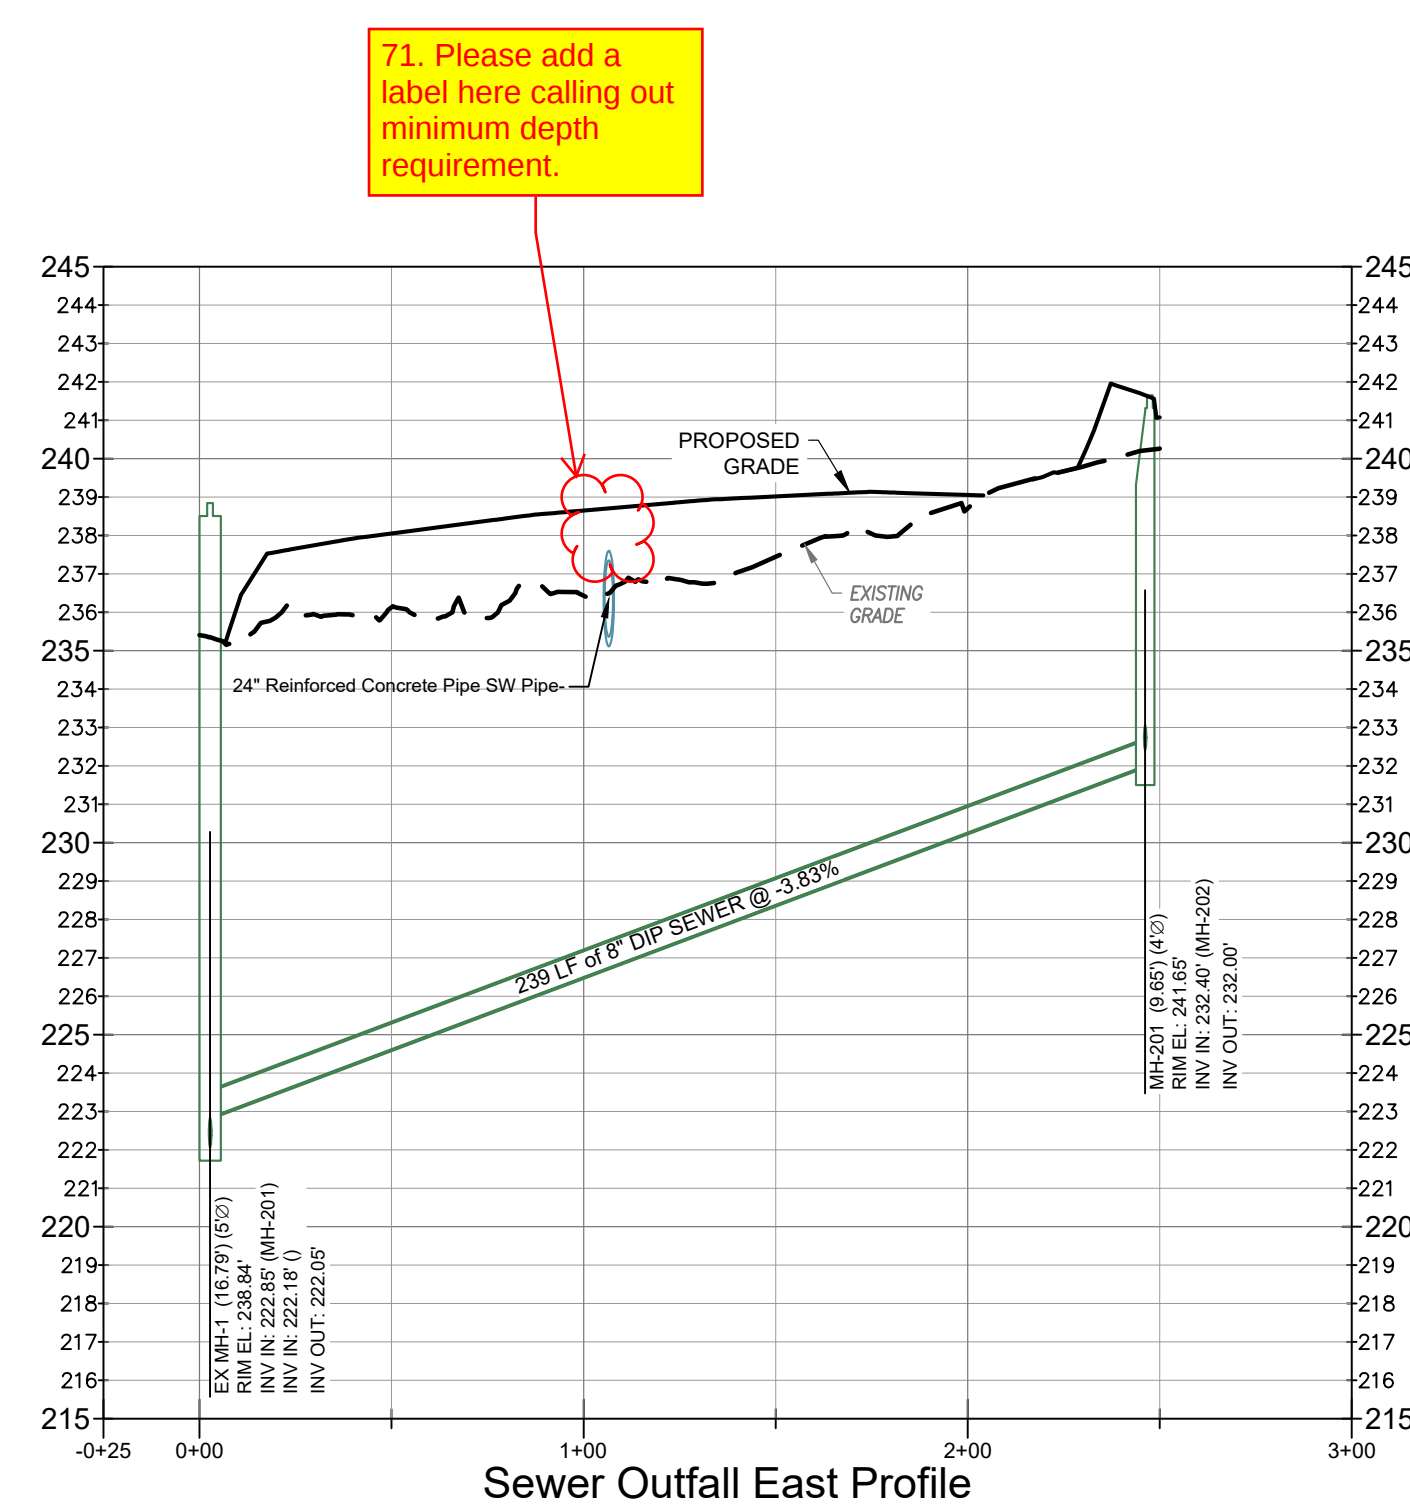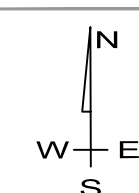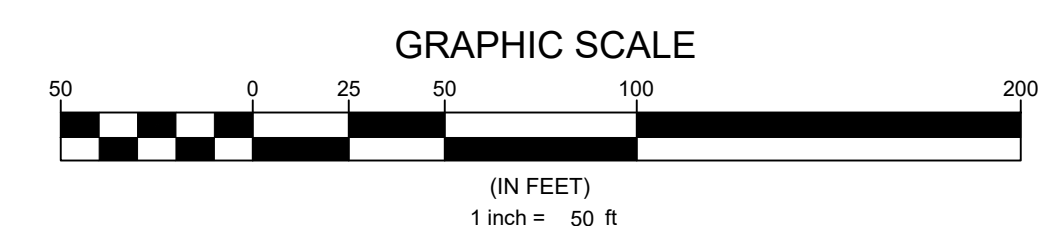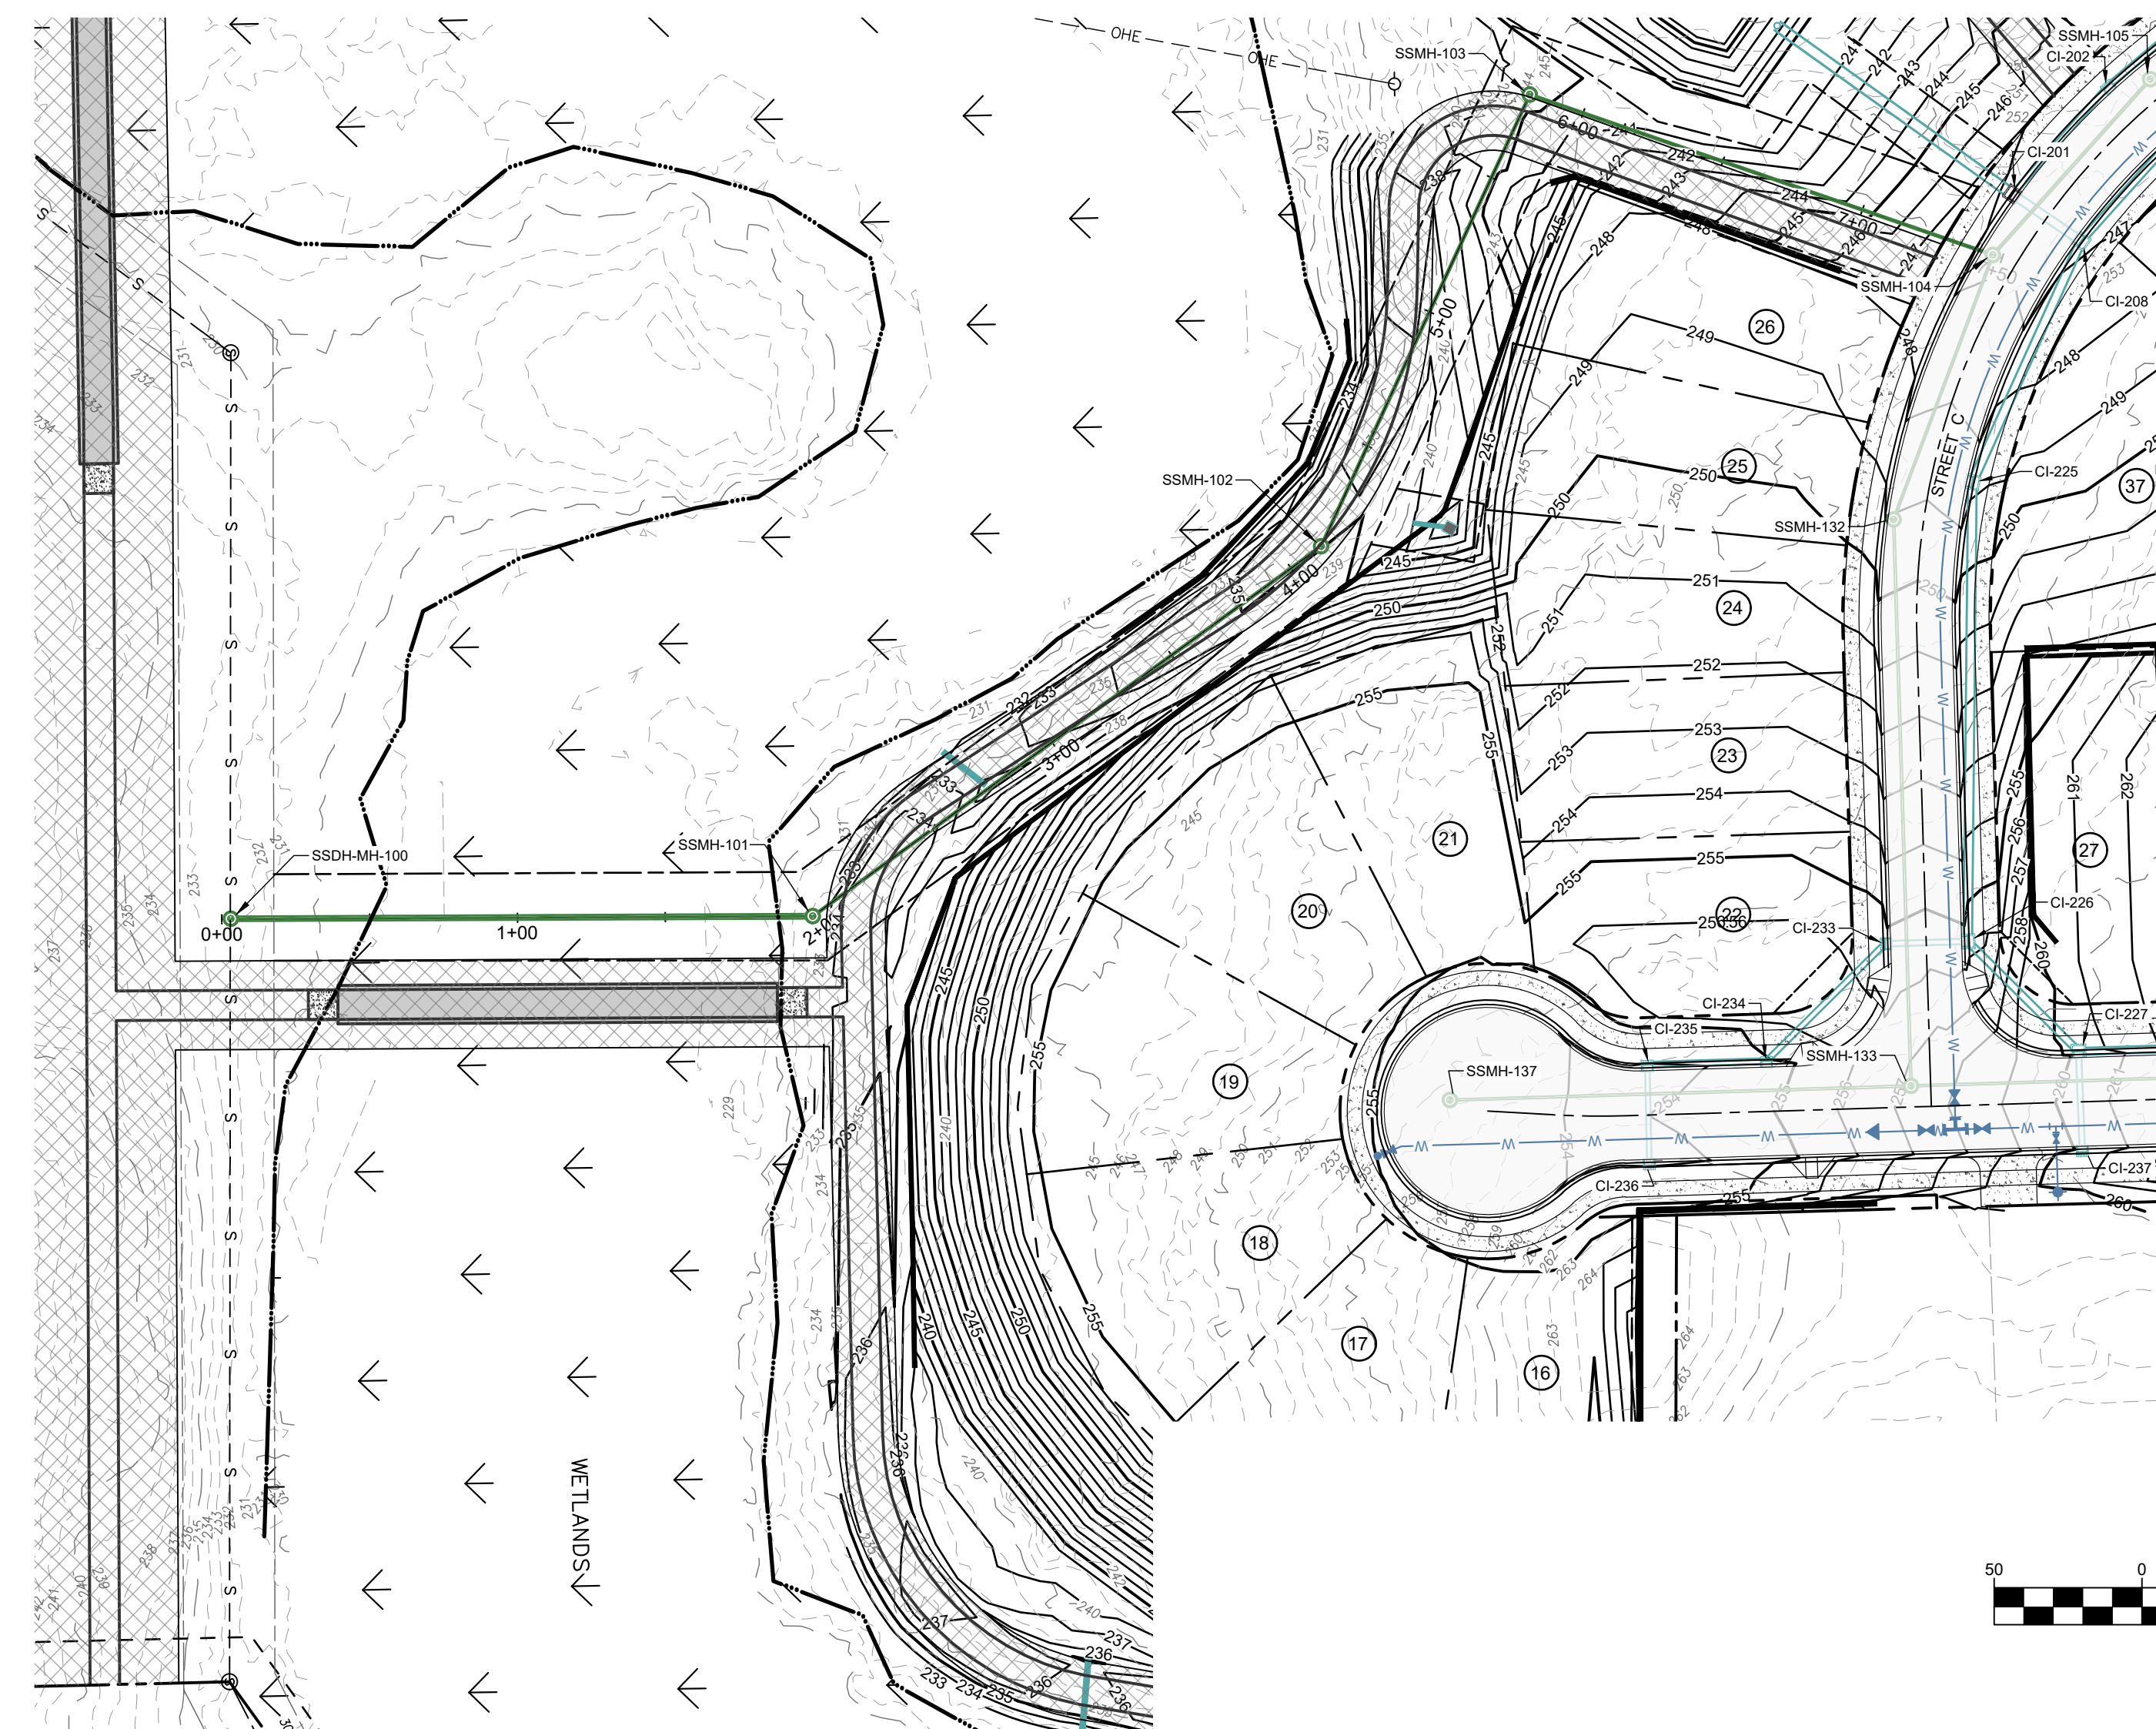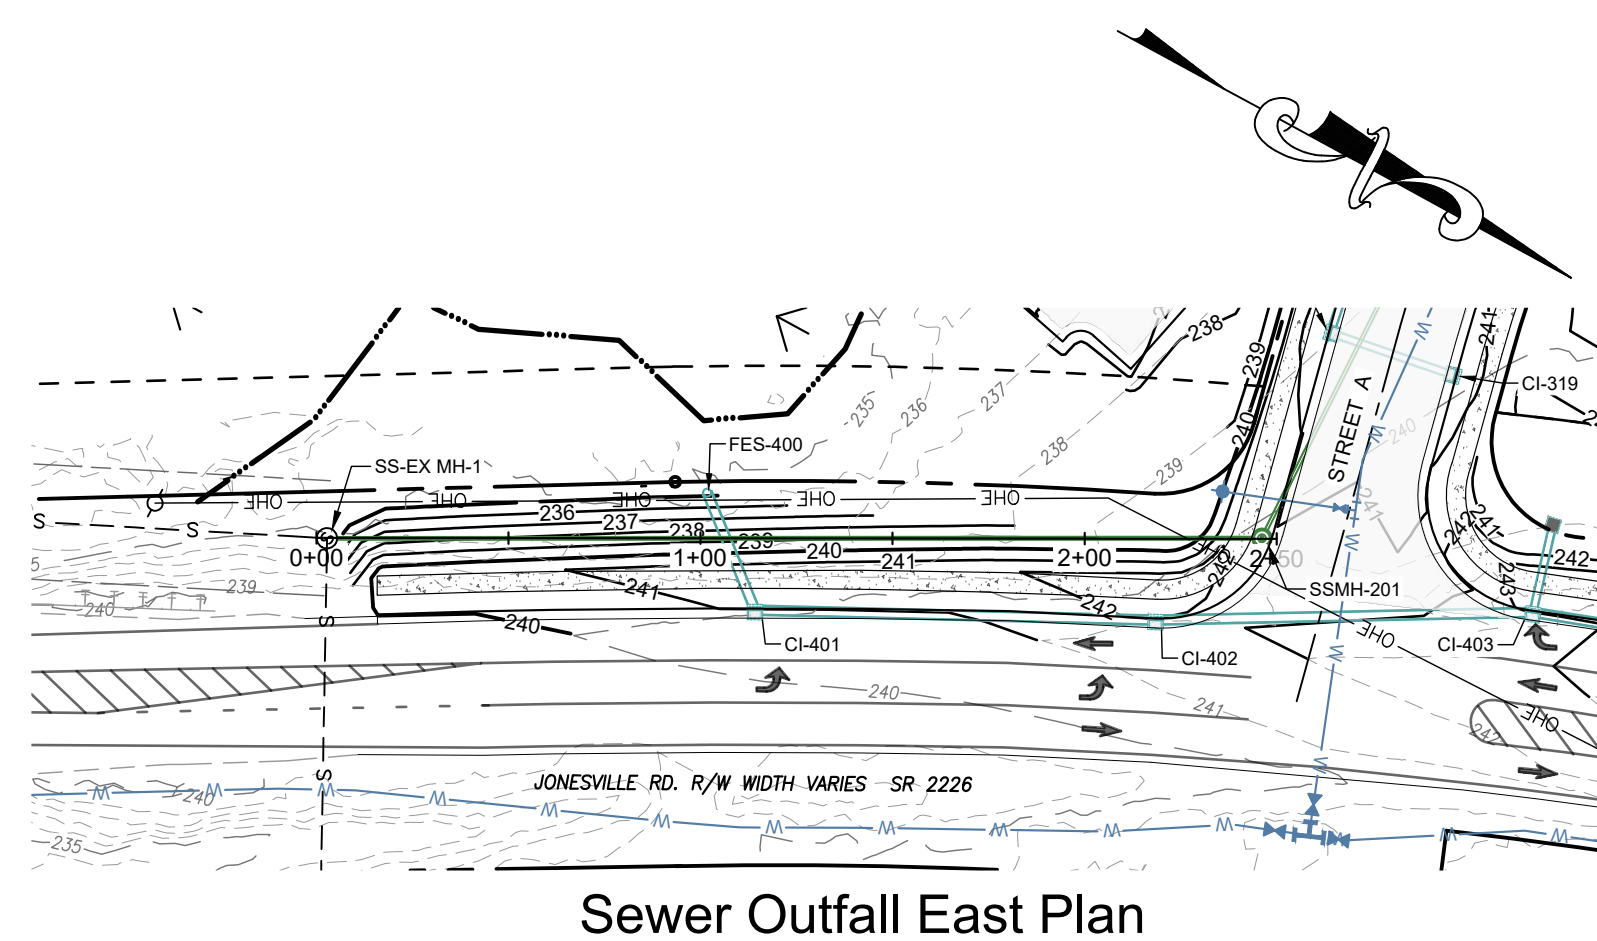

File Location: C:\Users\BryanHarris\Quantech\Engineering - Documents\Harris Creek Farm - Jonesville\Engineering - DWG\Construction Plans\63 Street A - Plan & Profile.dwg

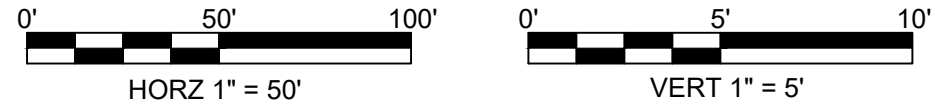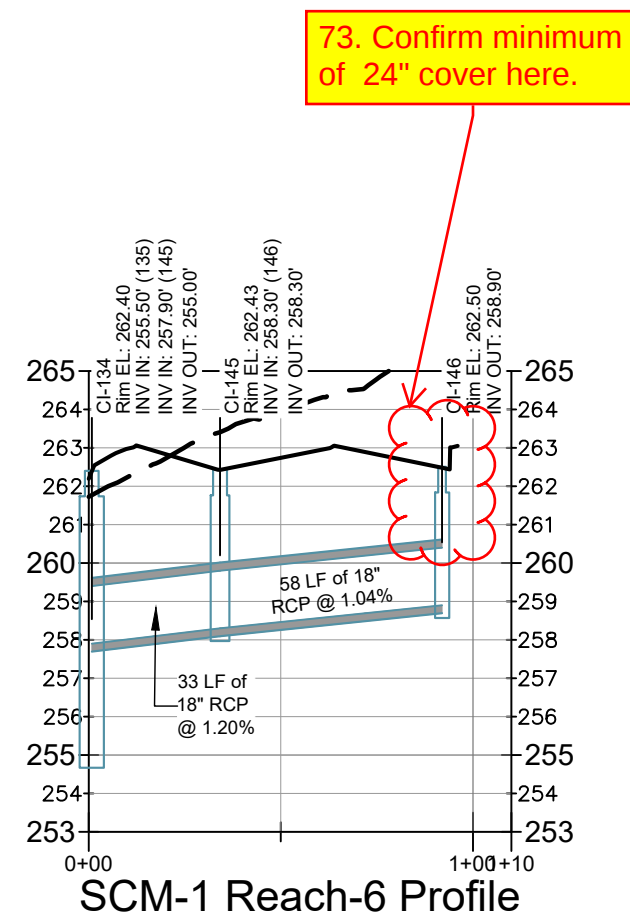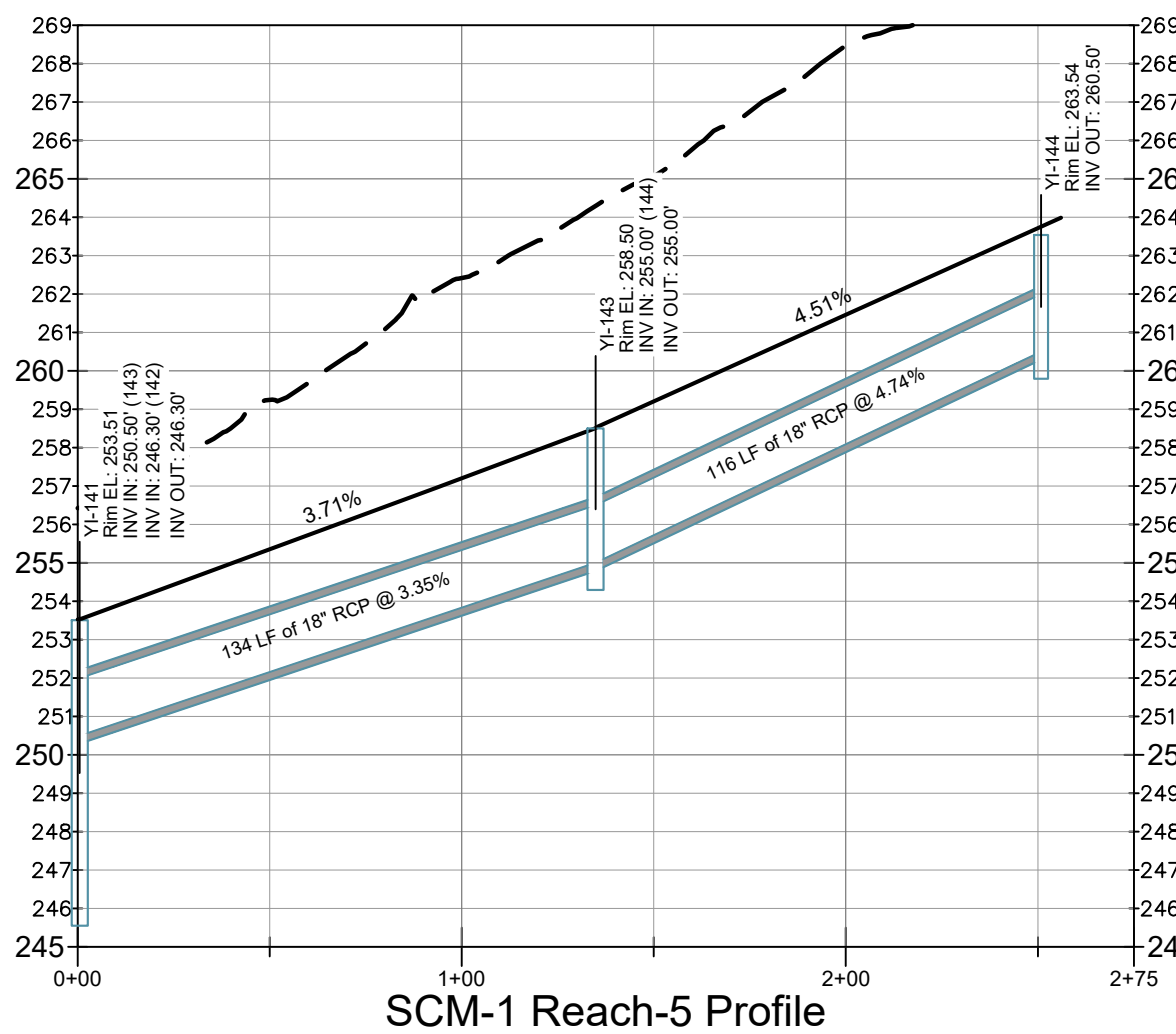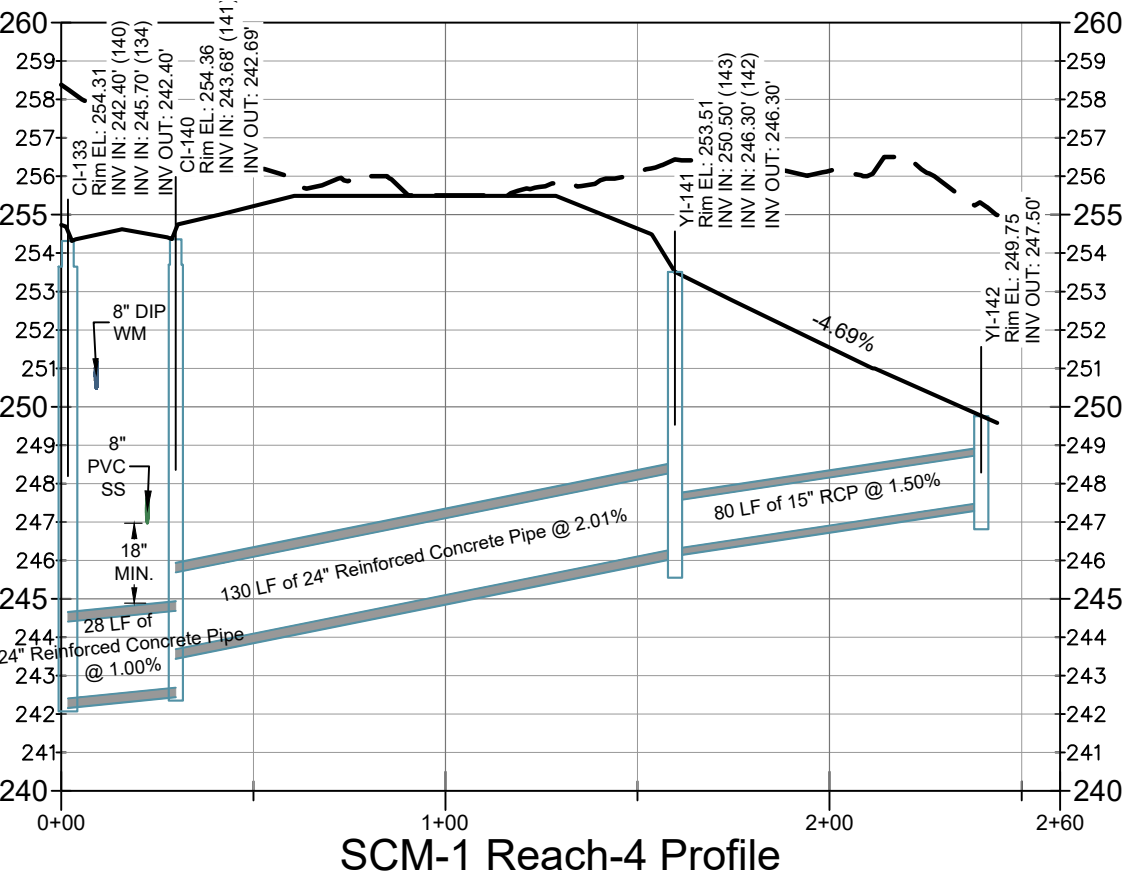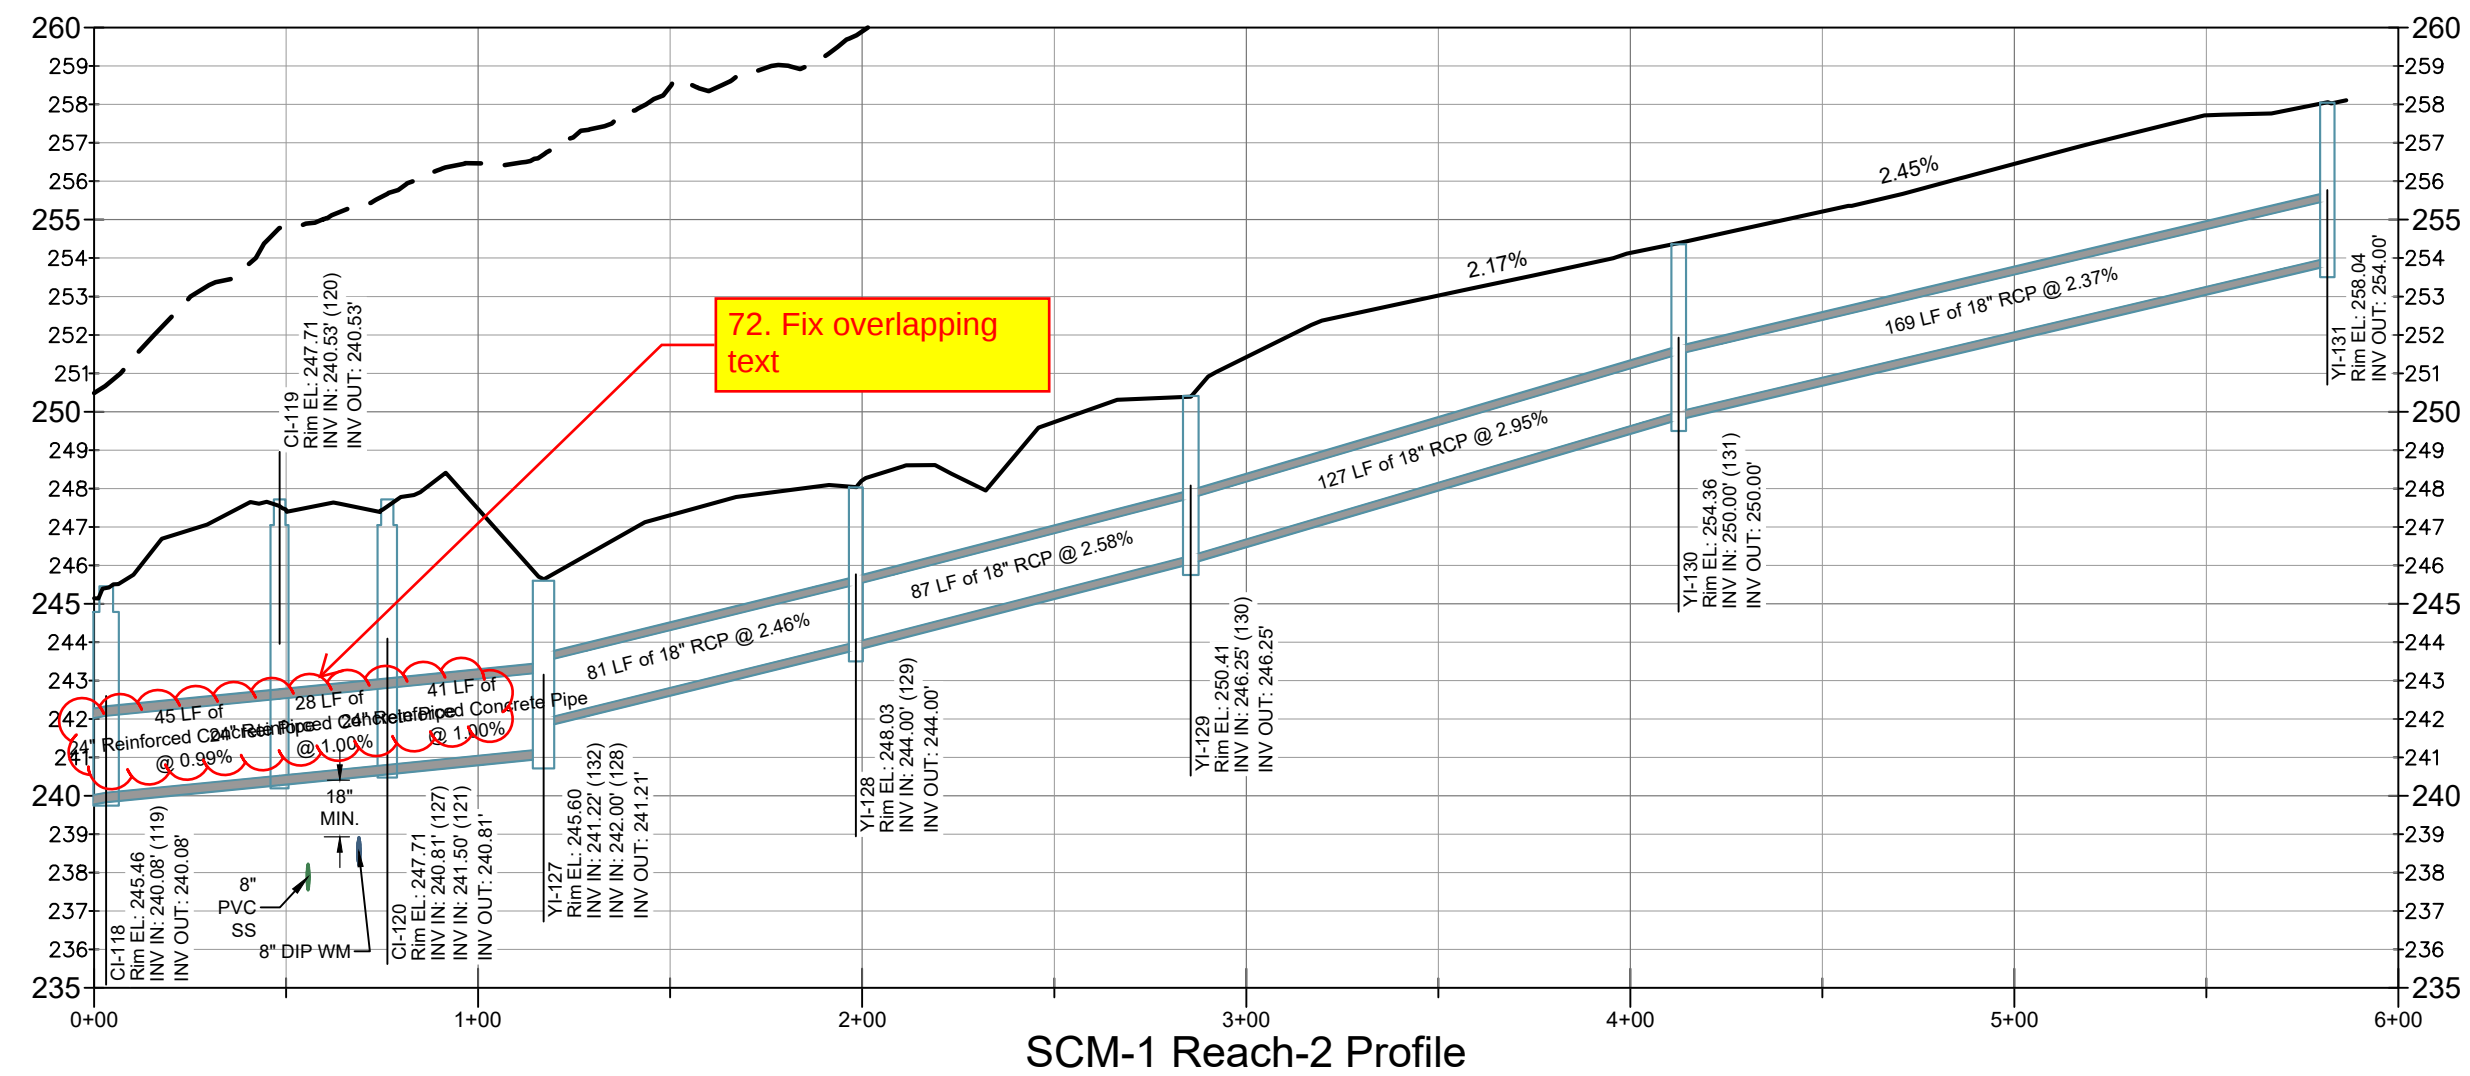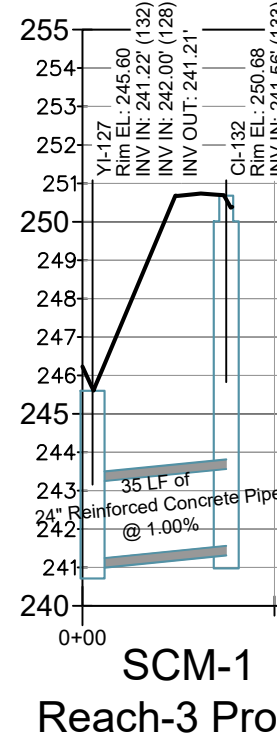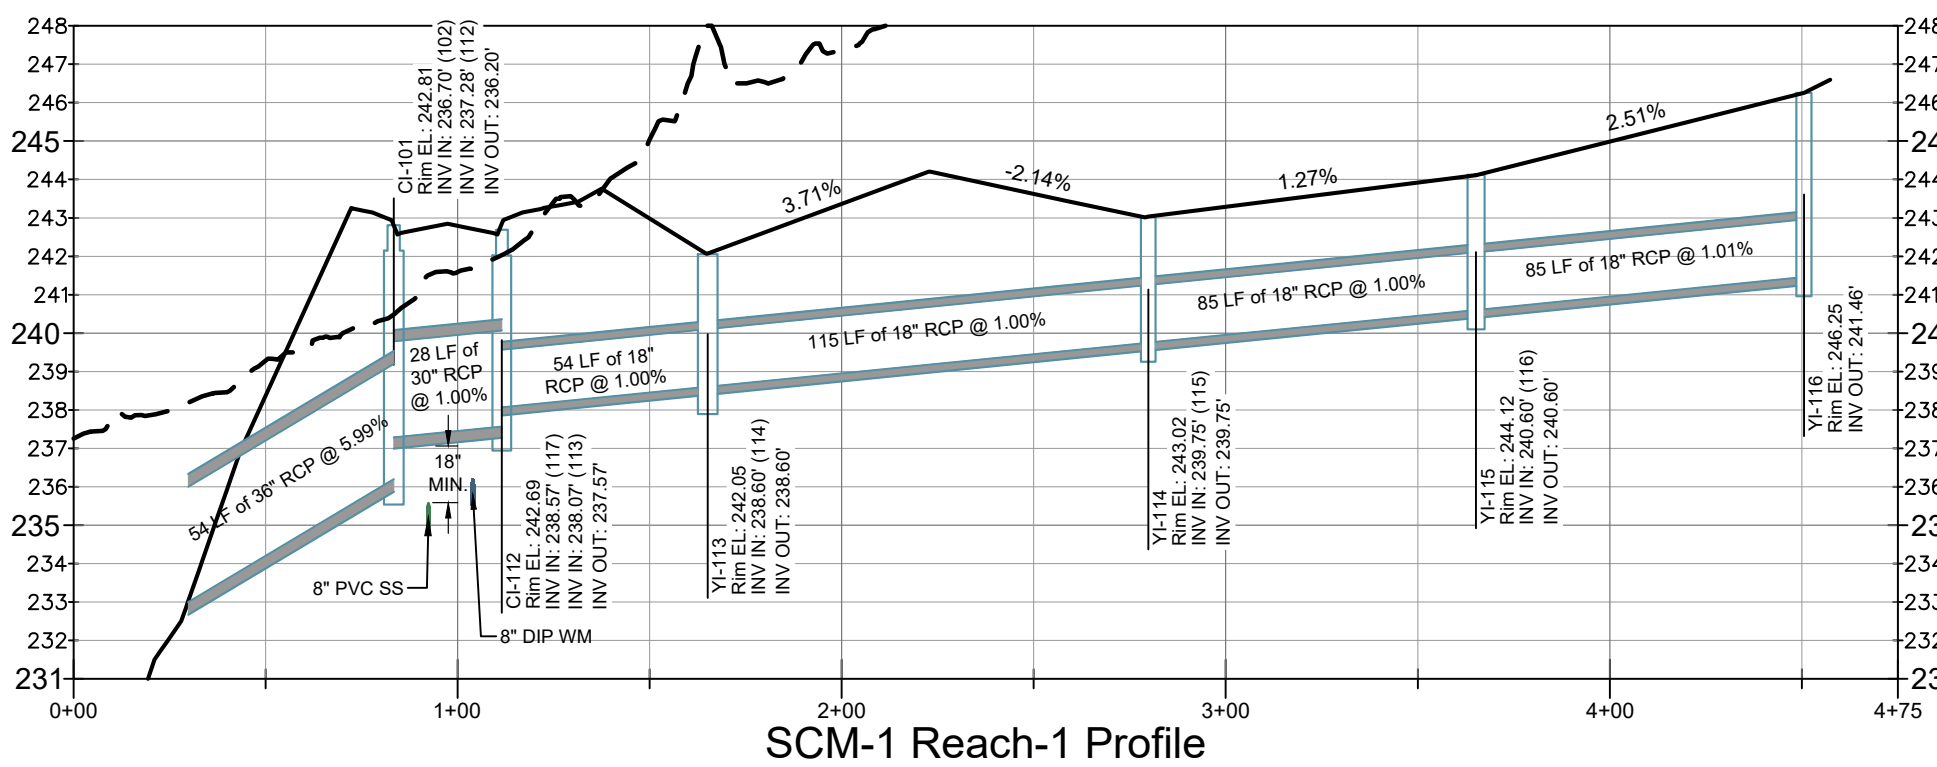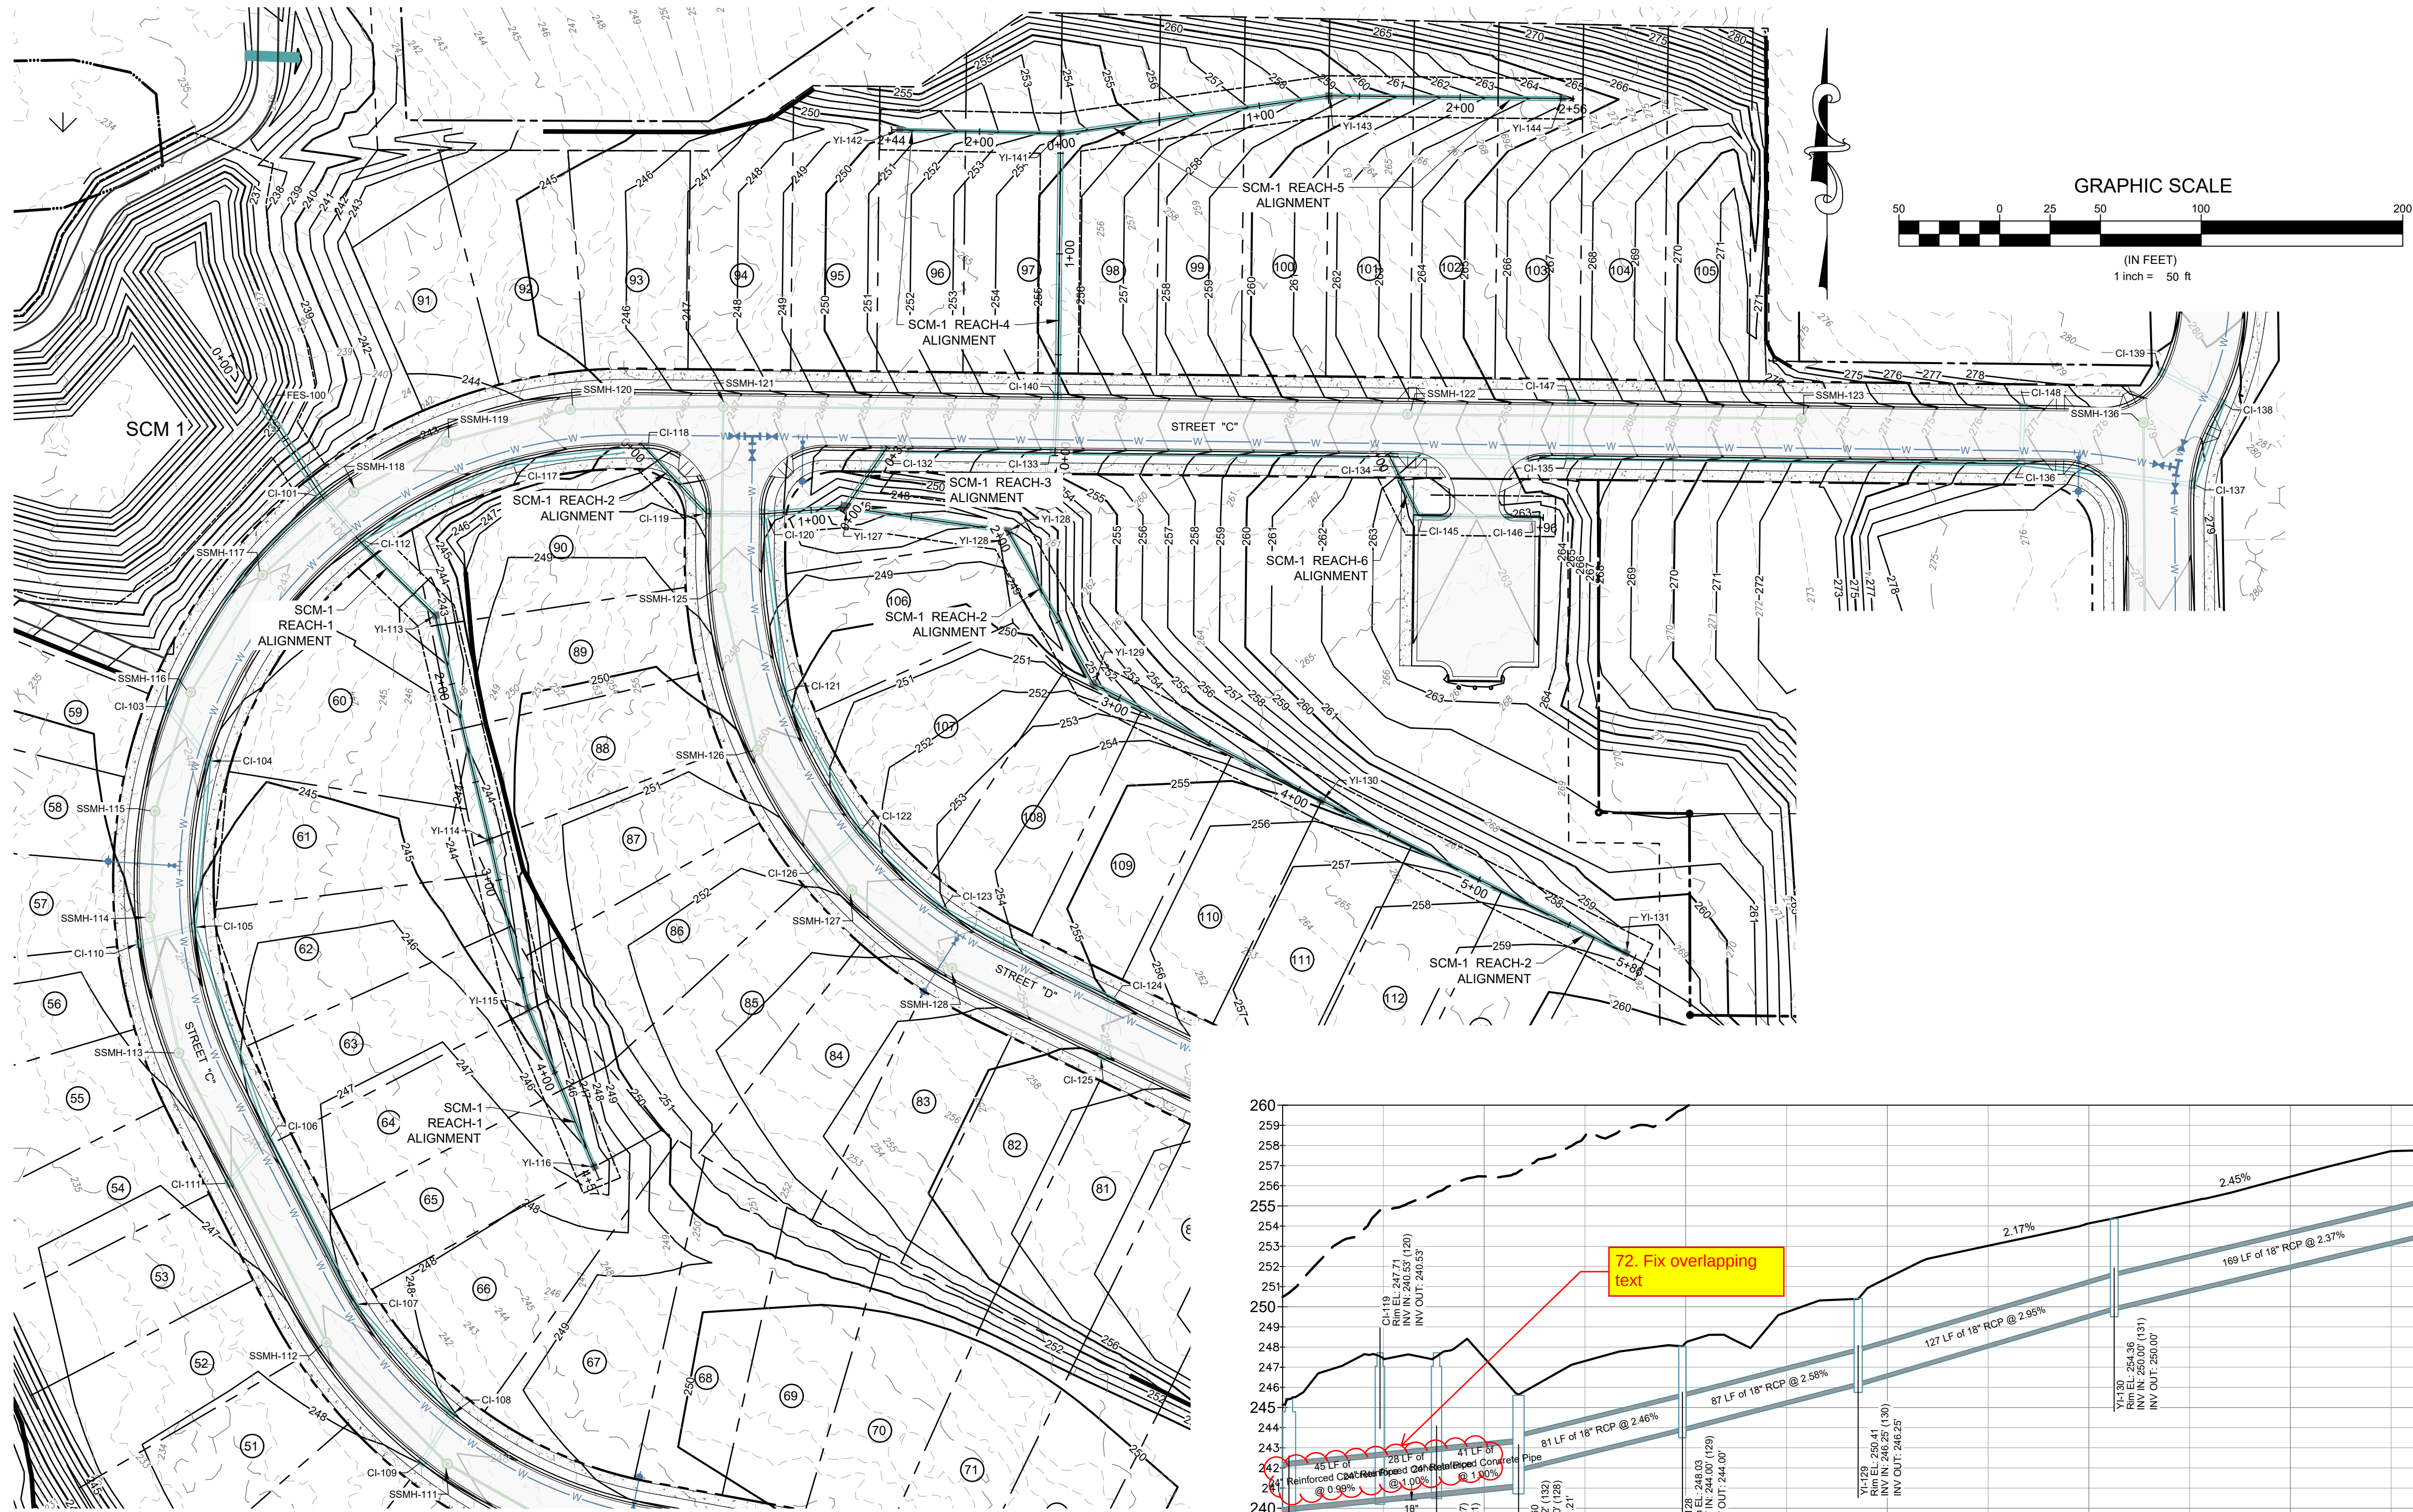

Developer
THE CSC GROUP
CONTRIBUTE TO THE SUCCESS OF LOCAL COMMUNITY
10030 Green Level Church Rd, Suite 802 #149: Cary, NC 27519

Engineer
QUANTECH ENGINEERING
Firm # F-1517
15000 Weston Parkway
Cary, N.C. 27513
(919) 996-9455

Surveyor

Jurisdiction / Municipality
Rolesville
Town of Rolesville
502 Southtown Cir
Rolesville, NC 27571
Phone: 919-554-6517
PSP-24-05

Other Consultants

Sheet map:

Seal:
NORTH CAROLINA PROFESSIONAL ENGINEER
SEAL
53676
BRYAN A. HARRIS

FINAL DRAWING - FOR REVIEW PURPOSES ONLY

Issued / Print Date: 2025-May-30 (17:54)
File Name: 53 Street A Plan & Profile.dwg

Last Saved by: Tim Newsome
Drawn by: TAN

Project:
HARRIS CREEK FARMS
CID-25-??

Issued for: PROGRESS DRAWINGS
DO NOT USE FOR CONSTRUCTION




REVISIONS

No.	Date	Description
-----	------	-------------






Sheet Title:
SCM 1 STORM ALIGNMENTS & PROFILES

Sheet #:
59




File Location: C:\Users\BryanHarris\OneDrive\Documents\Harris Creek Farm - Jonesville\Engineering\DWG\Construction\Plans\63 Street A - Plan & Profile.dwg

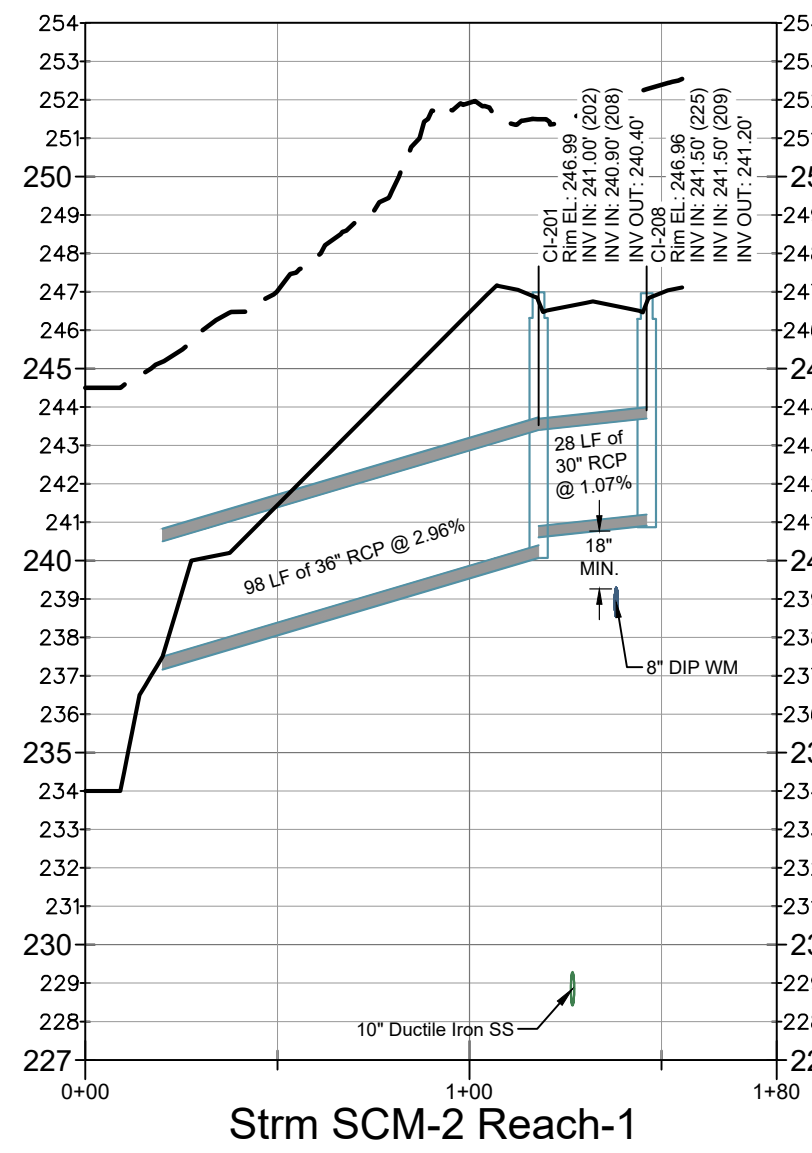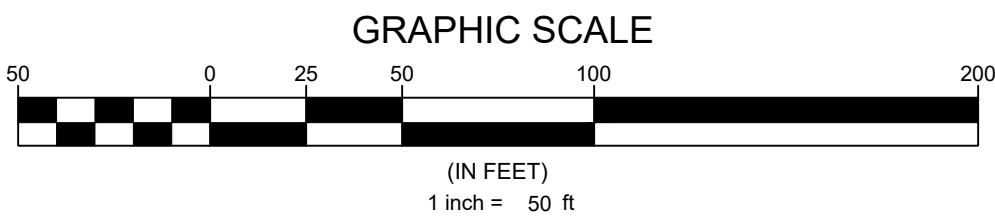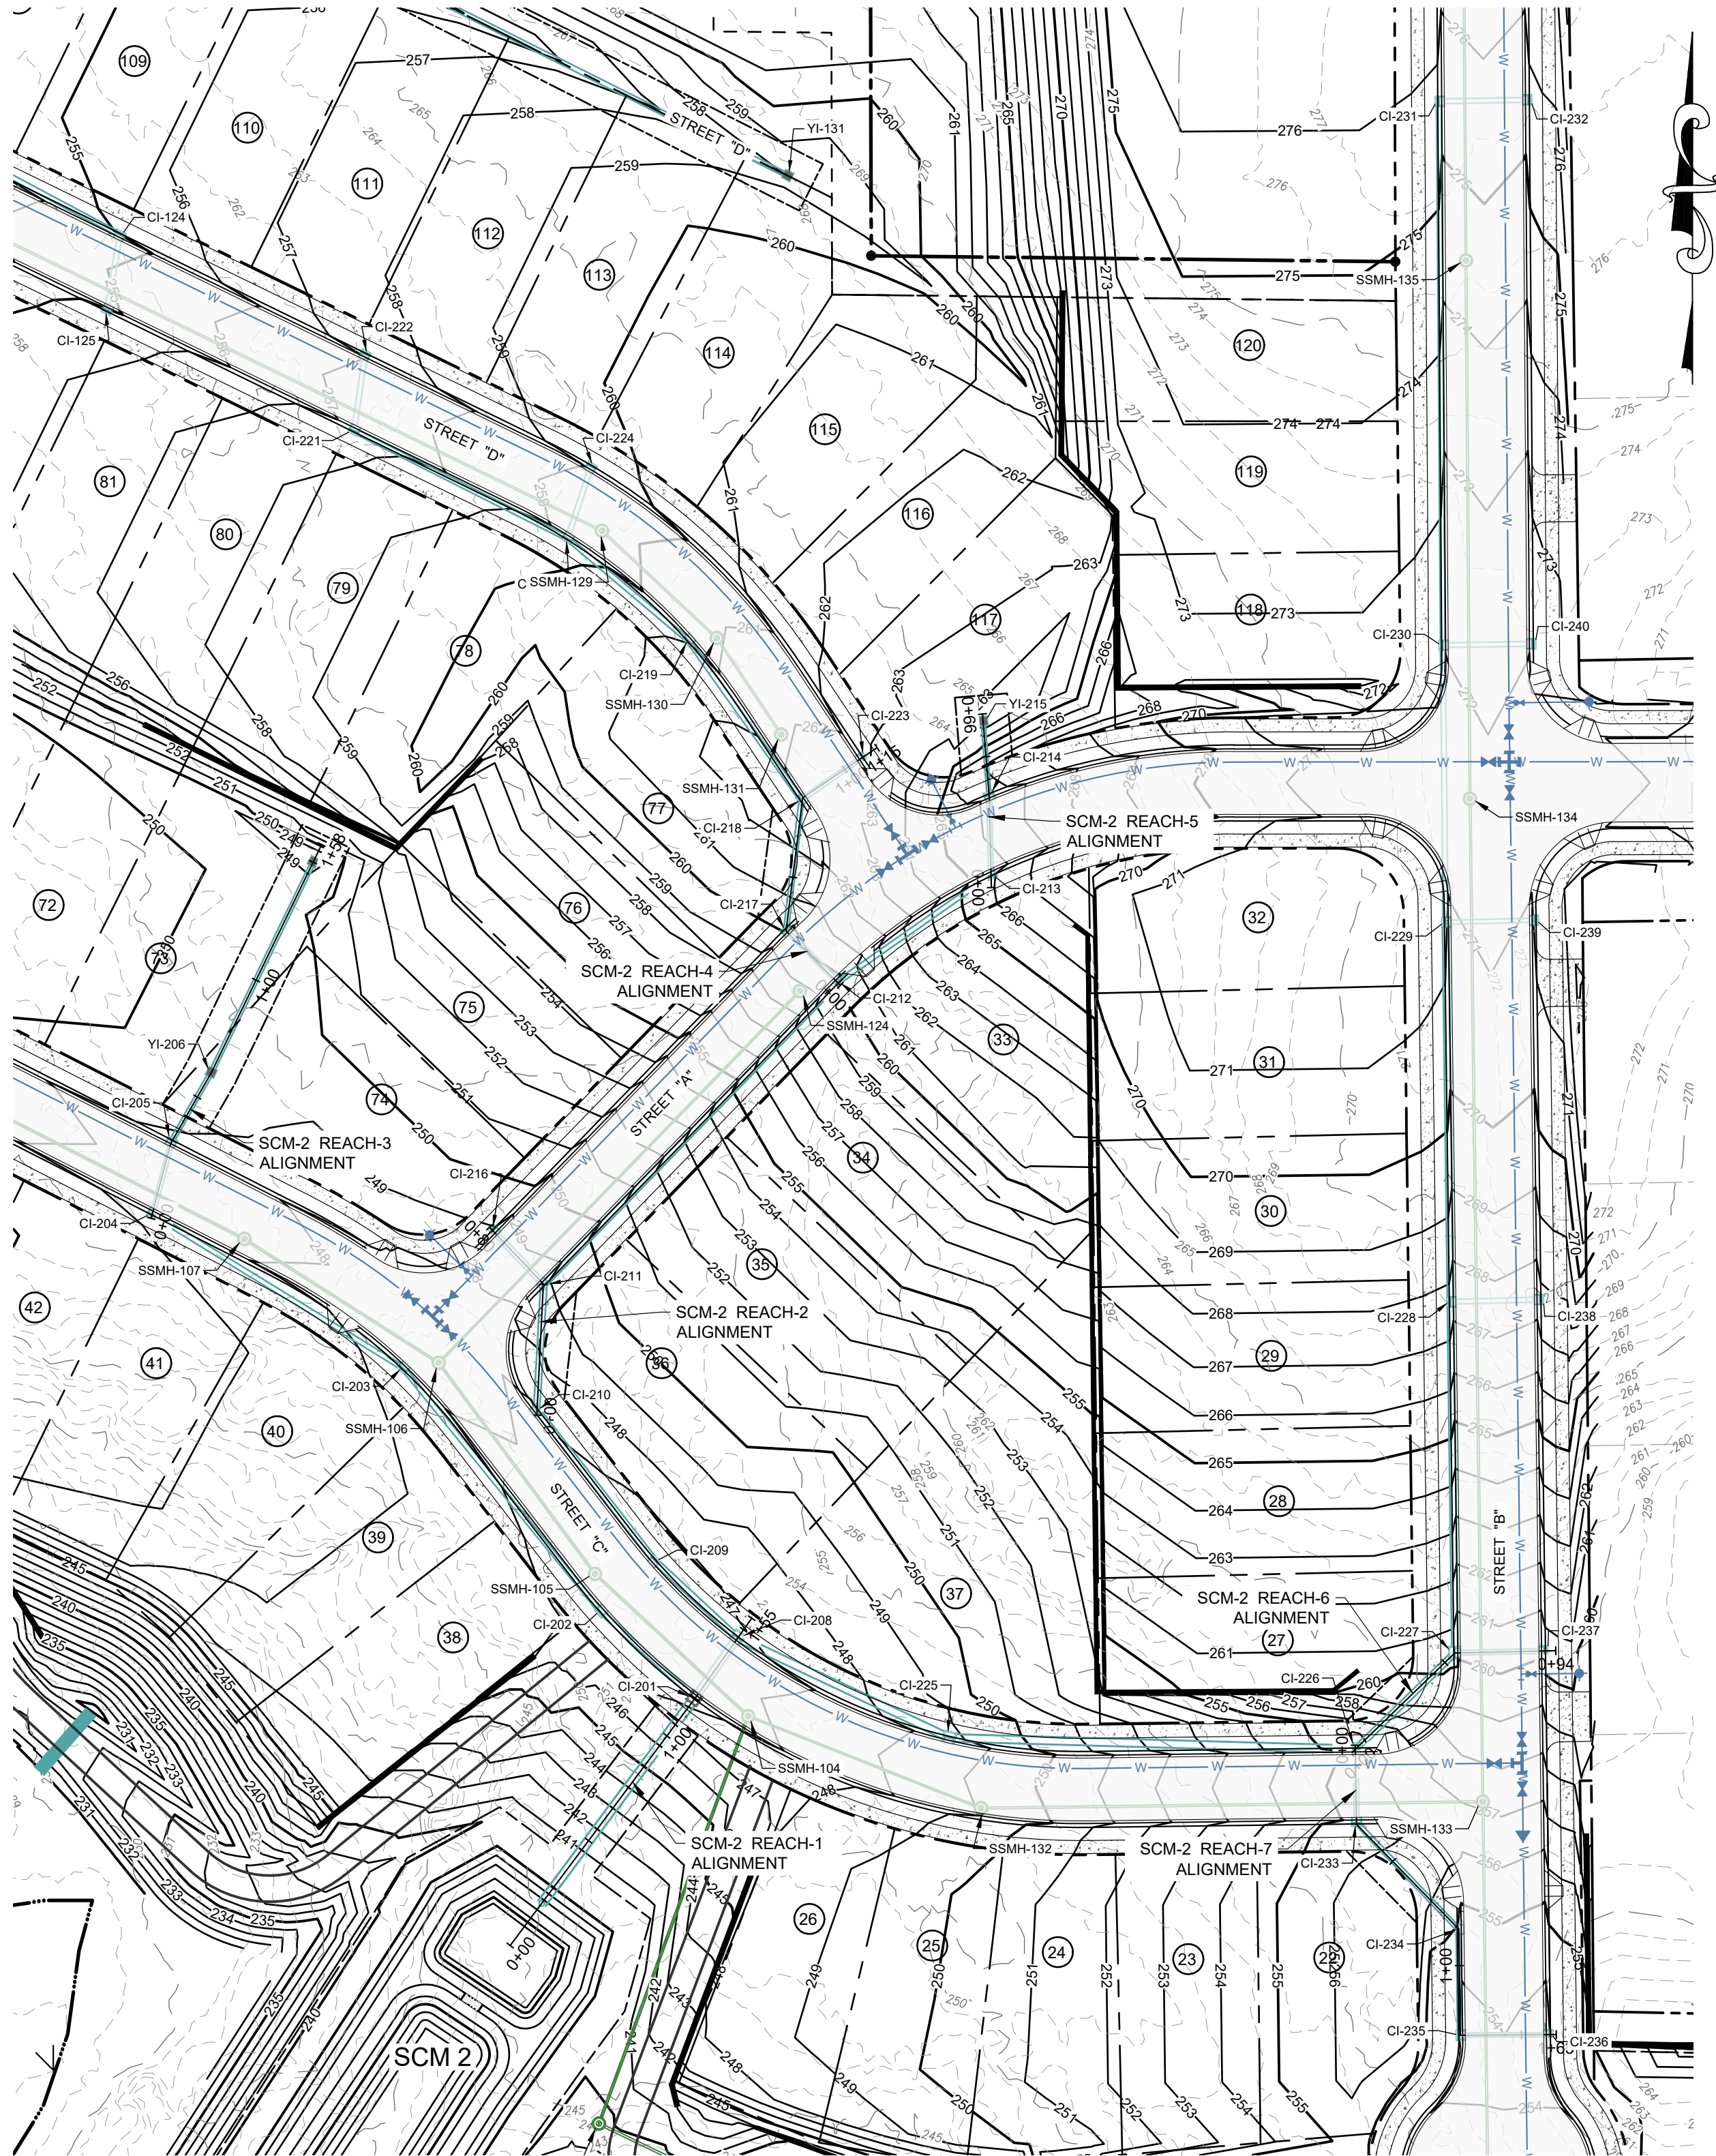

74. Fix text overlap

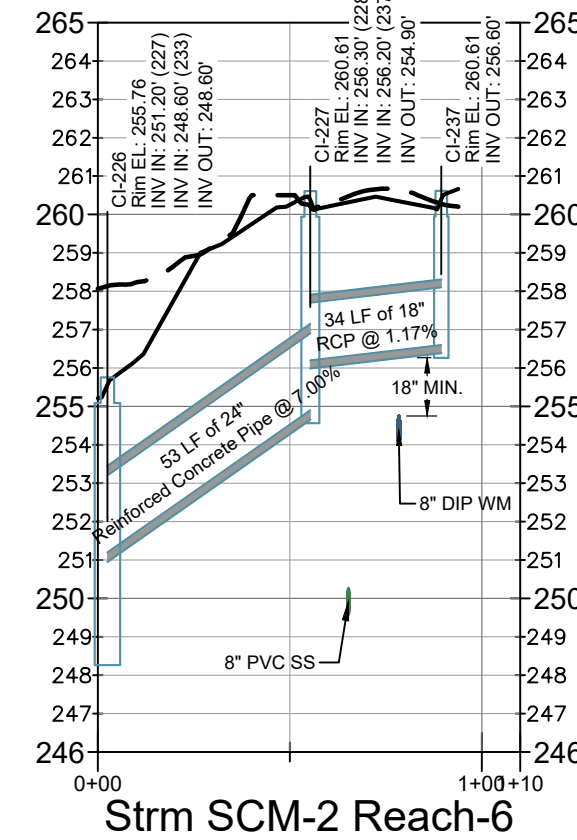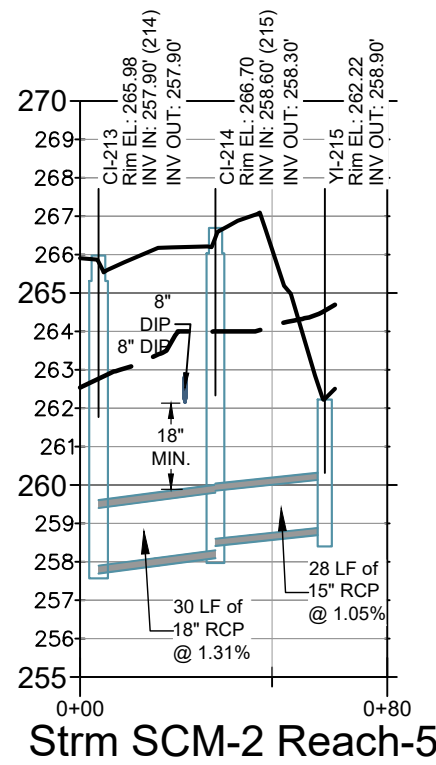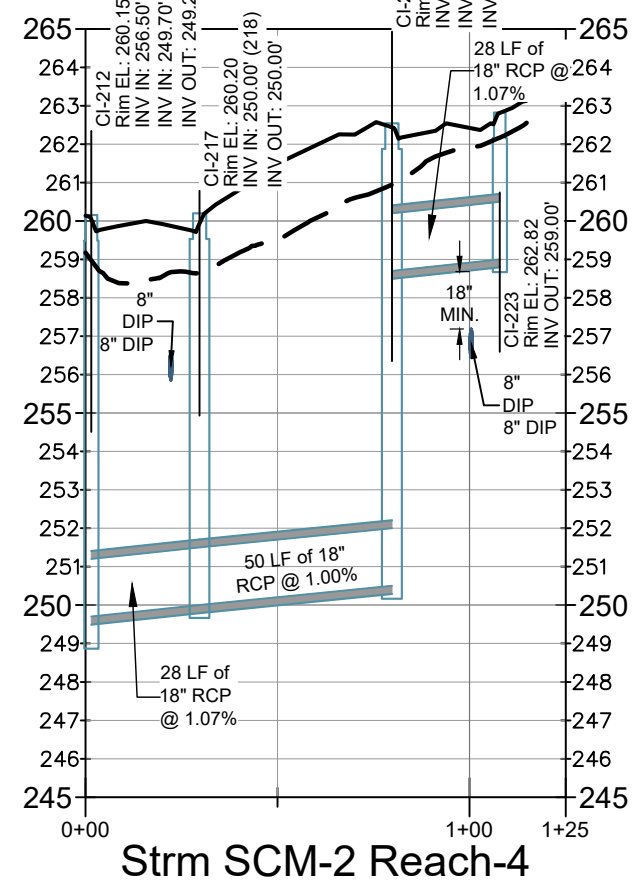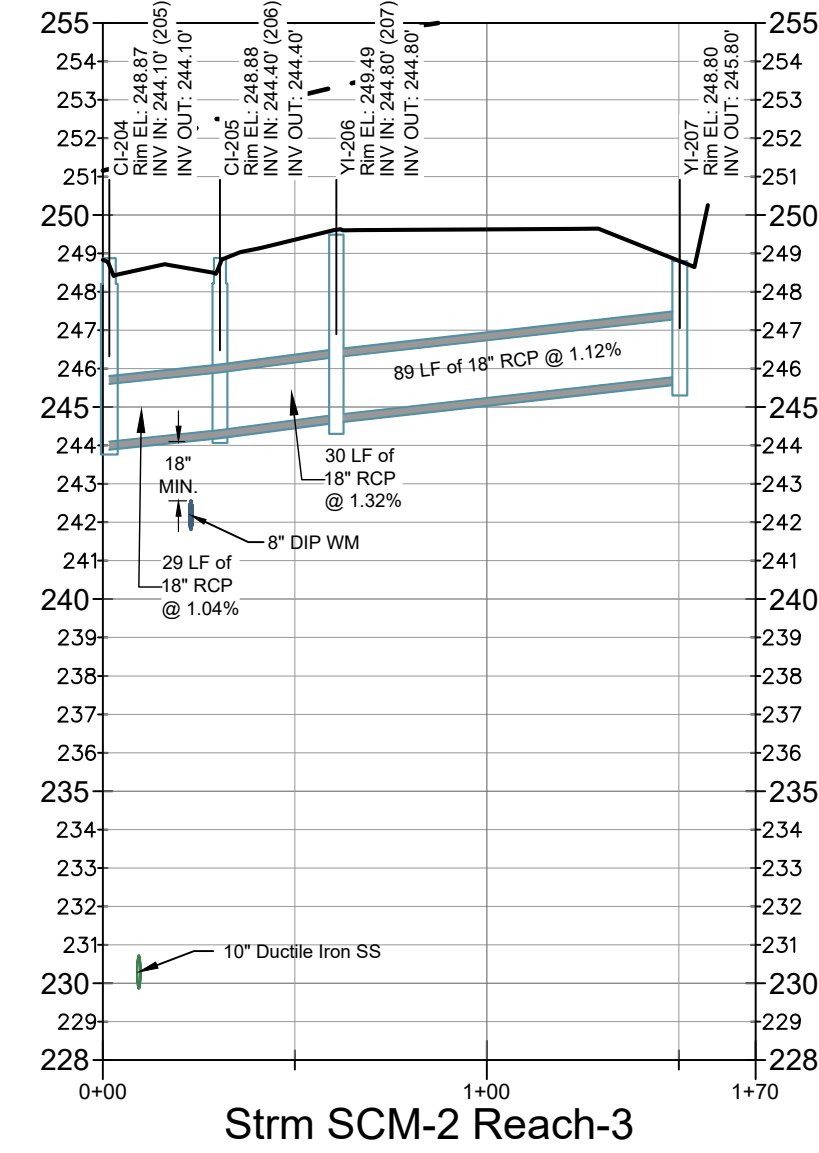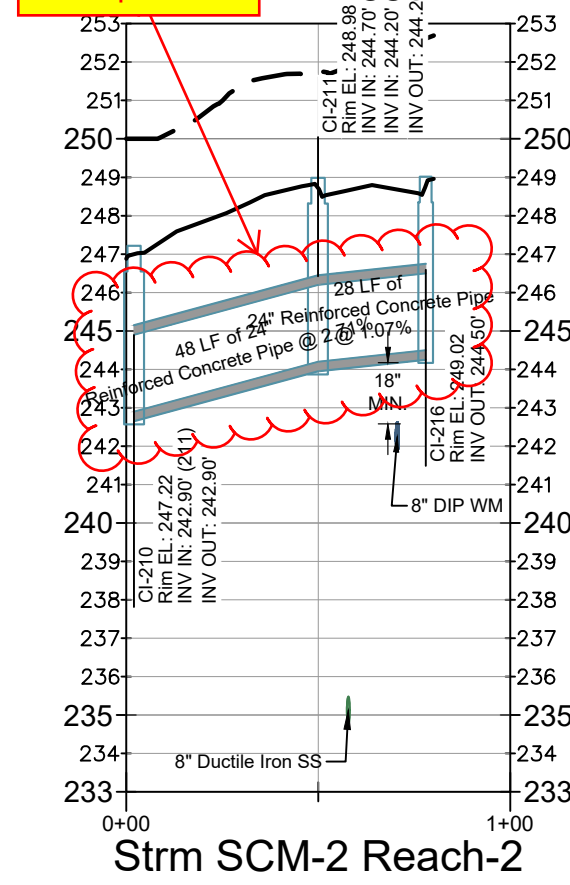

75. Provide a minimum of 24" cover over storm drainage.

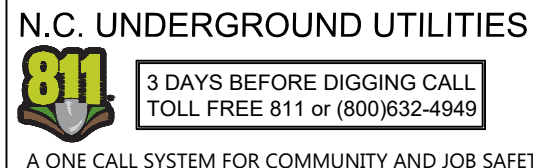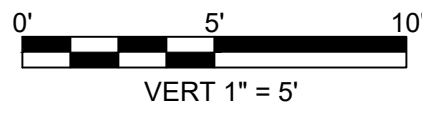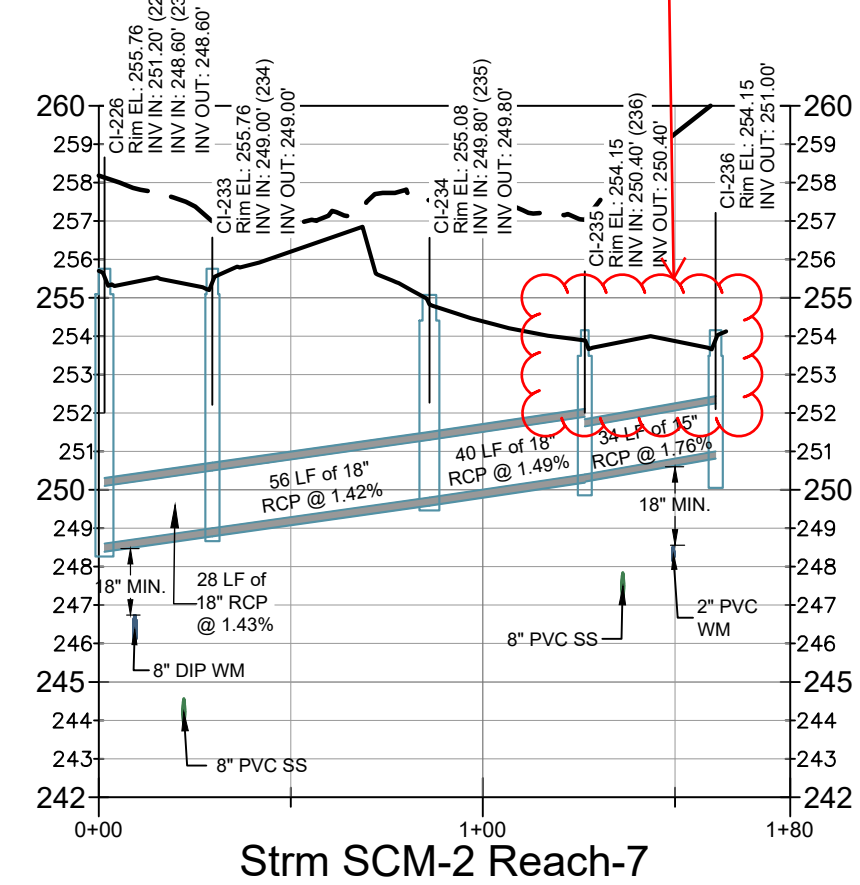

Developer

THE CSC GROUP
CONTRIBUTE TO THE SUCCESS OF LOCAL COMMUNITY

10030 Green Level Church Rd, Suite 802 #149, Cary, NC 27519

Engineer

QUANTECH ENGINEERING
INNOVATIVE SOLUTIONS | SUSTAINING THE FUTURE

Firm # F-1517
15000 Weston Parkway
Cary, N.C. 27513
(919) 996-9455

Surveyor

Jurisdiction / Municipality

Rolesville
Official City Seal of Rolesville, NC

Town of Rolesville
502 Southtown Cir
Rolesville, NC 27571
Phone: 919-554-6517

PSP-24-05

Other Consultants

Sheet map:

N
W
E
S

Seal:

NORTH CAROLINA
PROFESSIONAL
SEAL
53676
ENGINEER
BRYAN A. HAIR

FINAL DRAWING - FOR
REVIEW PURPOSES ONLY

Issued / Print Date: 2025-May-30 (17:55)
File Name: 53 Street A Plan & Profile.dwg

Last Saved by: Tim Newsome
Drawn by: TAN

Project:

HARRIS CREEK FARMS

CID-25-??

Issued for:

PROGRESS DRAWINGS
DO NOT USE FOR
CONSTRUCTION

REVISIONS



No.	Date	Description
-----	------	-------------

Sheet Title:


SCM 2 STORM
ALIGNMENTS &
PROFILES

Sheet #:

60

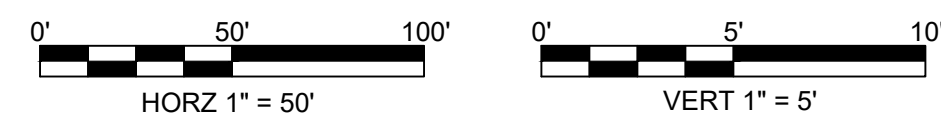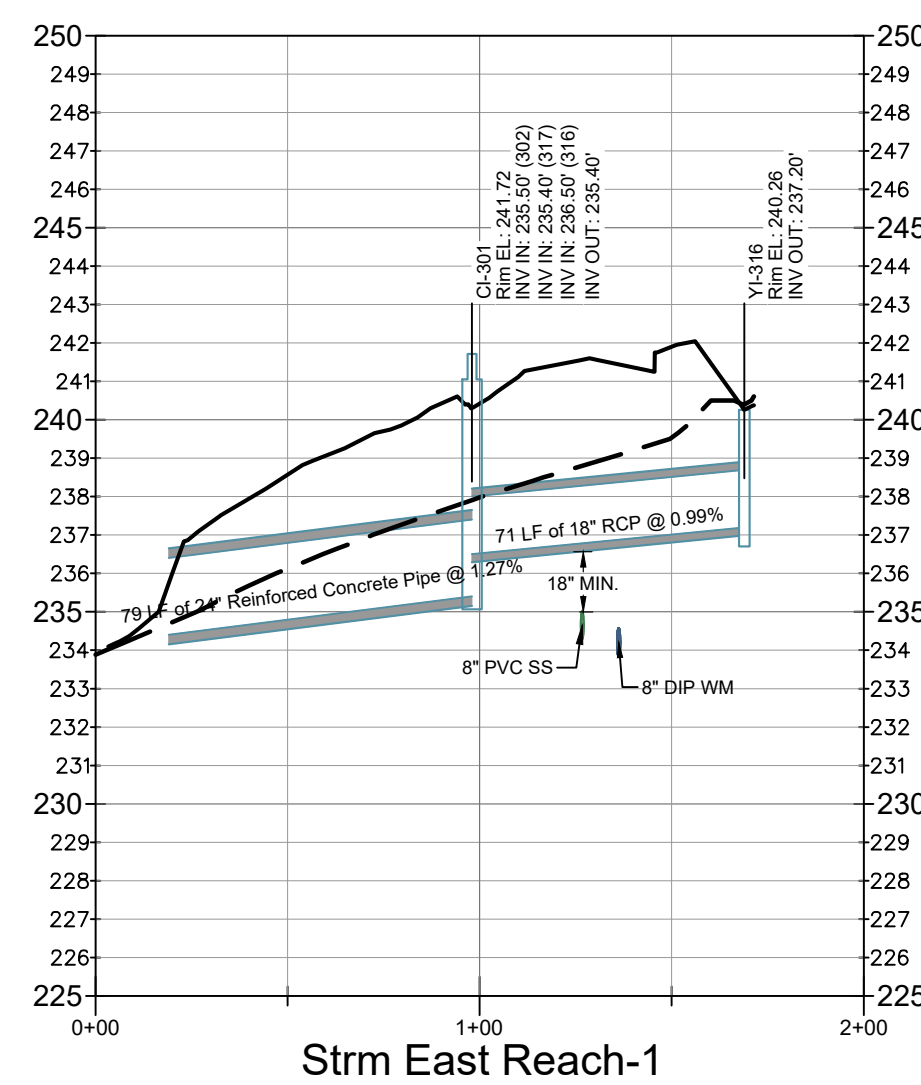

File Location: C:\Users\BryanHarris\OneDrive\Documents\Harris Creek Farm - Jonesville\Engineering - DWG\Construction Plans\62 Jonesville Road Widening and Striping Plan.dwg

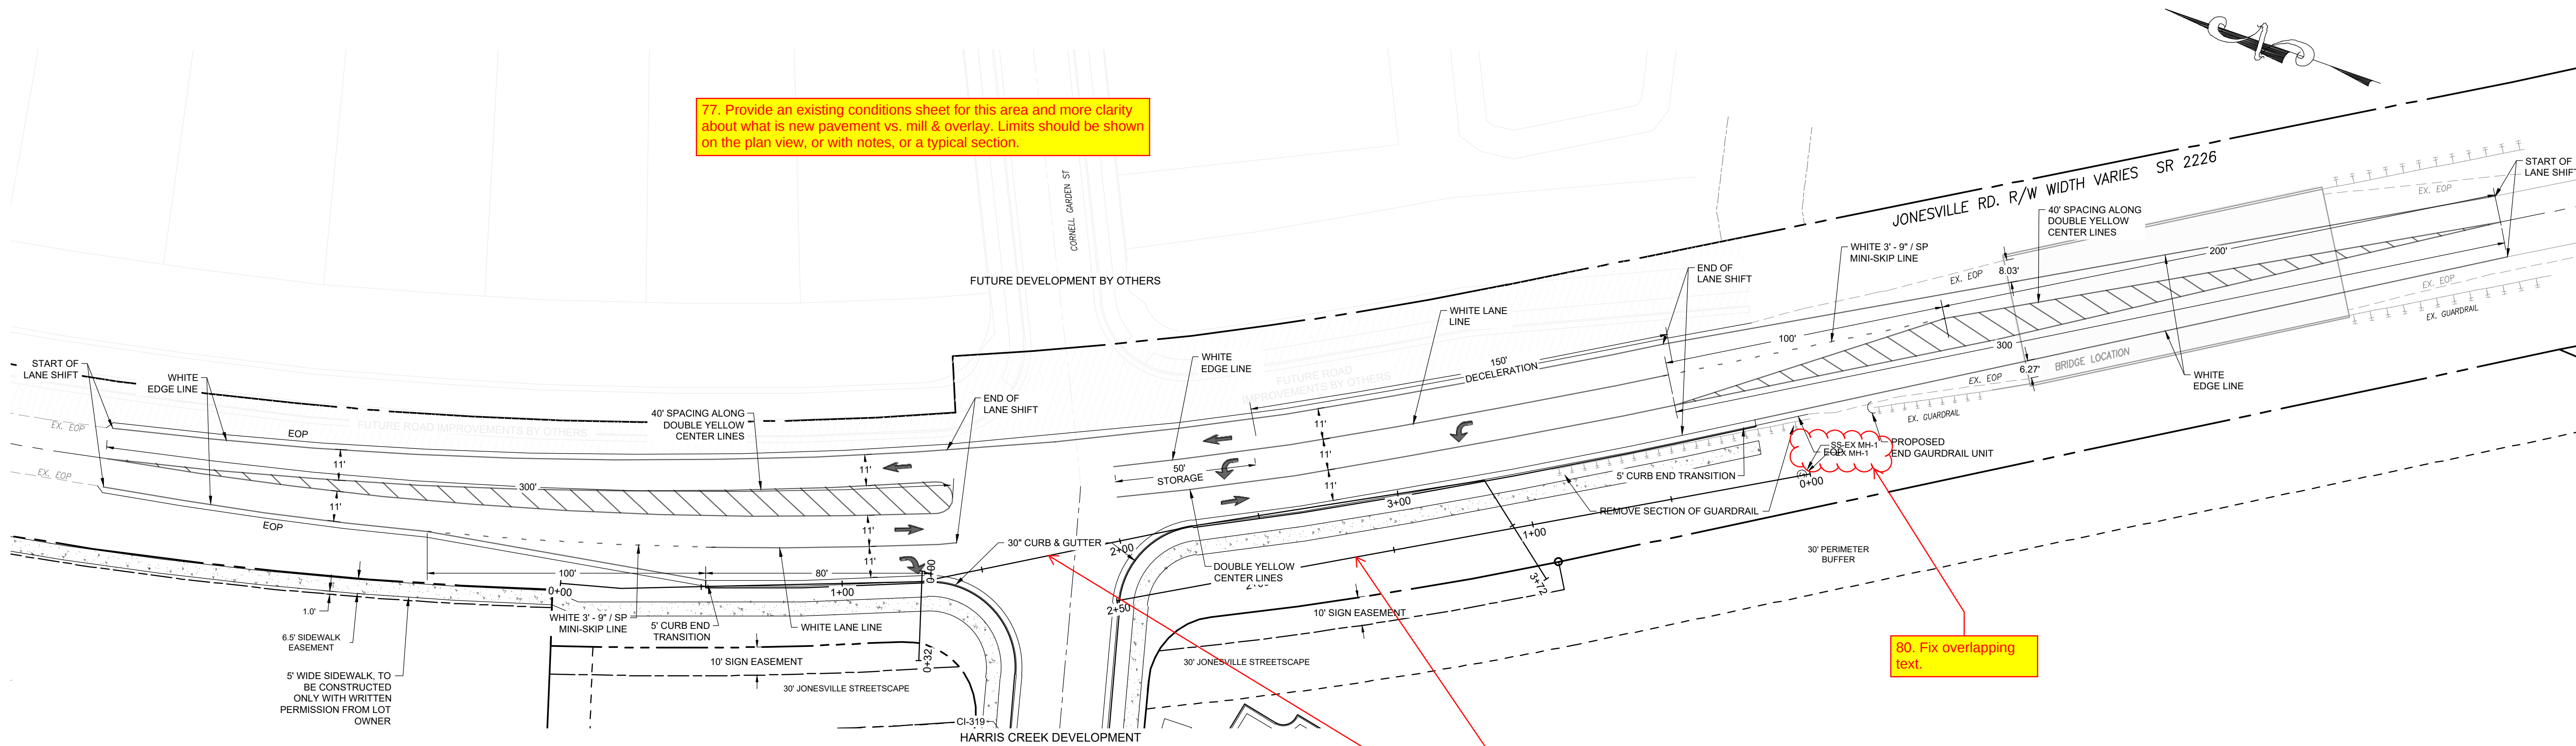



Jonesville Road Widening and Striping Plan

SCALE: 1" = 30'

78. Will there be any signs along Jonesville Road? If so, please show and provide details.

79. Freeze alignments off of striping plan.

80. Fix overlapping text.

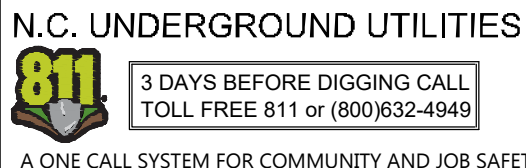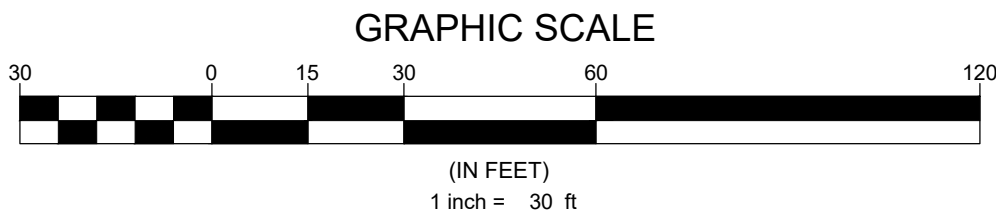


Developer
THE CSC GROUP
CONTRIBUTE TO THE SUCCESS OF LOCAL COMMUNITY
10030 Green Level Church Rd, Suite 802 #149- Cary, NC 27519

Engineer
QUANTECH ENGINEERING
Firm # F-1517
15000 Weston Parkway
Cary, N.C. 27513
(919) 996-9455

Surveyor

Jurisdiction / Municipality
Rolesville
Town of Rolesville
502 Southtown Cir
Rolesville, NC 27571
Phone: 919-554-6517
PSP-24-05

Other Consultants

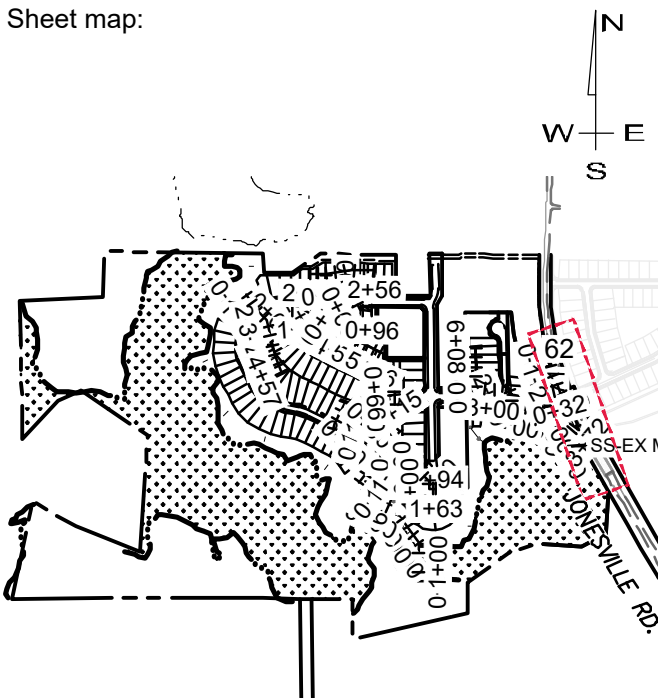

Seal:

FINAL DRAWING - FOR REVIEW PURPOSES ONLY

Issued / Print Date: 2025-May-30 (17:58)
File Name: 62 Jonesville Road Widening and Striping Plan.dwg
Last Saved by: Tim Newsome
Drawn by: TAN



Project:
HARRIS CREEK FARMS
CID-25-??


Issued for: **PROGRESS DRAWINGS
DO NOT USE FOR CONSTRUCTION**


REVISIONS		
No.	Date	Description

Sheet Title:
JONESVILLE ROAD WIDENING AND STRIPING PLAN





Sheet #:
62

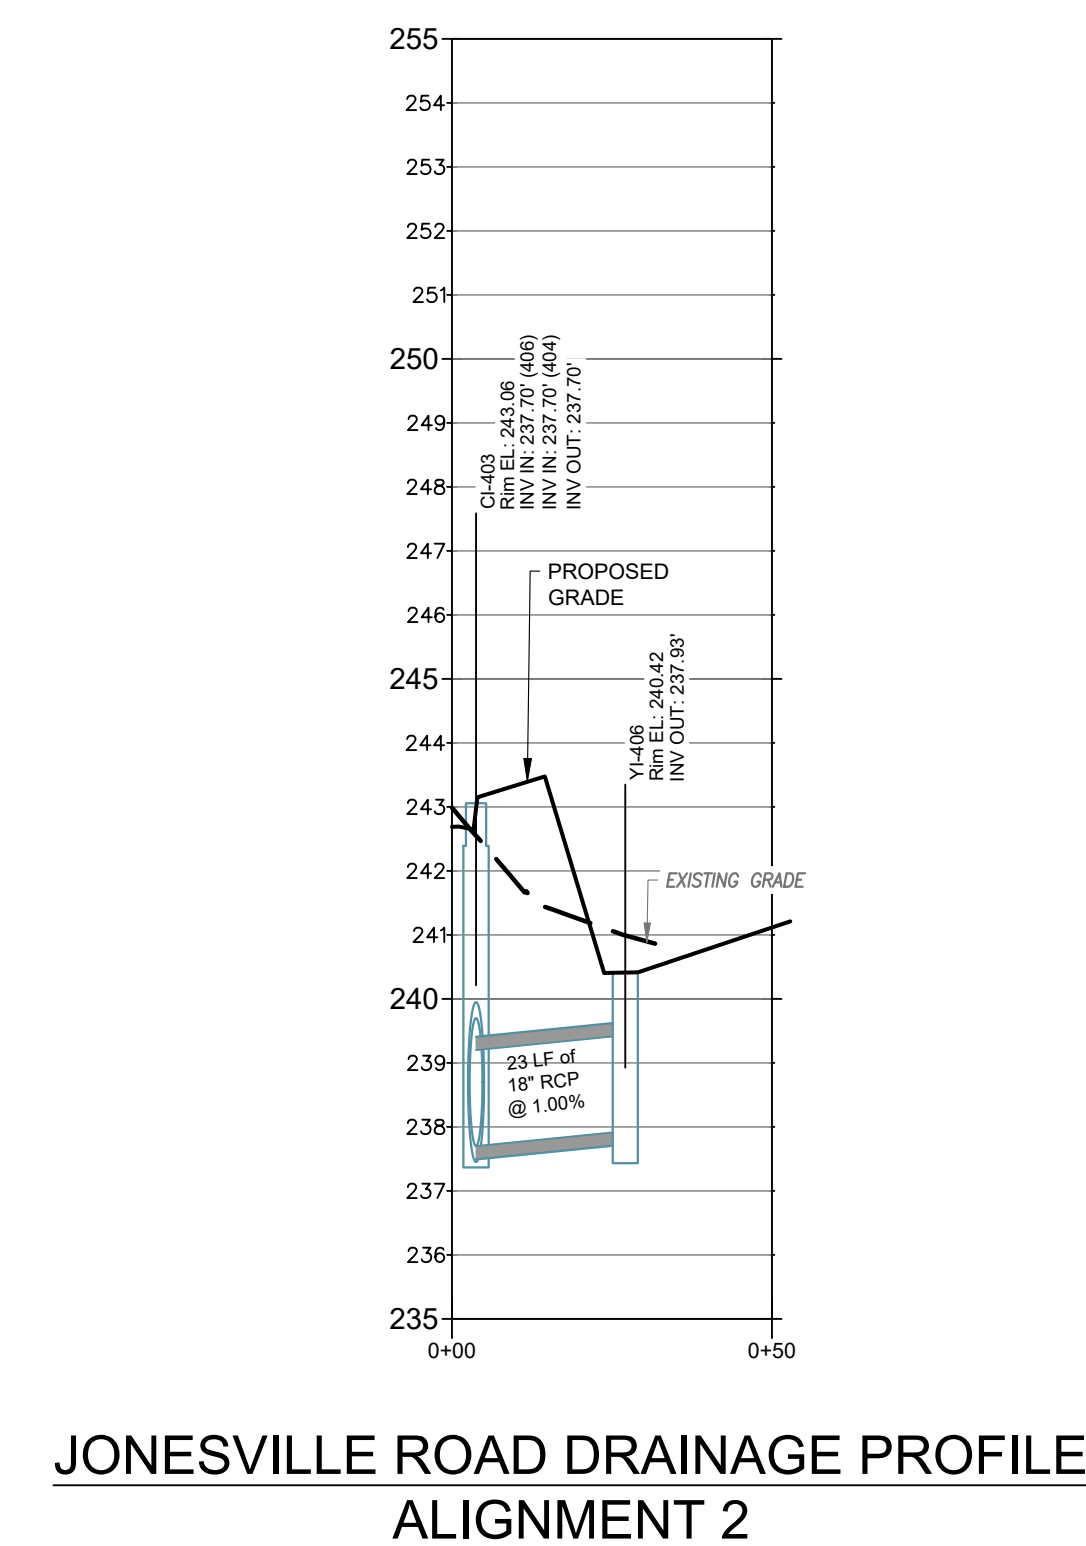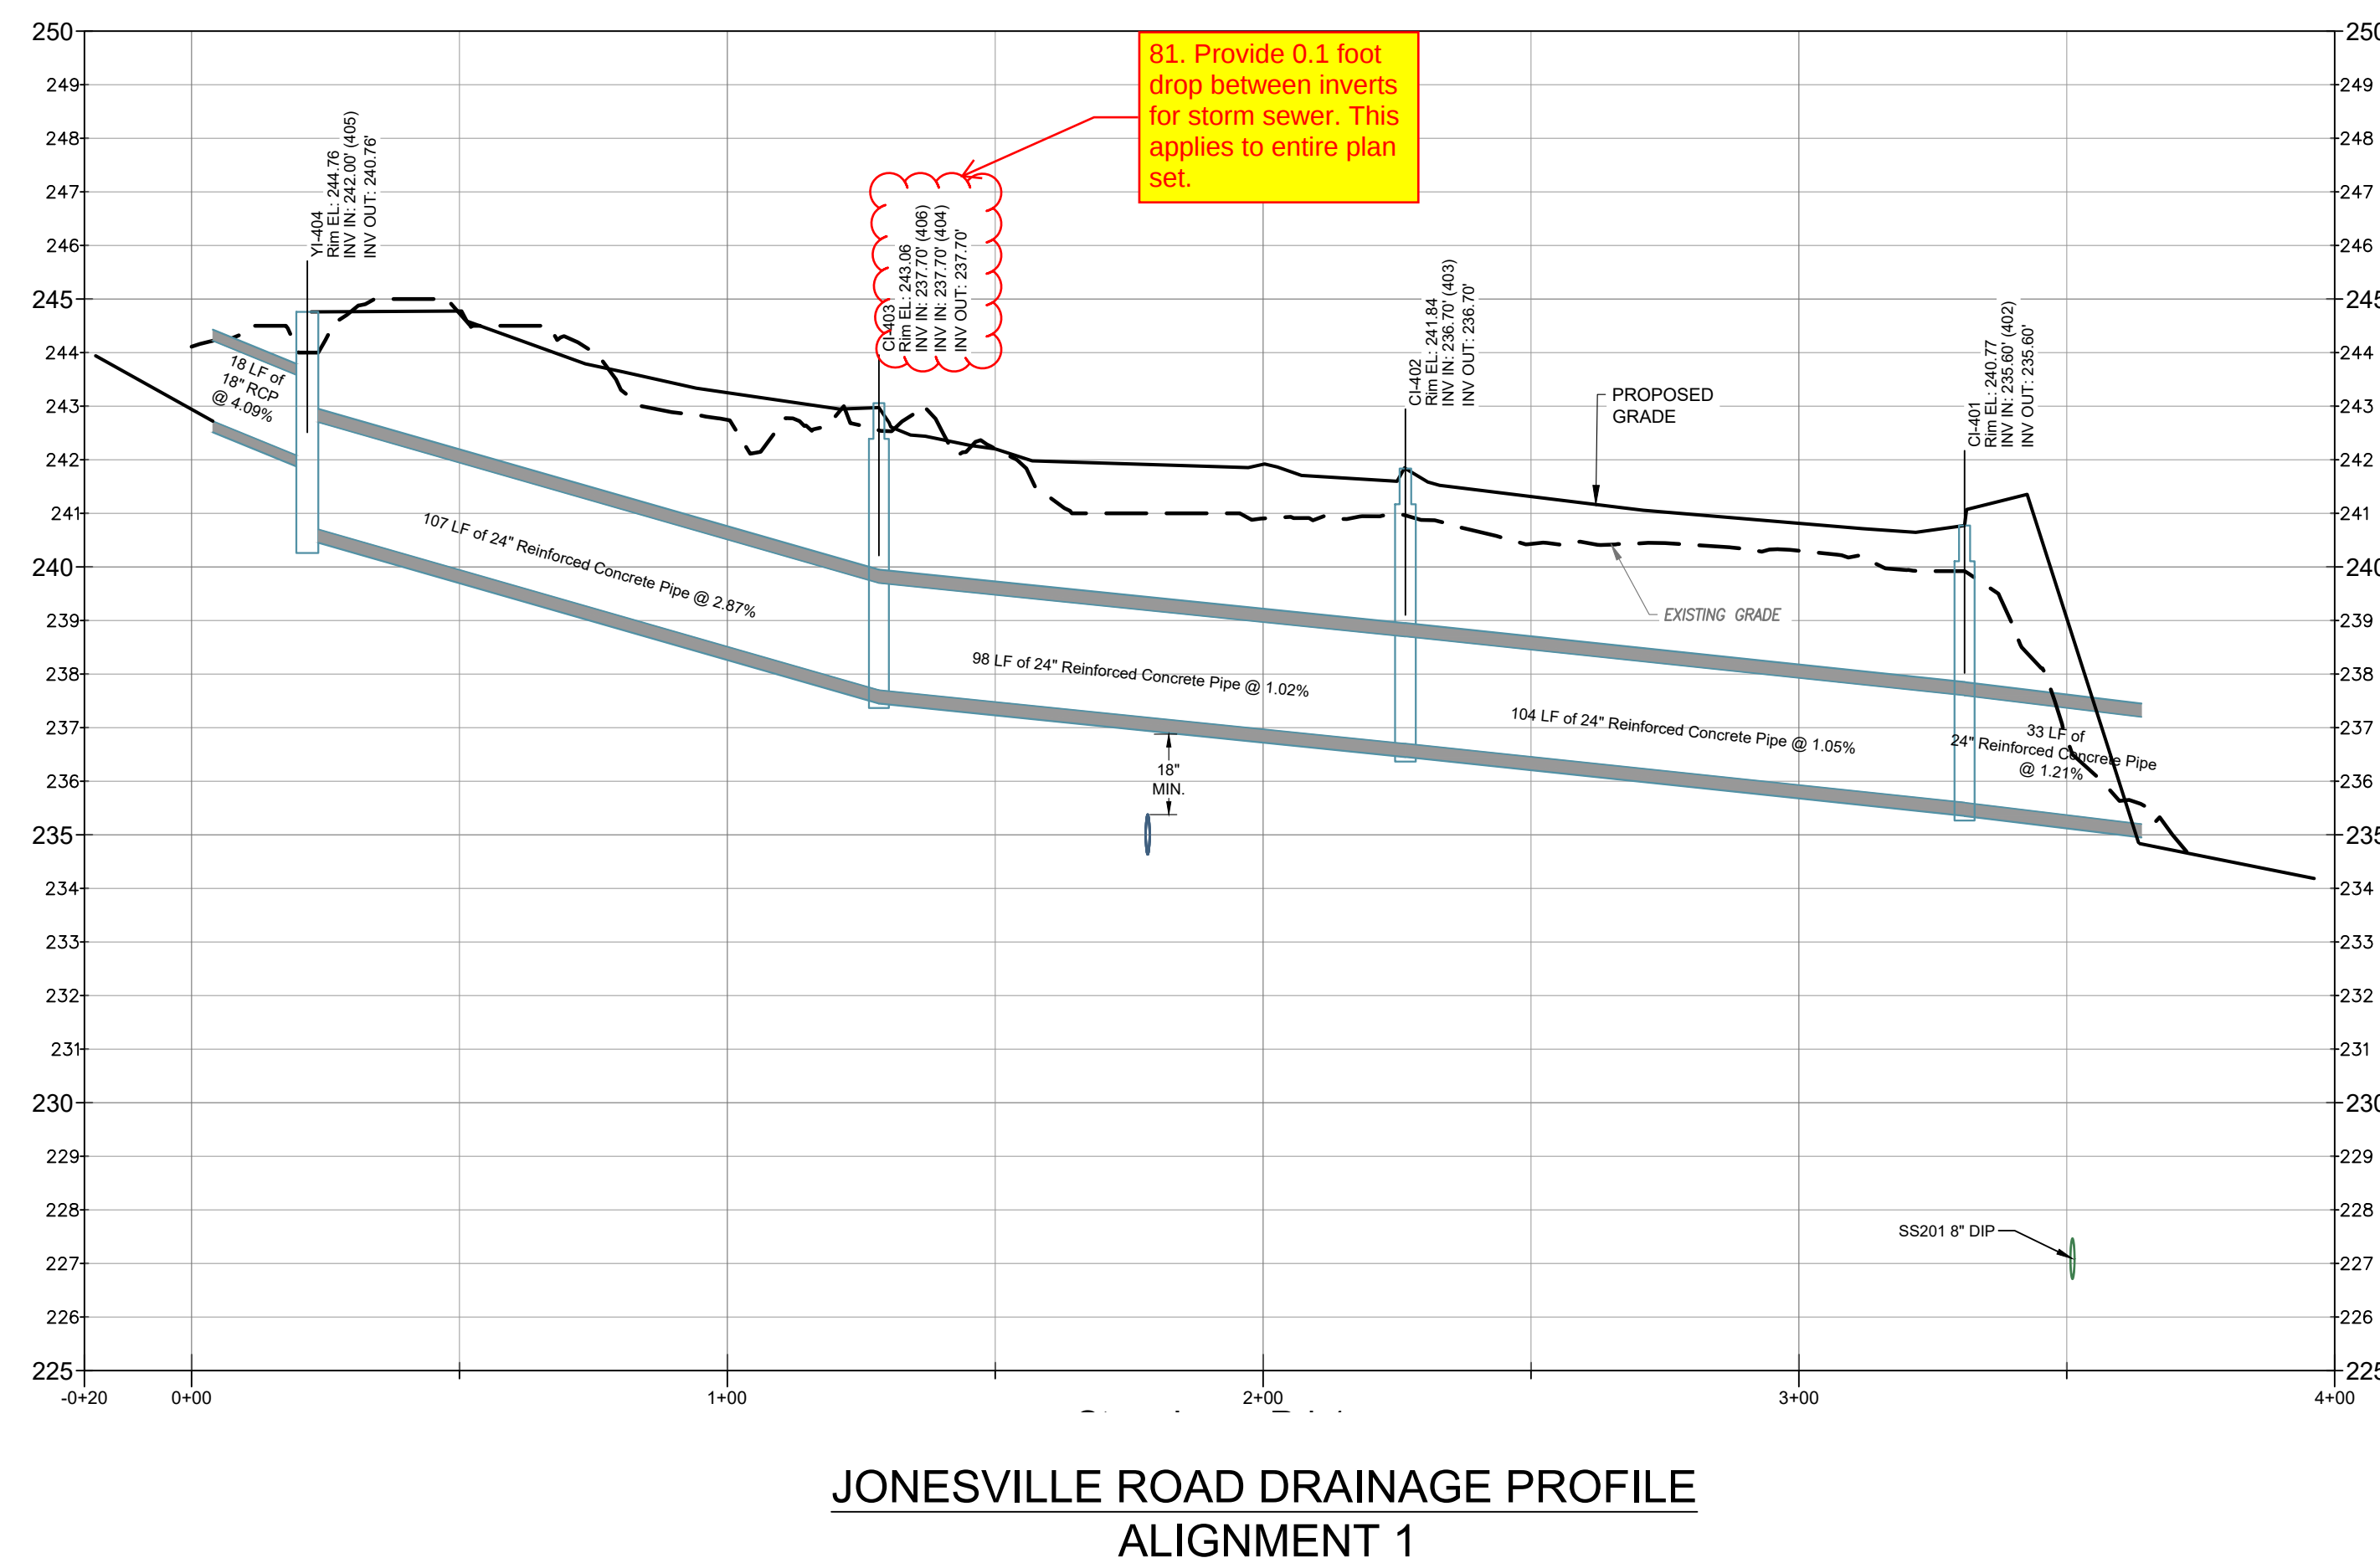[illegible]

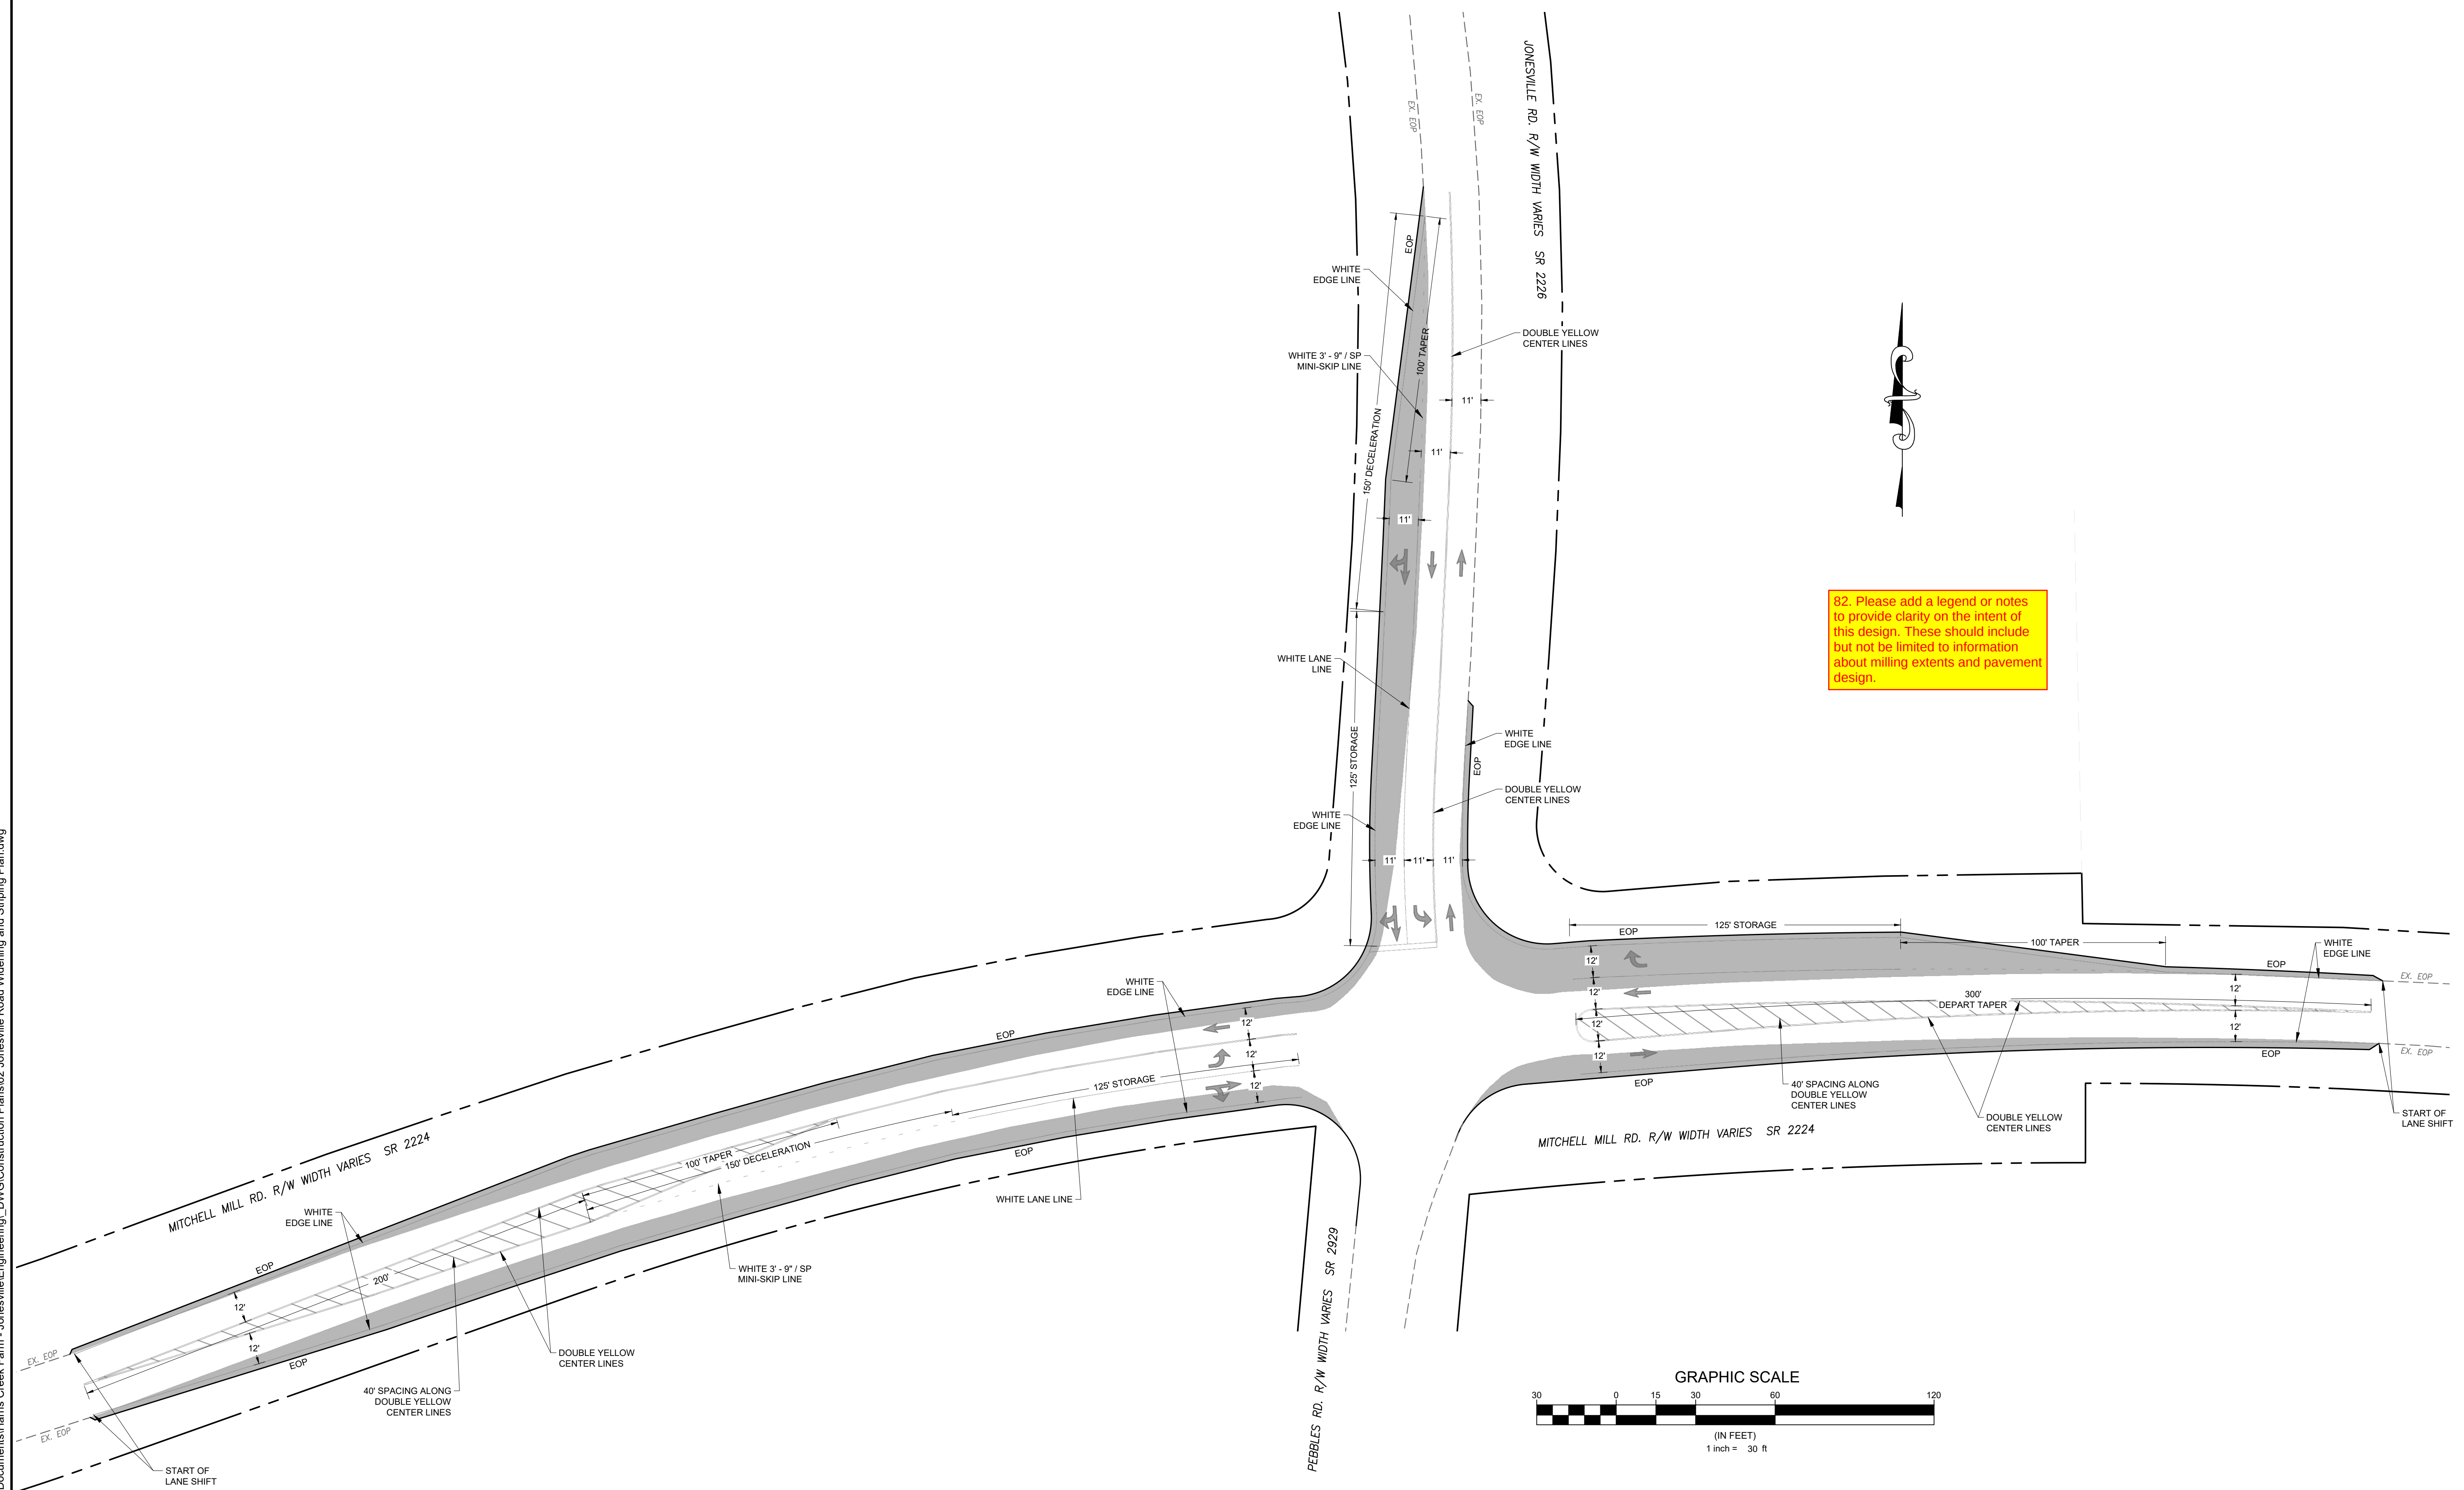

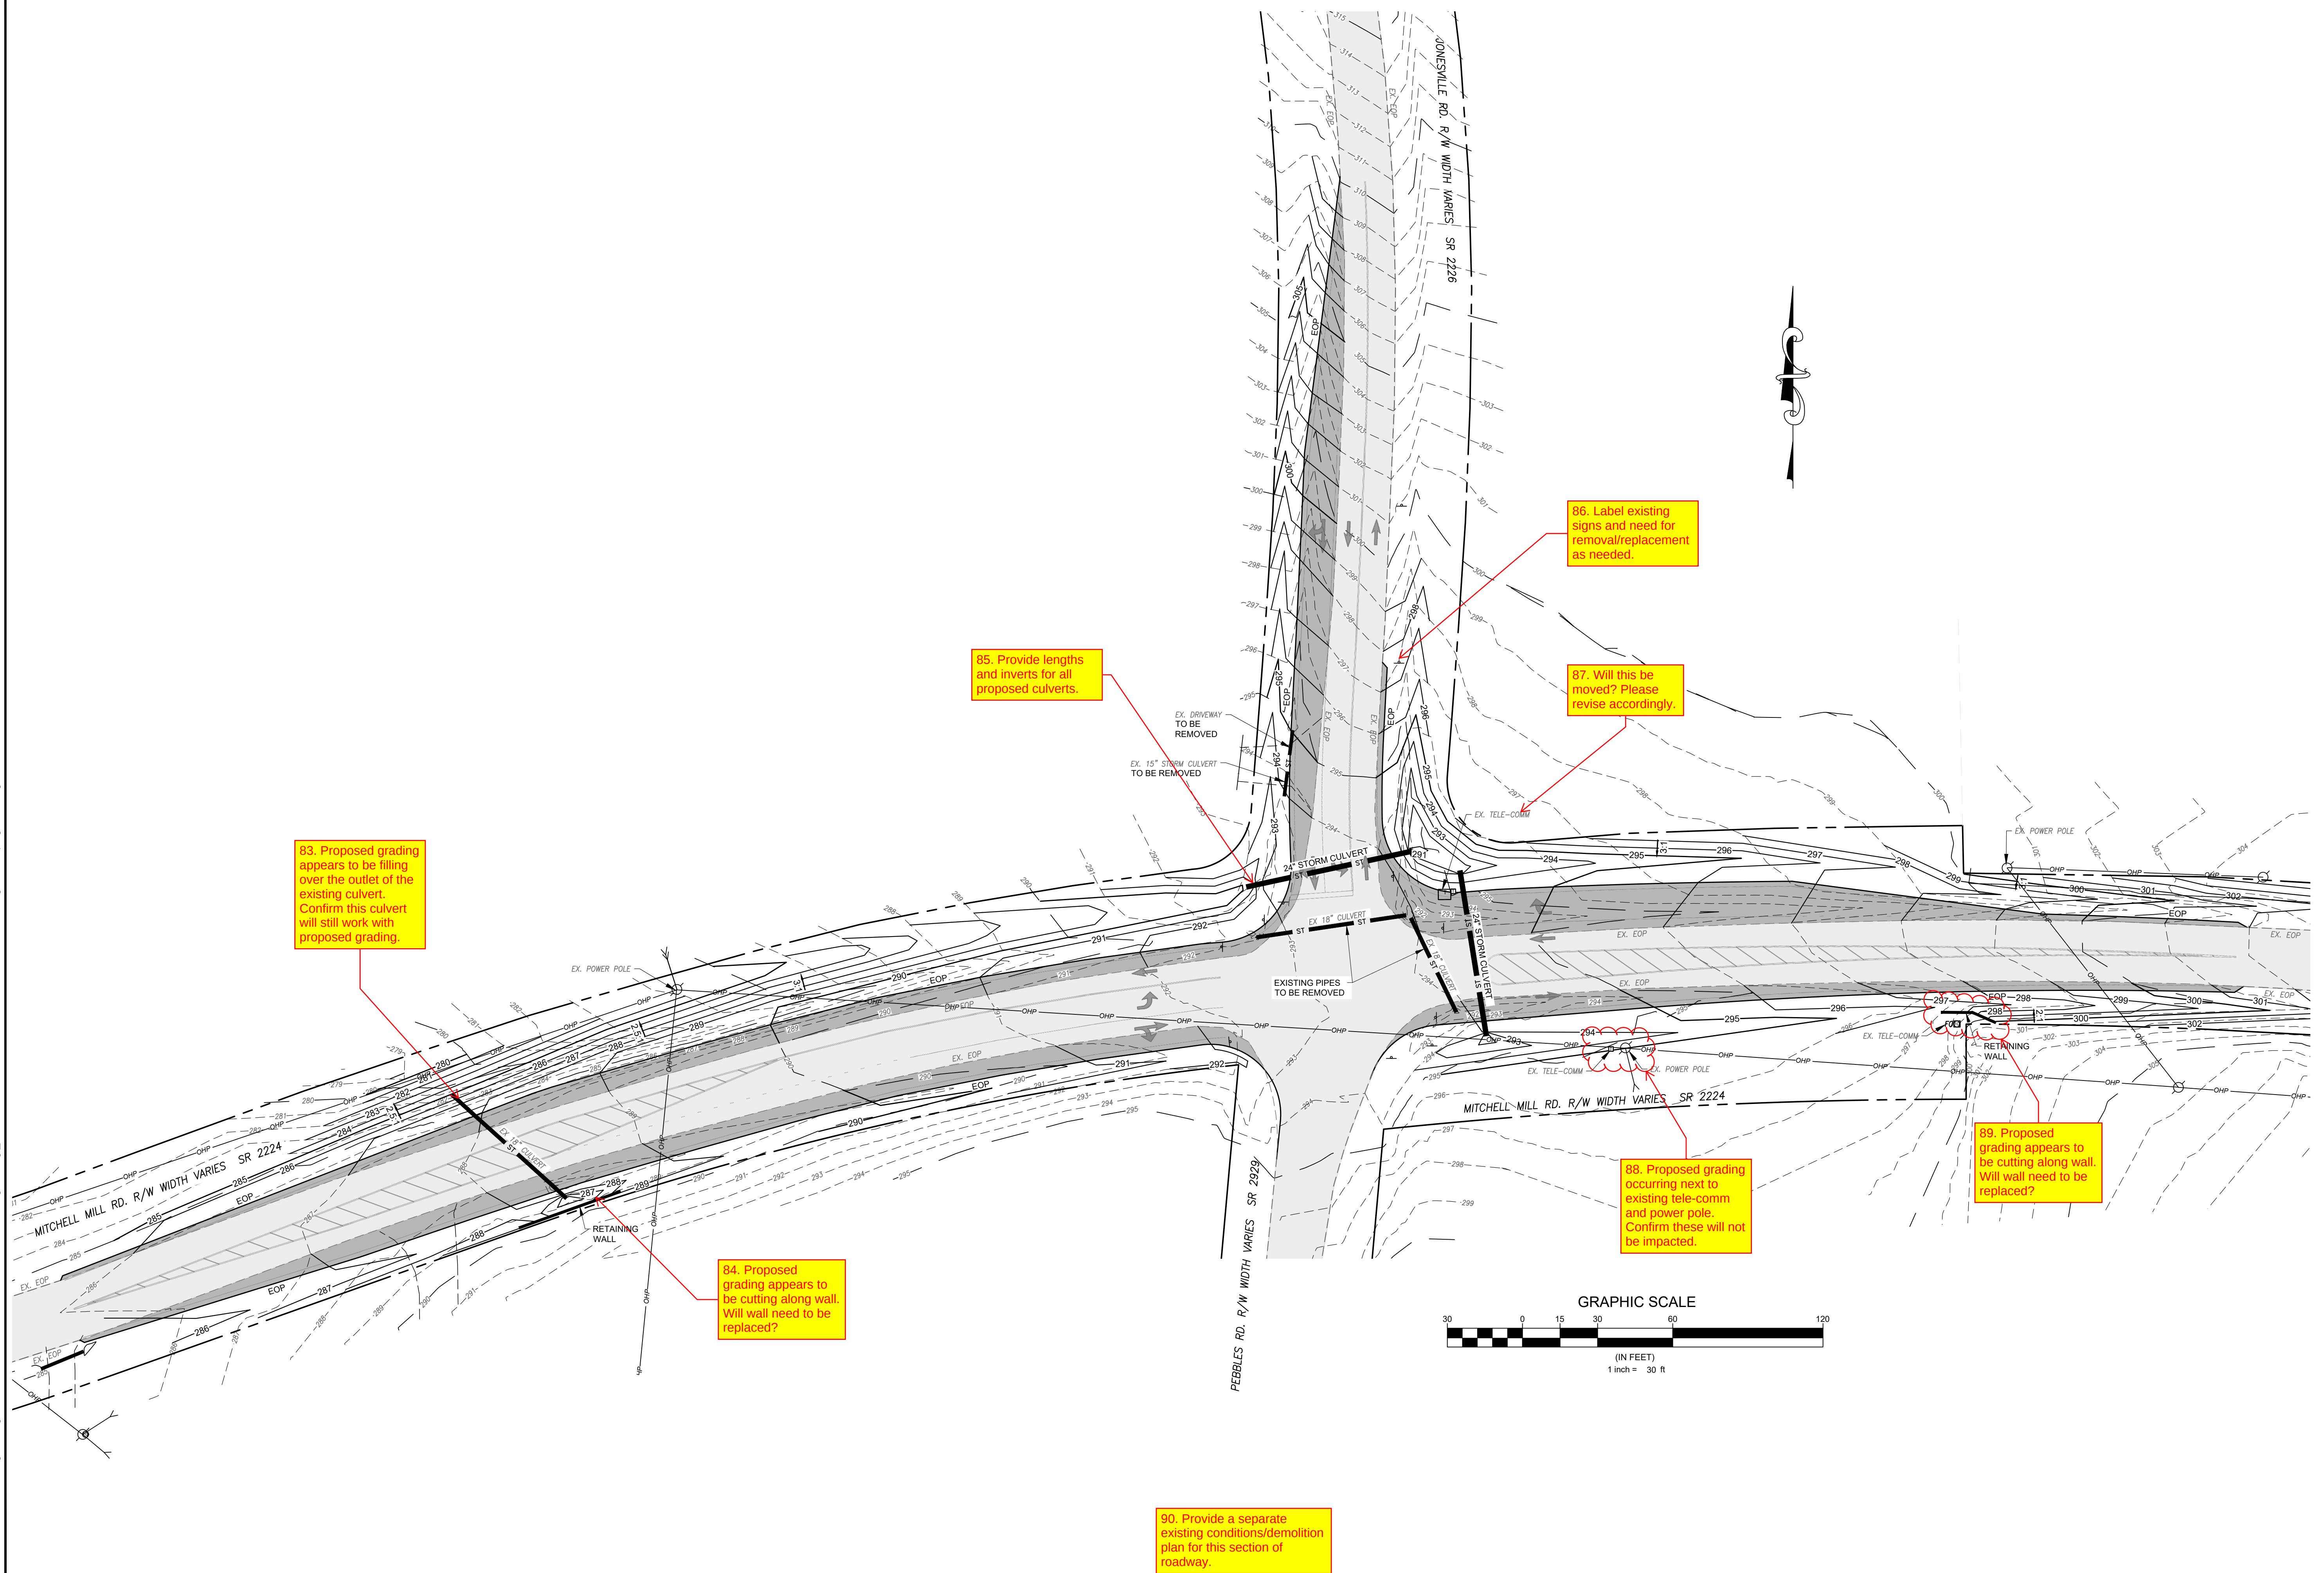

File Location: C:\Users\BryanHarris\Quantech\Engineering - Documents\Harris Creek Farm - Jonesville\Engineering\DWG\Construction Plans\62 Jonesville Road Widening and Striping Plan.dwg

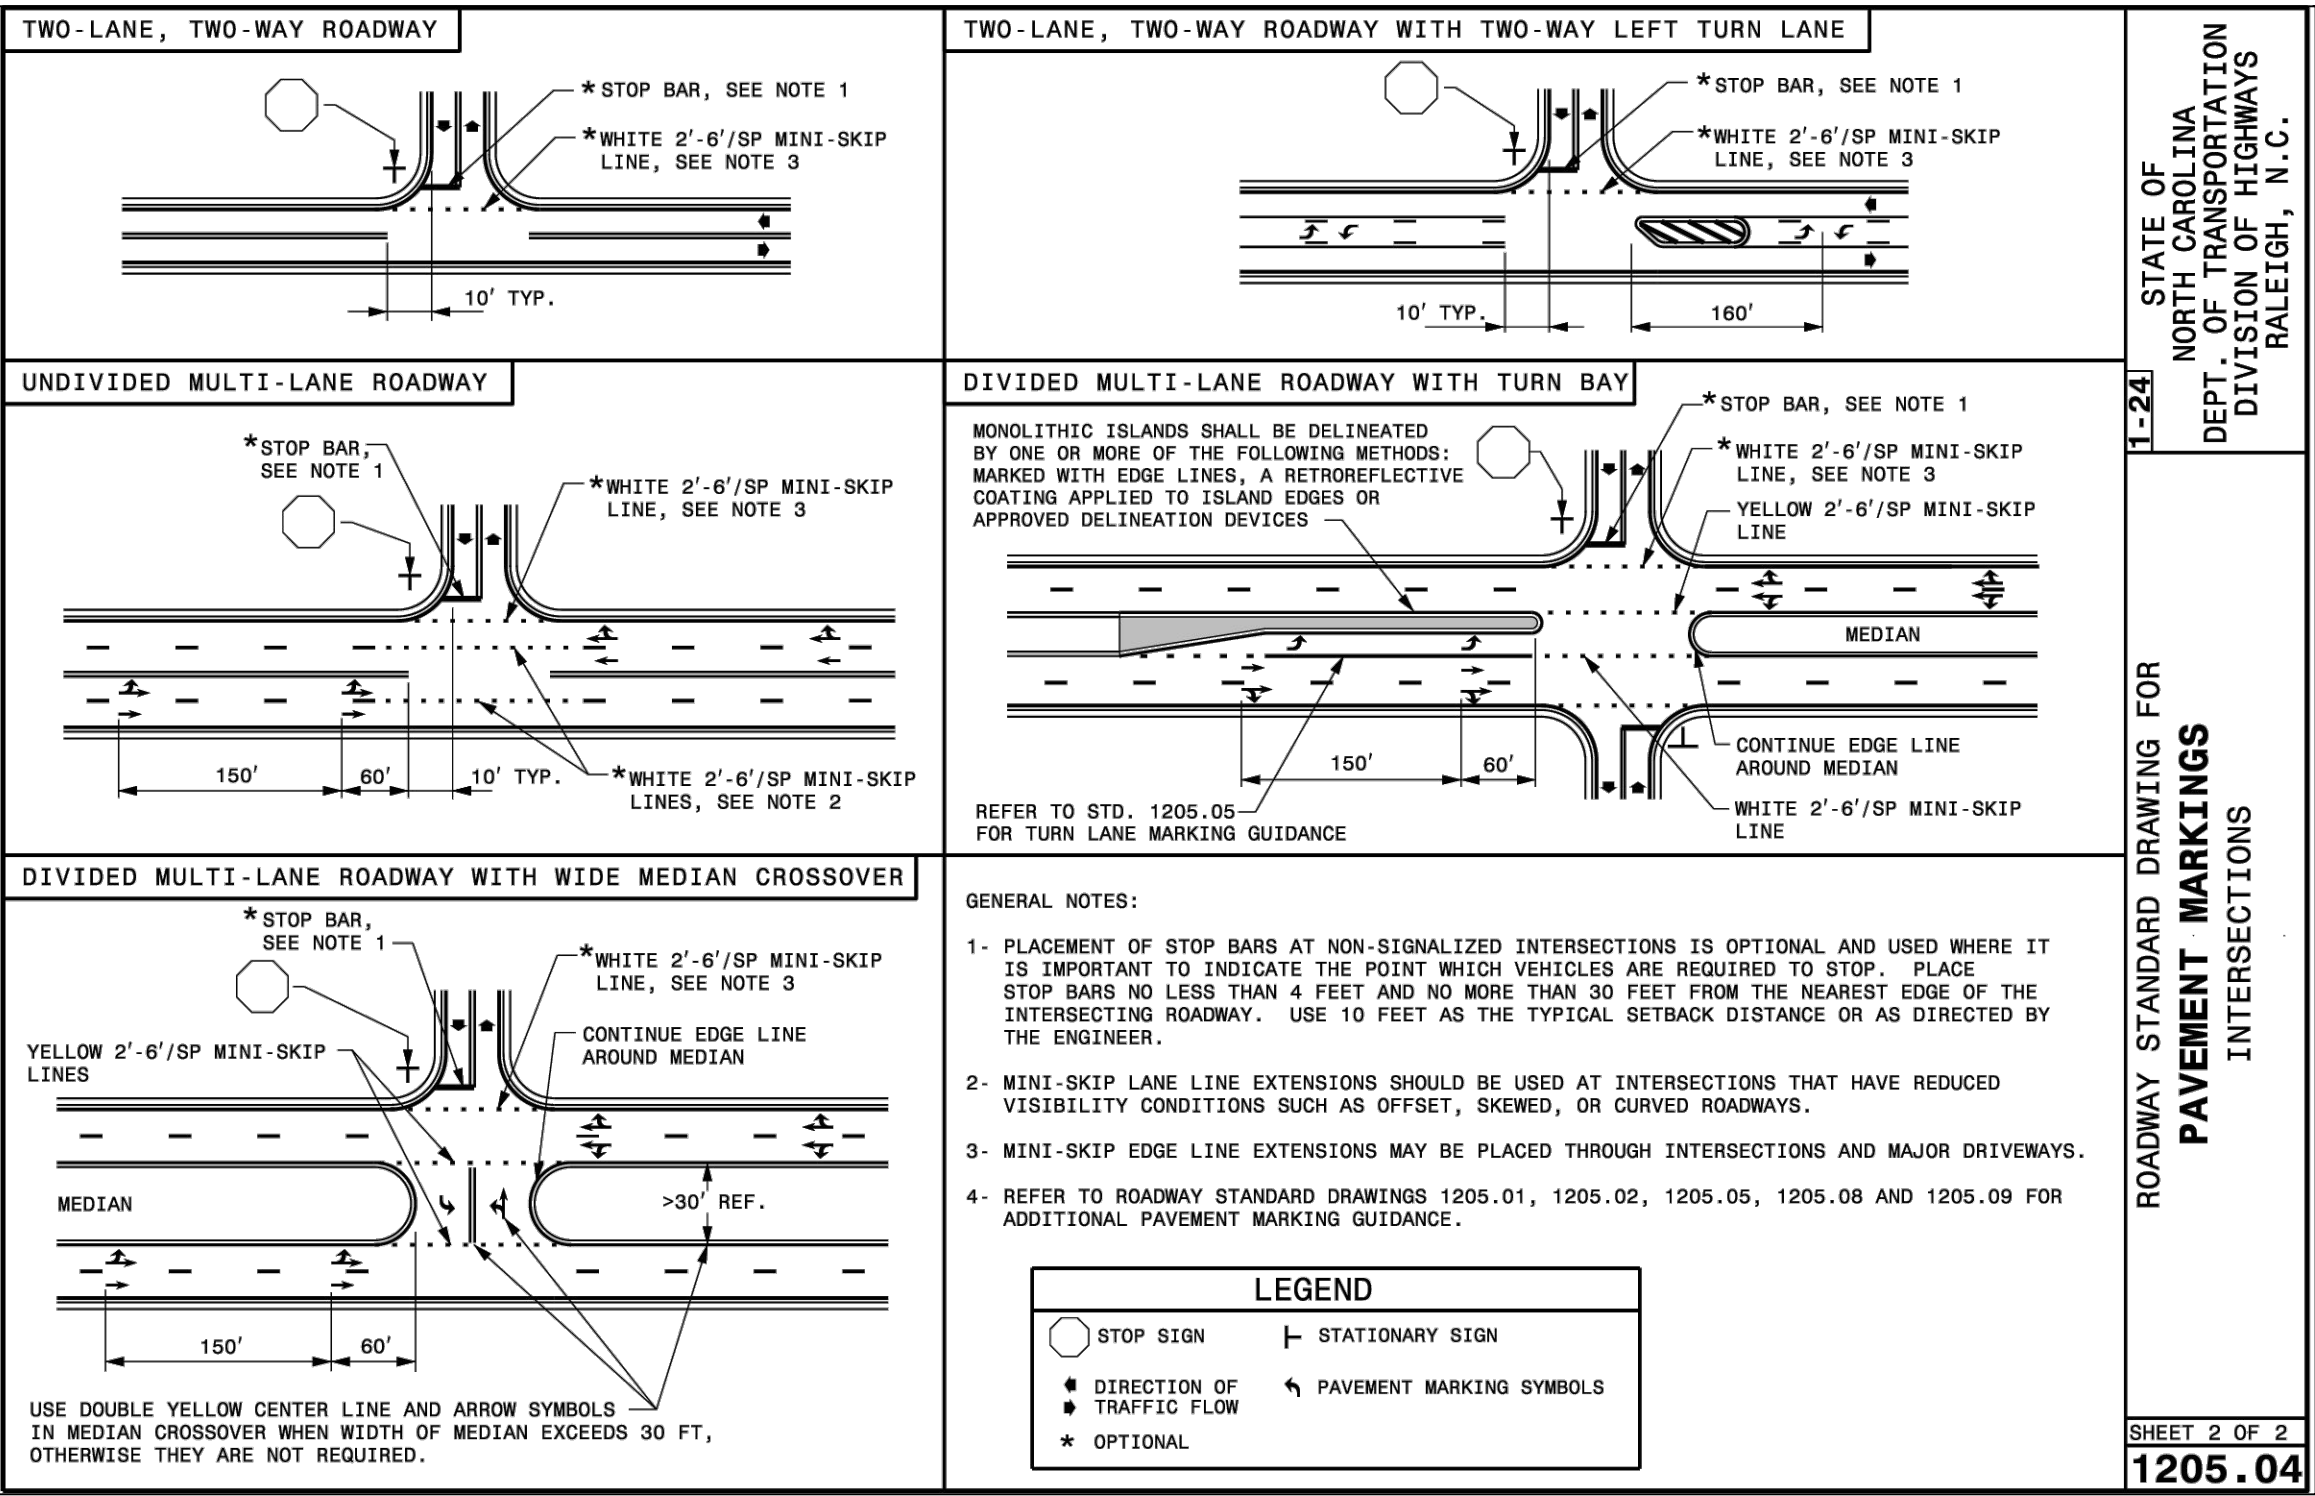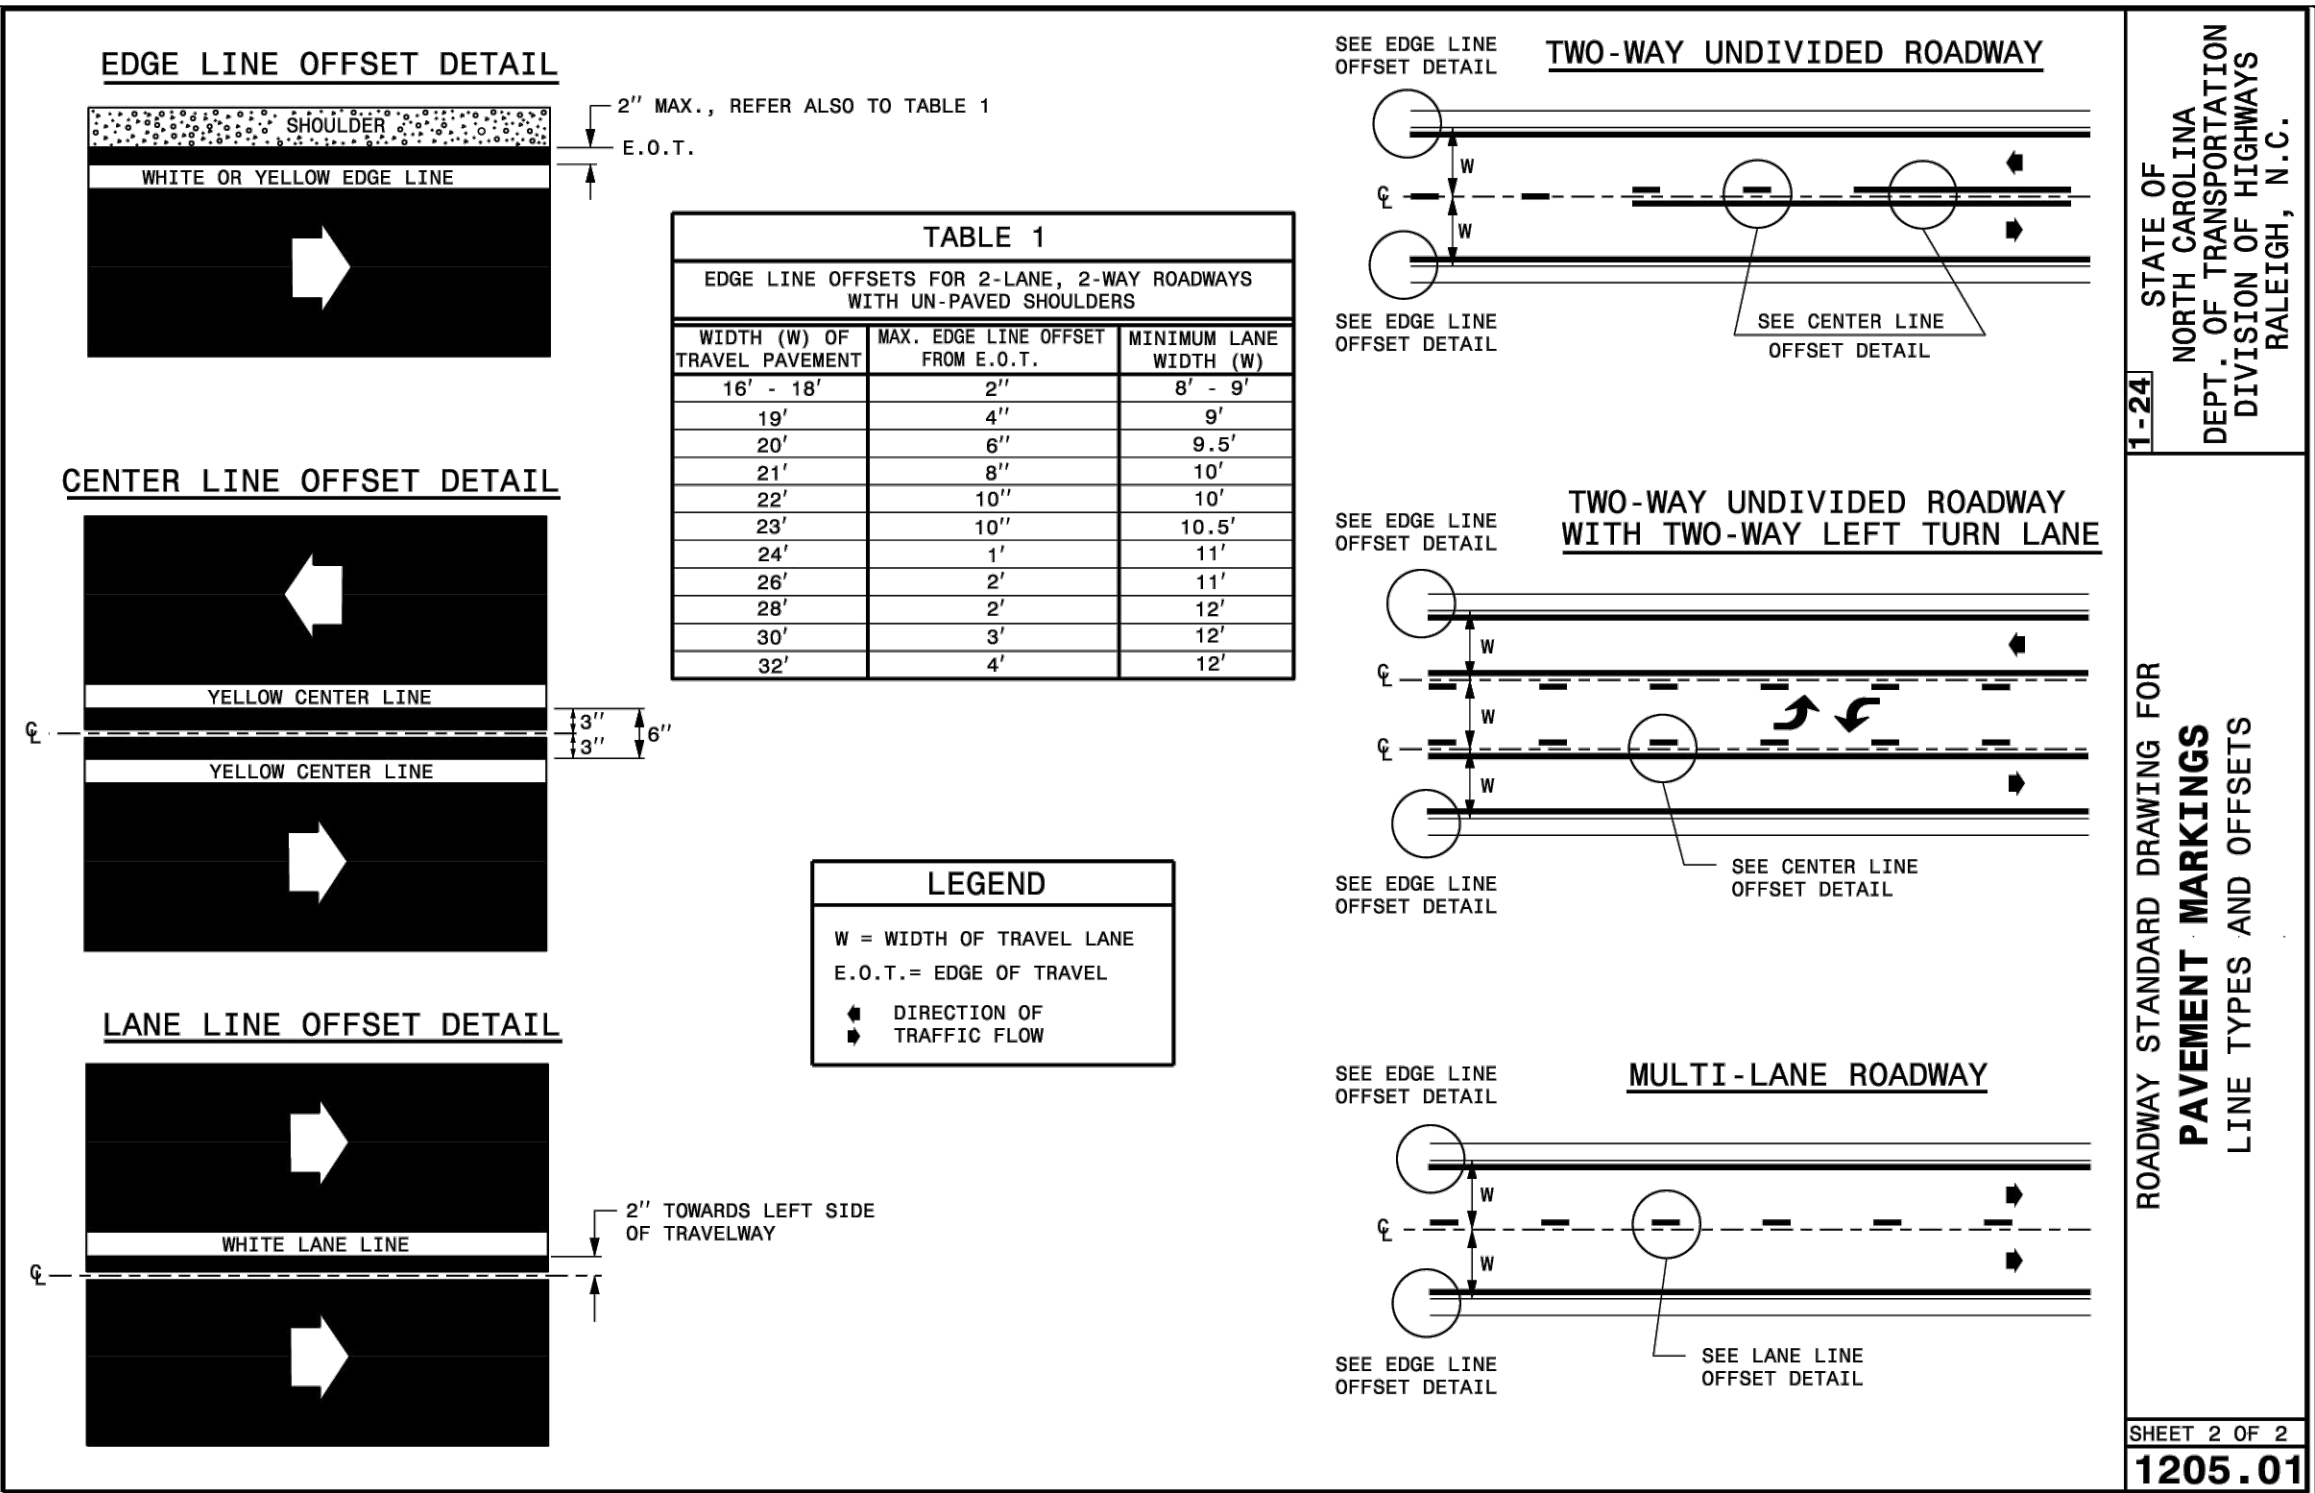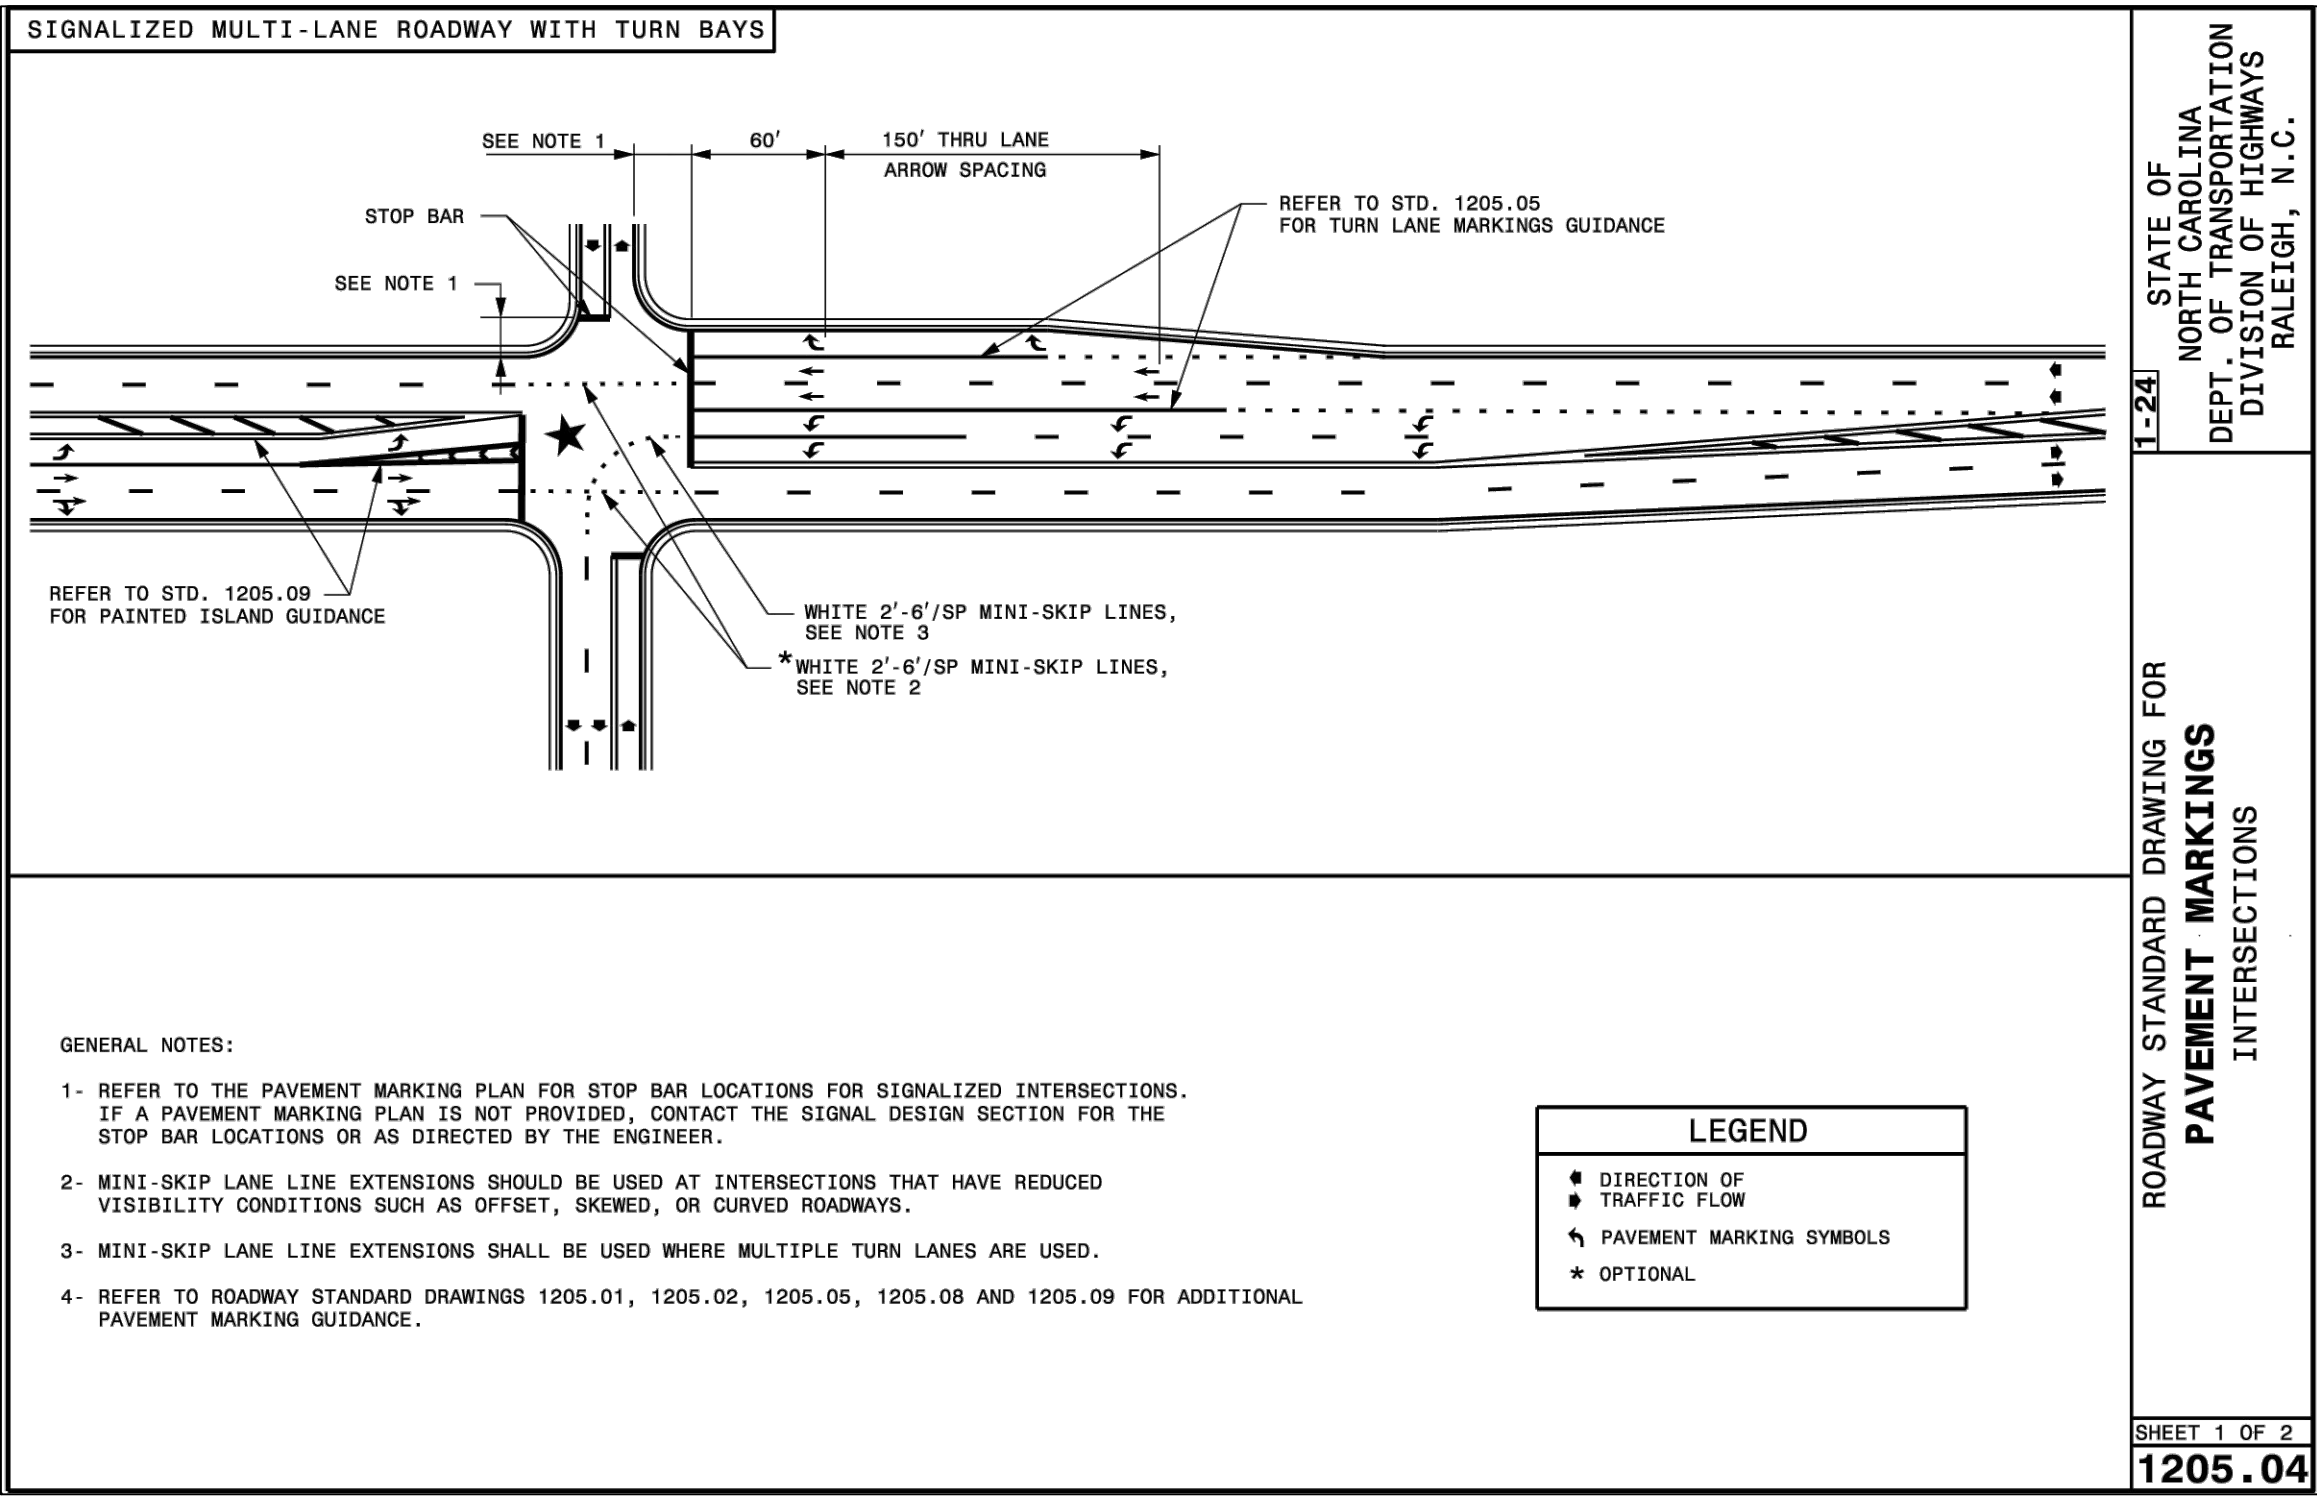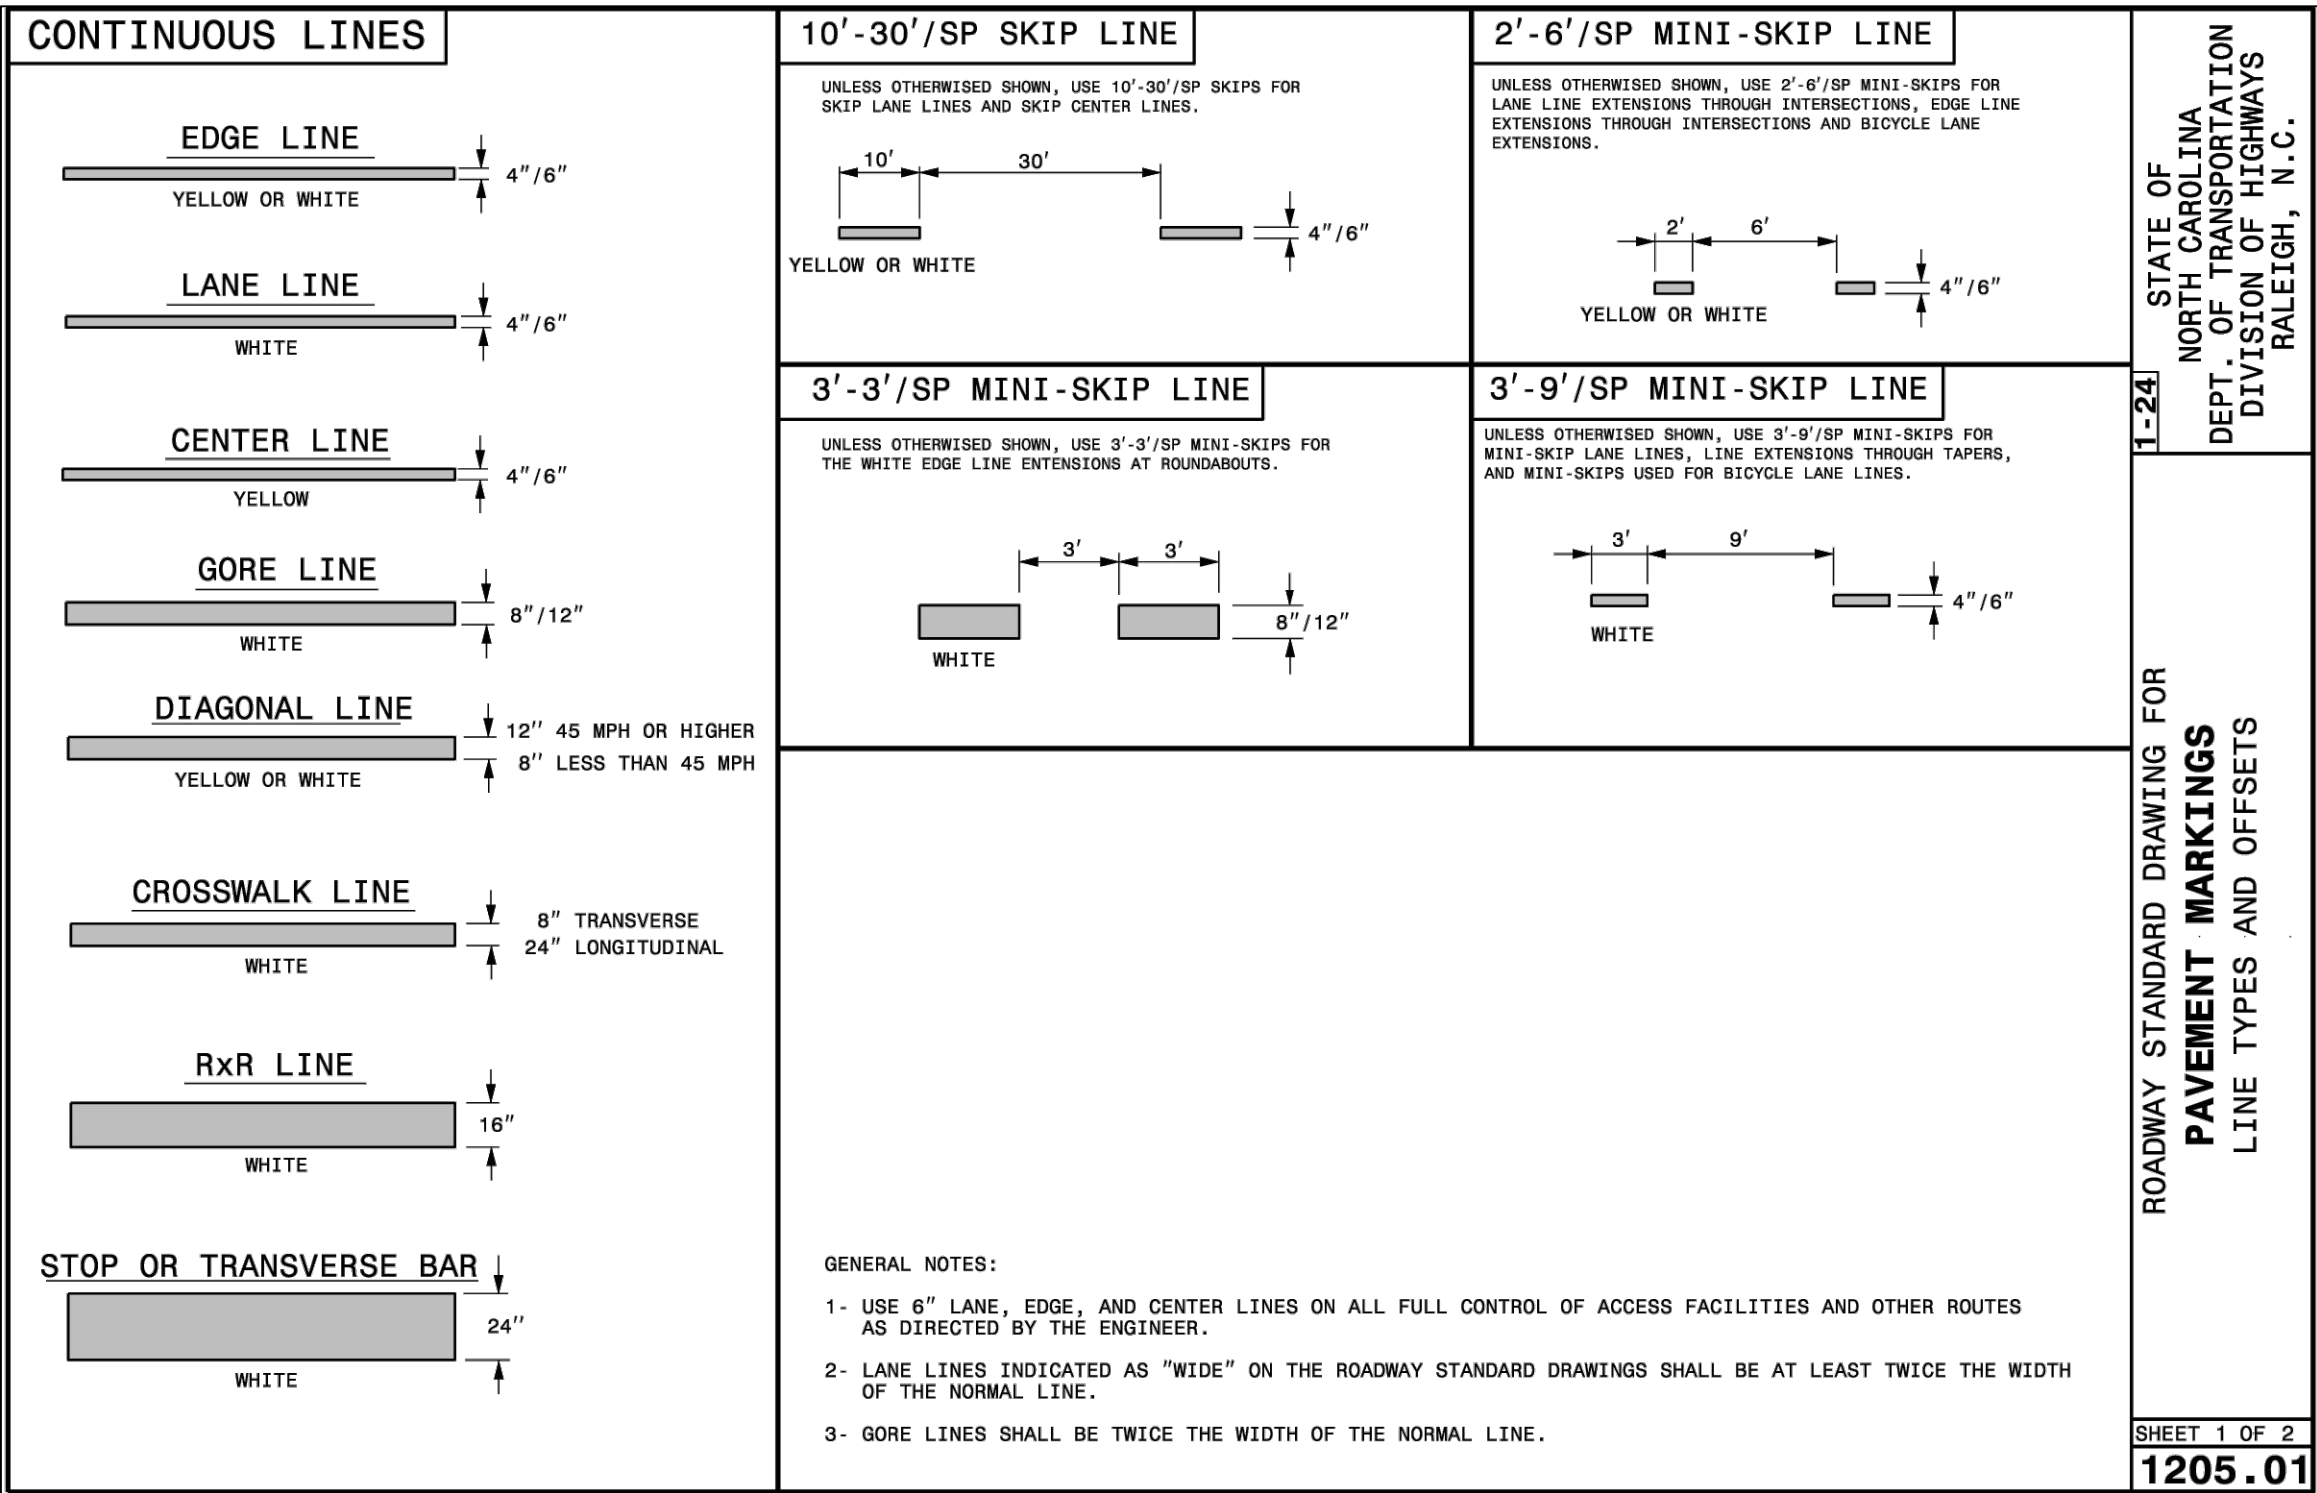

Developer



10030 Green Level Church Rd, Suite 802 #149- Cary, NC 27519

Engineer



Firm # F-1517

15000 Weston Parkway
Cary, N.C. 27513
(919) 996-9455

Surveyor

Jurisdiction / Municipality




Town of Rolesville
502 Southtown Cir
Rolesville, NC 27571
Phone: 919-554-6517

PSP-24-05

Other Consultants

Sheet map:

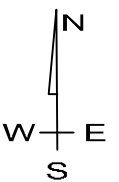

Seal:



FINAL DRAWING - FOR
REVIEW PURPOSES ONLY

Issued / Print Date: 2025-May-30 (18:00)
File Name: 62 Jonesville Road Widening and Striping Plan.dwg

Last Saved by: Tim Newsome
Drawn by: TAN

Project:

**HARRIS CREEK
FARMS**

CID-25-??

Issued for: PROGRESS DRAWINGS
DO NOT USE FOR
CONSTRUCTION

REVISIONS

No. Date Description


Sheet Title:

**ROAD
WIDENING &
STRIPING
DETAILS**

Sheet #:




66

N.C. UNDERGROUND UTILITIES

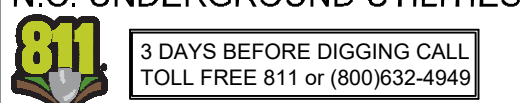

A ONE CALL SYSTEM FOR COMMUNITY AND JOB SAFETY

File Location: C:\Users\BryanHarris\Quantech\Engineering - Documents\Harris Creek Farm - Jonesville\Engineering\DWG\Construction Plans\62 Jonesville Road Widening and Striping Plan.dwg

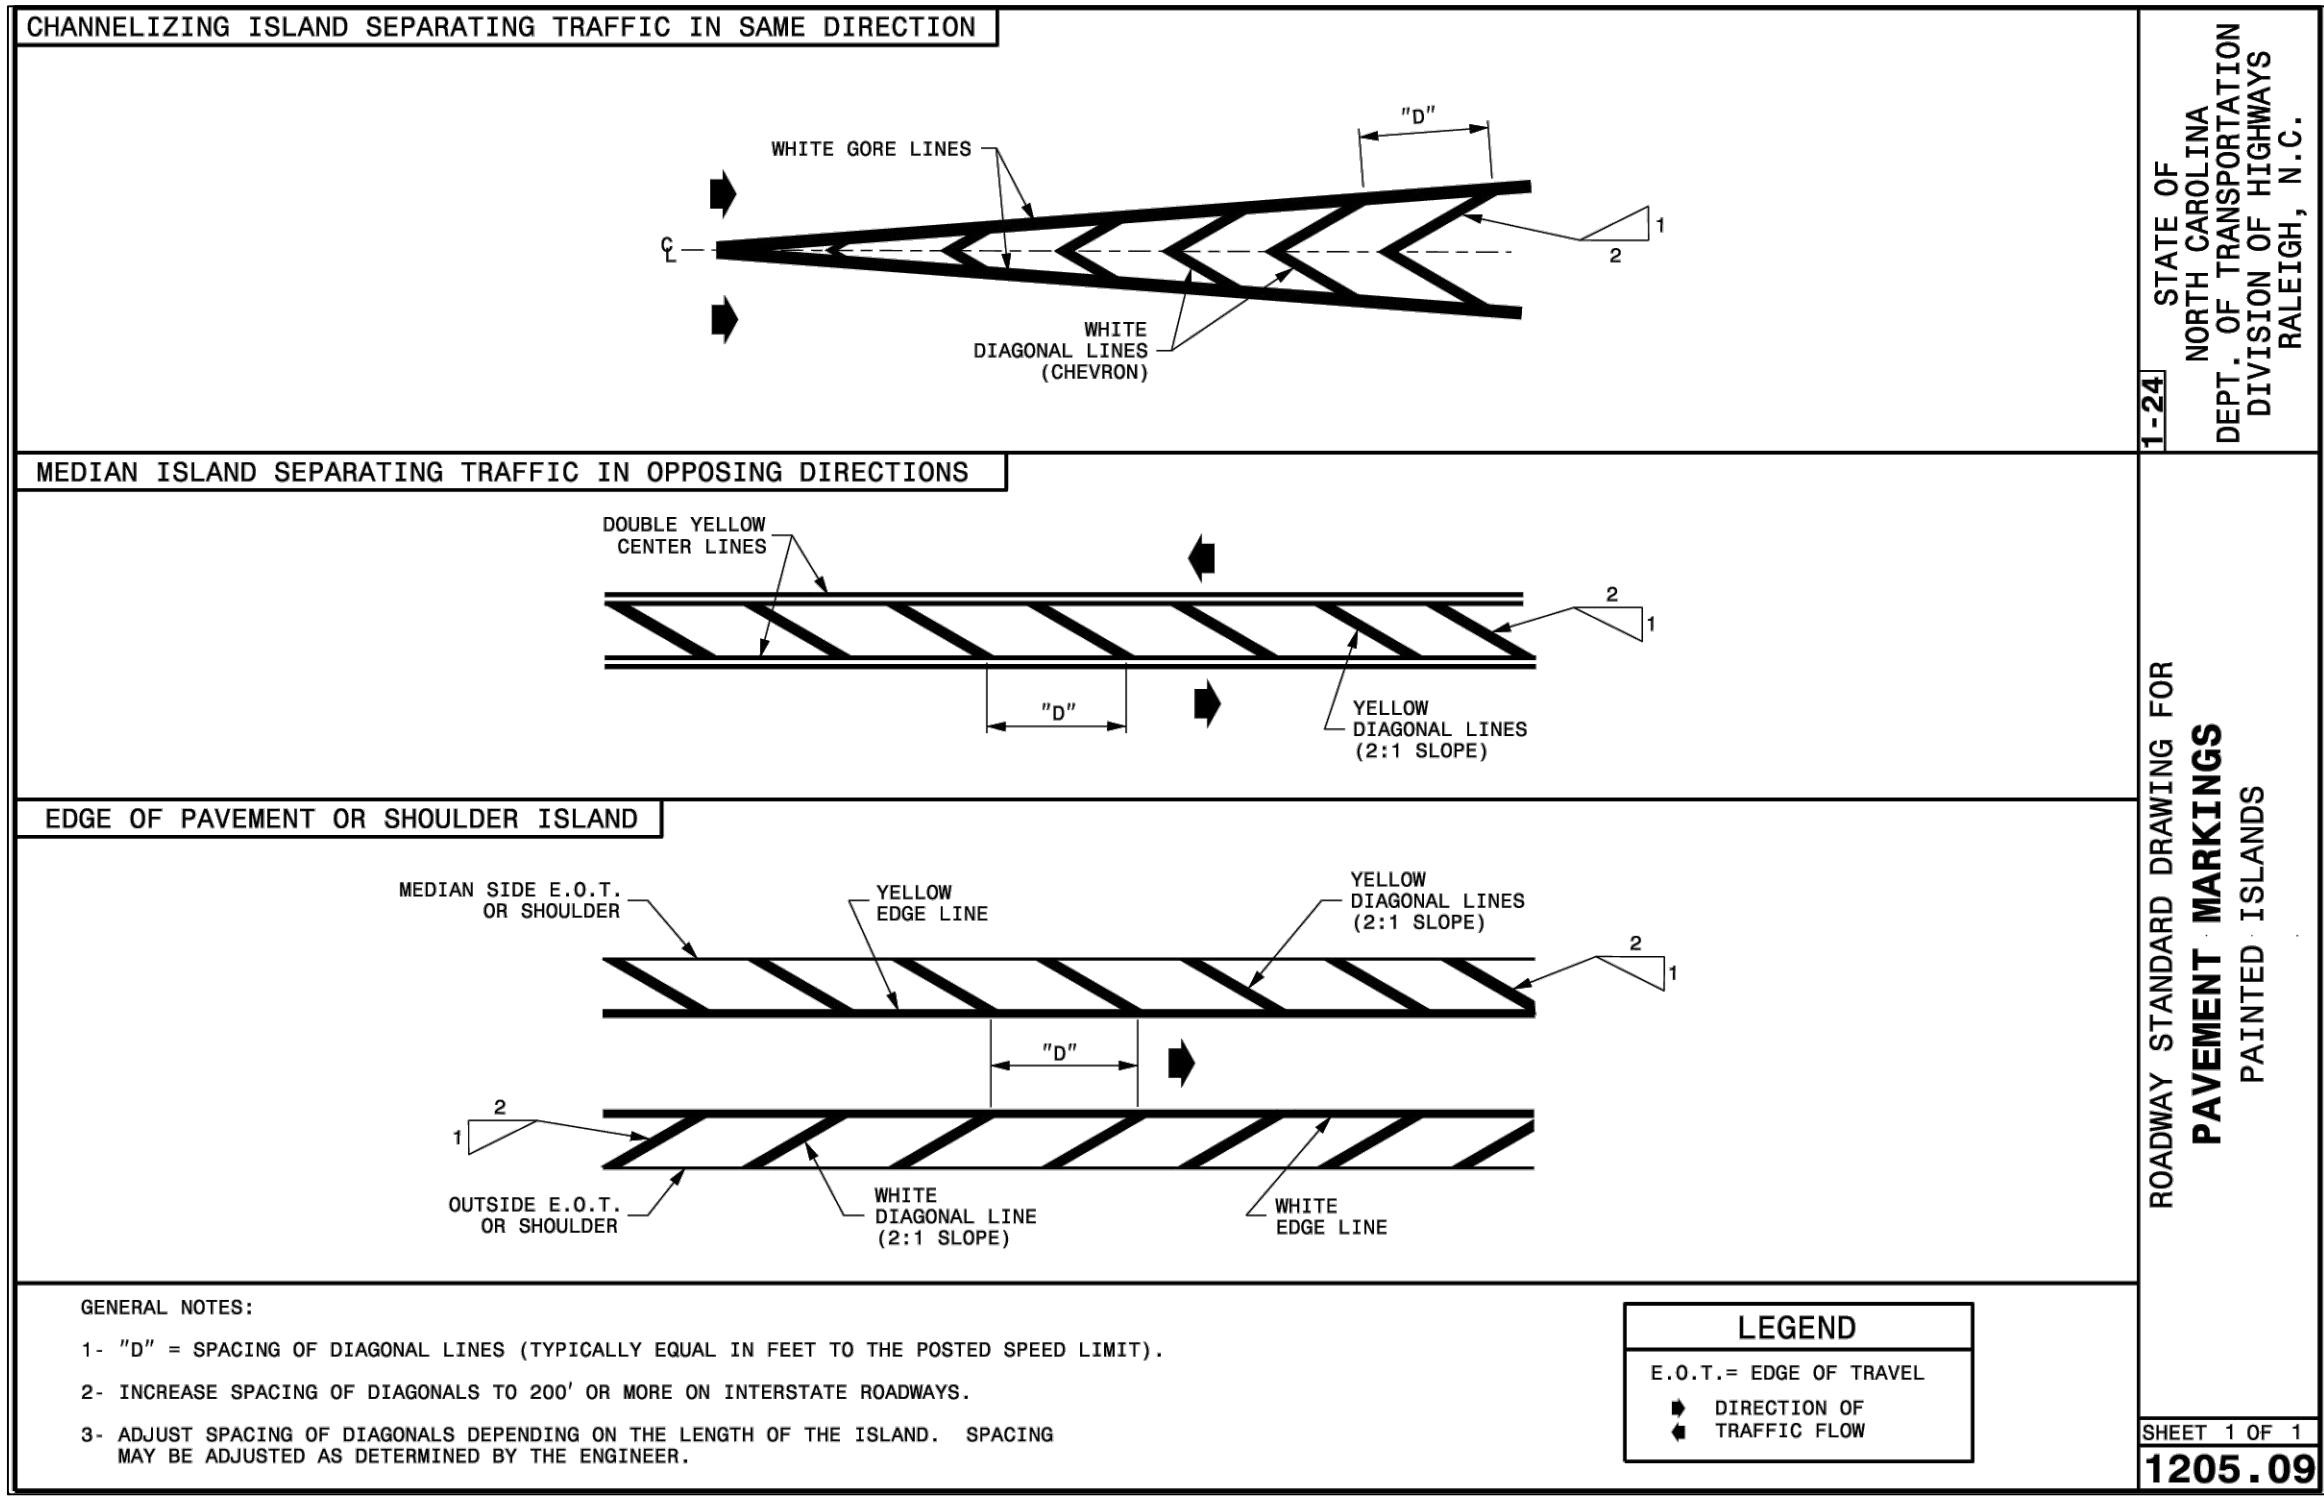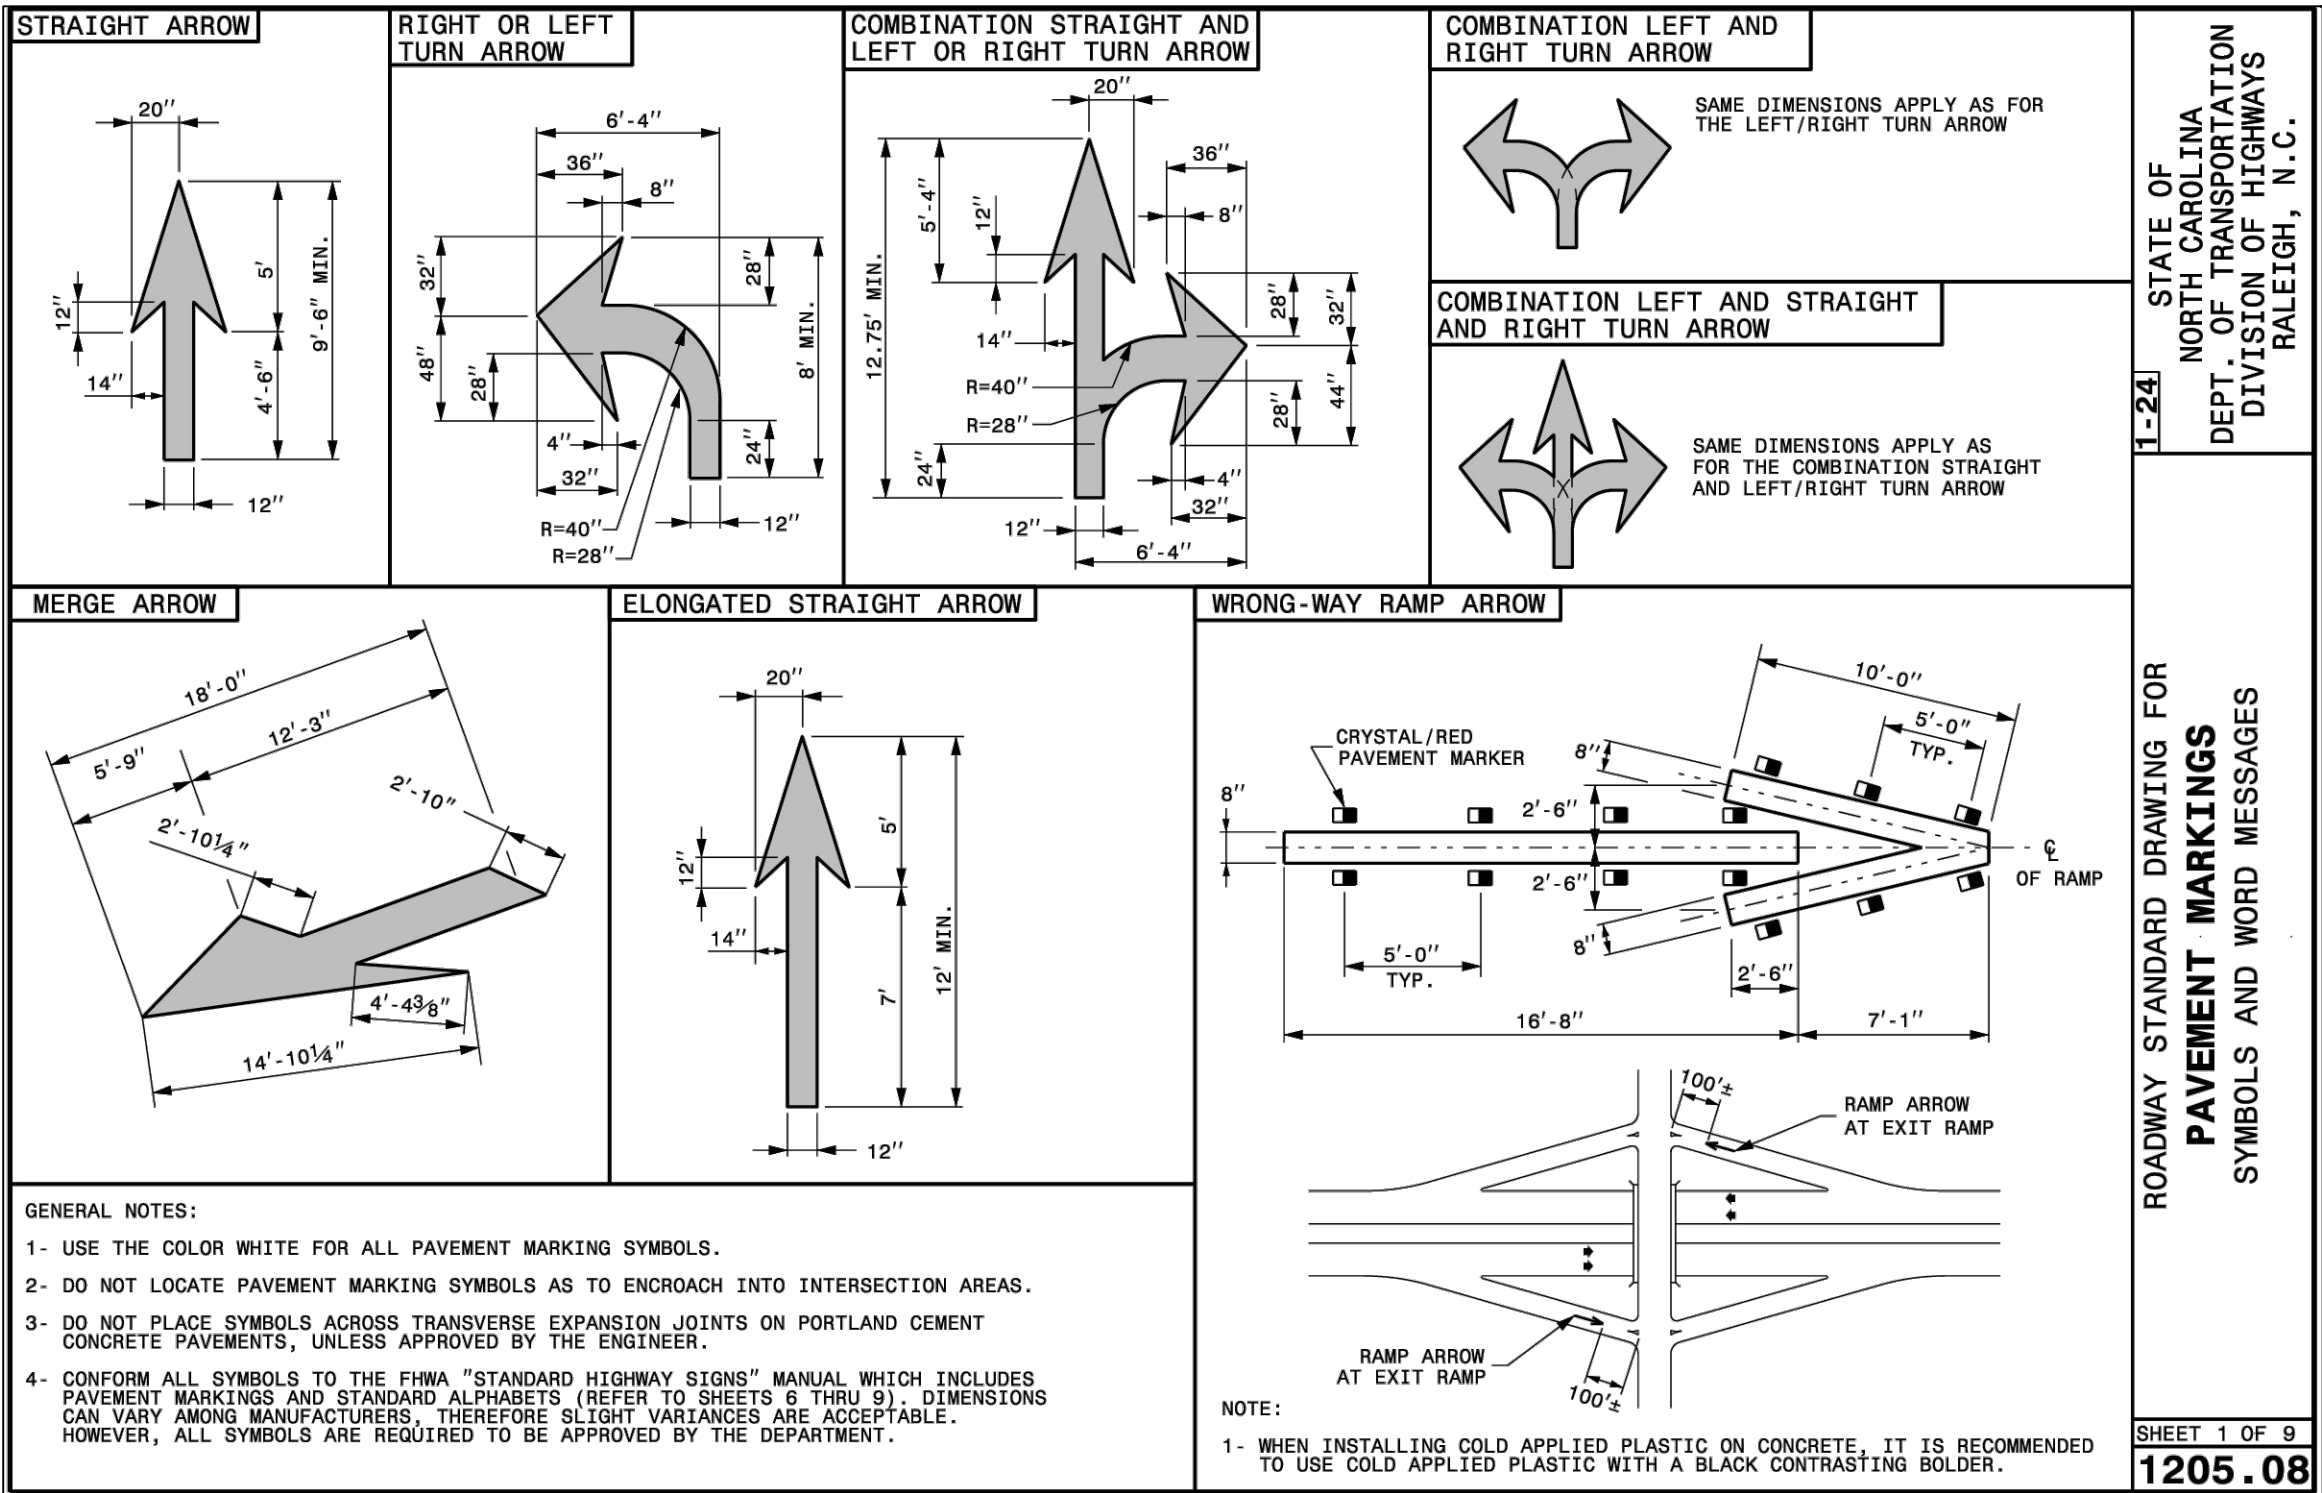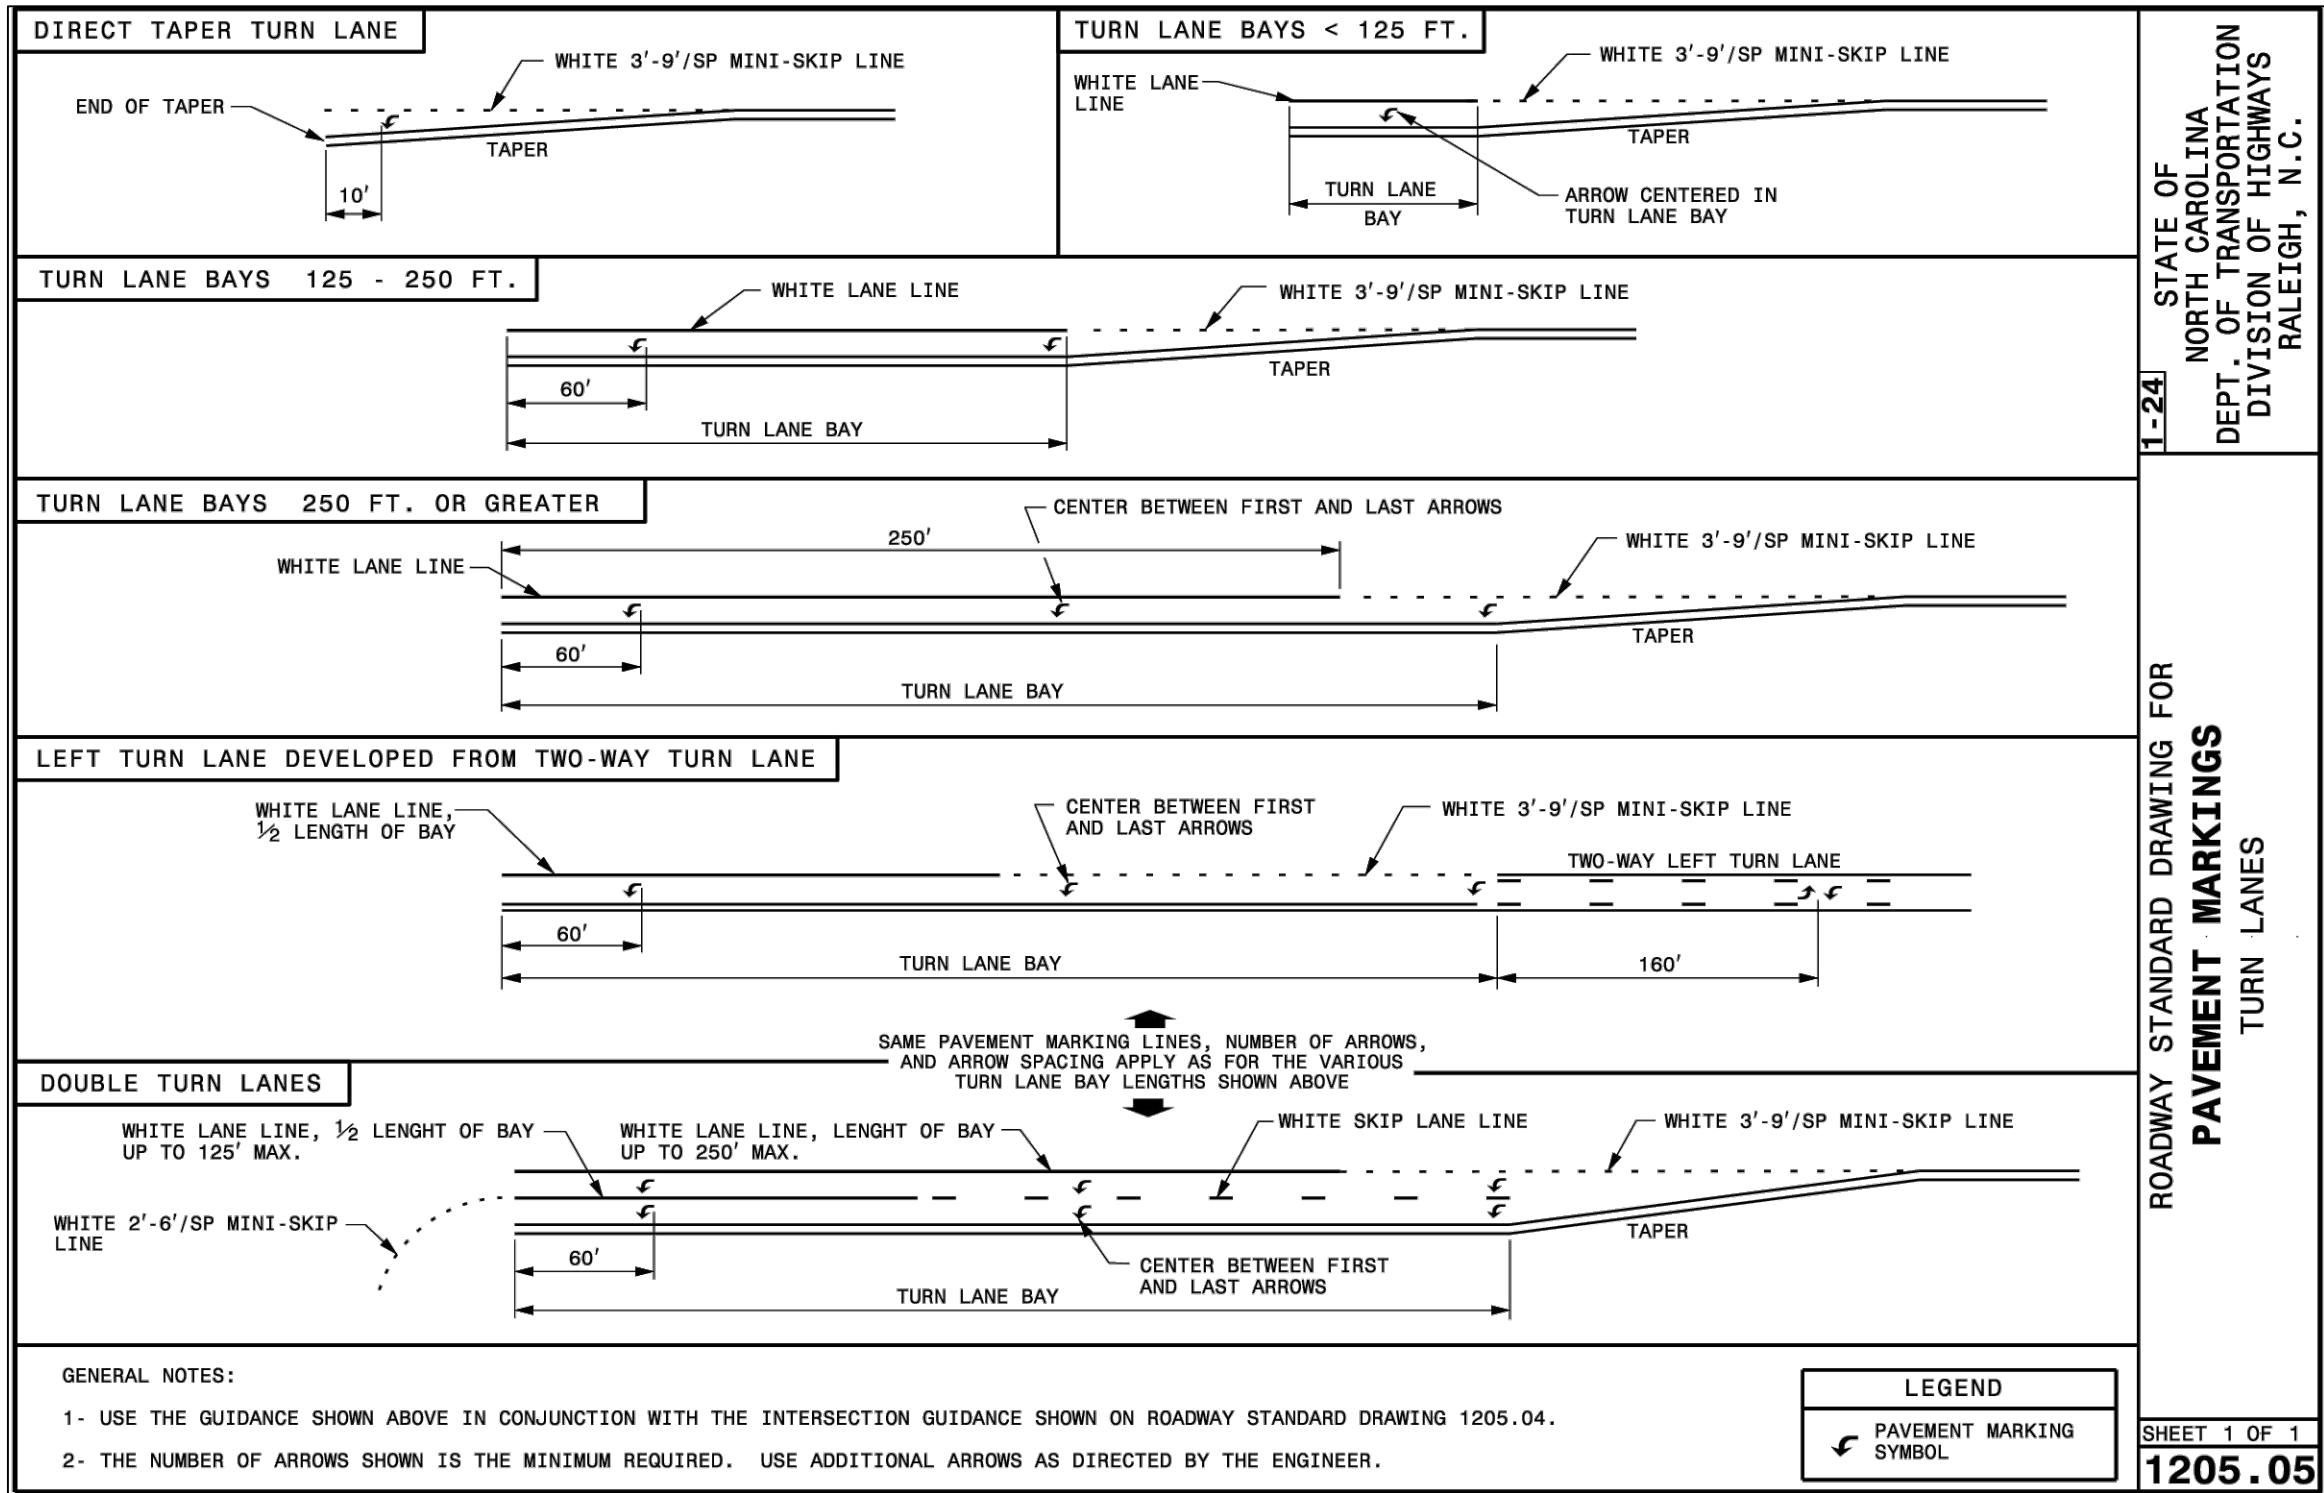

Developer

THE CSC GROUP
CONTRIBUTE TO THE SUCCESS OF LOCAL COMMUNITY

10030 Green Level Church Rd, Suite 802 #149: Cary, NC 27519

Engineer

QUANTECH ENGINEERING
Firm # F-1517
15000 Weston Parkway
Cary, N.C. 27513
(919) 996-9455

Surveyor

Jurisdiction / Municipality

Rolesville
Town of Rolesville
502 Southtown Cir
Rolesville, NC 27571
Phone: 919-554-6517
PSP-24-05

Other Consultants

Sheet map:

N
W E
S

Seal:

PROFESSIONAL SEAL
NORTH CAROLINA
SEAL
53676
ENGINEER
BRYAN A. HARRIS

FINAL DRAWING - FOR REVIEW PURPOSES ONLY

Issued / Print Date: 2025-May-30 (18:00)
File Name: 62 Jonesville Road Widening and Striping Plan.dwg

Last Saved by: Tim Newsome
Drawn by: TAN

Project:

HARRIS CREEK FARMS
CID-25-??

Issued for: PROGRESS DRAWINGS
DO NOT USE FOR CONSTRUCTION


REVISIONS		
No.	Date	Description

Sheet Title:

ROAD WIDENING & STRIPING DETAILS

Sheet #:

File Location: C:\Users\BryanHarris\Quantech\Quantech Engineering - Documents\Harris Creek Farm - Jonesville\Engineering\DWG\Construction Plans\62 Jonesville Road Widening and Striping Plan.dwg

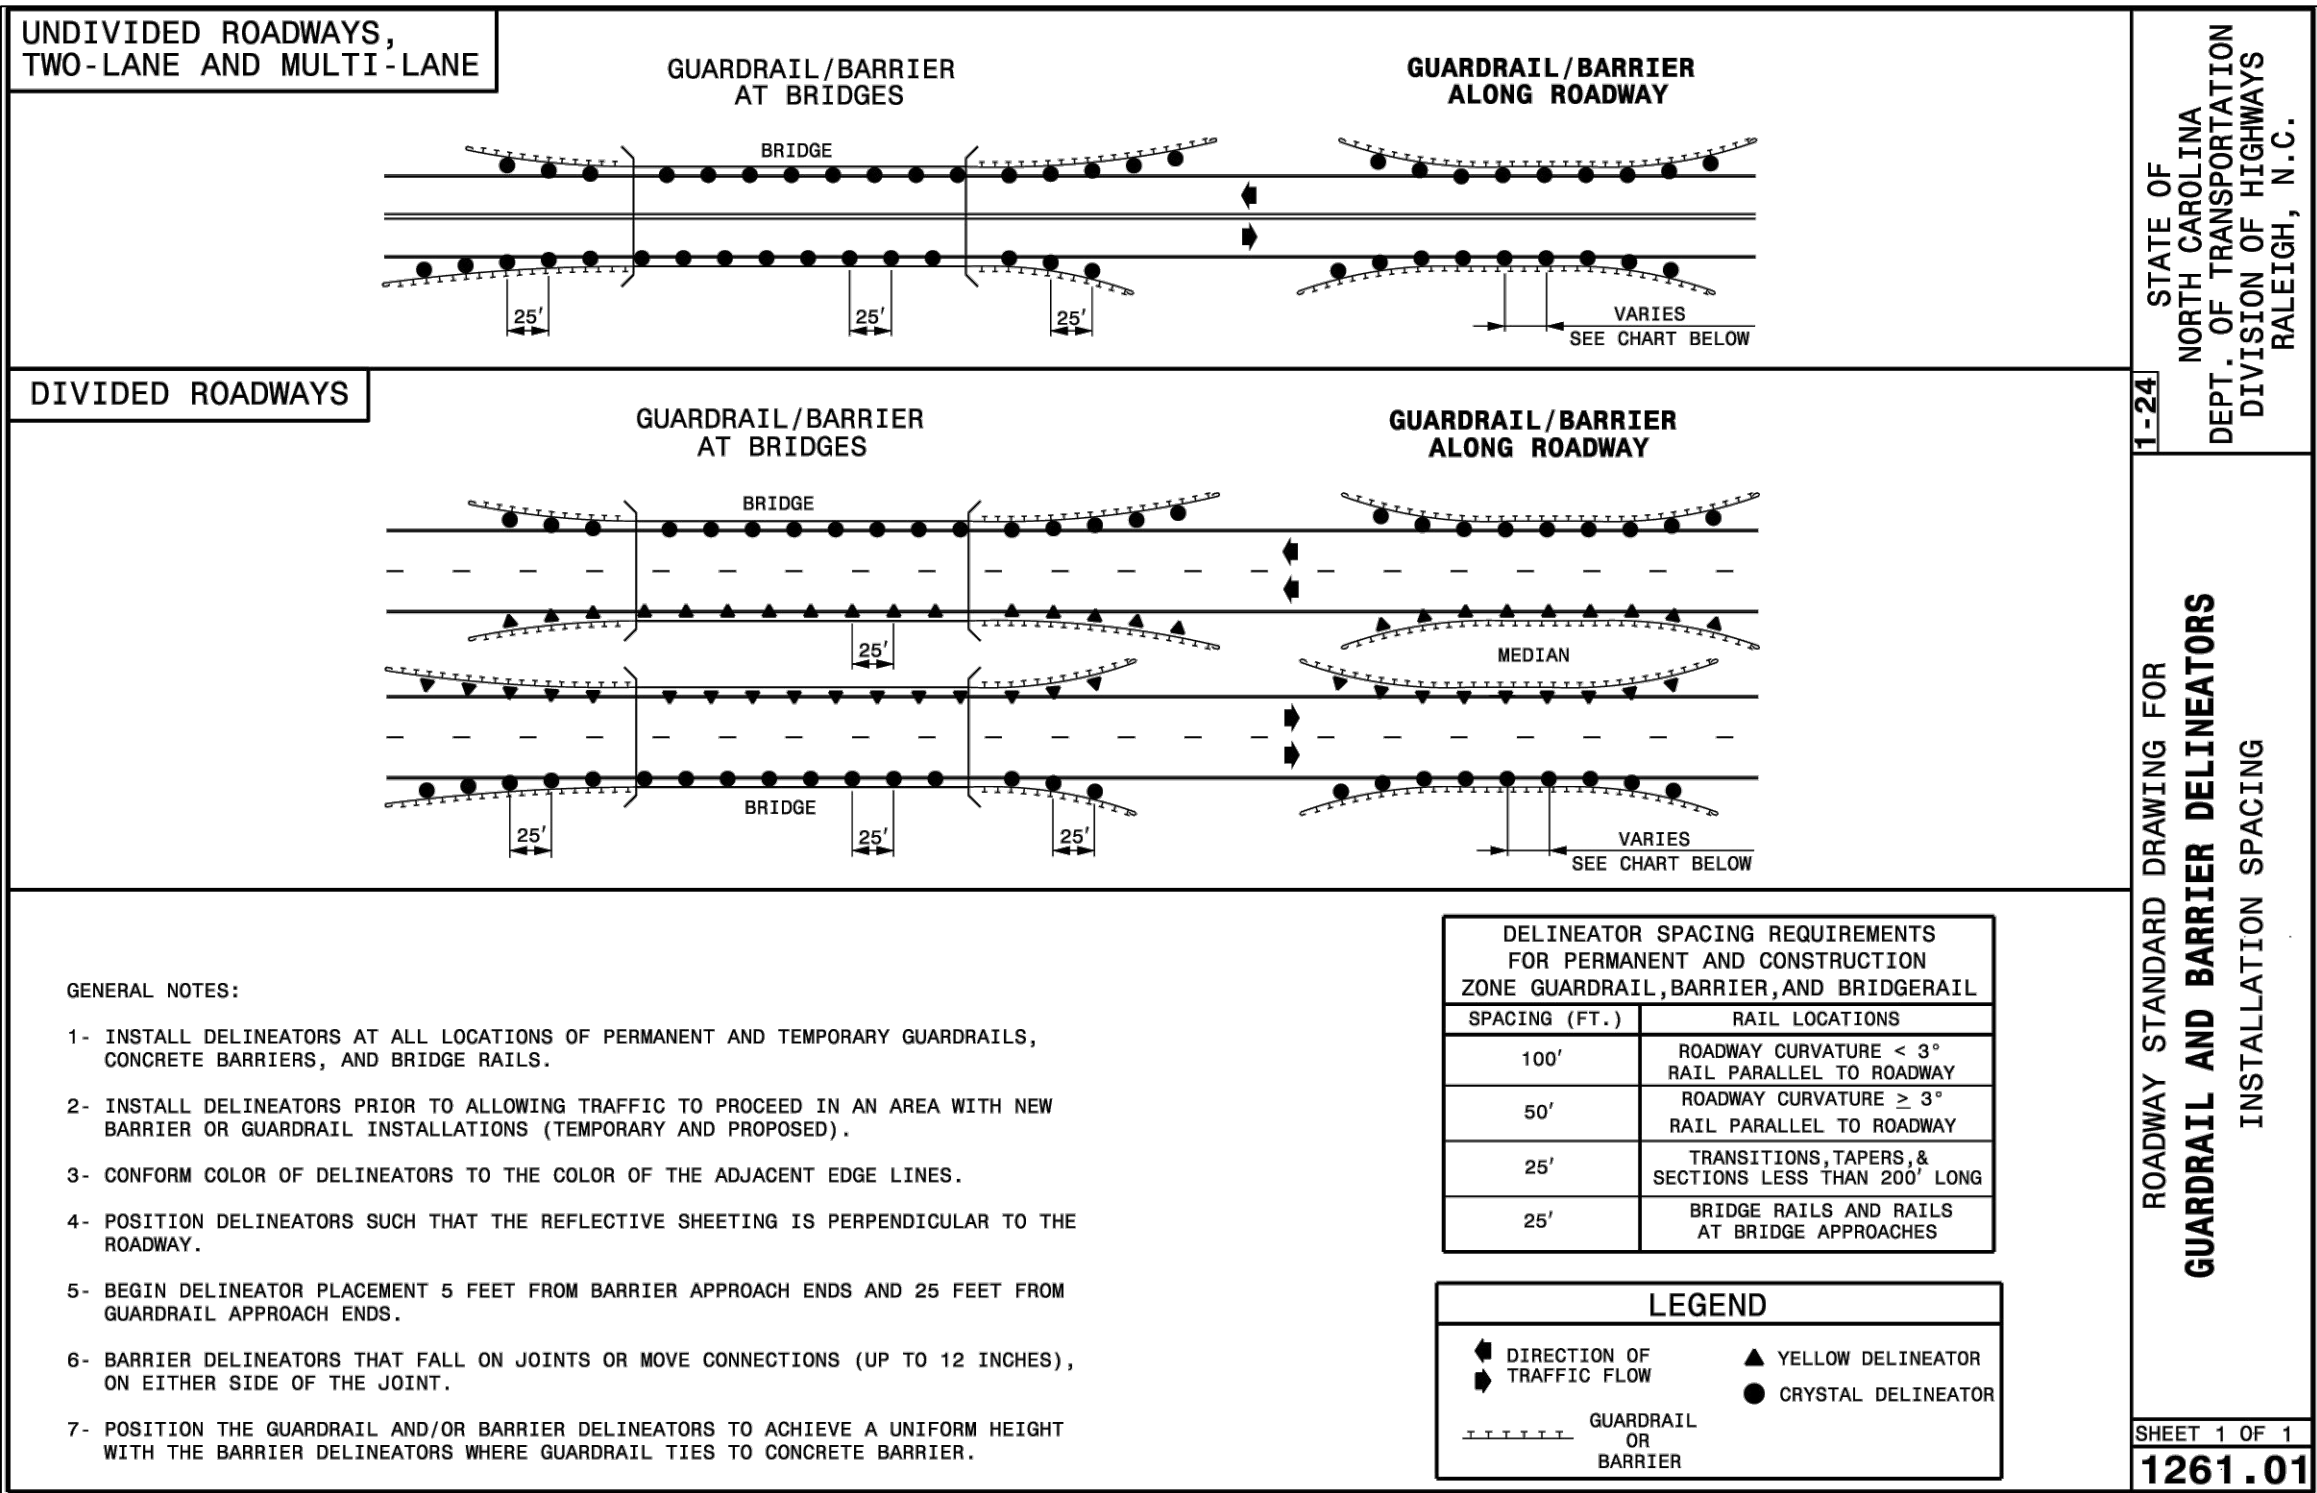

Developer

THE CSC GROUP

CONTRIBUTE TO THE SUCCESS OF LOCAL COMMUNITY

10030 Green Level Church Rd, Suite 802 #149, Cary, NC 27519

Engineer

QUANTECH ENGINEERING

INNOVATIVE SOLUTIONS | ENGINEERING THE FUTURE

Firm # F-1517

15000 Weston Parkway
Cary, N.C. 27513
(919) 996-9455

Surveyor

Jurisdiction / Municipality

Rolesville

Services Community to Capital Connections

Est. 2007

Town of Rolesville
502 Southtown Cir
Rolesville, NC 27571
Phone: 919-554-6517
PSP-24-05

Other Consultants

Sheet map:

Seal:

FINAL DRAWING - FOR
REVIEW PURPOSES ONLY

Issued / Print Date: 2025-May-30 (18:00)
File Name: 62 Jonesville Road Widening and Striping
Plan.dwg

Last Saved by: Tim Newsome
Drawn by: TAN

Project:

HARRIS CREEK
FARMS

CID-25-??

Issued for:

PROGRESS DRAWINGS
DO NOT USE FOR
CONSTRUCTION

REVISIONS

Sheet Title:

ROAD
WIDENING &
STRIPING
DETAILS

Sheet #:



811

3 DAYS BEFORE DIGGING CALL
TOLL FREE 811 or (800)632-4949

A ONE CALL SYSTEM FOR COMMUNITY AND JOB SAFETY

69

File Location: C:\Users\BryanHarris\Quantech\Engineering - Documents\Harris Creek Farm - Jonesville Road Widening and Striping Plan.dwg

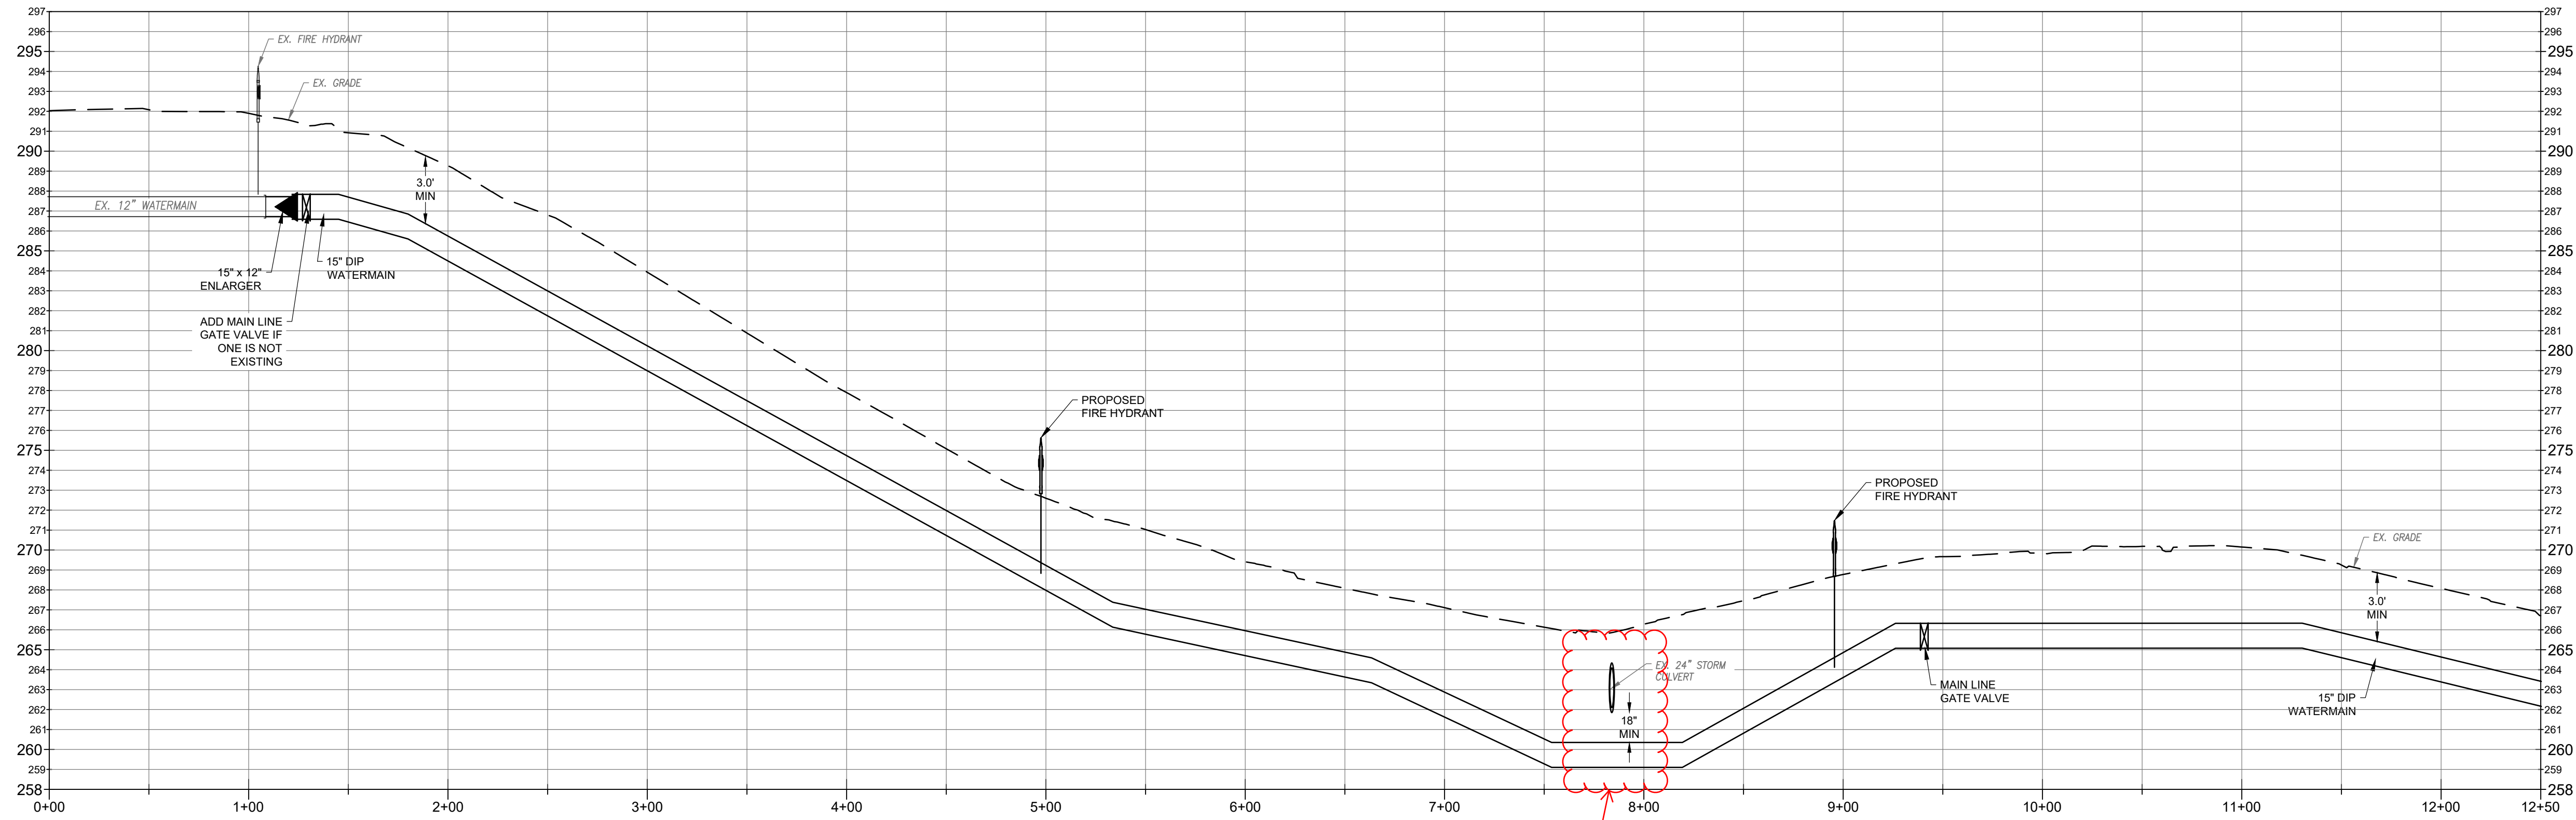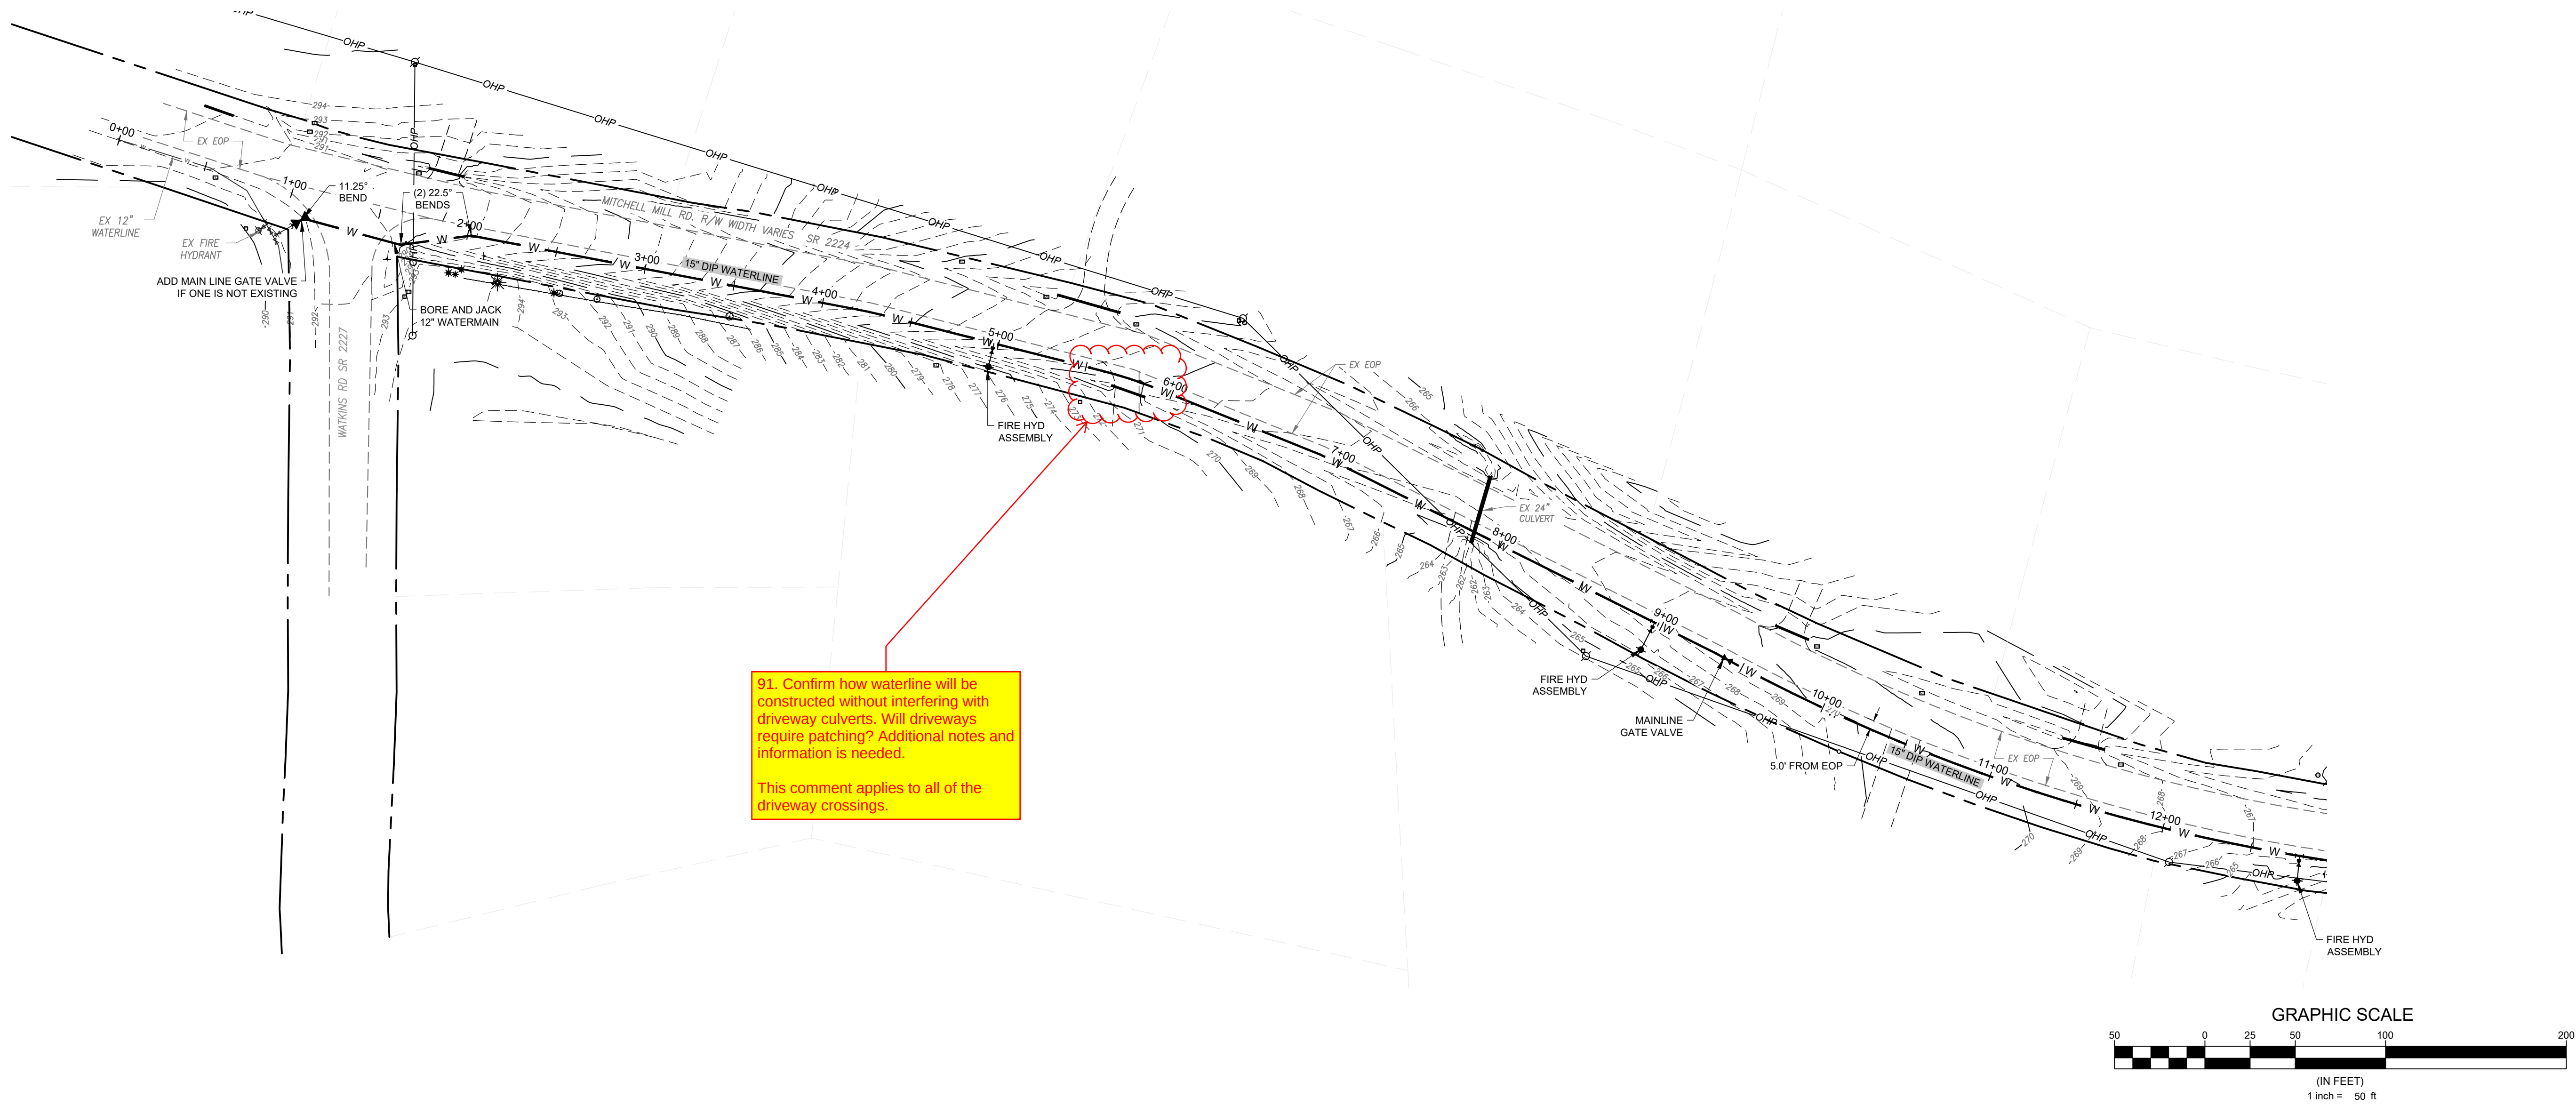

Developer



10030 Green Level Church Rd, Suite 802 #149: Cary, NC 27519

Engineer



INNOVATIVE SOLUTIONS | SUSTAINING THE FUTURE

Firm # F-1517

15000 Weston Parkway
Cary, N.C. 27513
(919) 996-9455

Surveyor


Jurisdiction / Municipality



PSP-24-05

Other Consultants

Sheet map:

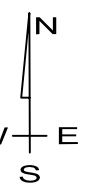

Seal:



FINAL DRAWING - FOR
REVIEW PURPOSES ONLY

Issued / Print Date: 2025-May-30 (18:00)
File Name: 62 Jonesville Road Widening and Striping
Plan.dwg

Last Saved by: Tim Newsome
Drawn by: TAN

Project:

**HARRIS CREEK
FARMS**

CID-25-??

Issued for: **PROGRESS DRAWINGS
DO NOT USE FOR
CONSTRUCTION**

REVISIONS

No. Date Description


Sheet Title:

**MITCHELL
WATERLINE
0+00 TO 12+50**

Sheet #:





70

N.C. UNDERGROUND UTILITIES

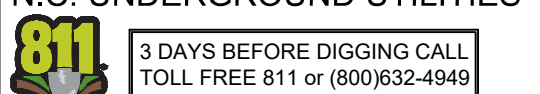

A ONE CALL SYSTEM FOR COMMUNITY AND JOB SAFETY

File Location: C:\Users\BryanHarris\Quantech\Engineering - Documents\Harris Creek Farm - Jonesville\Engineering - DWG\Construction Plans\62 Jonesville Road Widening and Striping Plan.dwg

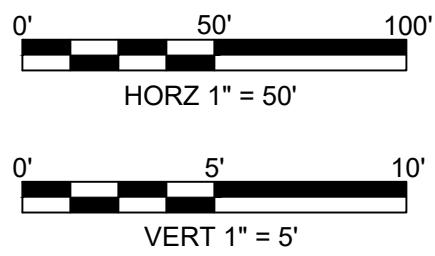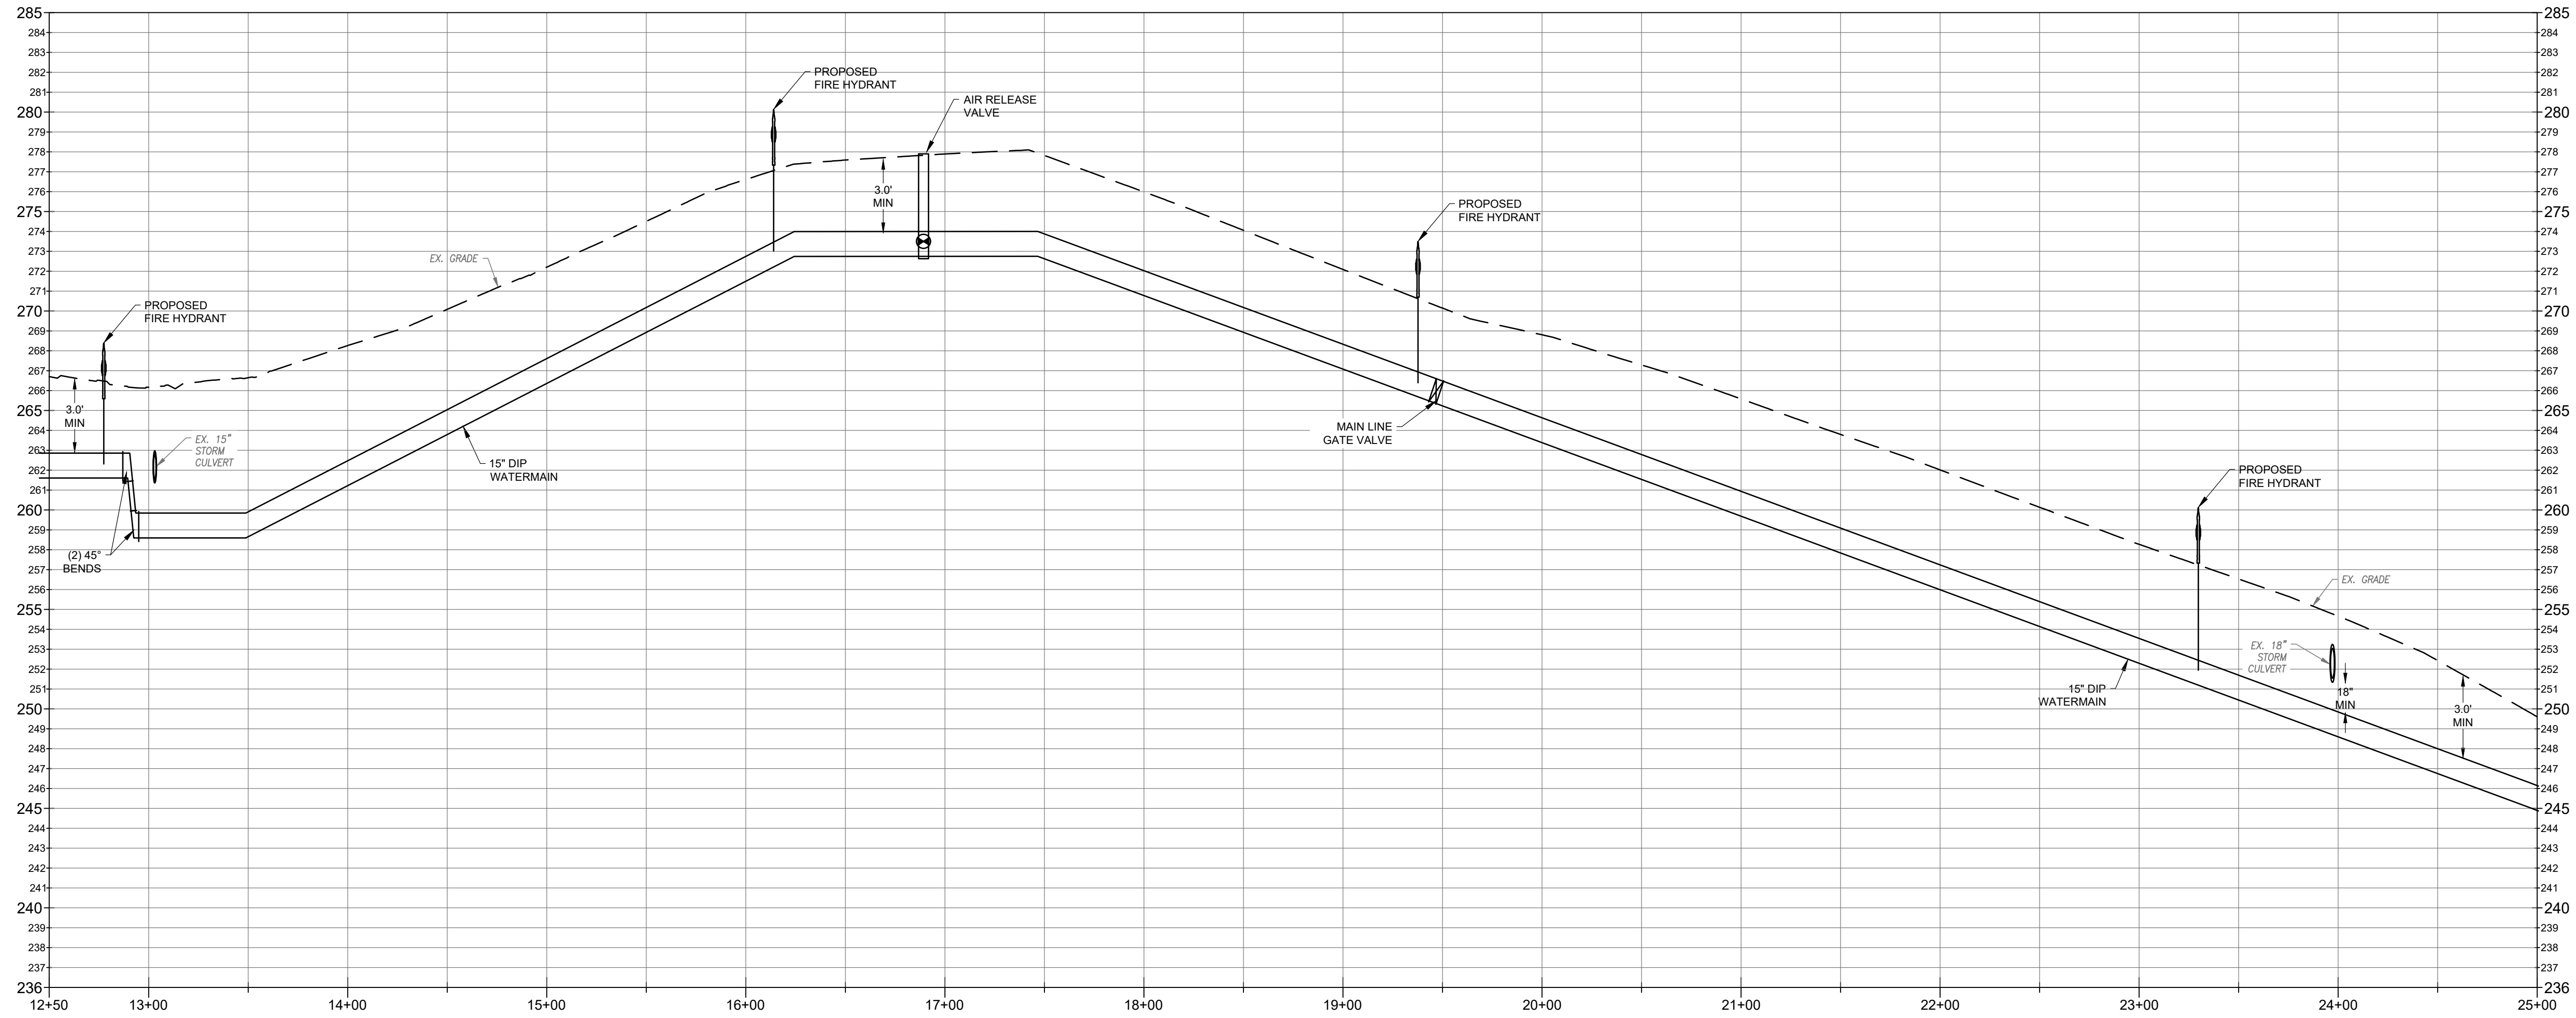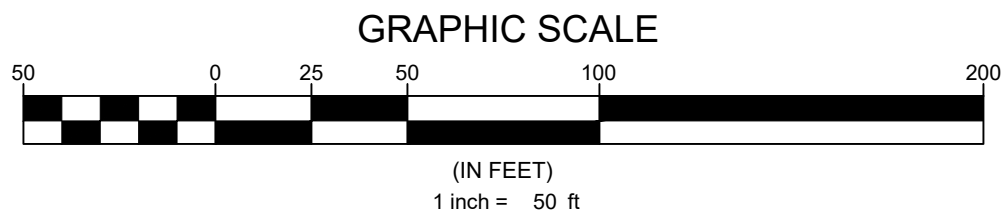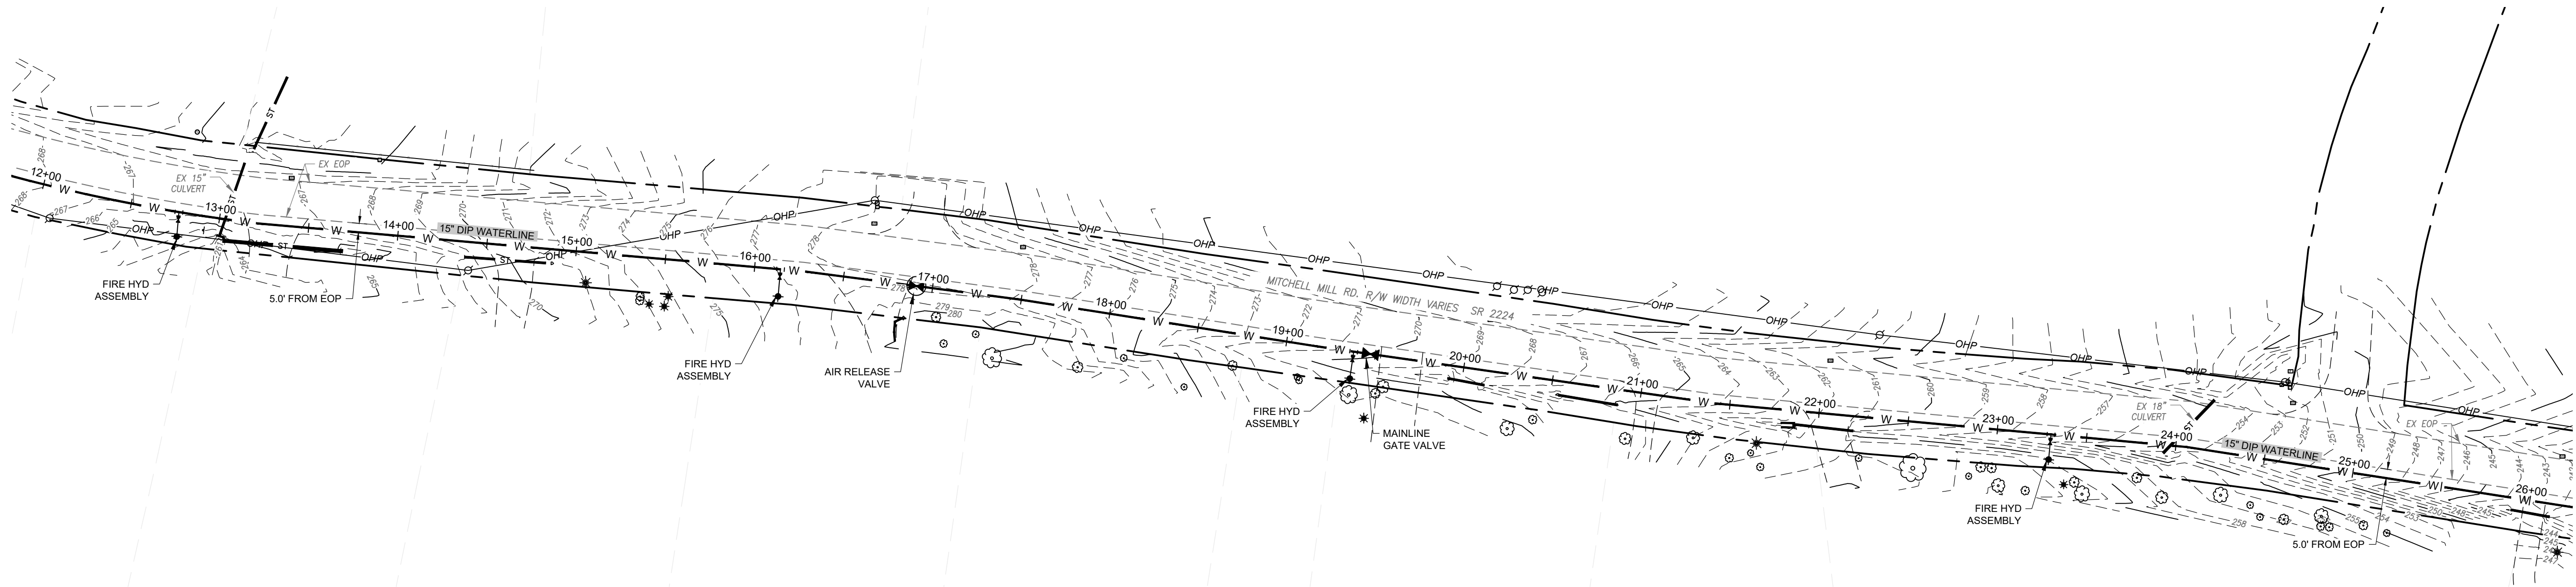

Developer



10030 Green Level Church Rd, Suite 802 #149, Cary, NC 27519

Engineer



QUANTECH ENGINEERING

Firm # F-1517

15000 Weston Parkway
Cary, N.C. 27513
(919) 996-9455


Surveyor

Jurisdiction / Municipality



Other Consultants

Sheet map:

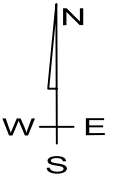

Seal:



FINAL DRAWING - FOR
REVIEW PURPOSES ONLY

Issued / Print Date: 2025-May-30 (18:01)
File Name: 62 Jonesville Road Widening and Striping
Plan.dwg

Last Saved by: Tim Newsome
Drawn by: TAN

Project:

**HARRIS CREEK
FARMS**

CID-25-??

Issued for: PROGRESS DRAWINGS
DO NOT USE FOR
CONSTRUCTION

REVISIONS




No. Date Description



Sheet Title:

**MITCHELL
WATERLINE
12+50 TO 25+00**




Sheet #:

71

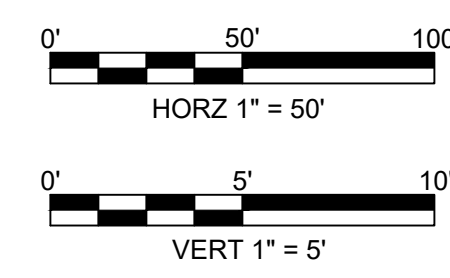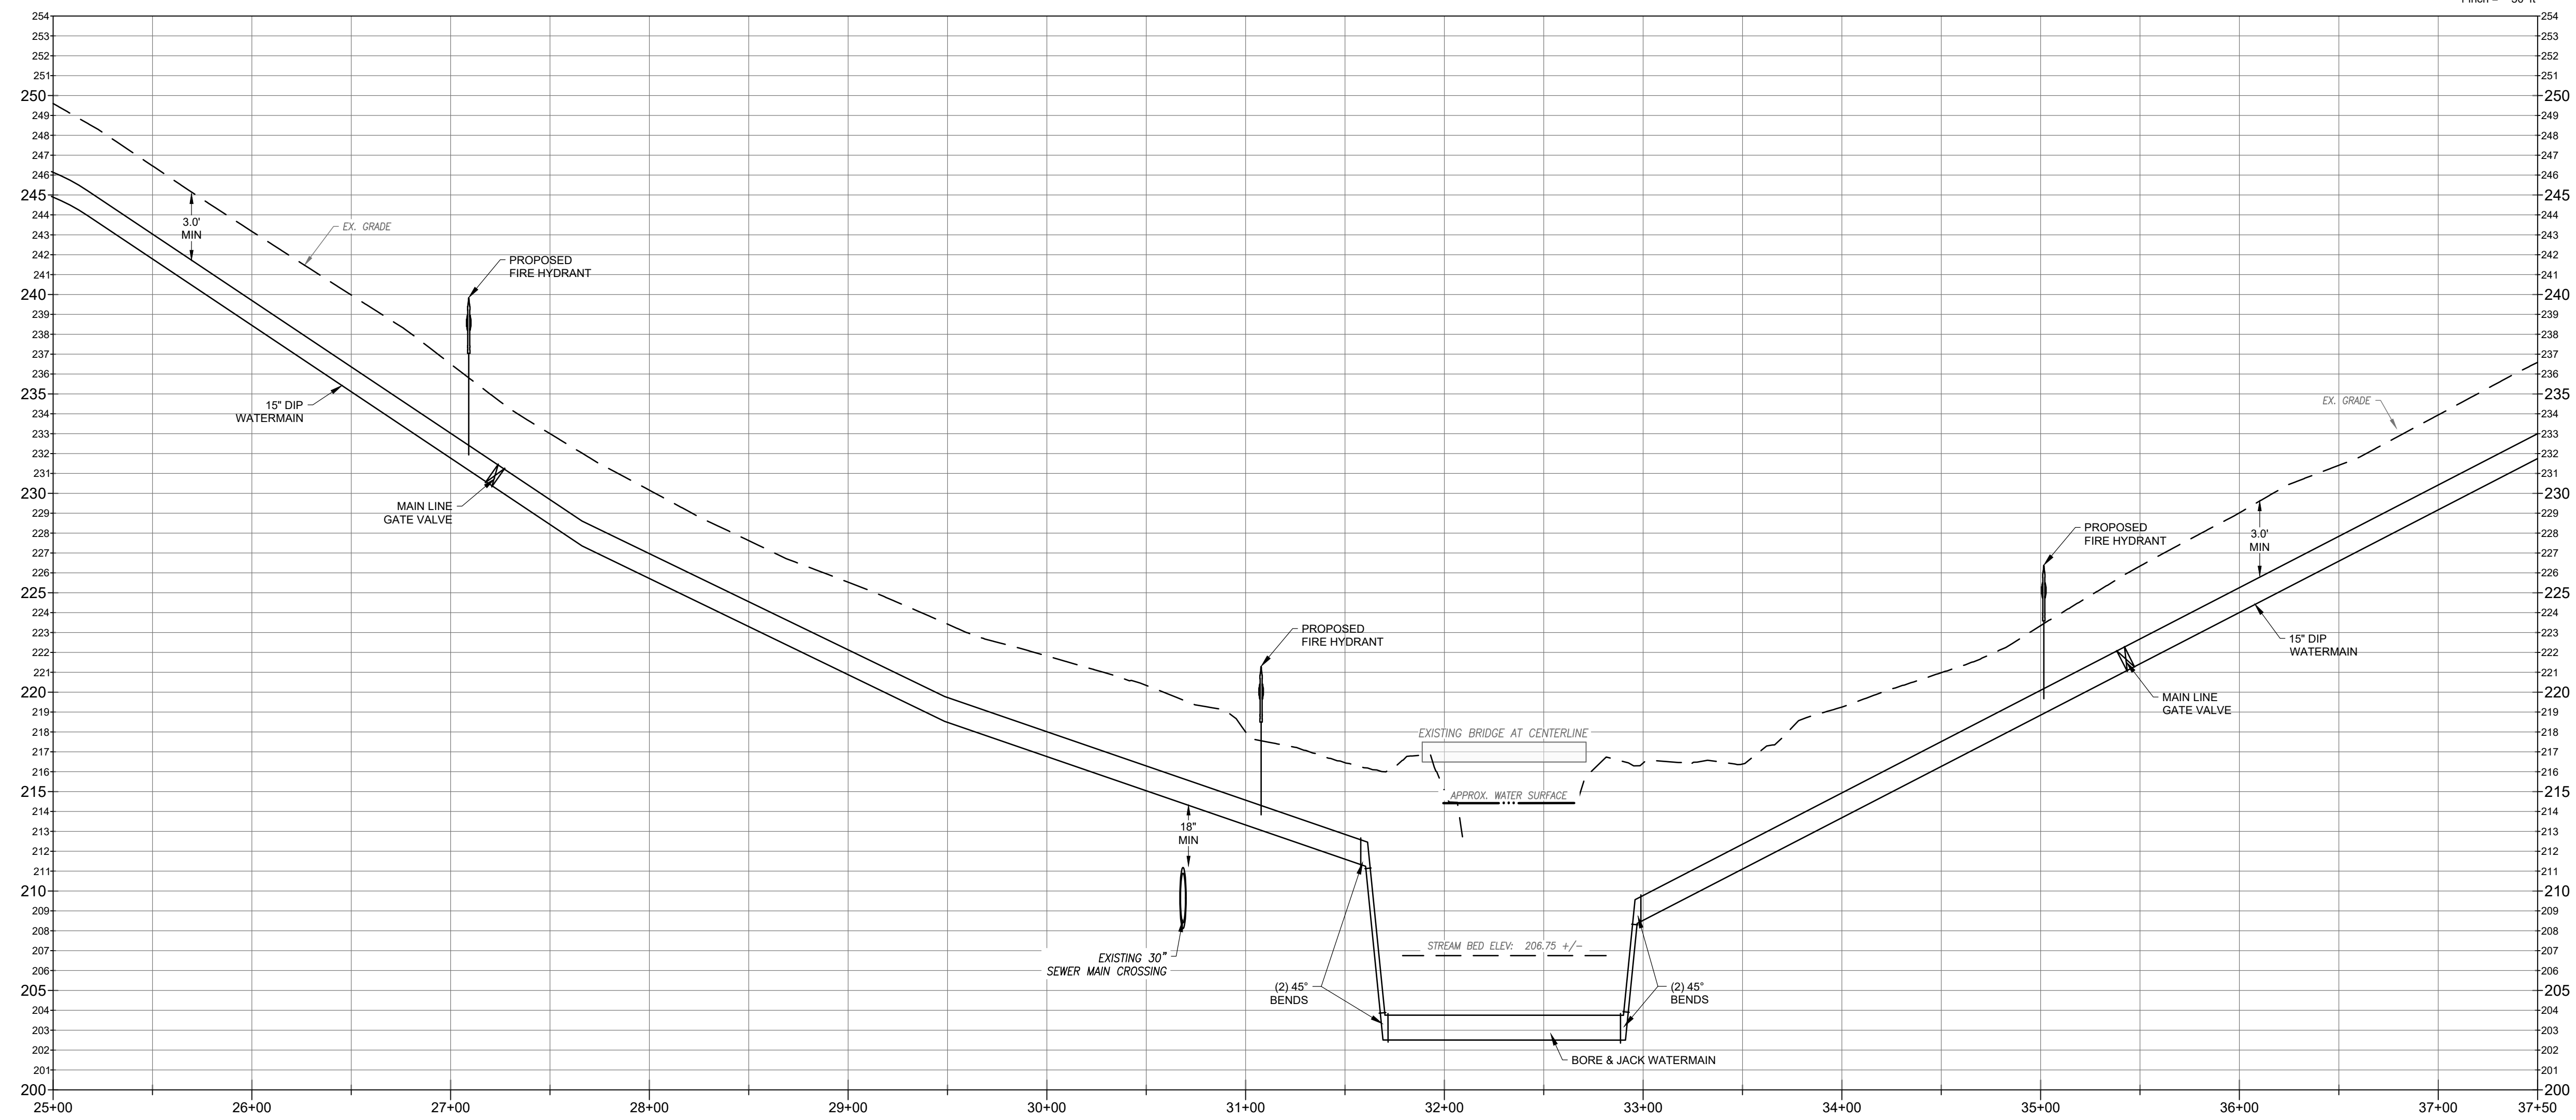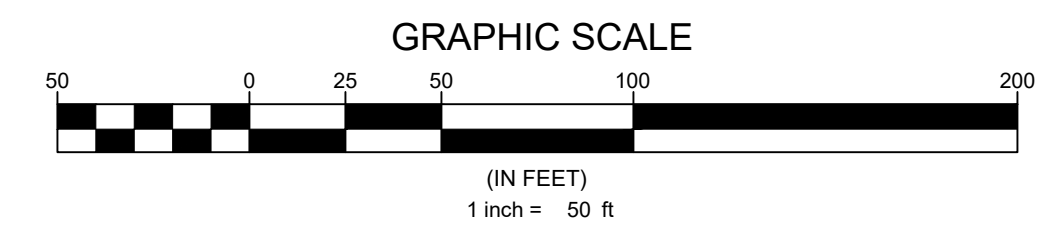

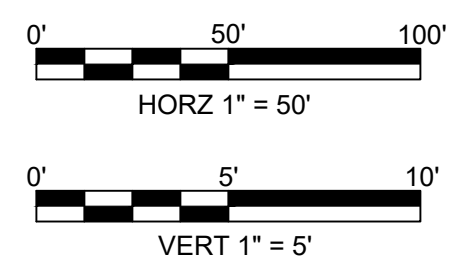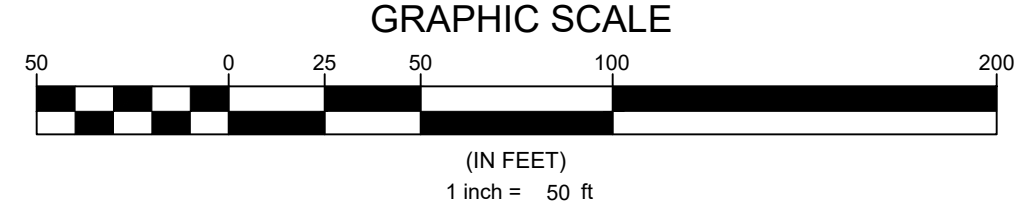

File Location: C:\Users\BryanHarris\Quantech\Engineering - Documents\Harris Creek Farm - Jonesville\Engineering\DWG\Construction Plans\62 Jonesville Road Widening and Striping Plan.dwg

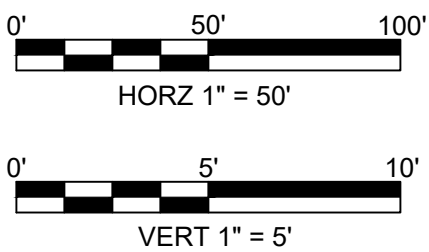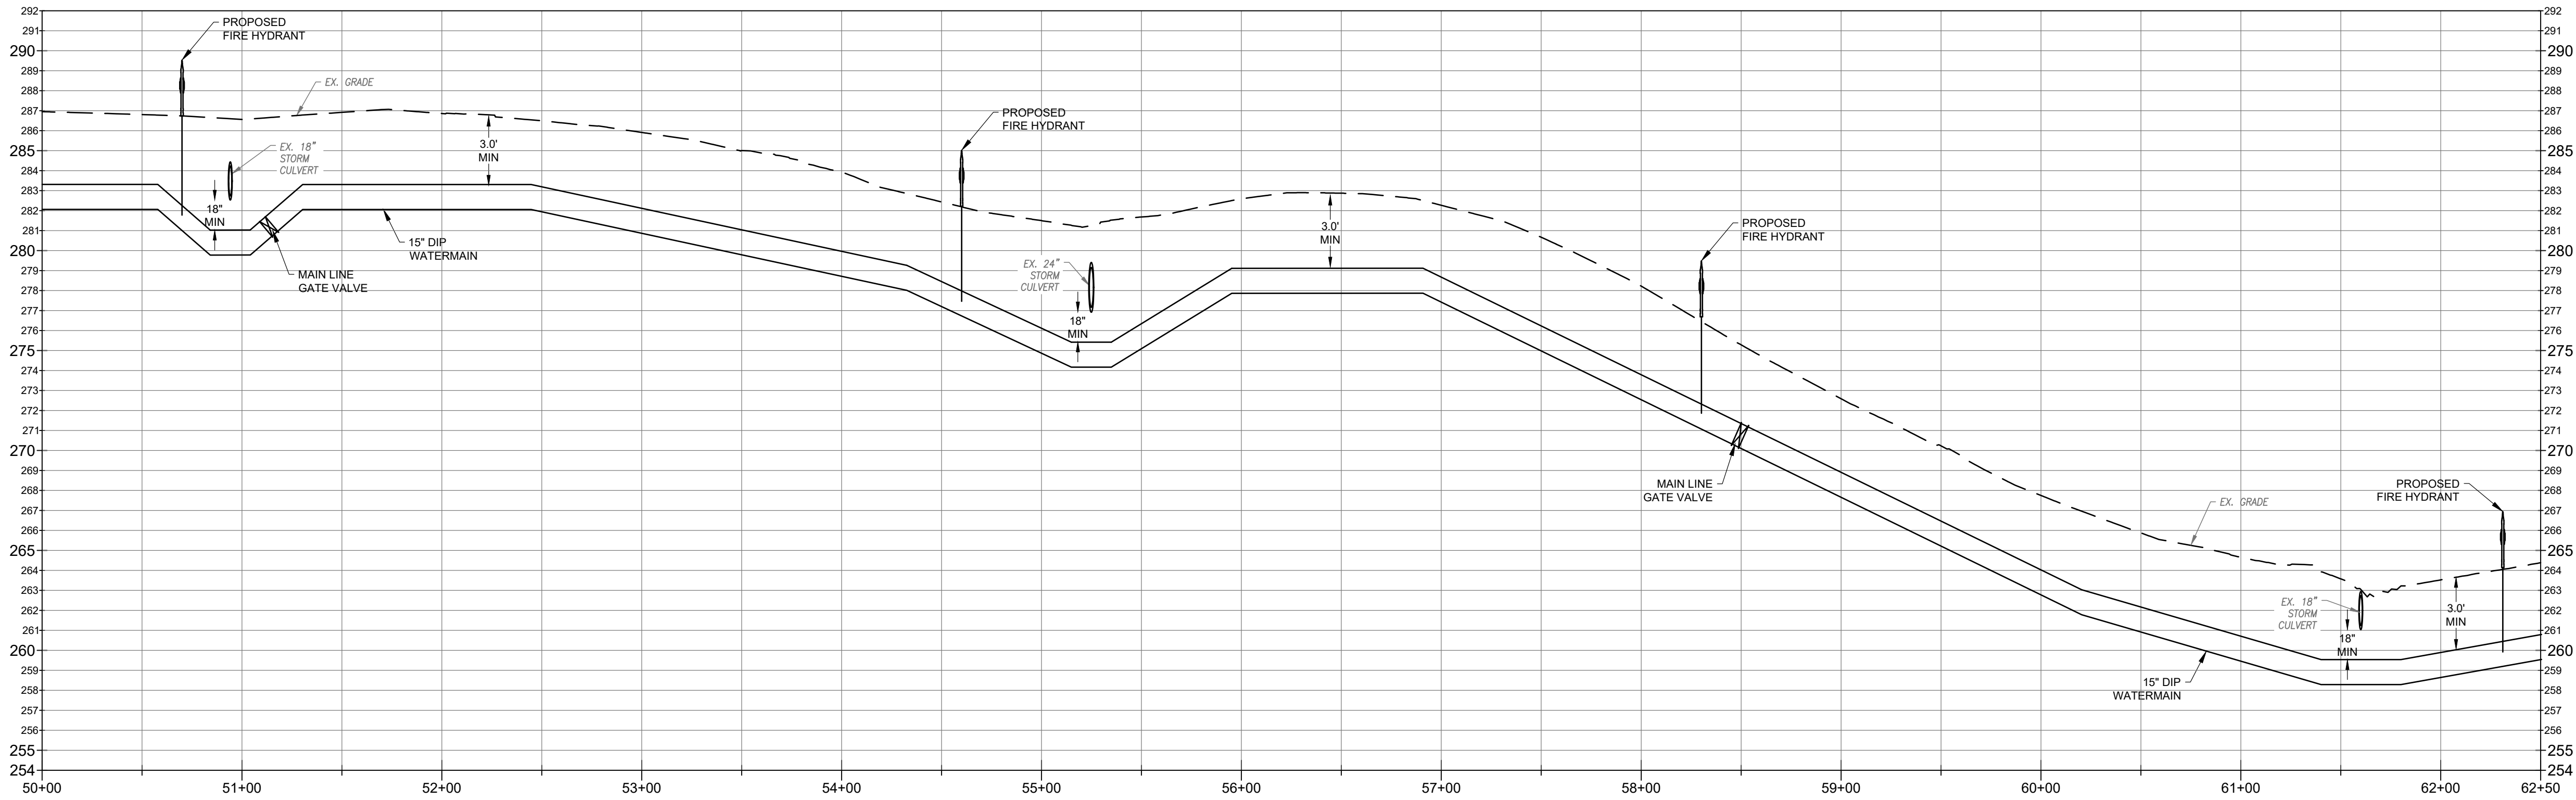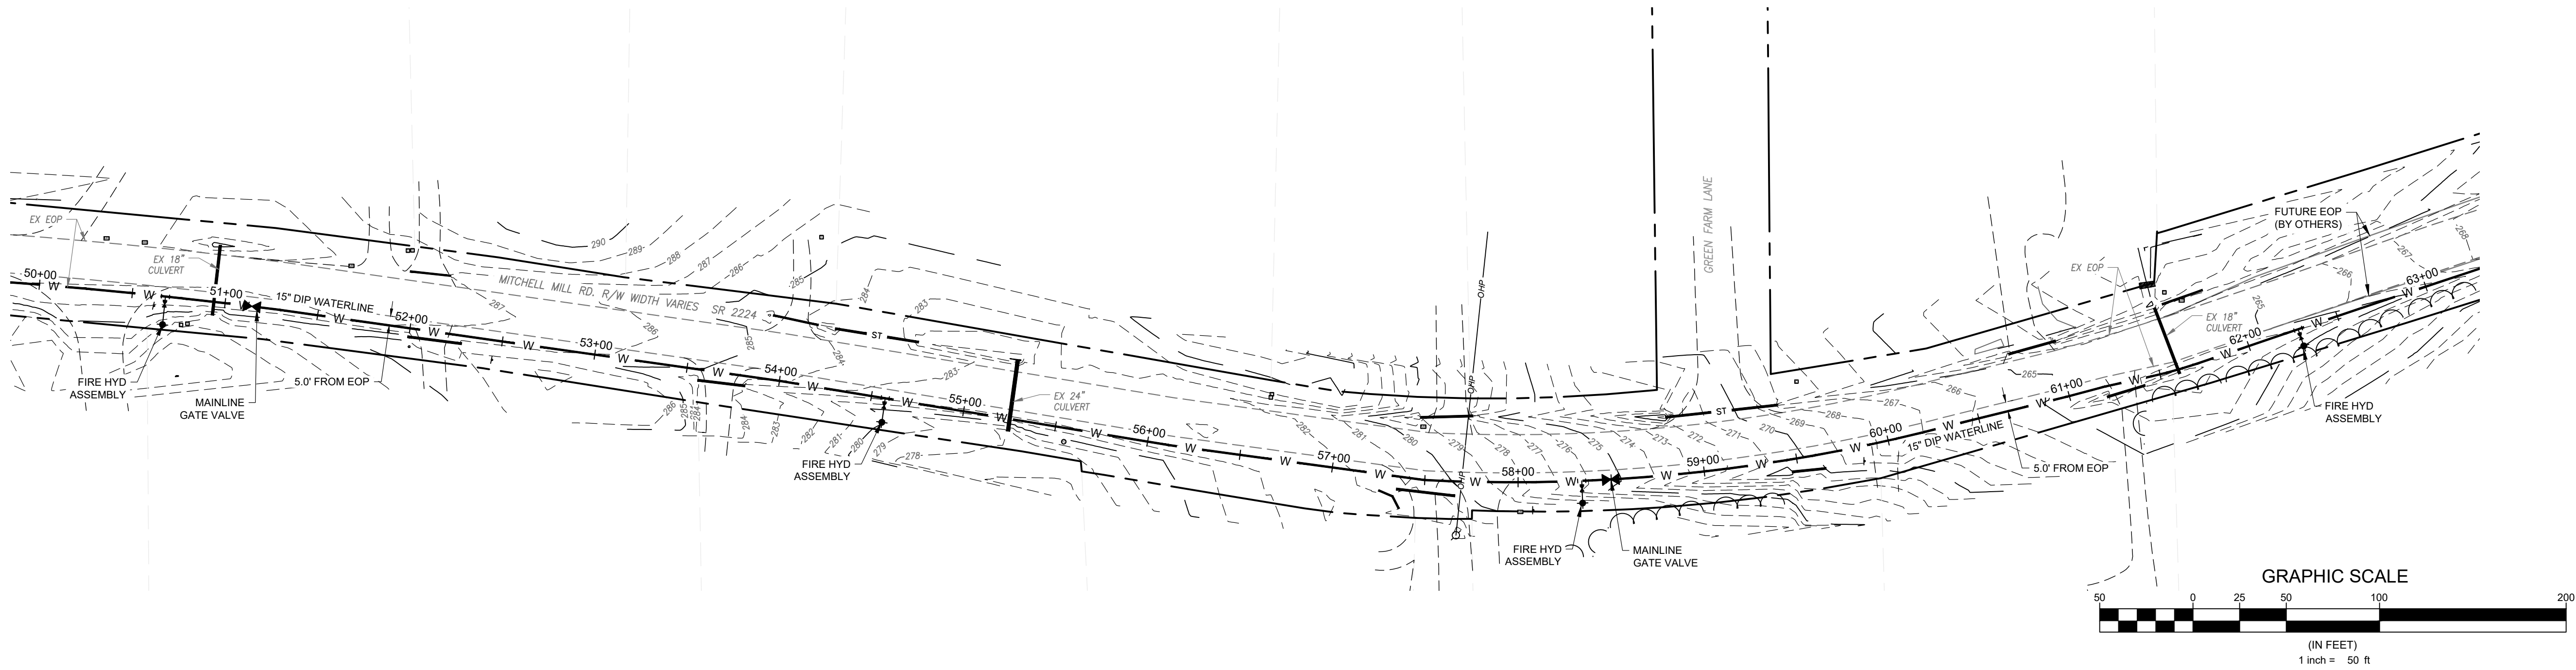

Developer
THE CSC GROUP
CONTRIBUTE TO THE SUCCESS OF LOCAL COMMUNITY
10030 Green Level Church Rd, Suite 802 #149, Cary, NC 27519

Engineer
QUANTECH ENGINEERING
Firm # F-1517
15000 Weston Parkway
Cary, N.C. 27513
(919) 996-9455

Surveyor

Jurisdiction / Municipality
Rolesville
Town of Rolesville
502 Southtown Cir
Rolesville, NC 27571
Phone: 919-554-6517
PSP-24-05

Other Consultants

Sheet map:

Seal:

FINAL DRAWING - FOR REVIEW PURPOSES ONLY

Issued / Print Date: 2025-May-30 (18:02)
File Name: 62 Jonesville Road Widening and Striping Plan.dwg

Last Saved by: Tim Newsome
Drawn by: TAN

Project:

HARRIS CREEK FARMS

CID-25-??

Issued for: PROGRESS DRAWINGS
DO NOT USE FOR CONSTRUCTION


REVISIONS		
No.	Date	Description



Sheet Title:

MITCHELL WATERLINE 50+00 TO 62+50




Sheet #:

74

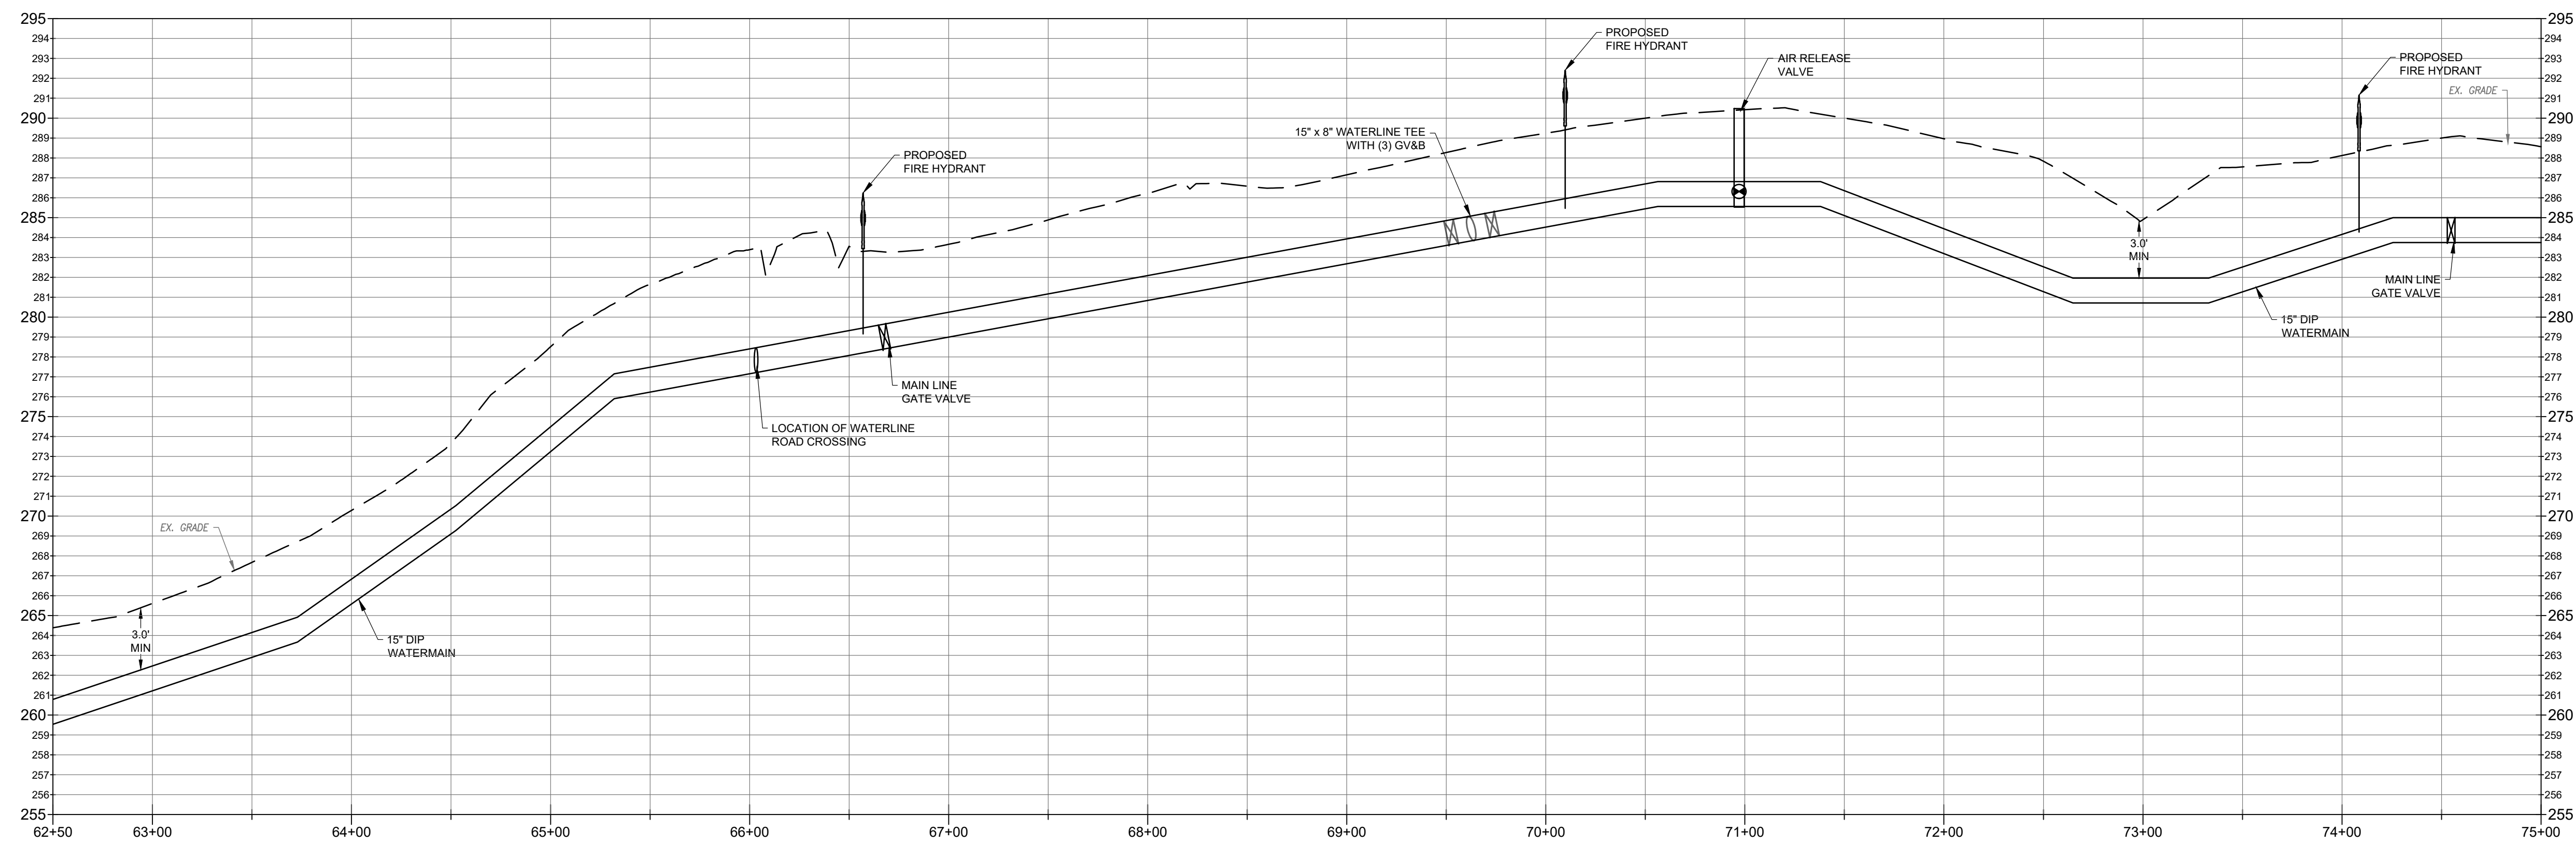

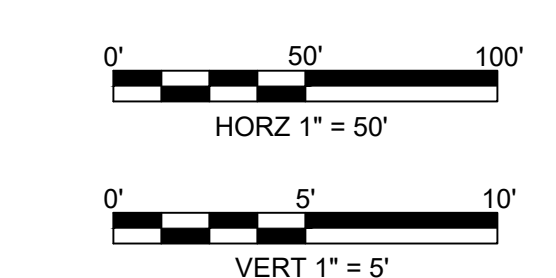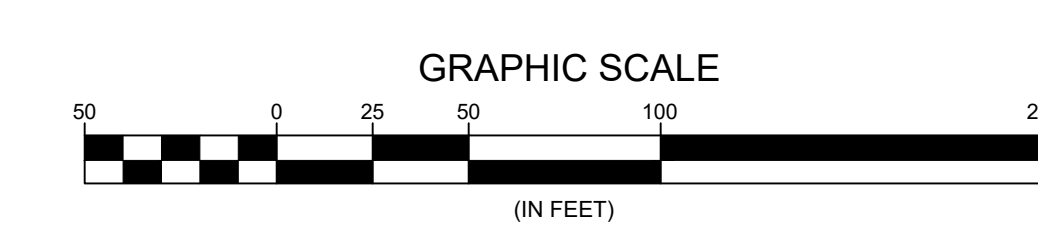

File Location: C:\Users\BryanHarris\OneDrive\Engineering - Documents\Harris Creek Farm - Jonesville\Engineering - DWG\Construction Plans\62 Jonesville Road Widening and Striping Plan.dwg

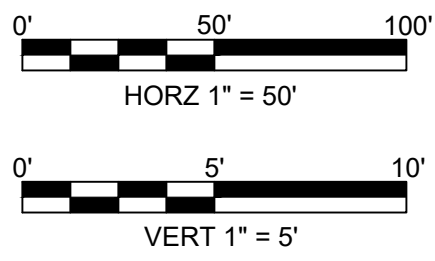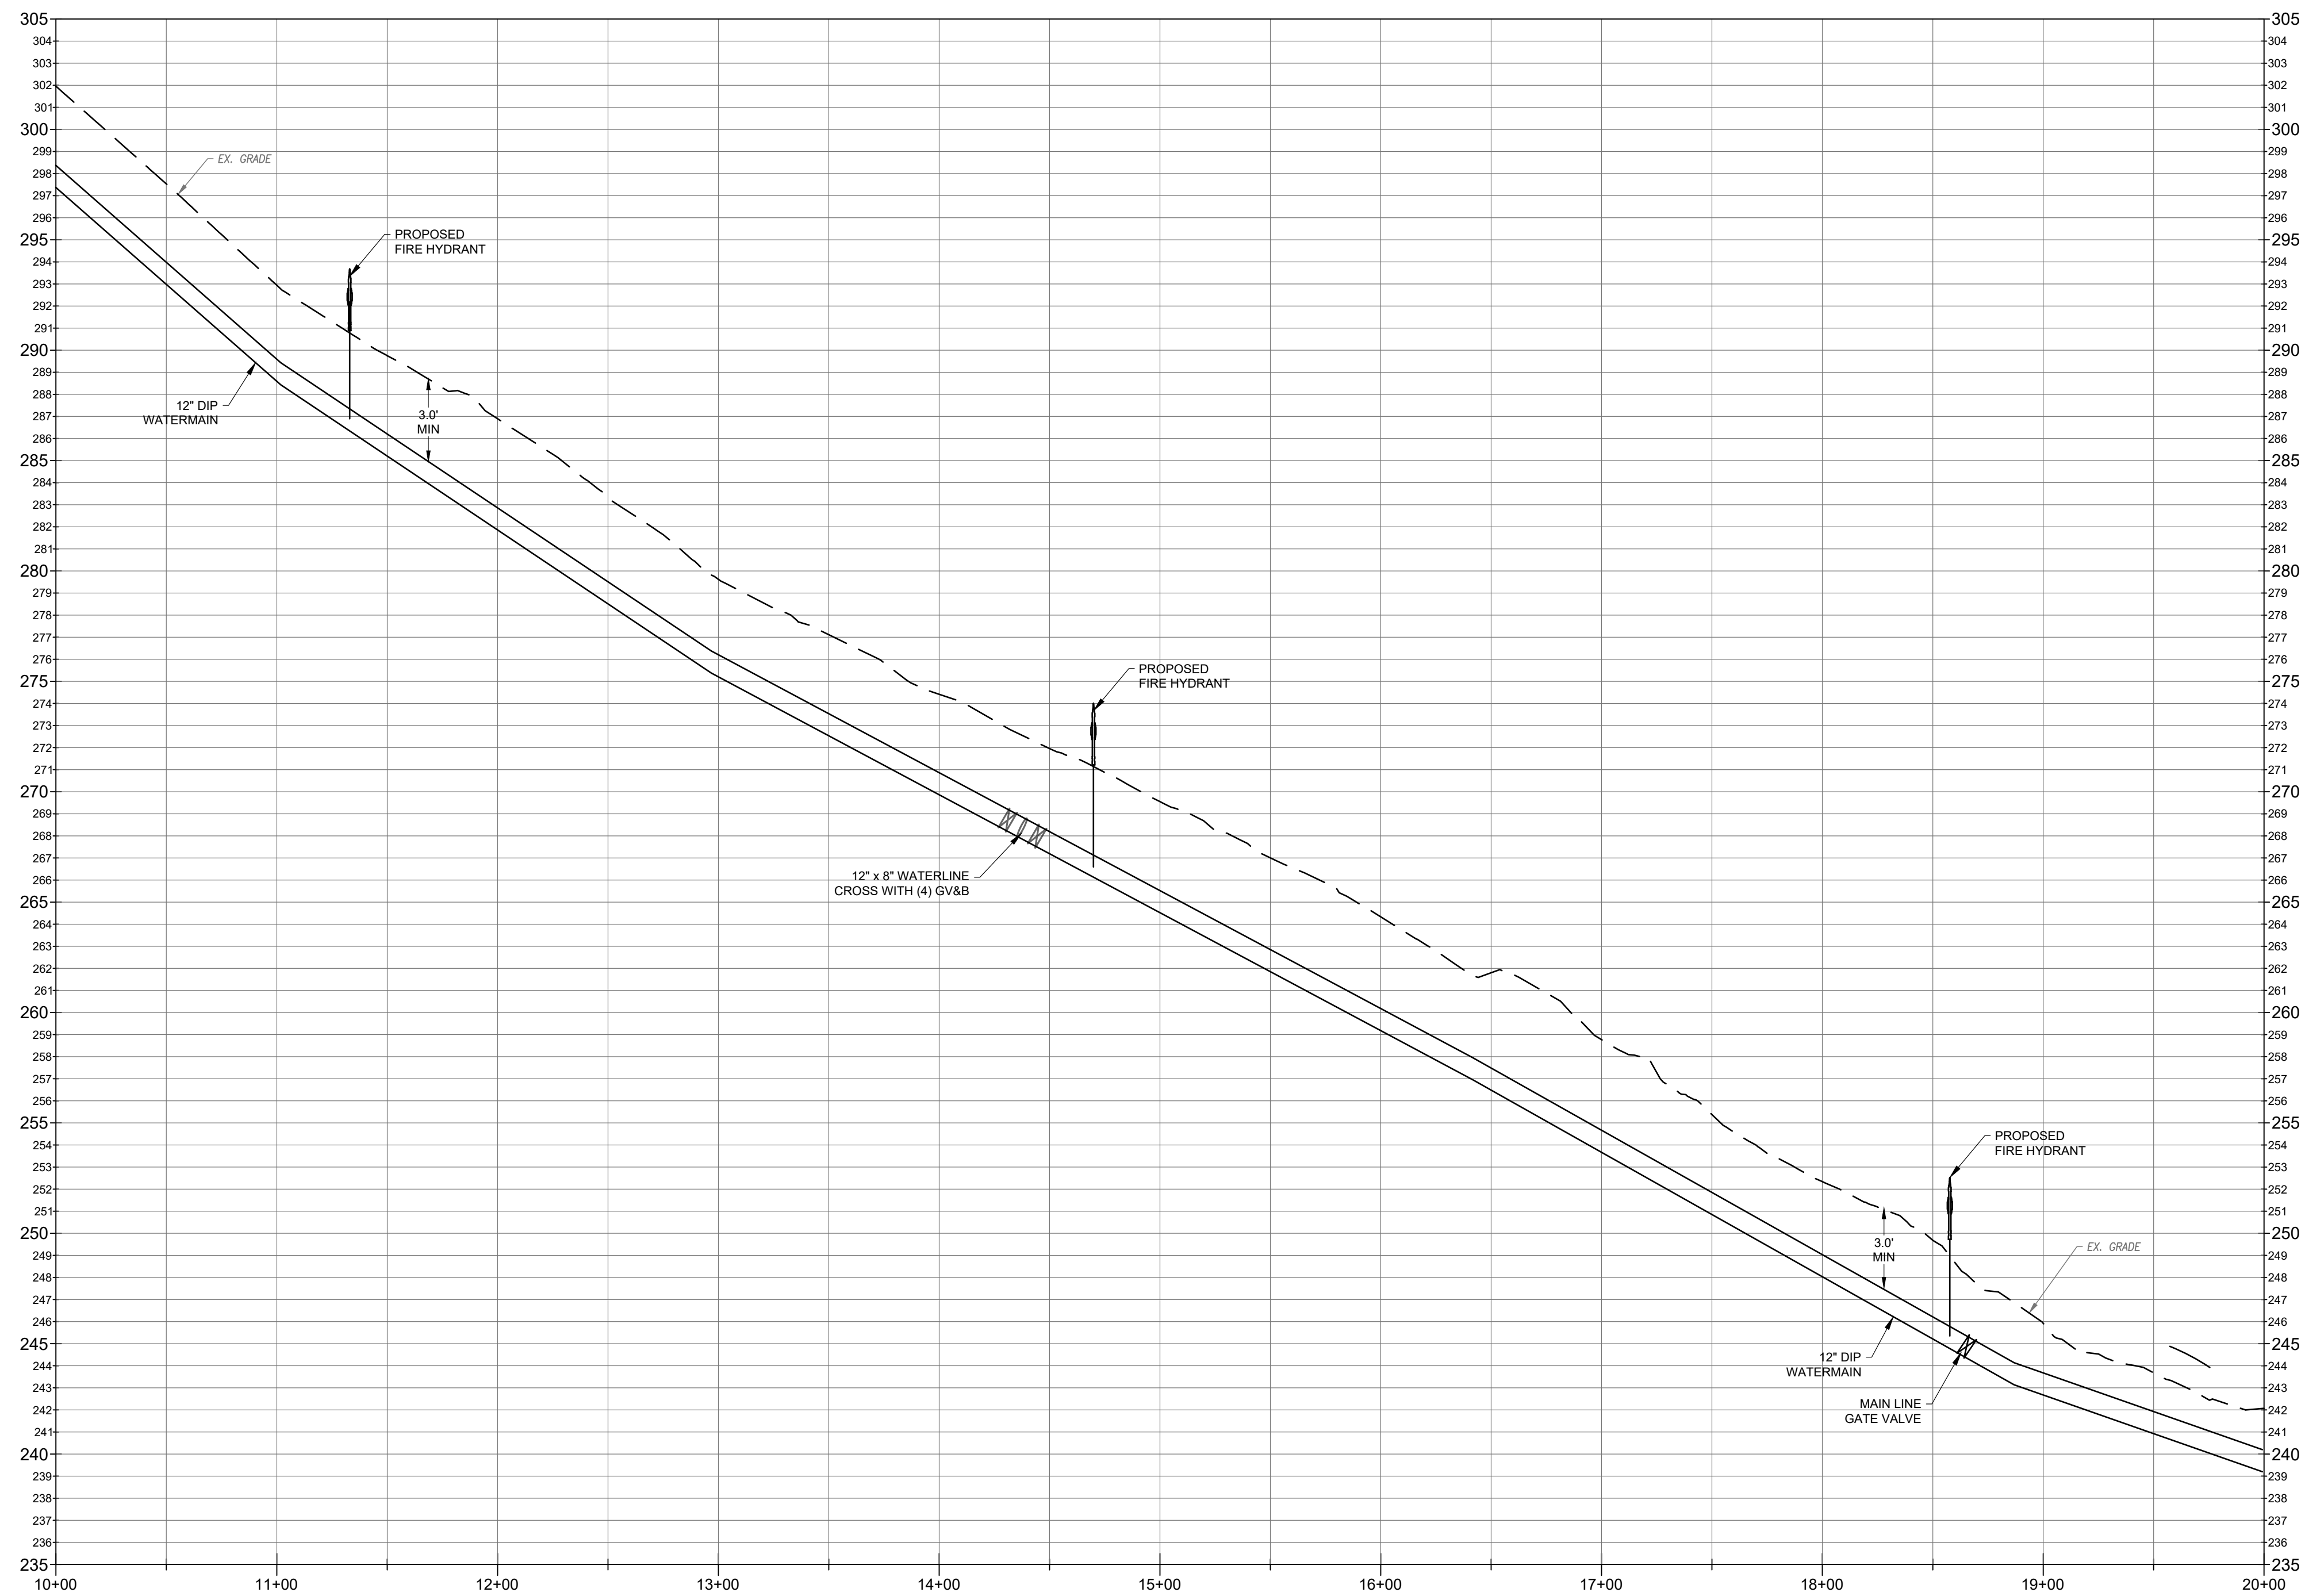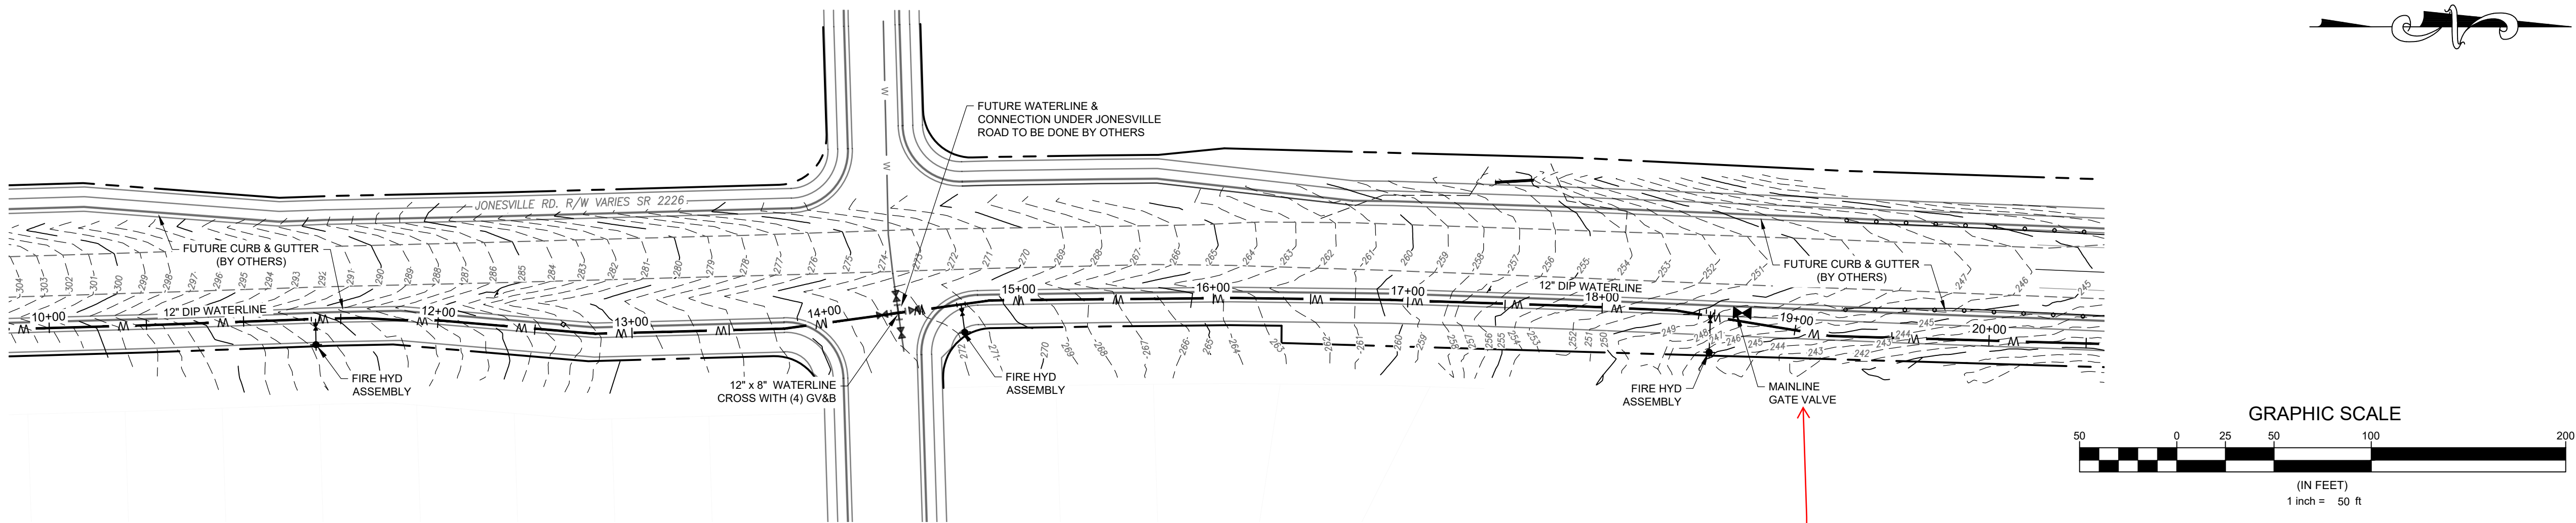

Developer



THE CSC GROUP

CONTRIBUTE TO THE SUCCESS OF LOCAL COMMUNITY

10030 Green Level Church Rd, Suite 802 #149: Cary, NC 27519

Engineer



QUANTECH ENGINEERING

INNOVATIVE SOLUTIONS | SUSTAINING THE FUTURE

Firm # F-1517

15000 Weston Parkway
Cary, N.C. 27513
(919) 996-9455

Surveyor

Jurisdiction / Municipality



Rolesville

Services • Development • Digital Connection

Town of Rolesville
502 Southtown Cir
Rolesville, NC 27571
Phone: 919-554-6517
PSP-24-05

Other Consultants

Sheet map:



Seal:



FINAL DRAWING - FOR
REVIEW PURPOSES ONLY

Issued / Print Date: 2025-May-30 (18:04)

File Name: 62 Jonesville Road Widening and Striping Plan.dwg

Last Saved by: Tim Newsome
Drawn by: TAN

Project:

HARRIS CREEK
FARMS

CID-25-??

Issued for:

PROGRESS DRAWINGS
DO NOT USE FOR
CONSTRUCTION

REVISIONS

No.	Date	Description



Sheet Title:

JONESVILLE RD
WATERLINE
10+00 TO 20+00

Sheet #:

78

File Location: C:\Users\BryanHarris\OneDrive\Engineering - Documents\Harris Creek Farm - Jonesville\Engineering\DWG\Construction\Plans\62 Jonesville Road Widening and Striping Plan.dwg

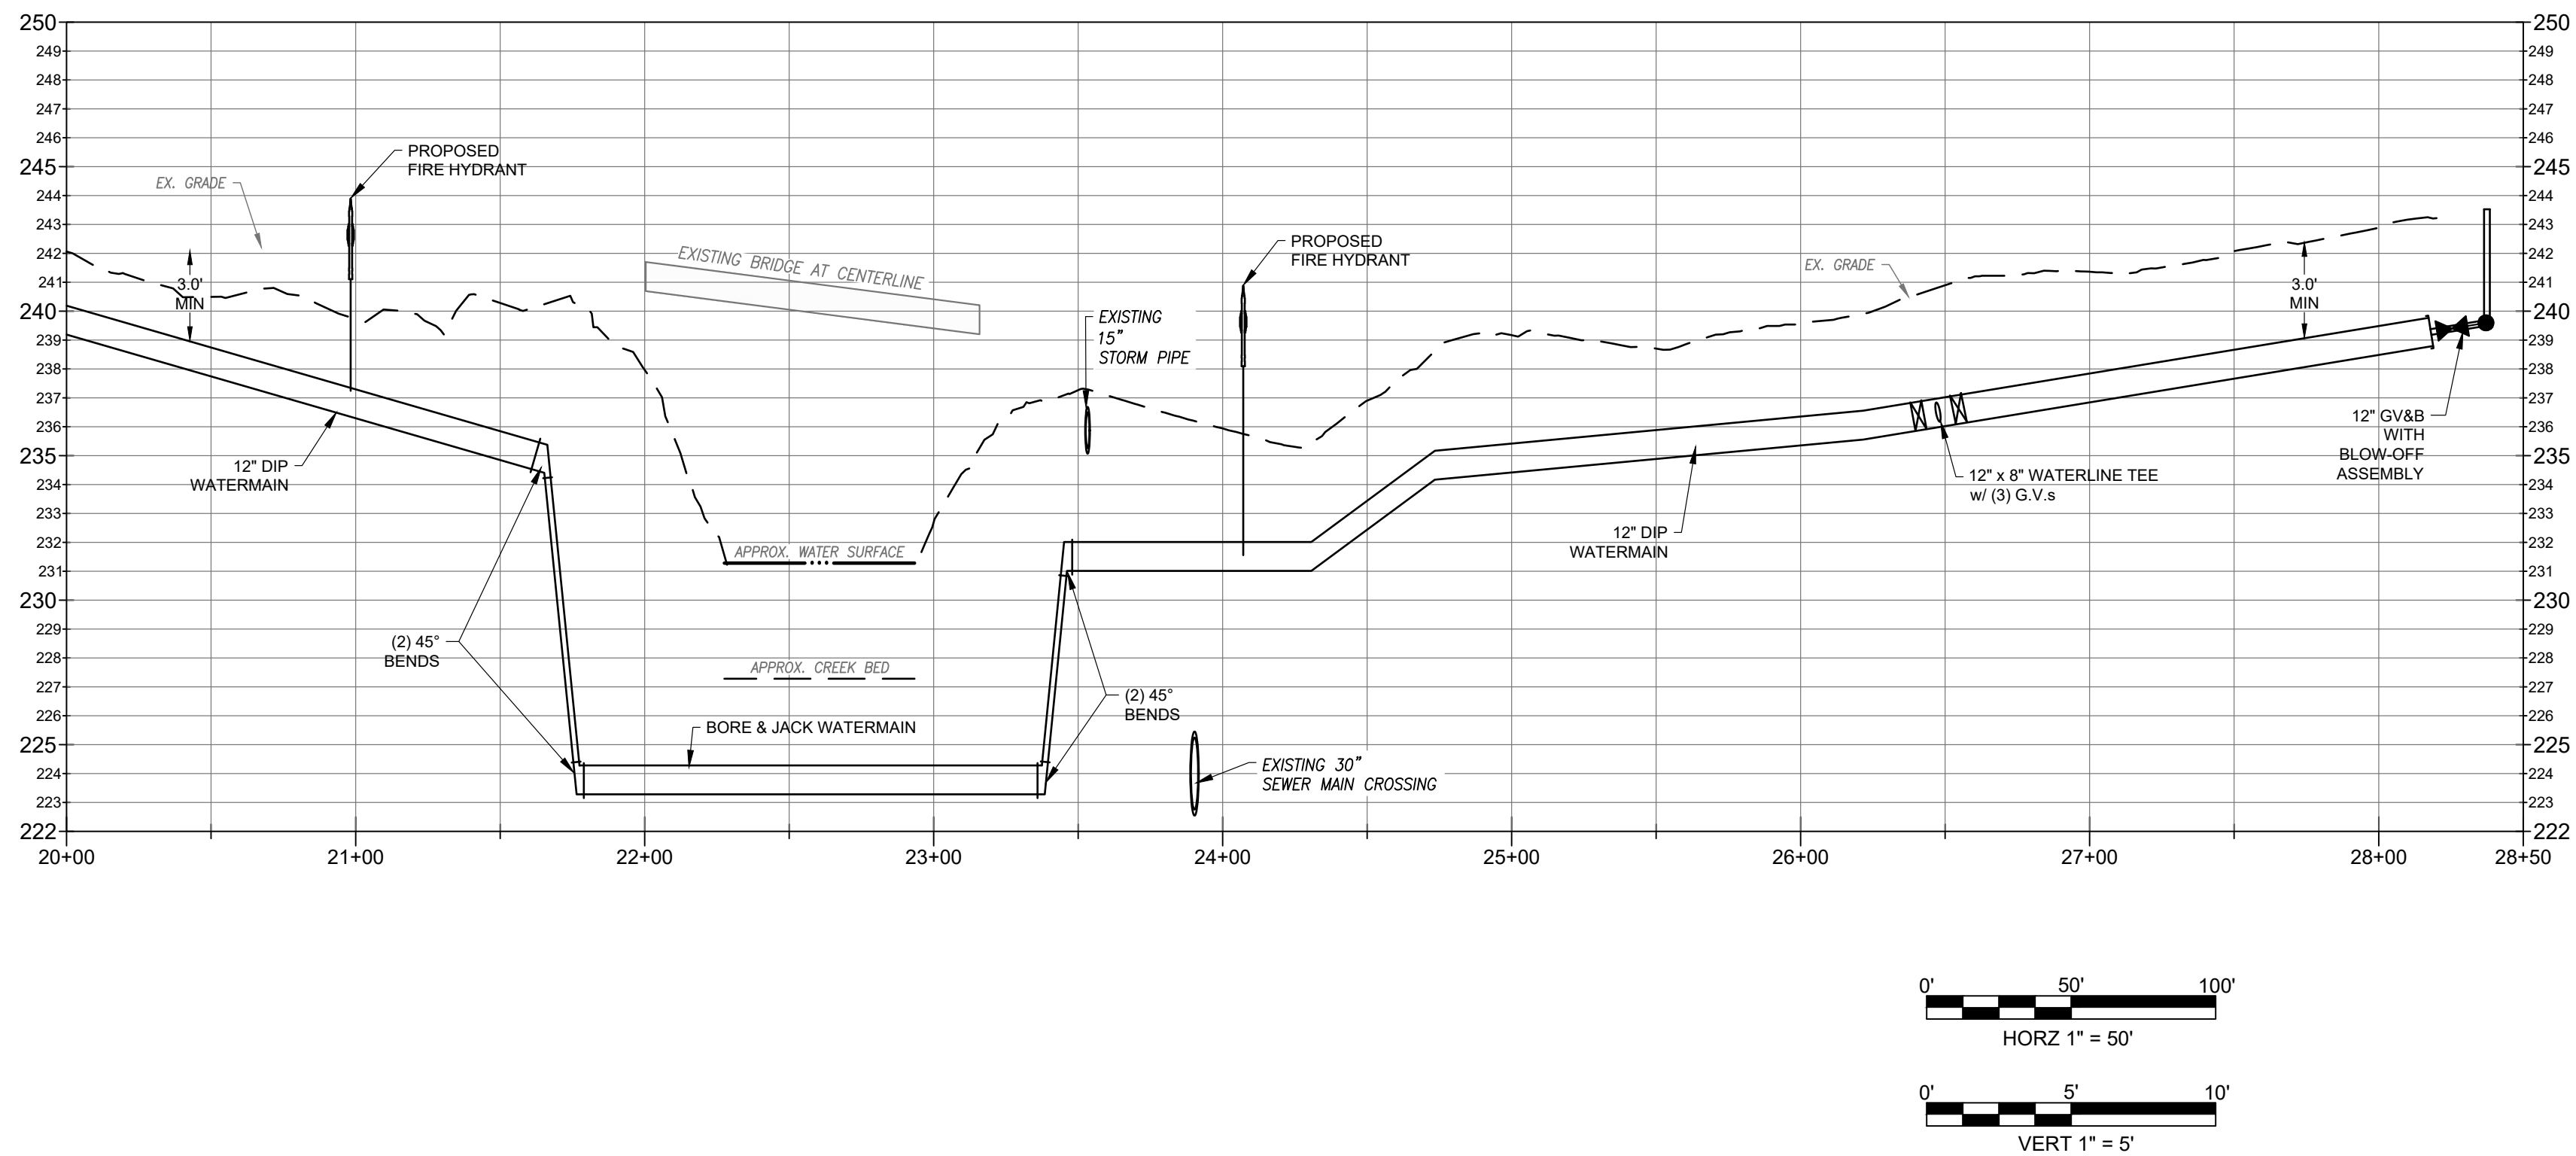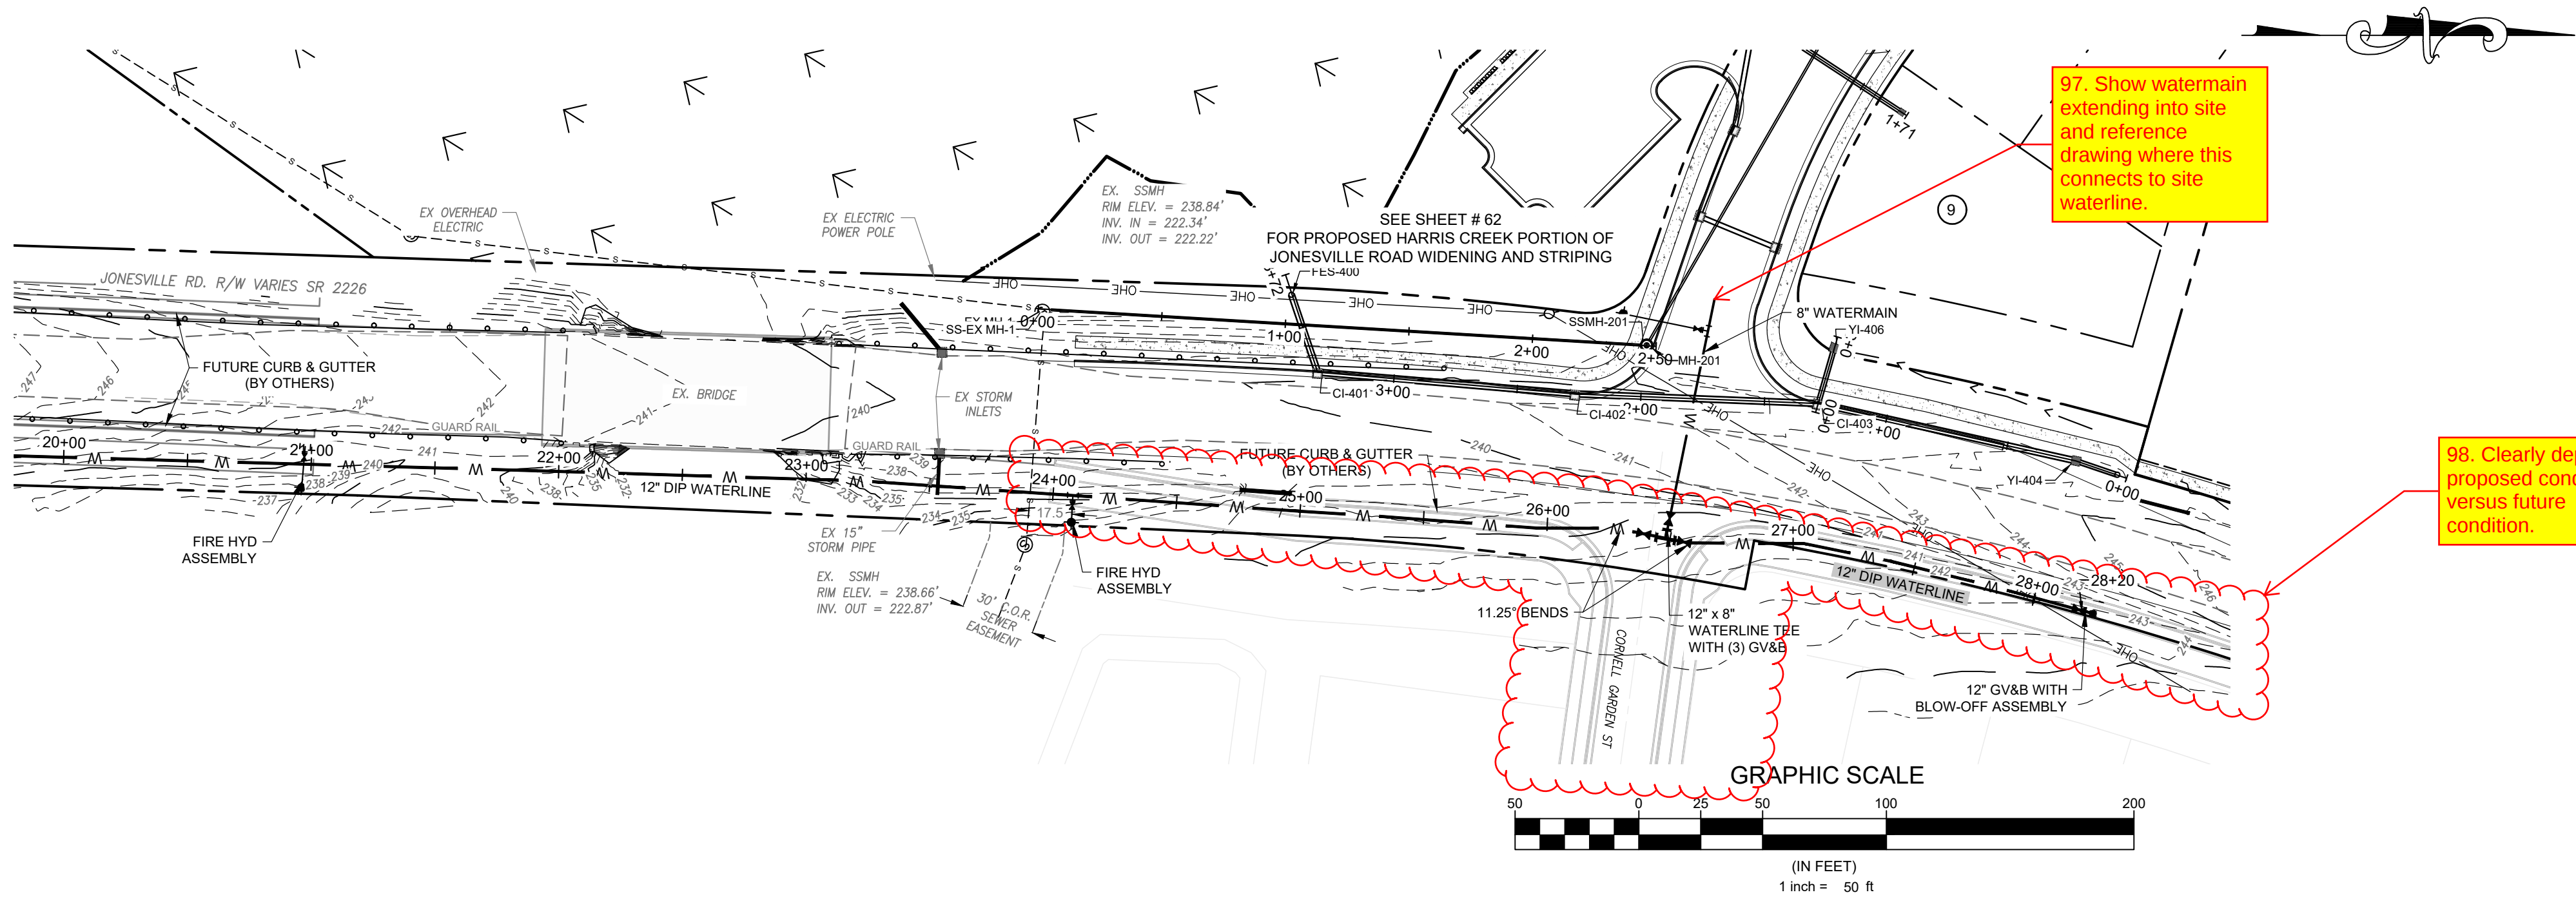

Developer



10030 Green Level Church Rd, Suite 802 #149: Cary, NC 27519

Engineer




Surveyor

Jurisdiction / Municipality



Other Consultants

Sheet map:

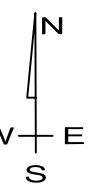

Seal:



FINAL DRAWING - FOR REVIEW PURPOSES ONLY

Issued / Print Date: 2025-May-30 (18:05)
File Name: 62 Jonesville Road Widening and Striping Plan.dwg

Last Saved by: Tim Newsome
Drawn by: TAN

Project:

HARRIS CREEK FARMS

CID-25-??

Issued for: PROGRESS DRAWINGS
DO NOT USE FOR CONSTRUCTION

REVISIONS

No. Date Description


Sheet Title:

**JONESVILLE RD
WATERLINE
20+00 TO 30+00**

Sheet #:

79

N.C. UNDERGROUND UTILITIES

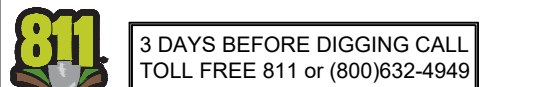

A ONE CALL SYSTEM FOR COMMUNITY AND JOB SAFETY