

CLIENT
ASHTON RALEIGH RESIDENTIAL, LLC
5711 SIX FORKS ROAD, SUITE 300
RALEIGH, NC 27609
PHONE: 919.232.3695
CONTACT: BOB MISHLER

THE POINT
PHASE 4 SUBDIVISION PLAT
EAST YOUNG STREET
WAKE FOREST TOWNSHIP, WAKE COUNTY, NORTH CAROLINA



REVISIONS

NO.	DATE
-----	------

PLAN INFORMATION

PROJECT NO.	AWH20000
FILENAME	AWH20000-F8
CHECKED BY	JBT
DRAWN BY	KMM
SCALE	1"=30'
DATE	01.29.2025

SHEET
FINAL PLAT
3-7

GENERAL NOTES


1. FOR GENERAL NOTES, SEE SHEET 1.



Please provide metes and bounds for highlighted lines along open space. Show adjoining lots and references or road names

Please provide a grid tie and/or coordinates for a property corner and statement on how the coordinates were established

X:\Projects\AWH-20000\02_Geomatics\Survey\Plats\AWH20000-F8.plt 4.dwg, 1/30/2025 5:18:43 AM, Katie Martin

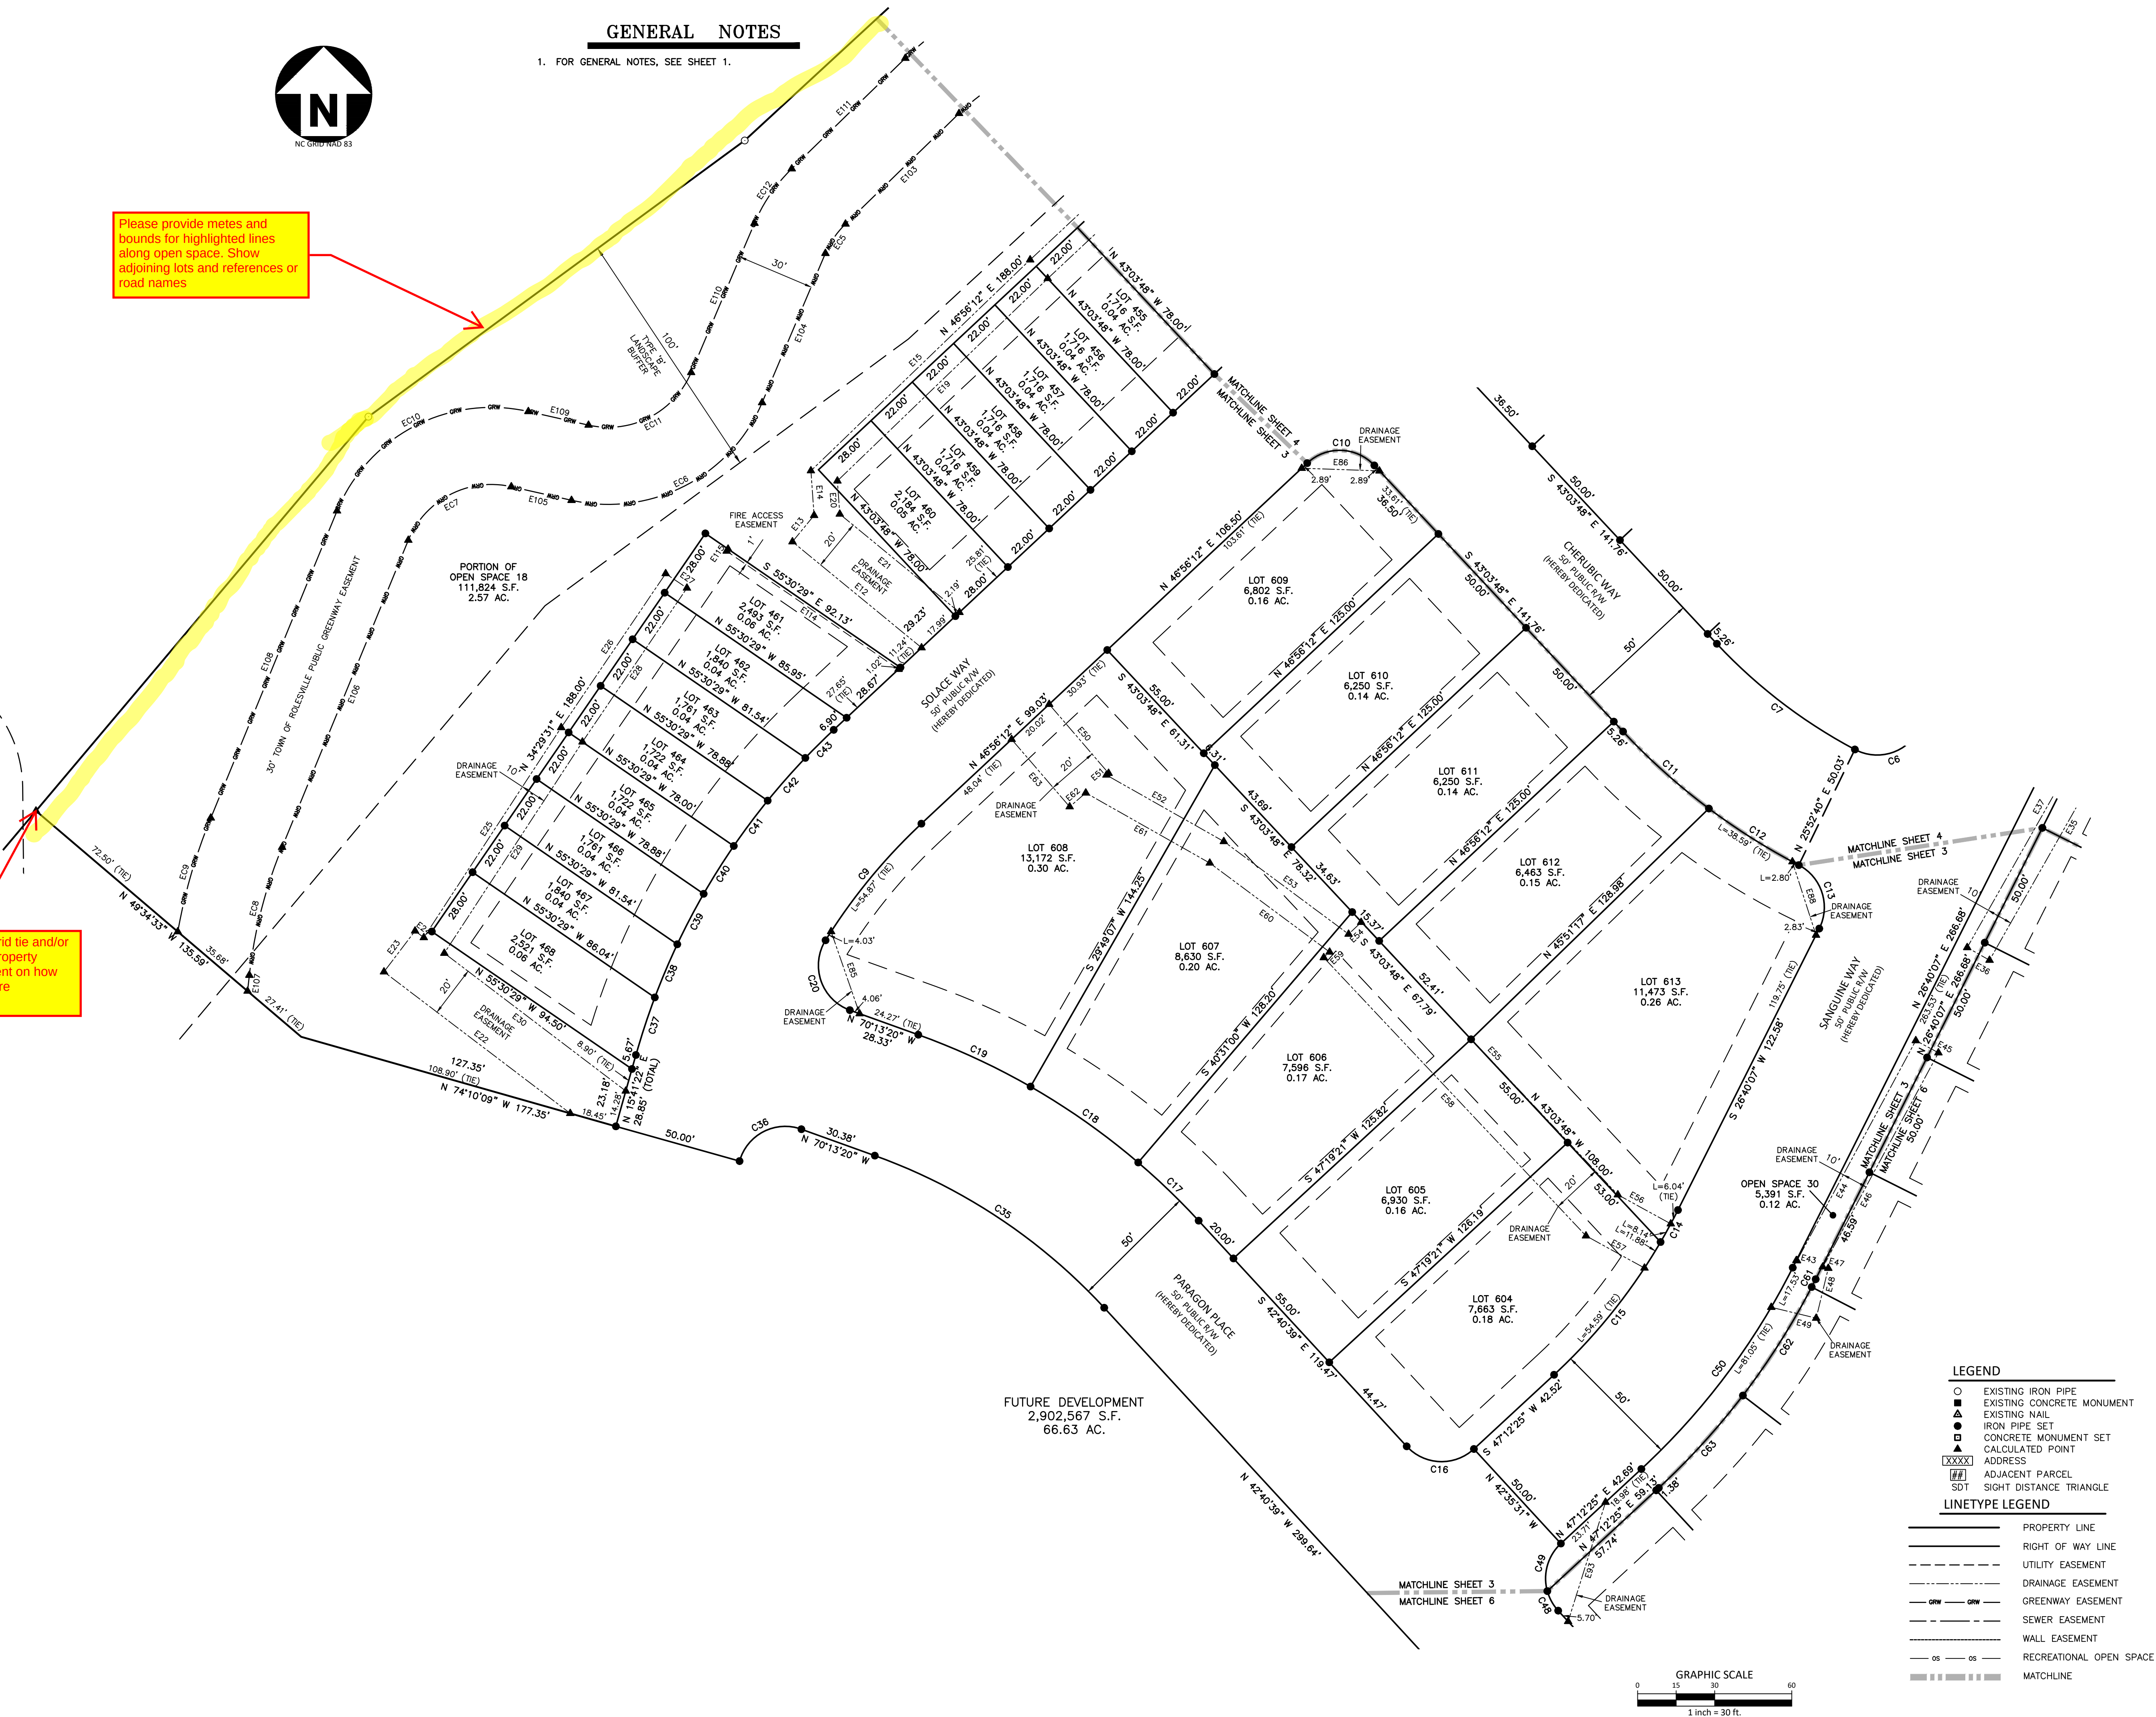



www.mcadamsco.com

CLIENT

ASHTON RALEIGH RESIDENTIAL, LLC
5711 SIX FORKS ROAD, SUITE 300
RALEIGH, NC 27609
PHONE: 919.232.3695
CONTACT: BOB MISHLER

THE POINT
PHASE 4 SUBDIVISION PLAT
EAST YOUNG STREET
WAKE FOREST TOWNSHIP, WAKE COUNTY, NORTH CAROLINA



NO.	DATE
-----	------

PLAN INFORMATION

PROJECT NO.	AWH20000
FILENAME	AWH20000-F8
CHECKED BY	JBT
DRAWN BY	KMM
SCALE	1"=30'
DATE	01.29.2025

SHEET

FINAL PLAT

4-7