


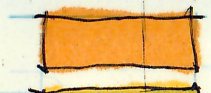


ROLESVILLE ROAD


PROJECT INFORMATION

| | | |
|---------------------|------------|---|
| 40' LOTS: | 150 |  |
| 50' LOTS: | 161 |  |
| 60' LOTS: | 110 |  |
| TOWNHOUSES: | 125 |  |
| TOTAL UNITS: | 546 | |

review ROW mins. 40FT
review private verse public
Collector and Local roads
based on LOT#

minimum length between
roads, xx FT

**Sketch Master Plan
MERRITT PROPERTY**

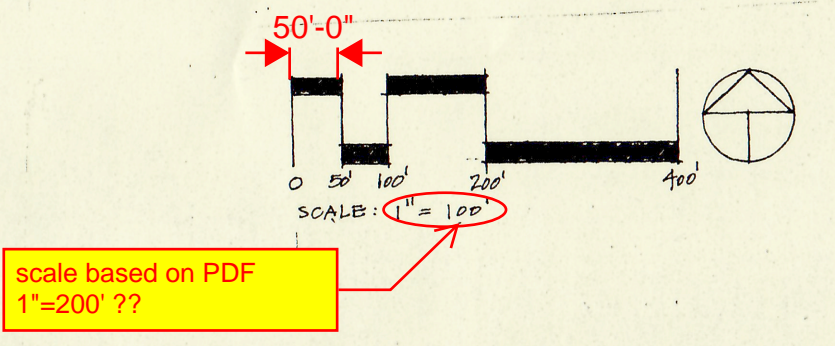

**AMERICAN
Engineering**

400 Westshore Boulevard, Suite 400
Raleigh, NC 27603
919.860.1101
www.americaneng.com