
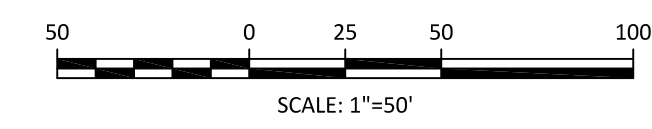


JONES DAIRY ROAD WIDENING IS UNDER SEPARATE COVER AND HAS BEEN ALREADY BEEN SUBMITTED. IT IS CURRENTLY UNDER REVIEW

#1 was this storm removed and regraded?

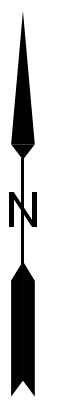


The Nau Company
 Consulting Civil Engineers
 PO Box 810, Rolesville, NC 27571
 919-435-6395
 NCBELS License P-0751

CLIENT:
 PRESERVE AT JONES DAIRY, LLC
 10534 ARNOLD PALMER DRIVE
 RALEIGH, NC 27617 919-491-0761

NO.	DATE	REVISIONS
1	2024-01-17	REVISIONS PER DOT COMMENTS FOR WATER LINE CONNECTIONS
2	2023-03-23	TOWARDS STORM AND WATER MAINS FOR 10'5" DIA TO 10' DIA
3	2023-03-24	TOWARDS FIGHTING BULL DRIVE
4	2023-03-24	REVISED PHASE LINES
5	2023-03-28	REVISED STORM PHASE DATA FROM EXISTING STRUCTURES TO 10' DIA
6	2023-05-03	REVISED PHASE GRADING AND RESPONSES PER TOWN REVIEW
7	2024-01-19	REVISED PHASE GRADING DATA TO 11' DIA AND 12' DIA
8	2024-01-19	CONNECT TO 12' PRECASTAL DRIVE

PRESERVE AT JONES DAIRY - CENTRAL
CONSTRUCTION DRAWINGS
 ROLESVILLE, NC
SITE PLAN - WEST

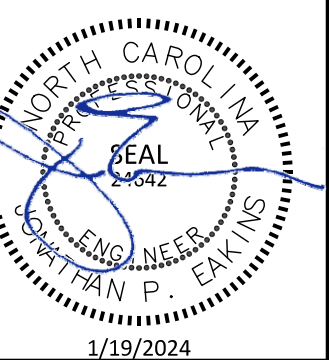

PROJECT NO:	---
DESIGN BY:	JPE
DRAWN BY:	RSF
SCALE:	1"=50'
DATE:	2023-01-27
SHEET NO:	C2.7