


#1 was this storm removed and regraded?

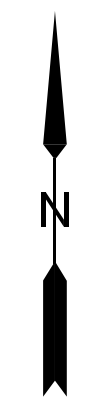


The Nau Company
 Consulting Civil Engineers
 PO Box 810, Rolesville, NC 27571
 919-435-6395
 NCBELS License P-0751

CLIENT:
 PRESERVE AT JONES DAIRY, LLC
 10534 ARNOLD PALMER DRIVE
 RALEIGH, NC 27617 919-491-0761

NO.	DATE	REVISIONS
1	2024-03-17	REVISIONS PER DOT COMMENTS FOR WATER LINE CONNECTIONS
2	2024-03-23	REVISED STORM FLOW RATES BASED ON 15 MIN FLOW TO FLOW
3	2024-03-24	TOWARDS FIGHTING BUILD DRIVE
4	2024-03-24	REVISED PHASE LINES
5	2024-03-28	REVISED STORM FLOW RATES FROM EXISTING STRUCTURES DATA TO 100
6	2024-05-03	REVISED FLOOD ZONING AND RESPONSES PER TOWN REVIEW
7	2024-05-03	REVISED STORM DRAINAGE DATA TO 15 MIN FLOW TO FLOW
8	2024-05-03	REVISED STORM DRAINAGE DATA TO 15 MIN FLOW TO FLOW
9	2024-05-03	CONNECTION TO PRELIMINARY DRIVE AND FLOW WAY

PRESERVE AT JONES DAIRY - CENTRAL
CONSTRUCTION DRAWINGS
 ROLESVILLE, NC
LOT GRADING PLAN - CENTRAL

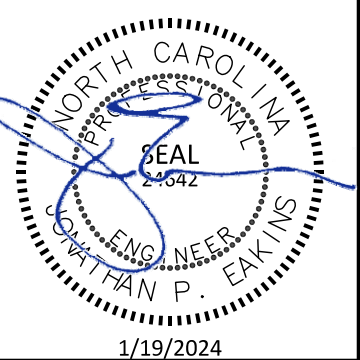

PROJECT NO: ...
 DESIGN BY: JPE
 DRAWN BY: RSF
 SCALE: 1"=50'
 DATE: 2023-01-27
 SHEET NO: **C4.2**

PRELIMINARY DRAWING - FOR REVIEW ONLY - NOT FOR CONSTRUCTION