

JONES DAIRY ROAD WIDENING IS UNDER SEPARATE COVER AND HAS BEEN ALREADY BEEN SUBMITTED. IT IS CURRENTLY UNDER REVIEW


#1 was this storm removed and regraded?

NO.	DATE	REVISIONS
1	2023-03-17	REVISIONS PER DOT COMMENTS FOR WATER LINE CONNECTIONS
2	2023-03-23	REVISED STORM AND SEWER LINES TO 15' DIA. (15' DIA. TO 15' DIA.)
3	2023-03-24	REVISED PHASE LINES
4	2023-03-28	REVISED STORM PIPE DATA FROM EXISTING STRUCTURES (15' DIA. TO 15' DIA.)
5	2023-05-03	REVISED PHASE LINES AND RESPONSES PER TOWN REVIEW
6	2023-08-01	REVISED PHASE LINES AND RESPONSES PER TOWN REVIEW
7	2024-01-19	REVISED PHASE LINES AND RESPONSES PER TOWN REVIEW

**PRESERVE AT JONES DAIRY - CENTRAL
 CONSTRUCTION DRAWINGS**

ROLESVILLE, NC

GRADING PLAN - WEST

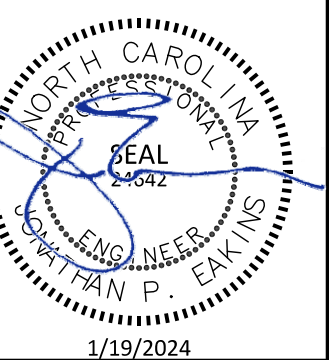

PROJECT NO: ---

DESIGN BY: JPE

DRAWN BY: RSF

SCALE: 1"=50'

DATE: 2023-01-27

SHEET NO: **C4.5**

