


The Nau Company
 Consulting Civil Engineers
 PO Box 810, Rolesville, NC 27571
 919-435-6395
 NCBELS License P-0751

CLIENT:
 PRESERVE AT JONES DAIRY, LLC
 10534 ARNOLD PALMER DRIVE
 RALEIGH, NC 27617 919-491-0761

| NO. | DATE | REVISIONS |
|-----|------------|---|
| 1 | 2023-03-17 | REVISIONS PER DOT COMMENTS FOR WATER LINE CONNECTIONS |
| 2 | 2023-03-23 | TOWARDS STORM INLET BEARS WEIGHT OF 100 LBS PER SQ YD LOAD |
| 3 | 2023-03-24 | REVISED PHASE LINES |
| 4 | 2023-03-28 | REVISED STORM PIPE DATA FROM EXISTING STRUCTURES (DA TO 100) |
| 5 | 2023-05-03 | REVISED STORM DRAINING AND REVISIONS PER TOWN REVIEW |
| 6 | 2023-08-01 | REVISED STORM DRAINING DATA (DOTS 112, 113 AND 219) AND CONNECTION TO FREESTALL DRIVE |
| 7 | 2024-01-19 | CONNECTION TO FREESTALL DRIVE |

**PRESERVE AT JONES DAIRY - CENTRAL
 CONSTRUCTION DRAWINGS**
 ROLESVILLE, NC
DRAINAGE PLAN - WEST

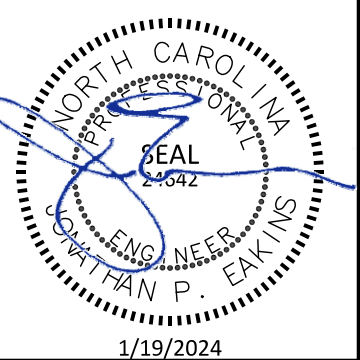

| | |
|--------------|-------------|
| PROJECT NO.: | --- |
| DESIGN BY: | JPE |
| DRAWN BY: | RSF |
| SCALE: | 1"=50' |
| DATE: | 2023-01-27 |
| SHEET NO.: | C5.5 |

#1 was this storm removed and regraded?