



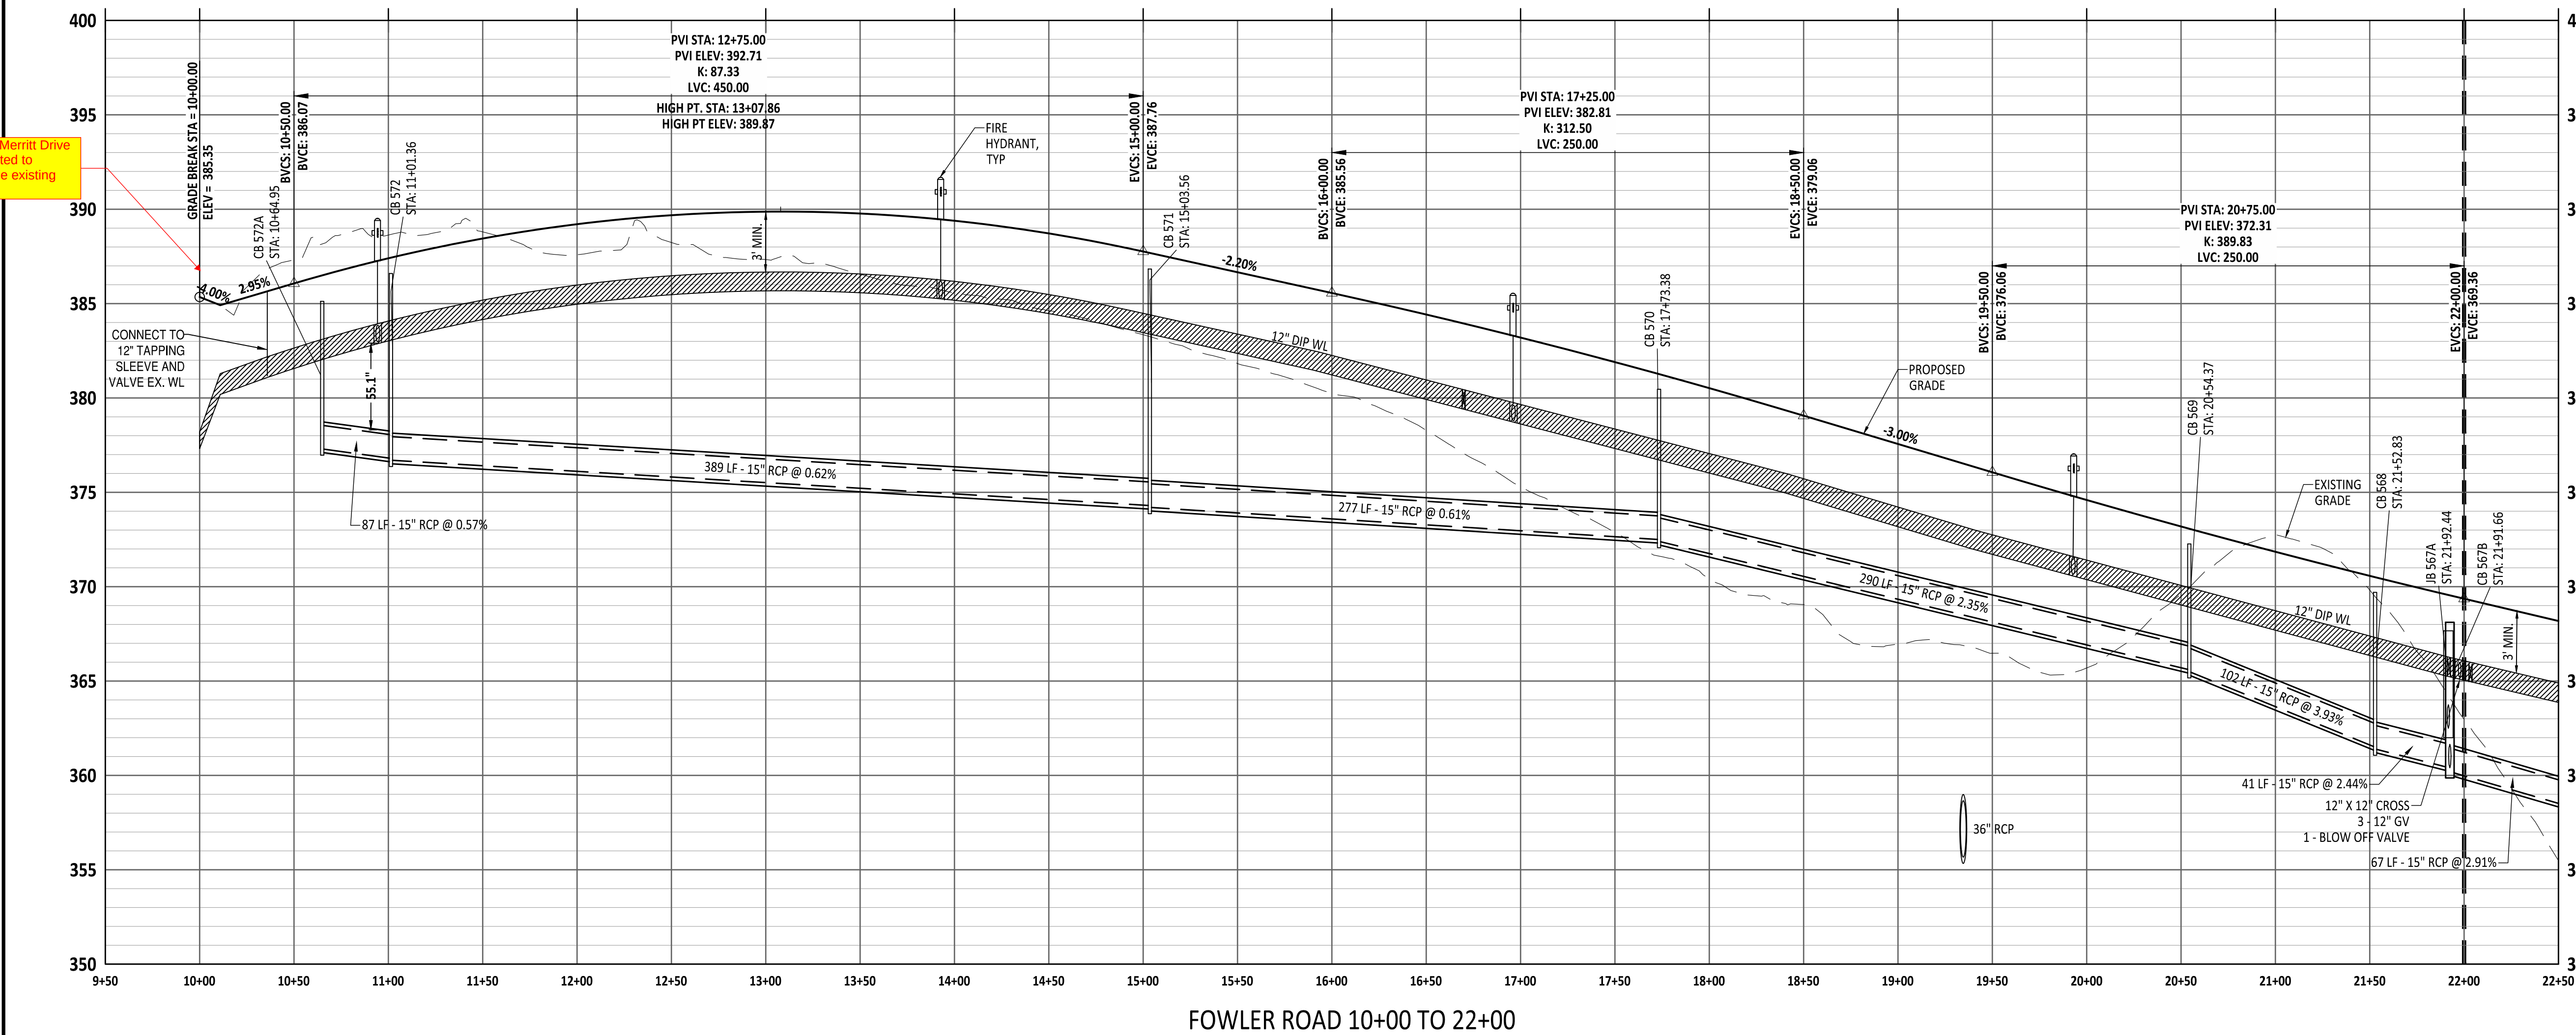

NOTE:
1. CONTRACTOR TO CONFIRM LOCATION, DEPTH, SIZE, AND MATERIAL OF EXISTING UTILITIES AND REPORT ANY DISCREPANCIES TO AMERICAN ENGINEERING.

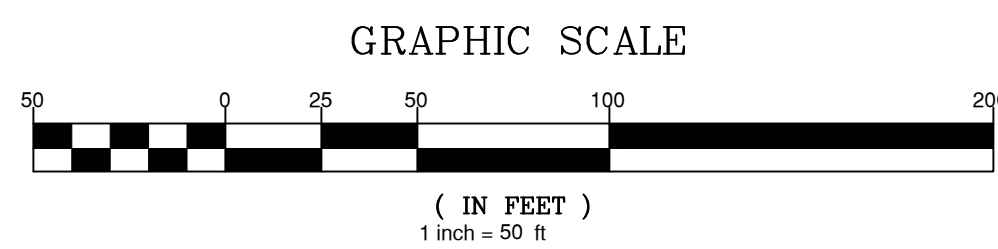

Public Sewer Collection / Extension System
The City of Raleigh consents to the connection and extension of the City's public sewer system as shown on this plan. The material and Construction methods used for this project shall conform to the standards and specifications of the City's Public Utilities Handbook.

City of Raleigh
Public Utilities Department Permit # _____

Public Water Distribution / Extension System
The City of Raleigh consents to the connection and extension of the City's public water system as shown on this plan. The material and Construction methods used for this project shall conform to the standards and specifications of the City's Public Utilities Handbook.

City of Raleigh
Public Utilities Department Permit # _____

North Carolina 811
*** 3 Days Before Digging ***
North Carolina 811
811 on 1-800-632-4949
Remote Ticket Entry
http://nc811.org/remoteticketentry.htm

AMERICAN Engineering
American Engineering Associates - Southeast, P.A.
4020 Westchase Boulevard, Suite 450
Raleigh, NC 27607
919-469-1101

PRELIMINARY
PRELIMINARY
NOT FOR CONSTRUCTION
FOR INFORMATION, ONLY

NO.	DATE	REVISION
1	07/01/25	FIRST REVISION SET
2	08/05/25	SECOND WAKE COUNTY SUBMITTAL

STIPULATION FOR REUSE
THIS DRAWING WAS PREPARED FOR USE ON THE SPECIFIC SITE, NAMED HEREON, CONTEMPORANEOUSLY WITH ITS ISSUE DATE AS LISTED, HEREON, AND IT IS NOT SUITABLE FOR USE ON A DIFFERENT PROJECT SITE OR AT A LATER TIME. USE OF THIS DRAWING FOR REFERENCE OR EXAMPLE ON ANOTHER PROJECT REQUIRES THE SERVICES OF PROPERLY LICENSED ARCHITECTS AND ENGINEERS. REPRODUCTION OF THIS DRAWING FOR REUSE ON ANOTHER PROJECT IS NOT AUTHORIZED AND MAY BE CONTRARY TO THE LAW.

MERRITT RESERVE

FOWLER ROAD



PLAN & PROFILE

ROLESVILLE RD

WAKE COUNTY NC 27312

JOB NUMBER: 23-0004
CHECKED BY: JK
DRAWN BY: DH/JM/LL
DATE: 08/04/2025
SHEET TITLE:
FOWLER ROAD PLAN & PROFILE
SHEET NO.: **CS-200**

PROJECT NUMBER = CID-25-02

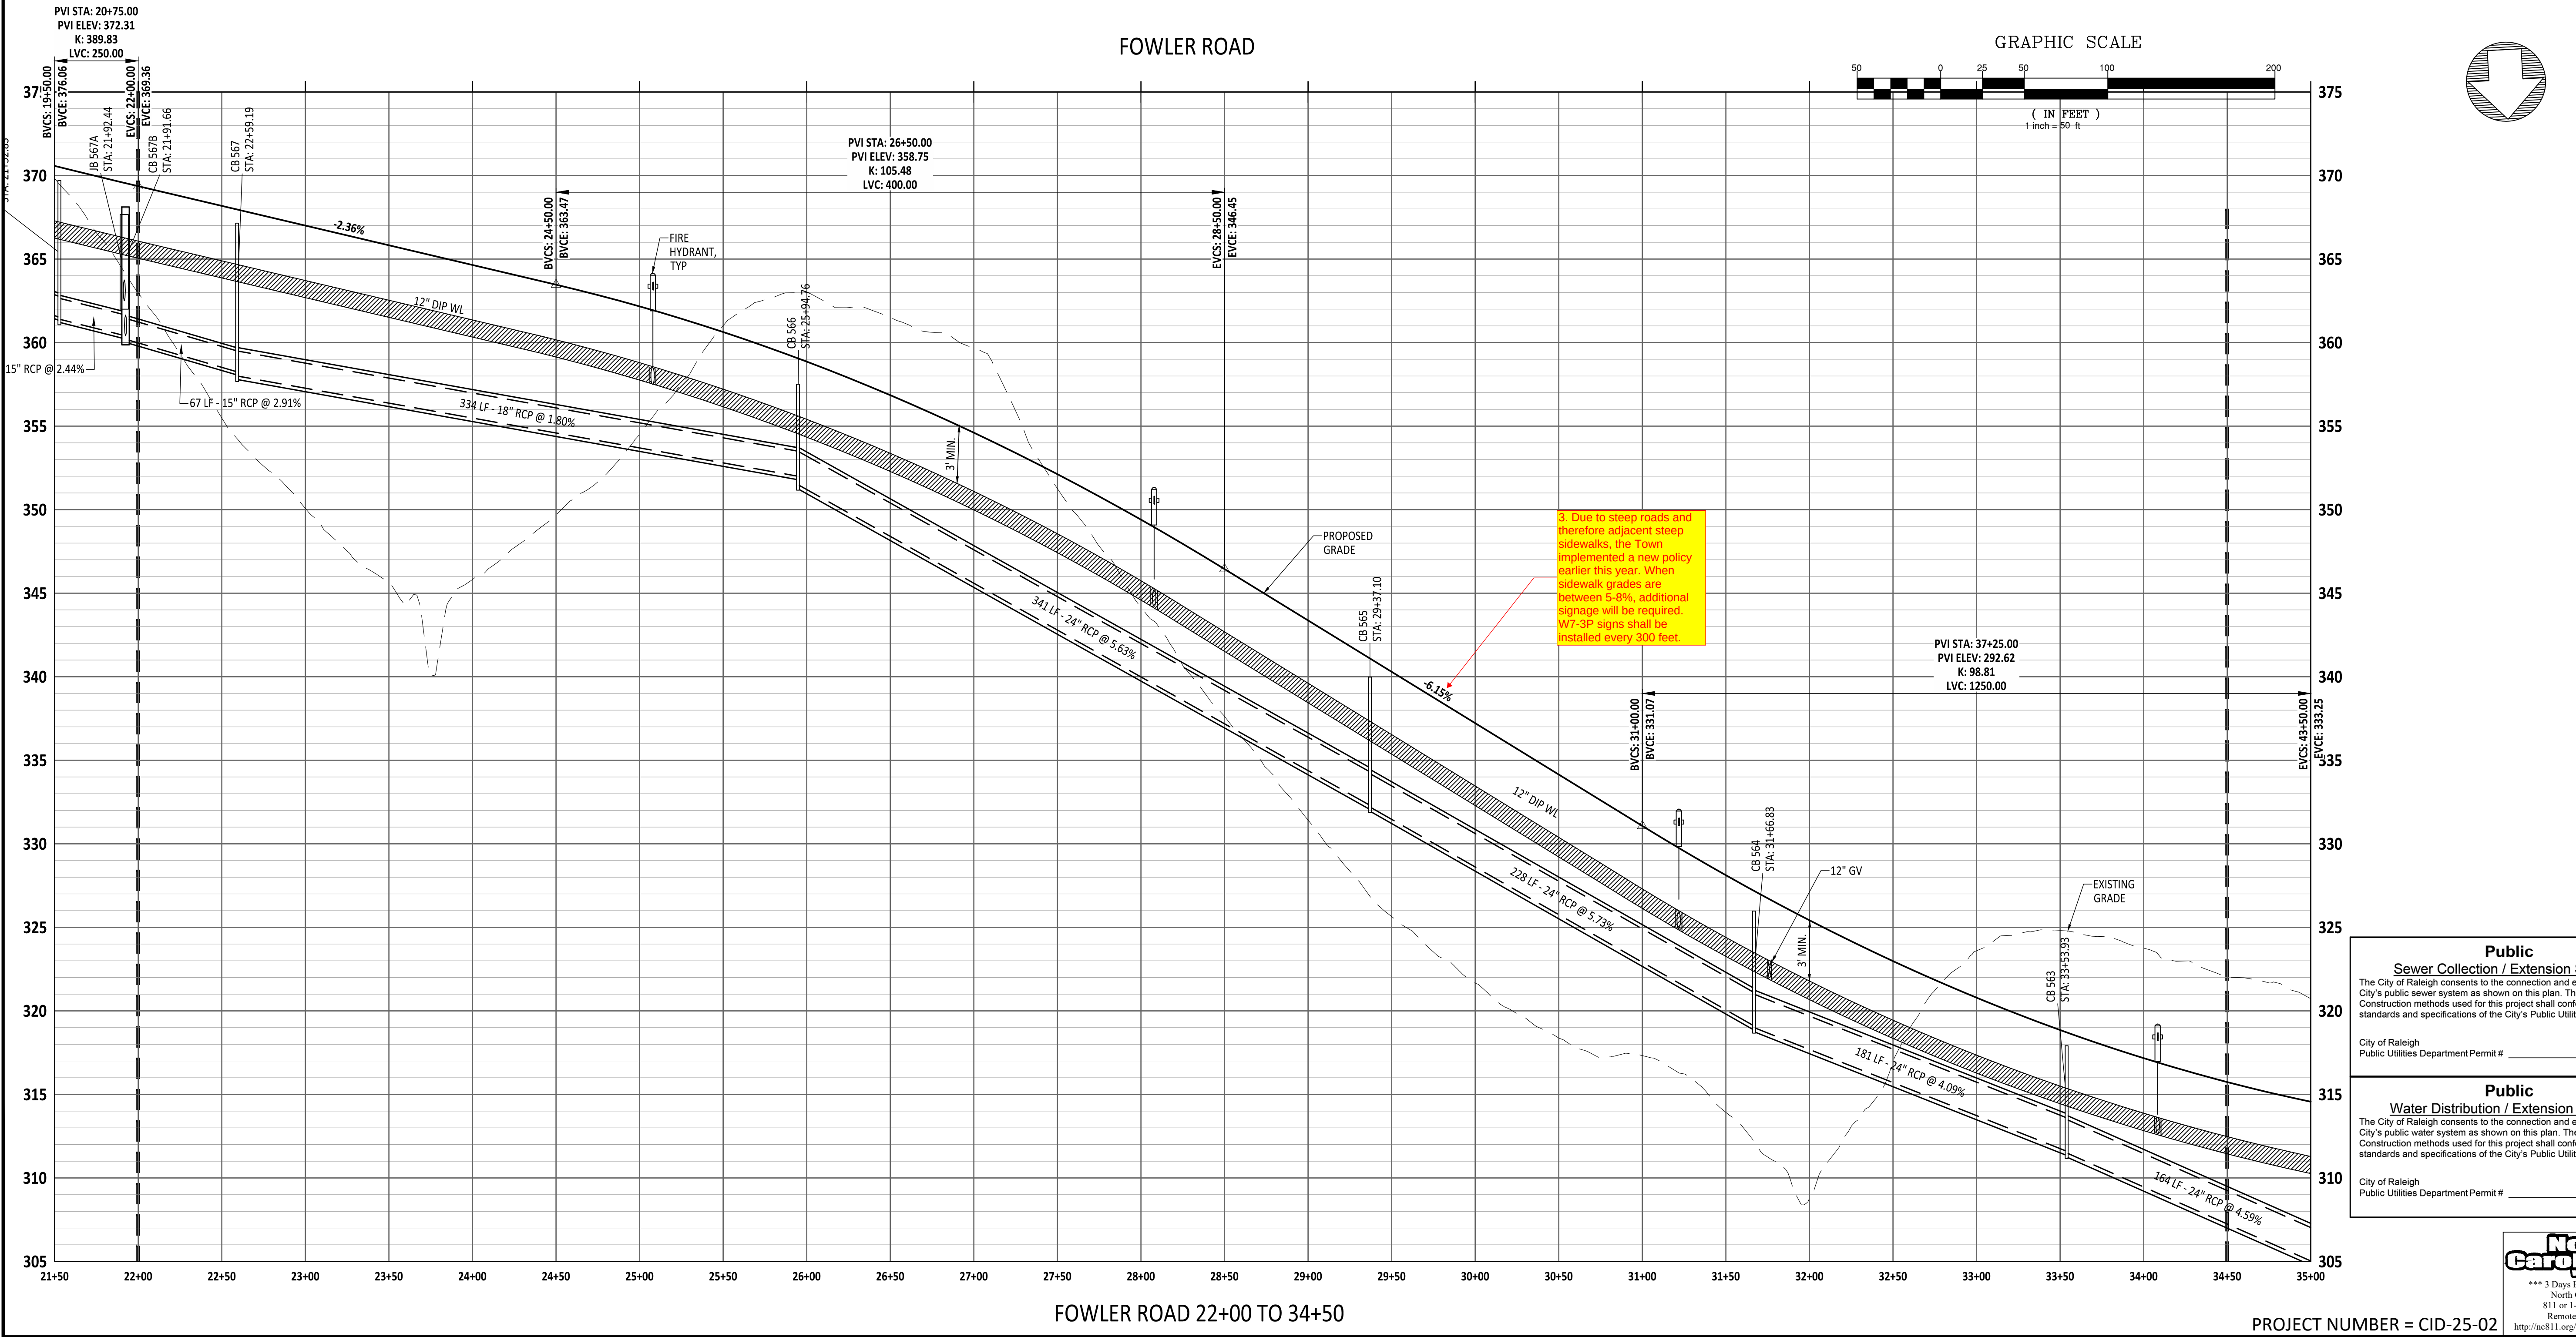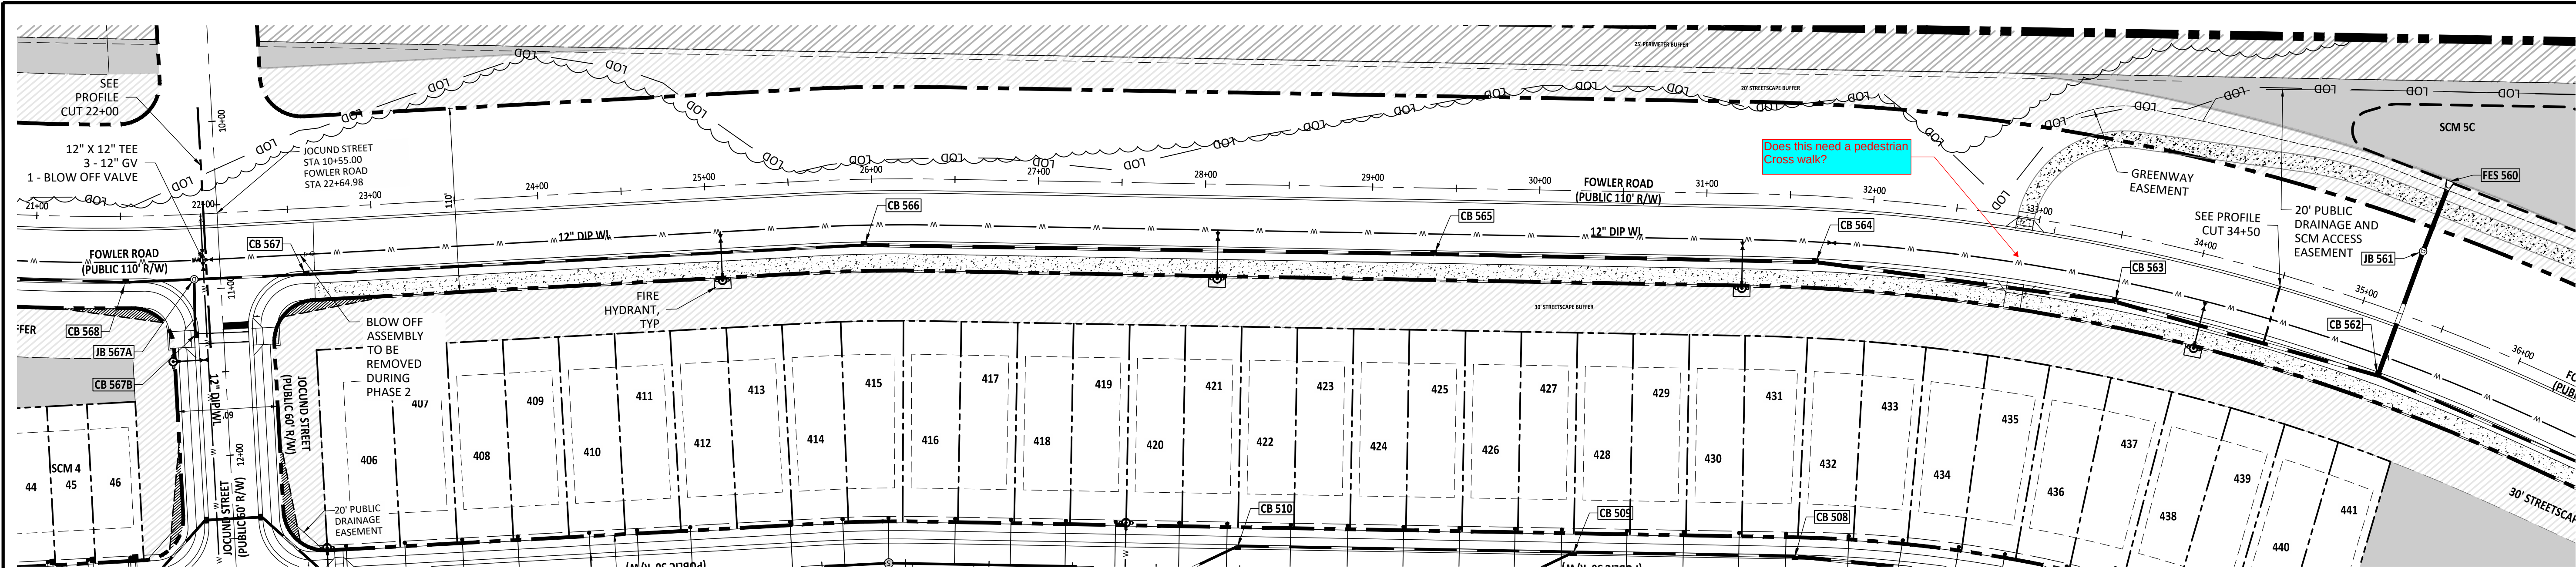

NO.	DATE	REVISION
1	07/01/25	FIRST REVISION SET
2	08/05/25	SECOND WAKE COUNTY SUBMITTAL

STIPULATION FOR REUSE

THIS DRAWING WAS PREPARED FOR USE ON THE SPECIFIC SITE, NAMED HEREIN, CONTEMPORANEOUSLY WITH ITS ISSUE DATE AS LISTED, HEREON, AND IT IS NOT SUITABLE FOR USE ON A DIFFERENT PROJECT SITE OR AT A LATER TIME. USE OF THIS DRAWING FOR REFERENCE OR EXAMPLE ON ANOTHER PROJECT REQUIRES THE SERVICES OF PROPERLY LICENSED ARCHITECTS AND ENGINEERS. REPRODUCTION OF THIS DRAWING FOR REUSE ON ANOTHER PROJECT IS NOT AUTHORIZED AND MAY BE CONTRARY TO THE LAW.

MERRITT RESERVE

FOWLER ROAD


PLAN & PROFILE

ROLESVILLE RD

WAKE COUNTY NC 27312





JOB NUMBER:	23-0004
CHECKED BY:	JK
DRAWN BY:	DH/MA/LL
DATE:	08/04/2025
SHEET TITLE:	FOWLER ROAD PLAN & PROFILE
SHEET NO.:	CS-201



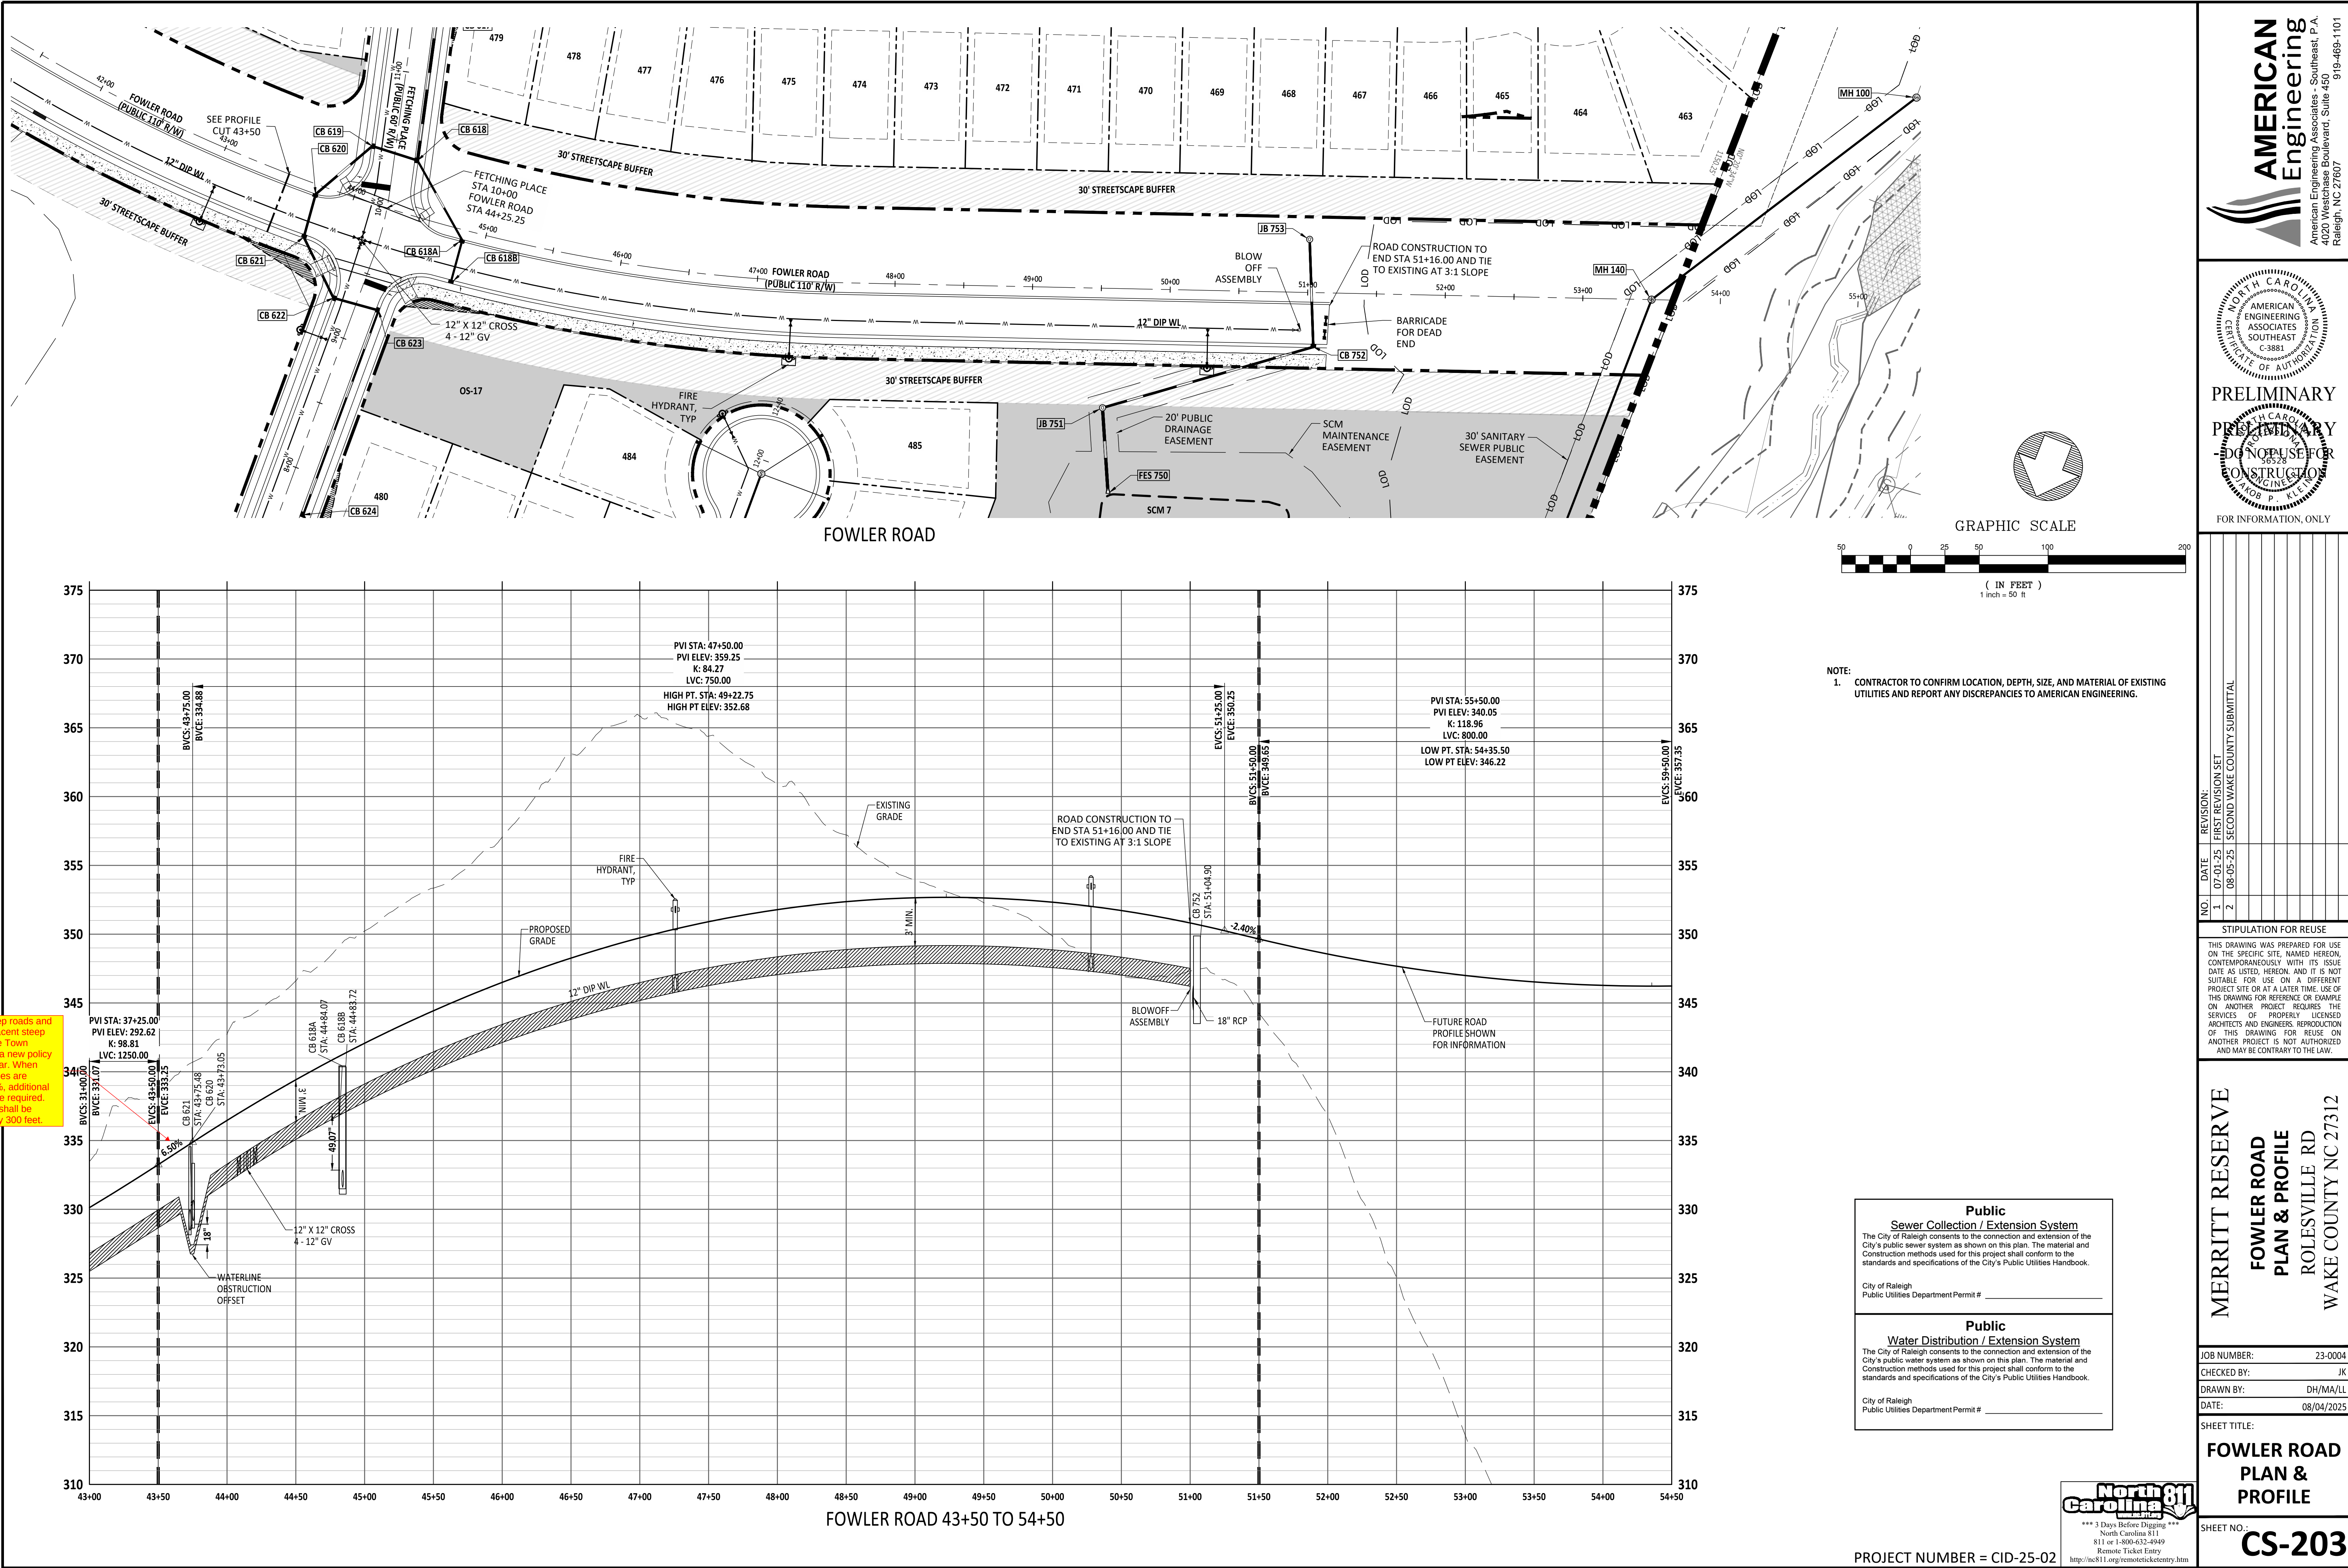




GRAPHIC SCALE

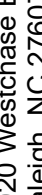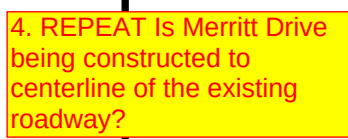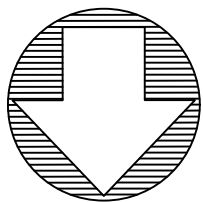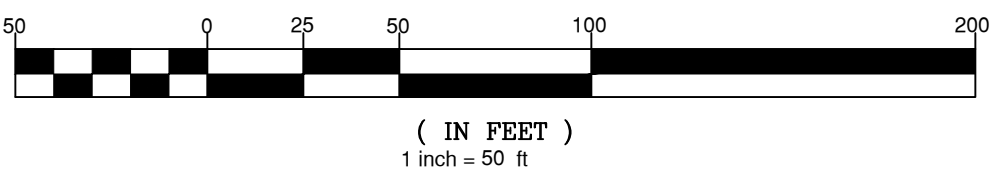

AMERICAN
Engineering

American Engineering Associates - Southeast, P.A.
4020 Westchase Boulevard, Suite 450
Raleigh, NC 27607 919-469-1101

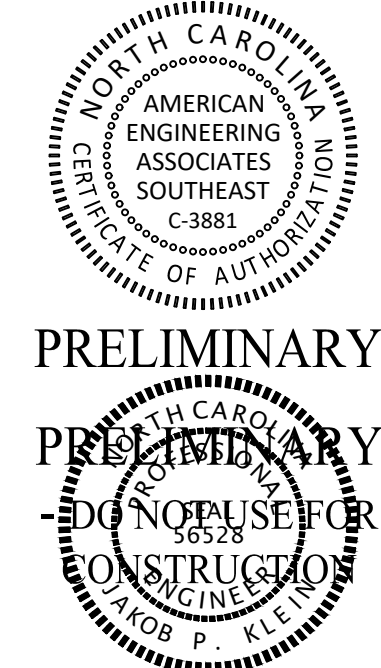

FOR INFORMATION, ONLY

[illegible]

STIPULATION FOR REUSE

THIS DRAWING WAS PREPARED FOR USE ON THE SPECIFIC SITE, NAMED HEREON, CONTEMPORANEOUSLY WITH ITS ISSUE DATE AS LISTED, HEREON, AND IT IS NOT SUITABLE FOR USE ON A DIFFERENT PROJECT SITE OR AT A LATER TIME. USE OF THIS DRAWING FOR REFERENCE OR EXAMPLE ON ANOTHER PROJECT REQUIRES THE SERVICES OF PROPERLY LICENSED ARCHITECTS AND ENGINEERS. REPRODUCTION OF THIS DRAWING FOR REUSE ON ANOTHER PROJECT IS NOT AUTHORIZED AND MAY BE CONTRARY TO THE LAW.

MERRITT RESERVE
MERRITT RESERVE DR
PLAN & PROFILE
ROLESVILLE RD
WAKE COUNTY NC 27312


JOB NUMBER:	23-0004
CHECKED BY:	JK
DRAWN BY:	DH/MA/LL
DATE:	08/04/2025

SHEET TITLE:
**MERRITT
RESERVE DR
PLAN &
PROFILE**





SHEET NO.: 33 313





PROJECT NUMBER = CID-25-02

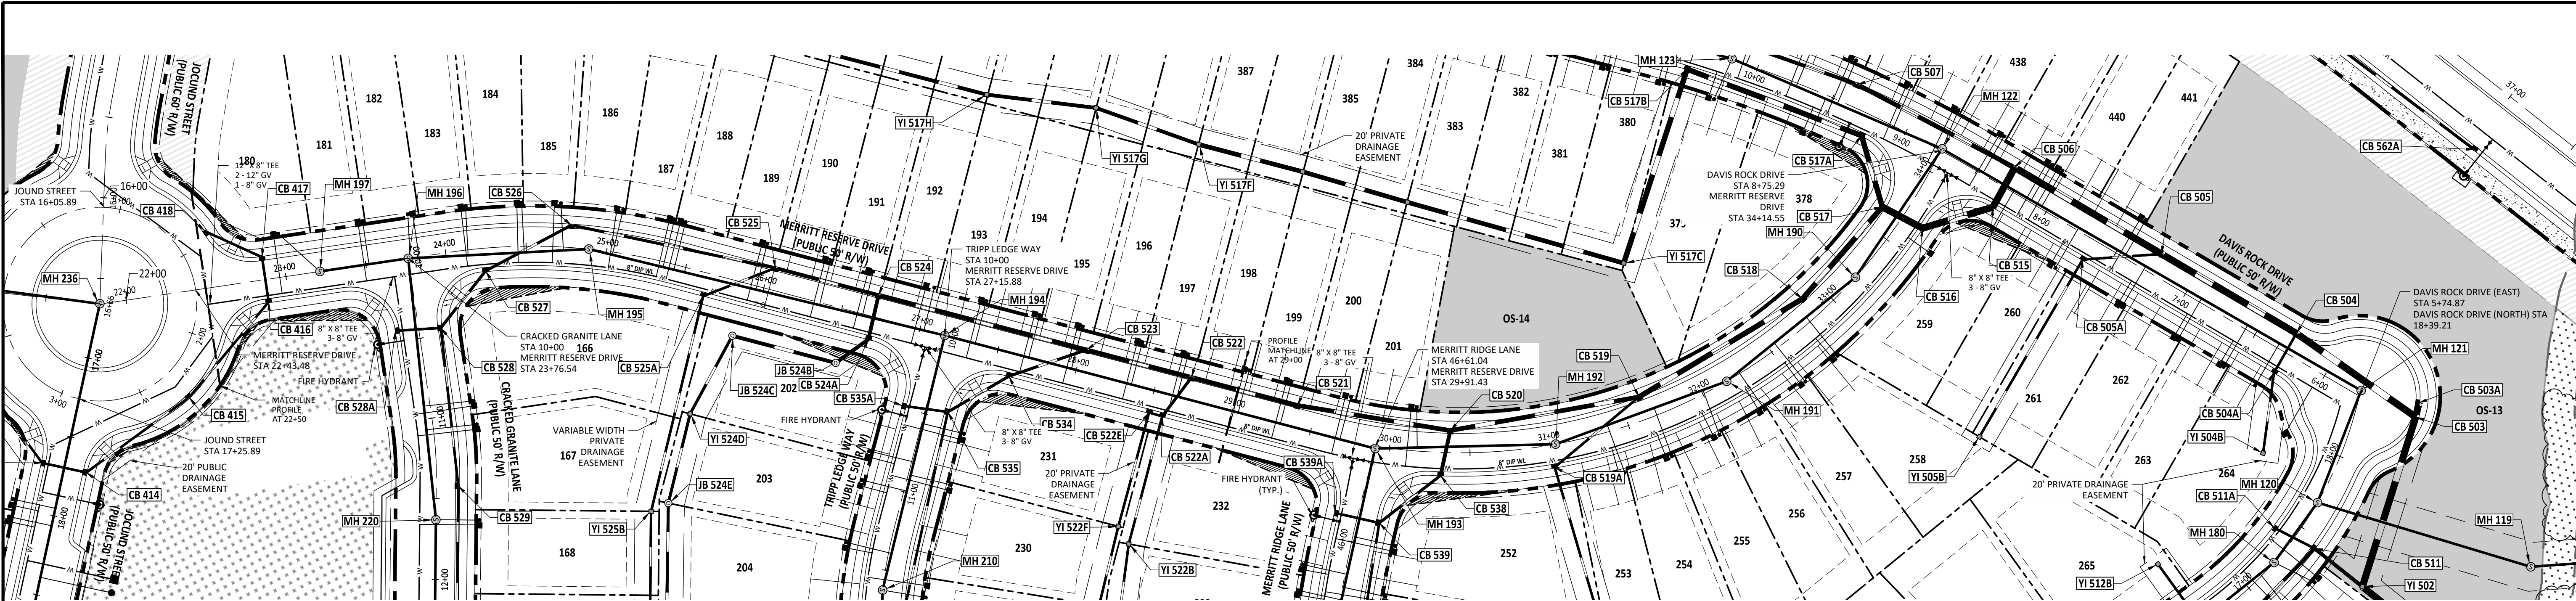

MERRITT RESERVE DRIVE PLAN & PROFILE

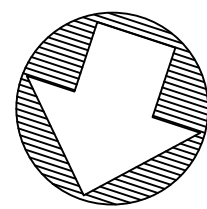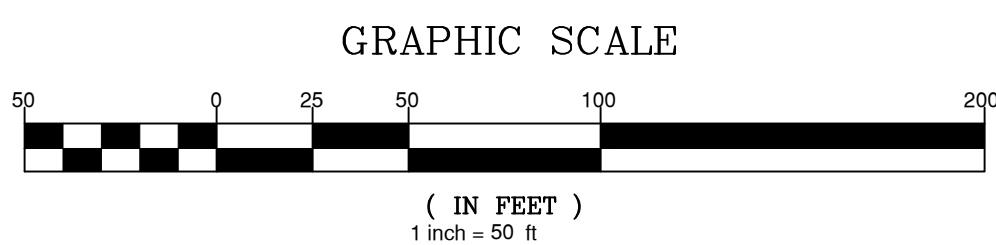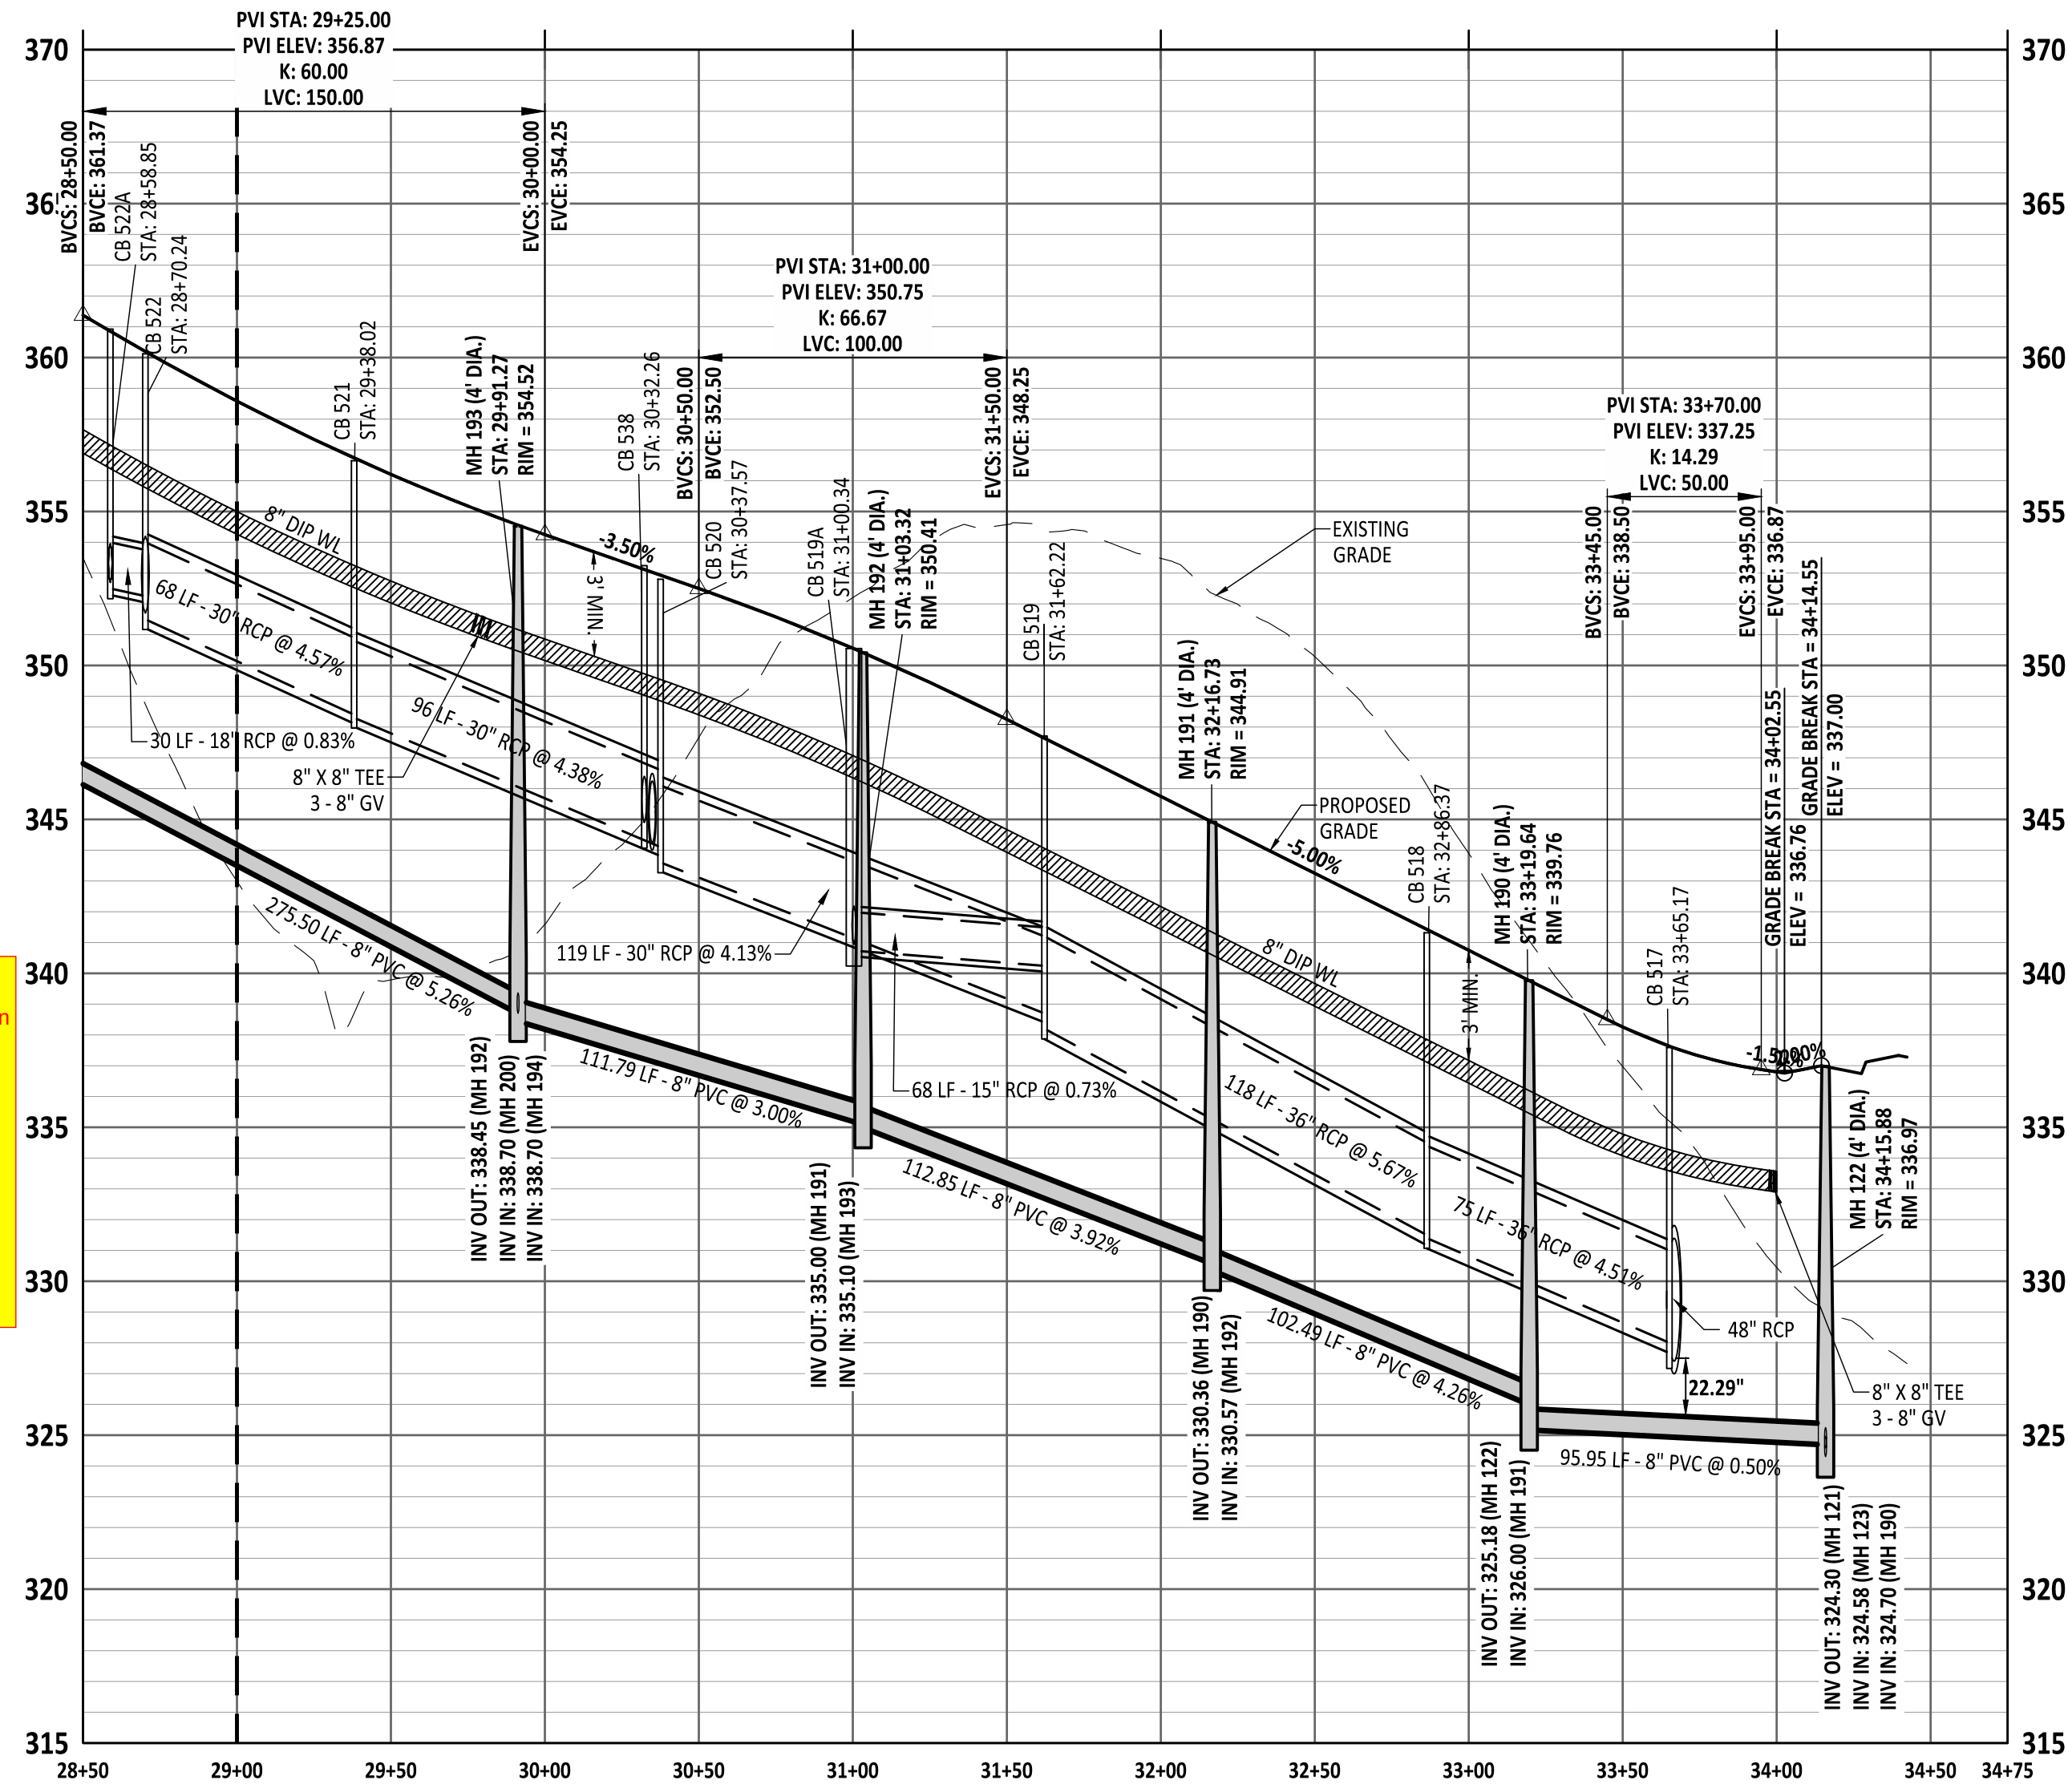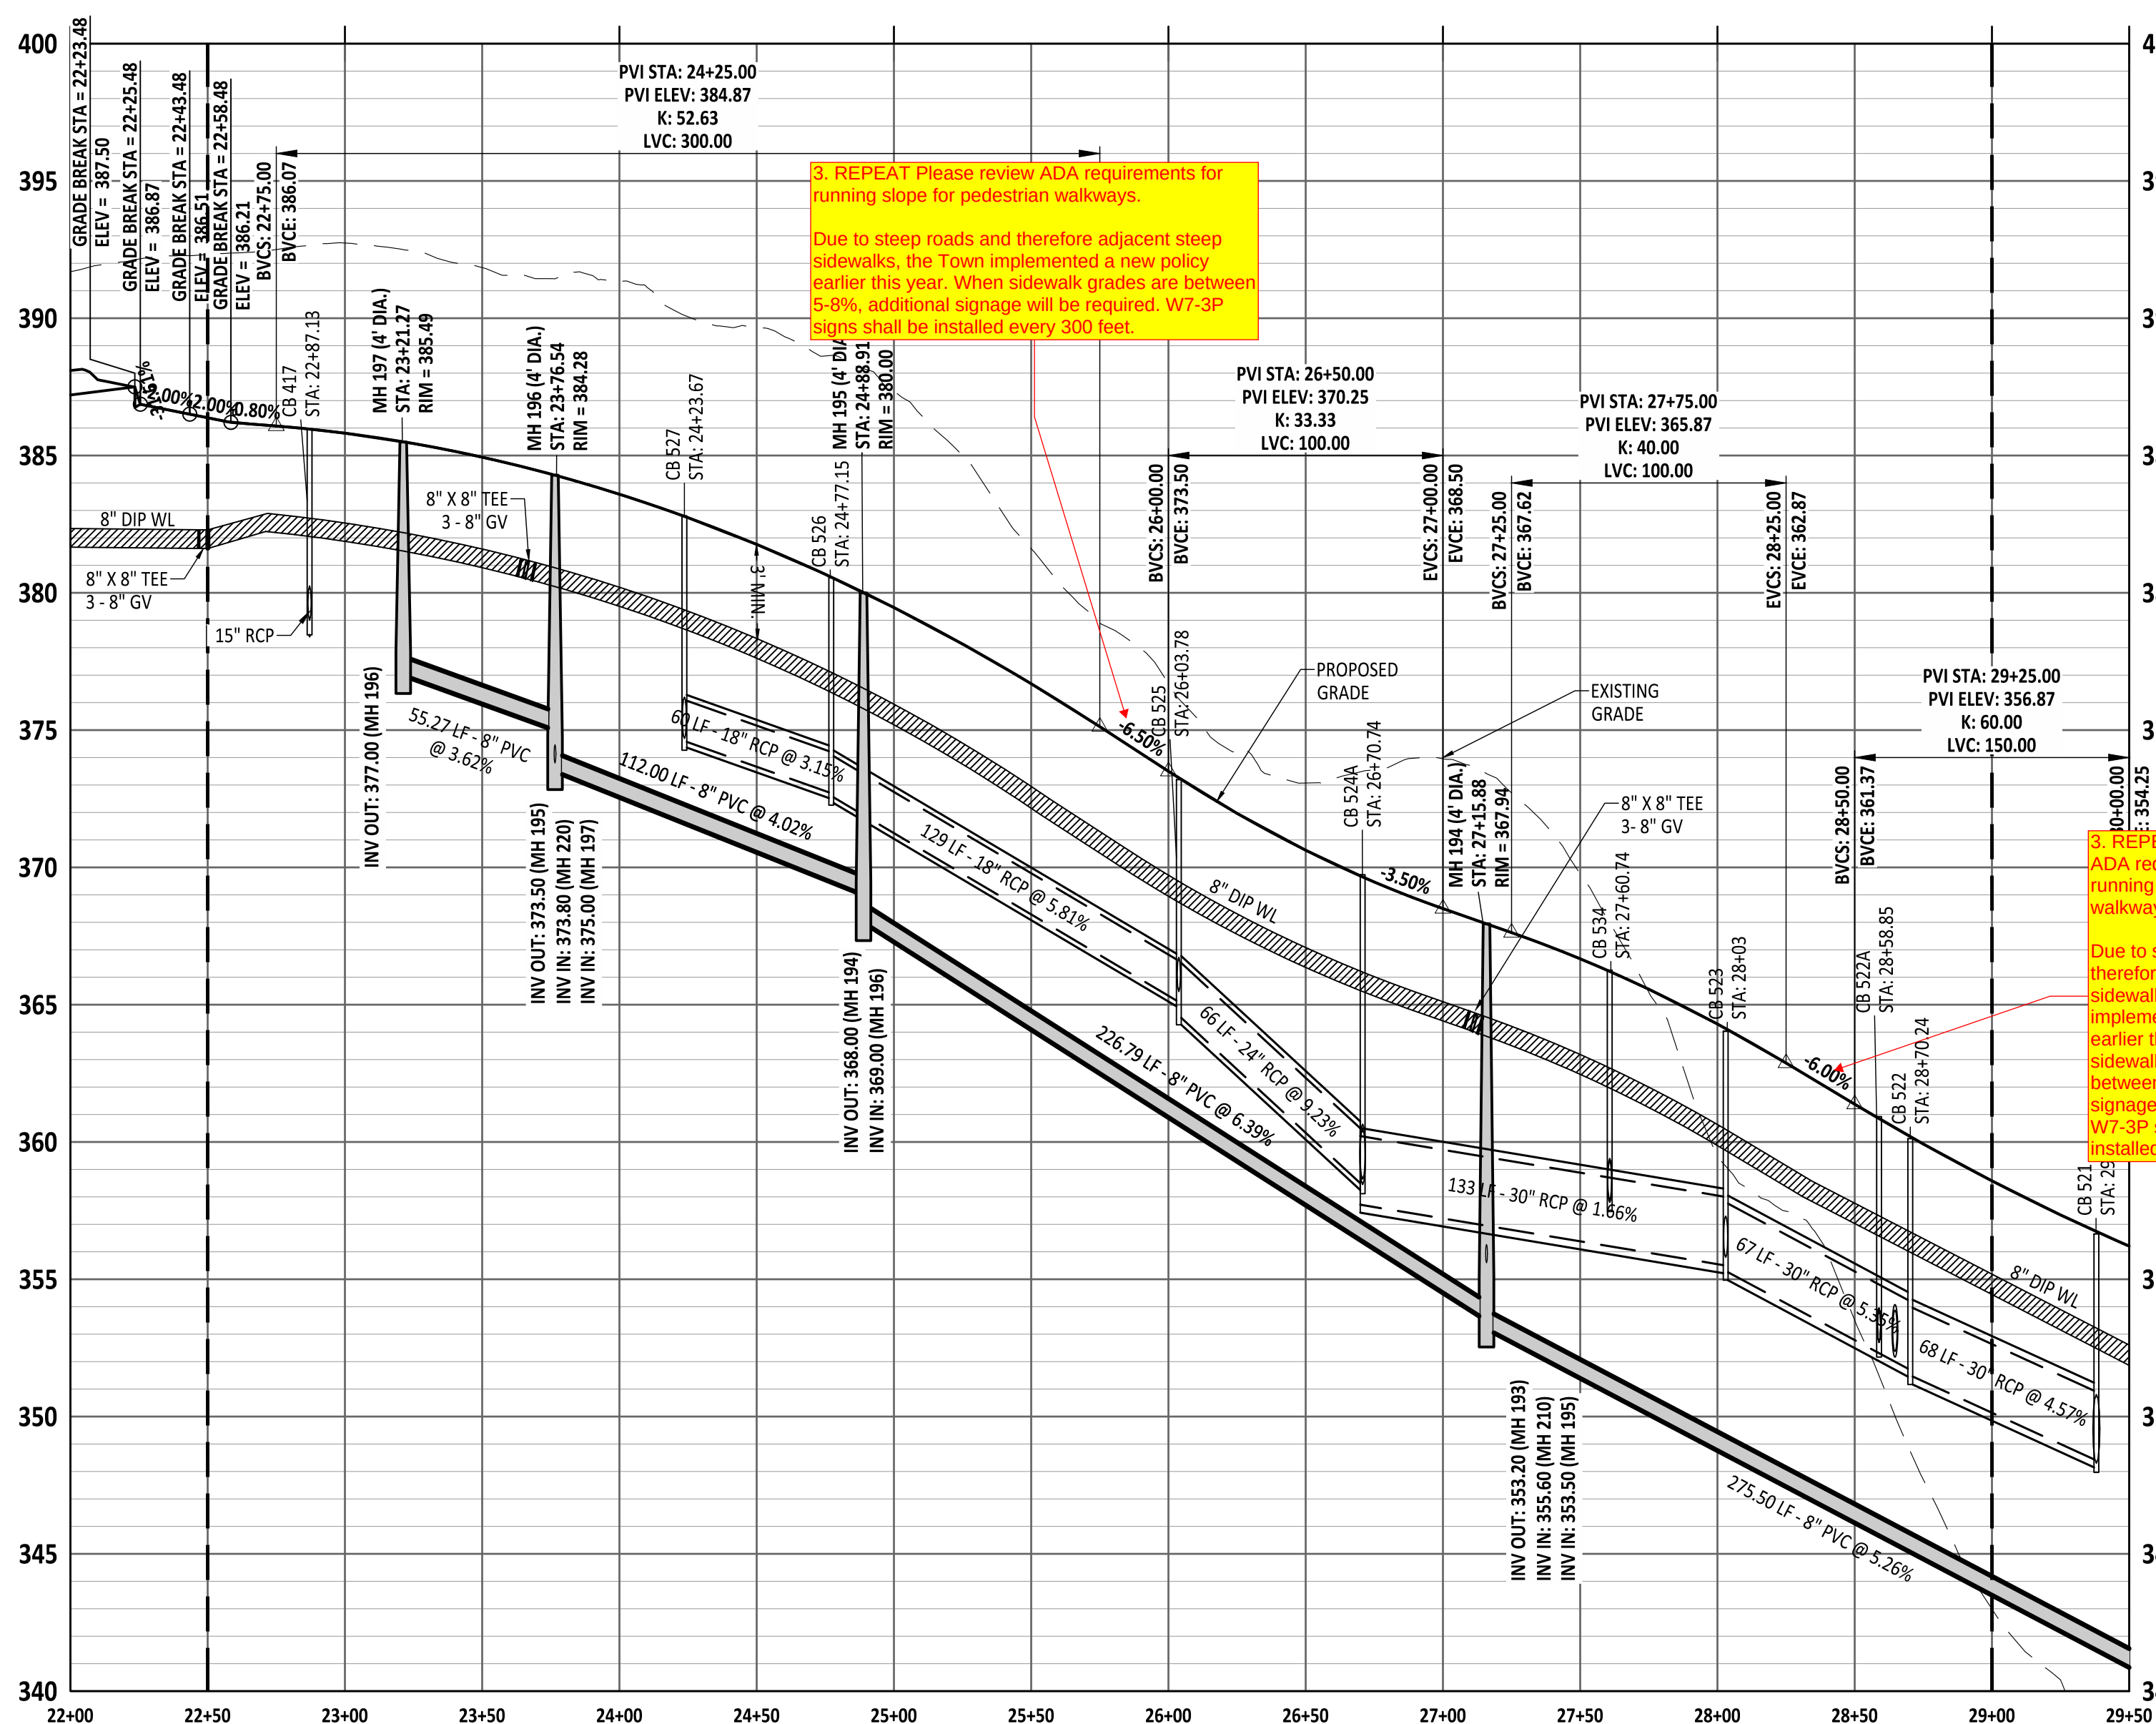

PROJECT NUMBER = CID-25-02

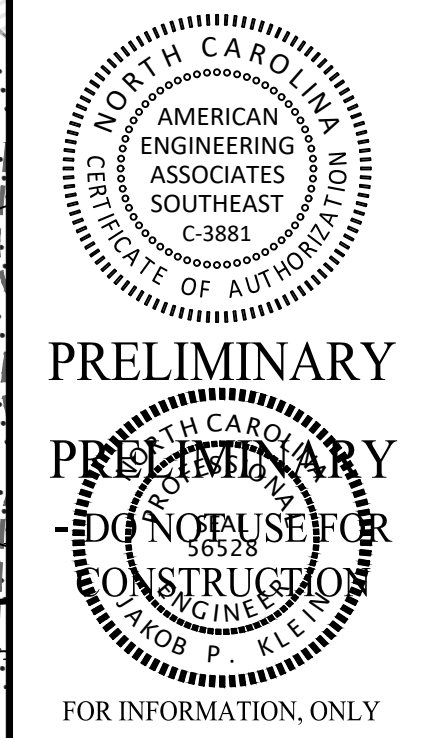
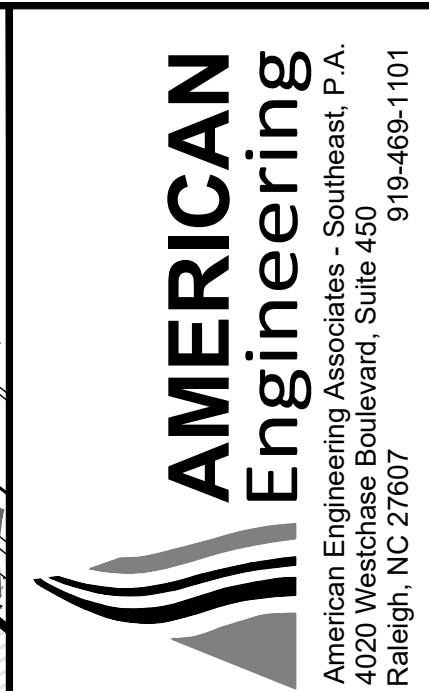


REVISION			
NO.	DATE	REVISION	BY
1	07/01/25	FIRST REVISION SET	
2	08/05/25	SECOND WAKE COUNTY SUBMITTAL	

STIPULATION FOR REUSE
THIS DRAWING WAS PREPARED FOR USE ON THE SPECIFIC SITE, NAMED HEREON, AND IS NOT SUITABLE FOR USE ON A DIFFERENT PROJECT SITE OR AT A LATER TIME. USE OF THIS DRAWING FOR REFERENCE OR EXAMPLE ON ANOTHER PROJECT REQUIRES THE SERVICES OF A PROPERLY LICENSED ARCHITECTS AND ENGINEERS. REPRODUCTION OF THIS DRAWING FOR REUSE ON ANOTHER PROJECT IS NOT AUTHORIZED AND MAY BE CONTRARY TO THE LAW.

MERRITT RESERVE
MERRITT RESERVE DR
PLAN & PROFILE
ROLESVILLE RD
WAKE COUNTY NC 27312

JOB NUMBER: 23-0004
CHECKED BY: JK
DRAWN BY: DH/MA/LL
DATE: 08/04/2025
SHEET TITLE:
MERRITT RESERVE DR PLAN & PROFILE
SHEET NO.: **CS-211**

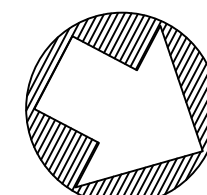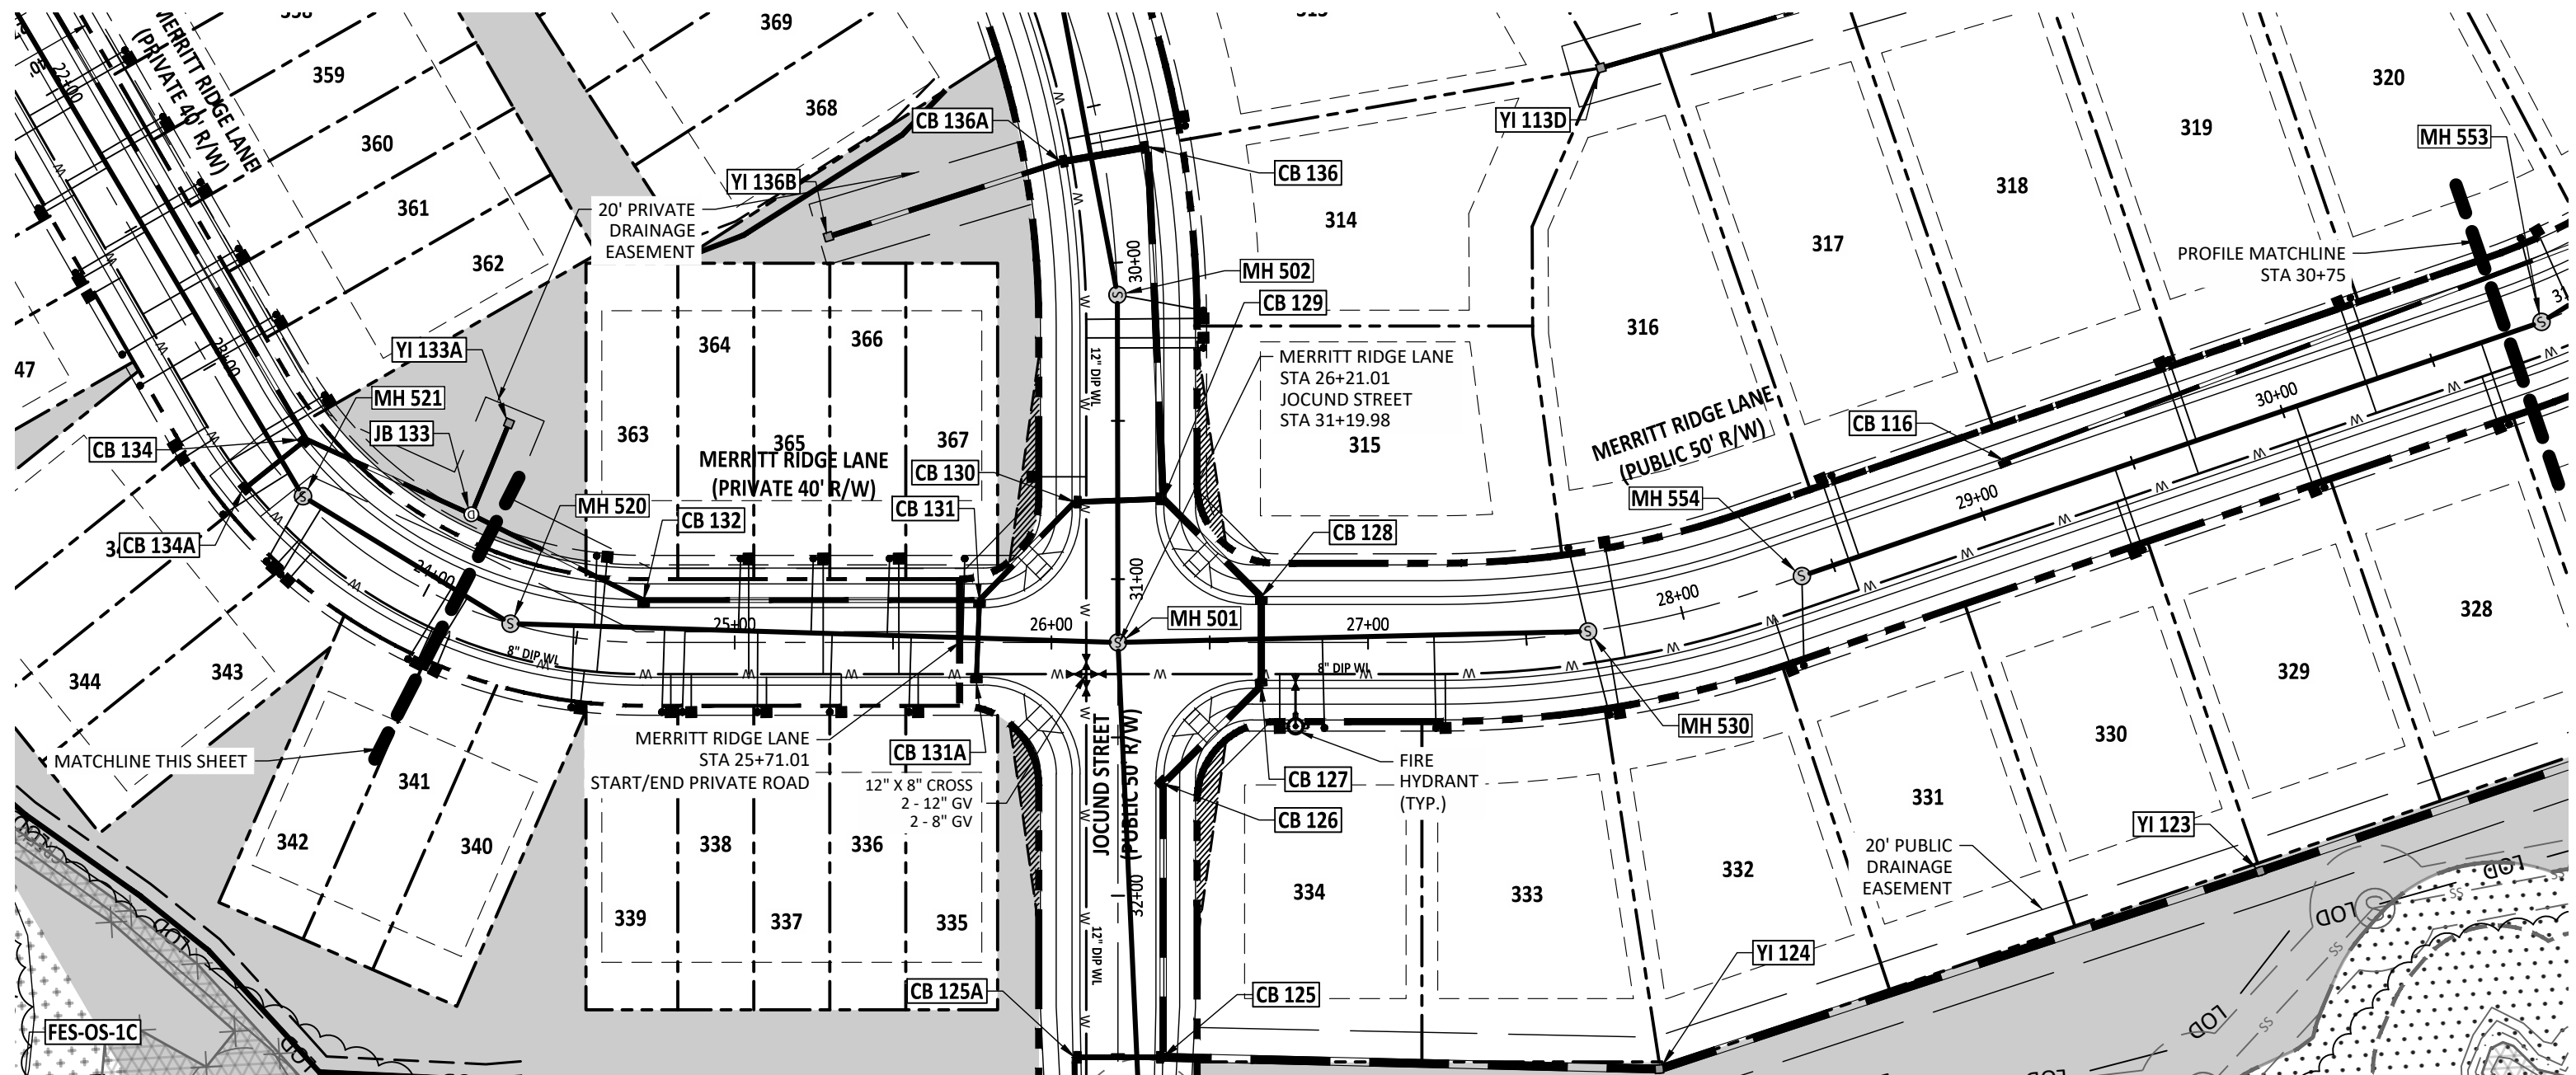

North Carolina 811
www.nc811.org

*** 3 Days Before Digging ***
North Carolina 811
811 or 1-800-632-4949
Remote Ticket Entry
<http://nc811.org/remoteticketentry.htm>

SHEET NO.: **CS-231**



PRELIMINARY
PRELIMINARY
- DO NOT USE FOR CONSTRUCTION -






FOR INFORMATION, ONLY

[illegible]

STIPULATION FOR REUSE

THIS DRAWING WAS PREPARED FOR USE ON THE SPECIFIC SITE, NAMED HEREON, CONTEMPORANEOUSLY WITH ITS ISSUE DATE AS LISTED, HEREON, AND IT IS NOT SUITABLE FOR USE ON A DIFFERENT PROJECT SITE OR AT A LATER TIME. USE OF THIS DRAWING FOR REFERENCE OR EXAMPLE ON ANOTHER PROJECT REQUIRES THE SERVICES OF PROPERLY LICENSED ARCHITECTS AND ENGINEERS. REPRODUCTION OF THIS DRAWING FOR REUSE ON ANOTHER PROJECT IS NOT AUTHORIZED AND MAY BE CONTRARY TO THE LAW.

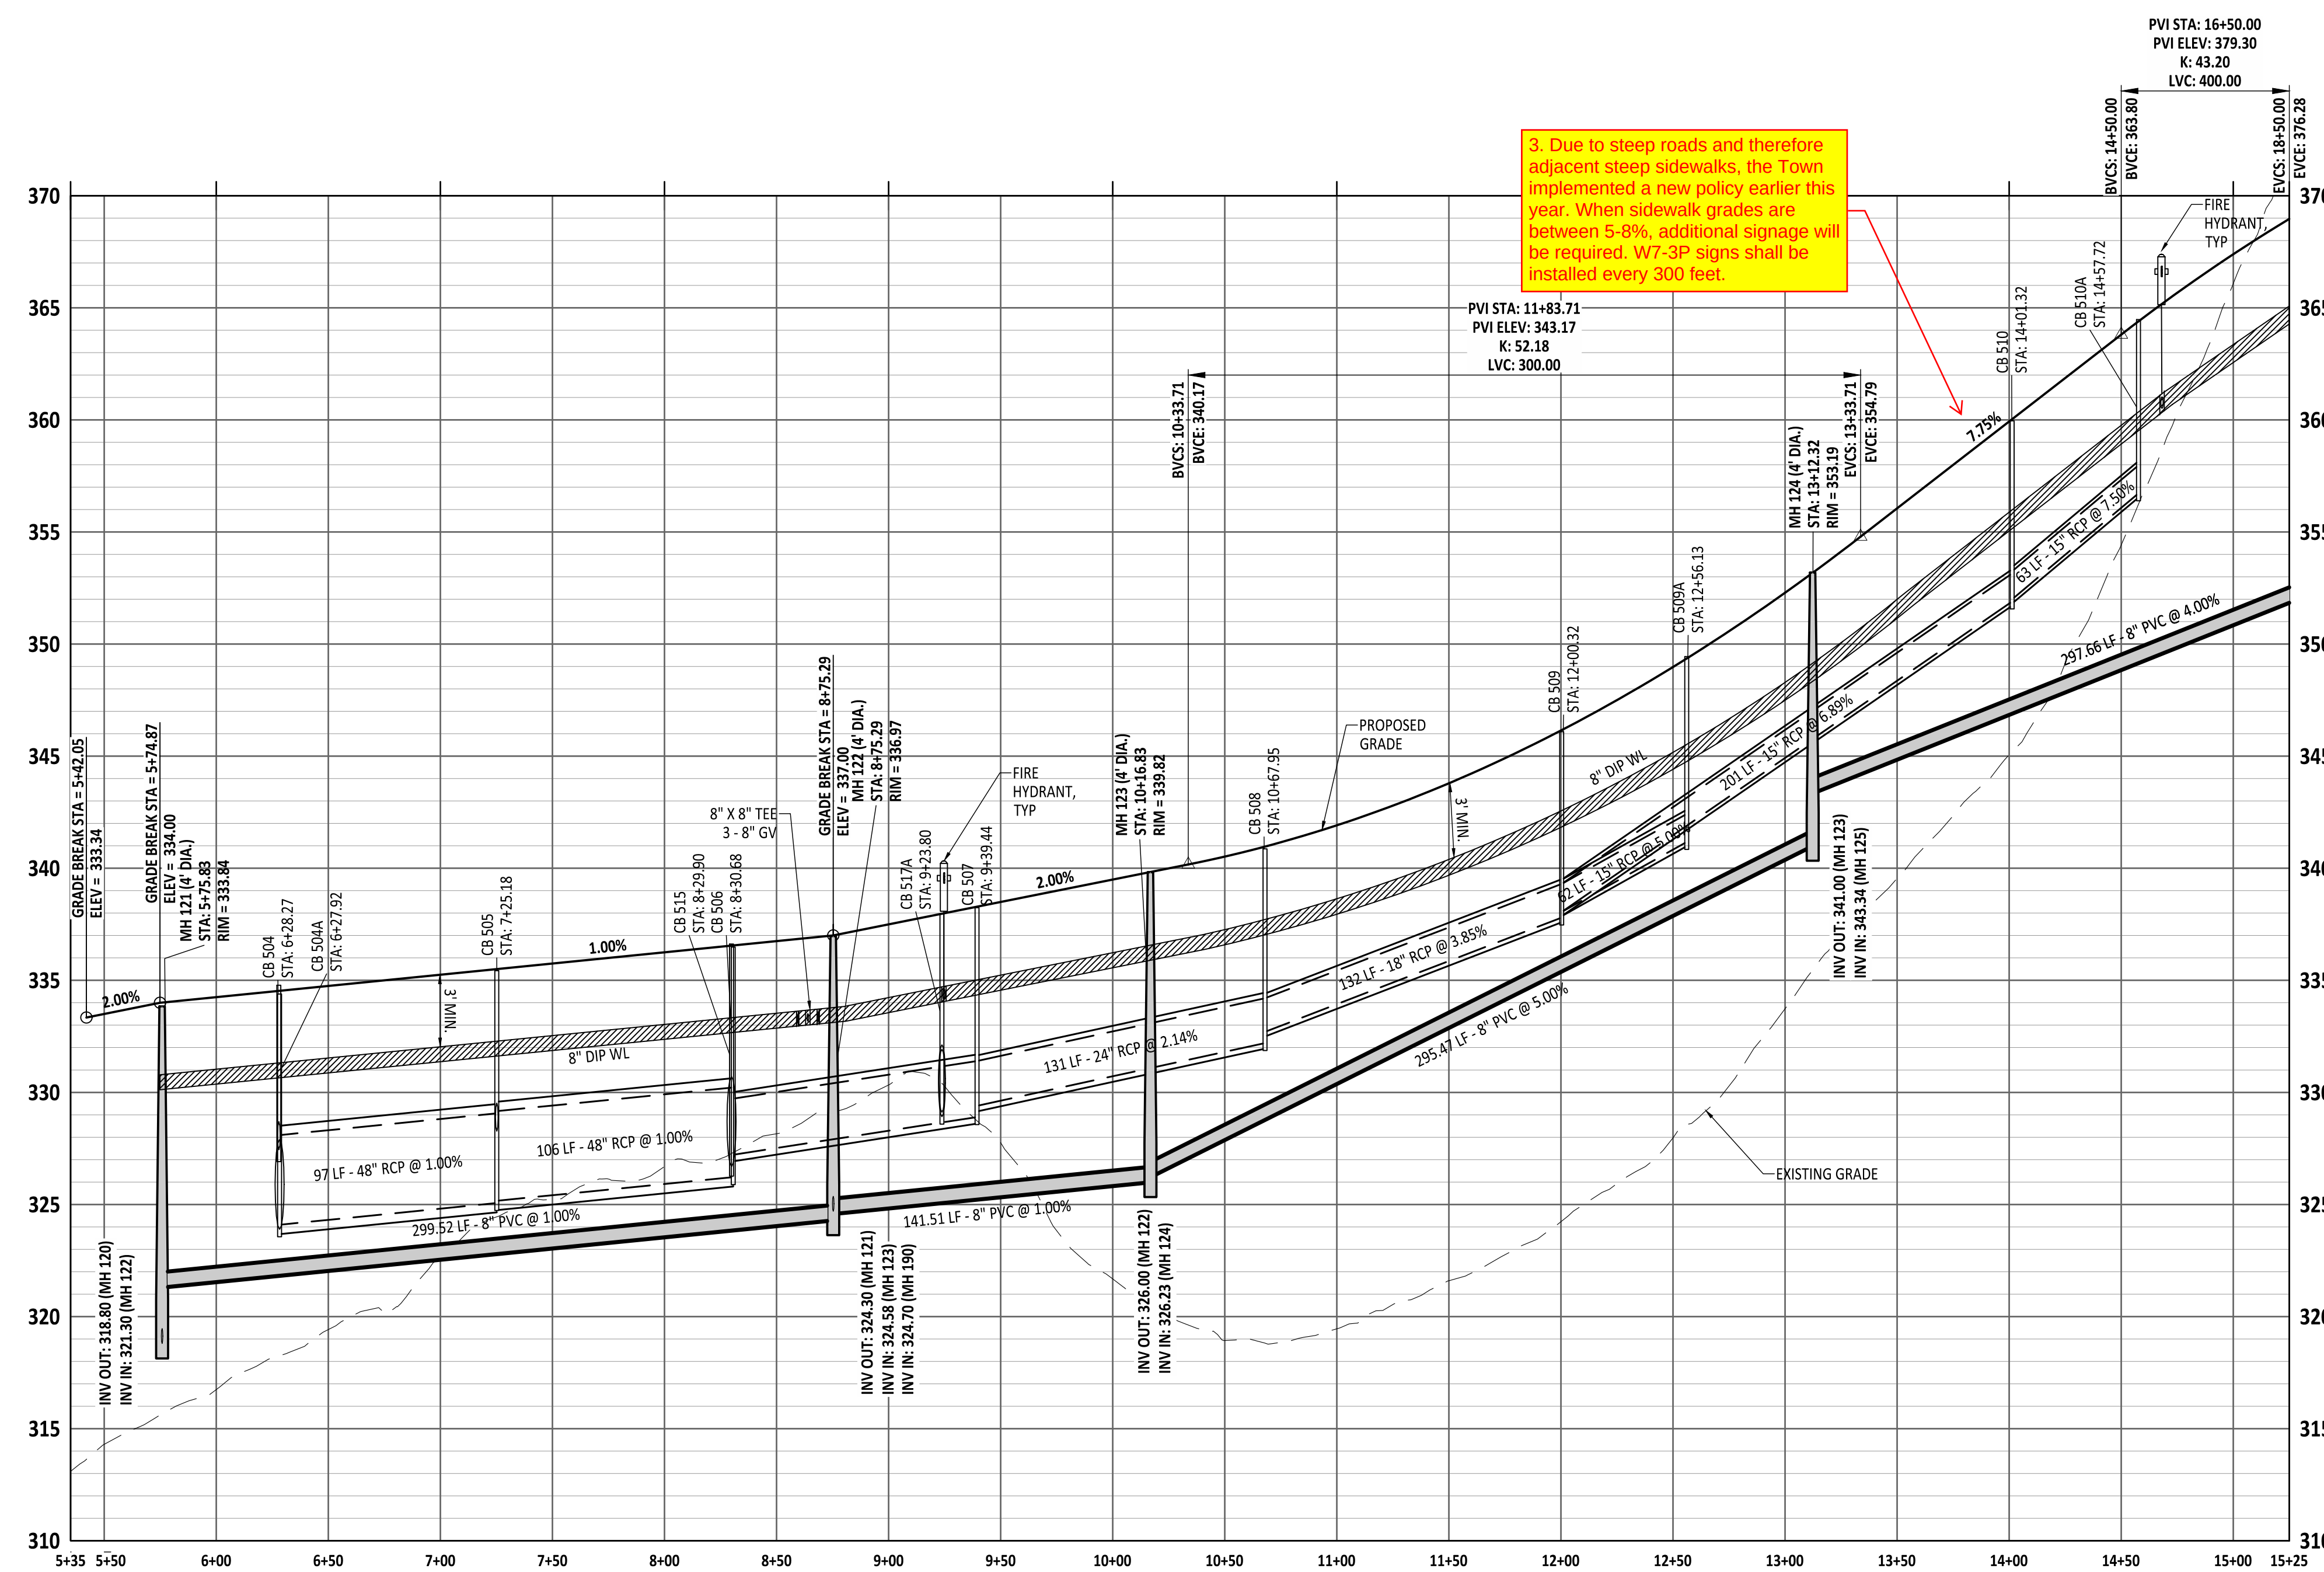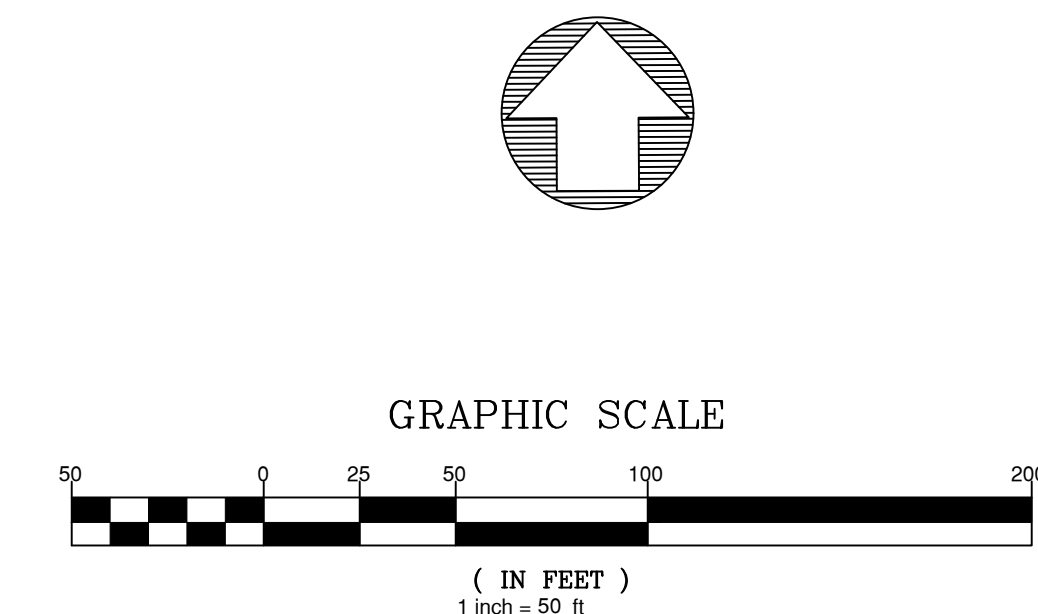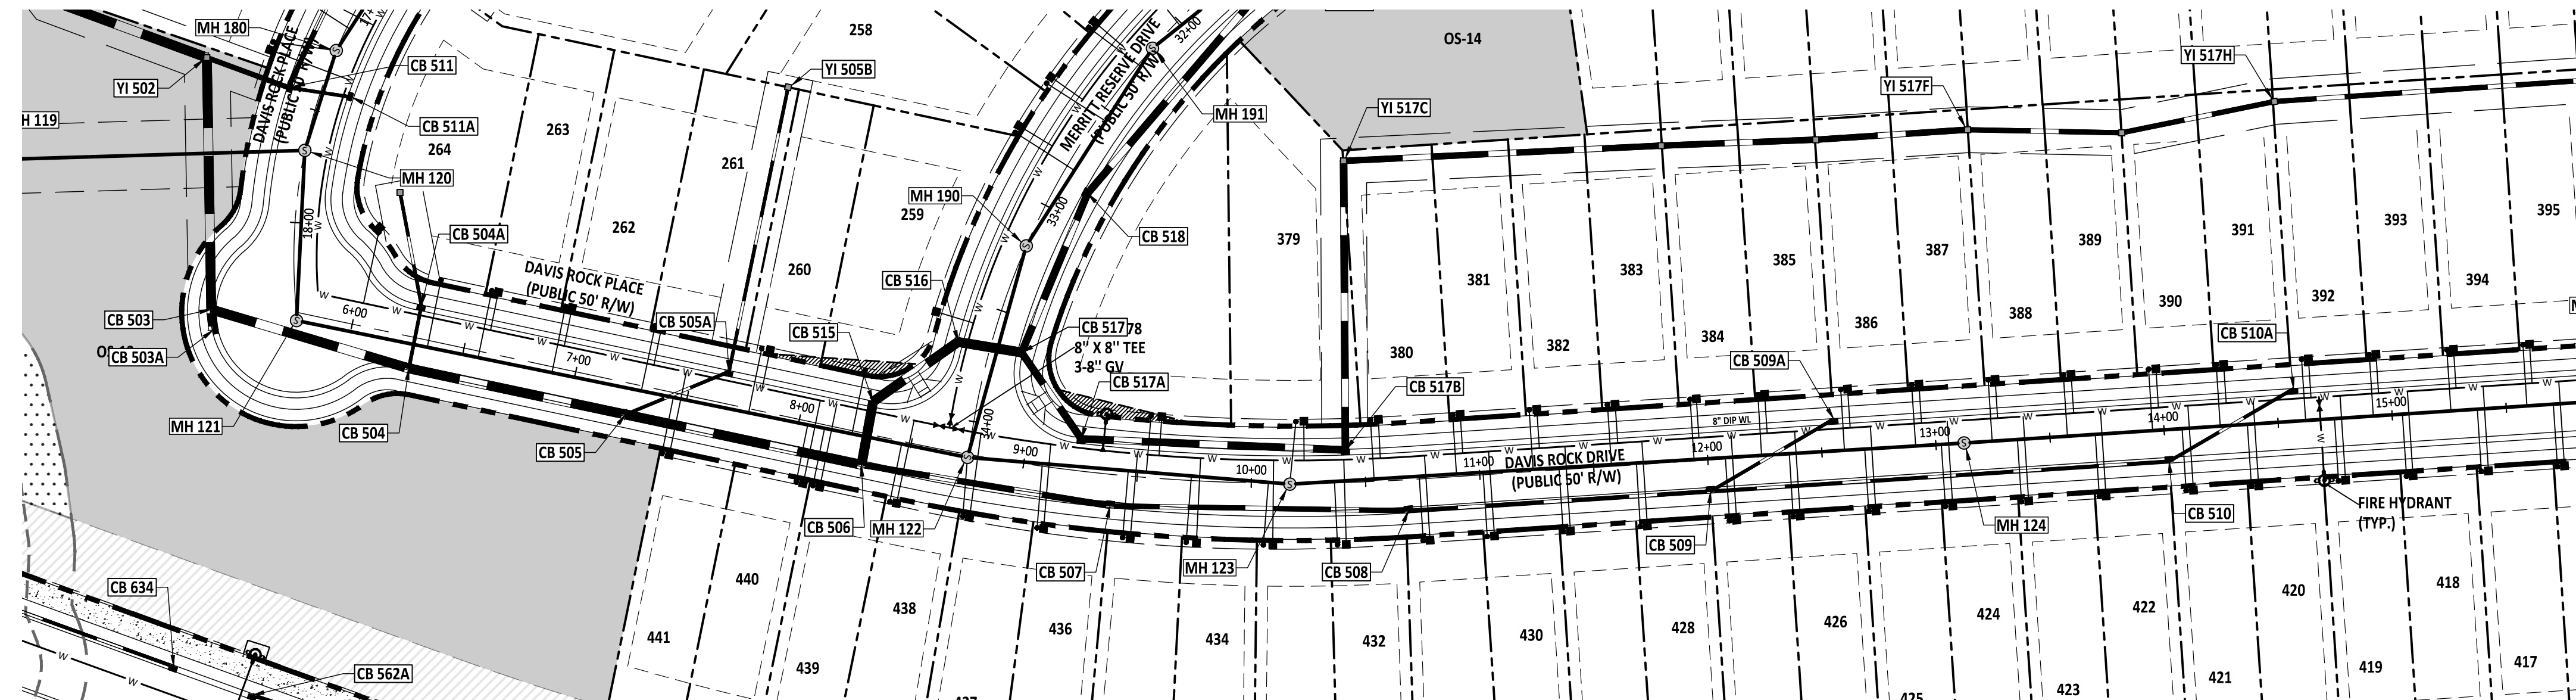

Public
Sewer Collection / Extension System

The City of Raleigh consents to the connection and extension of the City's public sewer system as shown on this plan. The material and Construction methods used for this project shall conform to the standards and specifications of the City's Public Utilities Handbook.

City of Raleigh
Public Utilities Department Permit # _____

Public
Water Distribution / Extension System


The City of Raleigh consents to the connection and extension of the City's public water system as shown on this plan. The material and Construction methods used for this project shall conform to the standards and specifications of the City's Public Utilities Handbook.

City of Raleigh
Public Utilities Department Permit # _____

PROJECT NUMBER = CID-25-02

North Carolina 811
www.nc811.org

*** 3 Days Before Digging ***
North Carolina 811
811 or 1-800-632-4949
Remote Ticket Entry
<http://nc811.org/remoteticketentry.htm>

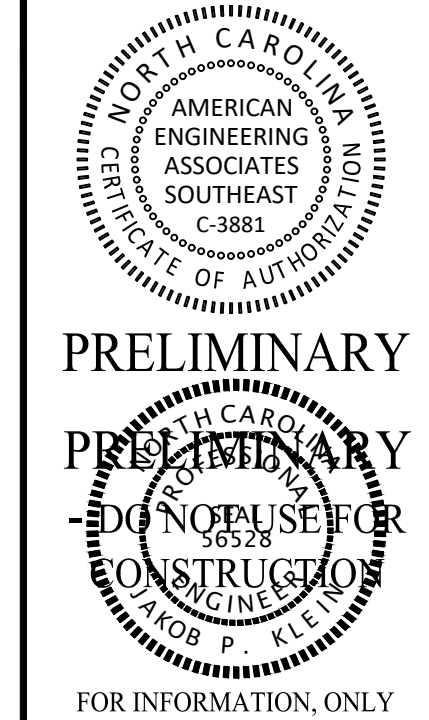[illegible]

STIPULATION FOR REUSE




THIS DRAWING WAS PREPARED FOR USE ON THE SPECIFIC SITE, NAMED HEREON, CONTEMPORANEOUSLY WITH ITS ISSUE DATE AS LISTED, HEREON, AND IT IS NOT SUITABLE FOR USE ON A DIFFERENT PROJECT SITE OR AT A LATER TIME. USE OF THIS DRAWING FOR REFERENCE OR EXAMPLE ON ANOTHER PROJECT REQUIRES THE SERVICES OF PROPERLY LICENSED ARCHITECTS AND ENGINEERS. REPRODUCTION OF THIS DRAWING FOR REUSE ON ANOTHER PROJECT IS NOT AUTHORIZED AND MAY BE CONTRARY TO THE LAW.

MERRITT RESERVE
DAVIS ROCK DRIVE
PLAN & PROFILE
ROLESVILLE RD
WAKE COUNTY NC 27312



JOB NUMBER:	23-000
CHECKED BY:	JL
DRAWN BY:	DH/MA/L
DATE:	08/04/202

SHEET TITLE:
**DAVIS ROCK
DRIVE PLAN &
PROFILE**

SHEET NO.:
CS-240

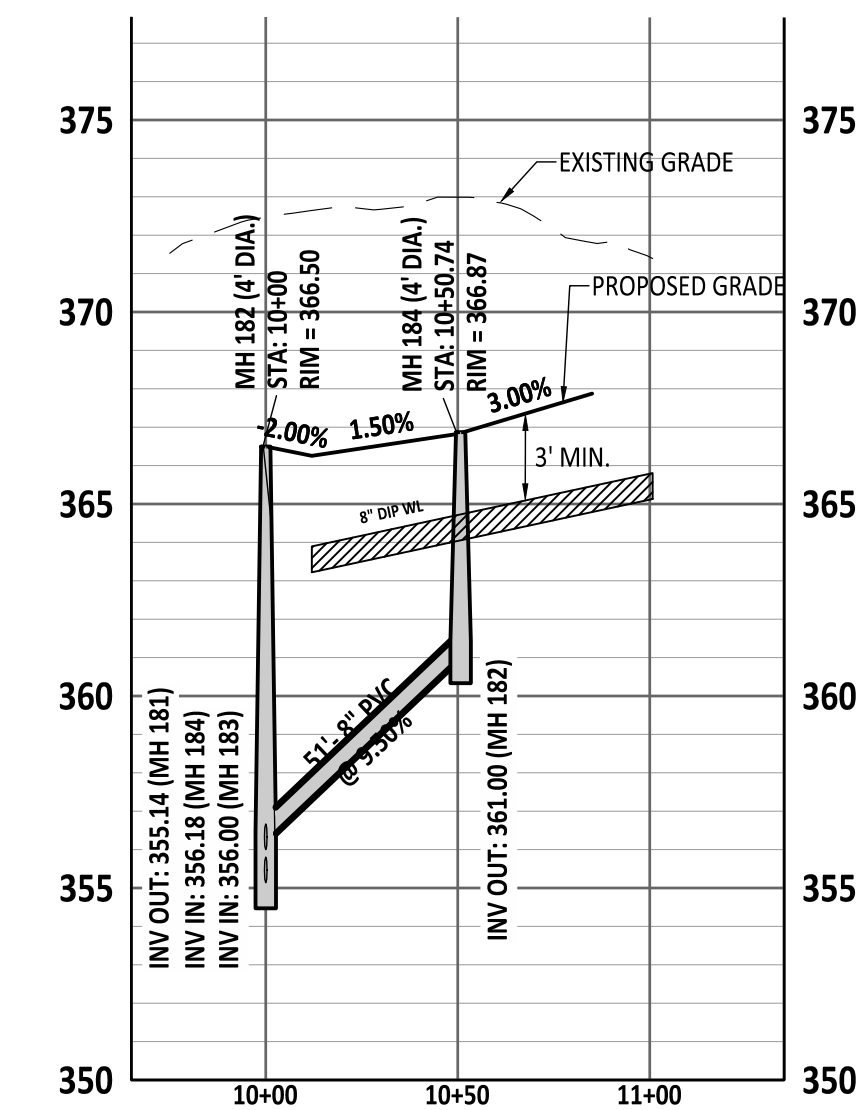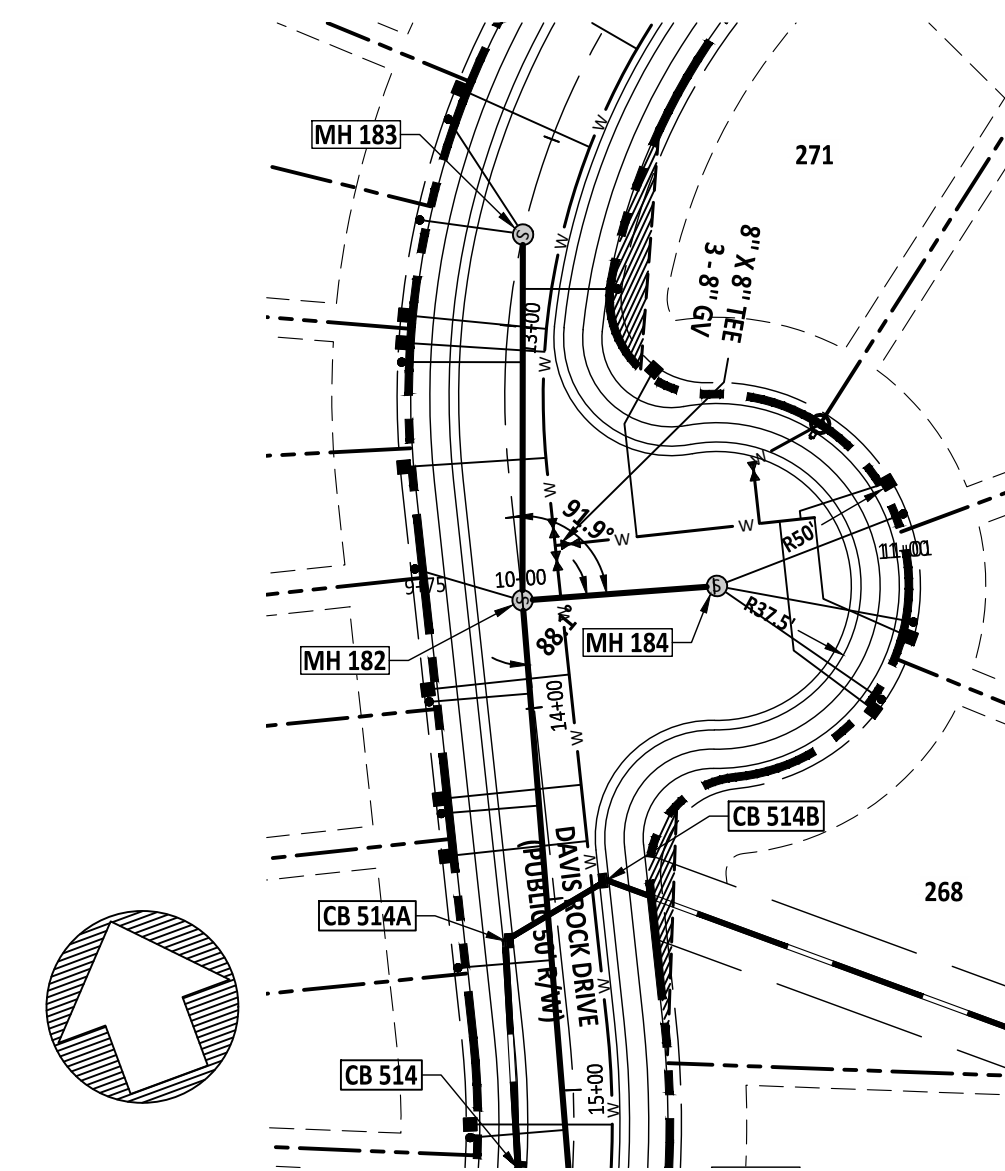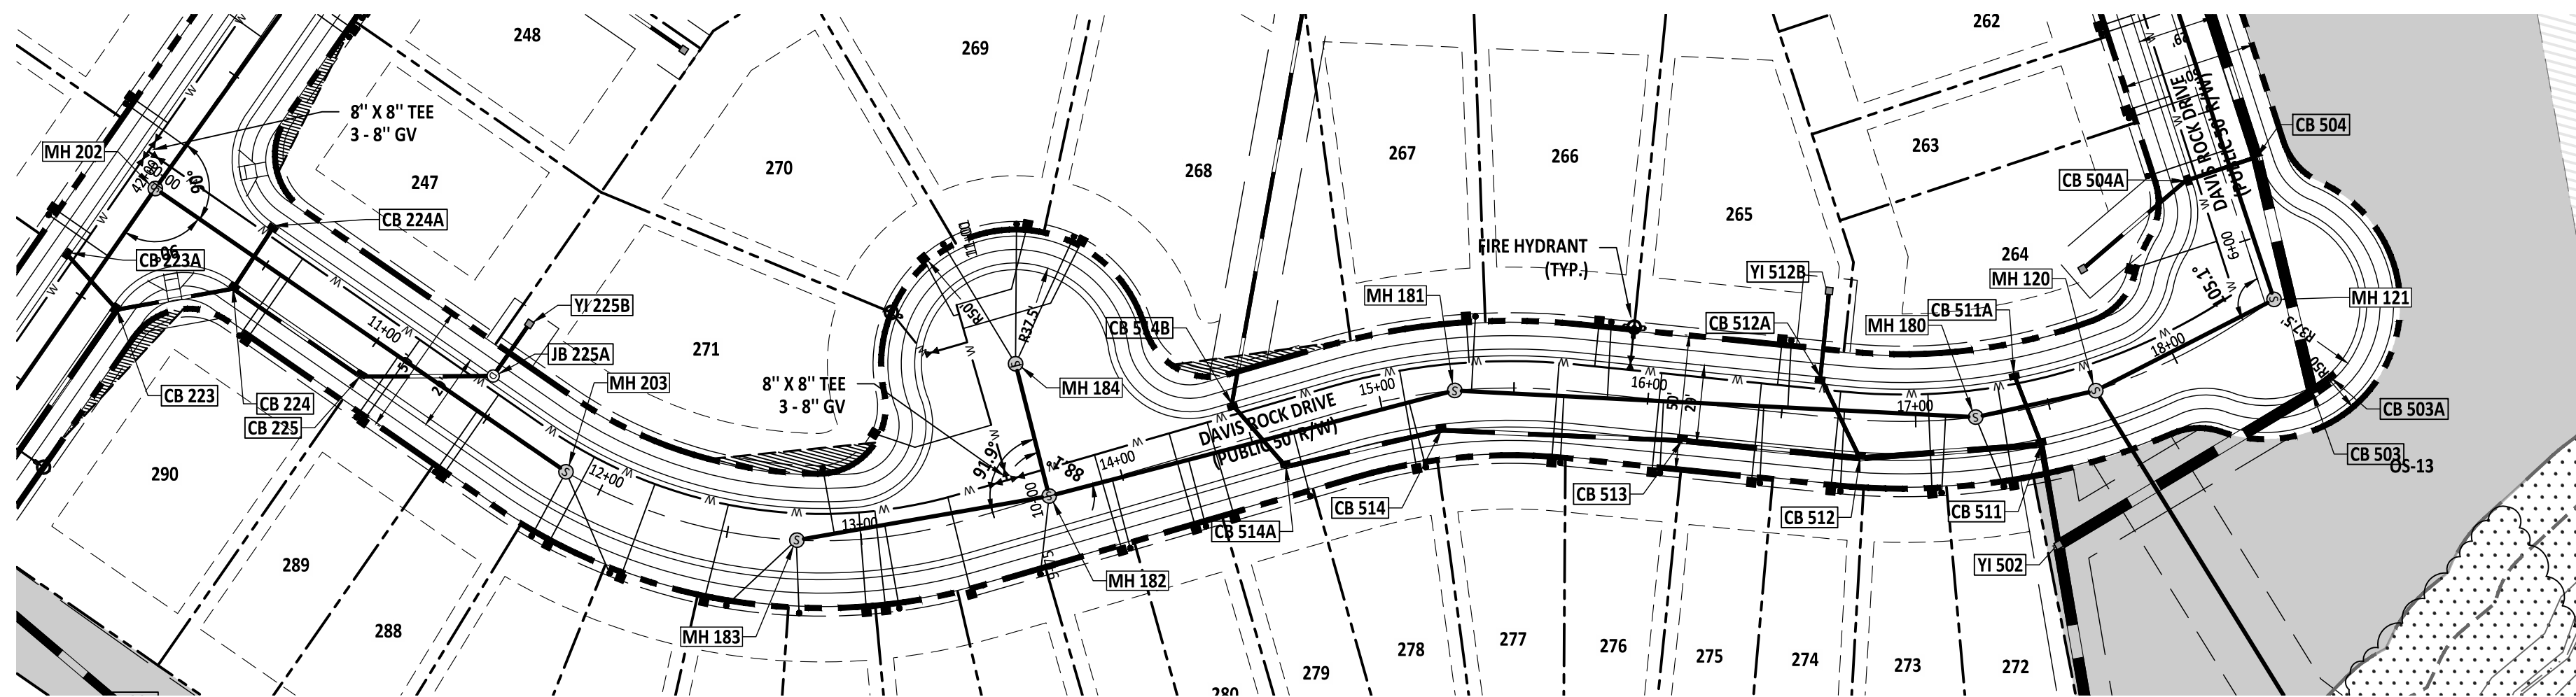

DAVIS ROCK DRIVE PLAN & PROFILE

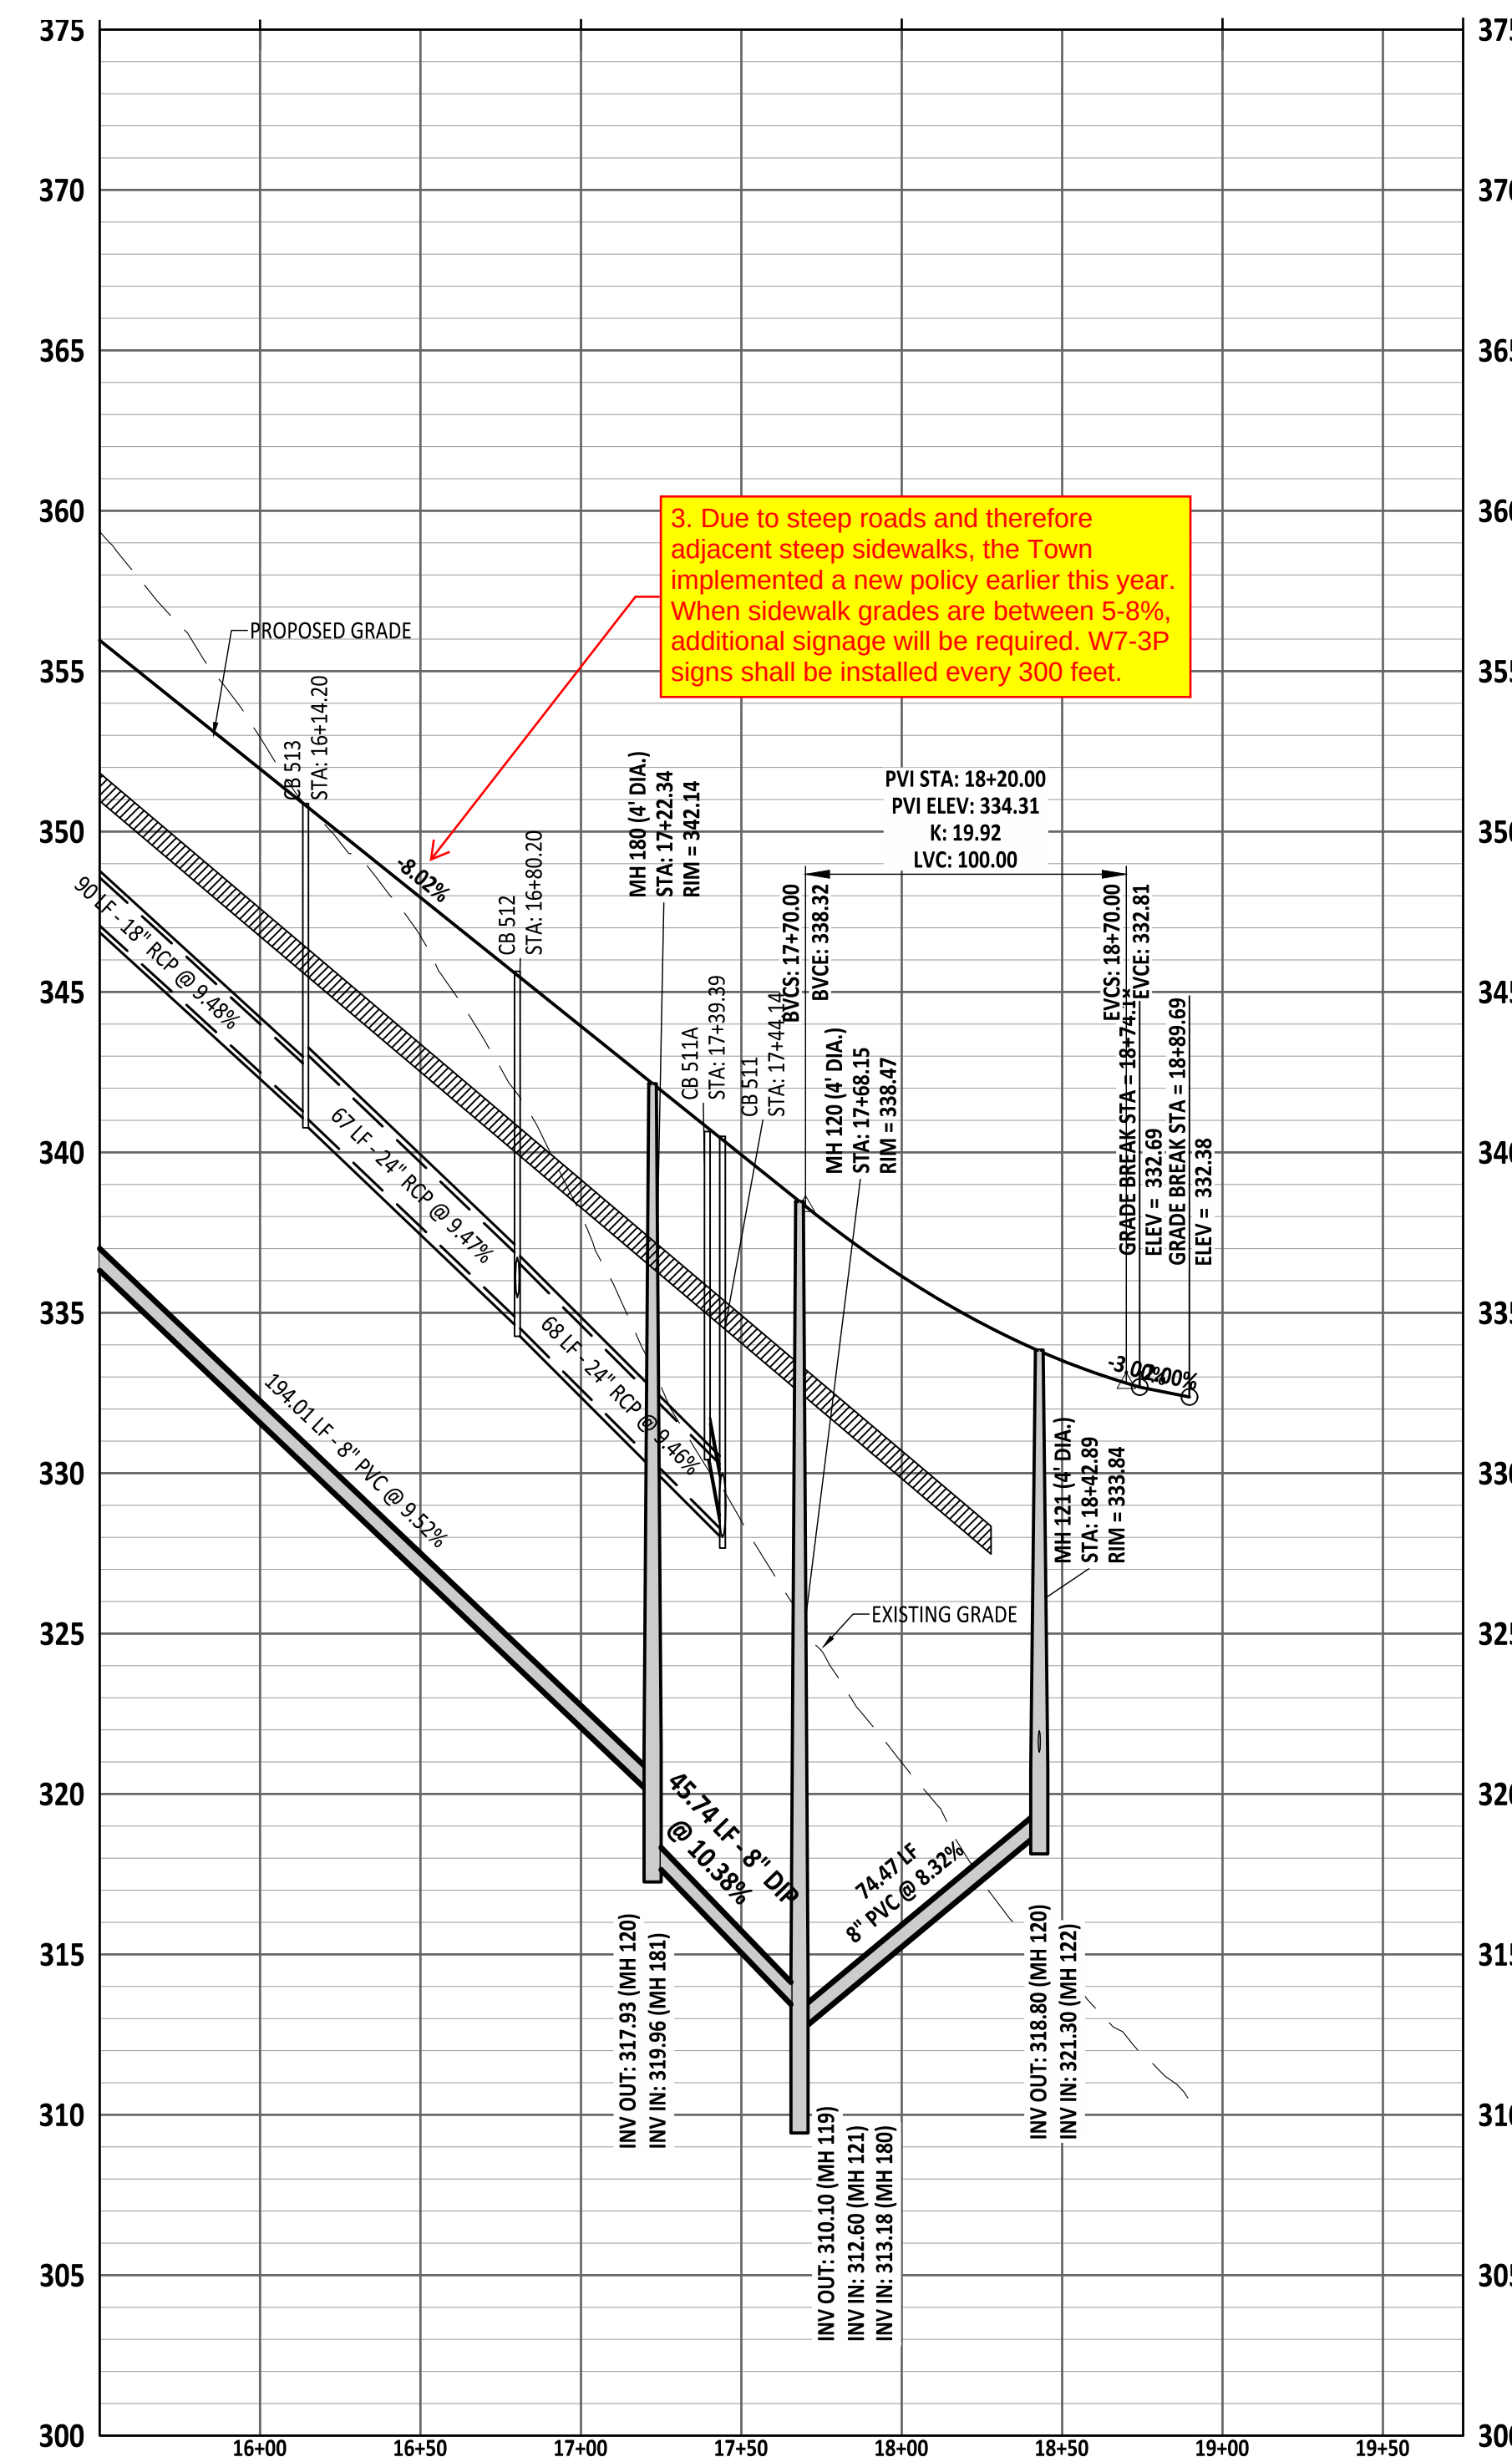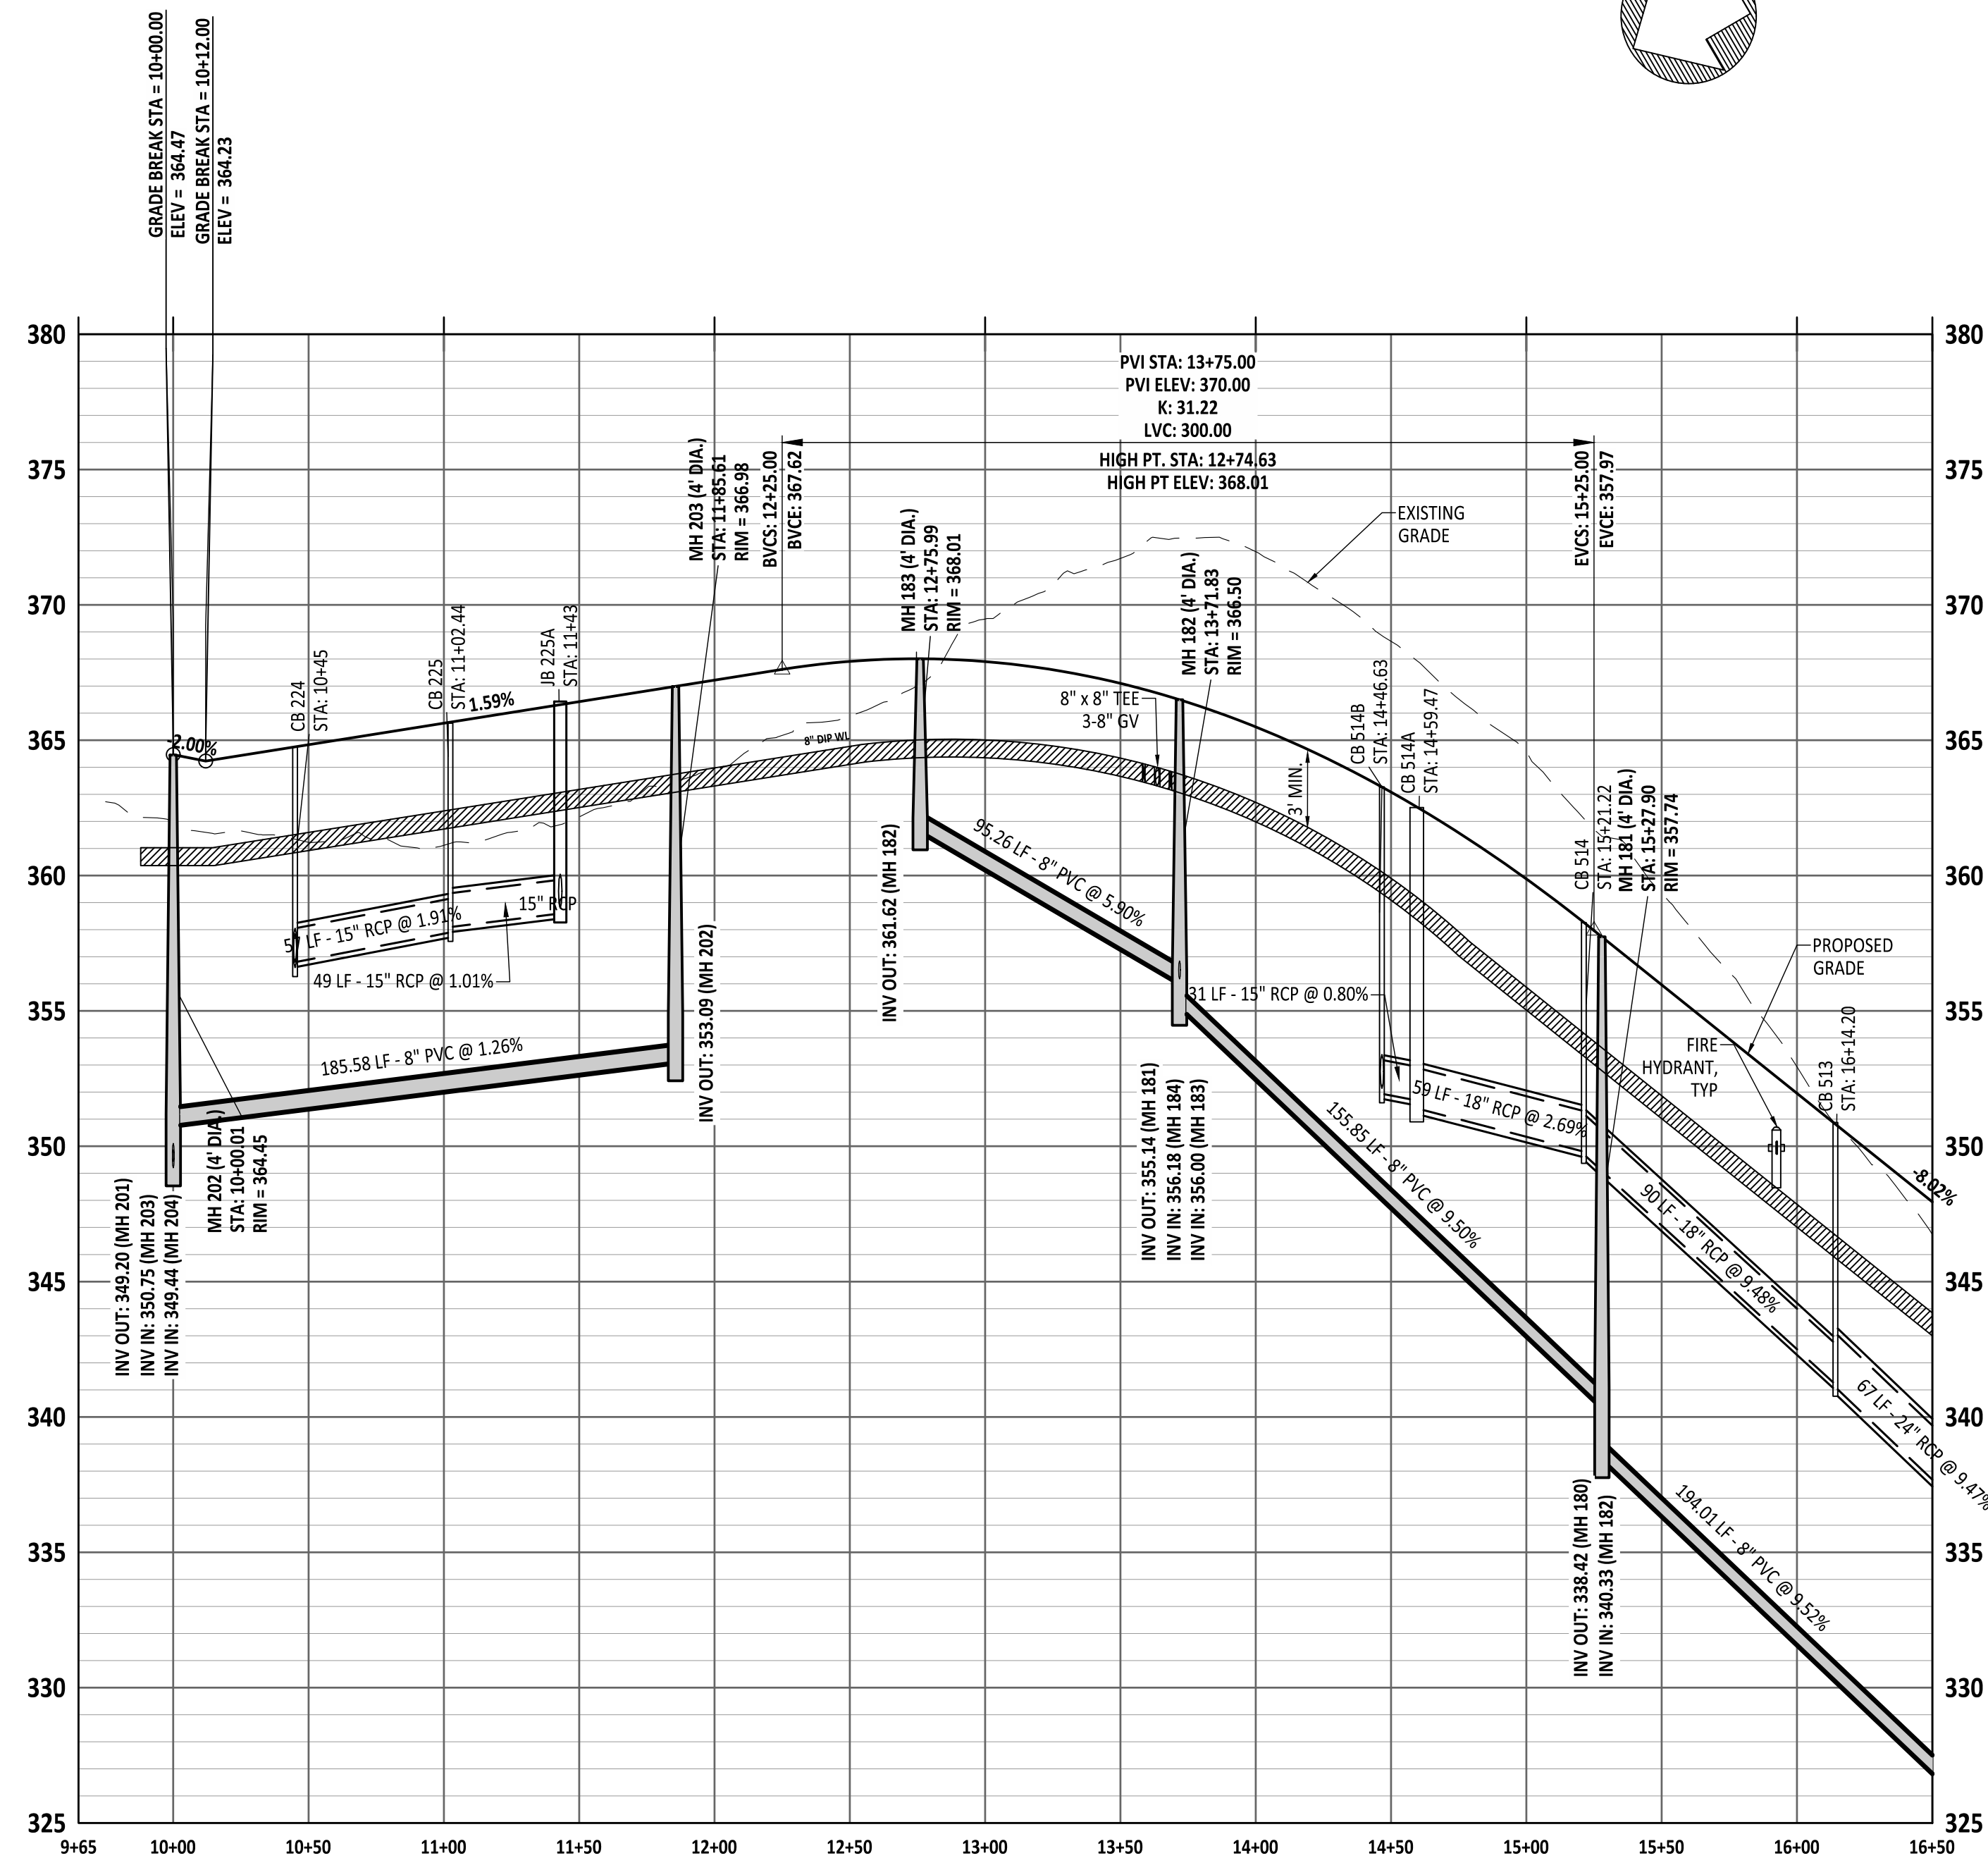

3. Due to steep roads and therefore adjacent steep sidewalks, the Town implemented a new policy earlier this year. When sidewalk grades are between 5-8%, additional signage will be required. W7-3P signs shall be installed every 300 feet.

Public
Sewer Collection / Extension System

The City of Raleigh consents to the connection and extension of the City's public sewer system as shown on this plan. The material and Construction methods used for this project shall conform to the standards and specifications of the City's Public Utilities Handbook.

City of Raleigh
Public Utilities Department Permit # _____

Public
Water Distribution / Extension System

The City of Raleigh consents to the connection and extension of the City's public water system as shown on this plan. The material and Construction methods used for this project shall conform to the standards and specifications of the City's Public Utilities Handbook.

City of Raleigh
Public Utilities Department Permit # _____



AMERICAN
Engineering

American Engineering Associates - Southeast, P.A.
4020 Westchase Boulevard, Suite 450
Raleigh, NC 27607 919-469-1101

NORTH CAROLINA
 AMERICAN
 ENGINEERING
 ASSOCIATES
 SOUTHEAST
 C-3881
 STATE OF NORTH CAROLINA
 ENGINEER
 JOSEPH P. KLEI

[illegible]

STIPULATION FOR REUSE

THIS DRAWING WAS PREPARED FOR USE ON THE SPECIFIC SITE, NAMED HEREON, CONTEMPORANEOUSLY WITH ITS ISSUE DATE AS LISTED, HEREON, AND IT IS NOT SUITABLE FOR USE ON A DIFFERENT PROJECT SITE OR AT A LATER TIME. USE OF THIS DRAWING FOR REFERENCE OR EXAMPLE ON ANOTHER PROJECT REQUIRES THE SERVICES OF PROPERLY LICENSED ARCHITECTS AND ENGINEERS. REPRODUCTION OF THIS DRAWING FOR REUSE ON ANOTHER PROJECT IS NOT AUTHORIZED AND MAY BE CONTRARY TO THE LAW.

**MERRITT RESERVE
DAVIS ROCK DRIVE PLAN
& PROFILE
ROLESVILLE RD
WAKE COUNTY NC 27312**

JOB NUMBER:	23-0004
CHECKED BY:	JK
DRAWN BY:	DH/MA/LL
DATE:	08/04/2025


DAVIS ROCK DRIVE PLAN & PROFILE

SHEET NO.: **CS-242**





North 811
Carolina
www.nc811.org

*** 3 Days Before Digging ***
North Carolina 811
811 or 1-800-632-4949
Remote Ticket Entry
<http://nc811.org/remoteticketentry.htm>


PROJECT NUMBER = CID-25-02

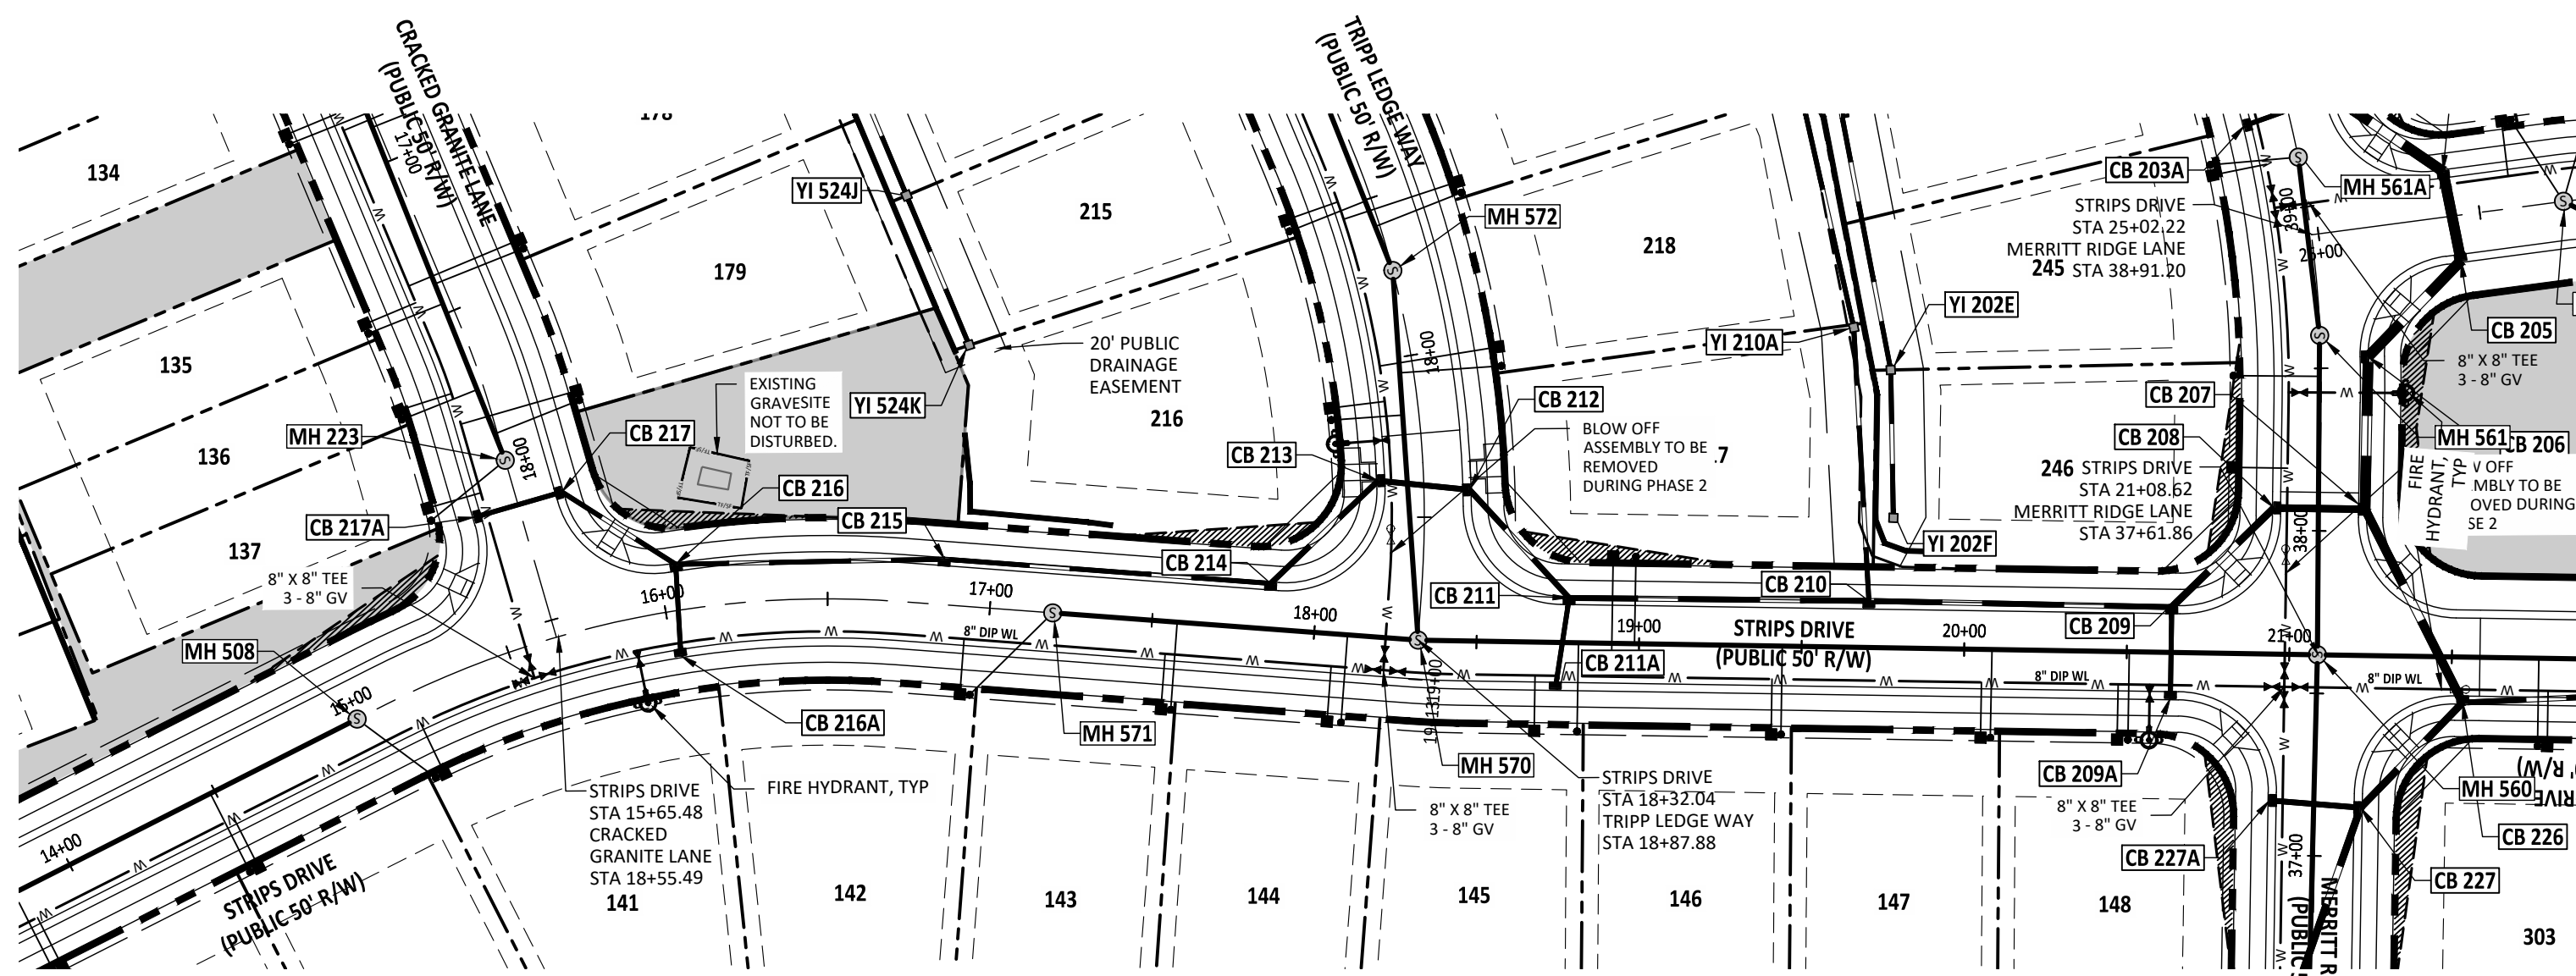

STRIPS DRIVE PLAN & PROFILE

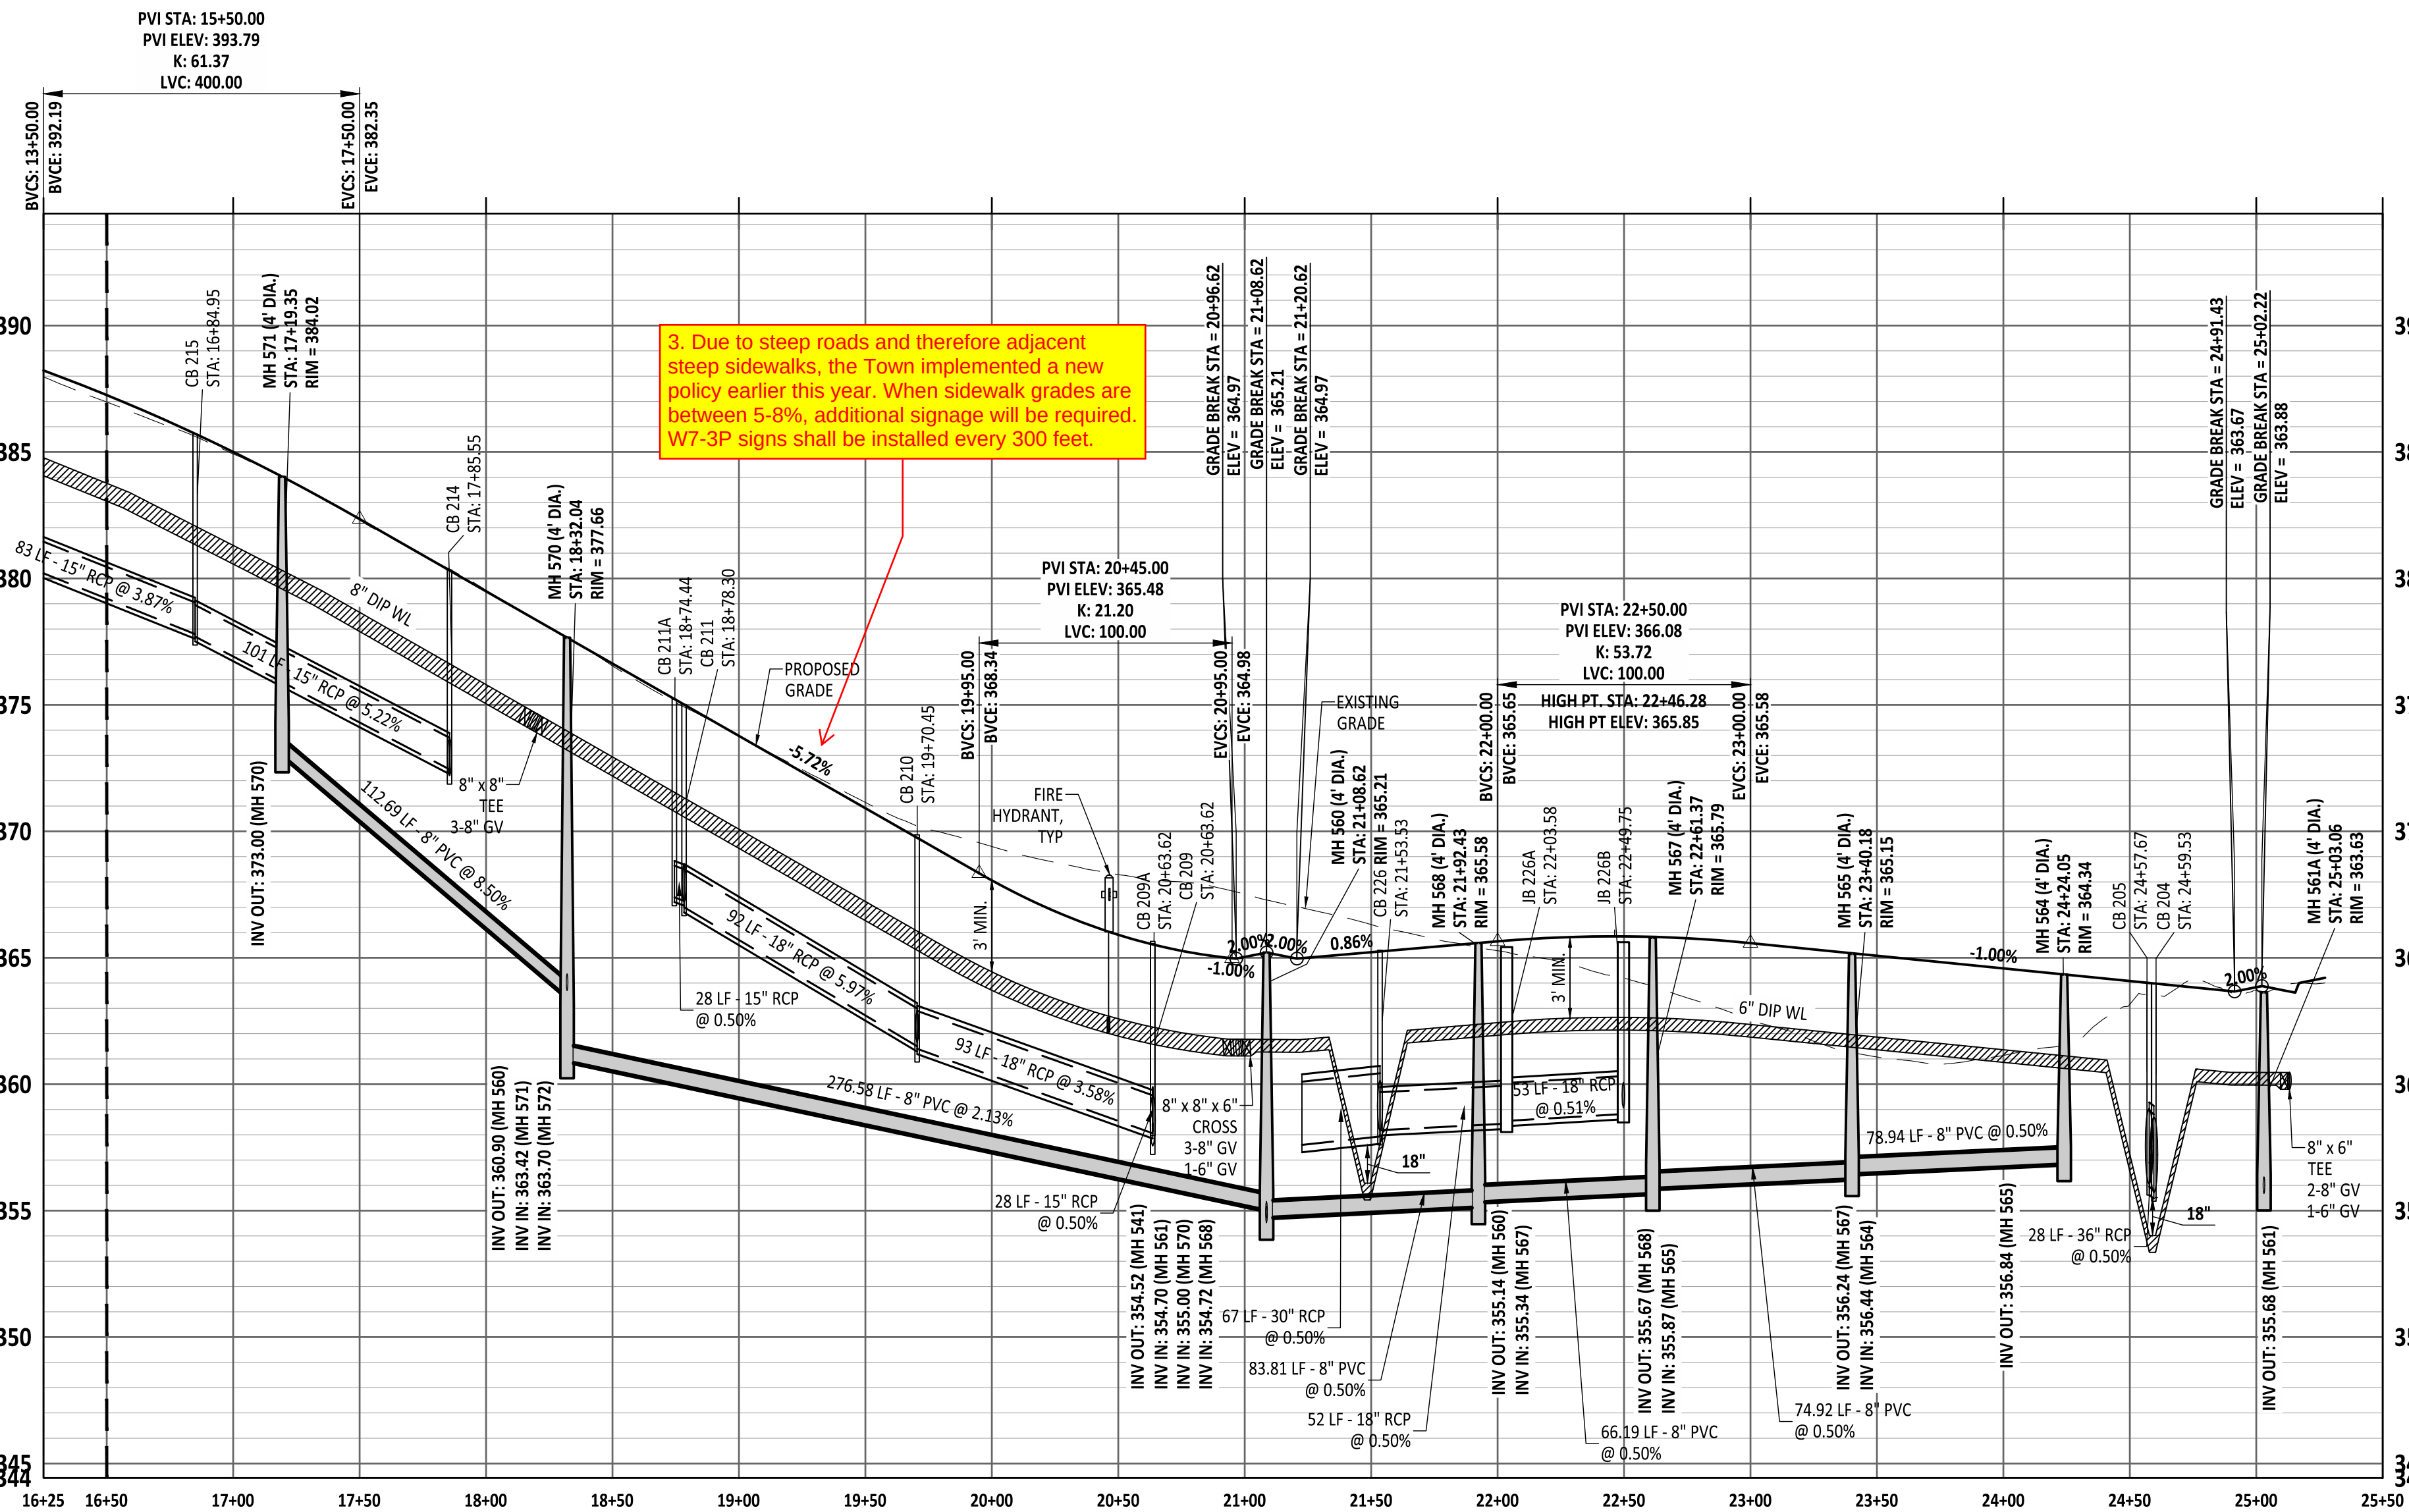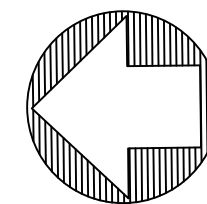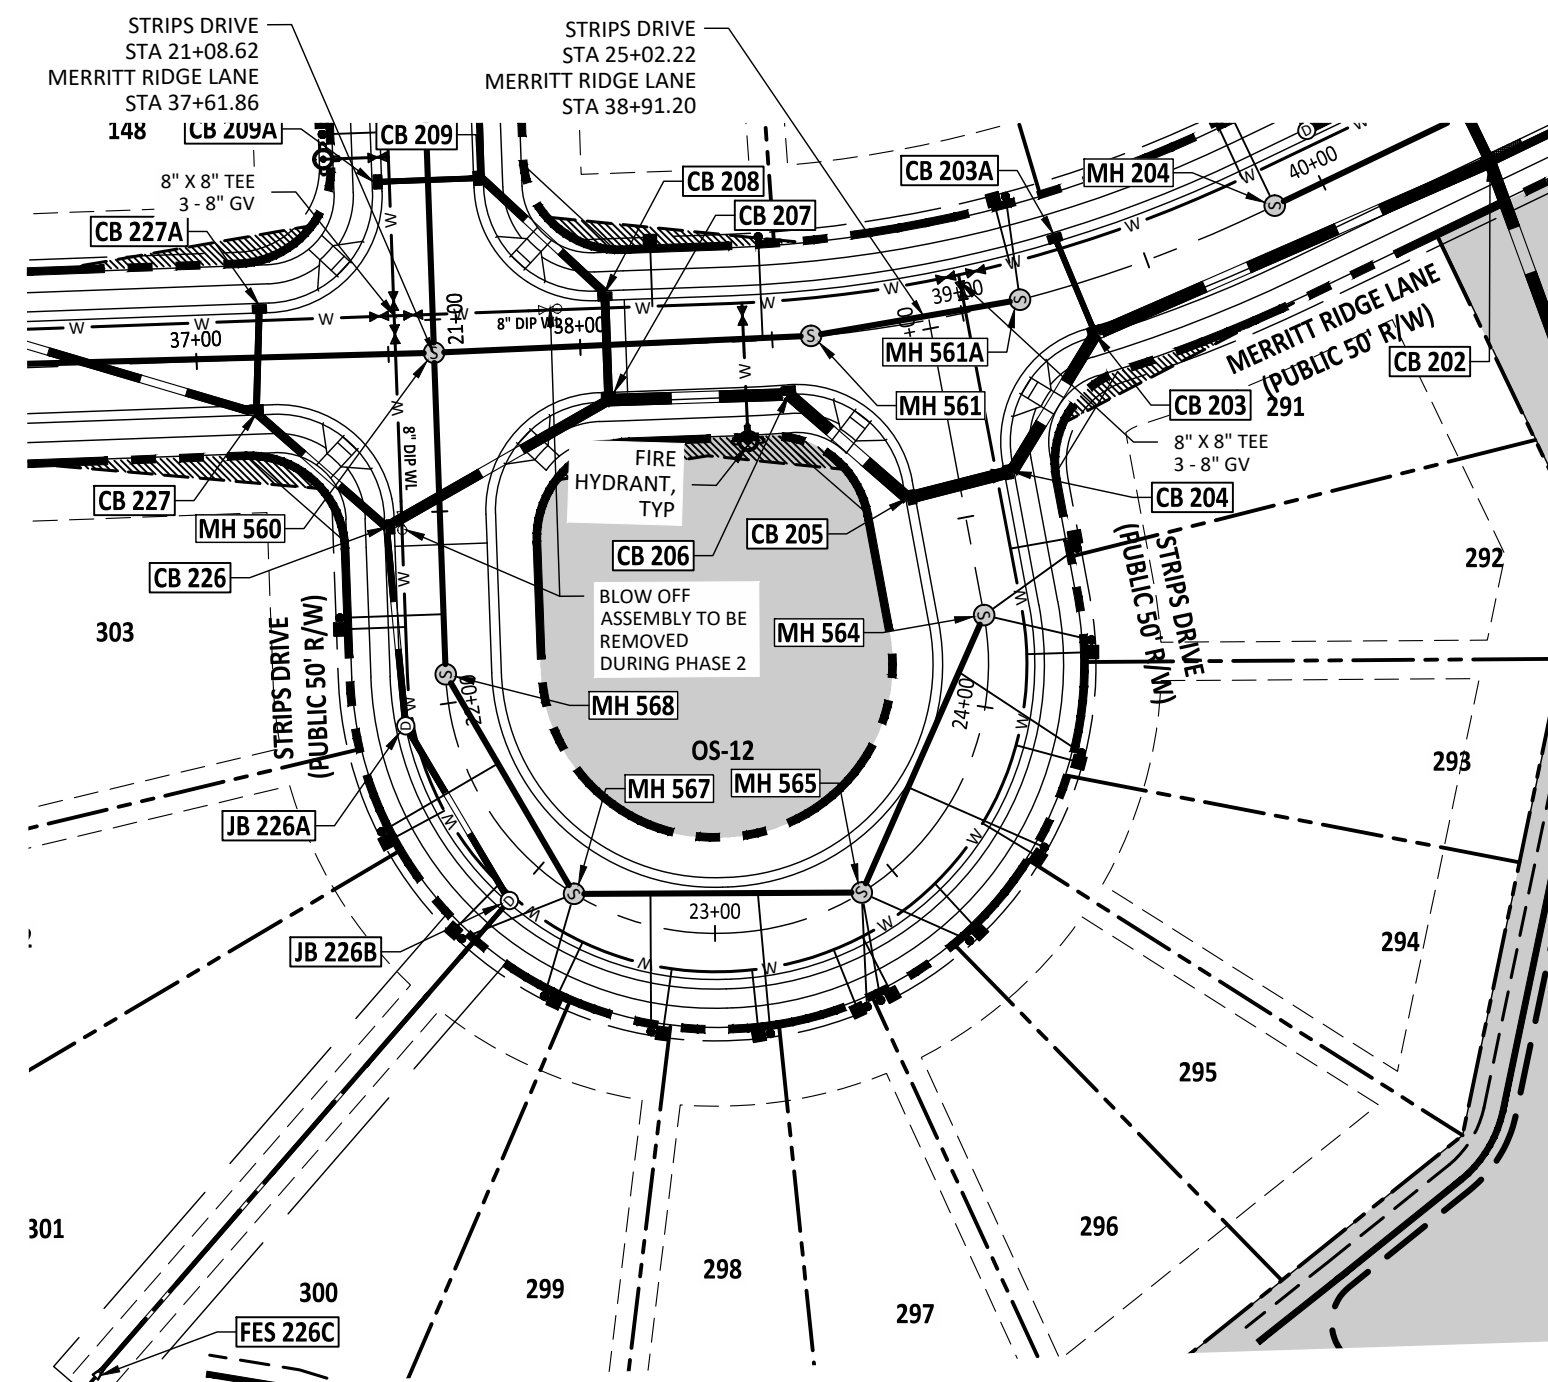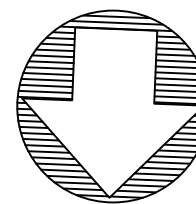

GRAPHIC SCALE

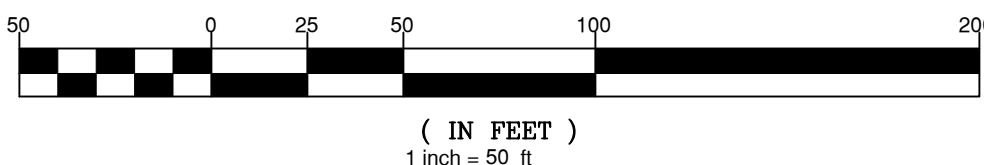

3. Due to steep roads and therefore adjacent steep sidewalks, the Town implemented a new policy earlier this year. When sidewalk grades are between 5-8%, additional signage will be required. W7-3P signs shall be installed every 300 feet.

Public
Sewer Collection / Extension System

The City of Raleigh consents to the connection and extension of the City's public sewer system as shown on this plan. The material and Construction methods used for this project shall conform to the standards and specifications of the City's Public Utilities Handbook.

City of Raleigh
Public Utilities Department Permit #

Public
Water Distribution / Extension System

The City of Raleigh consents to the connection and extension of the City's public water system as shown on this plan. The material and Construction methods used for this project shall conform to the standards and specifications of the City's Public Utilities Handbook.

City of Raleigh
Public Utilities Department Permit #

North Carolina
811
*** 3 Days Before Digging ***
North Carolina 811
811 or 1-800-632-4949
Remote Ticket Entry
<http://nc811.org/remoteticketentry.htm>

AMERICAN
Engineering

American Engineering Associates - Southeast, P.A.
4020 Westchase Boulevard, Suite 450
Raleigh, NC 27607
919-469-1101

PRELIMINARY
PRELIMINARY
DO NOT USE FOR
CONSTRUCTION

FOR INFORMATION, ONLY

NO.	DATE	REVISION:
1	07/01/25	FIRST REVISION SET
2	08/05/25	SECOND WAKE COUNTY SUBMITTAL

STIPULATION FOR REUSE

THIS DRAWING WAS PREPARED FOR USE ON THE SPECIFIC SITE, NAMED HEREIN, CONTEMPORANEOUSLY WITH ITS ISSUE DATE AS LISTED, HEREON, AND IT IS NOT SUITABLE FOR USE ON A DIFFERENT PROJECT SITE OR AT A LATER TIME. USE OF THIS DRAWING FOR REFERENCE OR EXAMPLE ON ANOTHER PROJECT REQUIRES THE SERVICES OF PROPERLY LICENSED ARCHITECTS AND ENGINEERS. REPRODUCTION OF THIS DRAWING FOR REUSE ON ANOTHER PROJECT IS NOT AUTHORIZED AND MAY BE CONTRARY TO THE LAW.

MERRITT RESERVE

STRIPS DR PLAN & PROFILE

ROLESVILLE RD

WAKE COUNTY NC 27312

JOB NUMBER: 23-0004

CHECKED BY: JK


DRAWN BY: DH/MA/LL

DATE: 08/04/2025

SHEET TITLE:

STRIPS DR
PLAN &
PROFILE

SHEET NO.: **CS-261**

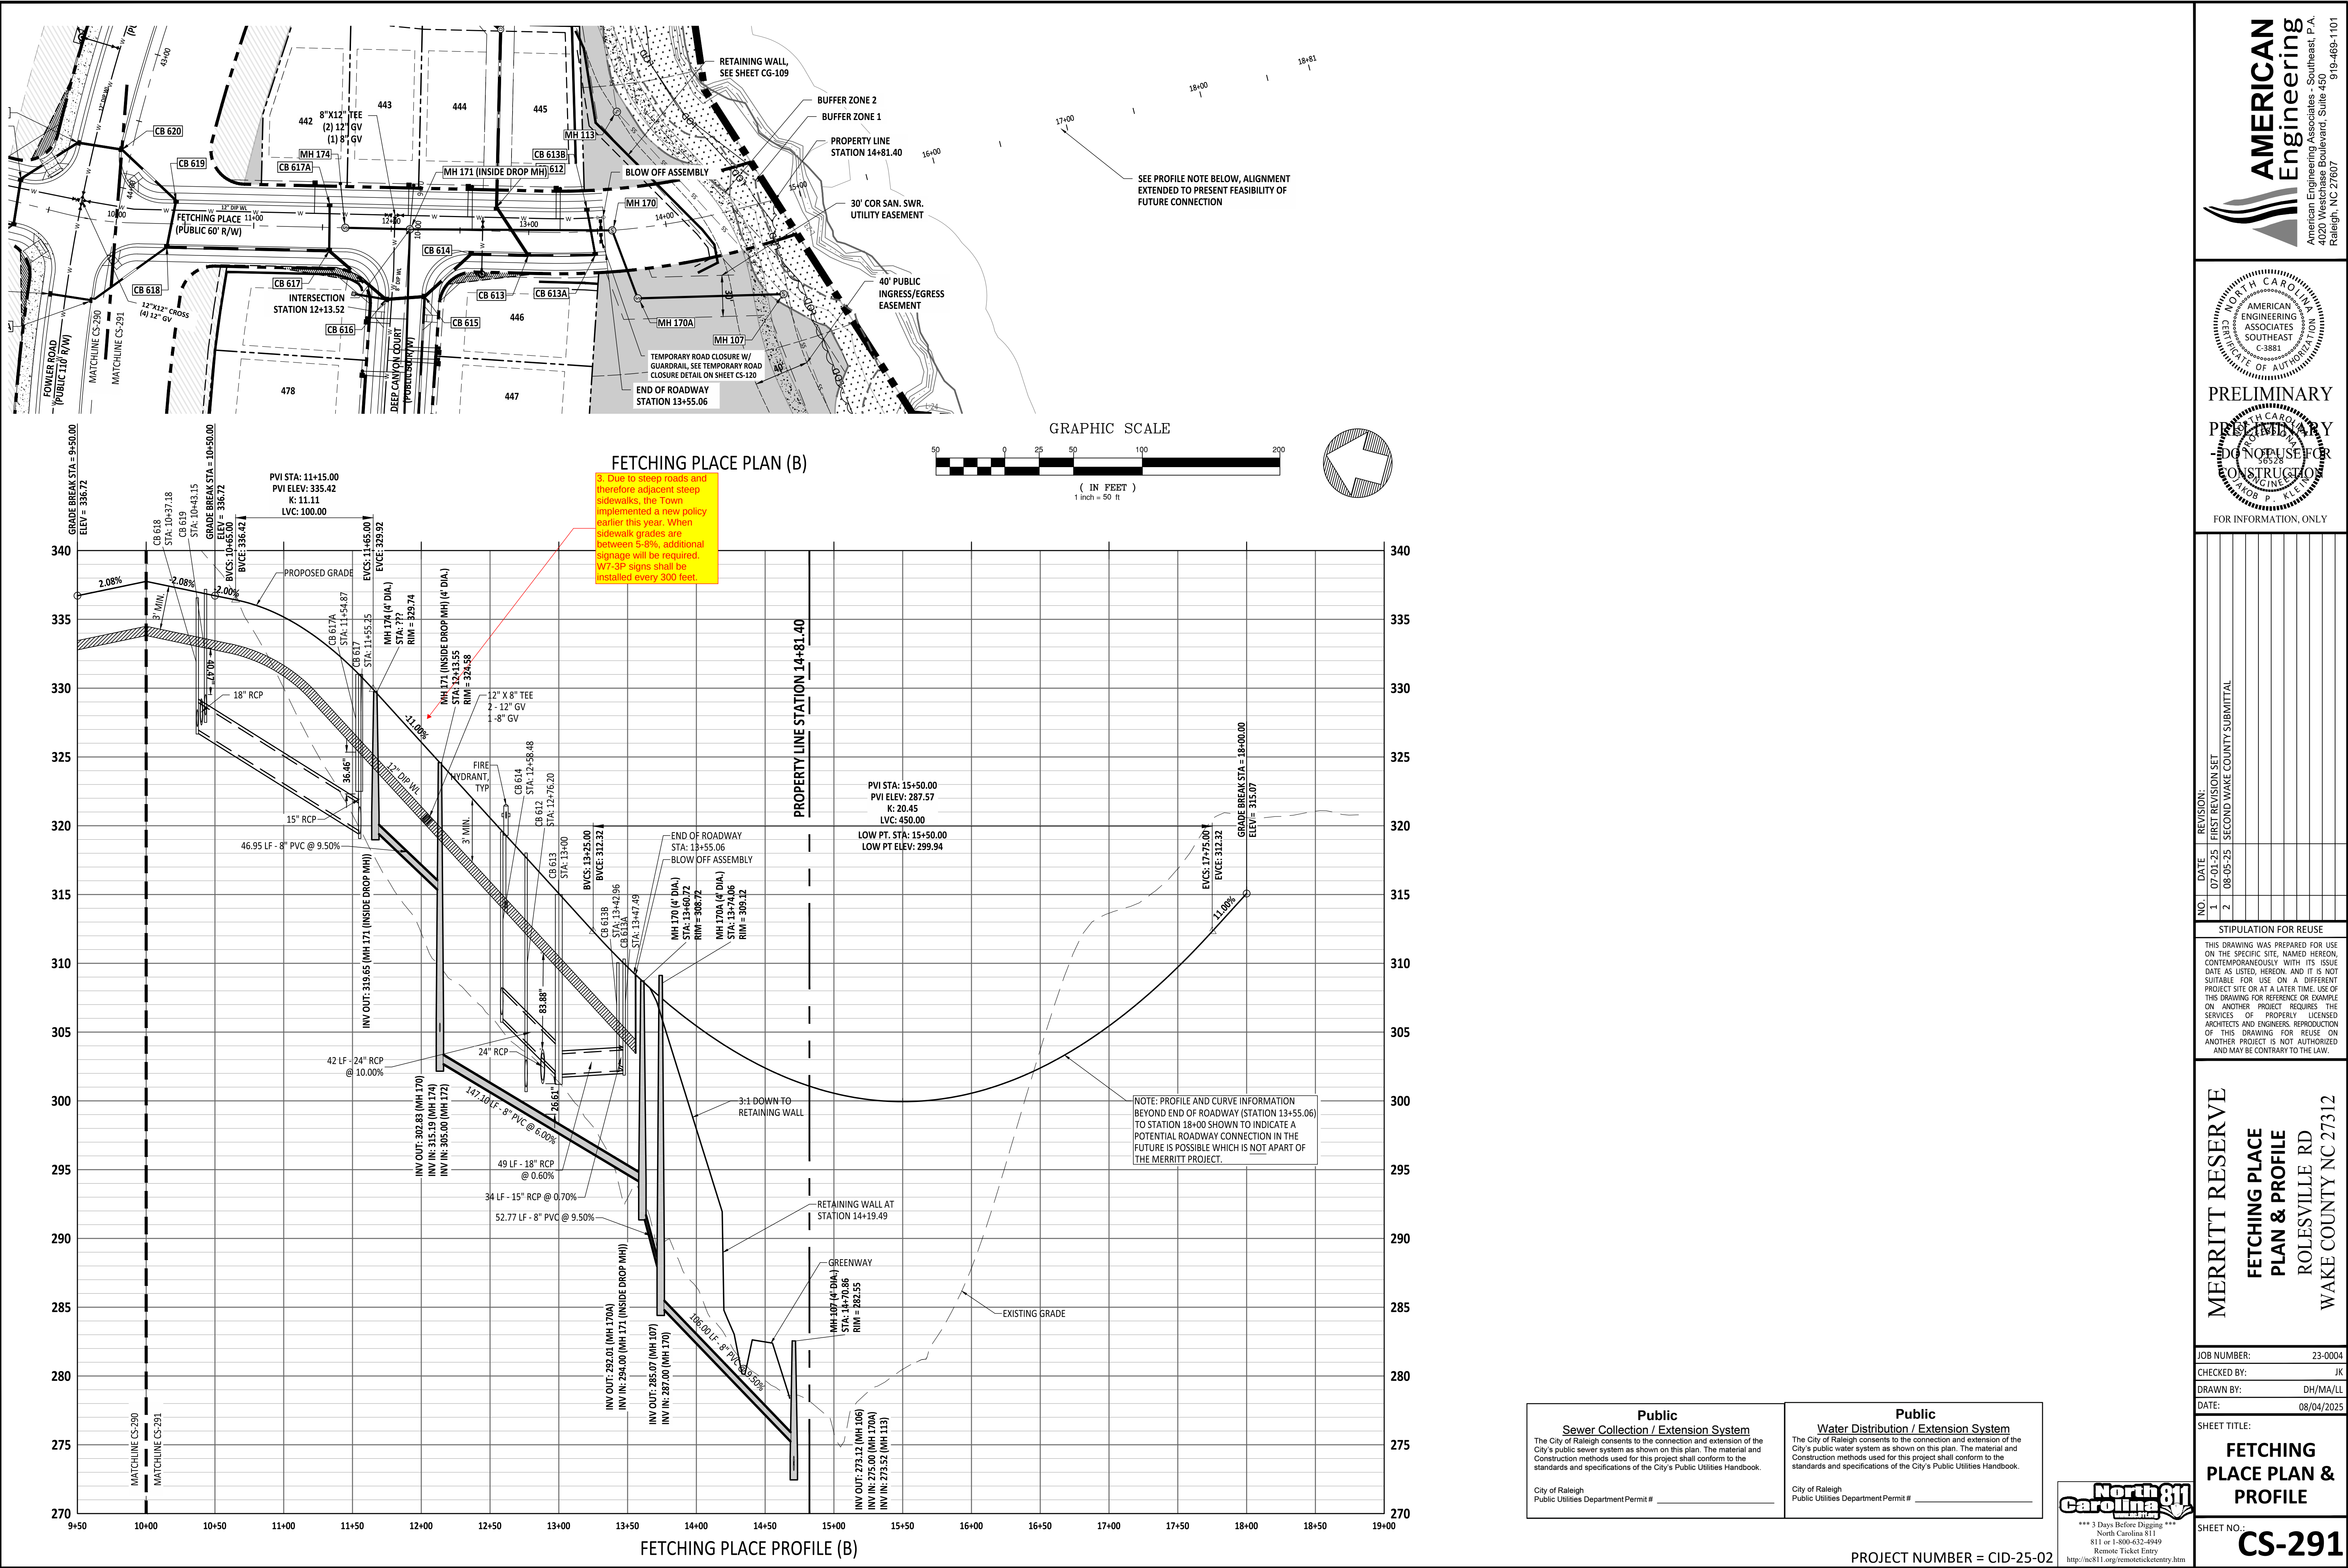

NO.	DATE	REVISION:
1	07/01/25	FIRST REVISION SET
2	08/05/25	SECOND WAKE COUNTY SUBMITTAL

STIPULATION FOR REUSE


THIS DRAWING WAS PREPARED FOR USE ON THE SPECIFIC SITE, NAMED HEREON, CONTEMPORANEOUSLY WITH ITS ISSUE DATE AS LISTED, HEREON, AND IT IS NOT SUITABLE FOR USE ON A DIFFERENT PROJECT SITE OR AT A LATER TIME. USE OF THIS DRAWING FOR REFERENCE OR EXAMPLE ON ANOTHER PROJECT REQUIRES THE SERVICES OF PROPERLY LICENSED ARCHITECTS AND ENGINEERS. REPRODUCTION OF THIS DRAWING FOR REUSE ON ANOTHER PROJECT IS NOT AUTHORIZED AND MAY BE CONTRARY TO THE LAW.

MERRITT RESERVE
FETCHING PLACE
PLAN & PROFILE
ROLESVILLE RD
WAKE COUNTY NC 27312


JOB NUMBER: 23-0004
CHECKED BY: JK
DRAWN BY: DH/MA/LL
DATE: 08/04/2025

SHEET TITLE:
**FETCHING
PLACE PLAN &
PROFILE**

SHEET NO.:
CS-291

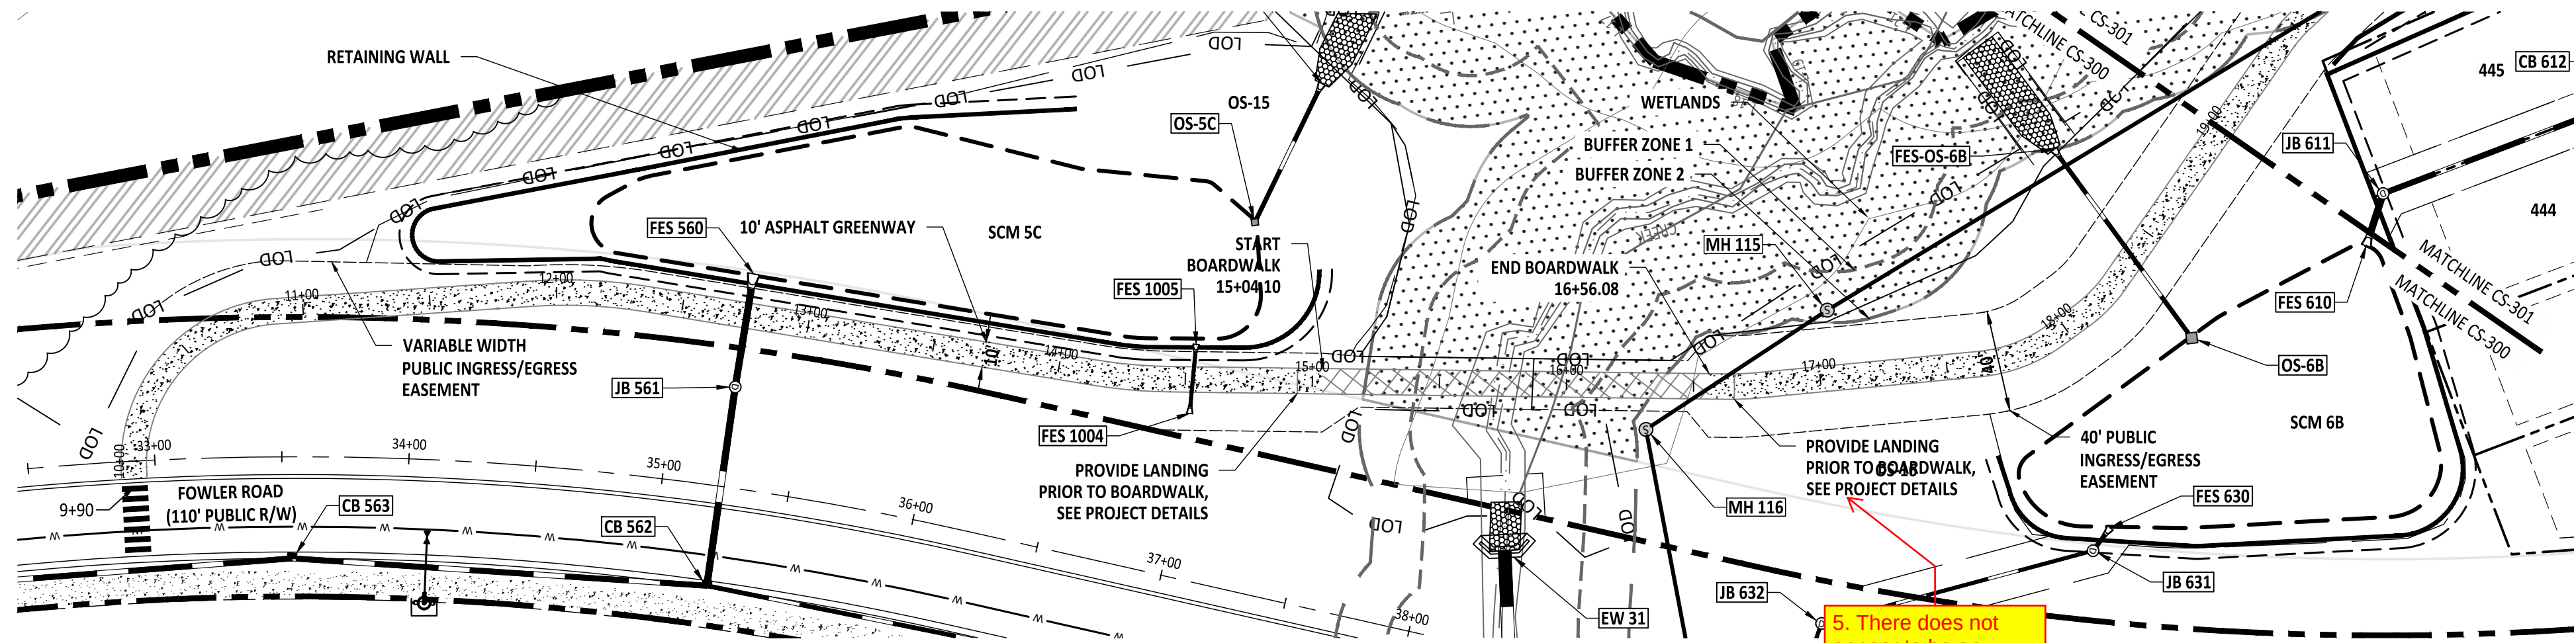

GREENWAY PLAN (A)

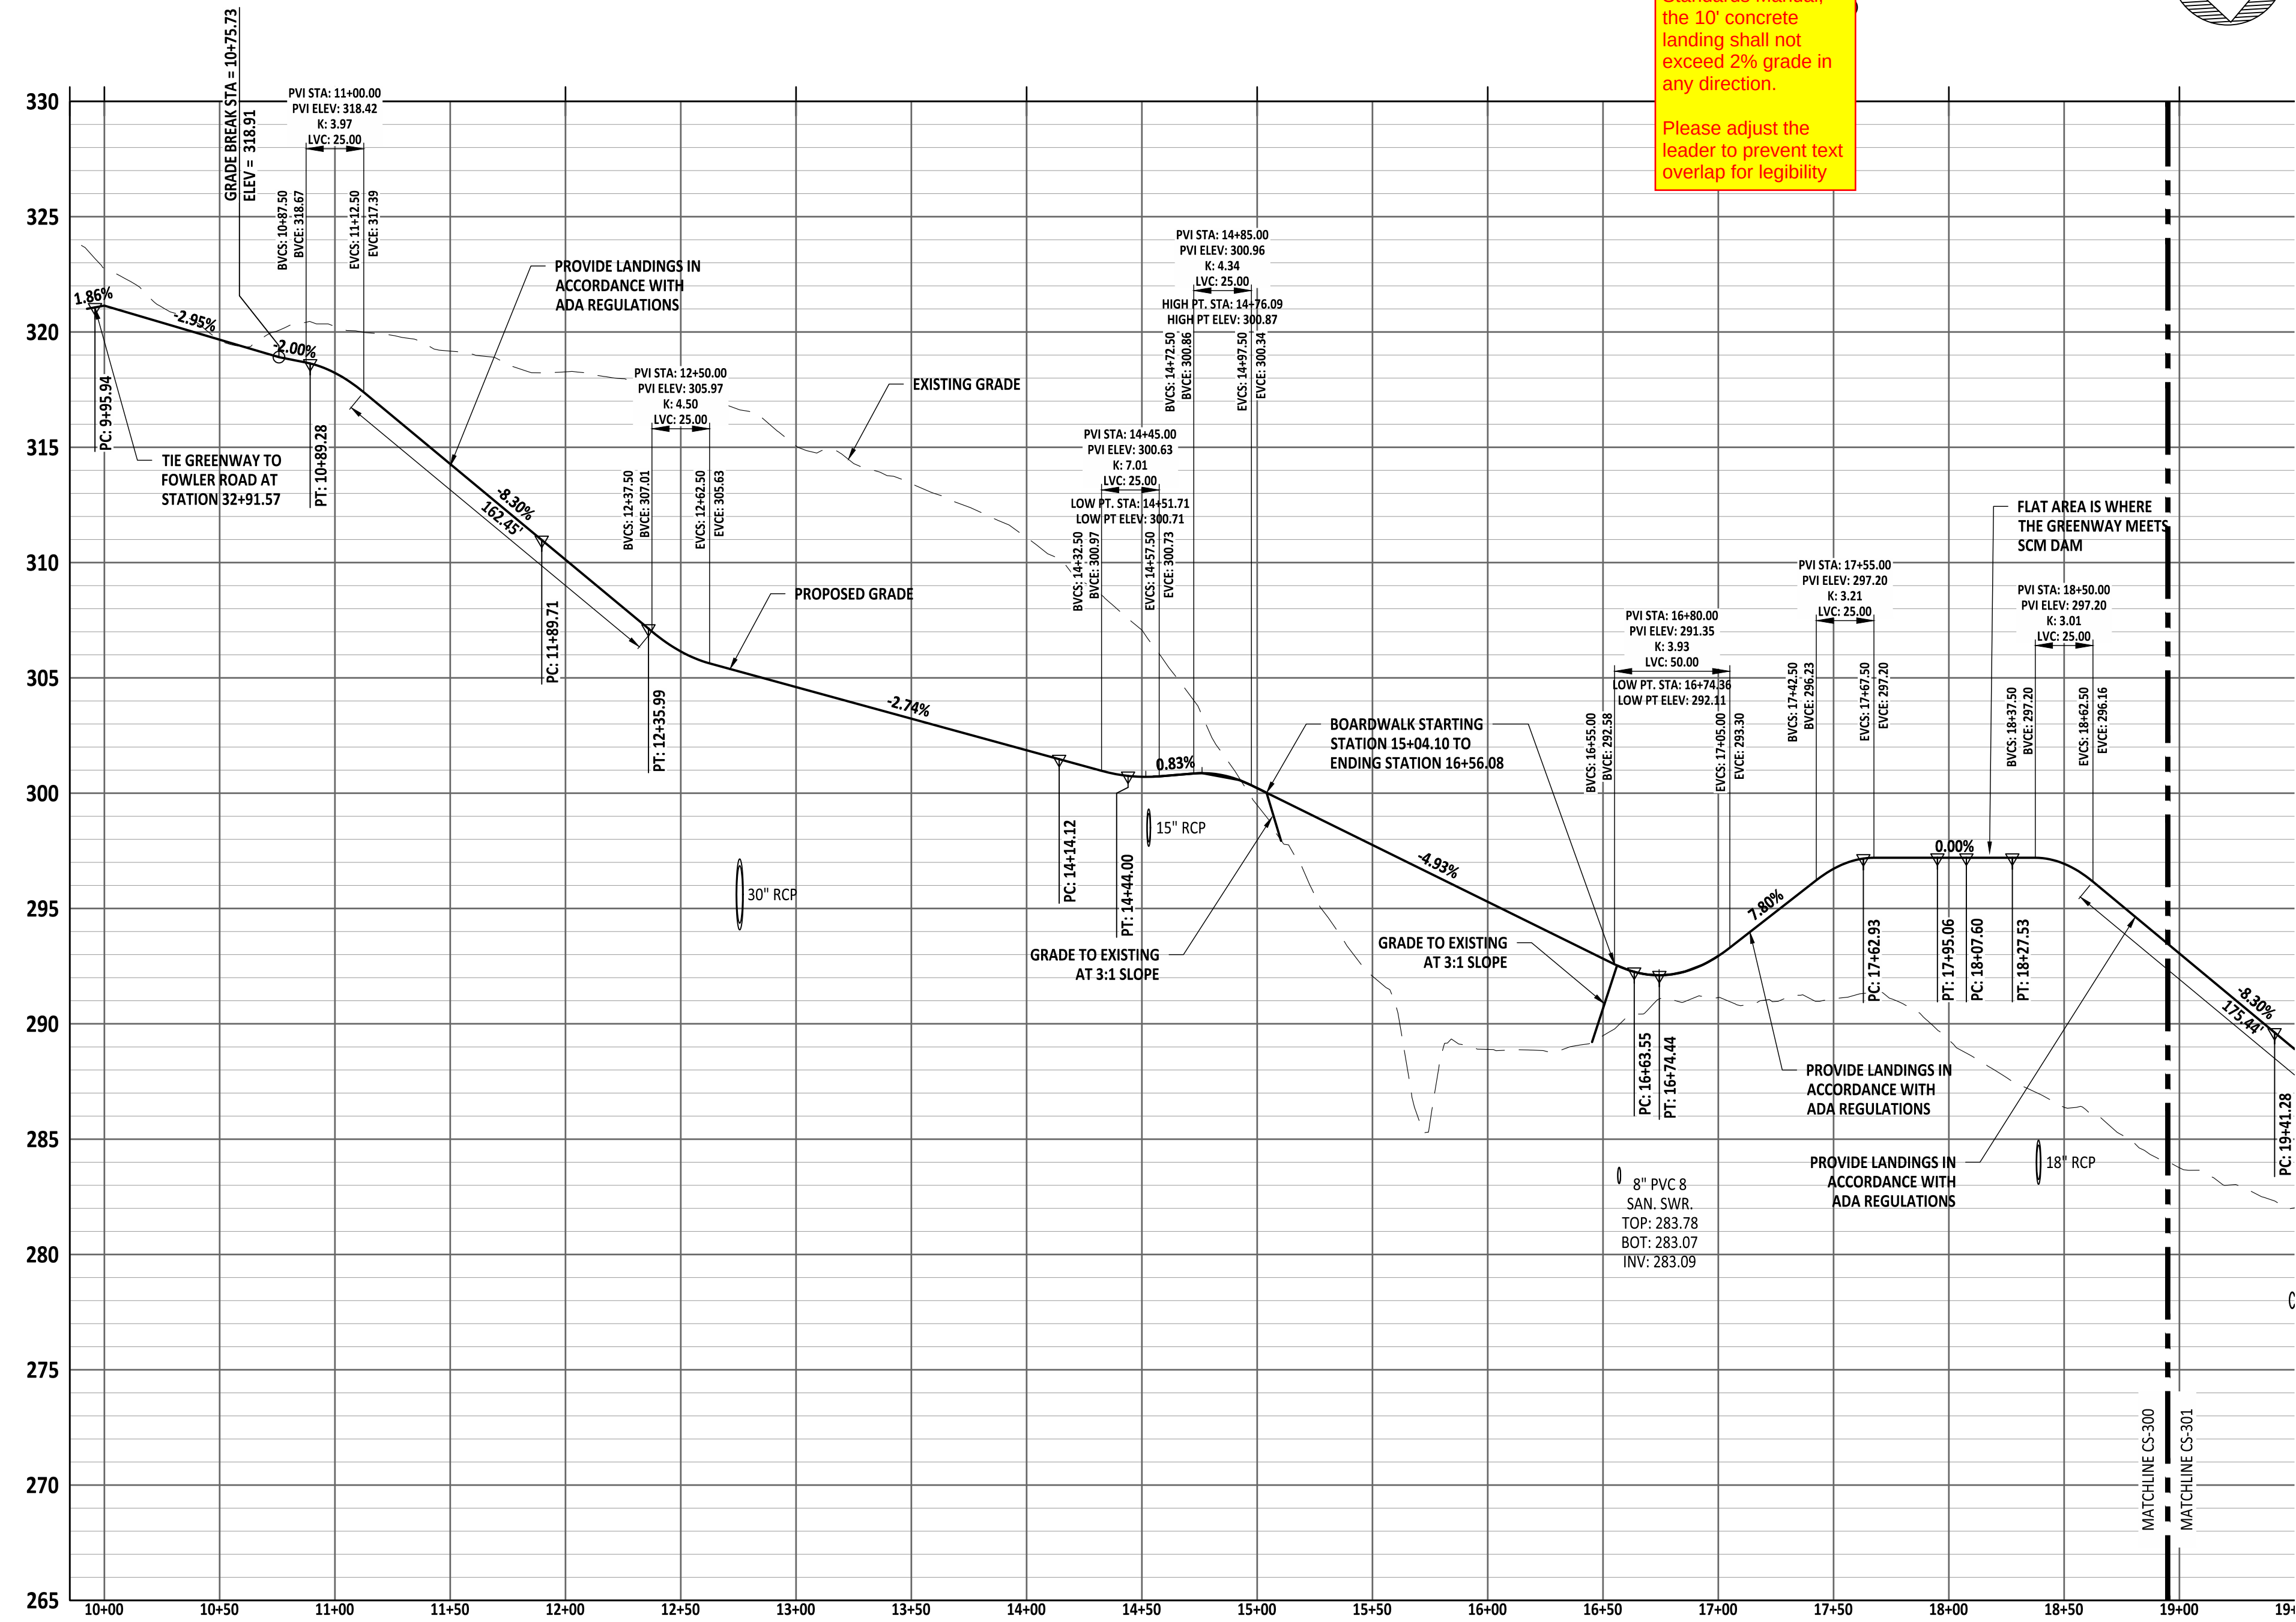

GREENWAY PROFILE (A)

5. There does not appear to be any details that specify the requirements for the 10' landing that is required. Per the Standards Manual, the 10' concrete landing shall not exceed 2% grade in any direction.

Please adjust the leader to prevent text overlap for legibility


NOTES

- GREENWAYS SHALL BE CONSTRUCTED WITH EITHER ASPHALT OR CONCRETE PAVEMENT.
 - WHEN USING ASPHALT, A 2-INCH MINIMUM ASPHALT COURSE, TYPE S9.5B, WITH A 6-INCH AGGREGATE BASE COURSE SHALL BE PROVIDED.
 - WHEN CONCRETE IS USED, A 4-INCH MINIMUM PORTLAND CEMENT CONCRETE (PCC) WITH A 6-INCH AGGREGATE BASE COURSE SHALL BE PROVIDED.
- REGARDLESS OF MATERIAL, GEOTEXTILE STABILIZATION FABRIC SHALL BE PLACED UNDER THE COMPACTED AGGREGATE BASE COURSE (ABC) THE ENTIRE LENGTH AND WIDTH OF THE GREENWAY.

Public Sewer Collection / Extension System The City of Raleigh consents to the connection and extension of the City's public sewer system as shown on this plan. The material and construction methods used for this project shall conform to the standards and specifications of the City's Public Utilities Handbook. City of Raleigh Public Utilities Department Permit # _____	Public Water Distribution / Extension System The City of Raleigh consents to the connection and extension of the City's public water system as shown on this plan. The material and construction methods used for this project shall conform to the standards and specifications of the City's Public Utilities Handbook. City of Raleigh Public Utilities Department Permit # _____
--	--



PROJECT NUMBER = CID-25-02

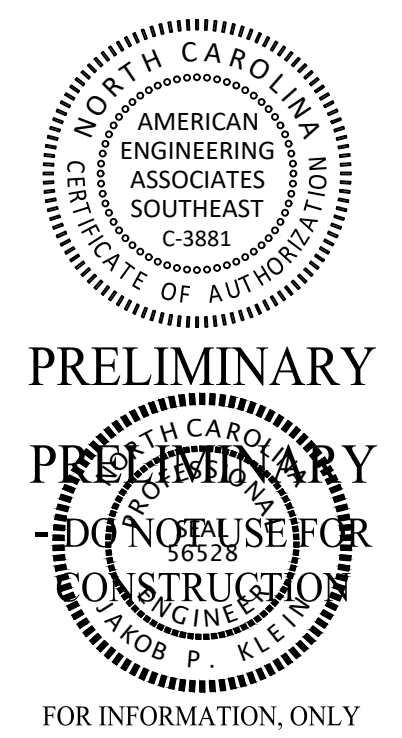

NO.	DATE	REVISION
1	07/01/25	FIRST REVISION SET
2	08/05/25	SECOND WAKE COUNTY SUBMITTAL

STIPULATION FOR REUSE

THIS DRAWING WAS PREPARED FOR USE ON THE SPECIFIC SITE, NAMED HEREON, CONTEMPORANEOUSLY WITH ITS ISSUE DATE AS LISTED, HEREON, AND IT IS NOT SUITABLE FOR USE ON A DIFFERENT PROJECT SITE OR AT A LATER TIME. USE OF THIS DRAWING FOR REFERENCE OR EXAMPLE ON ANOTHER PROJECT REQUIRES THE SERVICES OF PROPERLY LICENSED ARCHITECTS AND ENGINEERS. REPRODUCTION OF THIS DRAWING FOR REUSE ON ANOTHER PROJECT IS NOT AUTHORIZED AND MAY BE CONTRARY TO THE LAW.

MERRITT RESERVE









GREENWAY PLAN & PROFILE

ROLESVILLE RD


WAKE COUNTY NC 27312

JOB NUMBER:	23-0004
CHECKED BY:	JK
DRAWN BY:	DH/MA/LL
DATE:	08/04/2025
SHEET TITLE:	GREENWAY PLAN & PROFILE
SHEET NO.:	CS-300


Z:\06\13-0004 Merritt Property (BIO)DWG\Working Drawings\Construction Set\CS-500-502 CIVIL DETAILS.dwg
2025-09-03

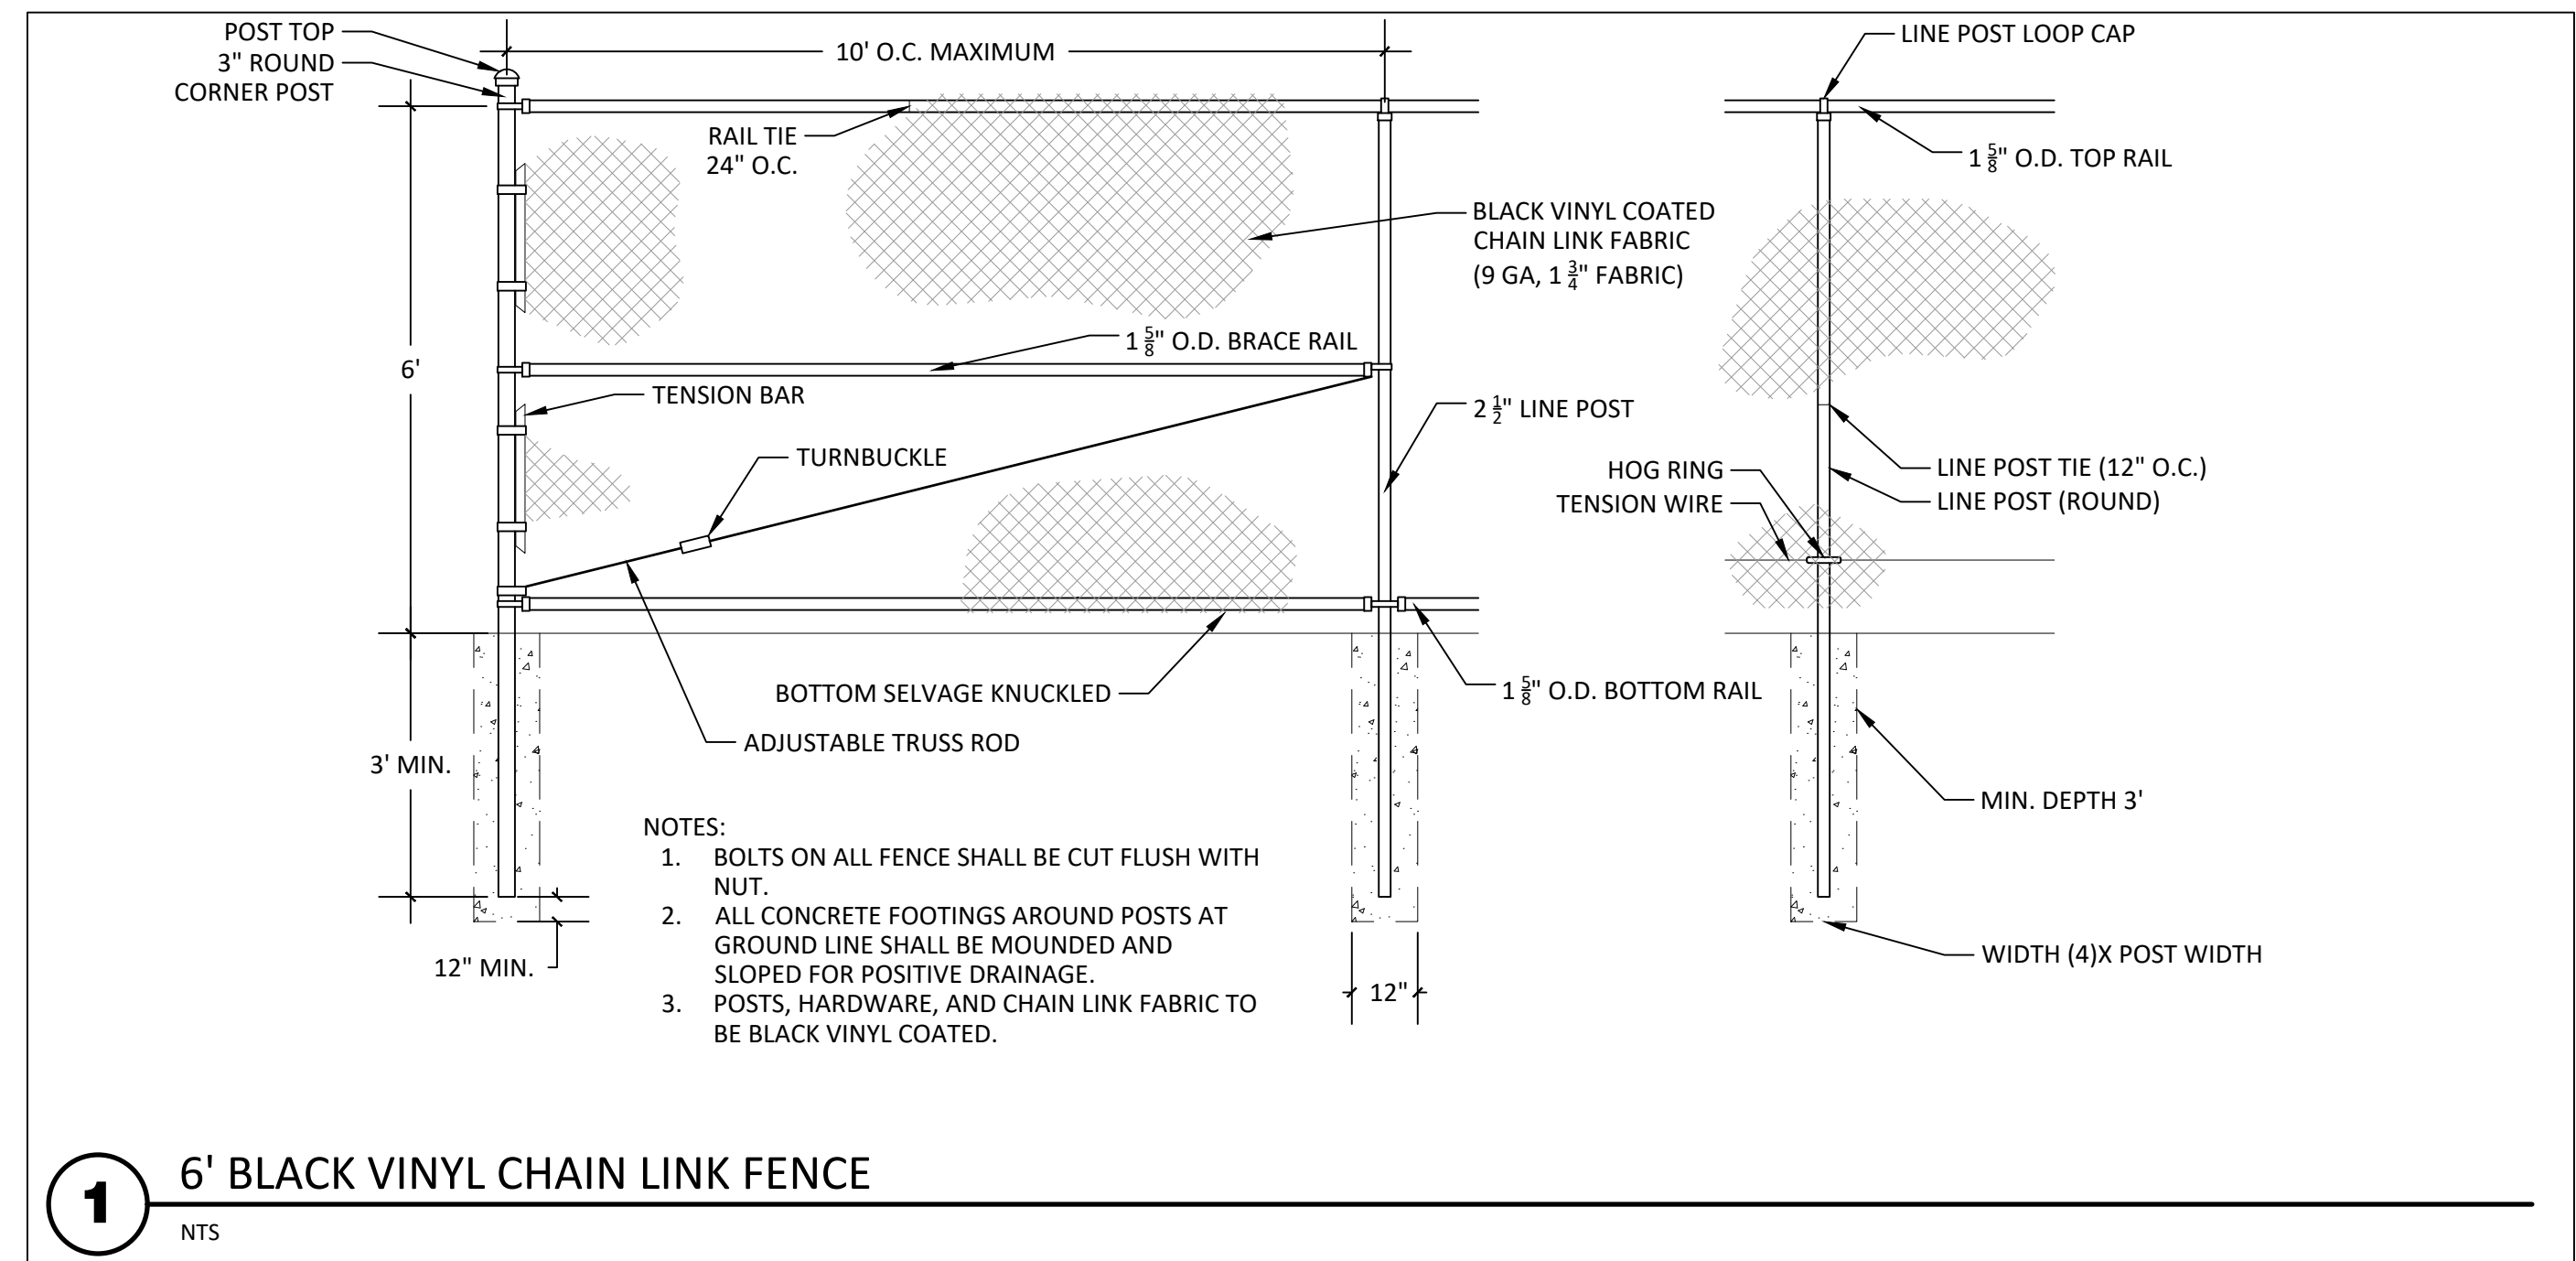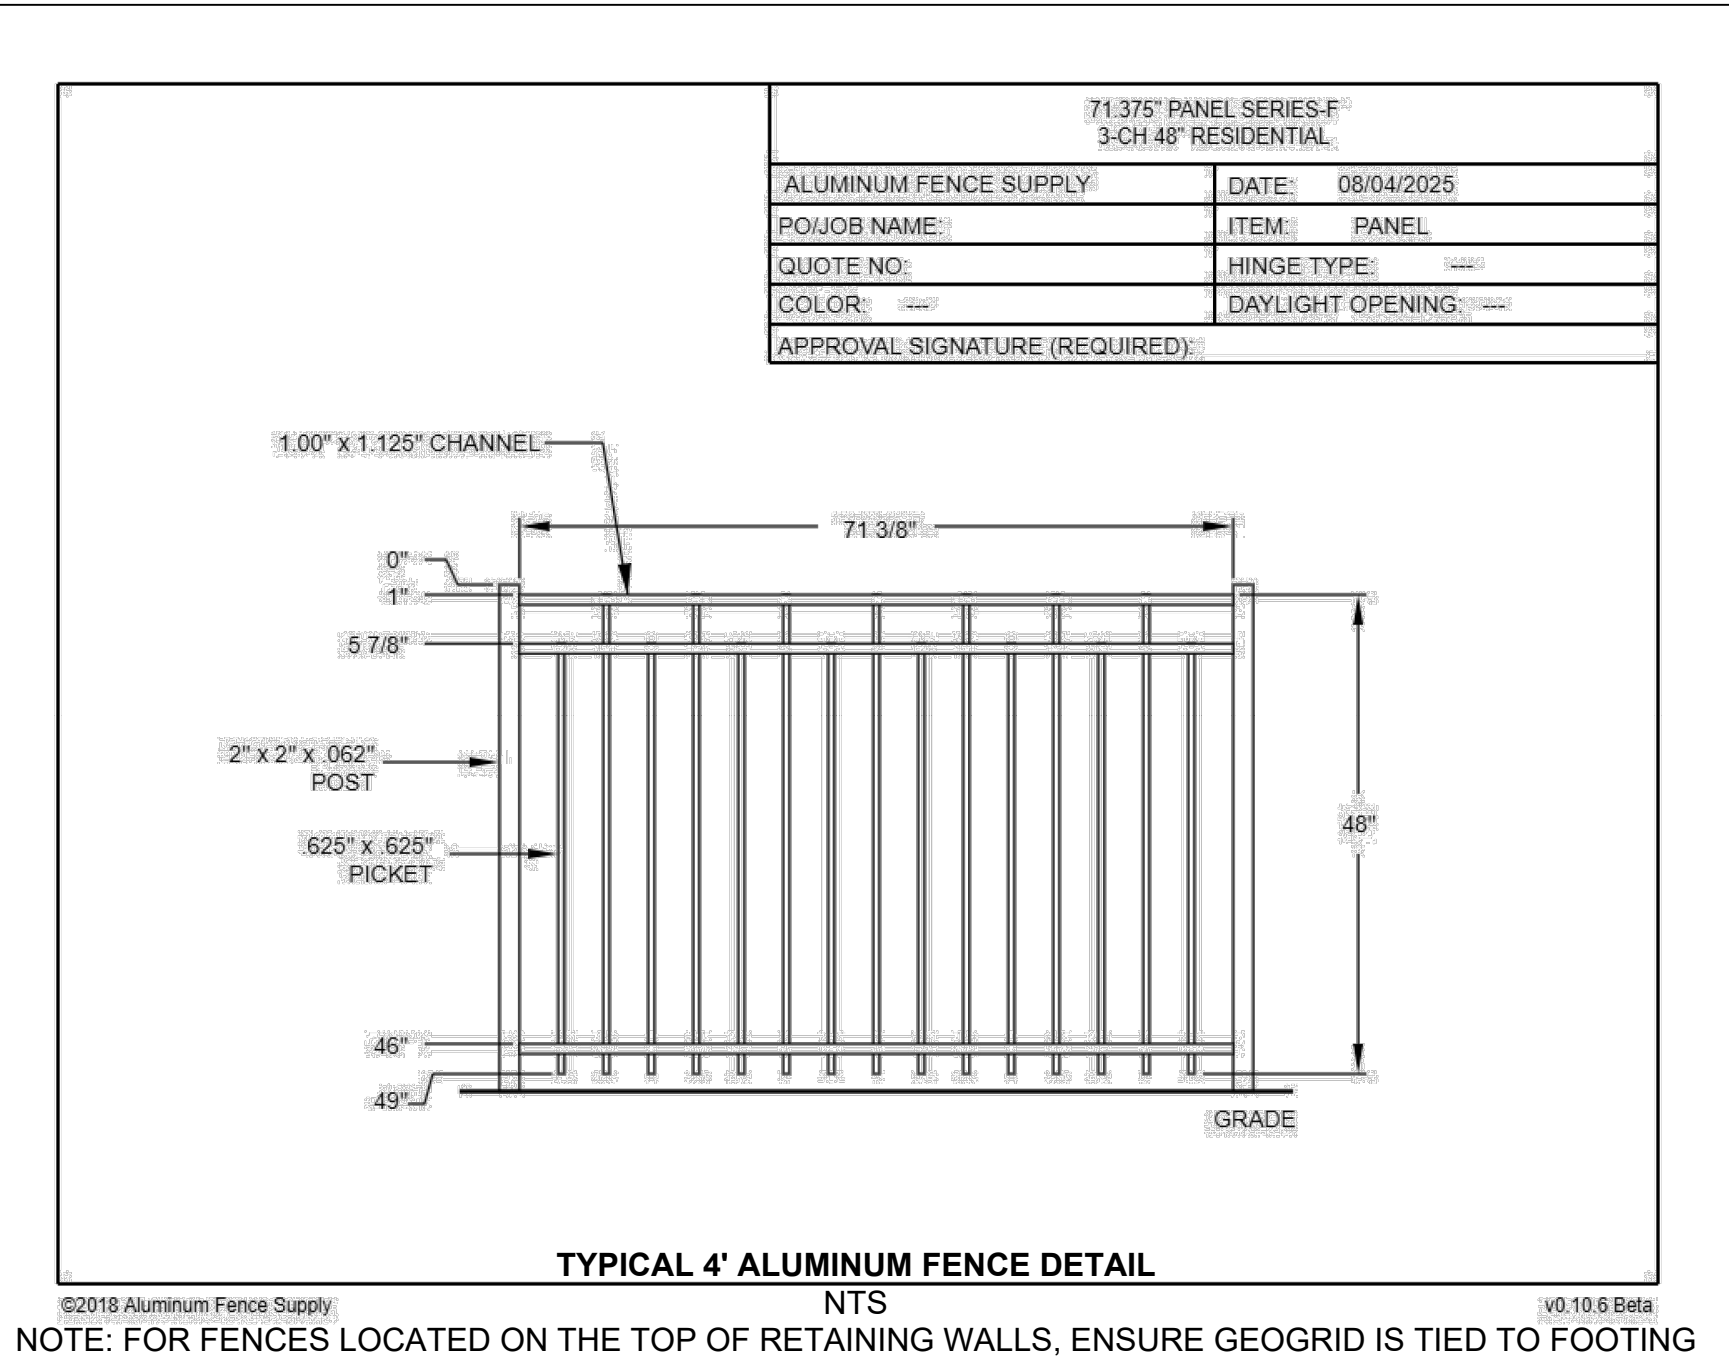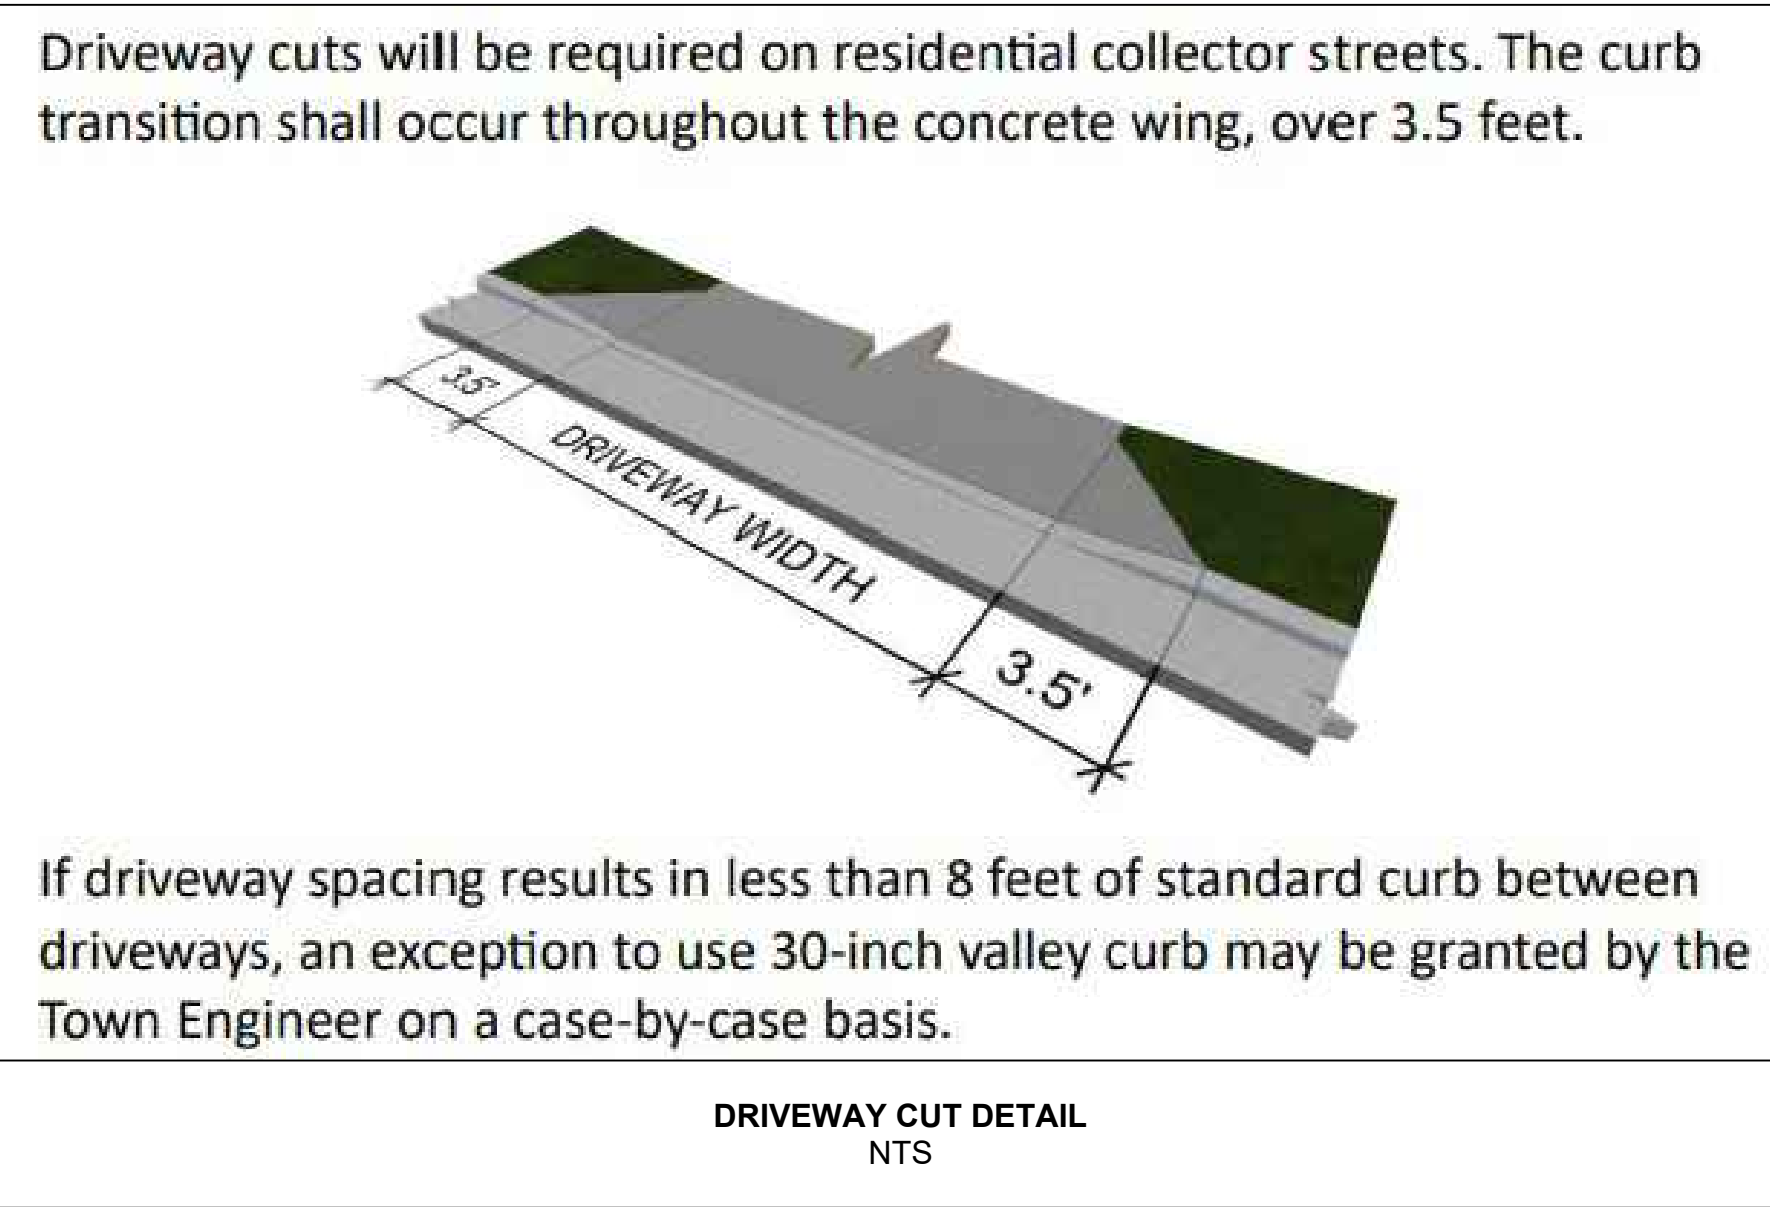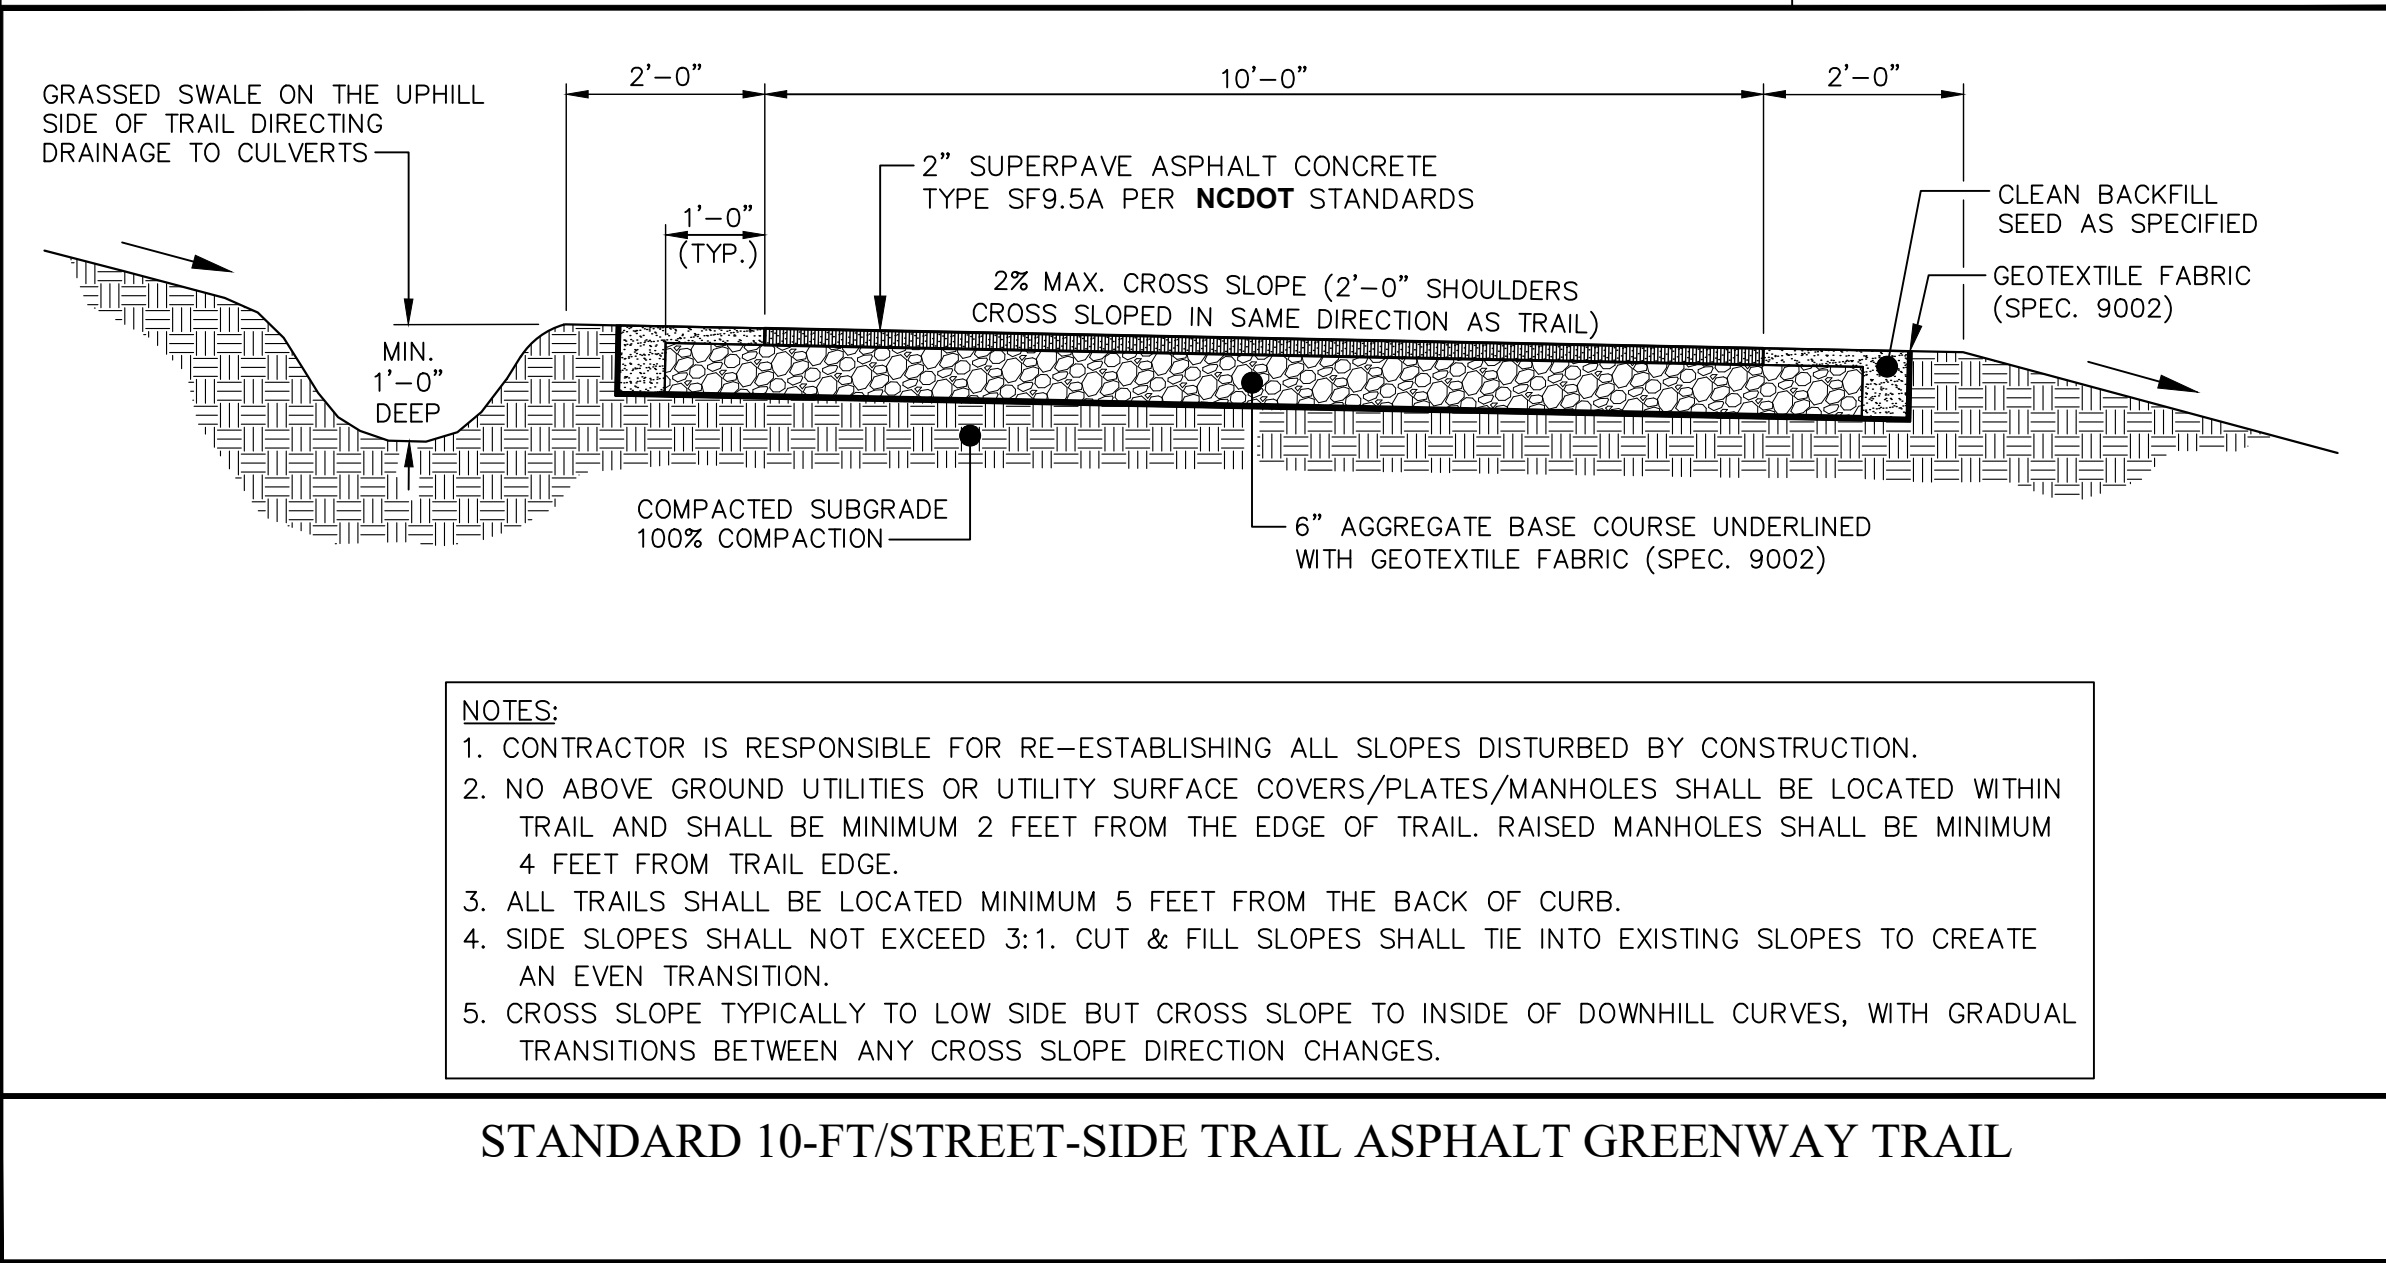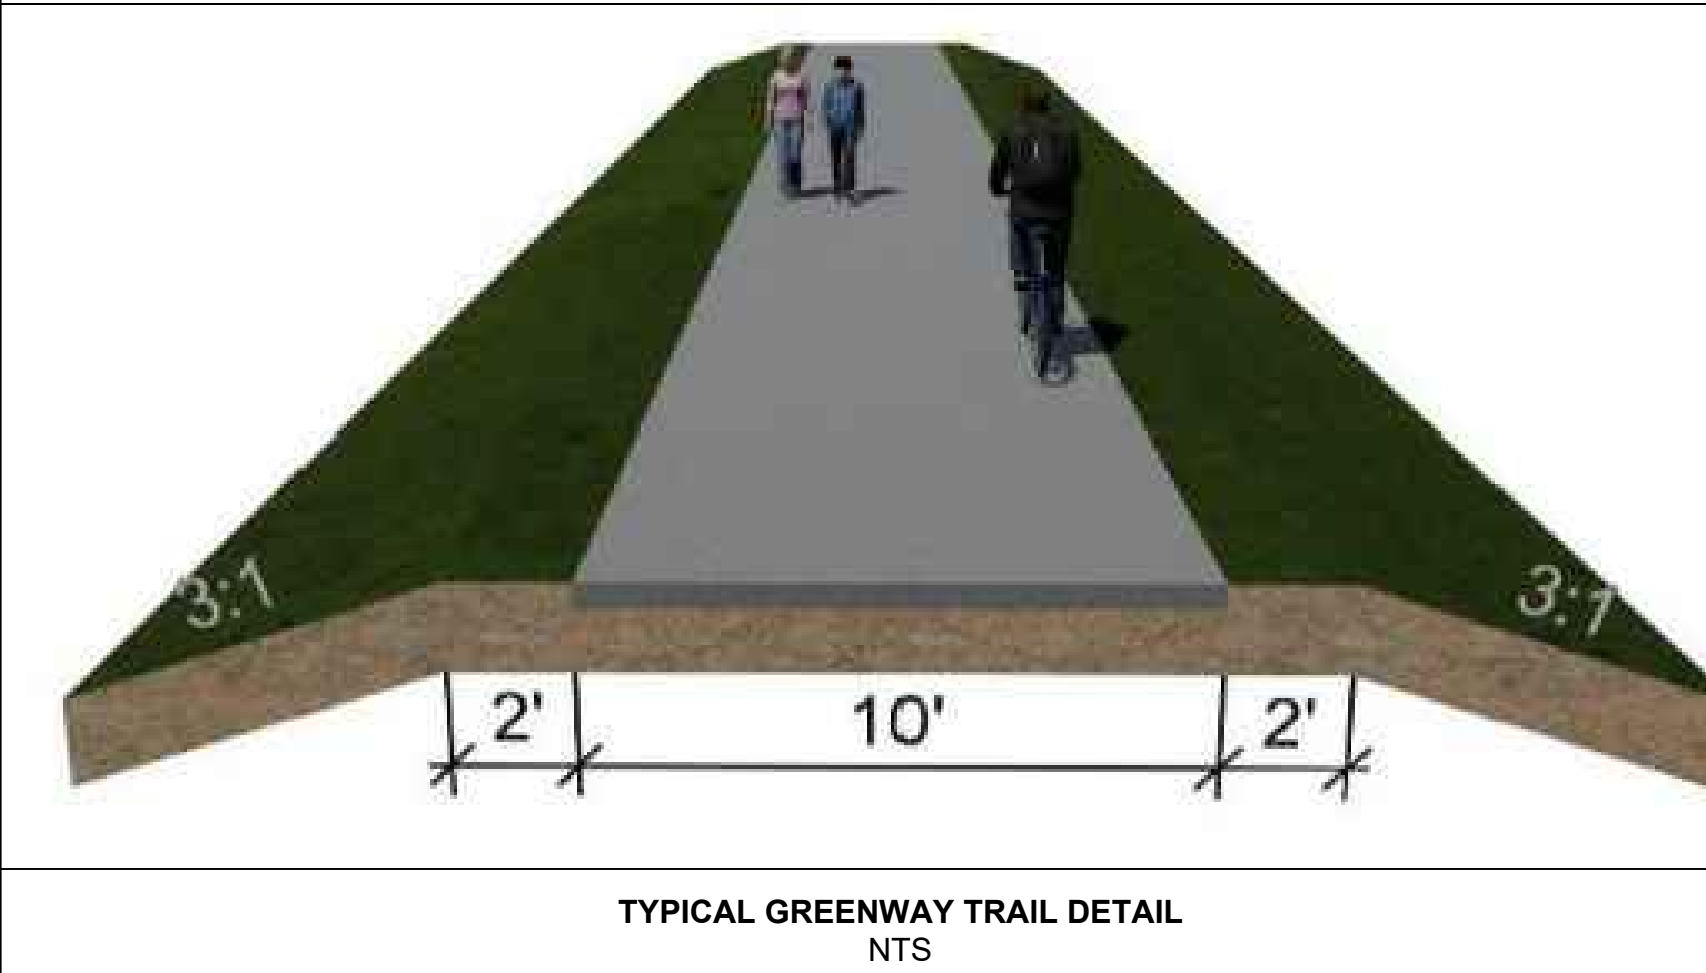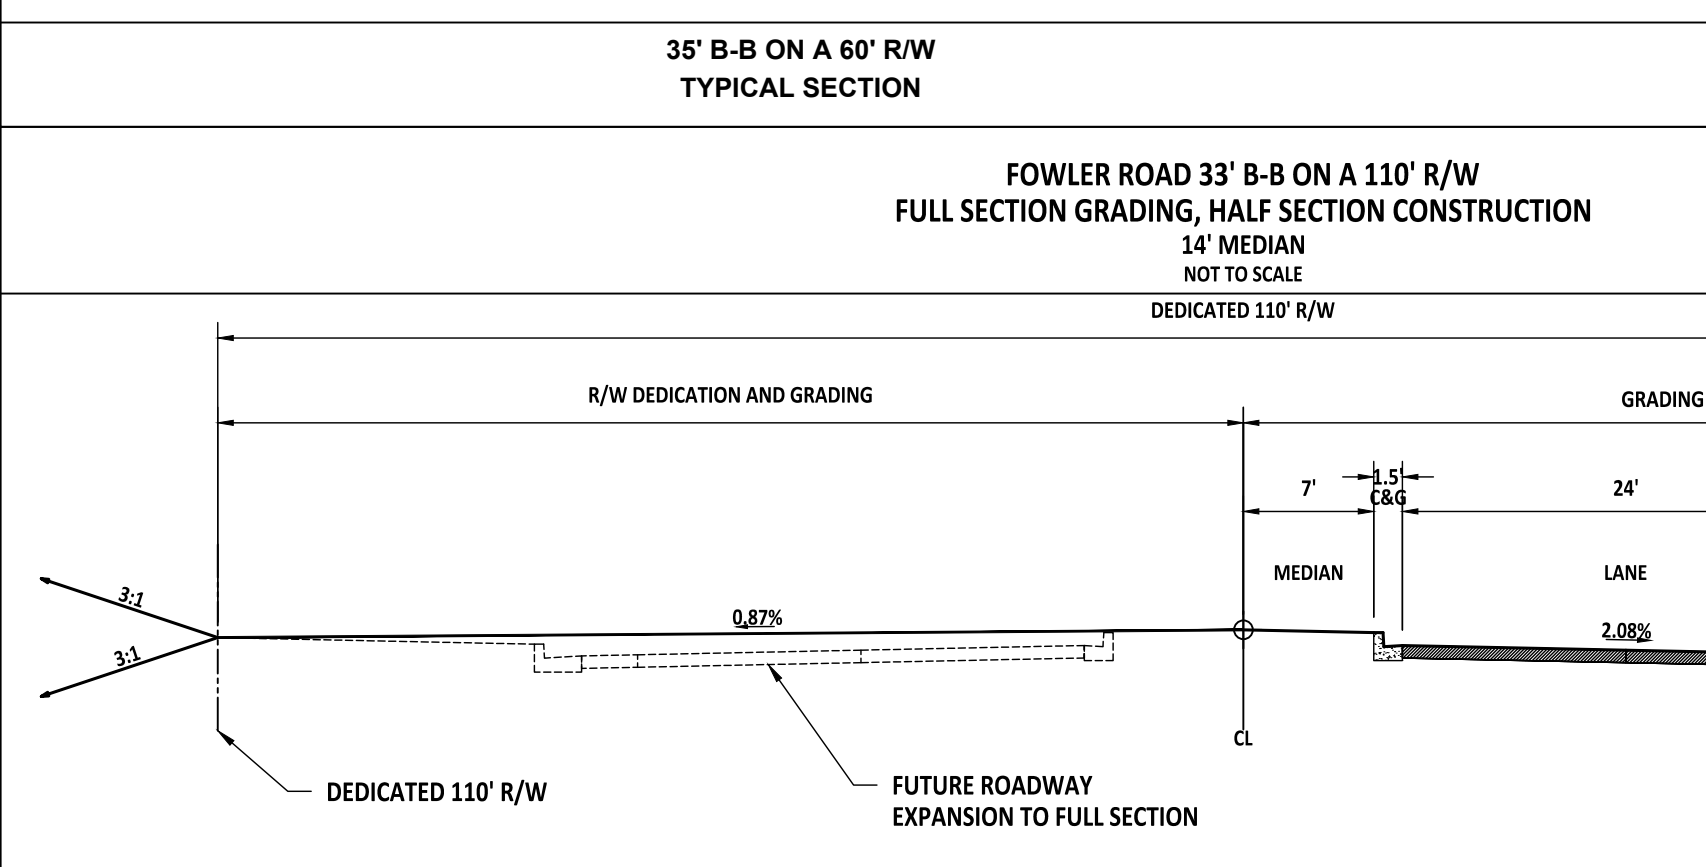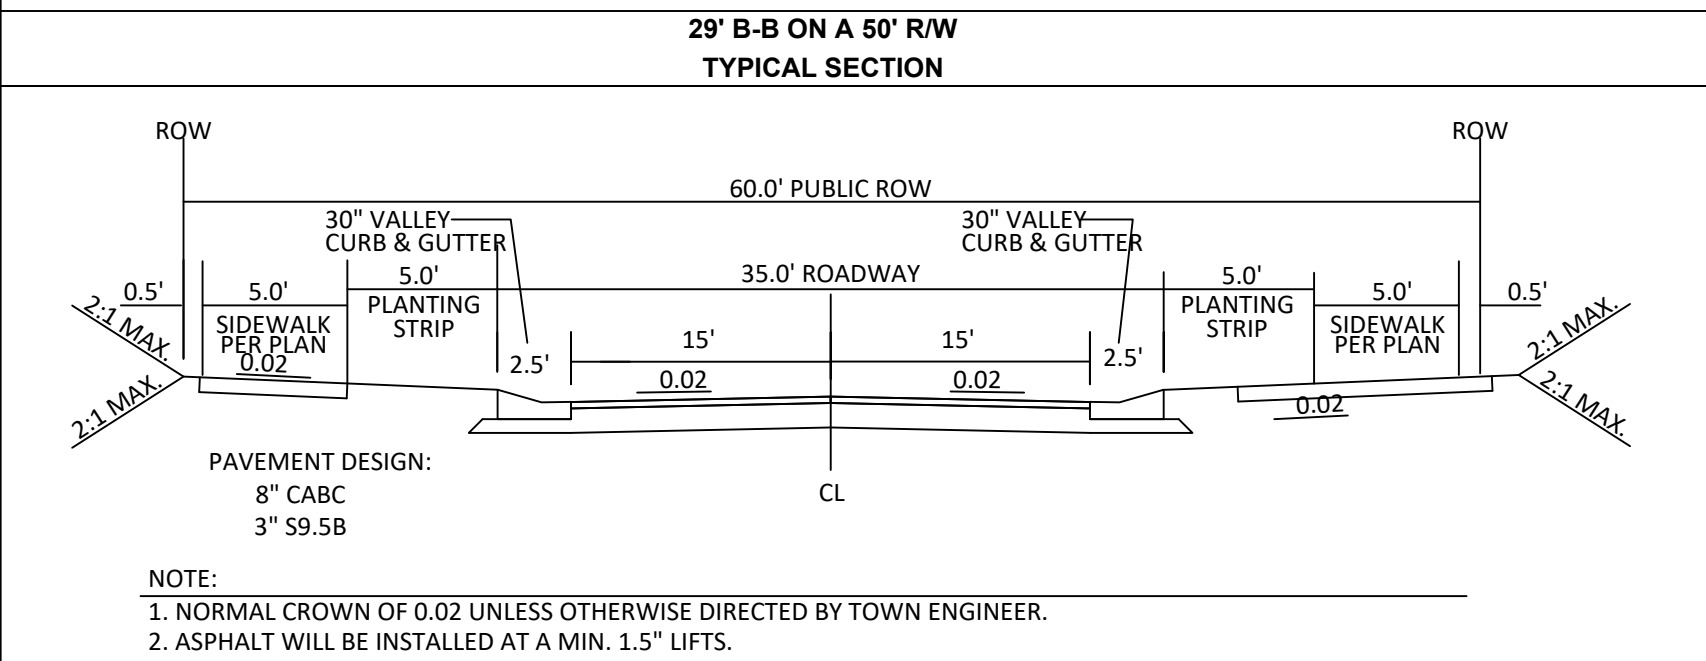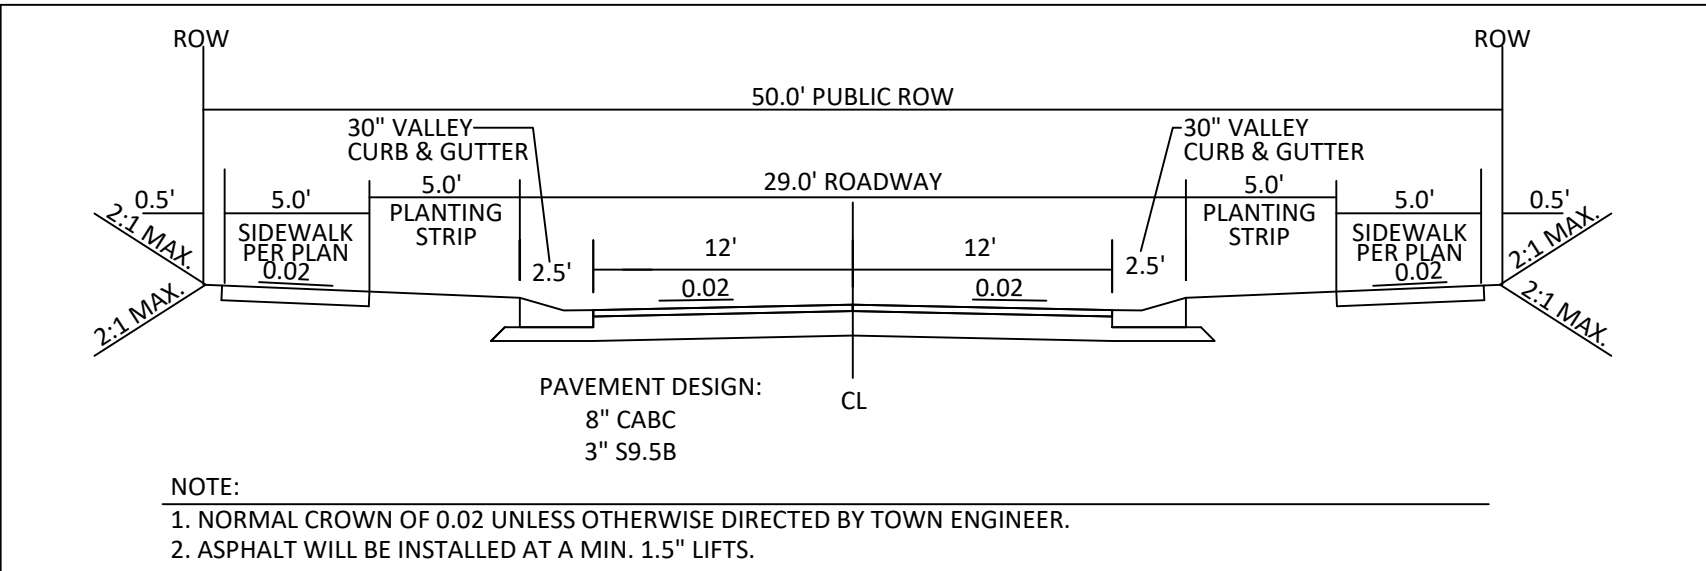

6. The 3 details for a greenway trail provides duplication. Please review and only include 1 detail that meets the Town of Rolesville requirements for greenways.

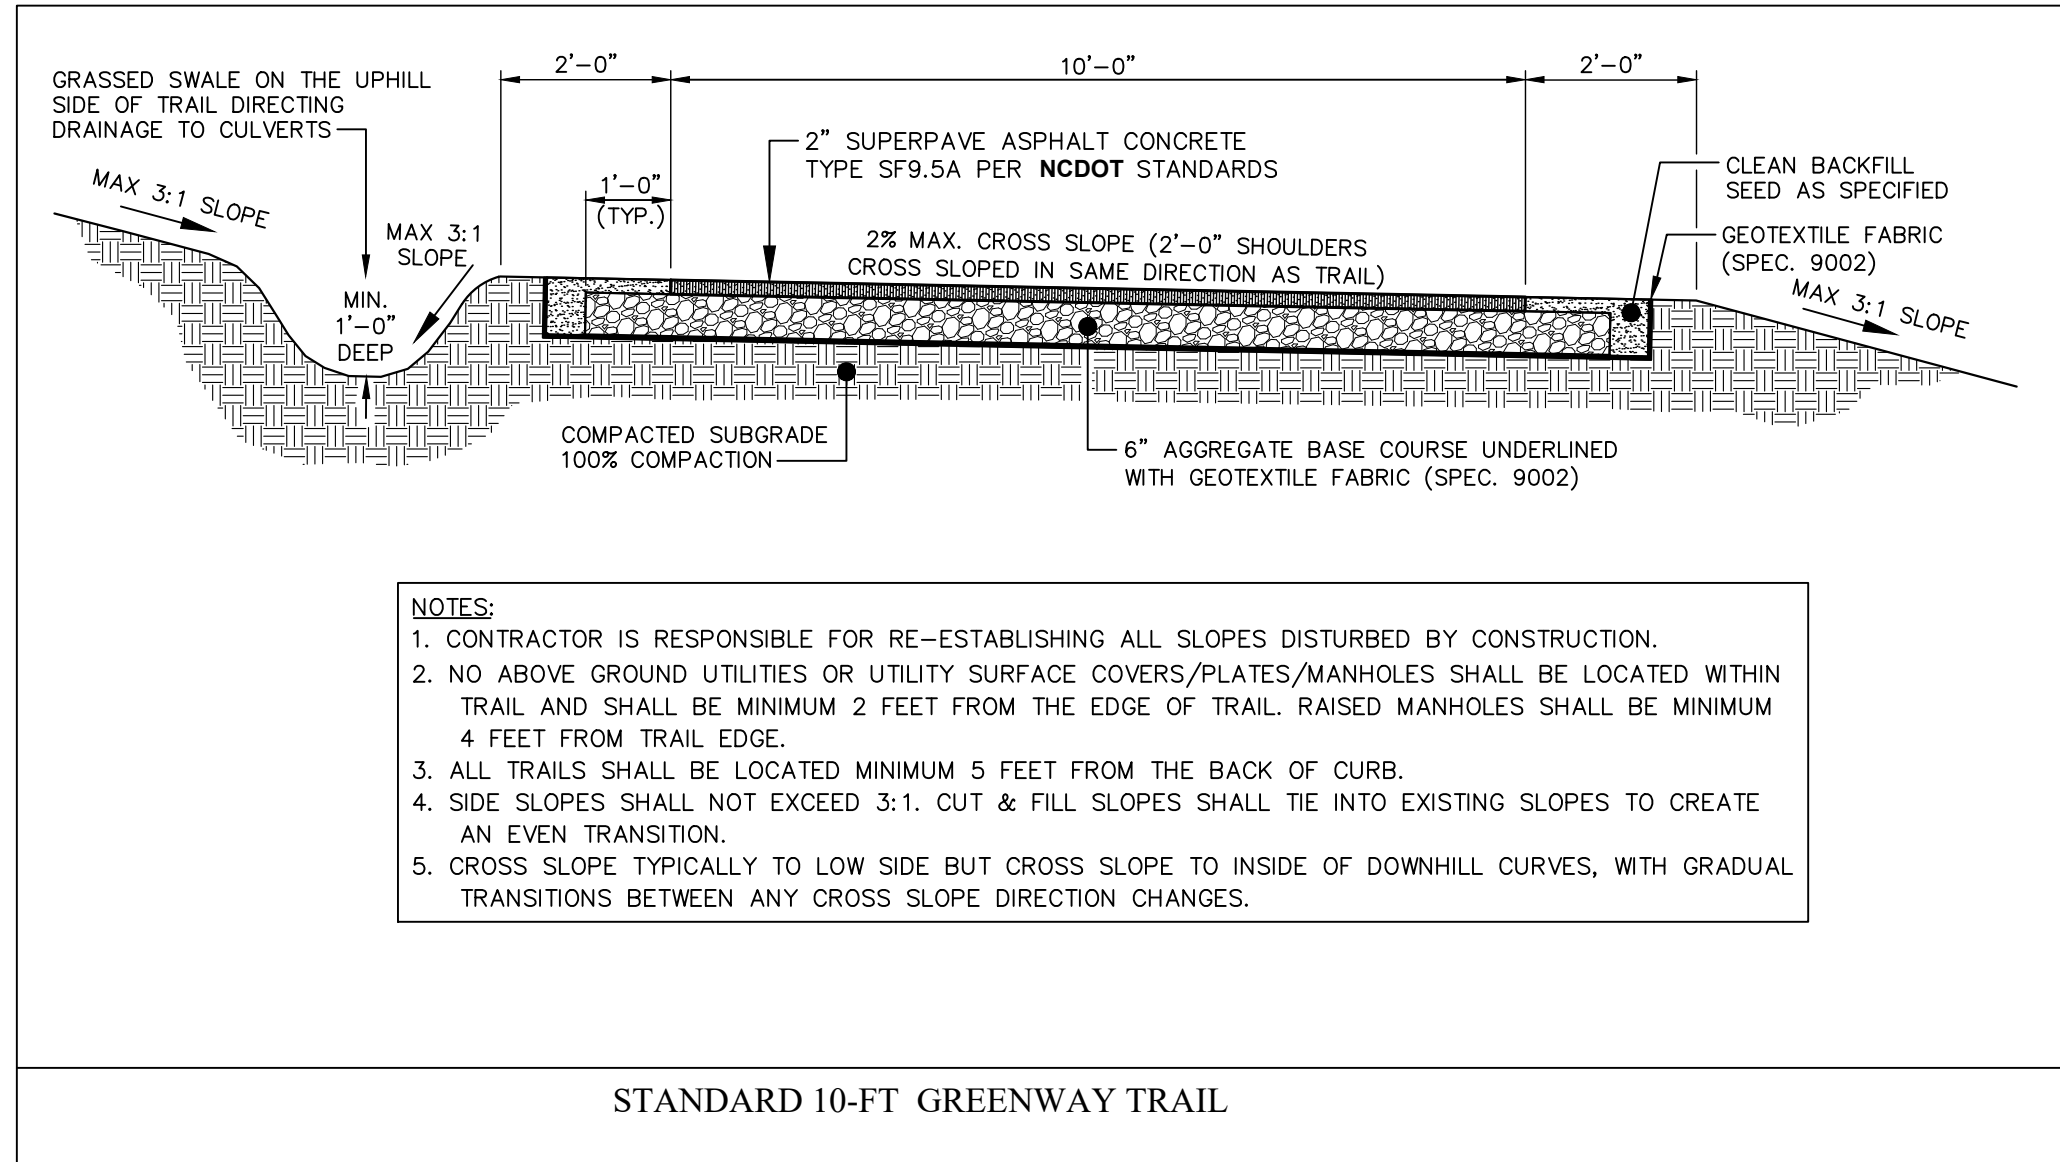



PROJECT NUMBER = CID-25-02

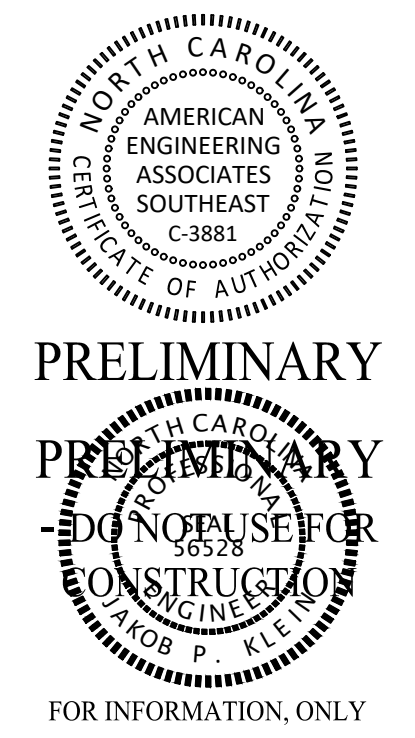





NO.	DATE	REVISION	DESCRIPTION
1	07/01/25	FIRST REVISION SET	
2	08/05/25	SECOND WAKE COUNTY SUBMITTAL	

STIPULATION FOR REUSE
THIS DRAWING WAS PREPARED FOR USE ON THE SPECIFIC SITE, NAMED HEREON, CONTEMPORANEOUSLY WITH ITS ISSUE DATE AS LISTED, HEREON, AND IT IS NOT SUITABLE FOR USE ON A DIFFERENT PROJECT SITE OR AT A LATER TIME. USE OF THIS DRAWING FOR REFERENCE OR EXAMPLE ON ANOTHER PROJECT REQUIRES THE SERVICES OF PROPERLY LICENSED ARCHITECTS AND ENGINEERS. REPRODUCTION OF THIS DRAWING FOR REUSE ON ANOTHER PROJECT IS NOT AUTHORIZED AND MAY BE CONTRARY TO THE LAW.

MERRITT RESERVE	SITE DETAILS
ROLESVILLE RD	WAKE COUNTY NC 27312
JOB NUMBER:	23-0004
CHECKED BY:	JK
DRAWN BY:	DH/MA/LL
DATE:	08/04/2025
SHEET TITLE:	SITE DETAILS
SHEET NO.:	CS-503

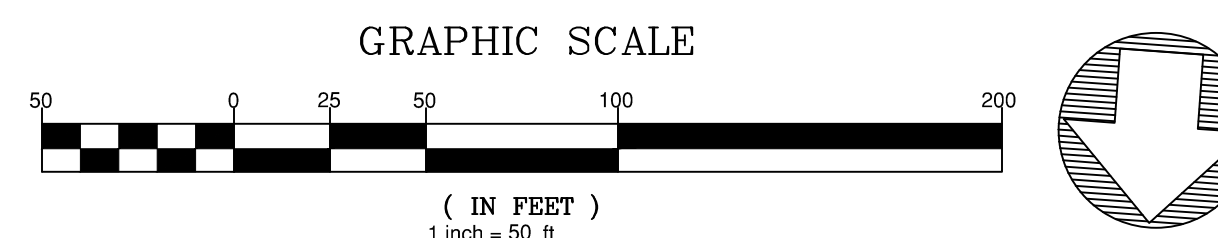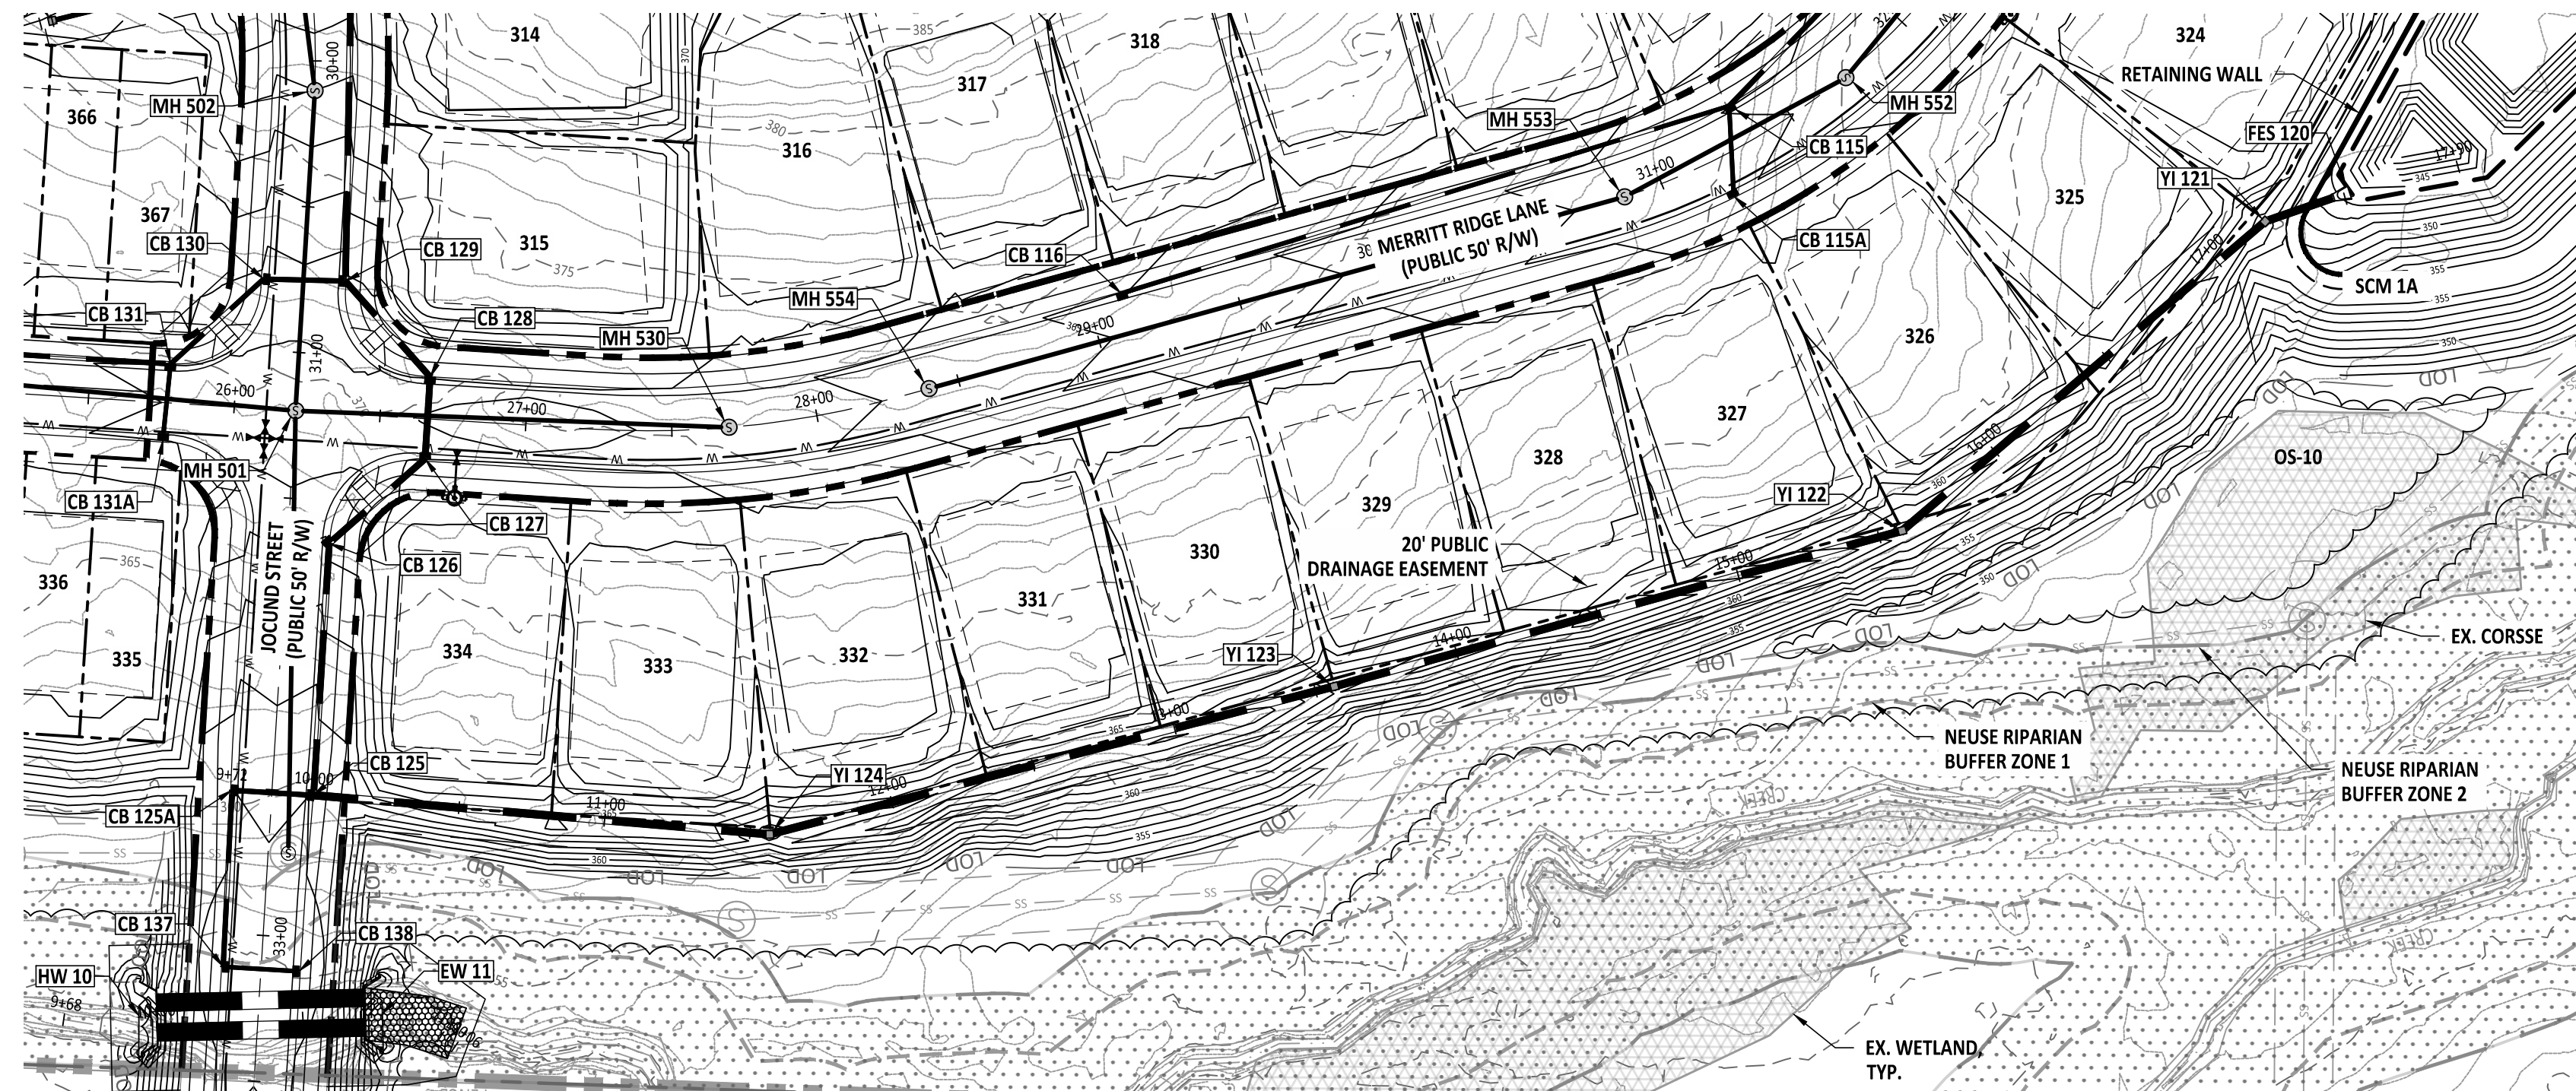

7. All pipe outlets that have the HGL outside of the pipe shall have O-ring gaskets for those pipe segments. This is acceptable only at outlets where the SCM water levels may raise above the pipe. Please review the modeling and plans, and ensure that O-ring gaskets are clearly labeled.

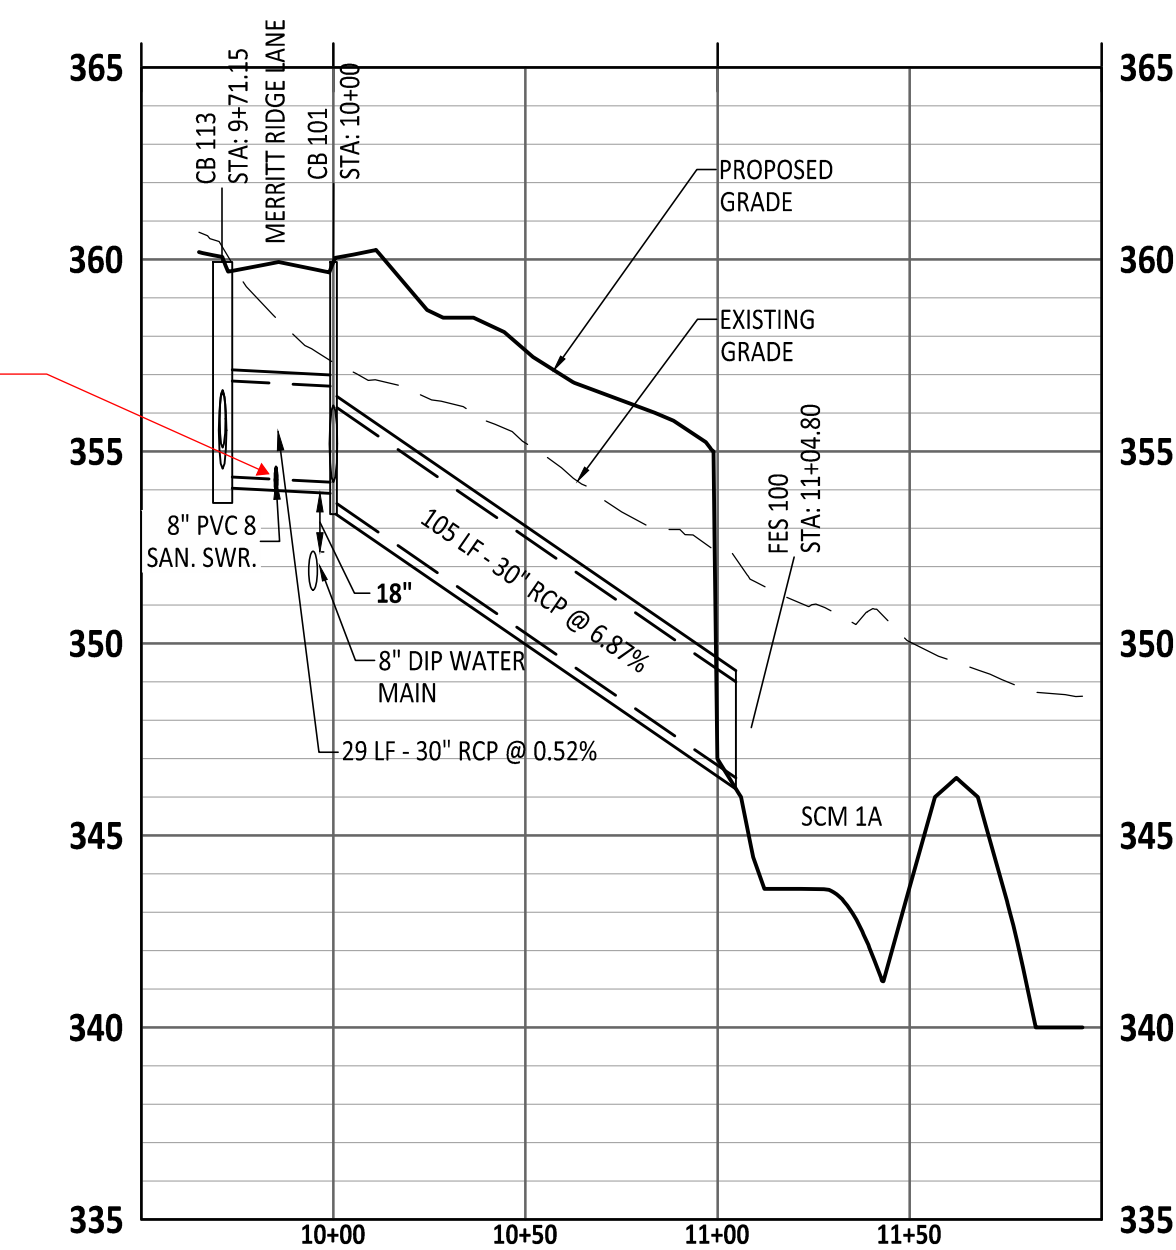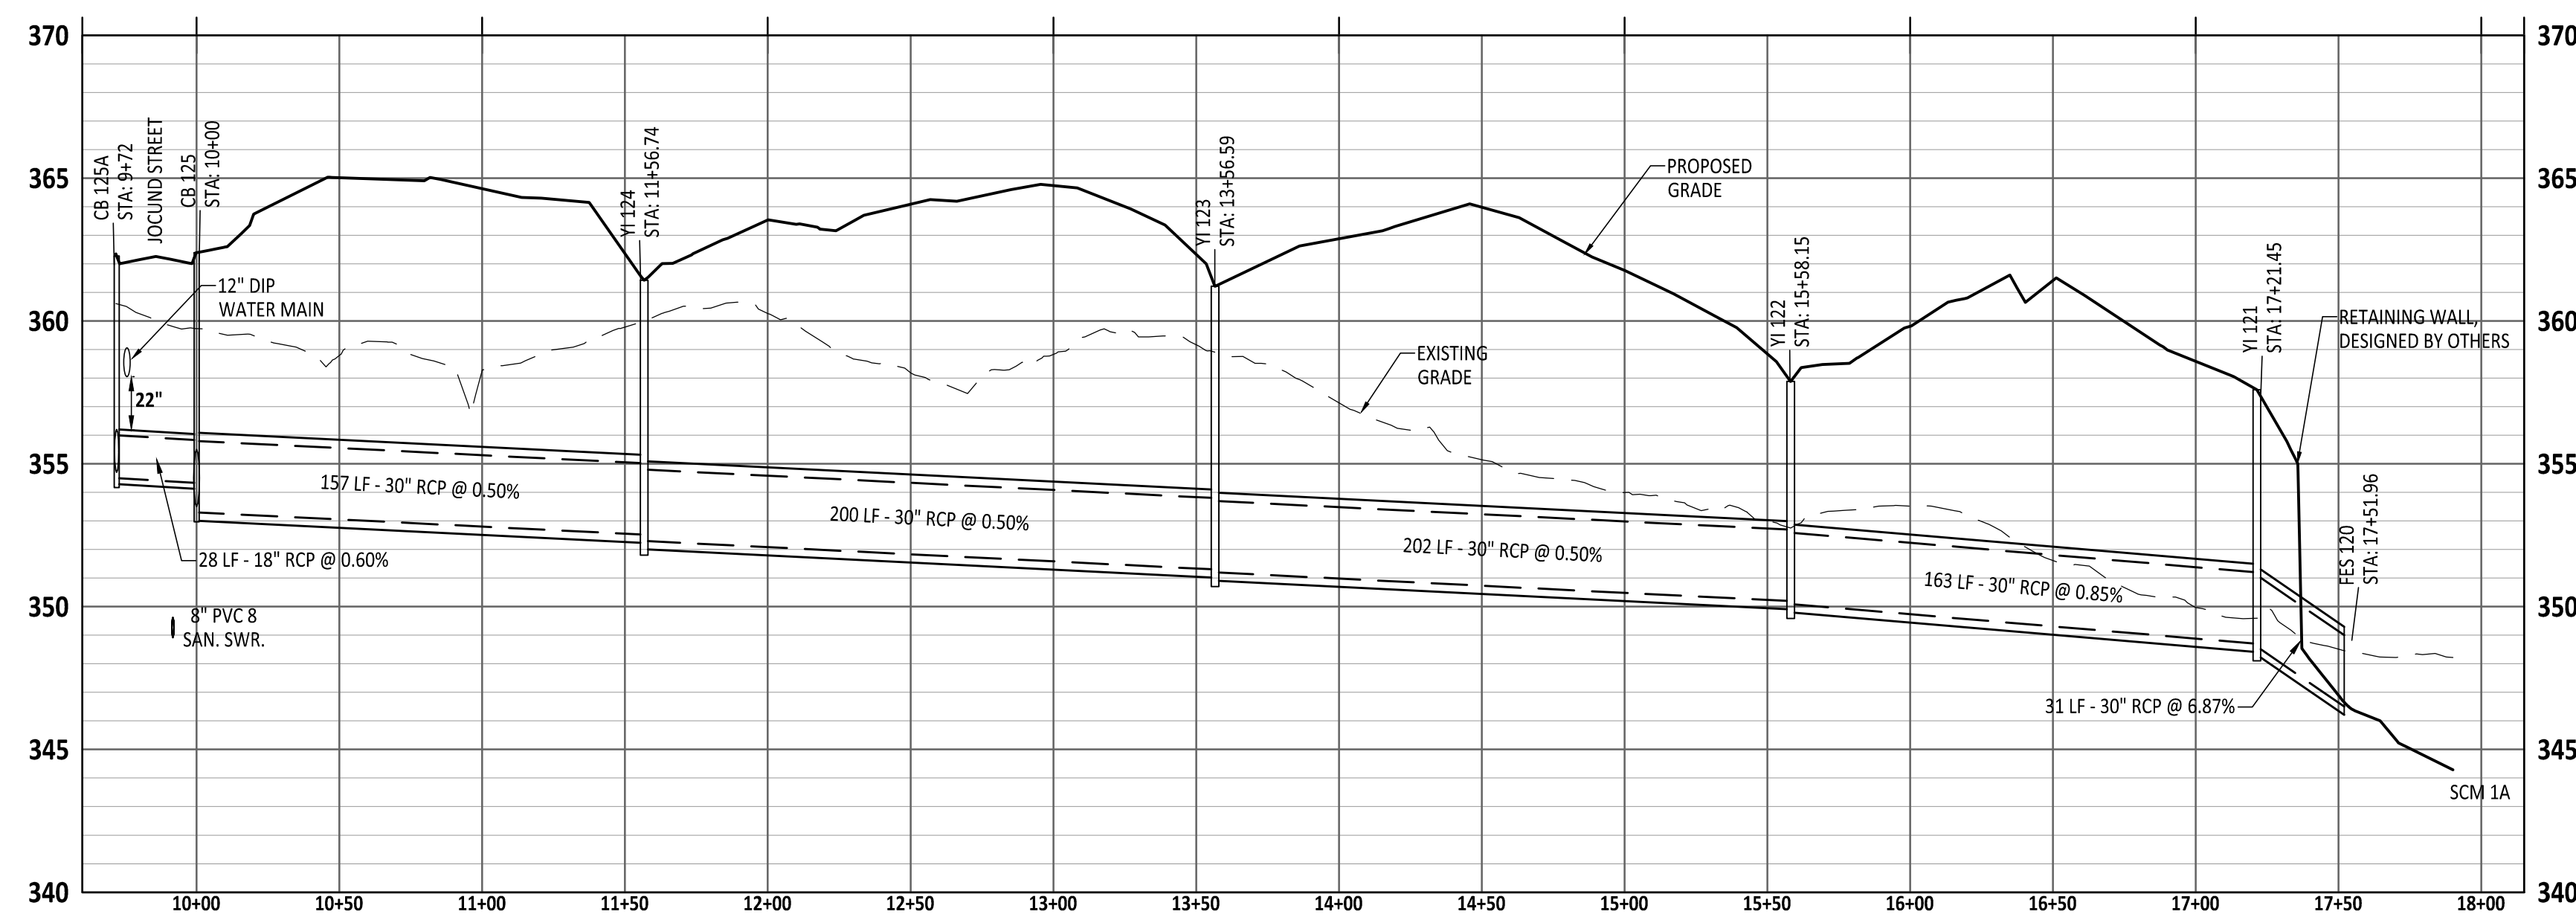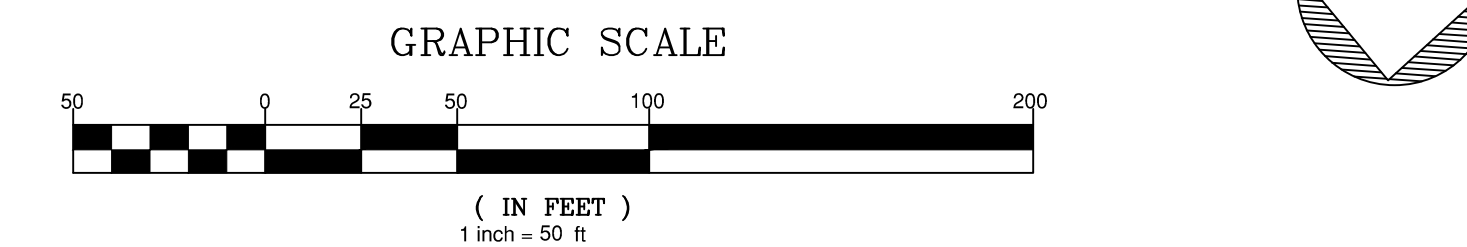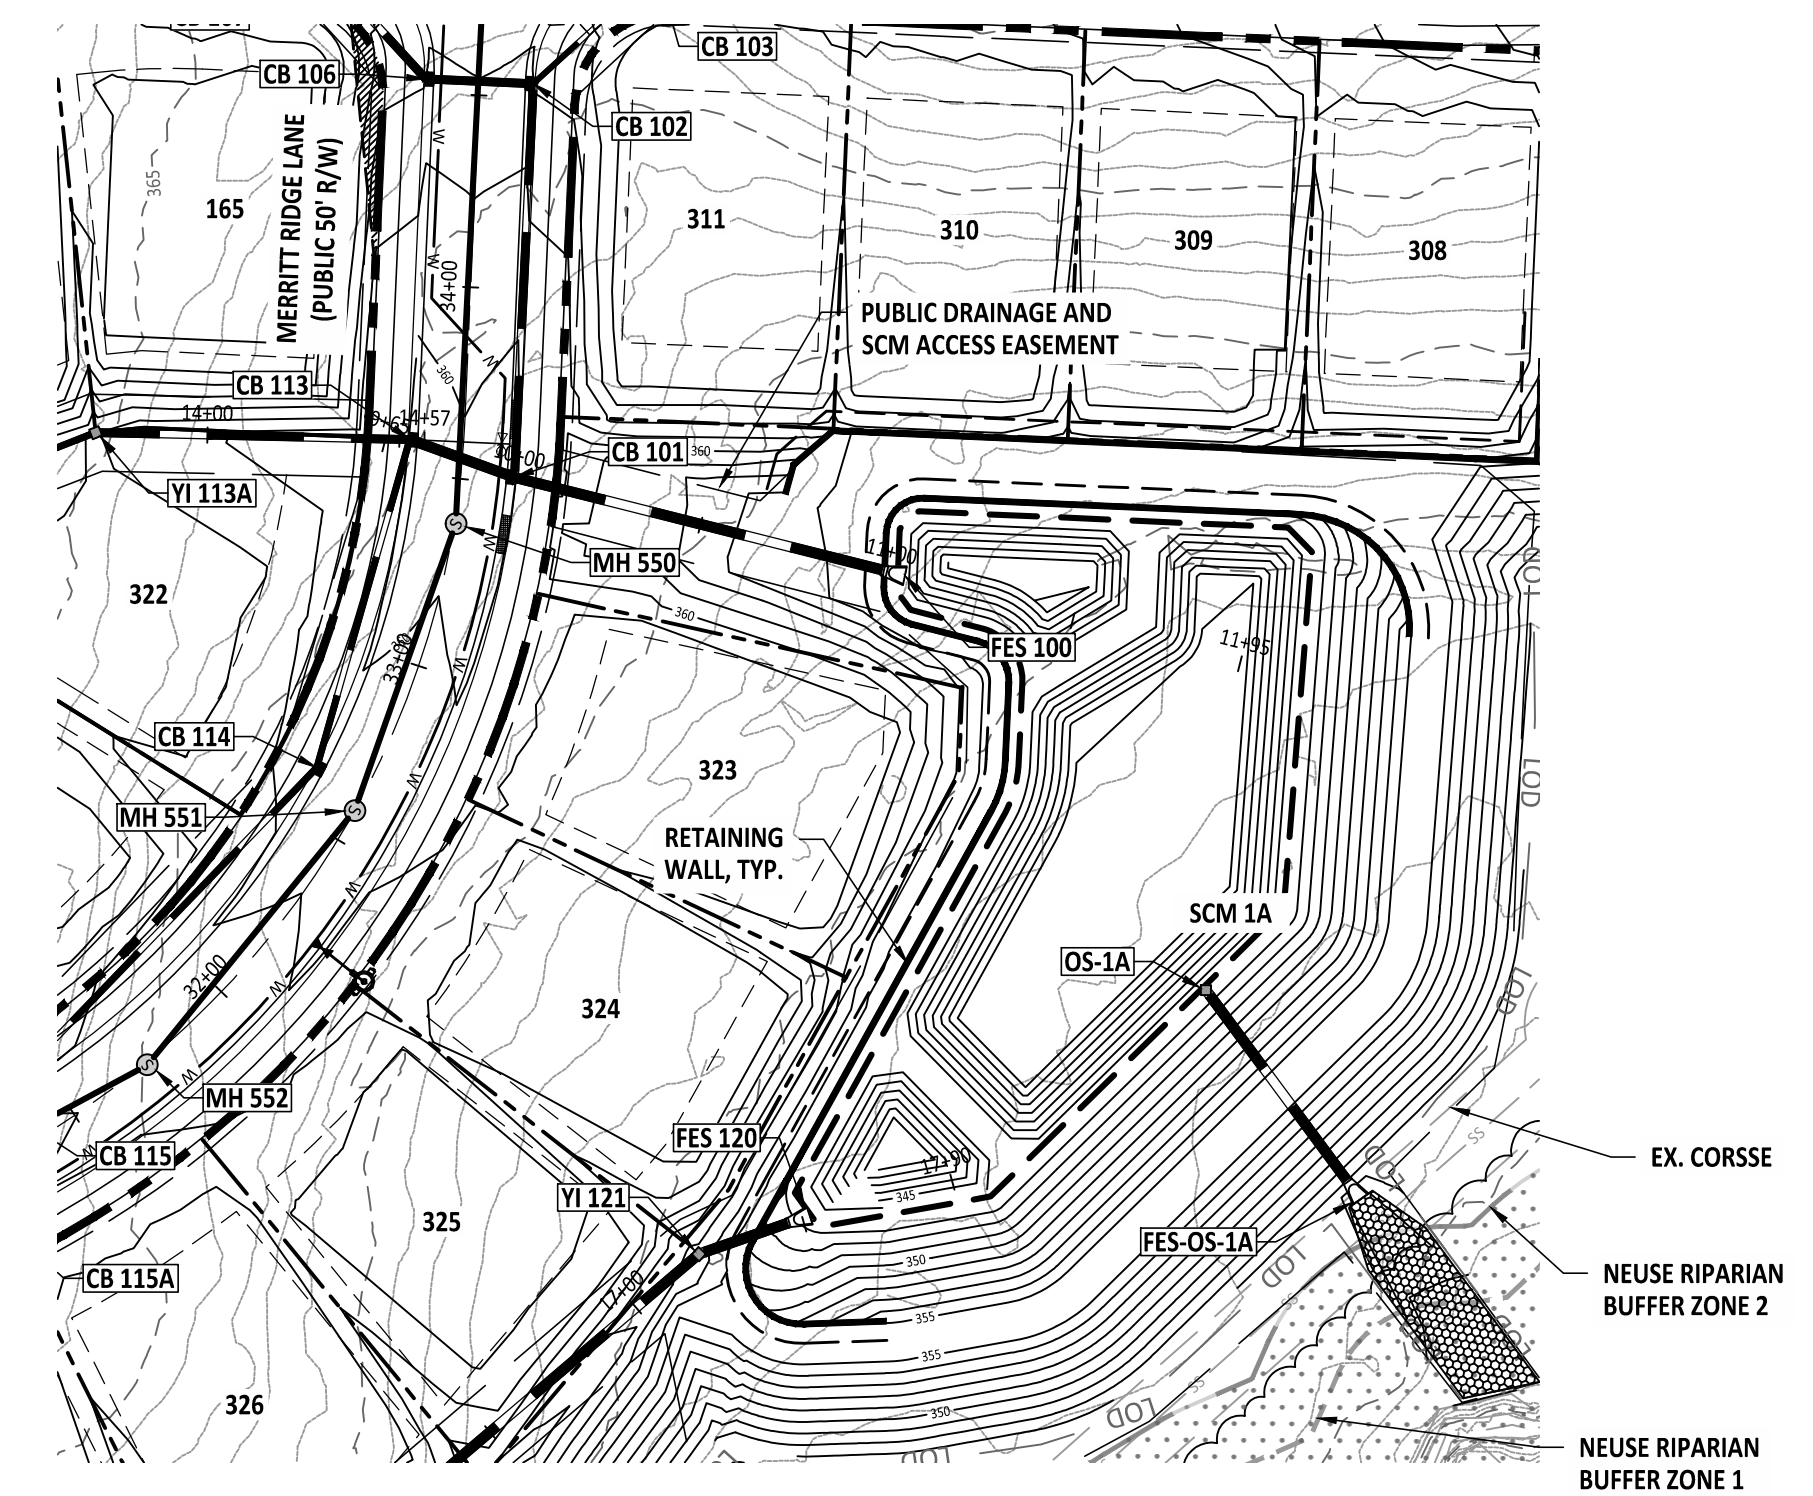

8. Please review Sanitary sewer to ensure no conflict with Storm water

[illegible]

STIPULATION FOR REUSE


THIS DRAWING WAS PREPARED FOR USE ON THE SPECIFIC SITE, NAMED HEREON, CONTEMPORANEOUSLY WITH ITS ISSUE DATE AS LISTED, HEREON, AND IT IS NOT SUITABLE FOR USE ON A DIFFERENT PROJECT SITE OR AT A LATER TIME. USE OF THIS DRAWING FOR REFERENCE OR EXAMPLE ON ANOTHER PROJECT REQUIRES THE SERVICES OF PROPERLY LICENSED ARCHITECTS AND ENGINEERS. REPRODUCTION OF THIS DRAWING FOR REUSE ON ANOTHER PROJECT IS NOT AUTHORIZED AND MAY BE CONTRARY TO THE LAW.

MERRITT RESERVE
STORM OUTFALL PLAN & PROFILE
ROLESVILLE RD
WAKE COUNTY NC 27312


B NUMBER:	23-0004
CHECKED BY:	JK
DRAWN BY:	DH/MA/LL
DATE:	08/04/2025
SHEET TITLE:	

**STORM
OUTFALL PLAN
& PROFILE**


SHEET NO.: **CU-300**

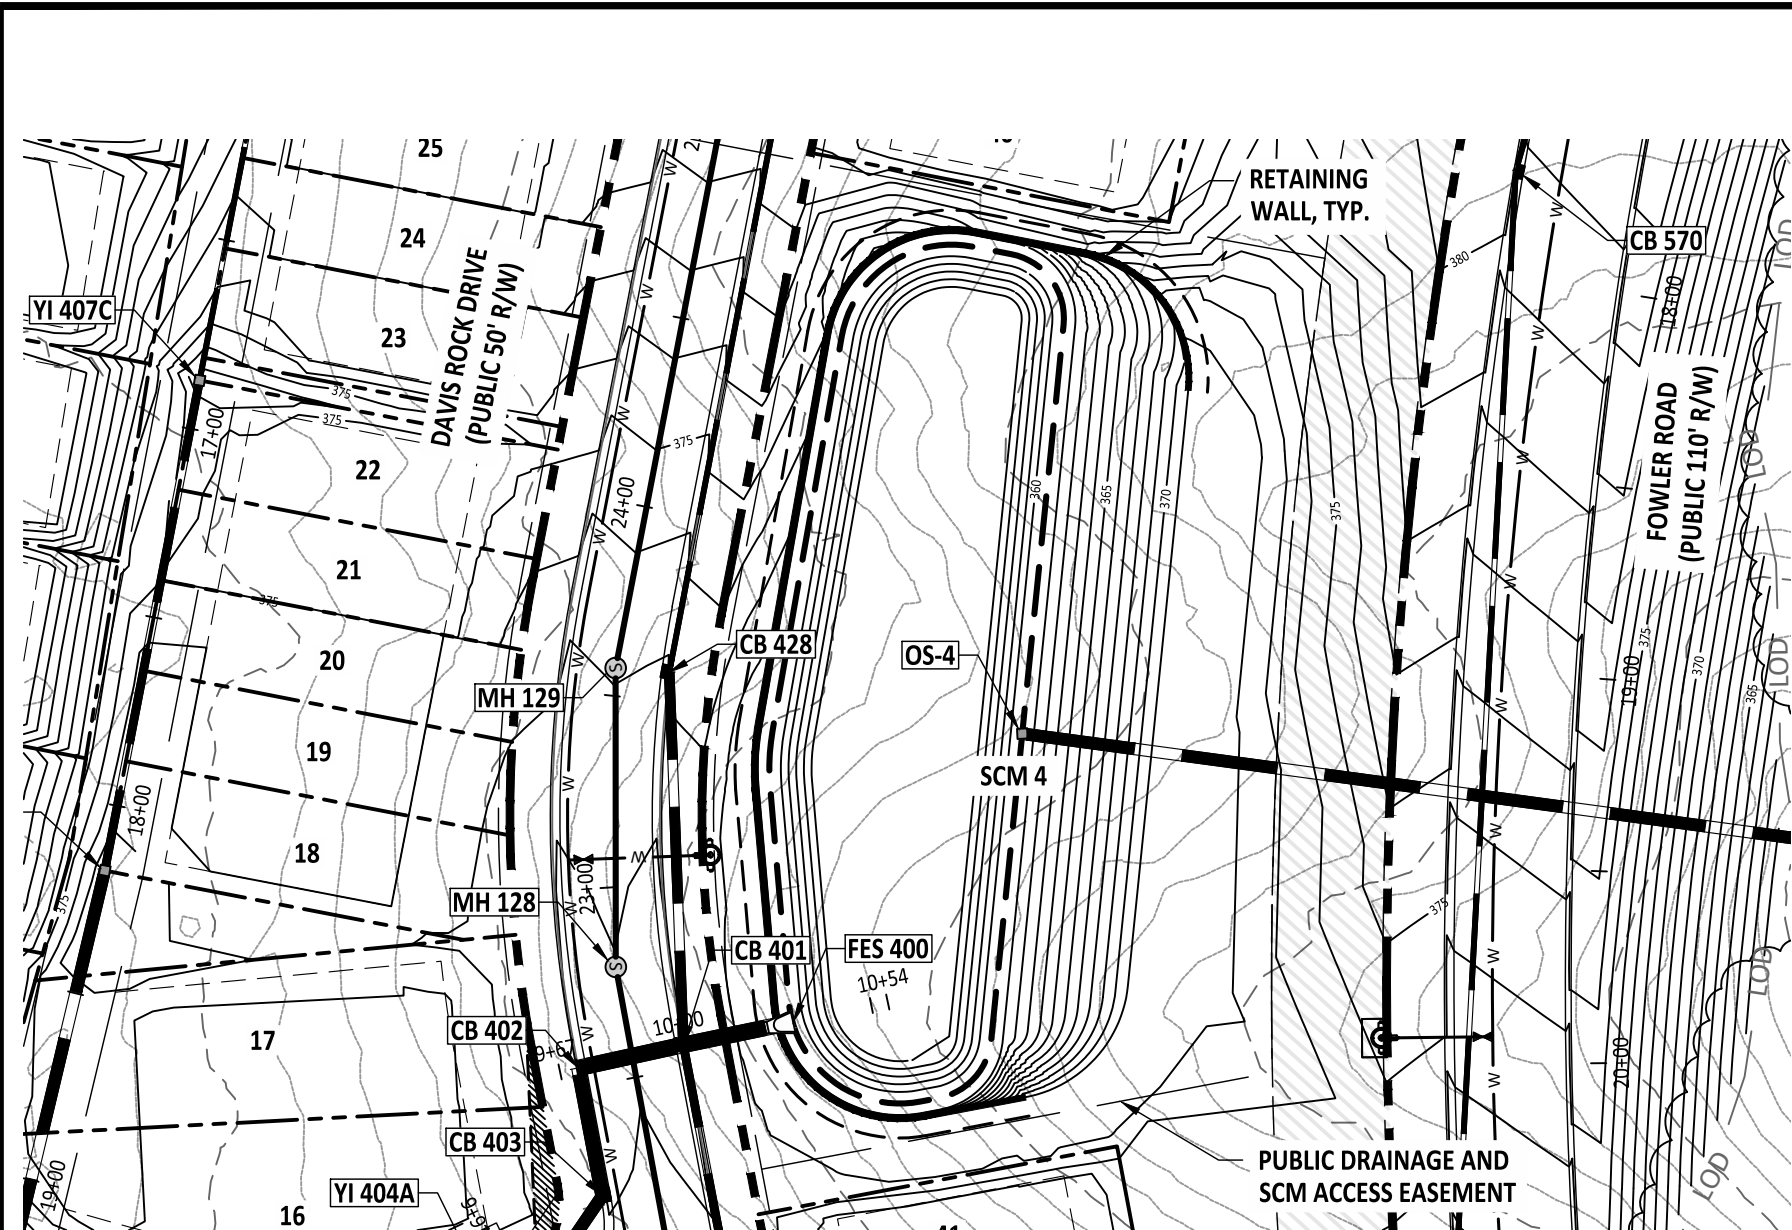


CB 402 TO FES 400 PLAN VIEW

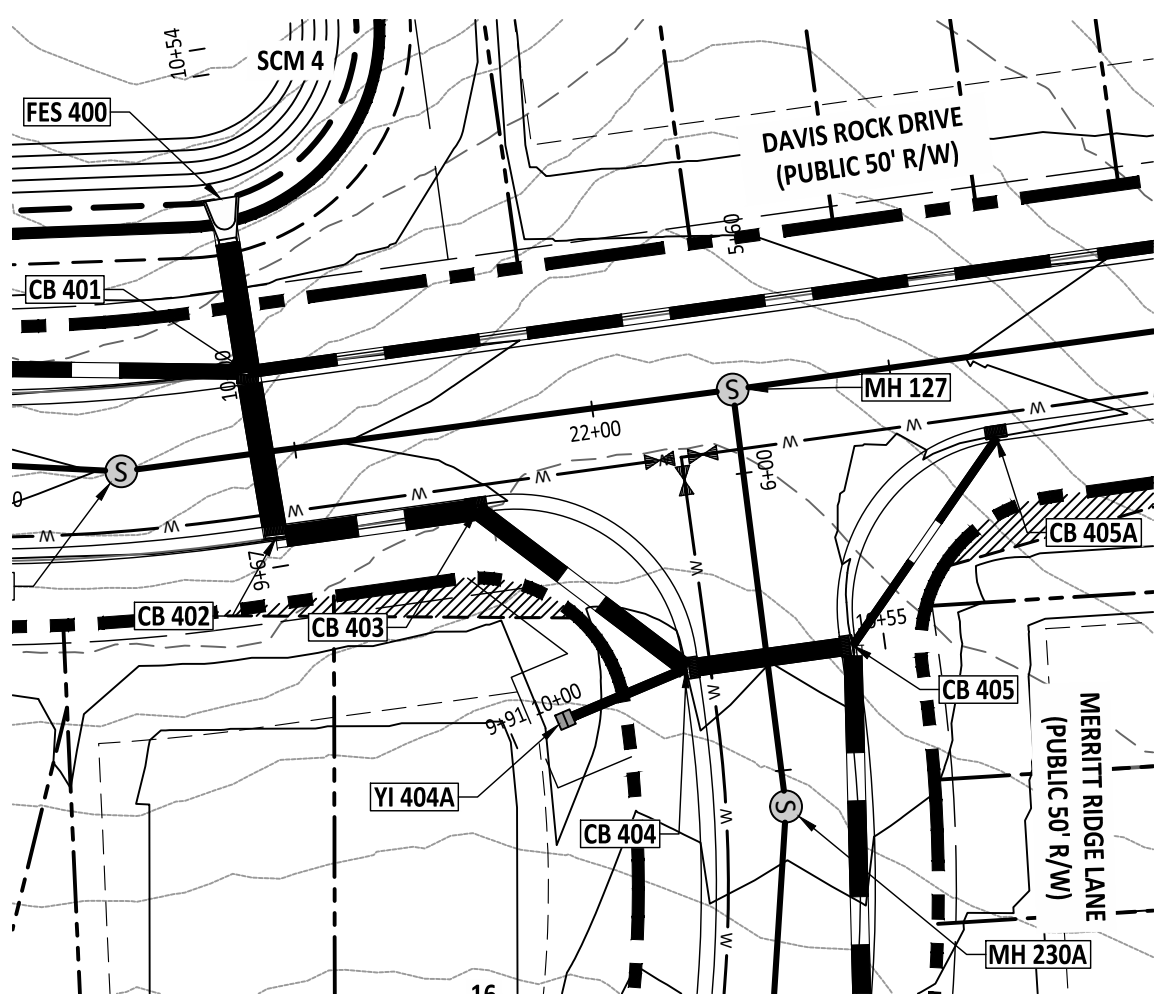


YI 404A TO CB 405 PLAN VIEW

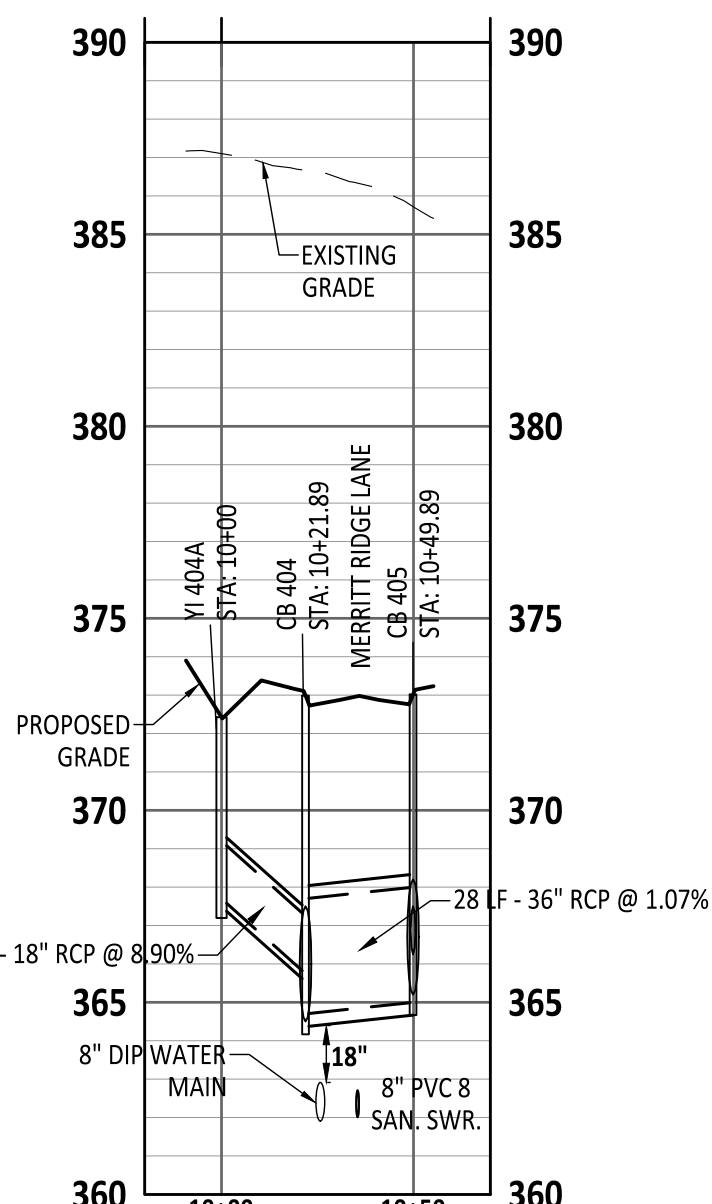

YI 404A TO CB 404 PROFILE

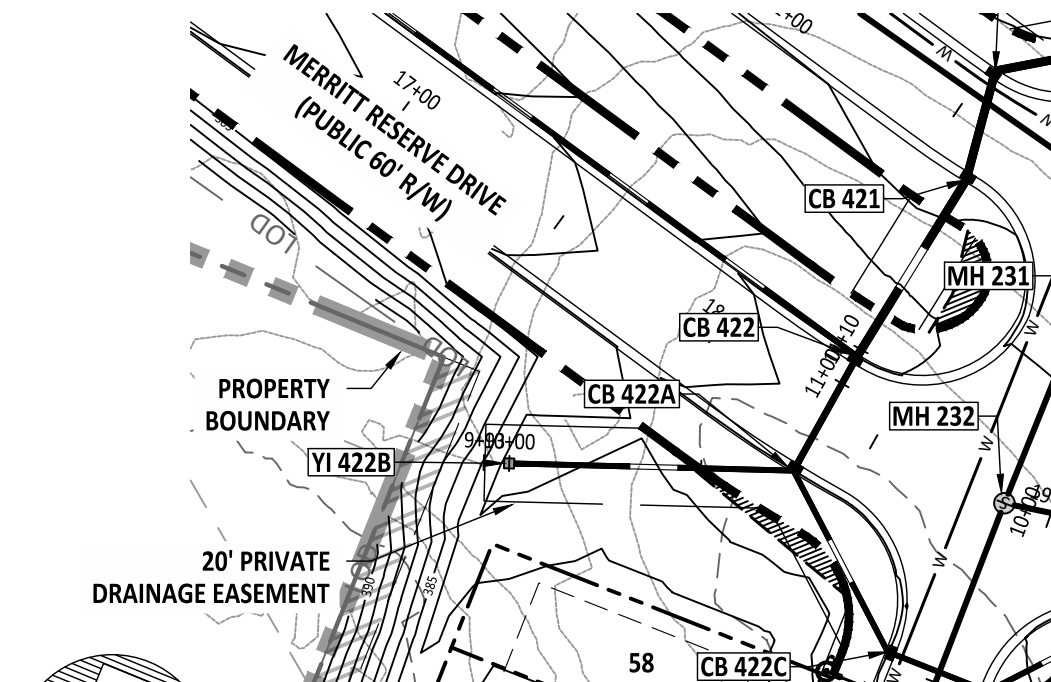


YI 422B TO CB 422 PLAN VIEW

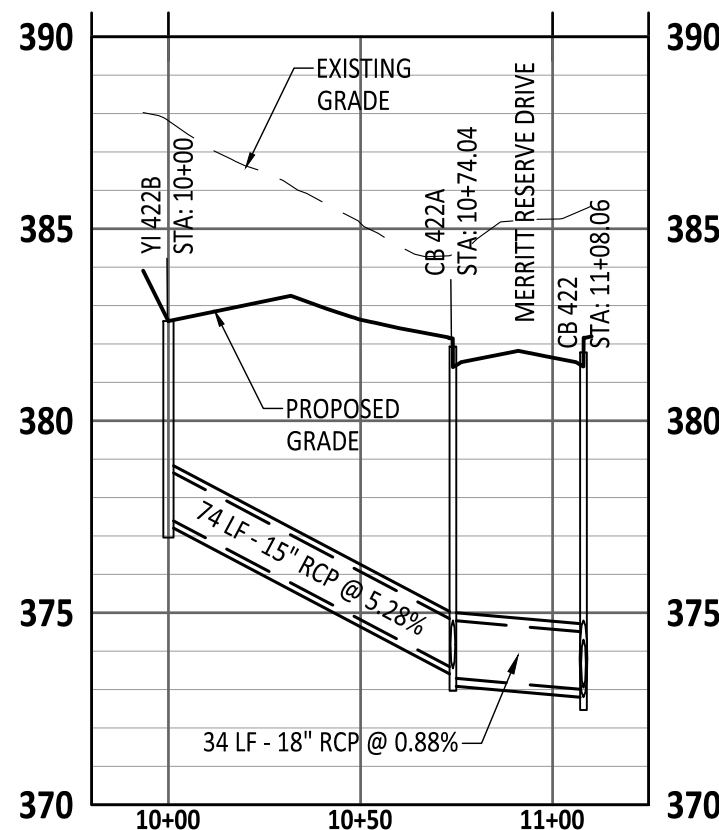


YI 422B TO CB 422 PROFILE







YI 407G TO CB 407 PLAN VIEW

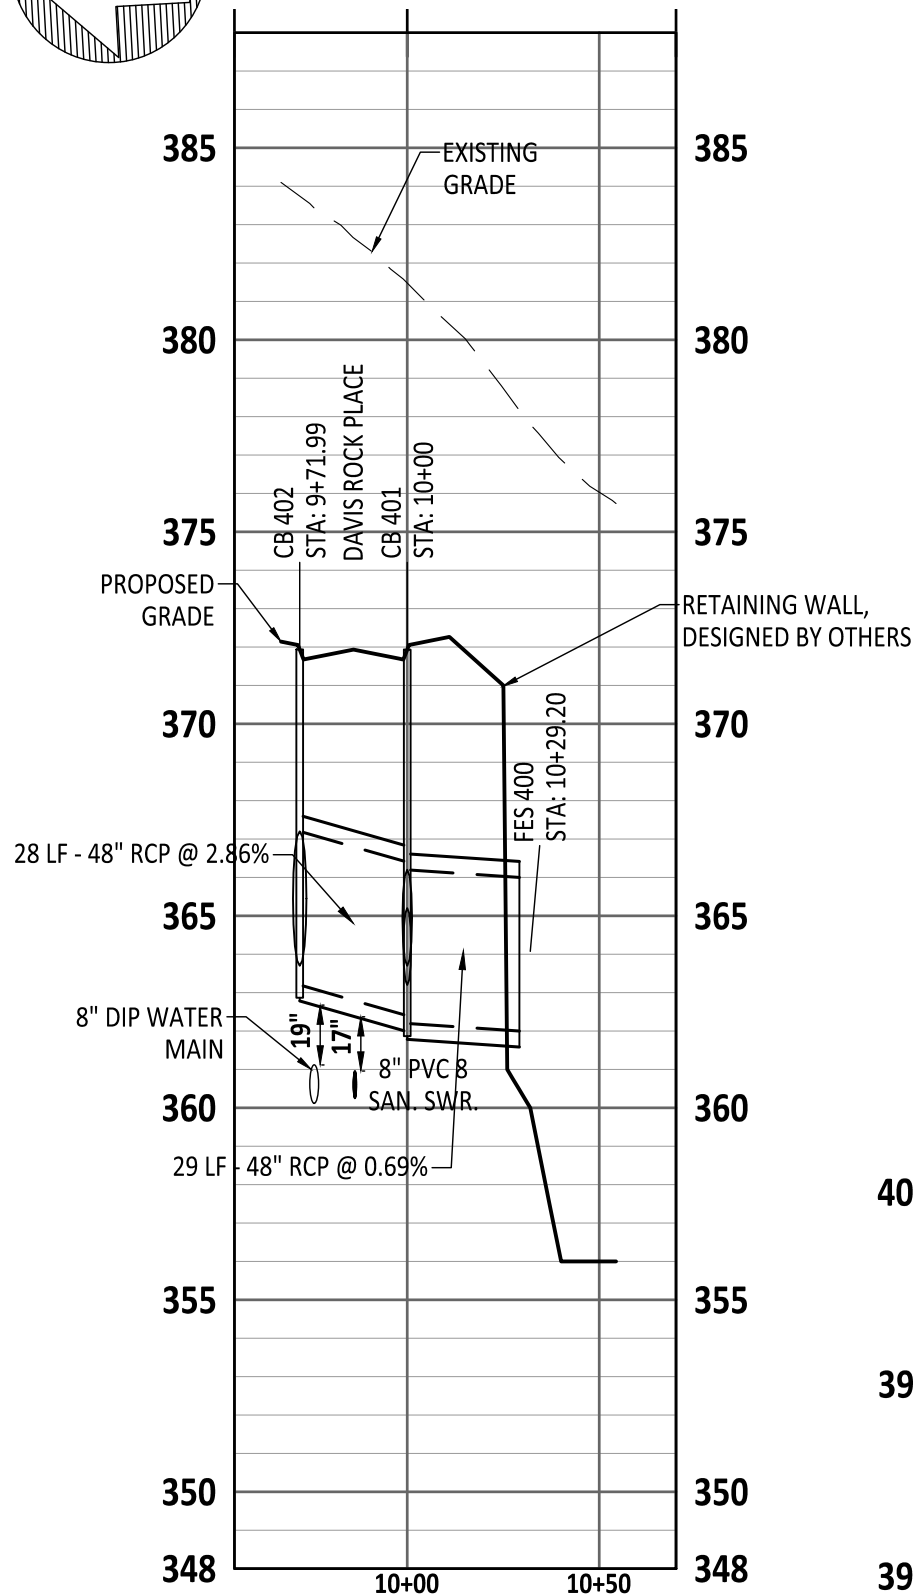

CB 402 TO FES 400 PROFILE

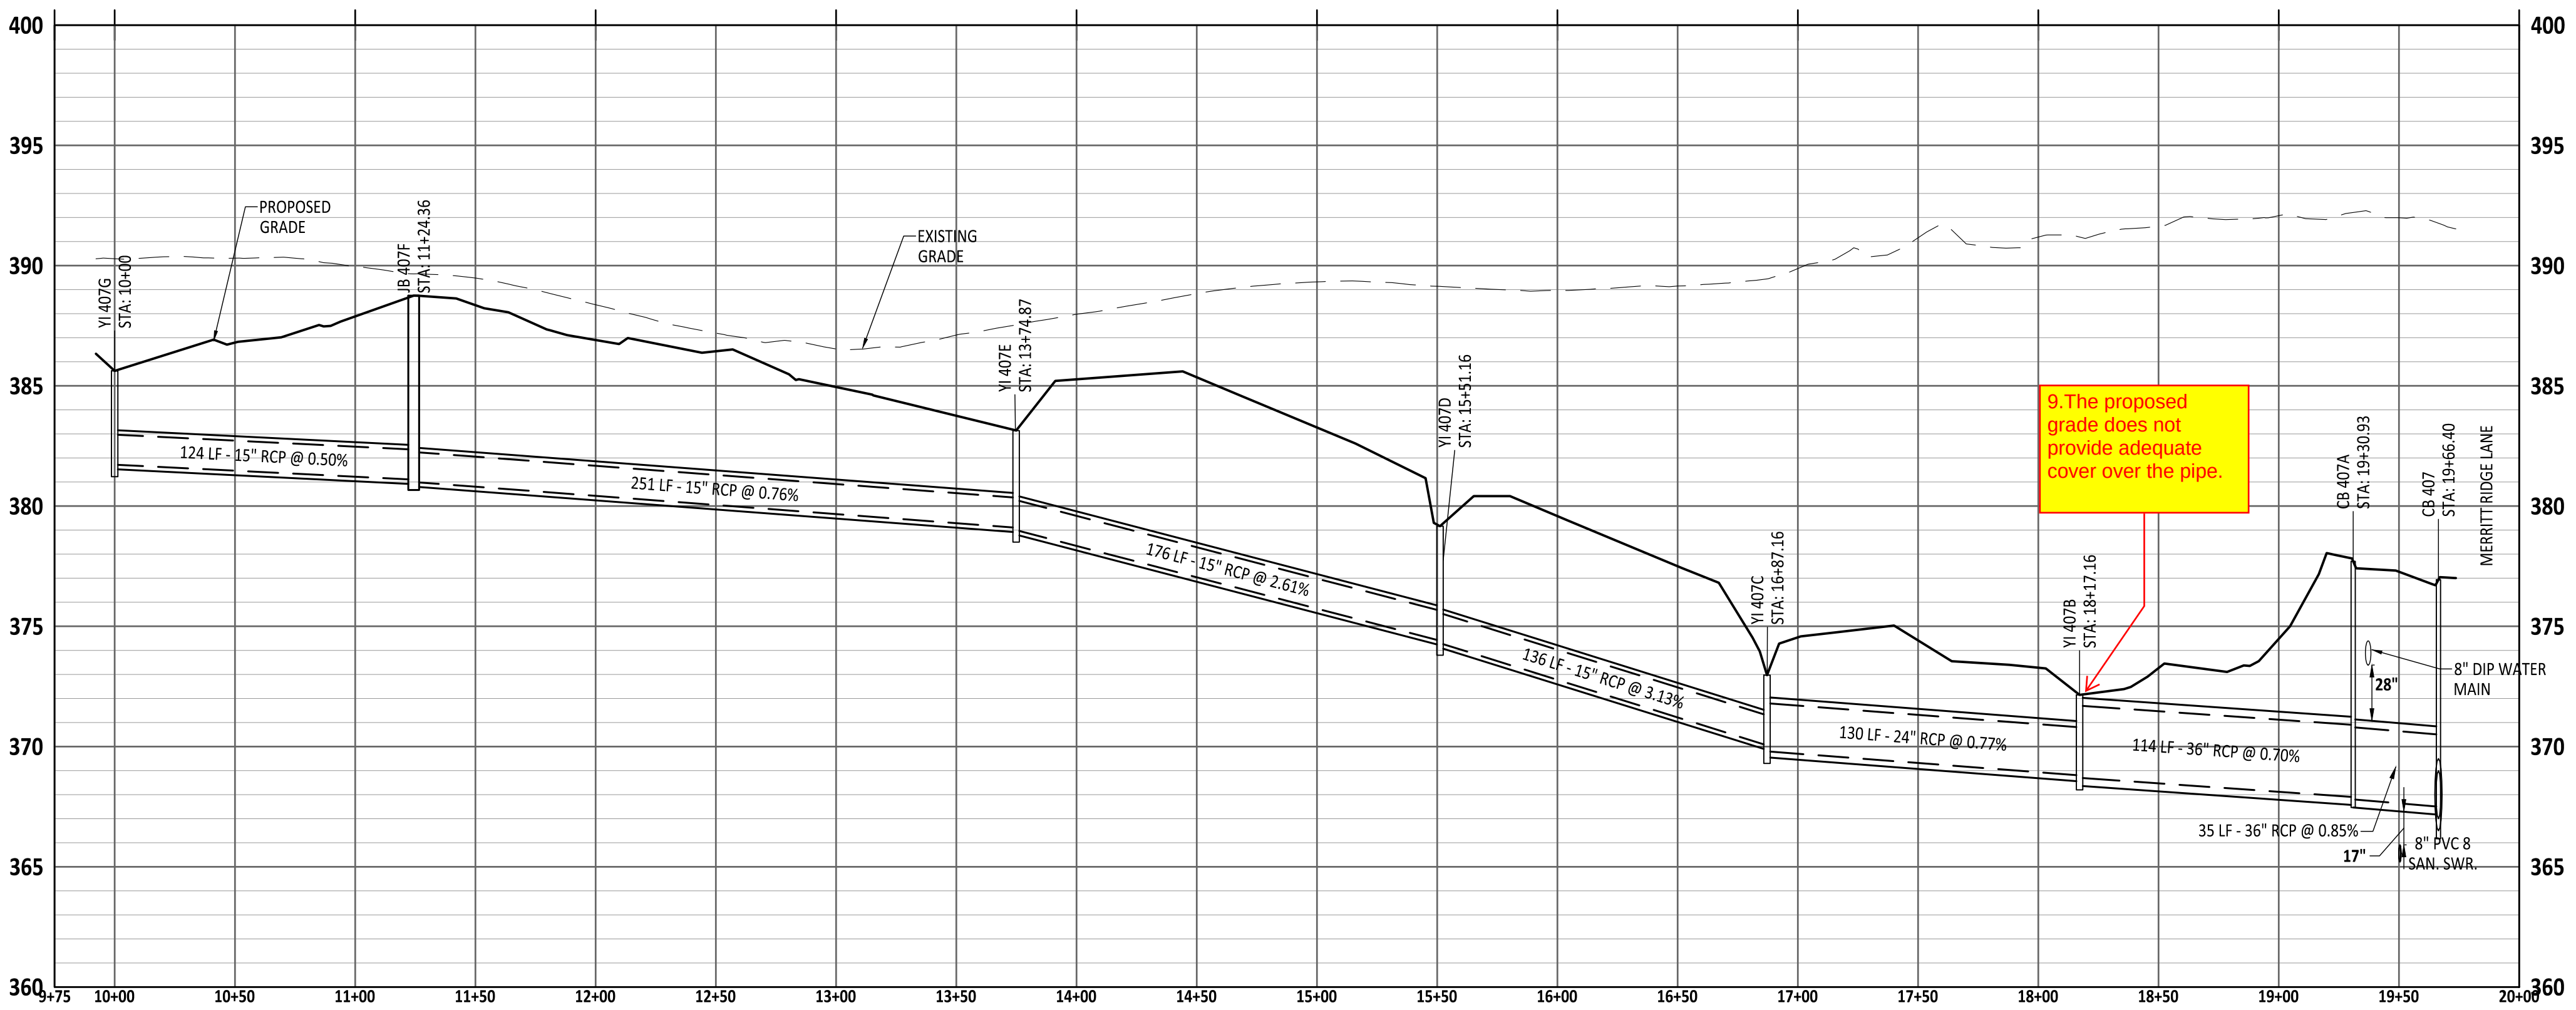

YI 407G TO CB 407 PROFILE

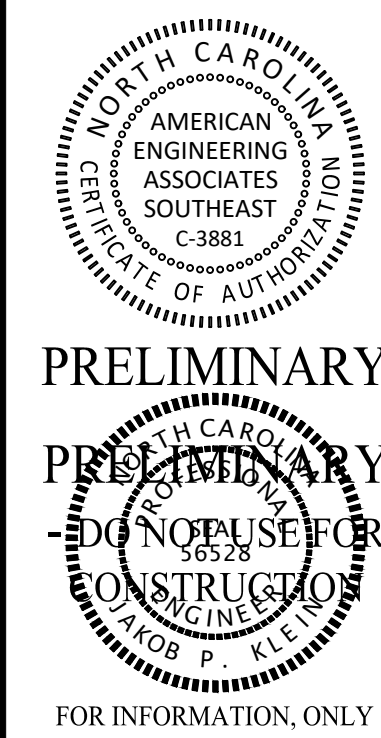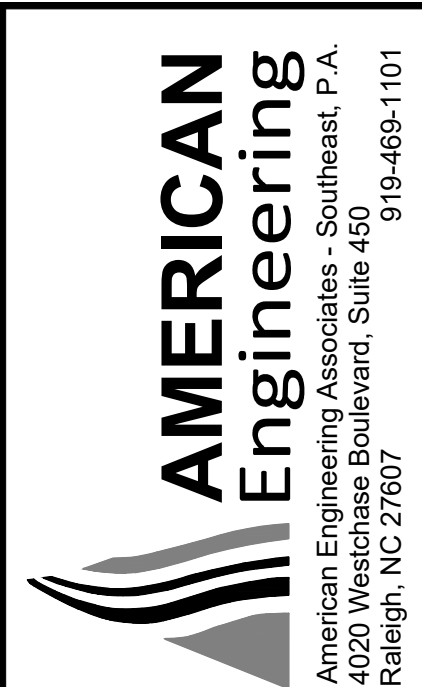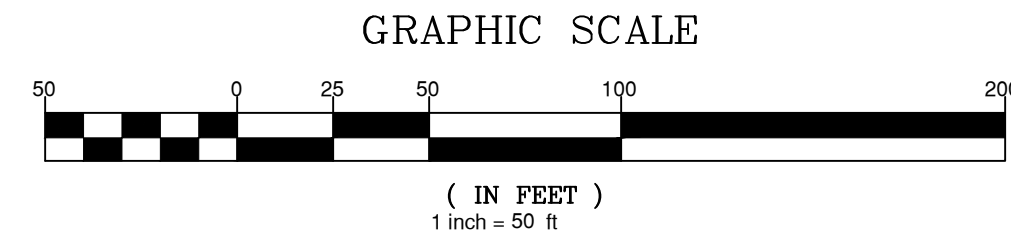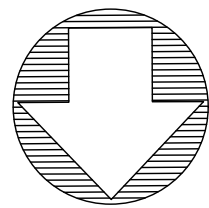

NO.	DATE	REVISION
1	07/01/25	FIRST REVISION SET
2	08/05/25	SECOND WAKE COUNTY SUBMITTAL

STIPULATION FOR REUSE

THIS DRAWING WAS PREPARED FOR USE ON THE SPECIFIC SITE, NAMED HEREON, CONTEMPORANEOUSLY WITH ITS ISSUE DATE AS LISTED, HEREON, AND IT IS NOT SUITABLE FOR USE ON A DIFFERENT PROJECT SITE OR AT A LATER TIME. USE OF THIS DRAWING FOR REFERENCE OR EXAMPLE ON ANOTHER PROJECT REQUIRES THE SERVICES OF PROPERLY LICENSED ARCHITECTS AND ENGINEERS. REPRODUCTION OF THIS DRAWING FOR REUSE ON ANOTHER PROJECT IS NOT AUTHORIZED AND MAY BE CONTRARY TO THE LAW.

MERRITT RESERVE

STORM OUTFALL PLAN & PROFILE

ROLESVILLE RD

WAKE COUNTY NC 27312

JOB NUMBER: 23-0004
CHECKED BY: JK
DRAWN BY: DH/MA/LL
DATE: 08/04/2025

STORM OUTFALL PLAN & PROFILE

SHEET NO.:
CU-306

PROJECT NUMBER = CID-25-02