



File Location: C:\Users\Tim Newsome\Quantech\Engineering - Documents\Harris Creek Farm - Jonesville\Engineering - DWG\Construction Plans\16 Overall Grading & Drainage Plan.dwg

MATCHLINE SEE SHEET 17

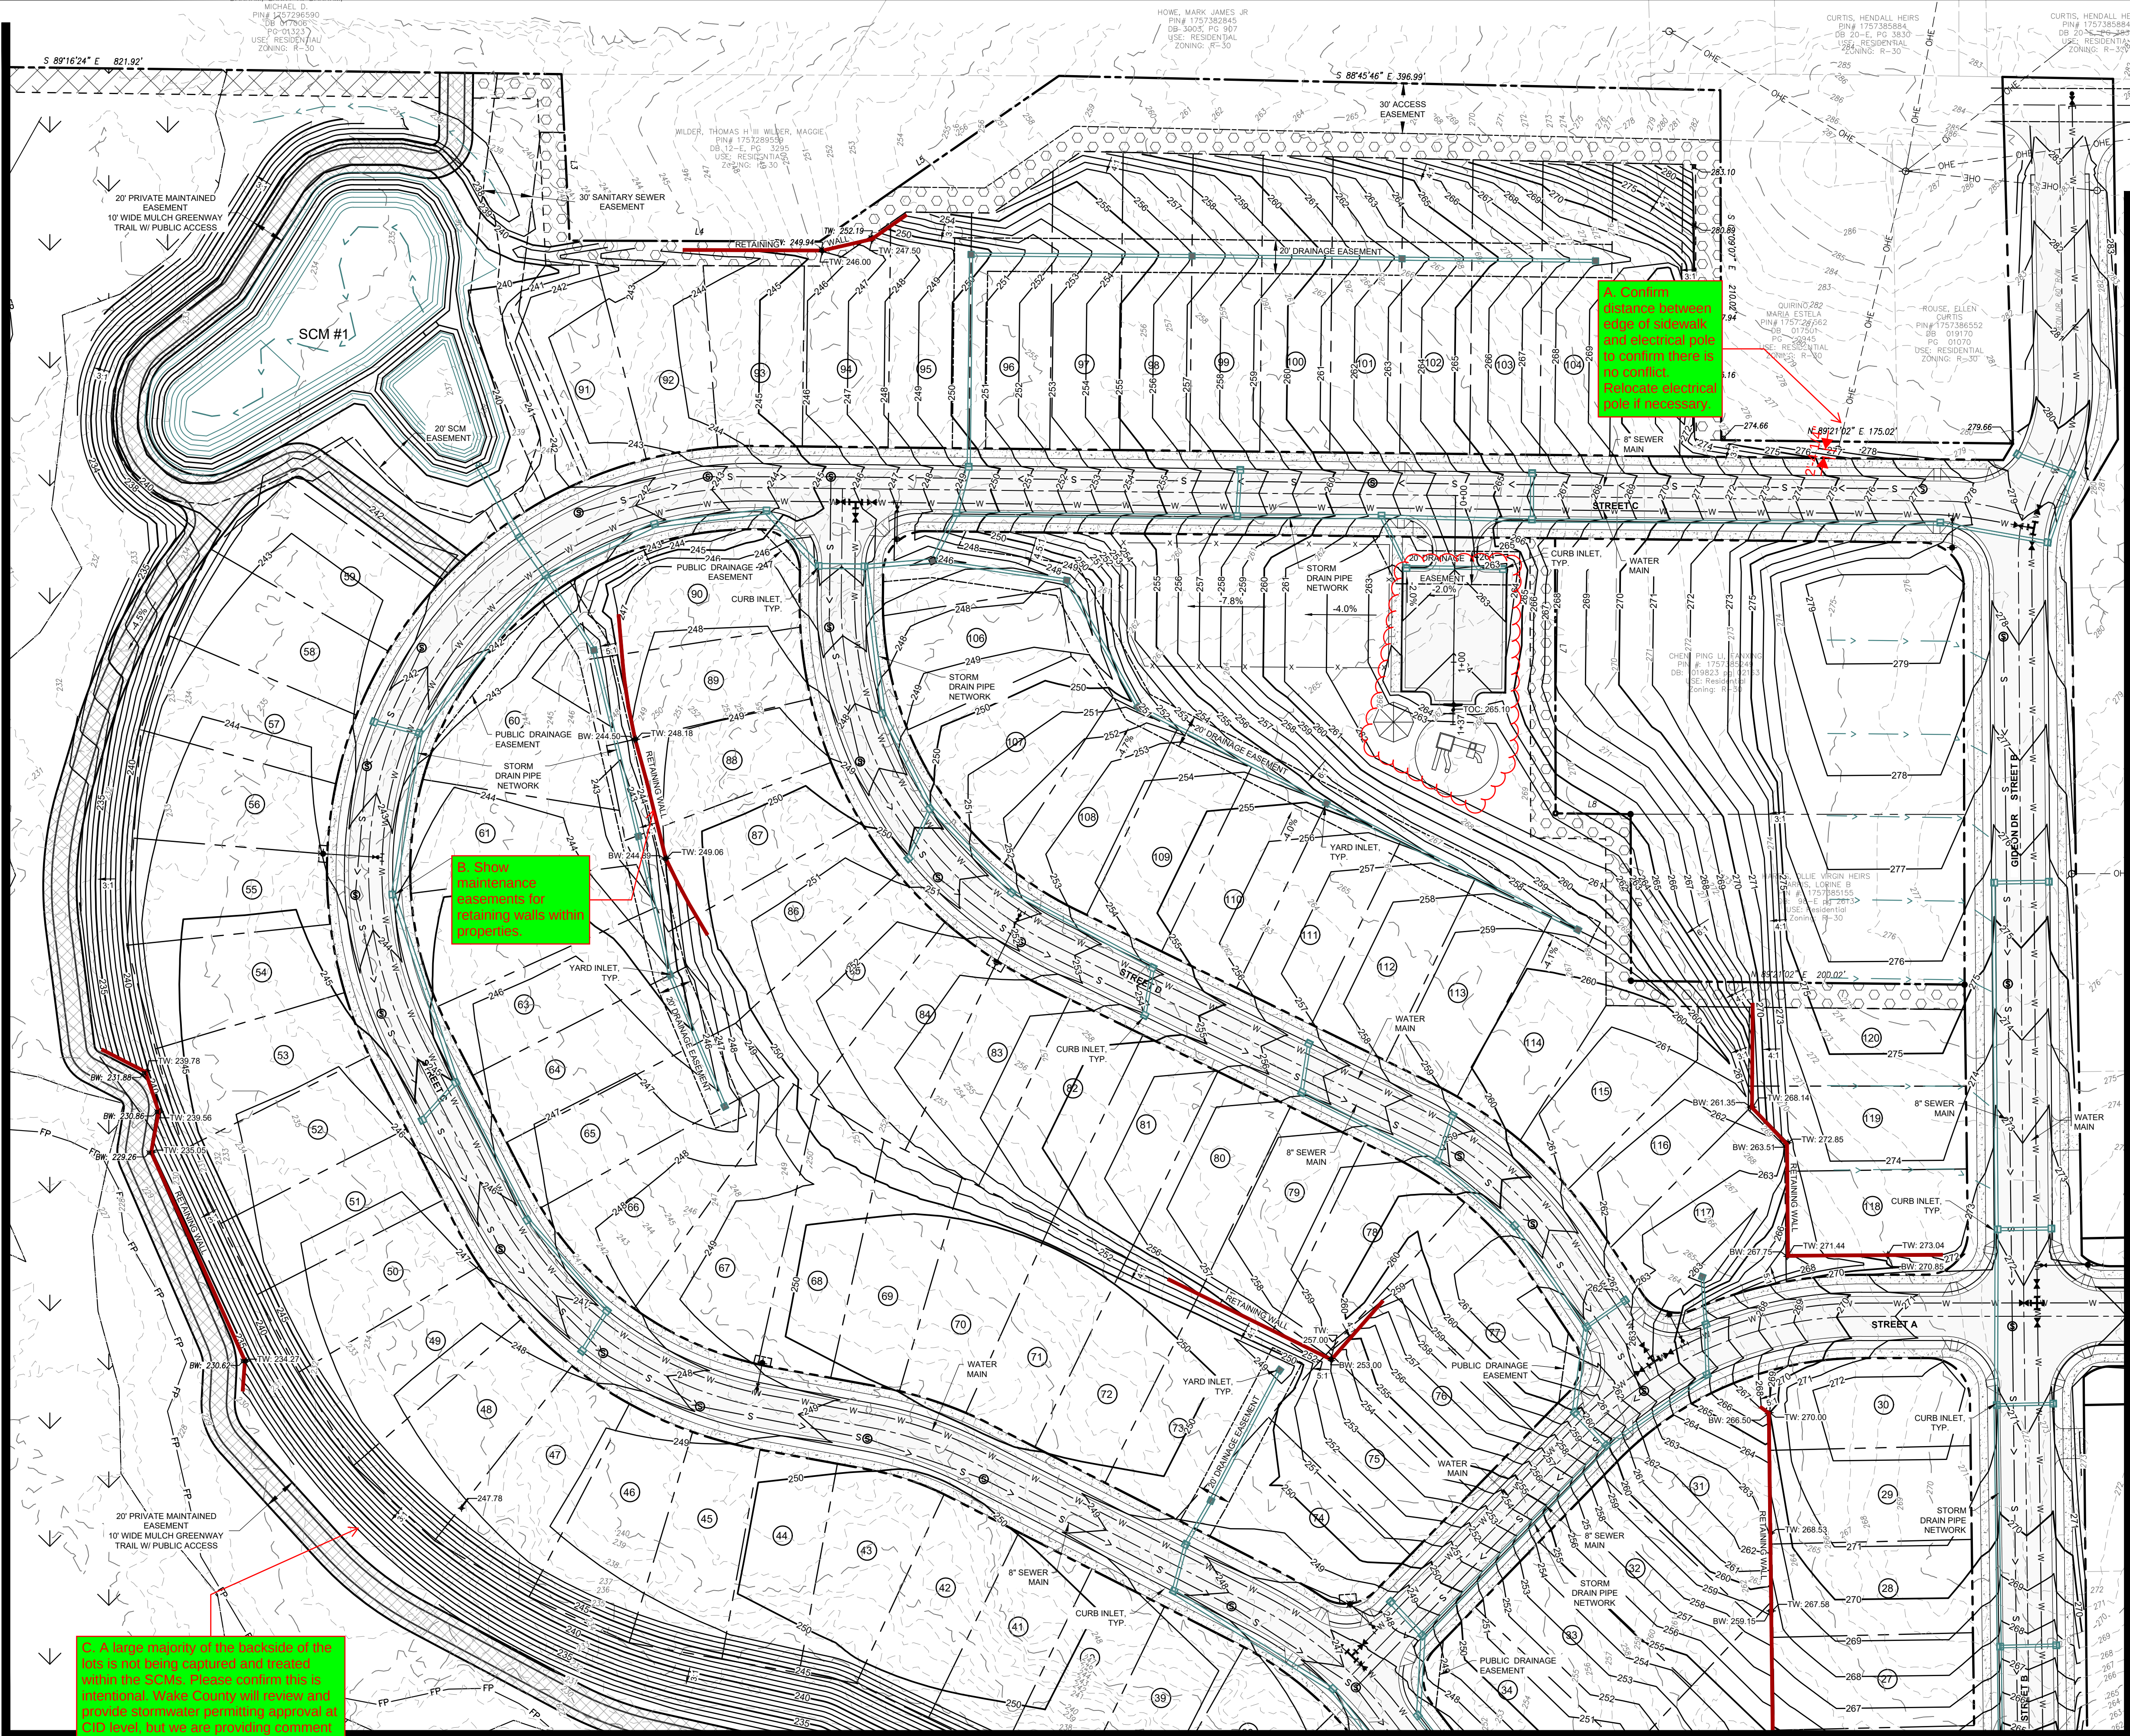

MATCHLINE SEE SHEET 21

- GRADING PLAN LEGEND**
- EXISTING MAJOR CONTOUR
 - EXISTING MINOR CONTOUR
 - PROPOSED MINOR CONTOUR
 - PROPOSED MAJOR CONTOUR
 - PROPOSED R.O.W.
 - PROPOSED LOT LINE
 - EXISTING SEWER LINE
 - EXISTING SEWER MANHOLE
 - PROPOSED SEWER LINE
 - PROPOSED SEWER MANHOLE
 - EXISTING WATER LINE
 - PROPOSED WATERLINE
 - PROPOSED GATE VALVE
 - EXISTING EASEMENT
 - PROPOSED EASEMENT
 - PROPOSED STORM WATER INLET
 - PROPOSED STORM PIPE
 - PROPOSED RETAINING WALL

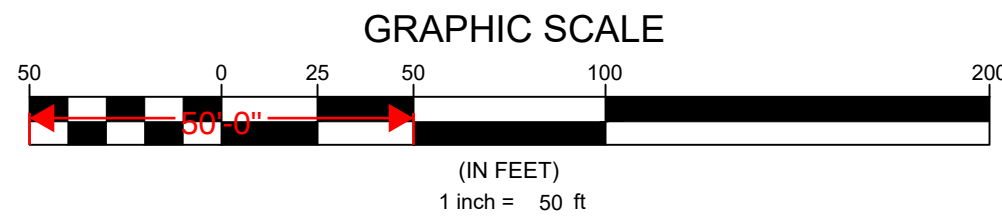

N.C. UNDERGROUND UTILITIES
811
3 DAYS BEFORE DIGGING CALL
TOLL FREE 811 or (800)632-4949
A ONE CALL SYSTEM FOR COMMUNITY AND JOB SAFETY

Developer
THE CSC GROUP
CONTRIBUTE TO THE SUCCESS OF LOCAL COMMUNITY
10030 Green Level Church Rd, Suite 802 #149, Cary, NC 27519

Engineer
QUANTECH ENGINEERING
INNOVATIVE SOLUTIONS | ENGINEERING THE FUTURE
Firm # F-1517
15000 Weston Parkway
Cary, N.C. 27513
(919) 996-9455

Surveyor
BCSO
Bateman Civil Survey Company
2524 Reliance Avenue
Apex, NC 27539
919-557-1080 ext 109
www.batemancivilsurvey.com

Jurisdiction / Municipality
Rolesville
Town of Rolesville
502 Southtown Cir
Rolesville, NC 27571
Phone: 919-554-6517
PSP-24-05

Other Consultants

Sheet map:

Seal:
NORTH CAROLINA
PROFESSIONAL
SEAL
53676
ENGINEER
BRYAN A. HAIR

PRELIMINARY - FOR REVIEW PURPOSES ONLY

Issued / Print Date: 2025-February-28 (09:14)
File Name: 16 Overall Grading & Drainage Plan.dwg

Last Saved by: Tim Newsome
Drawn by: TAN

Project:

HARRIS CREEK FARMS


Issued for: **PRELIMINARY PLANS DO NOT USE FOR CONSTRUCTION**

No.	Date	Description
1	11/08/24	Town of Rolesville Planning Dept. comments
2	02/07/25	Town of Rolesville Planning Dept. comments

Sheet Title: **GRADING & DRAINAGE PLAN SHEET 3 OF 6**

Sheet #:

File Location: C:\Users\Tim Newsome\Quantech\Engineering - Documents\Harris Creek Farm - Jonesville\Engineering - DWG\Construction Plans\16 Overall Grading & Drainage Plan.dwg

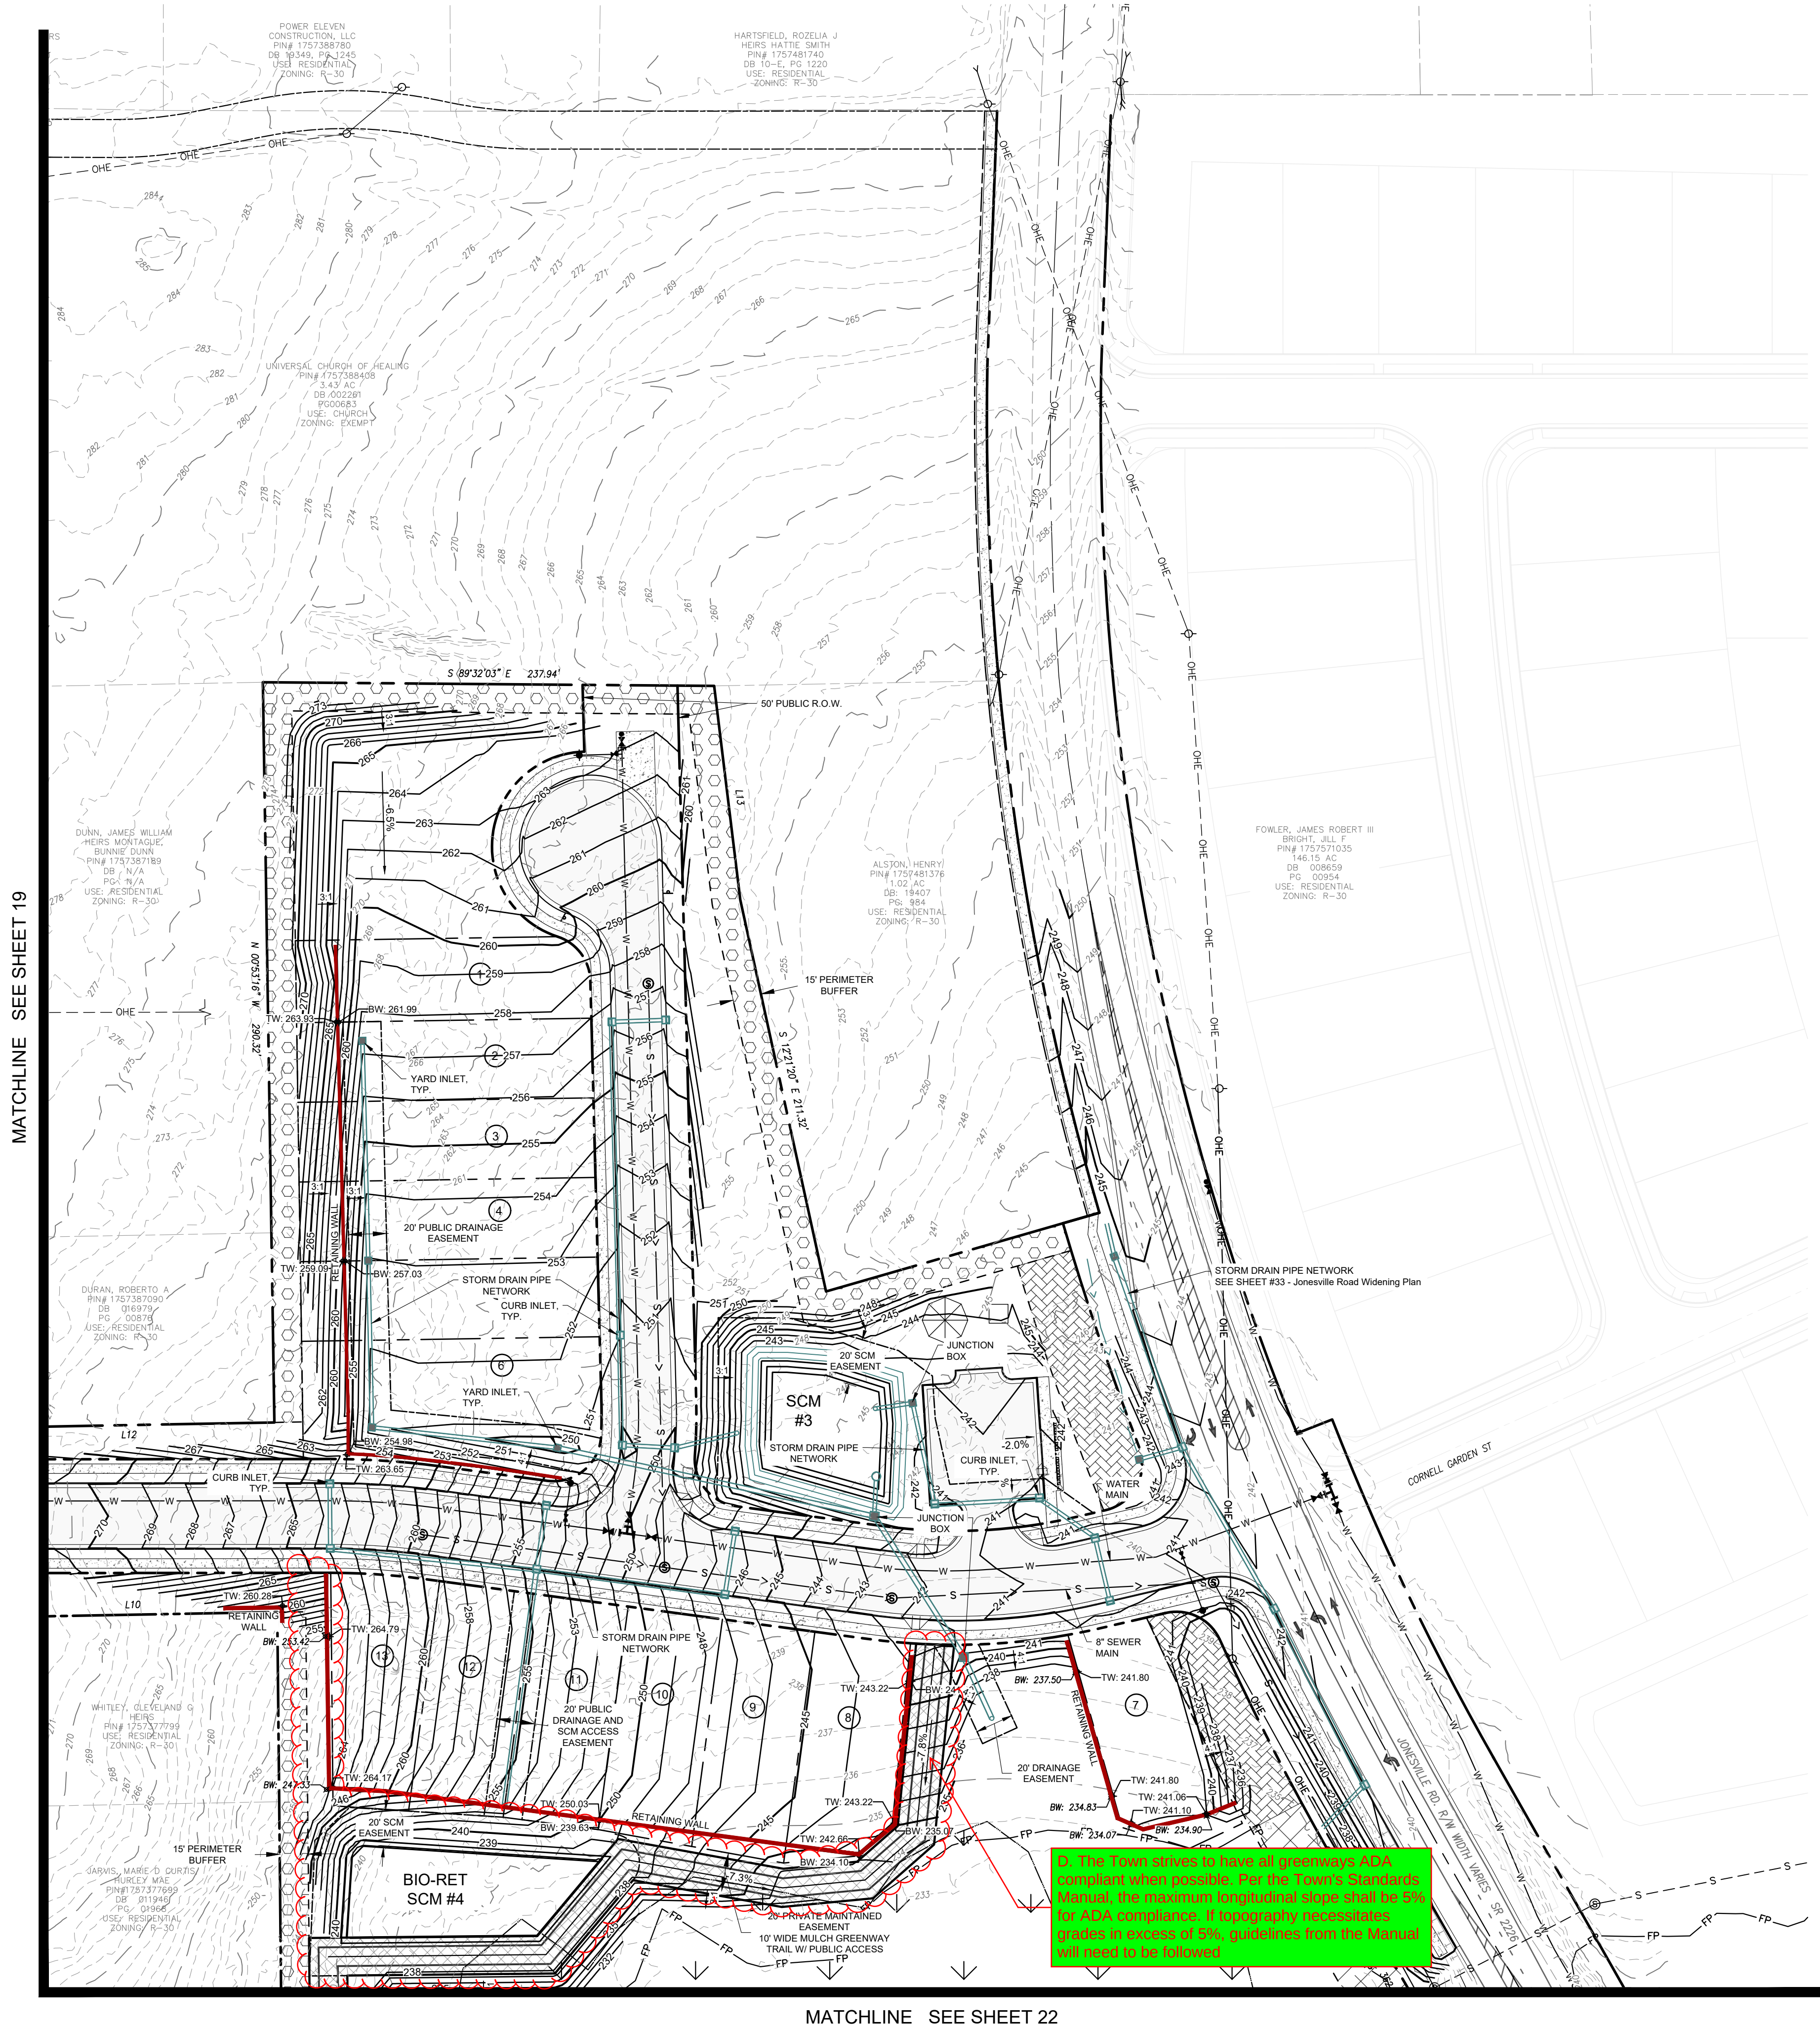


MATCHLINE SEE SHEET 19

MATCHLINE SEE SHEET 22



GRADING PLAN LEGEND

EXISTING MAJOR CONTOUR	---
EXISTING MINOR CONTOUR	- - - - -
PROPOSED MINOR CONTOUR	---
PROPOSED MAJOR CONTOUR	---
PROPOSED R.O.W.	---
PROPOSED LOT LINE	---
EXISTING SEWER LINE	---
EXISTING SEWER MANHOLE	⊙
PROPOSED SEWER LINE	---
PROPOSED SEWER MANHOLE	⊙
EXISTING WATER LINE	---
PROPOSED WATERLINE	---
PROPOSED GATE VALVE	⋈
EXISTING EASEMENT	---
PROPOSED EASEMENT	---
PROPOSED STORM WATER INLET	⊠
PROPOSED STORM PIPE	---
PROPOSED RETAINING WALL	---

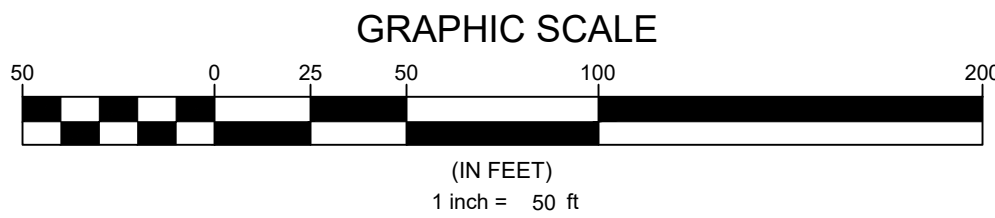


Developer
THE CSC GROUP
CONTRIBUTE TO THE SUCCESS OF LOCAL COMMUNITY
10030 Green Level Church Rd, Suite 802 #149, Cary, NC 27519

Engineer
QUANTECH ENGINEERING
INNOVATIVE SOLUTIONS | ENGINEERING THE FUTURE
Firm # F-1517
15000 Weston Parkway
Cary, N.C. 27513
(919) 996-9455

Surveyor
BCSC Bateman Civil Survey Company
2524 Reliance Avenue
Apex, NC 27539
919-557-1080 ext 109
www.batemancivilsurvey.com

Jurisdiction / Municipality
Rolesville
Town of Rolesville
502 Southtown Cir
Rolesville, NC 27571
Phone: 919-554-6517
PSP-24-05

Other Consultants

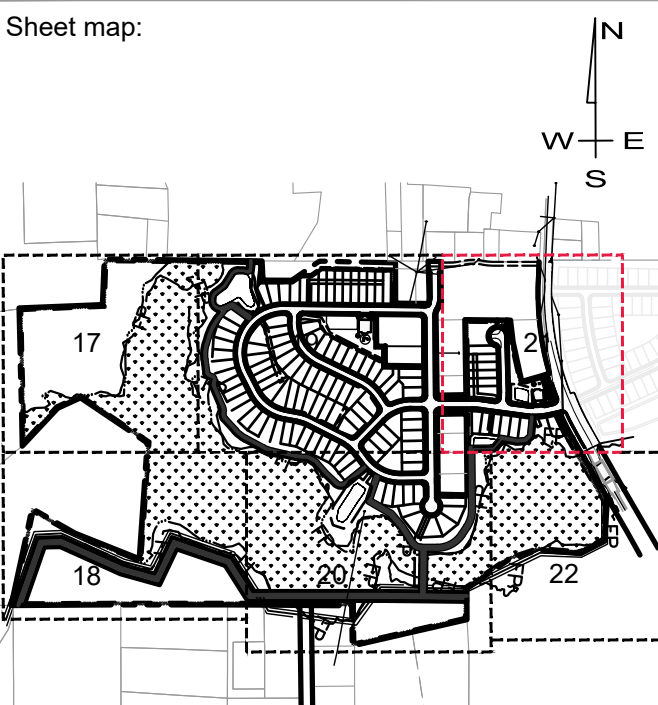

Seal:

PRELIMINARY - FOR REVIEW PURPOSES ONLY

Issued / Print Date: 2025-February-28 (09:14)
File Name: 16 Overall Grading & Drainage Plan.dwg

Last Saved by: Tim Newsome
Drawn by: TAN

Project:


HARRIS CREEK FARMS

Issued for: **PRELIMINARY PLANS**
DO NOT USE FOR CONSTRUCTION


No.	Date	Description
1	11/08/24	Town of Rolesville Planning Dept. comments
2	02/07/25	Town of Rolesville Planning Dept. comments

GRADING & DRAINAGE PLAN SHEET 5 OF 6

Sheet #:

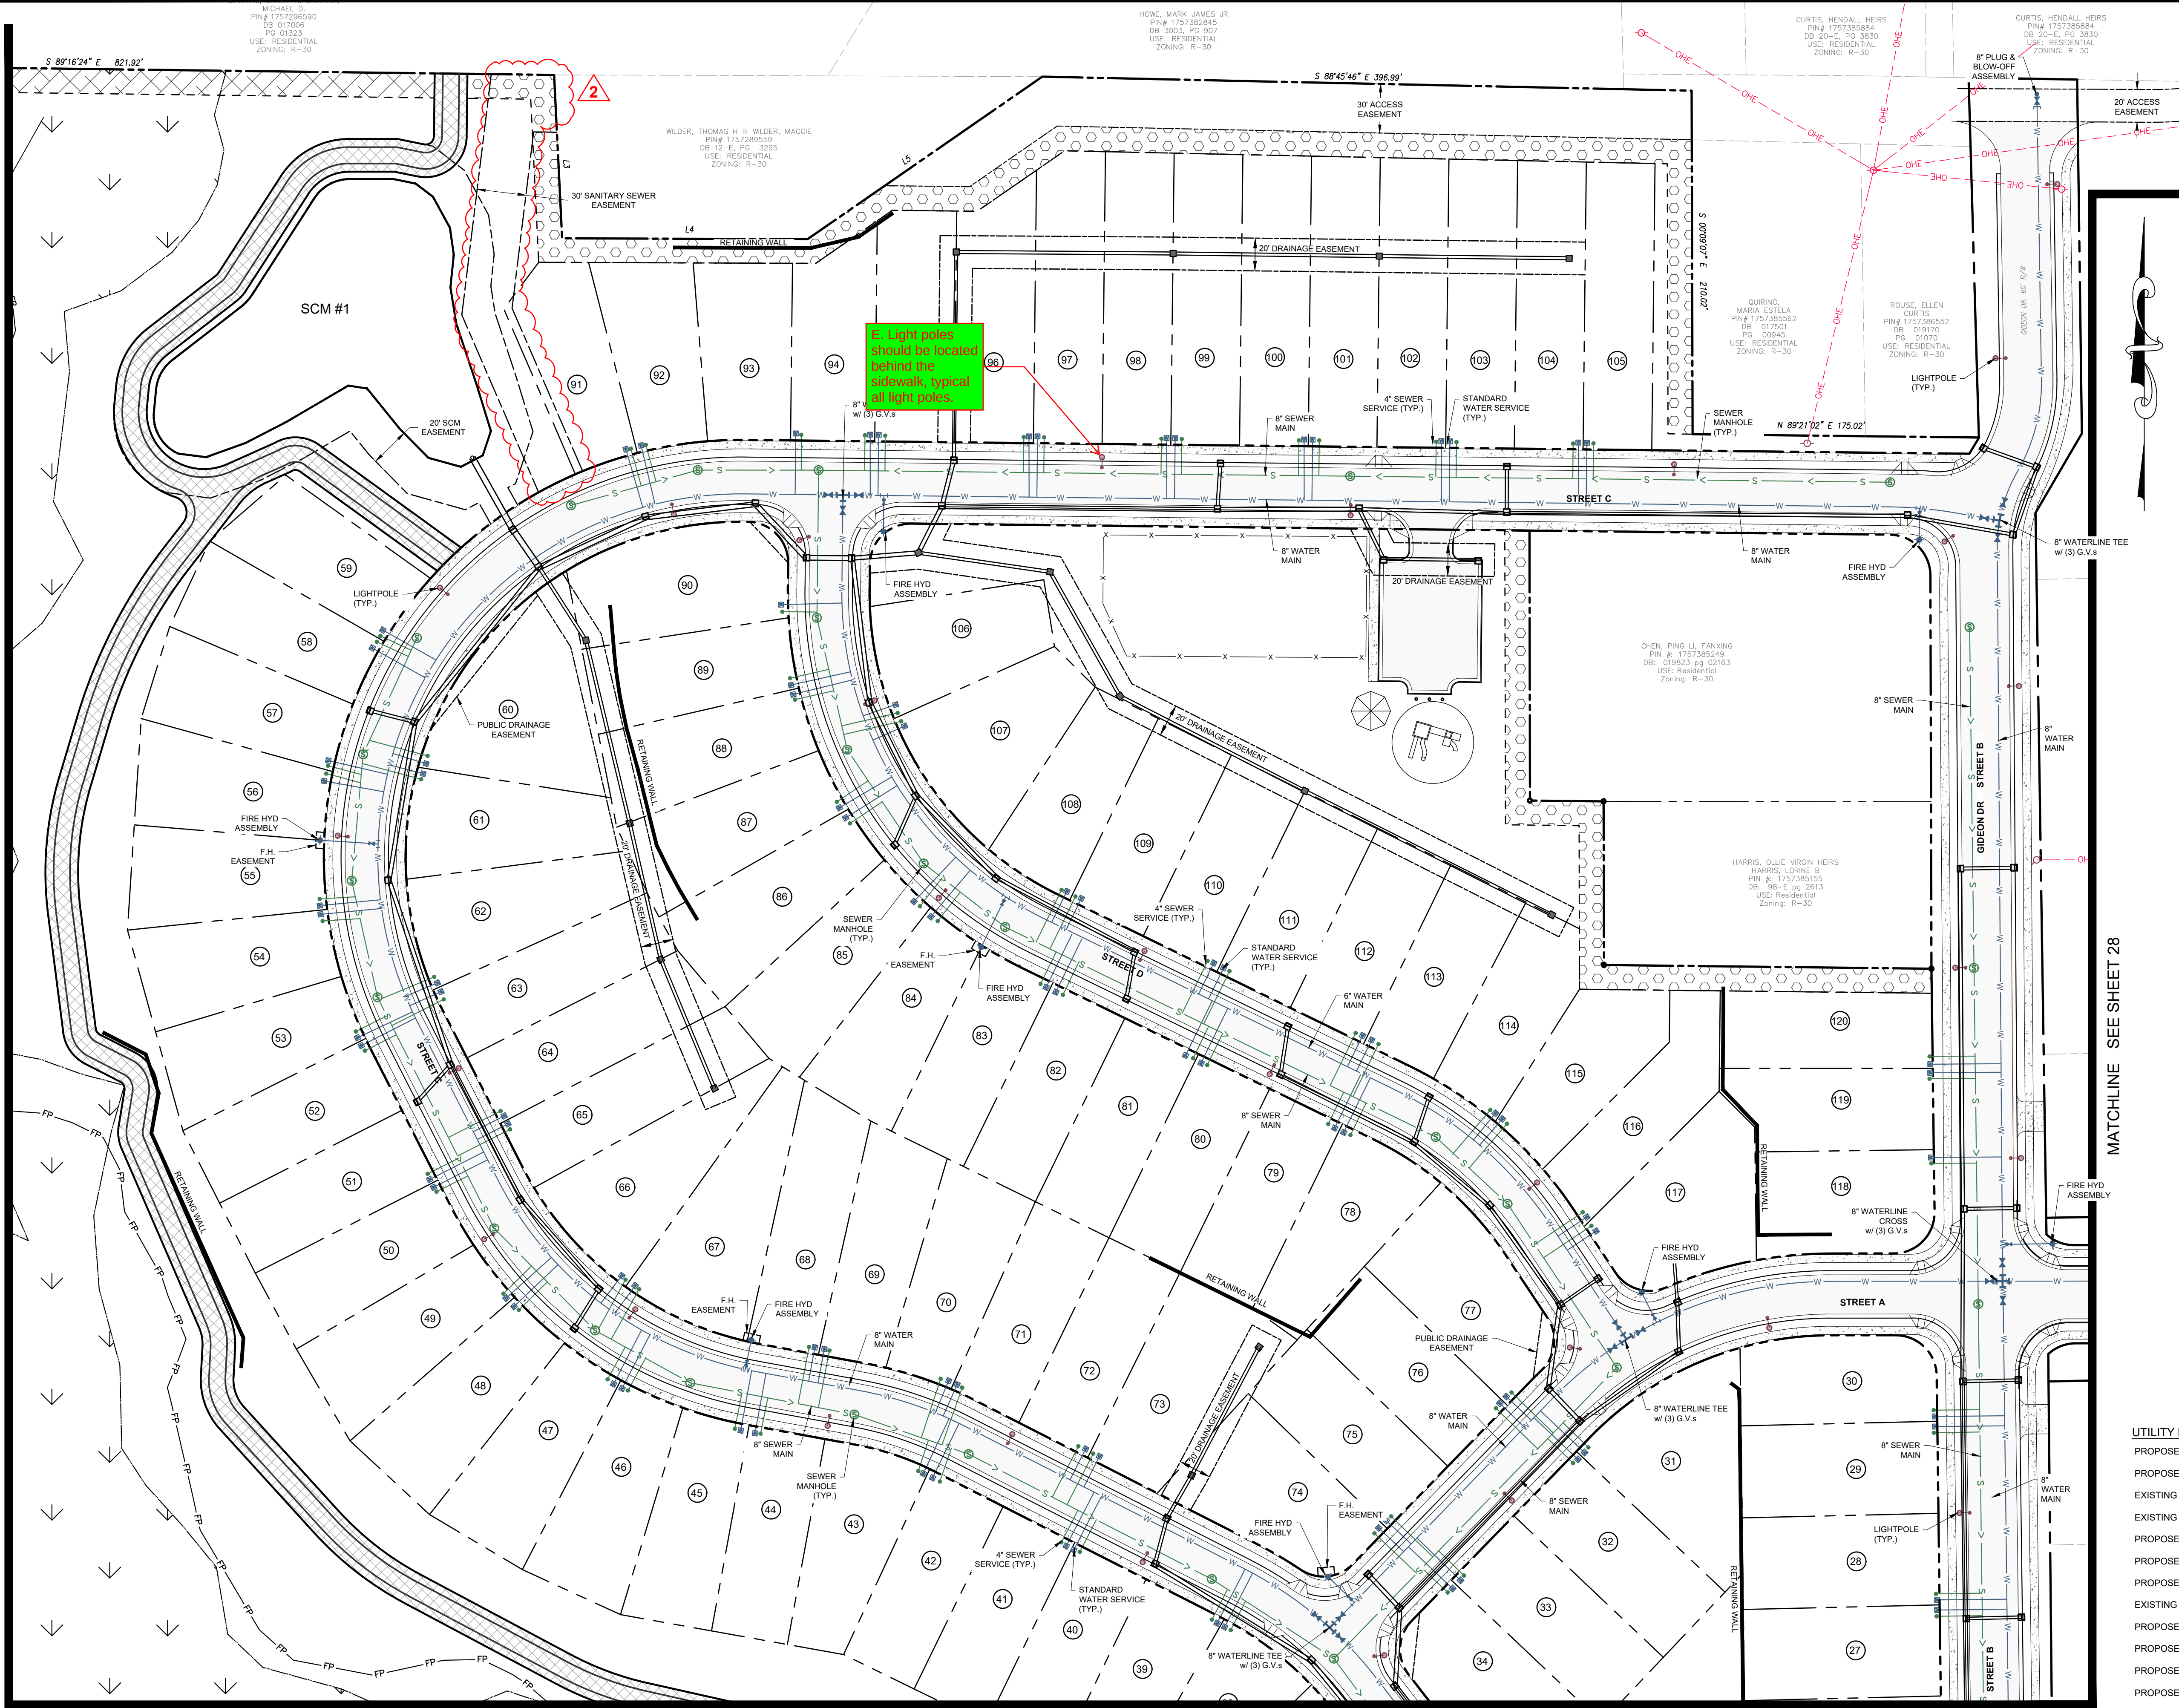

Developer  THE CSC GROUP CONTRIBUTE TO THE SUCCESS OF LOCAL COMMUNITY	
10030 Green Level Church Rd, Suite 802 #149: Cary, NC 27519	
Engineer  QUANTECH ENGINEERING INNOVATIVE SOLUTIONS ENGINEERING THE FUTURE Firm # F-1517 15000 Weston Parkway Cary, N.C. 27513 (919) 996-9455	
Surveyor 	Batemans Civil Survey Company 2524 Reliance Avenue Apex, NC 27539 919-557-1080 ext 109 www.batemancivilsurvey.com
Jurisdiction / Municipality 	Town of Rolesville 502 Southtown Cir Rolesville, NC 27571 Phone: 919-554-6517 PSP-2005
Other Consultants	

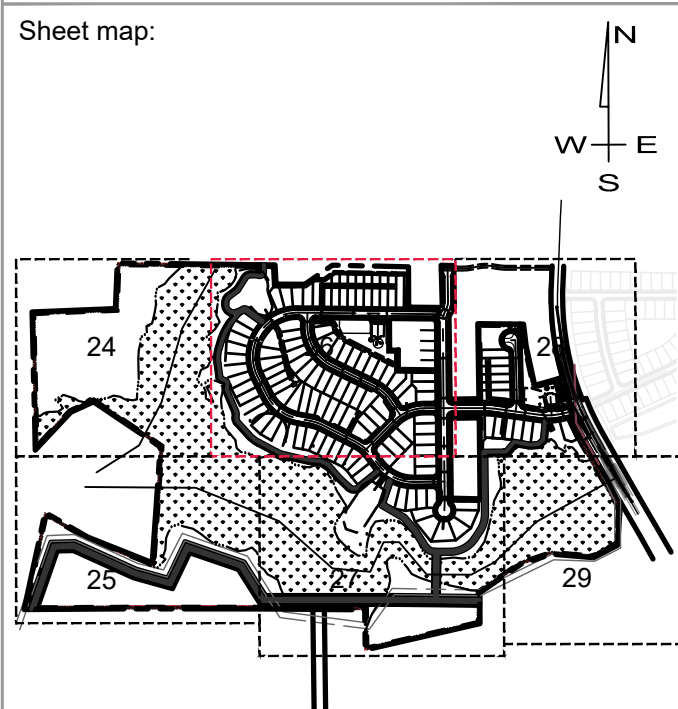

Seal:



PRELIMINARY - FOR
REVIEW PURPOSES ONLY

Issued / Print Date: 2025-February-28 (09:16)
File Name: 233 Overall Utility Plan.dwg

Last Saved by: Tim Newsome
Drawn by: TAN

Project:

HARRIS CREEK FARMS





Issued for: <u>PRELIMINARY PLANS</u> <u>DO NOT USE FOR</u> <u>CONSTRUCTION</u>		
REVISIONS		
No.	Date	Description
1	11/08/24	Town of Rolesville Planning Dept. comments
2	02/07/25	Town of Rolesville Planning Dept. comments

Sheet Title:

UTILITY PLAN
SHEET 3 OF 6

Sheet #:

File Location: C:\Users\Tim Newsome\Quantech\Engineering - Documents\Harris Creek Farm - Jonesville\Engineering - DWG\Construction Plans\33 Road and Waterline plans.dwg

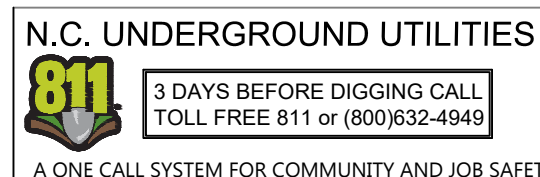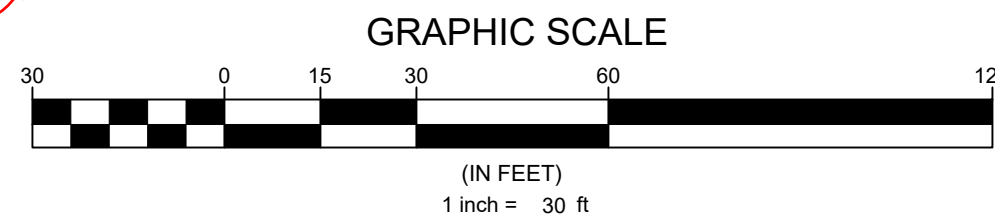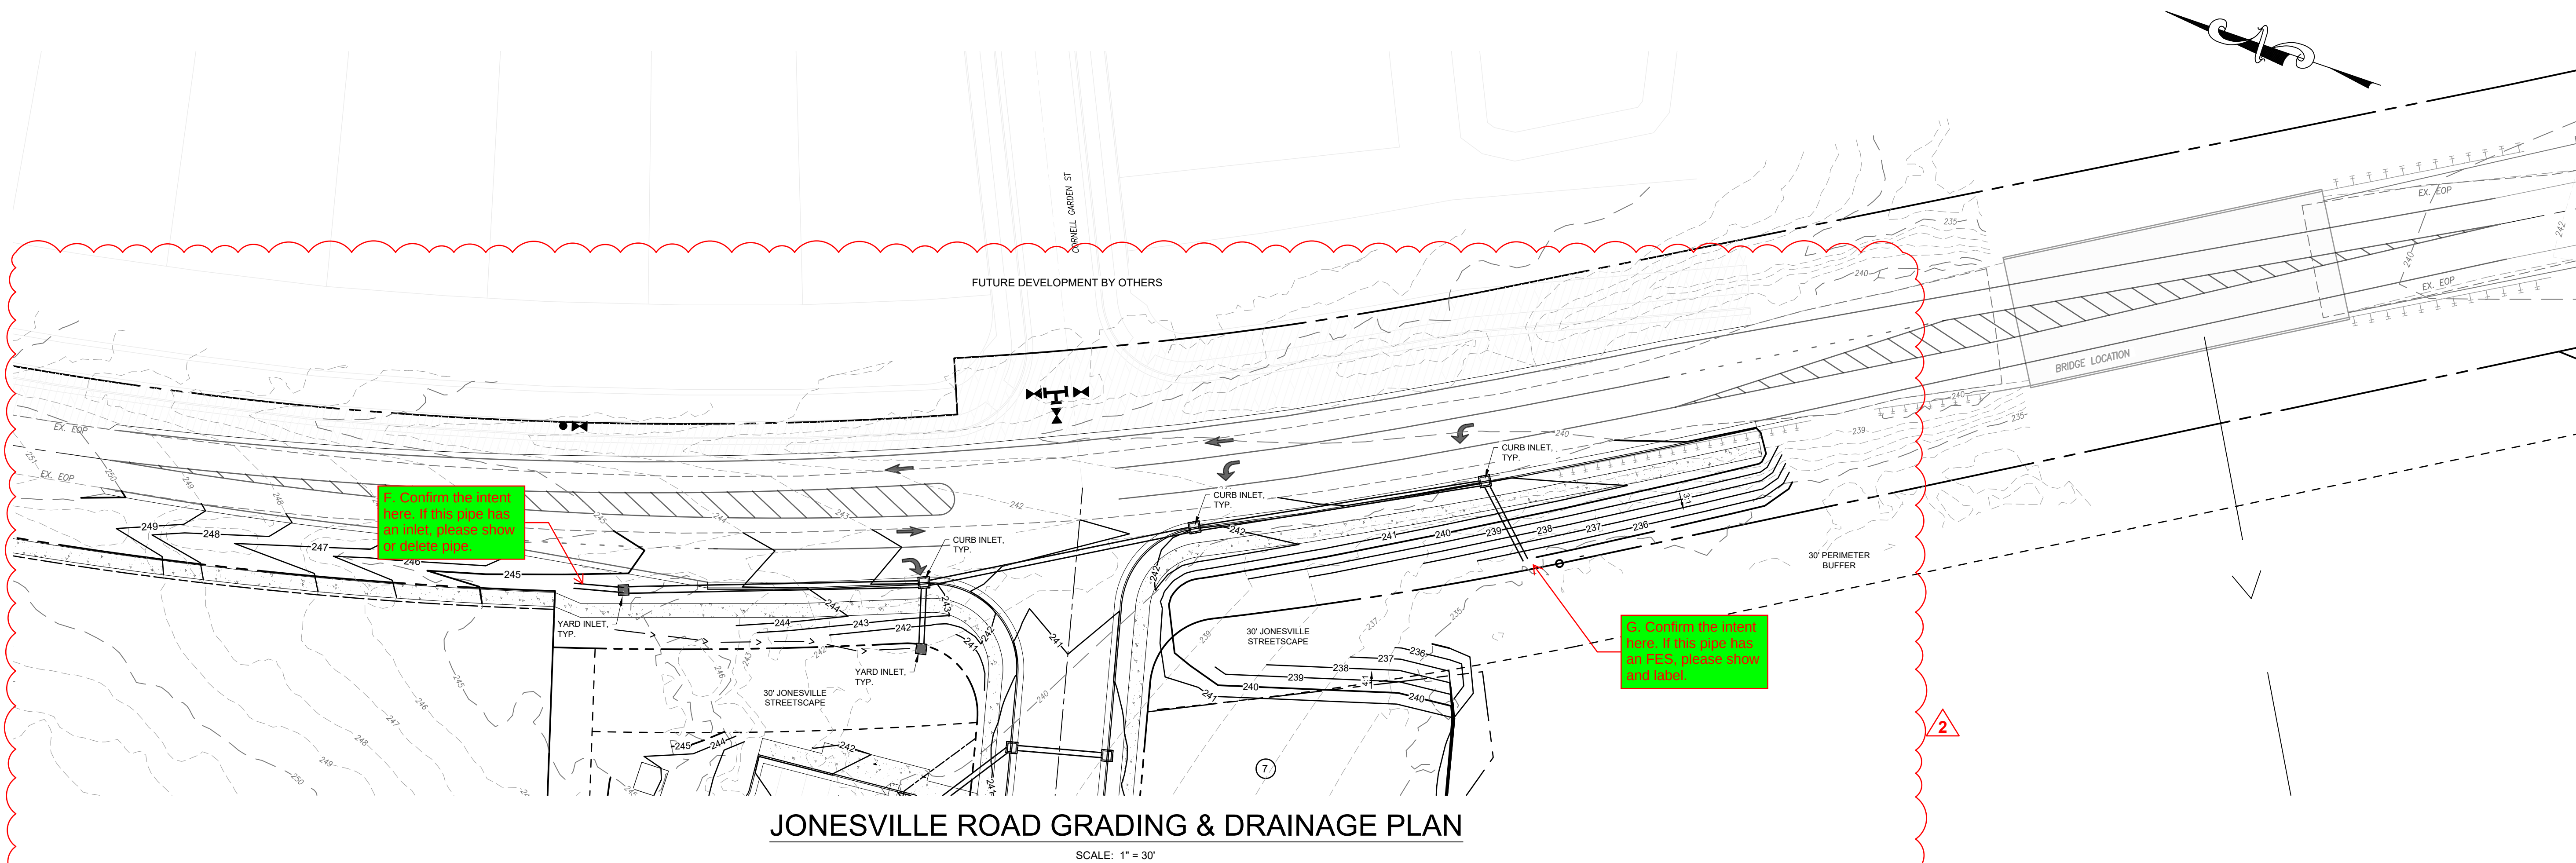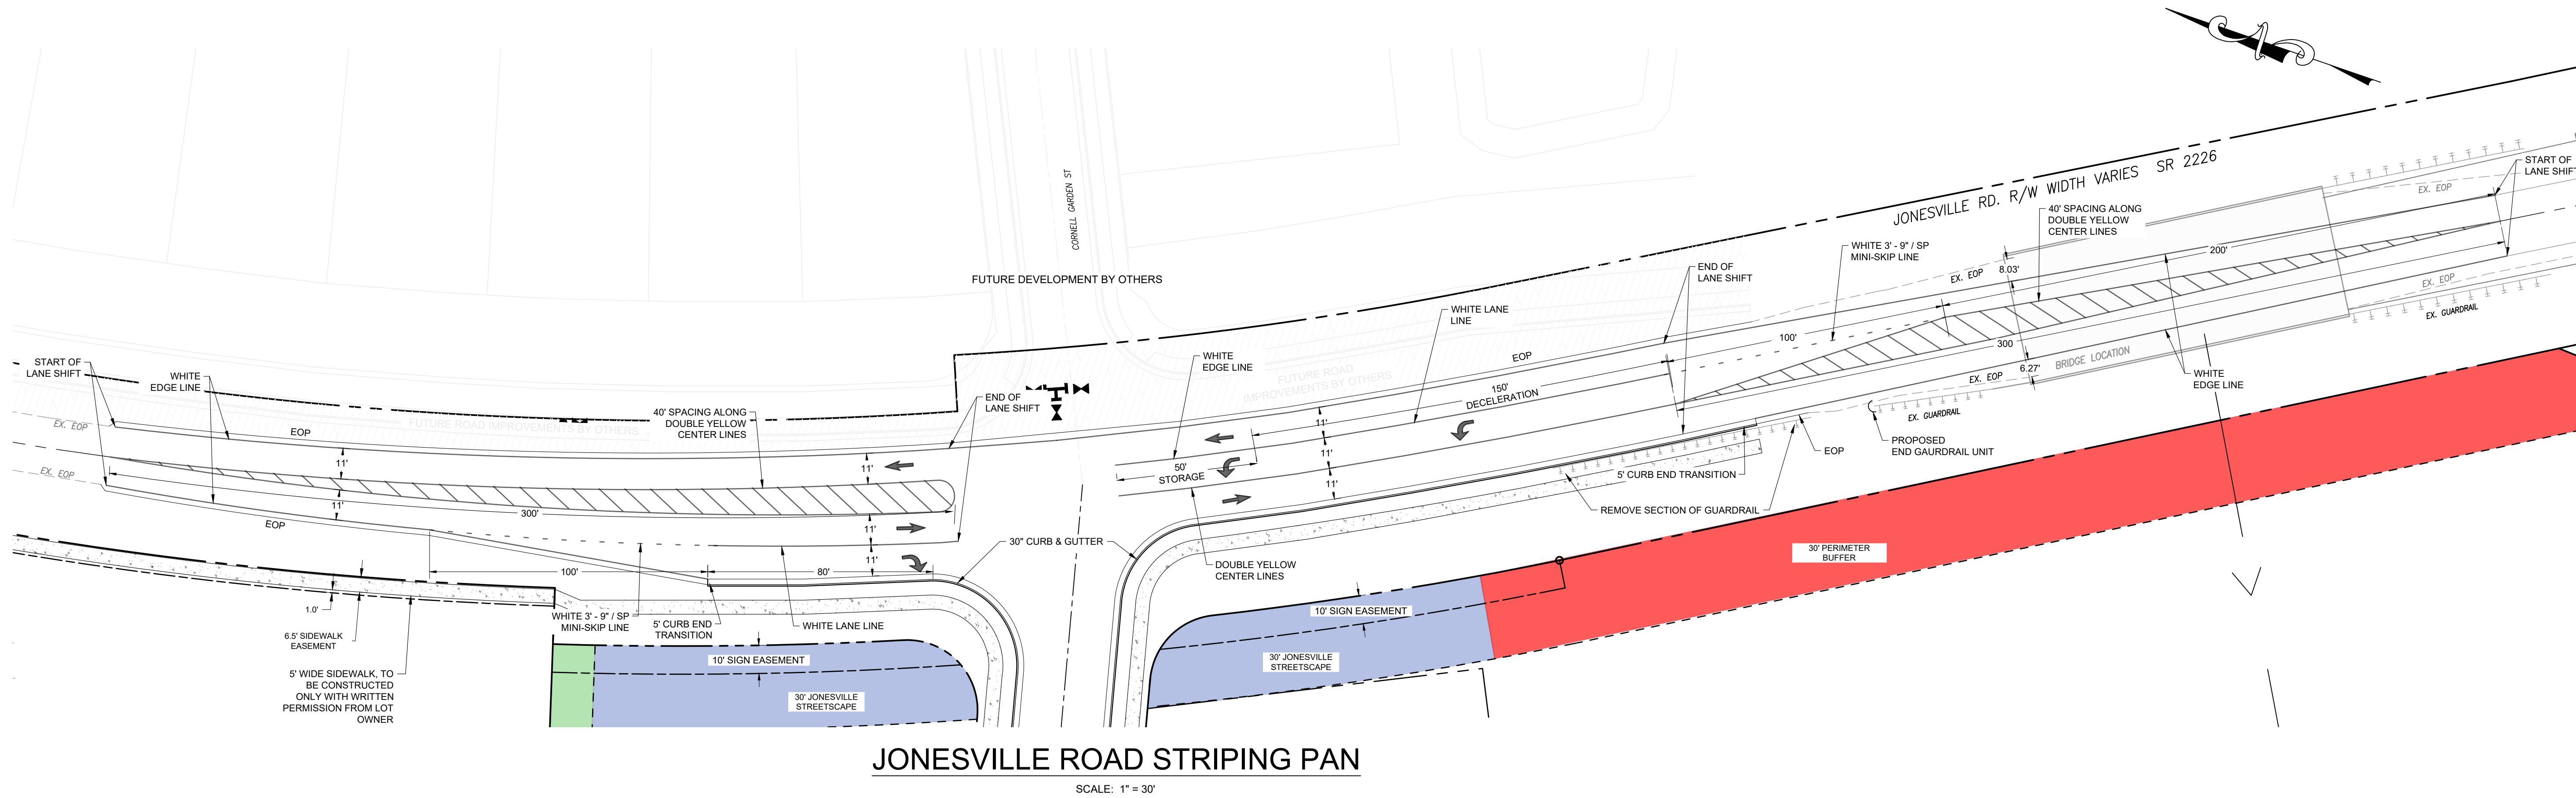

Developer
THE CSC GROUP
CONTRIBUTE TO THE SUCCESS OF LOCAL COMMUNITY
10030 Green Level Church Rd, Suite 802 #149: Cary, NC 27519

Engineer
QUANTECH ENGINEERING
INNOVATIVE SOLUTIONS | ENGINEERING THE FUTURE
Firm # F-1517
15000 Weston Parkway
Cary, N.C. 27513
(919) 996-9455

Surveyor

Jurisdiction / Municipality
Rolesville
Town of Rolesville
502 Southtown Cir
Rolesville, NC 27571
Phone: 919-554-6517
PSP-24-05

Other Consultants

Sheet map:

Seal:
PROFESSIONAL SEAL
53676
BYRON A. HARRIS
PRELIMINARY - FOR REVIEW PURPOSES ONLY

Issued / Print Date: 2025-February-28 (09:17)
File Name: 33 Road and Waterline plans.dwg

Last Saved by: Tim Newsome
Drawn by: TAN

Project:
HARRIS CREEK FARMS

Issued for: **PRELIMINARY PLANS DO NOT USE FOR CONSTRUCTION**

No.	Date	Description
1	11/08/24	Town of Rolesville Planning Dept. comments
2	02/07/25	Town of Rolesville Planning Dept. comments

Sheet Title:
JONESVILLE ROAD WIDENING PLAN

Sheet #:
33