

V3 - SDP-23-08 Tidal Wave Car Wash

TIDAL WAVE AUTO SPA


ROLESVILLE, NC, USA

TOWN PROJECT ID # V1-SDP-23-08




MOUNT PLEASANT, SC
843.884.1667
GREENVILLE, SC
864.298.0534
SUMMERVILLE, SC
843.972.0710
SPARTANBURG, SC
864.272.1272
CHARLOTTE, NC
980.312.5450
WWW.SEAMONWHITESIDE.COM

SITE LOCATION MAP

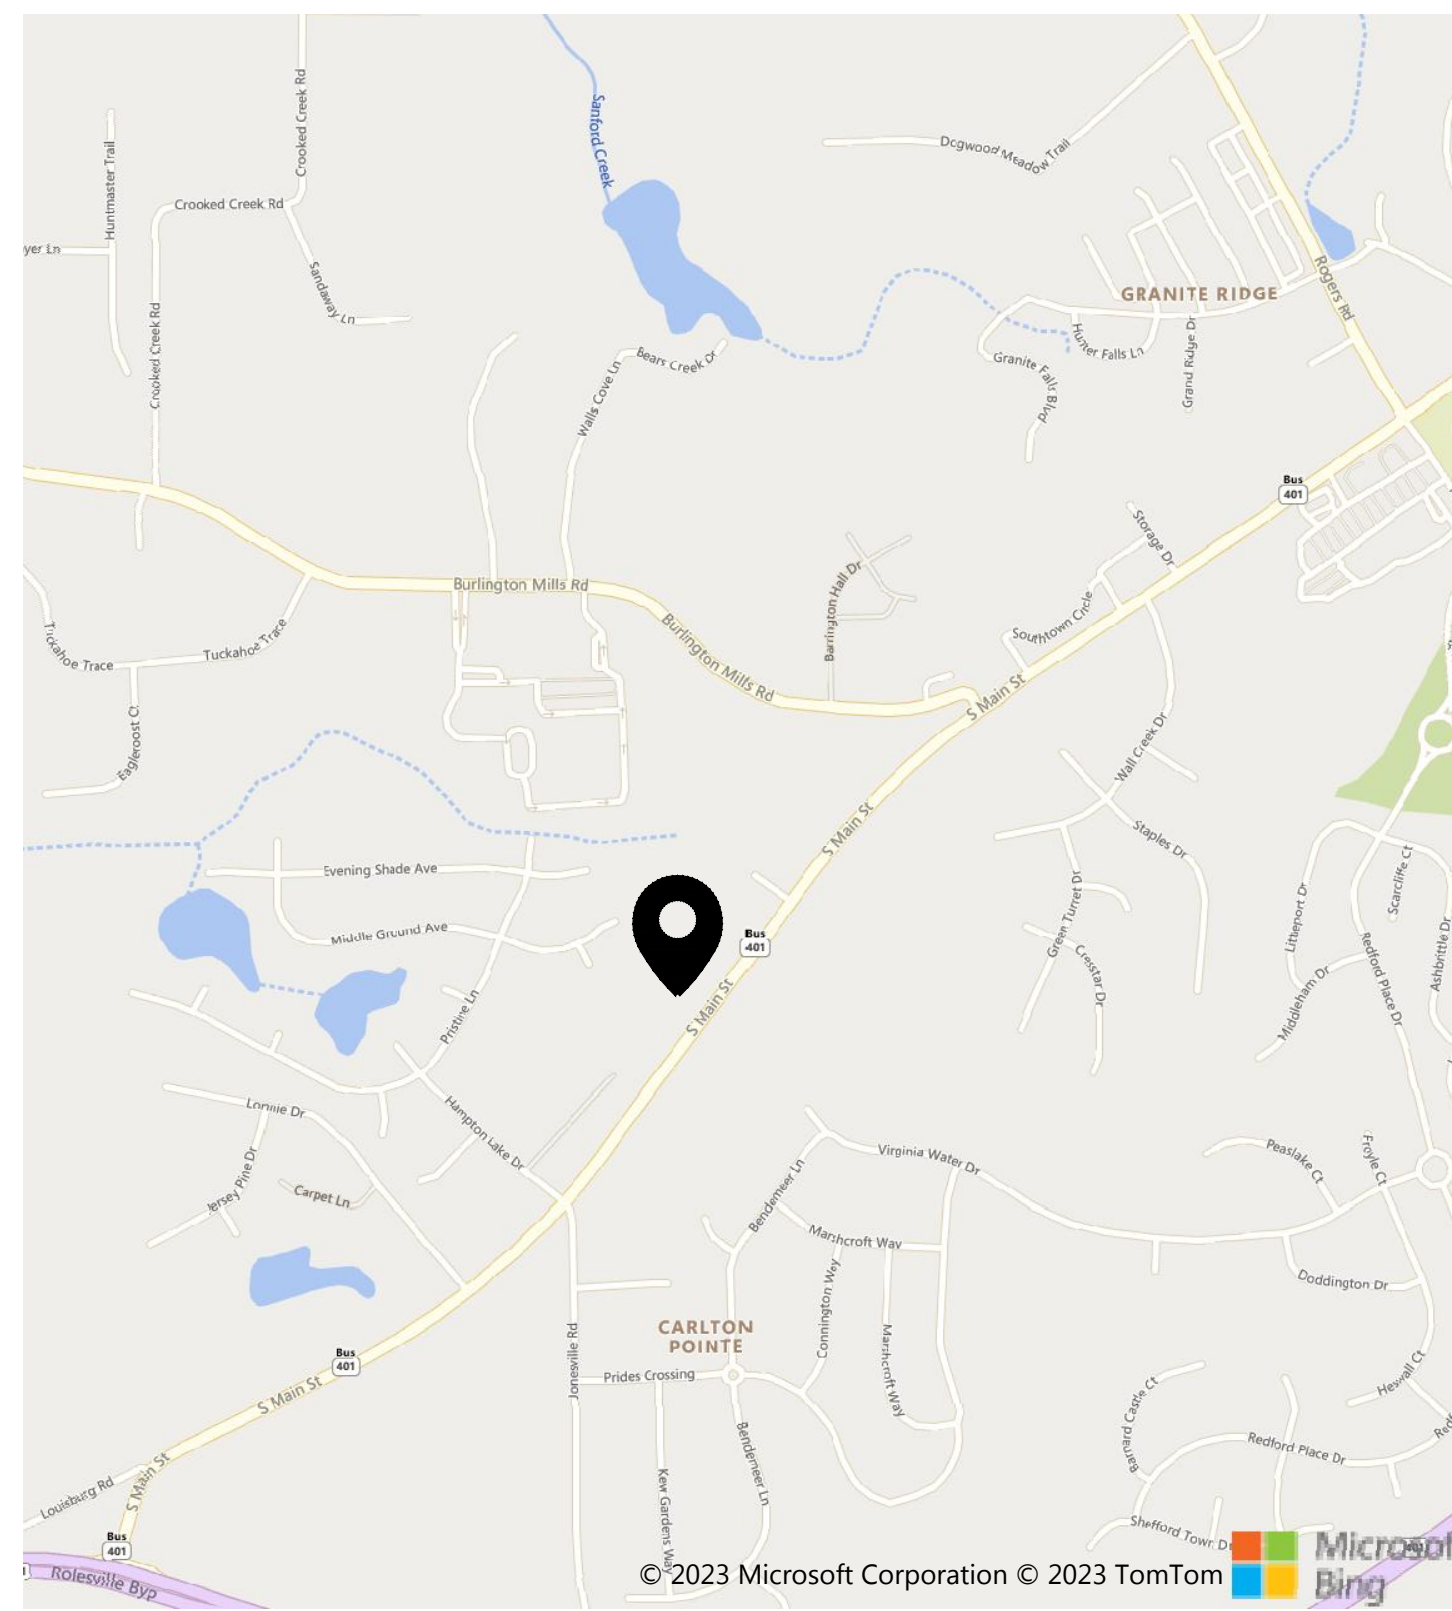

SITE OVERVIEW

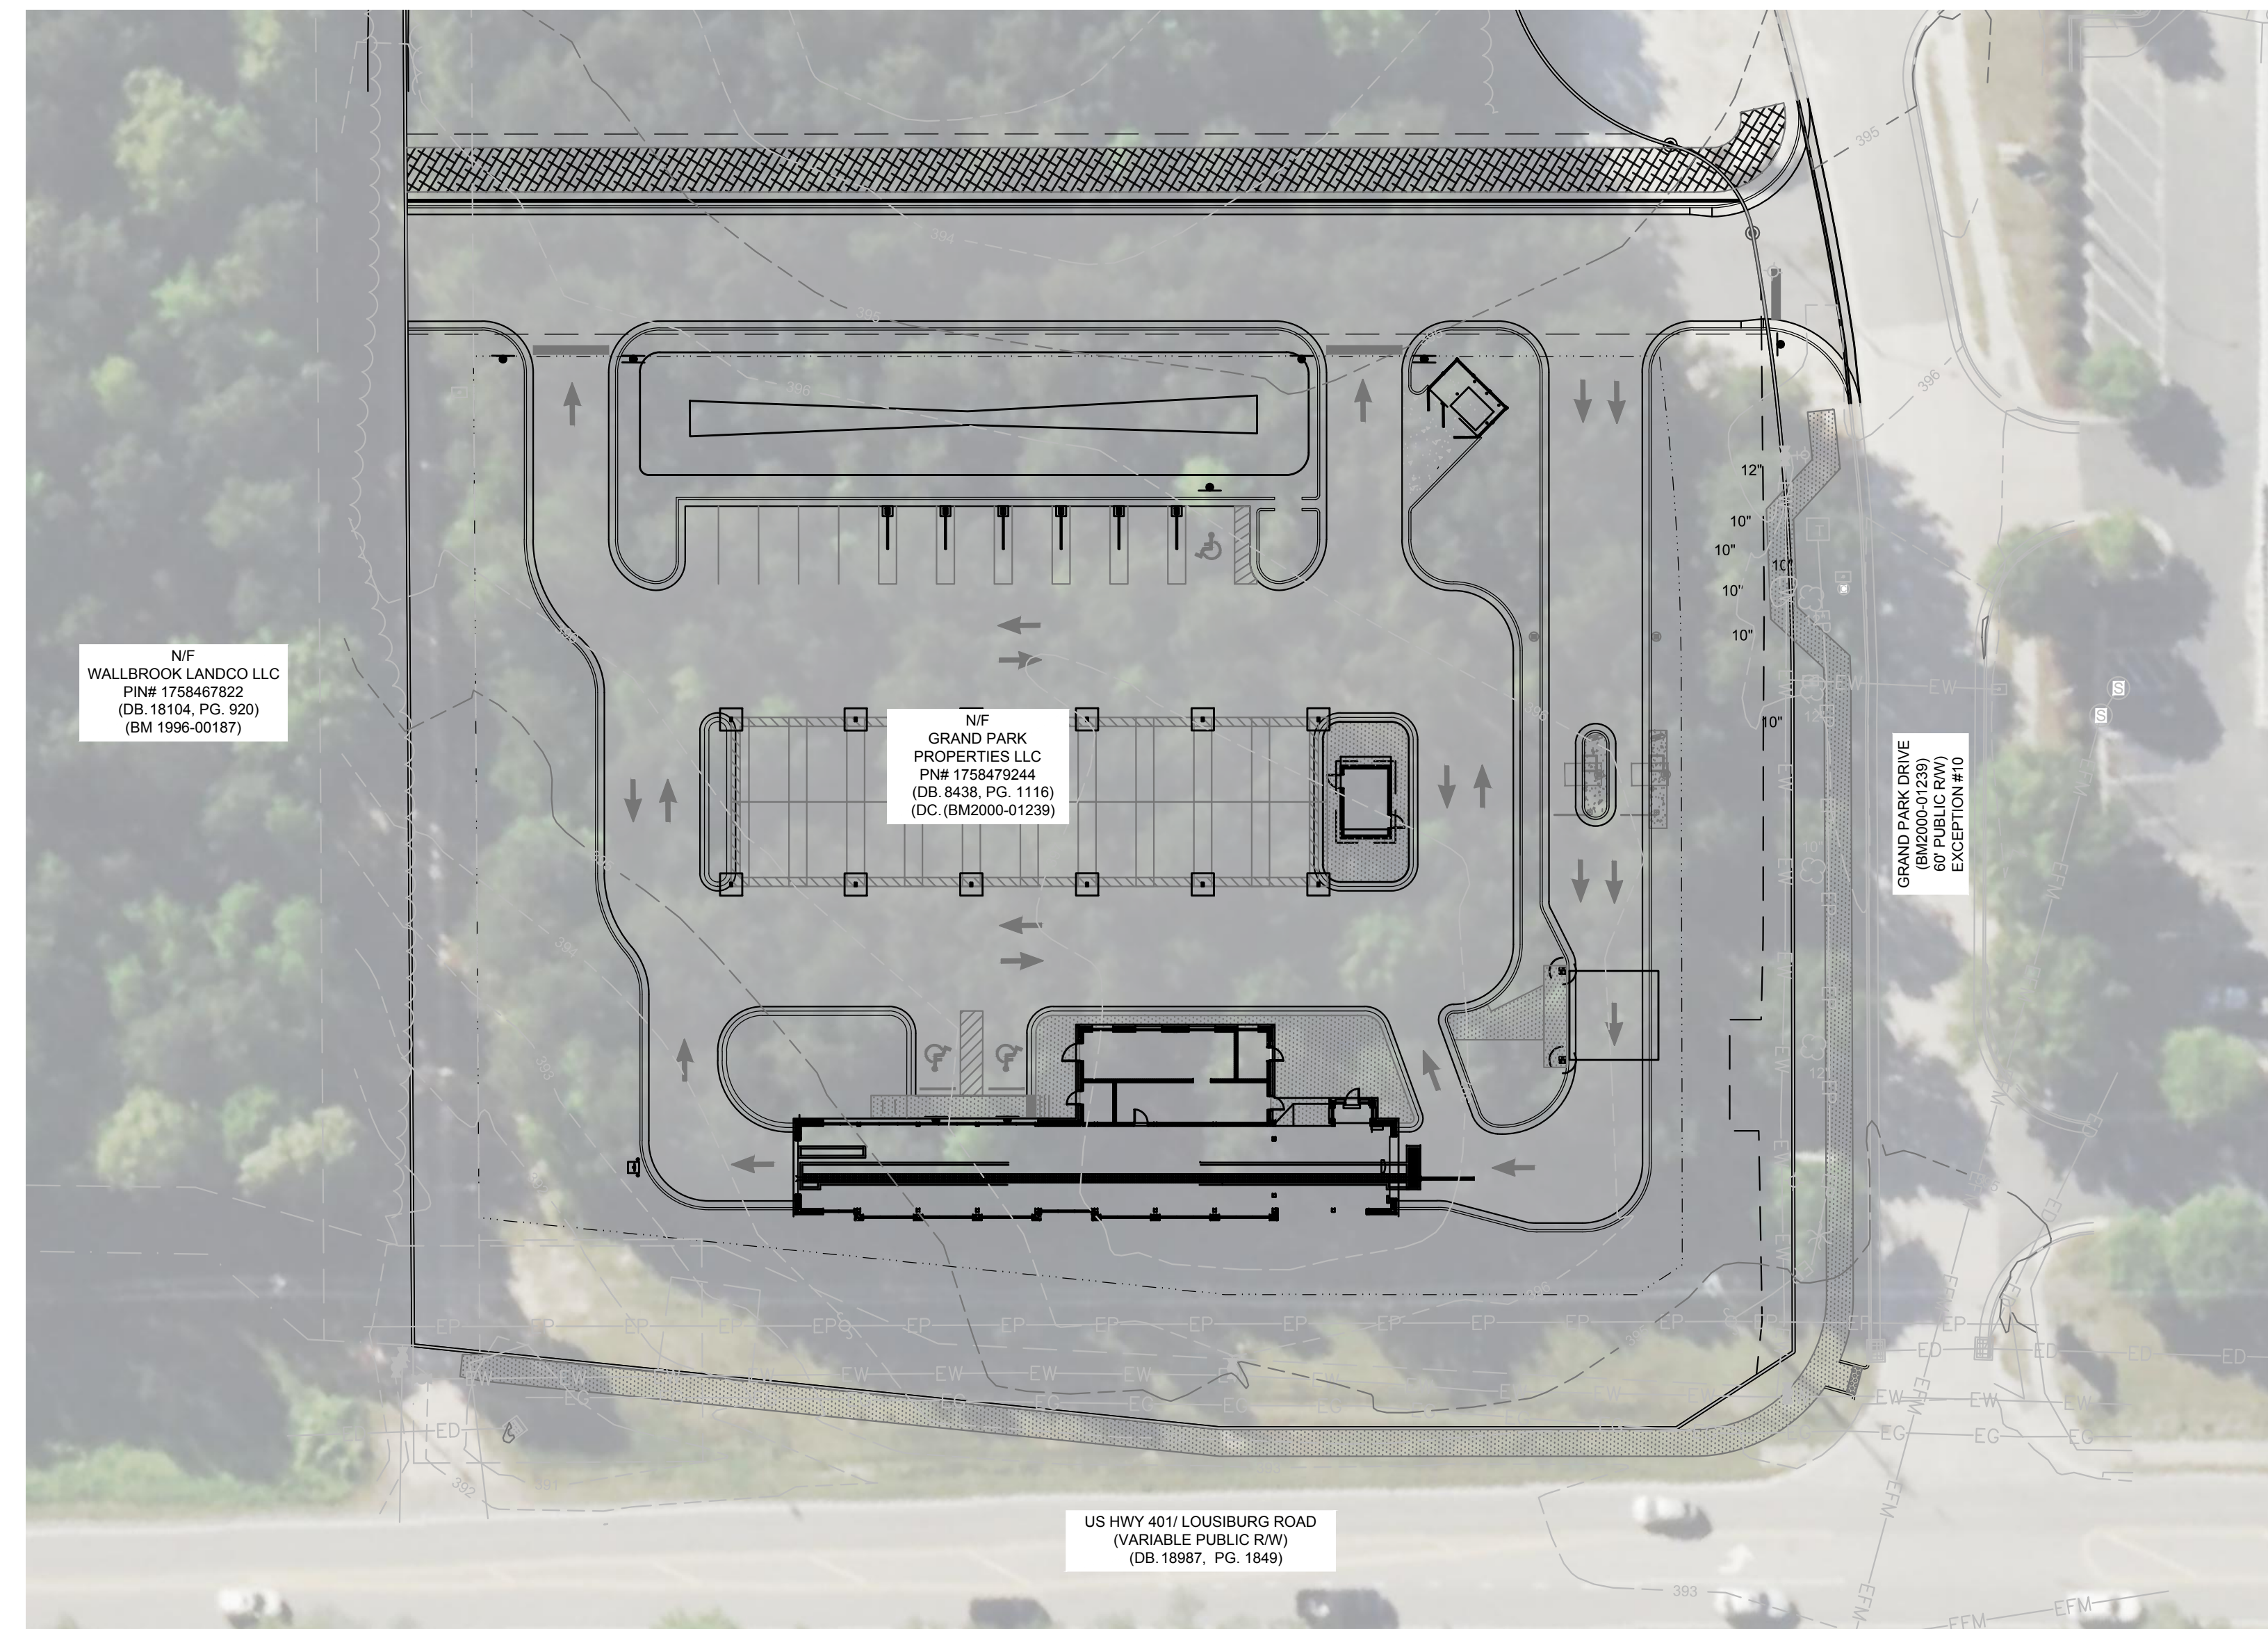

PROJECT DESCRIPTION

PROJECT DATA:
THIS PROJECT IS LOCATED ON A 1.92 ACRE SITE, IN ROLESVILLE, NC. THE PROPERTY AS IT EXISTS IS AN UNDEVELOPED LOT. THE PROPOSED DEVELOPMENT WILL BE AN AUTOMATED CAR WASH WITH ASSOCIATED PARKING AND INFRASTRUCTURE.

FLOOD ZONE:
THIS PROPERTY IS LOCATED OUTSIDE OF ANY REGULATED FLOOD ZONES, ZONEX (OTHER AREAS), NAVD88, SCALED FROM THE FIRM THE TOWN OF ROLESVILLE, NORTH CAROLINA PANEL NO. 3720175800K.

PROPERTY INFORMATION:
PARCEL ID: 1758479244
ZONING DISTRICT: GI (GENERAL INDUSTRIAL)

GENERAL NOTES

PROJECT SURVEY INFORMATION AND CONTRACTOR VERIFICATION REQUIREMENTS

- BOUNDARY, TOPOGRAPHIC, TREE, WETLAND DELINEATION, AND OTHER EXISTING CONDITIONS SHOWN ARE FROM SURVEY PREPARED BY MSP & ASSOCIATES LAND SURVEYING, INC.
- ALL ELEVATIONS ARE BASED ON NAVD88 DATUM.
- THE CONTRACTOR SHALL VERIFY THE EXISTING TOPOGRAPHIC WORK, EXISTING UTILITY LINE LOCATIONS AND ELEVATIONS PRIOR TO BEGINNING WORK. SHOULD THE CONTRACTOR FIND ANY DISCREPANCIES ON THE DRAWINGS PRIOR TO BEGINNING WORK OR DURING CONSTRUCTION, THE ENGINEER SHALL BE NOTIFIED IMMEDIATELY.
- THE CONTRACTOR SHALL MAINTAIN AND BE SOLELY RESPONSIBLE FOR JOBSITE SAFETY.
- AN AUTOCAD BASE PLAN OF THIS DRAWINGS CAN BE PROVIDED TO THE CONTRACTOR UPON REQUEST. ENGINEER SHALL NOT BE RESPONSIBLE FOR ERRORS IN ELECTRONIC DATA.
- THE CONTRACTOR IS RESPONSIBLE FOR TRAFFIC CONTROL PLANS AND COORDINATION WITH THE TOWN OF ROLESVILLE FOR LANE/ROAD CLOSURE AS NEEDED THROUGHOUT CONSTRUCTION.
- ALL SITE WORK TO BE PERFORMED IN CONFORMANCE WITH THE TOWN OF ROLESVILLE CODE OF ORDINANCE. MATERIAL SPECIFICATIONS ARE PROVIDED IN THE SPECIFICATIONS AND SPECIAL PROVISIONS SECTION.
- ALL UTILITY INSTALLATIONS, PUBLIC AND PRIVATE, SHALL BE PERFORMED IN CONFORMANCE WITH THE TOWN OF ROLESVILLE WATER AND SEWER POLICIES, PROCEDURES, STANDARDS AND SPECIFICATIONS.

EROSION CONTROL, STORMWATER AND FLOODPLAIN MANAGEMENT

APPROVED

EROSION CONTROL SEC-

STORMWATER MGMT. SWF-

FLOOD STUDY SWF-

DATE _____

ENVIRONMENTAL CONSULTANT SIGNATURE

PROJECT CONTACTS

DEVELOPER:
SHJ DEVELOPMENT, LLC
124 EAST THOMPSON STREET
POST OFFICE DRAWER 311
THOMASTON, GA 30286
CONTACT: ALEX PERRY
PHONE: 478-972-2418

OWNER:
GRAND PARK PROPERTIES, LLC
2636 WAIT AVENUE
WAKE FOREST, NC 27587
CONTACT: GEORGE M. UPCHURCH, JR.

CIVIL ENGINEER & LANDSCAPE ARCHITECT:
SEAMON WHITESIDE & ASSOCIATES, LLC
230 E PETERSON DR
CHARLOTTE, NC 28217
CONTACT: TOMMIE LITTLE
PHONE: 980-312-5450

UTILITY CONTACTS:
CITY OF RALEIGH PUBLIC UTILITIES
ONE EXCHANGE PLAZA,
RALEIGH, NC 27601
PHONE: 919-996-3245

SOURCES:
SURVEYOR
MSP & ASSOCIATES
LAND SURVEYING INC.
301 E. HILLCREST DR.
GREENVILLE, SC, 29609
PHONE: (864) 370-2232

- REPEAT: Provide utilities for all Parcels being subdivided from Master Parcel
1a.) COR has concerns with the Subdivision/splitting of this parcel. With parceling of this site the northwest parcel will need to be provided Utilities (water and sewer) for future connections to parcel.
1b.) COR requires the extension of utilities (water and sewer) to each parcel off of Grand Park Drive Lot 2 to be split for Tidal Wave (A/B) and Lot 6 does not have service(s) either. Depending on WL size along Grand Park. Note that the North half parcel of Lot 2 of the site is lower (concern to get gravity sewer)?
- REPEAT: Confirm the intent to build the cul-de-sac for development (platted with Cul-da-sac)
- Include SWM report with next submission

4.) Include revision history, typ.



Know what's below.
Call before you dig.

Sheet List Table

C1.0	TITLESHEET
C1.1	LEGEND & REVISION NOTES
C2.1	SURVEY
C2.2	TREE SURVEY
C3.1	EXISTING CONDITIONS AND DEMO PLAN
C4.1	EROSION CONTROL PH I
C4.2	EROSION CONTROL PH II
C4.3	EROSION CONTROL PH III
C4.4	EROSION CONTROL NOTES
C4.4	EROSION CONTROL DETAILS
C4.5	EROSION CONTROL DETAILS
C5.1	SITE PLAN
C5.2	VEHICLE STACKING & TURNING MOVEMENT
C5.3	FIRE PROTECTION PLAN
C6.1	OVERALL GRADING AND DRAINAGE PLAN
C6.2	DRAINAGE PROFILES
C7.1	UTILITY PLAN AND PROFILES
C7.2	UTILITY PROFILES
C8.1	CONSTRUCTION DETAILS
C8.2	CONSTRUCTION DETAILS
C8.3	CONSTRUCTION DETAILS
C8.4	CONSTRUCTION DETAILS
C8.5	CONSTRUCTION DETAILS
D1.0	ADS STORMTECH
D1.1	ADS STORMTECH
D1.2	ADS STORMTECH
D1.3	ADS STORMTECH
D1.4	ADS STORMTECH
L1.0	LANDSCAPE PLAN
L1.1	PLANT SCHEDULE & DETAILS & NOTES

SITE DATA TABLE:

ADDRESS: 0 S MAIN STREET, ROLESVILLE, NC
PROPERTY AREA: 1.92 ACRES
PARCEL: 1758479244
EXISTING USE: UNDEVELOPED
PROPOSED USE: CAR WASH
WATERSHED: TOMS CREEK (MILL CREEK)
RIVER BASIN: NEUSE

PROPERTY ZONING: GI (GENERAL INDUSTRIAL)
BUILDING SETBACKS:
FRONT (SE): 30'
CORNER (NE): 25'
REAR (NW): 35'
SIDE (SW): 15'

PERIMETER LANDSCAPE YARDS:
NORTHEAST: 15'


REQUIRED OPEN SPACE (5%) = 0.01 AC (4182 SF)

BUILDING:
BUILDING AREA: 3325 SF
BUILDING HEIGHT: 21'-7"

PRE VS. POST DEVELOPMENT AREA:
SITE AREA: 1.92 AC
PRE-IMPERVIOUS AREA: 0.04 AC (2.08%)
POST-IMPERVIOUS AREA: 1.30 AC (67.7%)

PARKING NOTE:
PARKING REQUIRED:
1 SPACE PER 400 SF GFA OR 5 SPACES MINIMUM = 5 SPACES

PARKING PROVIDED:
EMPLOYEE SPACES: 5 SPACES (1 ADA)
VACUUM STALLS: 34 STALLS

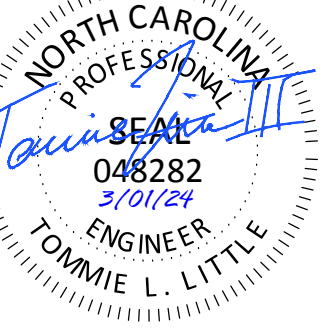

TIDAL WAVE AUTO SPA
ROLESVILLE, NC

SW+ PROJECT: 10772
DATE: 3/01/24
DRAWN BY: CPE
CHECKED BY: TLL

REVISION HISTORY

NO.	DATE	DESCRIPTION

TITLESHEET


REVISION HISTORY	

DRAWING LEGEND

NOTE: THIS LEGEND DOES NOT APPLY TO 'EXISTING CONDITIONS' SHEET(S). THOSE ARE SHOWN IN THE ORIGINAL FORMAT AS RECEIVED BY THE SURVEYOR

OBJECTS AND SYMBOLS	EXISTING	NEW	OBJECTS AND SYMBOLS	EXISTING	NEW	HATCH PATTERNS	SWPP PLAN LEGEND
Right of Way			Benchmark		N/A		Turf Reinforcement Mat (TR)
Lot Line			Sanitary Sewer Manhole				Sodding (S)
Adjoining Property Line		N/A	Sanitary Sewer Manhole ID #	N/A			Temporary Seeding (TS)
Easement		N/A	Sanitary Sewer Cleanout				Permanent Seeding (PS)
Setback		(Same as Existing)	TYPE 1 Storm Drainage Structure (CI-1)				Erosion Control Blanket (EC)
Sanitary Sewer (Gravity)			Catch Basin (CB)				Concrete Washout Basin (CW)
Sanitary Sewer (Force Main)			Storm Drainage Junction Box (JB)				Block & Stone Inlet Protection
Water Line			Yard Inlet (YI)				Filter Fabric Inlet Protection
Curb & Gutter (Straight)			Control Structure (CS)				Construction Entrance
Curb & Gutter (Roll)			Storm Drainage Structure ID #	N/A			Dandy Sack or Grate Gator Inlet Protection
Previous Phase Storm Drain Pipe		N/A	Telephone Box		N/A		
Storm Drain Pipe			Telephone Manhole		N/A		
Drainage Flow Arrow	N/A		Electrical Box		N/A		
Silt Fence, Standard			Electrical Manhole		N/A		
Match Line	N/A		Power Pole				
Drainage Basin Limits	N/A		Light Pole				
Conduit			Fire Hydrant Assembly				
Natural Gas			Water Line Valve				
Overhead Electrical			Water Line Reducer				
Underground Electrical			Sign				
Underground Telephone			ADA Accessible Parking Space				
Fence			Spot Elevation				
Elevation Contour			Drainage Basin Area	N/A			
Revision Cloud (Encloses Revision)	N/A		Parking Count ID #	N/A			
			Revision ID #	N/A			
			Rip Rap at Pipe Outlet	N/A			
						Demo Existing Gravel	
						Demo Existing Trees	
						Proposed Sidewalk	
						Heavy Duty Concrete Pavement	
						Standard Duty Concrete Pavement	
						Asphalt Greenway	
						Area to be Permanently Stabilized	

501 WINDO PARK BOULEVARD, SUITE 200 | MOUNT PLEASANT, SC 29546 | JUDSON MILLS BUILDING 6000, 701 EASLEY BROOK RD, SUITE 6000, GREENVILLE, SC 29611 | 230 PETERSON DR., CHARLOTTE, NC 28217 | 720 N. CEDAR STREET | SUMMERVILLE, SC 29586 | 104 N. DANIEL MORGAN AVENUE, SUITE 300 | SPARTANBURG, SC 29301
COPYRIGHT © SEAMON WHITESIDE & ASSOCIATES, INC. | THIS DRAWING SHALL NOT BE REPRODUCED IN ANY MANNER OR FOR ANY PURPOSE WITHOUT WRITTEN PERMISSION.

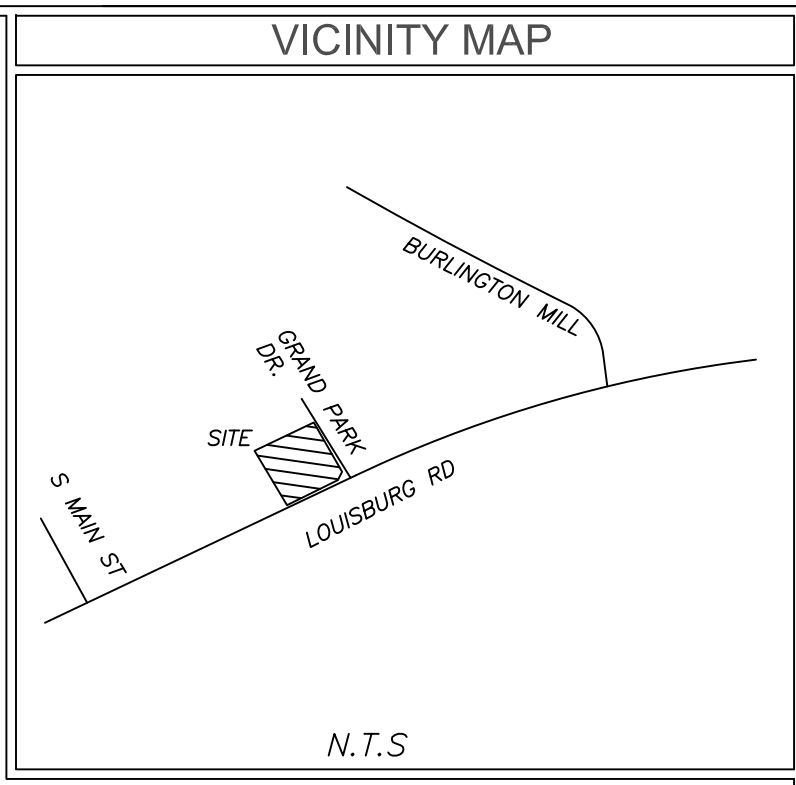

TITLE EXCEPTIONS



Schedule B-Section II Title Exceptions
 Fidelity National Title Insurance Company
 Commitment Number: NC252306067V;NACS230520; Effective Date: June 29, 2023

10. Easements, rights of ways, boundary lines, and improvements as set forth on Plat recorded in Book of Maps 2000, Page 1239, Book of Maps 1996, Page 1582, Book of Maps 1999, Page 1039, and Book of Maps 2003, Page 614, Wake County Registry. (AFFECTS SITE AS PLOTTED)

11. Deed of Easement Vehicular Access and Utility Services to Elevated Water Tank Facility from Grand Park Properties LLC to the City of Raleigh, dated May 5, 2003 and recorded in Book 10123, Page 2779, Wake County Registry. (AFFECTS SITE AS PLOTTED)

12. Right of way conveyance and easements contained in Deed for Highway Right of Way in favor of the Department of Transportation dated April 1, 2021, recorded April 11, 2022, in Book 18987, Page 1849, Wake County Registry. (AFFECTS SITE AS PLOTTED)

13. Cross Access Easement Agreement between Wallbrook Landco LLC and Grand Park Properties, LLC, dated April 12, 2022 and recorded in Book 18988, Page 1102, Wake County Registry. (AFFECTS SITE: UNABLE TO PLOT; NO DESCRIPTION OR MEASUREMENTS FOR EASEMENT)

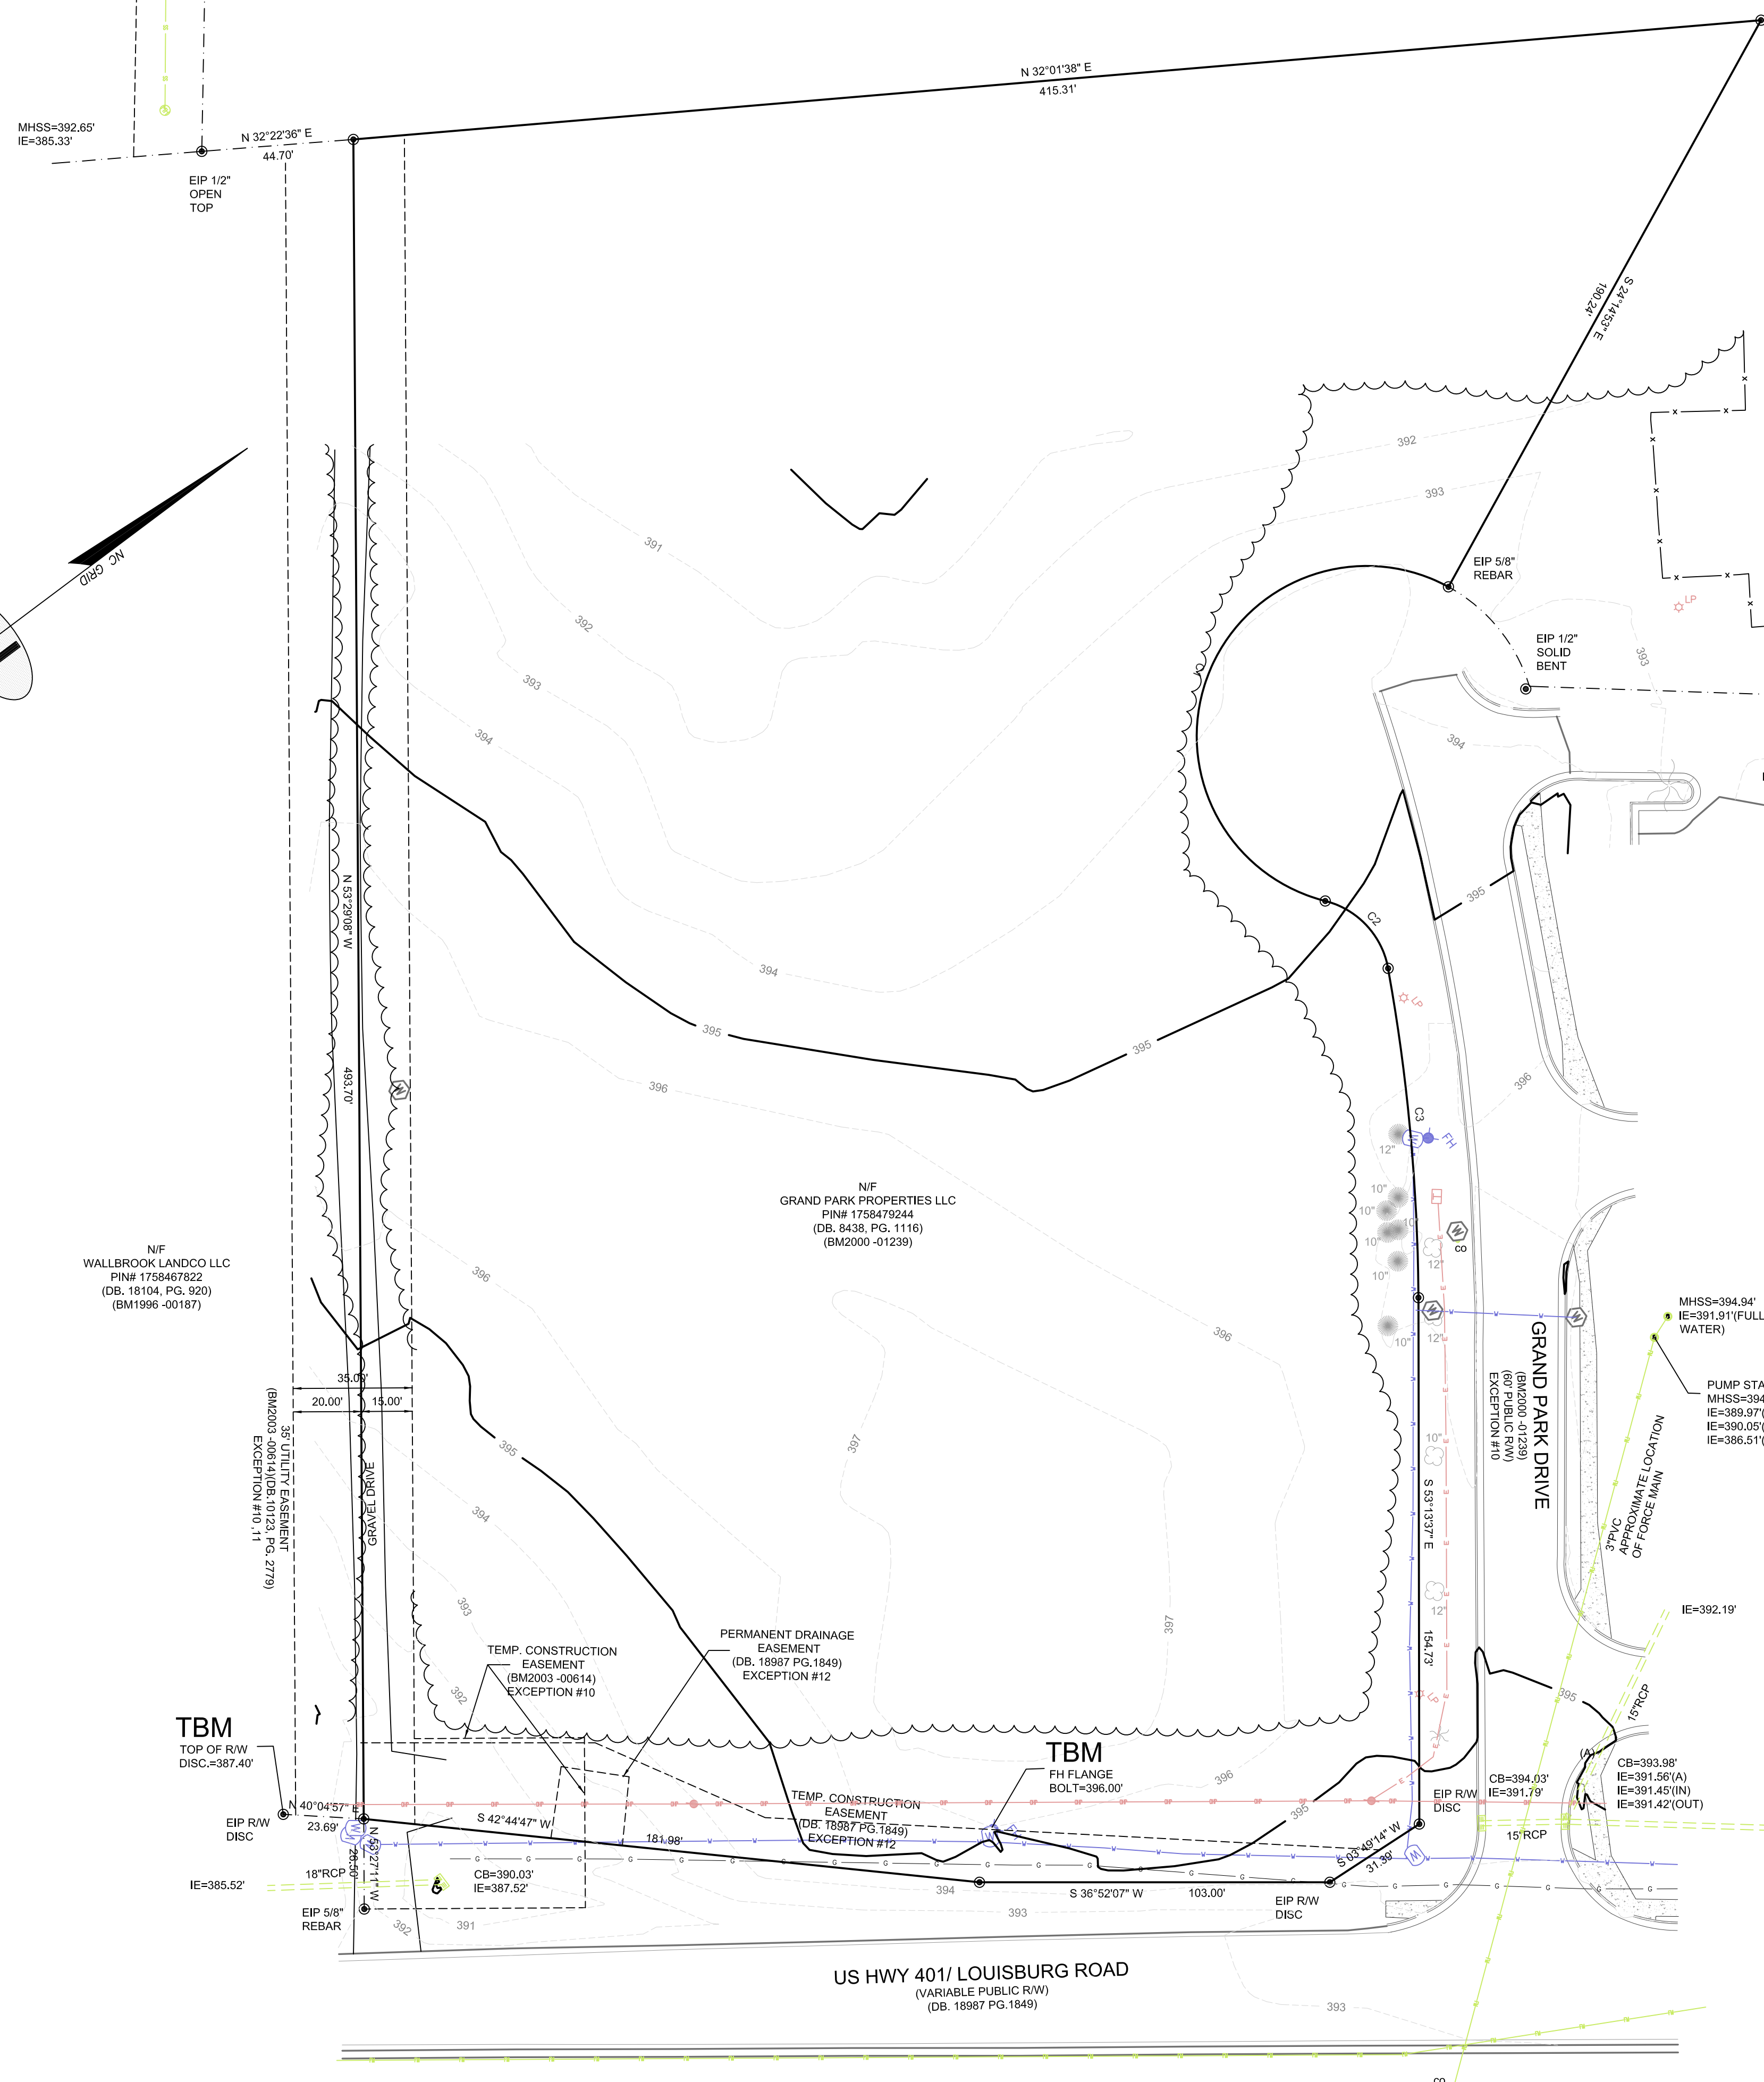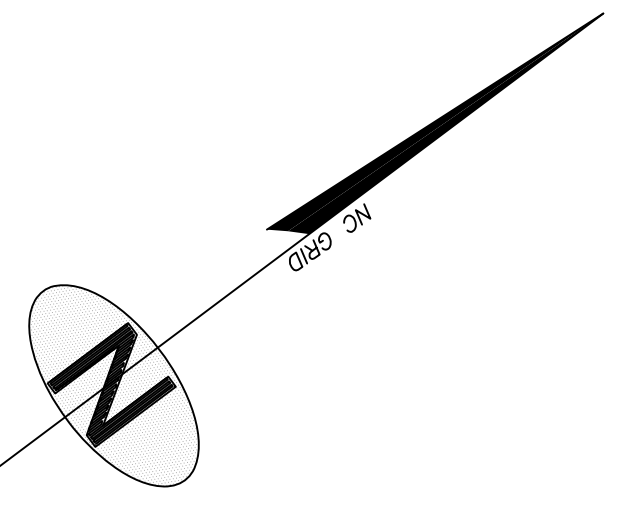

SURVEYORS CERTIFICATION

* To: Fidelity National Title Insurance Company and TWAS Properties LLC, a Delaware limited liability company

This is to certify that this map or plat and the survey on which it is based were made in accordance with the 2021 Minimum Standard Detail Requirements for ALTA/NSPS Land Title Surveys, jointly established and adopted by ALTA and NSPS, and includes items 1-6a,b,7a,b, 8, 9, 11, 13, 16, 17, 18, 20 and 21 of Table A thereof. The field work was completed on 6/6/23.

NIF
 GRAND PARK PROPERTIES LLC
 PIN# 1758479244
 (BM1999-01039)

6/6/23
 Date

Michael S. Perdue PLS #L-4322

LEGEND

- CB CPP CATCH BASIN
- CT CORRUGATED PLASTIC PIPE
- DI CRIMPED TOP PIPE
- DI DROP INLET
- IE INVERT ELEVATION
- JB JUNCTION BOX
- MH MANHOLE
- OT OPEN TOP PIPE
- POB POINT OF BEGINNING
- POC POINT OF COMMENCEMENT
- TBM TEMPORARY BENCHMARK
- RCP REINFORCED CONCRETE PIPE
- SS SANITARY SEWER
- OHP OVERHEAD POWER
- EIP IRON PIN FOUND
- NP IRON PIN SET
- WV WATER VALVE
- WM WATER METER
- GV GAS VALVE
- GM GAS METER
- TP TELEPHONE PEDESTAL
- FH FIRE HYDRANT
- LP LIGHT POLE
- PM POWER METER
- BV BACKFLOW VALVE
- EB ELECTRICAL BOX
- PHONE LINE
- GUY WIRE
- C GAS LINE
- W WATER LINE
- HP POWER LINE
- E UNDERGROUND POWER LINE
- PP POWER POLE
- SSM SANITARY SEWER MANHOLE
- SSM STORM SEWER MANHOLE
- CB CATCH BASIN
- GM GAS METER
- TR TRANSFORMER
- PT PEAR TREE
- PN PINE TREE
- MY CREPE MYRTLE

GENERAL NOTES

This property is in Zone X based on Flood Insurance Rate Map 3720175800K dated 07/19/2022. This determination was made by graphically determining the position of said site on said FIRM Map.

Contact proper Authorities Before building near utility lines, for easement width and restrictions. Underground Utilities are approximate and should be verified prior to any construction. Locations shown are approximate.

This survey has been prepared for the exclusive use of the person or entities named hereon. No express or implied warranties with respect to the information shown hereon is to be extended to any persons or entities other than those shown hereon.

Elevations based on GPS VRS connected to NC GPS Network. Vertical Datum NAVD 88.

Property Zoned GI-CZ
 Setbacks to be verified by Engineer prior to development.

I, Michael S. Perdue certify that this plat was drawn under my supervision from an actual survey made under my supervision and is a portion property as shown in (DB, 8438, PG. 1116); that the ratio of precision as calculated 1: 20,000 +/- and was not adjusted; that this plat was prepared in accordance with G.S. 47-30 as amended. Witness my original signature, registration # and seal this 6th day of June 2023.

That this survey is of an existing parcel of land, existing structures and buildings and does not create a new street or change existing streets.

Michael S. Perdue, PLS# L-4322

All matters shown on recorded plats are shown on survey, if applicable.

There was evidence of recent earth moving work or construction was observed on the property.

There was no visible evidence of cemeteries or burial grounds found.

No evidence of the site being used as a solid waste dump, sump or sanitary landfill.

No evidence of wetlands being marked on subject property.

Property PIN# 1758479244

Survey Reference
 (DB, 8438, PG. 1116)
 (BM, 2000-01239)

NIF
 WALLBROOK LANDCO LLC
 PIN# 1758467822
 (DB, 18104, PG. 320)
 (BM1996-00167)


TBM
 TOP OF R/W
 DISC=387.40

US HWY 401/ LOUISBURG ROAD
 (VARIABLE PUBLIC RW)
 (DB, 18987 PG.1849)

CURVE	RADIUS	ARC LENGTH	CHORD LENGTH	CHORD BEARING	DELTA ANGLE	TANGENT
C1	50.00'	1.6977'	99.20'	S 31°42'56" E	119°32'39"	391.83'
C2	25.01'	28.63'	27.05'	N 83°49'48" E	65°34'40"	16.11'
C3	570.00'	197.34'	97.22'	S 58°23'28" E	9°47'04"	48.79'



Know what's below
 Call before you dig.
 Dial 811
 Or Call 800-282-7411

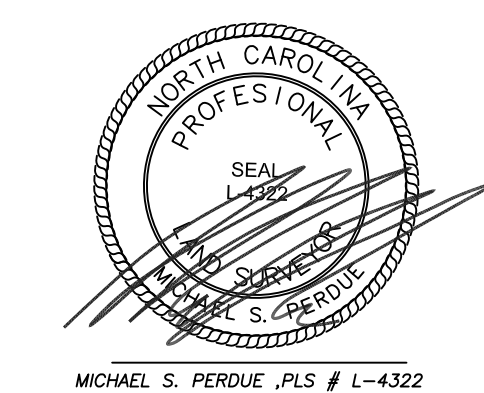

ALTA/NSPS LAND TITLE SURVEY FOR


TWAS Properties LLC

TOWN: ROLESVILLE COUNTY: WAKE STATE: NORTH CAROLINA

DATE: 6/6/23 SCALE: 1:30

FIELD WORK: MSP DRAWN BY: MSP REVIEWED BY: MSP

MSP FILE: twrolesville MSP JOB#: 231820

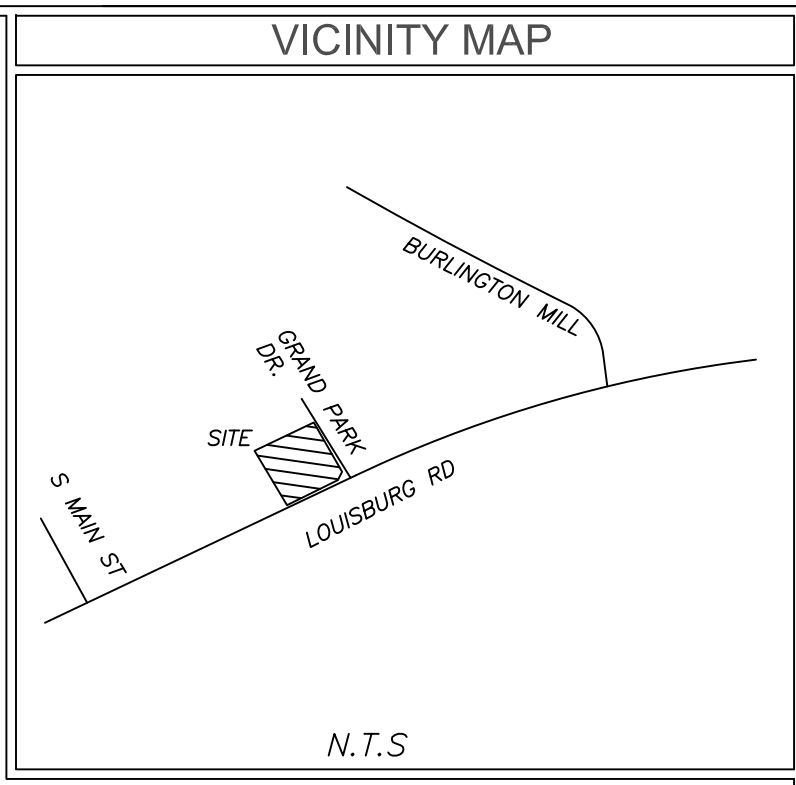

TITLE EXCEPTIONS

Schedule B-Section II Title Exceptions
 Fidelity National Title Insurance Company
 Commitment Number: NC252306067V;NACS230520; Effective Date: June 29, 2023

10. Easements, rights of ways, boundary lines, and improvements as set forth on Plat recorded in Book of Maps 2000, Page 1239, Book of Maps 1996, Page 1582, Book of Maps 1999, Page 1039, and Book of Maps 2003, Page 614, Wake County Registry. (AFFECTS SITE AS PLOTTED)

11. Deed of Easement Vehicular Access and Utility Services to Elevated Water Tank Facility from Grand Park Properties LLC to the City of Raleigh, dated May 5, 2003 and recorded in Book 10123, Page 2779, Wake County Registry. (AFFECTS SITE AS PLOTTED)

12. Right of way conveyance and easements contained in Deed for Highway Right of Way in favor of the Department of Transportation dated April 1, 2021, recorded April 11, 2022, in Book 18987, Page 1849, Wake County Registry. (AFFECTS SITE AS PLOTTED)

13. Cross Access Easement Agreement between Wallbrook Landco LLC and Grand Park Properties, LLC, dated April 12, 2022 and recorded in Book 18988, Page 1102, Wake County Registry. (AFFECTS SITE: UNABLE TO PLOT; NO DESCRIPTION OR MEASUREMENTS FOR EASEMENT)

SURVEYORS CERTIFICATION

* To: Fidelity National Title Insurance Company and TWAS Properties LLC, a Delaware limited liability company

This is to certify that this map or plat and the survey on which it is based were made in accordance with the 2021 Minimum Standard Detail Requirements for ALTA/NSPS Land Title Surveys, jointly established and adopted by ALTA and NSPS, and includes items 1-6a,b,7a,b, 8, 9, 11, 13, 16, 17, 18, 20 and 21 of Table A thereof. The field work was completed on 6/6/23.

Michael S. Perdue, PLS #L-4322
 Date: 6/6/23

GENERAL NOTES

This property is in Zone X based on Flood Insurance Rate Map 3720175800K dated 07/19/2022. This determination was made by graphically determining the position of said site on said FIRM Map.

Contact proper Authorities Before building near utility lines, for easement width and restrictions. Underground Utilities are approximate and should be verified prior to any construction. Locations shown are approximate.

This survey has been prepared for the exclusive use of the person or entities named hereon. No express or implied warranties with respect to the information shown hereon is to be extended to any persons or entities other than those shown hereon.

Elevations based on GPS VRS connected to NC GPS Network. Vertical Datum NAVD 88.

Property Zoned GI-CZ
 Setbacks to be verified by Engineer prior to development.

I, Michael S. Perdue certify that this plat was drawn under my supervision from an actual survey made under my supervision and is a portion property as shown in (DB, 8438, PG. 1116); that the ratio of precision as calculated 1: 20,000 +/- and was not adjusted; that this plat was prepared in accordance with G.S. 47-30 as amended. Witness my original signature, registration # and seal this 6th day of June 2023.

That this survey is of an existing parcel of land, existing structures and buildings and does not create a new street or change existing streets.

Michael S. Perdue, PLS# L-4322

All matters shown on recorded plats are shown on survey, if applicable.

There was evidence of recent earth moving work or construction was observed on the property.

No evidence of the site being used as a solid waste dump, sump or sanitary landfill.


No evidence of wetlands being marked on subject property.

Property PIN# 1758479244


Survey Reference
 (DB, 8438, PG. 1116)
 (BM, 2000-01239)

LEGEND

- CB CPP CORRUGATED PLASTIC PIPE
- CT CRIMPED TOP PIPE
- DI DROP INLET
- IE INVERT ELEVATION
- JB JUNCTION BOX
- MH MANHOLE
- OT OPEN TOP PIPE
- POB POINT OF BEGINNING
- POC POINT OF COMMENCEMENT
- TBM TEMPORARY BENCHMARK
- RCP REINFORCED CONCRETE PIPE
- SS SANITARY SEWER
- OHP OVERHEAD POWER
- EIP IRON PIN FOUND
- NP IRON PIN SET
- WP WATER VALVE
- WM WATER METER
- GV GAS VALVE
- GM GAS METER
- TP TELEPHONE PEDESTAL
- FR FIRE HYDRANT
- LP LIGHT POLE
- PM POWER METER
- BV BACKFLOW VALVE
- EB ELECTRICAL BOX
- PHONE LINE
- GUY WIRE
- WATER LINE
- POWER LINE
- UNDERGROUND POWER LINE
- POWER POLE
- SANITARY SEWER MANHOLE
- STORM SEWER MANHOLE
- CATCH BASIN
- GAS METER
- TRANSFORMER
- PEAR TREE
- PINE TREE
- CREPE MYRTLE

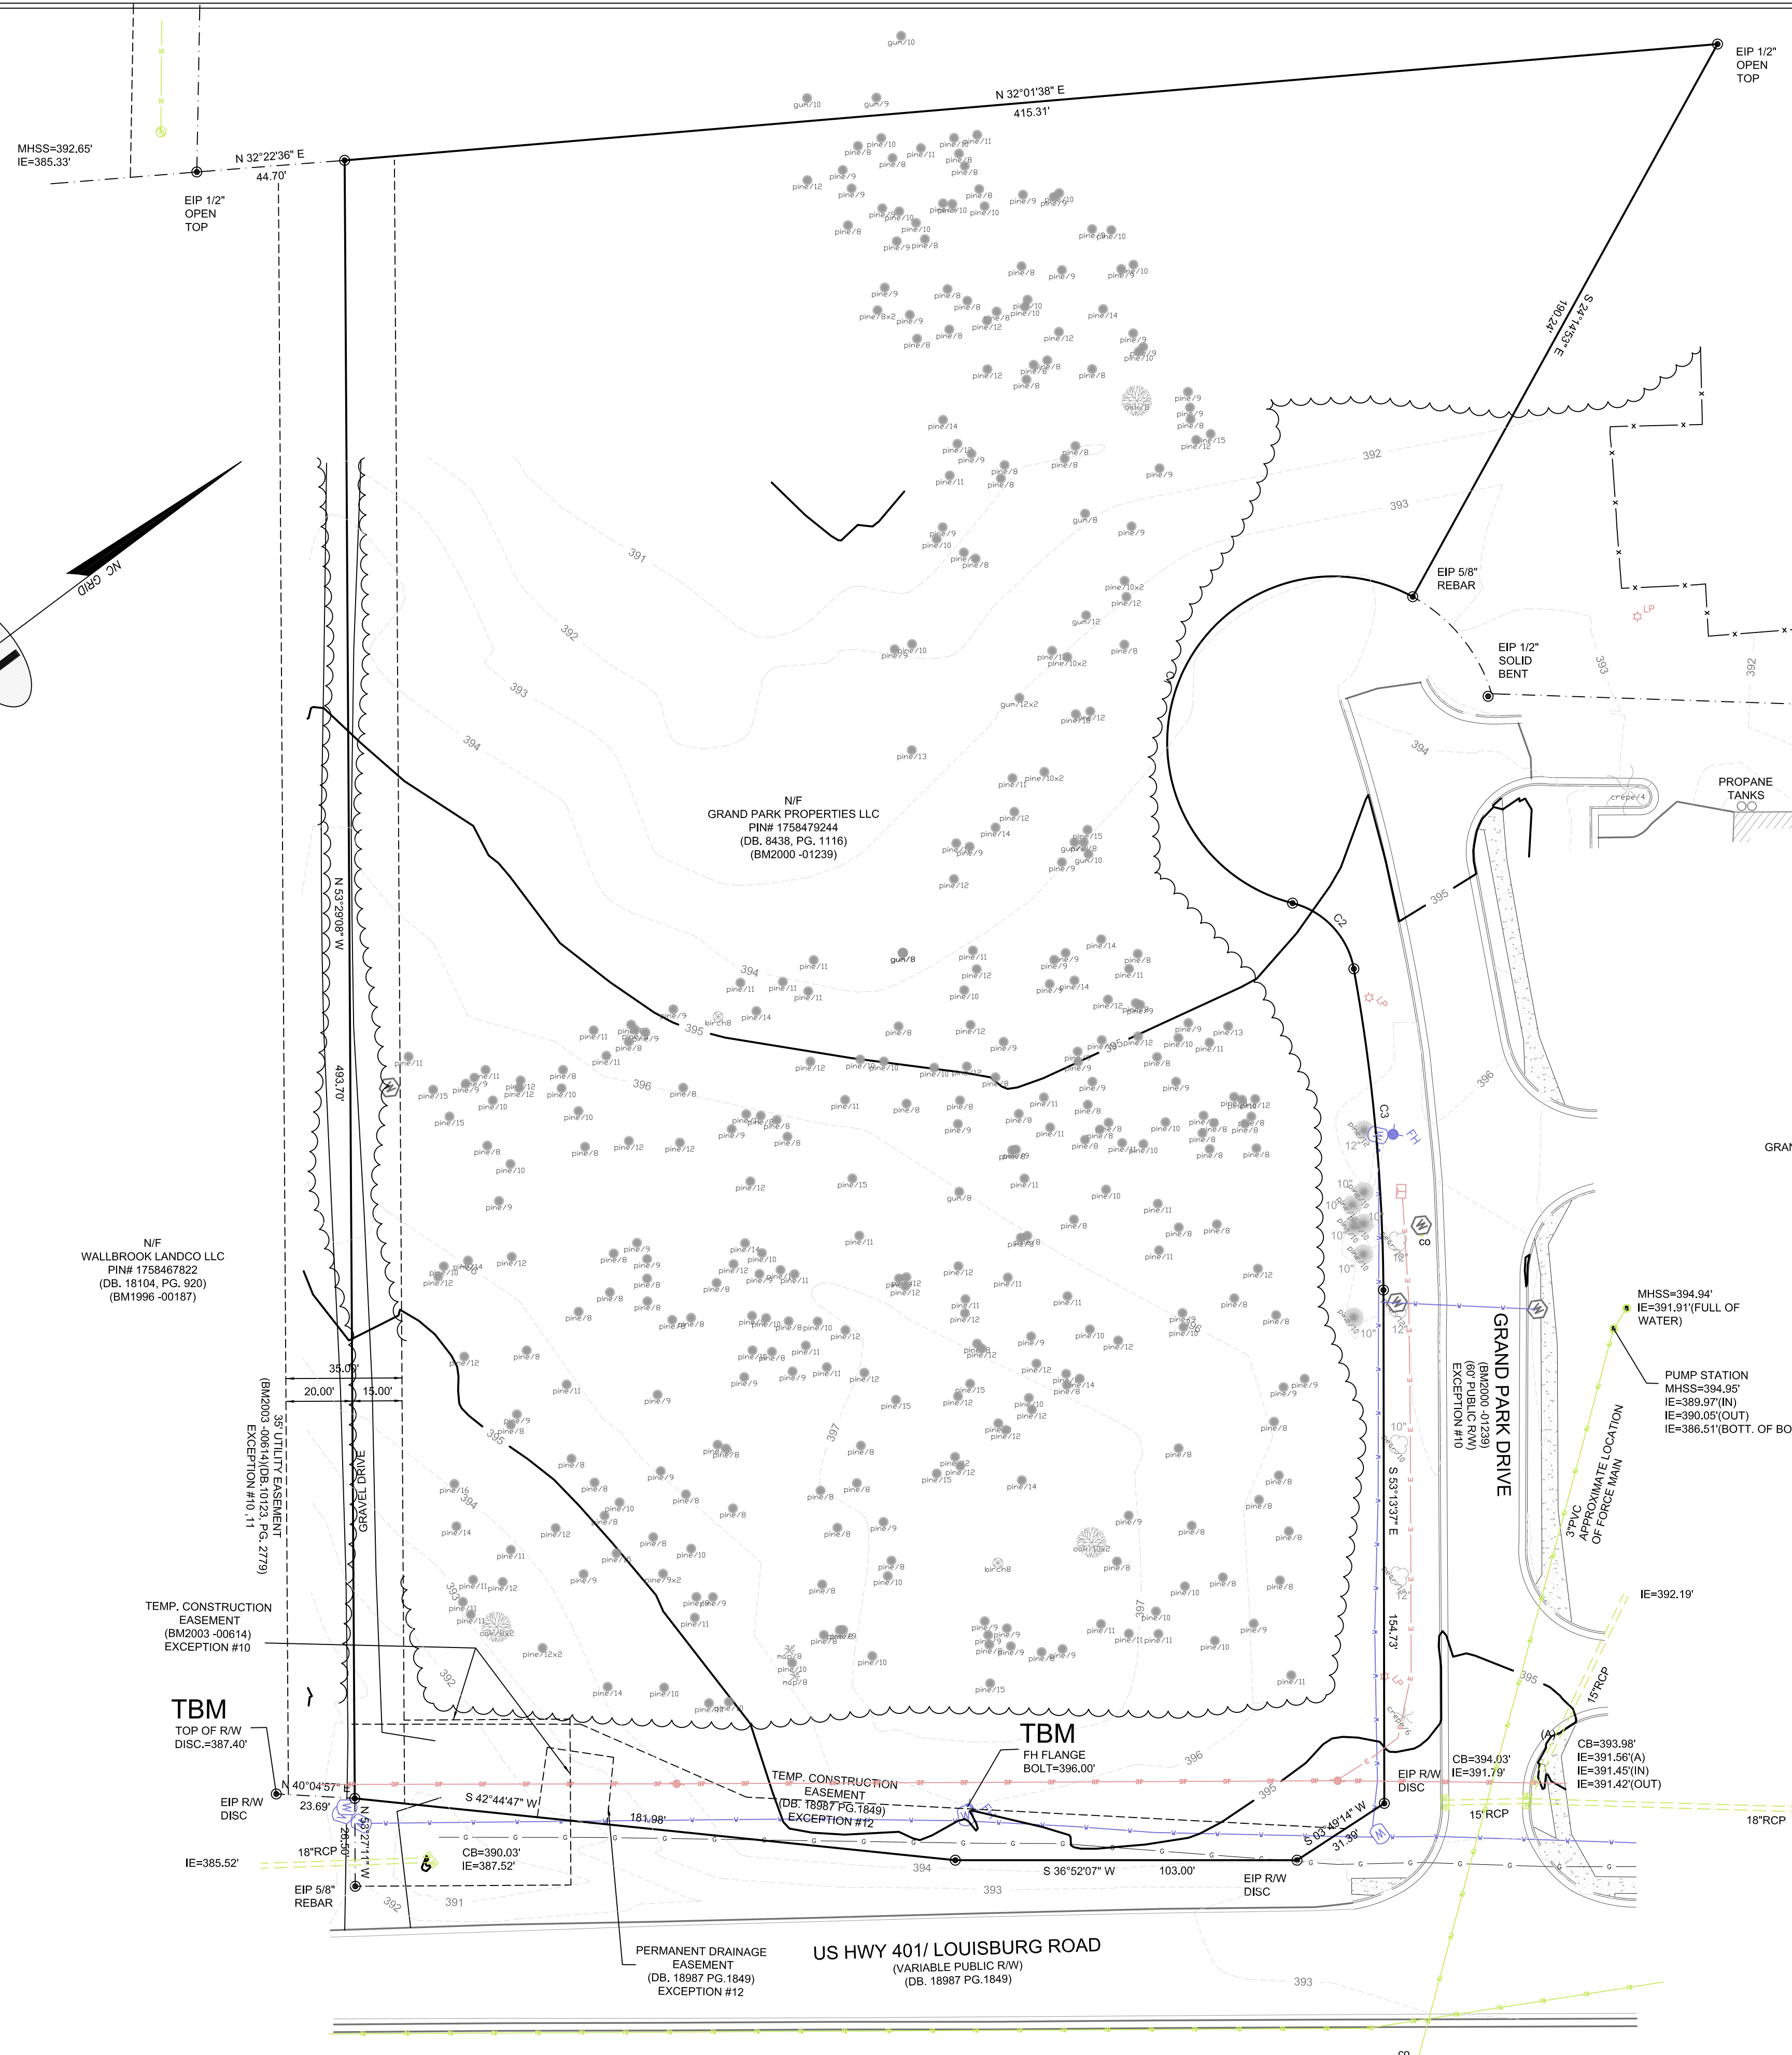

CURVE	RADIUS	ARC LENGTH	CHORD LENGTH	CHORD BEARING	DELTA ANGLE	TANGENT
C1	50.00'	1.6877'	19.20'	S 31°42'56" E	1194°32'38"	391.83'
C2	25.01'	28.63'	27.05'	N 83°49'48" E	65°34'40"	16.11'
C3	570.00'	197.34'	97.22'	S 58°23'28" E	9°47'04"	48.79'

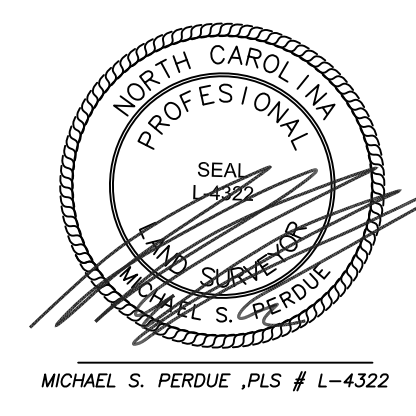

ALTA/NSPS LAND TITLE SURVEY FOR


TWAS Properties LLC

TOWN: ROLESVILLE COUNTY: WAKE STATE: NORTH CAROLINA

DATE: 6/6/23 SCALE: 1:30

FIELD WORK: MSP DRAWN BY: MSP REVIEWED BY: MSP

MSP FILE: twrolesville MSP JOB#: 231820

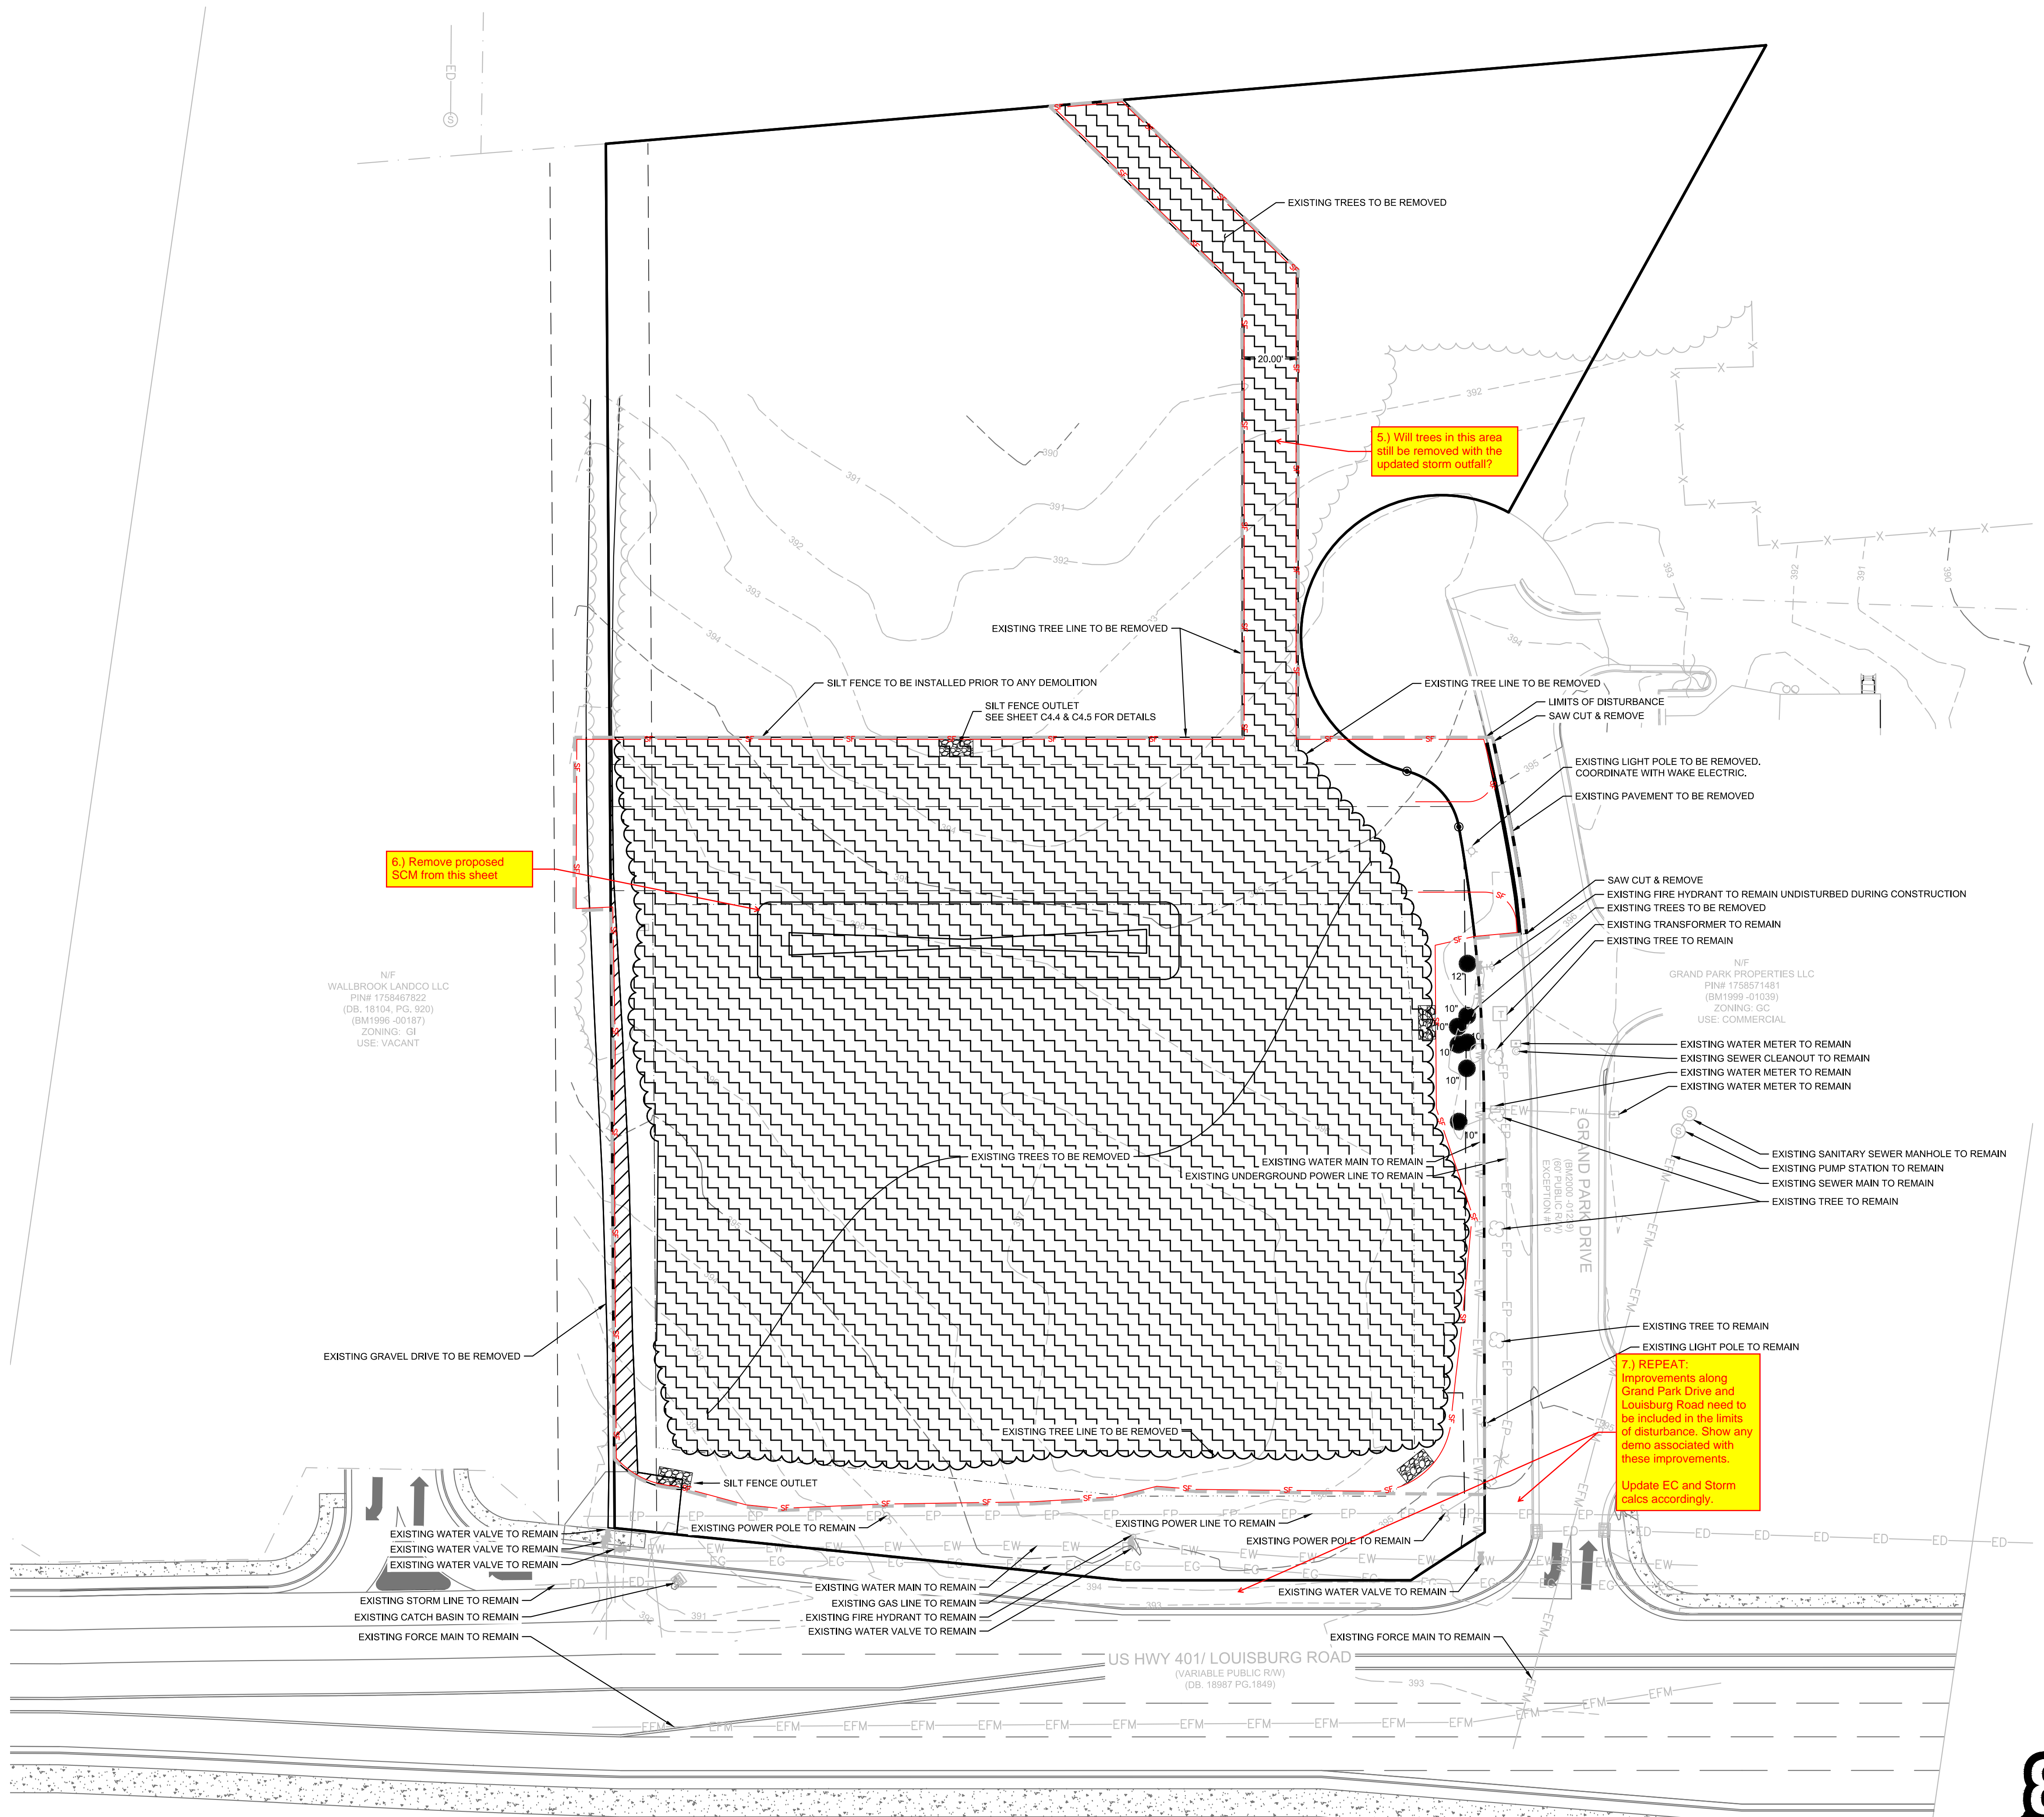

6.) Remove proposed SCM from this sheet.


5.) Will trees in this area still be removed with the updated storm outfall?

7.) REPEAT: Improvements along Grand Park Drive and Louisburg Road need to be included in the limits of disturbance. Show any demo associated with these improvements. Update EC and Storm calcs accordingly.

- DEMOLITION NOTES:**
- ALL DEMOLITION DEBRIS IS TO BE REMOVED FROM THE PROJECT SITE AND DISPOSED OF IN ACCORDANCE WITH APPLICABLE COUNTY, STATE, AND FEDERAL REGULATIONS.
 - CONTRACTOR IS RESPONSIBLE FOR LOCATING ALL EXISTING UTILITIES BEFORE ANY WORK IS STARTED. ENGINEER SHALL BE NOTIFIED OF ANY DISCREPANCIES BETWEEN THE FIELD MARKINGS AND SURVEY.
 - NO LAND DISTURBING ACTIVITY PRIOR TO APPROVAL OF EROSION AND SEDIMENT CONTROL PLAN AND THE ISSUANCE OF THE LAND-DISTURBING PERMIT AT THE PRECONSTRUCTION MEETING.
 - CONTRACTOR TO REMOVE ALL TREES WITHIN LIMITS OF DISTURBANCE.

EXISTING UTILITY NOTE:

THE LOCATION OF EXISTING UNDERGROUND UTILITIES ARE SHOWN IN AN APPROXIMATE WAY ONLY AND HAVE NOT BEEN INDEPENDENTLY VERIFIED BY THE OWNER OR ITS REPRESENTATIVE. THE CONTRACTOR SHALL DETERMINE THE EXACT LOCATION OF ALL EXISTING UTILITIES BEFORE COMMENCING ANY WORK, AND AGREES TO BE FULLY RESPONSIBLE FOR ANY AND ALL DAMAGES WHICH MIGHT OCCUR DUE TO THE CONTRACTOR'S FAILURE TO EXACTLY LOCATE AND PRESERVE ANY AND ALL UNDERGROUND UTILITIES.

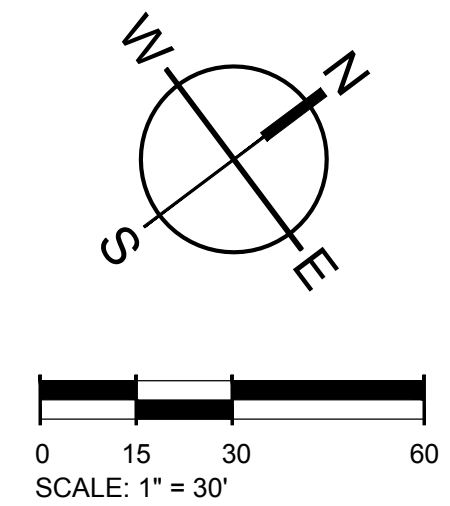

DEMOLITION LEGEND		
DEMO EXISTING GRAVEL		LIMITS OF DISTURBANCE
DEMO EXISTING TREES		EXISTING UTILITY TO REMAIN
SILT FENCE OUTLET		EXISTING CURB TO BE REMOVED

		—EP—
		—



Know what's below.
Call before you dig.

501 WINDY PARK BOULEVARD, SUITE 200 | MOUNT PLEASANT, SC 29546 | JUDSON MILLS BUILDING 6000, 701 EASLEY BROOK RD, SUITE 6000, GREENVILLE, SC 29611 | 230 PETERSON DR., CHARLOTTE, NC 28217 | 712 N. CEDAR STREET | SUMMERVILLE, SC 29586 | 104 N. DANIEL MORGAN AVENUE, SUITE 300 | SPARTANBURG, SC 29301
 COPYRIGHT © SEAMON WHITESIDE & ASSOCIATES, INC. | THIS DRAWING SHALL NOT BE REPRODUCED IN ANY MANNER OR FOR ANY PURPOSE WITHOUT WRITTEN PERMISSION.

N/F
WALLBROOK LANDCO LLC
PIN# 1758467822
(DB, 18104, PG, 520)
(BM1998-001637)
ZONING: G1
USE: VACANT

N/F
GRAND PARK PROPERTIES LLC
PIN# 1758571481
(BM1999-01039)
ZONING: GC
USE: COMMERCIAL

EXISTING WATER VALVE TO REMAIN
EXISTING WATER VALVE TO REMAIN
EXISTING WATER VALVE TO REMAIN
EXISTING STORM LINE TO REMAIN
EXISTING CATCH BASIN TO REMAIN
EXISTING FORCE MAIN TO REMAIN

EXISTING WATER MAIN TO REMAIN
EXISTING GAS LINE TO REMAIN
EXISTING FIRE HYDRANT TO REMAIN
EXISTING WATER VALVE TO REMAIN

EXISTING POWER POLE TO REMAIN
EXISTING POWER LINE TO REMAIN
EXISTING POWER POLE TO REMAIN

US HWY 401/ LOUISBURG ROAD
(VARIABLE PUBLIC RW)
(DB, 18987 PG, 1849)

EXISTING SANITARY SEWER MANHOLE TO REMAIN
EXISTING PUMP STATION TO REMAIN
EXISTING SEWER MAIN TO REMAIN
EXISTING TREE TO REMAIN

EXISTING TREE TO REMAIN
EXISTING LIGHT POLE TO REMAIN

EXISTING WATER METER TO REMAIN
EXISTING SEWER CLEANOUT TO REMAIN
EXISTING WATER METER TO REMAIN
EXISTING WATER METER TO REMAIN


SAW CUT & REMOVE
EXISTING FIRE HYDRANT TO REMAIN UNDISTURBED DURING CONSTRUCTION
EXISTING TREES TO BE REMOVED
EXISTING TRANSFORMER TO REMAIN
EXISTING TREE TO REMAIN

EXISTING LIGHT POLE TO BE REMOVED.
COORDINATE WITH WAKE ELECTRIC.
EXISTING PAVEMENT TO BE REMOVED

EXISTING TREE LINE TO BE REMOVED
LIMITS OF DISTURBANCE
SAW CUT & REMOVE

EXISTING TREE LINE TO BE REMOVED
SILT FENCE TO BE INSTALLED PRIOR TO ANY DEMOLITION
SILT FENCE OUTLET
SEE SHEET C4.4 & C4.5 FOR DETAILS

EXISTING TREES TO BE REMOVED

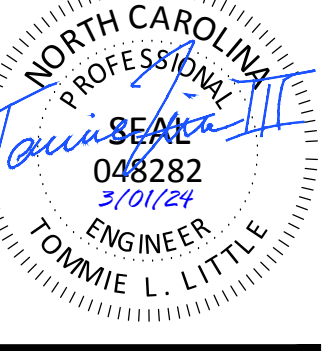

SW+ PROJECT: 10772
DATE: 3/01/24
DRAWN BY: CPE
CHECKED BY: TLL

REVISION HISTORY

NO.	DESCRIPTION


EROSION CONTROL PH I

PHASE I SEQUENCING:

- DRAFT EROSION AND SEDIMENT CONTROL PLAN MUST BE APPROVED AND A LETTER OF APPROVAL (LOA) MUST BE ISSUED PRIOR TO OBTAINING THE CERTIFICATE OF COVERAGE FROM DEQ
- RECEIVE NPDES COVERAGE FROM NCDEQ.
- PRE-CONSTRUCTION CONFERENCE TO BE CONDUCTED WITH THE WAKE COUNTY FIELD CONSULTANT (JEEVAN NEUPANE 919-819-8907) TO DISCUSS EROSION CONTROL MEASURE. FAILURE TO SCHEDULE SUCH CONFERENCE PRIOR TO ANY LAND DISTURBING ACTIVITY IS SUBJECT TO FINE. LDP WILL BE ISSUED AT THE PRE-CONSTRUCTION MEETING (ON-SITE). SITE SHOULD BE FLAGGED PRIOR TO PRE-CONSTRUCTION MEETING.
- INSTALL SILT FENCE, INLET PROTECTION, BERMS AND OTHER MEASURES AS SHOWN ON PLANS, CLEARING ONLY AS NECESSARY TO INSTALL THESE DEVICES.
- CALL FOR ON-SITE INSPECTION BY WAKE COUNTY FIELD CONSULTANT (JEEVAN NEUPANE 919-819-8907). WHEN APPROVED, INSPECTOR GIVES CONTRACTOR THE ABILITY TO CLEAR AND GRUB SITE.
- THE CONTRACTOR SHALL DILIGENTLY AND CONTINUOUSLY MAINTAIN ALL EROSION CONTROL DEVICES AND STRUCTURES.
- FOR PHASED EROSION CONTROL PLANS, CONTRACTOR SHALL MEET WITH EROSION CONTROL INSPECTOR PRIOR TO COMMENCING WITH EACH PHASE OF EROSION CONTROL MEASURES.
- CONTRACTOR SHALL NOT ALLOW MORE THAN 0.25 ACRES OF DISTURBED AREA TO DRAIN TOWARDS 100LF OF SILT FENCE OR PERFORM GRADING IN A MANNER THAT ALLOWS SEDIMENT LADEN WATER TO FLOW LONGITUDINALLY ALONG SILT FENCE LINE. IF A LOW SPOT DEVELOPS ALONG GRADING NEAR SILT FENCE, CONTRACTOR SHALL COORDINATE WITH EROSION CONTROL INSPECTOR TO PLACE A SILT FENCE OUTLET IN OUTLET LOCATIONS.
- CONTACT WAKE COUNTY FIELD CONSULTANT (JEEVAN NEUPANE 919-819-8907) UPON COMPLETION OF INSTALLATION OF PERIMETER EROSION AND SEDIMENT CONTROLS PRIOR TO PROCEEDING WITH ANY OTHER EARTH DISTURBANCE OR GRADING.
- UPON APPROVAL FROM WAKE COUNTY FIELD CONSULTANT (JEEVAN NEUPANE 919-819-8907), COMPLETE DEMOLITION OF ANY SITE FEATURES (PAVEMENT, CURB, ETC.), CLEARING AND GRUBBING, AND STRIP SITE OF TOP SOIL. ALL DEMOLISHED MATERIAL IS TO BE DISPOSED IN ACCORDANCE WITH APPLICABLE NORTH CAROLINA REGULATIONS. CONTRACTOR TO ENSURE ALL APPLICABLE DEMOLITION PERMITS HAVE BEEN ISSUED AND HAVE ORIGINALS OF THE SAME PRIOR TO COMMENCING DEMOLITION ACTIVITIES.
- CONTACT WAKE COUNTY FIELD CONSULTANT (JEEVAN NEUPANE 919-819-8907) UPON COMPLETION OF STRIPPING, THE STOCKPILING OF TOPSOIL, THE CONSTRUCTION OF TEMPORARY SEDIMENT AND EROSION CONTROL FACILITIES, DISPOSAL OF ALL WASTE MATERIAL, AND PREPARATION OF THE GROUND.

INLET PROTECTION NOTE:

PROVIDE APPROPRIATE INLET PROTECTION FOR VARIOUS PHASES OF THE CONSTRUCTION. HARDWARE CLOTH AND GRAVEL PROTECTION SHALL BE PROVIDED FOR INLETS IN NON-PAVED AREA. WEEP FILTERS SHALL BE PROVIDED FOR INLETS IN PAVED AREAS.

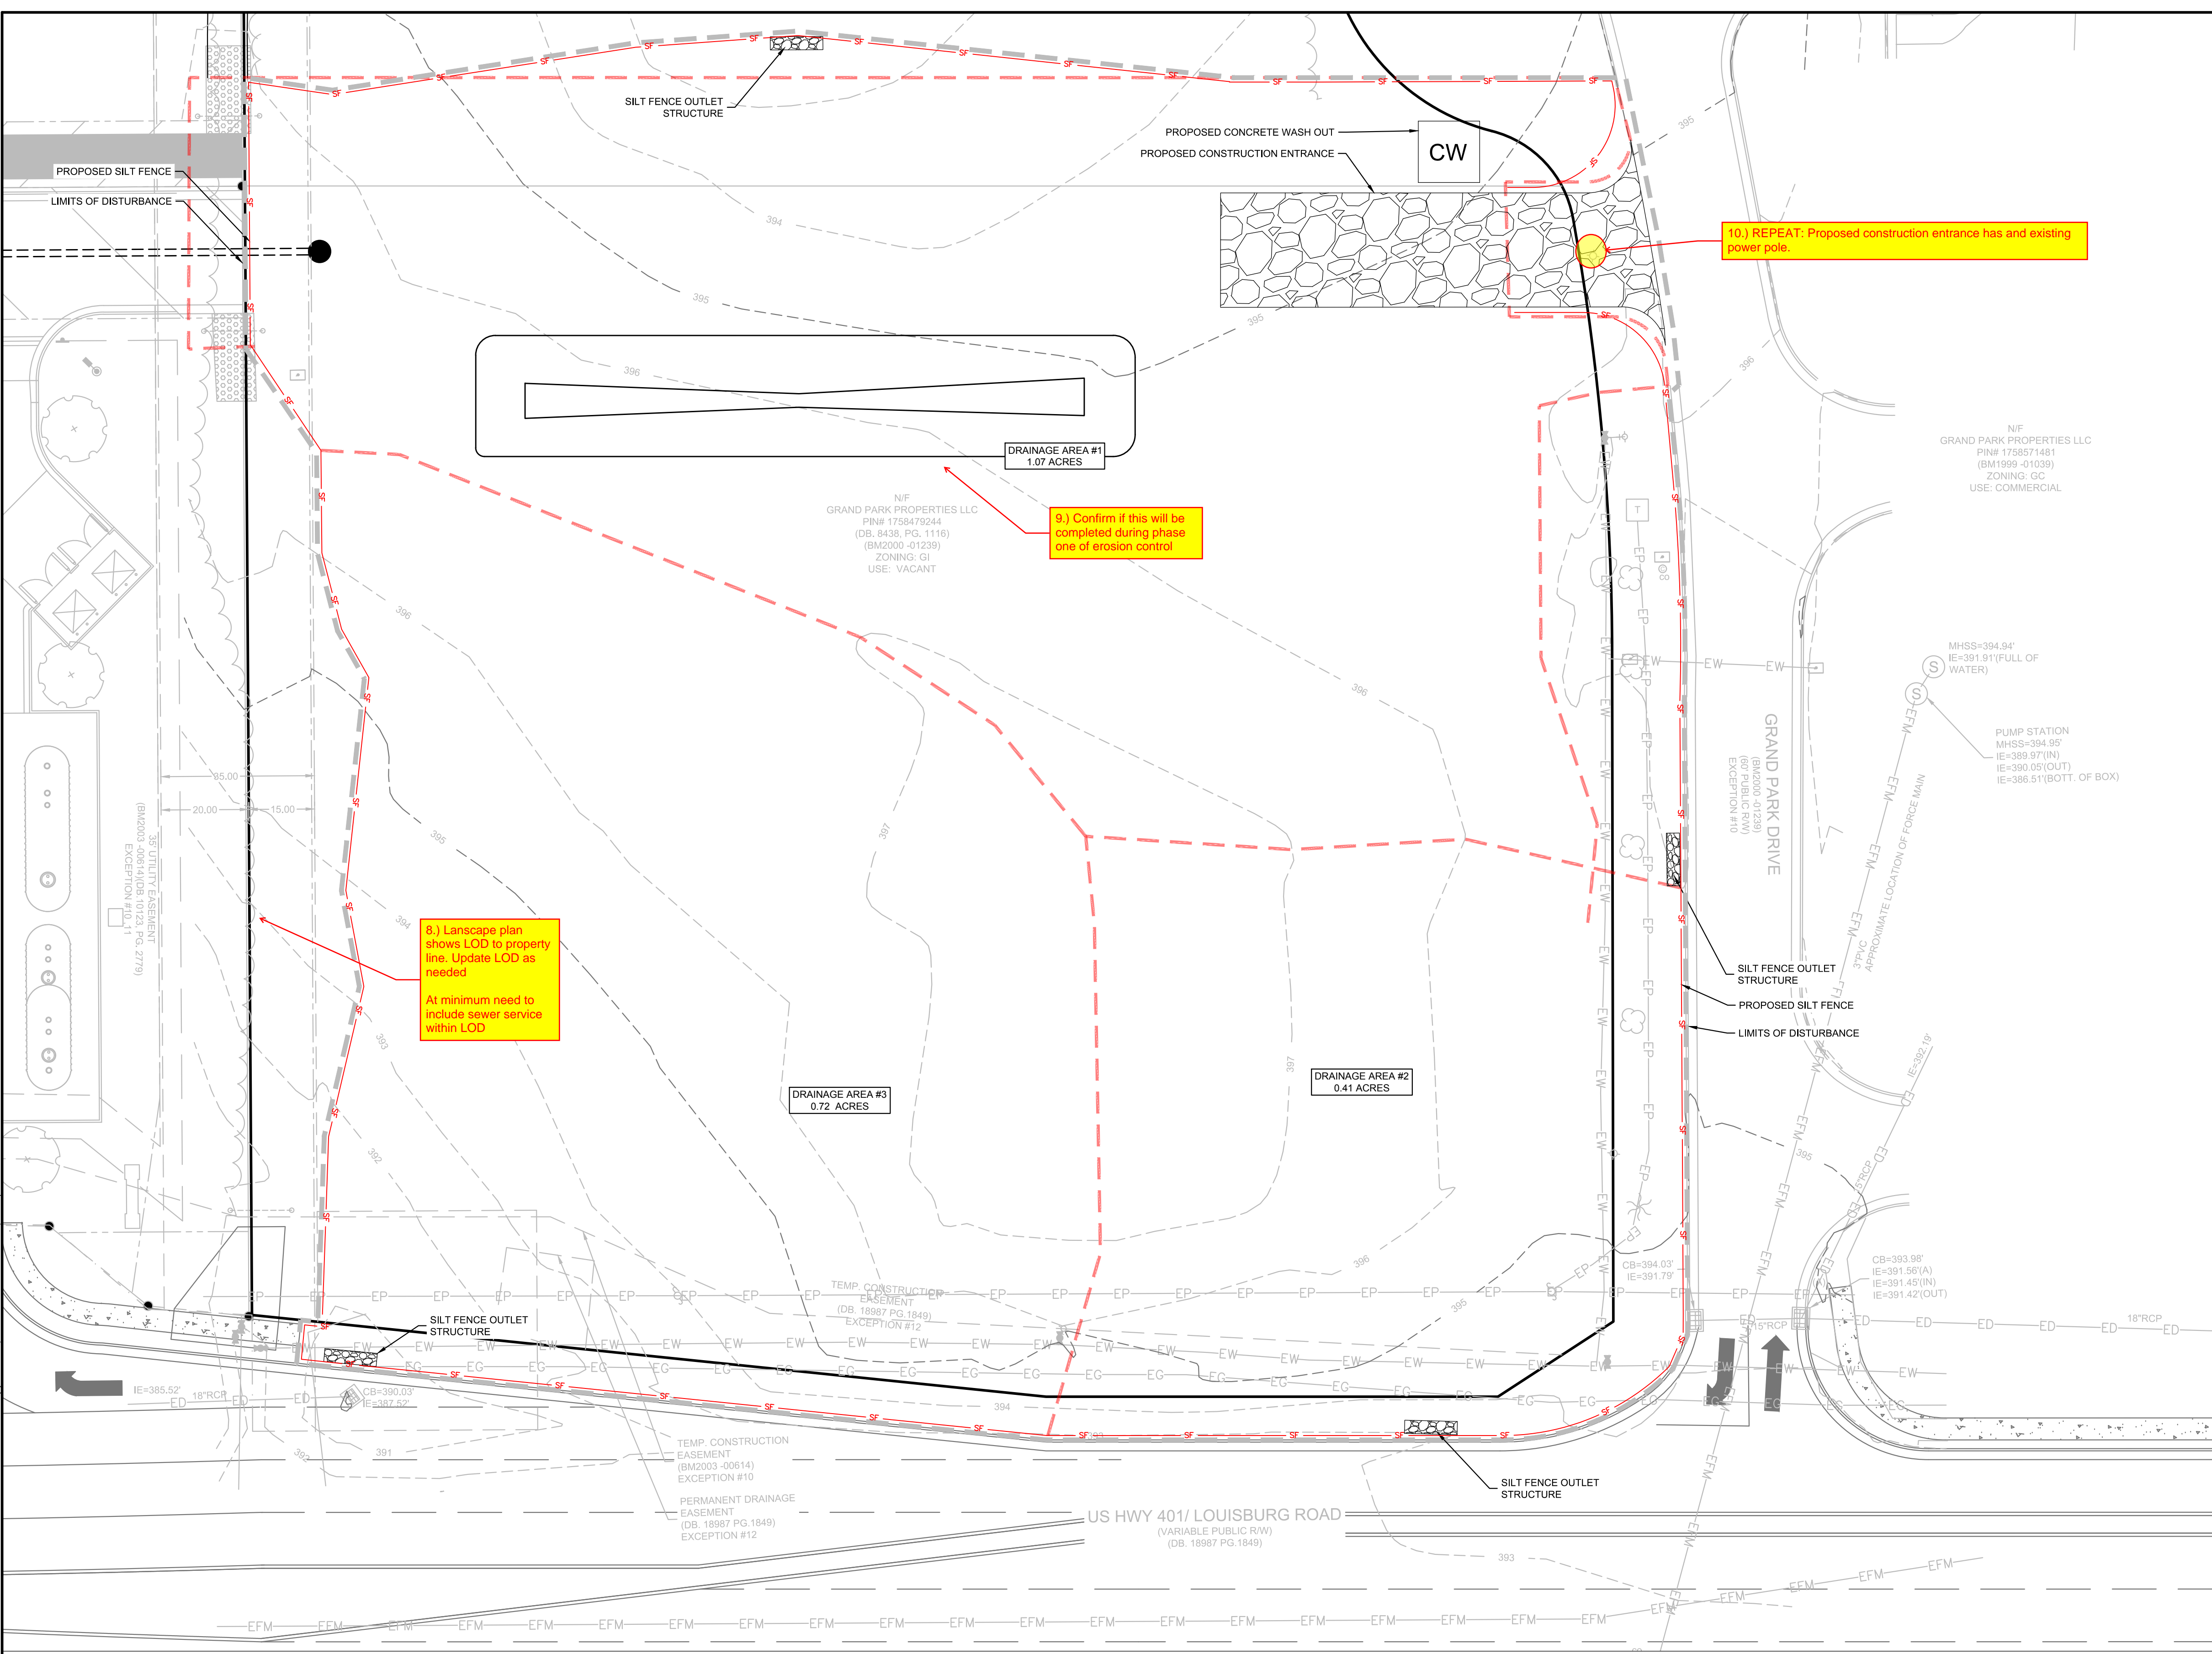

8.) Landscape plan shows LOD to property line. Update LOD as needed.
At minimum need to include sewer service within LOD

9.) Confirm if this will be completed during phase one of erosion control


10.) REPEAT: Proposed construction entrance has an existing power pole.

TOTAL SITE ACREAGE
1.92 ACRES

DISTURBED ACREAGE
2.22 ACRES

EXISTING UTILITY NOTE:
THE LOCATION OF EXISTING UNDERGROUND UTILITIES ARE SHOWN IN AN APPROXIMATE WAY ONLY AND HAVE NOT BEEN INDEPENDENTLY VERIFIED BY THE OWNER OR ITS REPRESENTATIVE. THE CONTRACTOR SHALL DETERMINE THE EXACT LOCATION OF ALL EXISTING UTILITIES BEFORE COMMENCING ANY WORK, AND AGREES TO BE FULLY RESPONSIBLE FOR ANY AND ALL DAMAGES WHICH MIGHT OCCUR DUE TO THE CONTRACTOR'S FAILURE TO EXACTLY LOCATE AND PRESERVE ANY AND ALL UNDERGROUND UTILITIES.

STABILIZATION NOTE:
PROVIDE FINAL STABILIZATION FOR ALL DISTURBED AREAS. REFER TO THE LANDSCAPE PLAN FOR SPECIFIC MATERIALS / PLANTINGS. ANY DISTURBED AREA NOT ADDRESSED IN THE LANDSCAPE PLANS SHALL BE PERMANENT SEEDED.

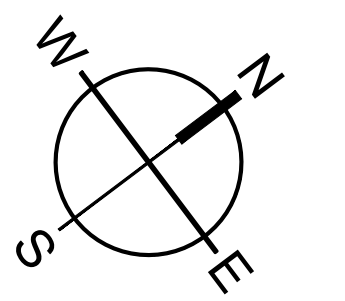

E&S PLAN LEGEND

LIMITS OF DISTURBANCE	---	CONCRETE WASHOUT BASIN (SEE DETAIL)	CW
SILT FENCE, STANDARD	—S—	SILT BAG INLET PROTECTION	⊙
SILT FENCE OUTLET/TRIP RAP APRON/RIP RAP BASIN & ROCK SEDIMENT TRAP	—S—	HARDWARE CLOTH AND GRAVEL INLET PROTECTION	⊠
CONSTRUCTION ENTRANCE	—S—	TEMPORARY SEEDING	⊙
PERMANENT SOD	⊙		




501 WANDO PARK BOULEVARD, SUITE 200 | MOUNT PLEASANT, SC 29546 | JUDSON MILLS BUILDING 6000 TOY EASLEY BRIDGE RD, SUITE 6000 | GREENVILLE, SC 29611 | 701 N. CEDAR STREET | SUMMERVILLE, SC 29585 | 104 N. DANIEL MORGAN AVENUE, SUITE 300 | SPARTANBURG, SC 29301
COPYRIGHT © SEAMON WHITESIDE & ASSOCIATES, INC. THIS DRAWING SHALL NOT BE REPRODUCED IN ANY MANNER WITHOUT WRITTEN PERMISSION.

PHASE II SEQUENCING:

1. CONTACT THE WAKE COUNTY FIELD CONSULTANT (JEEVAN NEUPANE 919-819-8907) FOR APPROVAL TO PROCEED.
2. TEMPORARILY STABILIZE GRADED AREAS (NON-STEEP SLOPES) AS REQUIRED.
3. COMPLETE ROUGH GRADING. COMPLETE THE INSTALLATION OF STORMWATER SYSTEM AND SITE UTILITIES.
4. CONTACT THE WAKE COUNTY FIELD CONSULTANT (JEEVAN NEUPANE 919-819-8907) UPON COMPLETION OF ROUGH GRADING, BUT PRIOR TO PLACING TOPSOIL, PERMANENT DRAINAGE, OR OTHER SITE DEVELOPMENT IMPROVEMENTS AND GROUND COVERS.
5. INSTALL CURB ALONG THE PERIMETER OF THE SITE TO AID IN THE PROTECTION OF THE EXISTING ADJACENT PROPERTIES AND THE ADJACENT ROADWAYS.

INLET PROTECTION NOTE:

PROVIDE APPROPRIATE INLET PROTECTION FOR VARIOUS PHASES OF THE CONSTRUCTION. HARDWARE CLOTH AND GRAVEL INLET PROTECTION SHALL BE PROVIDED FOR INLETS IN NON-PAVED AREA. DANDY SACK INLET PROTECTION SHALL BE PROVIDED FOR INLETS IN PAVED AREAS.

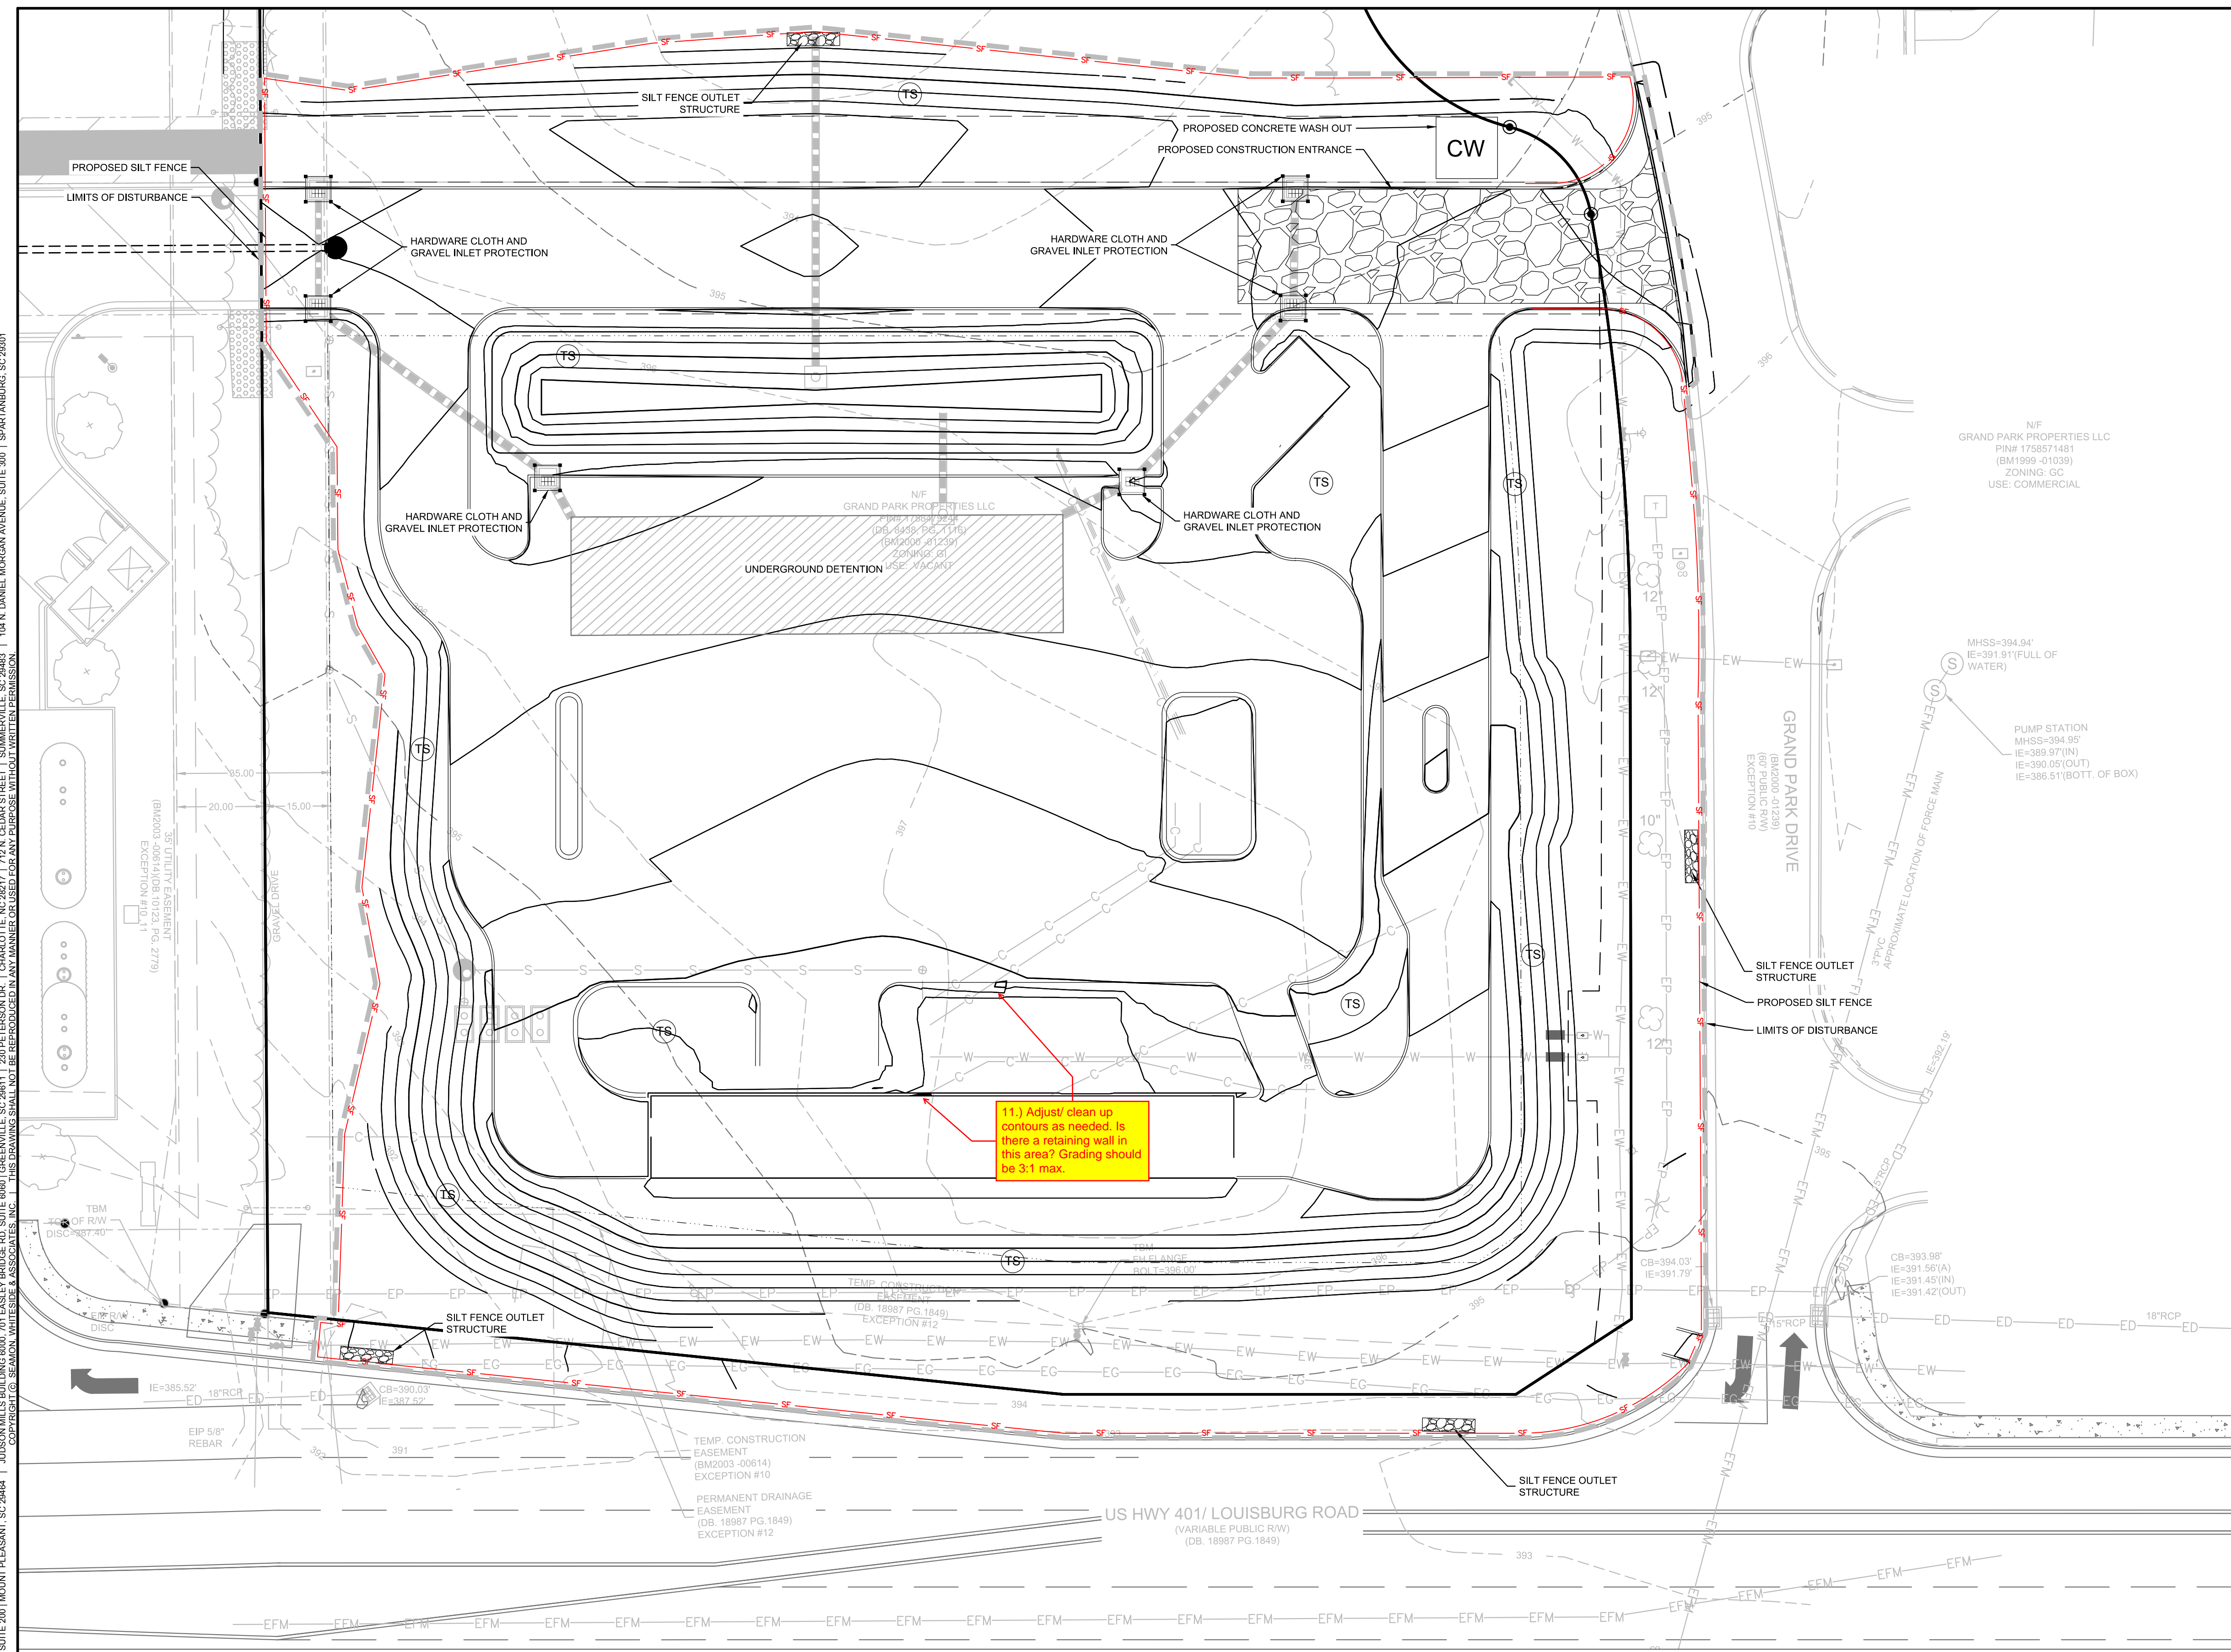


TOTAL SITE ACREAGE
 1.92 ACRES

DISTURBED ACREAGE
 2.22 ACRES

EXISTING UTILITY NOTE:
 THE LOCATION OF EXISTING UNDERGROUND UTILITIES ARE SHOWN IN AN APPROXIMATE WAY ONLY AND HAVE NOT BEEN INDEPENDENTLY VERIFIED BY THE OWNER OR ITS REPRESENTATIVE. THE CONTRACTOR SHALL DETERMINE THE EXACT LOCATION OF ALL EXISTING UTILITIES BEFORE COMMENCING ANY WORK, AND AGREES TO BE FULLY RESPONSIBLE FOR ANY AND ALL DAMAGES WHICH MIGHT OCCUR DUE TO THE CONTRACTOR'S FAILURE TO EXACTLY LOCATE AND PRESERVE ANY AND ALL UNDERGROUND UTILITIES.

STABILIZATION NOTE:
 PROVIDE FINAL STABILIZATION FOR ALL DISTURBED AREAS. REFER TO THE LANDSCAPE PLAN FOR SPECIFIC MATERIALS / PLANTINGS. ANY DISTURBED AREA NOT ADDRESSED IN THE LANDSCAPE PLANS SHALL BE PERMANENT SEEDED.

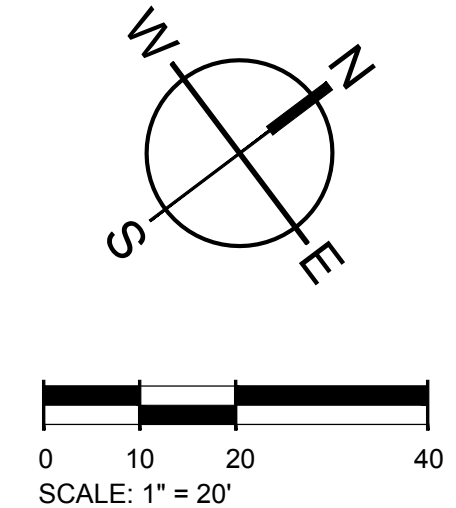

E&S PLAN LEGEND


LIMITS OF DISTURBANCE	---	CONCRETE WASHOUT BASIN (SEE DETAIL)	CW
SILT FENCE, STANDARD	—+—	SILT BAG INLET PROTECTION	⊙
SILT FENCE OUTLET/ RIP RAP APRON/ RIP RAP BASIN & ROCK SEDIMENT TRAP	⊞	HARDWARE CLOTH AND GRAVEL INLET PROTECTION	⊞
CONSTRUCTION ENTRANCE	⊞	TEMPORARY SEEDING	TS
PERMANENT SOD	PS		



501 WINDO PARK BOULEVARD, SUITE 200 | MOUNT PLEASANT, SC 29546 | JUDSON MILLS BUILDING 6000 TOY EASLEY BROOK RD, SUITE 600 | GREENVILLE, SC 29611 | 230 PETERSON DR | CHARLOTTE, NC 28217 | 7124 CEDAR STREET | SUMMERVILLE, SC 29585 | 104 N. DANIEL MORGAN AVENUE, SUITE 300 | SPARTANBURG, SC 29301
 COPYRIGHT © SEAMON WHITESIDE & ASSOCIATES, INC. THIS DRAWING SHALL NOT BE REPRODUCED IN ANY MANNER OR USED FOR ANY PURPOSE WITHOUT WRITTEN PERMISSION.

PHASE III SEQUENCING:

1. CONTACT WAKE COUNTY FIELD CONSULTANT (JEEVAN NEUPANE 919-819-8907) FOR APPROVAL TO PROCEED
2. BEGIN FINE GRADING AND INITIATE FINAL PAVING
3. ONCE BUILDING CONSTRUCTION FOR SITE IS COMPLETE, CONTACT THE WAKE COUNTY FIELD CONSULTANT (JEEVAN NEUPANE 919-819-8907) FOR APPROVAL TO REMOVE APPLICABLE EROSION CONTROL MEASURES.
4. PERMANENTLY STABILIZE ANY REMAINING AREAS IN ACCORDANCE WITH THE PERMANENT SEEDING SCHEDULE AND NOTES. INSTALL FINAL SITE LANDSCAPING
5. REQUEST FINAL APPROVAL FROM THE WAKE COUNTY FIELD CONSULTANT (JEEVAN NEUPANE 919-819-8907) PRIOR TO REMOVING ANY REMAINING SEDIMENT CONTROL MEASURES AND UPON COMPLETION OF FINAL GRADING, PERMANENT DRAINAGE, AND EROSION CONTROL FACILITIES, INCLUDING ESTABLISHED GROUND COVERS AND PLANTINGS, AND ALL OTHER WORK OF THE BUILDING PERMITS.

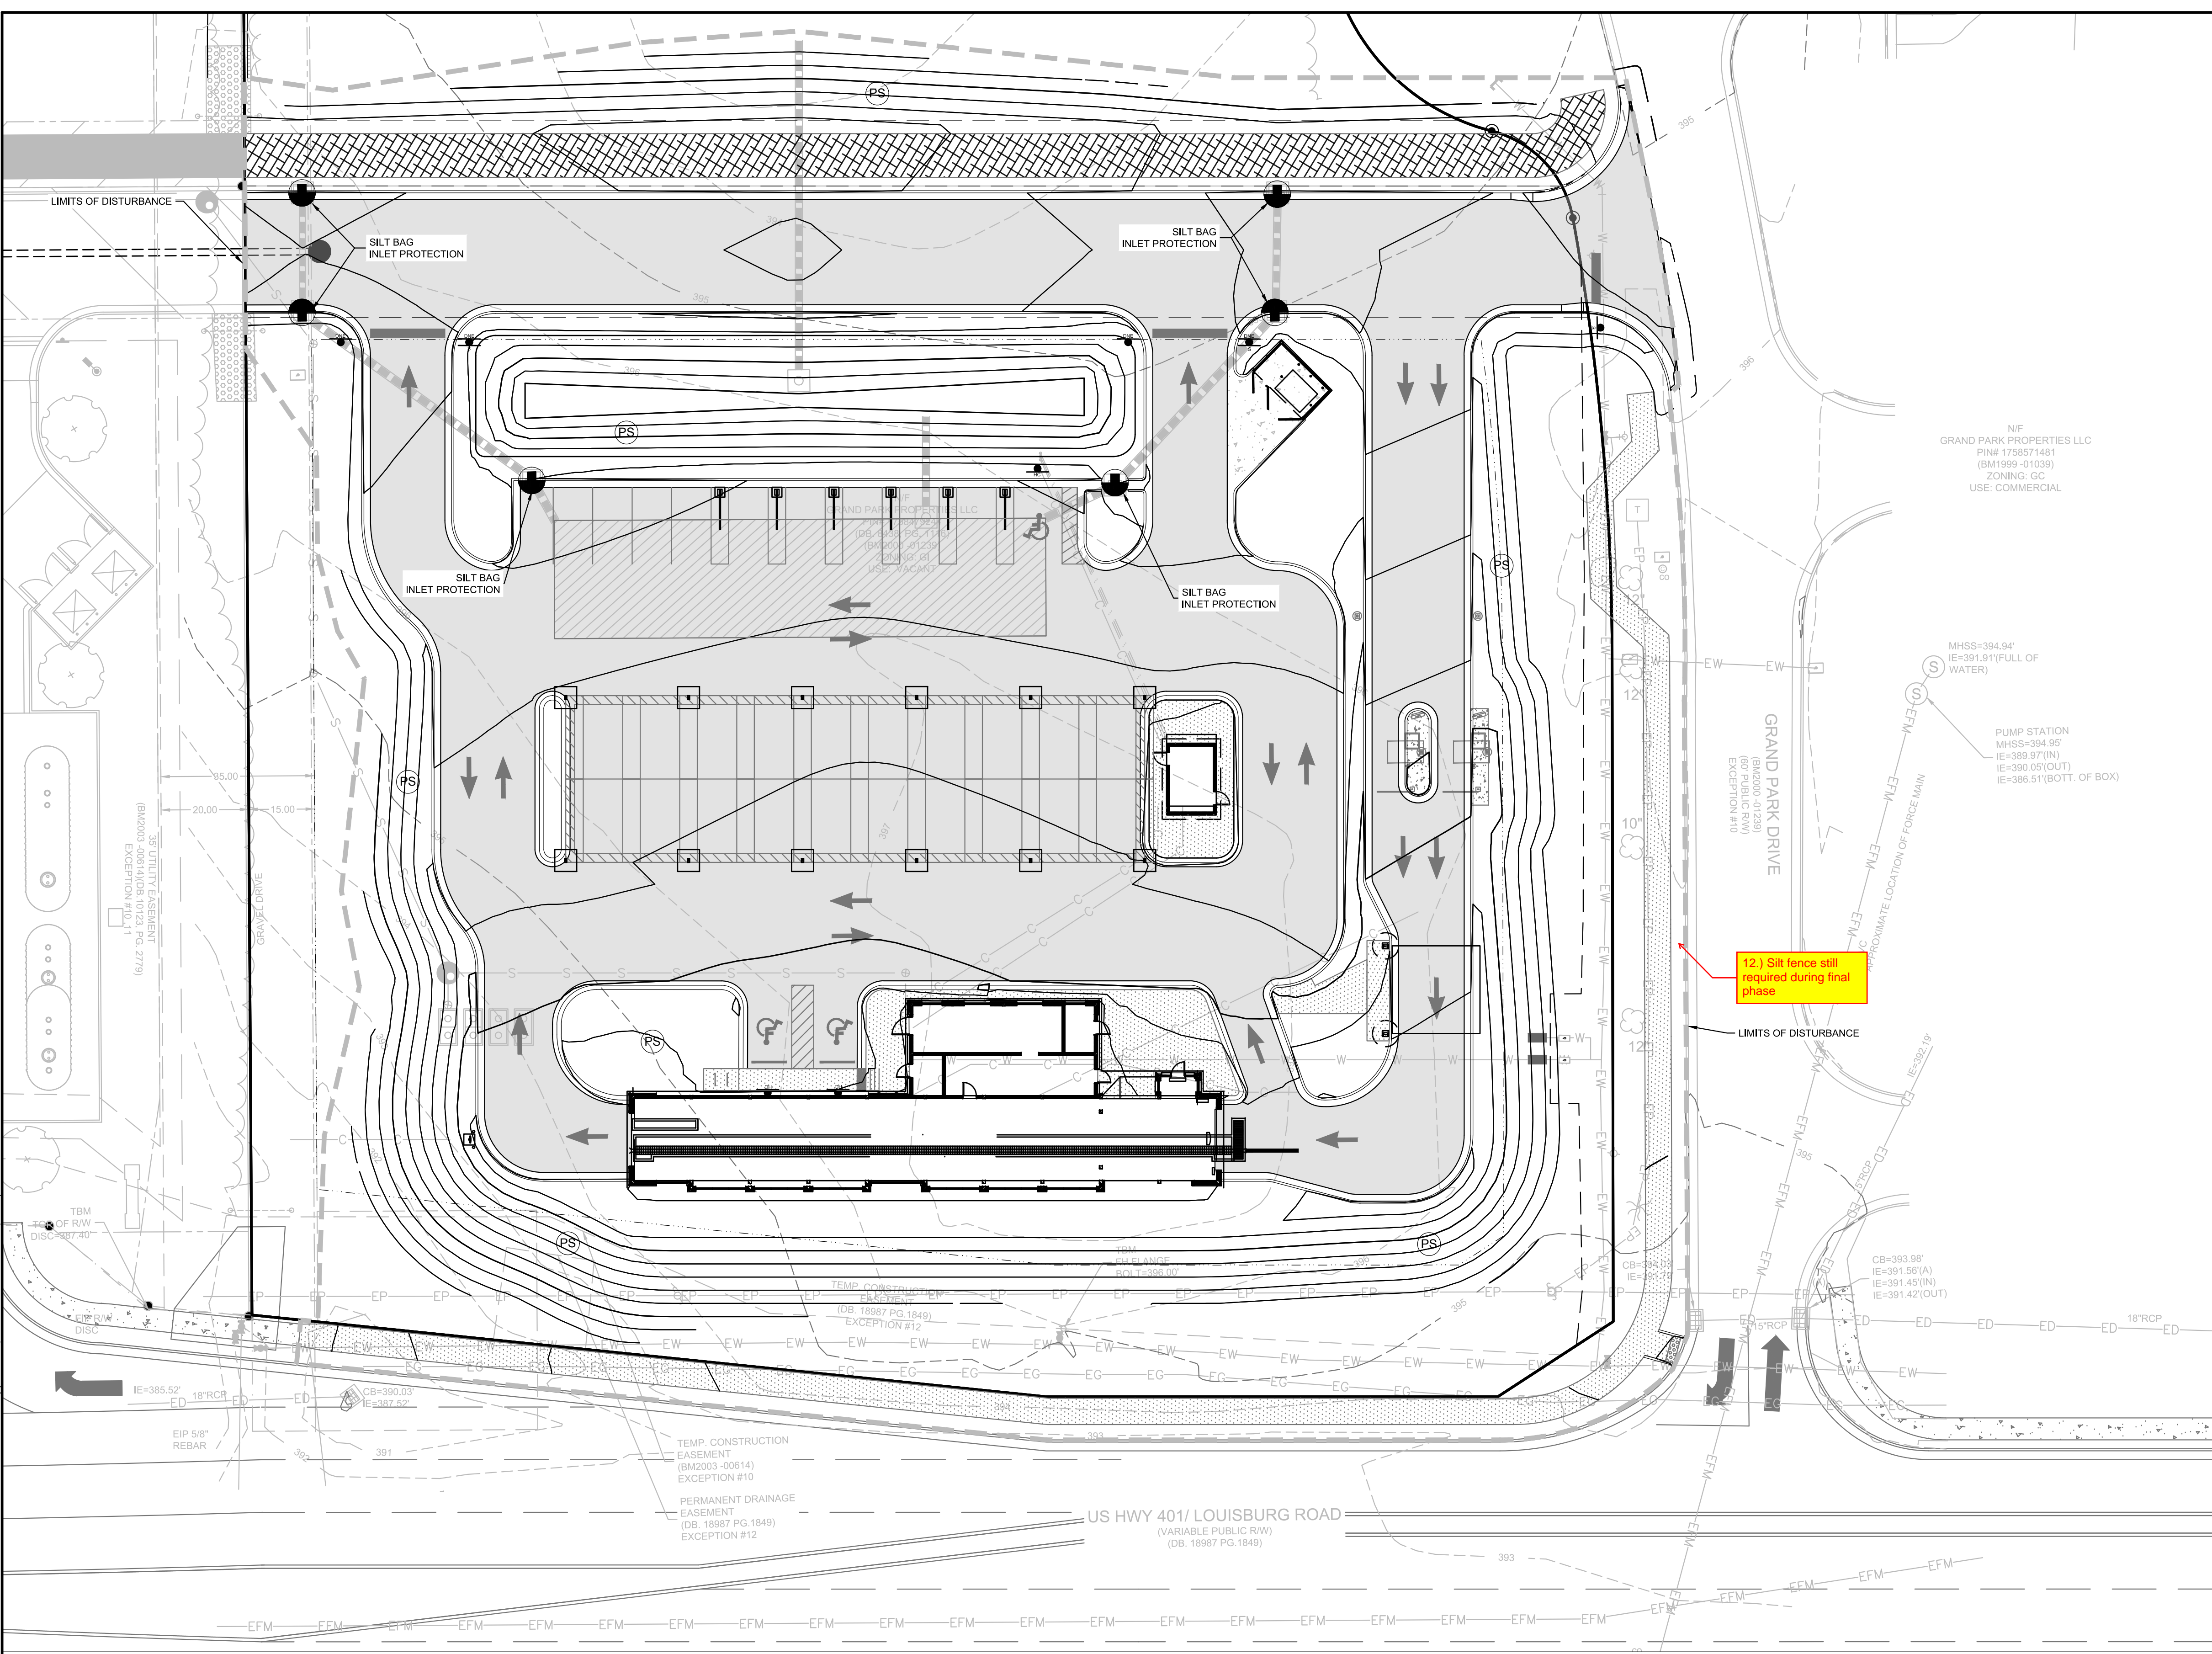

N/F
GRAND PARK PROPERTIES LLC
PIN# 1758571481
(BM)1988-01039
ZONING: GC
USE: COMMERCIAL

MHSS-394.94'
IE=391.91'(FULL OF WATER)

PUMP STATION
MHSS-394.96'
IE=389.97'(IN)
IE=390.05'(OUT)
IE=388.51'(BOTT. OF BOX)


12.) Silt fence still required during final phase

TOTAL SITE ACREAGE
1.92 ACRES

DISTURBED ACREAGE
2.22 ACRES

EXISTING UTILITY NOTE:
THE LOCATION OF EXISTING UNDERGROUND UTILITIES ARE SHOWN IN AN APPROXIMATE WAY ONLY AND HAVE NOT BEEN INDEPENDENTLY VERIFIED BY THE OWNER OR ITS REPRESENTATIVE. THE CONTRACTOR SHALL DETERMINE THE EXACT LOCATION OF ALL EXISTING UTILITIES BEFORE COMMENCING ANY WORK, AND AGREES TO BE FULLY RESPONSIBLE FOR ANY AND ALL DAMAGES WHICH MIGHT OCCUR DUE TO THE CONTRACTOR'S FAILURE TO EXACTLY LOCATE AND PRESERVE ANY AND ALL UNDERGROUND UTILITIES.

STABILIZATION NOTE:
PROVIDE FINAL STABILIZATION FOR ALL DISTURBED AREAS. REFER TO THE LANDSCAPE PLAN FOR SPECIFIC MATERIALS / PLANTINGS. ANY DISTURBED AREA NOT ADDRESSED IN THE LANDSCAPE PLANS SHALL BE PERMANENT SEEDDED.

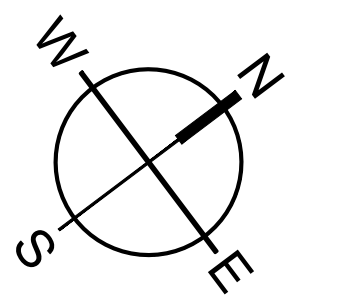


0 10 20 40
SCALE: 1" = 20'

E&S PLAN LEGEND


LIMITS OF DISTURBANCE	CONCRETE WASHOUT BASIN (SEE DETAIL)	CW
SILT FENCE, STANDARD	SILT BAG INLET PROTECTION	SB
SILT FENCE OUTLET/TRIP RAP APRON/RIP RAP BASIN & ROCK SEDIMENT TRAP	HARDWARE CLOTH AND GRAVEL INLET PROTECTION	HC
CONSTRUCTION ENTRANCE	TEMPORARY SEEDING	TS
PERMANENT SOD		PS



501 WINDO PARK BOULEVARD, SUITE 200 | MOUNT PLEASANT, SC 29546 | JUDSON MILLS BUILDING 6000 TOY EASLEY BROOK RD, SUITE 6000 | GREENVILLE, SC 29611 | 230 PETERSON DR. | CHARLOTTE, NC 28217 | 713 N. CEDAR STREET | SUMMERVILLE, SC 29586 | 104 N. DANIEL MORGAN AVENUE, SUITE 300 | SPARTANBURG, SC 29301
COPYRIGHT © SEAMON WHITESIDE & ASSOCIATES, INC. THIS DRAWING SHALL NOT BE REPRODUCED IN ANY MANNER OR USED FOR ANY PURPOSE WITHOUT WRITTEN PERMISSION.

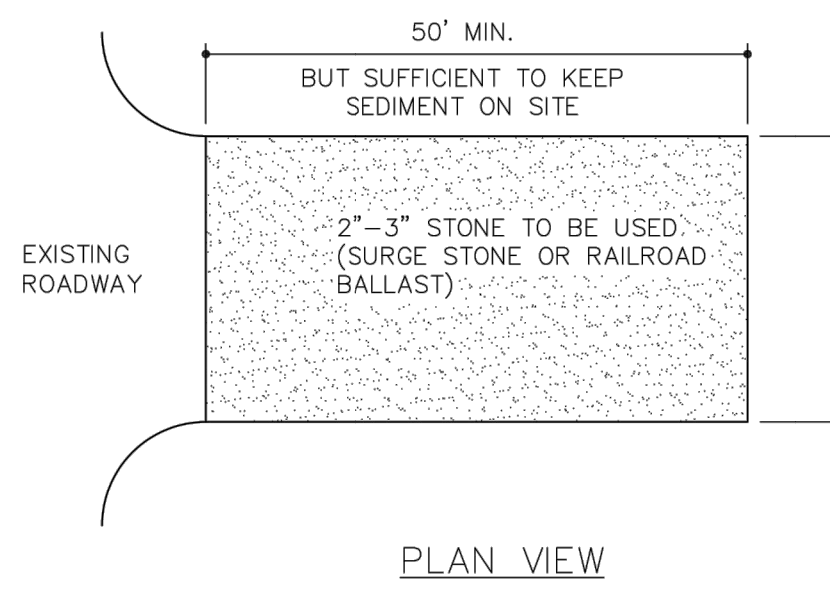


- NOTES:**
1. INSTALL SILT FENCE OR TREE PROTECTION FENCE TO ENSURE CONSTRUCTION ENTRANCE IS USED BY VEHICLES.
 2. IF MUD IS NOT REMOVED FROM TIRES AFTER VEHICLE TRAVELS OVER STONE, THE TIRES OF THE VEHICLE MUST BE WASHED BEFORE ENTERING PUBLIC ROADS.
- MAINTENANCE NOTES:**
1. THE GRAVEL CONSTRUCTION ENTRANCE MUST BE MAINTAINED IN A CONDITION TO PREVENT TRACKING OR DIRECT FLOW OF MUD ONTO ADJACENT ROADWAYS.
 2. REPLACEMENT OF STONE MAY BE NECESSARY TO ENSURE THE GRAVEL ENTRANCE FUNCTIONS PROPERLY.
 3. REPLENISHMENT OF STONE MAY BE NECESSARY.
 4. FREQUENT CHECKS OF THE DEVICE AND TIMELY MAINTENANCE SHOULD BE COMPLETED.
 5. ANY MATERIAL TRACKED ONTO THE ROADWAY SHALL BE CLEANED UP IMMEDIATELY.

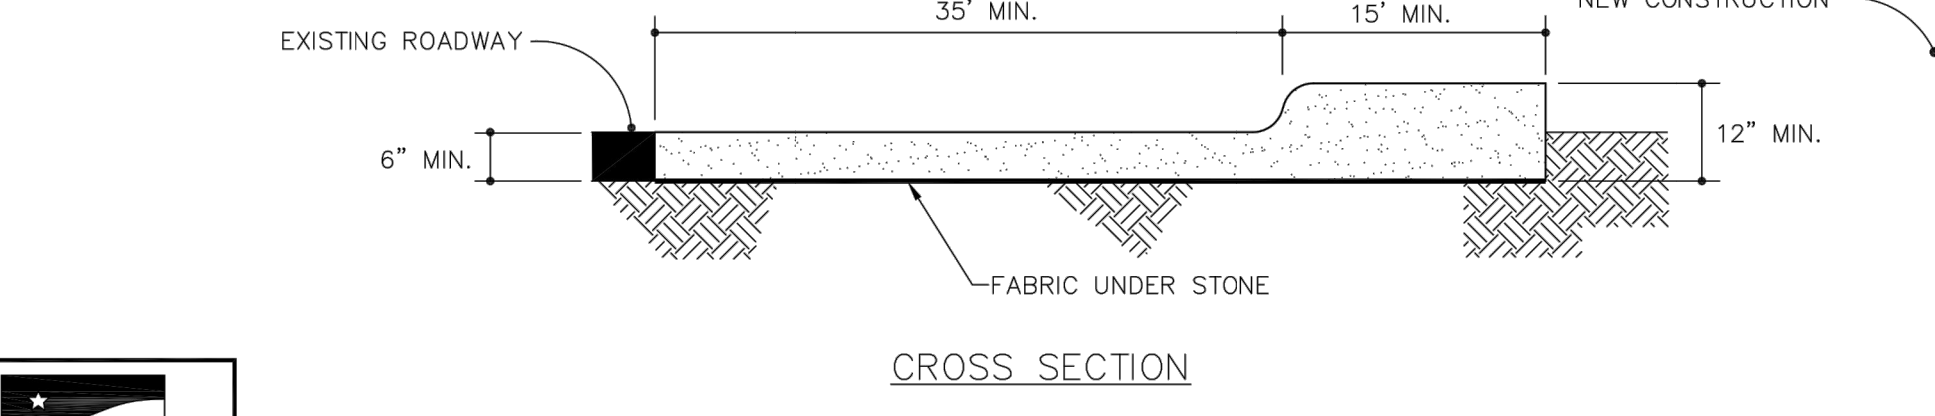

STANDARD CONSTRUCTION ENTRANCE




EFFECTIVE: 01/31/08

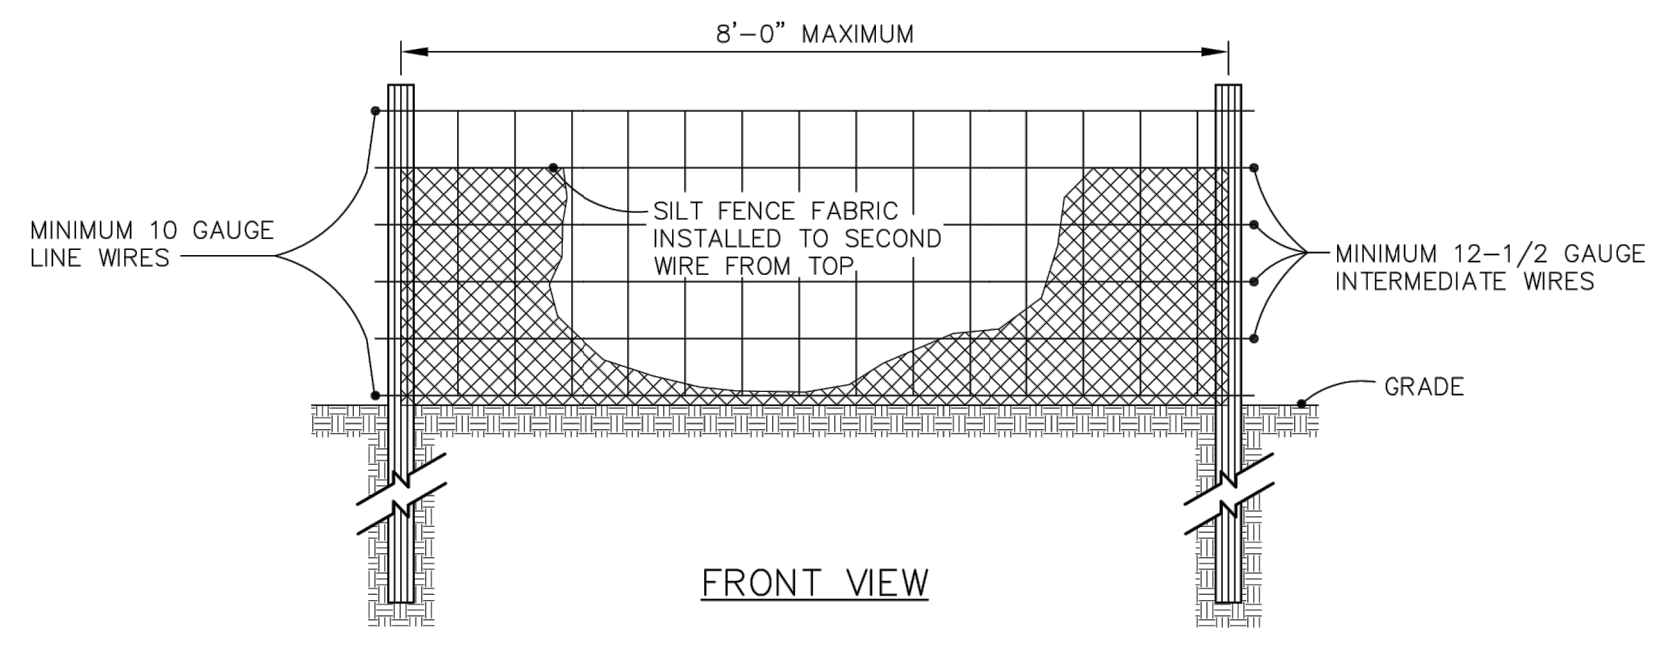

- MAINTENANCE NOTES:**
1. INSPECT BAG AFTER EACH SIGNIFICANT RAINFALL OF 1 INCHES OR GREATER, OVER A 24-HOUR PERIOD. MAKE ANY REPAIRS IMMEDIATELY.
 2. INSPECT THE SILT FENCE TO BE SURE THE BOTTOM OF THE GEOTEXTILE IS KEPT IN PROPERLY.
 3. AT A MINIMUM, REMOVE AND DISPOSE OF ALL SILT ACCUMULATIONS WHEN DEPTH REACHES 1/2 THE HEIGHT OF THE GEOTEXTILE. DO NOT UNDERMINE THE FENCE DURING CLEANOUT.
 4. DISPOSE OF SEDIMENT BY HAULING IT TO AN APPROVED WASTE SITE WITH APPROPRIATE PERIMETER PROTECTION.
 5. REMOVE AND REPLACE DETERIORATED OR CLOGGED SILT FENCE.
 6. REPLACE SILT FENCE REMOVED FOR ACCESS AT THE END OF EACH DAY'S OPERATION.
 7. INSTALL ADDITIONAL POSTS OR WIRE BACKING IF FENCE IS SAGGING.




EFFECTIVE: 01/31/08

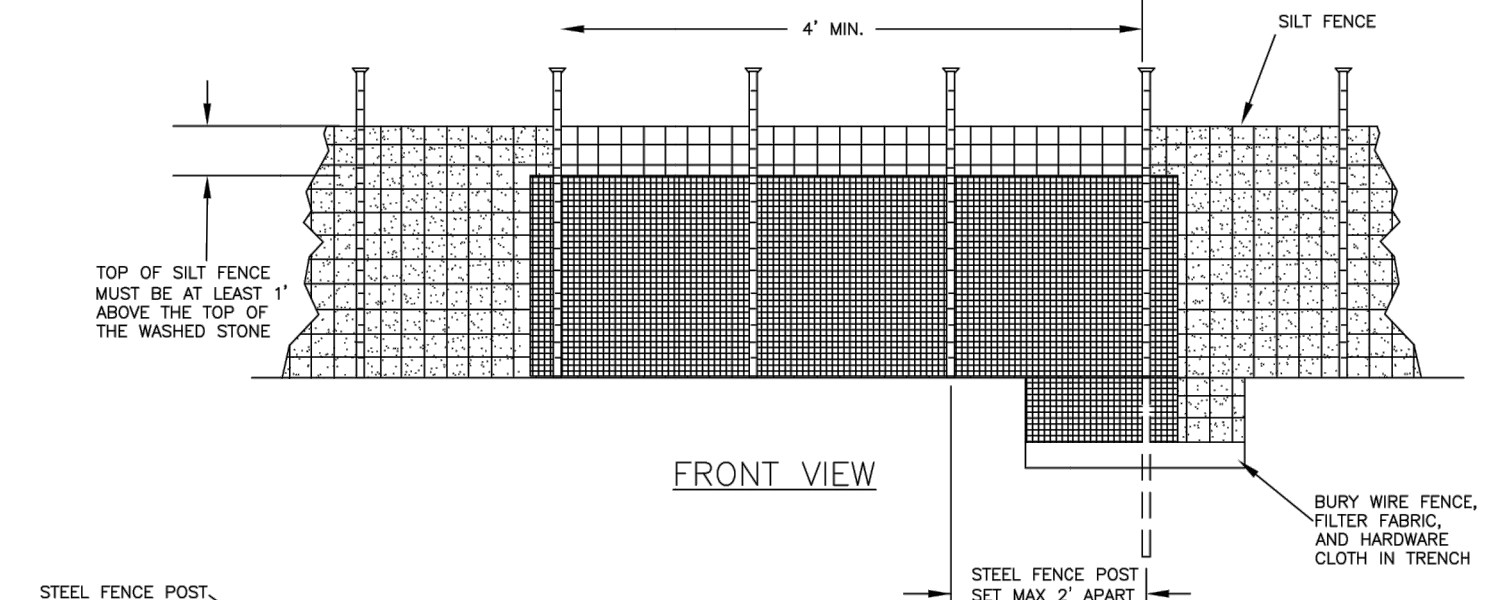

- MAINTENANCE NOTES:**
1. INSPECT THE DEVICE PERIODICALLY AND AFTER 1 INCH RAINFALL OVER 24 HOUR PERIOD FOR DAMAGE AND SEDIMENT ACCUMULATION TO CONFIRM THE DEVICE IS FUNCTIONING PROPERLY.
 2. AT A MINIMUM, REMOVE SEDIMENT FROM THE DEVICE WHEN ACCUMULATIONS REACH ONE-HALF THE HEIGHT OF THE SEDIMENT CONTROL STONE.
 3. REPLACE OR CLEAN THE SEDIMENT CONTROL STONE AS NEEDED TO ALLOW WATER TO DRAIN THROUGH THE DEVICE BETWEEN RAINFALL EVENTS.
 4. REPAIR AREAS WHERE OUTLET BECOMES UNDERMINED DUE TO CONCENTRATED FLOWS.



EFFECTIVE: 01/31/08

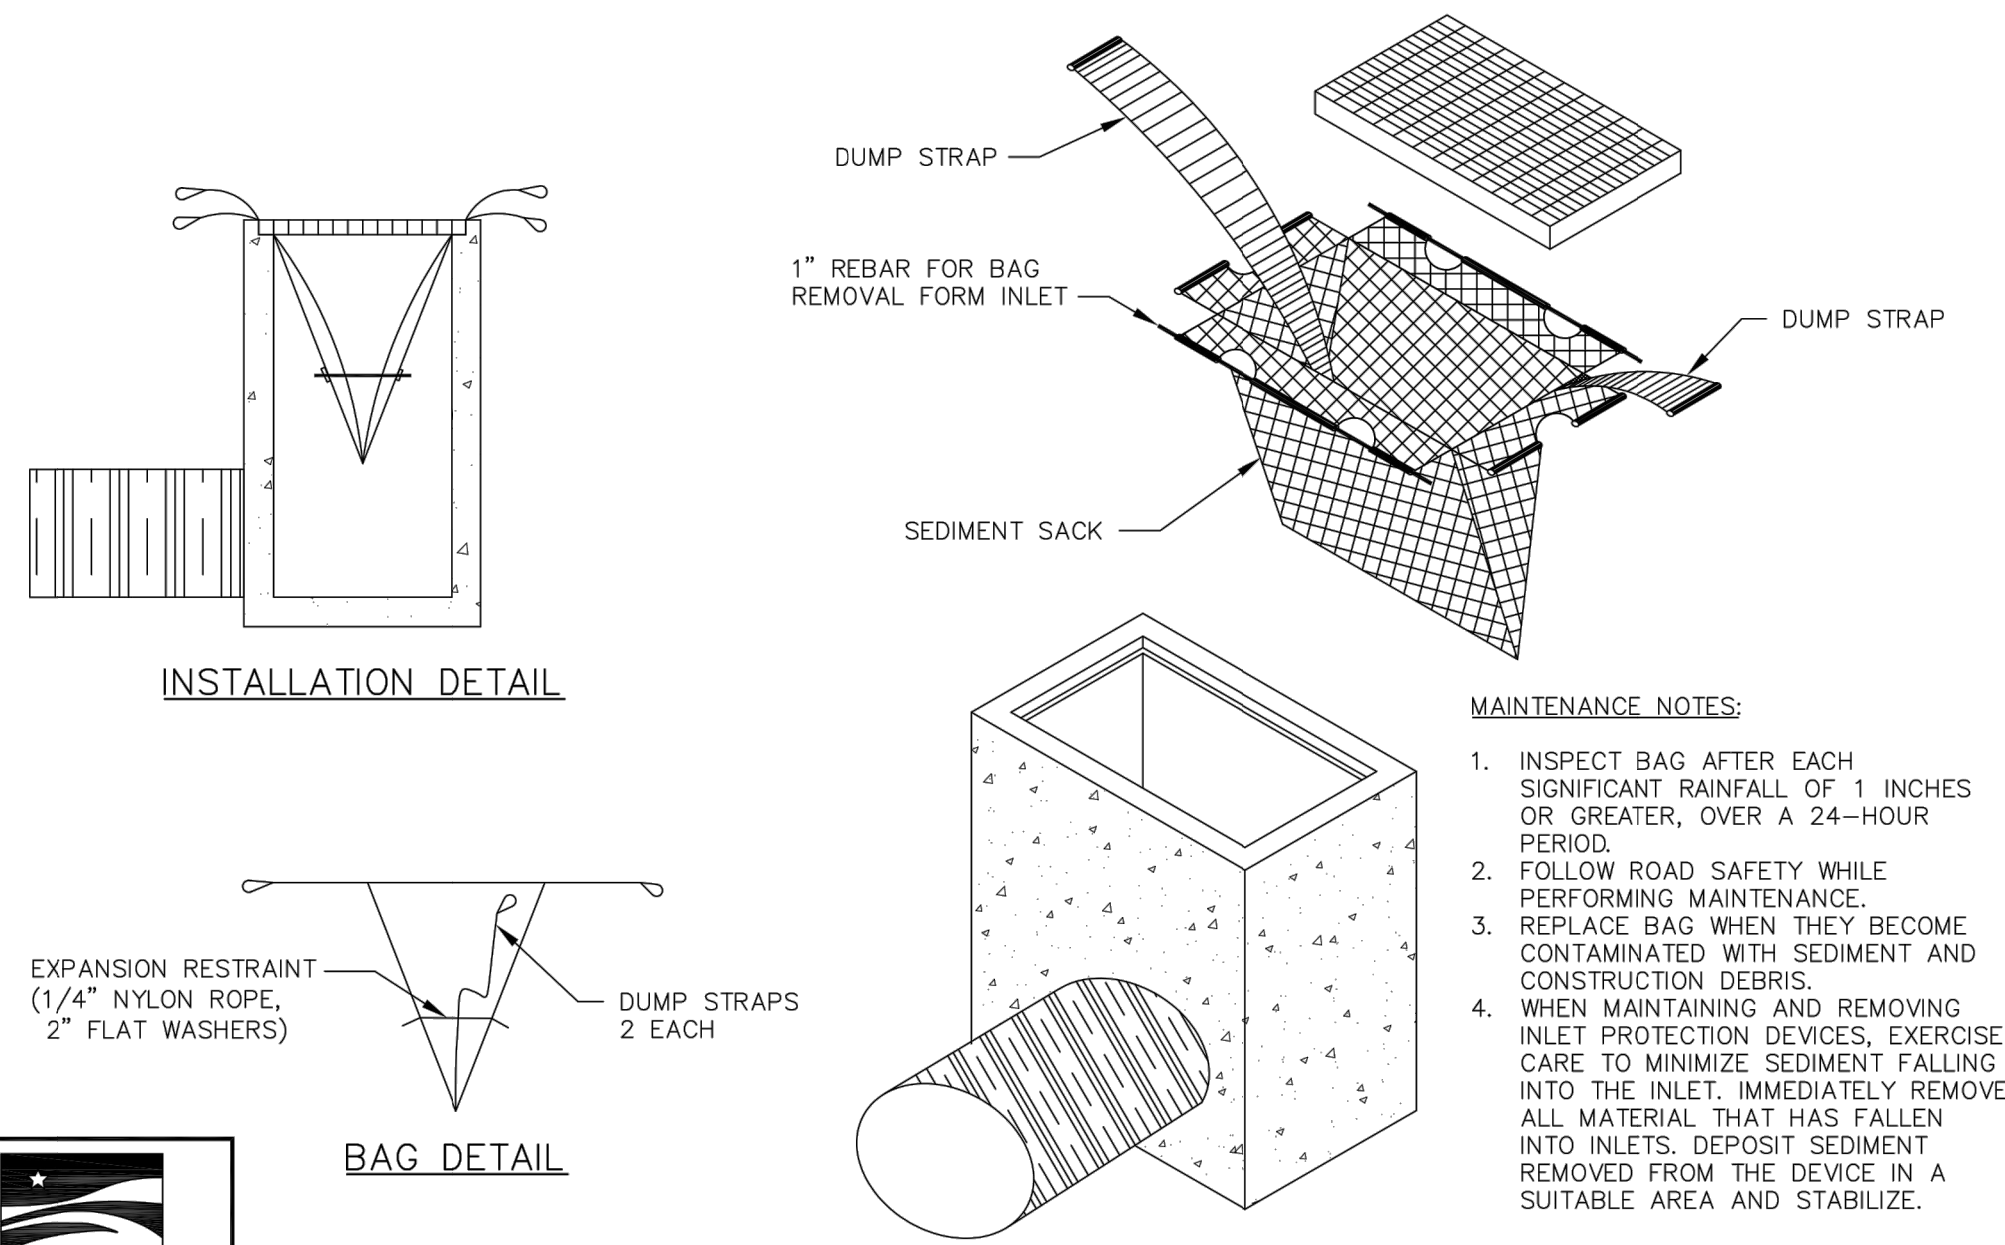


- MAINTENANCE NOTES:**
1. INSPECT BAG AFTER EACH SIGNIFICANT RAINFALL OF 1 INCHES OR GREATER, OVER A 24-HOUR PERIOD.
 2. FOLLOW ROAD SAFETY WHILE PERFORMING MAINTENANCE.
 3. REPLACE BAG WHEN THEY BECOME CONTAMINATED WITH SEDIMENT AND CONSTRUCTION DEBRIS.
 4. WHEN MAINTAINING AND REMOVING INLET PROTECTION DEVICES, EXERCISE CARE TO MINIMIZE SEDIMENT FALLING INTO THE INLET. IMMEDIATELY REMOVE ALL MATERIAL THAT HAS FALLEN INTO INLETS. DEPOSIT SEDIMENT REMOVED FROM THE DEVICE IN A SUITABLE AREA AND STABILIZE.

STANDARD SILT BAG - INLET SEDIMENT CONTROL DEVICE




EFFECTIVE: 01/31/08

- GENERAL NOTES:**
1. UNIFORMLY GRADE A SHALLOW DEPRESSION APPROACHING THE INLET.
 2. DRIVE 5-FOOT STEEL POSTS 2 FEET INTO THE GROUND SURROUNDING THE INLET. SPACE POSTS EVENLY AROUND THE PERIMETER OF THE INLET, A MAXIMUM OF 4 FEET APART.
 3. SURROUND THE POSTS WITH WIRE MESH HARDWARE CLOTH. SECURE THE WIRE MESH TO THE STEEL POSTS AT THE TOP, MIDDLE, AND BOTTOM. PLACING A 2-FOOT FLAP OF THE WIRE MESH UNDER THE GRAVEL FOR ANCHORING IS RECOMMENDED.
 4. PLACE CLEAN GRAVEL (NO DOT #5 OR #57 STONE) ON A 2:1 SLOPE WITH A HEIGHT OF 16 INCHES AROUND THE WIRE, AND SMOOTH TO AN EVEN GRADE.
 5. ONCE THE CONTRIBUTING DRAINAGE AREA HAS BEEN STABILIZED, REMOVE ACCUMULATED SEDIMENT, AND ESTABLISH FINAL GRADING ELEVATIONS.
 6. COMPACT THE AREA PROPERLY AND STABILIZED IT WITH GROUND COVER.

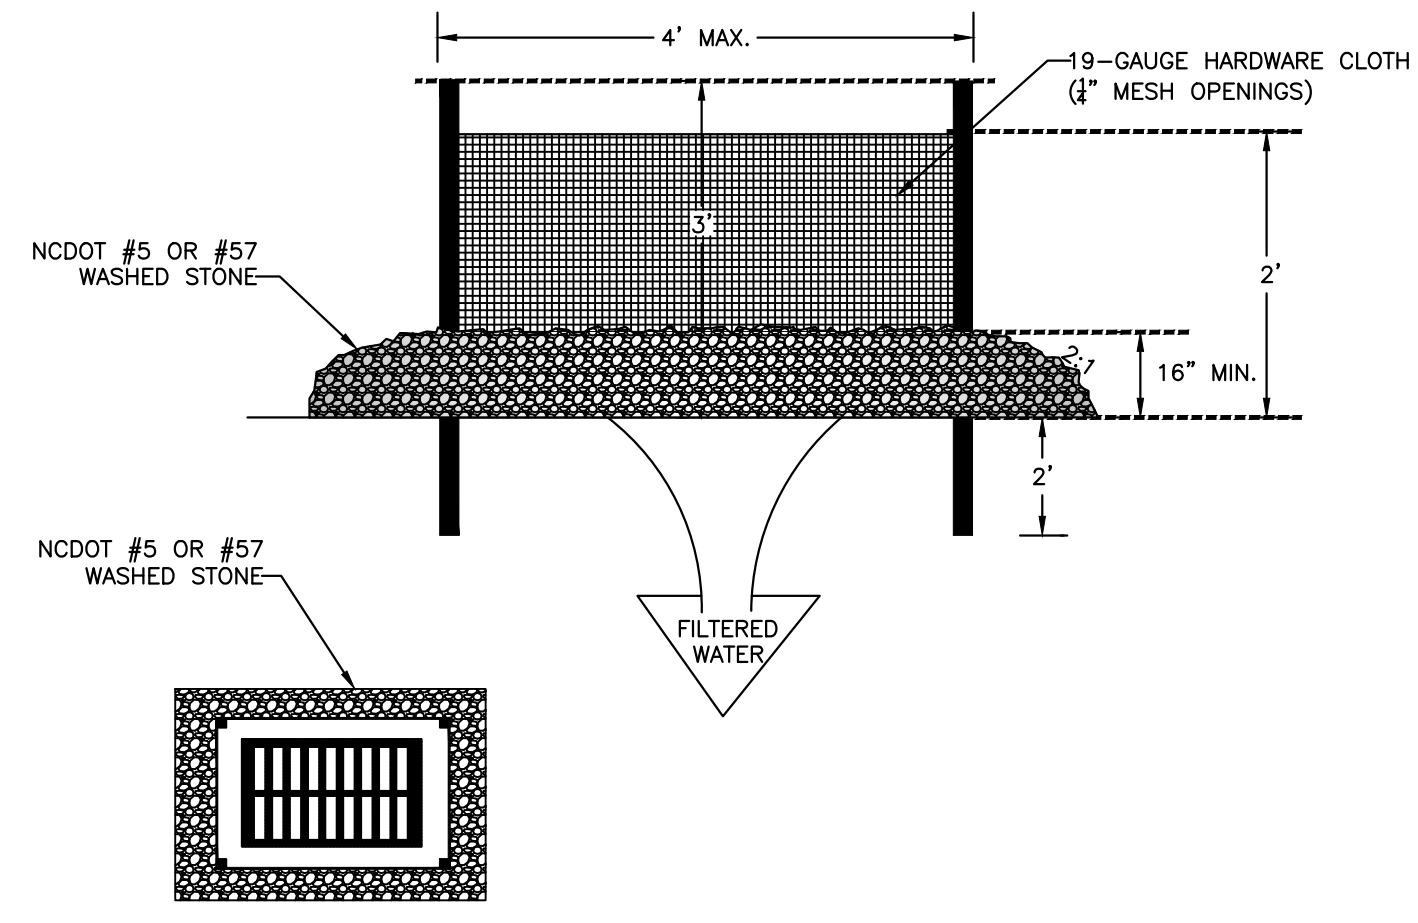

Hardware Cloth and Gravel Inlet Protection
SCALE: NOT TO SCALE

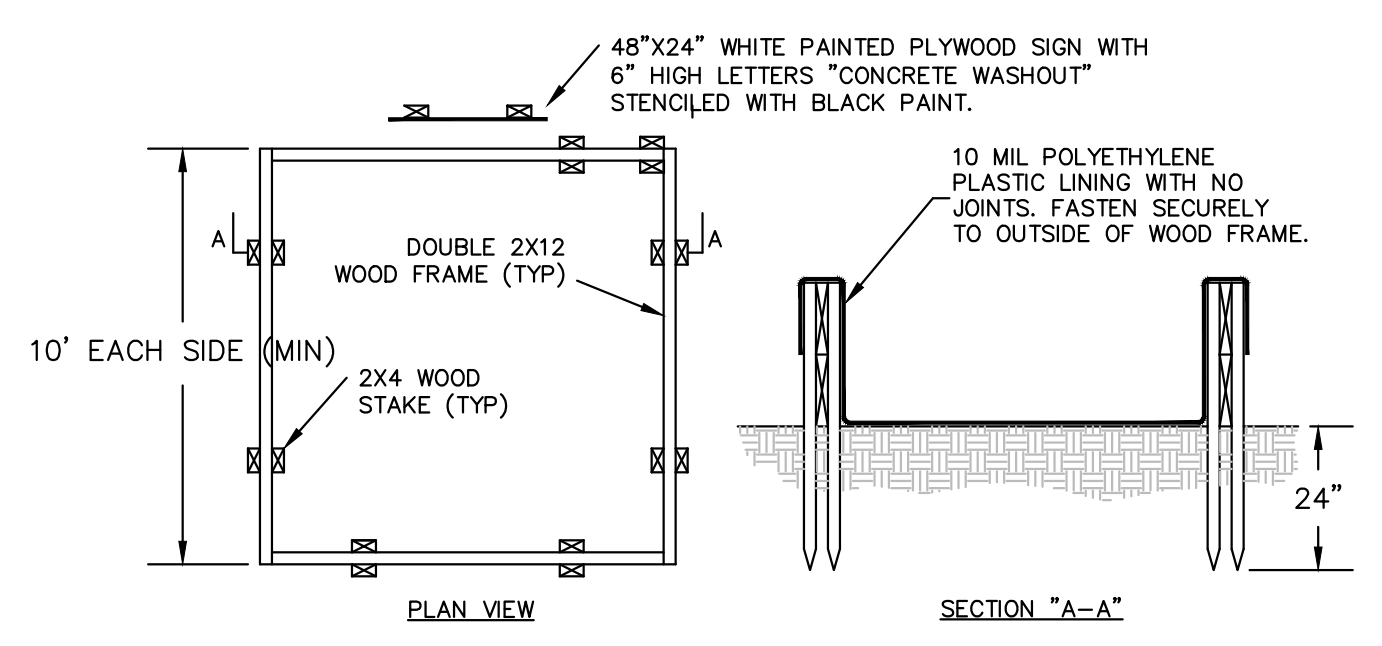

- NOTES:**
1. PREPARE GROUND & FRAME SUCH THAT SHARP OBJECTS/CORNERS DO NOT DAMAGE THE LINER. PROMPTLY REMOVE CONTENTS (AS NOTED BELOW) & REPLACE LINER IF LEAKAGE IS OBSERVED.
 2. LIQUID & CONCRETE DEBRIS SHALL BE REMOVED BY VACUUM TRUCK & LEGALLY DISPOSED UPON COMPLETION OF PROJECT OR ANYTIME WHEN LIQUID REACHES A LEVEL 8" BELOW THE TOP.

Concrete Washout Basin
SCALE: NOT TO SCALE

FOR LATE WINTER AND EARLY SPRING:

- SOIL AMENDMENTS:**
FOLLOW RECOMMENDATIONS OF SOIL TESTS OR APPLY 2,000 LB/ACRE GROUND AGRICULTURAL LIMESTONE AND 750 LB/ACRE 10-10-10 FERTILIZER
- MULCH:**
APPLY 4,000 LB/ACRE STRAW. ANCHOR STRAW BY TACKING WITH ASPHALT, NETTING, OR A MULCH ANCHORING TOOL. A DISK WITH BLADES SET NEARLY STRAIGHT CAN BE USED AS A MULCH ANCHORING TOOL.
- MAINTENANCE:**
REFERTILIZE IF GROWTH IS NOT FULLY ADEQUATE. RESEED, FERTILIZE AND MULCH IMMEDIATELY FOLLOWING EROSION OR OTHER DAMAGE

FOR SUMMER:


- SOIL AMENDMENTS:**
FOLLOW RECOMMENDATIONS OF SOIL TESTS OR APPLY 2,000 LB/ACRE GROUND AGRICULTURAL LIMESTONE AND 750 LB/ACRE 10-10-10 FERTILIZER
- MULCH:**
APPLY 4,000 LB/ACRE STRAW. ANCHOR STRAW BY TACKING WITH ASPHALT, NETTING, OR A MULCH ANCHORING TOOL. A DISK WITH BLADES SET NEARLY STRAIGHT CAN BE USED AS A MULCH ANCHORING TOOL.
- MAINTENANCE:**
REFERTILIZE IF GROWTH IS NOT FULLY ADEQUATE. RESEED, FERTILIZE AND MULCH IMMEDIATELY FOLLOWING EROSION OR OTHER DAMAGE

FOR FALL:


- SOIL AMENDMENTS:**
FOLLOW RECOMMENDATIONS OF SOIL TESTS OR APPLY 2,000 LB/ACRE GROUND AGRICULTURAL LIMESTONE AND 1,000 LB/ACRE 10-10-10 FERTILIZER
- MULCH:**
APPLY 4,000 LB/ACRE STRAW. ANCHOR STRAW BY TACKING WITH ASPHALT, NETTING, OR A MULCH ANCHORING TOOL. A DISK WITH BLADES SET NEARLY STRAIGHT CAN BE USED AS A MULCH ANCHORING TOOL.
- MAINTENANCE:**
REPAIR AND REFERTILIZE DAMAGED AREAS IMMEDIATELY. TOPDRESS WITH 50 LB/ACRE OF NITROGEN IN MARCH. IF IT IS NECESSARY TO EXTEND TEMPORARY COVER BEYOND JUNE 15, OVERSEED WITH 50 LB/ACRE KOBE LESPEDEZA IN LATE FEBRUARY OR EARLY MARCH.

FOR ADDITIONAL INFORMATION, REFER TO NCDENR EROSION AND SEDIMENT CONTROL PLANNING AND DESIGN MANUAL (ESCPDM), SECTION 6.10. FOR PERMANENT SEED BED PREP, SEASONAL OPERATIONS, INCLUDING SEED BED GRADATIONS OF FERTILIZERS, THE KINDS OF SEED, AND THE RATES OF APPLICATION OF LIMESTONE, FERTILIZER, AND SEED, REFER TO NCDENR ESCPDM SECTION 6.11.

Temporary Seeding Schedule
SCALE: NOT TO SCALE

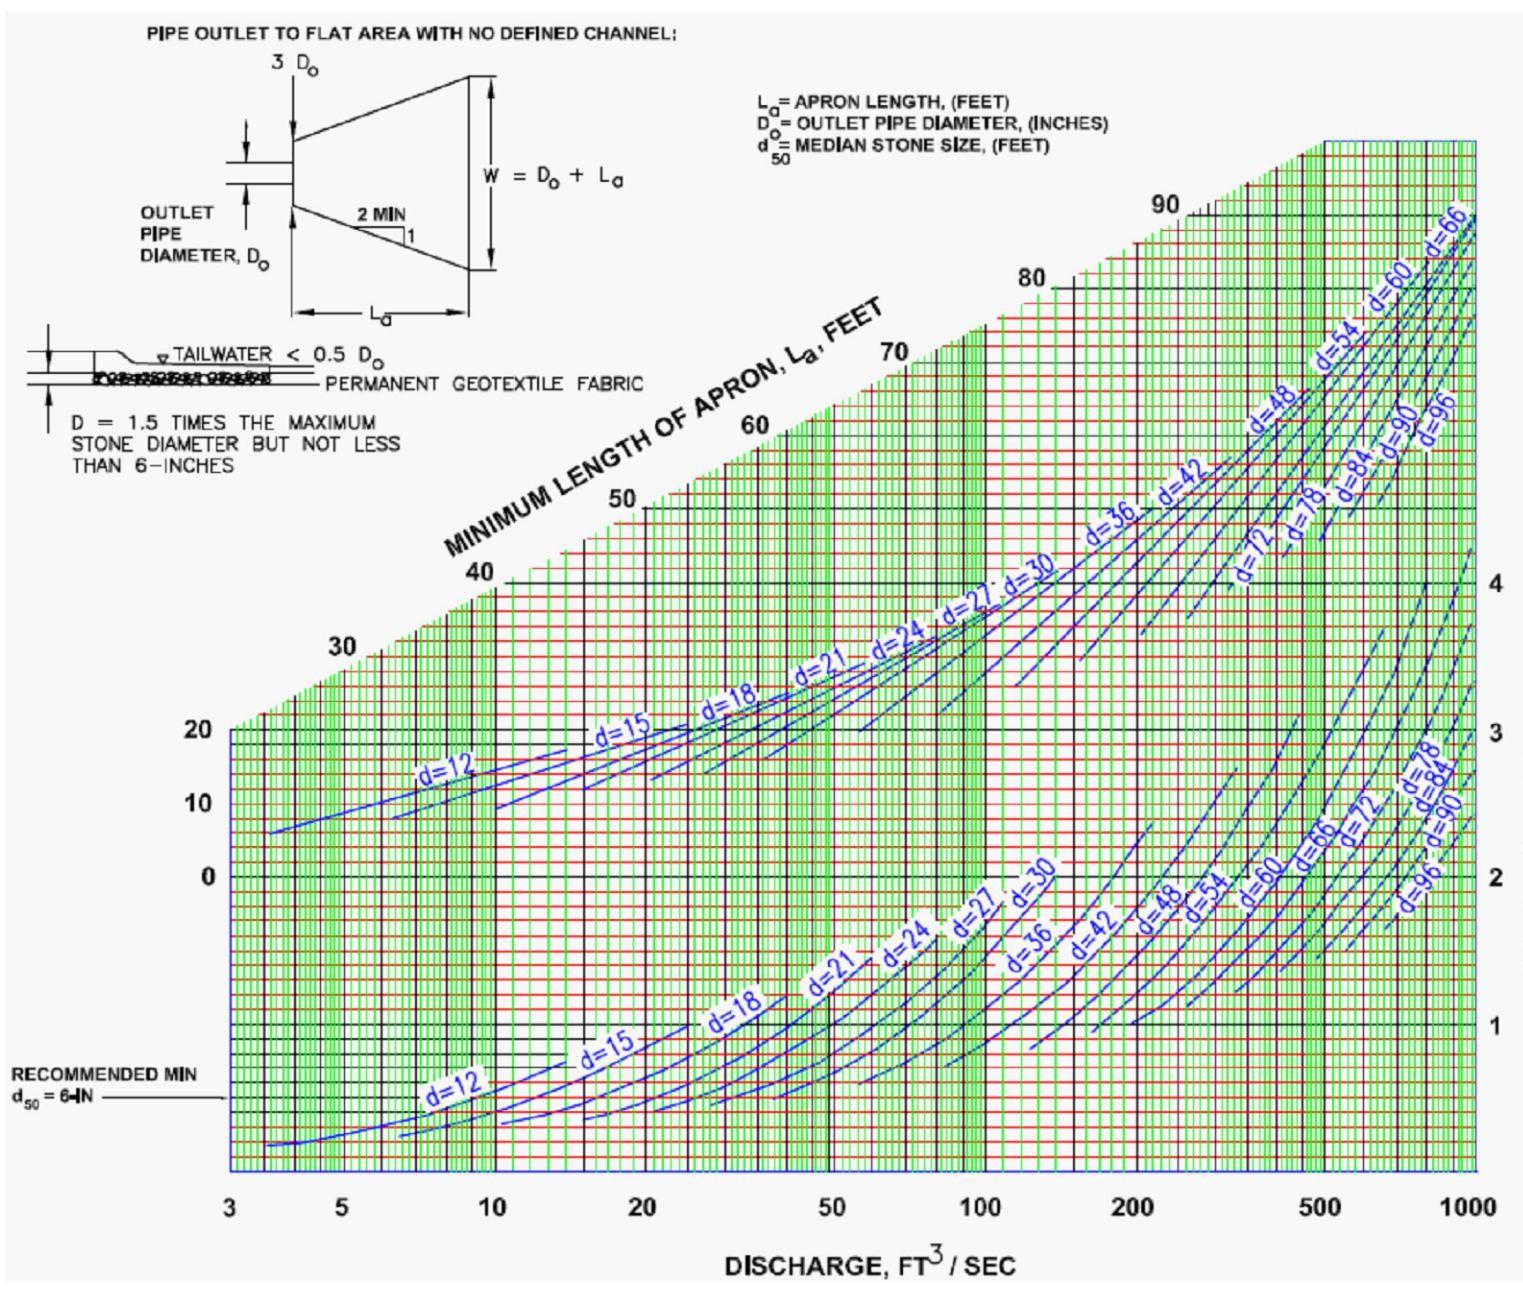


Pipe Outlet Riprap Protection with Calculations
SCALE: NOT TO SCALE

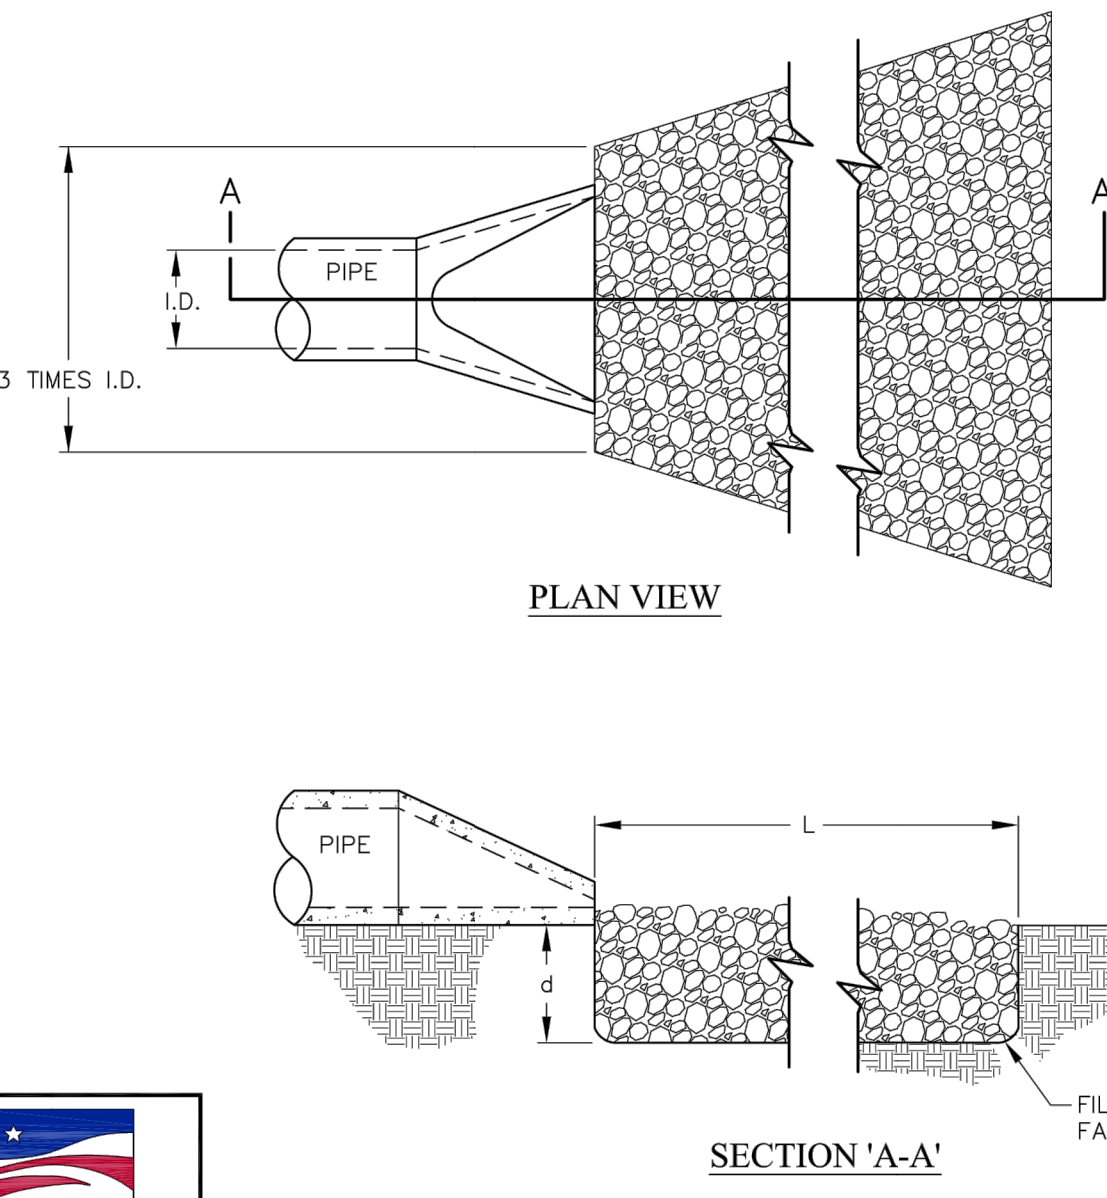

- NOTES:**
1. L = THE LENGTH OF THE RIPRAP APRON.
 2. d = 1.5 TIMES THE MAXIMUM STONE DIAMETER BUT NOT LESS THAN 6" (INCHES).
 3. A FILTER BLANKET OR FILTER FABRIC SHOULD BE INSTALLED BETWEEN THE RIPRAP AND SOIL FOUNDATION.
- MAINTENANCE NOTES:**
1. INSPECT RIPRAP OUTLET STRUCTURES WEEKLY AND AFTER SIGNIFICANT (1 INCH OR GREATER) RAINFALL EVENTS TO SEE IF ANY EROSION AROUND OR BELOW THE RIPRAP HAS TAKEN PLACE, OR IF STONES HAVE BEEN DISLODGED. IMMEDIATELY MAKE ALL NEEDED REPAIRS TO PREVENT FURTHER DAMAGE.


STANDARD PIPE OUTLET TO FLAT AREA NO WELL-DEFINED CHANNEL

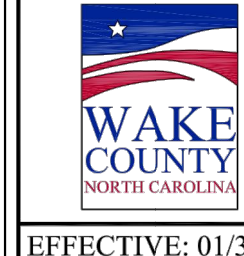

EFFECTIVE: 01/31/08



MOUNT PLEASANT, SC 843.884.1667
GREENVILLE, SC 864.298.0534
SUMMERVILLE, SC 843.972.0710
SPARTANBURG, SC 864.272.1272
CHARLOTTE, NC 980.312.5450
WWW.SEAMONWHITESIDE.COM

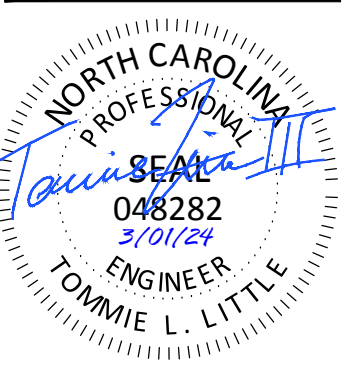

TIDAL WAVE AUTO SPA
ROLESVILLE, NC

SW+ PROJECT: 10772
DATE: 3/01/24
DRAWN BY: CPE
CHECKED BY: TLL

REVISION HISTORY

NO.	DESCRIPTION

EROSION CONTROL DETAILS

PART III SELF-INSPECTION, RECORDKEEPING AND REPORTING

SECTION A: SELF-INSPECTION

Self-inspections are required during normal business hours in accordance with the table below. When adverse weather or site conditions would cause the safety of the inspection personnel to be in jeopardy, the inspection may be delayed until the next business day on which it is safe to perform the inspection. In addition, when a storm event of equal to or greater than 1.0 inch occurs outside of normal business hours, the self-inspection shall be performed upon the commencement of the next business day. Any time when inspections were delayed shall be noted in the inspection Record.

Inspect	Frequency (during normal business hours)	Inspection records must include:
(1) Erosion control measures in good working order	Daily	Daily rainfall amounts. If no daily rain gauge observations are made during weekend or holiday periods, and no individual day rainfall information is available, record the cumulative rain measurements for those unattended days (and the well determine if a rain inspection is warranted). The permittee may use another rain-measuring device approved by the Division.
(2) E&S Measures	At least once per 7 calendar days and within 24 hours of a rain event ≥ 1.0 inch in 24 hours	1. Identification of the measures inspected. 2. Date and time of the inspection. 3. Name of the person performing the inspection. 4. Indication of whether the measures were operating properly. 5. Description of maintenance needs for the measures. 6. Description, evidence, and date of corrective actions taken.
(3) Stormwater discharge outfalls (SDO)	At least once per 7 calendar days and within 24 hours of a rain event ≥ 1.0 inch in 24 hours	1. Identification of the discharge outfalls inspected. 2. Date and time of the inspection. 3. Name of the person performing the inspection. 4. Evidence of indicators of stormwater pollutants such as oil, silt, debris, floating or suspended solids or discoloration. 5. Indication of visible sediment leaving the site. 6. Description, evidence, and date of corrective actions taken.
(4) Perimeter of site	At least once per 7 calendar days and within 24 hours of a rain event ≥ 1.0 inch in 24 hours	1. Identification of the perimeter of the site. 2. Description, evidence, and date of corrective actions taken, and 3. An evaluation as to the actions taken to control future releases.
(5) Streams or wetlands onsite or offsite (where applicable)	At least once per 7 calendar days and within 24 hours of a rain event ≥ 1.0 inch in 24 hours	If the stream or wetland has increased visible sedimentation or a stream has visible increased turbidity from the construction activity, then a record of the following shall be made: 1. Description, evidence and date of corrective actions taken, and 2. Records of the required reports to the appropriate Division Regional Office per Part III, Section C, Item 2)(3)(a) of this permit.
(6) Ground stabilization measures	After each phase of grading	1. The phase of grading/operation of perimeter E&S measures, clearing and grubbing, installation of storm drainage facilities, completion of all land-disturbing activity, construction or redevelopment, permanent ground cover. 2. Documentation that the required ground stabilization measures have been provided within the required timeframe or as soon as they will be provided as soon as possible.

NOTE: The rain inspection resets the required 7 calendar day inspection requirement.

PART III SELF-INSPECTION, RECORDKEEPING AND REPORTING

SECTION B: RECORDKEEPING

1. E&S Plan Documentation

The approved E&S plan as well as any approved deviation shall be kept on the site. The approved E&S plan must be kept up-to-date throughout the coverage under this permit. The following items pertaining to the E&S plan shall be kept on site and available for inspection at all times during normal business hours.

Item to Document	Documentation Requirements
(a) Each E&S measure has been installed and does not significantly deviate from the locations, dimensions and relative elevations shown on the approved E&S plan.	Initial and date each E&S measure on a copy of the approved E&S plan or complete, date and sign an inspection report that lists each E&S measure shown on the approved E&S plan. This documentation is required upon the initial installation of the E&S measures or if the E&S measures are modified after initial installation.
(b) A phase of grading has been completed.	Initial and date a copy of the approved E&S plan or complete, date and sign an inspection report to indicate completion of the construction phase.
(c) Ground cover is located and installed in accordance with the approved E&S plan.	Initial and date a copy of the approved E&S plan or complete, date and sign an inspection report to indicate compliance with approved ground cover specifications.
(d) The maintenance and repair requirements for all E&S measures have been performed.	Complete, date and sign an inspection report.
(e) Corrective actions have been taken to E&S measures.	Initial and date a copy of the approved E&S plan or complete, date and sign an inspection report to indicate the completion of the corrective action.

2. Additional Documentation to be Kept on Site

In addition to the E&S plan documents above, the following items shall be kept on the site and available for inspectors at all times during normal business hours, unless the Division provides a site-specific exemption based on unique site conditions that make this requirement not practical.

(a) This General Permit as well as the Certificate of Coverage, after it is received.

(b) Records of inspections made during the previous twelve months. The permittee shall record the required observations on the Inspection Record Form provided by the Division or a similar inspection form that includes all the required elements. Use of electronically-available records in lieu of the required paper copies will be allowed if shown to provide equal access and utility as the hard-copy records.

3. Documentation to be Retained for Three Years

All data used to complete the E&S and all inspection records shall be maintained for a period of three years after project completion and made available upon request. (40 CFR 122.41)

PART III SELF-INSPECTION, RECORDKEEPING AND REPORTING

SECTION C: REPORTING

1. Occurrences that Must be Reported

Permittees shall report the following occurrences:

- Visible sediment deposition in a stream or wetland.
- Oil spills if:
 - They are 25 gallons or more,
 - They are less than 25 gallons but cannot be cleaned up within 24 hours,
 - They cause sheen on surface waters (regardless of volume), or
 - They are within 100 feet of surface waters (regardless of volume).
- Releases of hazardous substances in excess of reportable quantities under Section 313 of the Clean Water Act (Ref: 40 CFR 110.3 and 40 CFR 117.3) or Section 102 of CERCLA (Ref: 40 CFR 302.4) or G.S. 148-215.85.
- Anticipated bypasses and unanticipated bypasses.
- Noncompliance with the conditions of this permit that may endanger health or the environment.

2. Reporting Timeframes and Other Requirements

After a permittee becomes aware of an occurrence that must be reported, he shall contact the appropriate Division regional office within the timeframes and in accordance with the other requirements listed below. Occurrences outside normal business hours may also be reported to the Department's Environmental Emergency Center personnel at (800) 856-0368.

Occurrence	Reporting Timeframes (After Discovery) and Other Requirements
(a) Visible sediment deposition in a stream or wetland	<ul style="list-style-type: none"> Within 24 hours, an oral or electronic notification. Within 7 calendar days, a report that contains a description of the sediment and actions taken to address the cause of the deposition. Division staff may waive the requirement for a written report on a case-by-case basis. If the stream is named on the NC 303(d) list, as impaired for sediment-related causes, the permittee may be required to perform additional monitoring, inspections or apply more stringent practices if staff determine that additional requirements are needed to assure compliance with the Federal or state impaired-waters conditions.
(b) Oil spills and release of hazardous substances per Item 1)(b)-(c) above	<ul style="list-style-type: none"> Within 24 hours, an oral or electronic notification. The notification shall include information about the date, time, nature, volume and location of the spill or release. A report at least ten days before the date of the bypass, if possible. The report shall include an evaluation of the anticipated quality and effect of the bypass.
(c) Anticipated bypasses (40 CFR 122.41(m)(7))	<ul style="list-style-type: none"> Within 24 hours, an oral or electronic notification. Within 7 calendar days, a report that includes an evaluation of the quality and effect of the bypass.
(d) Unanticipated bypasses (40 CFR 122.41(m)(8))	<ul style="list-style-type: none"> Within 24 hours, an oral or electronic notification. Within 7 calendar days, a report that contains a description of the noncompliance, and its cause, the period of noncompliance, including exact dates and times, and if the noncompliance has not been corrected, the anticipated time noncompliance is expected to continue, and steps taken or planned to reduce, eliminate, and prevent recurrence of the noncompliance. (40 CFR 122.41(m)(8)). Division staff may waive the requirement for a written report on a case-by-case basis.

PART II, SECTION 6, ITEM (4) DRAW DOWN OF SEDIMENT BASINS FOR MAINTENANCE OR CLOSE OUT

Sediment basins and traps that receive runoff from drainage areas of one acre or more shall use outlet structures that withdraw water from the surface when these devices need to be drawn down for maintenance or close out unless this is infeasible. The circumstances in which it is not feasible to withdraw water from the surface shall be rare (for example, times with extended cold weather). Non-surface withdrawals from sediment basins shall be allowed only when all of the following criteria have been met:

- The E&S plan authority has been provided with documentation of the non-surface withdrawal and the specific time periods or conditions in which it will occur. The non-surface withdrawal shall not commence until the E&S plan authority has approved these items.
- Non-surface withdrawal has been reported as an anticipated bypass in accordance with Part III, Section C, Item 2)(c) and (d) of this permit.
- Dewatering discharges are treated with controls to minimize discharges of pollutants from stormwater that is removed from the sediment basin. Examples of appropriate controls include properly sized, designed and maintained dewatering tanks, weir tanks, and filtration systems.
- Vegetated, upland areas of the sites or a properly designed stone pad is used to the extent feasible at the outlet of the dewatering treatment devices described in Item (c) above.
- Velocity dissipation devices such as check dams, sediment traps, and riprap are provided at the discharge points of all dewatering devices.
- Sediment removed from the dewatering treatment devices described in Item (c) above is disposed of in a manner that does not cause deposition of sediment into waters of the United States.

GROUND STABILIZATION AND MATERIALS HANDLING PRACTICES FOR COMPLIANCE WITH THE NCG01 CONSTRUCTION GENERAL PERMIT

Implementing the details and specifications on this plan sheet will result in the construction activity being considered compliant with the Ground Stabilization and Materials Handling sections of the NCG01 Construction General Permit (Sections E and F, respectively). The permittee shall comply with the Erosion and Sediment Control plan approved by the delegated authority having jurisdiction. All details and specifications shown on this sheet may not apply depending on site conditions and the delegated authority having jurisdiction.

SECTION E: GROUND STABILIZATION

Site Area Description	Stabilize within this many calendar days after ceasing land disturbance	Timeframe variations
(a) Perimeter dikes, swales, ditches, and perimeter slopes	7	None
(b) High Quality Water (HQW) Zones	7	None
(c) Slopes steeper than 3:1	7	If slopes are 10' or less in length and are not steeper than 2:1, 14 days are allowed. -7 days for slopes greater than 50' in length and with slopes steeper than 4:1 -7 days for perimeter dikes, swales, ditches, perimeter slopes and HQW Zones -10 days for Falls Lake Watershed
(d) Slopes 3:1 to 4:1	14	
(e) Areas with slopes flatter than 4:1	14	

NOTE: After the permanent cessation of construction activities, any areas with temporary ground stabilization shall be converted to permanent ground stabilization as soon as practicable but in no case longer than 90 calendar days after the last land disturbing activity. Temporary ground stabilization shall be maintained in a manner to render the surface stable against accelerated erosion until permanent ground stabilization is achieved.

GROUND STABILIZATION SPECIFICATION

Stabilize the ground sufficiently so that rain will not dislodge the soil. Use one of the techniques in the table below:

Temporary Stabilization	Permanent Stabilization
<ul style="list-style-type: none"> Temporary grass seed covered with straw or other mulches and tackifiers Hydroseeding Roller erosion control products with or without temporary grass seed Appropriately applied straw or other mulch Plastic sheeting 	<ul style="list-style-type: none"> Permanent grass seed covered with straw or other mulches and tackifiers Geotextile fabrics such as permanent soil reinforcement matting Hydroseeding Shrubs or other permanent plantings covered with mulch Uniform and evenly distributed ground cover sufficient to restrain erosion Structural methods such as concrete, asphalt or retaining walls Roller erosion control products with grass seed

POLYACRYLAMIDES (PAMS) AND FLOCCULANTS

- Select flocculants that are appropriate for the soils being exposed during construction, selecting from the NC DWR List of Approved PAMS/Flocculants.
- Apply flocculants at or before the inlets to Erosion and Sediment Control Measures.
- Apply flocculants at the concentrations specified in the NC DWR List of Approved PAMS/Flocculants and in accordance with the manufacturer's instructions.
- Provide ponding area for containment of treated Stormwater before discharging offsite.
- Store flocculants in leak-proof containers that are kept under storm-resistant cover or surrounded by secondary containment structures.

NCG01 SELF-INSPECTION, RECORDKEEPING AND REPORTING **EFFECTIVE: 04/01/19**

EQUIPMENT AND VEHICLE MAINTENANCE

- Maintain vehicles and equipment to prevent discharge of fluids.
- Provide drip pans under any stored equipment.
- Identify leaks and repair as soon as feasible, or remove leaking equipment from the project.
- Collect all spent fluids, store in separate containers and properly dispose as hazardous waste (recycle when possible).
- Remove leaking vehicles and construction equipment from service until the problem has been corrected.
- Bring used fuels, lubricants, coolants, hydraulic fluids and other petroleum products to a recycling or disposal center that handles these materials.

LITTER, BUILDING MATERIAL AND LAND CLEARING WASTE

- Never bury or burn waste. Place litter and debris in approved waste containers.
- Provide a sufficient number and size of waste containers (e.g. dumpster, trash receptacle) on site to contain construction and domestic wastes.
- Locate waste containers at least 50 feet away from storm drain inlets and surface waters unless no other alternatives are reasonably available.
- Locate waste containers on areas that do not receive substantial amounts of runoff from upland areas and does not drain directly to a storm drain, stream or wetland.
- Cover waste containers at the end of each workday and before storm events or provide secondary containment. Repair or replace damaged waste containers.
- Anchor all lightweight items in waste containers during times of high winds.
- Empty waste containers as needed to prevent overflow. Clean up immediately if containers overflow.
- Dispose waste off-site at an approved disposal facility.
- On business days, clean up and dispose of waste in designated waste containers.

PAINT AND OTHER LIQUID WASTE

- Do not dump paint and other liquid waste into storm drains, streams or wetlands.
- Locate paint washouts at least 50 feet away from storm drain inlets and surface waters unless no other alternatives are reasonably available.
- Contain liquid wastes in a controlled area.
- Containment must be labeled, sized and placed appropriately for the needs of site.
- Prevent the discharge of soaps, solvents, detergents and other liquid wastes from construction sites.

PORTABLE TOILETS

- Install portable toilets on level ground, at least 50 feet away from storm drains, streams or wetlands unless there is no alternative reasonably available. If 50 foot offset is not attainable, provide relocation of portable toilet behind silt fence or place on a gravel pad and surround with sand bags.
- Provide staking or anchoring of portable toilets during periods of high winds or in high foot traffic areas.
- Monitor portable toilets for leaking and properly dispose of any leaked material. Utilize a licensed sanitary waste hauler to remove leaking portable toilets and replace with properly operating unit.

EARTHEN STOCKPILE MANAGEMENT

- Show stockpile locations on plans. Locate earthen-material stockpile areas at least 50 feet away from storm drain inlets, sediment basins, perimeter sediment controls and surface waters unless it can be shown other alternatives are reasonably available.
- Protect stockpile with silt fence installed along toe of slope with a minimum offset of five feet from the toe of stockpile.
- Provide stable stone access point when feasible.
- Stabilize stockpile within the timeframes provided on this sheet and in accordance with the approved plan and any additional requirements. Soil stabilization is defined as vegetative, physical or chemical coverage techniques that will restrain accelerated erosion on disturbed soils for temporary or permanent control needs.

HAZARDOUS AND TOXIC WASTE

- Create designated hazardous waste collection areas on-site.
- Place hazardous waste containers under cover or in secondary containment.
- Do not store hazardous chemicals, drums or bagged materials directly on the ground.

CONCRETE WASHOUTS

- Do not discharge concrete or cement slurry from the site.
- Dispose of, or recycle steel, hardened concrete residue in accordance with local and state solid waste regulations and at an approved facility.
- Manage washout from mortar mixers in accordance with the above item and in addition place the mixer and associated materials on impervious barrier and within lot perimeter silt fence.
- Install temporary concrete washouts per local requirements, where applicable. If an alternate method or product is to be used, contact your approval authority for review and approval. If local standard details are not available, use one of the two types of temporary concrete washouts provided on this detail.
- Do not use concrete washouts for dewatering or storing defective curb or sidewalk sections. Stormwater accumulated within the washout may not be pumped into or discharged to the storm drain system or receiving surface waters. Liquid waste must be pumped out and removed from project.
- Locate washouts at least 50 feet from storm drain inlets and surface waters unless it can be shown that no other alternatives are reasonably available. At a minimum, install protection of storm drain inlet(s) closest to the washout which could receive spills or overflow.
- Locate washouts in an easily accessible area, on level ground and install a stone entrance pad in front of the washout. Additional controls may be required by the approving authority.
- Install at least one sign directing concrete trucks to the washout within the project limits. Post signage on the washout itself to identify this location.
- Remove loadings from the washout when at approximately 75% capacity to limit overflow events. Replace the tarp, sand bags or other temporary structural components when no longer functional. When utilizing alternative or proprietary products, follow manufacturer's instructions.
- At the completion of the concrete work, remove remaining loadings and dispose of in an approved disposal facility. Fill pit, if applicable, and stabilize any disturbance caused by removal of washout.

HERBICIDES, PESTICIDES AND RODENTICIDES

- Store and apply herbicides, pesticides and rodenticides in accordance with label restrictions.
- Store herbicides, pesticides and rodenticides in their original containers with the label, which lists directions for use, ingredients and first aid steps in case of accidental poisoning.
- Do not store herbicides, pesticides and rodenticides in areas where flooding is possible or where they may spill or leak into wells, stormwater drains, ground water or surface water. If a spill occurs, clean area immediately.
- Do not stockpile these materials onsite.

CONCRETE WASHOUT STRUCTURE WITH LINER

CONCRETE WASHOUT STRUCTURE

NCG01 GROUND STABILIZATION AND MATERIALS HANDLING **EFFECTIVE: 04/01/19**

501 WINDO PARK BOULEVARD, SUITE 200 | MOUNT PLEASANT, SC 29566 | JUDSON MILLS BUILDING, 6000 TOY EASLEY BROCK RD, SUITE 600 | GREENVILLE, SC 29611 | 230 PETERSON DR. | CHARLOTTE, NC 28217 | 701 N. CEDAR STREET | SUMMERVILLE, SC 29585 | THESE DRAWINGS SHALL NOT BE REPRODUCED IN ANY MANNER WITHOUT WRITTEN PERMISSION FROM SEAMON WHITESIDE & ASSOCIATES, INC.

SEAMON WHITESIDE

MOUNT PLEASANT, SC 29566
843.884.1667

GREENVILLE, SC 29611
864.298.0534

SUMMERVILLE, SC 29585
843.972.0710

SPARTANBURG, SC 29176
864.272.1272

CHARLOTTE, NC 28203
980.312.5450

WWW.SEAMONWHITESIDE.COM

SEAMON WHITESIDE & ASSOCIATES, INC.

NO. C-2466

CERTIFICATE OF AUTHORITY

PROFESSIONAL SEAL

048282

2/01/24

ENGINEER

JOYDIE L. LITTLE

TIDAL WAVE AUTO SPA


ROLESVILLE, NC

SW+ PROJECT: 10772
DATE: 3/01/24
DRAWN BY: CPE
CHECKED BY: TLL

REVISION HISTORY

NO.	DESCRIPTION

EROSION CONTROL DETAILS

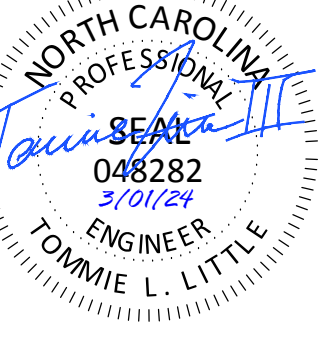

TIDAL WAVE AUTO SPA
ROLESVILLE, NC

SW+ PROJECT: 10772
DATE: 3/01/24
DRAWN BY: CPE
CHECKED BY: TLL

REVISION HISTORY	

SITE PLAN

C5.1

SITE INFORMATION:

ADDRESS: ROLESVILLE, NC
PROPERTY AREA: 1.92 ACRES
PARCEL: 1758479244
EXISTING USE: UNDEVELOPED
PROPOSED USE: CAR WASH

PROPERTY ZONING: GI-CZ (GENERAL INDUSTRIAL - CONDITIONAL ZONING)

BUILDING SETBACKS:

FRONT (SE):	30'
CORNER (NE):	25'
REAR (NW):	35'
SIDE (SW):	15'

PERIMETER LANDSCAPE YARDS:
NORTHEAST: 15'

REQUIRED OPEN SPACE (5%) = 0.01 AC (4182 SF)

PRE VS. POST DEVELOPMENT AREA:

SITE AREA:	1.92 AC
PRE-IMPERVIOUS AREA:	0.04 AC (2.08%)
POST-IMPERVIOUS AREA:	1.30 AC (67.7%)

PARKING NOTE:

PARKING REQUIRED:
1 SPACE PER 400 SF GFA OR 5 SPACES MINIMUM = 5 SPACES


PARKING PROVIDED:

EMPLOYEE SPACES: (4 MAX ON SHIFT)	5 SPACES
VACUUM STALLS:	26 STALLS (1 ADA)
ADA PARKING:	2 SPACES
TOTAL PARKING:	33 SPACES

BIKE PARKING:
REQUIRED: 1 SPACE (1 SPACE PER 5000 SF GFA)
PROVIDED: 4 SPACES

SITE LAYOUT AND STAKING NOTES:

- CONTRACTOR SHALL CAREFULLY EXAMINE ALL DOCUMENTS AND THE CONSTRUCTION SITE TO OBTAIN FIRST HAND KNOWLEDGE OF EXISTING CONDITIONS.
- ENTIRE SITE SHALL BE DRESSED TO UNIFORM, WELL DRAINED AND VISUALLY APPEALING SURFACE WITH A MINIMUM TOPSOIL LAYER OF FOUR INCHES.
- ALL STRIPING AND SIGNS SHALL CONFORM WITH THE NORTH CAROLINA DEPARTMENT OF TRANSPORTATION AND THE MANUAL ON UNIFORM TRAFFIC CONTROL DEVICES LATEST EDITION. PARKING STALL STRIPING TO BE WHITE WITH BLUE HANDICAPPED STRIPING.
- ALL HANDICAP PARKING SPACED AND ACCESSIBLE ROUTE SHALL CONFORM WITH THE AMERICAN WITH DISABILITY ACT DESIGN GUIDELINES AND SPECIFICATIONS LATEST EDITION.
- DIMENSIONS AND CURVE RADII ARE GIVEN TO FACE OF CURB. WHERE CURB AND GUTTER IS SHOWN, OTHERWISE DIMENSIONS ARE GIVEN TO THE EDGE OF PAVEMENT. CONTRACTOR IS TO COORDINATE WITH THE ARCHITECTURAL PLANS AS TO THE BUILDING LAYOUT AND DIMENSIONS.

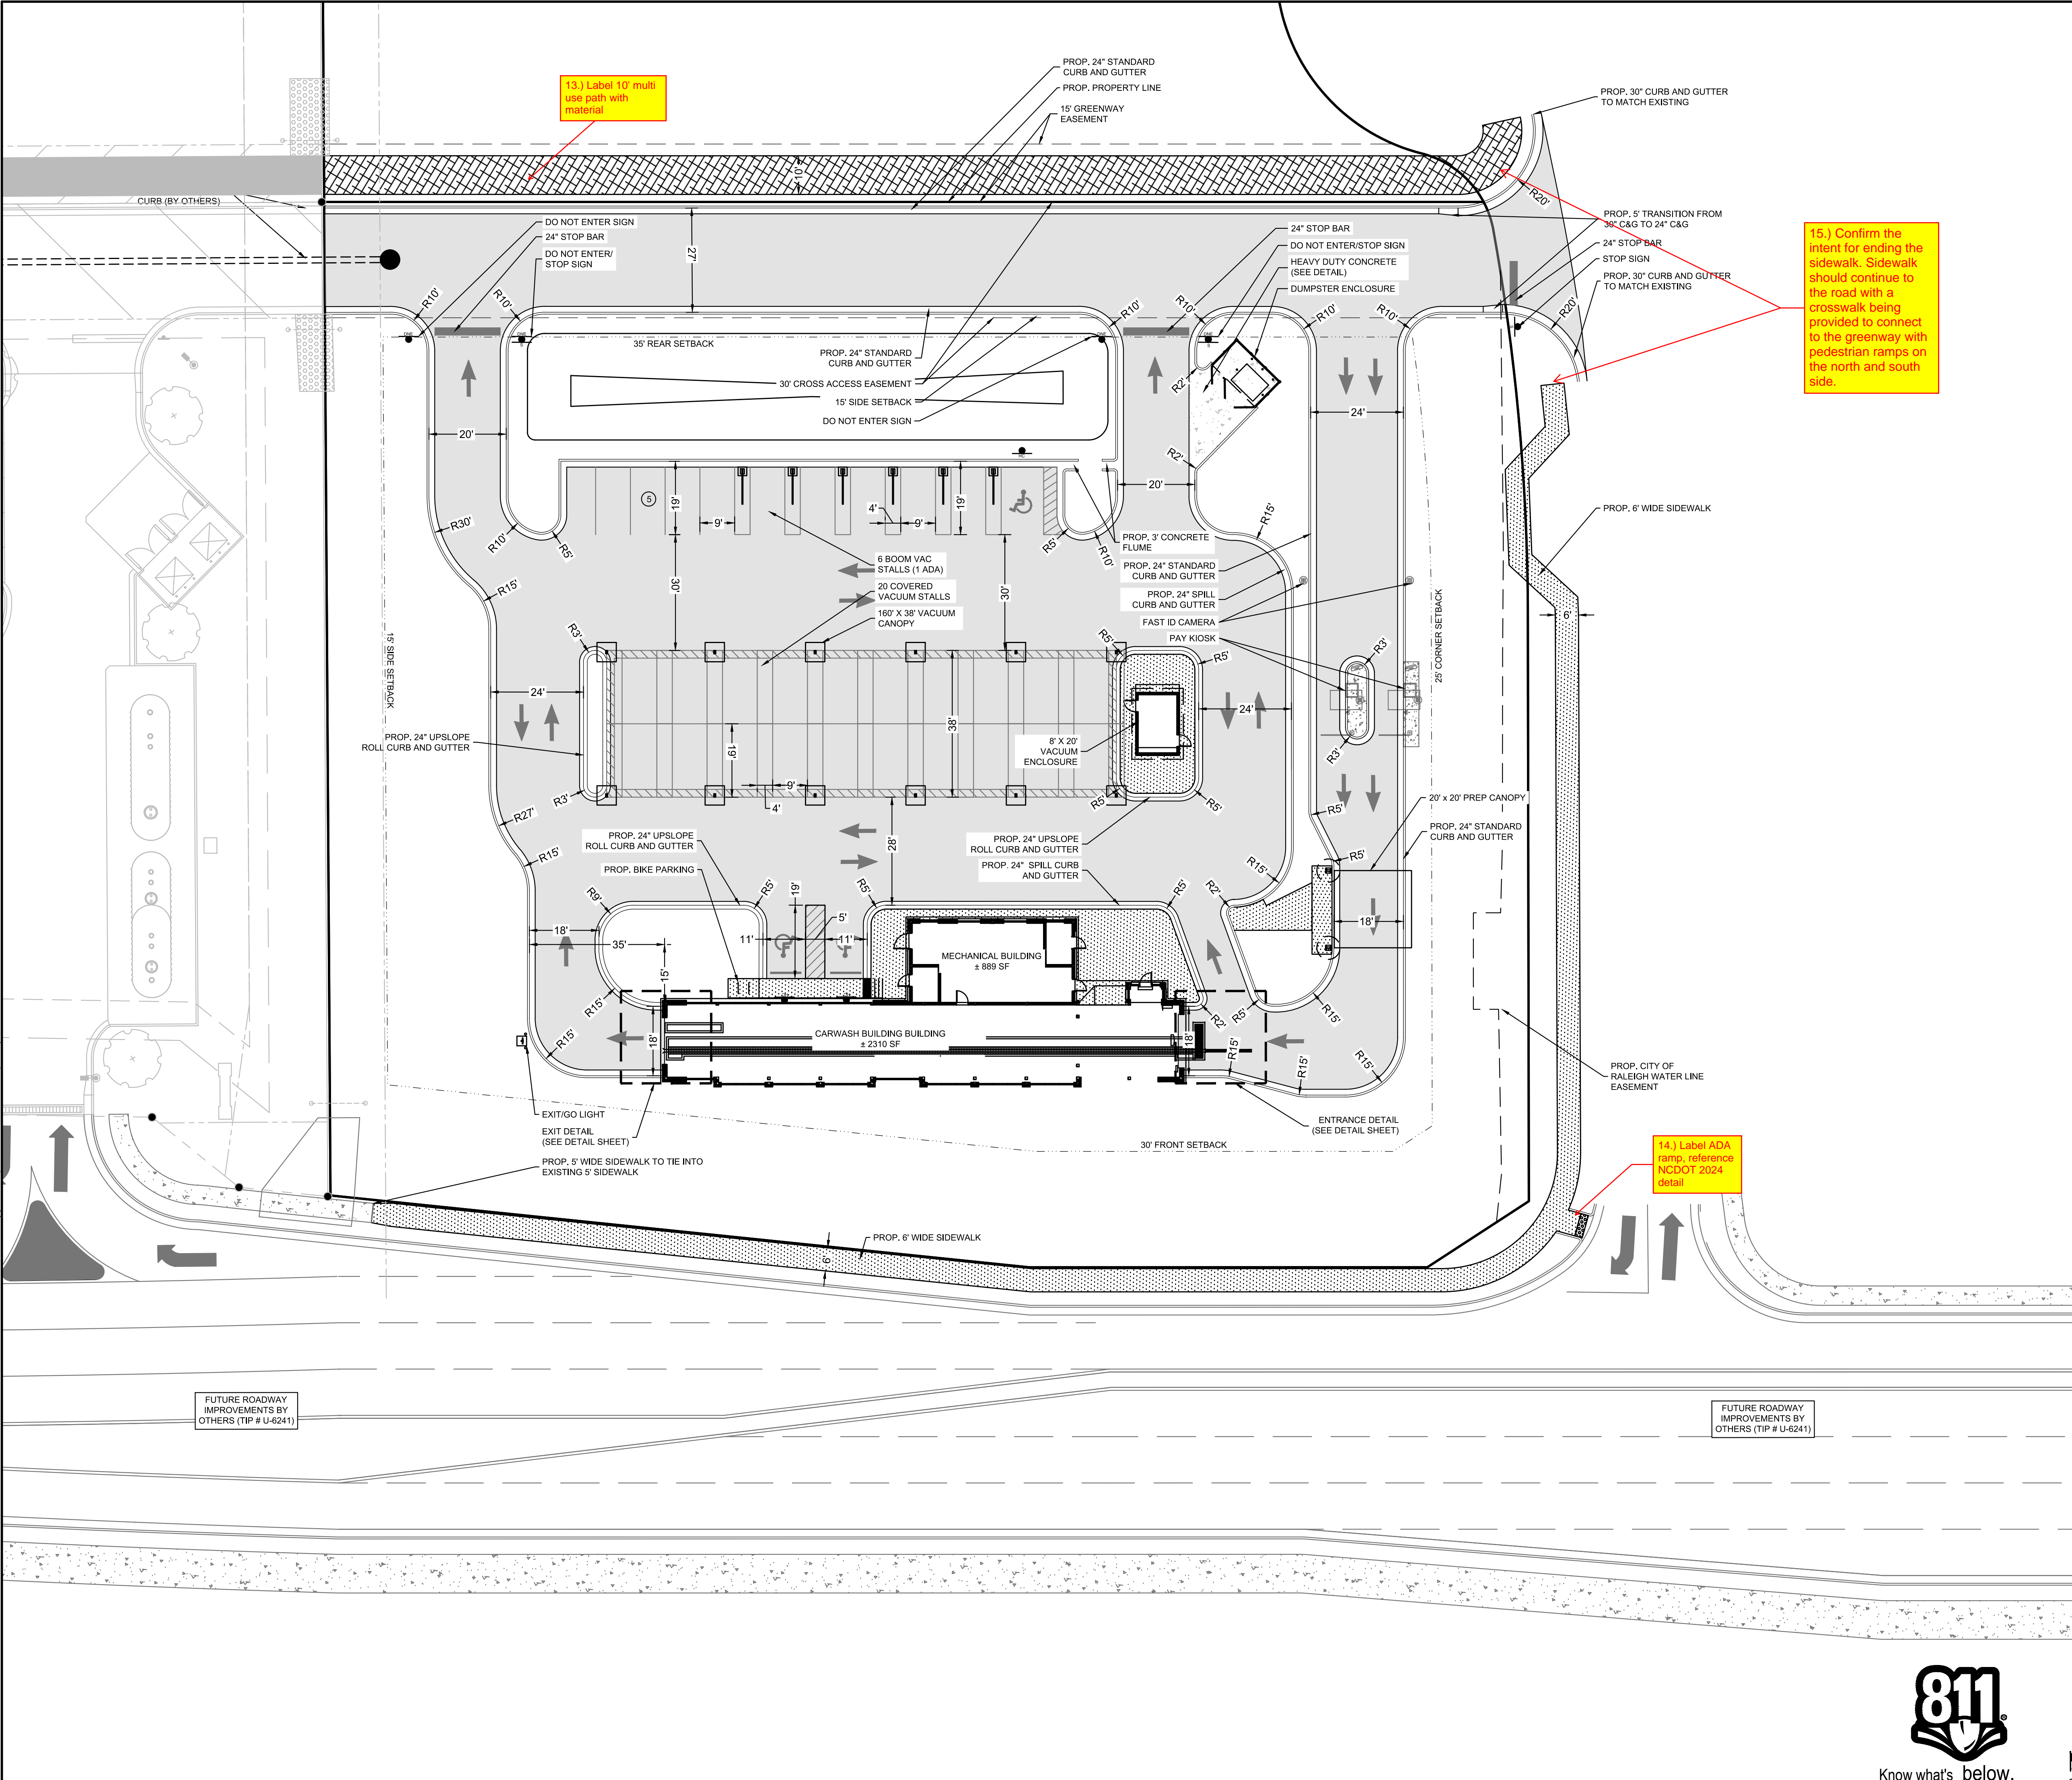


13.) Label 10' multi use path with material

15.) Confirm the intent for ending the sidewalk. Sidewalk should continue to the road with a crosswalk being provided to connect to the greenway with pedestrian ramps on the north and south side.

14.) Label ADA ramp, reference NCDOT 2024 detail


SITE LEGEND

	PROPOSED SIDEWALK
	HEAVY DUTY CONCRETE PAVEMENT
	STANDARD DUTY CONCRETE PAVEMENT
	ASPHALT GREENWAY
	STOP SIGN
	DO NOT ENTER SIGN
	HANDICAP PARKING SIGN

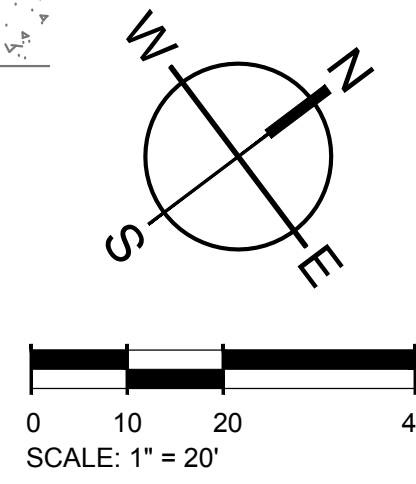

501 WINDO PARK BOULEVARD, SUITE 200 | MOUNT PLEASANT, SC 29546 | 104 N. DANIEL MORGAN AVENUE, SUITE 300 | SPARTANBURG, SC 29301

501 WINDO PARK BOULEVARD, SUITE 200 | MOUNT PLEASANT, SC 29564 | JUDSON MILLS BUILDING 6000, 701 EASLEY BROOK RD, SUITE 6000, GREENVILLE, SC 29611 | 230 PETERSBURG | CHARLOTTE, NC 28217 | 720 N. CEDAR STREET | SUMMERVILLE, SC 29586 | 104 N. DANIEL MCGRAW AVENUE, SUITE 300 | SPARTANBURG, SC 29301
 COPYRIGHT © SEAMON WHITESIDE & ASSOCIATES, INC. | THIS DRAWING SHALL NOT BE REPRODUCED IN ANY MANNER OR USED FOR ANY PURPOSE WITHOUT WRITTEN PERMISSION.

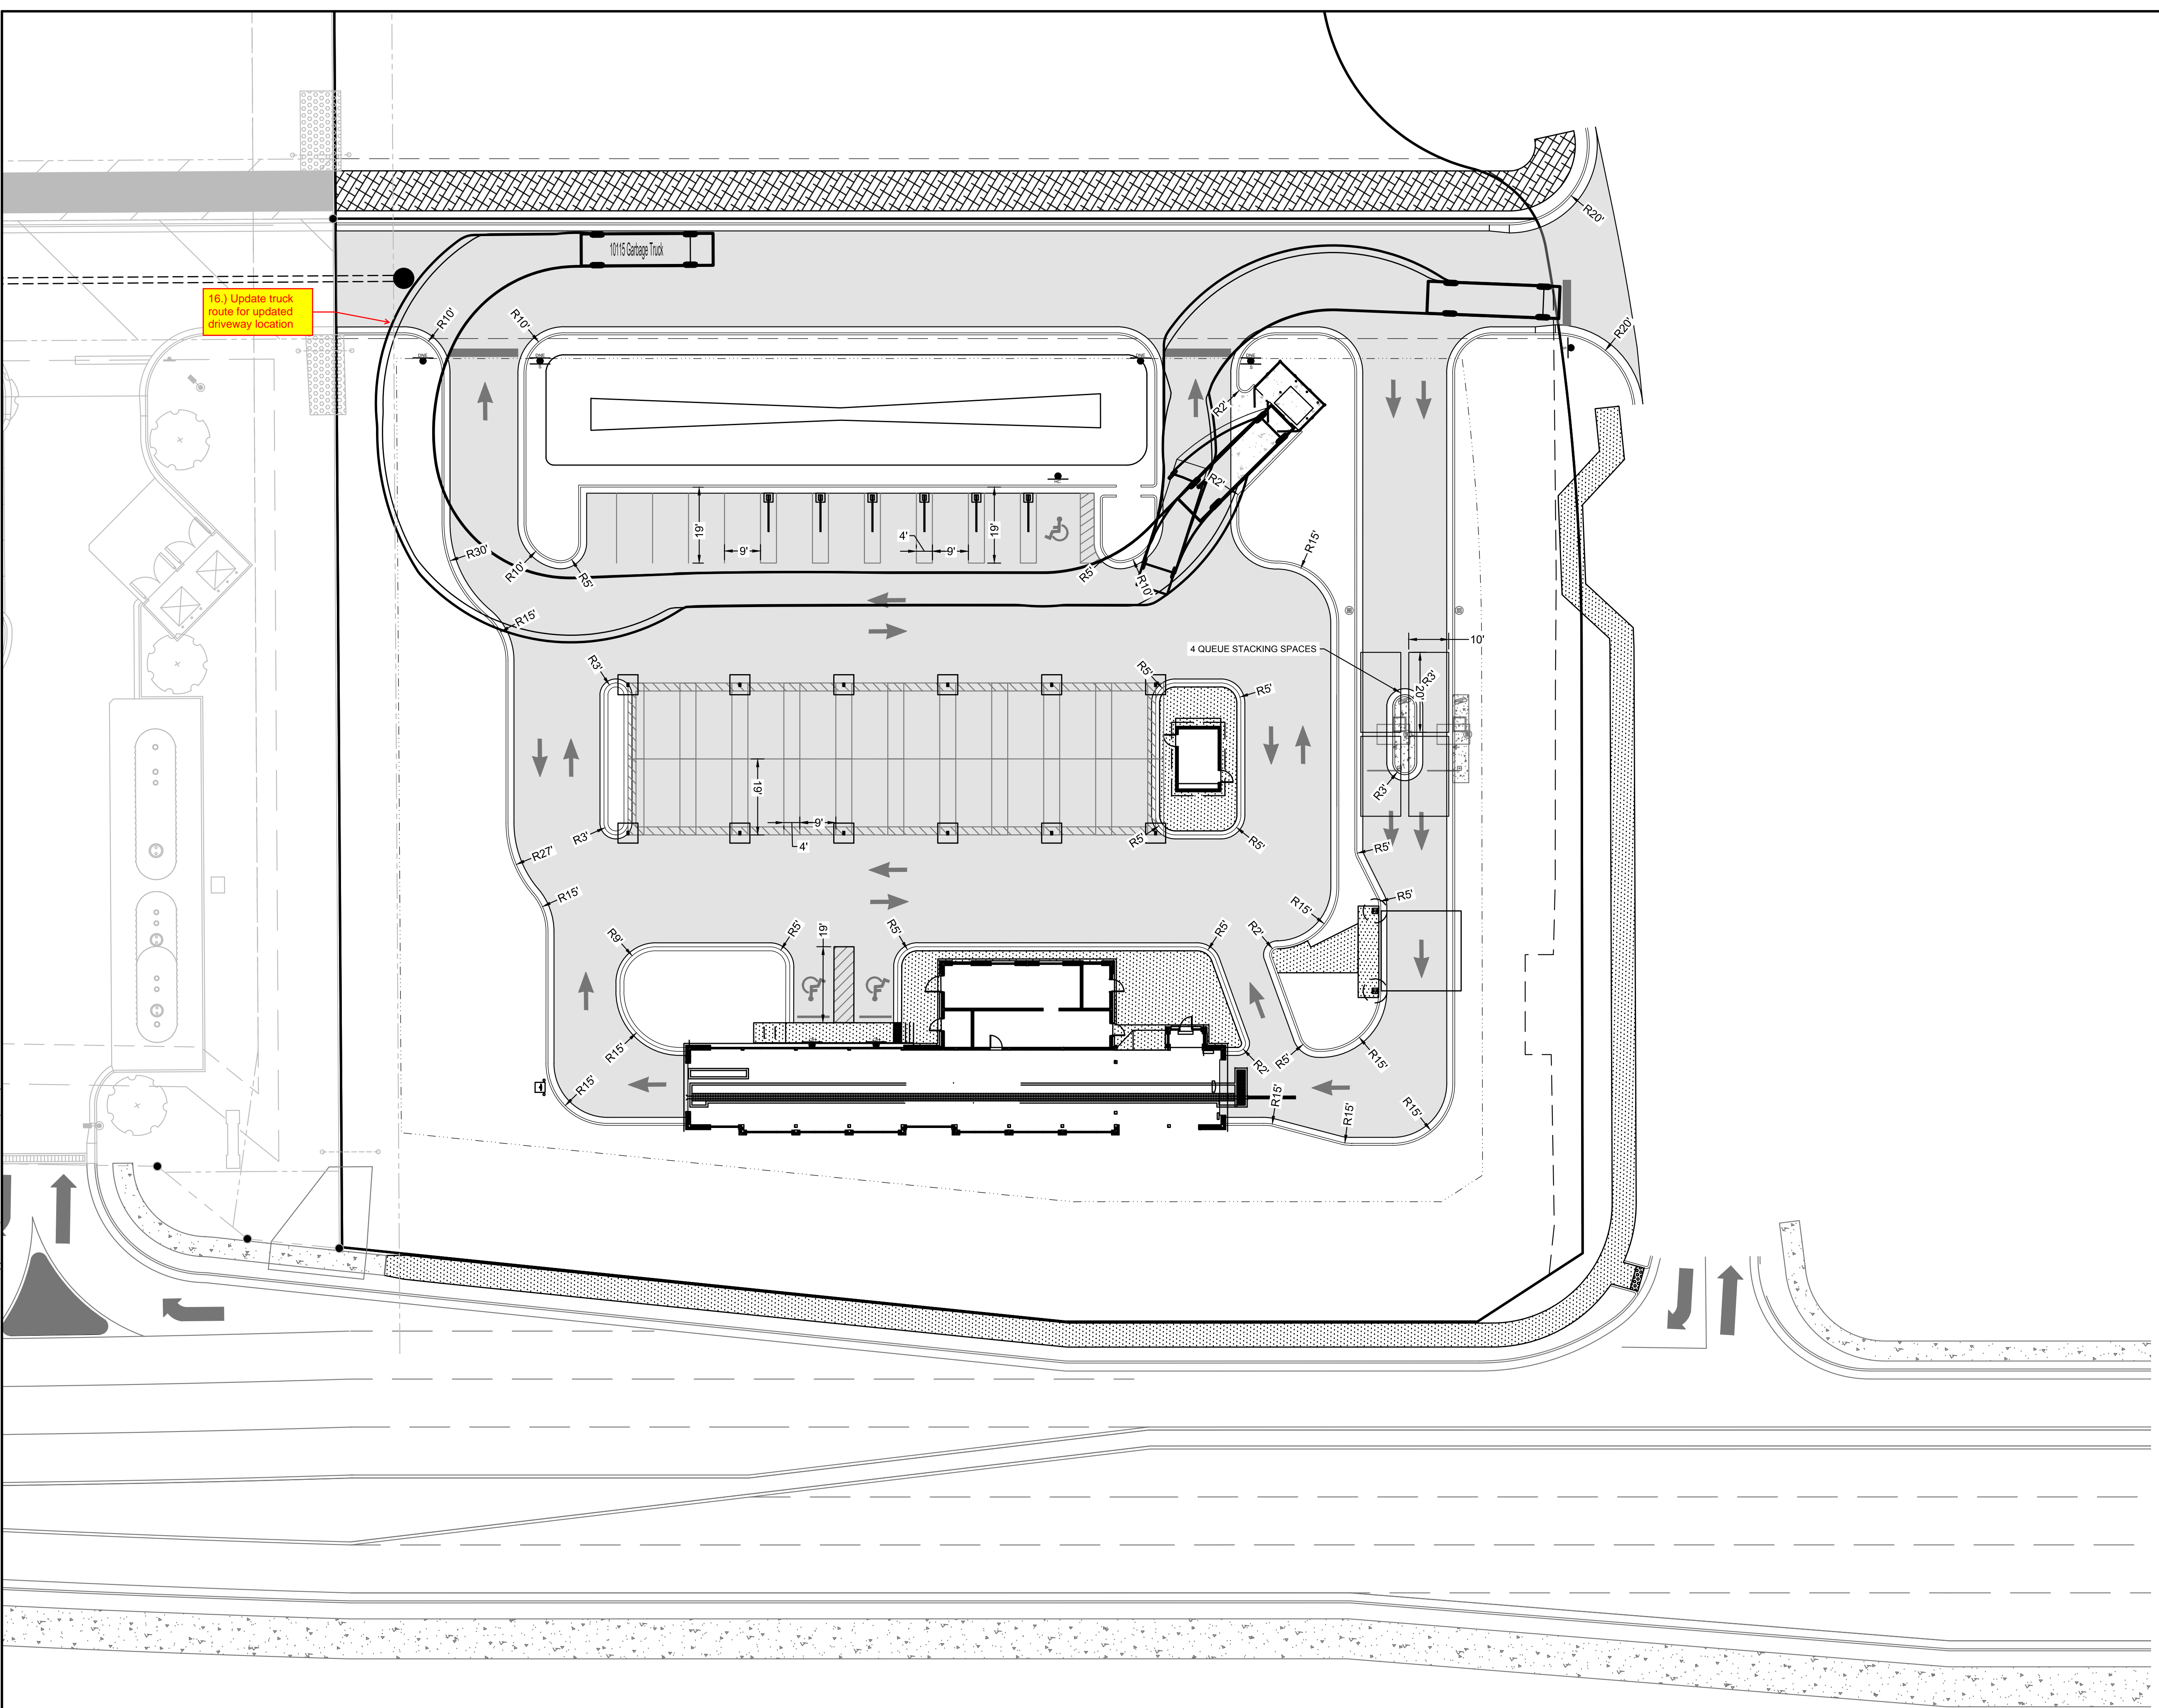

SITE INFORMATION:

ADDRESS: ROLESVILLE, NC
 PROPERTY AREA: 1.82 ACRES
 PARCEL: 1758479244
 EXISTING USE: UNDEVELOPED
 PROPOSED USE: CAR WASH

PROPERTY ZONING: GI-CZ (GENERAL INDUSTRIAL - CONDITIONAL ZONING)

BUILDING SETBACKS:

FRONT (SE):	30'
FRONT (NE):	25'
SIDE (NW):	15'
SIDE (SW):	30'

PERIMETER LANDSCAPE YARDS:

NORTHEAST:	15'
------------	-----

PRE VS. POST DEVELOPMENT AREA:

SITE AREA:	1.82 AC
PRE-IMPERVIOUS AREA:	0.04 AC (2.20%)
POST-IMPERVIOUS AREA:	1.29 AC (70.88%)

PARKING NOTE:


PARKING REQUIRED:
 1 SPACE PER 400 SF GFA OR 5 SPACES MINIMUM = 5 SPACES

PARKING PROVIDED:


EMPLOYEE SPACES:	5 SPACES (1 ADA)
(4 MAX ON SHIFT)	
VACUUM STALLS:	34 STALLS

SITE LAYOUT AND STAKING NOTES:

- CONTRACTOR SHALL CAREFULLY EXAMINE ALL DOCUMENTS AND THE CONSTRUCTION SITE TO OBTAIN FIRST HAND KNOWLEDGE OF EXISTING CONDITIONS.
- ENTIRE SITE SHALL BE DRESSED TO UNIFORM, WELL DRAINED AND VISUALLY APPEALING SURFACE WITH A MINIMUM TOPSOIL LAYER OF FOUR INCHES.
- ALL STRIPING AND SIGNS SHALL CONFORM WITH THE NORTH CAROLINA DEPARTMENT OF TRANSPORTATION AND THE MANUAL ON UNIFORM TRAFFIC CONTROL DEVICES LATEST EDITION. PARKING STALL STRIPING TO BE WHITE WITH BLUE HANDICAPPED STRIPING.
- ALL HANDICAP PARKING SPACED AND ACCESSIBLE ROUTE SHALL CONFORM WITH THE AMERICAN WITH DISABILITY ACT DESIGN GUIDELINES AND SPECIFICATIONS LATEST EDITION.
- DIMENSIONS AND CURVE RADII ARE GIVEN TO FACE OF CURB, WHERE CURB AND GUTTER IS SHOWN. OTHERWISE DIMENSIONS ARE GIVEN TO THE EDGE OF PAVEMENT. CONTRACTOR IS TO COORDINATE WITH THE ARCHITECTURAL PLANS AS TO THE BUILDING LAYOUT AND DIMENSIONS.

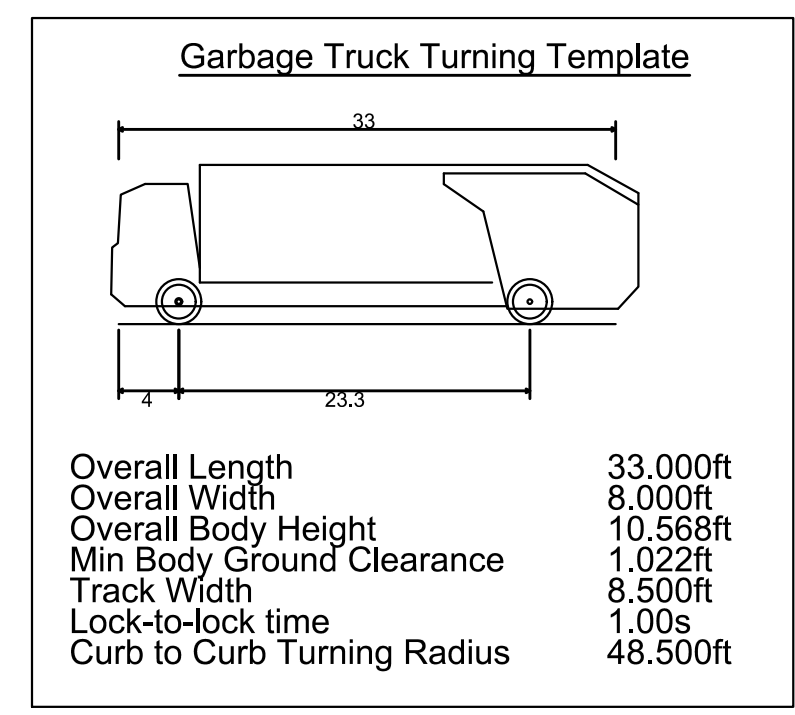

MOUNT PLEASANT, SC
 843.884.1667
 GREENVILLE, SC
 864.298.0534
 SUMMERVILLE, SC
 843.972.0710
 SPARTANBURG, SC
 864.272.1272
 CHARLOTTE, NC
 980.312.5450
 WWW.SEAMONWHITESIDE.COM

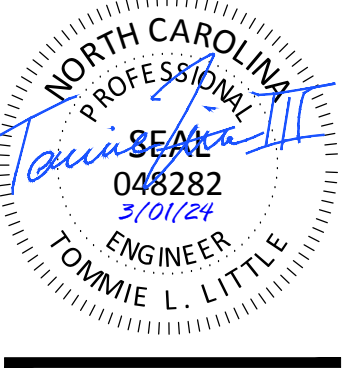

TIDAL WAVE AUTO SPA
 ROLESVILLE, NC

SW+ PROJECT: 10772
 DATE: 3/01/24
 DRAWN BY: CPE
 CHECKED BY: TLL



REVISION HISTORY


NO.	DESCRIPTION

VEHICLE
 STACKING &
 TURNING
 MOVEMENT



Know what's below.
 Call before you dig.

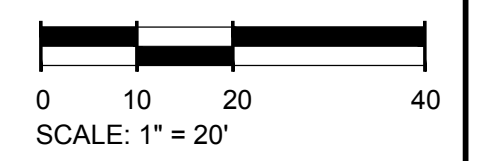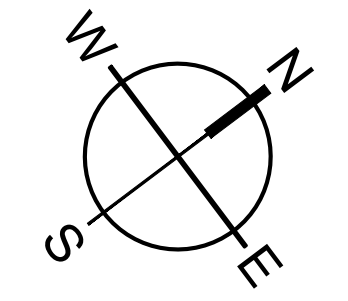

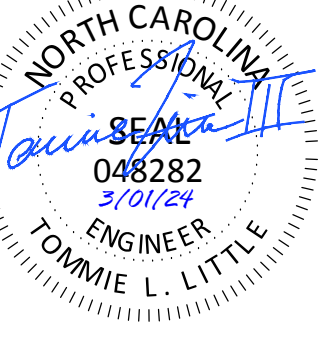

TIDAL WAVE AUTO SPA
ROLESVILLE, NC

SW+ PROJECT: 10772
DATE: 3/01/24
DRAWN BY: CPE
CHECKED BY: TLL

REVISION HISTORY

NO.	DESCRIPTION

FIRE PROTECTION PLAN

SITE INFORMATION:
ADDRESS: ROLESVILLE, NC
PROPERTY AREA: 1.82 ACRES
PARCEL: 1758479244
EXISTING USE: UNDEVELOPED
PROPOSED USE: CAR WASH

PROPERTY ZONING: GI-CZ (GENERAL INDUSTRIAL - CONDITIONAL ZONING)
BUILDING SETBACKS:
FRONT (SE): 30'
FRONT (NE): 25'
SIDE (NW): 15'
SIDE (SW): 30'

PERIMETER LANDSCAPE YARDS:
NORTHEAST: 15'

PRE VS. POST DEVELOPMENT AREA:
SITE AREA: 1.82 AC
PRE-IMPERVIOUS AREA: 0.04 AC (2.20%)
POST-IMPERVIOUS AREA: 1.29 AC (70.88%)

PARKING NOTE:
PARKING REQUIRED:
1 SPACE PER 400 SF GFA OR 5 SPACES MINIMUM = 5 SPACES


PARKING PROVIDED:
EMPLOYEE SPACES: 5 SPACES (1 ADA)
(4 MAX ON SHIFT)
VACUUM STALLS: 34 STALLS

SITE LAYOUT AND STAKING NOTES:


- CONTRACTOR SHALL CAREFULLY EXAMINE ALL DOCUMENTS AND THE CONSTRUCTION SITE TO OBTAIN FIRST HAND KNOWLEDGE OF EXISTING CONDITIONS.
- ENTIRE SITE SHALL BE DRESSED TO UNIFORM, WELL DRAINED AND VISUALLY APPEALING SURFACE WITH A MINIMUM TOPSOIL LAYER OF FOUR INCHES.
- ALL STRIPING AND SIGNS SHALL CONFORM WITH THE NORTH CAROLINA DEPARTMENT OF TRANSPORTATION AND THE MANUAL ON UNIFORM TRAFFIC CONTROL DEVICES LATEST EDITION. PARKING STALL STRIPING TO BE WHITE WITH BLUE HANDICAPPED STRIPING.
- ALL HANDICAP PARKING SPACED AND ACCESSIBLE ROUTE SHALL CONFORM WITH THE AMERICAN WITH DISABILITY ACT DESIGN GUIDELINES AND SPECIFICATIONS LATEST EDITION.
- DIMENSIONS AND CURVE RADII ARE GIVEN TO FACE OF CURB, WHERE CURB AND GUTTER IS SHOWN. OTHERWISE DIMENSIONS ARE GIVEN TO THE EDGE OF PAVEMENT. CONTRACTOR IS TO COORDINATE WITH THE ARCHITECTURAL PLANS AS TO THE BUILDING LAYOUT AND DIMENSIONS.

FIRE TRUCK TURNING TEMPLATE

Copy of Rolesville Fire Truck 1	50.000ft
Overall Length	8.333ft
Overall Width	10.101ft
Overall Body Height	0.920ft
Min Body Ground Clearance	8.333ft
Track Width	0.10s
Lock-to-lock time	45.00°
Max Wheel Angle	

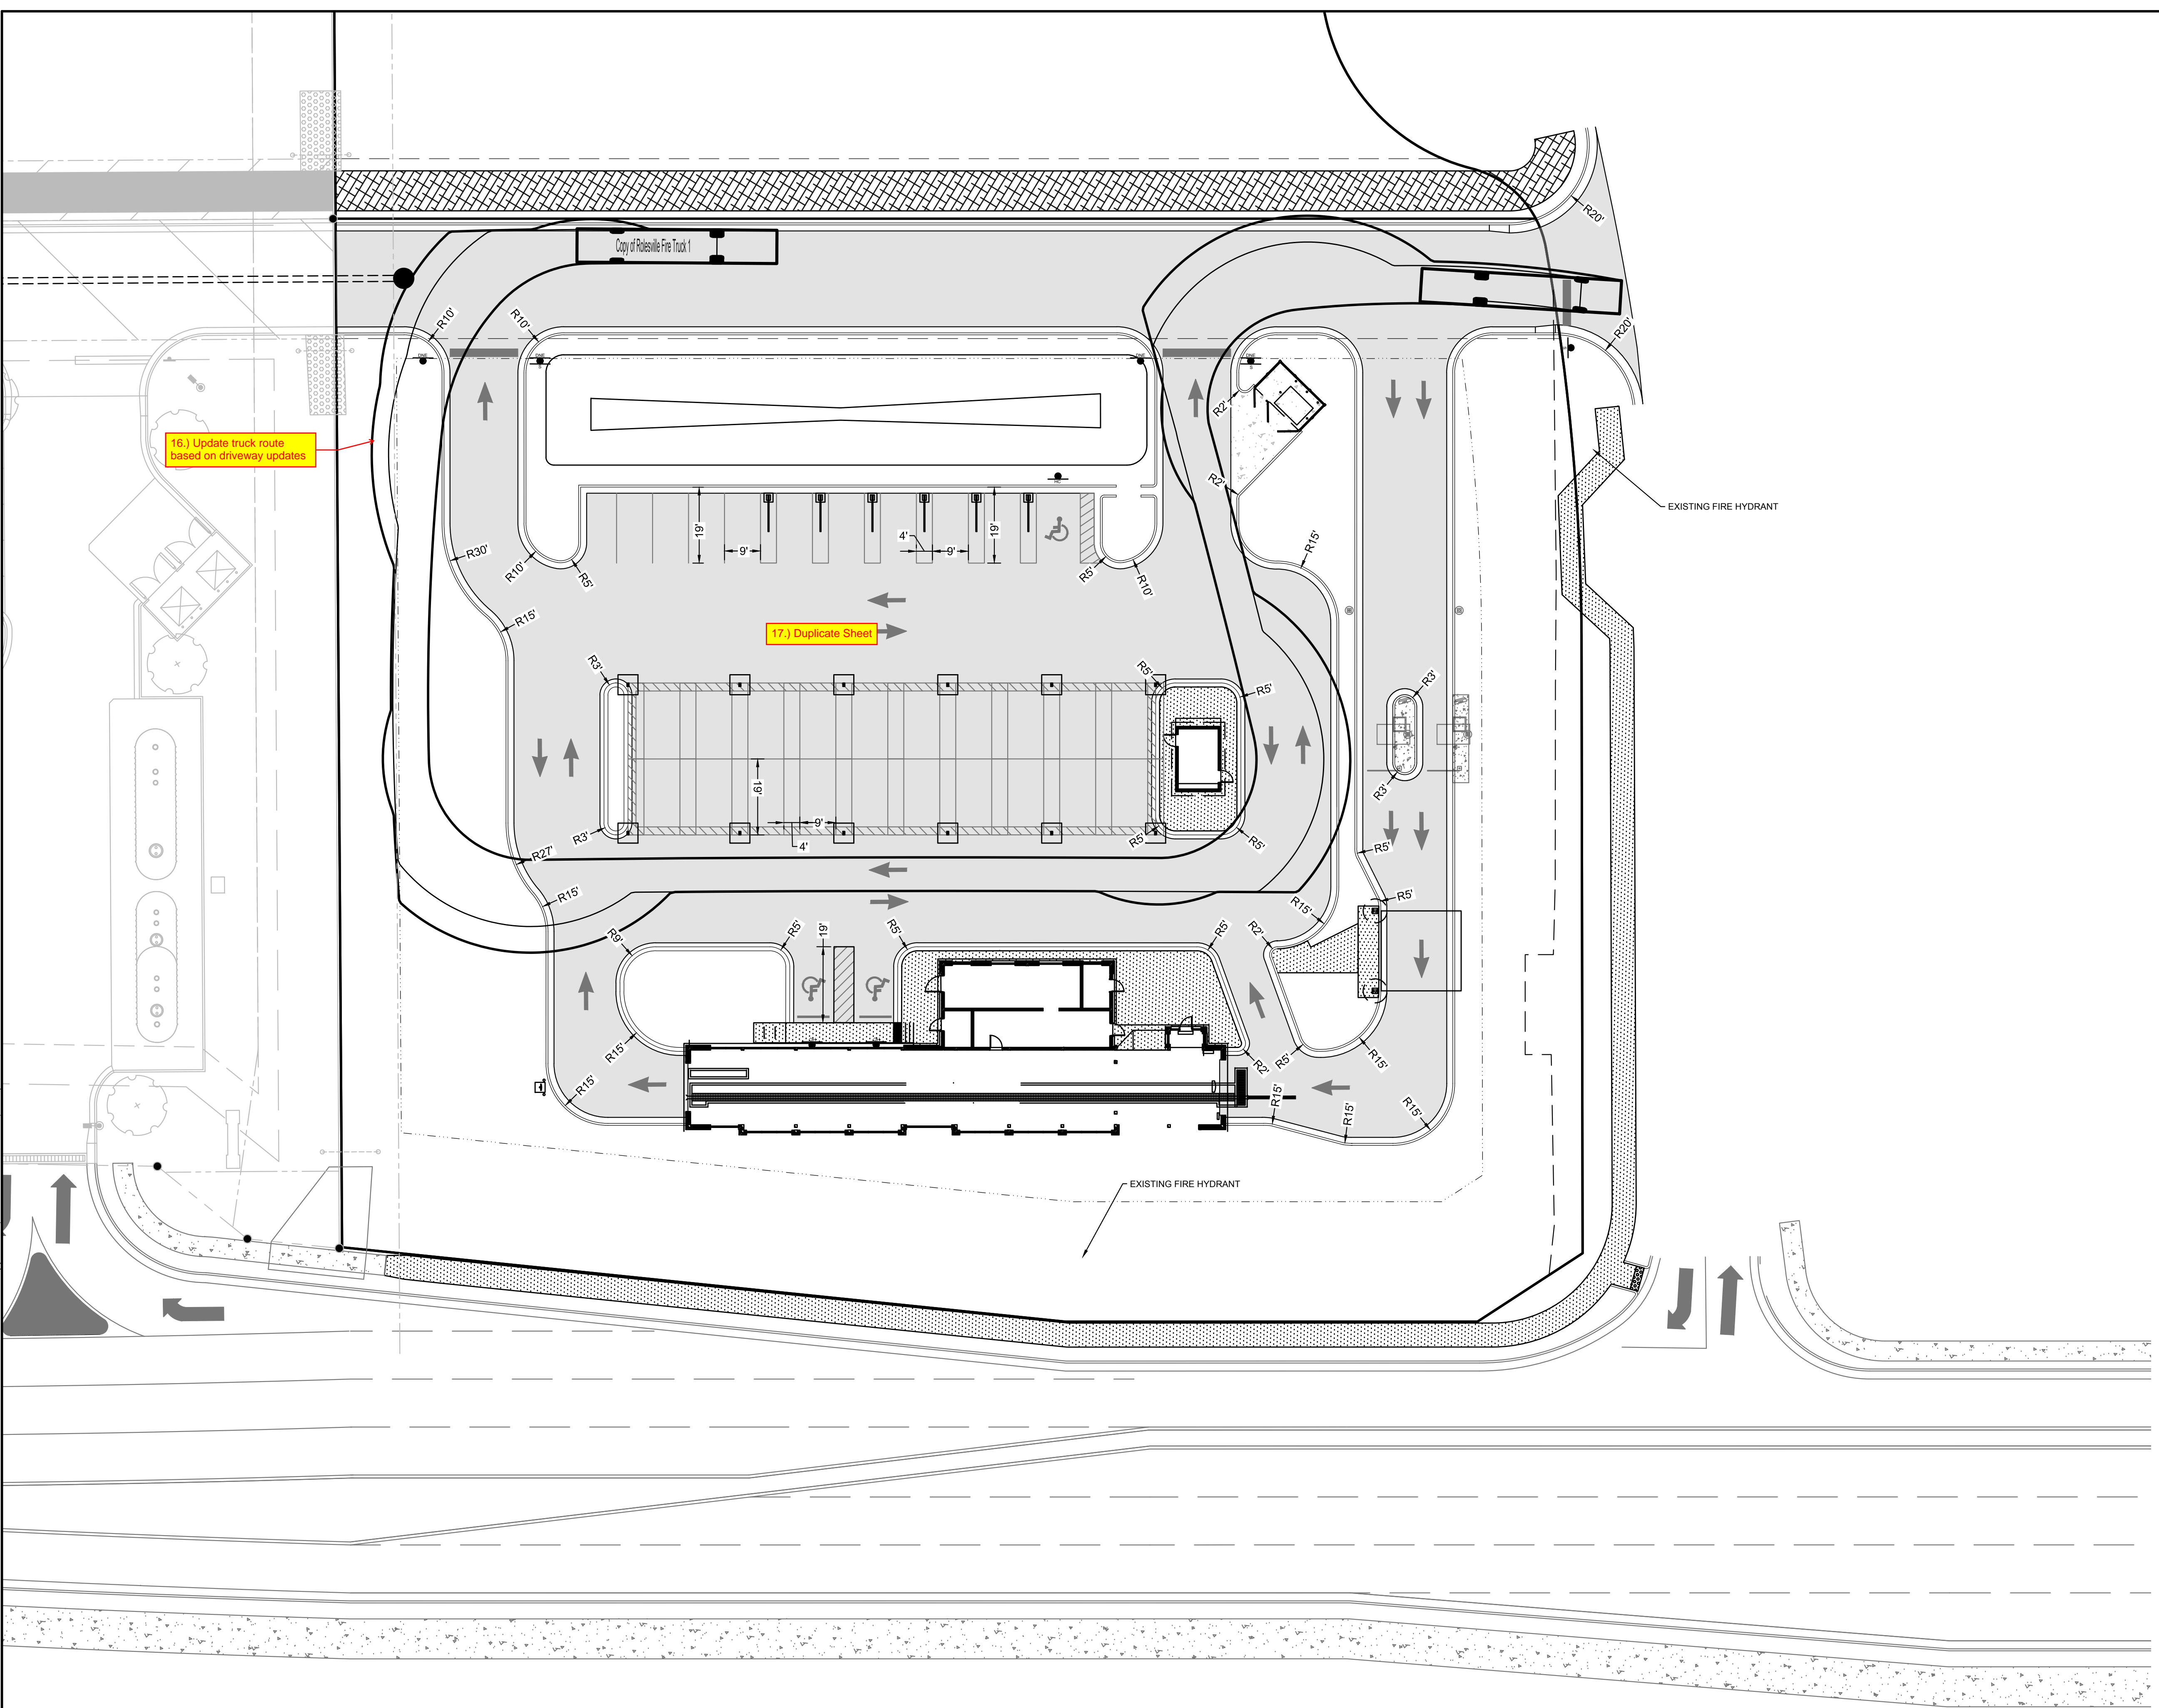


Know what's below.
Call before you dig.

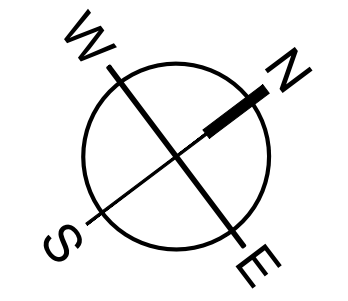

SCALE: 1" = 20'




501 WINDO PARK BOULEVARD, SUITE 200 | MOUNT PLEASANT, SC 29546 | JUDSON MILLS BUILDING 6000, 701 EASLEY BROOK RD, SUITE 600 | GREENVILLE, SC 29611 | 230 PETERSON DR | CHARLOTTE, NC 28217 | 710 N. CEDAR STREET | SUMMERVILLE, SC 29583 | 104 N. DANIEL MCGRAW AVENUE, SUITE 300 | SPARTANBURG, SC 29301
COPYRIGHT © SEAMON WHITESIDE & ASSOCIATES, INC. | THIS DRAWING SHALL NOT BE REPRODUCED IN ANY MANNER OR USED FOR ANY PURPOSE WITHOUT WRITTEN PERMISSION.

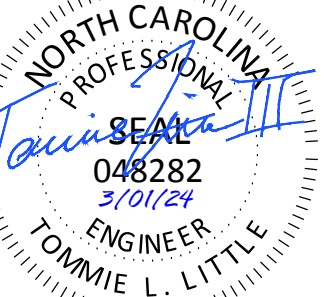

TIDAL WAVE AUTO SPA
ROLESVILLE, NC



Know what's below.
Call before you dig.

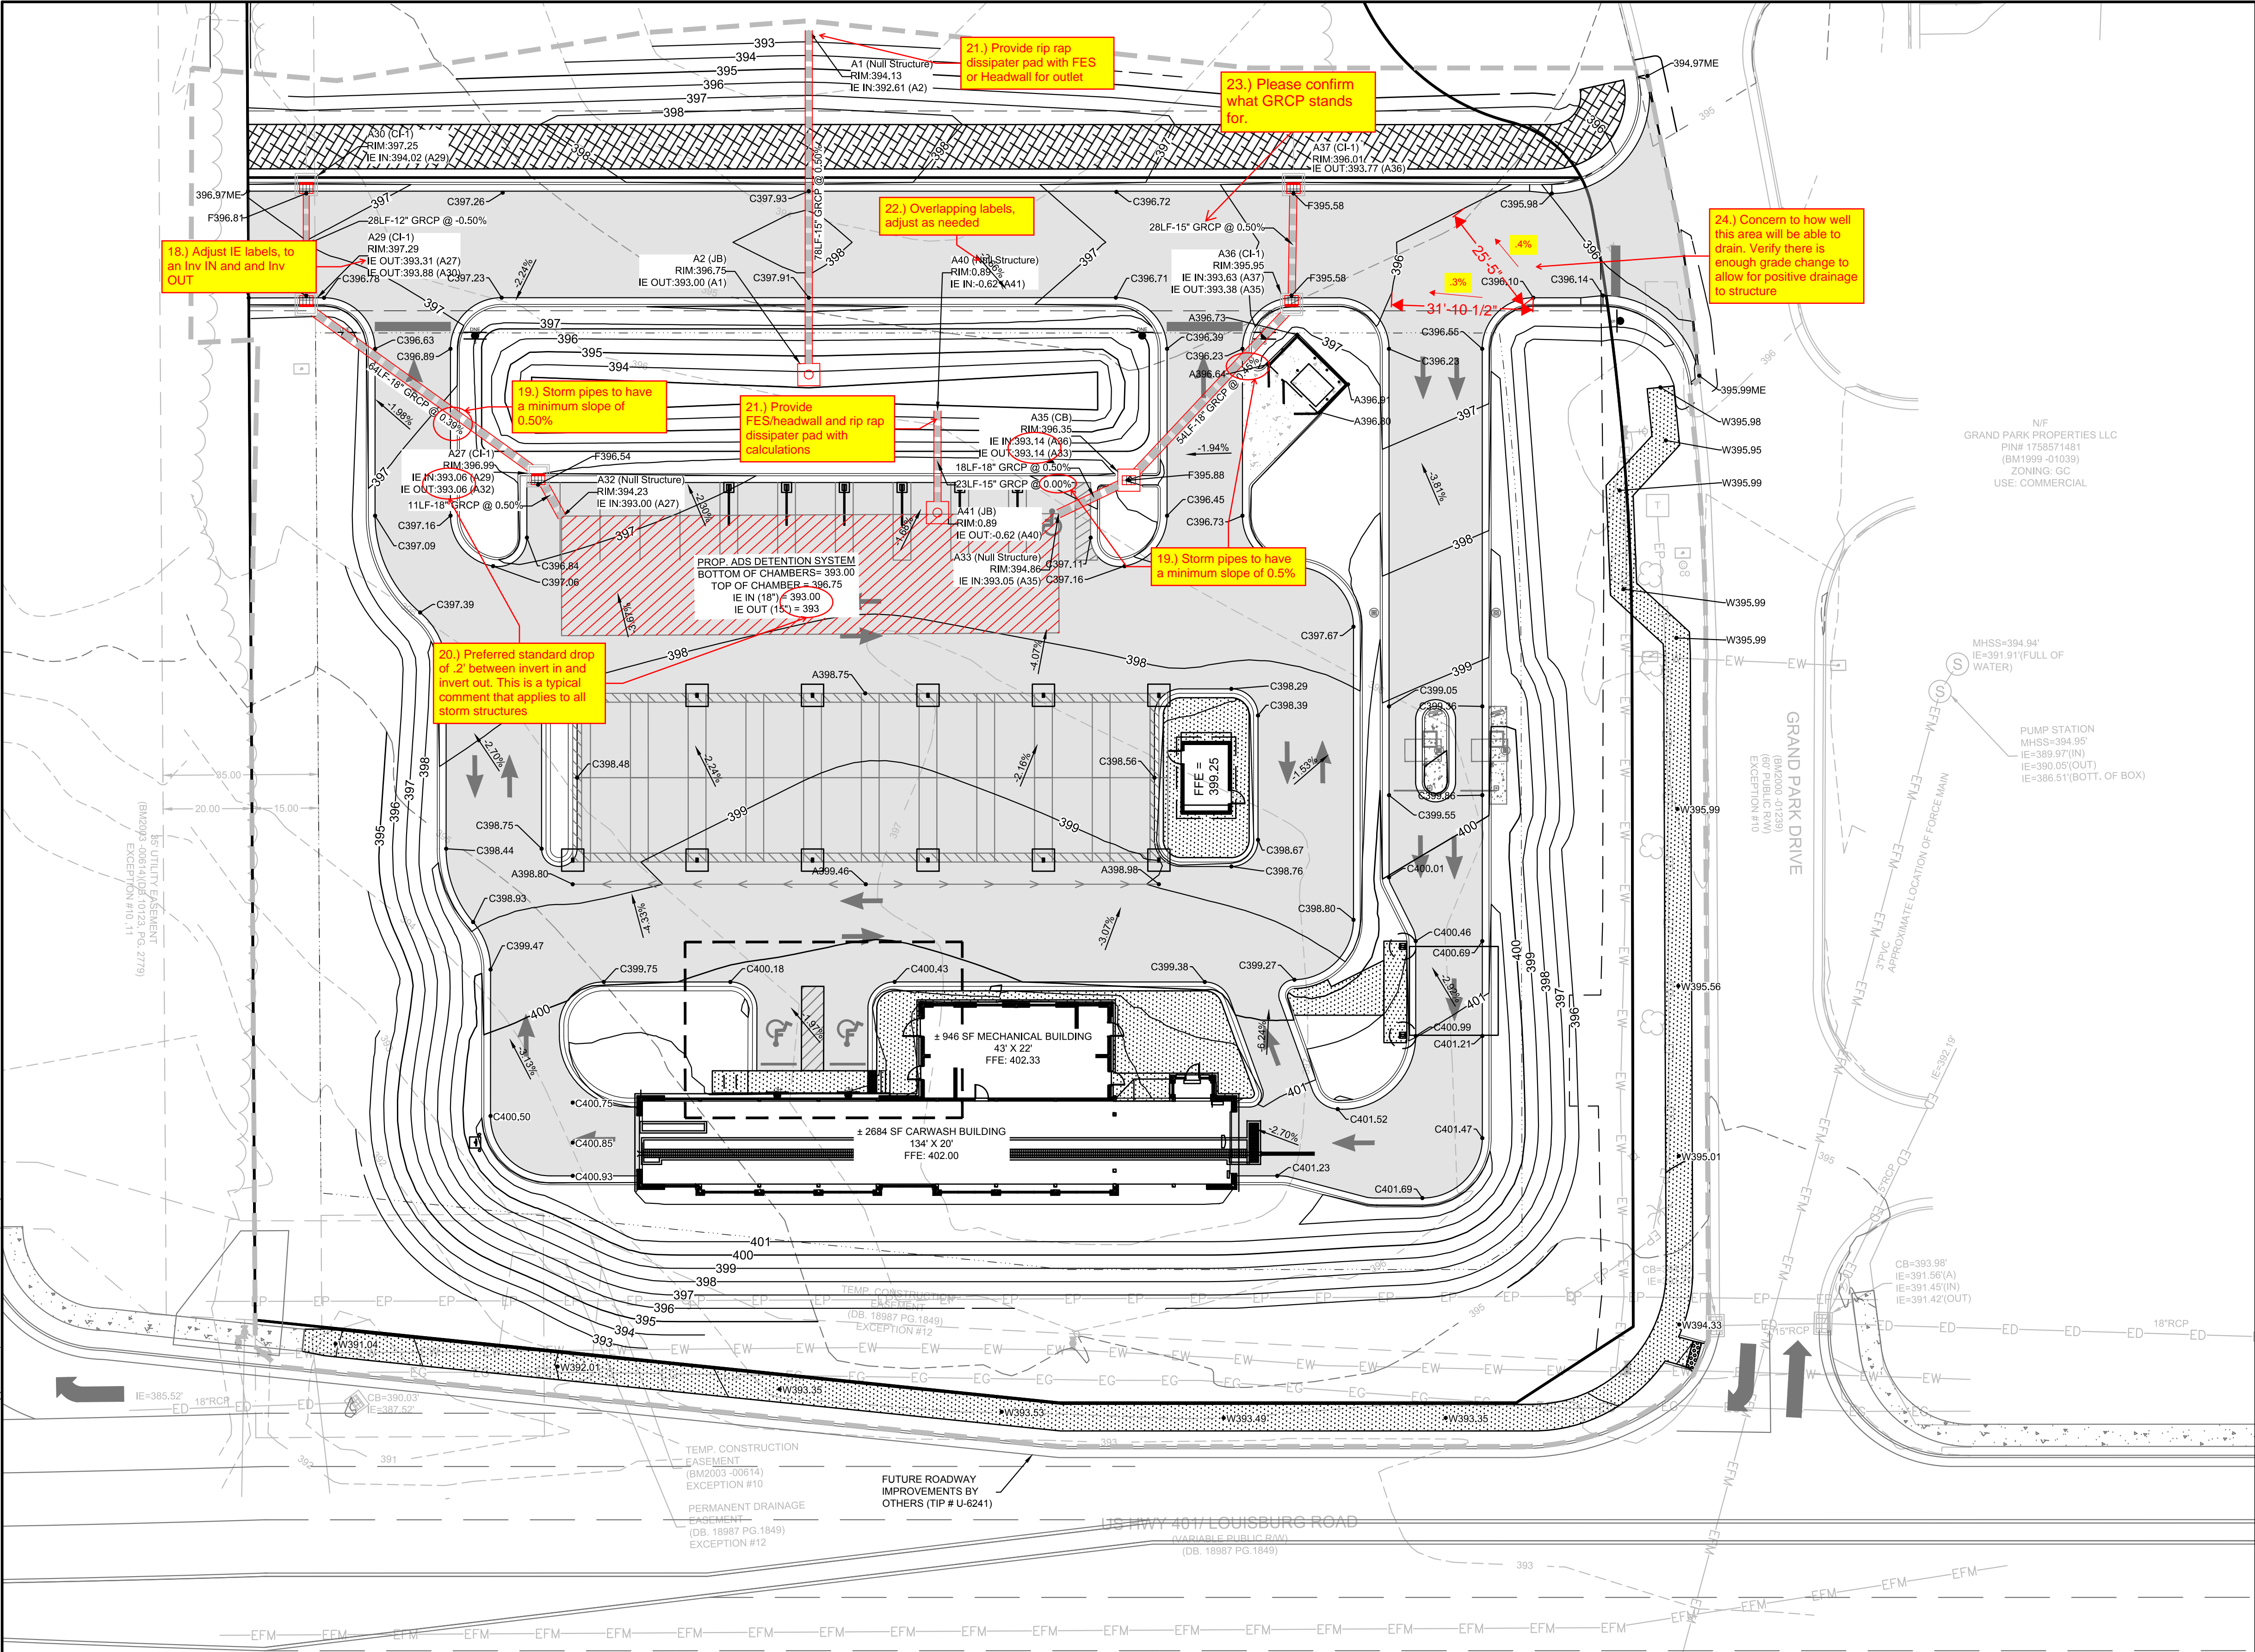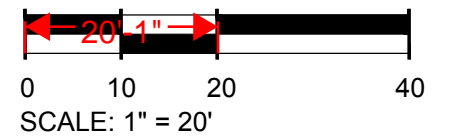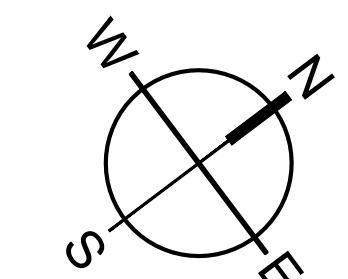

18.) Adjust IE labels, to an Inv IN and Inv OUT

19.) Storm pipes to have a minimum slope of 0.50%


21.) Provide FES/headwall and rip rap dissipater pad with calculations

20.) Preferred standard drop of 2' between invert in and invert out. This is a typical comment that applies to all storm structures

23.) Please confirm what GRCP stands for.

22.) Overlapping labels, adjust as needed

24.) Concern to how well this area will be able to drain. Verify there is enough grade change to allow for positive drainage to structure

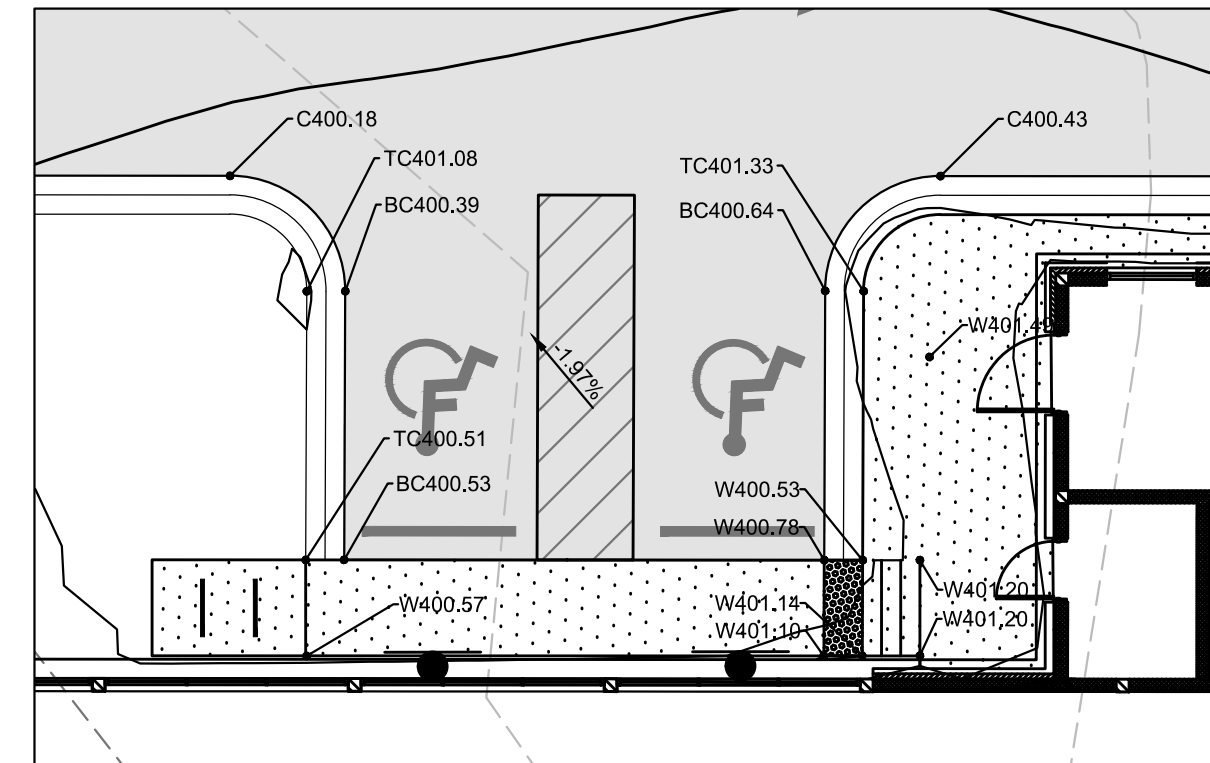

- NOTES:**
1. THE LONGITUDINAL SLOPE OF ALL SURFACES ALONG THE ADA ACCESSIBLE ROUTE, WHICH ARE NOT SPECIFICALLY NOTED AS BEING A RAMP, SHALL NOT EXCEED 1:20. RAMPS SHALL NOT EXCEED A SLOPE OF 1:12. TRANSVERSE SLOPES SHALL NOT EXCEED 1:50. CONTRACTOR SHALL FIELD VERIFY SLOPES BEFORE INSTALLATION AND NOTIFY ENGINEER IMMEDIATELY IF MAX. SLOPES ARE EXCEEDED.
 2. AT PARKING SPACES AND ASSOCIATED ACCESS AISLES, SLOPE SHALL NOT EXCEED 1:50 IN ANY DIRECTION.

LEGEND

RCP DRAINAGE PIPE	
GRADING LIMITS	
HOODED CATCH BASIN (HCB)	
JUNCTION BOX (JB)	

SPOT ELEV KEY (FINISHED GRADING)

A-(ASPHALT) SURFACE OF FINISHED ASPHALT ROADWAY OR WALKING PATH
 C-(CONCRETE) CONCRETE PAVING
 D-(DIRT) FINISHED GROUND ELEVATION
 F-(FLOW) ELEVATION AT WHICH SURFACE WATER FLOWS INTO DRAINAGE STRUCTURE
 -SURFACE OF ASPHALT ADJACENT TO THROAT OR GRATE AT CURB INLET
 -SURFACE OF ACCESS COVER FOR JUNCTION OR ISOLATION BOX
 -SURFACE OF GRATE AT OUTSIDE EDGE FOR CATCH BASIN, GUTTER INLET, OR GRATED POND STRUCTURE
 FFE - FINISHED FLOOR ELEVATION
 G-(GUTTER) SURFACE OF FINISHED GUTTER AT LOWEST POINT (ALONG WATER FLOW PATH)
 W-(WALK) SURFACE OF FINISHED CONCRETE OR INTERLOCKING PAVER SIDEWALK, PATIO, PLAZA, OR SLAB
 TC - TOP OF CURB ELEVATION
 BC - BOTTOM OF CURB ELEVATION
 TS - TOP OF STAIRS ELEVATION
 BS - BOTTOM OF STAIRS ELEVATION
 TW - FINISHED GRADE ELEVATION AT TOP OF WALL
 BW - FINISHED GRADE ELEVATION AT BOTTOM OF WALL
 ME-(MATCH EXISTING) FOLLOWING ELEVATION NUMBER -
 INDICATES TO MATCH ELEVATION OF EXISTING SURFACE AT POINT OF CONNECTION


EXAMPLE: A12.56ME MEANS THAT THE SURFACE OF NEW ASPHALT IS TO BE AT ELEVATION 12.56 WHICH SHOULD MATCH THE ELEVATION OF THE EXISTING ASPHALT SURFACE AT THE JOINT

SW+ PROJECT: 10772
 DATE: 3/01/24
 DRAWN BY: CPE
 CHECKED BY: TLL

REVISION HISTORY

NO.	DESCRIPTION

OVERALL GRADING AND DRAINAGE PLAN

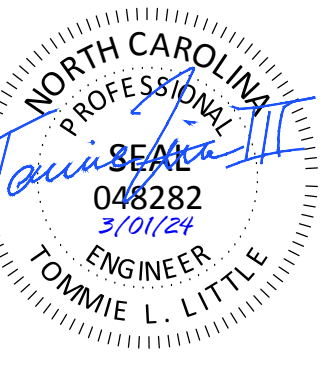

TIDAL WAVE AUTO SPA
ROLESVILLE, NC


SW+ PROJECT: 10772
DATE: 3/01/24
DRAWN BY: CPE
CHECKED BY: TLL

REVISION HISTORY


NO.	DESCRIPTION

DRAINAGE PROFILES


25.) Include profiles

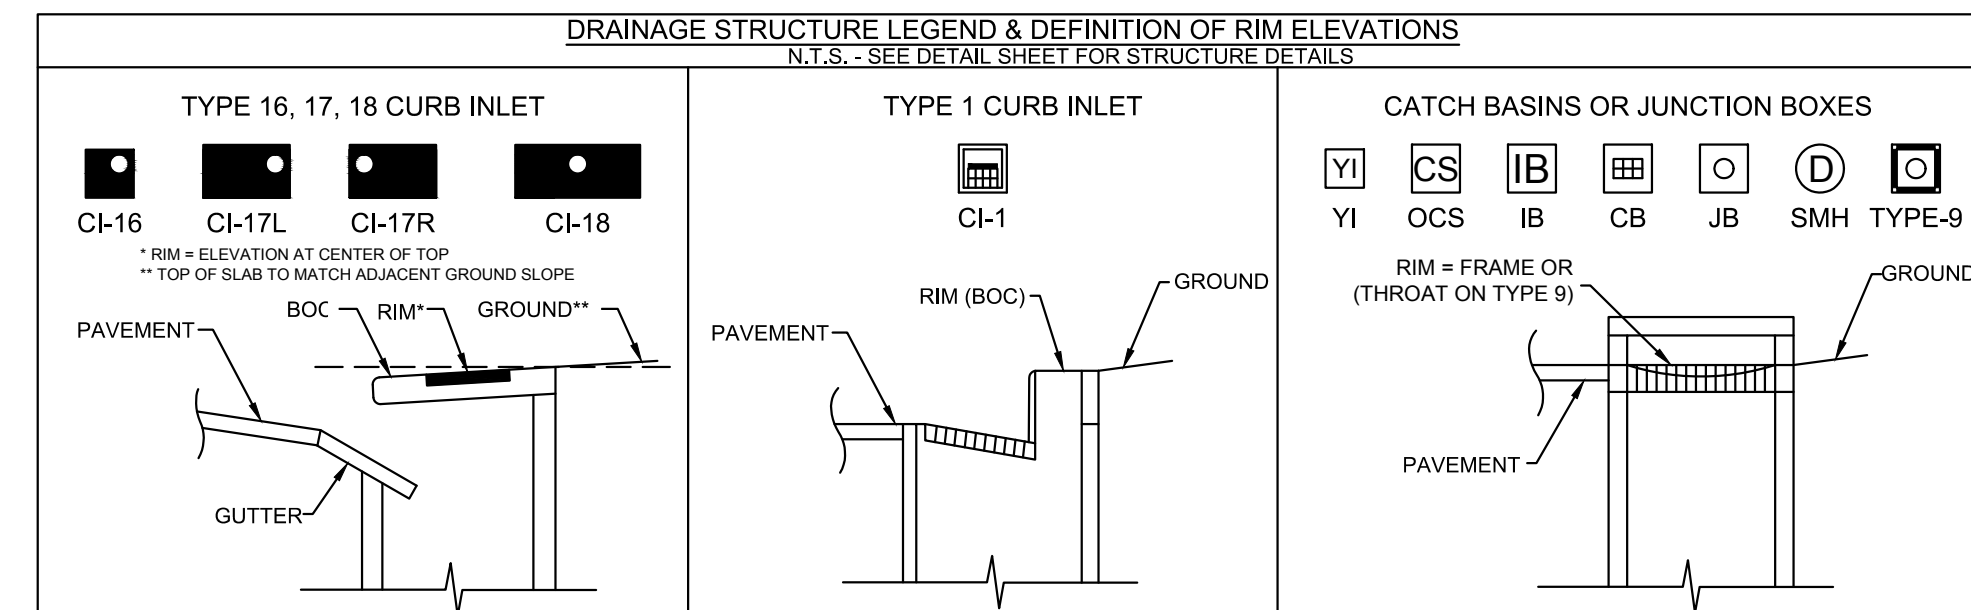


Know what's below.
Call before you dig.

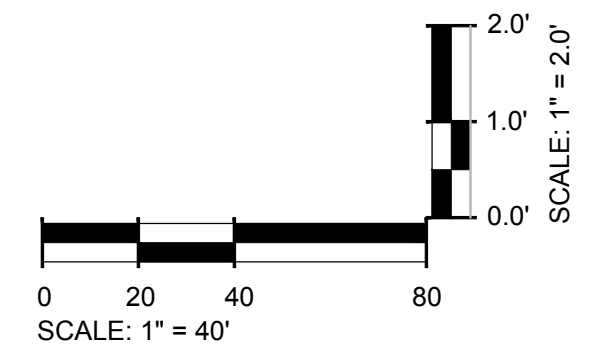

NO.	DESCRIPTION

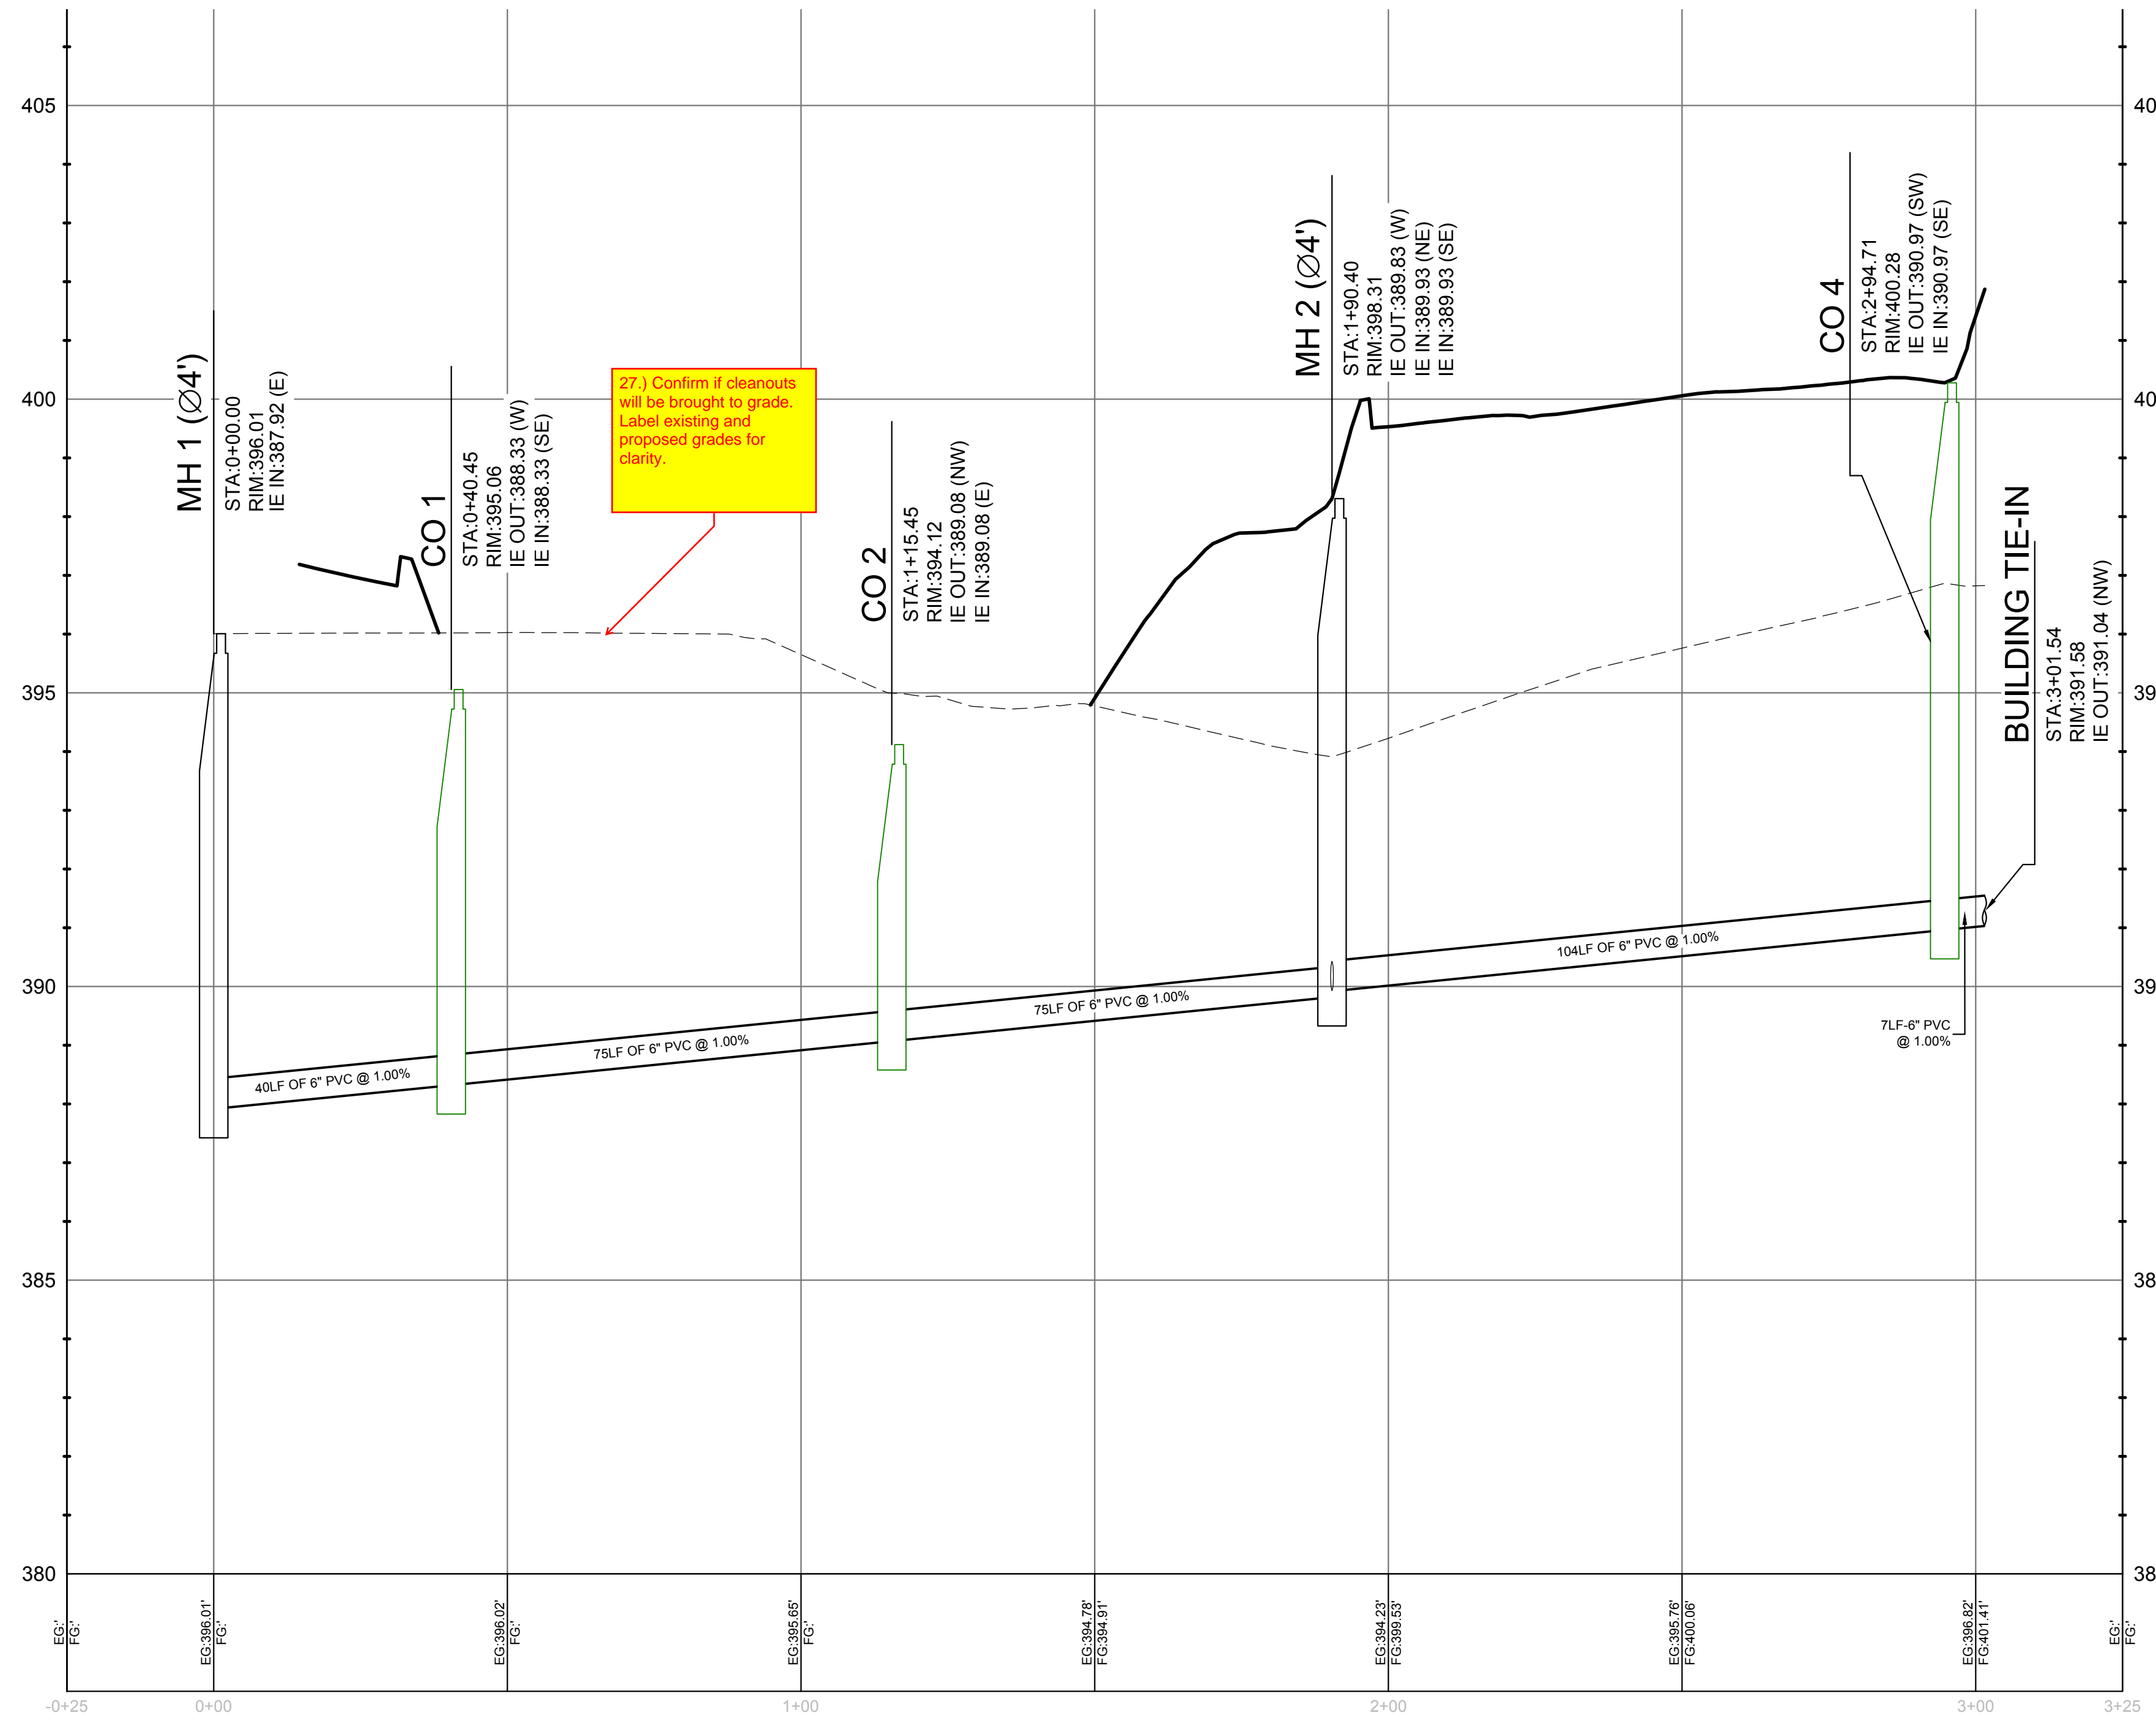


MH 1 - BUILDING TIE-IN PROFILE

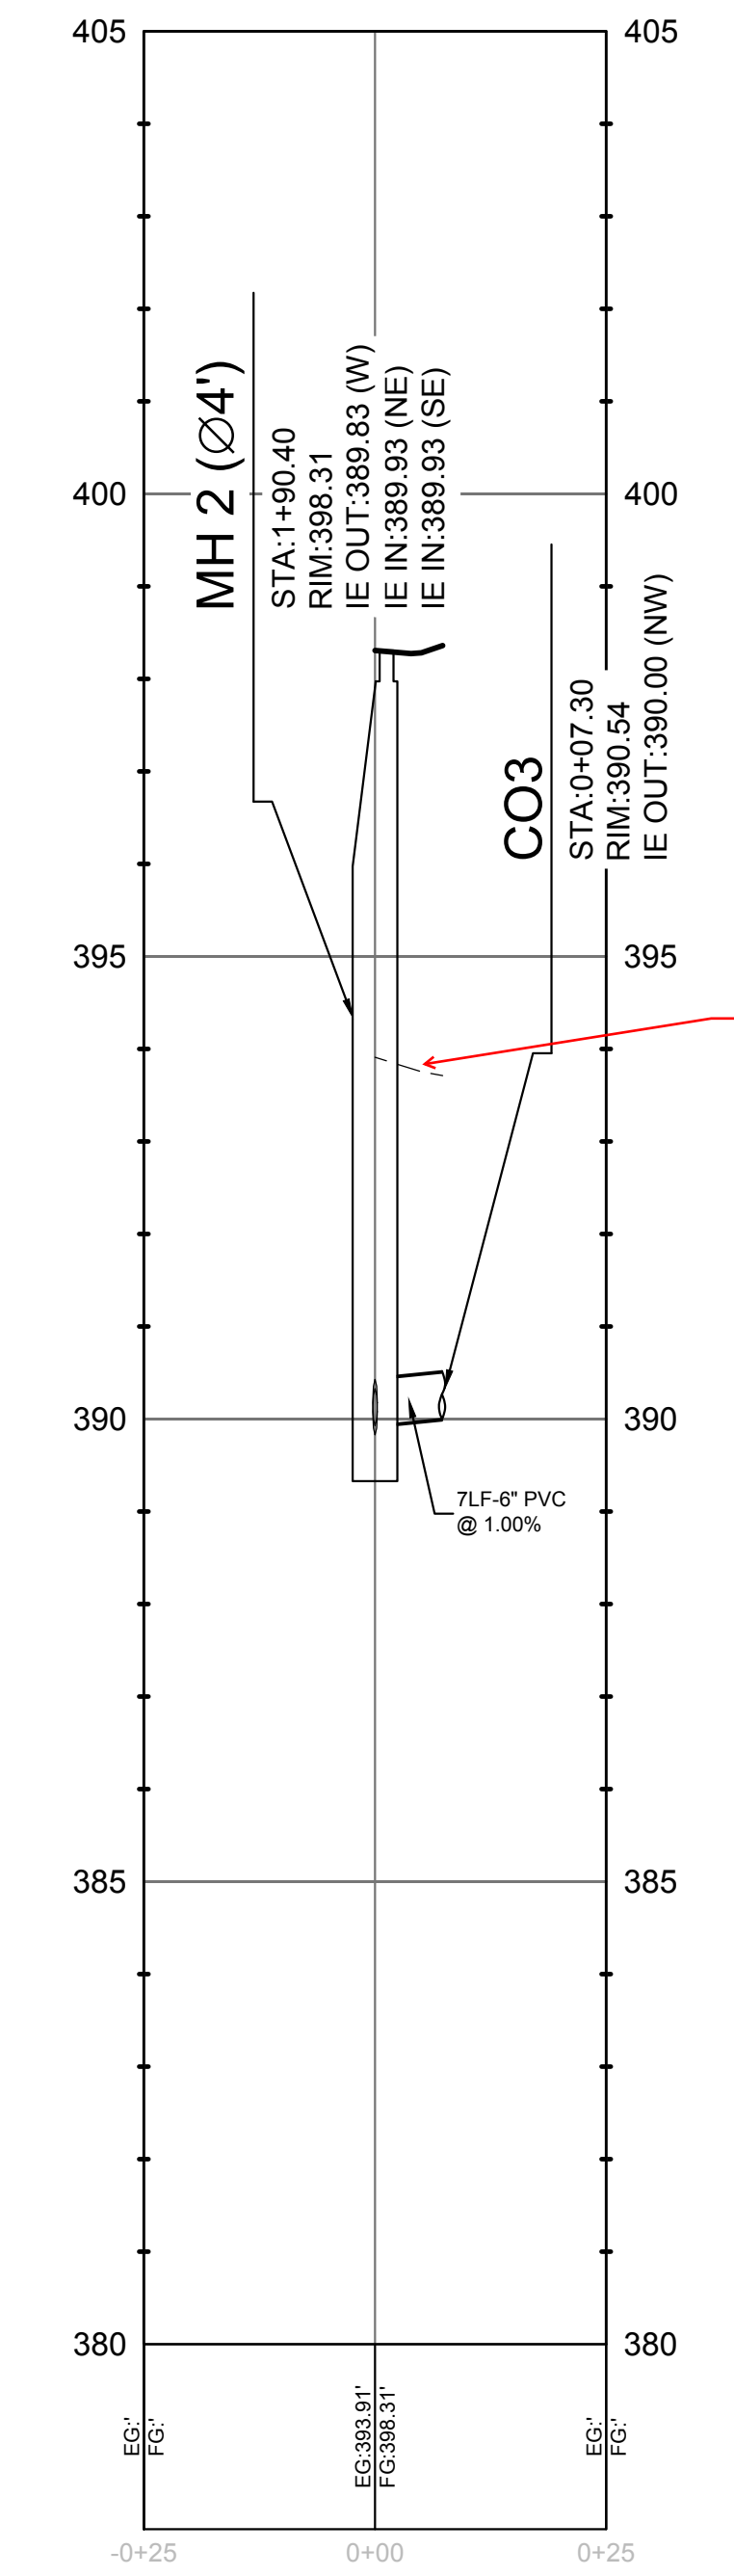

MH 2 - CO3 PROFILE

27.) Confirm if cleanouts will be brought to grade. Label existing and proposed grades for clarity.

27.) Label existing and proposed grades. Show CO3 structure. Clarify if the CO will be brought up to proposed or existing grade.

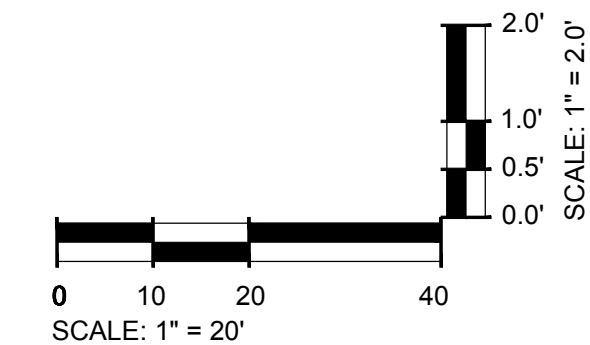


EXISTING UTILITY NOTE:
 THE LOCATION OF EXISTING UNDERGROUND UTILITIES ARE SHOWN IN AN APPROXIMATE WAY ONLY AND HAVE NOT BEEN INDEPENDENTLY VERIFIED BY THE OWNER OR ITS REPRESENTATIVE. THE CONTRACTOR SHALL DETERMINE THE EXACT LOCATION OF ALL EXISTING UTILITIES BEFORE COMMENCING ANY WORK, AND AGREES TO BE FULLY RESPONSIBLE FOR ANY AND ALL DAMAGES WHICH MIGHT OCCUR DUE TO THE CONTRACTOR'S FAILURE TO EXACTLY LOCATE AND PRESERVE ANY AND ALL UNDERGROUND UTILITIES.




501 WINDO PARK BOULEVARD, SUITE 200 | MOUNT PLEASANT, SC 29546 | JUDSON MILLS BUILDING 6000 TOY EASLEY BROOK RD, SUITE 6000, GREENVILLE, SC 29611 | 230 PETERSON DR., CHARLOTTE, NC 28217 | 723 N. CENAR STREET | SUMMERVILLE, SC 29585 | 104 N. DANIEL MORGAN AVENUE, SUITE 300 | SPARTANBURG, SC 29301



MOUNT PLEASANT, SC
843.884.1667
GREENVILLE, SC
864.298.0534
SUMMERVILLE, SC
843.972.0710
SPARTANBURG, SC
864.272.1272
CHARLOTTE, NC
980.312.5450
WWW.SEAMONWHITESIDE.COM

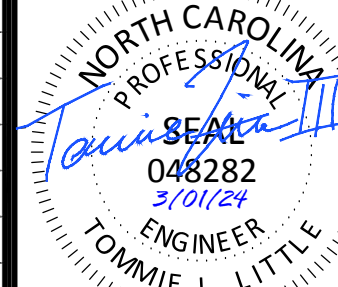

DATE OF PLANS		
03/31/2023		
REVISIONS		
NO.	DATE	DESCRIPTION
1	-	-
2	-	-
3	-	-
4	-	-
5	-	-
6	-	-
7	-	-
8	-	-
9	-	-
10	-	-

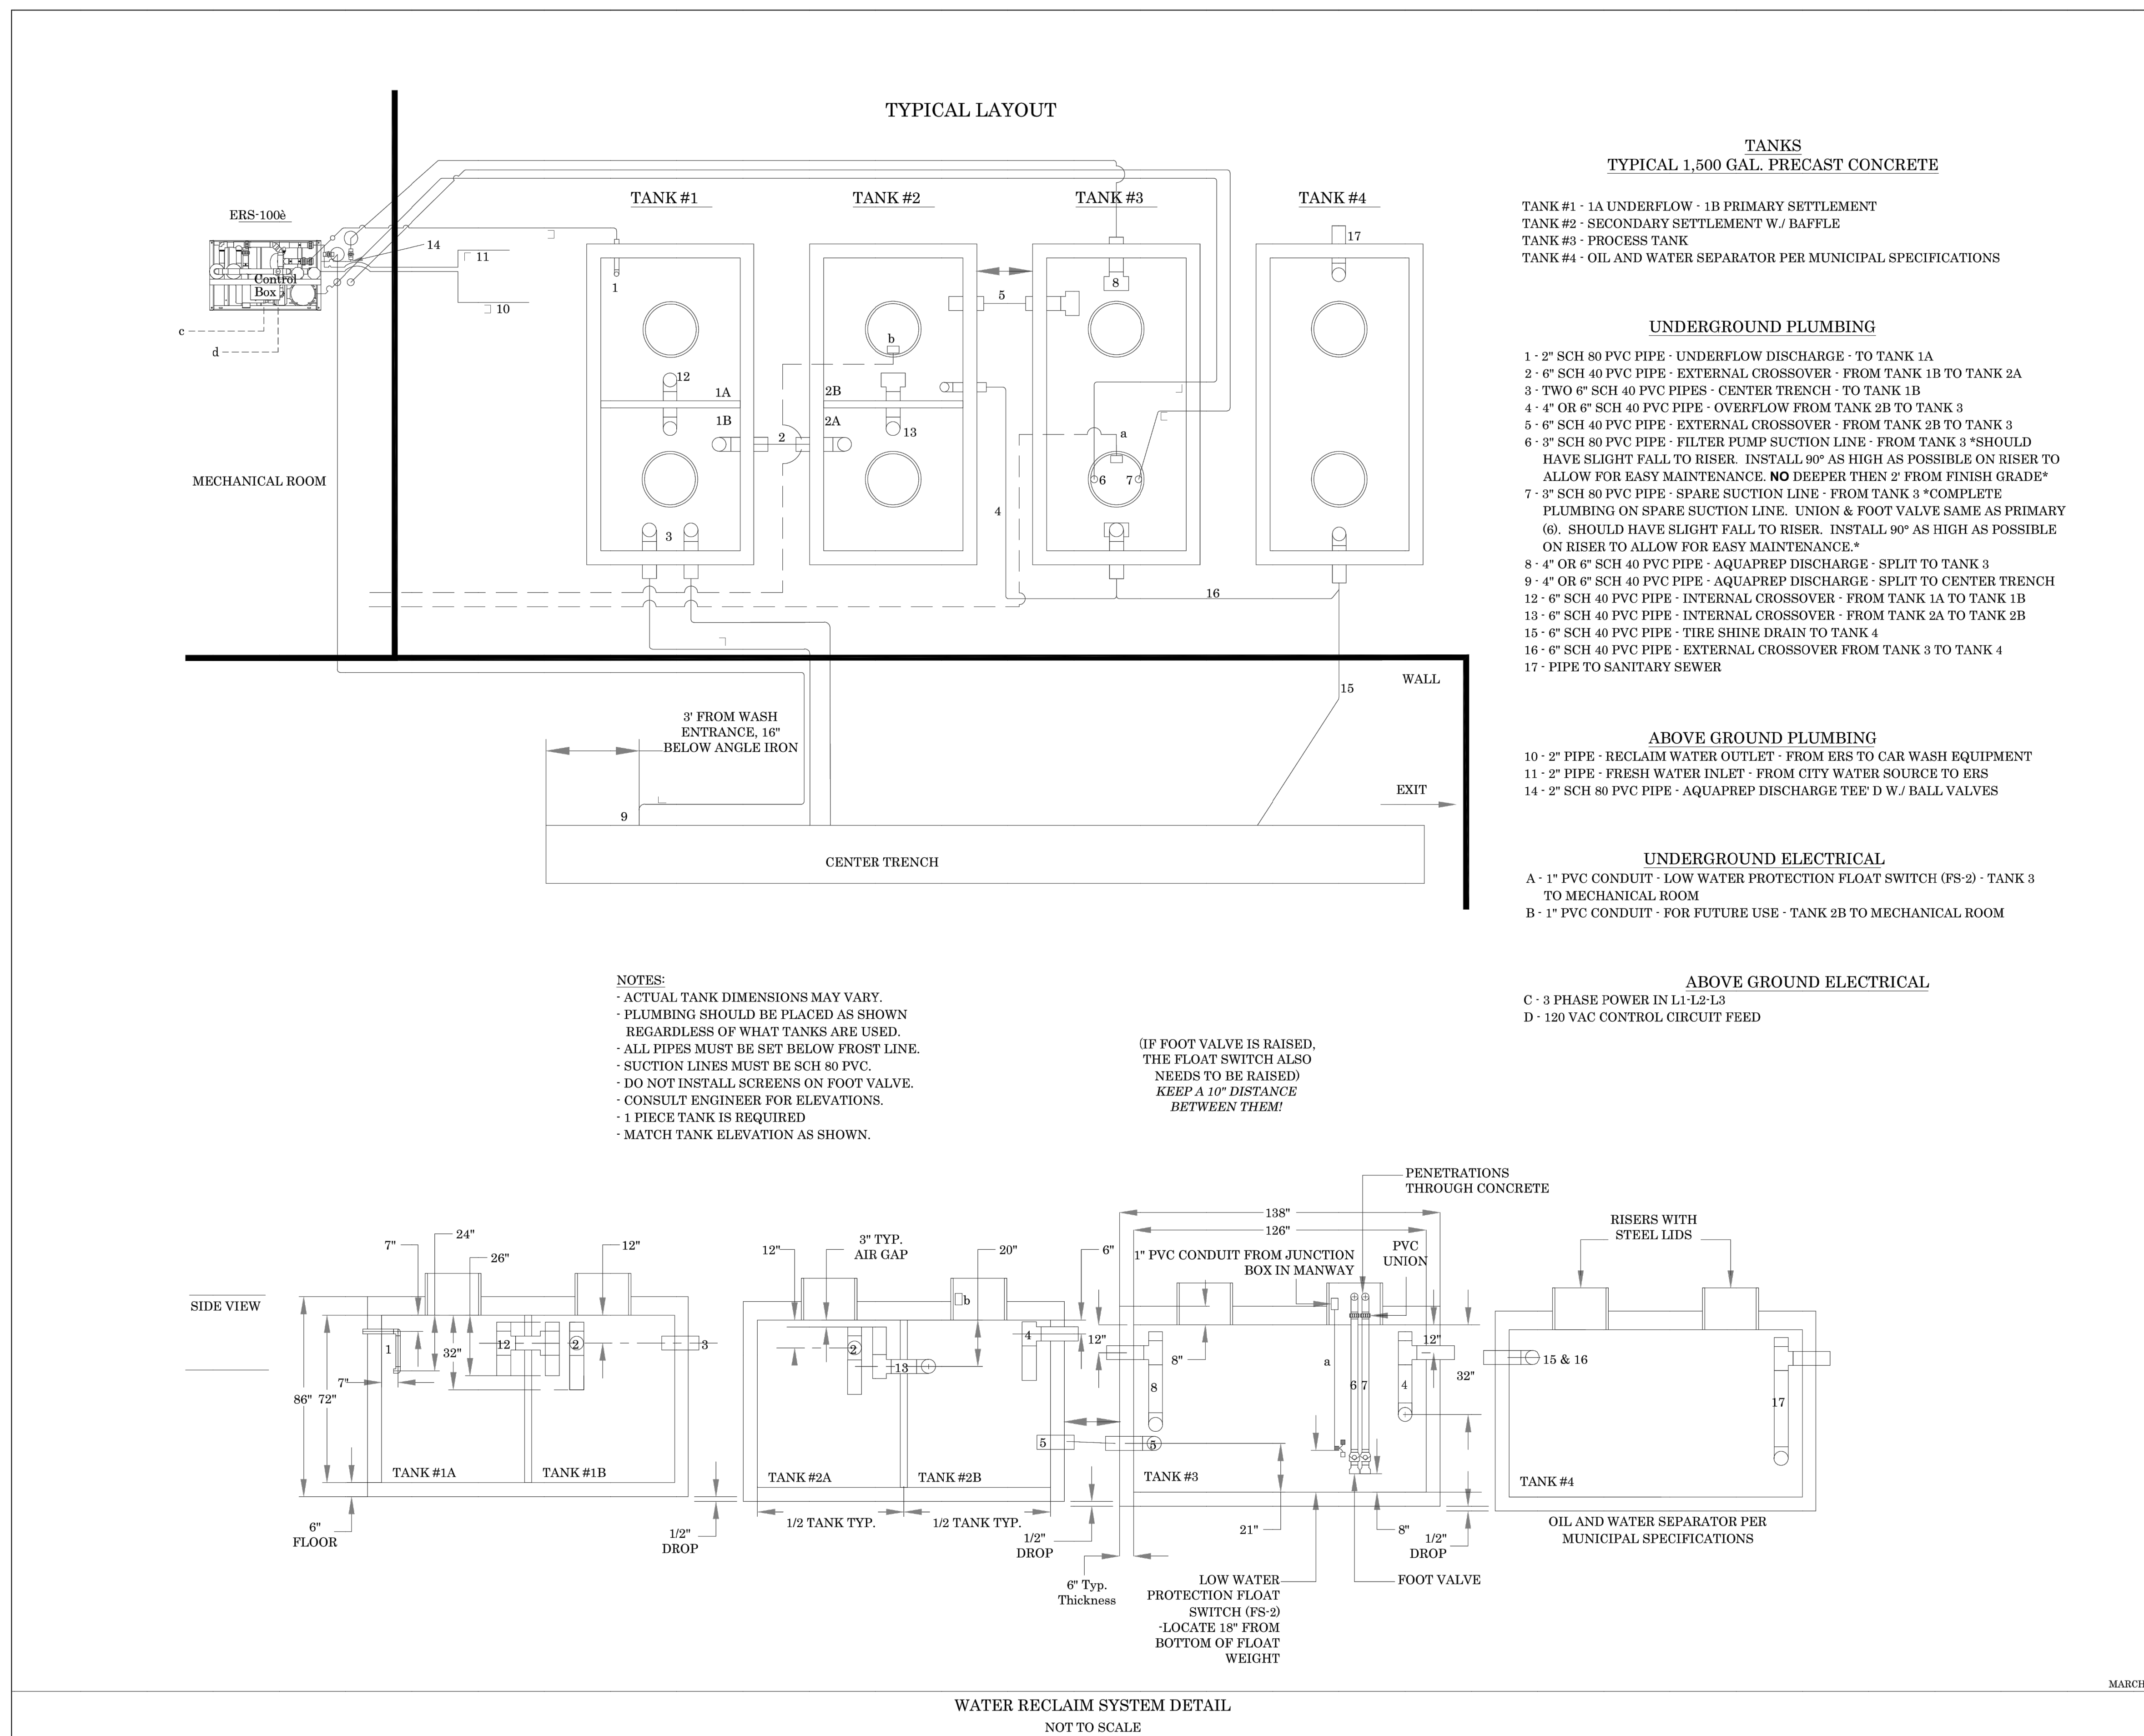

TECHNICAL CRITERIA
SHJ CONSTRUCTION GROUP
WATER RECLAIM SYSTEM DETAIL

TIDAL WAVE AUTO SPA
ROLESVILLE, NC

SW+ PROJECT: 10772
DATE: 3/01/24
DRAWN BY: CPE
CHECKED BY: TLL

REVISION HISTORY


NO.	DATE	DESCRIPTION

NOT TO SCALE
SHEET
1 OF 1


CONSTRUCTION DETAILS

501 WINDO PARK BOULEVARD, SUITE 200 | MOUNT PLEASANT, SC 29546 | JUDSON MILLS BUILDING 6000 TOY EASLEY BROOK RD, SUITE 600 | GREENVILLE, SC 29611 | 230 PETERSON DR. | CHARLOTTE, NC 28217 | 710 N. CEDAR STREET | SUMMERVILLE, SC 29586 | 104 N. DANIEL MORGAN AVENUE, SUITE 300 | SPARTANBURG, SC 29301
COPYRIGHT © SEAMON WHITESIDE & ASSOCIATES, INC. | THIS DRAWING SHALL NOT BE REPRODUCED IN ANY MANNER OR USED FOR ANY PURPOSE WITHOUT WRITTEN PERMISSION.


REVISION HISTORY

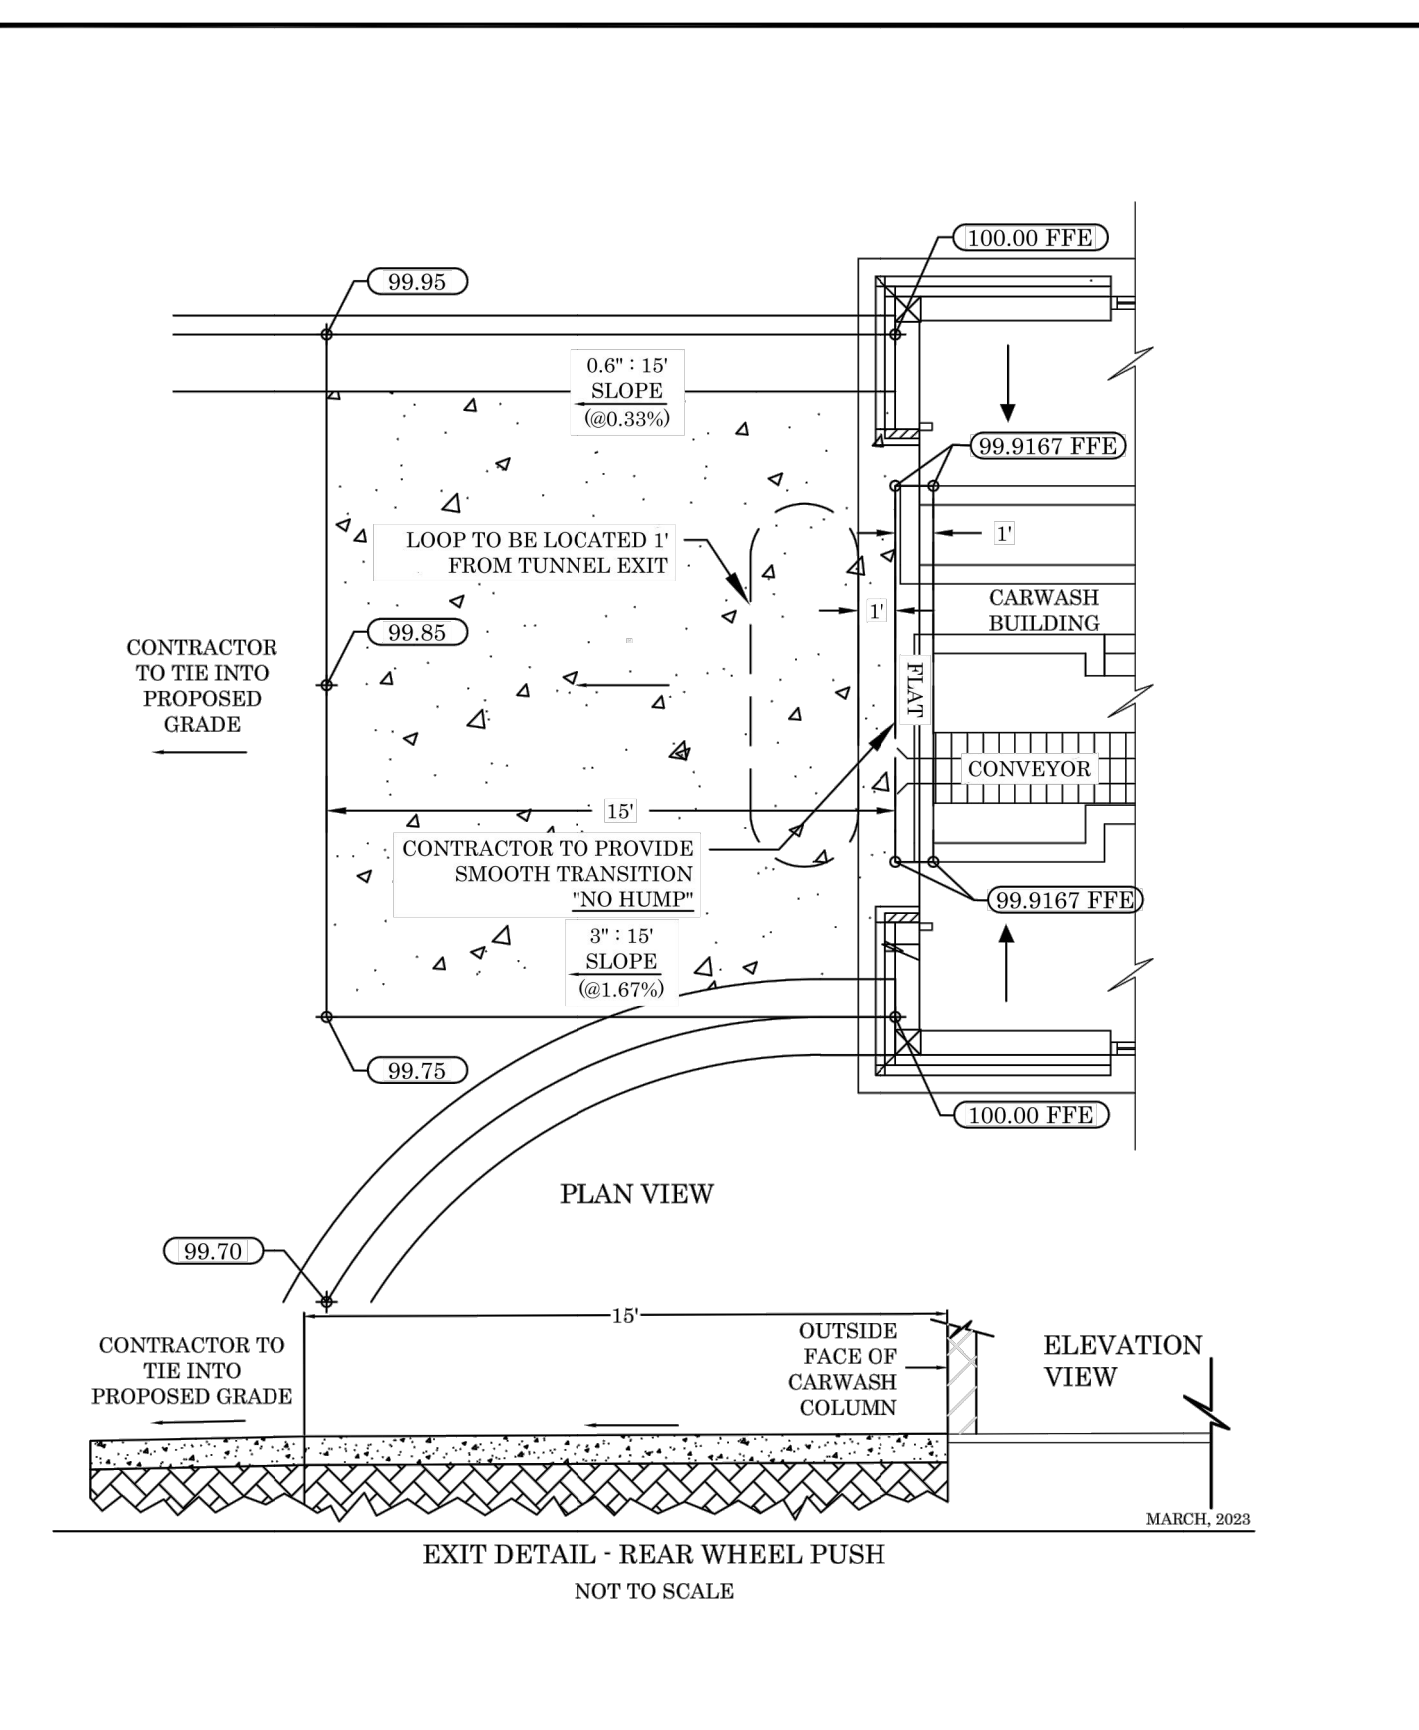


TECHNICAL CRITERIA	
DATE OF PLANS	03/15/2023
NOT TO SCALE	NOT TO SCALE

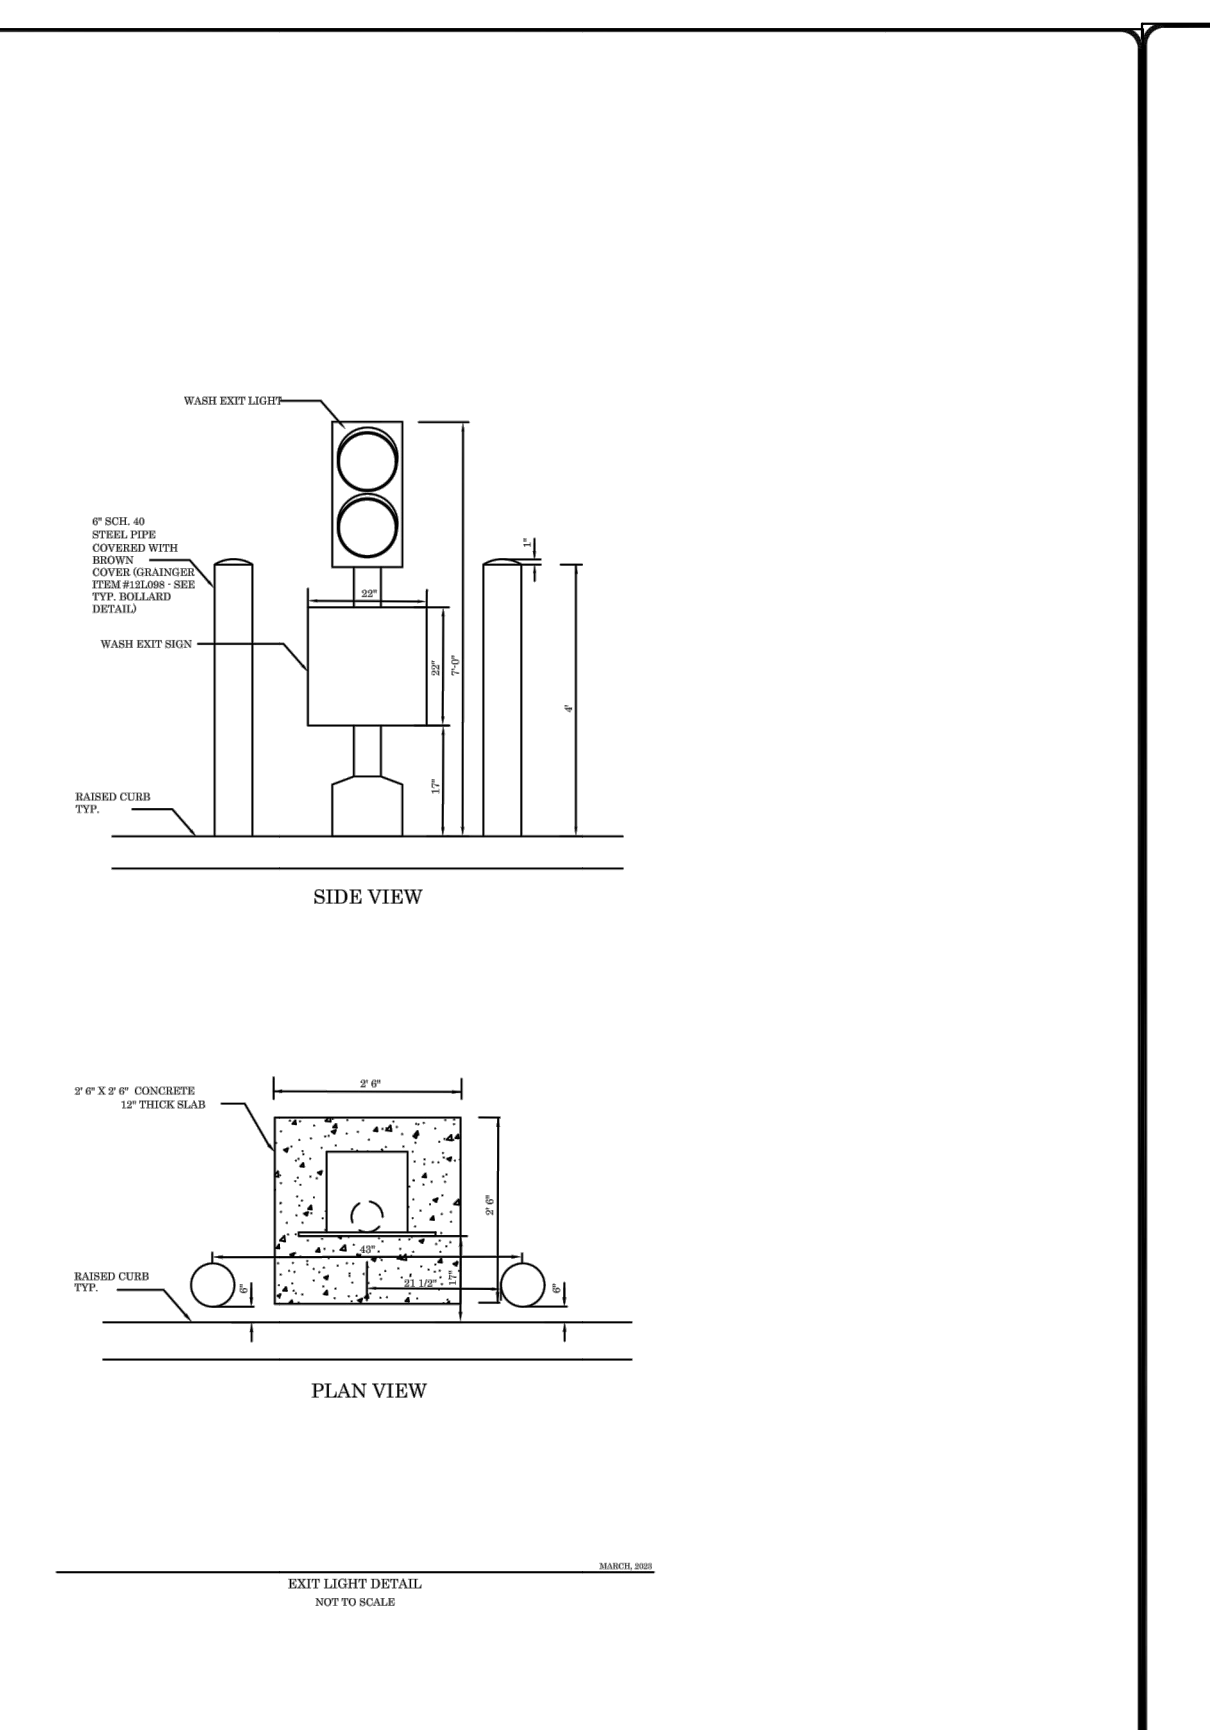


TECHNICAL CRITERIA	
DATE OF PLANS	03/15/2023
NOT TO SCALE	NOT TO SCALE

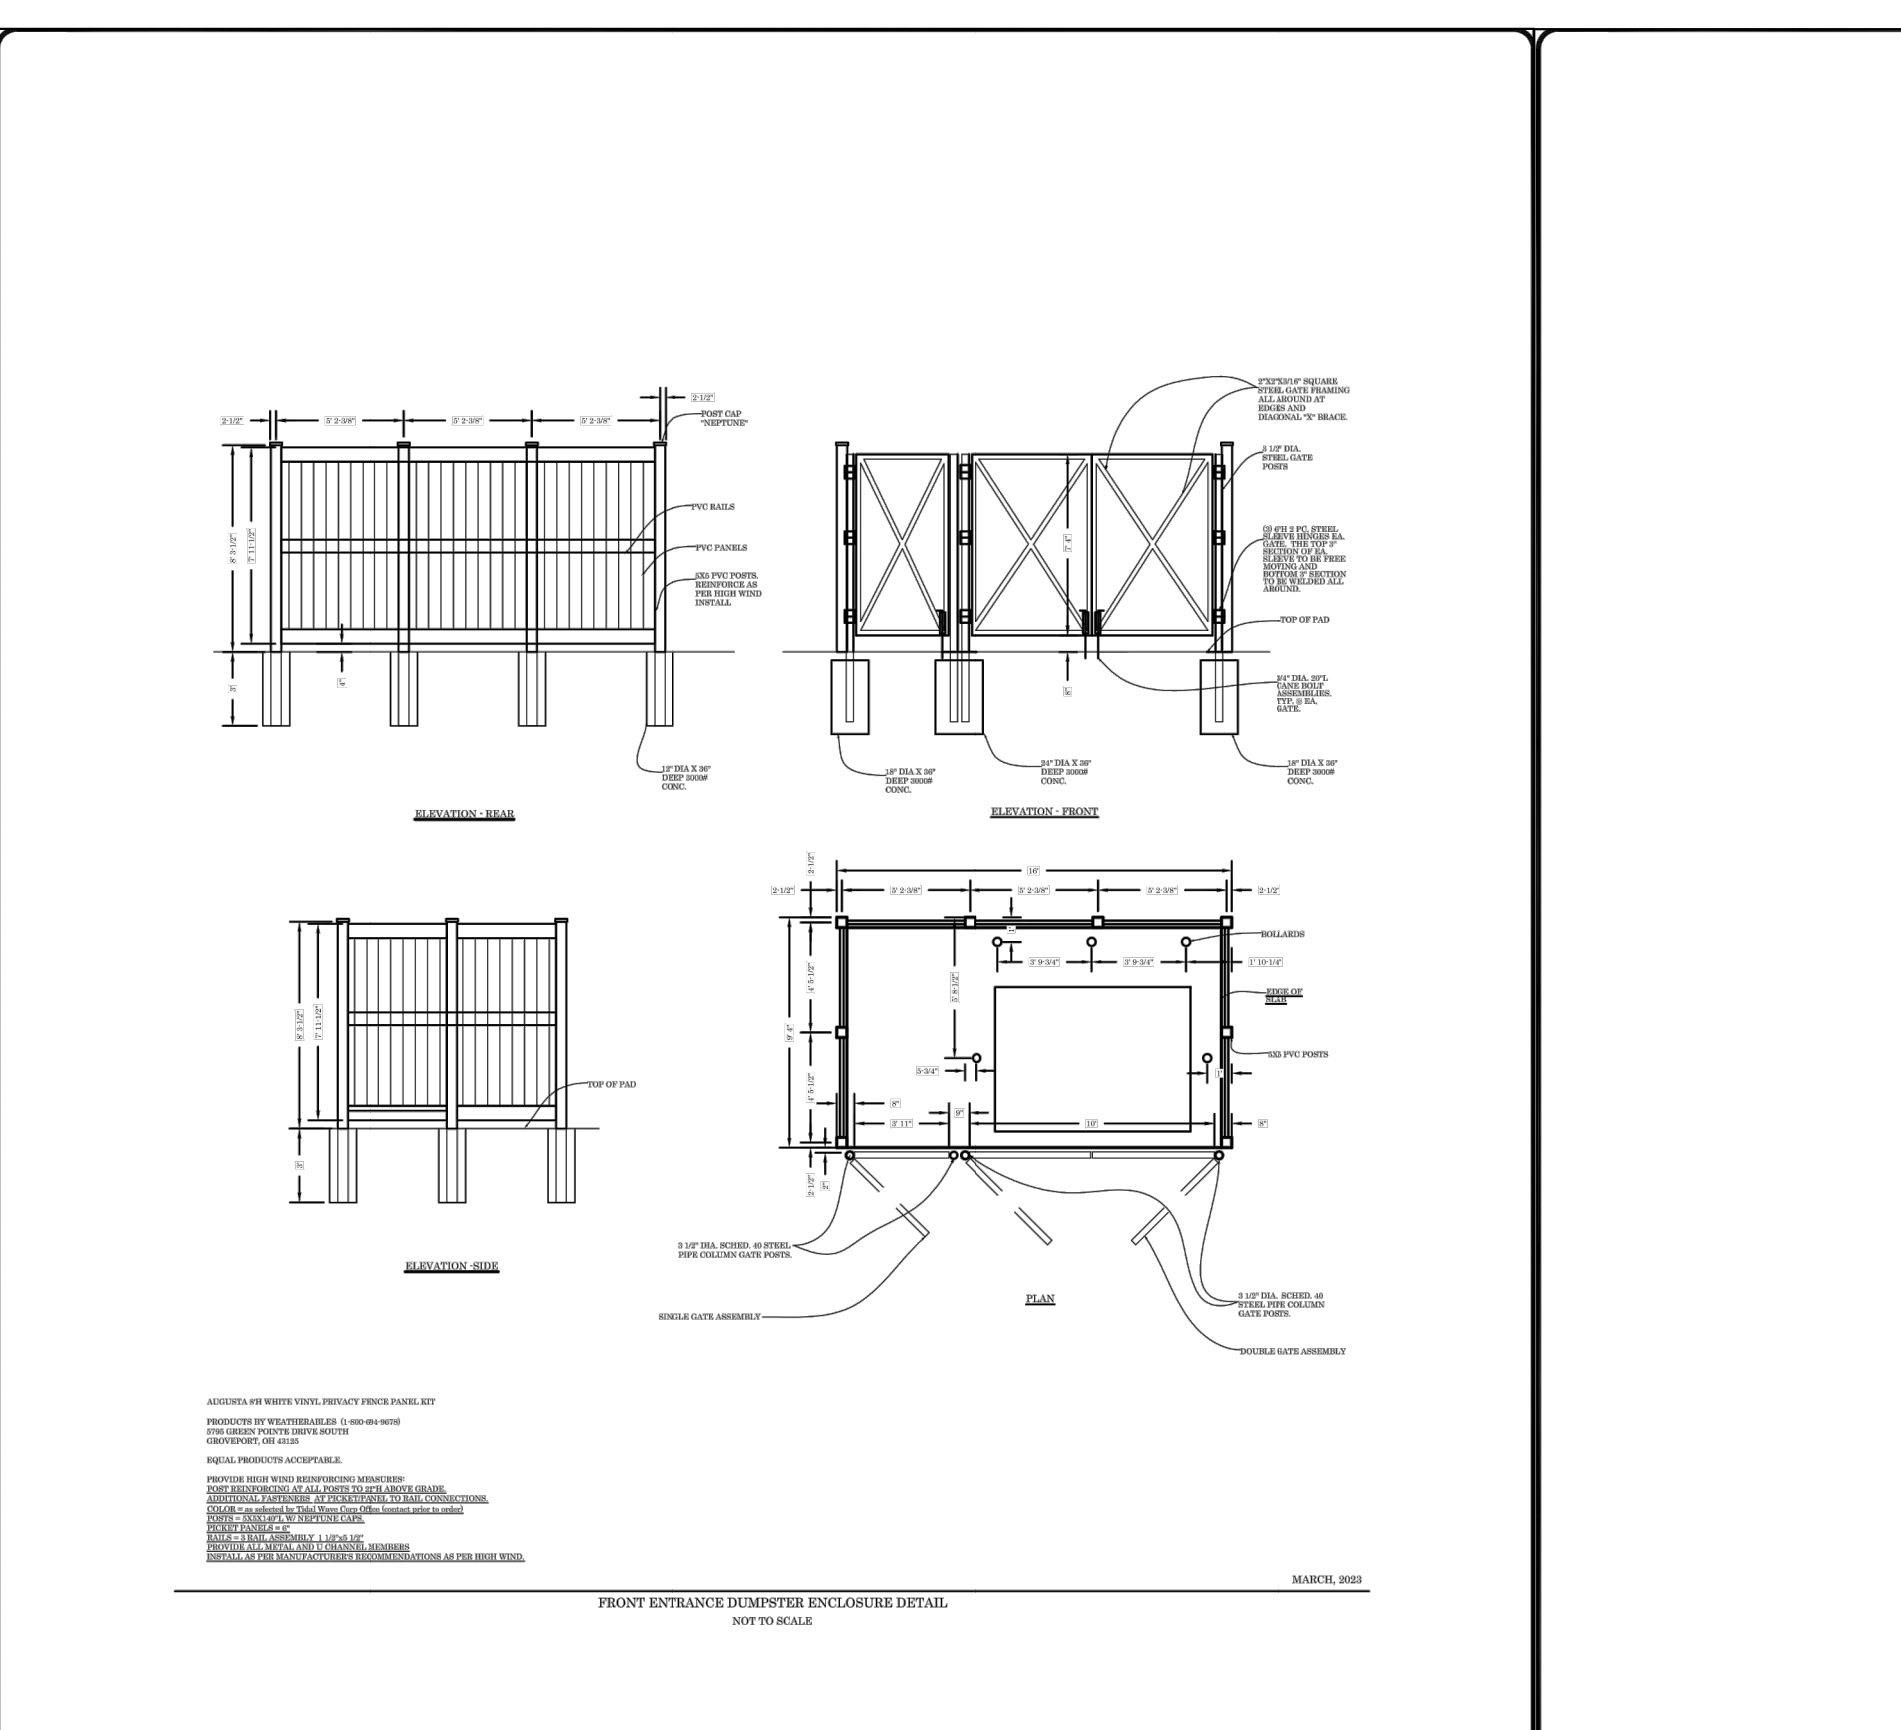

TECHNICAL CRITERIA	
DATE OF PLANS	03/15/2023
NOT TO SCALE	NOT TO SCALE

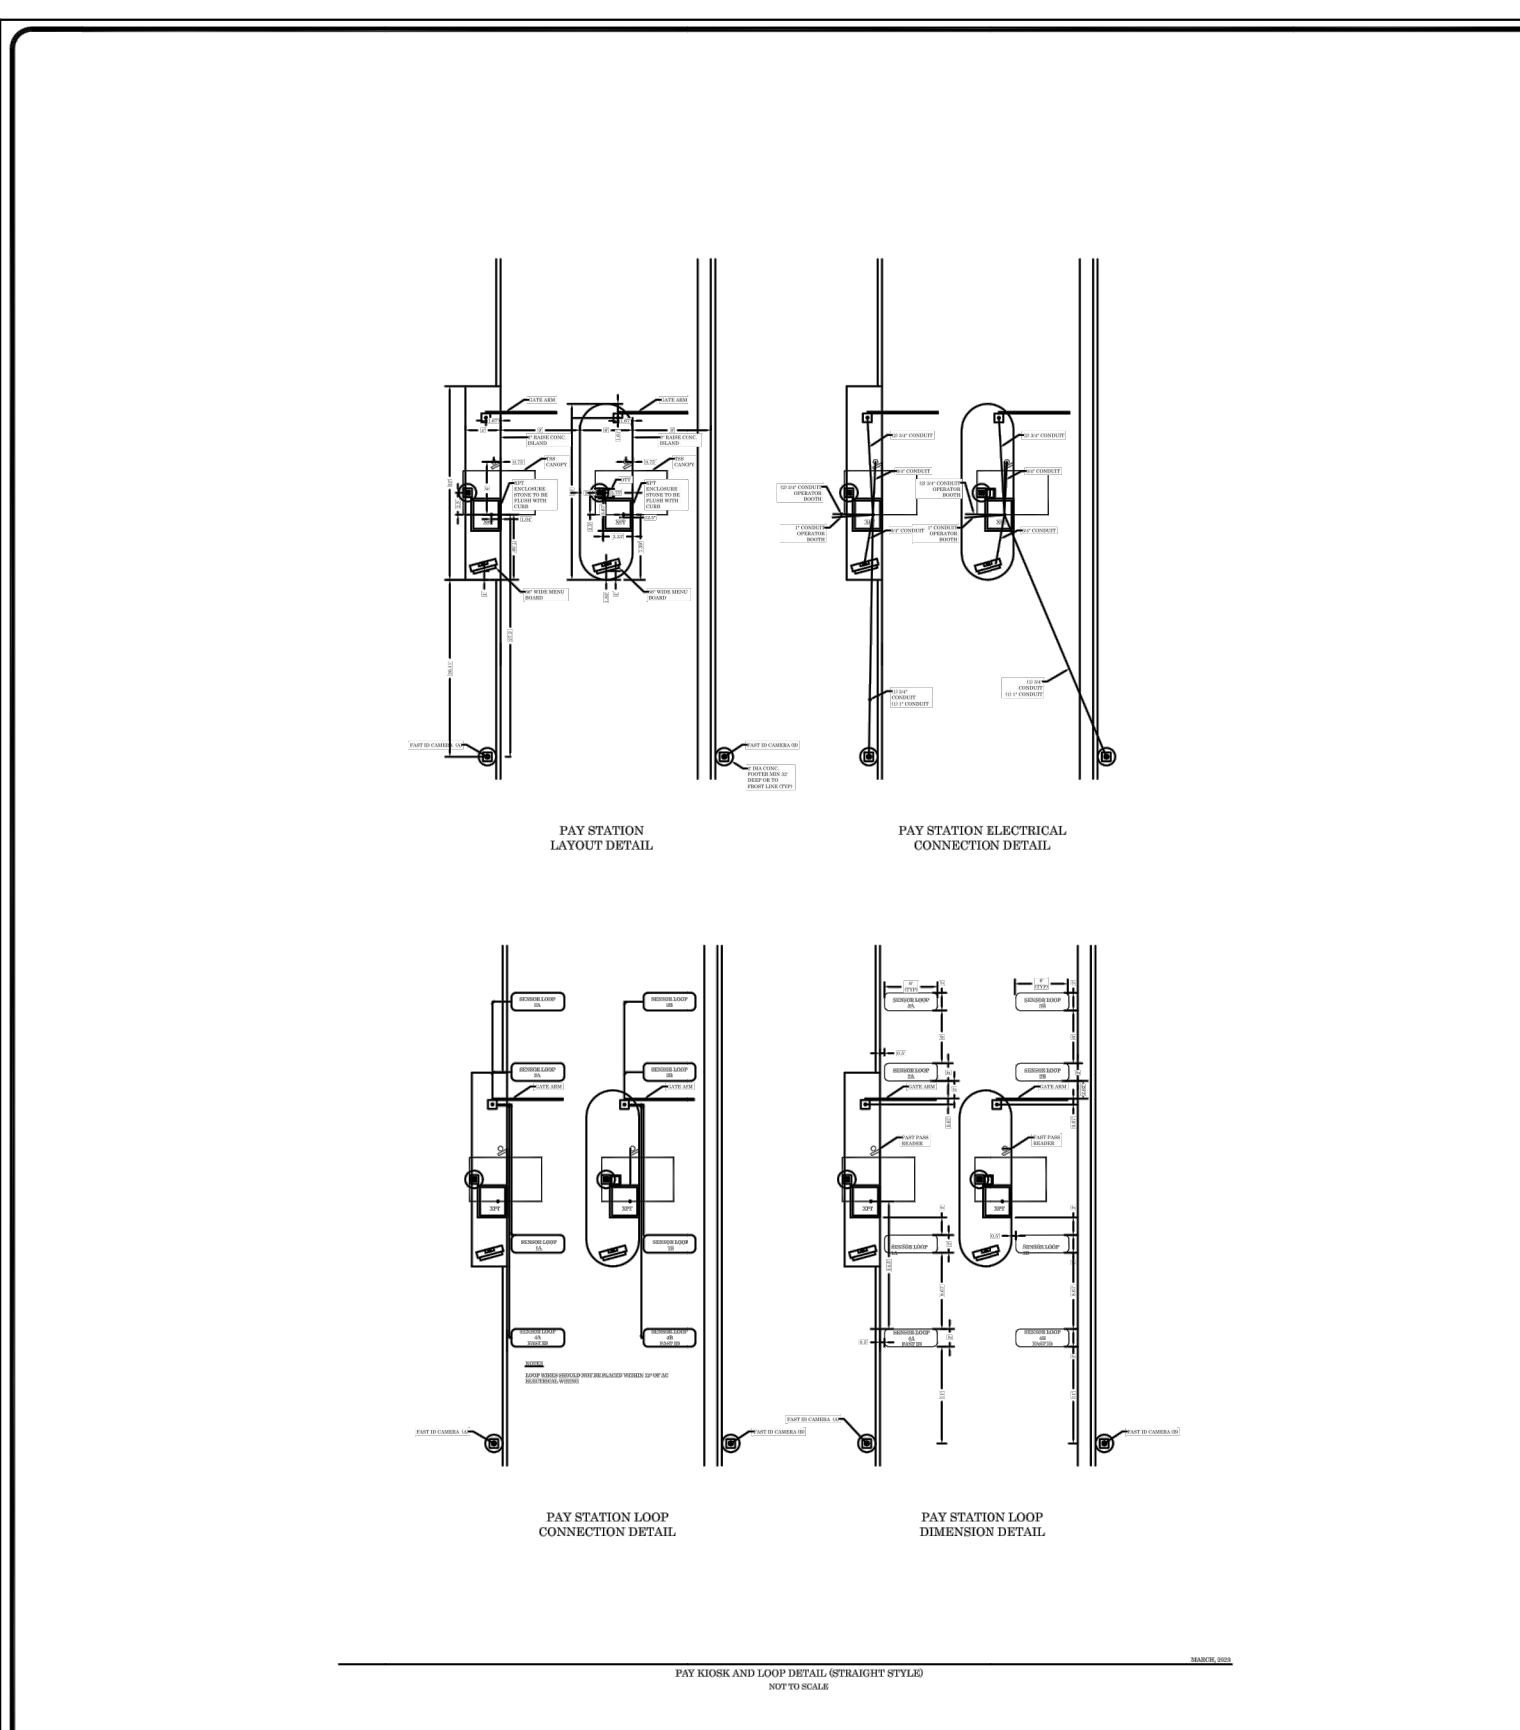

TECHNICAL CRITERIA	
DATE OF PLANS	03/31/2023
NOT TO SCALE	NOT TO SCALE

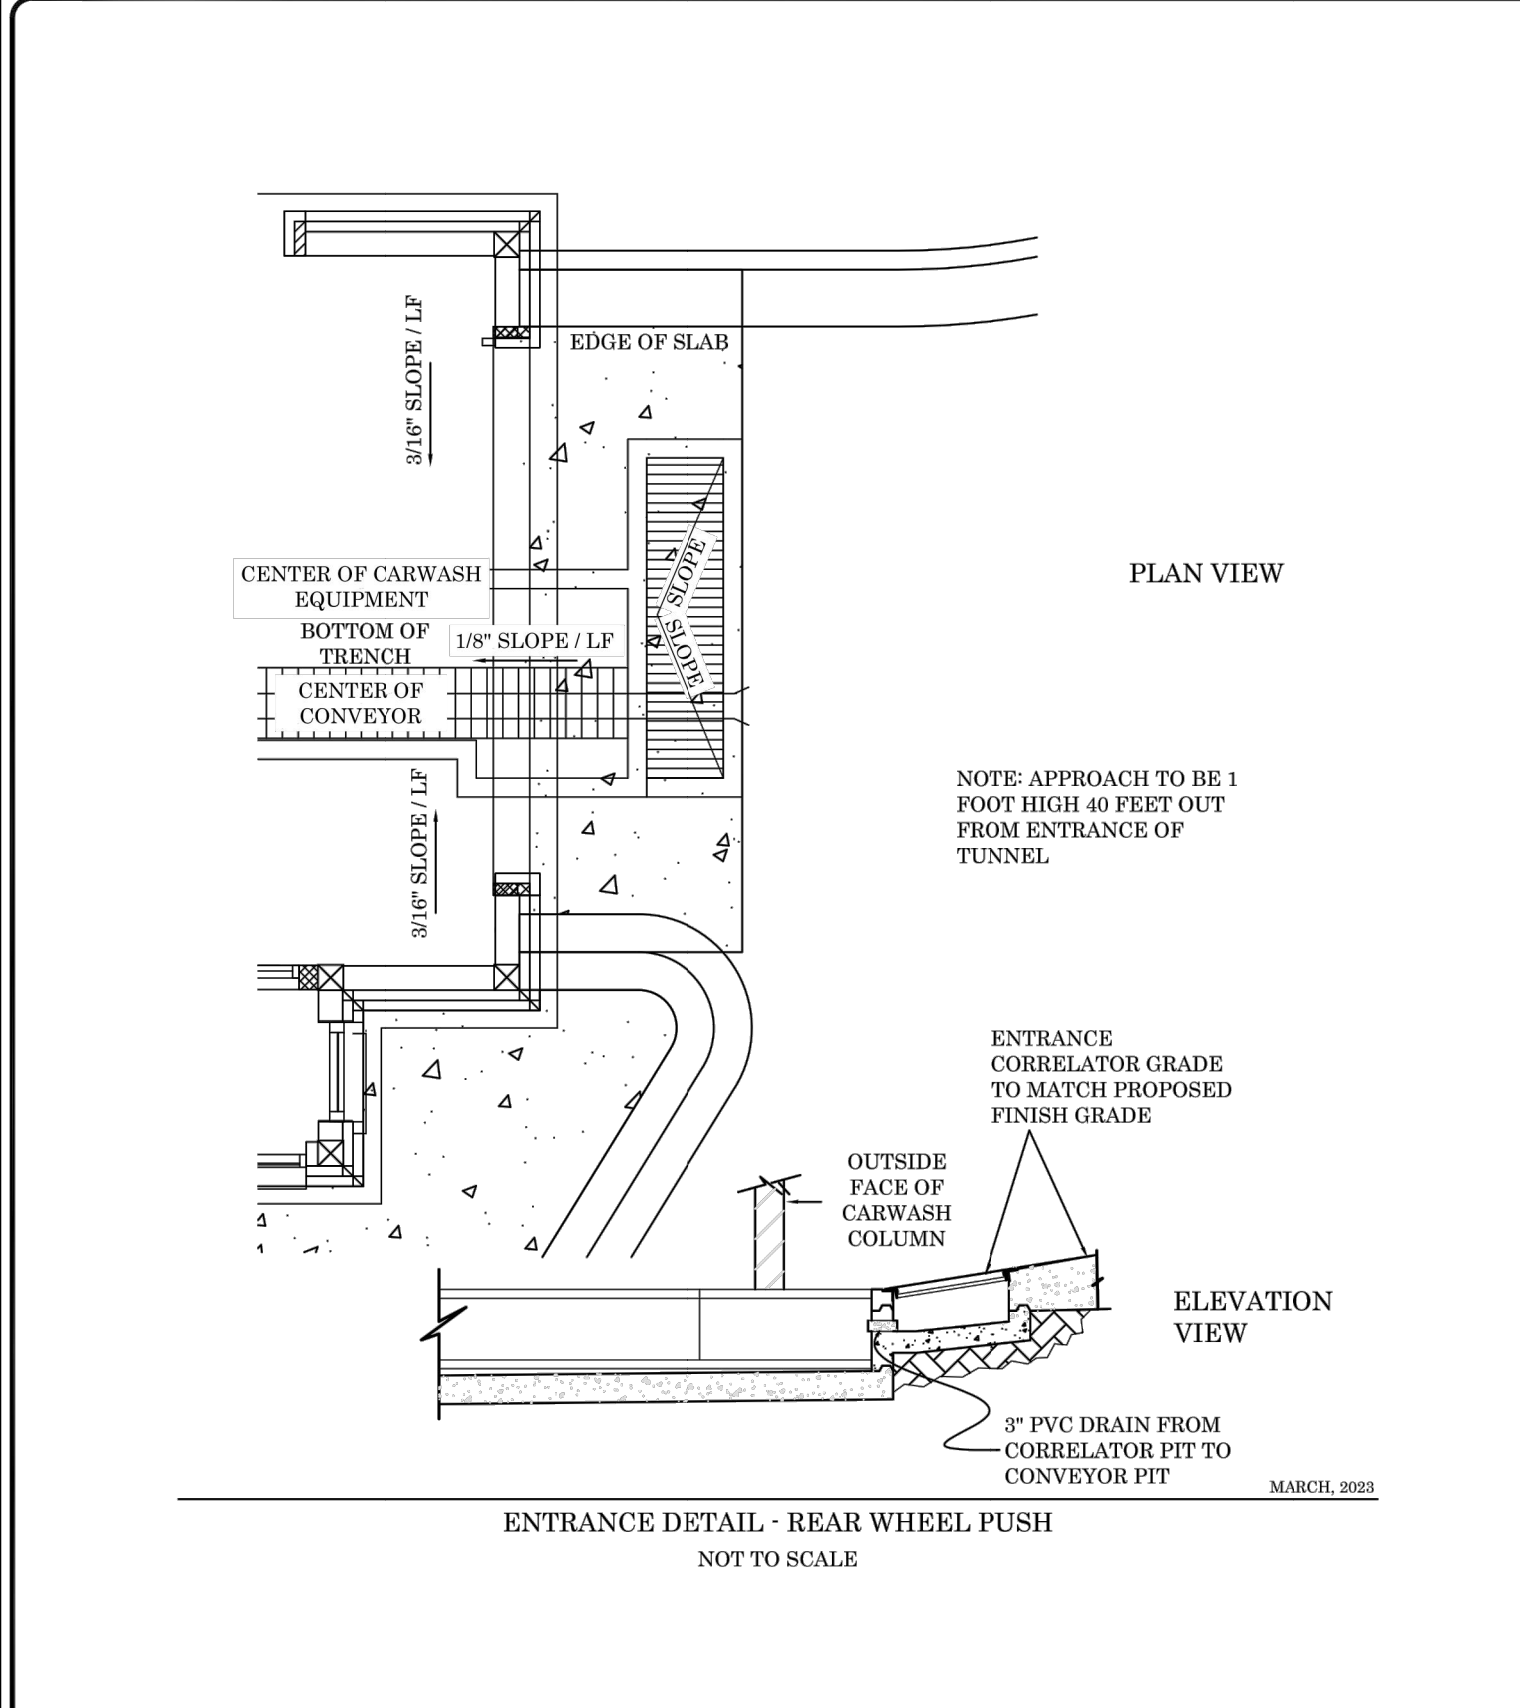

TECHNICAL CRITERIA	
DATE OF PLANS	03/15/2023
NOT TO SCALE	NOT TO SCALE

SAND-OIL INTERCEPTOR SCHEDULE

MODEL NO.	CAPACITY US (GAL)	OIL CAP. (LBS)	GRIT CAP. (GPM)	EMPTY WT (LBS)	LENGTH L1	WIDTH W1	HEIGHT HI	INLET FL1	OUTLET FL2
GO-500	500	250	2950	50	9,500	7'-10"	4'-4"	4'-6"	3'-3"
GO-750	750	375	2950	75	9,900	7'-10"	4'-4"	6'-0"	4'-2"
GO-1000	1,000	500	3950	100	13,350	8'-8"	5'-0"	6'-0"	4'-9"
GO-1500	1,500	750	4600	150	16,050	9'-2"	5'-8"	7'-0"	5'-9"
GO-2000	2,000	1,000	4600	200	21,250	9'-0"	6'-0"	8'-0"	6'-6"

OTHER SIZES ARE AVAILABLE. CONTACT US FOR MORE INFORMATION.

APPLICATIONS

- PARKING GARAGE PRESSURE WASHING
- GENERAL INDUSTRY
- EQUIPMENT & TRANSPORTATION WASHDOWN FACILITIES
- CARWASHES
- FIRE STATION WASHDOWN
- SERVICE STATION FUEL DEPOSITS
- MANUFACTURING FACILITY EFFLUENT WATER
- CITY MAINTENANCE WASHDOWN


GUARANTEED PERFORMANCE
 A certified performance analysis utilizing a proprietary computer program will accurately model systems to ensure that their effluent qualities meet the required discharge criteria (EPA and Local Codes)

Influent oily water contains oil droplets of many different sizes. These droplets rise at different rates. Park utilizes a statistical program that divides the droplets into ranges of sizes and calculates the rise rates of each range. This calculation determines which droplets the separator can capture.

Contact our Engineering Dept. @ 888-611-PARK for a free performance evaluation.

<p>Specifications</p> <p>CONCRETE: Class 1/1 concrete with design strength of 4500 psi at 28 days. Unit is of monolithic construction at floor and first stage of wall with sectional riser to required depth.</p> <p>REINFORCEMENT: Grade 60 reinforced with steel rebar conforming to ASTM A615 on required centers or equal.</p> <p>MATERIALS: Access frame & cover shall be fabricated with min. 1/4" thick nonskid floor plate, ball-down, & lifting handles. All materials to be corrosion resistant.</p> <p>Engineering Data Interceptor is structurally and hydraulically engineered conforming to Uniform Plumbing Code. Nominal total liquid capacity and oil holding capacity as indicated. Recommended for flow rates of 5 to 180 GPM (consult Park for proper sizing). Manufacturer shall submit performance calculations for oil & water separation certified by a licensed professional engineer. Field excavation and preparation shall be completed prior to delivery of interceptor.</p>	<p>PROJECT:</p> <p>CUSTOMER:</p> <p>ENGINEER:</p> <p>ORDER #:</p> <p>PROJ #:</p> <p>DATE:</p>
<p>888.611.PARK www.parkusa.com</p> <p>PARK DESIGN FOR WATER</p> <p>GO Trooper Grit Oil Interceptor</p> <p>Grit Oil Interceptor Model GO Sizes 500 thru 2000</p>	
<p>PM DRN ENG</p> <p>DATE 2018</p>	<p>REV. A</p> <p>DATE 2018</p>



501 WANDO PARK BOULEVARD, SUITE 200 | MOUNT PLEASANT, SC 29546 | JUDSON MILLS BUILDING 6000, 701 EASLEY BRIDGE RD, SUITE 6000, GREENVILLE, SC 29611, 713 N. CEDAR STREET | SUMMERVILLE, SC 29585 | 104 N. DANIEL MCGREGAN AVENUE, SUITE 300 | SPARTANBURG, SC 29301
 © COPYRIGHT © SEAMON WHITESIDE & ASSOCIATES, INC. | THIS DRAWING SHALL NOT BE REPRODUCED IN ANY MANNER WITHOUT WRITTEN PERMISSION.

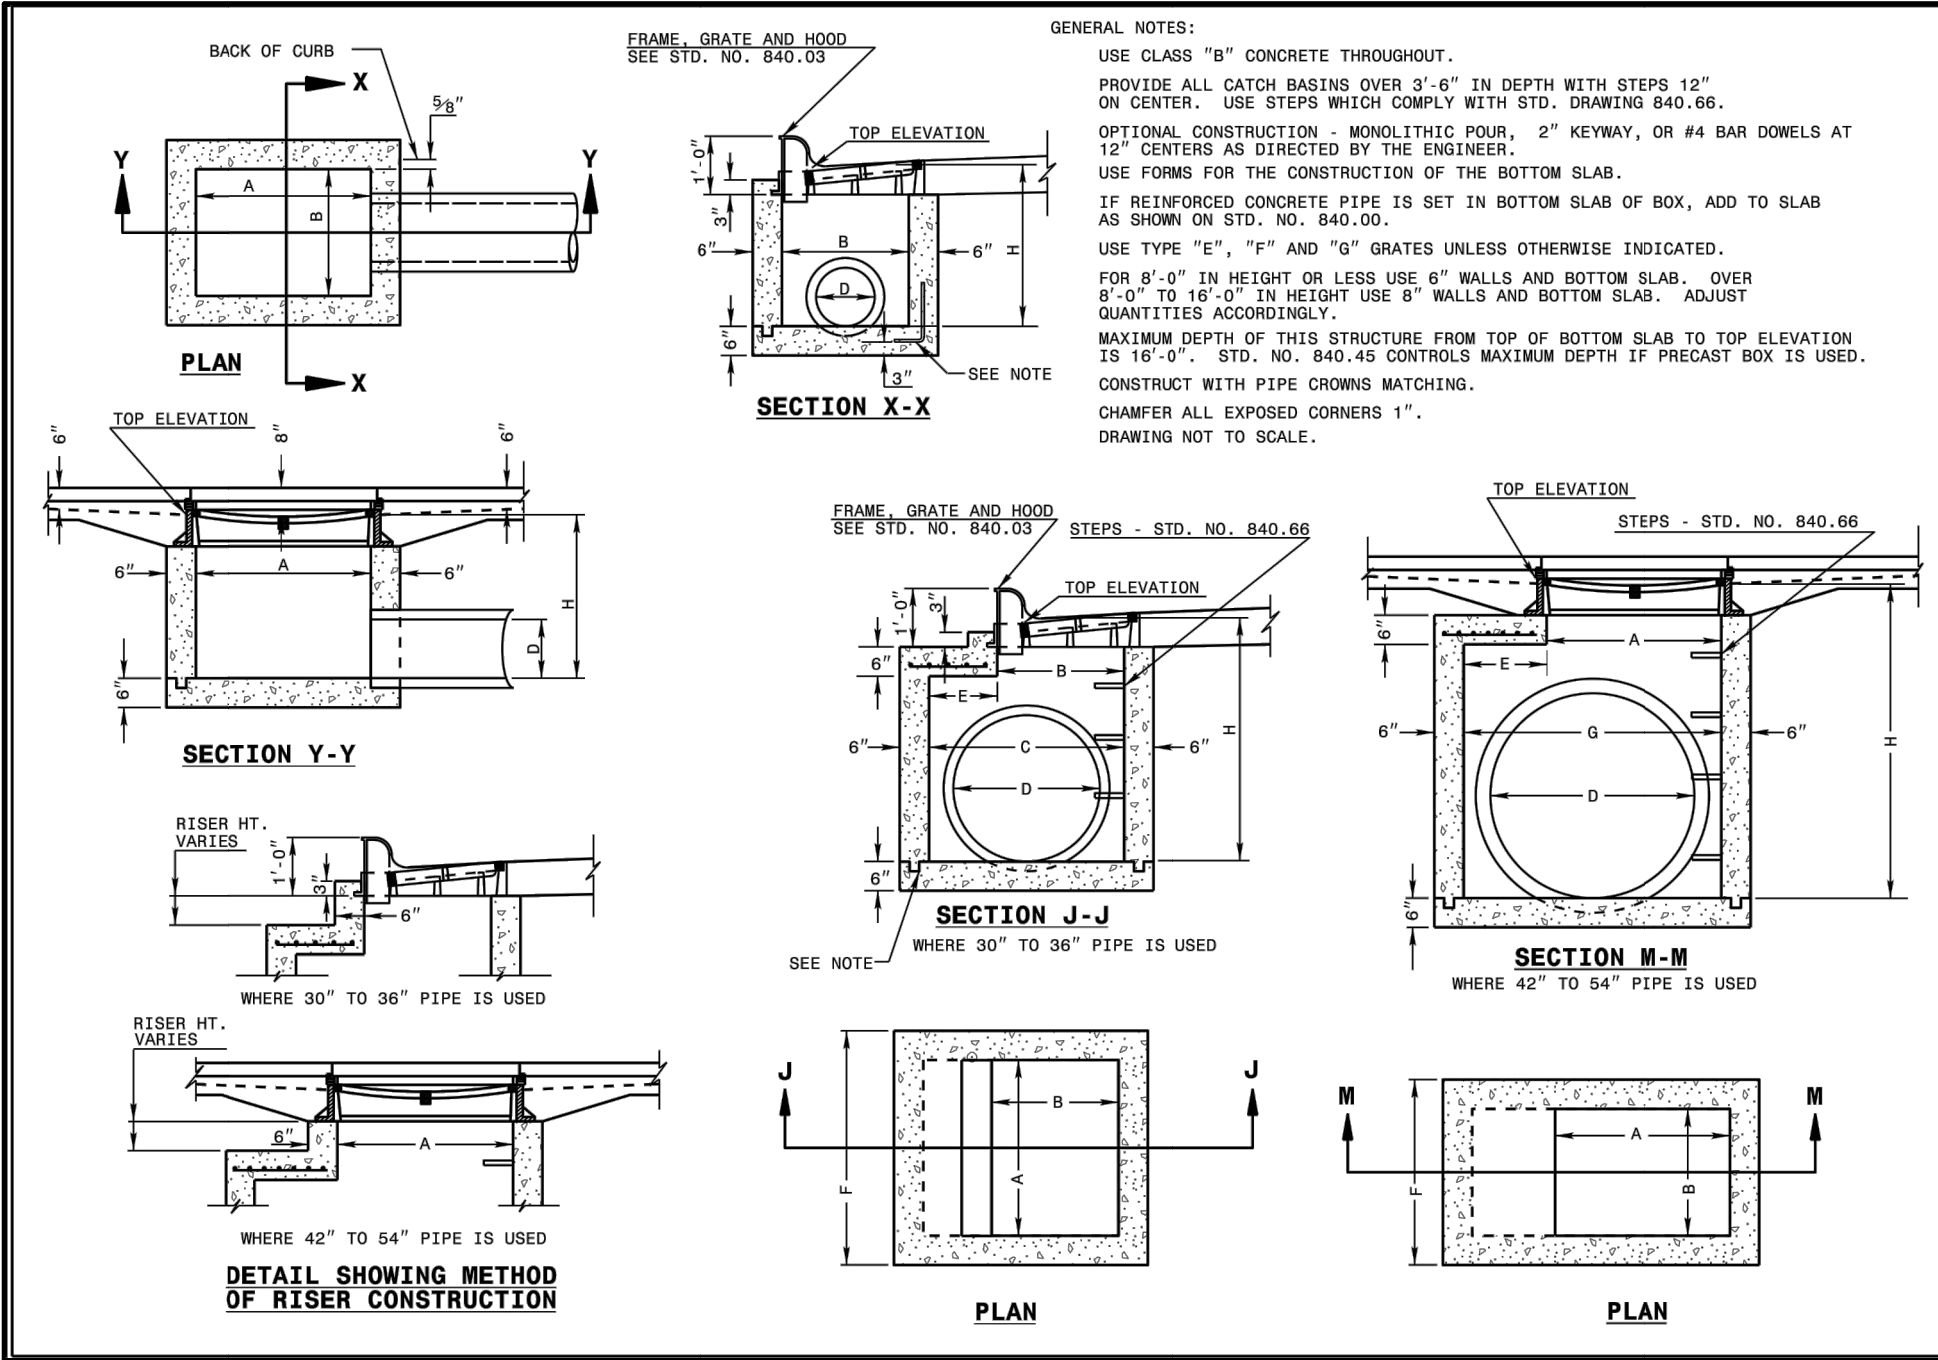

STATE OF NORTH CAROLINA
DEPT. OF TRANSPORTATION
DIVISION OF HIGHWAYS
RALEIGH, N.C.

ROADWAY STANDARD DRAWING FOR
CONCRETE CATCH BASIN
12" THRU 34" PIPE


SHEET 1 OF 2
840.02

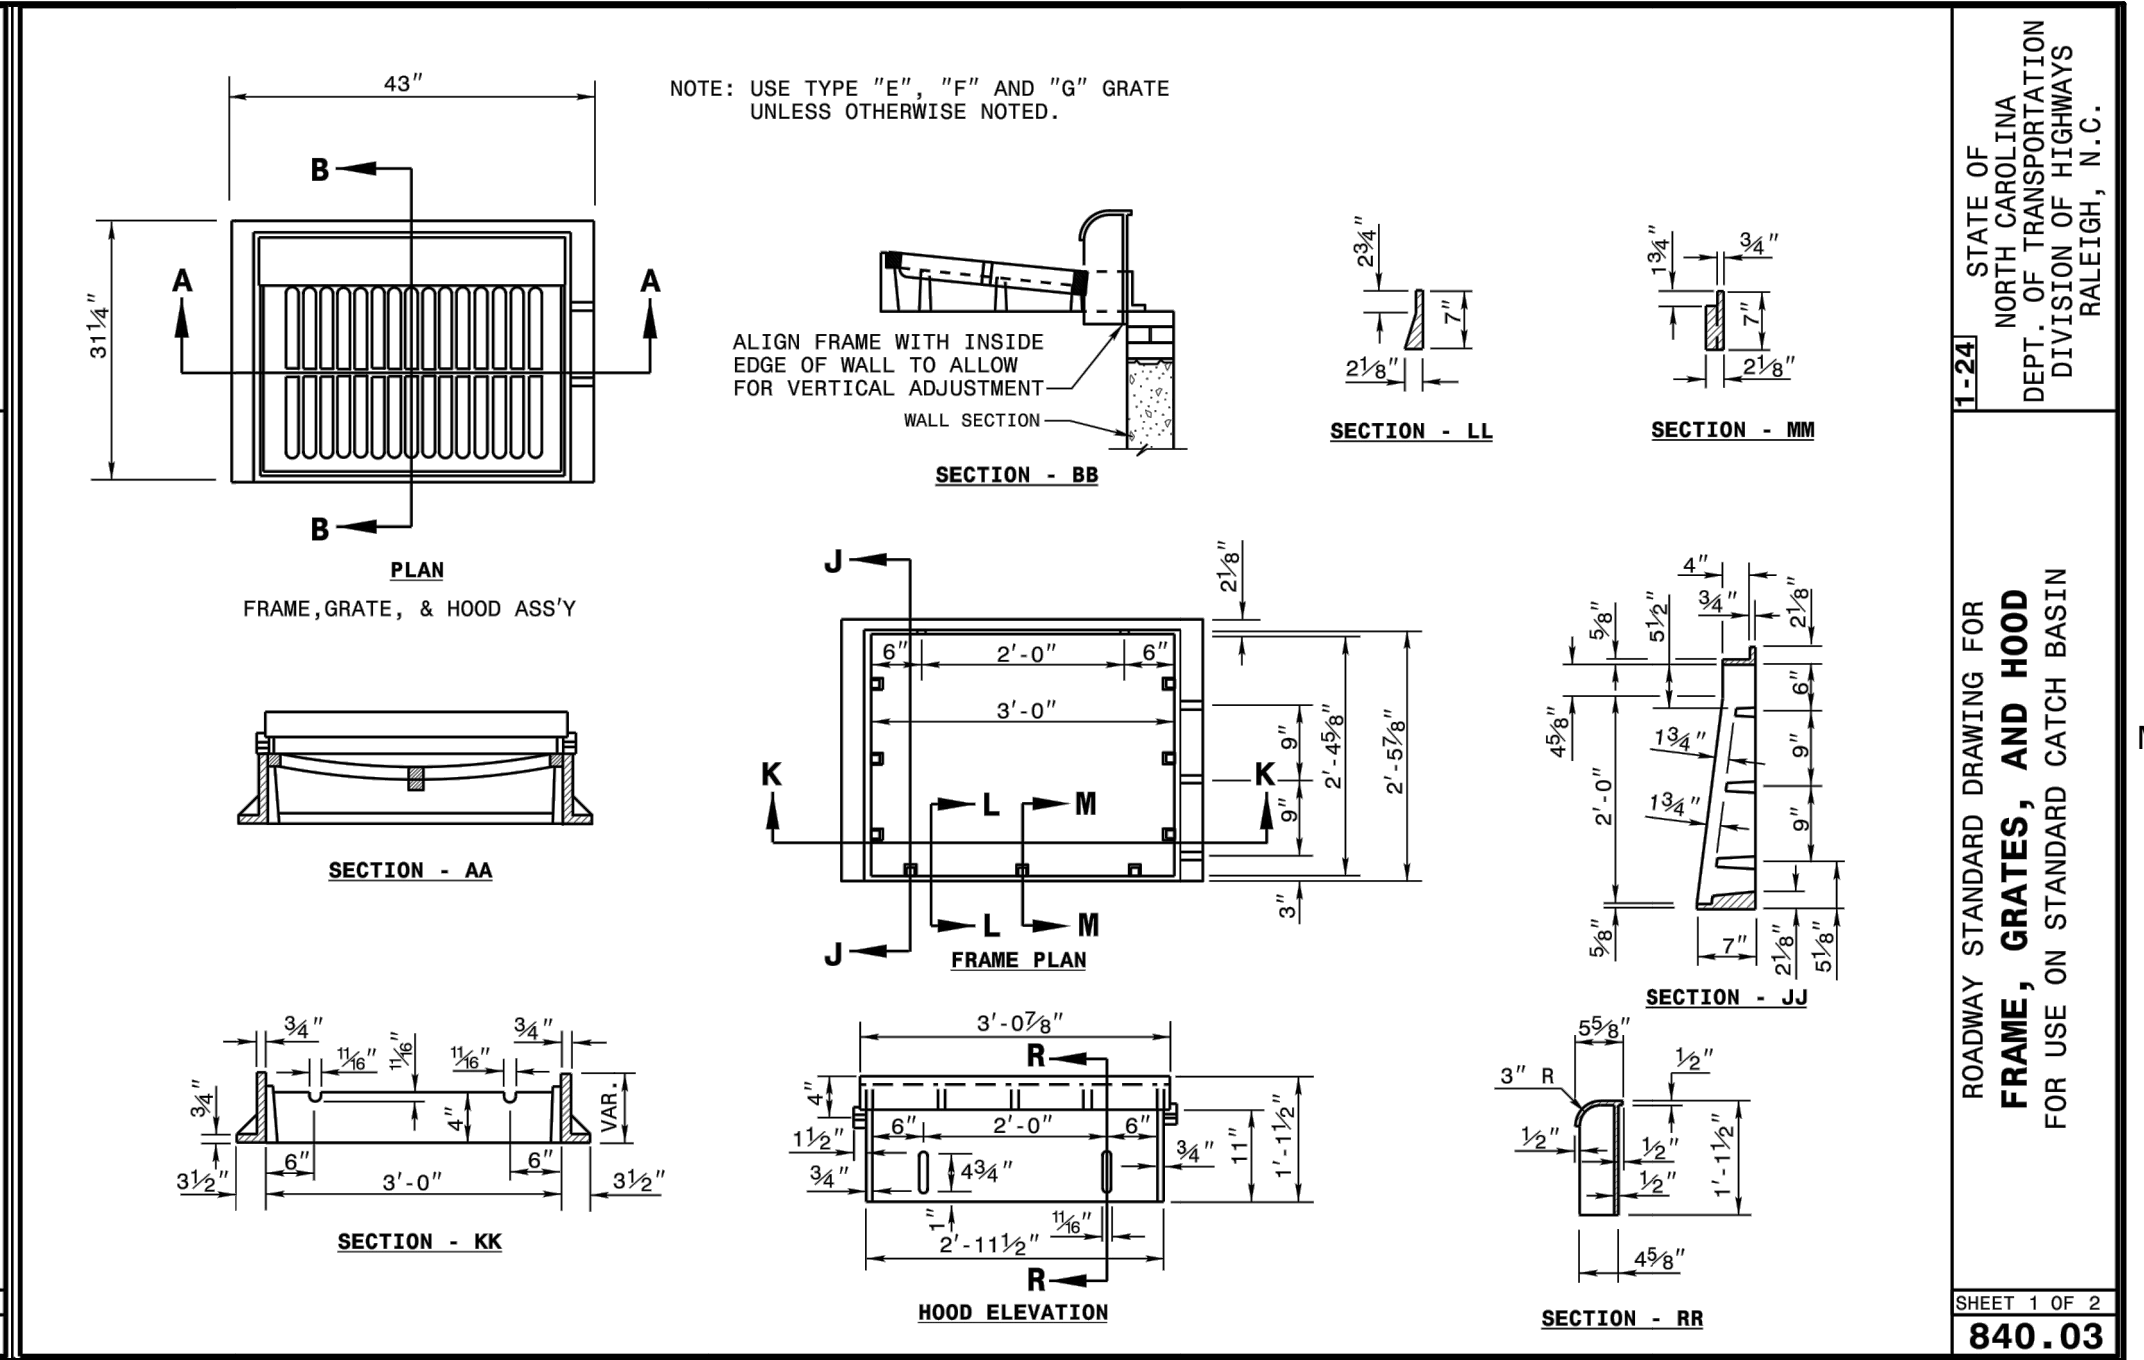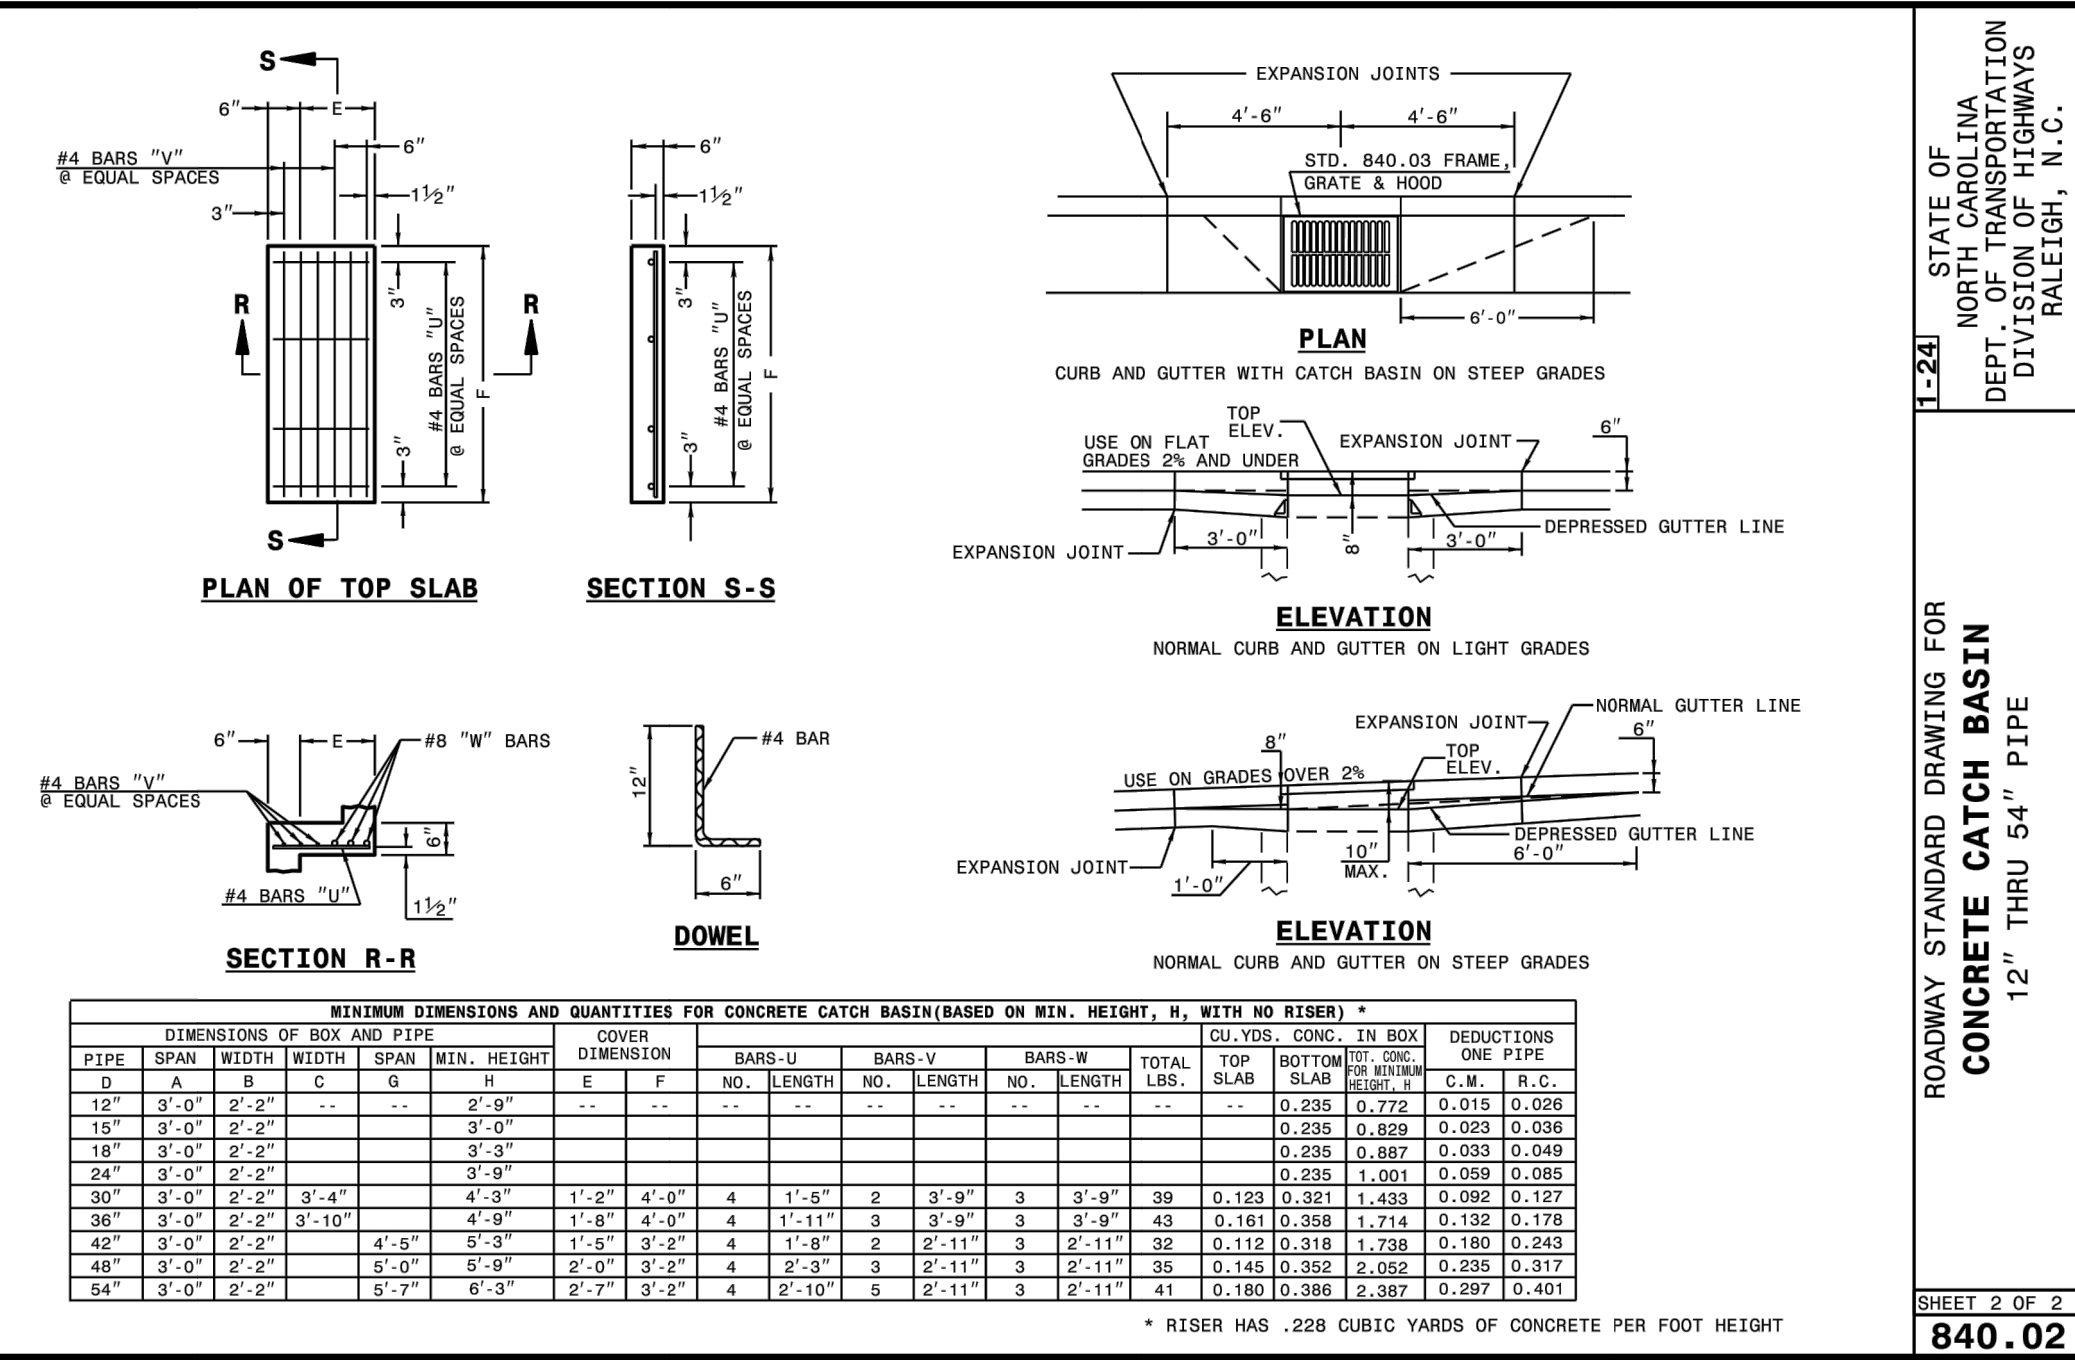

STATE OF NORTH CAROLINA
DEPT. OF TRANSPORTATION
DIVISION OF HIGHWAYS
RALEIGH, N.C.

ROADWAY STANDARD DRAWING FOR
CONCRETE CATCH BASIN
12" THRU 54" PIPE



SHEET 2 OF 2
840.02

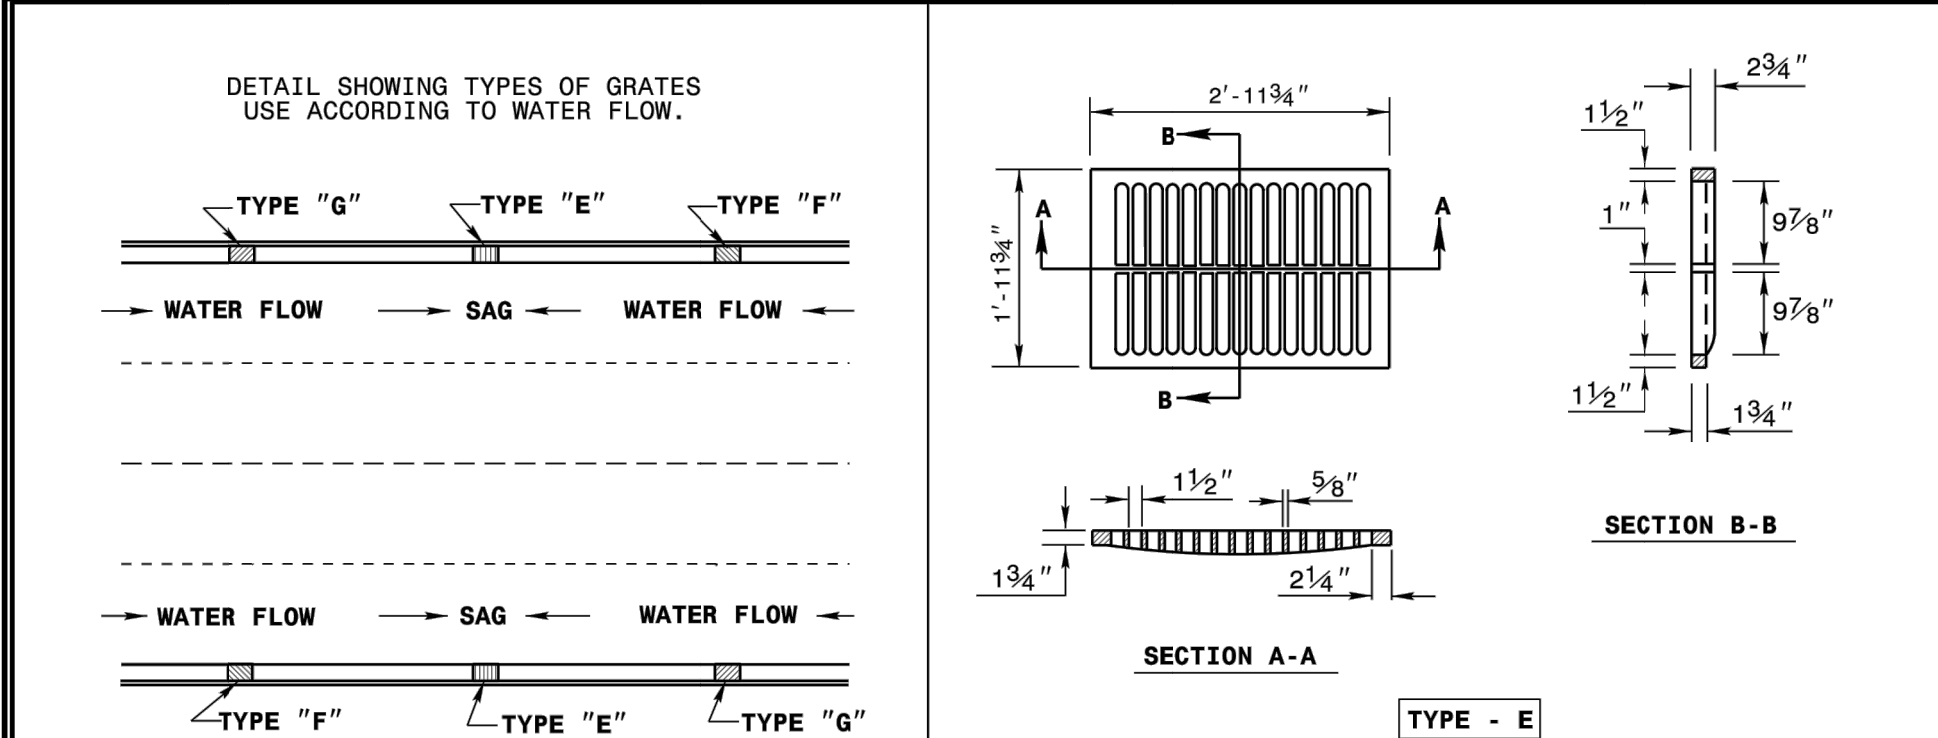

STATE OF NORTH CAROLINA
DEPT. OF TRANSPORTATION
DIVISION OF HIGHWAYS
RALEIGH, N.C.

ROADWAY STANDARD DRAWING FOR
FRAME, GRATE, AND HOOD
FOR USE ON STANDARD CATCH BASIN


SHEET 2 OF 2
840.03

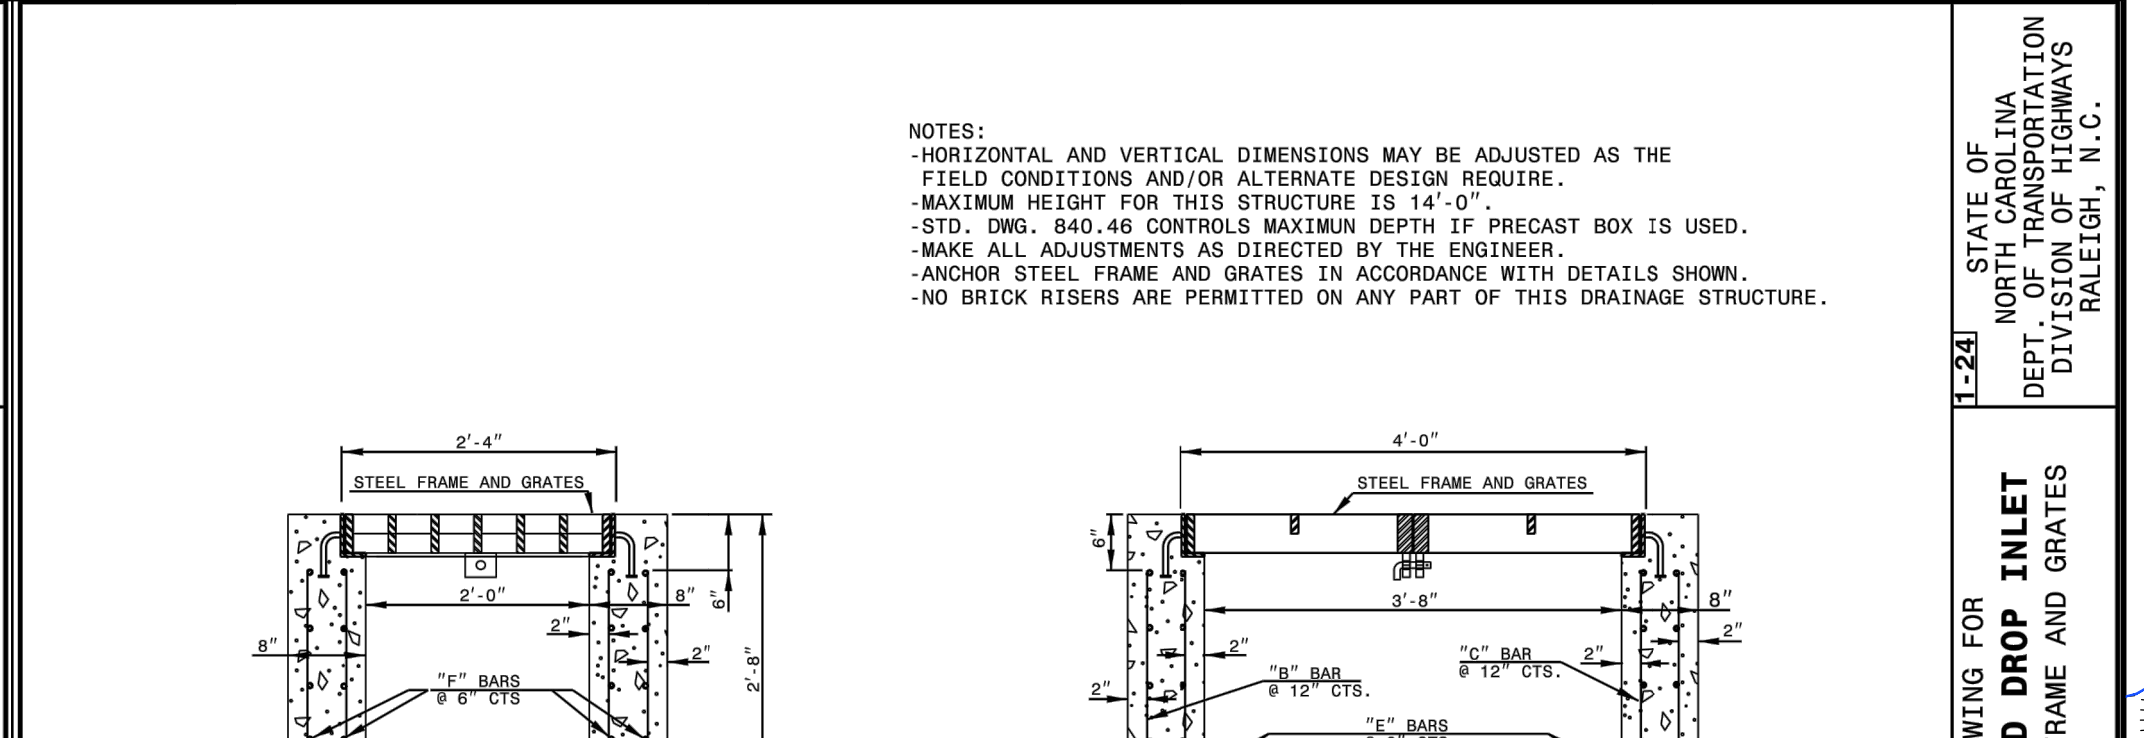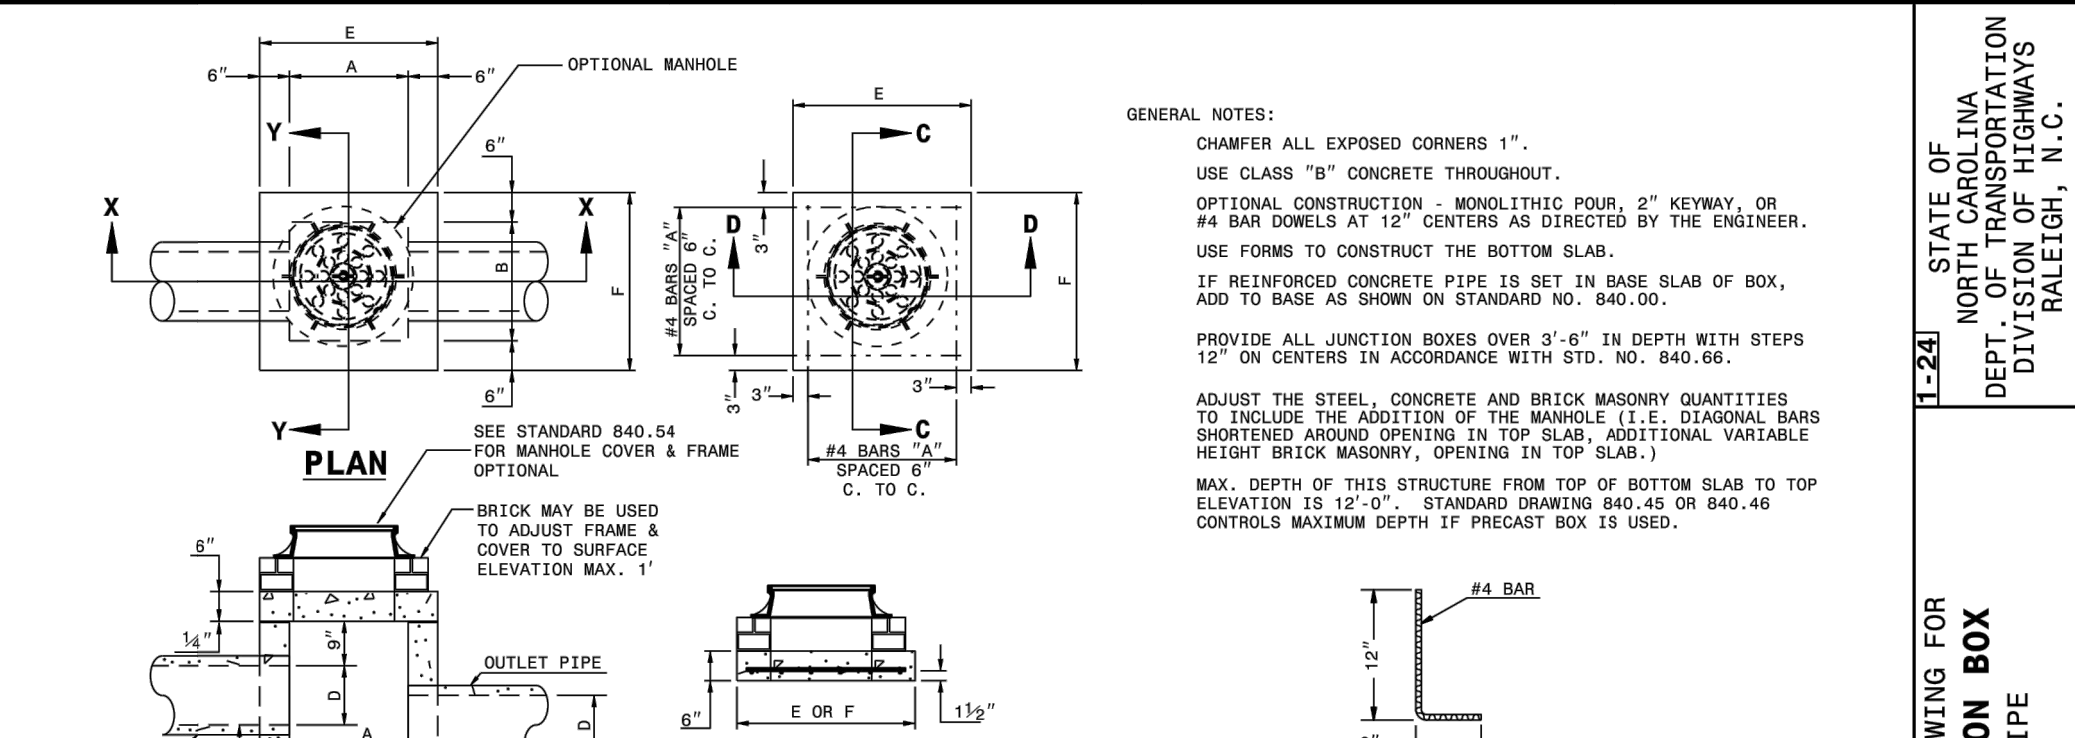

STATE OF NORTH CAROLINA
DEPT. OF TRANSPORTATION
DIVISION OF HIGHWAYS
RALEIGH, N.C.

ROADWAY STANDARD DRAWING FOR
TRAFFIC BEARING GRATED DROP INLET
FOR STEEL (840.37) DOUBLE FRAME AND GRATES



SHEET 1 OF 2
840.36

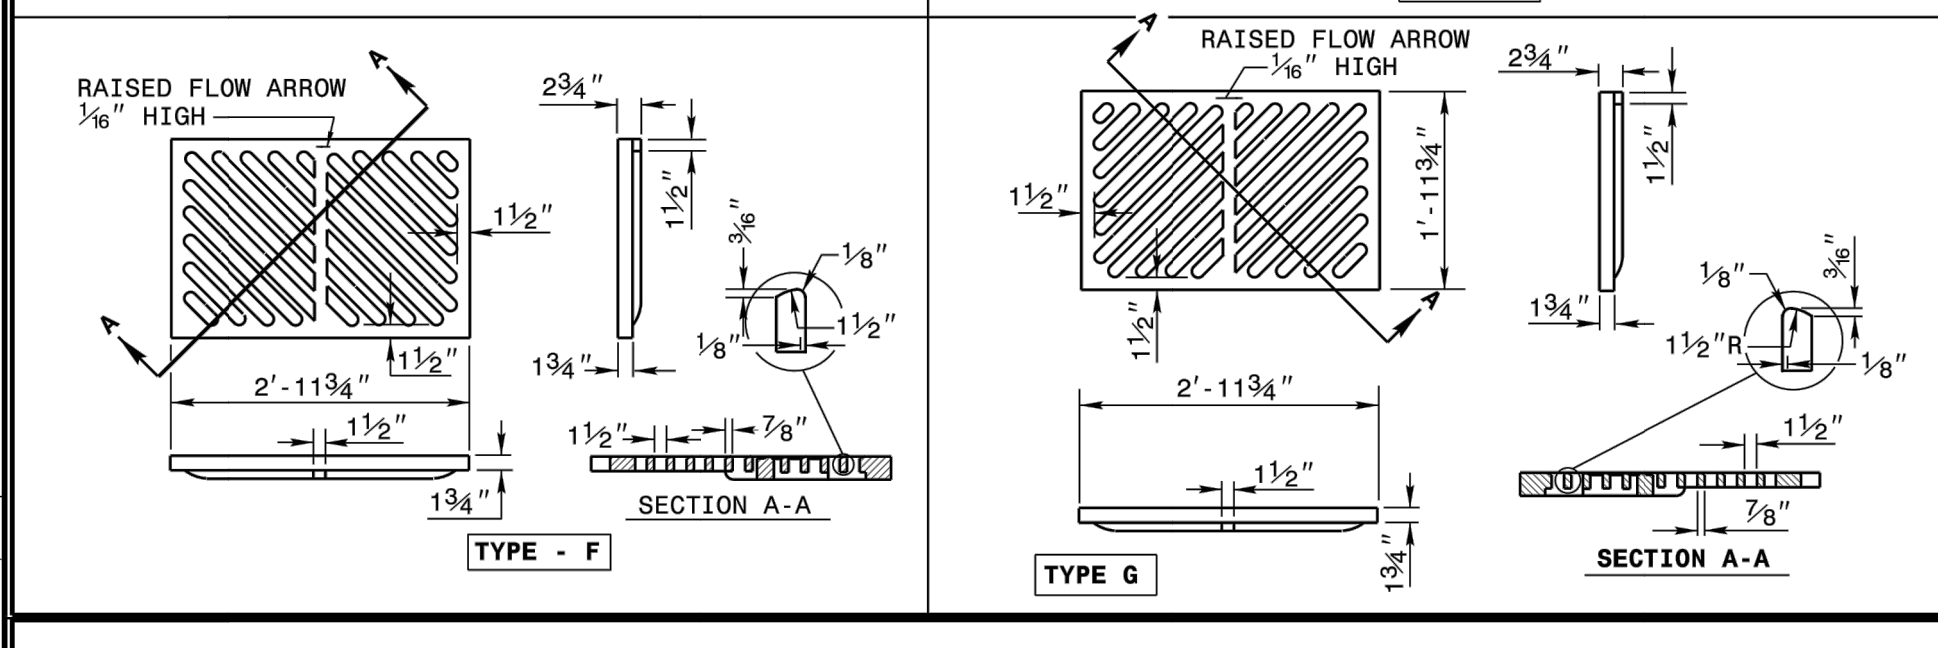

STATE OF NORTH CAROLINA
DEPT. OF TRANSPORTATION
DIVISION OF HIGHWAYS
RALEIGH, N.C.

ROADWAY STANDARD DRAWING FOR
TRAFFIC BEARING GRATED DROP INLET
FOR STEEL (840.37) DOUBLE FRAME AND GRATES


SHEET 2 OF 2
840.03

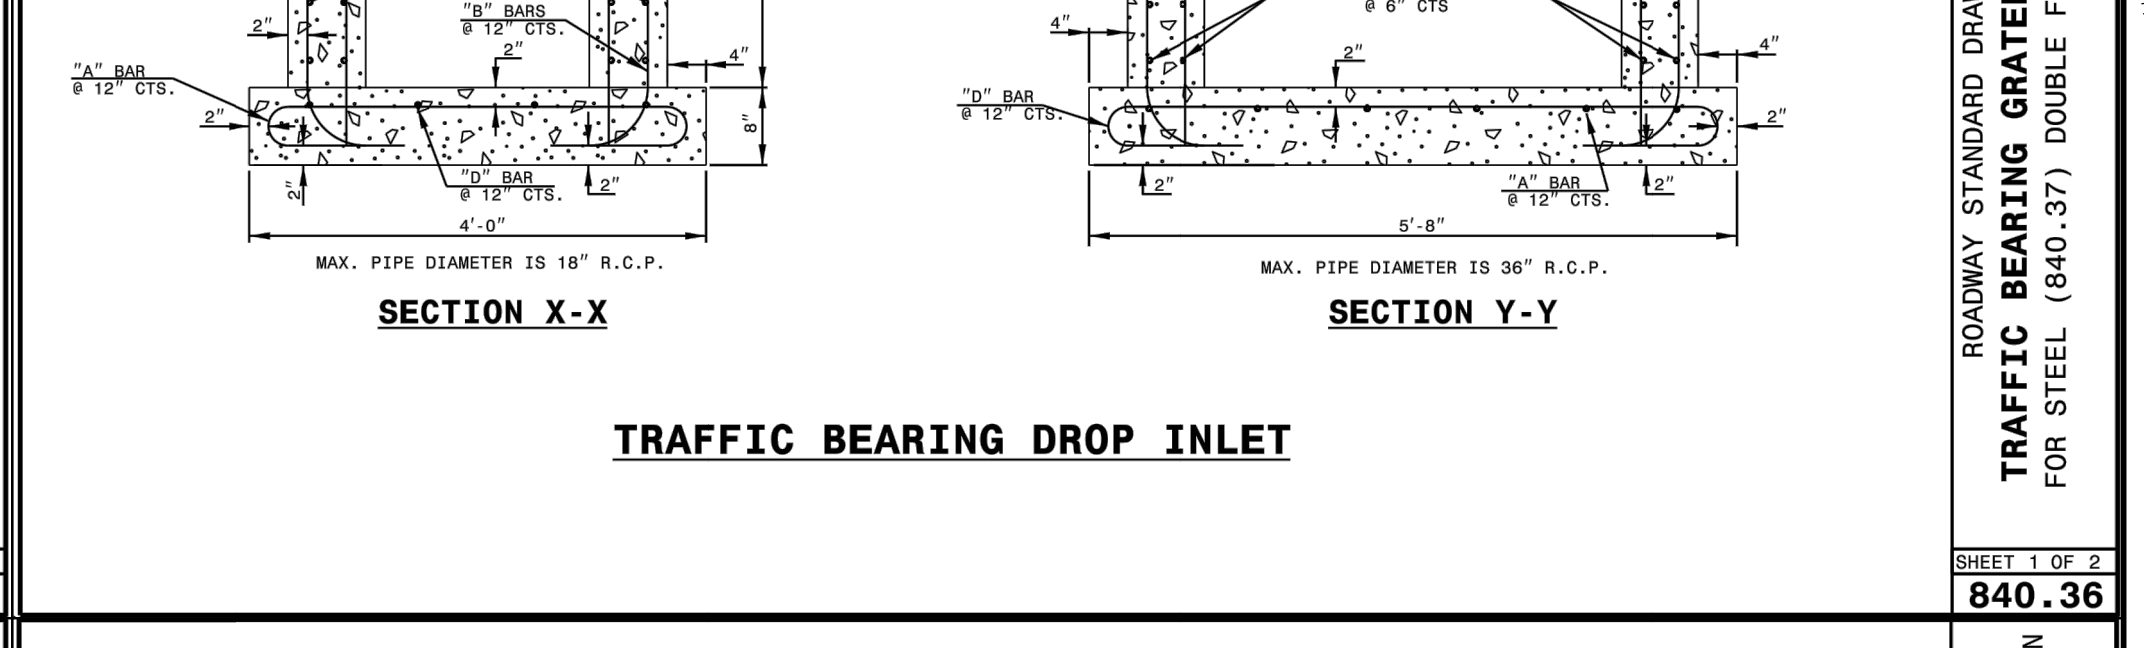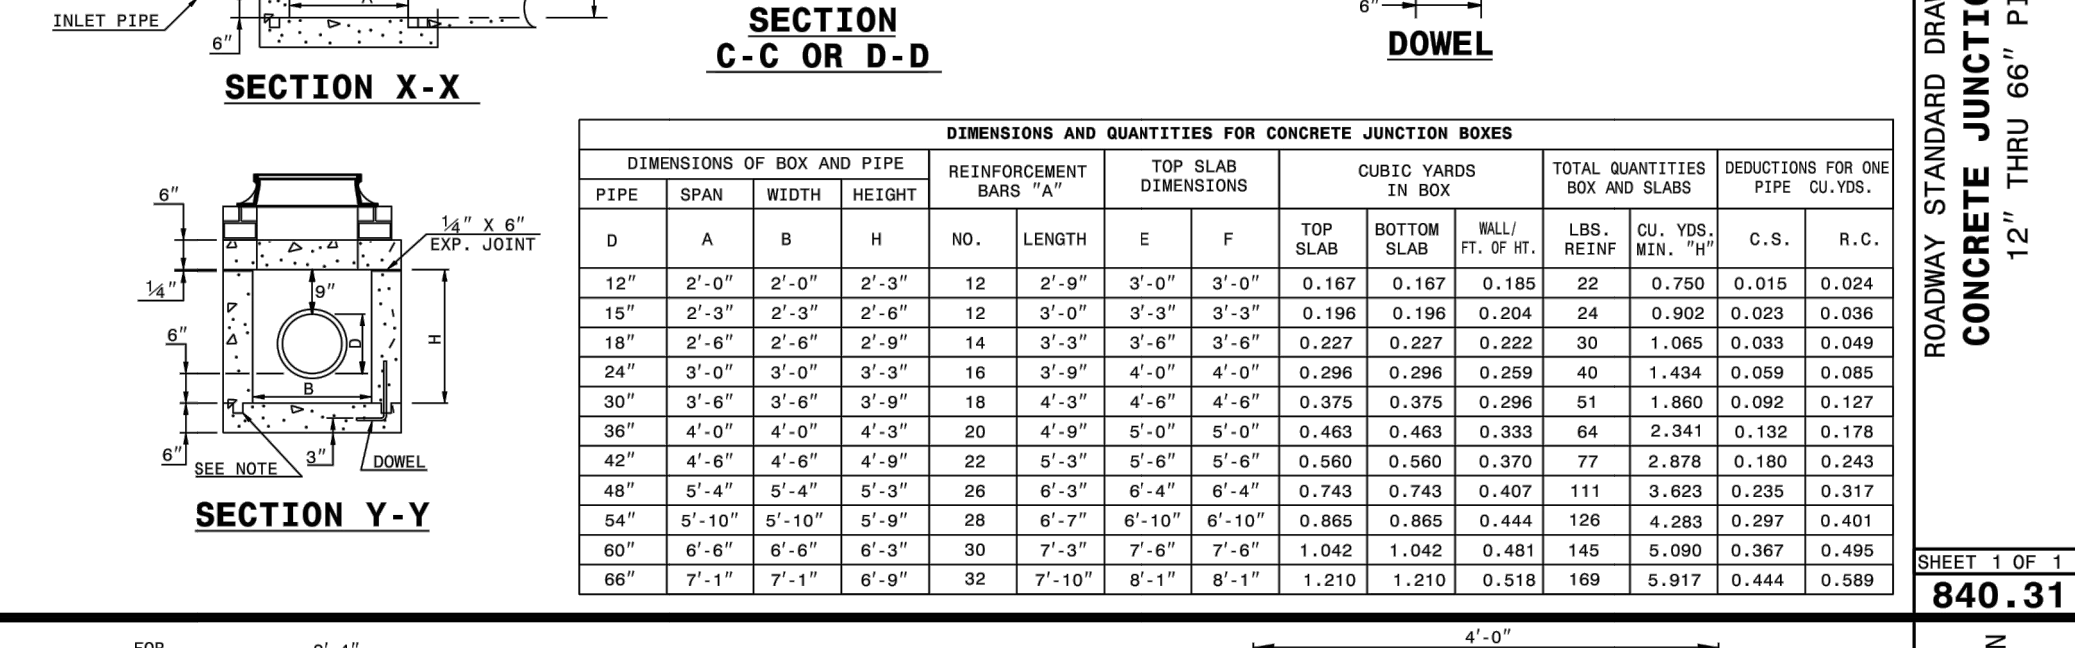

STATE OF NORTH CAROLINA
DEPT. OF TRANSPORTATION
DIVISION OF HIGHWAYS
RALEIGH, N.C.

ROADWAY STANDARD DRAWING FOR
TRAFFIC BEARING GRATED DROP INLET
FOR STEEL (840.37) DOUBLE FRAME AND GRATES



SHEET 1 OF 2
840.36

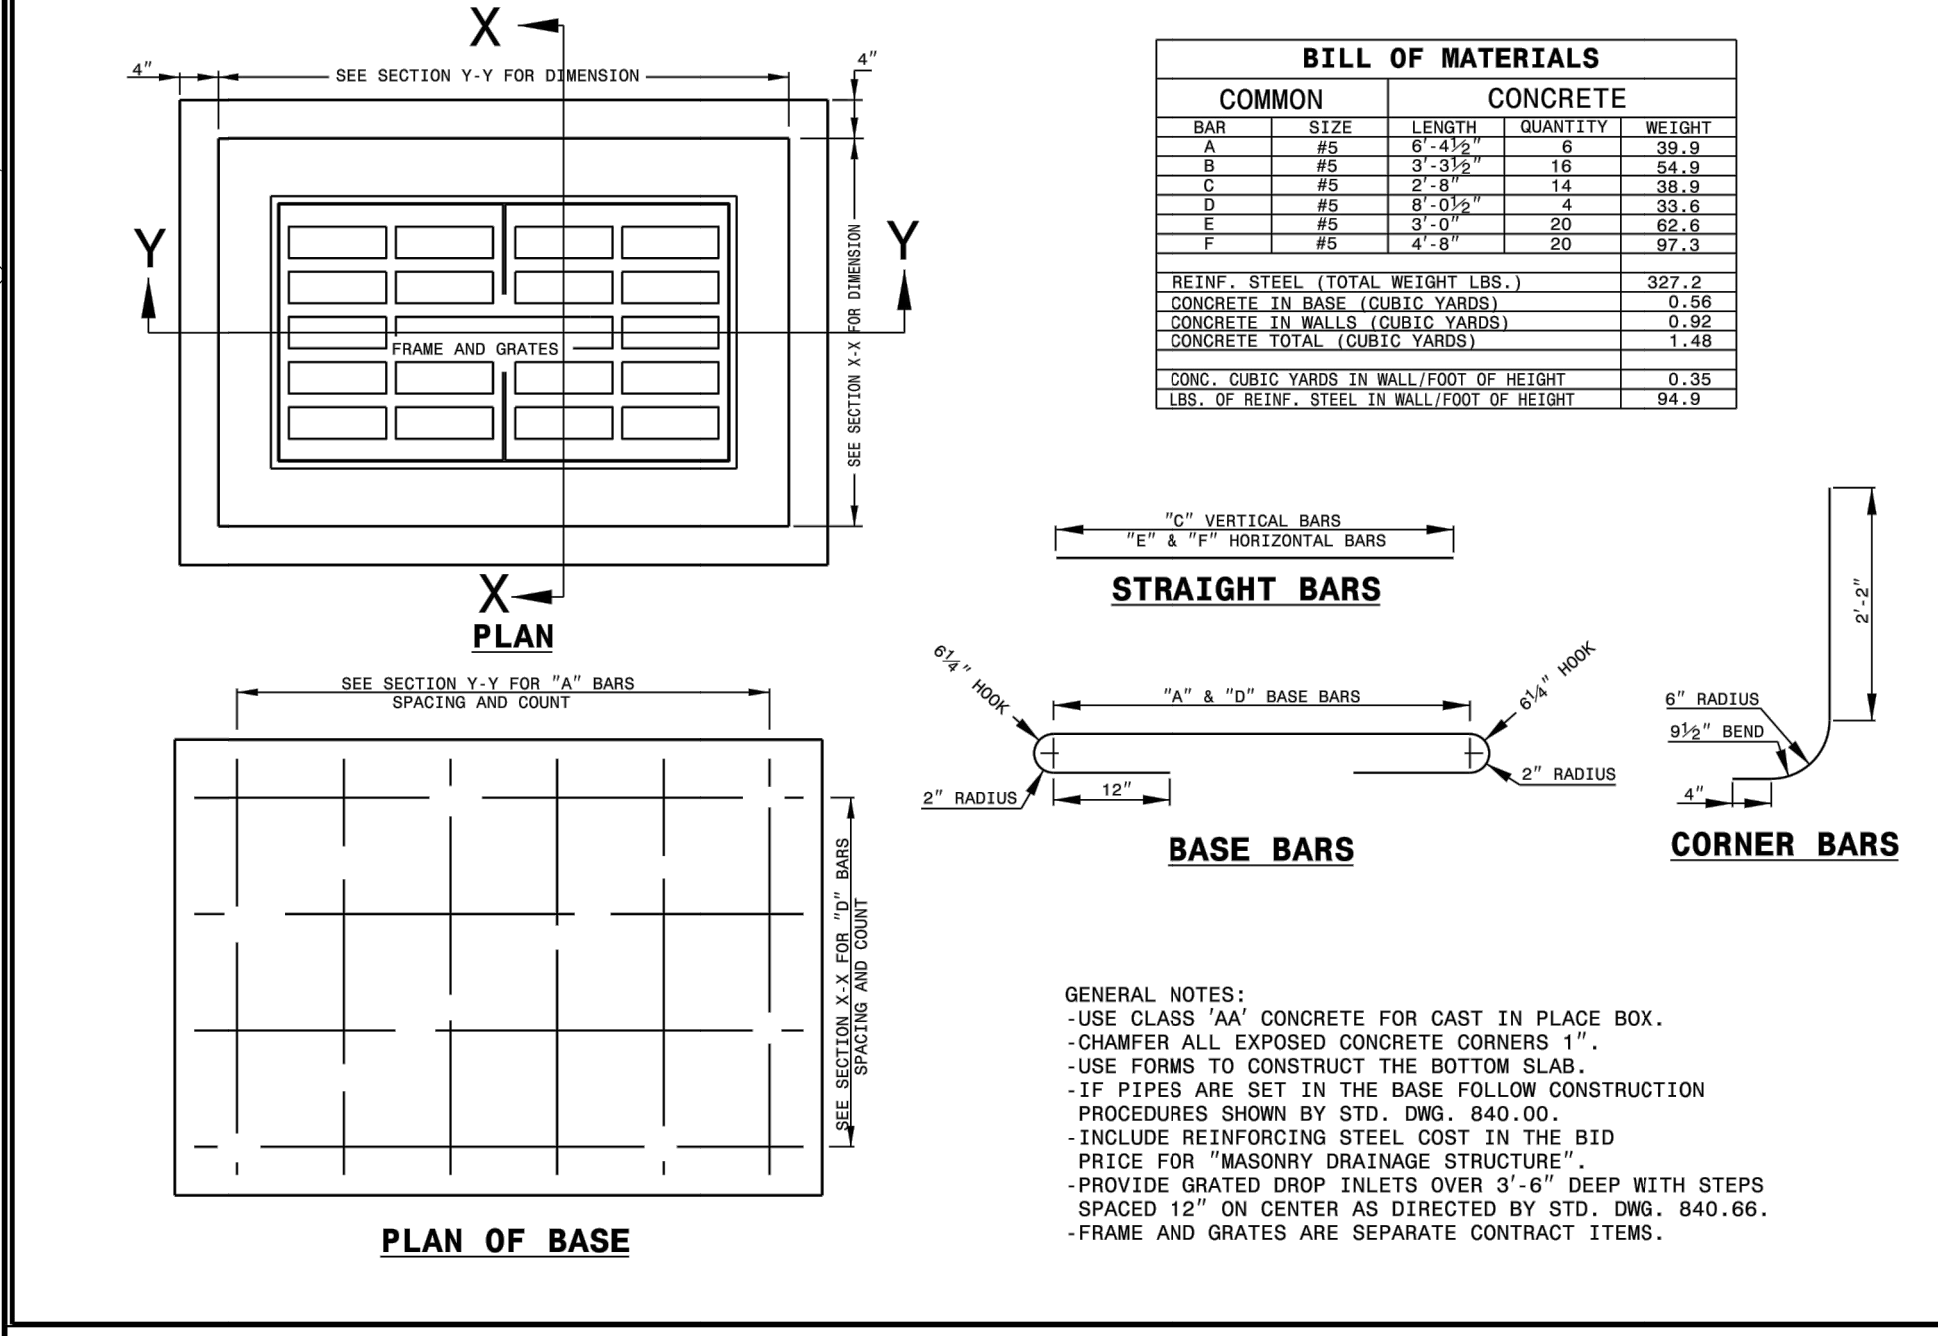

STATE OF NORTH CAROLINA
DEPT. OF TRANSPORTATION
DIVISION OF HIGHWAYS
RALEIGH, N.C.

ROADWAY STANDARD DRAWING FOR
TRAFFIC BEARING GRATED DROP INLET
FOR STEEL (840.37) DOUBLE FRAME AND GRATES

SHEET 2 OF 2
840.36

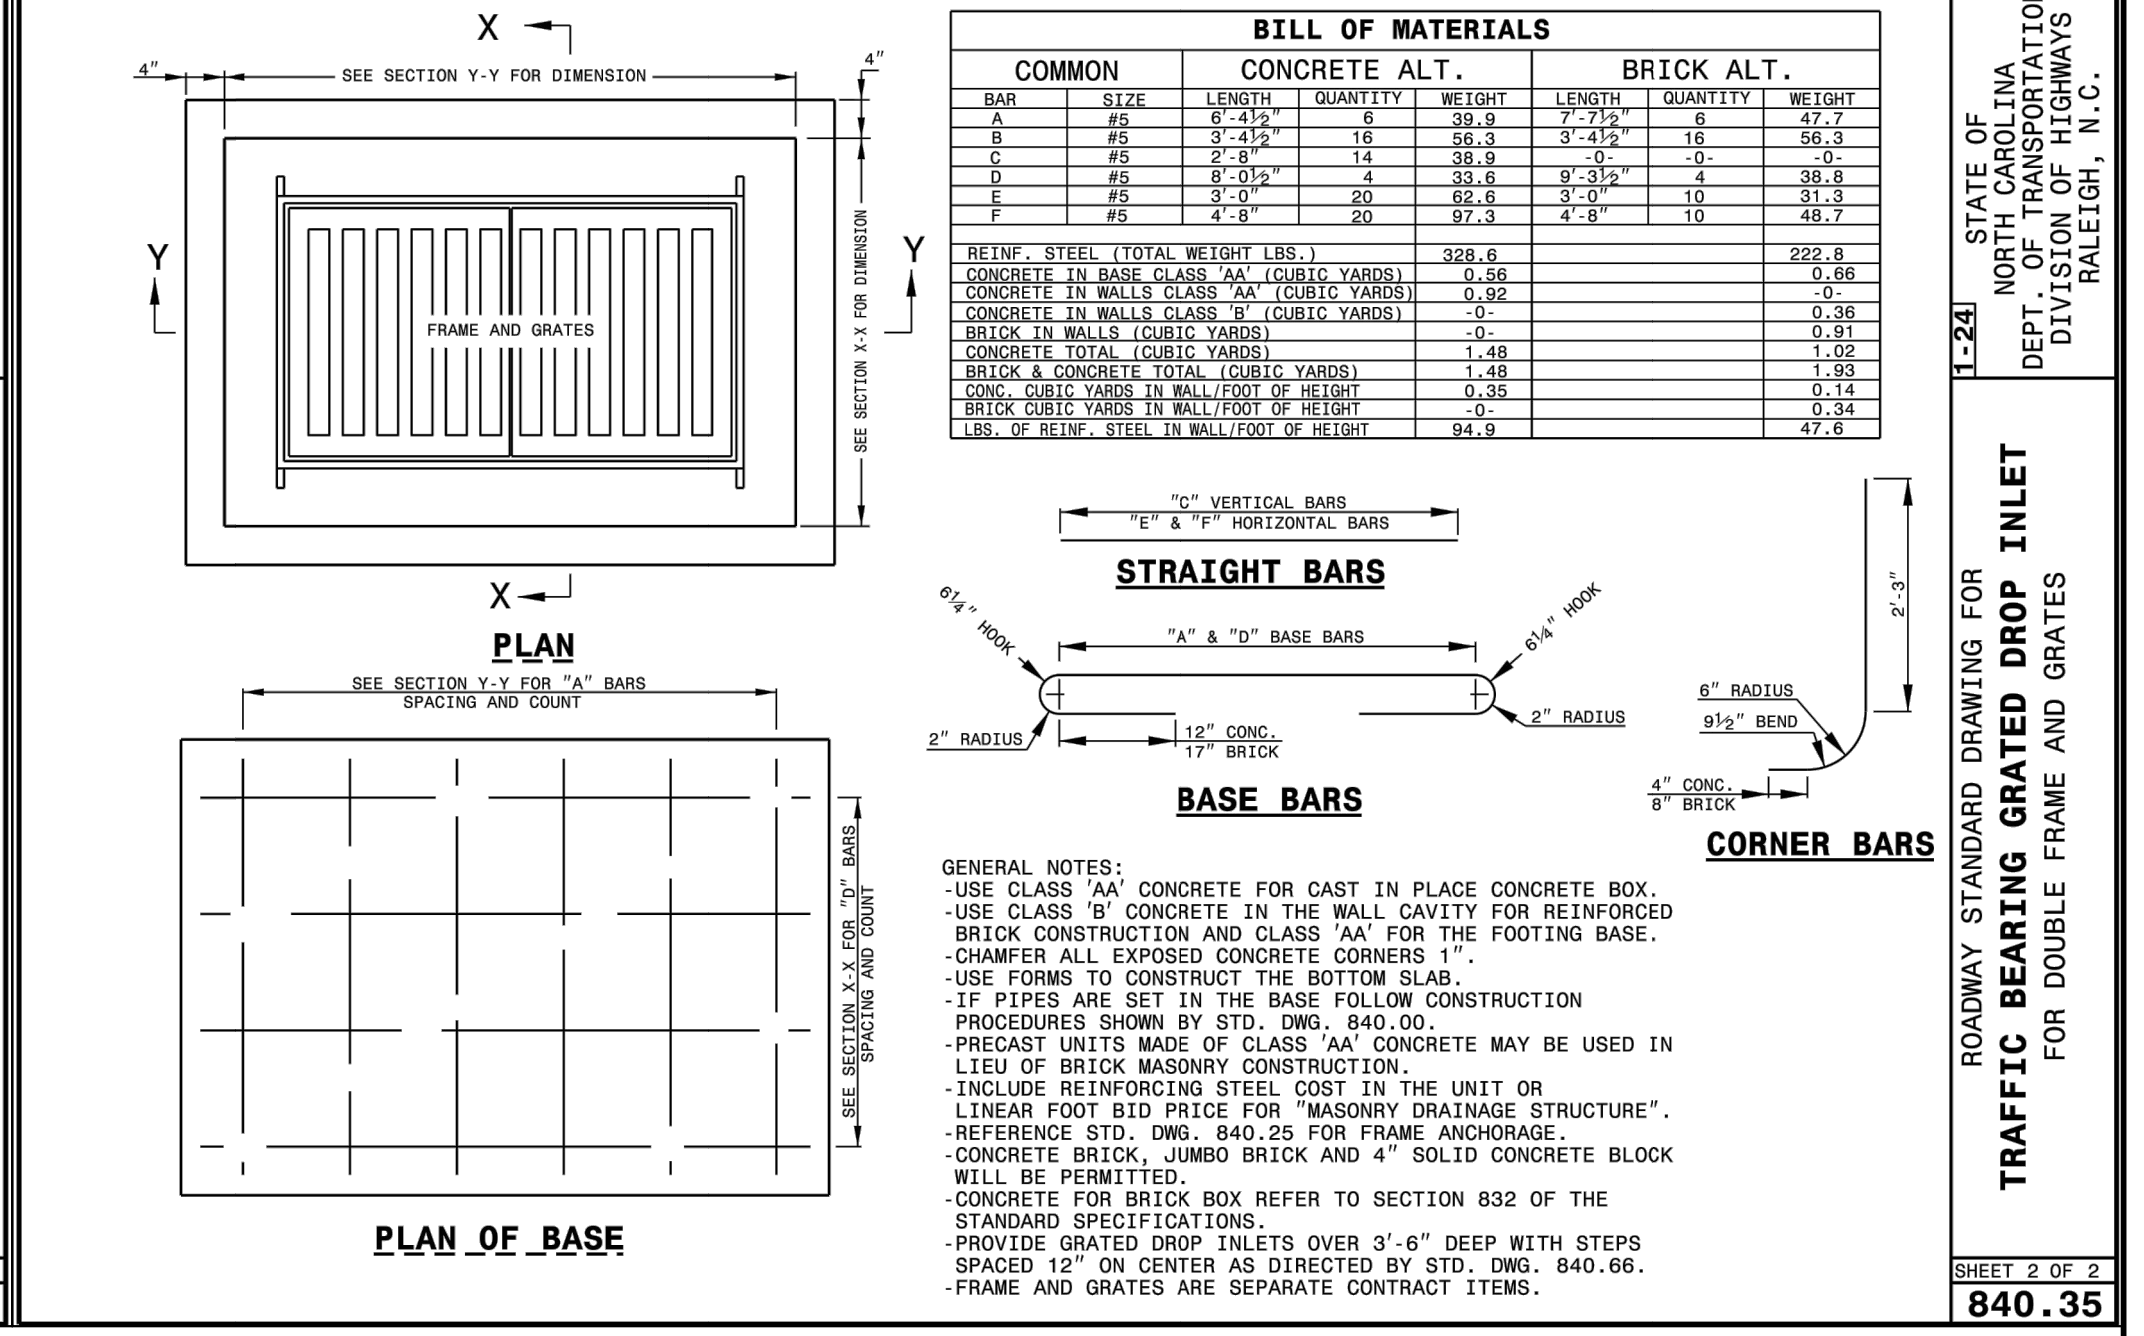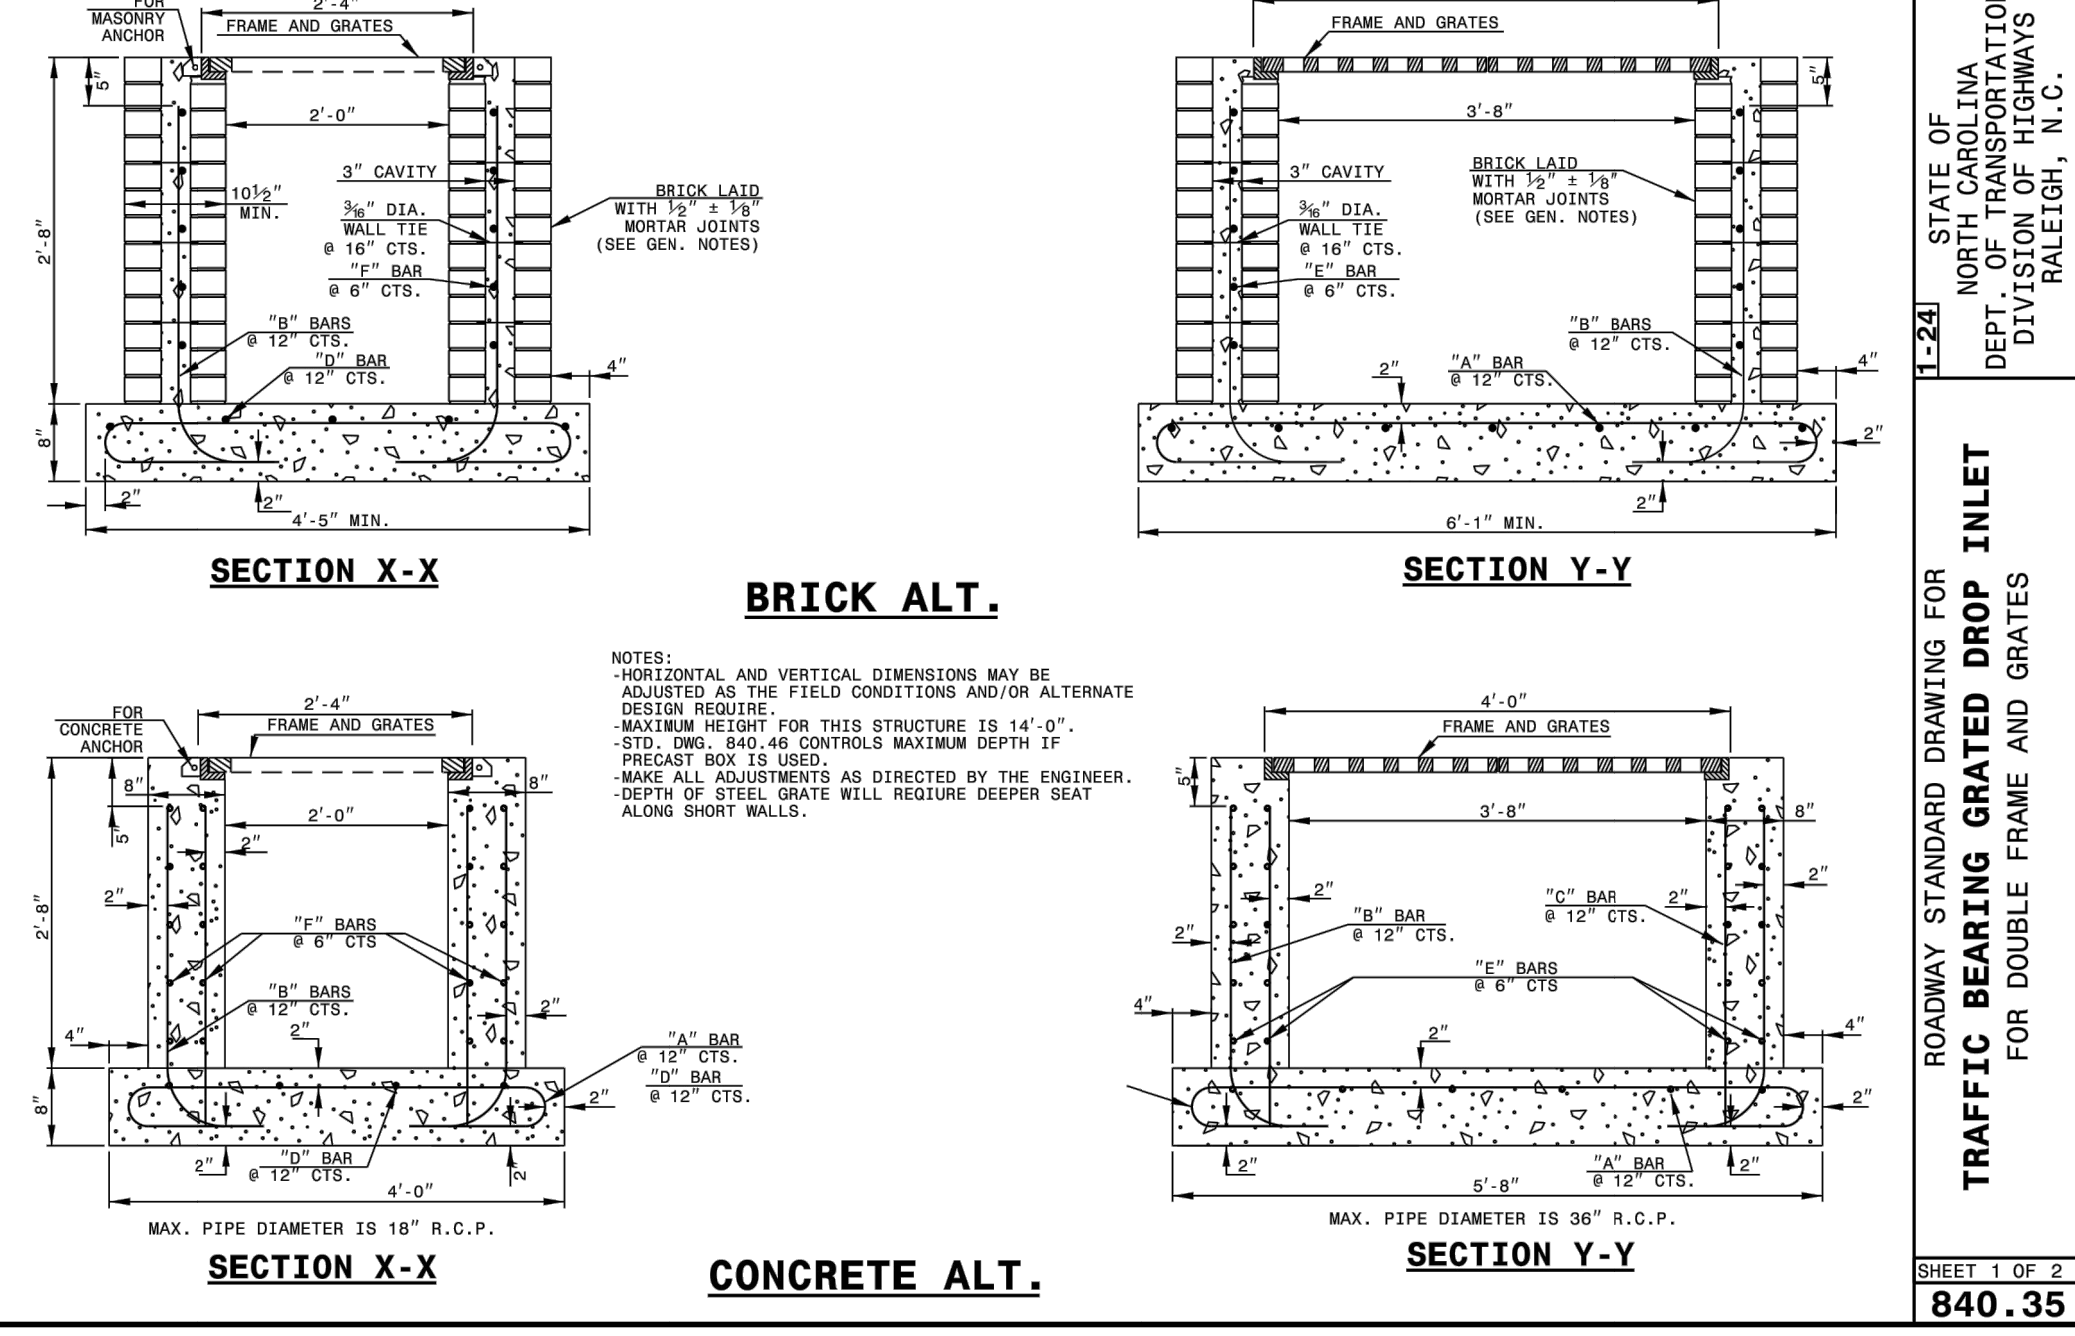

STATE OF NORTH CAROLINA
DEPT. OF TRANSPORTATION
DIVISION OF HIGHWAYS
RALEIGH, N.C.

ROADWAY STANDARD DRAWING FOR
TRAFFIC BEARING GRATED DROP INLET
FOR DOUBLE FRAME AND GRATES

SHEET 2 OF 2
840.35

PROJECT INFORMATION	
ENGINEERED PRODUCT MANAGER	
ADS SALES REP	
PROJECT NO.	



TWAS S MAIN

ROLESVILLE, NC, USA

SC-160LP STORMTECH CHAMBER SPECIFICATIONS

- CHAMBERS SHALL BE STORMTECH SC-160LP.
- CHAMBERS SHALL BE ARCH-SHAPED AND SHALL BE MANUFACTURED FROM VIRGIN, IMPACT-MODIFIED POLYPROPYLENE COPOLYMERS.
- CHAMBERS SHALL MEET THE REQUIREMENTS OF ASTM F2418, "STANDARD SPECIFICATION FOR POLYPROPYLENE (PP) CORRUGATED WALL STORMWATER COLLECTION CHAMBERS".
- CHAMBER ROWS SHALL PROVIDE CONTINUOUS, UNOBSTRUCTED INTERNAL SPACE WITH NO INTERNAL SUPPORTS THAT WOULD IMPEDE FLOW OR LIMIT ACCESS FOR INSPECTION.
- THE STRUCTURAL DESIGN OF THE CHAMBERS, THE STRUCTURAL BACKFILL, AND THE INSTALLATION REQUIREMENTS SHALL ENSURE THAT THE LOAD FACTORS SPECIFIED IN THE AASHTO LRFD BRIDGE DESIGN SPECIFICATIONS, SECTION 12.12, ARE MET FOR: 1) LONG-DURATION DEAD LOADS AND 2) SHORT-DURATION LIVE LOADS, BASED ON THE AASHTO DESIGN TRUCK WITH CONSIDERATION FOR IMPACT AND MULTIPLE VEHICLE PRESENCES.
- CHAMBERS SHALL BE DESIGNED, TESTED AND ALLOWABLE LOAD CONFIGURATIONS DETERMINED IN ACCORDANCE WITH ASTM F2787, "STANDARD PRACTICE FOR STRUCTURAL DESIGN OF THERMOPLASTIC CORRUGATED WALL STORMWATER COLLECTION CHAMBERS". LOAD CONFIGURATIONS SHALL INCLUDE: 1) INSTANTANEOUS (<1 MIN) AASHTO DESIGN TRUCK LIVE LOAD ON MINIMUM COVER 2) MAXIMUM PERMANENT (75-YR) COVER LOAD AND 3) ALLOWABLE COVER WITH PARKED (1-WEEK) AASHTO DESIGN TRUCK.
- REQUIREMENTS FOR HANDLING AND INSTALLATION:
 - TO MAINTAIN THE WIDTH OF CHAMBERS DURING SHIPPING AND HANDLING, CHAMBERS SHALL HAVE INTEGRAL, INTERLOCKING STACKING LUGS.
 - TO ENSURE A SECURE JOINT DURING INSTALLATION AND BACKFILL, THE HEIGHT OF THE CHAMBER JOINT SHALL NOT BE LESS THAN 1.5".
 - TO ENSURE THE INTEGRITY OF THE ARCH SHAPE DURING INSTALLATION, a) THE ARCH STIFFNESS CONSTANT SHALL BE GREATER THAN OR EQUAL TO 400 LBS/FT/%. THE ASC IS DEFINED IN SECTION 6.2.8 OF ASTM F2418. AND b) TO RESIST CHAMBER DEFORMATION DURING INSTALLATION AT ELEVATED TEMPERATURES (ABOVE 73° F / 23° C), CHAMBERS SHALL BE PRODUCED FROM REFLECTIVE GOLD OR YELLOW COLORS.
- ONLY CHAMBERS THAT ARE APPROVED BY THE SITE DESIGN ENGINEER WILL BE ALLOWED. UPON REQUEST BY THE SITE DESIGN ENGINEER OR OWNER, THE CHAMBER MANUFACTURER SHALL SUBMIT A STRUCTURAL EVALUATION FOR APPROVAL BEFORE DELIVERING CHAMBERS TO THE PROJECT SITE AS FOLLOWS:
 - THE STRUCTURAL EVALUATION SHALL BE SEALED BY A REGISTERED PROFESSIONAL ENGINEER.
 - THE STRUCTURAL EVALUATION SHALL DEMONSTRATE THAT THE SAFETY FACTORS ARE GREATER THAN OR EQUAL TO 1.95 FOR DEAD LOAD AND 1.75 FOR LIVE LOAD, THE MINIMUM REQUIRED BY ASTM F2787 AND BY SECTIONS 3 AND 12.12 OF THE AASHTO LRFD BRIDGE DESIGN SPECIFICATIONS FOR THERMOPLASTIC PIPE.
 - THE TEST DERIVED CREEP MODULUS AS SPECIFIED IN ASTM F2418 SHALL BE USED FOR PERMANENT DEAD LOAD DESIGN EXCEPT THAT IT SHALL BE THE 75-YEAR MODULUS USED FOR DESIGN.
- CHAMBERS AND END CAPS SHALL BE PRODUCED AT AN ISO 9001 CERTIFIED MANUFACTURING FACILITY.

IMPORTANT - NOTES FOR THE BIDDING AND INSTALLATION OF THE SC-160LP SYSTEM

- STORMTECH SC-160LP CHAMBERS SHALL NOT BE INSTALLED UNTIL THE MANUFACTURER'S REPRESENTATIVE HAS COMPLETED A PRE-CONSTRUCTION MEETING WITH THE INSTALLERS.
- STORMTECH SC-160LP CHAMBERS SHALL BE INSTALLED IN ACCORDANCE WITH THE "STORMTECH SC-160LP CONSTRUCTION GUIDE".
- FOUNDATION STONE AND EMBEDMENT STONE SURROUNDING CHAMBERS MUST BE A CLEAN, CRUSHED, ANGULAR STONE; AASHTO M43 #3,357, 4, 467, 5, 56, OR 57.
- THE FOUNDATION STONE SHALL BE LEVELED AND COMPACTED PRIOR TO PLACING CHAMBERS.
- THE DEPTH OF FOUNDATION STONE SHALL BE DETERMINED BASED ON THE SUBGRADE BEARING CAPACITY PROVIDED BY THE SITE DESIGN ENGINEER.
- THE CONTRACTOR MUST REPORT ANY DISCREPANCIES CONCERNING CHAMBER FOUNDATION DESIGN AND SUBGRADE BEARING CAPACITIES TO THE SITE DESIGN ENGINEER.
- JOINTS BETWEEN CHAMBERS SHALL BE PROPERLY SEATED PRIOR TO PLACING STONE.
- CHAMBERS SHALL BE INSTALLED "TOE TO TOE". NO ADDITIONAL SPACING BETWEEN ROWS IS REQUIRED.
- STORMTECH RECOMMENDS 3 BACKFILL METHODS:
 - STONESHOOTER LOCATED OFF THE CHAMBER BED.
 - BACKFILL AS ROWS ARE BUILT USING AN EXCAVATOR ON THE FOUNDATION STONE OR SUBGRADE.
 - BACKFILL FROM OUTSIDE THE EXCAVATION USING A LONG BOOM HOE OR EXCAVATOR.
- ADS RECOMMENDS THE USE OF "FLEXSTORM CATCH IT" INSERTS DURING CONSTRUCTION FOR ALL INLETS TO PROTECT THE SUBSURFACE STORMWATER MANAGEMENT SYSTEM FROM CONSTRUCTION SITE RUNOFF.

NOTES FOR CONSTRUCTION EQUIPMENT

- THE USE OF CONSTRUCTION EQUIPMENT OVER SC-160LP CHAMBERS IS LIMITED:
 - NO EQUIPMENT IS ALLOWED ON BARE CHAMBERS.
 - NO RUBBER Tired LOADERS, DUMP TRUCKS, OR EXCAVATORS ARE ALLOWED UNTIL PROPER FILL DEPTHS ARE REACHED IN ACCORDANCE WITH THE "STORMTECH SC-160LP CONSTRUCTION GUIDE".
 - WEIGHT LIMITS FOR CONSTRUCTION EQUIPMENT CAN BE FOUND IN THE "STORMTECH SC-106LP CONSTRUCTION GUIDE".
- FULL 36" (900 mm) OF STABILIZED COVER MATERIALS OVER THE CHAMBERS IS REQUIRED FOR DUMP TRUCK TRAVEL OR DUMPING.

CONTACT STORMTECH AT 1-888-892-2694 WITH ANY QUESTIONS ON INSTALLATION REQUIREMENTS OR WEIGHT LIMITS FOR CONSTRUCTION EQUIPMENT.

PROPOSED LAYOUT		PROPOSED ELEVATIONS:		*INVERT ABOVE BASE OF CHAMBER				
				PART TYPE	ITEM ON LAYOUT	DESCRIPTION	INVERT*	MAX FLOW
457	STORMTECH SC-160LP CHAMBERS	MAXIMUM ALLOWABLE GRADE (TOP OF PAVEMENT/UNPAVED):	399.45					
92	STORMTECH SC-160LP END CAPS	MINIMUM ALLOWABLE GRADE (UNPAVED WITH TRAFFIC):	391.12					
6	STONE ABOVE (in)	MINIMUM ALLOWABLE GRADE (UNPAVED NO TRAFFIC):	390.62	MANIFOLD	A	12" x 8" REDUCING CONCENTRIC MOLDED FITTINGS (12" PIPE)	-1.17"	0.96"
6	STONE BELOW (in)	MINIMUM ALLOWABLE GRADE (TOP OF RIGID CONCRETE PAVEMENT):	390.62					
40	STONE VOID	MINIMUM ALLOWABLE GRADE (BASE OF FLEXIBLE PAVEMENT):	390.62	MANIFOLD	B	18" x 8" ADS N-12 (18" PIPE)	-4.13"	
8351	INSTALLED SYSTEM VOLUME (CF) (PERIMETER STONE INCLUDED) (COVER STONE INCLUDED) (BASE STONE INCLUDED)	TOP OF STONE:	389.95	MANIFOLD	C	8" x 8" BOTTOM MANIFOLD, MOLDED FITTINGS	0.96"	
		TOP OF SC-160LP CHAMBER:	389.45					
		8" x 8" BOTTOM MANIFOLD INVERT:	388.53	MANIFOLD	D	15" x 8" ADS N-12 (15" PIPE)	-2.58"	
		8" ISOLATOR ROW PLUS INVERT:	388.53				0.96"	
8089	SYSTEM AREA (SF)	8" ISOLATOR ROW PLUS INVERT:	388.53	CONCRETE STRUCTURE	E	OCS (DESIGN BY ENGINEER / PROVIDED BY OTHERS)		3.4 CFS OUT
646.3	SYSTEM PERIMETER (ft)	8" ISOLATOR ROW PLUS INVERT:	388.53	CONCRETE STRUCTURE	F	(DESIGN BY ENGINEER / PROVIDED BY OTHERS)		4.4 CFS IN
		8" BOTTOM CONNECTION INVERT:	388.53	W/WEIR				
		18" x 8" BOTTOM MANIFOLD INVERT (8" PIPE):	388.53	CONCRETE STRUCTURE	G	(DESIGN BY ENGINEER / PROVIDED BY OTHERS)		5.9 CFS IN
		15" x 8" BOTTOM MANIFOLD INVERT (8" PIPE):	388.53	W/WEIR				
		12" x 8" BOTTOM MANIFOLD INVERT (8" PIPE):	388.53	CONCRETE STRUCTURE	H	(DESIGN BY ENGINEER / PROVIDED BY OTHERS)		0.7 CFS IN
		BOTTOM OF SC-160LP CHAMBER:	388.45	W/WEIR				
		12" x 8" BOTTOM MANIFOLD INVERT (12" PIPE):	388.35	UNDERDRAIN	I	4" ADS N-12 DUAL WALL PERFORATED HDPE UNDERDRAIN		
		15" x 8" BOTTOM MANIFOLD INVERT (15" PIPE):	388.24					
		18" x 8" BOTTOM MANIFOLD INVERT (18" PIPE):	388.11					
				UNDERDRAIN INVERT:	387.95			
		BOTTOM OF STONE:	387.95					


TWAS S MAIN	
ROLESVILLE, NC, USA	
DATE:	DRAWN: KH
PROJECT #:	CHECKED: N/A

DATE	CHK	DRW	CHK	DESCRIPTION

StormTech®
Chamber System

888-892-2694 | WWW.STORMTECH.COM

4640 TRUEMAN BLVD
HILLIARD, OH 43026
1-800-733-7473

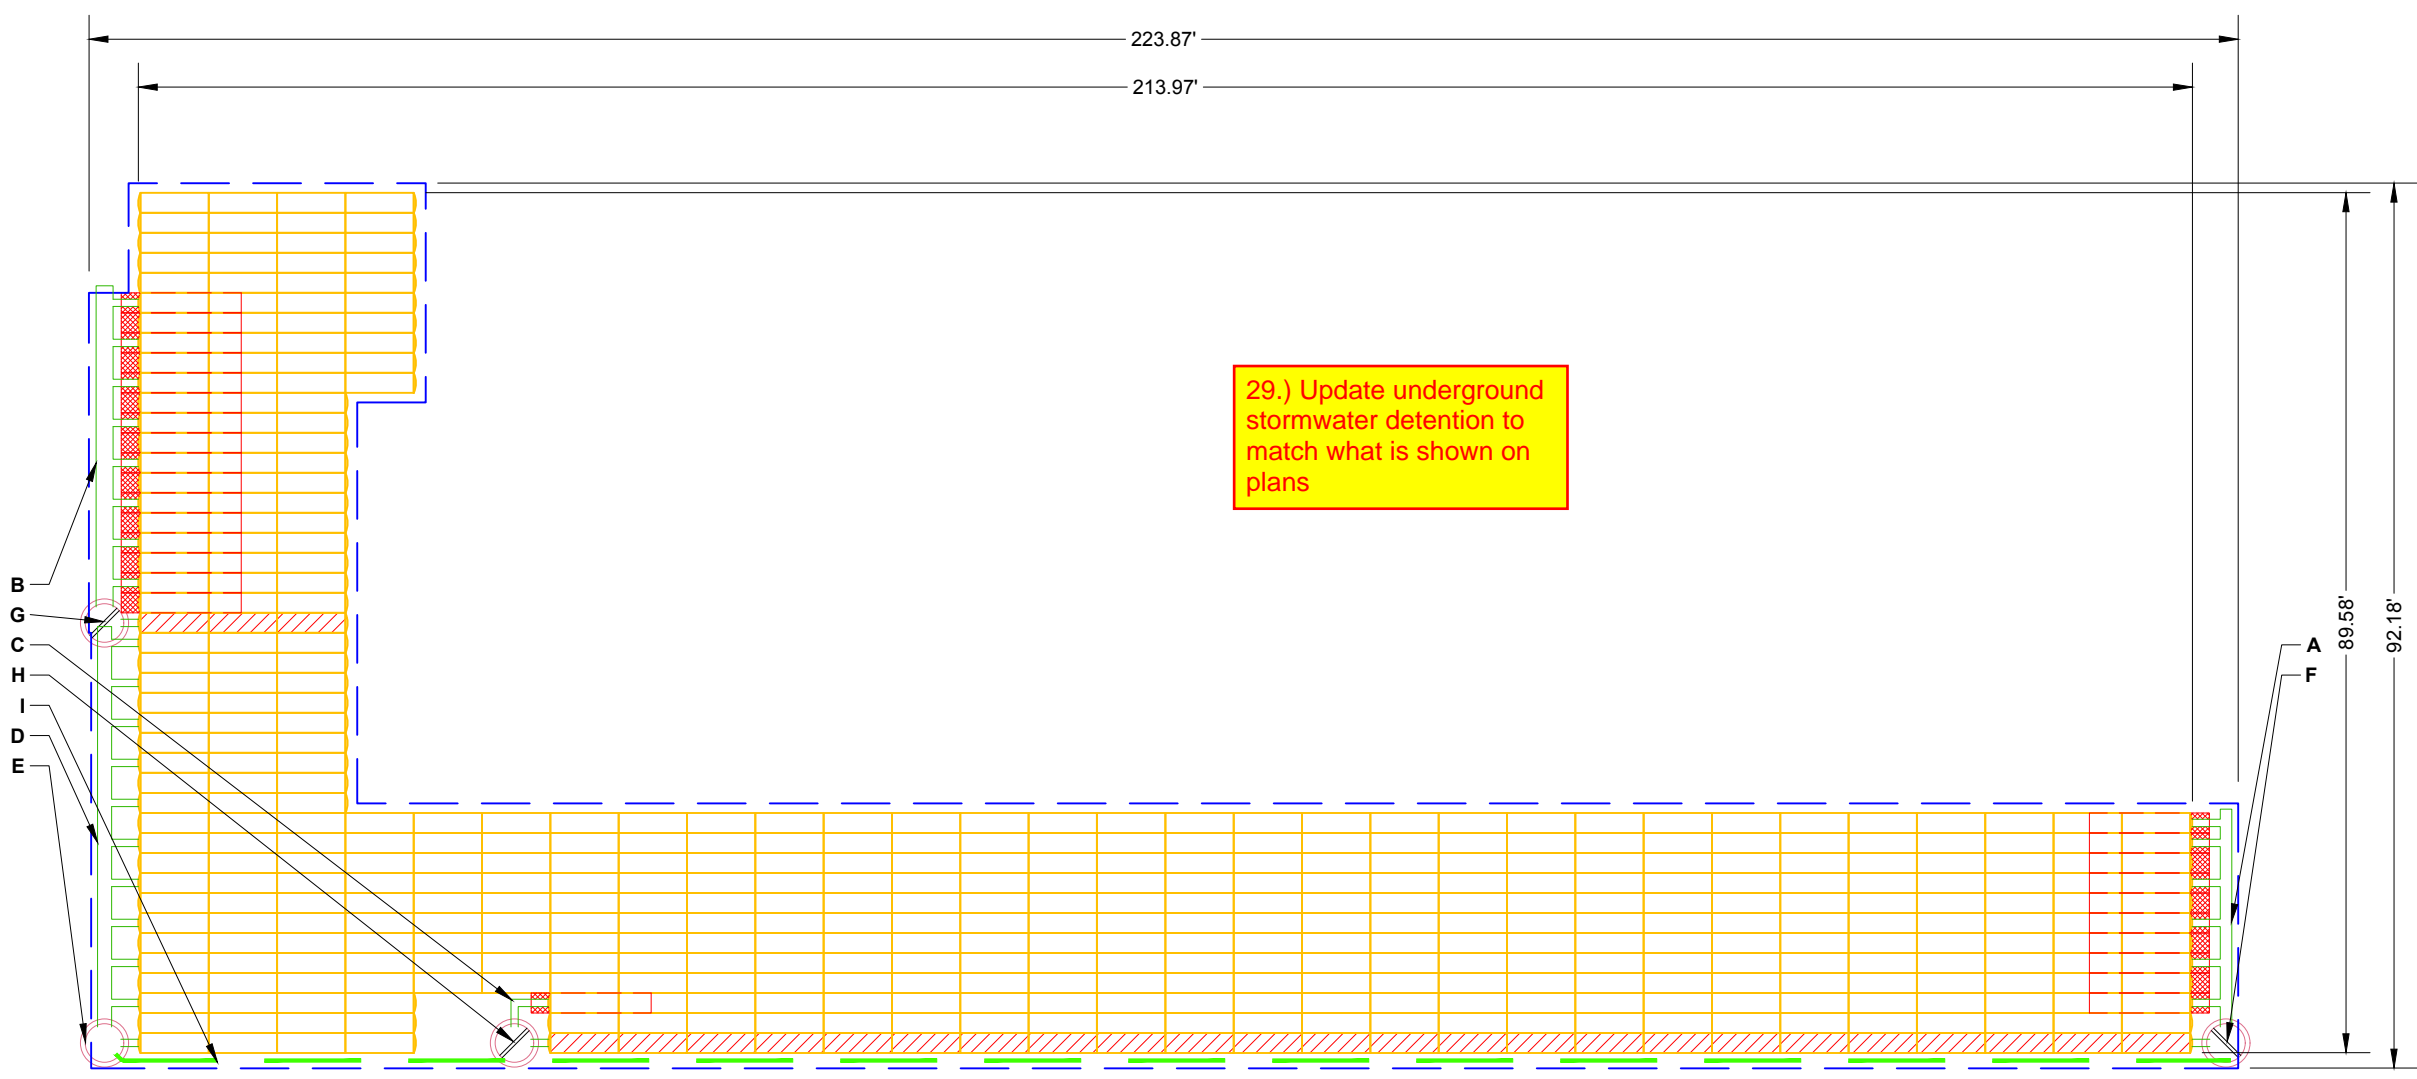

- ISOLATOR ROW PLUS (SEE DETAIL/TYP 2 PLACES)
- PLACE MINIMUM 12.50' OF ADSPLUS125 WOVEN GEOTEXTILE OVER BEDDING STONE AND UNDERNEATH CHAMBER FEET FOR SCOUR PROTECTION AT ALL CHAMBER INLET ROWS
- BED LIMITS

NOTES

- MANIFOLD SIZE TO BE DETERMINED BY SITE DESIGN ENGINEER. SEE TECH NOTE #6.32 FOR MANIFOLD SIZING GUIDANCE.
- DUE TO THE ADAPTATION OF THIS CHAMBER SYSTEM TO SPECIFIC SITE AND DESIGN CONSTRAINTS, IT MAY BE NECESSARY TO CUT AND COUPLE ADDITIONAL PIPE TO STANDARD MANIFOLD COMPONENTS IN THE FIELD.
- THE SITE DESIGN ENGINEER MUST REVIEW ELEVATIONS AND IF NECESSARY ADJUST GRADING TO ENSURE THE CHAMBER COVER REQUIREMENTS ARE MET.
- THIS CHAMBER SYSTEM WAS DESIGNED WITHOUT SITE-SPECIFIC INFORMATION ON SOIL CONDITIONS OR BEARING CAPACITY. THE SITE DESIGN ENGINEER IS RESPONSIBLE FOR DETERMINING THE SUITABILITY OF THE SOIL AND PROVIDING THE BEARING CAPACITY OF THE INSITU SOILS. THE BASE STONE DEPTH MAY BE INCREASED OR DECREASED ONCE THIS INFORMATION IS PROVIDED.
- **NOT FOR CONSTRUCTION:** THIS LAYOUT IS FOR DIMENSIONAL PURPOSES ONLY TO PROVE CONCEPT & THE REQUIRED STORAGE VOLUME CAN BE ACHIEVED ON SITE.


THIS DRAWING HAS BEEN PREPARED BASED ON INFORMATION PROVIDED TO ADS UNDER THE DIRECTION OF THE SITE DESIGN ENGINEER OR OTHER PROJECT REPRESENTATIVE. THE SITE DESIGN ENGINEER SHALL REVIEW THIS DRAWING PRIOR TO CONSTRUCTION. IT IS THE ULTIMATE RESPONSIBILITY OF THE SITE DESIGN ENGINEER TO ENSURE THAT THE PRODUCT(S) DEPICTED AND ALL ASSOCIATED DETAILS MEET ALL APPLICABLE LAWS, REGULATIONS, AND PROJECT REQUIREMENTS.

ACCEPTABLE FILL MATERIALS: STORMTECH SC-160LP CHAMBER SYSTEMS

MATERIAL LOCATION		DESCRIPTION	AASHTO MATERIAL CLASSIFICATIONS	COMPACTION / DENSITY REQUIREMENT
D	FINAL FILL: FILL MATERIAL FOR LAYER 'D' STARTS FROM THE TOP OF THE 'C' LAYER TO THE BOTTOM OF FLEXIBLE PAVEMENT OR UNPAVED FINISHED GRADE ABOVE. NOTE THAT PAVEMENT SUBBASE MAY BE PART OF THE 'D' LAYER	ANY SOIL/ROCK MATERIALS, NATIVE SOILS, OR PER ENGINEER'S PLANS. CHECK PLANS FOR PAVEMENT SUBGRADE REQUIREMENTS.	N/A	PREPARE PER SITE DESIGN ENGINEER'S PLANS. PAVED INSTALLATIONS MAY HAVE STRINGENT MATERIAL AND PREPARATION REQUIREMENTS.
C	INITIAL FILL: FILL MATERIAL FOR LAYER 'C' STARTS FROM THE TOP OF THE EMBEDMENT STONE ('B' LAYER) TO 14" (355 mm) ABOVE THE TOP OF THE CHAMBER. NOTE THAT PAVEMENT SUBBASE MAY BE A PART OF THE 'C' LAYER.	GRANULAR WELL-GRADED SOIL/AGGREGATE MIXTURES, <35% FINES OR PROCESSED AGGREGATE. MOST PAVEMENT SUBBASE MATERIALS CAN BE USED IN LIEU OF THIS LAYER.	AASHTO M145 ¹ A-1, A-2-4, A-3 OR AASHTO M43 ¹ 3, 357, 4, 467, 5, 56, 57, 6, 67, 68, 7, 78, 8, 89, 9, 10	BEGIN COMPACTIONS AFTER 12" (300 mm) OF MATERIAL OVER THE CHAMBERS IS REACHED. COMPACT ADDITIONAL LAYERS IN 6" (150 mm) MAX LIFTS TO A MIN. 95% PROCTOR DENSITY FOR WELL GRADED MATERIAL AND 95% RELATIVE DENSITY FOR PROCESSED AGGREGATE MATERIALS. ROLLER GROSS VEHICLE WEIGHT NOT TO EXCEED 12,000 lbs (53 kN). DYNAMIC FORCE NOT TO EXCEED 20,000 lbs (89 kN).
B	EMBEDMENT STONE: FILL SURROUNDING THE CHAMBERS FROM THE FOUNDATION STONE ('A' LAYER) TO THE 'C' LAYER ABOVE.	CLEAN, CRUSHED, ANGULAR STONE	AASHTO M43 ¹ 3, 357, 4, 467, 5, 56, 57	NO COMPACTION REQUIRED.
A	FOUNDATION STONE: FILL BELOW CHAMBERS FROM THE SUBGRADE UP TO THE FOOT (BOTTOM) OF THE CHAMBER.	CLEAN, CRUSHED, ANGULAR STONE	AASHTO M43 ¹ 3, 357, 4, 467, 5, 56, 57	PLATE COMPACT OR ROLL TO ACHIEVE A FLAT SURFACE. ^{2,3}

PLEASE NOTE:

- THE LISTED AASHTO DESIGNATIONS ARE FOR GRADATIONS ONLY. THE STONE MUST ALSO BE CLEAN, CRUSHED, ANGULAR. FOR EXAMPLE, A SPECIFICATION FOR #4 STONE WOULD STATE: "CLEAN, CRUSHED, ANGULAR NO. 4 (AASHTO M43) STONE".
- STORMTECH COMPACTION REQUIREMENTS ARE MET FOR 'A' LOCATION MATERIALS WHEN PLACED AND COMPACTED IN 6" (150 mm) (MAX) LIFTS USING TWO FULL COVERAGES WITH A VIBRATORY COMPACTOR.
- WHERE INFILTRATION SURFACES MAY BE COMPROMISED BY COMPACTION, FOR STANDARD DESIGN LOAD CONDITIONS, A FLAT SURFACE MAY BE ACHIEVED BY RAKING OR DRAGGING WITHOUT COMPACTION EQUIPMENT. FOR SPECIAL LOAD DESIGNS, CONTACT STORMTECH FOR COMPACTION REQUIREMENTS.
- ONCE LAYER 'C' IS PLACED, ANY SOIL/MATERIAL CAN BE PLACED IN LAYER 'D' UP TO THE FINISHED GRADE. MOST PAVEMENT SUBBASE SOILS CAN BE USED TO REPLACE THE MATERIAL REQUIREMENTS OF LAYER 'C' OR 'D' AT THE SITE DESIGN ENGINEER'S DISCRETION.

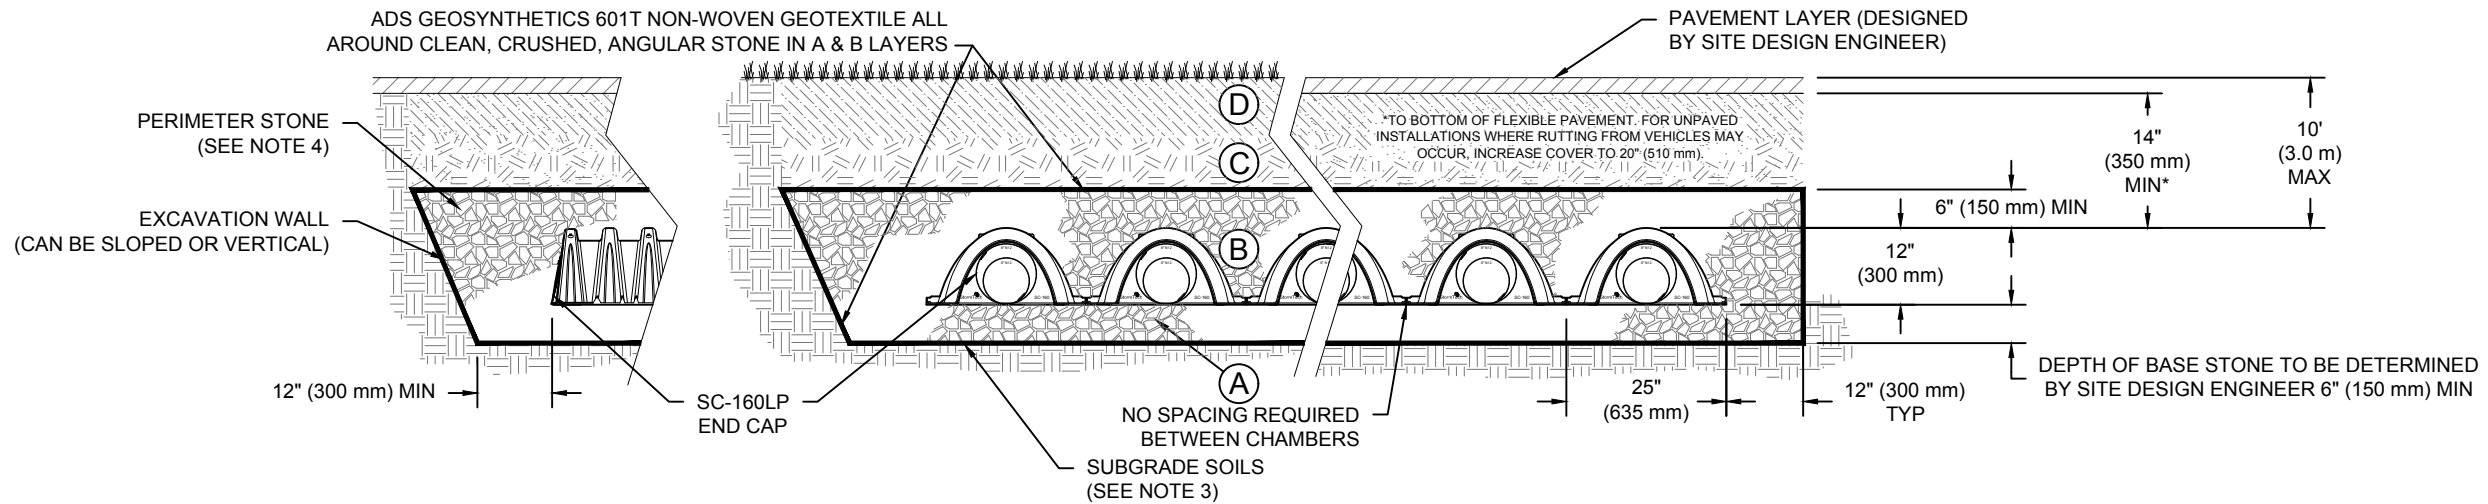

NOTES:

- CHAMBERS SHALL MEET THE REQUIREMENTS OF ASTM F2418, "STANDARD SPECIFICATION FOR POLYPROPYLENE (PP) CORRUGATED WALL STORMWATER COLLECTION CHAMBERS".
- CHAMBERS SHALL BE DESIGNED, TESTED AND ALLOWABLE LOAD CONFIGURATIONS DETERMINED IN ACCORDANCE WITH ASTM F2787, "STANDARD PRACTICE FOR STRUCTURAL DESIGN OF THERMOPLASTIC CORRUGATED WALL STORMWATER COLLECTION CHAMBERS". LOAD CONFIGURATIONS SHALL INCLUDE: 1) INSTANTANEOUS (<1 MIN) AASHTO DESIGN TRUCK LIVE LOAD ON MINIMUM COVER 2) MAXIMUM PERMANENT (75-YR) COVER LOAD AND 3) ALLOWABLE COVER WITH PARKED (1-WEEK) AASHTO DESIGN TRUCK.
- THE SITE DESIGN ENGINEER IS RESPONSIBLE FOR ASSESSING THE BEARING RESISTANCE (ALLOWABLE BEARING CAPACITY) OF THE SUBGRADE SOILS AND THE DEPTH OF FOUNDATION STONE WITH CONSIDERATION FOR THE RANGE OF EXPECTED SOIL MOISTURE CONDITIONS.
- PERIMETER STONE MUST BE EXTENDED HORIZONTALLY TO THE EXCAVATION WALL FOR BOTH VERTICAL AND SLOPED EXCAVATION WALLS.
- REQUIREMENTS FOR HANDLING AND INSTALLATION:
 - TO MAINTAIN THE WIDTH OF CHAMBERS DURING SHIPPING AND HANDLING, CHAMBERS SHALL HAVE INTEGRAL, INTERLOCKING STACKING LUGS
 - TO ENSURE A SECURE JOINT DURING INSTALLATION AND BACKFILL, THE HEIGHT OF THE CHAMBER JOINT SHALL NOT BE LESS THAN 1.5"
 - TO ENSURE THE INTEGRITY OF THE ARCH SHAPE DURING INSTALLATION, a) THE ARCH STIFFNESS CONSTANT SHALL BE GREATER THAN OR EQUAL TO 400 LBS/FT/%. THE ASC IS DEFINED IN SECTION 6.2.8 OF ASTM F2418. AND b) TO RESIST CHAMBER DEFORMATION DURING INSTALLATION AT ELEVATED TEMPERATURES (ABOVE 73° F / 23° C), CHAMBERS SHALL BE PRODUCED FROM REFLECTIVE GOLD OR YELLOW COLORS.


TWAS S MAIN
 ROLESVILLE, NC, USA
 DRAWN: KH
 CHECKED: N/A
 DATE:
 PROJECT #:
 DESCRIPTION

StormTech®
 Chamber System
 888-892-2694 | WWW.STORMTECH.COM

4640 TRUEMAN BLVD
 HILLIARD, OH 43026
 1-800-733-7473



THIS DRAWING HAS BEEN PREPARED BASED ON INFORMATION PROVIDED TO ADS UNDER THE DIRECTION OF THE SITE DESIGN ENGINEER OR OTHER PROJECT REPRESENTATIVE. THE SITE DESIGN ENGINEER SHALL REVIEW THIS DRAWING PRIOR TO CONSTRUCTION. IT IS THE ULTIMATE RESPONSIBILITY OF THE SITE DESIGN ENGINEER TO ENSURE THAT THE PRODUCT(S) DEPICTED AND ALL ASSOCIATED DETAILS MEET ALL APPLICABLE LAWS, REGULATIONS, AND PROJECT REQUIREMENTS.

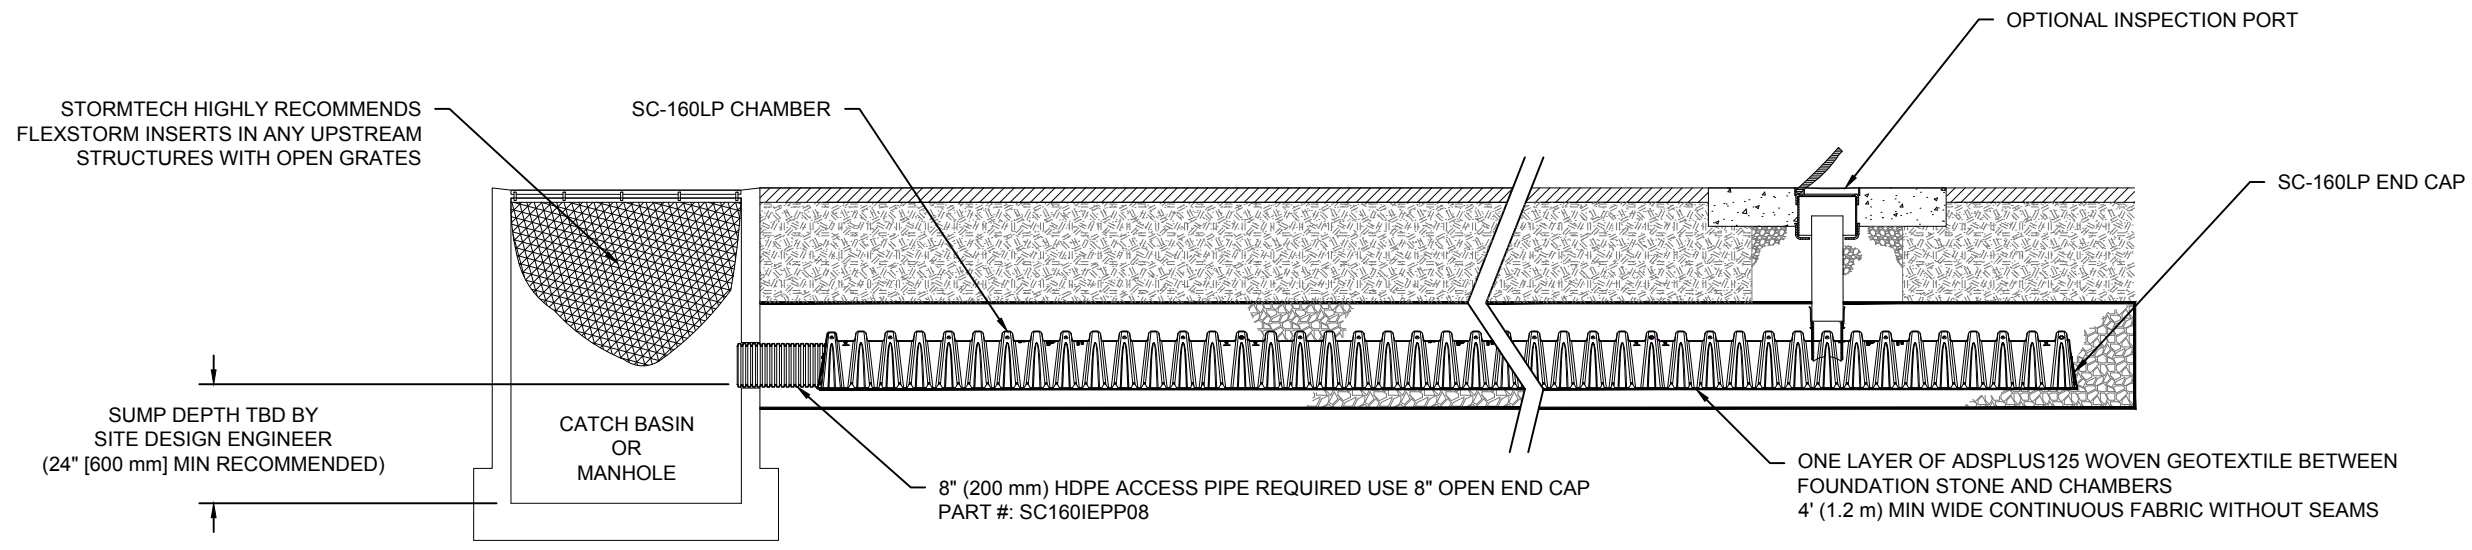

SC-160LP ISOLATOR ROW PLUS DETAIL
NTS

INSPECTION & MAINTENANCE


- STEP 1) INSPECT ISOLATOR ROW PLUS FOR SEDIMENT
- A. INSPECTION PORTS (IF PRESENT)
 - A.1. REMOVE/OPEN LID ON NYLOPLAST INLINE DRAIN
 - A.2. REMOVE AND CLEAN FLEXSTORM FILTER IF INSTALLED
 - A.3. USING A FLASHLIGHT AND STADIA ROD, MEASURE DEPTH OF SEDIMENT AND RECORD ON MAINTENANCE LOG
 - A.4. LOWER A CAMERA INTO ISOLATOR ROW PLUS FOR VISUAL INSPECTION OF SEDIMENT LEVELS (OPTIONAL)
 - A.5. IF SEDIMENT IS AT, OR ABOVE, 3" (80 mm) PROCEED TO STEP 2. IF NOT, PROCEED TO STEP 3.
 - B. ALL ISOLATOR PLUS ROWS
 - B.1. REMOVE COVER FROM STRUCTURE AT UPSTREAM END OF ISOLATOR ROW PLUS
 - B.2. USING A FLASHLIGHT, INSPECT DOWN THE ISOLATOR ROW PLUS THROUGH OUTLET PIPE
 - i) MIRRORS ON POLES OR CAMERAS MAY BE USED TO AVOID A CONFINED SPACE ENTRY
 - ii) FOLLOW OSHA REGULATIONS FOR CONFINED SPACE ENTRY IF ENTERING MANHOLE
 - B.3. IF SEDIMENT IS AT, OR ABOVE, 3" (80 mm) PROCEED TO STEP 2. IF NOT, PROCEED TO STEP 3.
- STEP 2) CLEAN OUT ISOLATOR ROW PLUS USING THE JETVAC PROCESS
- A. A FIXED CULVERT CLEANING NOZZLE WITH REAR FACING SPREAD OF 45" (1.1 m) OR MORE IS PREFERRED
 - B. APPLY MULTIPLE PASSES OF JETVAC UNTIL BACKFLUSH WATER IS CLEAN
 - C. VACUUM STRUCTURE SUMP AS REQUIRED
- STEP 3) REPLACE ALL COVERS, GRATES, FILTERS, AND LIDS; RECORD OBSERVATIONS AND ACTIONS.
- STEP 4) INSPECT AND CLEAN BASINS AND MANHOLES UPSTREAM OF THE STORMTECH SYSTEM.

NOTES



1. INSPECT EVERY 6 MONTHS DURING THE FIRST YEAR OF OPERATION. ADJUST THE INSPECTION INTERVAL BASED ON PREVIOUS OBSERVATIONS OF SEDIMENT ACCUMULATION AND HIGH WATER ELEVATIONS.
2. CONDUCT JETTING AND VACTORING ANNUALLY OR WHEN INSPECTION SHOWS THAT MAINTENANCE IS NECESSARY.

TWAS S MAIN	ROLESVILLE, NC, USA	DATE:	DRAWN: KH	CHECKED: N/A
		PROJECT #:		
		DESCRIPTION	CHK	DATE
		DRW	CHK	DATE
StormTech® Chamber System		888-892-2694 WWW.STORMTECH.COM		
4640 TRUEMAN BLVD HILLIARD, OH 43026 1-800-733-7473				
THIS DRAWING HAS BEEN PREPARED BASED ON INFORMATION PROVIDED TO ADS UNDER THE DIRECTION OF THE SITE DESIGN ENGINEER OR OTHER PROJECT REPRESENTATIVE. THE SITE DESIGN ENGINEER SHALL REVIEW THIS DRAWING PRIOR TO CONSTRUCTION. IT IS THE ULTIMATE RESPONSIBILITY OF THE SITE DESIGN ENGINEER TO ENSURE THAT THE PRODUCT(S) DEPICTED AND ALL ASSOCIATED DETAILS MEET ALL APPLICABLE LAWS, REGULATIONS, AND PROJECT REQUIREMENTS.				

UNDERDRAIN DETAIL

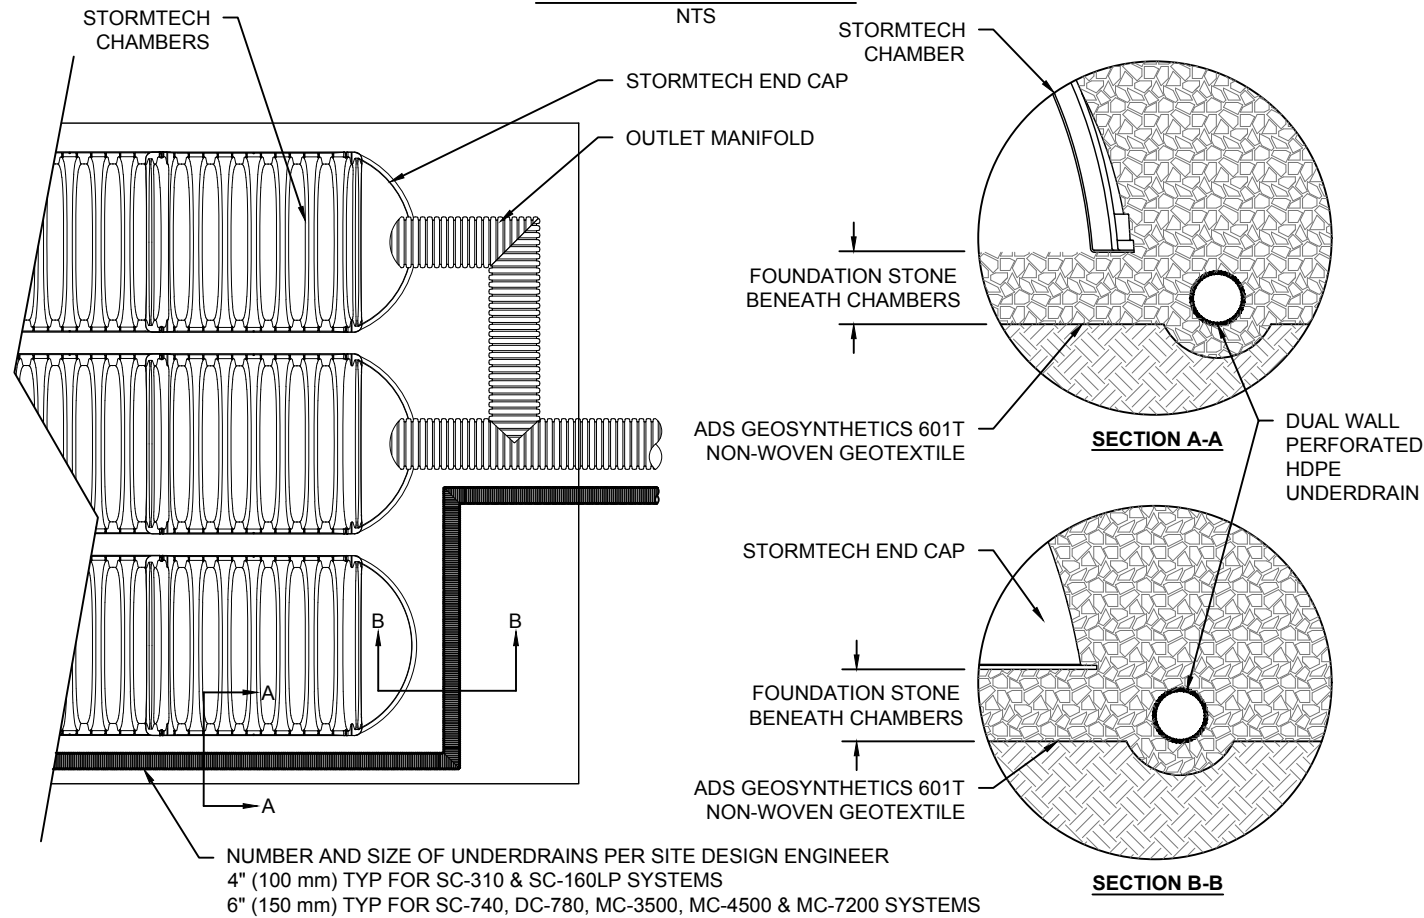

SC-160LP TECHNICAL SPECIFICATION

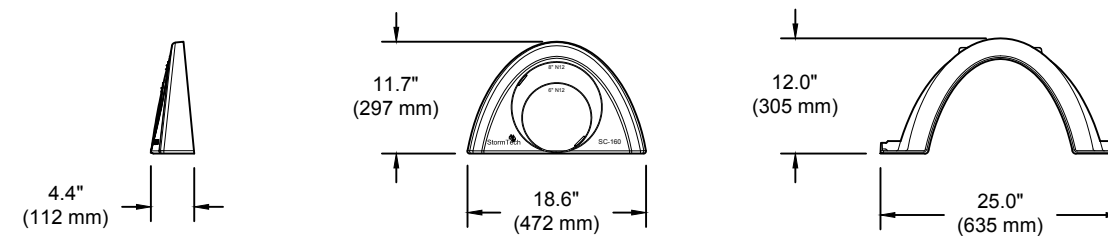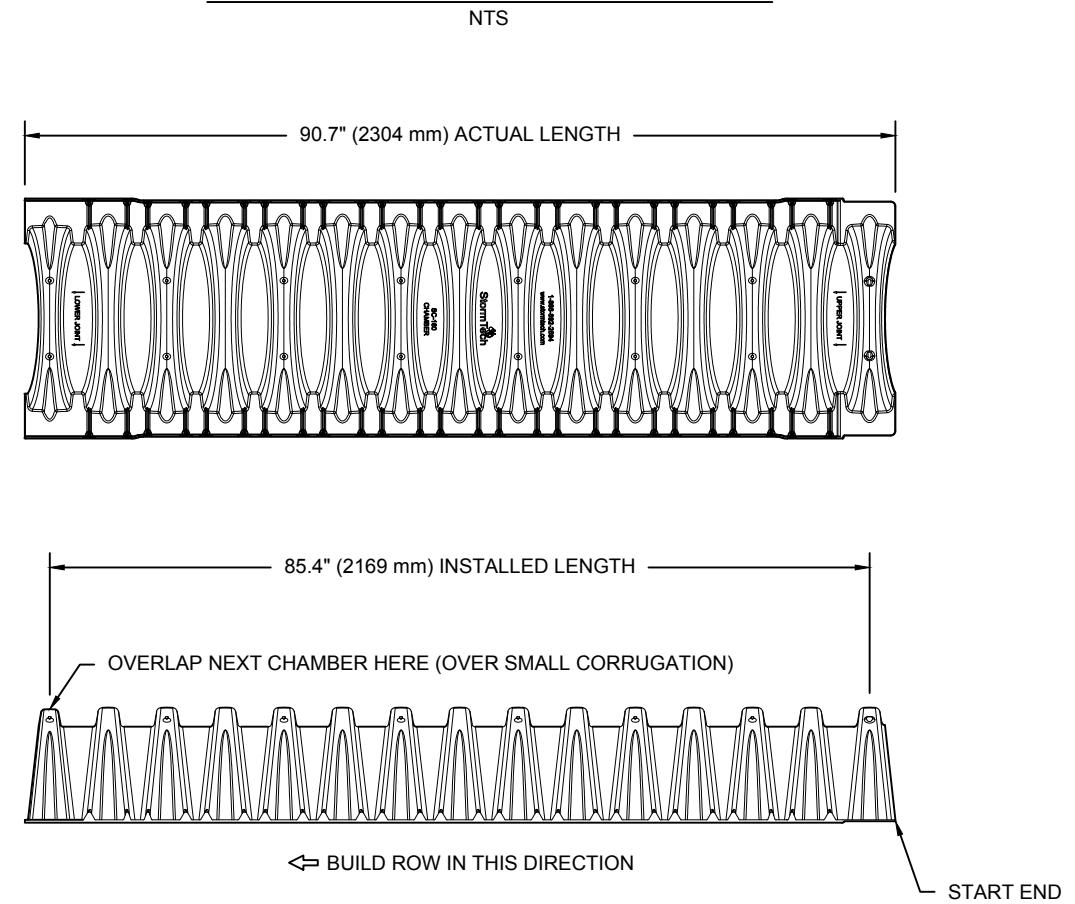

NOMINAL CHAMBER SPECIFICATIONS


SIZE (W X H X INSTALLED LENGTH)	25.0" X 12.0" X 85.4"	(635 mm X 305 mm X 2169 mm)
CHAMBER STORAGE	6.85 CUBIC FEET	(0.19 m ³)
MINIMUM INSTALLED STORAGE*	16.0 CUBIC FEET	(0.45 m ³)
WEIGHT	24.0 lbs.	(10.9 kg)

*ASSUMES 6" (152 mm) ABOVE, 6" (152 mm) BELOW, AND STONE BETWEEN CHAMBERS WITH 40% STONE POROSITY.

PART #	STUB	A
SC160EPP	6" (150 mm)	0.66" (16 mm)
	8" (200 mm)	0.80" (20 mm)
SC160EPP08	8" (200 mm)	0.96" (24 mm)

ALL STUBS ARE PLACED AT BOTTOM OF END CAP SUCH THAT THE OUTSIDE DIAMETER OF THE STUB IS FLUSH WITH THE BOTTOM OF THE END CAP. FOR ADDITIONAL INFORMATION CONTACT STORMTECH AT 1-888-892-2694.

NOTE: ALL DIMENSIONS ARE NOMINAL

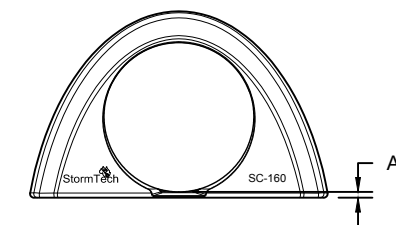

TWAS S MAIN
 ROLESVILLE, NC, USA

DATE: _____
 DRAWN: KH
 PROJECT #: _____
 CHECKED: N/A

DATE	DRW	CHK	DESCRIPTION

StormTech®
 Chamber System
 888-892-2694 | WWW.STORMTECH.COM

4640 TRUEMAN BLVD
 HILLIARD, OH 43026
 1-800-733-7473

ADS

THIS DRAWING HAS BEEN PREPARED BASED ON INFORMATION PROVIDED TO ADS UNDER THE DIRECTION OF THE SITE DESIGN ENGINEER OR OTHER PROJECT REPRESENTATIVE. THE SITE DESIGN ENGINEER SHALL REVIEW THIS DRAWING PRIOR TO CONSTRUCTION. IT IS THE ULTIMATE RESPONSIBILITY OF THE SITE DESIGN ENGINEER TO ENSURE THAT THE PRODUCT(S) DEPICTED AND ALL ASSOCIATED DETAILS MEET ALL APPLICABLE LAWS, REGULATIONS, AND PROJECT REQUIREMENTS.

GENERAL NOTES:

- SEE EROSION CONTROL PLANS (SHEETS C4.1 - C4.3) FOR SILT FENCE LOCATIONS, TREE PROTECTION ZONES AND BARRICADES, AND ADDITIONAL NOTES AND DETAILS.
- FOR TREE REMOVALS, PLEASE REFER TO SHEETS C3.1.
- FOR REQUIRED TREE MITIGATION AND DEVELOPMENT INCHES PER THE TOWN OF ROLESVILLE ZONING ORDINANCE, PLEASE REFER TO SHEET L1.1 FOR PLANT SCHEDULE QUANTITY AND SIZES.
- THE OVERALL PLANT QUANTITY FOR THE ENTIRE SITE CAN BE FOUND ON THE MASTER PLAN SCHEDULE, SHEET L-1.1.
- SEE SITE PLAN [C5.1] FOR SITE LABELS, INFORMATION AND DETAILS.
- CONTRACTOR TO CONTACT CIVIL ENGINEER OR LANDSCAPE ARCHITECT REGARDING ANY SITE WORK MODIFICATIONS FROM THESE PLANS PRIOR TO CHANGES IN THE FIELD.
CONTACT: 980-312-5450

OPEN SPACE

SITE AREA = 79,279.2 SF
OPEN SPACE REQUIREMENTS = 5% OF TOTAL SITE AREA
OPEN SPACE REQUIRED = 3,964 SF
OPEN SPACE PROVIDED = 4,293 SF

US HWY 401 / LOUISBURG ROAD (317 LF)			
	STREET BUFFER	PLANTINGS REQUIRED	PLANTINGS PROVIDED
MINIMUM BUFFER WIDTH	30' MIN.		
CANOPY TREE	1 TREE PER 40 LF	1	1
UNDERSTORY TREE*	2 TREES PER 40 LF	14	14

*UNDERSTORY TREES SHALL BE USED WHERE OVERHEAD UTILITIES CONFLICTS WITH STREET BUFFER


PLANT SCHEDULE HWY 401 BUFFER										
SYMBOL	CODE	QTY	BOTANICAL / COMMON NAME	SIZE	HEIGHT	SPREAD	SPACING	REMARKS		
TREES										
○	QUEP	1	QUERCUS PALUSTRIS / PIN OAK	2.5" CAL	8' MIN	4'-6"		AS SHOWN	FWF, SP	
UNDERSTORY TREES										
+	CERO	2	CERCIS CANADENSIS 'OKLAHOMA' / OKLAHOMA REDBUD	1.5" CAL	8' MIN	8'		AS SHOWN	FWF, SP	
○	CHIV	7	CHIONANTHUS VIRGINICUS / WHITE FRINGETREE	1.5" CAL	8' MIN	8'		AS SHOWN	FWF, SP	
○	MAGS	5	MAGNOLIA X SOULANGIANA / SAUCER MAGNOLIA	1.5" CAL	8' MIN	8'		AS SHOWN	MS, FWF, SP	

GRAND PARK DRIVE (275 LF)			
	STREET BUFFER	PLANTINGS REQUIRED	PLANTINGS PROVIDED
MINIMUM BUFFER WIDTH	10' MIN.		
CANOPY TREE	1 TREE PER 60 LF	5	6 (1 PROPOSED TREE, 5 EX. TREES TO REMAIN)

PLANT SCHEDULE GRAND PARK DRIVE										
SYMBOL	CODE	QTY	BOTANICAL / COMMON NAME	SIZE	HEIGHT	SPREAD	SPACING	REMARKS		
TREES										
○	QUEP	1	QUERCUS PALUSTRIS / PIN OAK	2.5" CAL	8' MIN	4'-6"		AS SHOWN	FWF, SP	

PLANT SCHEDULE										
SYMBOL	CODE	QTY	BOTANICAL / COMMON NAME	SIZE	HEIGHT	SPREAD	SPACING	REMARKS		
TREES										
○	ACRO	3	ACER RUBRUM 'OCTOBER GLORY'™ / OCTOBER GLORY MAPLE							
○	ILEO	2	ILEX OPACA / AMERICAN HOLLY							
○	QUEP	4	QUERCUS PALUSTRIS / PIN OAK							
UNDERSTORY TREES										
+	CERO	2	CERCIS CANADENSIS 'OKLAHOMA' / OKLAHOMA REDBUD							
○	CHIV	7	CHIONANTHUS VIRGINICUS / WHITE FRINGETREE							
○	MAGS	5	MAGNOLIA X SOULANGIANA / SAUCER MAGNOLIA							
SHRUBS										
○	ABES	21	ABELIA X GRANDIFLORA 'SHERWOOD' / DWARF ABELIA							
○	AZAF	10	AZALEA INDICA 'FORMOSA' / FORMOSA AZALEA							
○	ILCB	21	ILEX CORNUTA 'BURFORDI NANA' / DWARF BURFORD HOLLY							
○	LCRR	29	LOREPETALUM CHINENSIS RUBRUM 'RUBY' / DWARF RUBY FRINGE FLOWER							
○	PODM	10	PODOCARPUS MACROPHYLLUS / SOUTHERN YEW							
GRASSES										
○	MUHL	16	MUHLENBERGIA FILIPES / SWEETGRASS							
○	PANV	11	PANICUM VIRGATUM 'HEAVY METAL' / HEAVY METAL SWITCH GRASS							
GROUND COVERS										
○	LMBB	207	LIRIOPE MUSCARI 'BIG BLUE' / BIG BLUE LILYTURF							
SOD/SEED										
○	SOD2	29,634 SF	CYNODON DACTYLON 'TIFTUF' / TIFTUF BERMUDA GRASS							

- TIDAL WAVE LANDSCAPE NOTES**
- ALL DISTURBED AREAS NOT COVERED BY STRUCTURES, PAVING OR LANDSCAPING SHALL BE SODDED. NO SEEDING SHALL BE USED.
 - ALL PLANT BEDS SHALL BE UNDERLAIN WITH LANDSCAPING FABRIC AND HAVE 3" OF DYED BROWN OR BLACK WOOD MULCH WITH EDGING AS REQUIRED. NO PINE STRAW MULCH WILL BE ALLOWED.
 - ALL RIVER ROCK SHALL BE 4"-6" MINIMUM IN DIAMETER AND SHALL BE UNDERLAIN WITH LANDSCAPING FABRIC.
 - AN UNDERGROUND IRRIGATION SYSTEM, SHALL BE INSTALLED AND SHALL COMPLY WITH ALL LOCAL MUNICIPAL CODES AND REGULATIONS AND ALSO COMPLY WITH THE LATEST NATIONAL ELECTRIC CODE RULES FOR ALL ELECTRIC WORKS AND MATERIALS.
 - IF THERE IS NO PLANT BED AGAINST THE CAR WASH TUNNEL, VAC HOUSE(S), OR DUMPSTER ENCLOSURE, THEN THERE SHALL BE A 18 INCH MINIMUM STRIP OF RIVER ROCK INSTALLED.

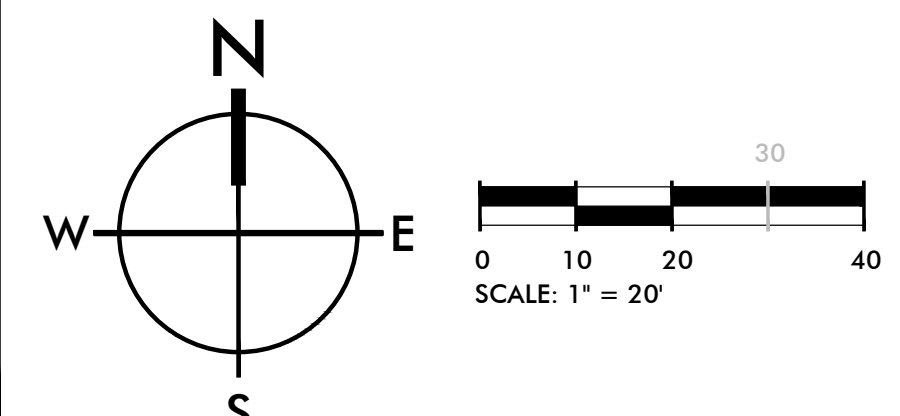

501 WANDO PARK BOULEVARD, SUITE 200 | MOUNT PLEASANT, SC 29546 | JUDSON MILLS BUILDING 6000, 701 EASLEY BROOK RD, SUITE 600 | GREENVILLE, SC 29611 | 230 PETERSON DR. | SUMMERVILLE, SC 29585 | 104 N. DANIEL MORGAN AVENUE, SUITE 300 | SPARTANBURG, SC 29301

- GENERAL PLANTING NOTES:**
- THE LANDSCAPE CONTRACTOR SHALL MEET WITH LANDSCAPE ARCHITECT PRIOR TO BEGINNING WORK SO THAT THERE IS A CLEAR UNDERSTANDING OF PROJECT REQUIREMENTS. FAILURE TO DO SO JEOPARDIZES FINAL ACCEPTANCE OF WORK.
 - THE LANDSCAPE CONTRACTOR IS HEREBY NOTIFIED OF THE EXISTENCE OF UNDERGROUND UTILITIES WITHIN THE LIMITS OF THE PROJECT AREA. THE LANDSCAPE CONTRACTOR SHALL VERIFY THE EXACT LOCATION OF ALL UTILITY LINES PRIOR TO COMMENCEMENT OF DIGGING OPERATIONS. THE LANDSCAPE CONTRACTOR WILL BE RESPONSIBLE FOR LOCATING, PROTECTING, AND REPAIRING ALL DAMAGE TO BUILDINGS, UTILITIES, PAVEMENT, AND CURB & GUTTER. ANY REPAIRS SHALL BE DONE PROMPTLY AT LANDSCAPE CONTRACTOR'S EXPENSE. THE WATER CONTRACTOR MUST ADVISE THE LANDSCAPE ARCHITECT IMMEDIATELY OF ANY POSSIBLE CONFLICTS BETWEEN PROPOSED IMPROVEMENTS AND UTILITIES, SIGNS, AND/OR OTHER STRUCTURES.
 - IT IS THE RESPONSIBILITY OF THE LANDSCAPE CONTRACTOR TO VERIFY THAT EACH EXCAVATED TREE OR SHRUB PIT WILL PERCOLATE (DRAIN) PRIOR TO ADDING TOPSOIL AND INSTALLING TREES OR SHRUBS. THE LANDSCAPE CONTRACTOR SHALL FILL THE BOTTOM OF HOLES WITH SIX (6) INCHES OF TOPSOIL. THIS WATER SHOULD PERCOLATE WITHIN A TWENTY-FOUR (24) HOUR PERIOD. IF WATER DOESN'T PERCOLATE, THE LANDSCAPE CONTRACTOR SHALL NOTIFY THE OWNER'S REPRESENTATIVE PRIOR TO INSTALLING PLANTS.
 - SHOULD THE LANDSCAPE CONTRACTOR ENCOUNTER UNSATISFACTORY SURFACE OR SUBSURFACE DRAINAGE CONDITIONS, SOIL DEPTH, LATENT SOILS, HARD PANS, STEAM OR OTHER UTILITY LINES OR OTHER CONDITIONS THAT WILL JEOPARDIZE THE HEALTH AND VIGOR OF THE PLANTS, THE LANDSCAPE CONTRACTOR MUST ADVISE THE LANDSCAPE ARCHITECT IN WRITING OF THE CONDITIONS PRIOR TO INSTALLING THE PLANTS. OTHERWISE, THE LANDSCAPE CONTRACTOR WARRANTS THAT THE PLANTING AREAS ARE SUITABLE FOR PROPER GROWTH AND DEVELOPMENT OF THE PLANTS TO BE INSTALLED.
 - THE LANDSCAPE CONTRACTOR WILL BE RESPONSIBLE FOR STAKING AND LAYOUT OF PLANTINGS ON THIS PROJECT. THE LANDSCAPE ARCHITECT OR OWNER SHALL BE ADVISED WHEN STAKES ARE READY FOR INSPECTION ON VARIOUS PLANTING AREAS. ALL LAYOUT WORK SHALL BE INSPECTED AND APPROVED BY THE LANDSCAPE ARCHITECT AND OWNER PRIOR TO OPENING ANY PLANTING PITS.
 - PLANT MATERIAL QUANTITIES PROVIDED IN THE PLANT SCHEDULE ARE FOR REFERENCE ONLY AND THE LANDSCAPE CONTRACTOR SHALL BE RESPONSIBLE FOR THE FINAL PLANT MATERIAL COUNTS. DISCREPANCIES BETWEEN QUANTITIES SHOWN ON THE PLANTING PLAN AND THOSE IN THE PLANT SCHEDULE SHALL BE BROUGHT TO THE ATTENTION OF THE LANDSCAPE ARCHITECT FOR CLARIFICATION. IF CLARIFICATION OF DISCREPANCIES FROM THE LANDSCAPE ARCHITECT IS NOT POSSIBLE, THEN QUANTITIES SHOWN ON THE PLANTING PLAN SHALL TAKE PRECEDENCE.**
 - REQUIREMENTS FOR THE MEASUREMENTS, BRANCHING, GRADING, QUALITY, BALLING AND BURLAPPING OF PLANTS IN THE PLANT LIST SHOULD FOLLOW OR EXCEED THE STANDARDS CURRENTLY RECOMMENDED BY THE AMERICAN ASSOCIATION OF NURSERYMEN, INC. IN THE AMERICAN STANDARD FOR NURSERY STOCKS (ANSI Z60.1), UNLESS OTHERWISE SPECIFIED, ANY SIZE SPECIFIED SHALL BE CONSIDERED MINIMUM. **MINIMUMS FOR HEIGHT, SPREAD, OR CALIPER SHALL TAKE PRECEDENCE OVER A SPECIFIED CONTAINER SIZE.**
 - ALL PLANTS SHALL HAVE A WELL FORMED HEAD WITH MINIMUM CALIPER, HEIGHT AND SPREAD OF THE SIDE BRANCHES AS SHOWN ON THE PLANT LIST. TRUNKS SHALL BE UNDAUNAGED AND TRAPEZOIDAL IN SHAPE AT THE SPECIES.
 - MEASUREMENT OF CONIFER HEIGHT SHALL INCLUDE NOT MORE THAN FIFTY (50) PER CENT OF THIS YEAR'S VERTICAL GROWTH (TOP CANDLE).
 - NO EXCAVATION OR PLANTING PIT SHALL BE LEFT UNATTENDED OVERNIGHT.
 - REMOVE BURLAP/STRAPPING AND WIRE BASKET FROM TOP 1/3 OF ROOT BALL ON TREES.
 - REMOVE PAPER, PLASTIC OR METAL AROUND ROOT BALLS OF SHRUBS.
 - DO NOT WRAP TREES.
 - WATER ALL PLANT MATERIAL IMMEDIATELY AFTER PLANTING.
 - TREE GUYING MATERIAL SHALL BE 'ARBOR-TIE' OR EQUIVALENT.
 - ALL PLANT BEDS TO BE MULCHED WITH 4" OF DOUBLE SHREDDED HARDWOOD MULCH UNLESS OTHERWISE SPECIFIED.
 - ALL AREAS OF PLANTING, INCLUDING AREAS OF GRASS SEEDING AND SOD, SHALL BE GRADED TO PROVIDE POSITIVE DRAINAGE AND SHALL BE PROVIDED APPROPRIATE SOIL FOR THE PROPOSED PLANTINGS. SEE SOIL NOTES.
 - ALL EXISTING VEGETATION WITHIN AREAS TO BE PLANTED, SODDED AND/OR SEEDS SHALL BE REMOVED PRIOR TO PLANTING, SODDING, AND SEEDING. ALL AREAS INDICATED TO BE GRASS SEED SHALL BE SEEDS PER GRASSING SPECIFICATIONS FOR PERMANENT STABILIZATION.
 - ALL DISTURBED AREAS NOT SPECIFICALLY CALLED OUT ON THIS PLAN SHALL BE SEEDS PER THE PROVIDED SEEDING SCHEDULE. ALL DISTURBED NATURAL AREAS SHALL BE MULCHED (SEE MULCH SPECIFICATIONS).
 - DRAINAGE TO BE PROVIDED FOR ALL ABOVE GROUND PLANTERS.
 - PLANTINGS SHALL BE PRUNED TO CONFORM WITH THE REQUIREMENTS OF ALL AUTHORITIES HAVING JURISDICTION, INCLUDING BUT NOT LIMITED TO THE CITY, COUNTY, STATE AND FEDERAL REQUIREMENTS.
 - THE LANDSCAPE CONTRACTOR SHALL BE RESPONSIBLE FOR CLEANING UP THE SITE AT THE COMPLETION OF THE PROJECT AND SHALL MAINTAIN THE SITE IN A REASONABLY NEAT AND CLEAN STATE THROUGHOUT THE INSTALLATION PROCESS. STREETS AND PAVED AREAS SHALL BE CLEANED REGULARLY TO REMOVE CONSTRUCTION MATERIALS AND OTHER DEBRIS RESULTING FROM WORK OF THE PROJECT.
 - REPLACEMENTS OF DEAD OR UNSATISFACTORY MATERIAL SHALL BE MADE AS SPECIFIED IN THE PLANT LIST. THE OWNER OR LANDSCAPE ARCHITECT SHALL INSPECT REPLACED PLANTS WHEN ALL REPLACEMENTS HAVE BEEN MADE. REPLACEMENTS ARE TO BE ALIVE AND IN A HEALTHY CONDITION WHEN THE REPLACEMENTS ARE COMPLETE. REPLACEMENTS ARE NOT SUBJECT TO AN ADDITIONAL GUARANTEE, BUT THE LANDSCAPE CONTRACTOR SHALL CONSULT WITH THE LANDSCAPE ARCHITECT ON REASON FOR PLANT DECLINE/DEATH AND HOW TO AVOID FUTURE INSTANCES.
 - SHOULD THE LANDSCAPE CONTRACTOR NOT MAKE REPLACEMENTS IN A SATISFACTORY AND TIMELY FASHION IN ACCORD WITH THE PLANTING NOTES, THE OWNER, AFTER PROPER NOTIFICATION TO THE LANDSCAPE CONTRACTOR MAY UTILIZE THE FUNDS OF THE RETAINAGE AND HAVE THE REPLACEMENTS MADE IN ACCORDANCE WITH THE SPECIFICATIONS BY ANOTHER CONTRACTOR.

- SOIL NOTES:**
- FOR EACH UNAMENDED SOIL TYPE, FURNISH SOIL ANALYSIS AND A WRITTEN REPORT BY A QUALIFIED SOIL-TESTING LABORATORY STATING PERCENTAGES OF ORGANIC MATTER, GRADATION OF SAND, SILT, AND CLAY CONTENT; CATION EXCHANGE CAPACITY; SODIUM ADSORPTION RATIO; DELETERIOUS MATERIAL, BUFFER PH LEVELS; AND MINERAL AND PLANT-NUTRIENT CONTENT OF THE SOIL.
 - A MINIMUM OF THREE REPRESENTATIVE SAMPLES SHALL BE TAKEN FROM VARIED LOCATIONS FOR EACH SOIL TO BE USED OR AMENDED FOR PLANTING PURPOSES.
 - LANDSCAPE CONTRACTOR SHALL SUBMIT TO LANDSCAPE ARCHITECT THE LAB RECOMMENDATIONS FOR SOIL TREATMENTS AND SOIL AMENDMENTS TO BE INCORPORATED. INDICATE LAB RECOMMENDATIONS IN WEIGHT PER 1000 SQ. FT. OR VOLUME PER CU. YD. FOR NITROGEN, PHOSPHORUS, AND POTASH NUTRIENTS AND ORGANIC AND INORGANIC SOIL AMENDMENTS TO BE ADDED TO PRODUCE PLANTING SOIL SUITABLE FOR HEALTHY, VIABLE PLANTS.
 - ALL SOILS USED FOR PLANTING SHALL BE PREPARED AS NECESSARY USING ORGANIC AND INORGANIC SOIL AMENDMENTS AND FERTILIZERS IN THE QUANTITIES RECOMMENDED IN THE SOIL ANALYSIS REPORT TO PRODUCE SATISFACTORY PLANTING SOIL FOR HEALTHY, VIABLE PLANTS. PLANTING SOILS SHALL HAVE A PH LEVEL BETWEEN 6.0 AND 7.0.
 - IN ALL PLANTING AREAS, SPREAD PLANTING SOIL TO A DEPTH OF 8 INCHES BUT NOT LESS THAN REQUIRED TO MEET FINISH GRADES AFTER NATURAL SETTLEMENT.


- IRRIGATION NOTES:**
- LANDSCAPE CONTRACTOR SHALL PROVIDE SHOP DRAWINGS OF PROPOSED IRRIGATION SYSTEM TO LANDSCAPE ARCHITECT AND OWNER FOR ACCEPTANCE. LANDSCAPE CONTRACTOR TO SUPPLY AUTOMATIC IRRIGATION SYSTEMS, COMPLETE AND INSTALLED. SYSTEM TO INCLUDE ALL VALVES, PIPES, HEADS, FITTINGS, RAIN SENSOR, AND CLOCK AND TO PROVIDE 100% HEAD TO HEAD COVERAGE OF ALL NEW SODDED AND IMPROVED EXISTING GRASS AREAS, TREES, SHRUBS AND PLANTING BEDS. COORDINATE IRRIGATION WITH OWNER'S REPRESENTATIVE.
 - LANDSCAPE CONTRACTOR SHALL OBTAIN ALL NECESSARY PERMITS FOR AUTOMATIC IRRIGATION SYSTEMS. LANDSCAPE CONTRACTOR SHALL PROVIDE ELECTRIC METER, BACKFLOW PREVENTER AND SERVICE IN ACCORDANCE WITH STATE AND LOCAL CODES FOR IRRIGATION SYSTEM. LOCATION OF METERS AND CONTROL PANELS FOR IRRIGATION SHALL BE APPROVED BY OWNER'S REPRESENTATIVE PRIOR TO INSTALLATION. COORDINATE WATER METER REQUIREMENTS WITH CIVIL ENGINEER.
 - LANDSCAPE CONTRACTOR TO PROVIDE DRIP IRRIGATION TO ALL ABOVE GROUND PLANTERS. IRRIGATION LINE TO BE INSTALLED BENEATH ADJACENT HARDSCAPE AS NECESSARY.
 - IRRIGATION PIPING, SPRINKLERS, AND OTHER EQUIPMENT MAY BE SHOWN OUTSIDE OF LANDSCAPE AREAS ON DRAWING FOR GRAPHIC CLARITY. ALL VES AND OTHER EQUIPMENT VALVES SHALL BE LOCATED IN MULCH BEDS.
 - NO IRRIGATION COMPONENTS, INCLUDING BUT NOT LIMITED TO, VALVE BOXES, CONTROL BOXES, BACKFLOW PREVENTERS, AND/OR RAIN SENSORS ARE ALLOWED TO BE INSTALLED WITHIN DEPARTMENT OF TRANSPORTATION RIGHT-OF-WAY.

- PLANT SCHEDULE NOTES:**
- THE TECHNICAL SPECIFICATIONS ARE MADE A PART OF THESE PLANS AND SHALL BE CONSULTED BY THE LANDSCAPE CONTRACTOR. THE LANDSCAPE CONTRACTOR IS RESPONSIBLE FOR IMPLEMENTING WORK AS SPECIFIED IN THE TECHNICAL SPECIFICATIONS AND ON THESE PLANS.
 - THE LANDSCAPE CONTRACTOR SHALL NOTIFY THIS OFFICE OF ANY DISCREPANCIES PRIOR TO BEGINNING OR CONTINUING WORK.
 - THERE WILL BE NO SUBSTITUTIONS, DELETIONS OR ADDITIONS WITHOUT APPROVAL OF THIS OFFICE.
 - SIZE OF PLANT MATERIALS SHALL CONFORM WITH THE CURRENT EDITION OF 'AMERICAN STANDARD FOR NURSERY STOCK' FOR NUMBER ONE GRADE NURSERY STOCK AS ADOPTED BY THE AMERICAN ASSOCIATION OF NURSERYMEN AND AMERICAN NATIONAL STANDARDS INSTITUTE.
 - THE QUANTITIES ON THE SCHEDULE ARE ONLY A GUIDE. ALL QUANTITIES SHALL BE VERIFIED BY THE LANDSCAPE CONTRACTOR ON THE PLANTING PLAN.

- ABBREVIATIONS:**
- | | | | |
|------------------------------|------------------------|--------------------------|------------------------|
| B&B = BALLED & BURLAPPED | CT = CLEAR TRUNK | GAL = GALLON CONTAINER | RF = REFOOLIATED |
| BR = BARE ROOT MATERIAL | ESP = ESPALIER | HC = HURRICANE CUT | SP = SPECIMEN MATERIAL |
| CAL = TRUNK CALIPER (MIN) | FTG = FULL TO GROUND | MS = MULTI-STEMMED TRUNK | TF = TREE FORM HABIT |
| CON = CONTAINERIZED MATERIAL | FWF = FULL WELL FORMED | OC = ON-CURCANE | TYP = TYPICAL |

1 Landscape Notes


SCALE: NOT TO SCALE

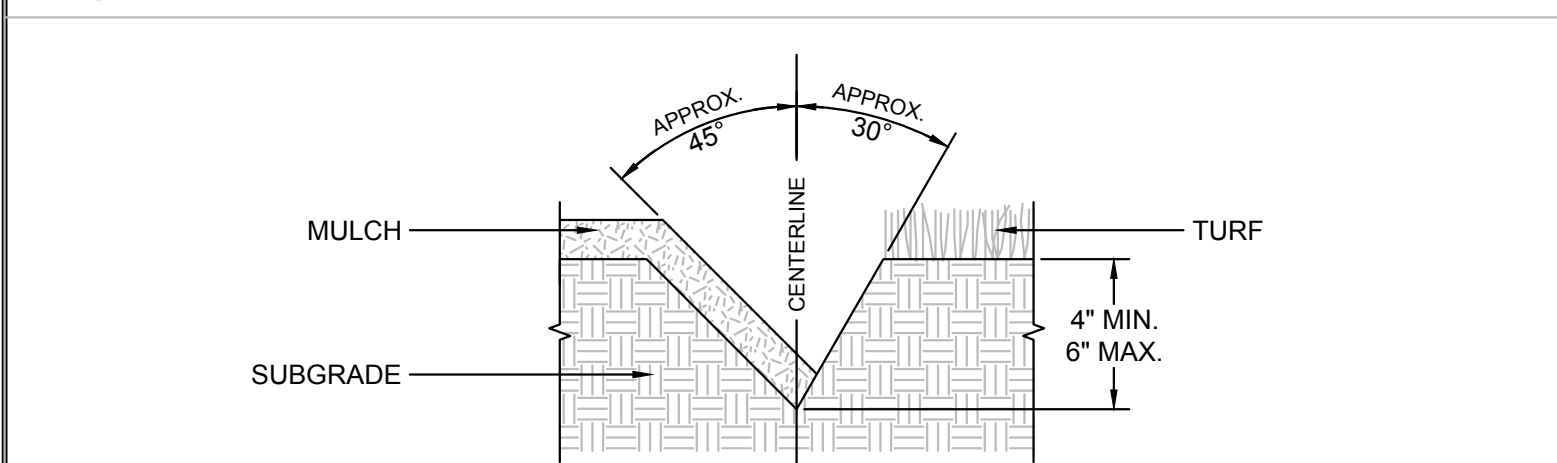

- NOTES:**
- SEE LANDSCAPE NOTES AND SPECIFICATIONS FOR FURTHER REQUIREMENTS RELATED TO THIS DETAIL.
 - EXCAVATE TRENCH BY HAND WITH SPADE.
 - ADD EXCESS SOIL TO ADJACENT PLANT BED AFTER PULLING BACK EXISTING MULCH. RAKE SOIL AND SMOOTH BEFORE MULCHING.

2 Lawn Edge Detail


SCALE: NOT TO SCALE

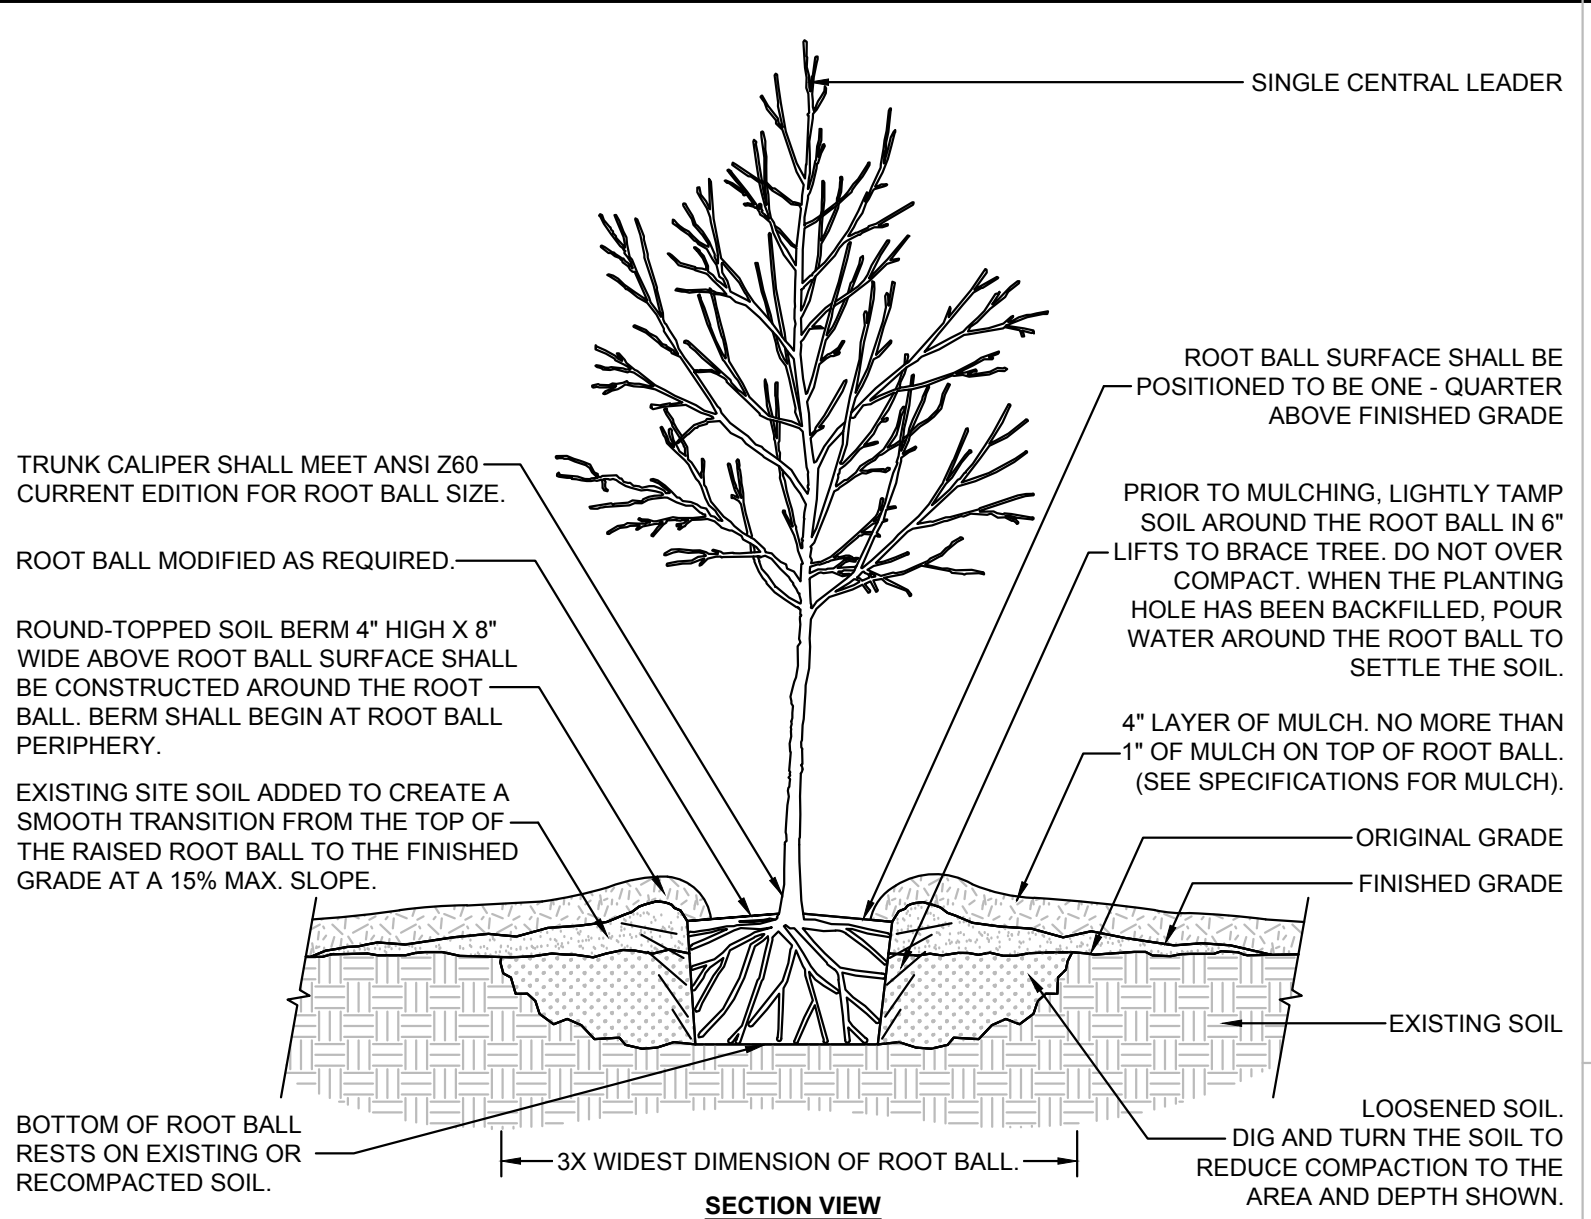

- NOTES:**
- SEE LANDSCAPE NOTES AND SPECIFICATIONS FOR FURTHER REQUIREMENTS RELATED TO THIS DETAIL.

3 Tree in Poorly Drained Soil


SCALE: NOT TO SCALE

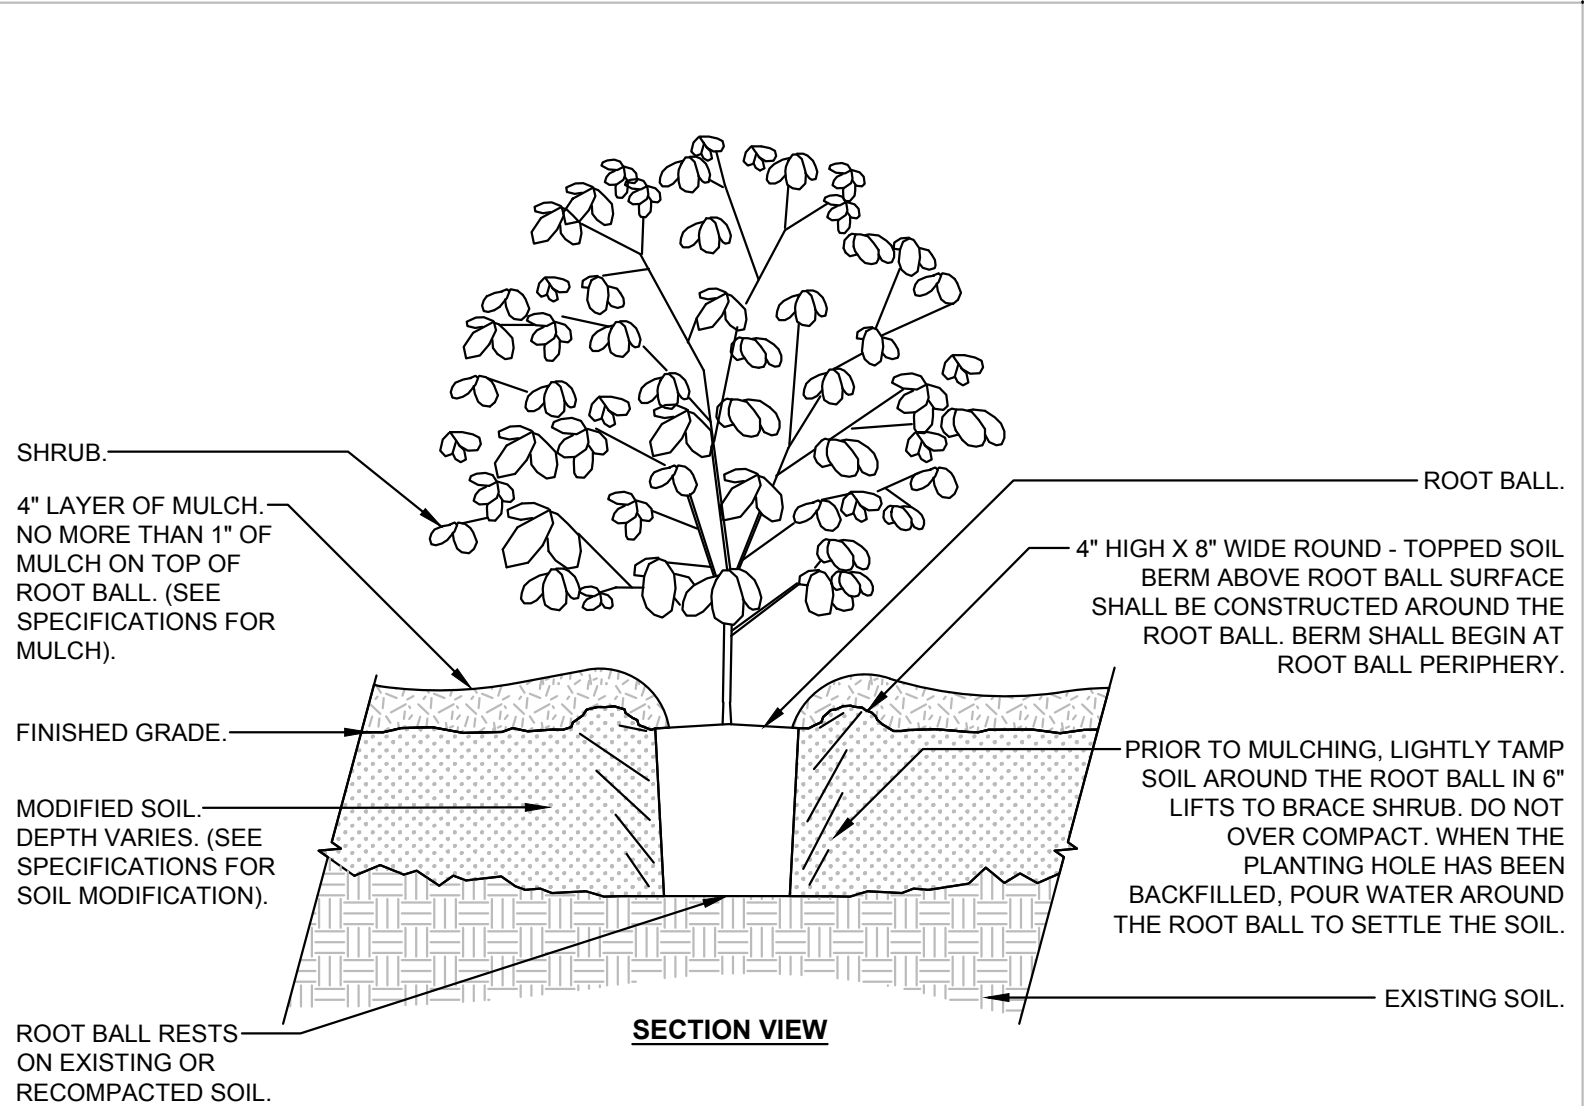

- NOTES:**
- SEE LANDSCAPE NOTES AND SPECIFICATIONS FOR FURTHER REQUIREMENTS RELATED TO THIS DETAIL.

4 Shrub Planting - Modified Soil


SCALE: NOT TO SCALE

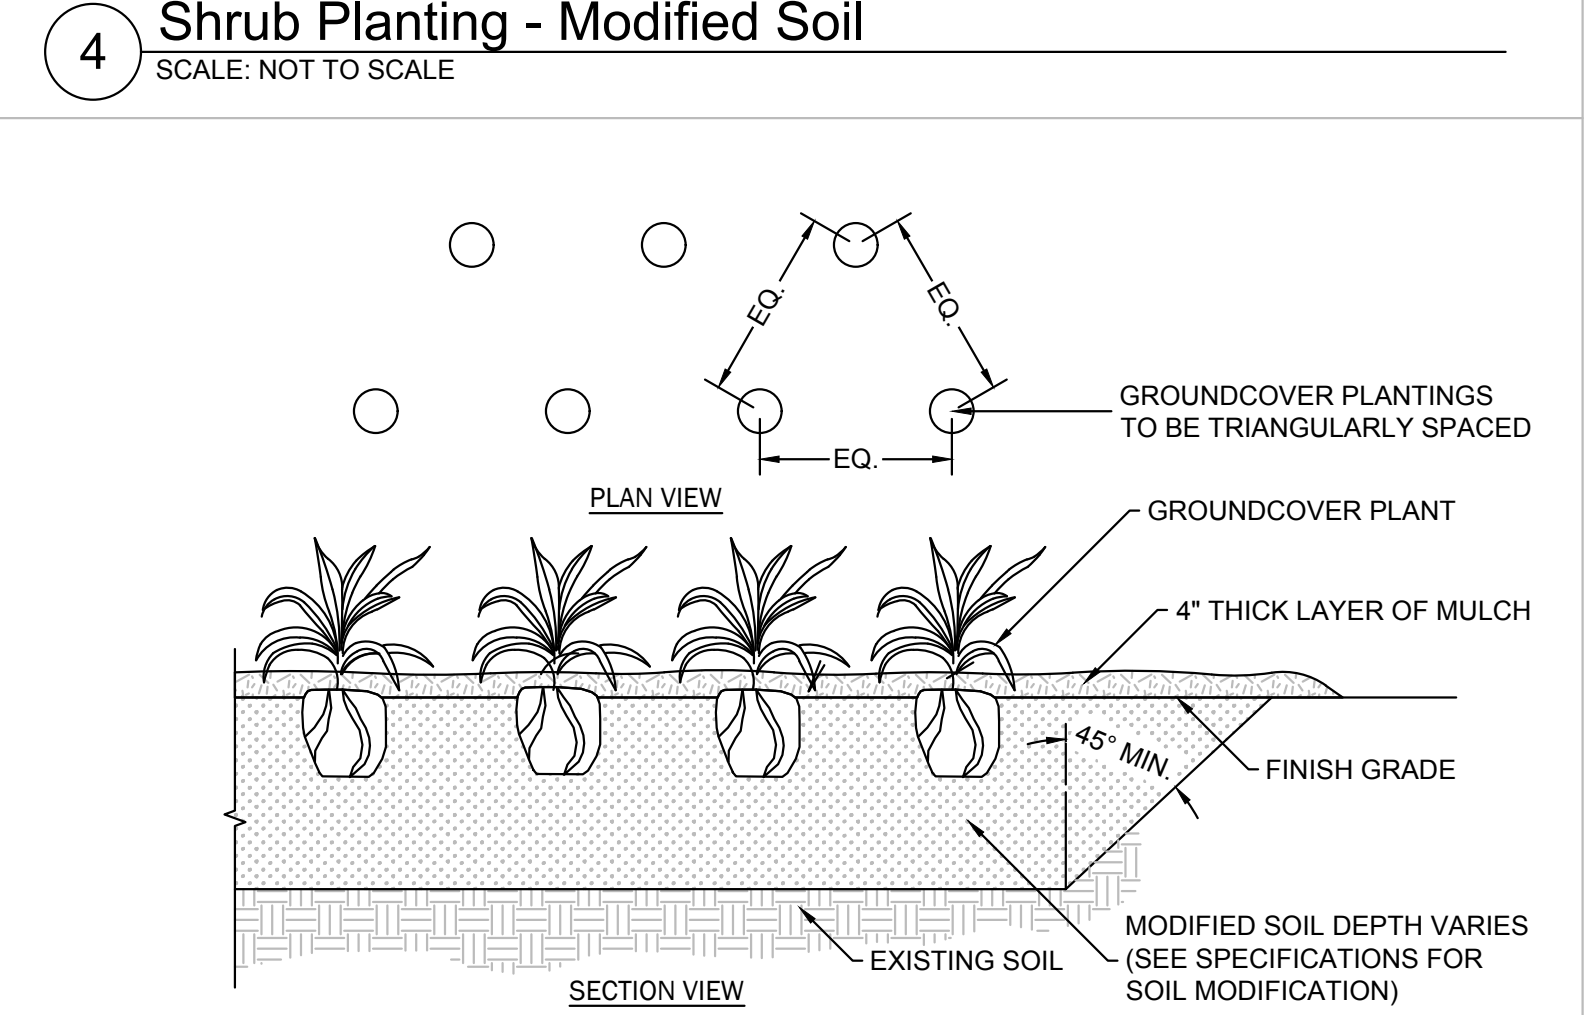

- NOTES:**
- SEE LANDSCAPE NOTES AND SPECIFICATIONS FOR FURTHER REQUIREMENTS RELATED TO THIS DETAIL.
 - SEE PLANT SCHEDULE FOR PLANT SPECIES, SIZE, AND SPACING DIMENSION.
 - SMALL ROOTS (1/2" OR LESS) THAT GROW AROUND, UP, OR DOWN THE ROOT BALL PERIPHERY ARE CONSIDERED A NORMAL CONDITION IN CONTAINER PRODUCTION AND ARE ACCEPTABLE HOWEVER THEY SHOULD BE ELIMINATED AT THE TIME OF PLANTING. ROOTS ON THE PERIPHERY CAN BE REMOVED AT THE TIME OF PLANTING.
 - THOROUGHLY TILL IN PLANTING SOIL MIXTURE AMENDMENTS TO DEPTH OF 8" IN ENTIRE GROUND COVER BED AREA. WORK SOIL TO LOOSE, UNIFORMLY FINE TEXTURE.
 - CONTRACTOR IS RESPONSIBLE FOR PROVIDING DRAINAGE FROM PLANTING HOLE/BEDS IF COMPACTED SOILS OR POORLY DRAINED SOIL IS ENCOUNTERED.
 - HAND-TAMP BACKFILL TO REMOVE VOIDS AND AIR POCKETS. WATER IMMEDIATELY AFTER PLANTING UNTIL NO MORE WATER IS ABSORBED.

5 Groundcover / Ornamental Grass Planting Detail

SCALE: NOT TO SCALE

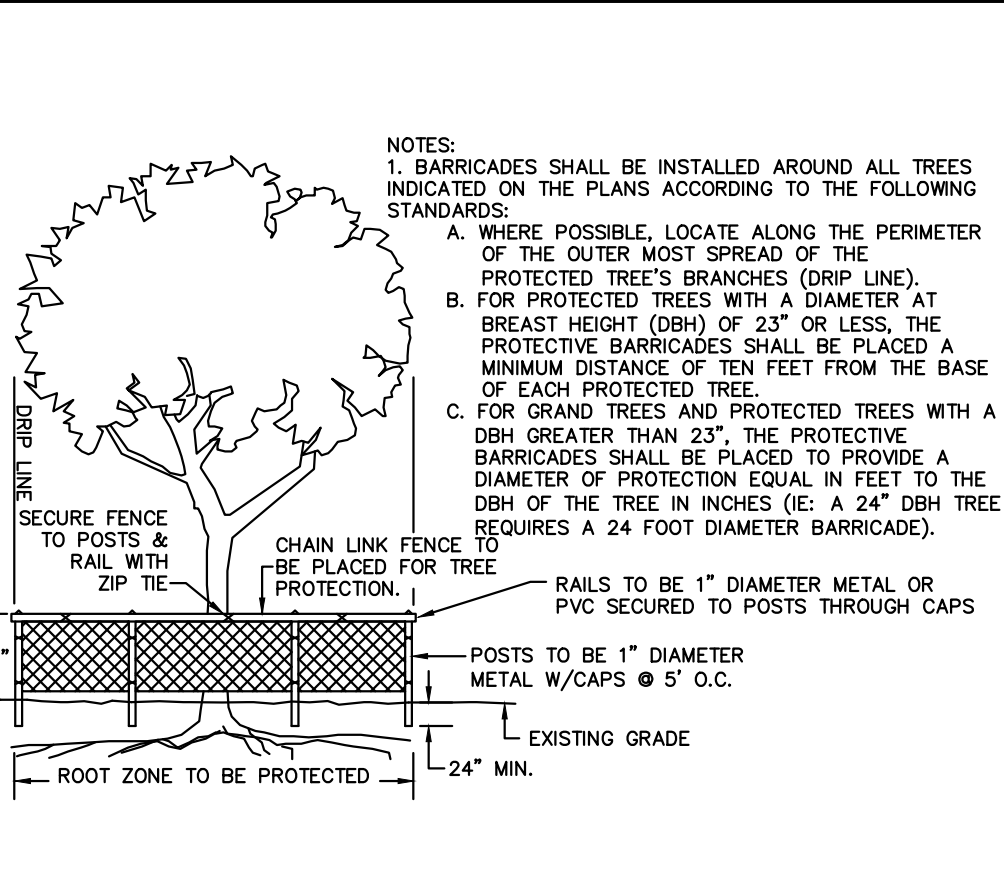

7 Tree Protection

SCALE: NOT TO SCALE

8 Bench

SCALE: NOT TO SCALE



MANUFACTURER	BELSON OUTDOORS
PRODUCT	CBP6-6SB-BK
WEBSITE	BELSON.COM
MATERIAL	STEEL
COLOR	BLACK
FINISH	RIVER
MOUNTING	SURFACE MOUNT
REMARKS	INSTALL PER MANUFACTURER SPECIFICATIONS
QUANTITY	1

9 Trash And Recycling Receptacles

SCALE: NOT TO SCALE



MANUFACTURER	BELSON OUTDOORS
PRODUCT	TR1953
WEBSITE	BELSON.COM
MATERIAL	PLASTIC
COLOR	CHARCOAL
FINISH	N/A
MOUNTING	N/A
REMARKS	ONE RECEPTACLE WILL HAVE RECYCLING DECAL AND THE OTHER WILL HAVE TRASH DECAL
QUANTITY	2

PLANT SCHEDULE								
SYMBOL	CODE	QTY	BOTANICAL / COMMON NAME	SIZE	HEIGHT	SPREAD	SPACING	REMARKS
TREES								
	ACRO	3	ACER RUBRUM 'OCTOBER GLORY' TM / OCTOBER GLORY MAPLE	2.5" CAL	8' MIN	4'-6"	AS SHOWN	FWF, SP
	ILEO	2	ILEX OPACA / AMERICAN HOLLY	2.5" CAL	6'-8"	4'-6"	AS SHOWN	FWF, SP
	QUEP	4	QUERCUS PALUSTRIS / PIN OAK	2.5" CAL	8' MIN	4'-6"	AS SHOWN	FWF, SP
UNDERSTORY TREES								
	CERO	2	CERCIS CANADENSIS 'OKLAHOMA' / OKLAHOMA REDBUD	1.5" CAL	8' MIN	8'	AS SHOWN	FWF, SP
	CHIV	7	CHIONANTHUS VIRGINICUS / WHITE FRINGETREE	1.5" CAL	8' MIN	8'	AS SHOWN	FWF, SP
	MAGS	5	MAGNOLIA X SOULANGIANA / SAUCER MAGNOLIA	1.5" CAL	8' MIN	8'	AS SHOWN	MS, FWF, SP
SHRUBS								
	ABES	21	ABELIA X GRANDIFLORA 'SHERWOODII' / DWARF ABELIA	3 GAL	18"-24"	18"-24"	AS SHOWN	FWF, SP
	AZAF	10	AZALEA INDICA 'FORMOSA' / FORMOSA AZALEA	3 GAL	18"-24"	18"-24"	AS SHOWN	FWF, SP
	ILCB	21	ILEX CORNUTA 'BURFORDII NANA' / DWARF BURFORD HOLLY	3 GAL	18"-24"	18"-24"	AS SHOWN	FWF, SP
	LCRR	29	LOROPETALUM CHINENSE RUBRUM 'RUBY' / DWARF RUBY FRINGE FLOWER	3 GAL	18"-24"	18"-24"	AS SHOWN	FWF, SP
	PODM	10	PODOCARPUS MACROPHYLLUS / SOUTHERN YEW	3 GAL	18"-24"	18"-24"	AS SHOWN	FWF, SP
GRASSES								
	MUHL	16	MUHLENBERGIA FILIPES / SWEETGRASS	3 GAL	18"-24"	18"-24"	AS SHOWN	FWF, SP
	PANV	11	PANICUM VIRGATUM 'HEAVY METAL' / HEAVY METAL SWITCH GRASS	3 GAL	18"-24"	18"-24"	AS SHOWN	FWF, SP
GROUND COVERS								
	LMBB	207	LIRIOPE MUSCARI 'BIG BLUE' / BIG BLUE LILYTURF	4" POT	8"-12"	8"-12"	24"	FWF, SP
SOD/SEED								
	SOD2	29,634 SF	CYNODON DACTYLON 'TIFTUF' / TIFTUF BERMUDA GRASS	SOD	N/A	N/A	N/A	SP

6 Plant Schedule

SCALE: NOT TO SCALE

SEAMON WHITESIDE

MOUNT PLEASANT, SC
843.884.1667


GREENVILLE, SC
864.298.0534

SUMMERVILLE, SC
843.972.0710

SPARTANBURG, SC
864.272.1272

CHARLOTTE, NC
980.312.5450

WWW.SEAMONWHITESIDE.COM

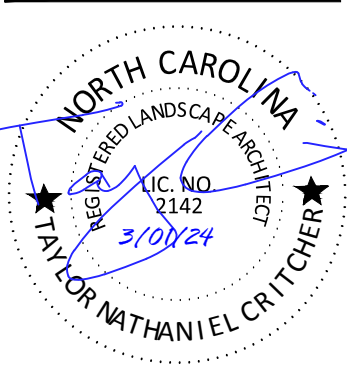

TIDAL WAVE AUTO SPA

ROLESVILLE, NC

SW+ PROJECT: 10772
DATE: 3/01/24
DRAWN BY: CPE
CHECKED BY: TLL

REVISION HISTORY

PLANT SCHEDULE & DETAILS & NOTES