



Comment #2

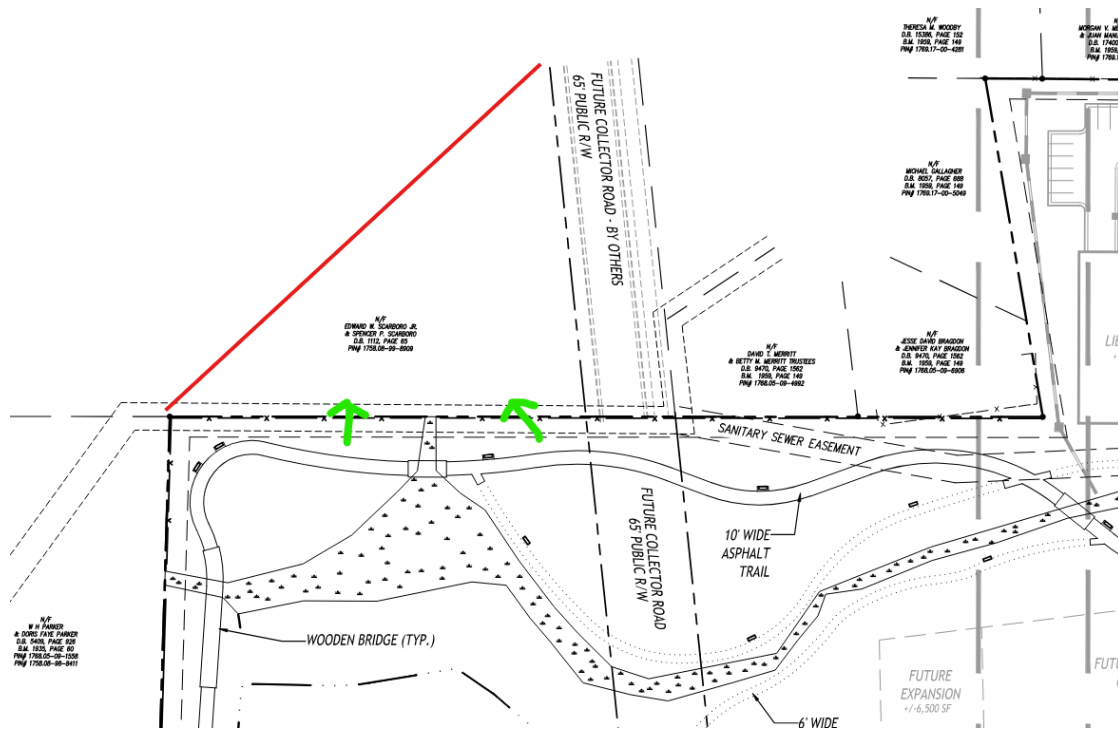

Comment #3

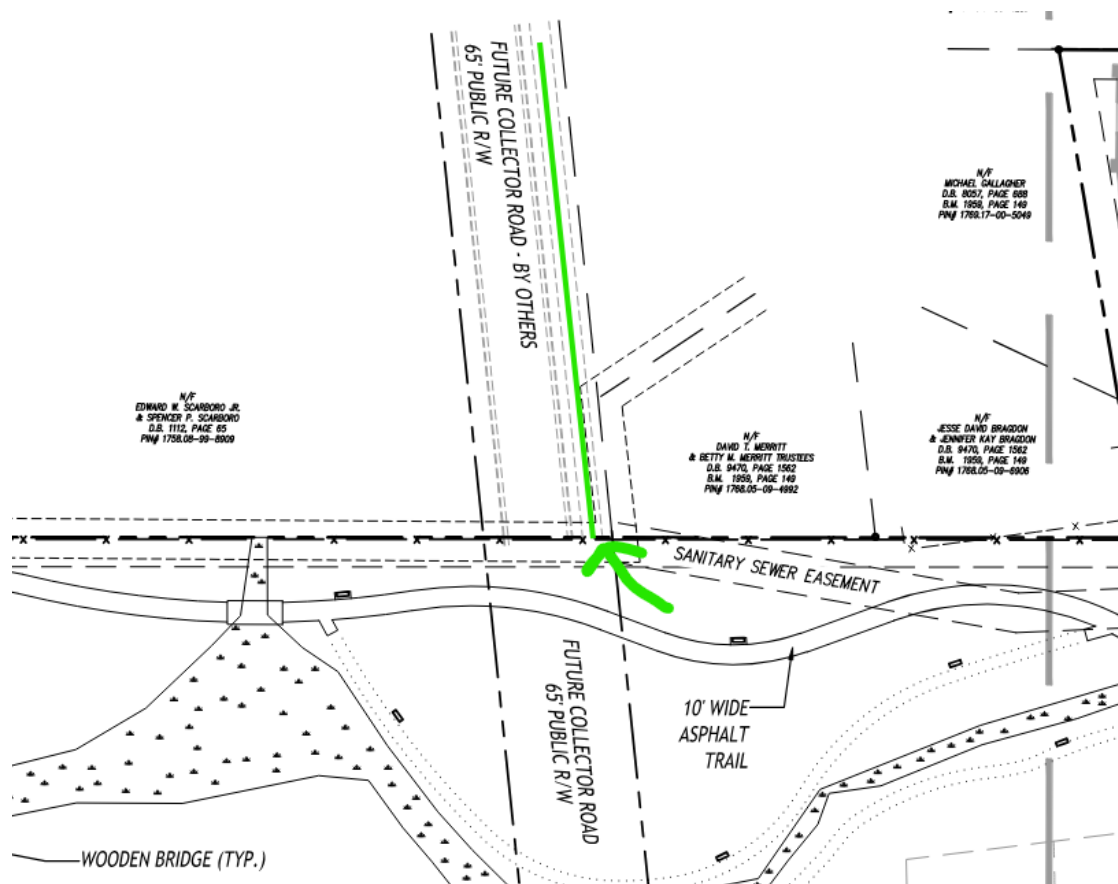

Comment #4

