

GENERAL NOTES

1. FOR GENERAL NOTES, SEE SHEET 1.

Please add NC Grid coordinates or appropriate tie. If GPS was used to establish the coordinates, please add the GPS survey statement to the face of the plat

Please add adjoiners and references



McADAMS
The John R. McAdams Company, Inc.
2905 Meridian Parkway
Durham, NC 27713
phone 919. 361. 5000
fax 919. 361. 2269
license number: C-0293, C-187
www.mcadamsco.com

CLIENT

ASHTON RALEIGH RESIDENTIAL, LLC
5711 SIX FORKS ROAD, SUITE 300
RALEIGH, NC 27609
PHONE: 919.232.3695
CONTACT: BOB MISHLER

THE POINT
PHASE 5 SUBDIVISION PLAT
EAST YOUNG STREET
WAKE FOREST TOWNSHIP, WAKE COUNTY, NORTH CAROLINA



REVISIONS

NO. DATE


PLAN INFORMATION

PROJECT NO. AWH20000
FILENAME AWH20000-F9
CHECKED BY JBT
DRAWN BY KMM
SCALE 1"=30'
DATE 01.29.2025


SHEET

FINAL PLAT

3-6

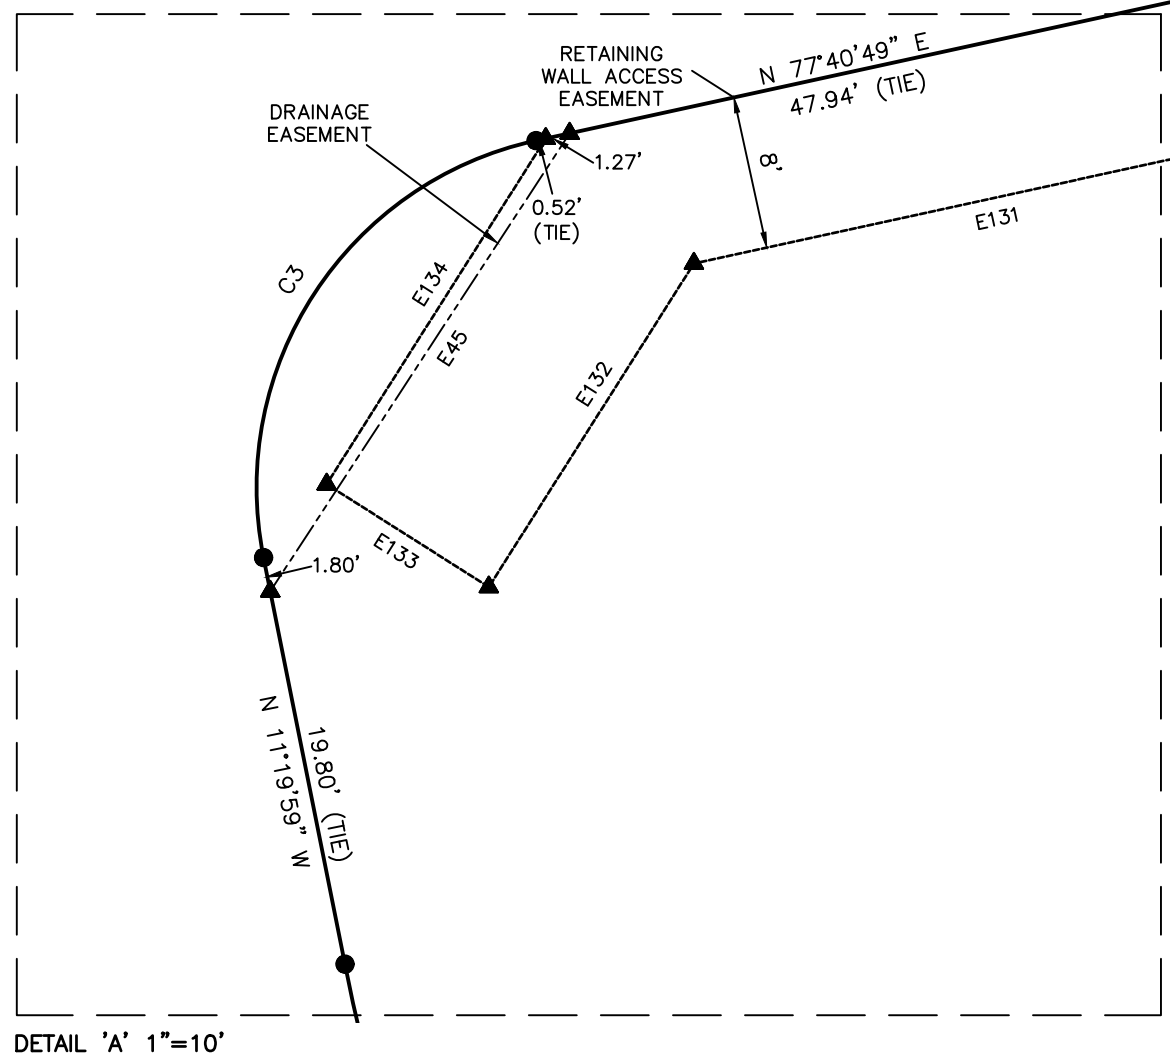


DETAIL 'A' 1"=10'

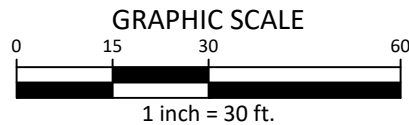


X:\Projects\AWH\AWH-20000\02_Geomatics\Survey\Plats\AWH20000-F9.plt 5.dwg, 2/24/2025 8:32:53 AM, Katie Martin

X:\Projects\AWH\AWH-20000\02_Geomarkets\Survey\Plats\AWH20000-09.plt 5.dwg, 2/24/2025 8:32:55 AM, Katie Martin

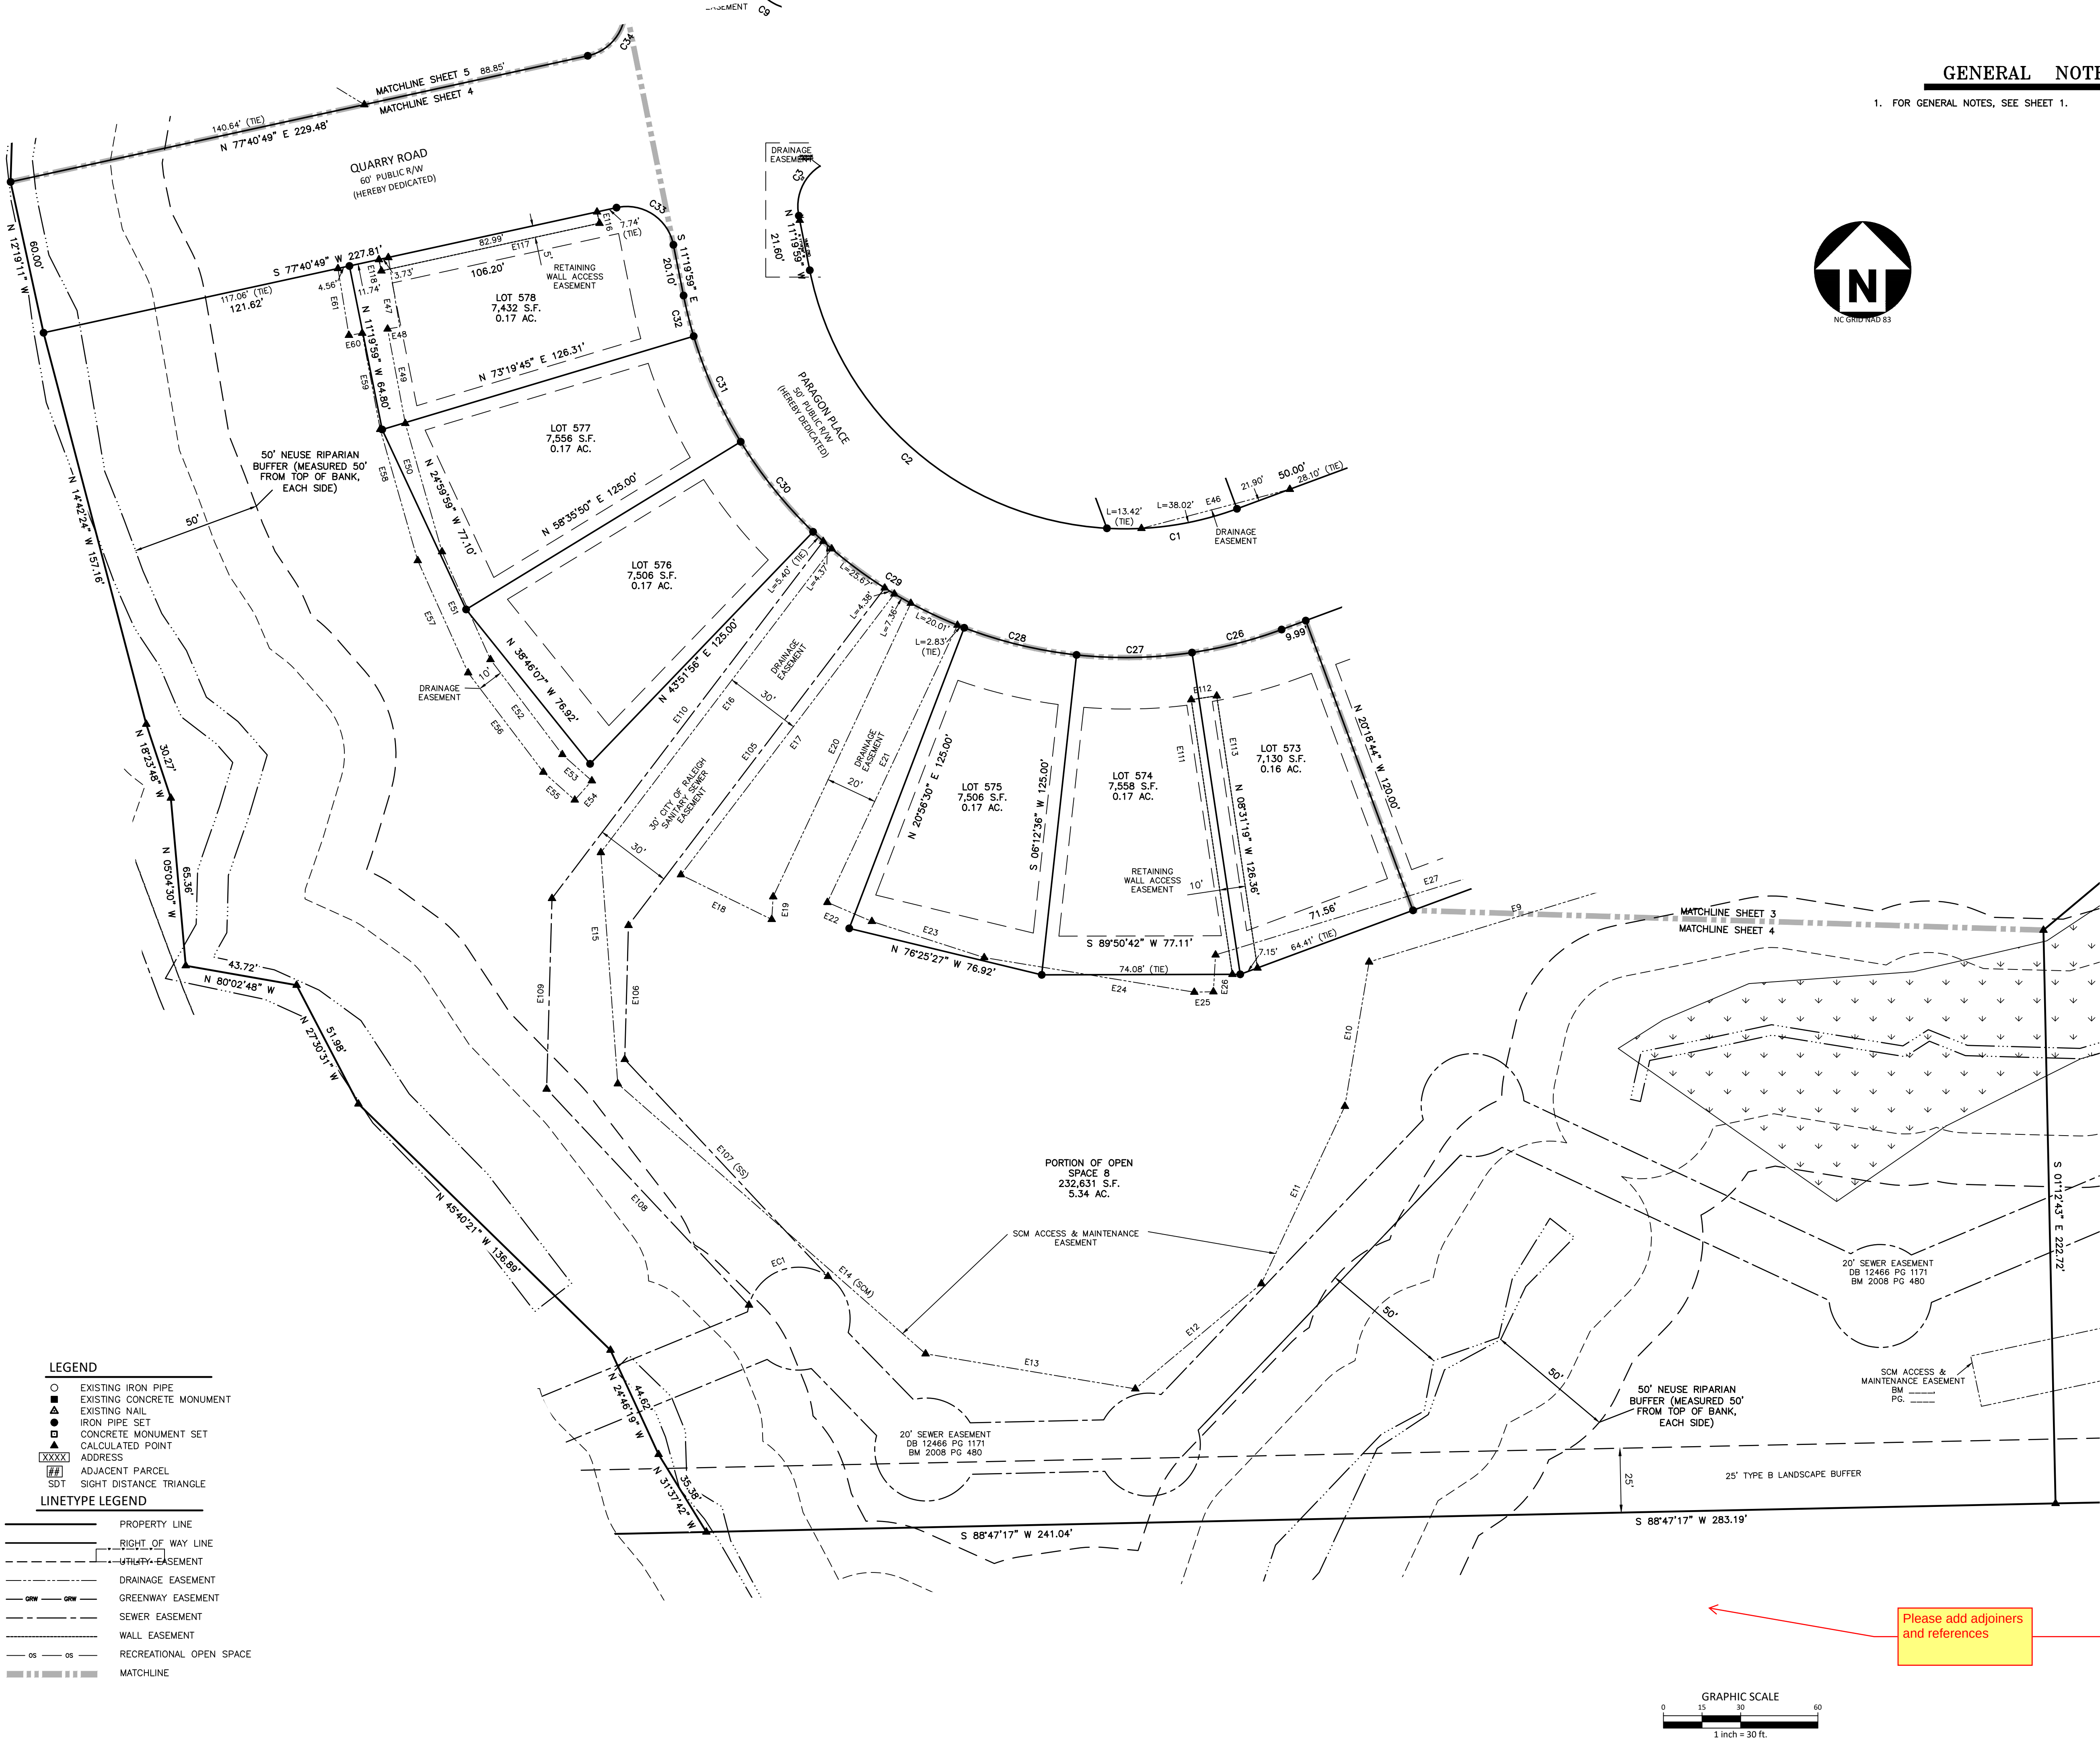

GENERAL NOTES

1. FOR GENERAL NOTES, SEE SHEET 1.

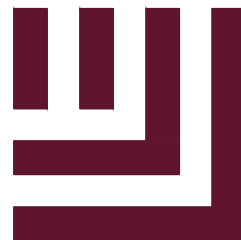

McADAMS

The John R. McAdams Company, Inc.
2905 Meridian Parkway
Durham, NC 27713

phone 919. 361. 5000
fax 919. 361. 2269
license number: C-0293, C-187

www.mcadamsco.com

CLIENT

ASHTON RALEIGH RESIDENTIAL, LLC
5711 SIX FORKS ROAD, SUITE 300
RALEIGH, NC 27609
PHONE: 919.232.3695
CONTACT: BOB MISHLER

THE POINT

PHASE 5 SUBDIVISION PLAT

EAST YOUNG STREET

WAKE FOREST TOWNSHIP, WAKE COUNTY, NORTH CAROLINA



REVISIONS

NO. DATE

PLAN INFORMATION

PROJECT NO. AWH20000
FILENAME AWH20000-F9
CHECKED BY JBT
DRAWN BY KMM
SCALE 1"=30'
DATE 01.29.2025

SHEET

FINAL PLAT

4-6