



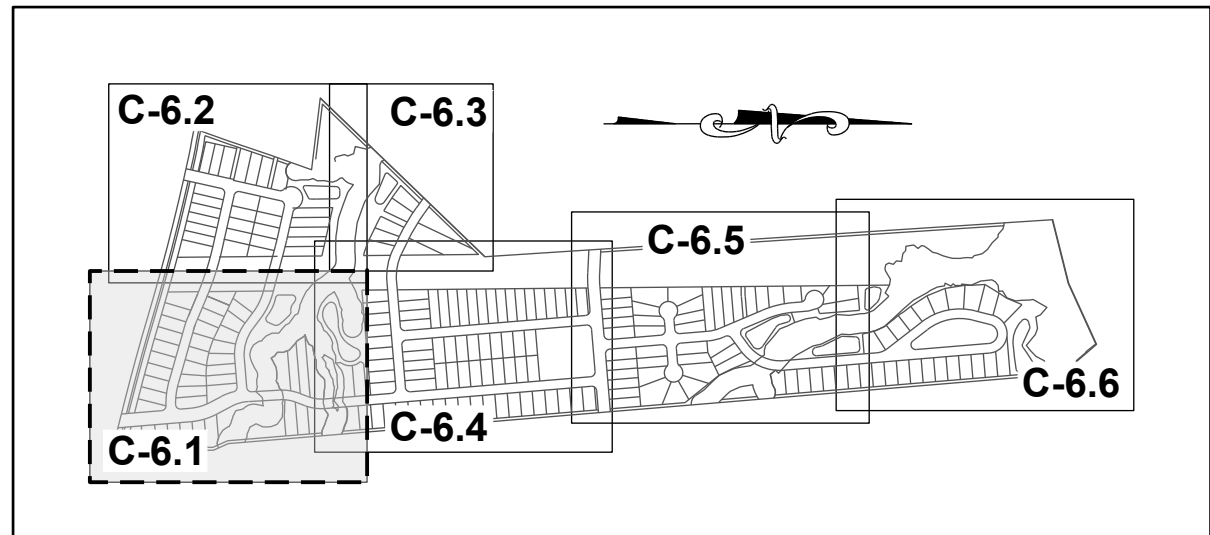

SITE KEY PLAN

LEGEND:

SEE SHEET C-6.0 FOR LEGEND, LINE AND CURVE TABLES

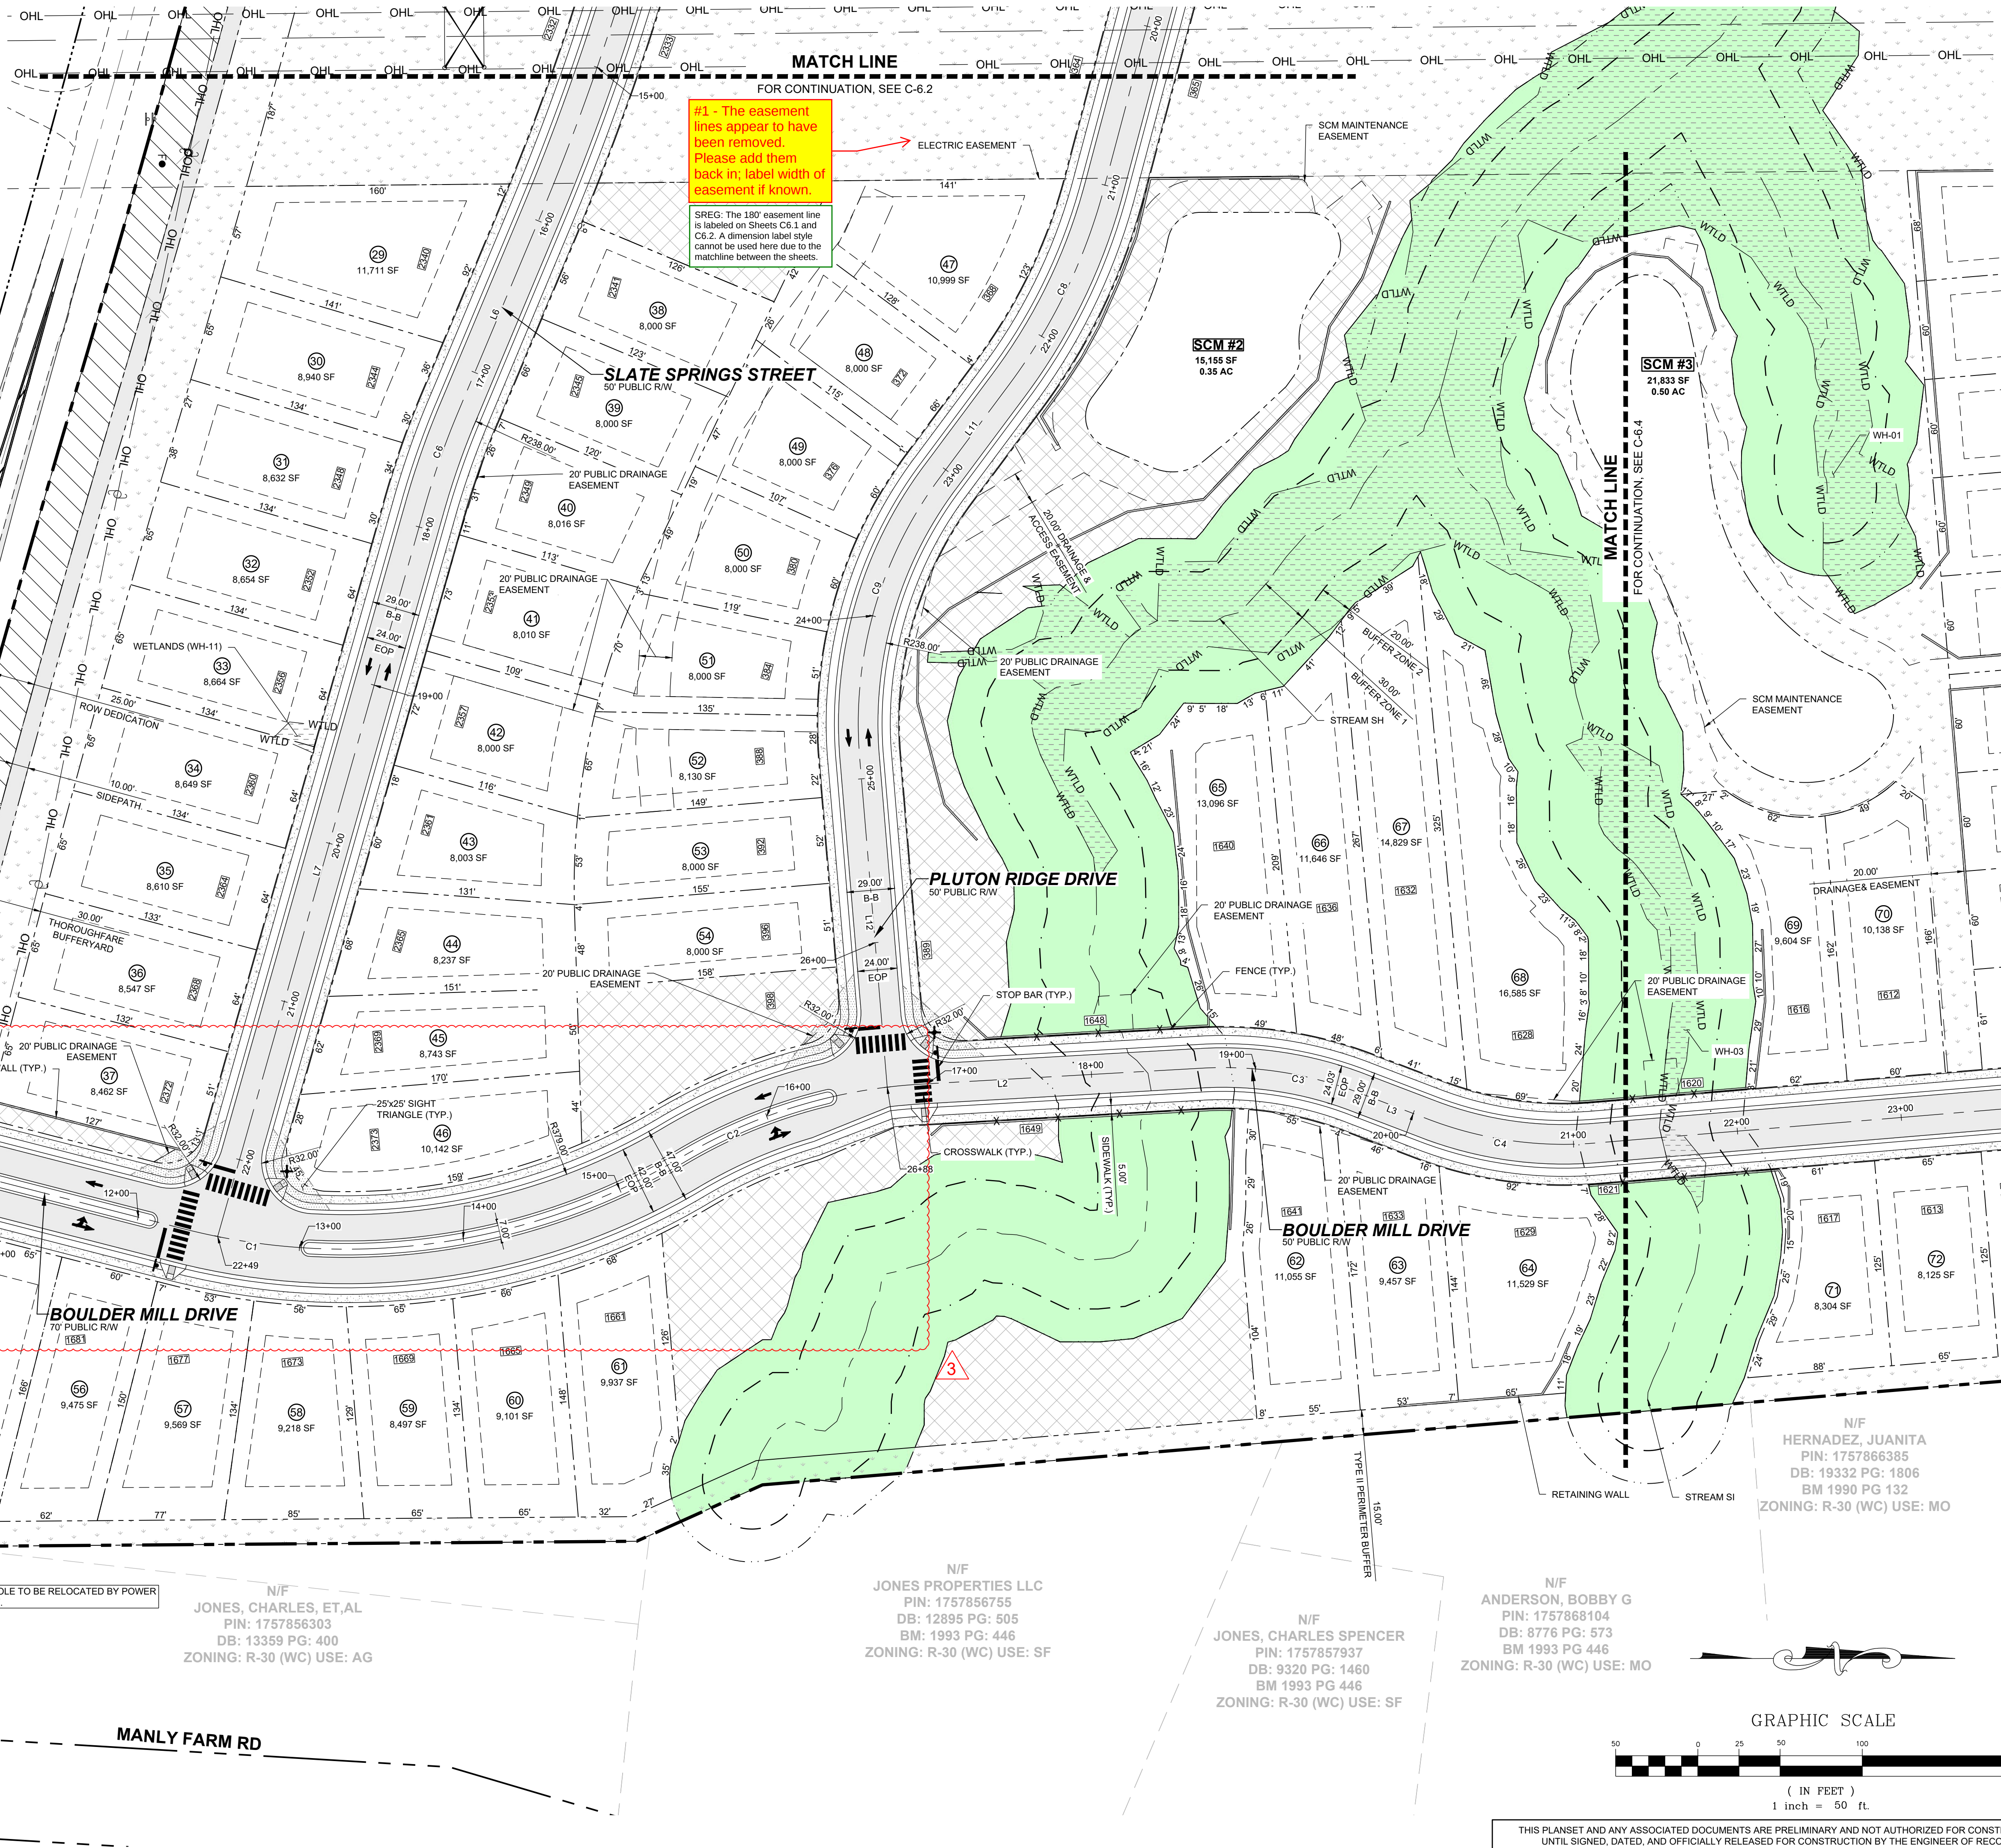

NO.	REVISIONS	DATE	BY
0			
1			
2			
3			



STRONGROCK
ENGINEERING GROUP


STRONG ROCK ENGINEERING GROUP, PLLC | COMPANY LICENSE # P-2166
305 CHURCH AT NORTH HILLS STREET, SUITE 1110 RALEIGH, NC 27609 | INFORMATION@STRONGROCKGROUP.COM

STRONG ROCK PROJECT	NOT FOR CONSTRUCTION	SCALE	AS SHOWN	JWL	SRG	JWL

HILLS AT HARRIS CREEK
TOWN OF ROLESVILLE, WAKE COUNTY, NORTH CAROLINA
PRELIMINARY SUBDIVISION PLAT
PARTIAL SITE PLAN I

DRAWING SHEET
C-6.1


21 OF 72

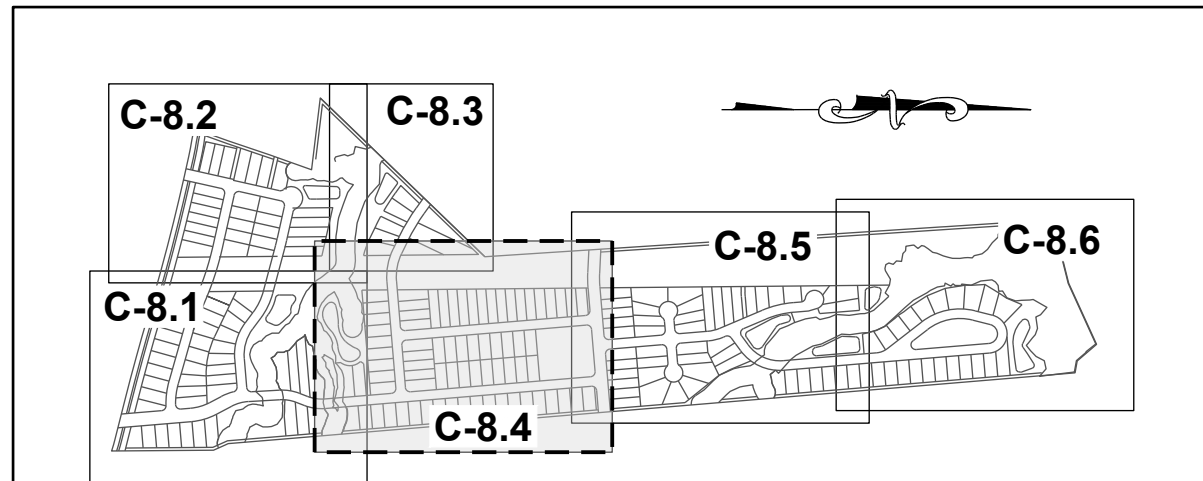

SITE KEY PLAN

LEGEND:

SEE SHEET C-8.0 FOR LEGEND.

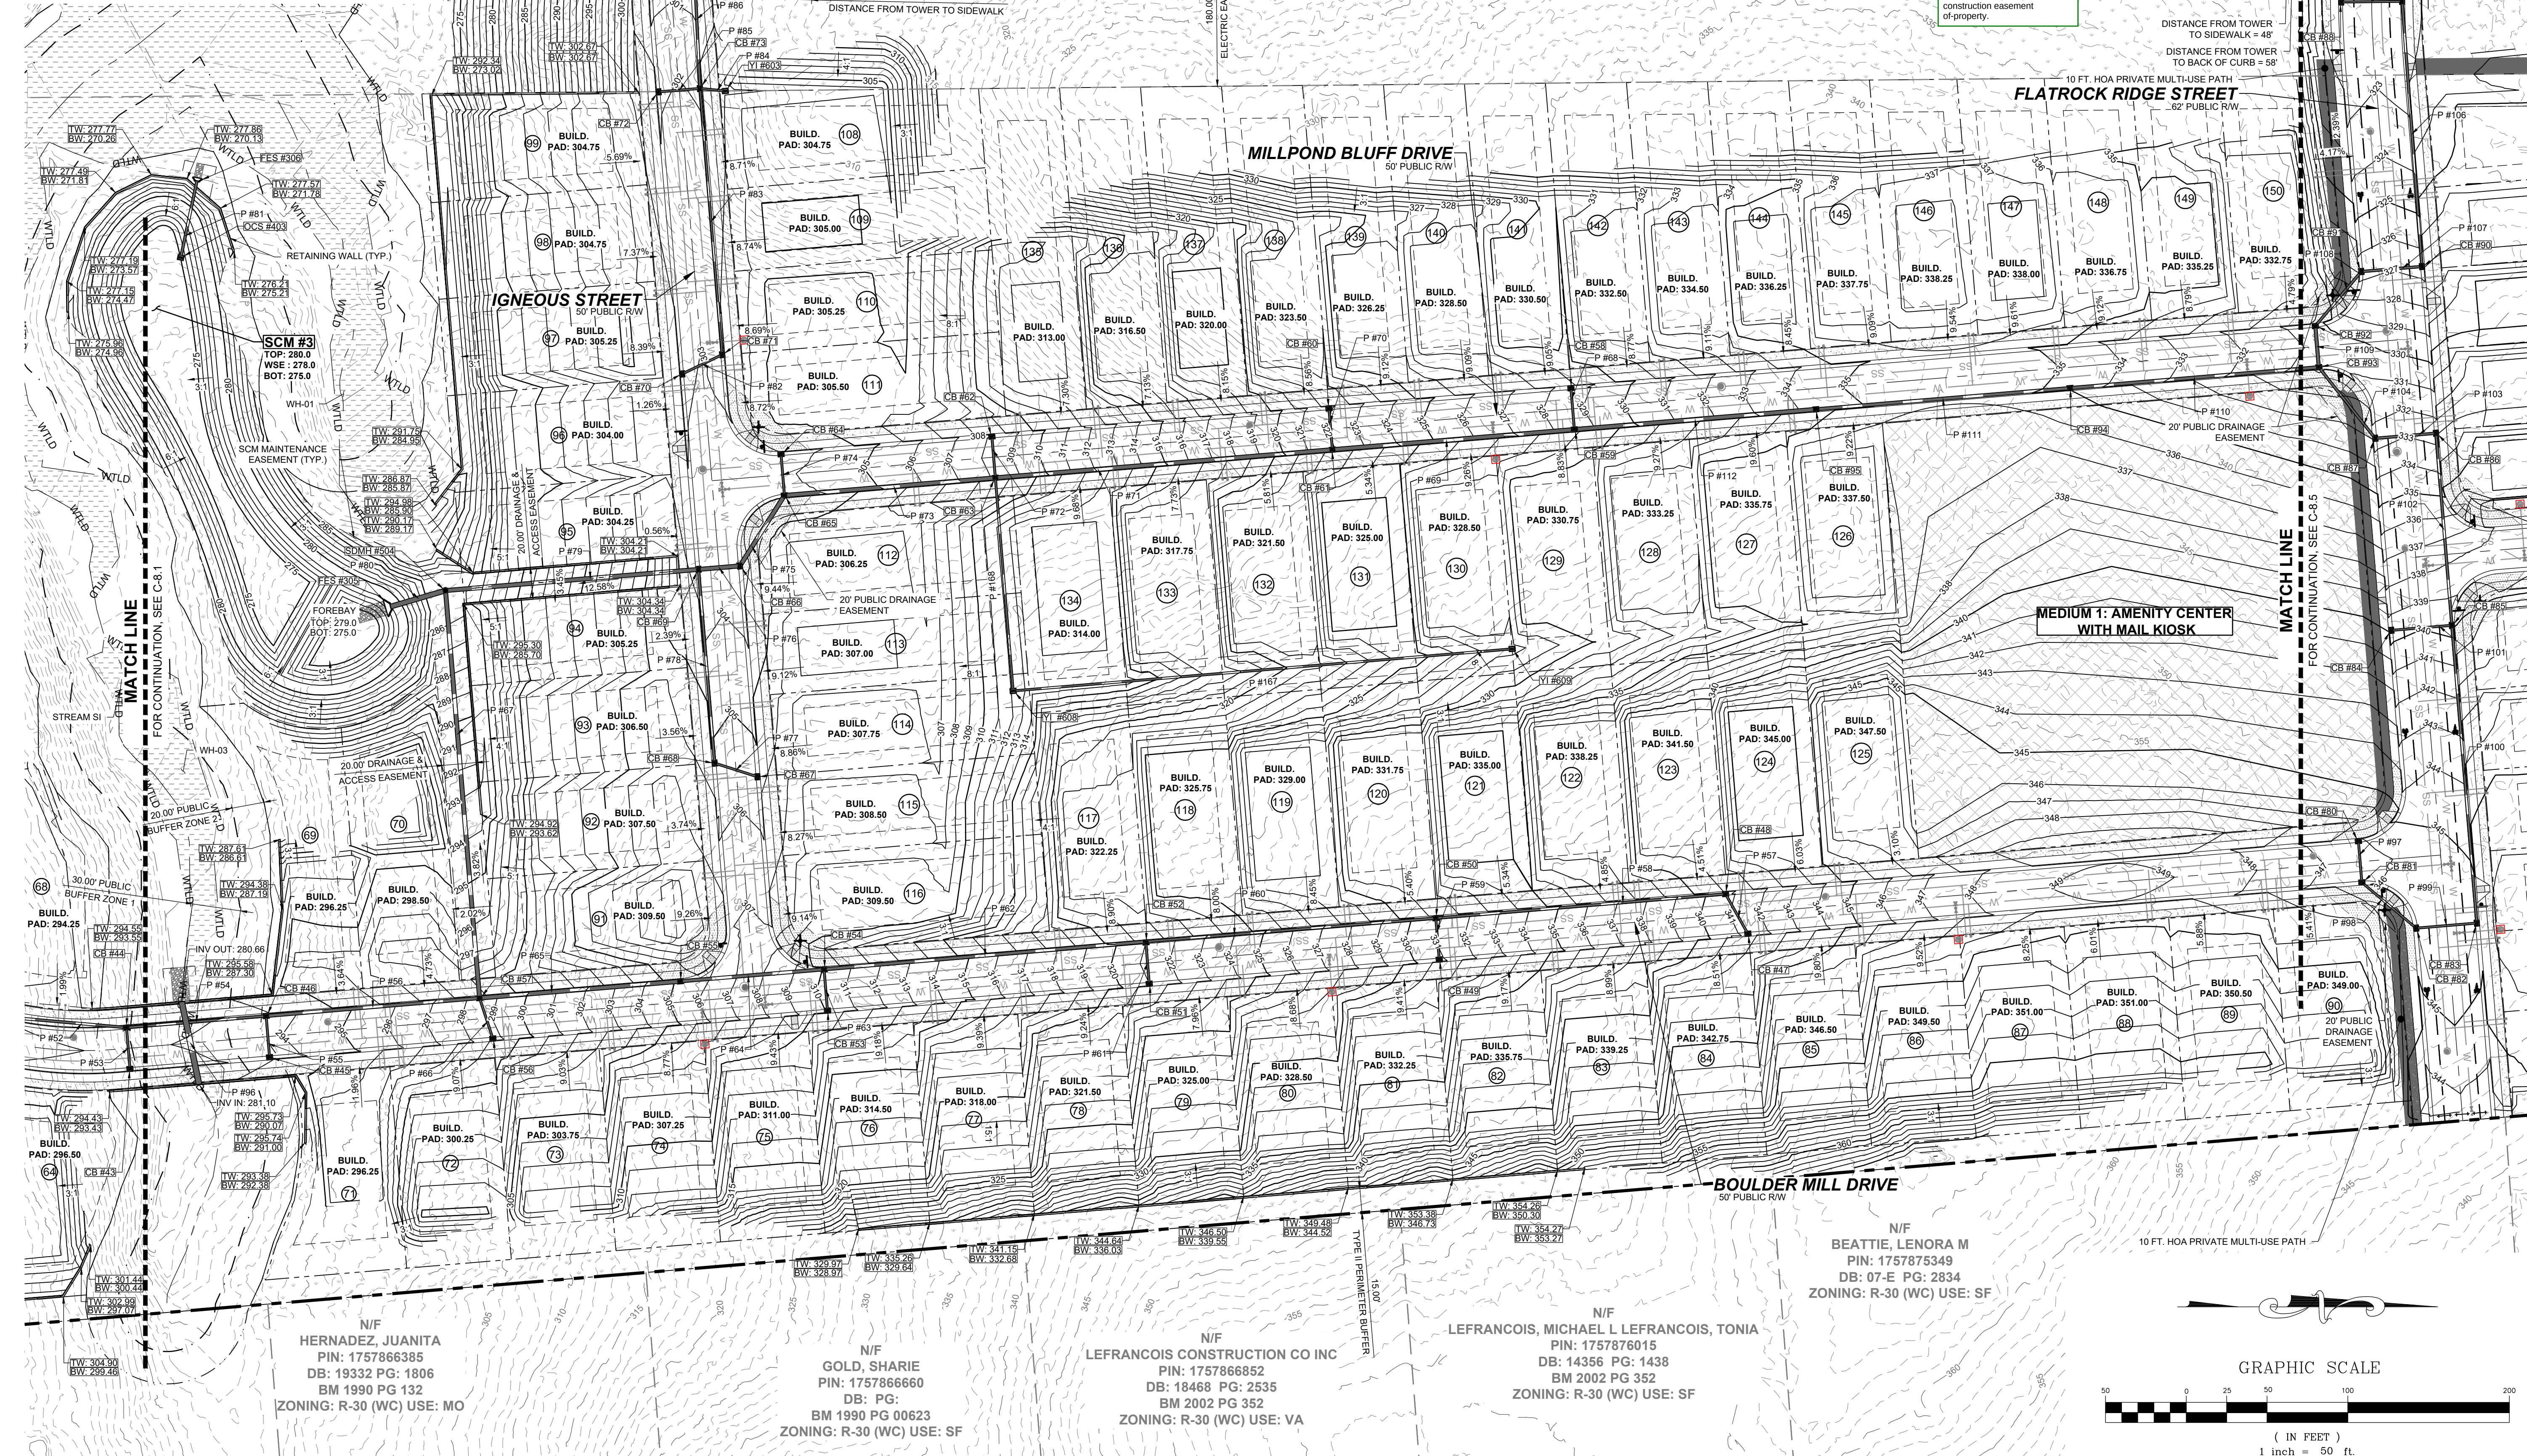

#3 - Since the roadway work is being stopped short, a fee-in-lieu will need to be provided. The other alternative is the roadway is constructed to the property line with a temporary construction easement provided for the required grading and work. This comment applies to all dead-end roads.

SREG: The roadway work has been extended all the way to the property line at all dead end streets. All proposed work lies in to existing grade at the property line in an effort to eliminate the need for a temporary construction easement of property.

STRONGROCK

ENGINEERING GROUP

STRONG ROCK ENGINEERING GROUP, PLLC | COMPANY LICENSE # P-2166
305 CHURCH AT NORTH HILLS STREET, SUITE 1110 RALEIGH, NC 27609 | INFORMATION@STRONGROCKGROUP.COM

STRONG ROCK PROJECT

NOT FOR CONSTRUCTION

SCALE AS SHOWN

DESIGNED BY JWL

DRAWN BY SRG

CHECKED BY JWL

HILLS AT HARRIS CREEK
TOWN OF ROLESVILLE, WAKE COUNTY, NORTH CAROLINA
PRELIMINARY SUBDIVISION PLAT
PARTIAL GRADING & DRAINAGE
PLAN IV

DRAWING SHEET

C-8.4

42 OF 72

REVISIONS

DATE

BY

0			
1	05/30/2024	TOWN OF ROLESVILLE V1-PSP-24-03	ISREG
2	08/30/2024	TOWN OF ROLESVILLE V2-PSP-24-03	ISREG
3	11/01/2024	TOWN OF ROLESVILLE V3-PSP-24-03	ISREG
	02/03/2025	TOWN OF ROLESVILLE V4-PSP-24-03	ISREG

