


Please also include the
Raleigh Water plan #
MRCP-0031-2025

01 OF 17	C-1.0 <u>DRAWING SHEET</u>	RESERVE @ MITCHELL MILL COMMERCIAL TOWN OF ROLESVILLE, WAKE COUNTY, NORTH CAROLINA CONSTRUCTION PLANS COVER SHEET	STRONG ROCK PROJECT PSP-23-03	STRONG ROCK ENGINEERING GROUP, PLLC COMPANY LICENSE # P-2168 305 CHURCH AT NORTH HILLS STREET, SUITE 1110 RALEIGH, NC 27609 INFORMATION@STRONGROCKGROUP.COM	SEAL:	CD SUBMITTAL #1	08/01/2023	BY	
			NOT FOR CONSTRUCTION						
			SCALE AS SHOWN						
			DESIGNED BY SRG						
			DRAWN BY SRG						
			CHECKED BY SRG						
				No.	REVISIONS	DATE	BY		


PIPE TABLE						
PIPE NO	TYPE	SIZE	LF	INV. IN	INV. OUT	GRADE
PIPE #01 BEGIN: SSMH #2 END: SSMH #1	PVC - SDR 26	8"	89	272.73	272.28	0.50%
PIPE #02 BEGIN: SSMH #3 END: SSMH #2	PVC - SDR 26	8"	146	273.65	272.93	0.50%
PIPE #03 BEGIN: SSCO #04 END: SSMH #3	PVC - SDR 26	8"	87	274.49	274.05	0.50%
PIPE #04 BEGIN: END: SSCO #04	PVC - SDR 26	8"	95	274.96	274.49	0.50%
PIPE #05 BEGIN: SSMH #4 END: SSMH #3	PVC - SDR 26	8"	187	274.79	273.85	0.50%
PIPE #06 BEGIN: SSMH #5 END: SSMH #4	PVC - SDR 26	8"	180	275.89	274.99	0.50%
PIPE #07 BEGIN: SSMH #6 END: SSMH #5	PVC - SDR 26	8"	58	276.38	276.09	0.50%
PIPE #08 BEGIN: SSMH #7 END: SSMH #6	PVC - SDR 26	8"	28	276.72	276.58	0.50%
PIPE #09 BEGIN: SSCO #03 END: SSMH #7	PVC - SDR 26	8"	89	277.37	276.92	0.50%
PIPE #10 BEGIN: END: SSCO #03	PVC - SDR 26	8"	160	278.17	277.37	0.50%
PIPE #11 BEGIN: SSMH #8 END: SSMH #7	PVC - SDR 26	8"	231	278.08	276.92	0.50%
PIPE #12 BEGIN: SSMH #9 END: SSMH #8	PVC - SDR 26	8"	43	278.49	278.28	0.50%
PIPE #13 BEGIN: SSCO #02 END: SSMH #9	PVC - SDR 26	8"	89	279.13	278.69	0.50%
PIPE #14 BEGIN: END: SSCO #02	PVC - SDR 26	8"	95	279.61	279.13	0.50%
PIPE #15 BEGIN: SSMH #10 END: SSMH #9	PVC - SDR 26	8"	37	278.88	278.69	0.50%
PIPE #16 BEGIN: SSCO #01 END: SSMH #10	PVC - SDR 26	8"	88	279.52	279.08	0.50%
PIPE #17 BEGIN: END: SSCO #01	PVC - SDR 26	8"	218	280.61	279.52	0.50%
PIPE #18 BEGIN: SSMH #1 END:	PVC - SDR 26	8"	76	272.08	267.50	6.05%
PIPE#19 BEGIN: SSCO #04 END: SSCO #04	PVC - SDR 26	8"	97	262.91	262.43	0.50%

THE CONTRACTOR RESPONSIBLE FOR THE EXTENSION OF WATER, SEWER, AND/OR REUSE, AS APPROVED IN THESE PLANS, IS RESPONSIBLE FOR CONTACTING THE INFRASTRUCTURE INSPECTIONS DIVISION AND SCHEDULE A PRE-CONSTRUCTION MEETING ON THE DEVELOPMENT PORTAL PRIOR TO BEGINNING ANY CONSTRUCTION. RALEIGH WATER MUST BE CONTACTED AT (919) 996-4540 AT LEAST TWENTY-FOUR HOURS PRIOR TO BEGINNING ANY WORK ACTIVITY AROUND CRITICAL WATER AND SEWER INFRASTRUCTURE.

FAILURE TO CALL FOR INSPECTION, INSTALL A DOWNSTREAM PLUG, HAVE PERMITTED PLANS ON THE JOBSITE, OR ANY OTHER VIOLATION OF CITY OF RALEIGH STANDARDS WILL RESULT IN A FINE AND POSSIBLE EXCLUSION FROM FUTURE WORK IN THE CITY OF RALEIGH.

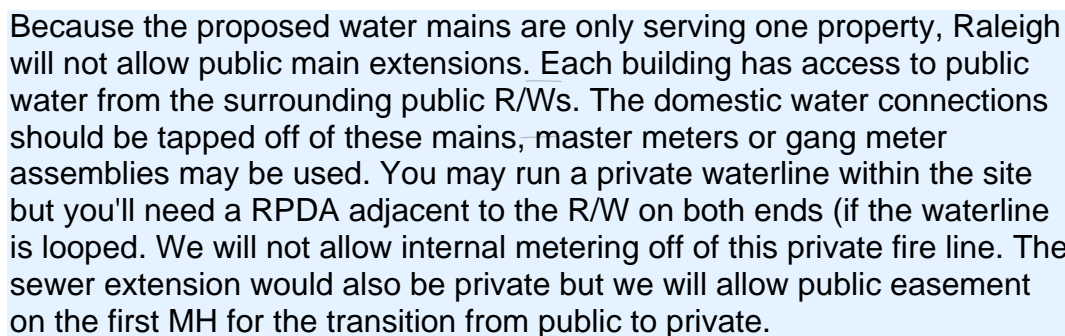

GRAPHIC SCALE

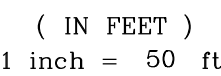

STRONG ROCK						SEAL	0	CD SUBMITTAL #1	BREC	08/07/2025
E N G I N E E R I N G G R O U P										
STRONG ROCK ENGINEERING GROUP, PLLC COMPANY LICENSE # P-2166										
305 CHURCH AT NORTH HILLS STREET, SUITE 1110 RALEIGH, NC 27609 INFORMATION@STRONGROCKGROUP.COM										
DESIGNED BY SRG										
DRAWN BY SRG										
NOT FOR CONSTRUCTION										
SCALE AS SHOWN										
PSP-23-03										
CHECKED BY SRG						No.		REVISIONS		DATE
										BY

DRAWING
SHEET

C-4.0