

PRELIMINARY SUBDIVISION PLANS

YOUNG ST COMMERCIAL GRAVITY COMPANIES

PSP-25-02

SURVEY BENCHMARK

BENCHMARK IS LOCAL TO SITE.
SEE SHEET C1.00 FOR BENCHMARK INFORMATION.
VERTICAL DATUM BASED ON NAVD 88.

PARCEL DATA

PIN: 1768464343
OWNER: WAKE CNTY BOARD OF EDUCATION
ADDRESS: 901 E YOUNG ST

ZONING: CG-CZ
AREA: 21.51 ACRES
REAL ESTATE ID: 0408361

SITE DATA TABLE


COUNTY PROJECT NO.	PSP-25-02
PARCEL PIN NO.	1768464343
TOTAL PROJECT AREA (ACRES)	21.51 AC
WATERSHED	MILBURNIE LAKE (HUC 10-0302020107)
RIVER BASIN	NEUSE RIVER BASIN
BOOK OF MAPS/DEED REFERENCE	DEED BOOK/PAGE 014097/02016
JURISDICTION	TOWN OF ROLESVILLE
EXISTING ZONING	CG-CZ
CURRENT USE	VACANT
PROPOSED USE	COMMERCIAL/RETAIL/OFFICE
EXISTING IMPERVIOUS AREA	0 SF
PROPOSED IMPERVIOUS AREA	TBD
TREE COVERAGE DATA	SEE SHEETS C1.10 & C1.11
SETBACKS:	
FRONT	20 FT
SIDE	15 FT
REAR	35 FT
CORNER	25 FT
PROJECT PERIMETER	5,000 FT
MINIMUM OPEN SPACE REQUIRED	1.07 AC
PROPOSED OPEN SPACE	1.09 AC

OPEN SPACE CALCULATIONS

REQUIRED TOTAL OPEN SPACE AREA	SITE AREA X 5%	21.51 X 5% = 1.07 AC
REQUIRED ACTIVE OPEN SPACE	50% OF TOTAL OPEN SPACE	1.07 X 50% = 0.54 AC
REQUIRED PASSIVE OPEN SPACE	TOTAL OPEN SPACE - ACTIVE OPEN SPACE (LESS THAN 50% OF TOTAL OPEN SPACE)	1.07 - 0.54 = 0.53 AC
PROVIDED TOTAL OPEN SPACE AREA	-	1.09 AC
PROVIDED ACTIVE OPEN SPACE	-	0.68 AC (62%)
PROVIDED PASSIVE OPEN SPACE	-	0.41 AC (38%)

901 E YOUNG ST, ROLESVILLE, NC | 27587 | WAKE COUNTY

FIRST SUBMITTAL: AUGUST 01, 2025

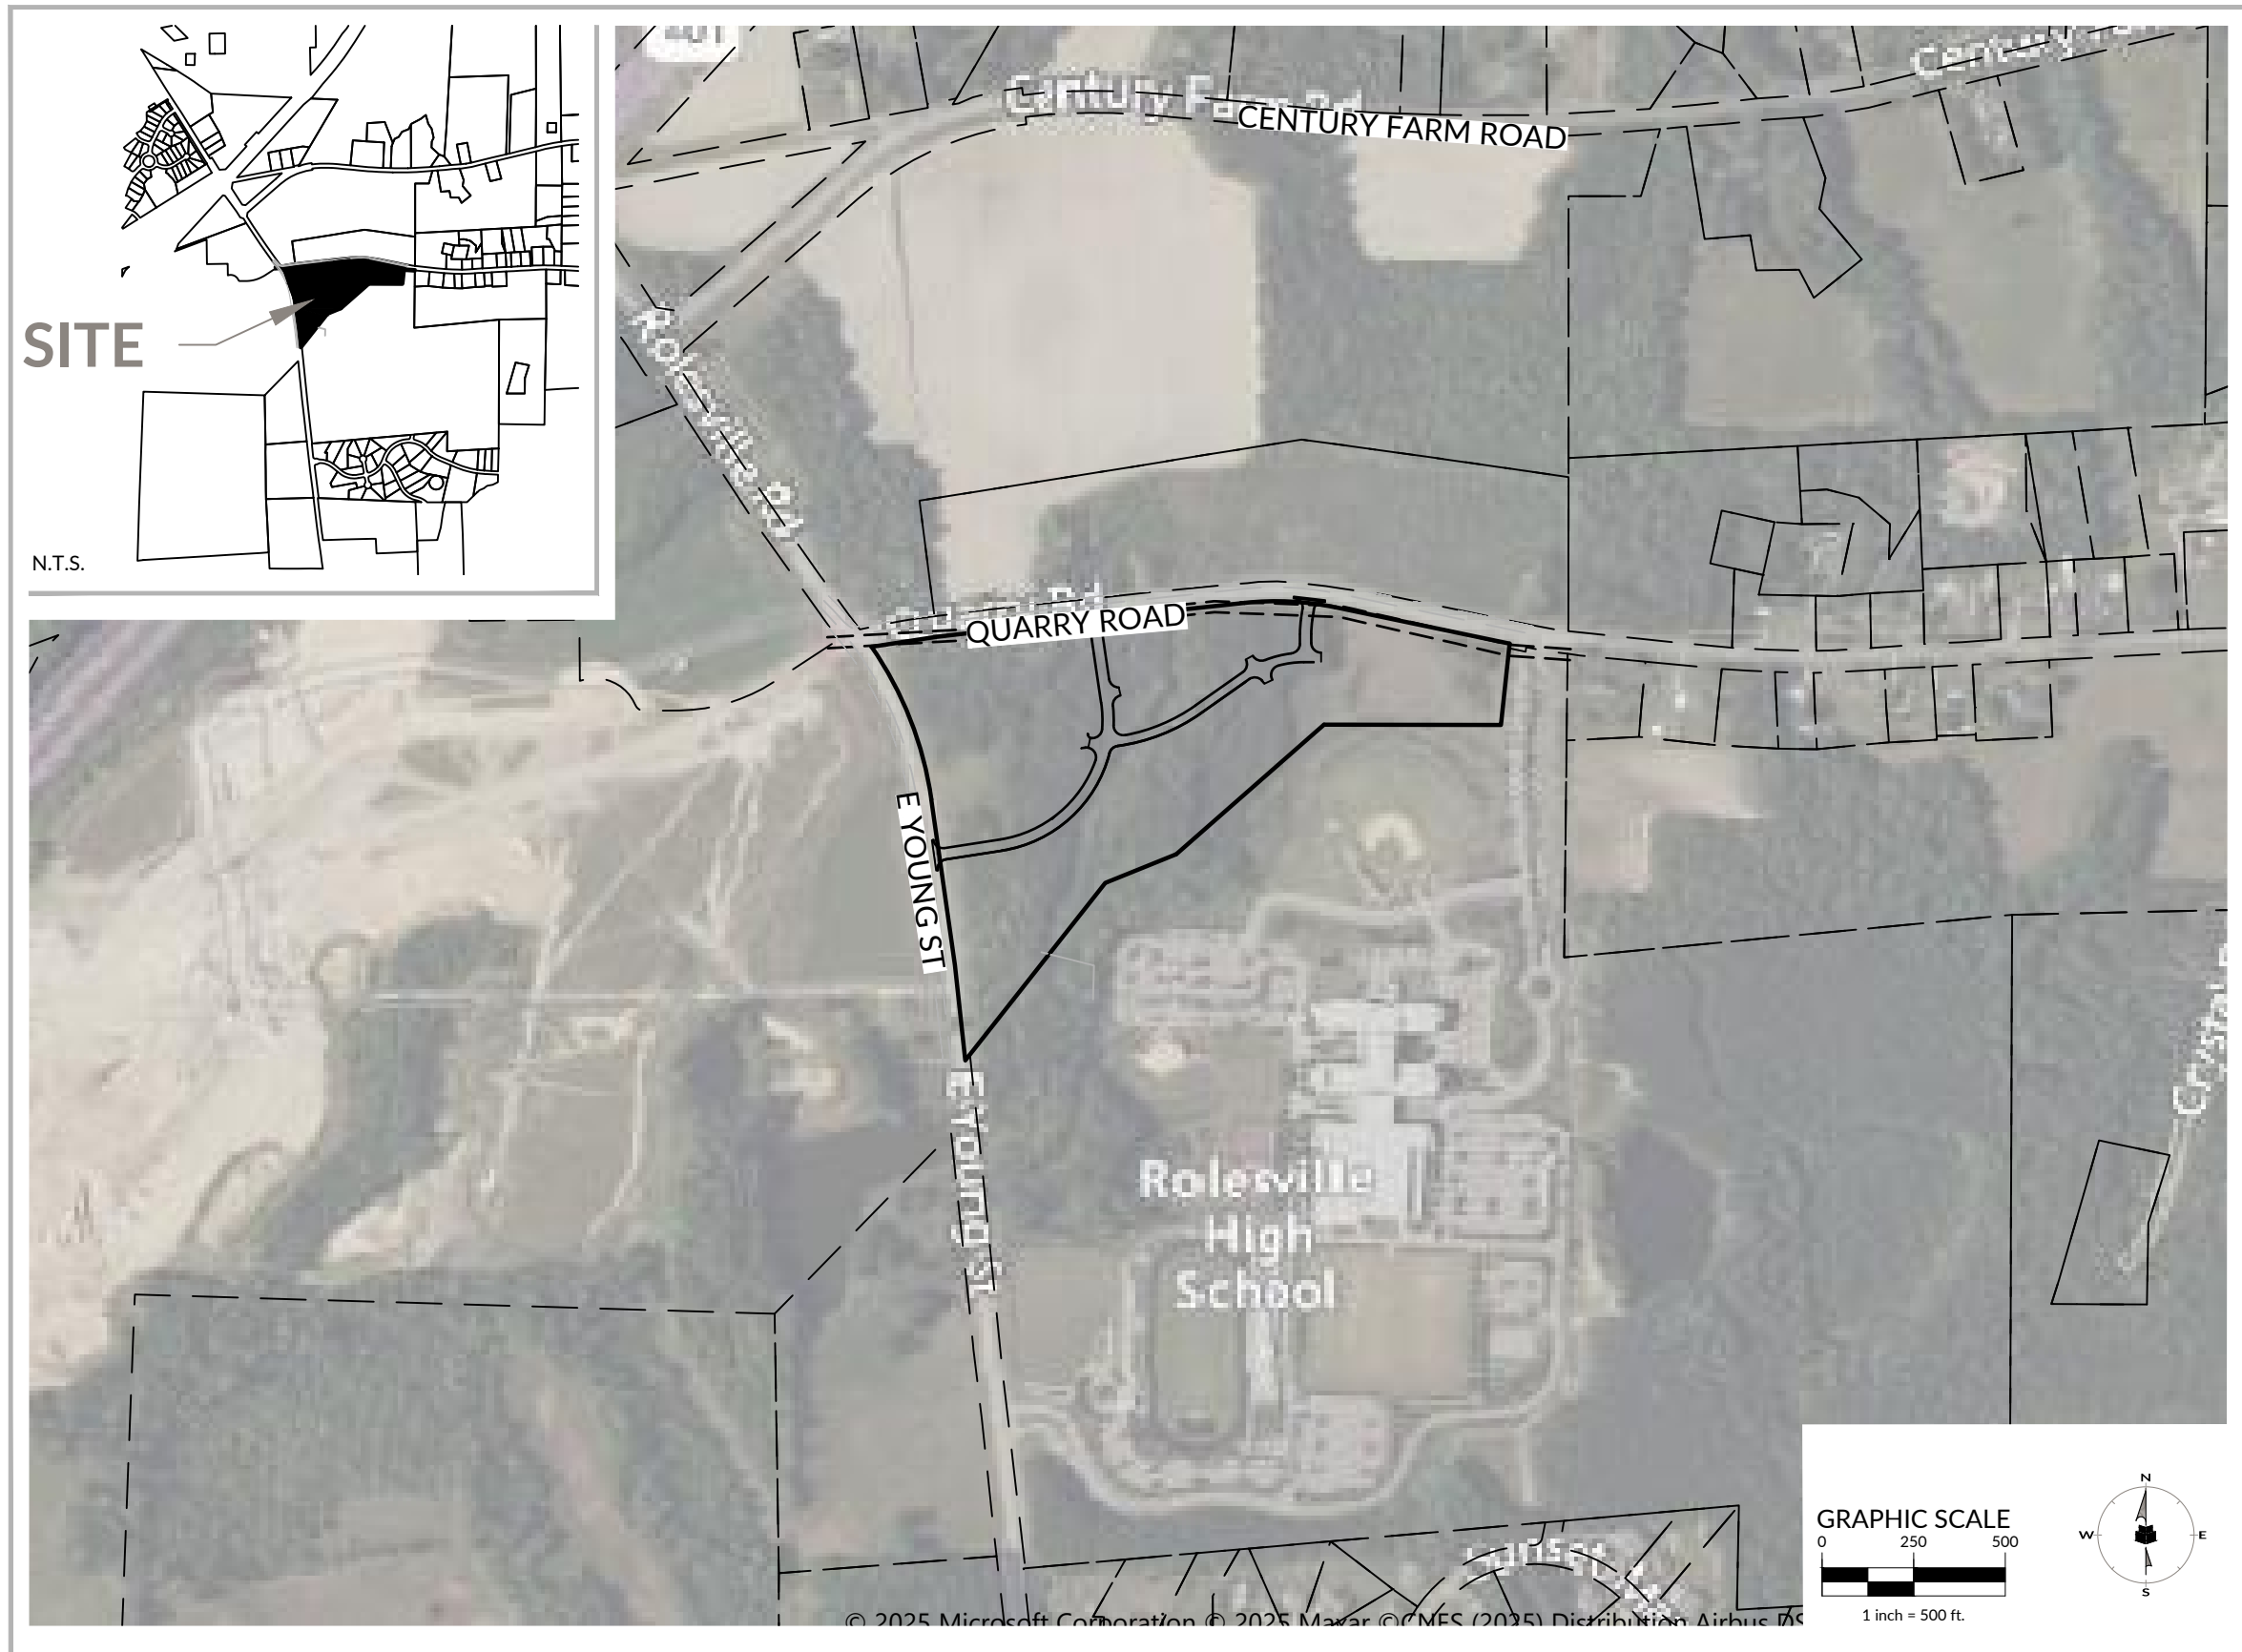

Sheet List Table

Sheet Number	Sheet Title
C0.00	COVER
C1.00	EXISTING CONDITIONS AND DEMOLITION PLAN
C1.10	TREE PRESERVATION PLAN
C1.11	TREE PRESERVATION CALCULATIONS & DETAILS
C2.00	SITE PLAN
C2.10	SITE PLAN CONCEPT
C3.00	UTILITY PLAN
C4.00	GRADING AND DRAINAGE PLAN

INFRASTRUCTURE DATA TABLE

	TOTAL
UNITS	
STREETS [LF]	1801
6" WATER MAIN [LF]	---
8" WATER MAIN [LF]	1739
12" WATER MAIN [LF]	---
8" SEWER MAIN [LF]	1807
12" SEWER MAIN [LF]	---
STORM DRAINAGE [LF]	2396
SCM'S >5 AC.	3
IMPERVIOUS SURFACE [SF.]	---
SEWER FLOW (360 GAL/UNIT)[GPD]	TBD
SIDEWALK [LF]	3251
PUBLIC GREENWAY [LF]	---

NOTES

WETLANDS & BUFFERS NOTES:
ALL IMPACTED WETLANDS AND BUFFERS AS SHOWN ON THIS SET OF PLANS SHALL BE PERMITTED THROUGH N.C.D.W.R. AND U.S.A.C.E. PRIOR TO OBTAINING CONSTRUCTION PLAN APPROVAL FROM THE TOWN OF ROLESVILLE.

EROSION AND SEDIMENT CONTROL:
EROSION CONTROL PLANS AND CALCULATIONS SHALL BE PROVIDED DURING THE TOWN OF ROLESVILLE'S CONSTRUCTION INFRASTRUCTURE DRAWING (C.I.D.) REVIEW PROCESS. THE LEVEL OF DESIGN PROVIDED IN THIS PLAN SET IS INSUFFICIENT TO PROVIDE ACCURATE EROSION AND SEDIMENT CONTROL DESIGN AND CALCULATIONS AT THIS TIME.

FIRE ACCESS:
FIRE ACCESS PLAN FOR THE PROPOSED LOTS SHALL BE PROVIDED DURING THE TOWN OF ROLESVILLE'S SITE DEVELOPMENT PLAN (S.D.P.) REVIEW PROCESS.

RESERVED FOR TOWN
OF ROLESVILLE
SIGNATURE BLOCK

CONTACT LIST:

CIVIL ENGINEER
Drew Plato, PE
WithersRavenel
137 S. Wilmington Street, Suite 200
Raleigh, NC 27601
919-535-5200
dplato@withersravenel.com

LANDSCAPE ARCHITECT
Kayleigh Gill, PLA
WithersRavenel
137 S. Wilmington St. Suite 200
Raleigh, NC 27601
919-535-5200
kgill@withersravenel.com

DEVELOPER
Jake Jones
Gravity Companies
2629 St. Mary's St.
Raleigh, NC 27609
919-414-5166
jake@gravity-companies.com

OWNER
Wake County Board of Education
Attn: Real Estate Services
1551 Rock Quarry Road
Raleigh, NC 27610
919-999-6550
dburnett@wcpss.net



WithersRavenel
137 S Wilmington Street | Suite 200 | Raleigh, NC 27601
License #: F-1479 | t: 919.469.3340 | www.withersravenel.com

PREPARED BY:

DEVELOPER:

Gravity Companies

2629 St. Mary's St.
Raleigh, NC 27609
PHONE #: 919-414-5166
ATTENTION: Jake Jones




Preliminary Subdivision Plans
Young ST Commercial
Gravity Companies
PSP-25-02
WR PROJECT NO. 24-0129-A
Town of Rolesville:
MUNI PRO NO: Muni Proj. No.
INITIAL PLAN DATE: 08/01/2025
R1:
R2:
R3:





PRELIMINARY SUBDIVISION PLANS
YOUNG ST COMMERCIAL
GRAVITY COMPANIES
PSP-25-02

901 E Young St, Rolesville, NC | 27587 | Wake County

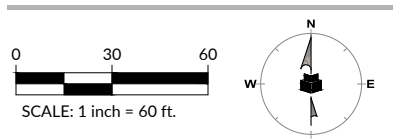

INITIAL PLAN DATE: 08/01/2025
REVISIONS:
R1 -

R2 -

R3 -


Know what's below.
Call  before you dig.

WR JOB NUMBER	24-0129-	
DRN: WR	DGN: WR	CKD: W

**TREE
PRESERVATION
PLAN**

C1.10

our people • your success

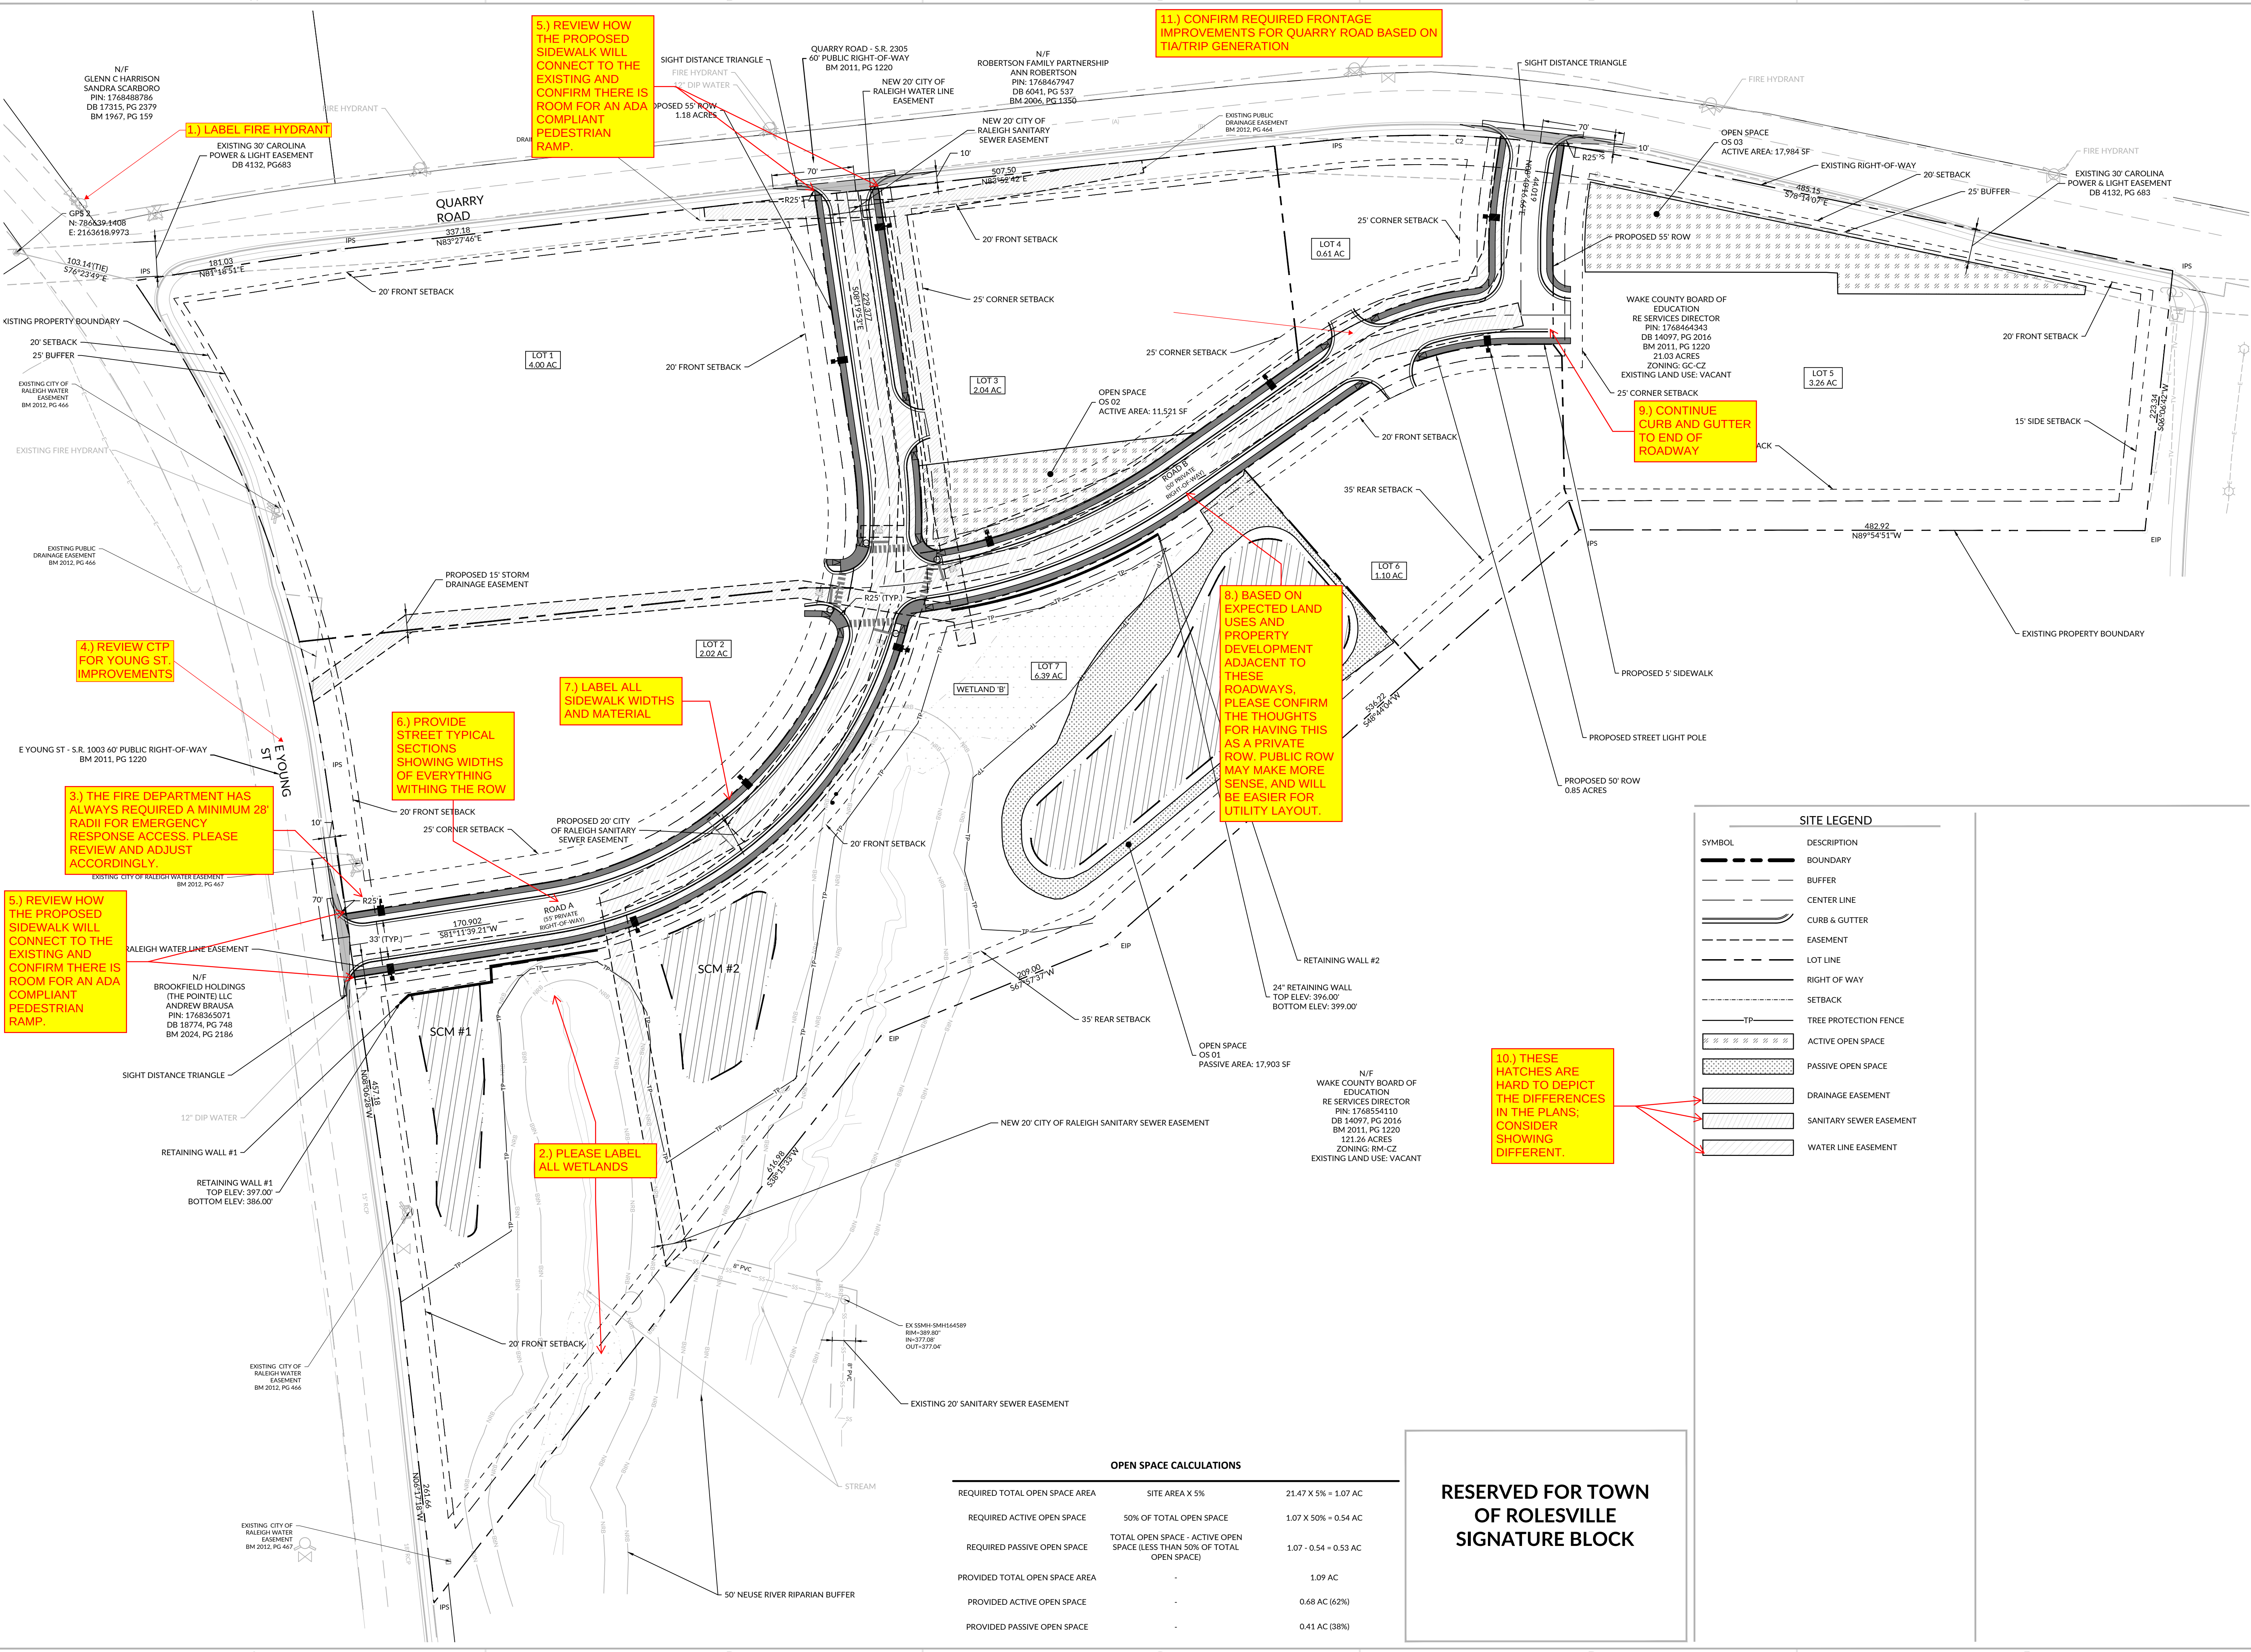

1.) LABEL FIRE HYDRANT

5.) REVIEW HOW THE PROPOSED SIDEWALK WILL CONNECT TO THE EXISTING AND CONFIRM THERE IS ROOM FOR AN ADA COMPLIANT PEDESTRIAN RAMP.

11.) CONFIRM REQUIRED FRONTAGE IMPROVEMENTS FOR QUARRY ROAD BASED ON TIA/TRIP GENERATION

9.) CONTINUE CURB AND GUTTER TO END OF ROADWAY

8.) BASED ON EXPECTED LAND USES AND PROPERTY DEVELOPMENT ADJACENT TO THESE ROADWAYS, PLEASE CONFIRM THE THOUGHTS FOR HAVING THIS AS A PRIVATE ROW. PUBLIC ROW MAY MAKE MORE SENSE, AND WILL BE EASIER FOR UTILITY LAYOUT.

10.) THESE HATCHES ARE HARD TO DEPICT THE DIFFERENCES IN THE PLANS; CONSIDER SHOWING DIFFERENT.

4.) REVIEW CTP FOR YOUNG ST IMPROVEMENTS

3.) THE FIRE DEPARTMENT HAS ALWAYS REQUIRED A MINIMUM 28' RADIUS FOR EMERGENCY RESPONSE ACCESS. PLEASE REVIEW AND ADJUST ACCORDINGLY.

5.) REVIEW HOW THE PROPOSED SIDEWALK WILL CONNECT TO THE EXISTING AND CONFIRM THERE IS ROOM FOR AN ADA COMPLIANT PEDESTRIAN RAMP.

6.) PROVIDE STREET TYPICAL SECTIONS SHOWING WIDTHS OF EVERYTHING WITHIN THE ROW

7.) LABEL ALL SIDEWALK WIDTHS AND MATERIAL

2.) PLEASE LABEL ALL WETLANDS

SITE LEGEND	
SYMBOL	DESCRIPTION
	BOUNDARY
	BUFFER
	CENTER LINE
	CURB & GUTTER
	EASEMENT
	LOT LINE
	RIGHT OF WAY
	SETBACK
	TREE PROTECTION FENCE
	ACTIVE OPEN SPACE
	PASSIVE OPEN SPACE
	DRAINAGE EASEMENT
	SANITARY SEWER EASEMENT
	WATER LINE EASEMENT

OPEN SPACE CALCULATIONS		
REQUIRED TOTAL OPEN SPACE AREA	SITE AREA X 5%	21.47 X 5% = 1.07 AC
REQUIRED ACTIVE OPEN SPACE	50% OF TOTAL OPEN SPACE	1.07 X 50% = 0.54 AC
REQUIRED PASSIVE OPEN SPACE	TOTAL OPEN SPACE - ACTIVE OPEN SPACE (LESS THAN 50% OF TOTAL OPEN SPACE)	1.07 - 0.54 = 0.53 AC
PROVIDED TOTAL OPEN SPACE AREA	-	1.09 AC
PROVIDED ACTIVE OPEN SPACE	-	0.68 AC (62%)
PROVIDED PASSIVE OPEN SPACE	-	0.41 AC (38%)

RESERVED FOR TOWN OF ROLESVILLE SIGNATURE BLOCK

WithersRavenel

137 S Wilmington Street, Suite 200 | Raleigh, NC 27601
License #: F-1479 | t: 919.469.3340 | www.withersravenel.com

GRAVITY COMPANIES

Gravity Companies
2629 St. Mary's St.
Raleigh, NC 27609

PRELIMINARY SUBDIVISION PLANS
YOUNG ST COMMERCIAL
GRAVITY COMPANIES
PSP-25-02

901 E Young St, Rolesville, NC | 27587 | Wake County

PRELIMINARY
NOT APPROVED
FOR CONSTRUCTION

0 20 40
SCALE: 1 inch = 60 ft.

INITIAL PLAN DATE: 08/01/2025
REVISIONS:
R1 -
R2 -
R3 -


Know what's below.
Call before you dig.
WR JOB NUMBER 24-0129-A
DRN: WR DGN: WR CKD: WR

SITE PLAN

C2.00

our people • your success

EST. 1983

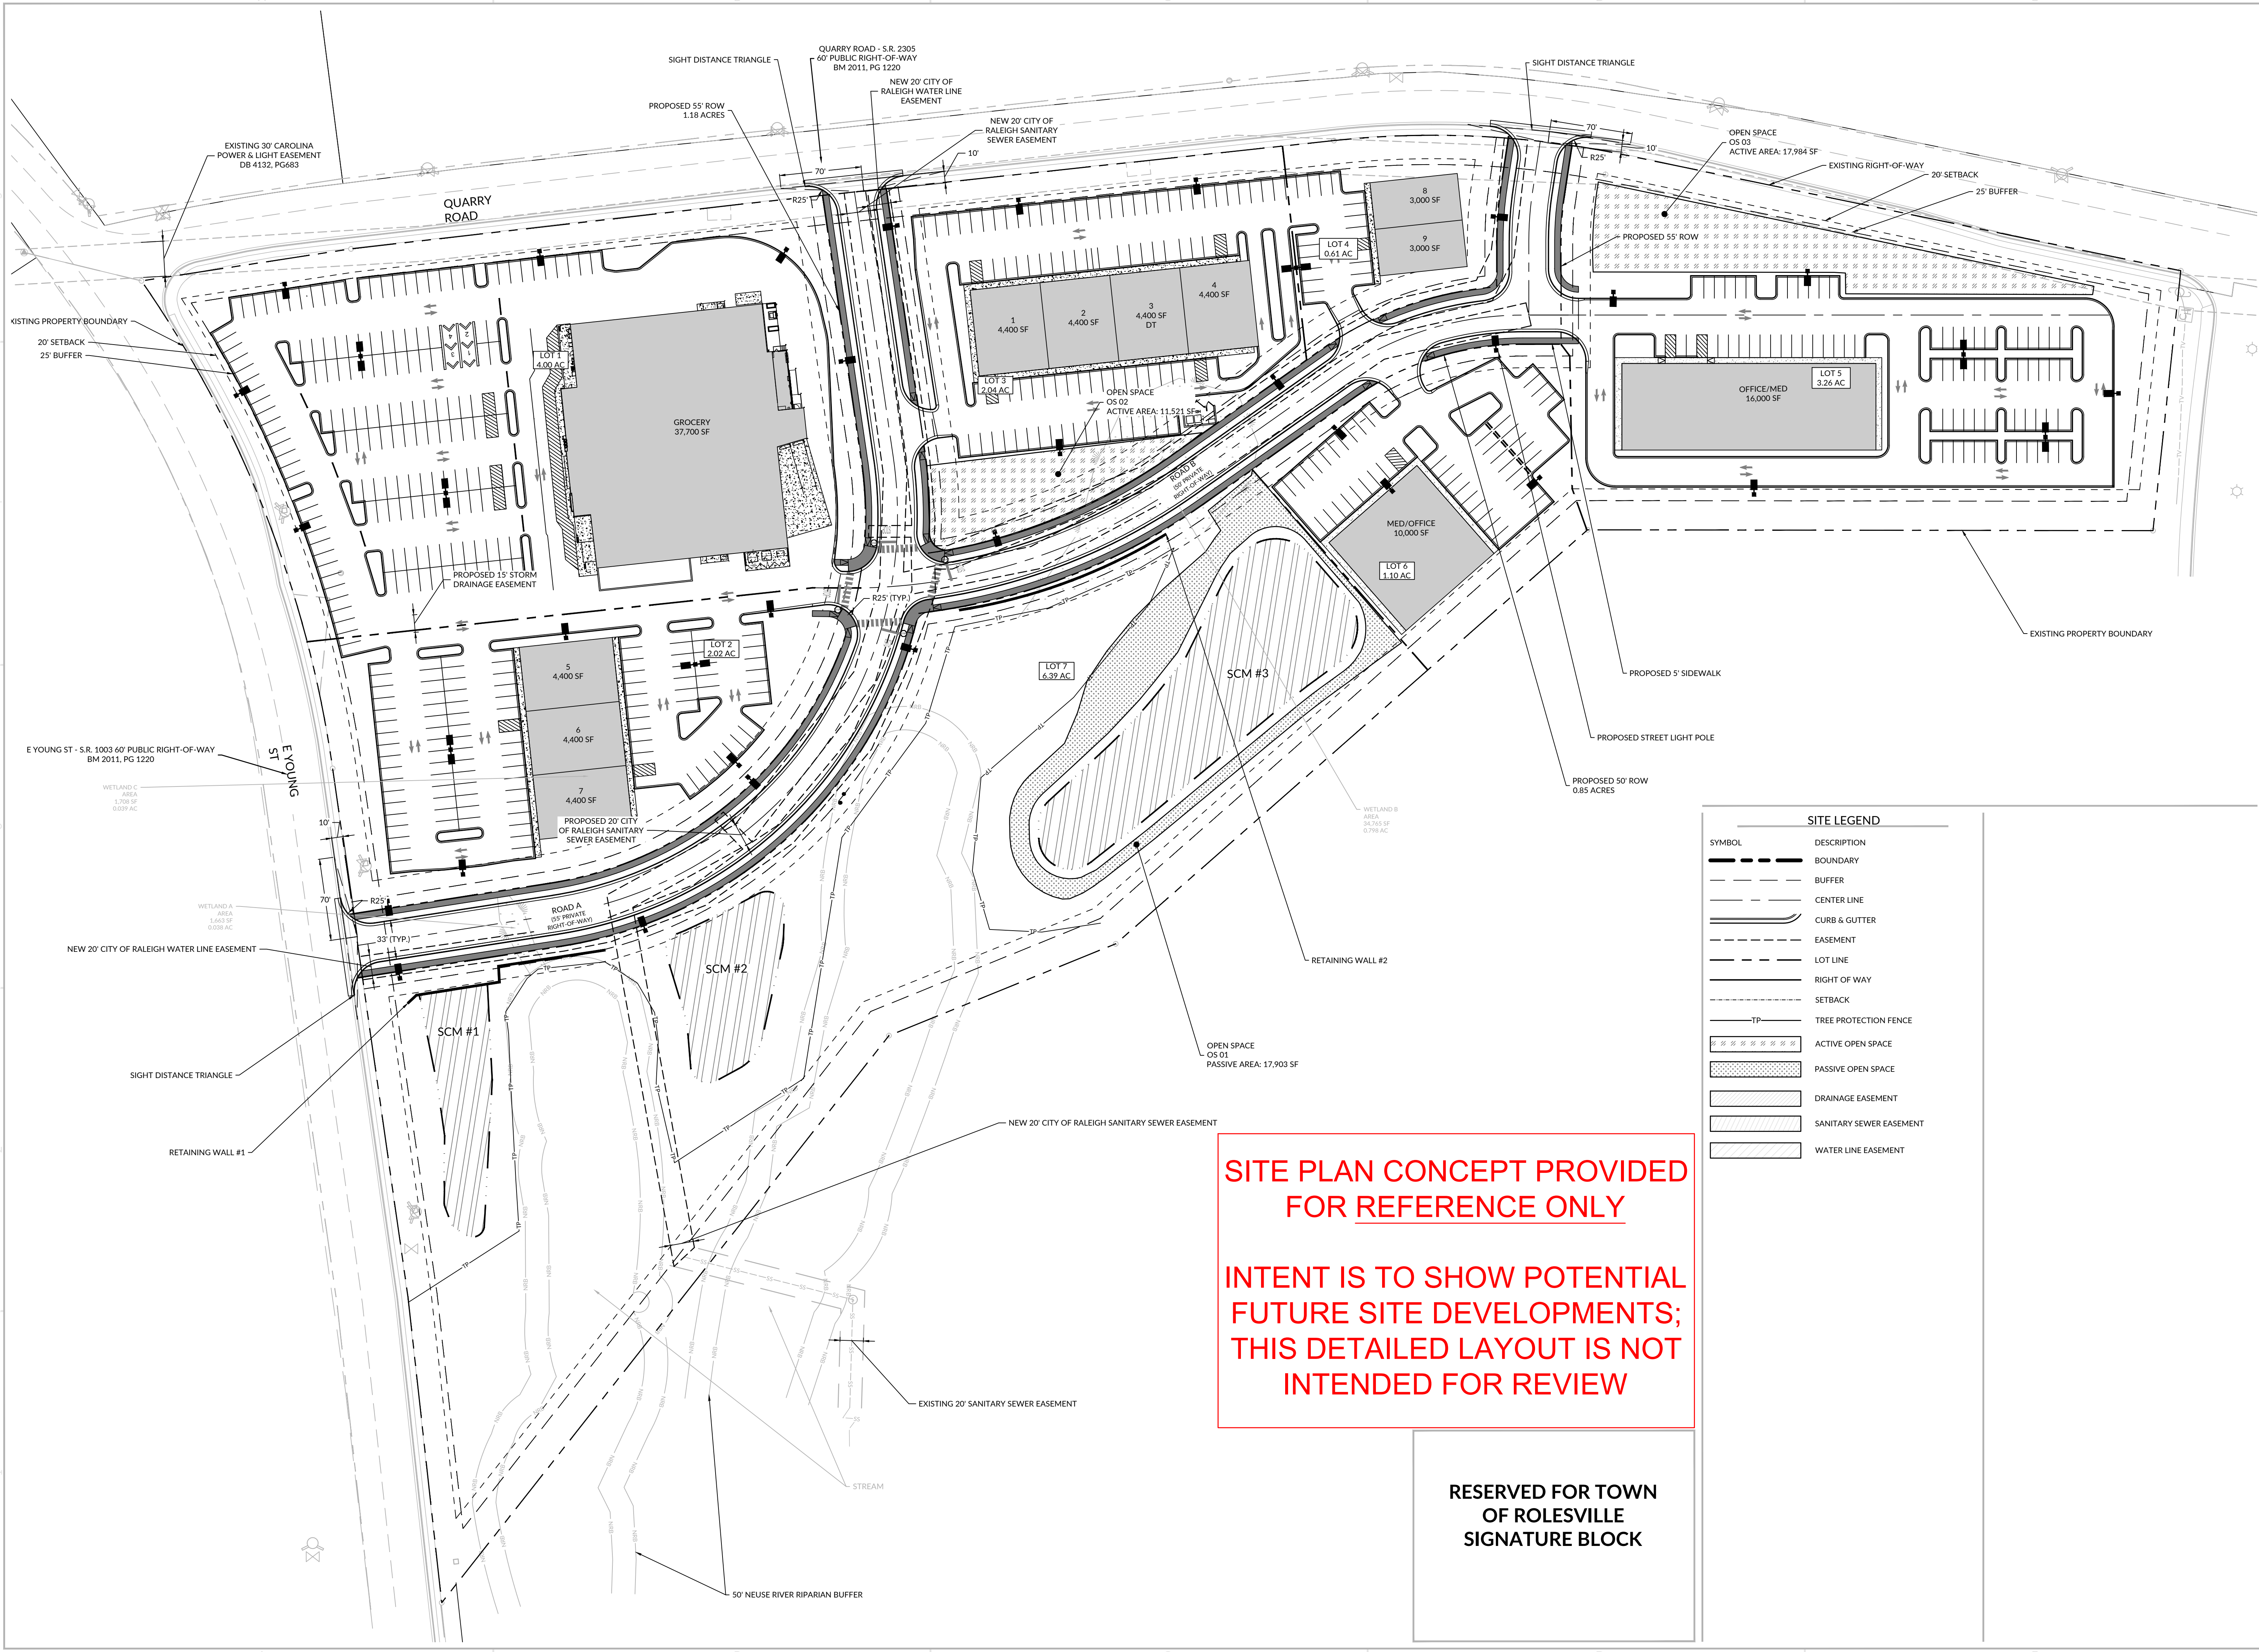

SITE LEGEND	
SYMBOL	DESCRIPTION
	BOUNDARY
	BUFFER
	CENTER LINE
	CURB & GUTTER
	EASEMENT
	LOT LINE
	RIGHT OF WAY
	SETBACK
	TREE PROTECTION FENCE
	ACTIVE OPEN SPACE
	PASSIVE OPEN SPACE
	DRAINAGE EASEMENT
	SANITARY SEWER EASEMENT
	WATER LINE EASEMENT

SITE PLAN CONCEPT PROVIDED
FOR REFERENCE ONLY

INTENT IS TO SHOW POTENTIAL
FUTURE SITE DEVELOPMENTS;
THIS DETAILED LAYOUT IS NOT
INTENDED FOR REVIEW

RESERVED FOR TOWN
OF ROLESVILLE
SIGNATURE BLOCK



PRELIMINARY SUBDIVISION PLANS
YOUNG ST COMMERCIAL
GRAVITY COMPANIES
PSP-25-02




INITIAL PLAN DATE: 08/01/2025
REVISIONS:
R1 -
R2 -
R3 -

Know what's below.
Call before you dig.
WR JOB NUMBER 24-0129-A
DRN: WR DGN: WR CKD: WR

SITE PLAN
CONCEPT

C2.10

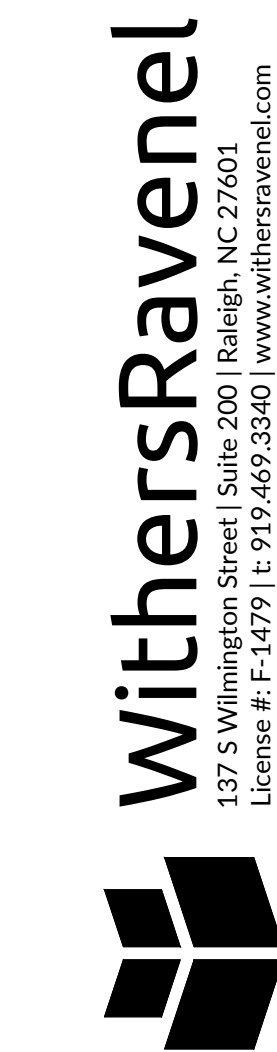

WithersRavenel
137 S Wilmington Street, Suite 200 | Raleigh, NC 27601
License #: F-1479 | t: 919.469.3340 | www.withersravenel.com

our people • your success



