

I, L. JORDAN PARKER, JR. CERTIFY THAT THIS PLAT WAS DRAWN UNDER MY SUPERVISION FROM AN ACTUAL SURVEY PERFORMED UNDER MY SUPERVISION FROM REFERENCES AS NOTED HERE ON; THAT THE BOUNDARIES NOT SURVEYED ARE CLEARLY INDICATED AS DRAWN FROM INFORMATION SHOWN IN THE REFERENCES; THAT THE RATIO OF PRECISION AS CALCULATED IS GREATER THAN 1:10000; THAT THE GLOBAL POSITIONING SYSTEM (GPS) SURVEY AND THE FOLLOWING INFORMATION WAS USED TO PERFORM THE GPS/GNSS SURVEY;

CLASS OF SURVEY: AA
POSITIONAL ACCURACY: HORIZONTAL 0.05 US SURVEY FEET
TYPE OF GPS FIELD PROCEDURE: REAL TIME KINEMATICS NETWORK (VRS)
DATES OF SURVEY:
DATUM/EPOCH: NAD 83(2011) 2010 00
PUBLISHED/FIXED CONTROL USE: RALPH DOT CORP ARP
LAT: 35°45'49.50795"
LONG: 78°34'44.39448"

GEIOD MODEL: GEOD12B
COMBINED GRID FACTORS: 0.99992301341532
UNITS: US SURVEY FOOT

THAT THIS PLAT WAS PREPARED IN ACCORDANCE WITH G.S. 47-30 AS AMENDED, WITNESS MY ORIGINAL SIGNATURE, LICENSE NUMBER AND SEAL

THIS _____ DAY OF _____, A.D. 2025.

PROFESSIONAL LAND SURVEYOR LICENSE NUMBER L-4685

THAT THE SURVEY IS OF ANOTHER CATEGORY, SUCH AS THE RECOMBINATION OF EXISTING PARCELS, A COURT-ORDERED SURVEY, OR OTHER EXEMPTION OR EXCEPTION TO THE DEFINITION OF SUBDIVISION.

PROFESSIONAL LAND SURVEYOR LICENSE NUMBER L-4685

I HEREBY CERTIFY THAT I AM THE OWNER OF THE PROPERTY SHOWN AND DESCRIBED HEREON, WHICH IS LOCATED IN THE SUBDIVISION JURISDICTION OF THE TOWN OF ROLESVILLE AND THAT I HEREBY ADOPT THIS PLAN OF SUBDIVISION WITH MY FREE CONSENT, ESTABLISH MINIMUM BUILDING SETBACK LINES, AND DEDICATE ALL STREETS, ALLEYS, WALKS, PARKS, AND OTHER SITES AND EASEMENTS TO PUBLIC OR PRIVATE USE AS NOTED. FURTHERMORE, I HEREBY DEDICATE ALL SANITARY SEWER, STORM SEWER AND WATER LINES TO THE TOWN OF ROLESVILLE.

OWNER DATE

ROLESVILLE, NORTH CAROLINA


I, _____, REVIEW OFFICER OF THE TOWN OF ROLESVILLE, WAKE COUNTY, CERTIFY THAT THE MAP OR PLAT TO WHICH THIS CERTIFICATION IS AFFIXED MEETS ALL STATUTORY REQUIREMENTS FOR RECORDING.

DATE REVIEW OFFICER

CERTIFICATE OF APPROVAL FOR RECORDING

I HEREBY CERTIFY THAT THE SUBDIVISION PLAT SHOWN HEREON HAS BEEN FOUND TO COMPLY WITH THE SUBDIVISION REGULATIONS OF THE TOWN OF ROLESVILLE, NORTH CAROLINA AND THAT THIS PLAT HAS BEEN APPROVED BY THE SUBDIVISION ADMINISTRATOR OF THE TOWN OF ROLESVILLE FOR RECORDING IN THE OFFICE OF THE REGISTER OF DEEDS OF WAKE COUNTY.

DATE SUBDIVISION ADMINISTRATOR, TOWN OF ROLESVILLE ROLESVILLE, NORTH CAROLINA

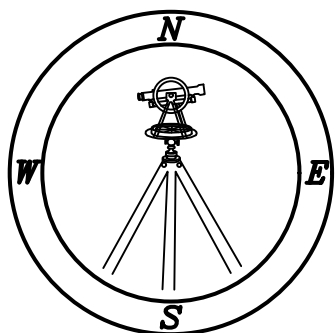

CMP


PROFESSIONAL LAND SURVEYORS, C-1525, 333 S. WHITE STREET, P.O. BOX 1253, WAKE FOREST N.C., 27588, (919) 556-3148

PRELIMINARY

FOR REVIEW PURPOSES ONLY

"Old property line" does not appear to match the legal description for "Tract 2" in reference noted. Please correct if depicted incorrectly.

To avoid confusion, please label as new lot 1 and new lot 2 or add to legend as new lot designation

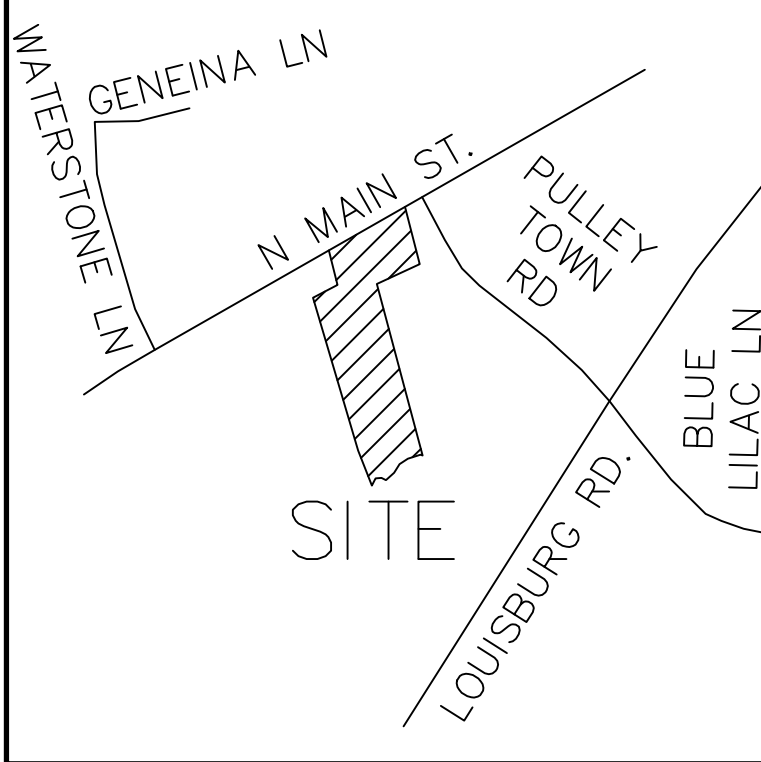

VICINITY MAP

LEGEND:

- EIP - EXISTING IRON PIPE
- EIB - EXISTING IRON BAR
- BEIP - BENT IRON PIPE
- BEIB - BENT IRON BAR
- CM - CONCRETE MONUMENT
- EPK - EXISTING PK NAIL
- SPK - SET PK NAIL
- NIP - NEW IRON PIPE SET
- R/W - RIGHT OF WAY
- CATV - CABLE TV BOX
- EB - ELECTRIC BOX
- TEL - TELEPHONE PEDESTAL
- PP - POWER POLE
- OHL - OVERHEAD LINE
- LP - LIGHT POLE
- WM - WATER METER
- WV - WATER VALVE
- CO - SEWER CLEAN-OUT
- CC - CONCRETE
- CB - CATCH BASIN
- MH - MANHOLE
- FH - FIRE HYDRANT

LINE TYPE LEGEND

- PROPERTY LINE - LINE SURVEYED
- RIGHT-OF-WAY
- ADJOINING LINE - LINE NOT SURVEYED
- OVERHEAD LINE
- BUILDING SETBACK
- EASEMENT
- BUTTER
- FLOOD HAZARD SOILS

LINE TABLE		
LINE	BEARING	DISTANCE
L-1	N 15°43'21" W	20.25'
L-2	S 60°11'20" W	119.97'
L-3	S 41°38'34" W	157.20'
L-4	N 75°27'27" W	58.66'
L-5	S 65°01'56" W	55.29'
L-6	S 77°37'12" W	76.79'
L-7	S 77°37'12" W	17.27'
L-8	S 23°01'14" W	84.96'
L-9	S 58°53'27" W	204.46'
L-10	S 35°56'41" W	57.74'

NOTES:

- AREA COMPUTED BY COORDINATE METHOD.
- THERE IS NO NCGS MONUMENT WITHIN 2000' OF THIS PROPERTY.
- NORTH ROTATION WAS OBTAINED VIA NC-VRS.
- THIS PROPERTY MAY BE SUBJECT TO NEUSE RIVER RIPARIAN BUFFER RULES. CALL N.C. DIVISION OF WATER QUALITY TO VERIFY (919-791-4200).

OWNER:

ROBERT WILLIAMS
2525 BURLINGTON MILLS RD
WAKE FOREST, NC 27587

RECOMBINATION SURVEY FOR

ROBERT WILLIAMS

716 N. MAIN STREET
OWNERS: ROBERT WILLIAMS
& RHONDA WILLIAMS

REF: D.B. 18985 PAGE 1086

TOWN OF ROLESVILLE
WAKE COUNTY, NORTH CAROLINA

120 60 0 120 240

SCALE 1"=120'

FEBRUARY 27, 2025

ZONED: RL

PIN # 1769.04-54-1584

PIN # 1769.04-53-1576

PRELIMINARY
FOR REVIEW PURPOSES ONLY

(NMAIN716.DWG - JML)