



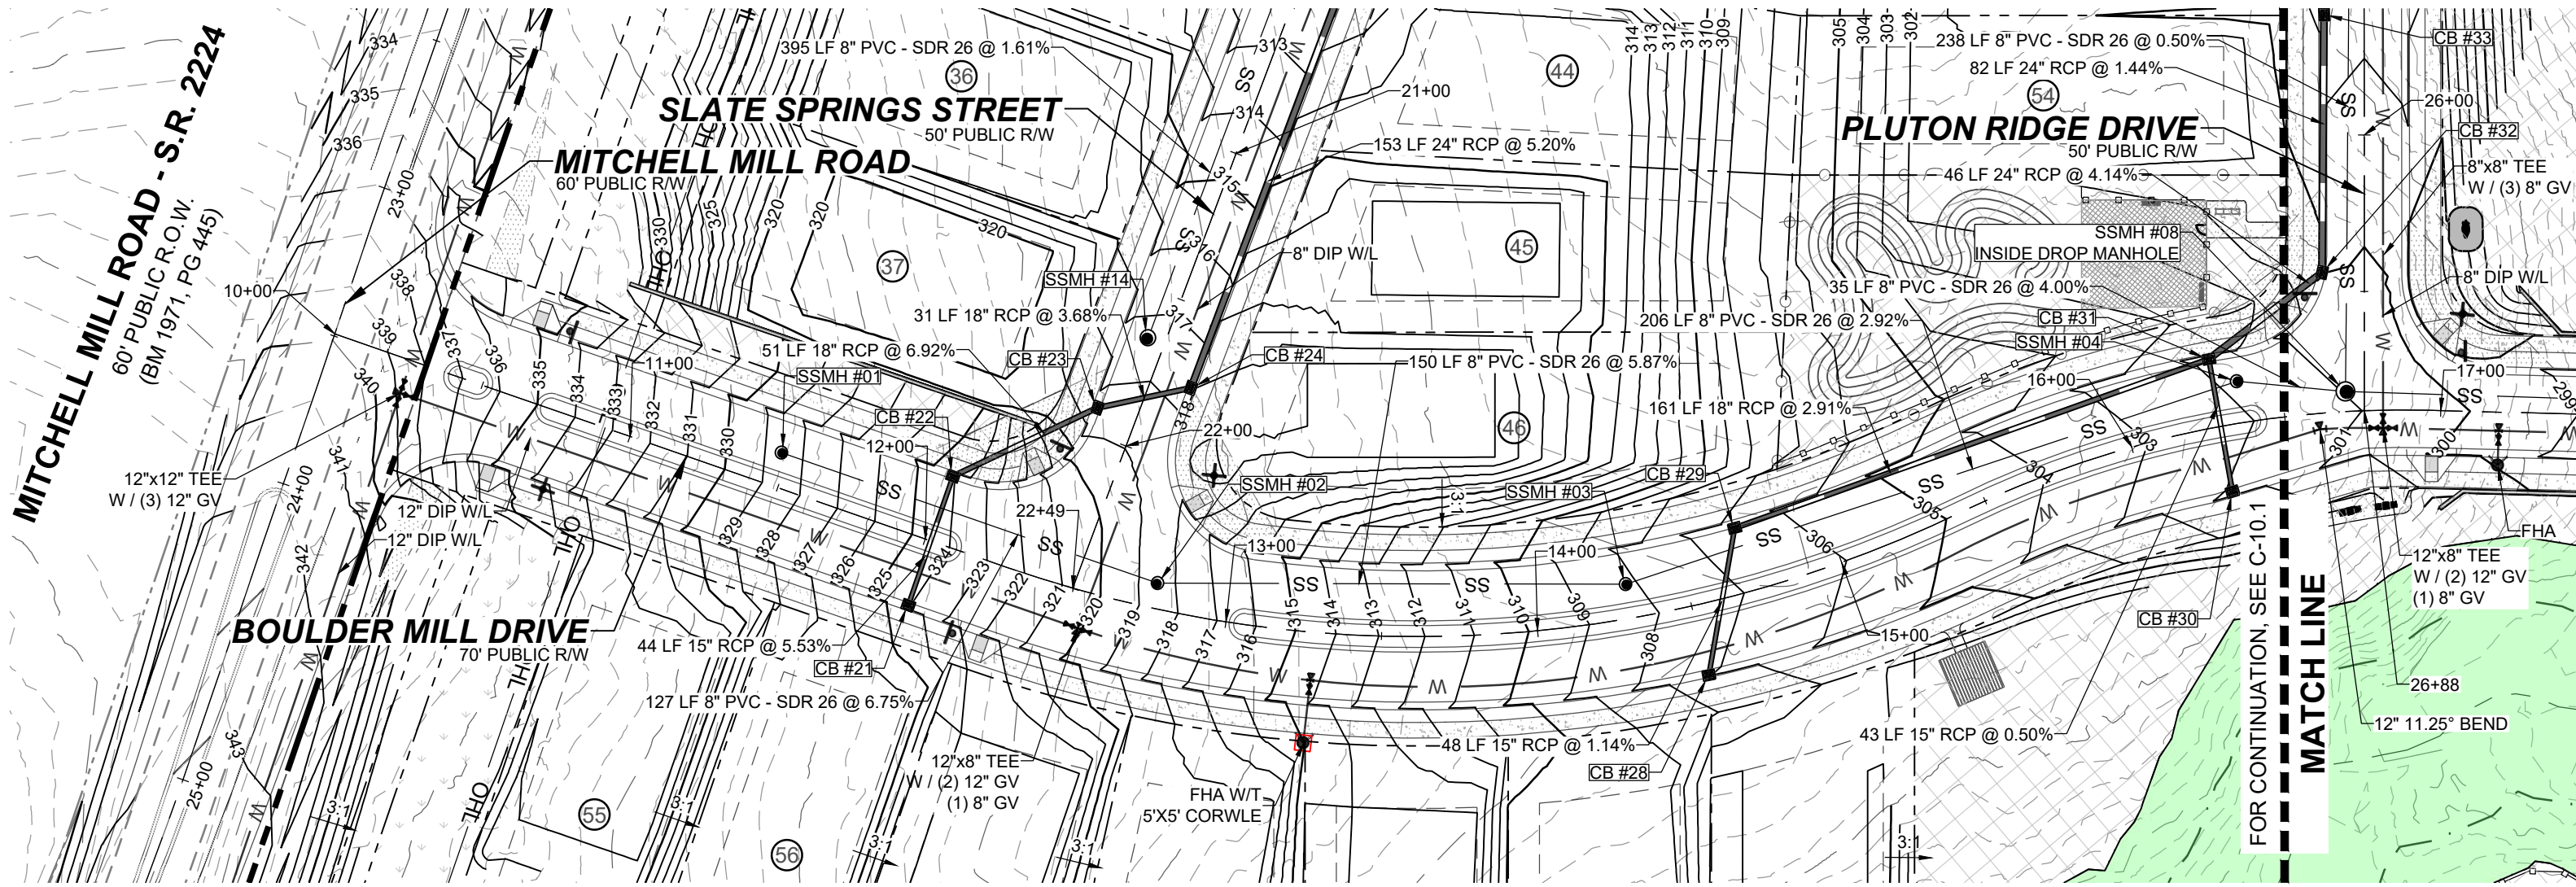


PROPOSED BOULDER MILL DRIVE - PLAN
HORIZONTAL: 1" = 50'

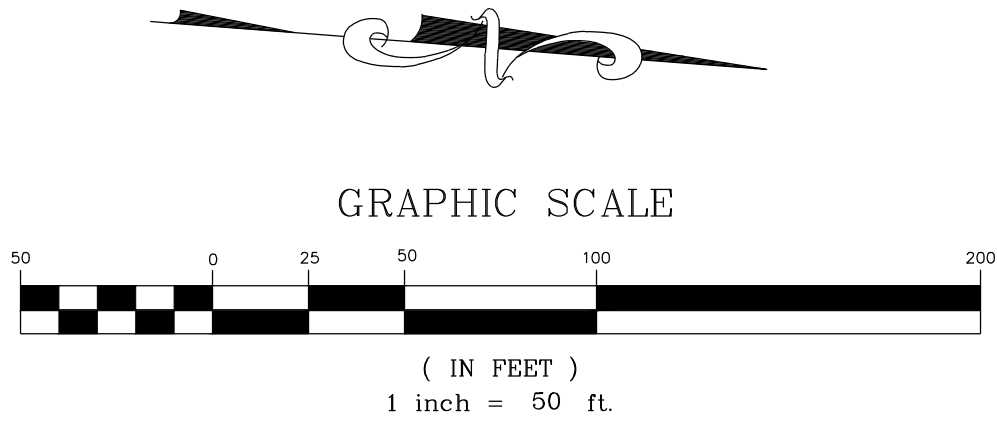

FYI, sewer installation depth from 5-12 ft can SDR 35. Deeper than 12' should e SDR 26.

SREG: This is noted, thank you.

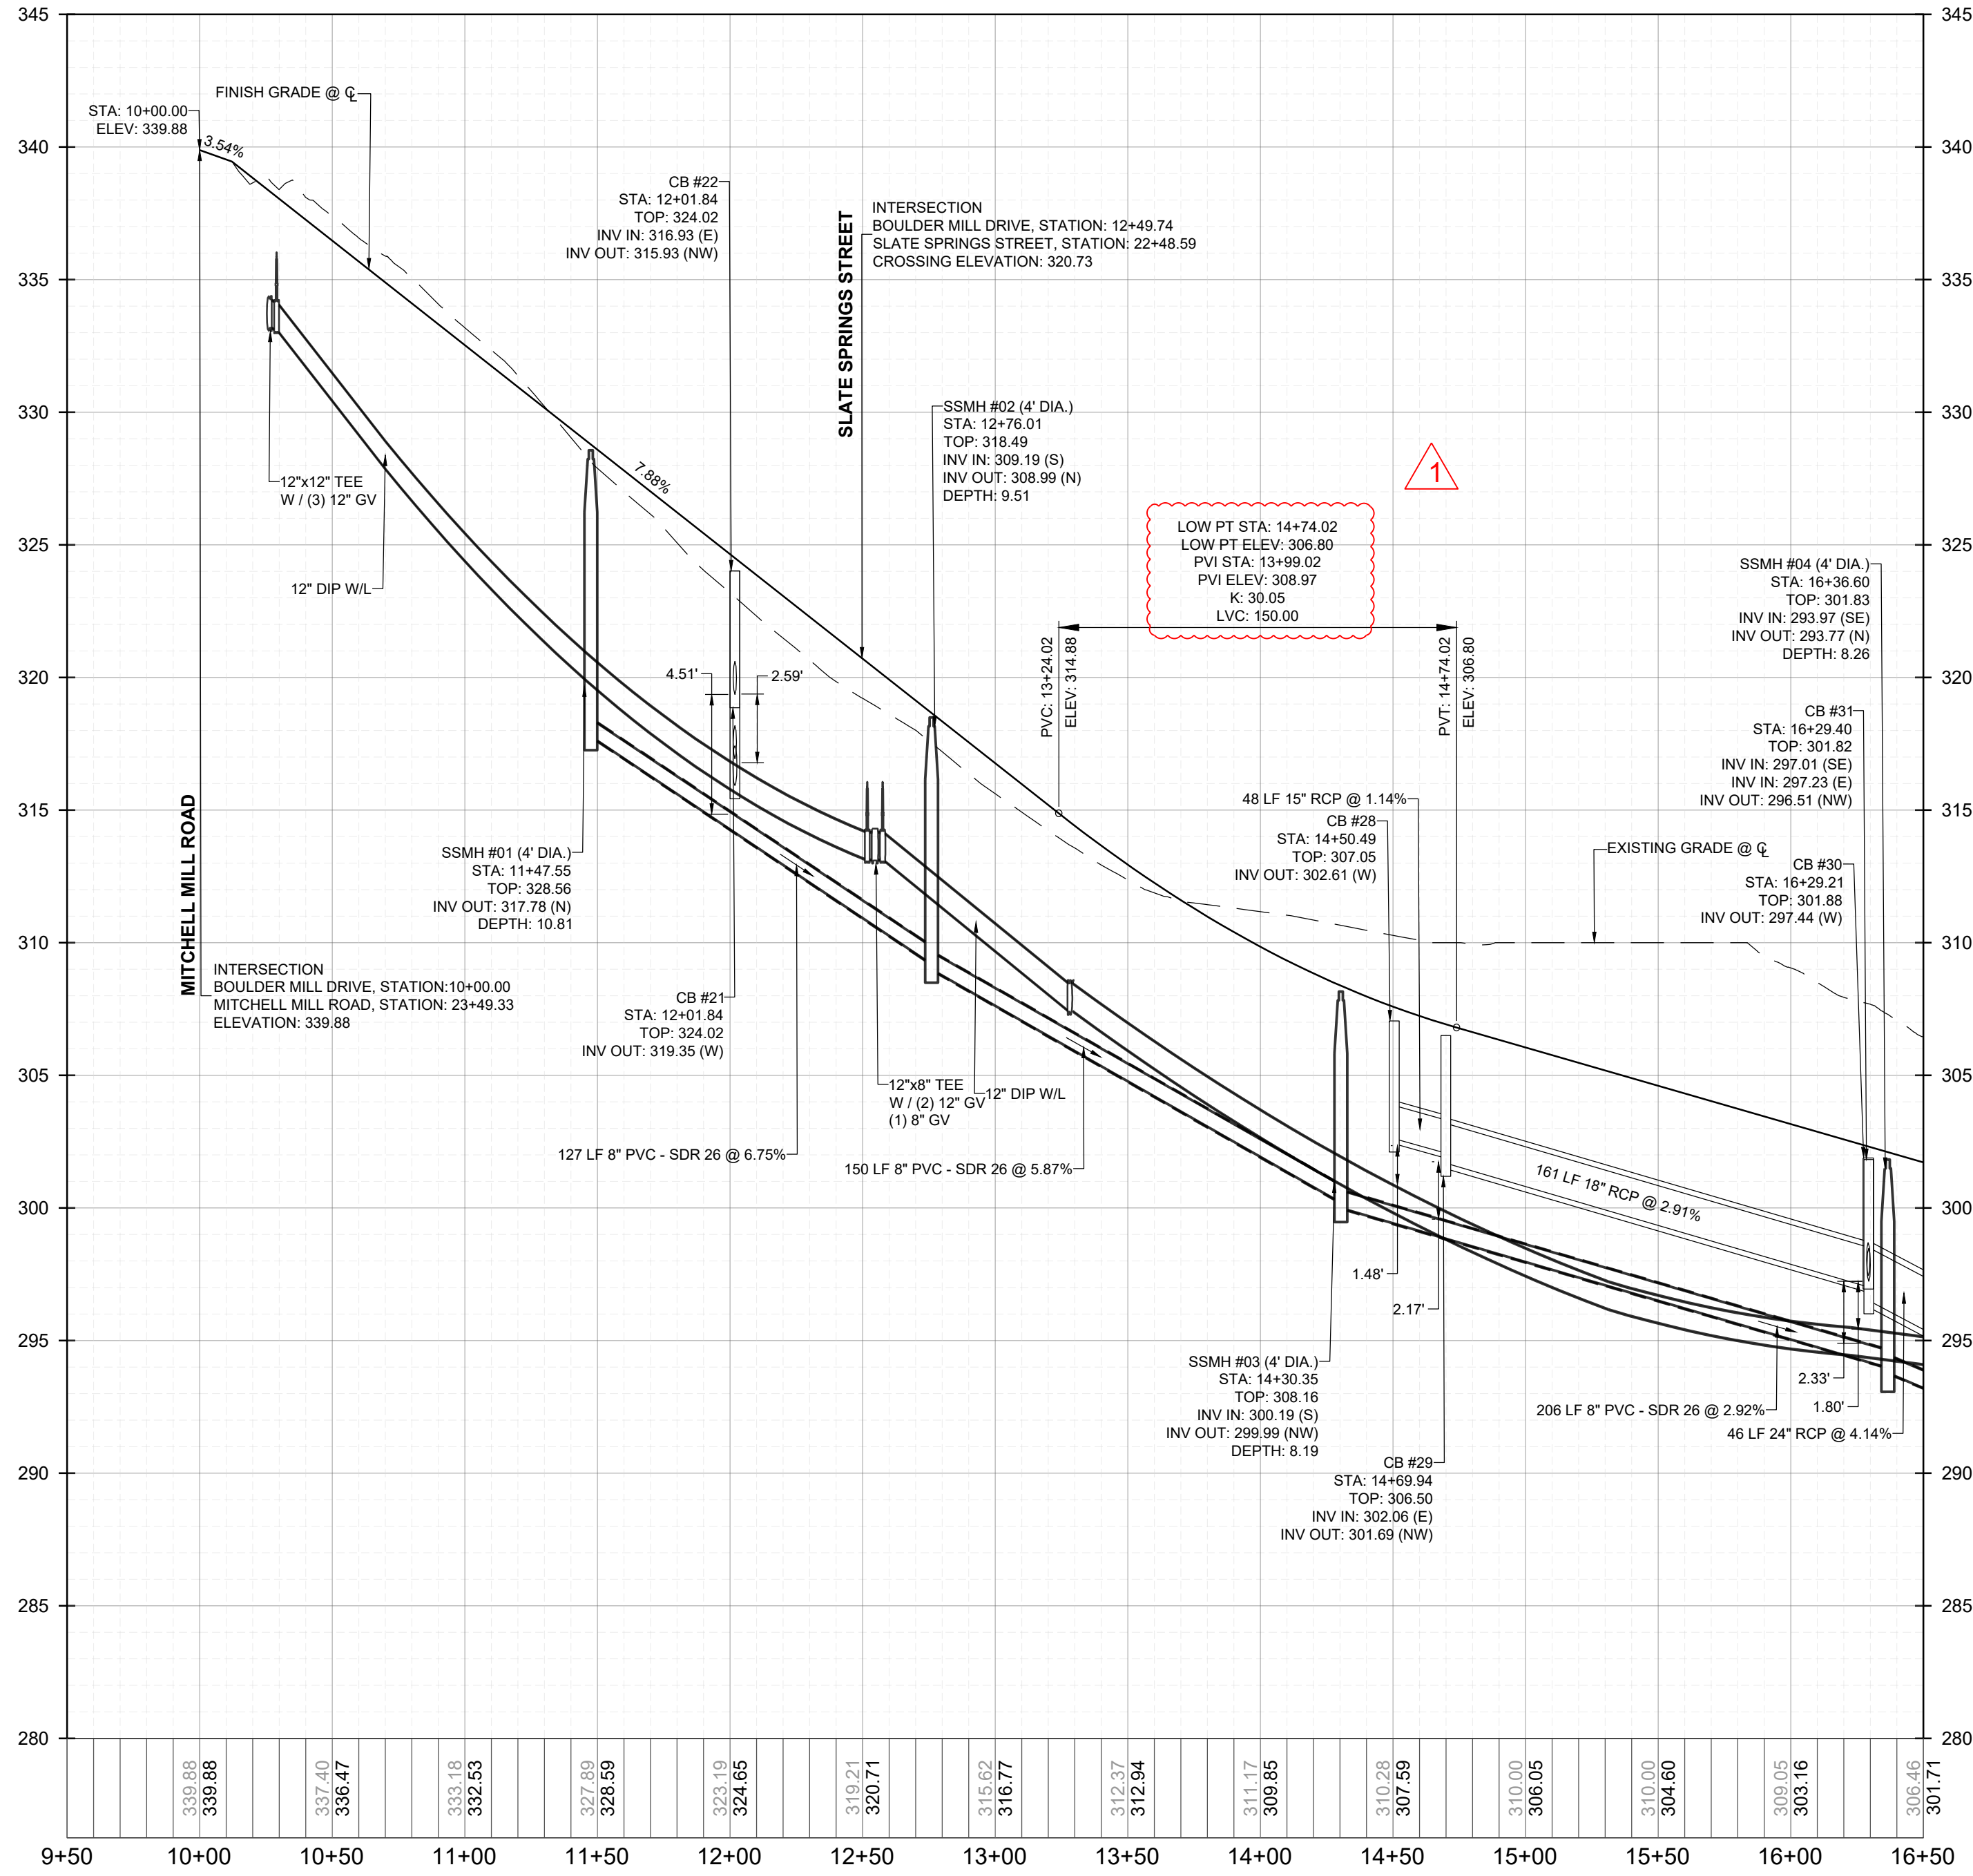

PROPOSED BOULDER MILL DRIVE - PROFILE
VERTICAL: 1" = 5'
HORIZONTAL: 1" = 50'

BY	DATE	REVISIONS
01		
02		



STRONG

ROCK

ENGINEERING GROUP

STRONG ROCK ENGINEERING GROUP, PLLC | COMPANY LICENSE # P-2766
305 CHURCH AT NORTH HILLS STREET, SUITE 1110 RALEIGH, NC 27609 | INFORMATION@STRONGROCKGROUP.COM



STRONG ROCK PROJECT	NOT FOR CONSTRUCTION	SCALE AS SHOWN	DESIGNED BY JWL	DRAWN BY SRG	CHECKED BY JWL
---------------------	----------------------	----------------	-----------------	--------------	----------------

HILLS AT HARRIS CREEK
TOWN OF ROLESVILLE, WAKE COUNTY, NORTH CAROLINA
CONSTRUCTION PLANS
PROPOSED BOULDER MILL DRIVE -
PLAN & PROFILE


DRAWING SHEET

C-10.0

69 OF 129

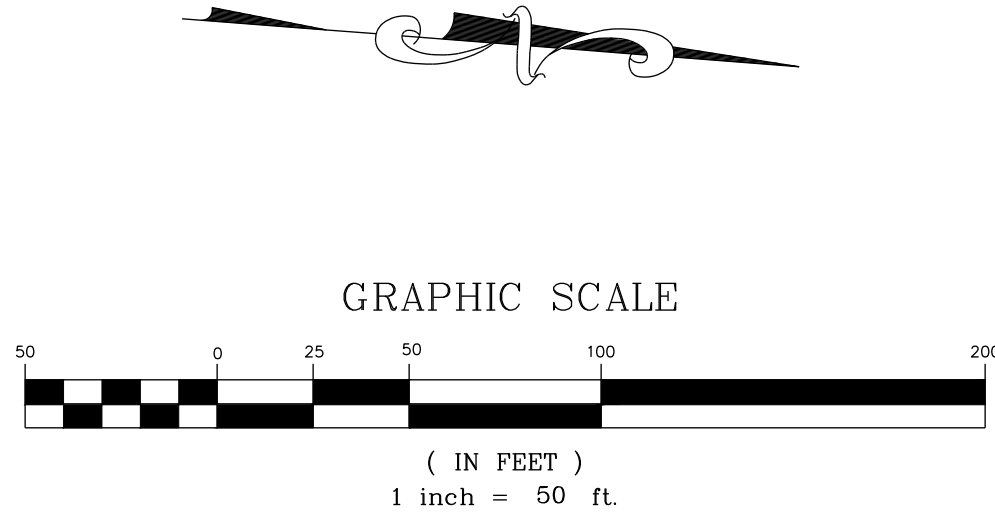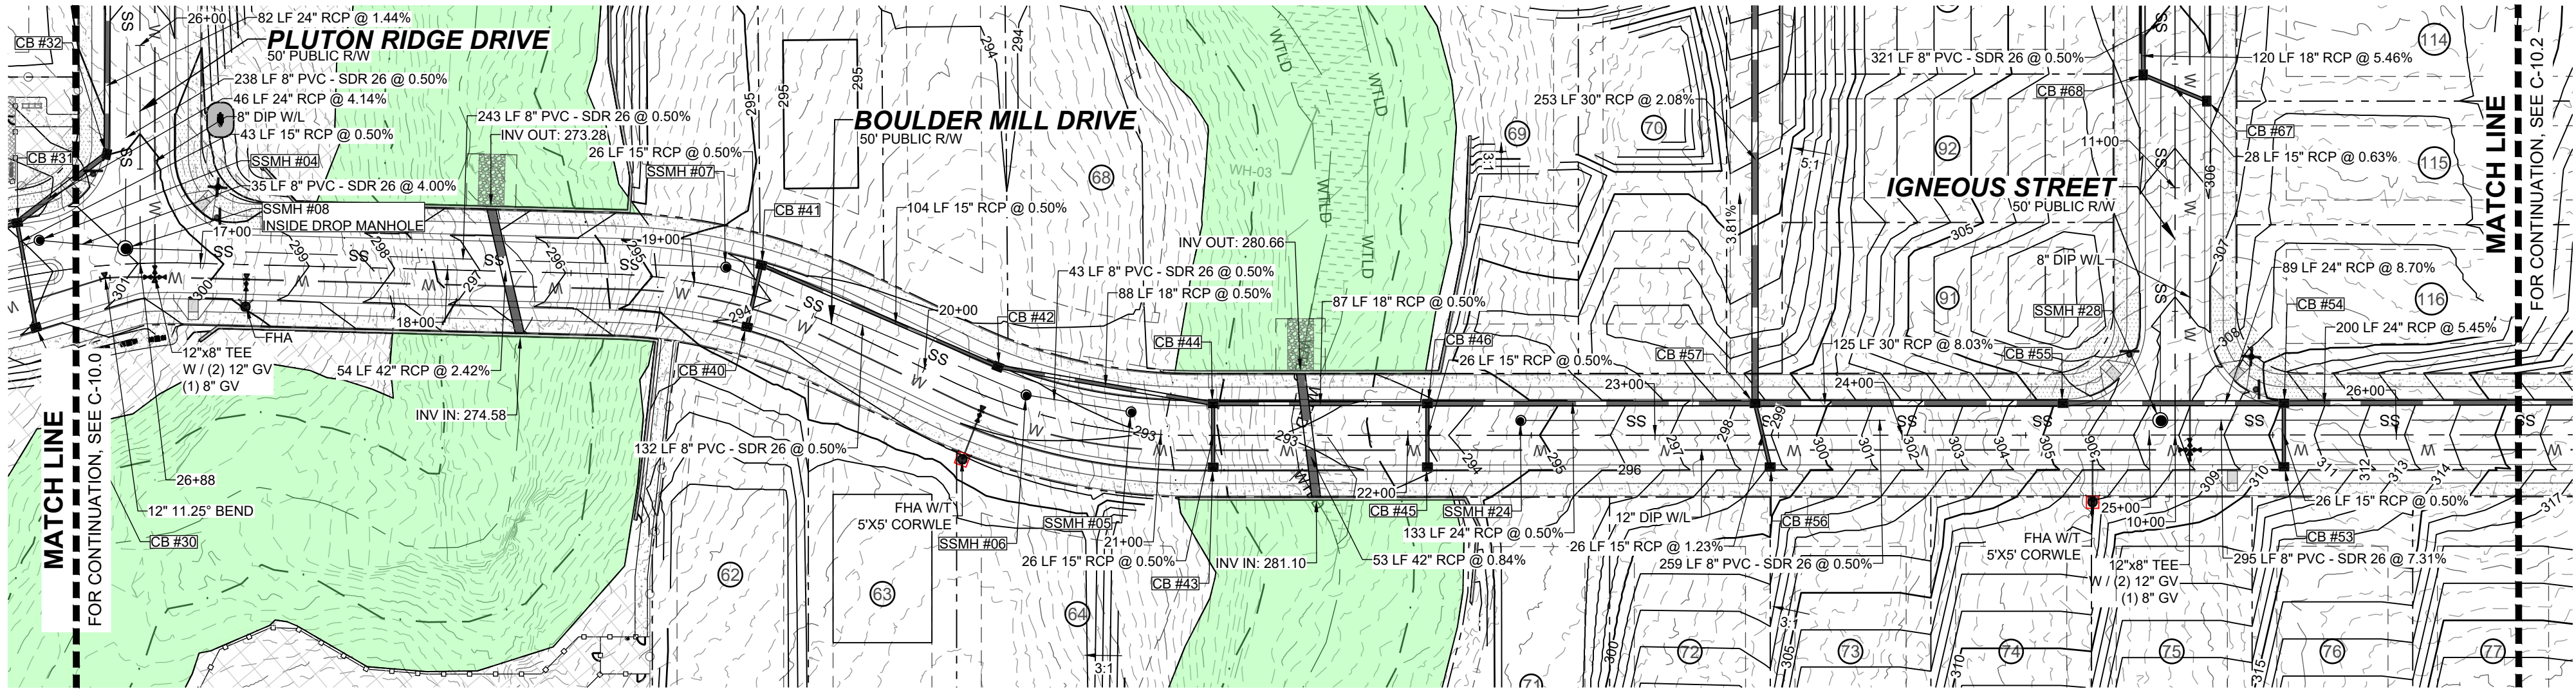

PROPOSED BOULDER MILL DRIVE - PLAN
HORIZONTAL: 1" = 50'

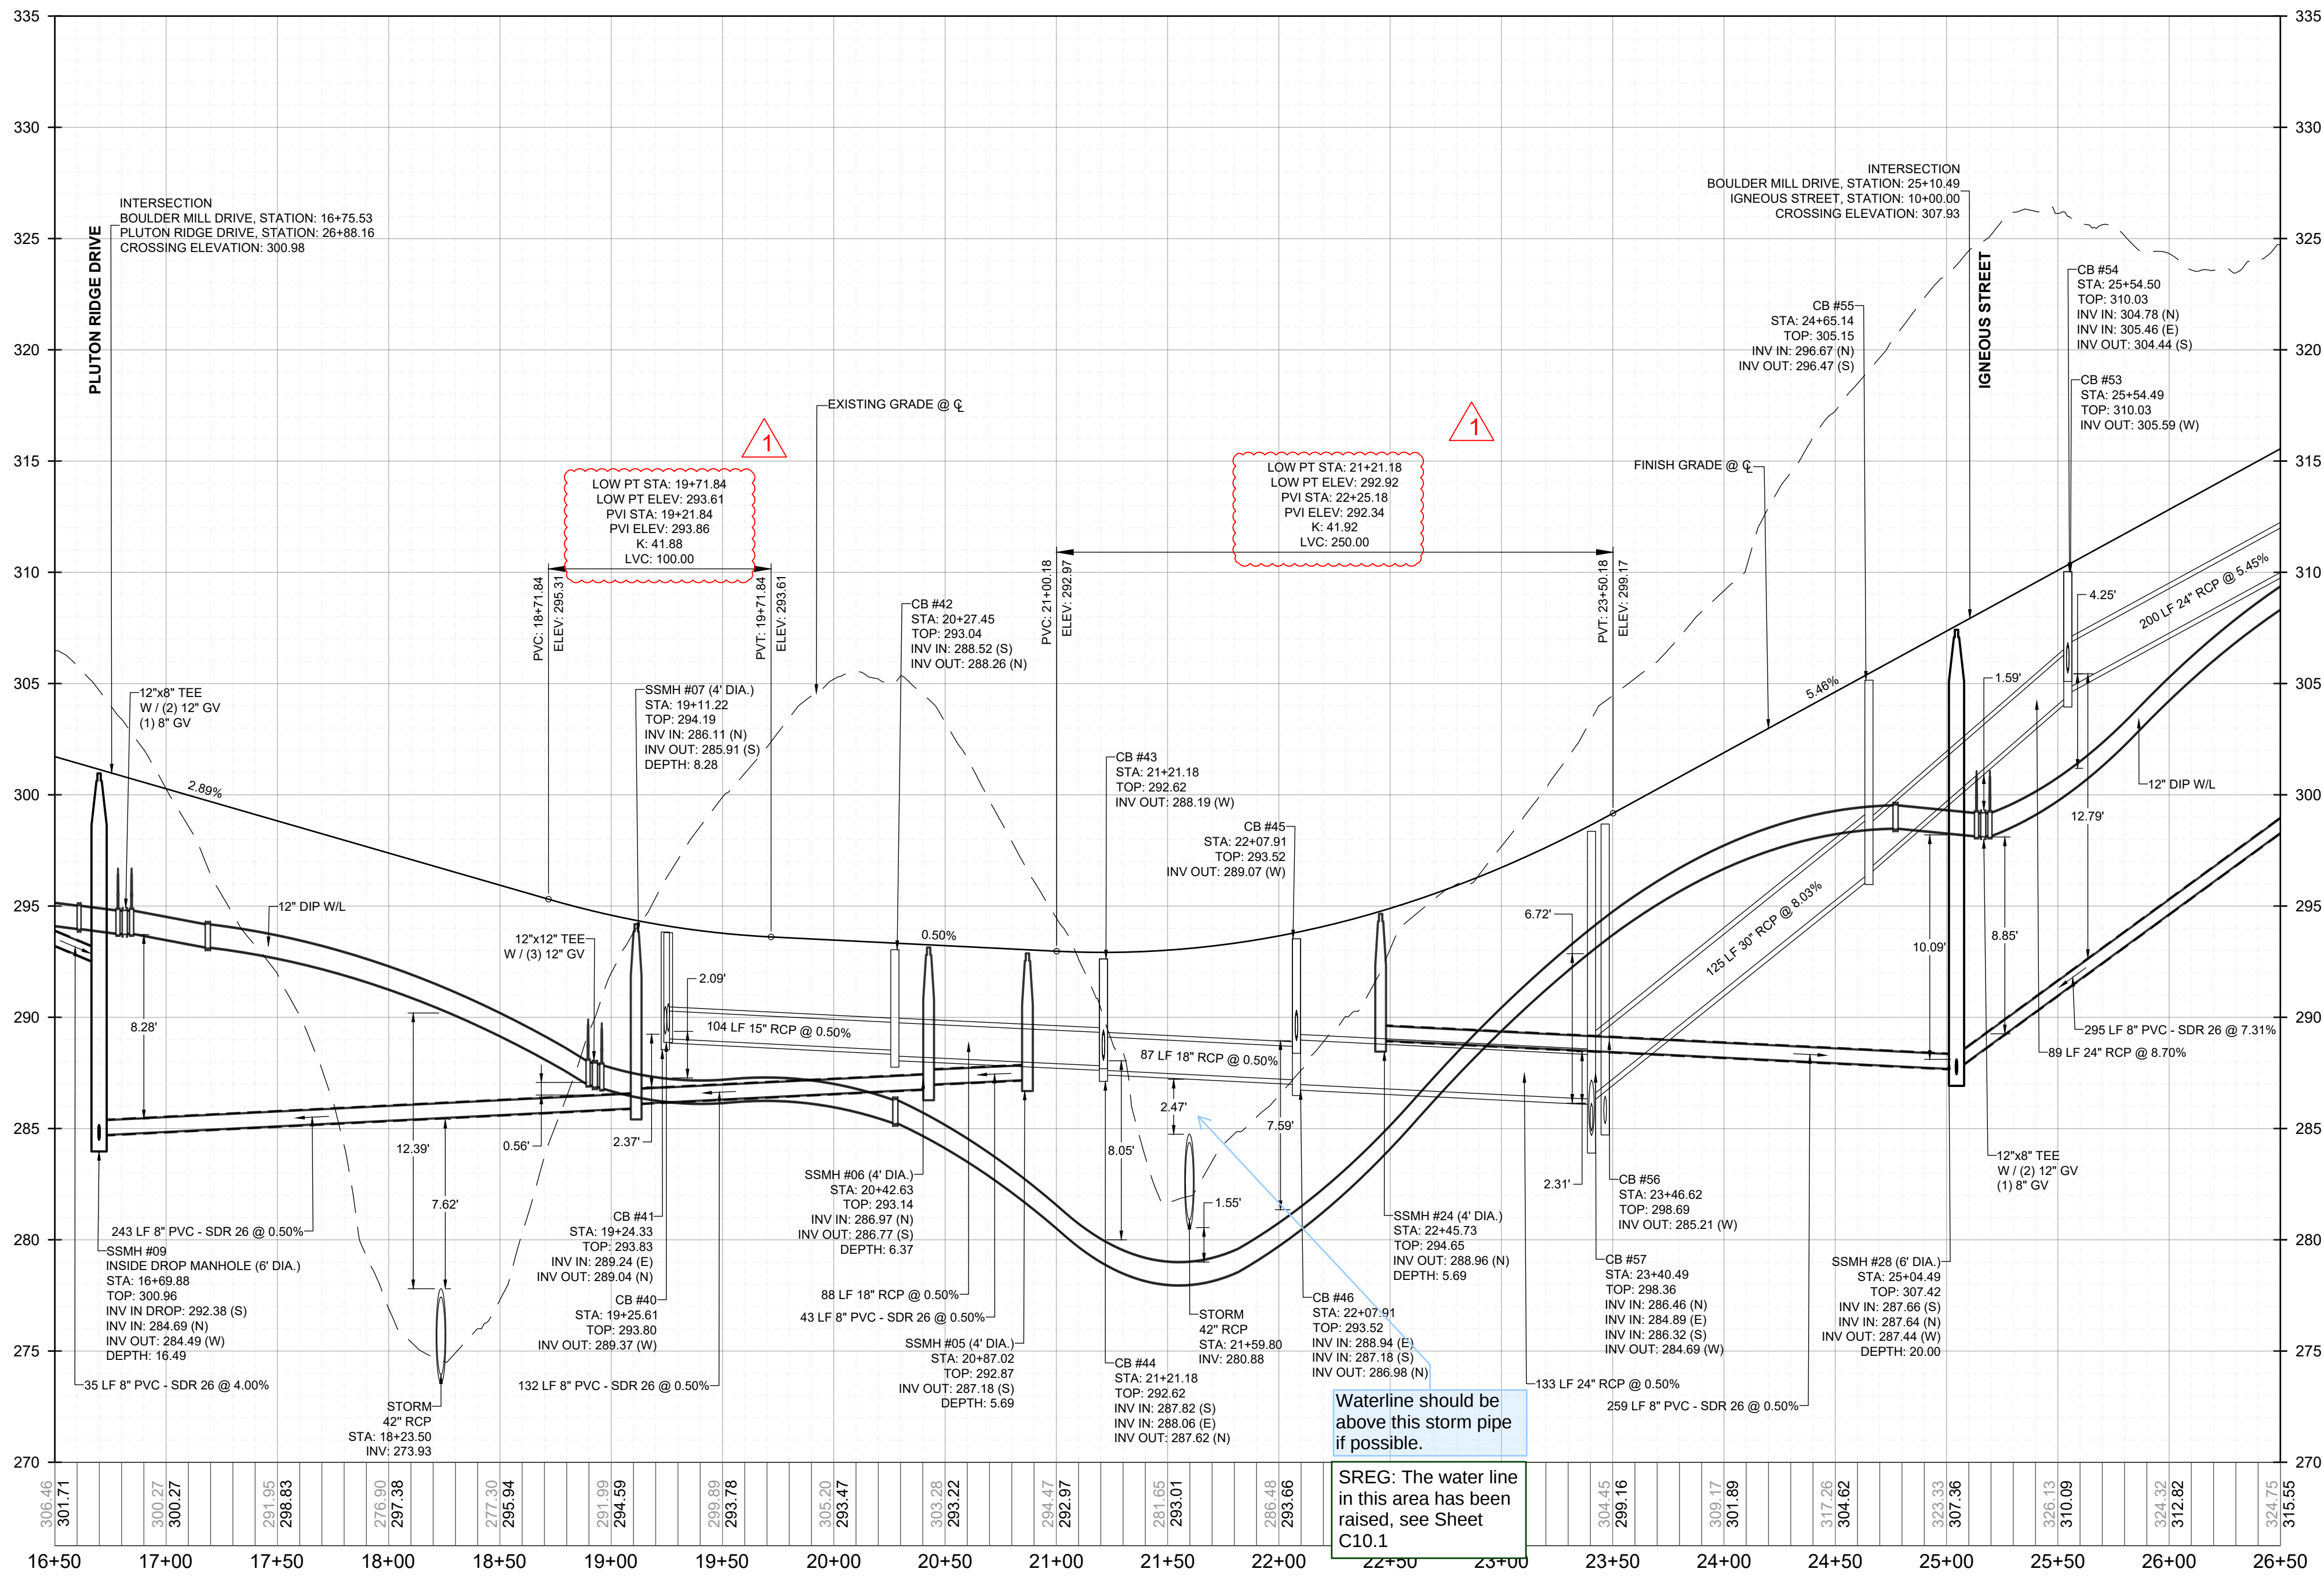

PROPOSED BOULDER MILL DRIVE - PROFILE
VERTICAL: 1" = 5'
HORIZONTAL: 1" = 50'

NO.	REVISIONS	DATE	BY
01			
02			



STRONGROCK
ENGINEERING GROUP


STRONG ROCK ENGINEERING GROUP, PLLC | COMPANY LICENSE # P-2166
305 CHURCH AT NORTH HILLS STREET, SUITE 1110 RALEIGH, NC 27609 | INFORMATION@STRONGROCKGROUP.COM

STRONG ROCK PROJECT
NOT FOR CONSTRUCTION
SCALE AS SHOWN
DESIGNED BY JWL
DRAWN BY SRG
CHECKED BY JWL


HILLS AT HARRIS CREEK
TOWN OF ROLESVILLE, WAKE COUNTY, NORTH CAROLINA
CONSTRUCTION PLANS
PROPOSED BOULDER MILL
DRIVE - PLAN & PROFILE

DRAWING SHEET

C-10.1

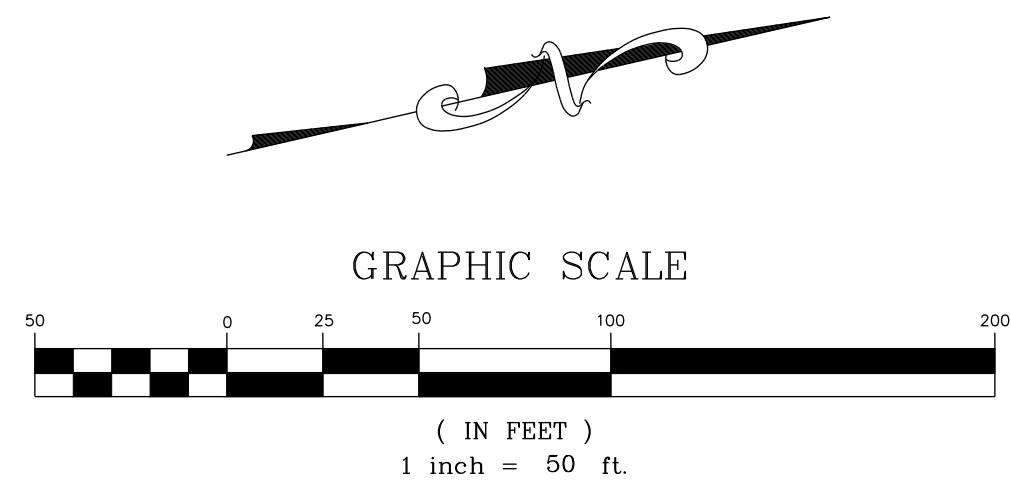

A circular professional engineer seal for the State of North Carolina. The outer ring contains the text "NORTH CAROLINA" at the top and "JOSHUA W. LAMBERT" at the bottom. The inner circle contains the text "PROFESSIONAL" at the top, "SEAL" in the center, "036225" below the seal, and "ENGINEER" at the bottom.

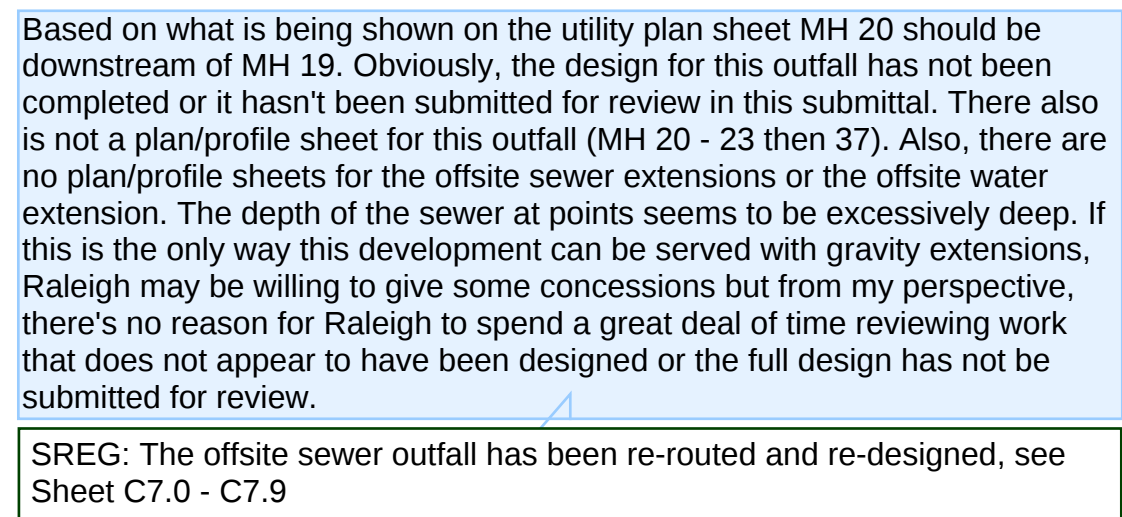

STRONG  **ENGINEERING GROUP**

STRONG ROCK ENGINEERING GROUP, PLLC | COMPANY LICENSE # P-2166
305 CHURCH AT NORTH HILLS STREET, SUITE 1110 RALEIGH, NC 27609 | INFORMATION@STRONGROCKGROUP.COM

STRONG ROCK PROJECT	NOT FOR CONSTRUCTION
SCALE	AS SHOWN
DESIGNED BY	JWL
DRAWN BY	SRG
CHECKED BY	JWL

HILLS AT HARRIS CREEK
TOWN OF ROLESVILLE, WAKE COUNTY, NORTH CAROLINA

CONSTRUCTION PLANS

PROPOSED PLUTON RIDGE DRIVE
PLAN & PROFILE

DRAWING
SHEET

C-10.4