

CERTIFICATE OF OWNERSHIP AND DEDICATION

I HEREBY CERTIFY THAT I AM THE OWNER OF THE PROPERTY SHOWN AND DESCRIBED HEREON, WHICH IS LOCATED IN THE SUBDIVISION JURISDICTION OF THE TOWN OF ROLESVILLE AND THAT I HEREBY ADOPT THIS PLAN OF SUBDIVISION WITH MY FREE CONSENT, ESTABLISH MINIMUM BUILDING SETBACK LINES, AND DEDICATE ALL STREETS, ALLEYS, WALKS, PARKS, AND OTHER SITES AND EASEMENTS TO PUBLIC OR PRIVATE USE AS NOTED. FURTHERMORE, I HEREBY DEDICATE ALL SANITARY SEWER AND WATER LINES TO THE CITY OF RALEIGH PUBLIC UTILITIES AND STORM SEWER TO THE TOWN OF ROLESVILLE.

OWNER: FH-HOF - ROLESVILLE, LLC

SIGNATURE PRINT NAME DATE

NORTH CAROLINA, COUNTY.

I, , A NOTARY PUBLIC OF THE COUNTY AND STATE AFORESAID, CERTIFY THAT PERSONALLY APPEARED BEFORE ME THIS DAY AND ACKNOWLEDGED THE EXECUTION OF THE FOREGOING INSTRUMENT. WITNESS MY HAND AND OFFICIAL STAMP OR SEAL, THIS DAY OF , 2025.

MY COMMISSION EXPIRES

CERTIFICATE OF APPROVAL FOR RECORDING

I HEREBY CERTIFY THAT THE SUBDIVISION PLAT SHOWN HEREON HAS BEEN FOUND TO COMPLY WITH THE SUBDIVISION REGULATIONS OF THE TOWN OF ROLESVILLE, NORTH CAROLINA AND THAT THIS PLAT HAS BEEN APPROVED BY THE LDA OF THE TOWN OF ROLESVILLE FOR RECORDING IN THE OFFICE OF THE REGISTER OF DEEDS OF WAKE COUNTY.

LDA TOWN OF ROLESVILLE NORTH CAROLINA DATE

I, , REVIEW OFFICER OF THE TOWN OF ROLESVILLE, WAKE COUNTY, CERTIFY THAT THE MAP OR PLAT TO WHICH THIS CERTIFICATION IS AFFIXED MEETS ALL STATUTORY REQUIREMENTS FOR RECORDING.

REVIEW OFFICER DATE

SURVEYOR'S CERTIFICATE

I, MICHAEL W. ZMUDA, CERTIFY THAT THIS PLAT WAS DRAWN UNDER MY SUPERVISION FROM AN ACTUAL SURVEY MADE UNDER MY SUPERVISION BASED ON THE DEED DESCRIPTION RECORDED IN BOOK 19845, PAGE 1077, WAKE COUNTY REGISTRY; THAT THE BOUNDARIES NOT SURVEYED ARE CLEARLY INDICATED AS DRAWN FROM INFORMATION FOUND IN THE REFERENCES SHOWN HEREON; THAT THE RATIO OF PRECISION OR POSITIONAL ACCURACY AS CALCULATED IS 1:34,300; THAT THIS PLAT WAS PREPARED IN ACCORDANCE WITH G.S. 47-30 AS AMENDED. WITNESS MY ORIGINAL SIGNATURE, LICENSE NUMBER AND SEAL THIS DAY OF ,A.D., 2025.


I, MICHAEL W. ZMUDA, FURTHER CERTIFY THAT THE SURVEY CREATES A SUBDIVISION OF LAND WITHIN THE AREA OF A COUNTY OR MUNICIPALITY THAT HAS AN ORDINANCE THAT REGULATES PARCELS OF LAND.

MICHAEL W. ZMUDA, PLS #L-5205

FSP-25-11

GENERAL NOTES

- A FIELD-RUN BOUNDARY SURVEY WAS PERFORMED BY JOHNSON, MIRMIRAN & THOMPSON FROM DECEMBER 2019 THROUGH MARCH 2020.
- THE SURVEY IS REFERENCED TO THE NORTH CAROLINA STATE PLANE COORDINATE SYSTEM, NAD83(2001) BASED ON FIELD TIES TO NGS MONUMENTS "TOMS" (PID EZ2419) AND "SCARBORO" (PID EZ2420).
- ALL DISTANCES ARE HORIZONTAL GROUND.
- THE SUBJECT PROPERTY IS LOCATED IN FLOOD ZONE X AS SHOWN ON THE NATIONAL FLOOD INSURANCE RATE MAP (FIRM) FOR WAKE COUNTY, NORTH CAROLINA, PANEL 1758, MAP NO. 3720175800K, WITH AN EFFECTIVE DATE OF JULY 19, 2022.
- ROLESVILLE PROJECT NUMBER: FSP-25-11
- RELATED PROJECT NUMBERS:  
SUP 20-02: SPECIAL USE PERMIT  
ANX 21-06: ANNEXATION  
PR 21-04 REVISED: INITIAL PRELIMINARY SUBDIVISION PLAT  
CID 23-01: WALLBROOK ROADWAY IMPROVEMENTS (VIRGINIA WATER DRIVE & WALLBROOK DRIVE)  
FSP 23-09: INTERMEDIATE FINAL PLAT
- ZONING: GC-CZ (GENERAL COMMERCIAL)  
SETBACKS: FRONT 20'  
SIDE 15'  
REAR 35'  
CORNER 25'
- OWNER: FH-HOF - ROLESVILLE, LLC  
C/O WILLIAM EMIL HONAKER  
1122 OBERLIN ROAD, SUITE 218  
RALEIGH, NC 27605  
D.B. 19845 PG 1077  
PIN# 1758671871
- DEVELOPER: FH-HOF - ROLESVILLE, LLC  
C/O WILLIAM EMIL HONAKER  
1122 OBERLIN ROAD, SUITE 218  
RALEIGH, NC 27605
- ENGINEER: ARK CONSULTING GROUP, PLLC  
925-A CONFERENCE DRIVE  
GREENVILLE, NC 27858  
(252) 558-0888
- LINEAR LENGTH OF NEW PUBLIC RIGHT-OF-WAY BEING DEDICATED: N/A
- THE RIGHT OF WAY ALIGNMENT OF WALL CREEK DRIVE HAS BEEN MODIFIED FOR DESIGN PURPOSES. A SUBDIVISION PLAT ENTITLED "WALLBROOK PHASE 1 LOT 6 TOWNHOME SUBDIVISION PLAT", RECORDED IN BOOK OF MAPS 2025, PAGES 198-204, DEDICATES THE PUBLIC RIGHT OF WAY FOR WALL CREEK DRIVE ADJACENT TO LOT 8 USING THE NEW ALIGNMENT. THIS PLAT MODIFIES THE BOUNDARY OF LOT 8 TO MATCH THE DEDICATED RIGHT OF WAY LINE.

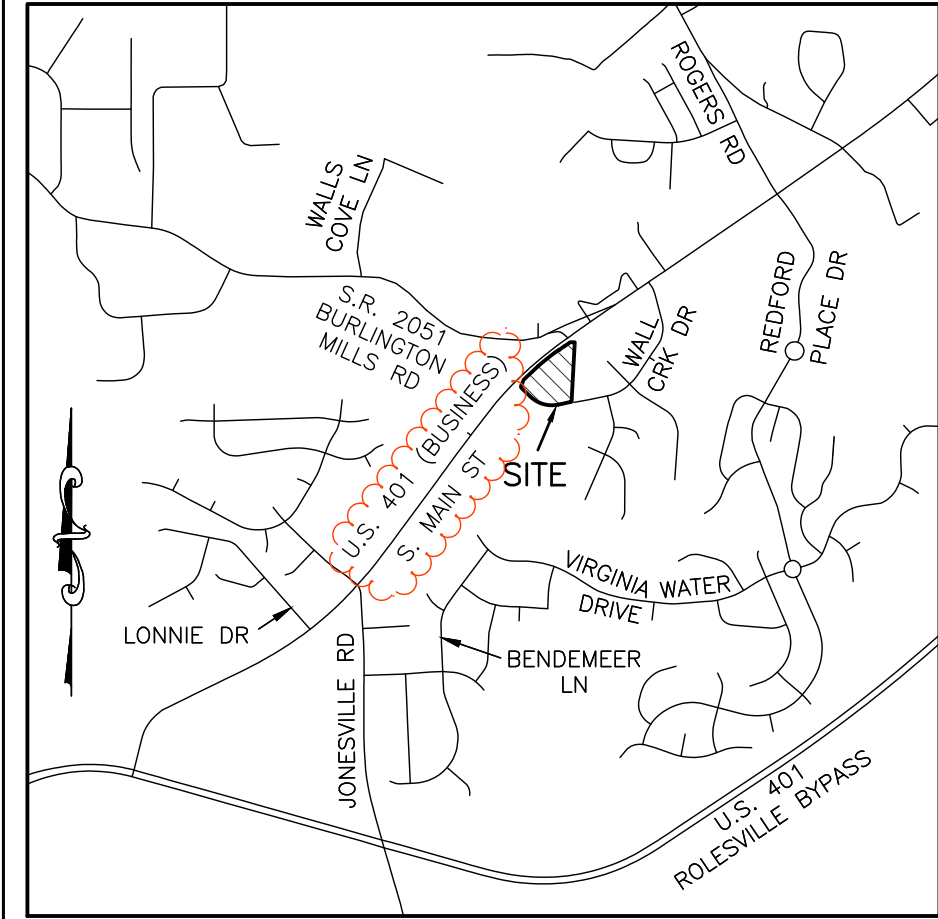

VICINITY MAP  
SCALE: 1" = ±2000'


REFERENCES

D.B. 14395 PG 2080  
D.B. 18992 PG 412  
D.B. 19845 PG 1077  
B.M. 2011 PG 383  
B.M. 2023 PG 1600-1602

AREA TABULATION


	AREA (AC.)	MAX. BUA (85%)	PLANNED USE
LOT 8A	2.9262	2.49 AC.	NON-RESIDENTIAL
LOT 8B	2.4031	2.04 AC.	NON-RESIDENTIAL




TOTAL: 5.3293 4.53 AC.  
(TOTAL AREA PRIOR TO RIGHT OF WAY ADJUSTMENT: 5.3456 AC.)

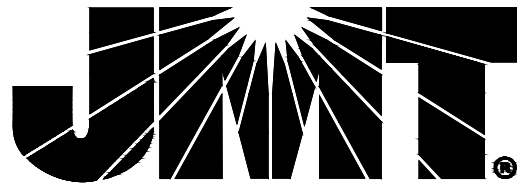

9201 ARBORETUM PARKWAY, SUITE 310 | RICHMOND, VA 23236  
N.C. License No. C-3097 | P: (804) 323-9900 | F: (804) 323-0596 | www.jmt.com

REVISION #	DATE	REASON FOR REVISION
1	4/17/2025	PER TOWN COMMENTS
FINAL SUBDIVISION PLAT <b>WALLBROOK LOT 8</b> WAKE FOREST TOWNSHIP TOWN OF ROLESVILLE, WAKE COUNTY, NORTH CAROLINA		
DRAWN BY: JSZ	PROJECT #: FSP-25-11	
CHECKED BY: MWZ	CONTRACT#:	JMT#: 19-04194-011
PLAT DATE: 02/26/2025	SCALE: 1"=50'	SHEET 1 OF 3

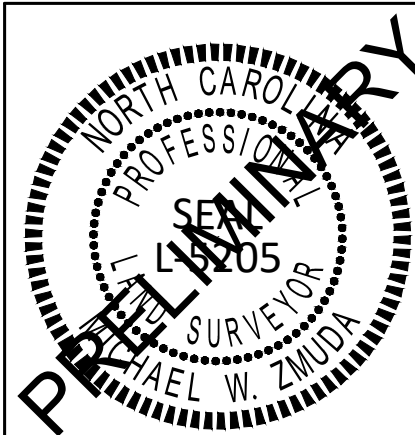


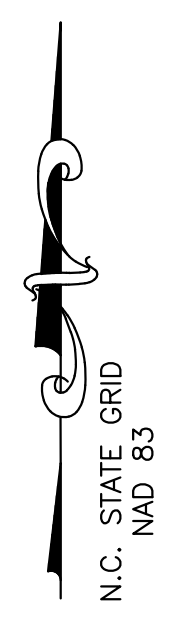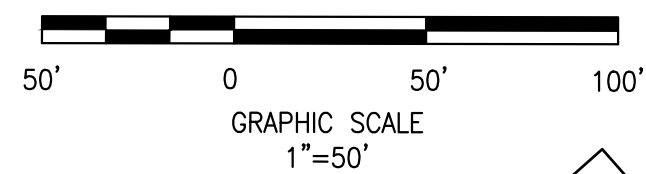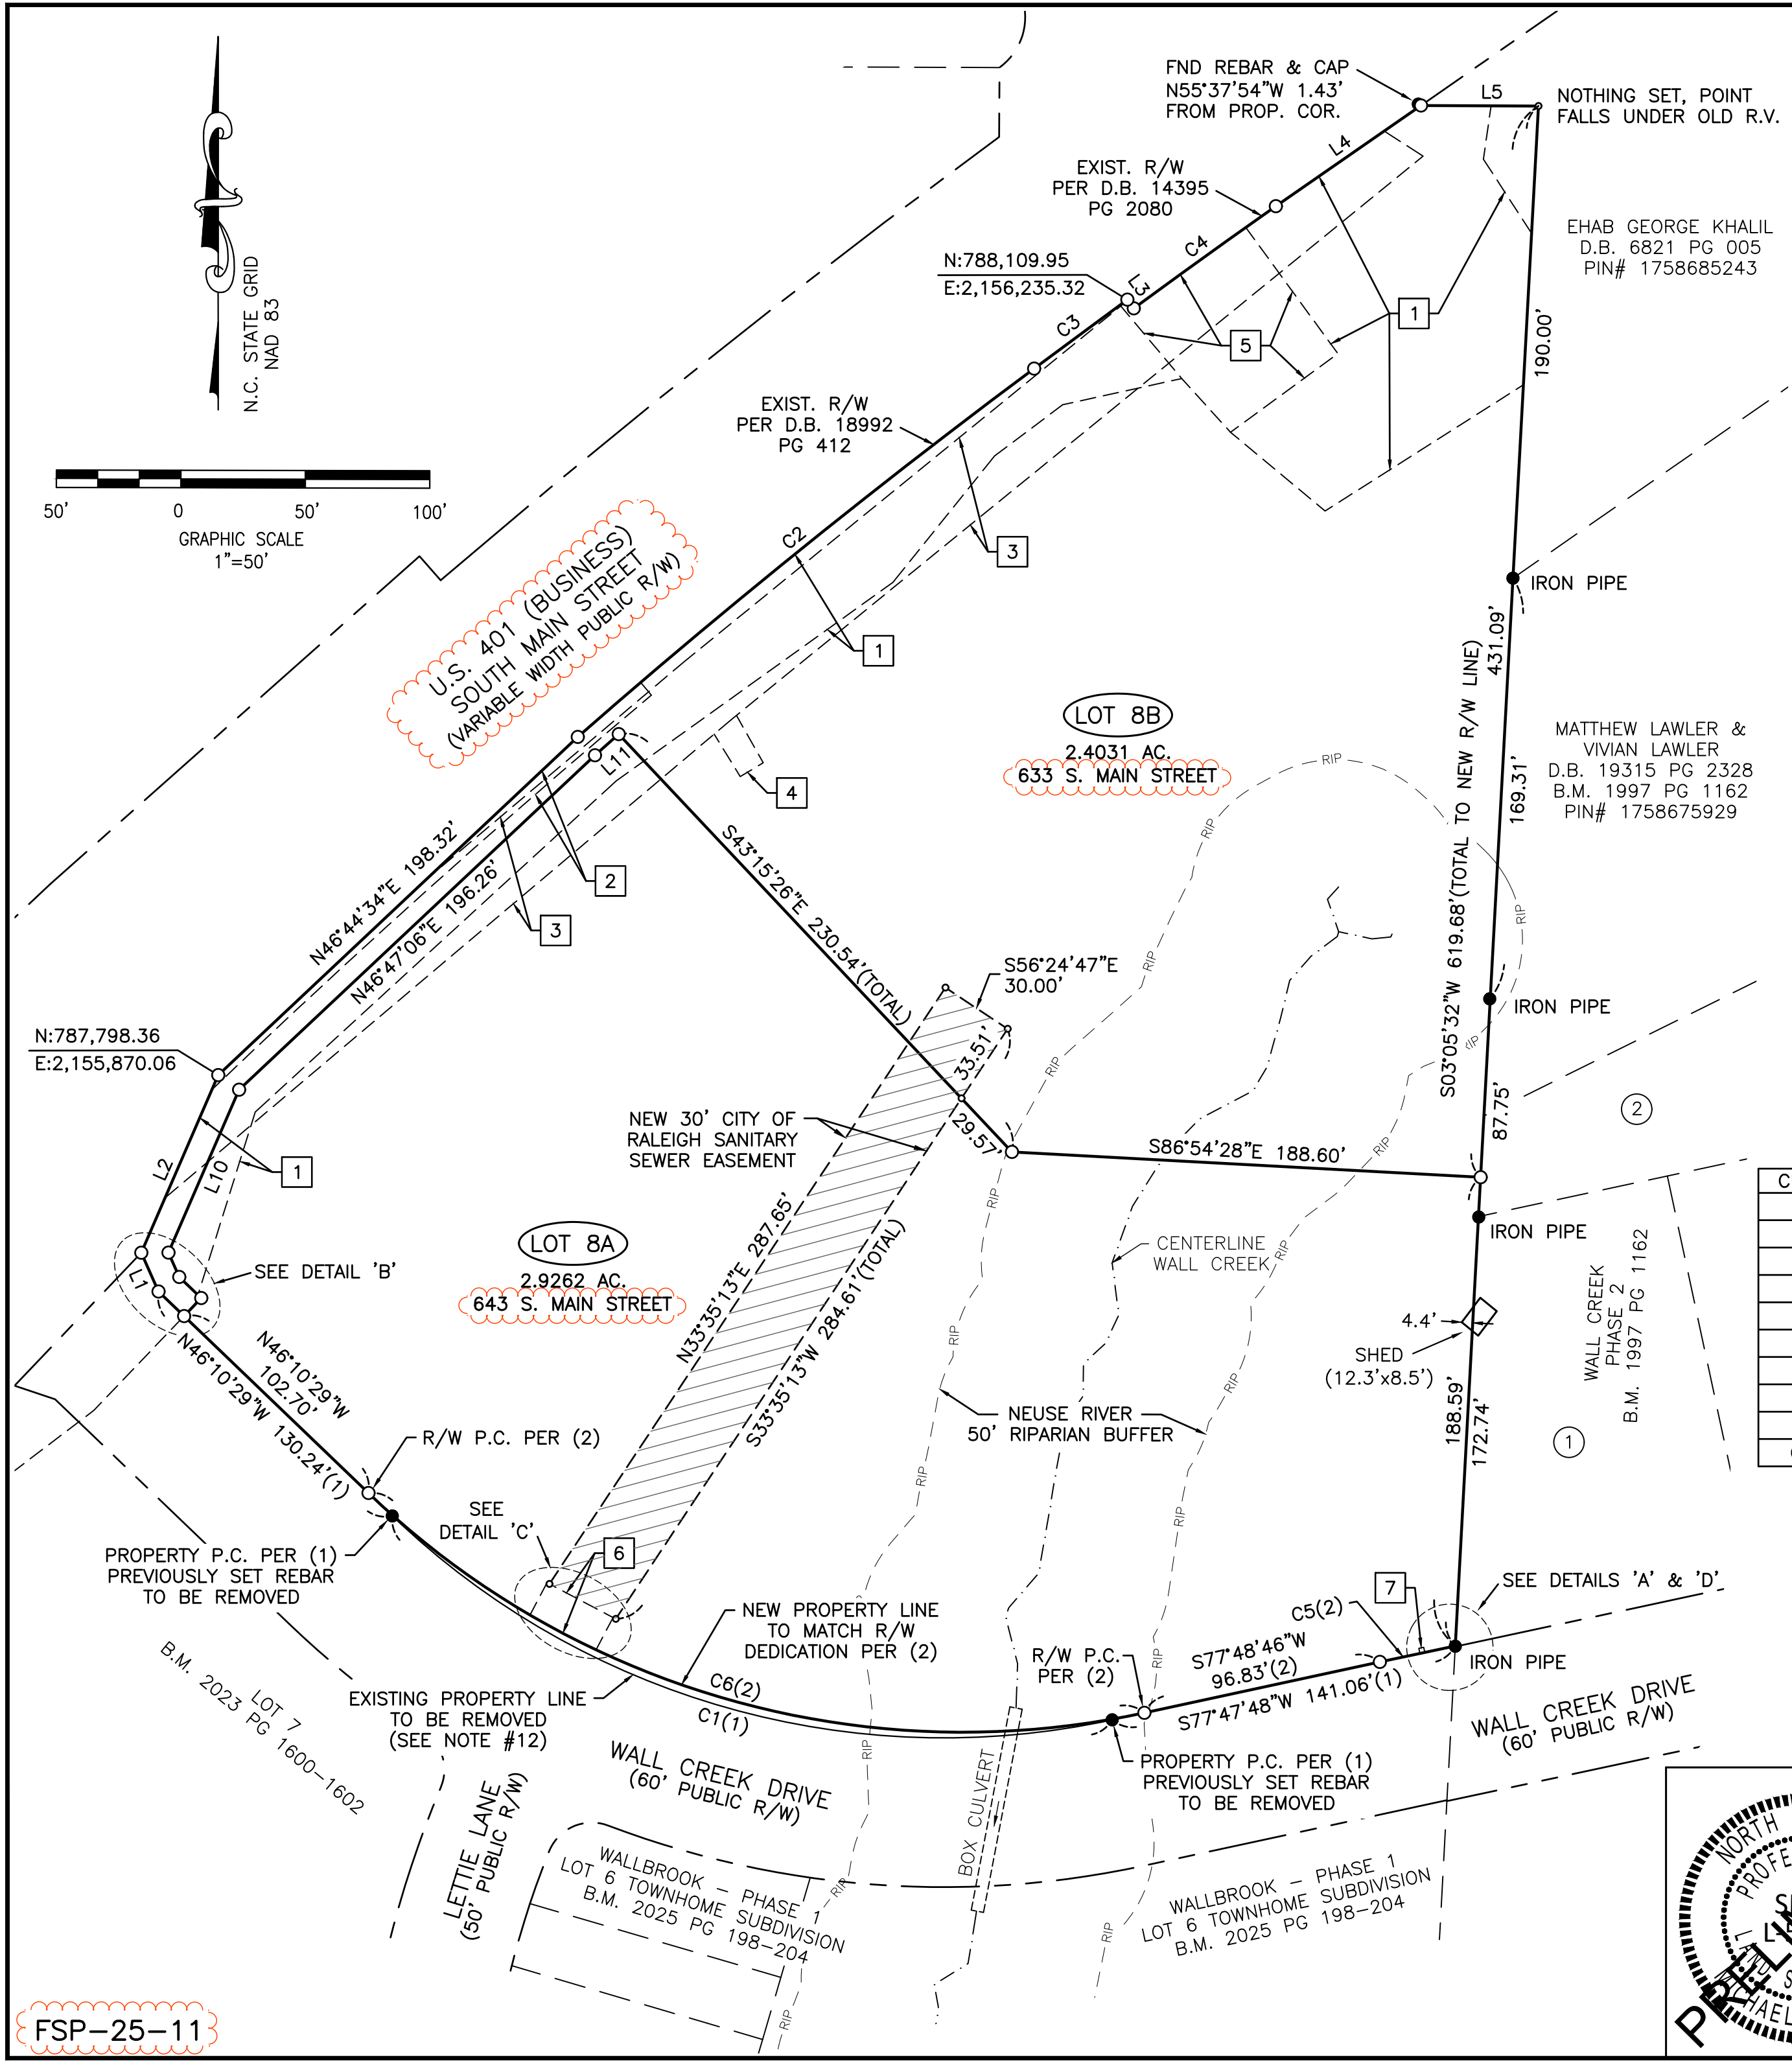

- LEGEND**
- FOUND MONUMENT AS NOTED
  - SET 5/8" IRON REBAR
  - DIMENSION POINT (NOTHING SET)
  - ① KEYNOTE – SEE PROPERTY OWNER TABLE (SHEET 3)
  - 1 KEYNOTE – SEE EXISTING EASEMENT TABLE (SHEET 3)
  - NEW CITY OF RALEIGH SANITARY SEWER EASEMENT
  - (1) RECORD DATA PER B.M. 2023 PG 1600–1602
  - (2) RECORD DATA PER B.M. 2025 PG 198–204
  - B.M. BOOK OF MAPS
  - P.C. POINT OF CURVATURE
  - R/W RIGHT OF WAY
  - SUBJECT PARCEL BOUNDARY LINE
  - - - RIGHT OF WAY LINE
  - - - ADJOINING PROPERTY LINE
  - - - EXISTING EASEMENT LINE
  - - - RIP NEUSE RIVER 50' RIPARIAN BUFFER (MEASURED FROM TOP OF BANK)


LINE	BEARING	DISTANCE
L1	N23°56'19"W	17.05'
L2	N23°25'13"E	77.77'
L3	S36°12'58"E	4.33'
L4	N55°13'38"E	70.99'
L5	S89°44'38"E	47.23'
L6	N46°10'29"W	14.24'
L7	N43°37'45"E	10.00'
L8	N46°10'29"W	12.24'
L9	N23°56'19"W	10.70'
L10	N23°25'13"E	71.32'
L11	N48°15'56"E	12.79'
L12	N27°47'49"E	14.67'
L13	N12°04'21"W	2.00'
L14	N77°55'39"E	2.00'
L15	S12°04'21"E	2.00'

CURVE	RADIUS	ARC LENGTH	CHORD LENGTH	CHORD BEARING	DELTA ANGLE
C1	320.00'	312.92'	300.60'	N74°11'20"W	56°01'43"
C2	2953.50'	235.70'	235.64'	N51°05'51"E	4°34'21"
C3	11465.50'	46.62'	46.62'	N53°30'00"E	0°13'59"
C4	3700.00'	70.31'	70.31'	N54°18'48"E	1°05'20"
C5	5030.00'	30.99'	30.99'	S77°59'21"W	0°21'11"
C6	345.00'	337.27'	324.00'	N74°10'51"W	56°00'45"
C7	5030.00'	12.53'	12.53'	S78°05'40"W	0°08'34"
C8	5030.00'	7.39'	7.39'	S77°58'51"W	0°05'03"
C9	5030.00'	2.00'	2.00'	S77°55'39"W	0°01'22"
C10	5030.00'	9.07'	9.07'	S77°51'52"W	0°06'12"

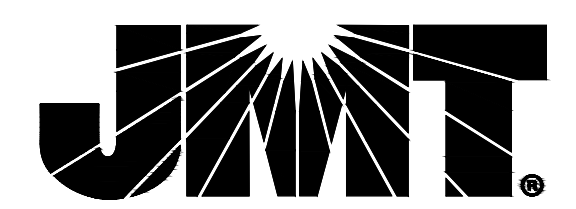





9201 ARBORETUM PARKWAY, SUITE 310 | RICHMOND, VA 23236  
N.C. License No. C-3097 | P: (804) 323-9900 | F: (804) 323-0596 | www.jmt.com

REVISION #	DATE	REASON FOR REVISION
1	4/17/2025	PER TOWN COMMENTS
<b>FINAL SUBDIVISION PLAT</b>		
<b>WALLBROOK LOT 8</b>		
<b>WAKE FOREST TOWNSHIP</b>		
<b>TOWN OF ROLESVILLE, WAKE COUNTY, NORTH CAROLINA</b>		
DRAWN BY: JSZ	PROJECT #: FSP-25-11	
CHECKED BY: MWZ	CONTRACT#:	JMT#: 19-04194-011
PLAT DATE: 02/26/2025	SCALE: 1"=50'	SHEET 2 OF 3

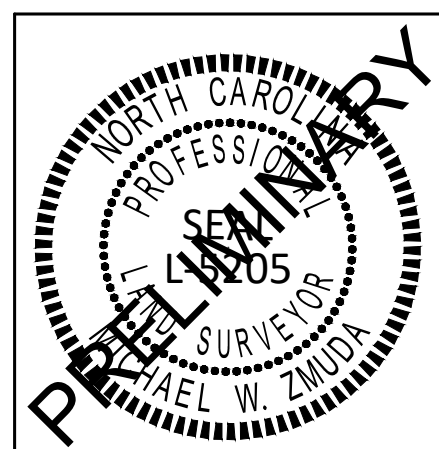

FSP-25-11



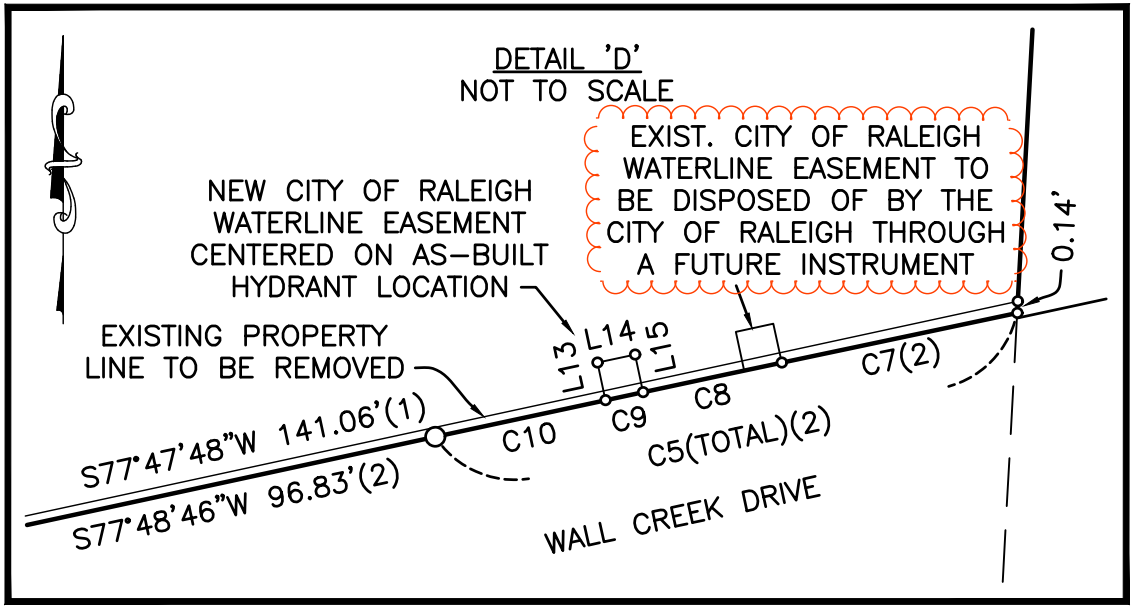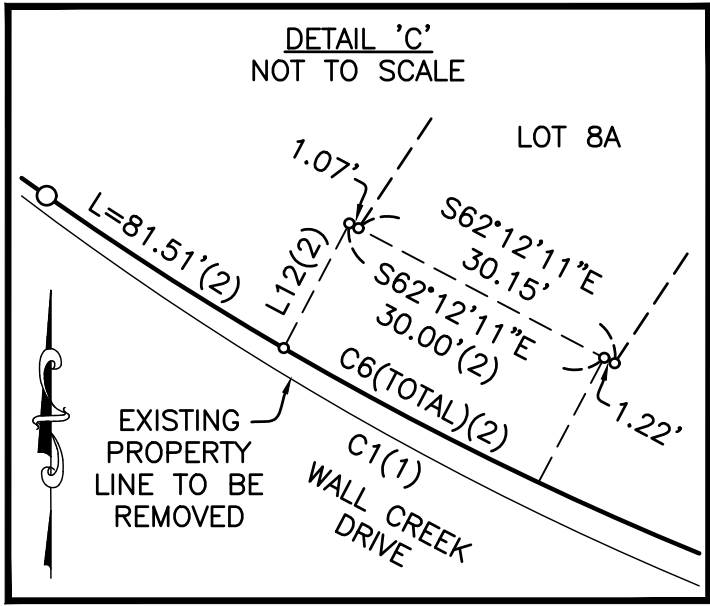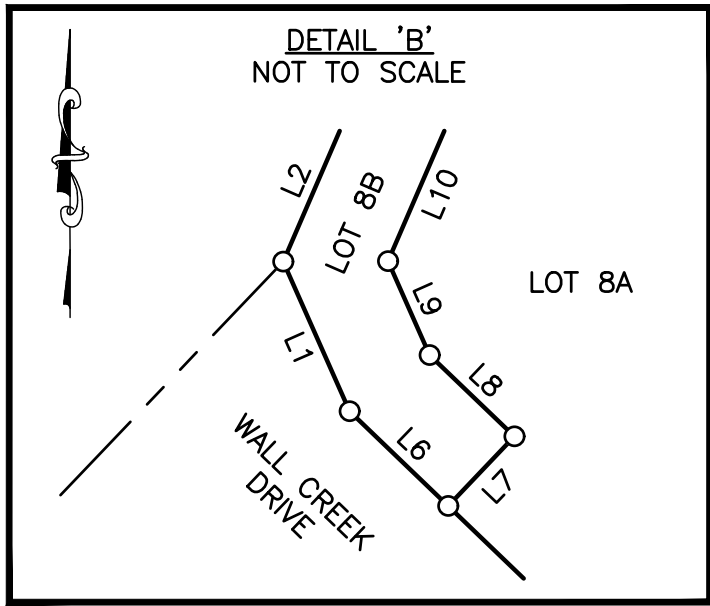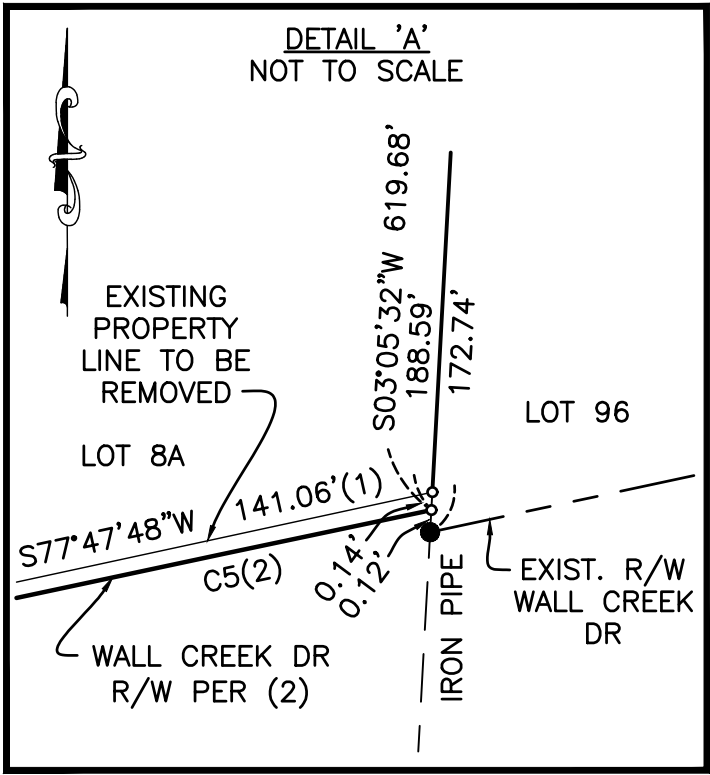


EXISTING EASEMENTS

- 1  
TEMPORARY CONSTRUCTION EASEMENT  
D.B. 18992 PG 412
- 2  
PERMANENT SLOPE EASEMENT  
D.B. 14395 PG 2087  
B.M. 2011 PG 383
- 3  
30' ELECTRIC LINE EASEMENT  
D.B. 3868 PG 917
- 4  
PERMANENT UTILITY EASEMENT  
D.B. 18992 PG 412
- 5  
PERMANENT DRAINAGE EASEMENT  
D.B. 18992 PG 412
- 6  
30' CITY OF RALEIGH  
SANITARY SEWER EASEMENT  
B.M. 2025 PG 198-204
- 7  
CITY OF RALEIGH  
WATERLINE EASEMENT  
B.M. 2025 PG 198-204  
(TO BE ABANDONED - SEE DETAIL 'D')

ADJOINING PROPERTY OWNERS

- 1  
CHARLES CULBERTSON &  
TERESA CULBERTSON  
D.B. 17393 PG 896  
B.M. 1997 PG 1162  
PIN# 1758674619
- 2  
RODERICK BLACKWELL &  
CHRISTINE BLACKWELL  
D.B. 8769 PG 1894  
B.M. 1997 PG 1162  
PIN# 1758676836

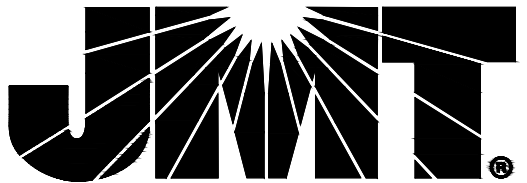

9201 ARBORETUM PARKWAY, SUITE 310 | RICHMOND, VA 23236  
N.C. License No. C-3097 | P: (804) 323-9900 | F: (804) 323-0596 | www.jmt.com

REVISION #	DATE	REASON FOR REVISION
1	4/17/2025	PER TOWN COMMENTS

FINAL SUBDIVISION PLAT  
**WALLBROOK  
LOT 8**  
WAKE FOREST TOWNSHIP  
TOWN OF ROLESVILLE, WAKE COUNTY, NORTH CAROLINA

DRAWN BY: JSZ	PROJECT #: FSP-25-11	
CHECKED BY: MWZ	CONTRACT#:	JMT#: 19-04194-011
PLAT DATE: 02/26/2025	SCALE: 1"=50'	SHEET 3 OF 3

