

# PARKER RIDGE - PHASE 2

## MAJOR SUBDIVISION FINAL PLAT

### FOR

## LENNAR CAROLINAS LLC



**VICINITY MAP**  
SCALE: 1" = 500'

#### SITE DATA TABLE

|                                           |                                                                                                                                                                               |
|-------------------------------------------|-------------------------------------------------------------------------------------------------------------------------------------------------------------------------------|
| Owner:                                    | KL LB BUY 2 LLC<br>225 Liberty Street, Suite 4210<br>New York, NY 10281                                                                                                       |
| Site Addresses:                           | 201 Redford Place Drive<br>82 School St.<br>Rolesville, NC 27571                                                                                                              |
| PIN(S):                                   | 1758988402                                                                                                                                                                    |
| Existing Zoning:                          | RM-CZ per MA-22-03                                                                                                                                                            |
| Town Application Ref.:                    | MA22-03, PSP23-02 & CID-23-06                                                                                                                                                 |
| Existing Lot Area:                        | 1,237,341 Sq. Ft. (28.405 Ac.)                                                                                                                                                |
| Single Family Lot Area:                   | 416,406 Sq. Ft. (9.559 Ac.)                                                                                                                                                   |
| R/w Dedication:                           | 147,587 Sq. Ft. (3.388 Ac.)                                                                                                                                                   |
| Homeowners Association<br>Common Lot Area | Open Space #1: 524,307 Sq. Ft. (12.036 Ac.)<br>Open Space #2: 43,973 Sq. Ft. (1.009 Ac.)<br>Open Space #3: 105,068 Sq. Ft. (2.412 Ac.)<br>Total: 673,348 Sq. Ft. (15.457 Ac.) |
| Remaining Area:                           | 0 Sq. Ft. (0 Ac.)                                                                                                                                                             |
| Total Site Area:                          | 1,237,341 Sq. Ft. (28.405 Ac.)                                                                                                                                                |
| Number of Open Space Lots:                | 3                                                                                                                                                                             |
| Number of Residential Lots:               | 78                                                                                                                                                                            |
| Impervious Area Allowed Per Lot:          | See Note #17 this sheet.                                                                                                                                                      |
| Single Family Setbacks (RM-CZ):           | Front: 20'<br>Side: 5'<br>Corner Side: 10'<br>Rear: 20'                                                                                                                       |

#### GENERAL NOTE

- The purpose of this plat is to dedicate right-of-way, easements, tree conservation areas and create new lots.
- No published horizontal survey monument found within 2,000 feet of this subject parcel(s).
- Areas calculated by coordinate geometry.
- All above ground and subsurface improvements are not necessarily shown hereon.
- All distances are horizontal ground distances.
- All bearings and coordinates are based on North Carolina State Plain Coordinate System (NAD 83, 2011 Adjustment).
- These Parcels may be subject to easements or rights of others that have not been disclosed on this plat.
- By graphic plotting only this property is located in Zone "X" (Areas determined to be outside of the 100-year flood plain), by the Federal Emergency Agency on Flood Insurance Rate Map, Community Panel No. 3720175800K and 3720176800K with an effective date of July 19, 2022, in Wake County, North Carolina. No field surveying was performed to determine this zone and an elevation certificate may be needed to verify this determination or apply for a variance from the Federal Emergency Management Agency.
- Boundary information shown hereon was prepared from an actual field survey and from existing records as referenced hereon.
- There was evidence of Wetlands and jurisdictional waters on the site. Wetland and streams shown hereon are based off preliminary jurisdictional determination completed by Soil & Environmental Consultants, PA, dated March 14, 2023.
- The subdivider shall file the approved final plat with the Register of Deeds of Wake County within sixty (60) days of the LDA of the Town of Rolesville approval; otherwise, such approval shall be null and void.
- All common area and open space lots are to be owned and maintained by the Property Owner's Association for this development.
- Declaration of Covenants, Conditions and Restrictions for Parker Ridge, has been recorded in Deed Book 19870 , Page 610, in the Wake County Register of Deeds.
- Stormwater Control Measure (SCM) Access and Maintenance Easement: The Stormwater Control Measure (SCM) Access and Maintenance Easement is/are hereby dedicated over the Stormwater Best Management Practice (BMP) facility. The SCM Access and Maintenance Easement is/are considered to be private, with the sole responsibility of the Owner to provide for all required maintenance and operations as approved by the Town Manager until completed and accepted by the Town. Upon Town acceptance of the as-built drawings operations and maintenance of the SCM shall be the responsibility of the Parker Ridge Home Owners Association.
- Stormwater Control Measures to be maintained by Parker Ridge Owners Association, Inc. per stormwater Agreement recorded in DB \_\_\_\_\_, PG \_\_\_\_\_, in the Wake County Register of Deeds.
- Easements for storm drainage shown on the plat are not made to Wake County but are irrevocably made to the subsequent owners of any and all of the properties shown hereon for their use and benefit public acceptance. It shall be the responsibility of the property owners to maintain the drainage easements and any drainage structures therein, so as to maintain the integrity of the drainage system and ensure positive drainage. Easements may not be piped without receiving plan approval from Wake County.
- The maximum impervious surface allowed (MISA) is 2,500 square feet for detached single family lots.

**OWNER:**  
KL LB BUY 2 LLC  
225 Liberty Street, Suite 4210  
New York, NY 10281  
Contact: Justin Potter  
Phone: (480) 447-9591

**DEVELOPER:**  
Lennar Carolinas, LLC  
5505 Waterford District Drive  
Miami, FL 33126  
Contact: John Nabers  
Phone: (919) 820-9707  
E-mail: John.Nabers@lennar.com

**APPLICANT/SURVEYOR:**  
Advanced Civil Design, Inc.  
51 Kilmoynne Drive, Suite 102  
Cary, NC 27511  
Contact: Cameron Rice  
Phone: (919) 481-6290  
E-mail: crice@advancedcivildesign.com

**REFERENCES:**  
D.B. 19559, Pg. 290  
B.M. 2001, Pg. 2437  
B.M. 2025, Pg. XXX  
B.M. 2025, Pg. XXX

#### CERTIFICATE OF SURVEY AND ACCURACY:

I, James D. Whitacre, a surveyor licensed under the provisions of Chapter 89C of the North Carolina General Statutes, do hereby certify that this plat was drawn under my supervision from an actual survey made under my supervision, (deed description recorded in Book 19368, Page 1816); that the boundaries not surveyed are shown as broken lines plotted from deeds cited herein; that the ratio of precision or positional accuracy as calculated is 1/10,000; that this plat was prepared in accordance with G.S. 47-30 as amended. I further certify that this plat creates a subdivision of land within the area of a county or municipality that has an ordinance that regulates parcels of land.

Witness my original signature, license number and seal this \_\_\_\_ day of \_\_\_\_  
\_\_\_\_\_, A.D., 2025.

Professional Surveyor L-5273

#### CERTIFICATE OF APPROVAL FOR RECORDING

I hereby certify that the subdivision plat shown hereon has been found to comply with the Subdivision Regulations of the Town of Rolesville, North Carolina and that this plat has been approved by the LDA of the Town of Rolesville for recording in the Office of the Register of Deeds of Wake County.

Date \_\_\_\_\_

Land Development Administrator, Town of Rolesville  
Rolesville, North Carolina

#### CERTIFICATE OF APPROVAL FOR RECORDING

I, \_\_\_\_\_, Review Officer of the Town of Rolesville, Wake County, certify that the map or plat to which this certification is affixed meets all statutory requirements for recording.

Review Officer \_\_\_\_\_ Date \_\_\_\_\_

#### CERTIFICATE OF SURVEY AND ACCURACY (GNSS):

I, James D. Whitacre, certify that this map was drawn under my supervision from an actual GNSS survey made under my supervision and the following information was used to perform the survey.

Class of survey: A  
Positional accuracy: 0.033 meters H  
Type of GNSS field procedure: Real Time Kinematic - NC Network  
Date(s) of survey: March 5, 2024  
Datum/Epoch: NAD 83 (NSRS 2011)  
Published/fixed control: NC Real Time Network  
Geoid model: Geoid 18  
Combined grid factor: 0.99990581  
Units: US Survey Feet

#### SUBDIVISION STREET DISCLOSURE STATEMENT

All public streets shall be dedicated to the Town of Rolesville, the State of North Carolina or the public as determined appropriate by the Board of Commissioners of the Town of Rolesville. All streets shown on the final plat shall be designated in accordance with G.S. § 136-102.6 and designation as public shall be conclusively presumed an offer of dedication to the public.

| Street Table       |           |           |        |
|--------------------|-----------|-----------|--------|
| Street Name        | Length    | R/W Width | Type   |
| Long Melford Drive | 1,549 Ft. | 60 Ft.    | Public |
| Zanning Drive      | 181 Ft.   | 65 Ft.    | Public |
| Quarry Pond Court  | 786 Ft.   | 50 Ft.    | Public |

| CURVE TABLE |            |         |         |               |
|-------------|------------|---------|---------|---------------|
| NO.         | DELTA      | RADIUS  | LENGTH  | CHORD BEARING |
| C1          | 058°05'29" | 300.00' | 304.17' | N74°43'20"W   |
| C2          | 014°45'19" | 300.00' | 77.26'  | S38°18'02"E   |
| C3          | 050°25'55" | 335.00' | 294.87' | N78°31'3"W    |
| C4          | 081°22'54" | 11.50'  | 16.33'  | N84°32'11"E   |
| C5          | 082°46'54" | 16.50'  | 23.84'  | S03°25'37"W   |
| C7          | 005°38'39" | 330.00' | 32.51'  | N35°08'17"W   |
| C8          | 001°23'37" | 330.00' | 8.03'   | N31°37'10"W   |
| C9          | 089°59'58" | 16.50'  | 25.92'  | N75°45'23"W   |
| C11         | 039°39'16" | 29.82'  | 20.64'  | S36°01'42"W   |
| C12         | 032°21'48" | 45.00'  | 25.42'  | N32°16'30"E   |
| C13         | 057°14'24" | 45.00'  | 44.96'  | N77°04'36"E   |
| C14         | 063°22'18" | 45.00'  | 49.77'  | S42°37'04"E   |
| C15         | 113°03'09" | 45.00'  | 88.79'  | S45°35'40"W   |
| C17         | 042°53'37" | 29.50'  | 22.08'  | N80°31'26"E   |
| C18         | 089°59'53" | 16.50'  | 25.92'  | N14°04'34"E   |
| C19         | 057°17'01" | 270.00' | 269.94' | N59°33'52"W   |
| C20         | 011°02'02" | 270.00' | 52.00'  | S86°16'36"W   |
| C21         | 004°31'46" | 270.00' | 21.34'  | S78°29'43"W   |
| C22         | 005°54'44" | 335.00' | 34.57'  | N72°33'49"W   |

| CURVE TABLE |            |         |        |               |
|-------------|------------|---------|--------|---------------|
| NO.         | DELTA      | RADIUS  | LENGTH | CHORD BEARING |
| C23         | 014°46'45" | 335.00' | 86.41' | N62°13'04"W   |
| C24         | 001°29'27" | 335.00' | 77.05' | S38°18'02"E   |
| C25         | 062°32'17" | 50.65'  | 55.29' | S20°31'48"W   |
| C27         | 007°35'51" | 45.00'  | 5.97'  | S78°06'08"E   |
| C31         | 043°46'17" | 64.90'  | 49.58' | N22°35'58"W   |
| C32         | 043°46'17" | 74.90'  | 57.22' | N22°35'58"W   |
| C33         | 003°30'59" | 270.00' | 16.57' | N32°40'52"W   |
| C35         | 006°41'53" | 360.00' | 42.08' | N72°57'23"W   |
| C36         | 094°34'49" | 50.00'  | 82.54' | N39°21'16"E   |
| C37         | 039°47'10" | 50.00'  | 34.72' | N06°02'26"E   |
| C38         | 029°38'10" | 50.00'  | 25.86' | N02°22'42"W   |
| C39         | 041°59'16" | 50.00'  | 36.64' | N40°02'14"W   |
| C40         | 038°10'29" | 75.00'  | 49.97' | S14°06'42"W   |
| C41         | 014°14'22" | 270.00' | 67.10' | N41°33'32"W   |
| C42         | 005°44'05" | 270.00' | 27.02' | N51°32'46"W   |
| C43         | 007°47'52" | 270.00' | 36.75' | N58°18'44"W   |
| C44         | 009°28'02" | 270.00' | 44.61' | N66°56'41"W   |
| C45         | 016°31'40" | 270.00' | 77.89' | N79°56'33"W   |
| C46         | 079°19'25" | 60.00'  | 83.07' | N42°29'20"E   |

| CURVE TABLE |            |        |         |               |
|-------------|------------|--------|---------|---------------|
| NO.         | DELTA      | RADIUS | LENGTH  | CHORD BEARING |
| C47         | 079°19'25" | 40.00' | 55.38'  | N42°29'20"E   |
| C48         | 045°54'41" | 60.00' | 48.08'  | S06°53'20"W   |
| C49         | 045°54'41" | 40.00' | 32.05'  | S06°53'20"W   |
| C50         | 033°35'39" | 40.00' | 23.45'  | S46°38'30"W   |
| C51         | 033°35'39" | 60.00' | 35.18'  | S46°38'30"W   |
| C52         | 058°14'48" | 40.02' | 40.68'  | S55°41'59"E   |
| C53         | 055°49'21" | 20.01' | 19.50'  | S54°29'34"E   |
| C54         | 046°48'25" | 9.69'  | 7.92'   | N55°41'10"W   |
| C55         | 052°43'05" | 29.68' | 27.31'  | N57°42'48"W   |
| C56         | 048°39'30" | 65.00' | 55.20'  | S19°21'12"W   |
| C57         | 048°39'30" | 45.00' | 38.22'  | S19°21'12"W   |
| C58         | 088°10'04" | 65.00' | 100.02' | N00°24'04"W   |
| C59         | 088°10'04" | 45.00' | 69.25'  | N00°24'04"W   |
| C60         | 040°01'12" | 40.00' | 27.94'  | S07°47'25"E   |
| C61         | 053°10'48" | 60.00' | 55.69'  | N22°48'25"E   |
| C62         | 053°10'48" | 40.00' | 37.13'  | N22°48'25"E   |

| LINE TABLE |          |             |
|------------|----------|-------------|
| LINE       | DISTANCE | BEARING     |
| L1         | 9.77'    | N58°08'06"E |
| L2         | 71.59'   | S78°49'39"W |
| L3         | 21.95'   | N68°36'34"W |
| L4         | 24.35'   | S73°46'43"W |
| L5         | 20.30'   | S42°57'56"W |
| L6         | 18.00'   | S11°26'08"E |
| L7         | 46.33'   | N11°46'24"E |
| L8         | 22.51'   | N08°47'28"E |
| L9         | 32.00'   | S59°04'38"W |
| L10        | 41.00'   | S59°04'38"W |
| L11        | 42.20'   | N72°47'03"E |
| L17        | 24.10'   | N28°41'30"W |
| L18        | 23.20'   | S33°10'50"E |
| L19        | 17.63'   | S70°56'31"W |
| L20        | 50.46'   | S82°18'06"W |
| L24        | 22.29'   | N80°29'06"W |
| L25        | 15.00'   | N45°38'11"W |
| L26        | 10.00'   | N44°21'49"E |
| L27        | 15.00'   | S45°38'11"E |
| L32        | 15.00'   | S59°04'38"E |
| L33        | 10.00'   | S30°55'22"E |
| L34        | 15.00'   | S59°04'38"W |
| L35        | 12.11'   | N61°05'17"W |
| L37        | 2.00'    | S32°13'45"E |
| L47        | 18.21'   | N18°13'49"W |

| LINE TABLE |          |             |
|------------|----------|-------------|
| LINE       | DISTANCE | BEARING     |
| L48        | 57.32'   | N30°55'22"W |
| L49        | 2.00'    | S59°04'38"W |
| L50        | 57.32'   | N30°55'22"W |
| L51        | 2.00'    | S59°04'38"E |
| L52        | 32.59'   | S66°30'41"E |
| L53        | 28.61'   | N68°05'24"W |
| L54        | 21.47'   | N09°36'43"W |
| L55        | 50.40'   | S35°50'59"W |
| L56        | 30.00'   | N31°04'45"W |
| L57        | 10.00'   | S30°55'22"E |
| L58        | 24.21'   | S48°09'25"E |
| L59        | 10.47'   | S59°04'38"W |
| L60        | 13.74'   | S48°09'25"E |
| L61        | 48.05'   | N87°23'12"E |
| L62        | 10.00'   | S02°36'48"E |
| L63        | 45.13'   | S75°59'25"W |
| L64        | 19.30'   | N14°00'35"W |
| L65        | 10.00'   | N89°17'11"E |
| L66        | 24.89'   | S44°29'06"E |
| L67        | 24.89'   | N44°29'06"W |
| L68        | 10.00'   | S45°30'54"W |
| L69        | 12.00'   | N59°04'38"E |
| L70        | 12.00'   | N58°33'32"E |
| L71        | 46.87'   | S59°33'03"W |
| L72        | 46.80'   | S59°33'03"W |

| LINE TABLE |          |             |
|------------|----------|-------------|
| LINE       | DISTANCE | BEARING     |
| L73        | 33.00'   | S85°05'23"E |
| L74        | 5.00'    | N87°34'21"W |
| L75        | 42.22'   | N02°25'39"E |
| L76        | 87.93'   | N29°58'23"W |
| L77        | 114.21'  | S58°42'57"W |
| L78        | 53.88'   | N03°59'54"E |
| L79        | 35.82'   | N36°31'51"W |
| L80        | 6.00'    | S53°28'09"W |
| L81        | 43.87'   | N36°31'51"W |
| L82        | 114.19'  | S58°42'57"W |
| L83        | 66.65'   | N02°47'49"W |
| L84        | 66.42'   | N30°55'22"W |
| L85        | 48.67'   | N02°25'39"E |
| L86        | 39.59'   | N89°01'31"W |
| L87        | 98.58'   | S81°32'11"W |
| L88        | 62.18'   | N31°04'45"W |
| L90        | 79.92'   | S59°23'13"W |
| L91        | 87.25'   | S59°23'13"W |
| L92        | 196.62'  | S58°35'04"W |
| L93        | 198.42'  | S58°35'04"W |
| L94        | 37.47'   | N81°32'11"E |
| L95        | 52.11'   | N33°39'15"E |
| L96        | 66.60'   | S49°31'23"W |
| L97        | 66.47'   | S49°31'23"W |
| L98        | 61.01'   | S57°07'23"W |

| LINE TABLE |          |             |
|------------|----------|-------------|
| LINE       | DISTANCE | BEARING     |
| L124       | 6.21'    | N14°22'37"E |
| L125       | 10.00'   | S75°37'23"E |
| L126       | 6.22'    | S14°22'37"W |
| L127       | 24.35'   | S73°46'43"W |
| L128       | 23.73'   | S04°35'13"W |
| L129       | 34.35'   | S59°05'18"W |
| L130       | 5.00'    | S30°54'42"E |
| L131       | 29.13'   | S59°05'18"W |
| L132       | 14.84'   | S04°35'13"W |
| L133       | 72.32'   | S30°55'22"E |
| L134       | 5.96'    | S59°04'38"W |
| L136       | 30.51'   | S73°46'43"W |
| L137       | 25.67'   | N68°36'34"W |
| L138       | 26.16'   | N68°36'34"W |
| L139       | 72.33'   | S78°49'39"W |
| L140       | 60.26'   | S78°49'39"W |
| L142       | 108.21'  | N06°04'32"W |
| L143       | 46.68'   | S54°17'20"E |
| L144       | 20.30'   | S42°57'56"W |
| L145       | 22.88'   | S42°57'56"W |
| L146       | 82.37'   | S44°53'23"W |
| L147       | 82.20'   | S44°53'23"W |
| L148       | 10.00'   | N45°06'37"W |
| L149       | 20.60'   | S12°40'01"E |
| L150       | 17.74'   | S66°59'28"W |

| Lot Addressing |                         |     |           |                         |     |              |                         |     |
|----------------|-------------------------|-----|-----------|-------------------------|-----|--------------|-------------------------|-----|
| Lot # 198      | 900 Long Melford Drive  | SFD | Lot # 228 | 1033 Long Melford Drive | SFD | Lot # 256    | 177 Quarry Pond Court   | SFD |
| Lot # 199      | 904 Long Melford Drive  | SFD | Lot # 229 | 1037 Long Melford Drive | SFD | Lot # 257    | 173 Quarry Pond Court   | SFD |
| Lot # 200      | 908 Long Melford Drive  | SFD | Lot # 230 | 1041 Long Melford Drive | SFD | Lot # 258    | 169 Quarry Pond Court   | SFD |
| Lot # 201      | 912 Long Melford Drive  | SFD | Lot # 231 | 1045 Long Melford Drive | SFD | Lot # 259    | 165 Quarry Pond Court   | SFD |
| Lot # 202      | 916 Long Melford Drive  | SFD | Lot # 232 | 1049 Long Melford Drive | SFD | Lot # 260    | 161 Quarry Pond Court   | SFD |
| Lot # 203      | 920 Long Melford Drive  | SFD | Lot # 233 | 1053 Long Melford Drive | SFD | Lot # 261    | 157 Quarry Pond Court   | SFD |
| Lot # 204      | 924 Long Melford Drive  | SFD | Lot # 234 | 1057 Long Melford Drive | SFD | Lot # 262    | 153 Quarry Pond Court   | SFD |
| Lot # 205      | 1004 Long Melford Drive | SFD | Lot # 235 | 1061 Long Melford Drive | SFD | Lot # 263    | 149 Quarry Pond Court   | SFD |
| Lot # 206      | 1008 Long Melford Drive | SFD | Lot # 236 | 1065 Long Melford Drive | SFD | Lot # 264    | 145 Quarry Pond Court   | SFD |
| Lot # 207      | 1012 Long Melford Drive | SFD | Lot # 237 | 1069 Long Melford Drive | SFD | Lot # 265    | 141 Quarry Pond Court   | SFD |
| Lot # 208      | 1016 Long Melford Drive | SFD | Lot # 238 | 1073 Long Melford Drive | SFD | Lot # 266    | 137 Quarry Pond Court   | SFD |
| Lot # 209      | 1020 Long Melford Drive | SFD | Lot # 239 | 100 Quarry Pond Court   | SFD | Lot # 267    | 133 Quarry Pond Court   | SFD |
| Lot # 210      | 1024 Long Melford Drive | SFD | Lot # 240 | 104 Quarry Pond Court   | SFD | Lot # 268    | 129 Quarry Pond Court   | SFD |
| Lot # 211      | 1028 Long Melford Drive | SFD | Lot # 241 | 108 Quarry Pond Court   | SFD | Lot # 269    | 125 Quarry Pond Court   | SFD |
| Lot # 212      | 1032 Long Melford Drive | SFD | Lot # 242 | 112 Quarry Pond Court   | SFD | Lot # 270    | 121 Quarry Pond Court   | SFD |
| Lot # 213      | 1040 Long Melford Drive | SFD | Lot # 243 | 116 Quarry Pond Court   | SFD | Lot # 271    | 117 Quarry Pond Court   | SFD |
| Lot # 214      | 1044 Long Melford Drive | SFD | Lot # 244 | 120 Quarry Pond Court   | SFD | Lot # 272    | 113 Quarry Pond Court   | SFD |
| Lot # 215      | 1048 Long Melford Drive | SFD | Lot # 245 | 124 Quarry Pond Court   | SFD | Lot # 273    | 109 Quarry Pond Court   | SFD |
| Lot # 216      | 1052 Long Melford Drive | SFD | Lot # 246 | 128 Quarry Pond Court   | SFD | Lot # 274    | 105 Quarry Pond Court   | SFD |
| Lot # 217      | 1056 Long Melford Drive | SFD | Lot # 247 | 132 Quarry Pond Court   | SFD | Lot # 275    | 101 Quarry Pond Court   | SFD |
| Lot # 218      | 1060 Long Melford Drive | SFD | Lot # 248 | 136 Quarry Pond Court   | SFD | Open Space 1 | 176 Quarry Pond Court   | OS  |
| Lot # 219      | 1064 Long Melford Drive | SFD | Lot # 249 | 140 Quarry Pond Court   | SFD | Open Space 2 | 1081 Long Melford Drive | OS  |
| Lot # 220      | 1001 Long Melford Drive | SFD | Lot # 250 | 144 Quarry Pond Court   | SFD | Open Space 3 | 913 Long Melford Drive  | OS  |
| Lot # 221      | 1005 Long Melford Drive | SFD | Lot # 251 | 148 Quarry Pond Court   | SFD |              |                         |     |
| Lot # 222      | 1009 Long Melford Drive | SFD | Lot # 252 | 152 Quarry Pond Court   | SFD |              |                         |     |
| Lot # 223      | 1013 Long Melford Drive | SFD | Lot # 253 | 156 Quarry Pond Court   | SFD |              |                         |     |
| Lot # 224      | 1017 Long Melford Drive | SFD | Lot # 254 | 160 Quarry Pond Court   | SFD |              |                         |     |
| Lot # 225      | 1021 Long Melford Drive | SFD | Lot # 255 | 164 Quarry Pond Court   | SFD |              |                         |     |
| Lot # 226      | 1025 Long Melford Drive | SFD |           |                         |     |              |                         |     |
| Lot # 227      | 1029 Long Melford Drive | SFD |           |                         |     |              |                         |     |

N/F  
CEDAR LAKES HOMEOWNERS  
ASSOCIATION, INC.  
DB 16748 PG 219  
BM 2016 PG 1977  
PIN# 175807663  
ZONING: RM-CZ

N/F  
CEDAR LAKES HOMEOWNERS  
ASSOCIATION, INC.  
DB 16748 PG 219  
BM 2016 PG 1977  
PIN# 175807663  
ZONING: RM-CZ



N/F  
CEDAR LAKES HOMEOWNERS  
ASSOCIATION, INC.  
DB 17611 PG 1888  
BM 2019 PG 1539  
PIN# 176808705  
ZONING: RM-CZ

N/F  
CEDAR LAKES HOMEOWNERS  
ASSOCIATION, INC.  
DB 17611 PG 1888  
BM 2019 PG 1539  
PIN# 176808705  
ZONING: RM-CZ

- NOTE:
1. Refer to Sheet 1 of this multi-page plat for notes, restrictions, and other requirements pertaining to this plat.
  2. See Sheet 1 for line and curve tables.
  3. All common area and open space lots are to be owned and maintained by the Property Owner's Association for this development.

LEGEND

- |        |                            |   |                                                      |
|--------|----------------------------|---|------------------------------------------------------|
| ●      | Iron Pin Found             | — | Property Boundary                                    |
| ○      | Iron Pipe Found            | — | Proposed Right-of-Way                                |
| ○      | Iron Pin Set               | — | Ex Right-of-Way                                      |
| ⊗      | PK Nail Set                | — | Proposed Property Line                               |
| ⊕      | Monument Found             | — | Adj. Property Line                                   |
| △      | Calculated Point           | — | Old Property Line                                    |
| N/F    | Now or Formerly            | — | Removed by this Plat                                 |
| DB/PG  | Deed Book / Page           | — | Property Line or R/W Not Surveyed                    |
| BM/PG  | Book of Maps / Page        | — | Ex. Utility Easement Line                            |
| HOA    | Homeowners Association     | — | Ex. Stream Centerline                                |
| R/W    | Right-of-Way               | — | 50' Neuse River Buffer                               |
| SCM    | Stormwater Control Measure | — | Proposed Easement                                    |
| SF     | Square Feet                | — | Landscape Buffer                                     |
| AC     | Acre                       | — | Building Setback                                     |
| Var.   | Variable                   | — | Zoning Line                                          |
| 0000   | Lot Address                | — | Tree Conservation Area                               |
| C.O.R. | City of Raleigh            | — | Jurisdictional Wetlands per S&EC/USACE dated 3/14/23 |
|        |                            | — | Private SCM Access and Maintenance Easement          |

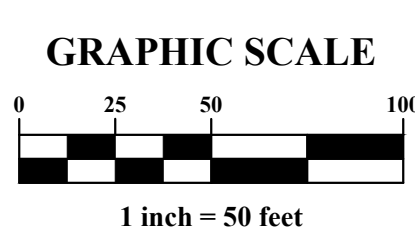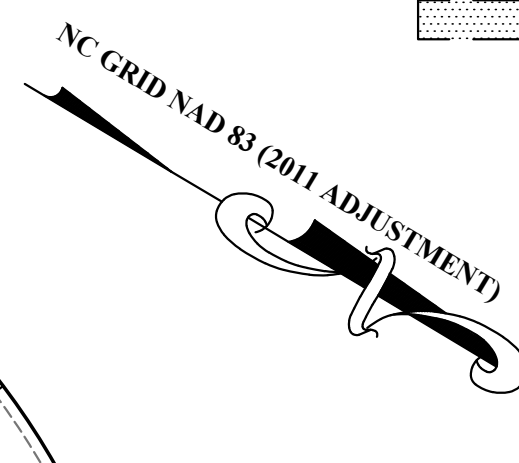

CONTROL CORNER  
N: 789336.5707  
E: 2159729.8521

OPEN SPACE #3  
1.65 AC CC

Parker Ridge - Phase 2  
Major Subdivision Final Plat  
for  
Lennar Carolinas, LLC

TOWN OF ROLESVILLE WAKE COUNTY NORTH CAROLINA

PLAN PREPARED BY:

ADVANCED  
CIVIL DESIGN  
ENGINEERS SURVEYORS

DRAWN BY: CMR

CHECKED BY: JDW

SCALE: 1" = 50'

V1 DATE: 07/01/25

V2 DATE: 09/02/25


V3 DATE:

V4 DATE:

SHEET 2 / 3

0:\22-0008-1149\NC\DWG\Production Drawings\Survey\Final Plots\0008-1149fp.ph2.dwg 2 Sep 02, 2025 - 4:37:22pm crice

SEE SHEET 3

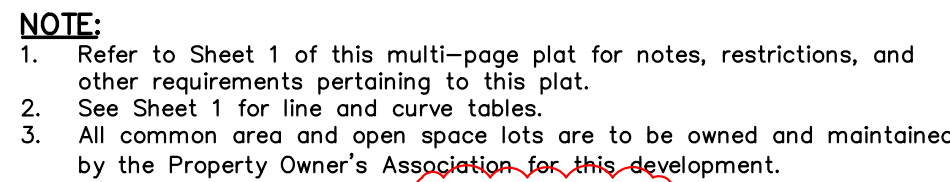

**Parker Ridge - Phase 2  
Major Subdivision Final Plat  
for  
Lennar Carolinas, LLC**

TOWN OF ROLESVILLE      WAKE COUNTY      NORTH CAROLINA



51 Kilmayne Drive  
Suite 102  
Cary, North Carolina 27511  
**ph 919.481.6290**  
fax 919.336.5127  
Firm License # C-2798

DRAWN BY: CMR

CHECKED BY: JDW

SCALE: 1" = 50'

---

V1 DATE: 07/01

V2 DATE: 09/02


SHEET 3 / 3

V3 DATE: .

|        |                               |  |                                                         |
|--------|-------------------------------|--|---------------------------------------------------------|
| ●      | Iron Pin Found                |  | Property Boundary                                       |
| ○      | Iron Pipe Found               |  | Proposed Right-of-Way                                   |
| ○      | Iron Pin                      |  | Ex Right-of-Way                                         |
|        | PK Nail Set                   |  | Proposed Property Line                                  |
|        | Monument Found                |  | Adj. Property Line                                      |
|        | Calculated Point              |  | Old Property Line<br>Removed by this Plat               |
| N/F    | Now or Formerly               |  | Property Line or R/W Not<br>Surveyed                    |
| DB/PG  | Deed Book / Page              |  | Ex. Utility Easement Line                               |
| BM/PG  | Book of Maps / Page           |  | Ex. Stream Centerline                                   |
| HOA    | Homeowners Association        |  | 50' Neuse River Buffer                                  |
| R/W    | Right-of-Way                  |  | Proposed Easement                                       |
| SCM    | Stormwater Control<br>Measure |  | Landscape Buffer                                        |
| SF     | Square Feet                   |  | Building Setback                                        |
| Ac.    | Acre                          |  | Zoning Line                                             |
| VAR    | Variable                      |  |                                                         |
|        | Lot Address                   |  | Tree Conservation Area                                  |
| C.O.R. | City of Raleigh               |  | Jurisdictional Wetlands per<br>S&EC/USACE dated 3/31/23 |
|        |                               |  | Private SCM Access and<br>Maintenance Easement          |



### GRAPHIC SCALE

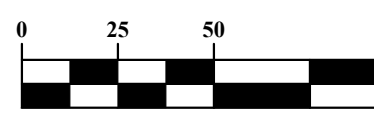

**1 inch = 50 feet**