

Drawings & Specifications, as instruments of service are & shall remain the property of the Architect. They are not to be used on other projects without the written permission of the Architect. Reproduction of these drawings in whole or in part, without the written & written appropriate compensation to the Architect.

Contractor is responsible for confirming and correlating dimensions given on these drawings with those given on the plans, means, methods, techniques, sequences or procedures, or of any other documents or programs in connection with the project.

©Copyright 2023

CLIENT NAME
CROSSLAND SOUTHEAST
801 EAST BLVD.
CHARLOTTE, NC 28203

TENANT
7-ELEVEN
3200 HACKBERRY RD, IRVING, TX 75063

STRUCTURAL CONSULTANT
JUSTIN BILLODEAU, P.E.
2301 BENTON MEADOWS BLVD, SUITE 230
AUSTIN, TX 78745
CONTACT: JUSTIN BILLODEAU, P.E.

PROTO:9350-CST-2022-01

7-ELEVEN 9350 CST
US 401 BUSINESS / S. MAIN STREET &
VIRGINIA WATER DRIVE
ROLESVILLE, NC



02/13/2024

Engineer Name: ROBERT B. PINKERTON

Engineer Number: 34942

THE SEAL & SIGNATURE APPLIED TO THIS DOCUMENT
INDICATE THE DRAWINGS ARE EXCLUSIVELY FOR
THE USE OF THE CONTRACTOR AND NOT FOR
INSTRUMENTS RELATED TO OR INTENDED TO BE USED FOR
ANY PART OR PURPOSE OTHER THAN THAT STATED
HEREIN.

REVISIONS


NO. DATE DESCRIPTION


Drawing Size: 30 x 42 Project #: 22050
Drawn By: ADF Checked By: ADF

Title: SITE PHOTOMETRICS

Sheet Number: E0.2

Date: 02/13/2024 Store #: 42337

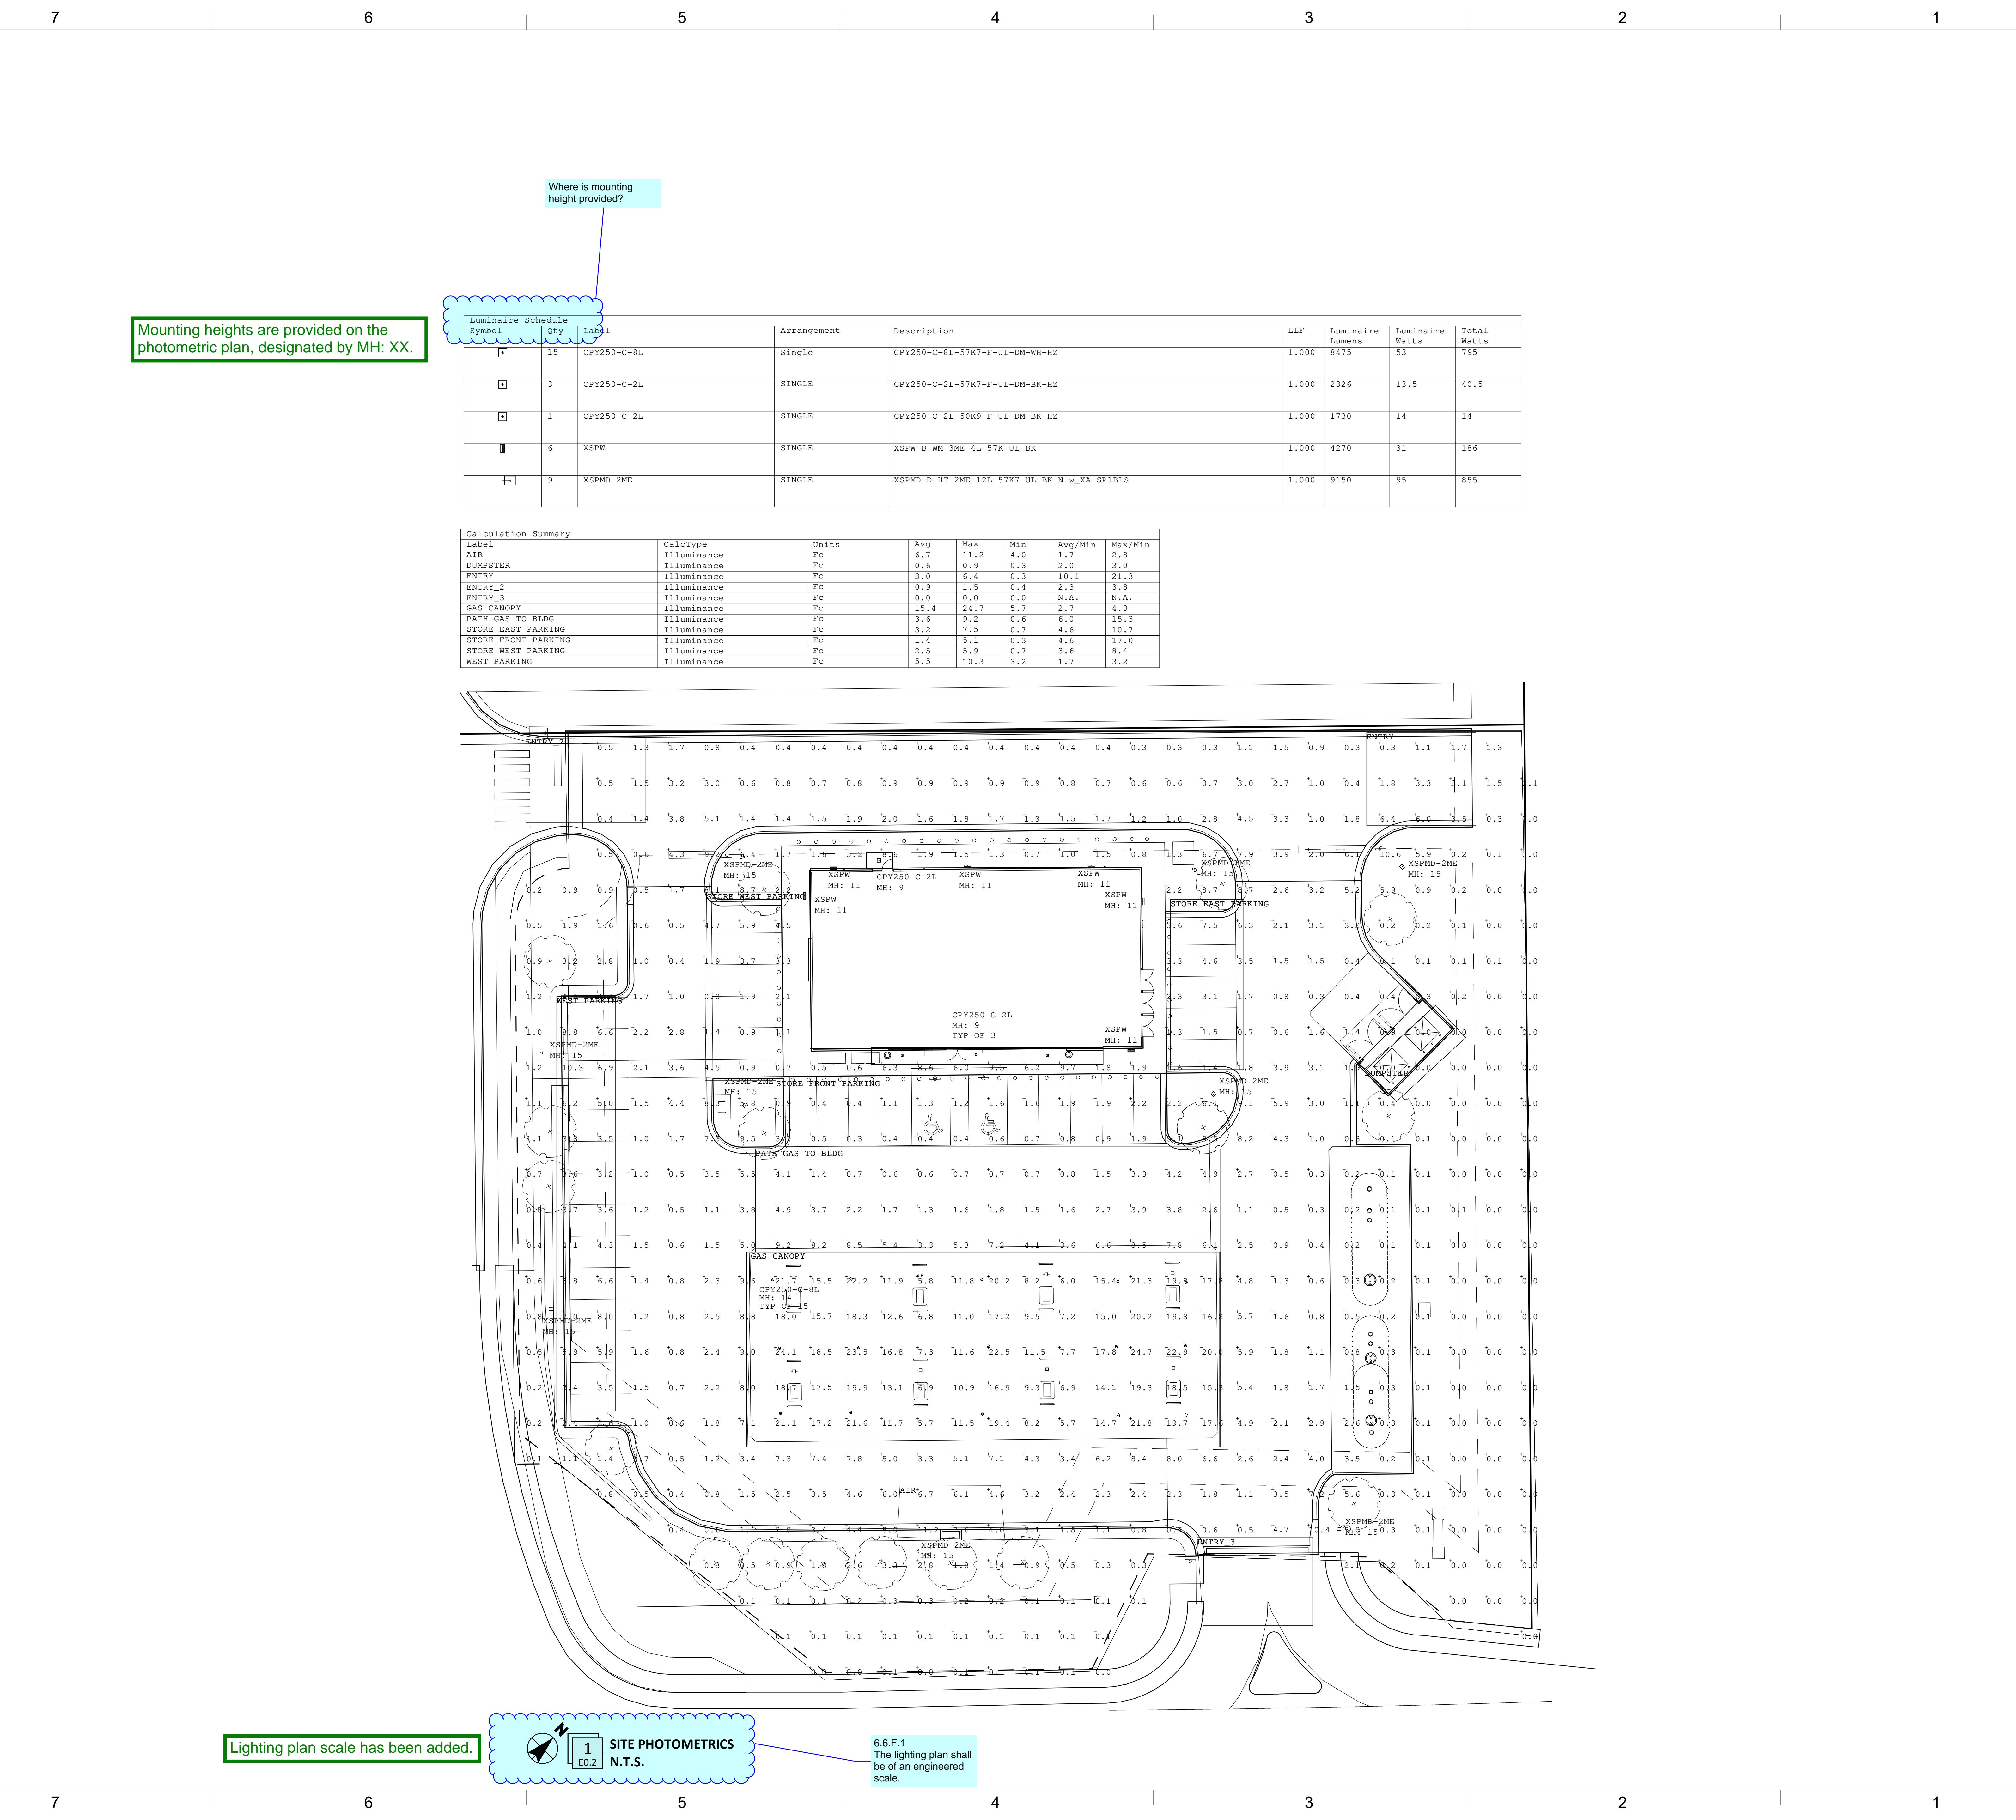

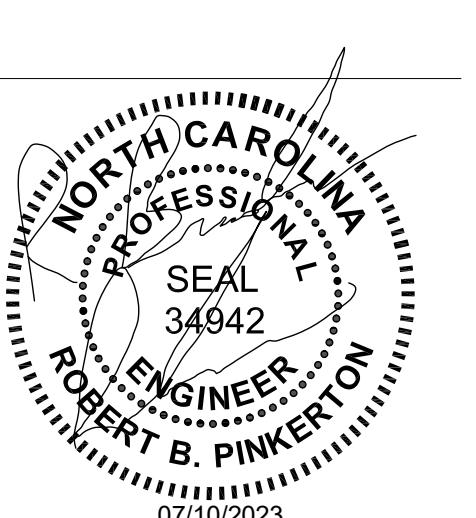

XSP Series

XSPMD LED Street/Area Luminaire - Medium

Product Description

Designed from the ground up as a totally optimized LED street and area lighting system, the XSP Series delivers incredible efficiency without sacrificing application performance. Beyond substantial energy savings, the XSP Series offers a host of other benefits including a longer life, lower maintenance costs, and a more efficient Precision Delivery Grid™ optic when compared to traditional cob head luminaires. The XSP Series is the better alternative for traditional street and area lighting with quick payback and improved performance.

Applications: Collector roads, major roads, parking lots, and general area spaces

Performance Summary

NanoOptic® Precision Delivery Grid™ optic

Assembled in the USA from Cree Lighting and imported parts

Initial Delivered Lumen: 11,875

Efficacy: Up to 125 LPW

CRI: Minimum 70 CRI

CCT: 3000K, 4000K, 5000K, 7000K

Limited Warranty: 10 years on luminaire; 10 years on Colorfast DeltaGuard® finish; up to 5 years for Sympox® accessories; 1 year on luminaire accessories

*For more information on warranty terms, refer to Sympox accessories, consult Sympox spec sheets for details on warranty terms.

Accessories

Backplate Cover Shield Bird Spikes XSP-BR04M Shutter Cap XA-HSLHRT

Al-Mg-Ti mounting base mounting cuff Nut & lock base connector

Aluminum mounting base for luminaire

Operating Temperature Range: -40°C - +40°C (-40°F - +104°F)

Weight: 14.2 lbs. (6.4kg)



Ordering Information
Example: XSPMD-D-11875-120-3007-UL-59-74

Rev. Date: V9 02/20/2023

XSPMD LED Street/Area Luminaire - Medium

Product Description

CONSTRUCTION & MATERIALS
• Die cast aluminum housing
• Tool-less assembly
• Meets UL 125° F (D2) IP: 144 (42mm) O.D. or (51mm) IP: 2,375 (diameter) O.D. horizontal lens (minimum 100mm in length) and is adjustable. 5° to 10° for fixture leveling. Includes two sets of lead-in leveling.

• Luminaire secures with two 410 stainless steel mounting bolts, optional foot base.

• Exclusive Colorfast DeltaGuard® finish features an E-Coat epoxy primer with an ultra-durable black, bronze or silver powder topcoat, providing excellent protection against corrosion and fading.

• Comes standard with Utility Label per ANSI C136.15-2020 and 7-pin NEMA 14-50P power receptacle per ANSI C136.4-41

• Weight: 14.2 lbs. (6.4kg)

ELECTRICAL SYSTEM

• Input Voltage: 120-277V, 50/60Hz

• Power Factor: >0.9 at full load

• Total Harmonic Distortion: <2% at full load

• Input IEC62040-2 Surge suppression protection standard: 20kV/10ka

• When code dictates fusing, a slow blow type C/D breaker should be used.

• Includes 200mA surge protection and 100mA lightning protection.

• Includes 100mA surge protection and 100mA lightning protection.

• Standard On-Ground Fault Protection (OGF) and Ground Fault Interruption (GFI).

• Meets FCC Part 15, Subpart B, Class A limits for conducted and radiated emissions.

• Luminaire and finish endurance tested to withstand 5,000 hours of elevated ambient salt fog conditions as defined in ASTM Standard B 117.

• Assembled by Cree Lighting and imported parts.

• Meets UL 1547, UL 1547-2015, UL 1547-2020, UL 1547-2021.

• Meets FCC Part 15, Subpart B, Class A limits for conducted and radiated emissions.

• Includes 100mA surge protection and 100mA lightning protection.

• Includes 100mA surge protection and 100mA lightning protection.

