



PUBLIC
WATER DISTRIBUTION / EXTENSION SYSTEM
THE CITY OF RALEIGH CONSENTS TO THE CONNECTION AND EXTENSION OF THE CITY'S PUBLIC WATER SYSTEM AS SHOWN ON THIS PLAN. THE MATERIAL AND CONSTRUCTION METHODS USED FOR THIS PROJECT SHALL CONFORM TO THE STANDARDS AND SPECIFICATIONS OF THE CITY'S PUBLIC UTILITIES HANDBOOK.
CITY OF RALEIGH
PUBLIC UTILITIES DEPARTMENT PERMIT # _____

PUBLIC
SEWER COLLECTION / EXTENSION SYSTEM
THE CITY OF RALEIGH CONSENTS TO THE CONNECTION AND EXTENSION OF THE CITY'S PUBLIC SEWER SYSTEM AS SHOWN ON THIS PLAN. THE MATERIAL AND CONSTRUCTION METHODS USED FOR THIS PROJECT SHALL CONFORM TO THE STANDARDS AND SPECIFICATIONS OF THE CITY'S PUBLIC UTILITIES HANDBOOK.
CITY OF RALEIGH
PUBLIC UTILITIES DEPARTMENT PERMIT # _____


4

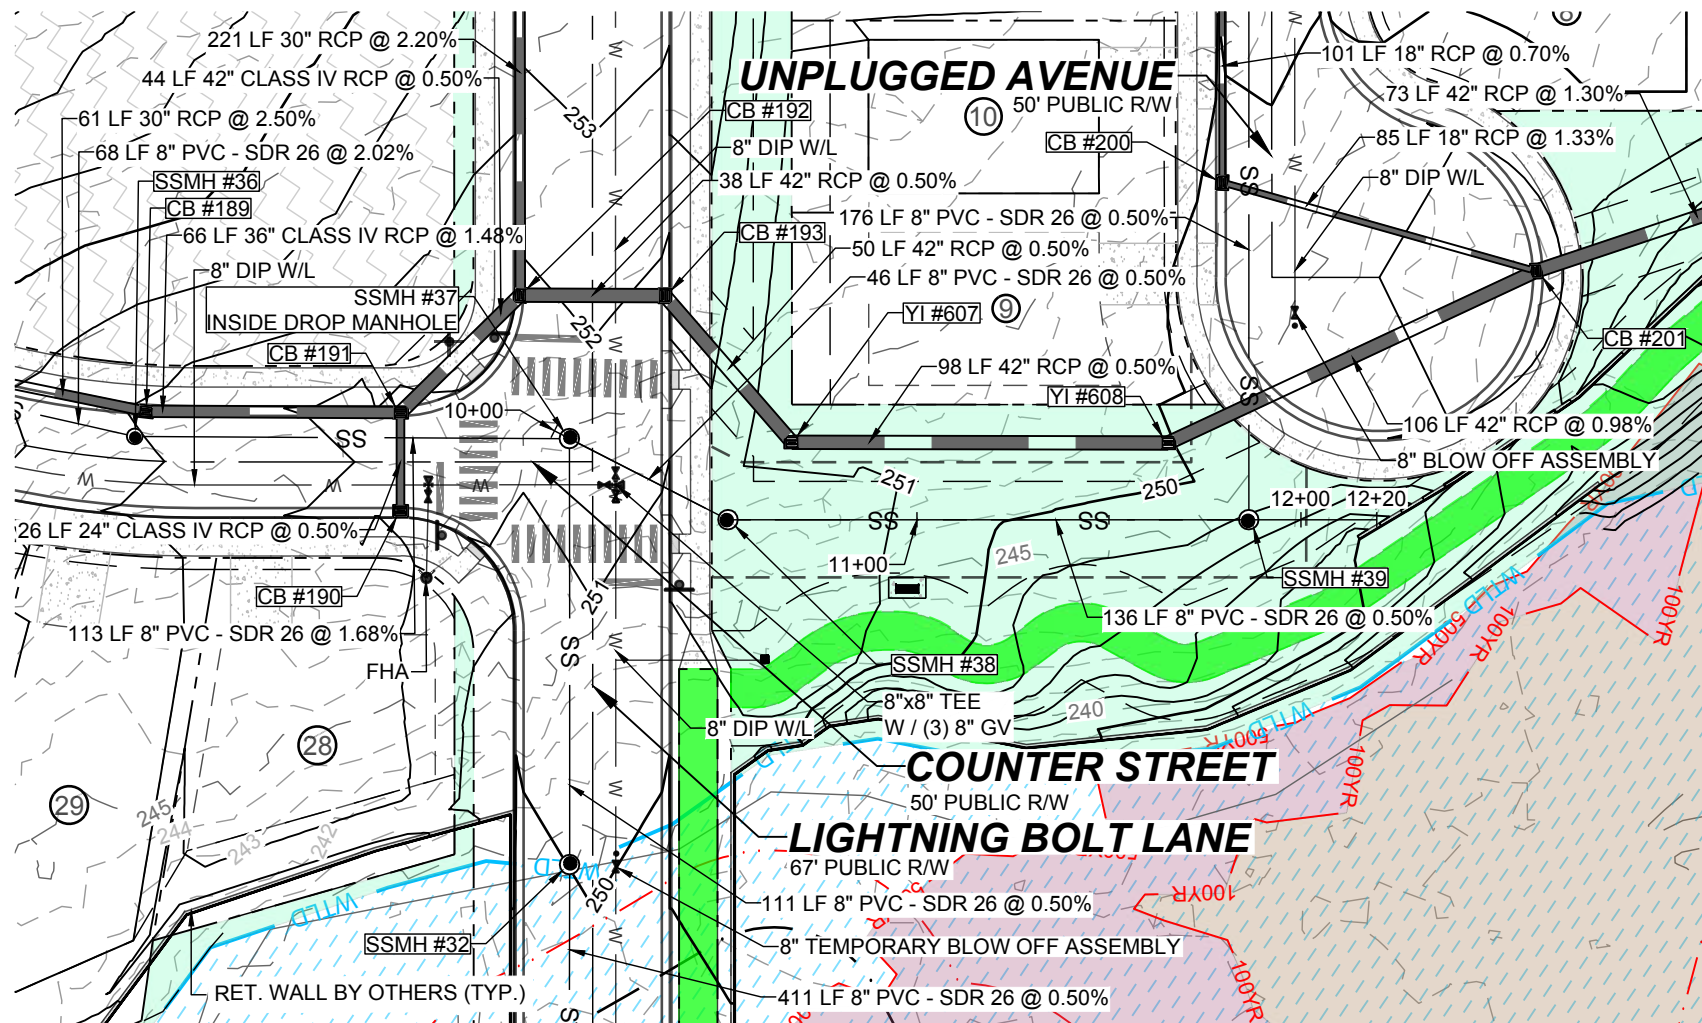


PROPOSED SSMH #37 - SSMH #39 - PLAN
HORIZONTAL: 1" = 50'

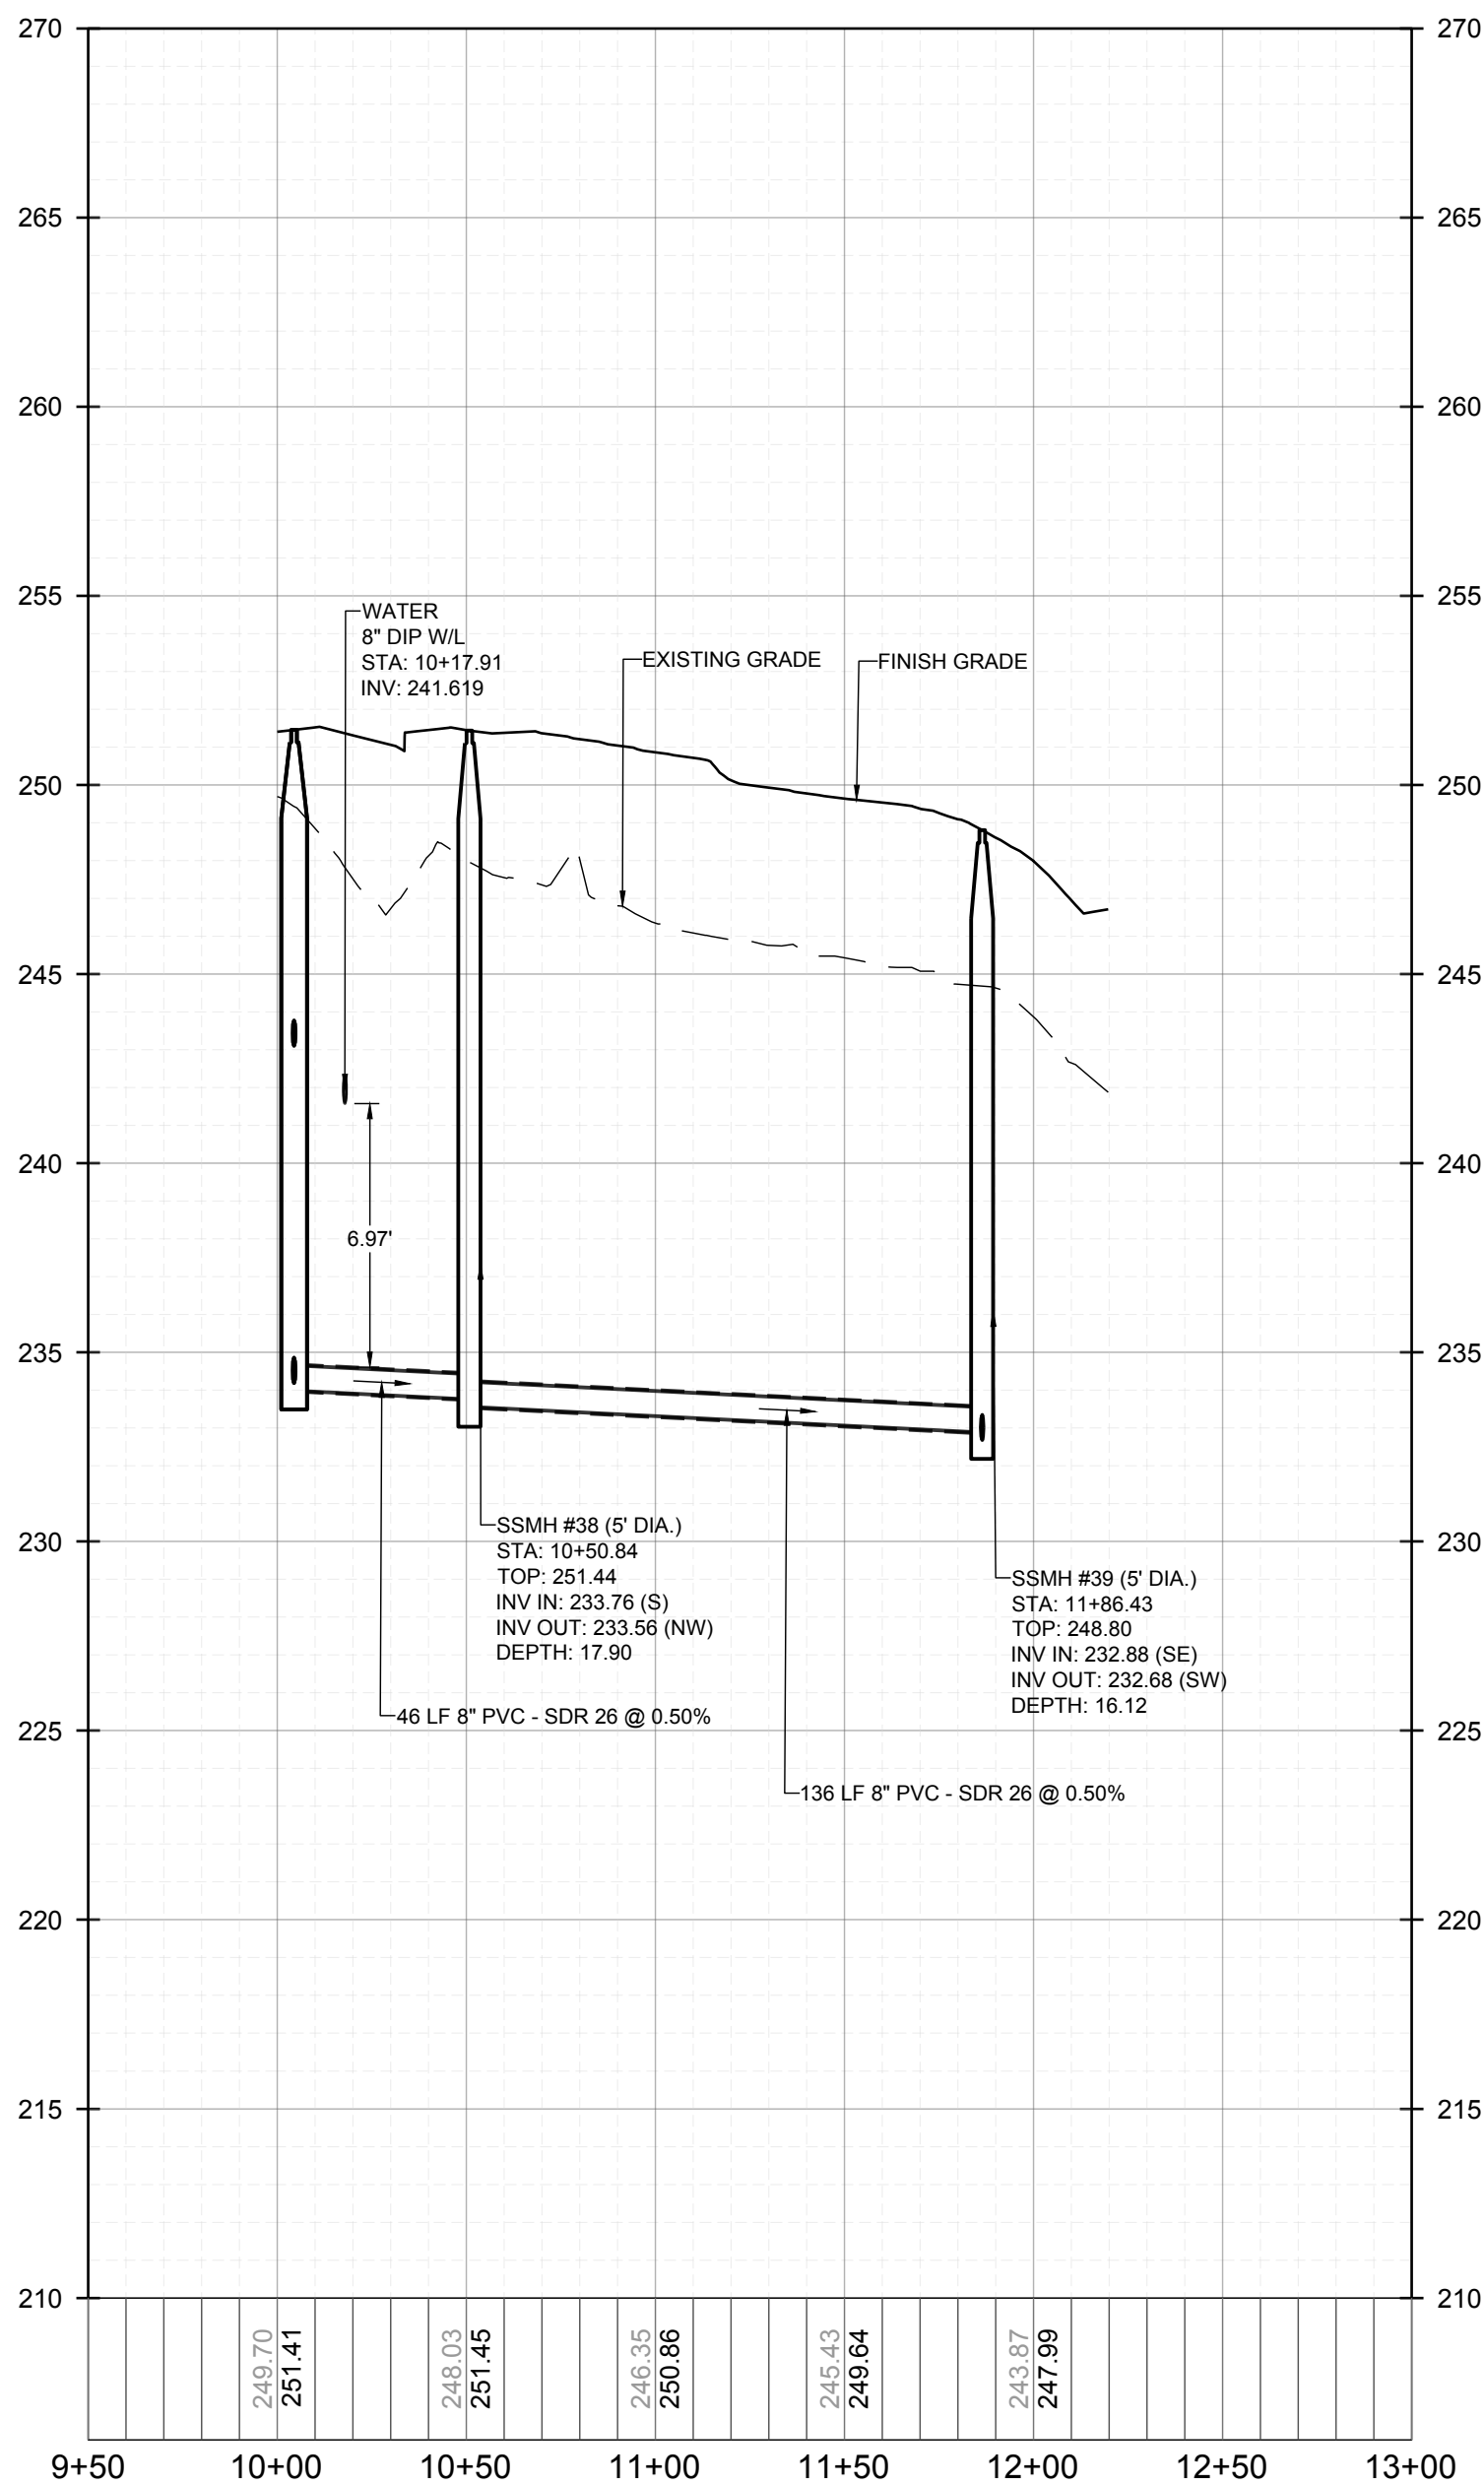



PROPOSED SSMH #37 - SSMH #39 - PROFILE
VERTICAL: 1" = 5'
HORIZONTAL: 1" = 50'

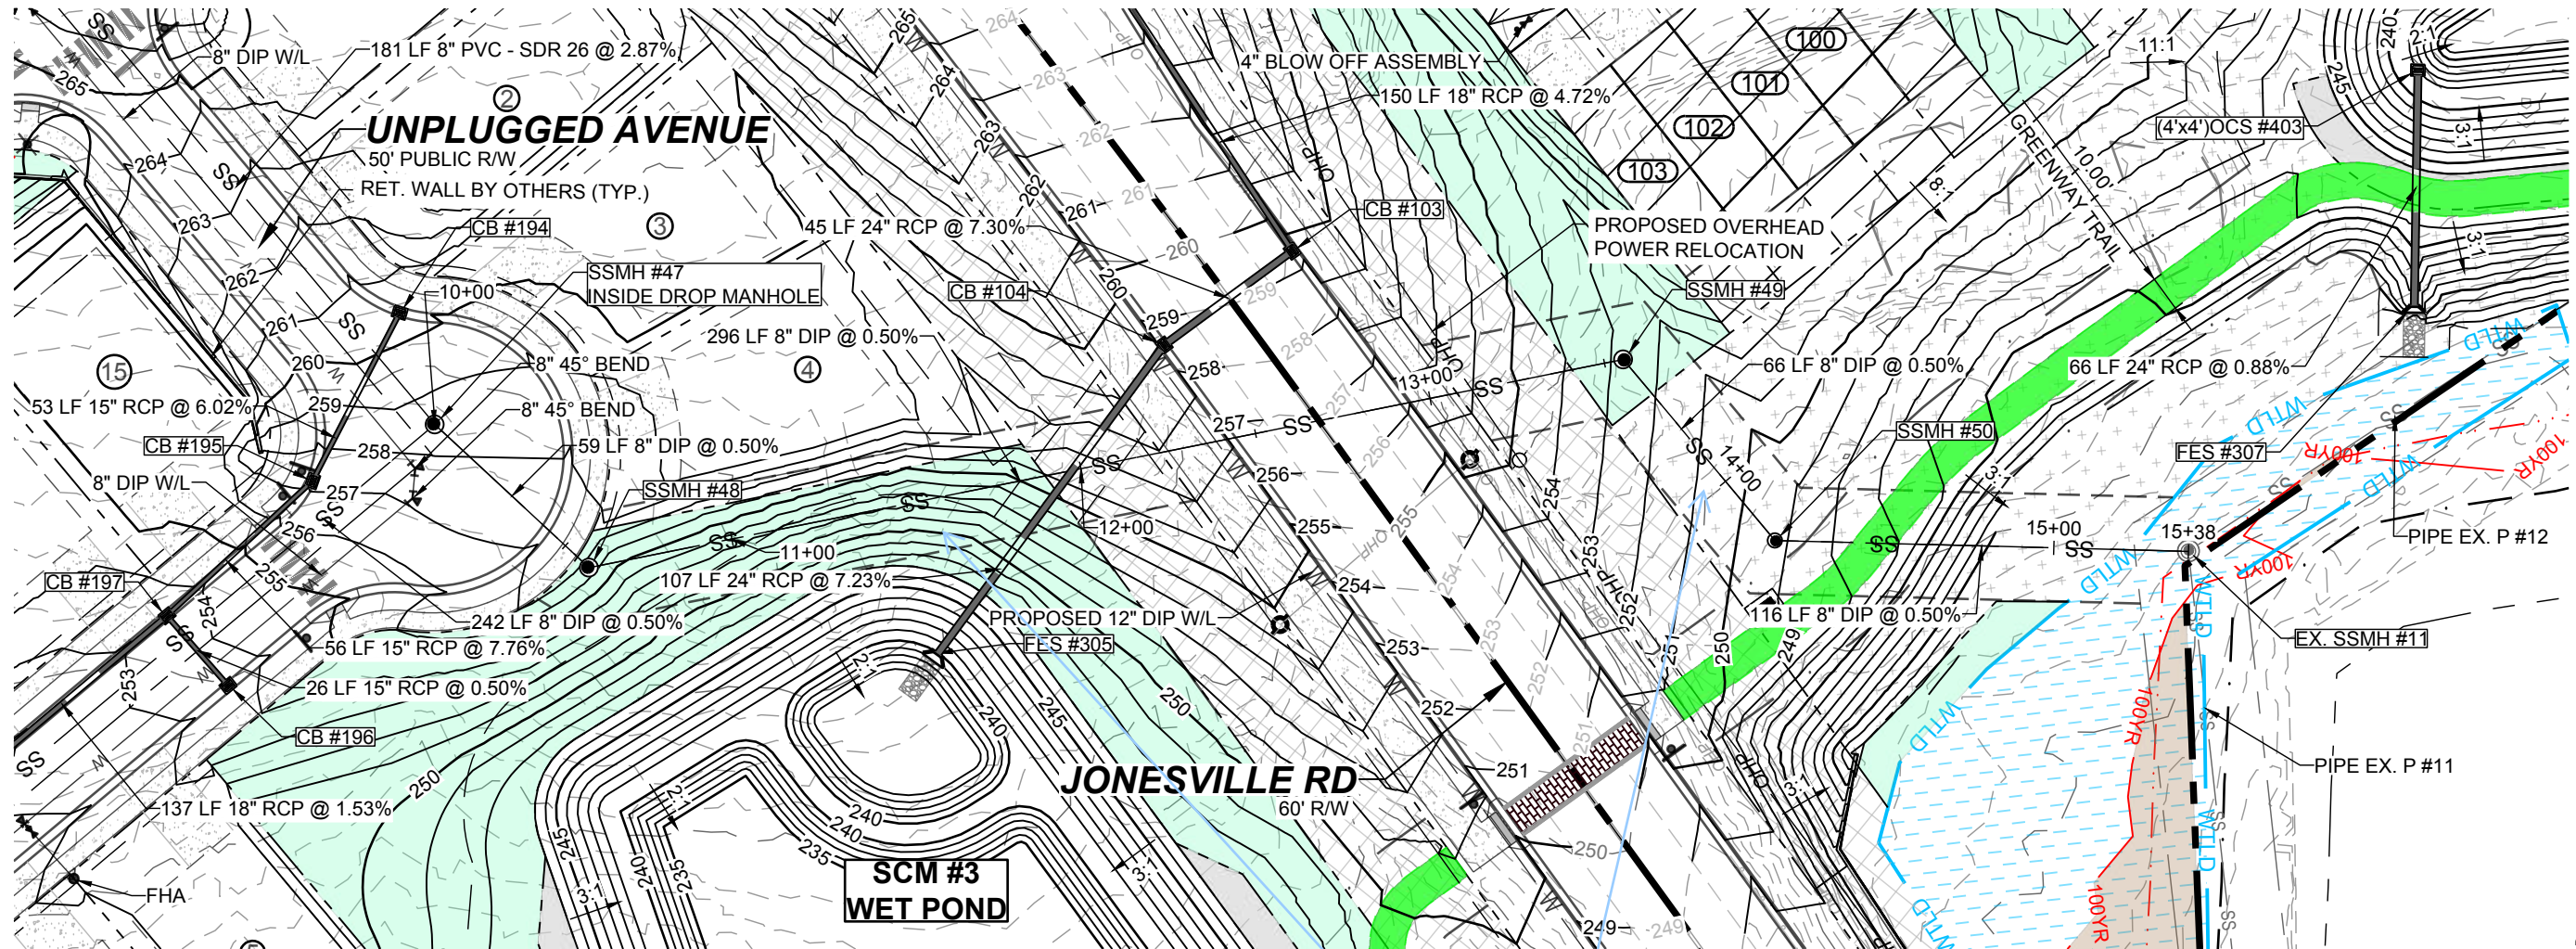

PROPOSED SSMH #47 - EX SSMH #11 - PLAN
HORIZONTAL: 1" = 50'


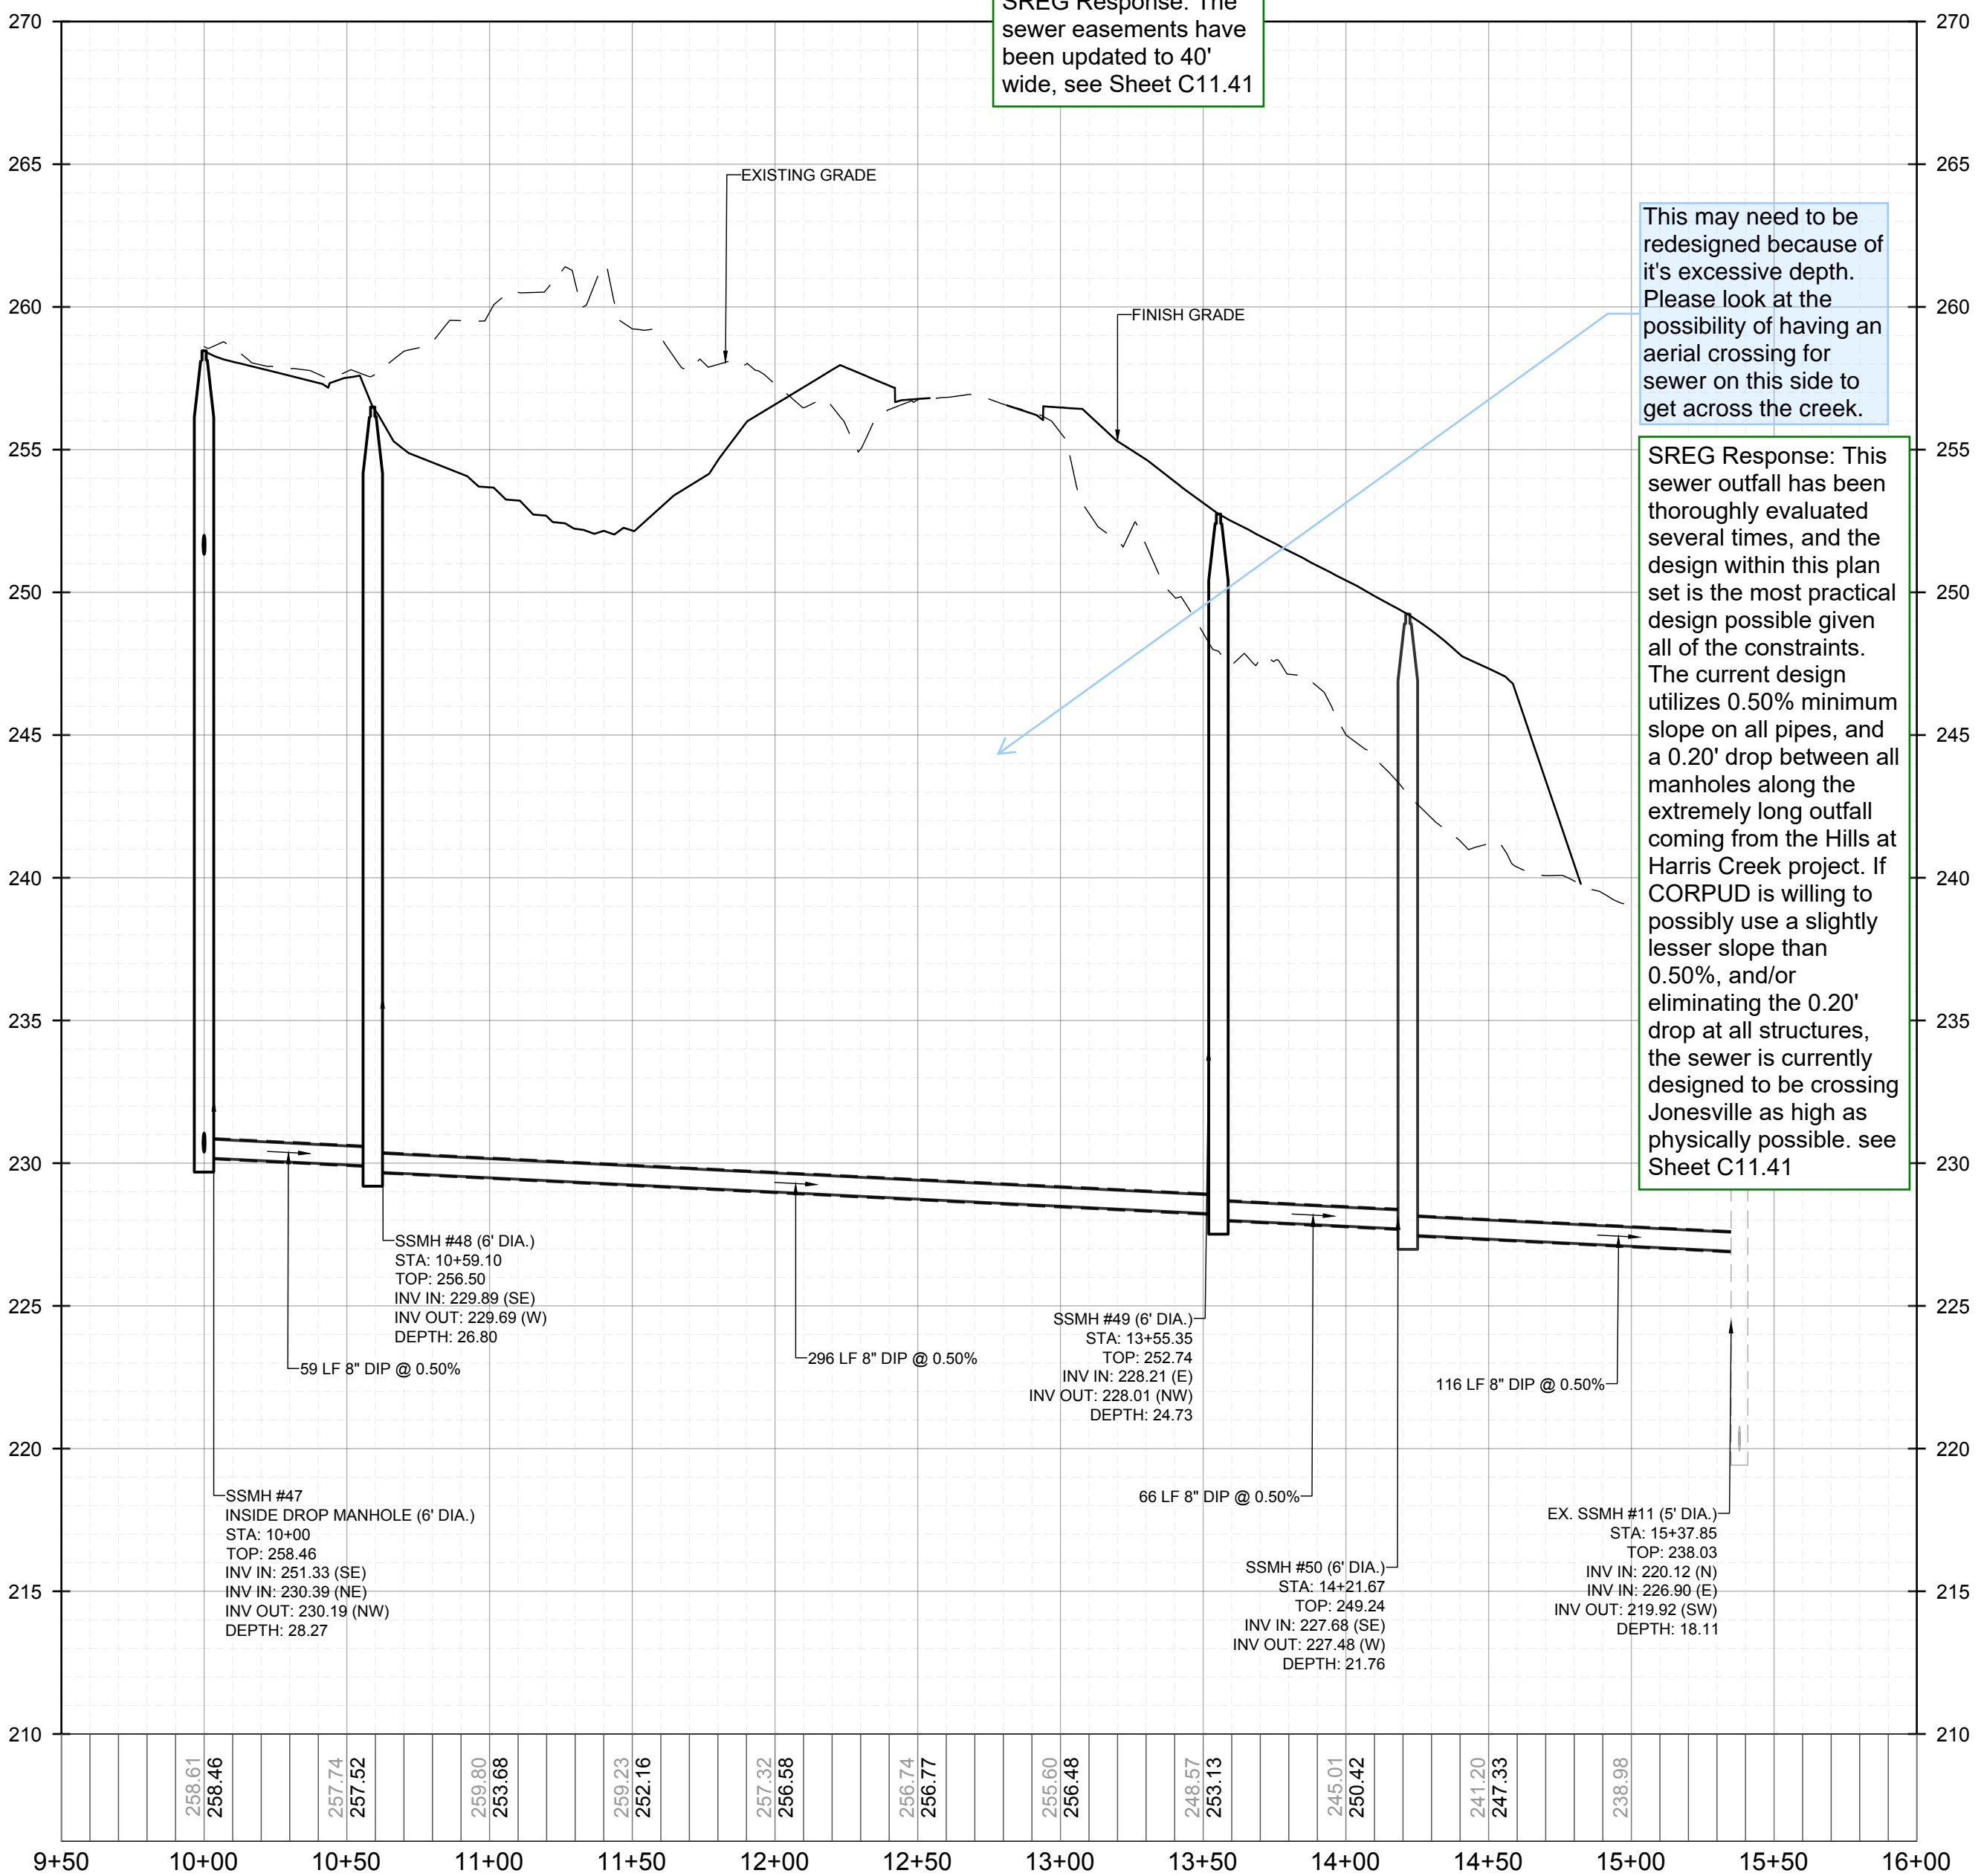


PROPOSED SSMH #47 - EX SSMH #11 - PROFILE
VERTICAL: 1" = 5'
HORIZONTAL: 1" = 50'

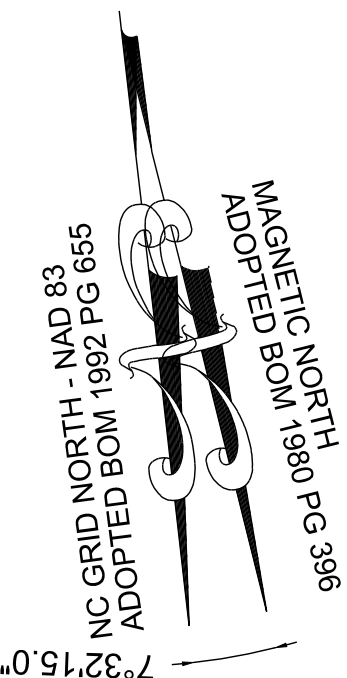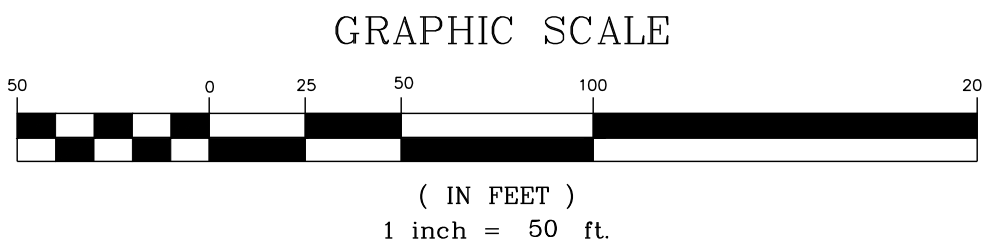





THIS PLANSET AND ANY ASSOCIATED DOCUMENTS ARE PRELIMINARY AND NOT AUTHORIZED FOR CONSTRUCTION UNTIL SIGNED, DATED, AND OFFICIALLY RELEASED FOR CONSTRUCTION BY THE ENGINEER OF RECORD.

CONSTRUCTION INFRASTRUCTURE DRAWINGS		SREG		BY	
01	CID-24-04	08/04/2024	SREG		
02	TOWN OF ROLESVILLE CID-24-04 V2	11/01/2024	SREG		
03	TOWN OF ROLESVILLE CID-24-04 V3	02/01/2024	SREG		
04	TOWN OF ROLESVILLE CID-24-04 V4	08/02/2025	SREG		
SEAL:		No.		DATE	
STRONGROCK		ENGINEERING GROUP		REVISIONS	
STRONG ROCK ENGINEERING GROUP, PLLC COMPANY LICENSE # P-2166		305 CHURCH AT NORTH HILLS STREET, SUITE 1110 RALEIGH, NC 27609 INFORMATION@STRONGROCKGROUP.COM			
RESERVE @ MITCHELL MILL		TOWN OF ROLESVILLE, WAKE COUNTY, NORTH CAROLINA		DRAWING SHEET	
CONSTRUCTION PLANS		ON-SITE SANITARY SEWER - PLAN & PROFILE		C-11.41	
STRONG ROCK PROJECT PSP-23-03		NOT FOR CONSTRUCTION		137 OF 227	
SCALE AS SHOWN		SRG			
DESIGNED BY		SRG			
DRAWN BY		SRG			
CHECKED BY		SRG			

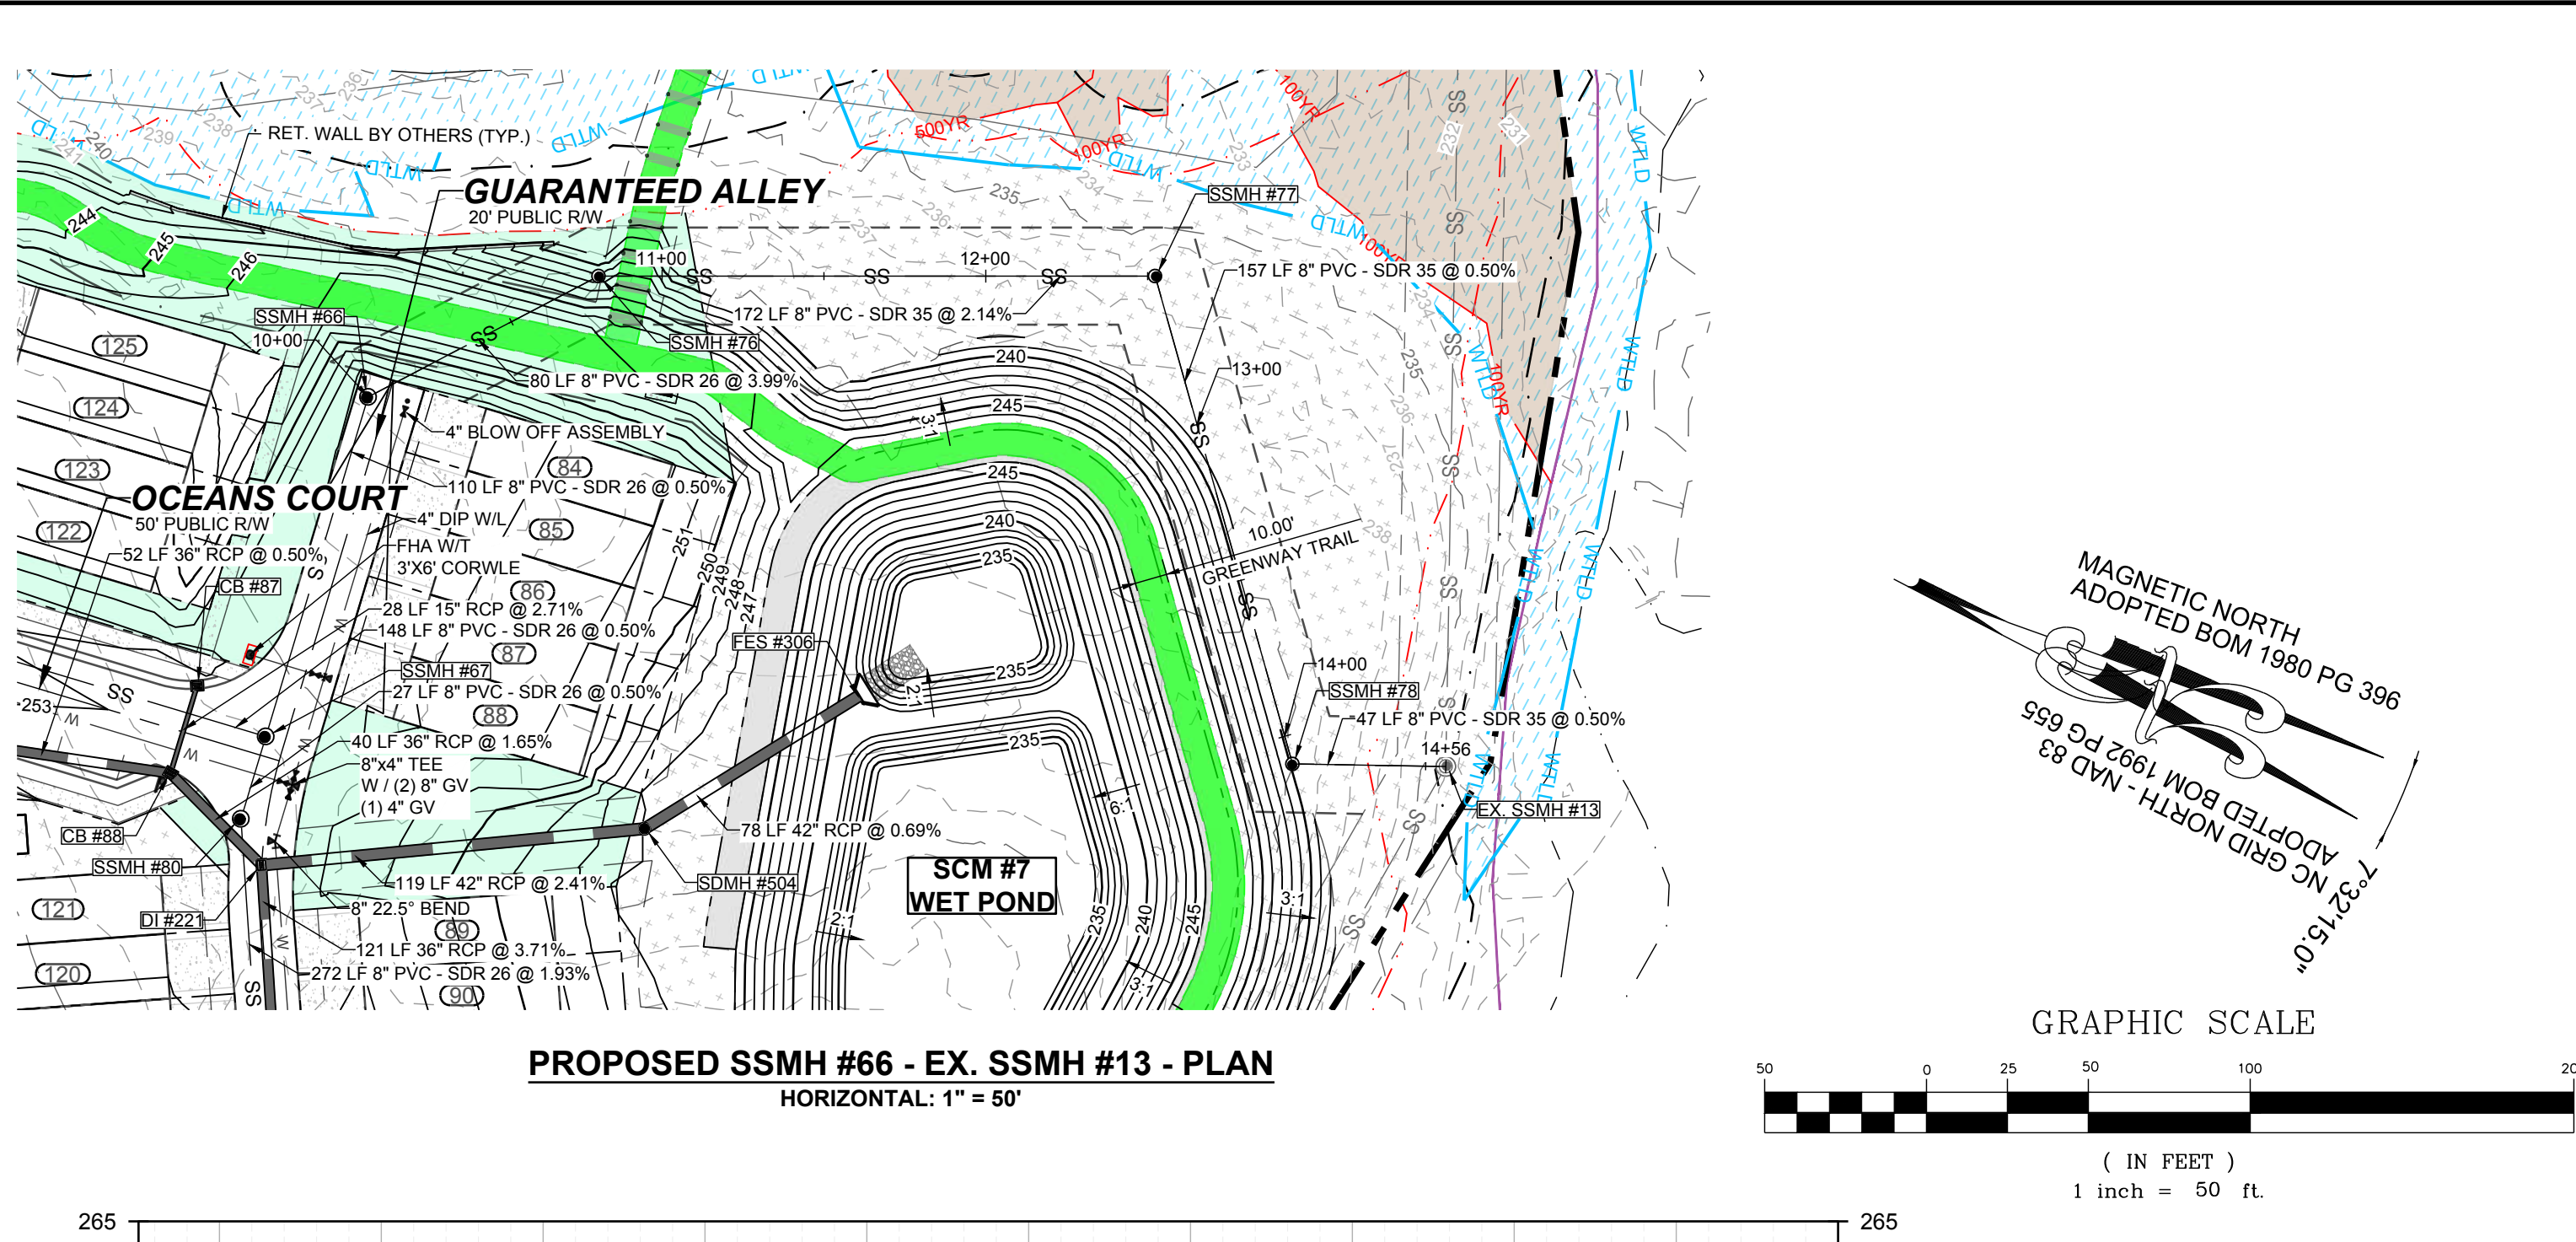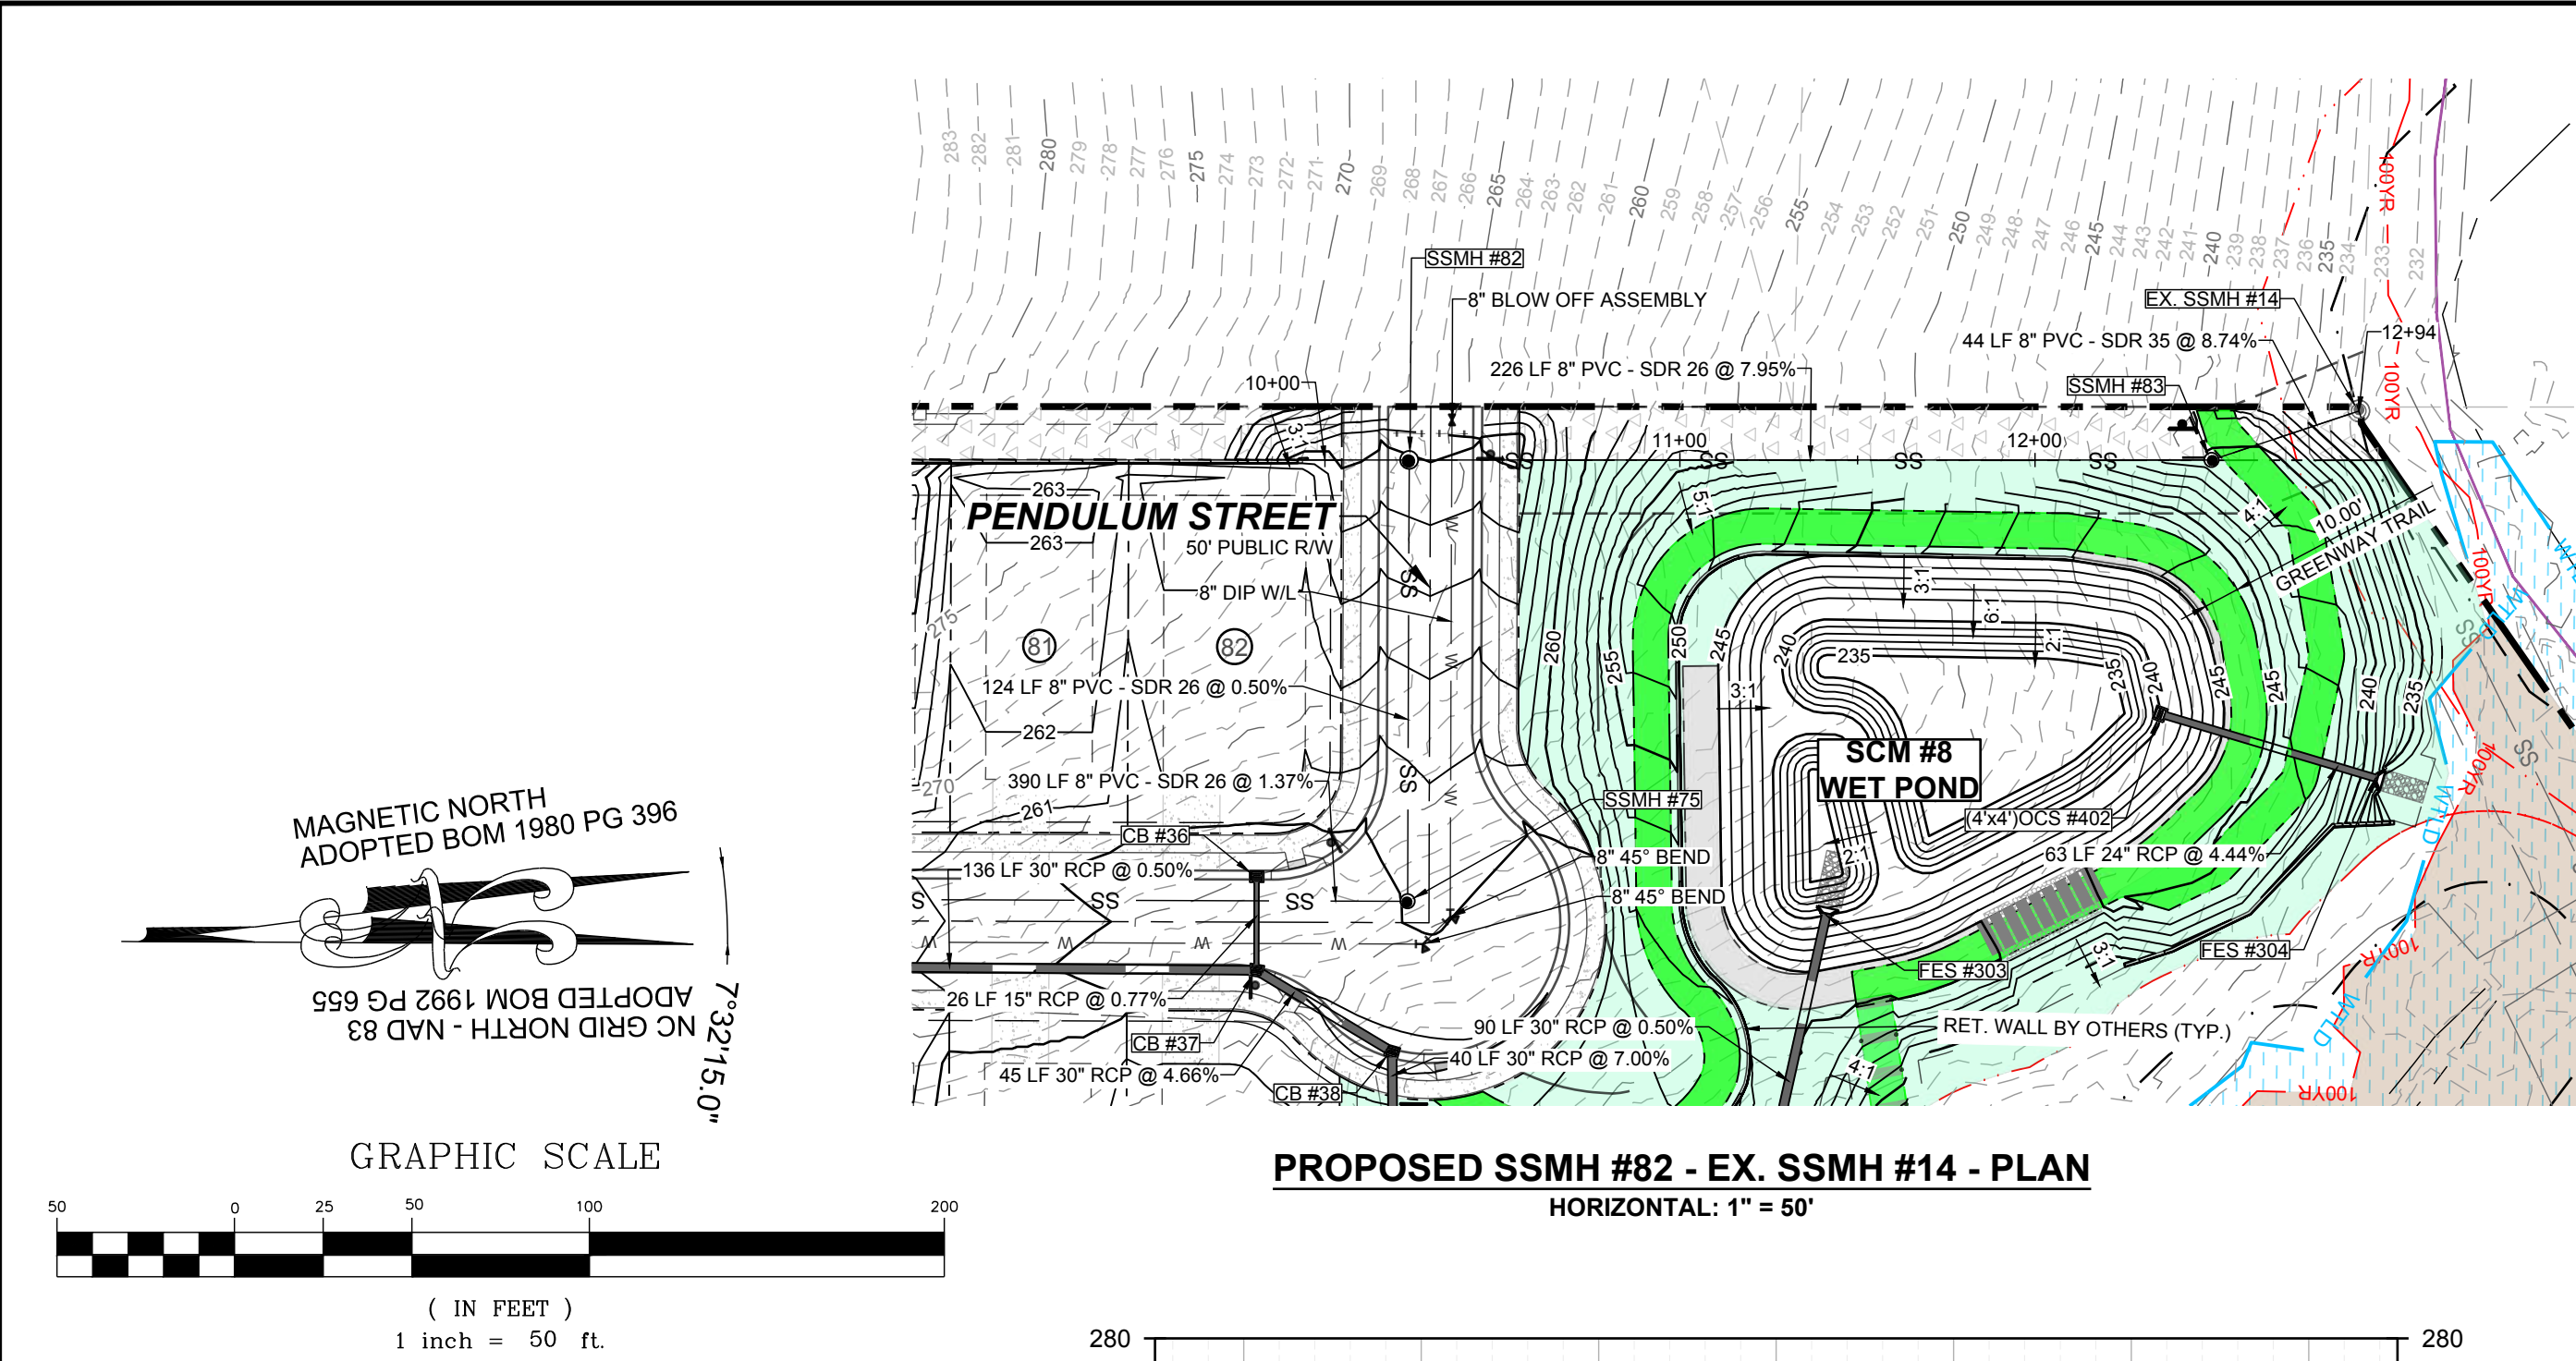

PUBLIC
WATER DISTRIBUTION / EXTENSION SYSTEM
THE CITY OF RALEIGH CONSENTS TO THE CONNECTION AND EXTENSION OF THE CITY'S PUBLIC WATER SYSTEM AS SHOWN ON THIS PLAN. THE MATERIAL AND CONSTRUCTION METHODS USED FOR THIS PROJECT SHALL CONFORM TO THE STANDARDS AND SPECIFICATIONS OF THE CITY'S PUBLIC UTILITIES HANDBOOK.
CITY OF RALEIGH
PUBLIC UTILITIES DEPARTMENT PERMIT # _____

PUBLIC
SEWER COLLECTION / EXTENSION SYSTEM
THE CITY OF RALEIGH CONSENTS TO THE CONNECTION AND EXTENSION OF THE CITY'S PUBLIC SEWER SYSTEM AS SHOWN ON THIS PLAN. THE MATERIAL AND CONSTRUCTION METHODS USED FOR THIS PROJECT SHALL CONFORM TO THE STANDARDS AND SPECIFICATIONS OF THE CITY'S PUBLIC UTILITIES HANDBOOK.
CITY OF RALEIGH
PUBLIC UTILITIES DEPARTMENT PERMIT # _____

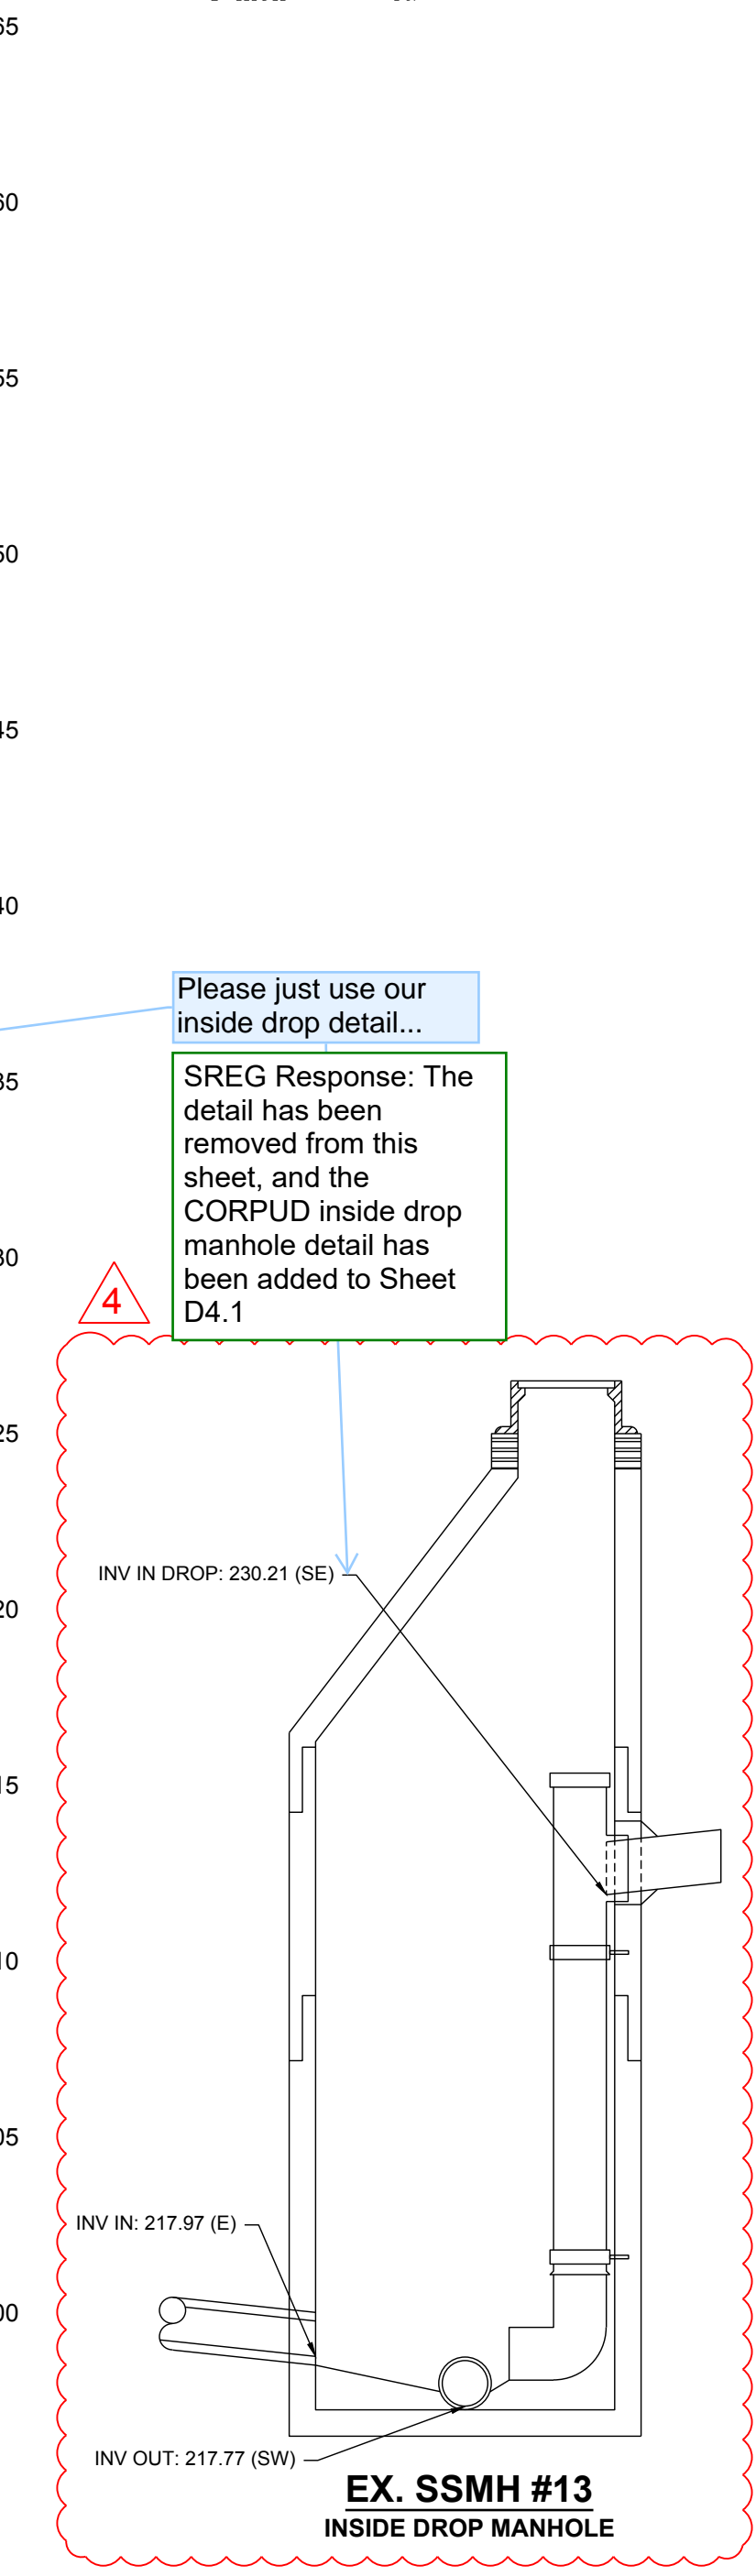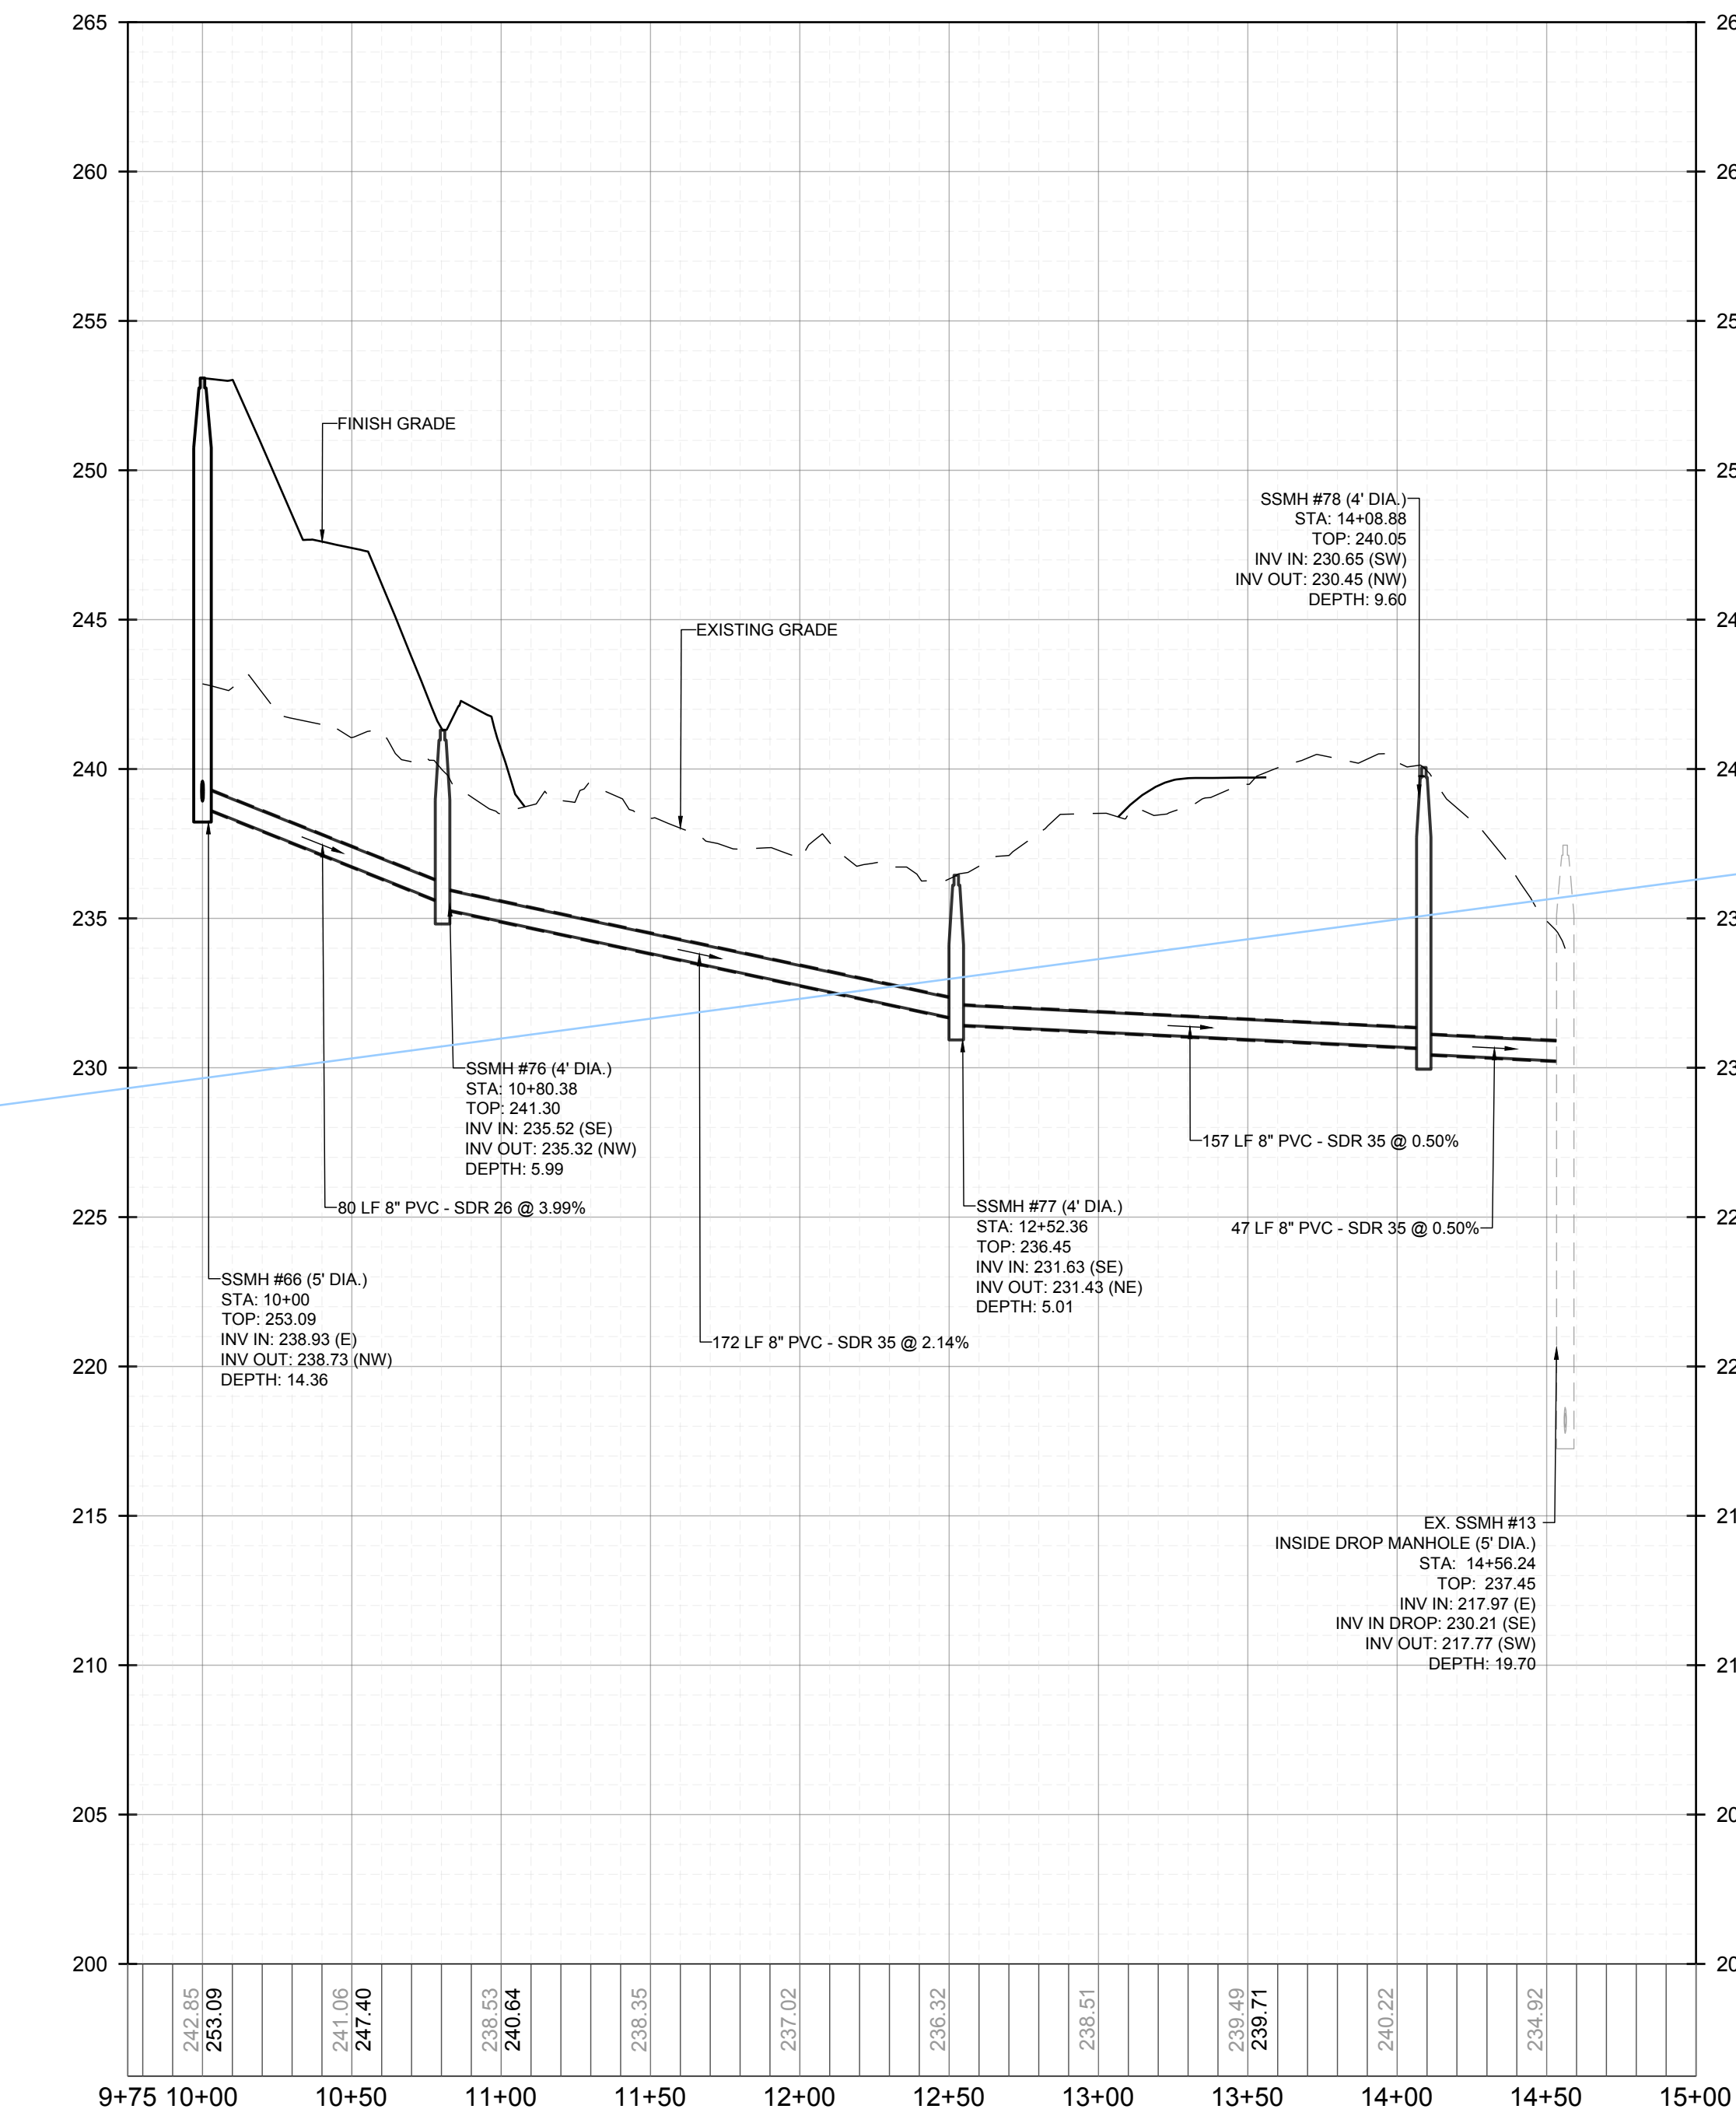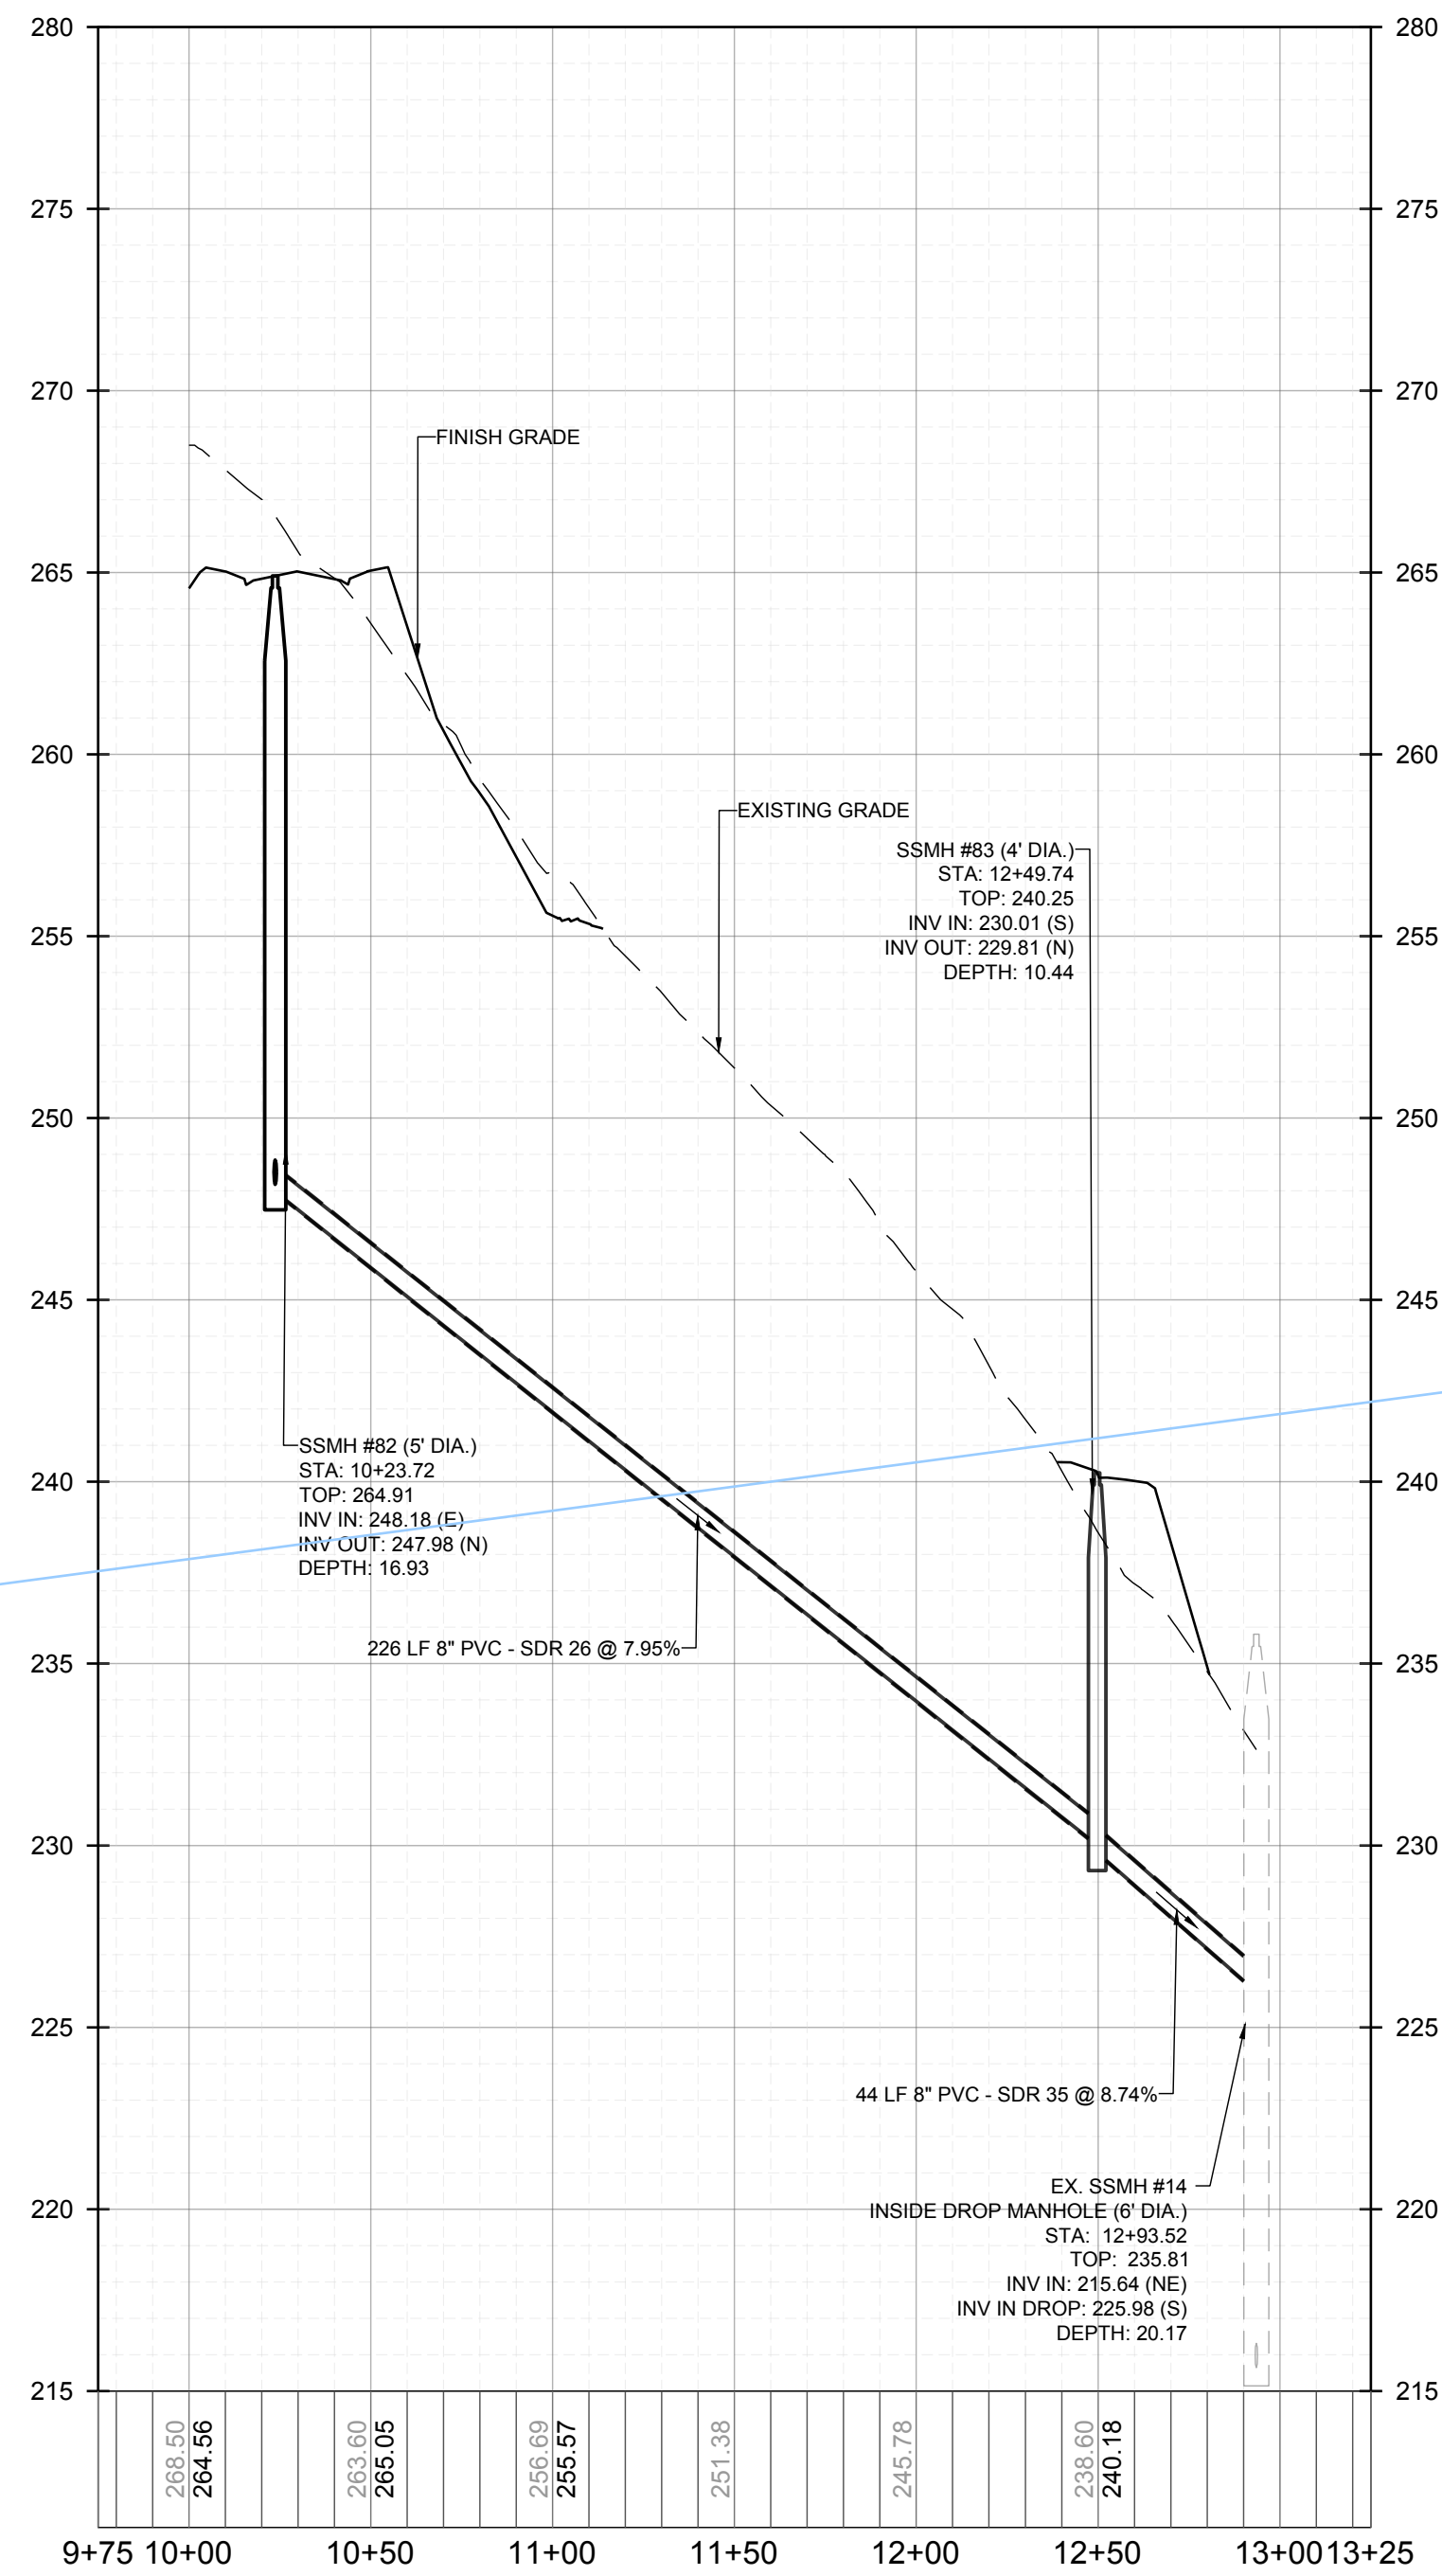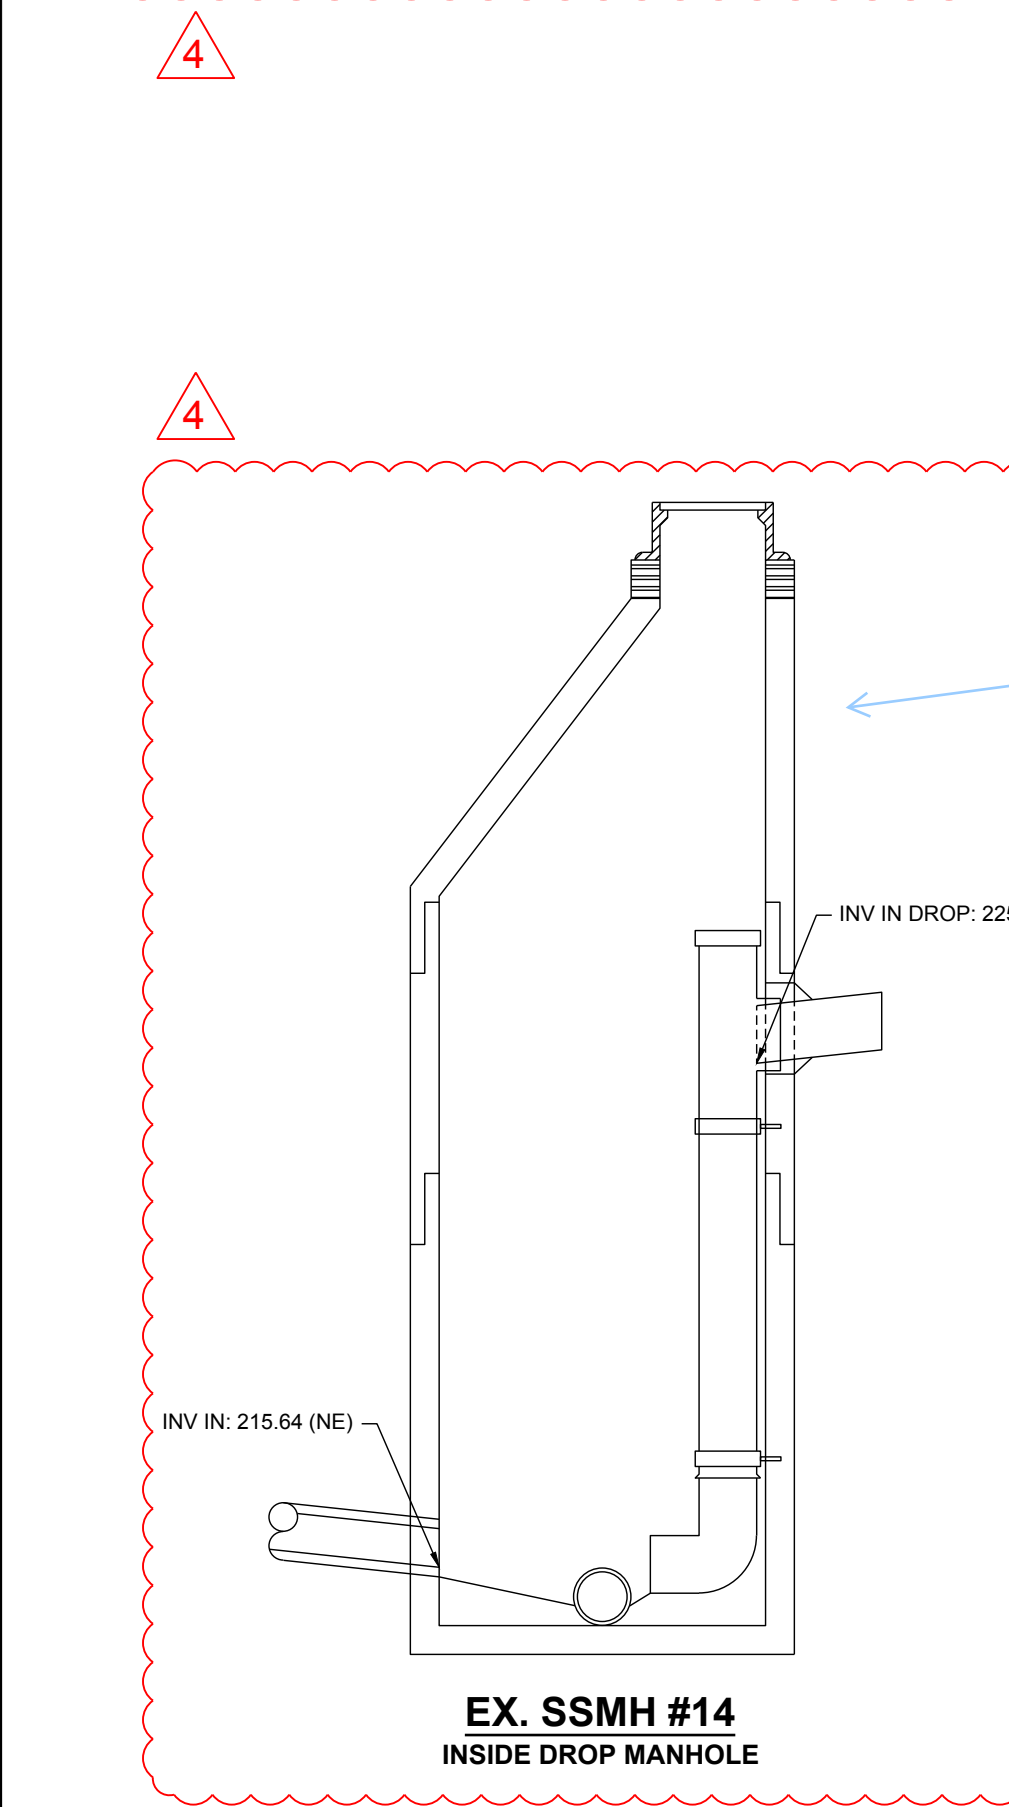

CONSTRUCTION INFRASTRUCTURE DRAWINGS				REVISIONS		DATE
NO.	DESCRIPTION	DATE	BY	NO.	DESCRIPTION	DATE
01	TOWN OF ROLESVILLE CID-24-04 V2	08/04/2024	SRG			
02	TOWN OF ROLESVILLE CID-24-04 V3	11/07/2024	SRG			
03	TOWN OF ROLESVILLE CID-24-04 V4	02/07/2024	SRG			
04	TOWN OF ROLESVILLE CID-24-04 V4	08/02/2025	SRG			


SEAL:

STRONGROCK
ENGINEERING GROUP
STRONG ROCK ENGINEERING GROUP, PLLC | COMPANY LICENSE # P-2166
305 CHURCH AT NORTH HILLS STREET, SUITE 1110 RALEIGH, NC 27609 | INFORMATION@STRONGROCKGROUP.COM



STRONG ROCK PROJECT
PSP-24-03
NOT FOR CONSTRUCTION
SCALE AS SHOWN
DESIGNED BY SRG
DRAWN BY SRG
CHECKED BY SRG

RESERVE @ MITCHELL MILL
TOWN OF ROLESVILLE, WAKE COUNTY, NORTH CAROLINA
CONSTRUCTION PLANS
ON-SITE SANITARY SEWER -
PLAN & PROFILE


DRAWING SHEET
C-11.42
138 OF 227

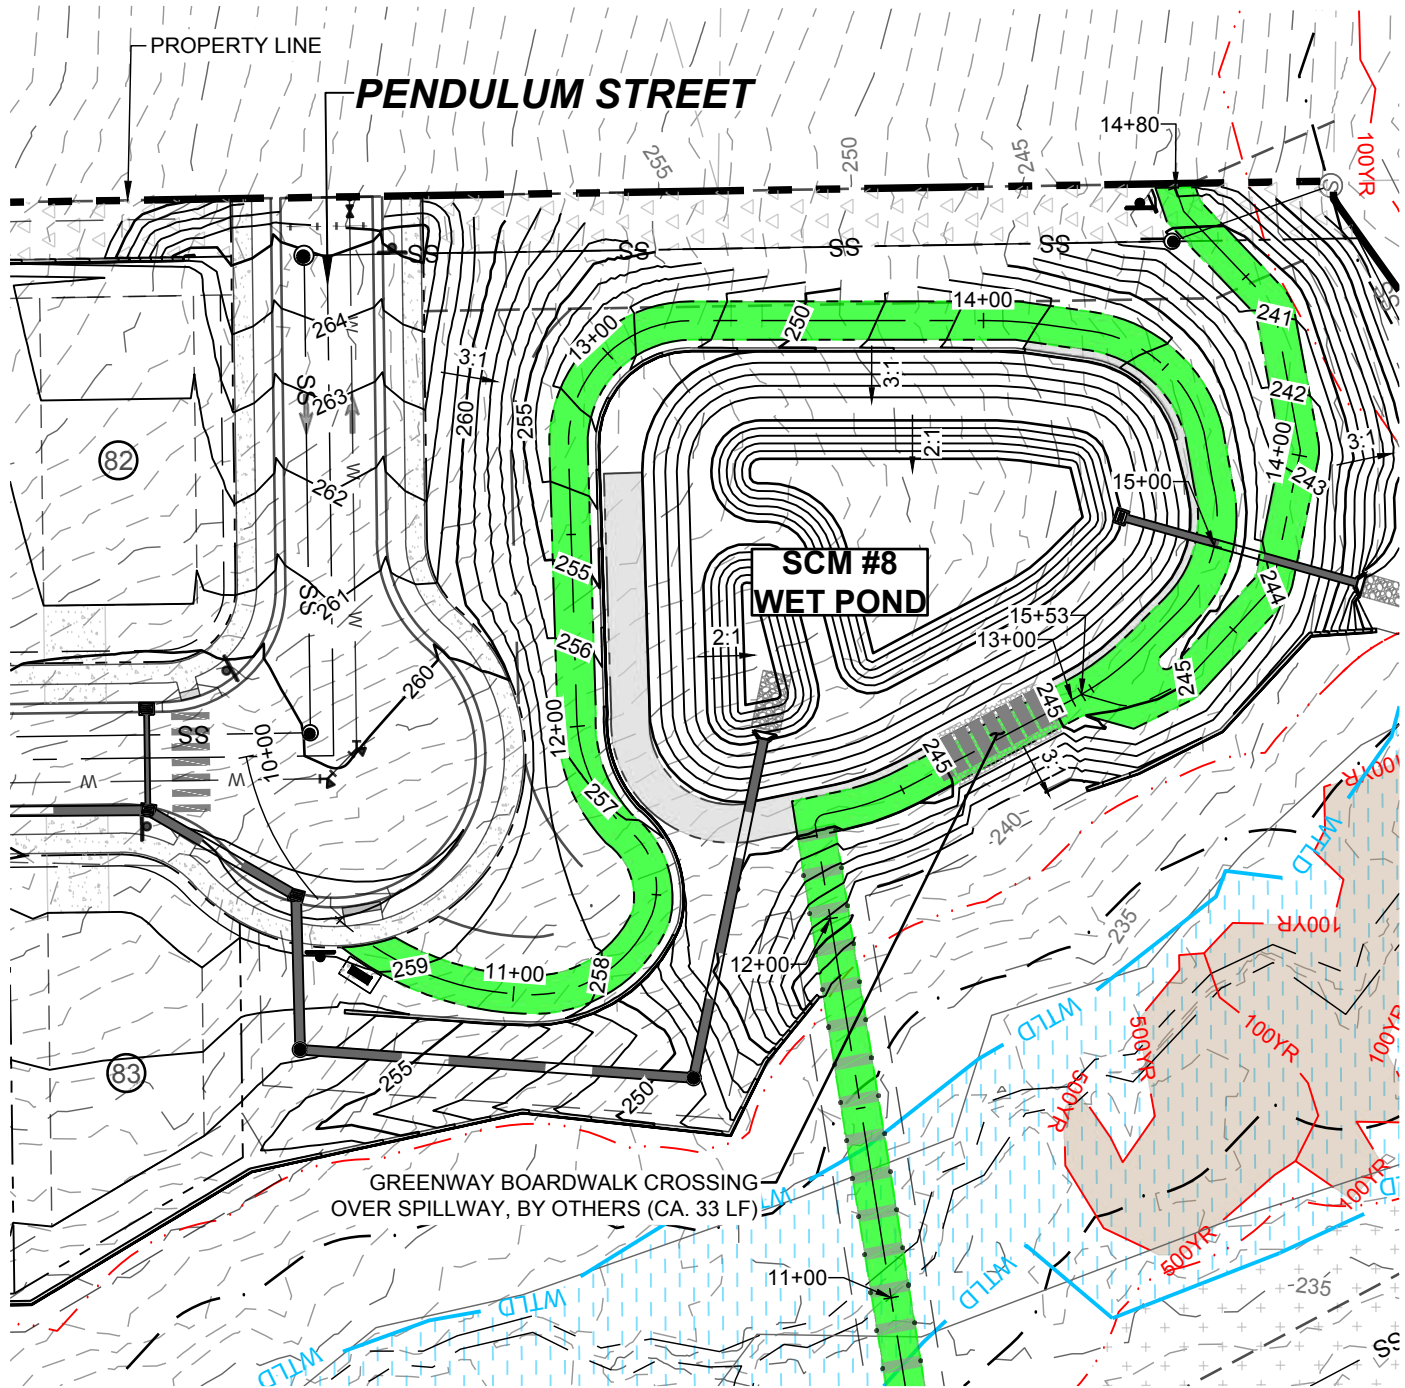



PROPOSED GREENWAY 4 - PLAN
HORIZONTAL: 1" = 50'

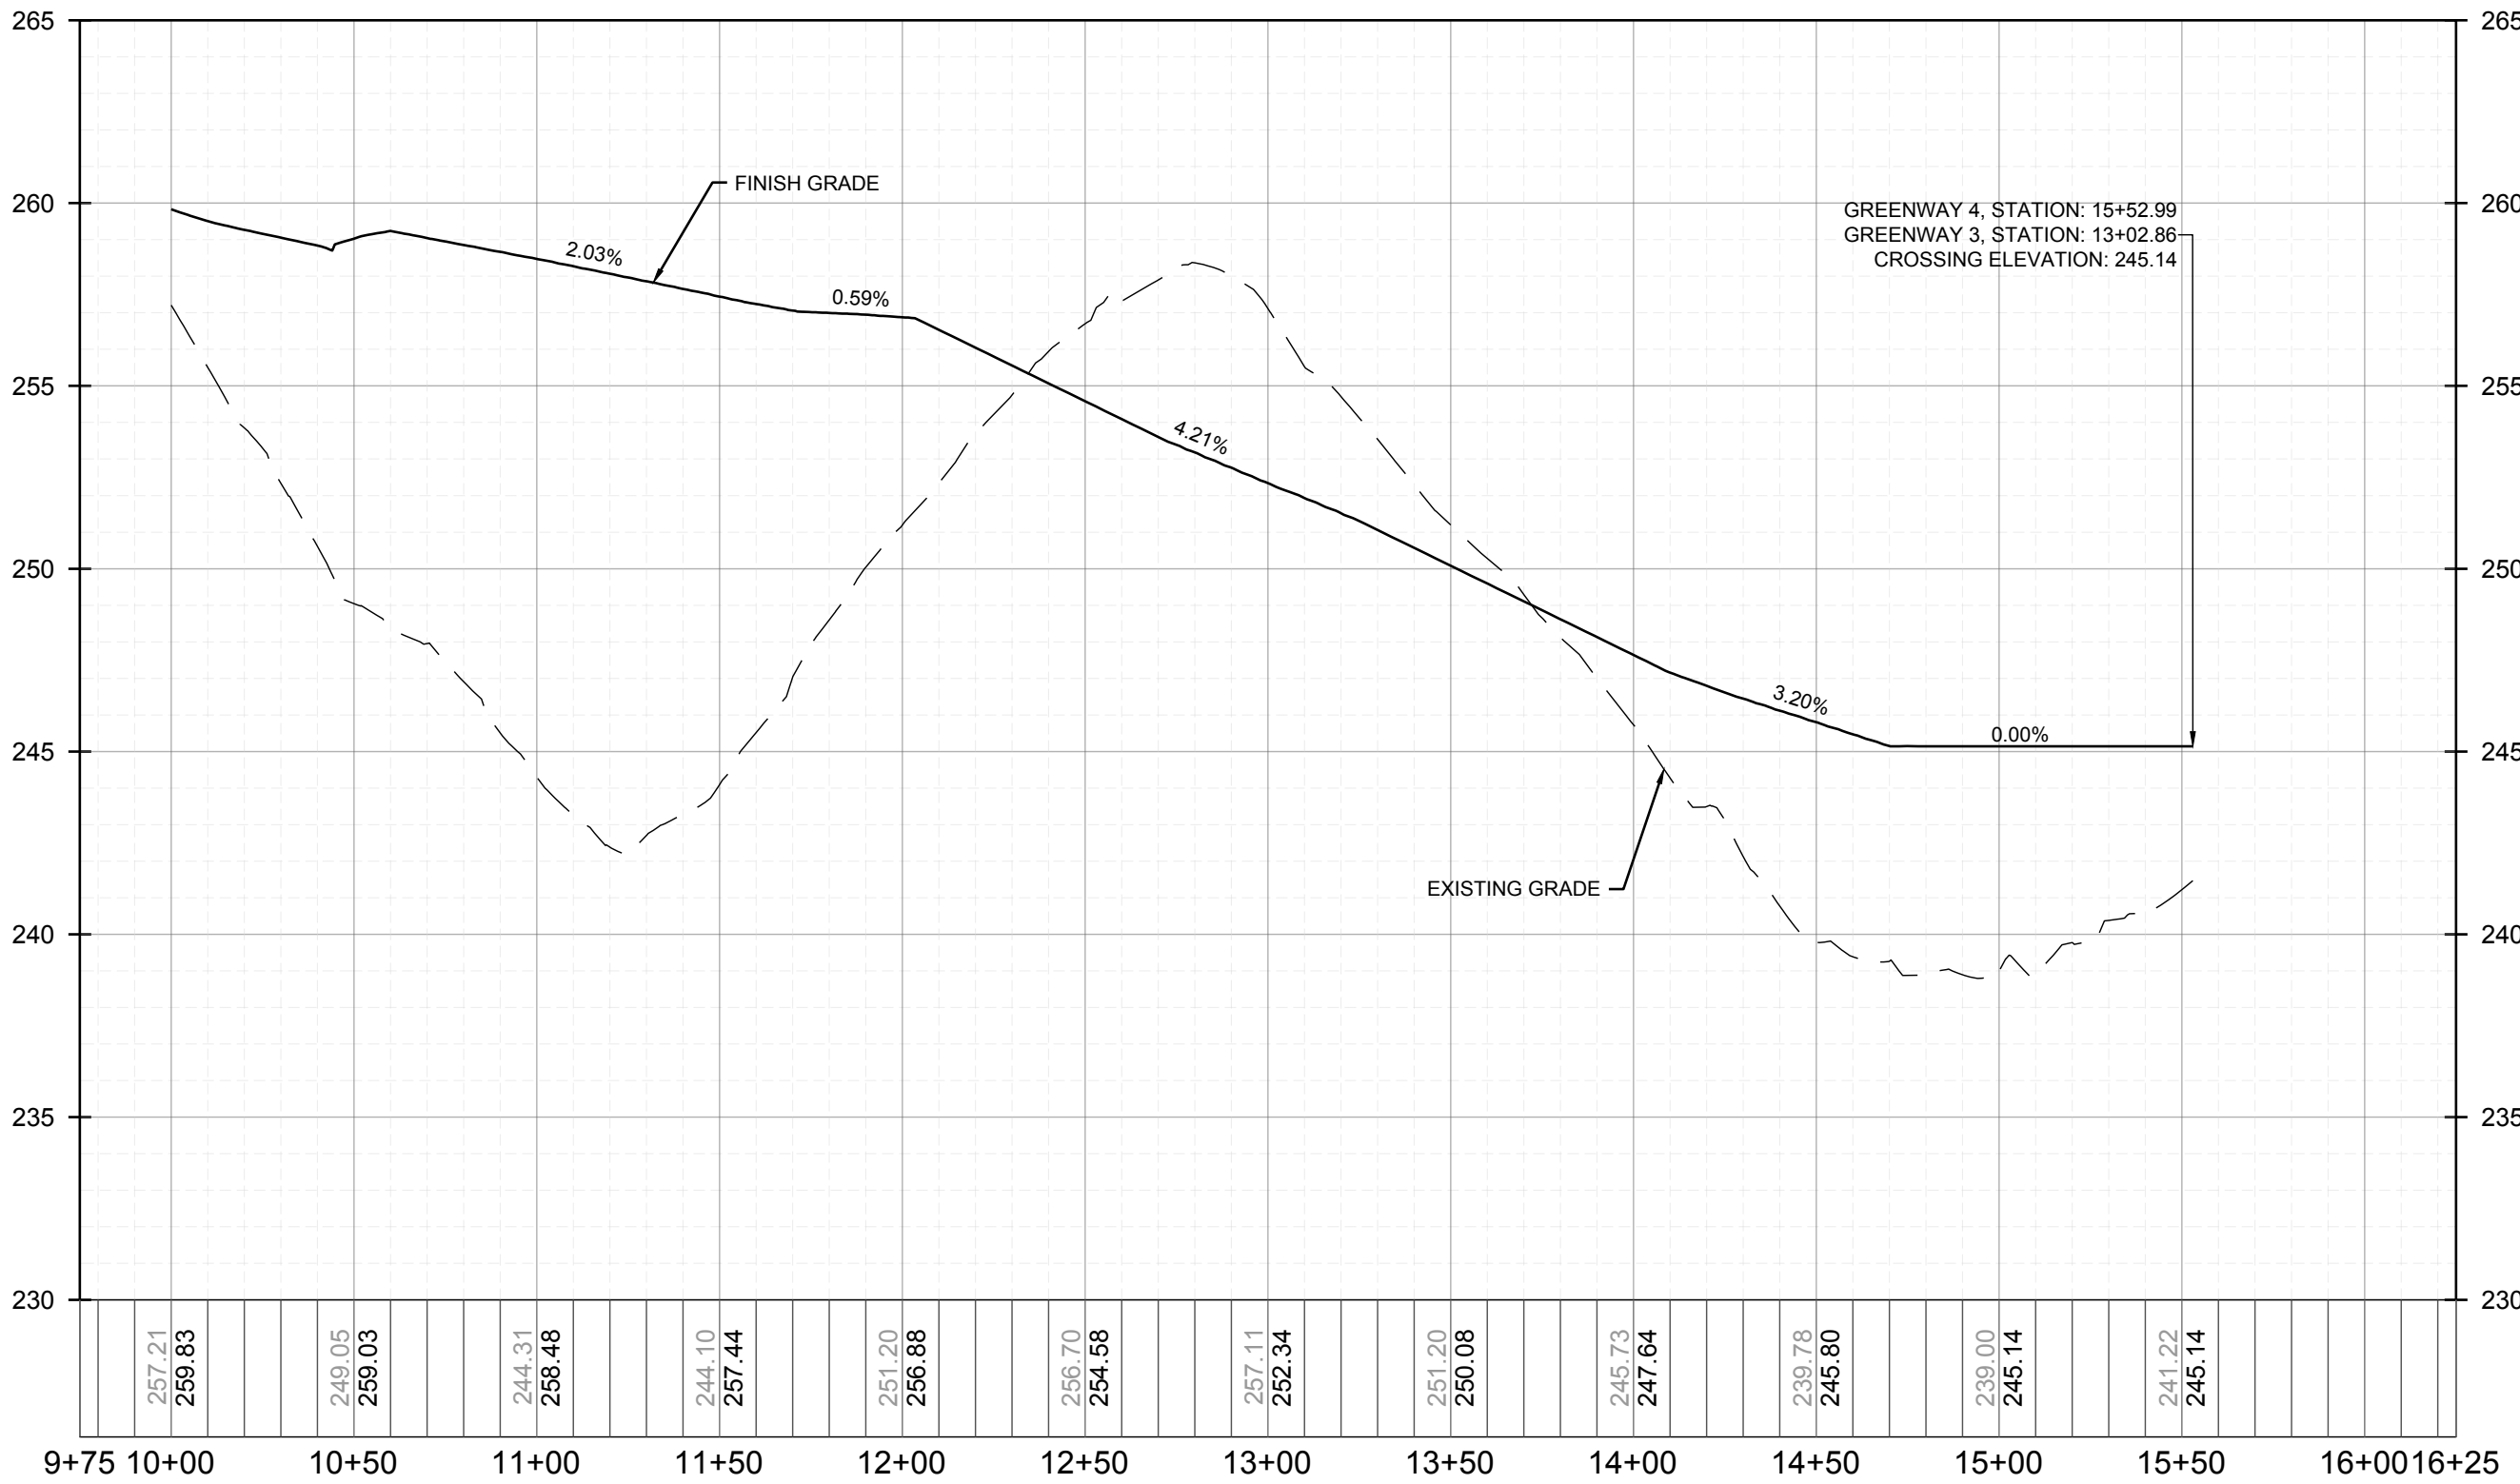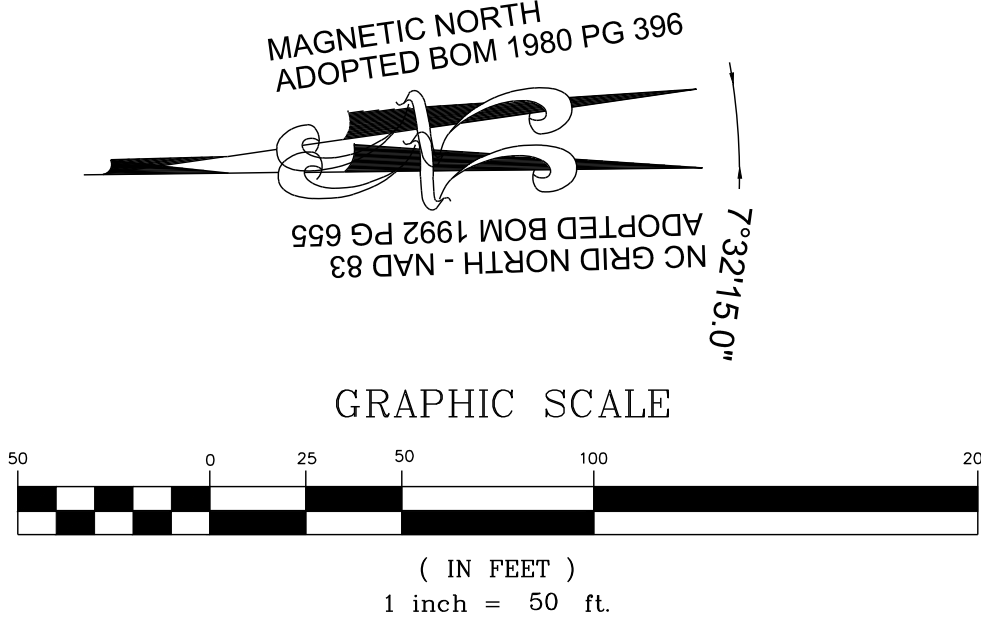



PROPOSED GREENWAY 4 - PROFILE
VERTICAL: 1" = 5'
HORIZONTAL: 1" = 50'

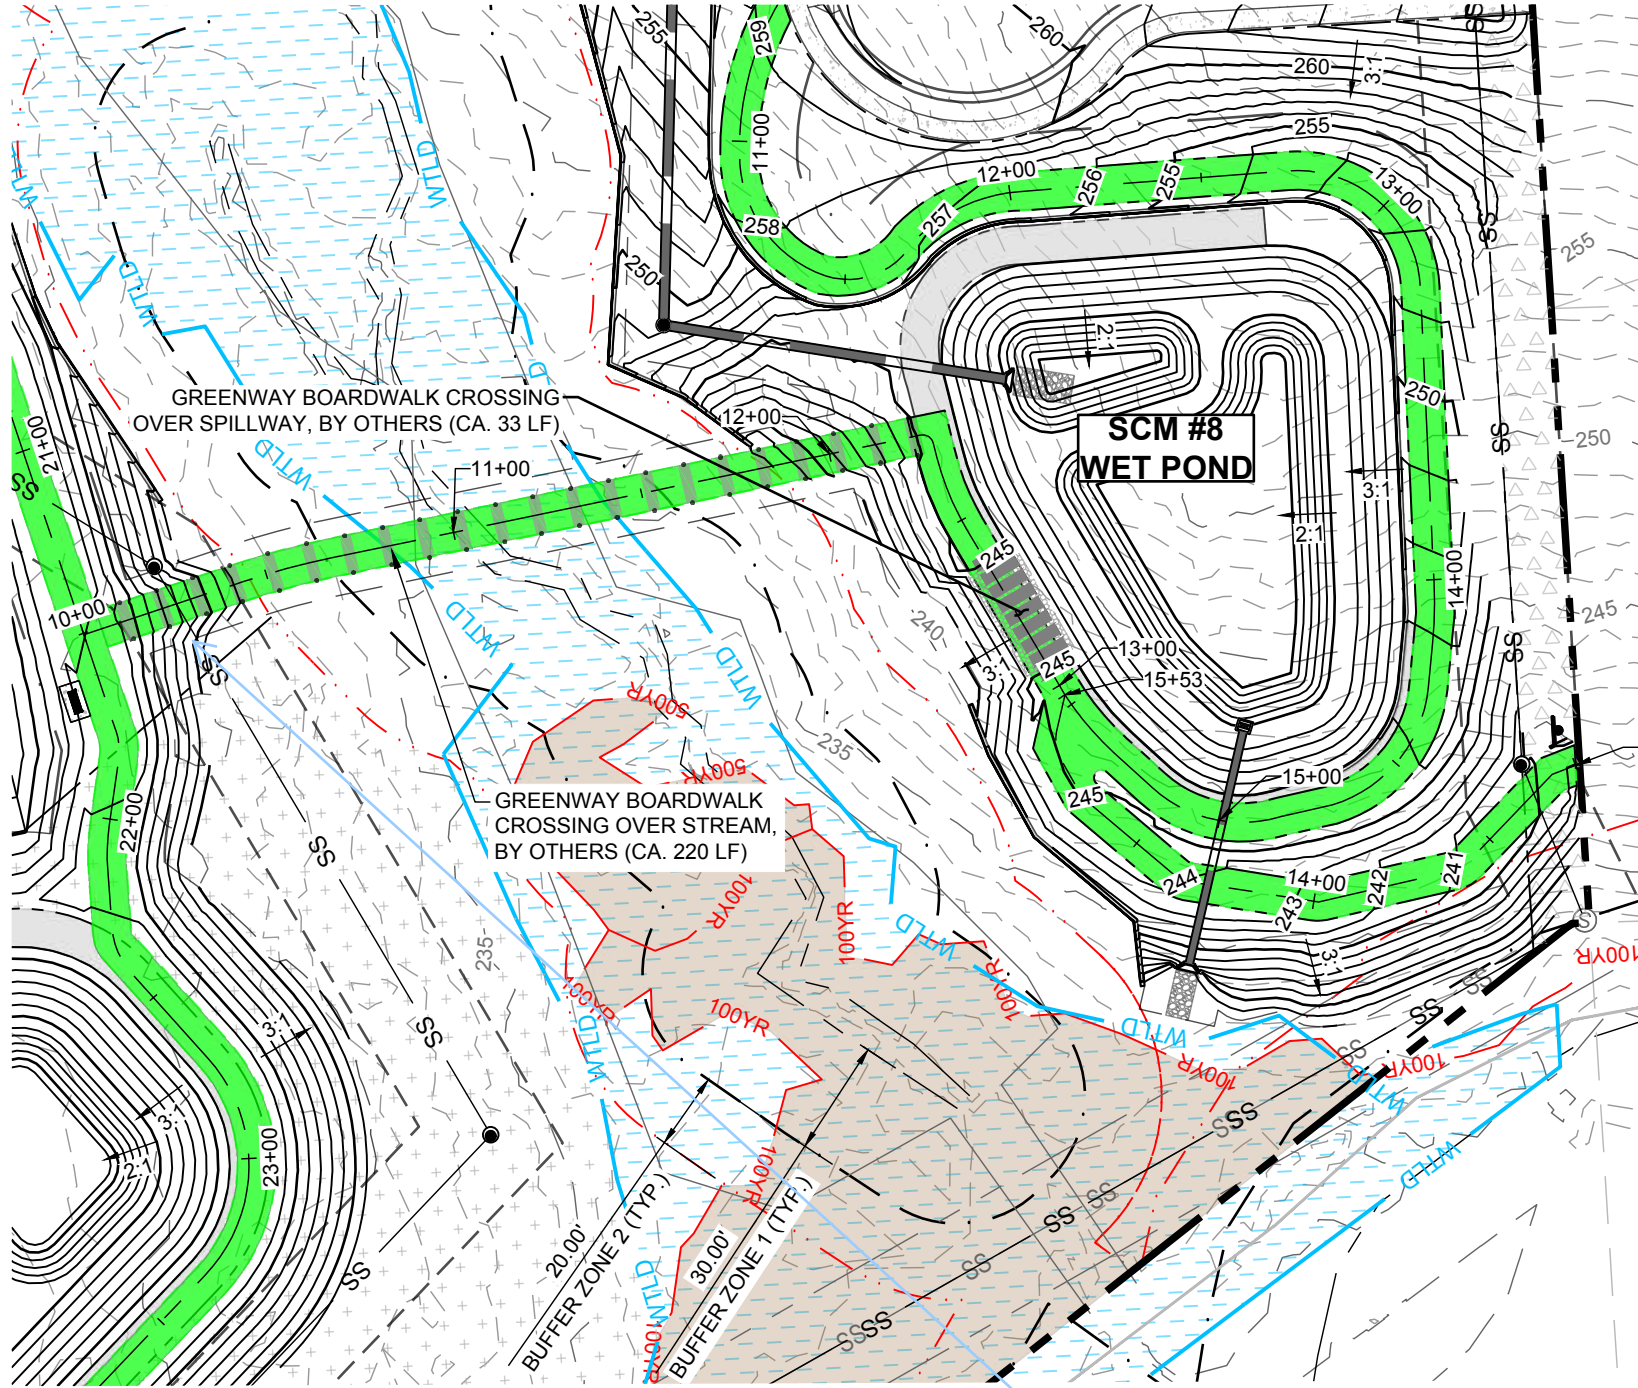

PROPOSED GREENWAY 5 - PLAN
HORIZONTAL: 1" = 50'

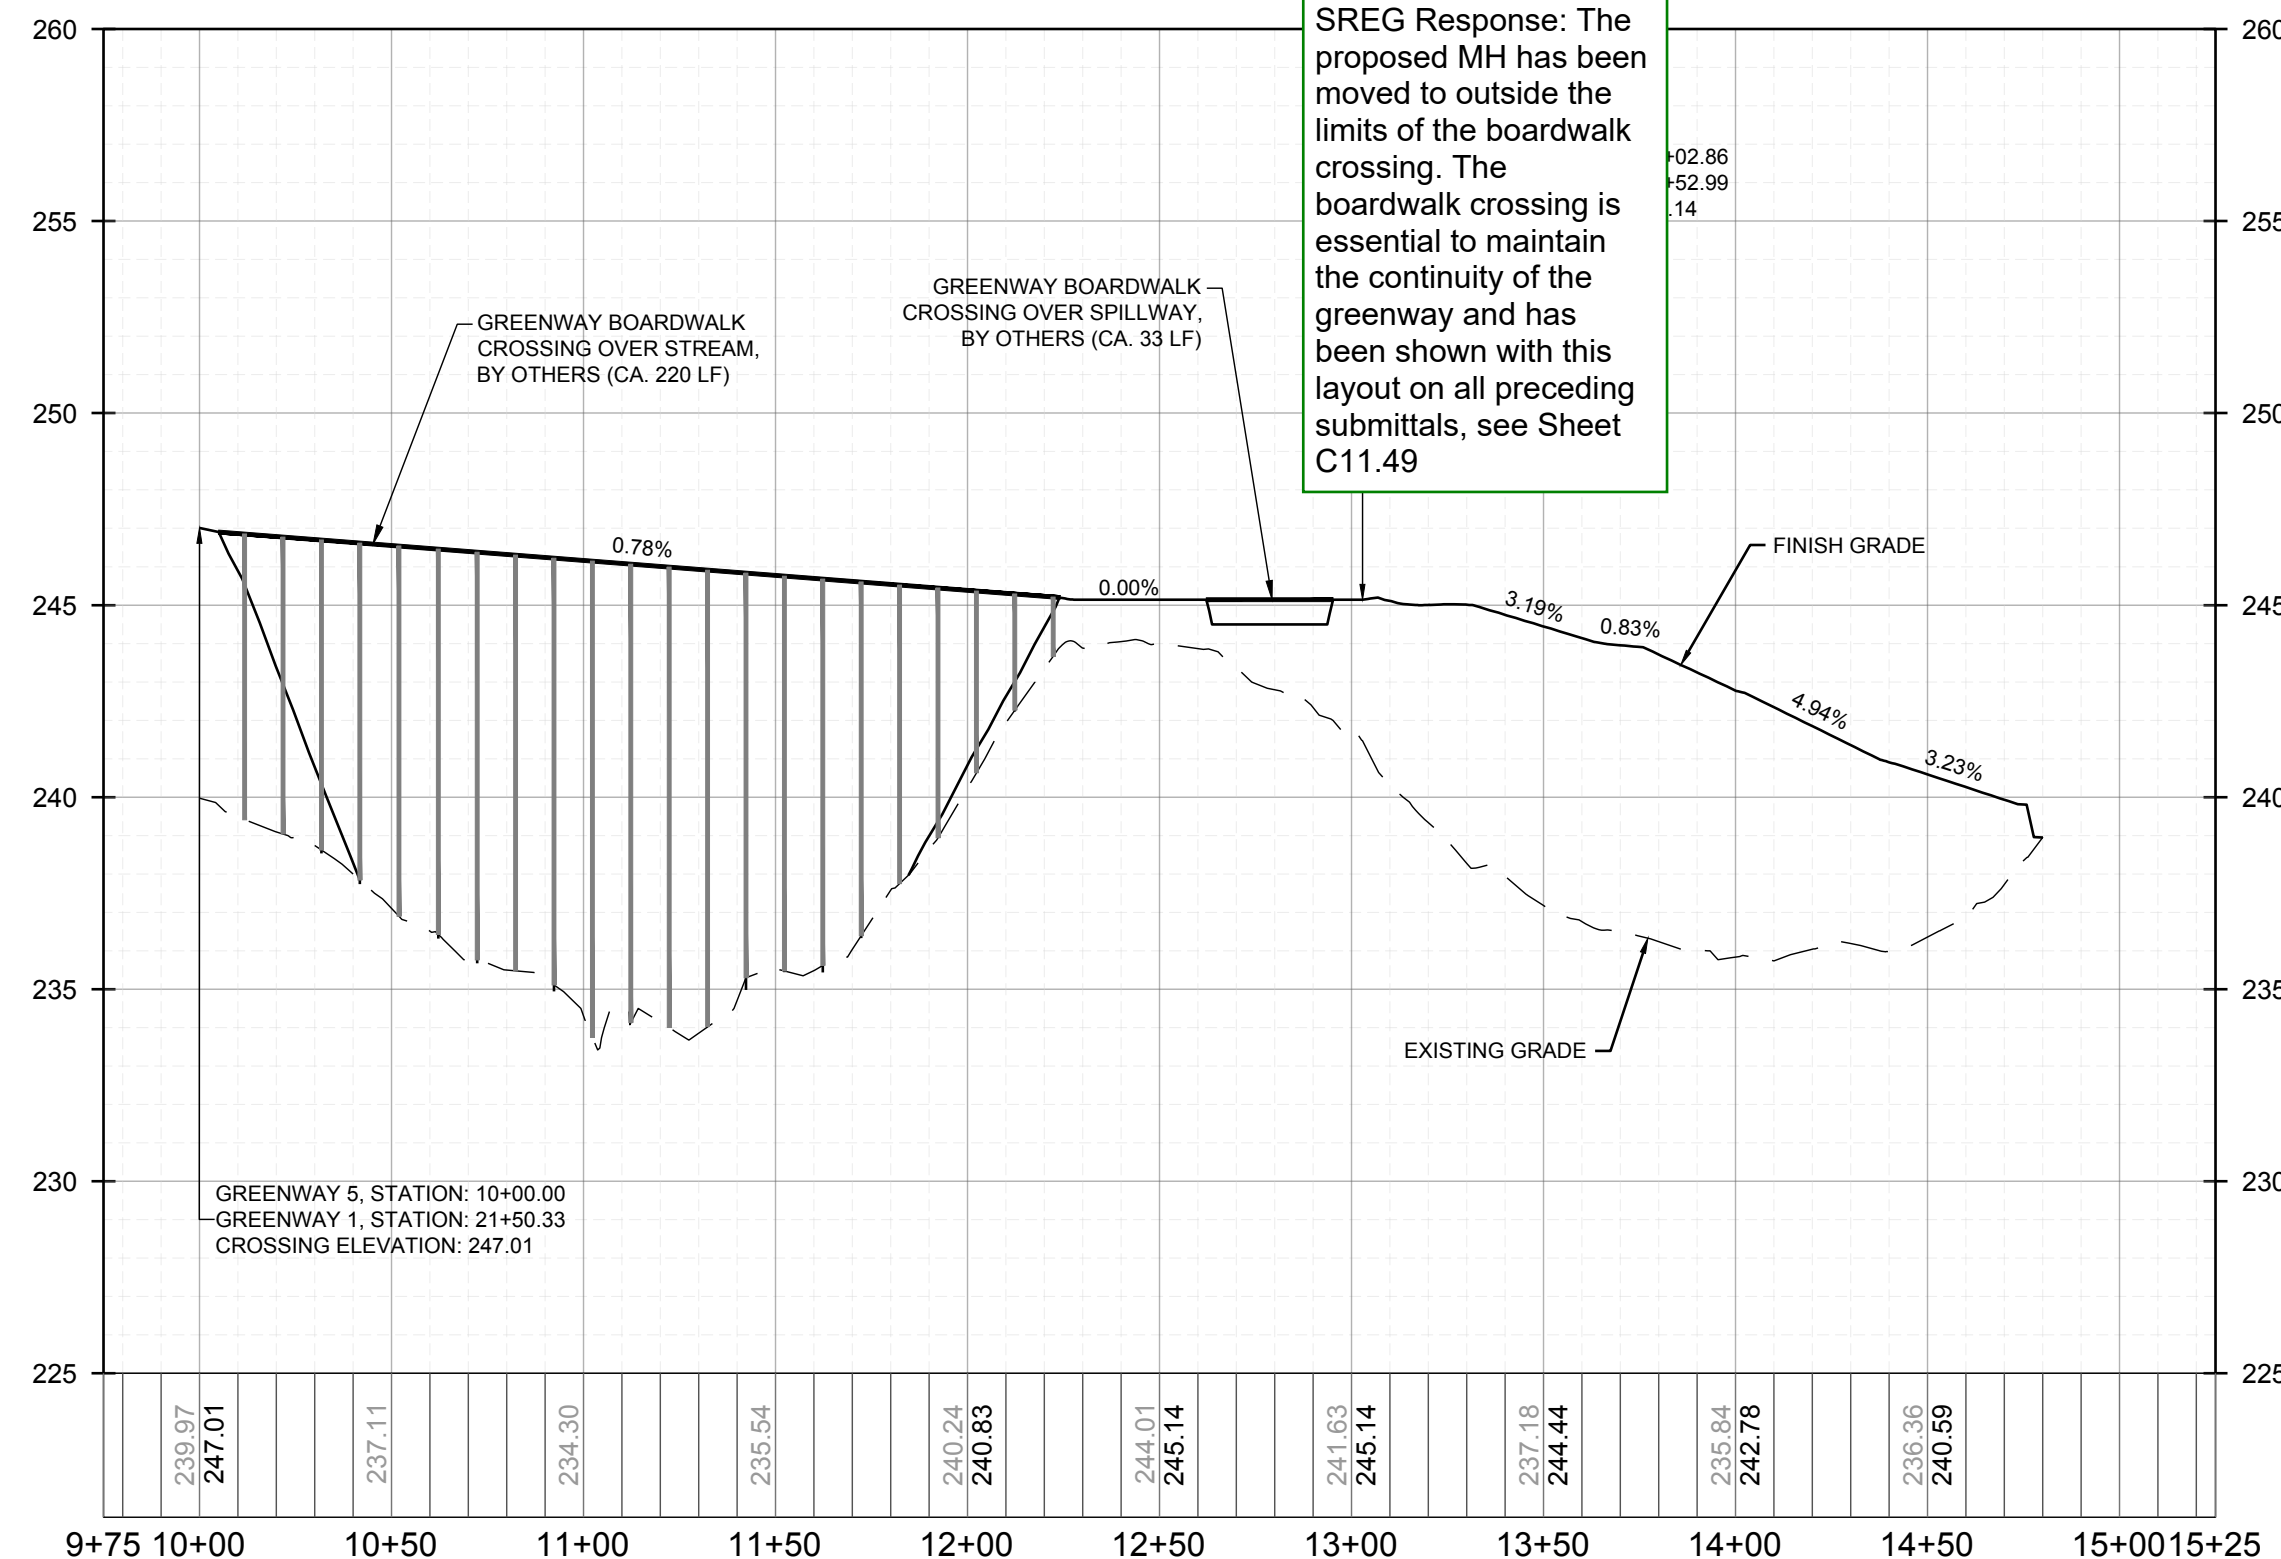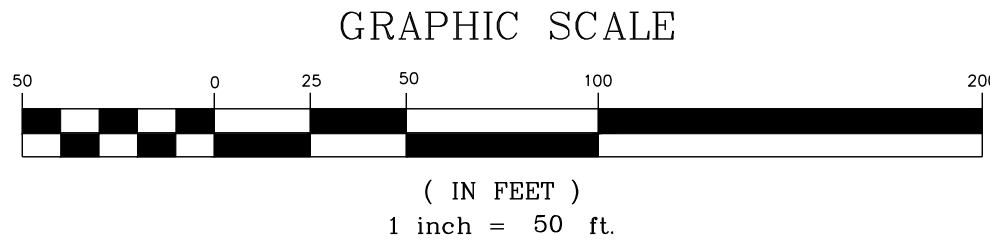

PROPOSED GREENWAY 5 - PROFILE
VERTICAL: 1" = 5'
HORIZONTAL: 1" = 50'

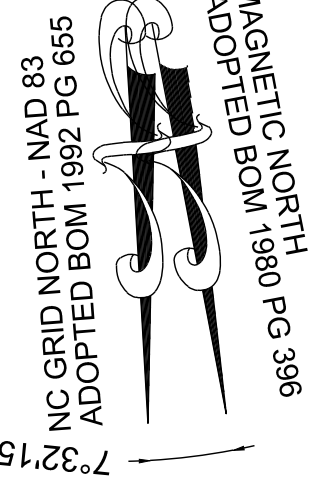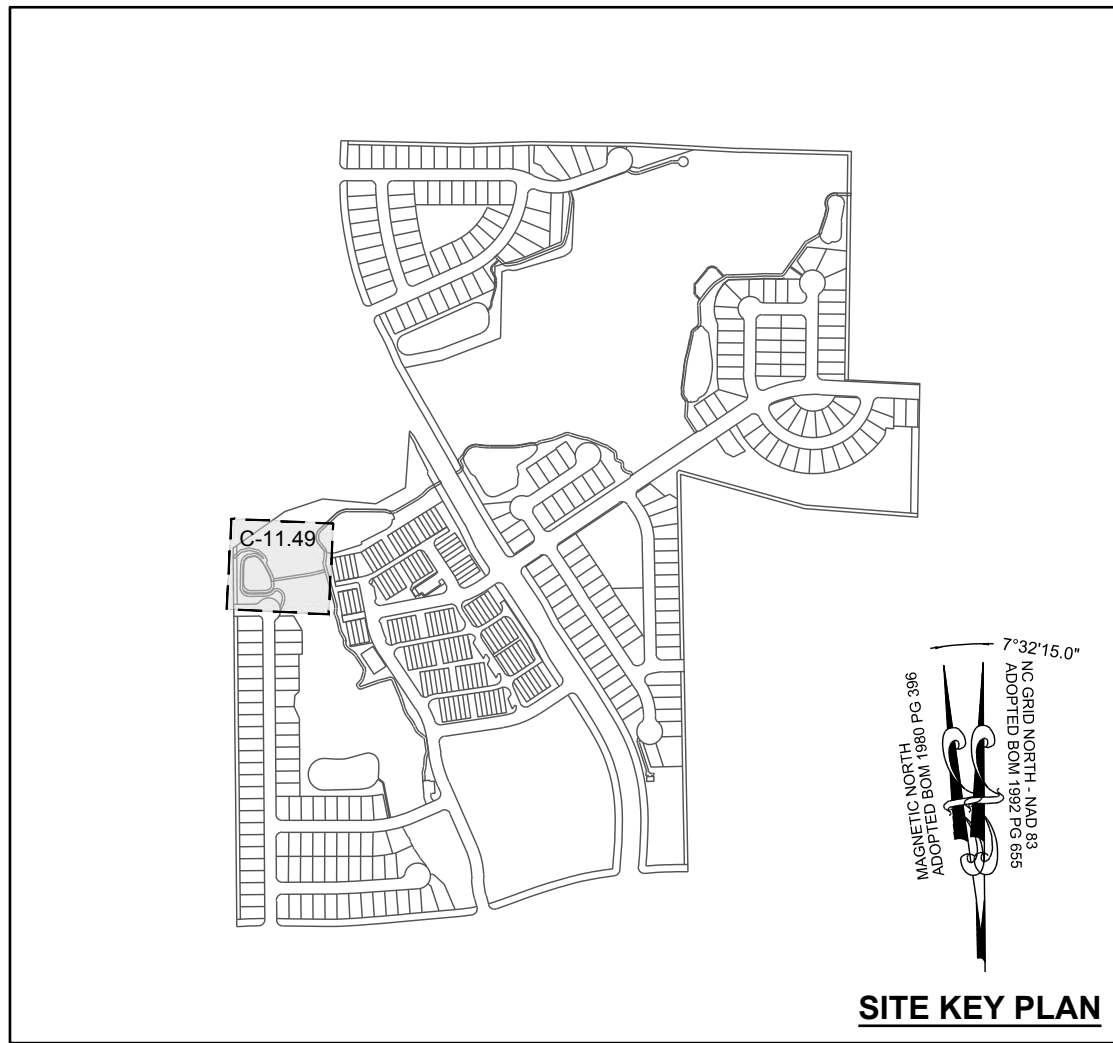


This will not be allowed over our Sanitary Sewer.

SREG Response: The proposed MH has been moved to outside the limits of the boardwalk crossing. The boardwalk crossing is essential to maintain the continuity of the greenway and has been shown with this layout on all preceding submittals, see Sheet C11.49




PUBLIC
WATER DISTRIBUTION / EXTENSION SYSTEM
THE CITY OF RALEIGH CONSENTS TO THE CONNECTION AND EXTENSION OF THE CITY'S PUBLIC WATER SYSTEM AS SHOWN ON THIS PLAN. THE MATERIAL AND CONSTRUCTION METHODS USED FOR THIS PROJECT SHALL CONFORM TO THE STANDARDS AND SPECIFICATIONS OF THE CITY'S PUBLIC UTILITIES HANDBOOK.
CITY OF RALEIGH
PUBLIC UTILITIES DEPARTMENT PERMIT # _____

PUBLIC
SEWER COLLECTION / EXTENSION SYSTEM
THE CITY OF RALEIGH CONSENTS TO THE CONNECTION AND EXTENSION OF THE CITY'S PUBLIC SEWER SYSTEM AS SHOWN ON THIS PLAN. THE MATERIAL AND CONSTRUCTION METHODS USED FOR THIS PROJECT SHALL CONFORM TO THE STANDARDS AND SPECIFICATIONS OF THE CITY'S PUBLIC UTILITIES HANDBOOK.
CITY OF RALEIGH
PUBLIC UTILITIES DEPARTMENT PERMIT # _____

CONSTRUCTION INFRASTRUCTURE DRAWINGS				REVISIONS		DATE	BY
01	CID-24-04	08/04/2024	SREG	No.			
02	TOWN OF ROLESVILLE CID-24-04 V2	11/07/2024	SREG				
03	TOWN OF ROLESVILLE CID-24-04 V3	02/07/2024	SREG				
04	TOWN OF ROLESVILLE CID-24-04 V4	08/02/2025	SREG				
SEAL:							
STRONG ROCK ENGINEERING GROUP, PLLC COMPANY LICENSE # P-2166							
305 CHURCH AT NORTH HILLS STREET, SUITE 1110 RALEIGH, NC 27609 INFORMATION@STRONGROCKGROUP.COM							
RESERVE @ MITCHELL MILL							
TOWN OF ROLESVILLE, WAKE COUNTY, NORTH CAROLINA							
CONSTRUCTION PLANS							
PROPOSED GREENWAY 4 & 5							
- PLAN & PROFILE							
DRAWING SHEET							
C-11.49							
145 OF 227							

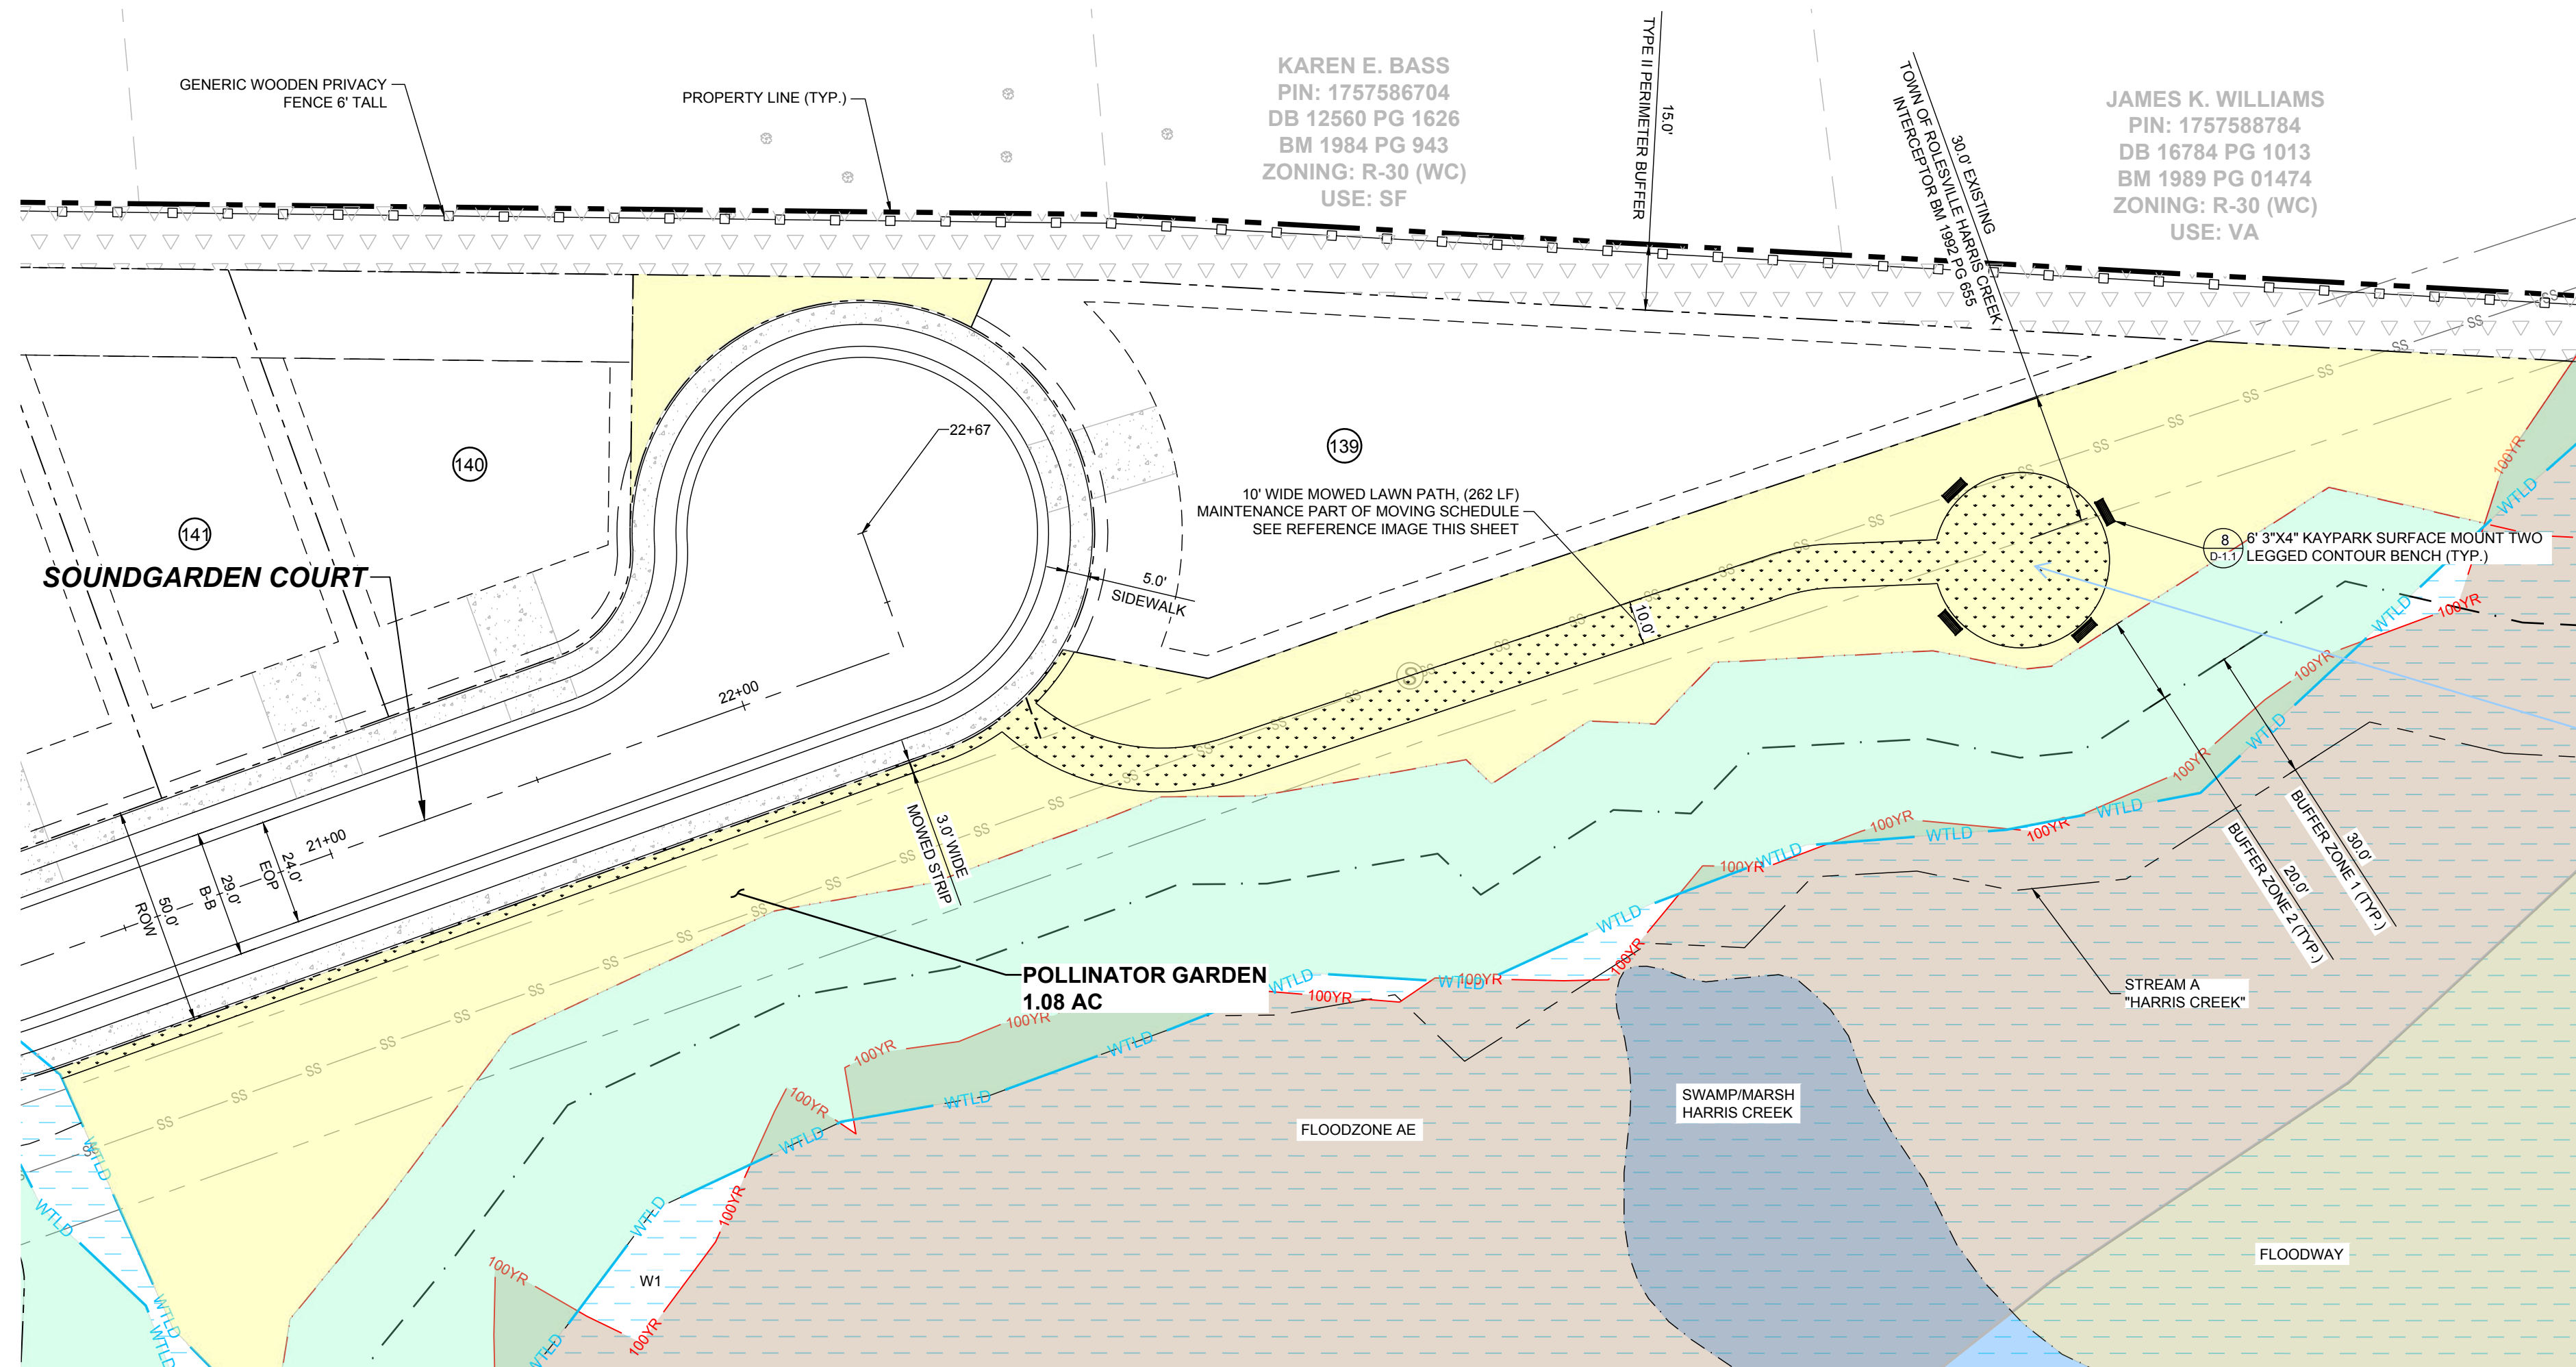

POLLINATOR GARDEN

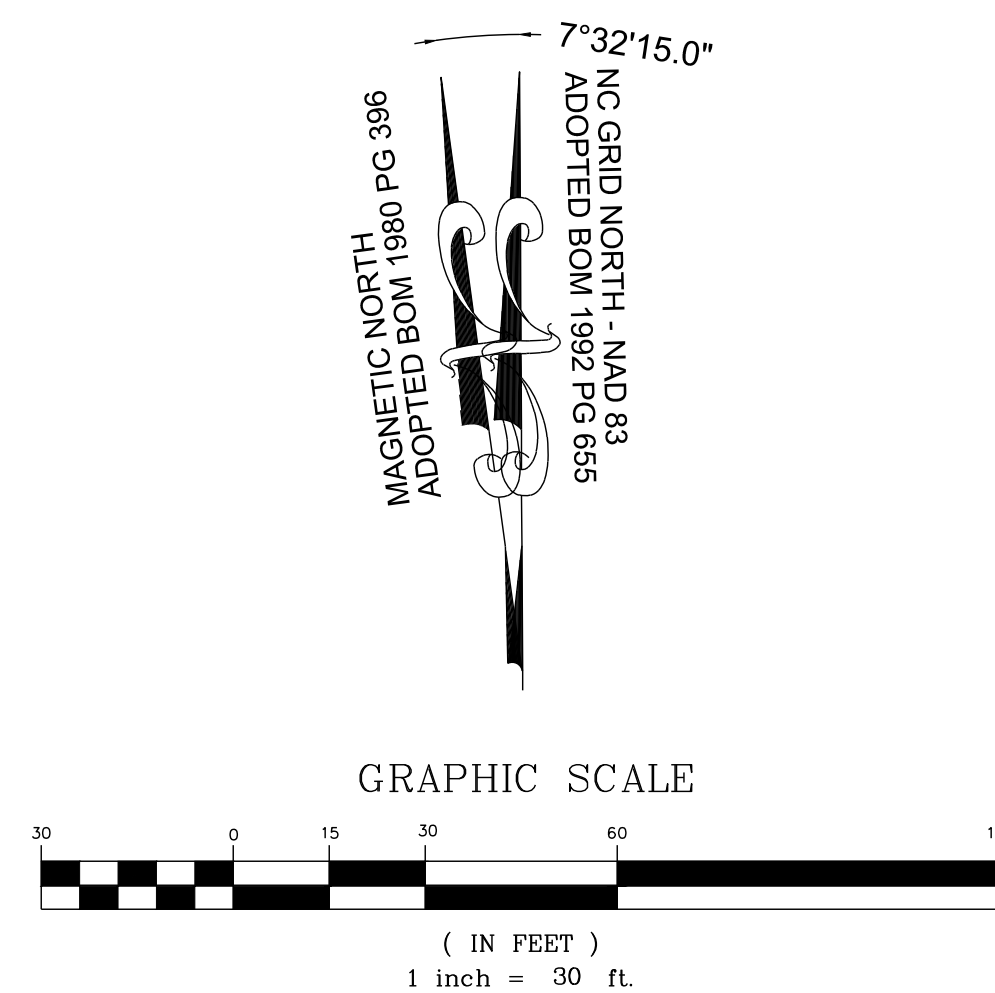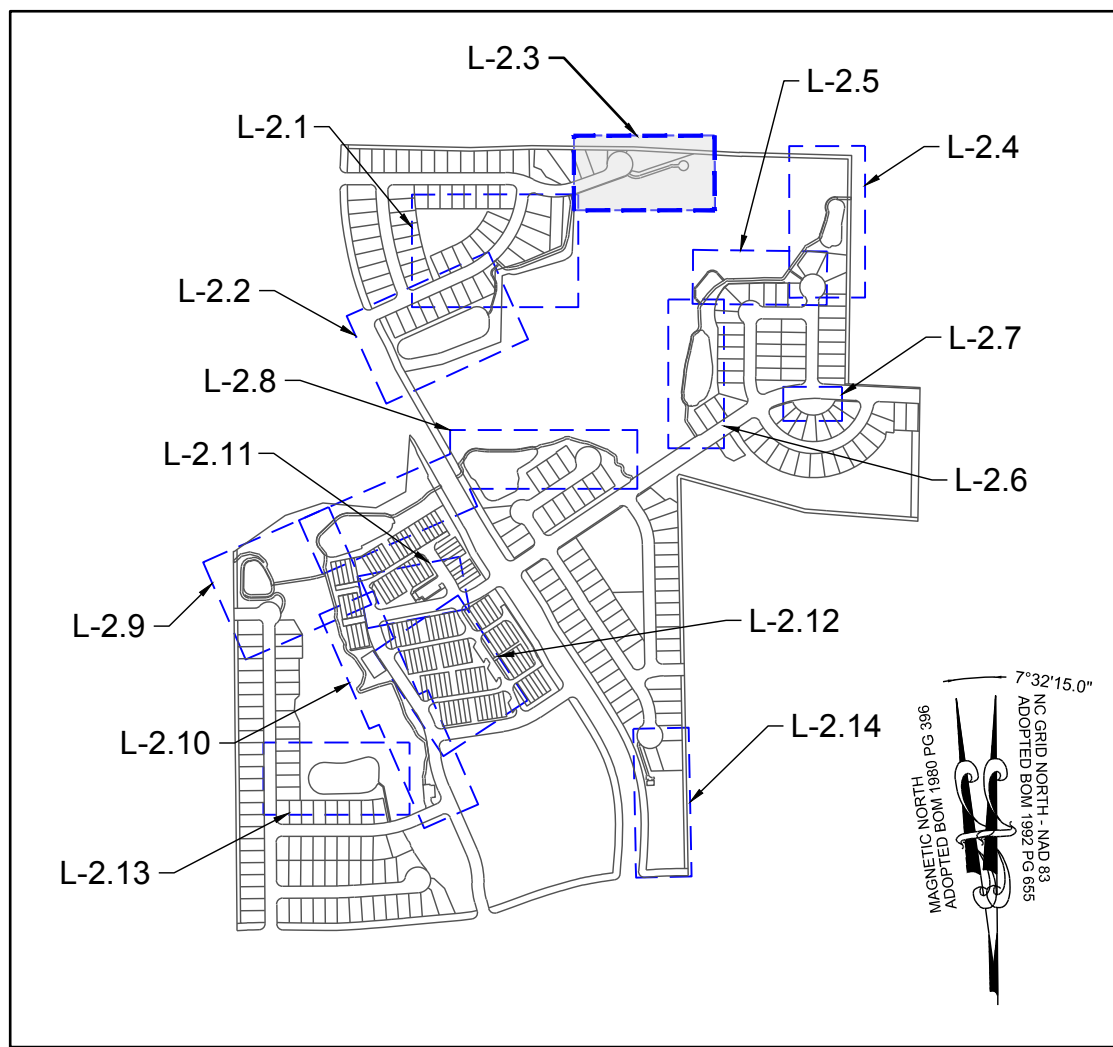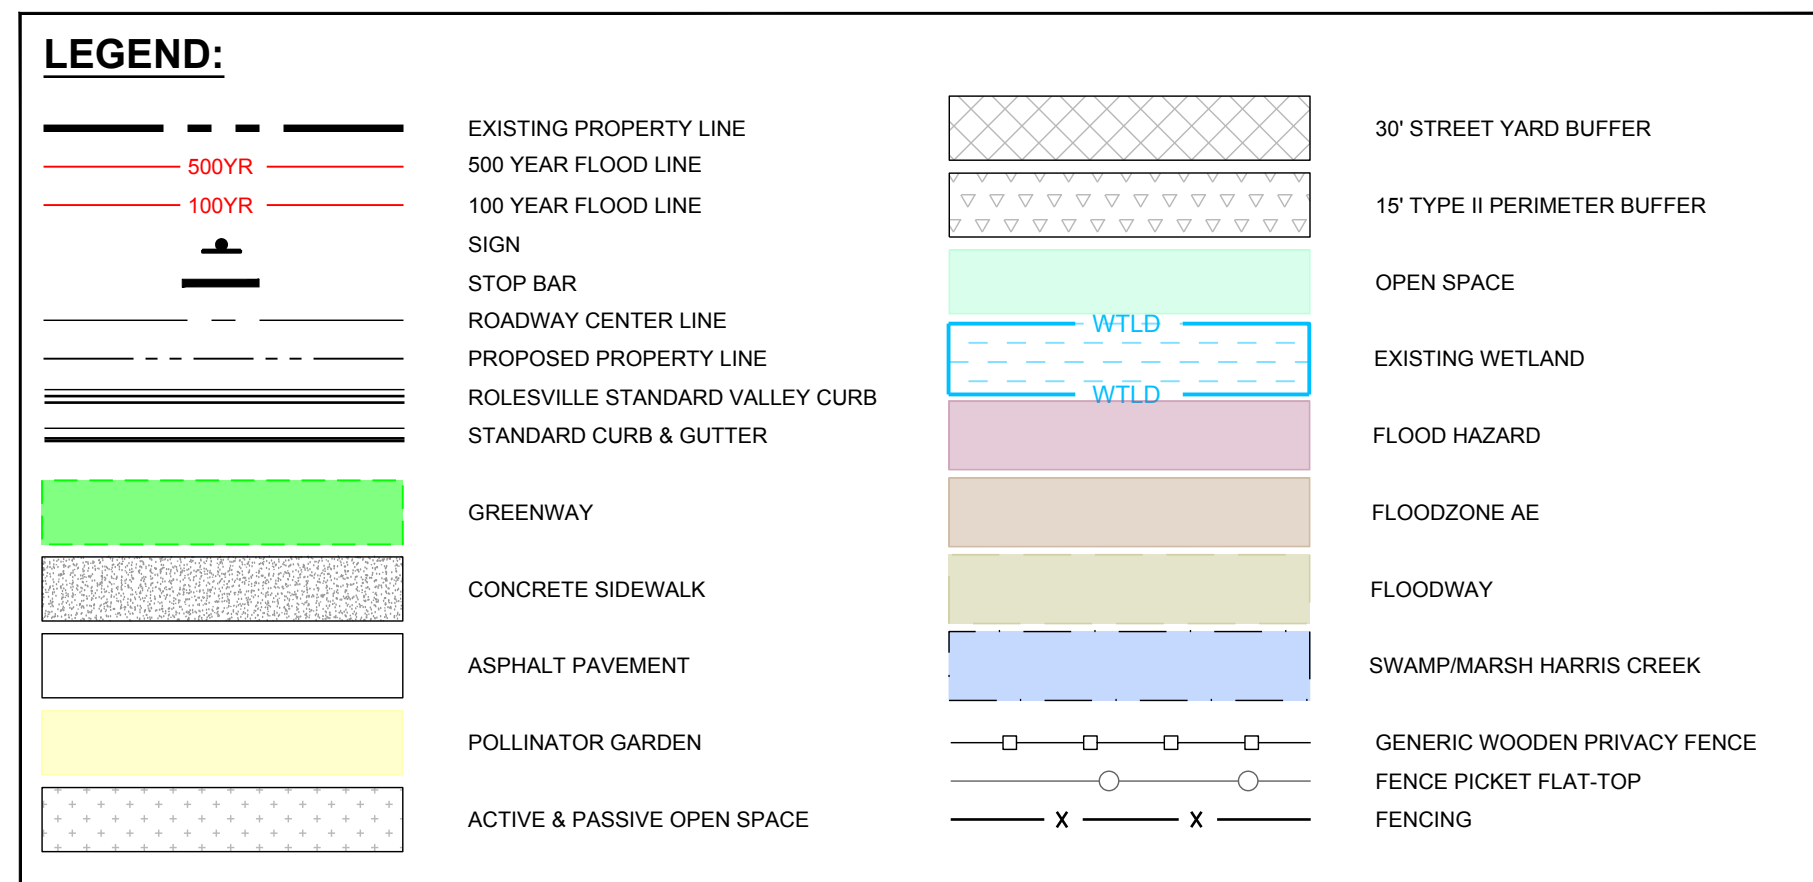

THIS PLANSET AND ANY ASSOCIATED DOCUMENTS ARE PRELIMINARY AND NOT AUTHORIZED FOR CONSTRUCTION UNTIL SIGNED, DATED, AND OFFICIALLY RELEASED FOR CONSTRUCTION BY THE ENGINEER OF RECORD.

SEAL	01	CONSTRUCTION INFRASTRUCTURE DRAWINGS CID-24-04	06/04/2024	SREG
	02	TOWN OF ROLESVILLE CID-24-04 V2	11/01/2024	SREG
	03	TOWN OF ROLESVILLE CID-24-04 V3	02/02/2024	SREG
	04	TOWN OF ROLESVILLE CID-24-04 V4	06/02/2025	SREG
	No	REVISIONS	DATE	BY

STRONG

ENGINEERING GROUP

STRONG ROCK ENGINEERING GROUP, PLLC | COMPANY LICENSE # P-2166
305 CHURCH AT NORTH HILLS STREET, SUITE 1110 RALEIGH, NC 27609 | INFORMATION@STRONGROCKGROUP.COM

STRONG ROCK PROJECT PSP-23-03	NOT FOR CONSTRUCTION	SCALE AS SHOWN	DESIGNED BY SRG	DRAWN BY SRG	CHECKED BY SRG
----------------------------------	-------------------------	----------------	-----------------	--------------	----------------

RESERVE @ MITCHELL MILL
TOWN OF ROLESVILLE, WAKE COUNTY, NORTH CAROLINA

CONSTRUCTION PLANS

POLLINATOR GARDEN

DRAWING SHEET

L-2.3