

RESERVE @ MITCHELL MILL

CONSTRUCTION PLANS

TOWN OF ROLESVILLE, WAKE COUNTY, NORTH CAROLINA

SITE INFORMATION:

LOCATION: 5109 MITCHELL MILL ROAD
COUNTY: WAKE COUNTY
PARENT PIN: 1757571035
DB/PG: DB 8659, PG 954
ZONING: RM-CZ & NC-CZ
TOTAL ACREAGE: 6,041,336 SF (138.69 AC)
NC-CZ ZONE ACREAGE: 54.08 AC
RESIDENTIAL ZONE RM-CZ: 84.61 AC
MAXIMUM UNITS PERMITTED: 395 UNITS (134 TOWNHOMES)
ZONING AND ANNEXATION: MA 22-06 & ANX22-03

BUILDING SETBACKS (MIN) RM-CZ CLUSTER OPTION

FRONT: 20'
SIDE: 5'
REAR: 20'
CORNER: 10'

BUILDING SETBACKS (MIN) NC-CZ

FRONT: 15'
SIDE: 10'
REAR: 10'

TOWNHOME SETBACKS NC-CZ

FRONT 20'
SIDE (STREET FRONTAGE): 10'
REAR: 20'
BUILDING SEPARATION: 30'
PARKING REQUIREMENT: 2.25 CARS PER UNIT
SHOWN UNITS: 118
REQUIRED PARKING: 248
OFF-STREET PARKING: 265

RIGHT OF WAY & OTHER AREAS:

NATURAL WETLANDS: 1,215,431 SF (27.90 AC)

OVERALL & PERIMETER STANDARDS:

SITE PERIMETER BUFFER TYPE 2
THOROUGHFARE BUFFER (JONESVILLE & MITCHELL MILL)

LOT ACREAGE:

NC ZONING DISTRICT

TOTAL NUMBER PROPOSED LOTS: 83 LOTS
MINIMUM PROPOSED LOT SIZE: 5,000 SF
MAXIMUM PROPOSED LOT SIZE: 8,545 SF
MINIMUM LOT WIDTH: 50'
MINIMUM LOT LENGTH: 100'
PROPOSED DENSITY: 4.41 UNITS/AC

MINIMUM COMMERCIAL AREA: 50,000 SF

RM ZONE

TOTAL NUMBER PROPOSED LOTS: 189 LOTS
MINIMUM PROPOSED LOT SIZE: 5,000 SF
MAXIMUM PROPOSED LOT SIZE: 13,548 SF
MINIMUM LOT WIDTH: 50'
PROPOSED DENSITY: 2.23 UNITS/AC

OPEN SPACE BREAKDOWN:

SEE OPEN SPACE CHART PAGES C-6
GREENWAY: 5,335 LF


IMPERVIOUS AREAS:

NC ZONING DISTRICT

BUA: 413,891 SF (9.50 AC)
ROADWAYS & SIDEWALKS: 404,587 SF (9.29 AC)
PONDS: 92,849 SF (2.13 AC)
TOTAL ON-SITE IMPERVIOUS AREA: 953,118 SF (21.88 AC)
TOTAL ON-SITE IMPERVIOUS PERCENT: 40.46%

RM-CZ ZONE

BUA: 625,597 SF (14.36 AC)
ROADWAYS & SIDEWALKS: 476,043 SF (10.93 AC)
PONDS: 134,696 SF (3.09 AC)
TOTAL ON-SITE IMPERVIOUS AREA: 1,247,471 SF (28.64 AC)
TOTAL ON-SITE IMPERVIOUS PERCENT: 33.85%

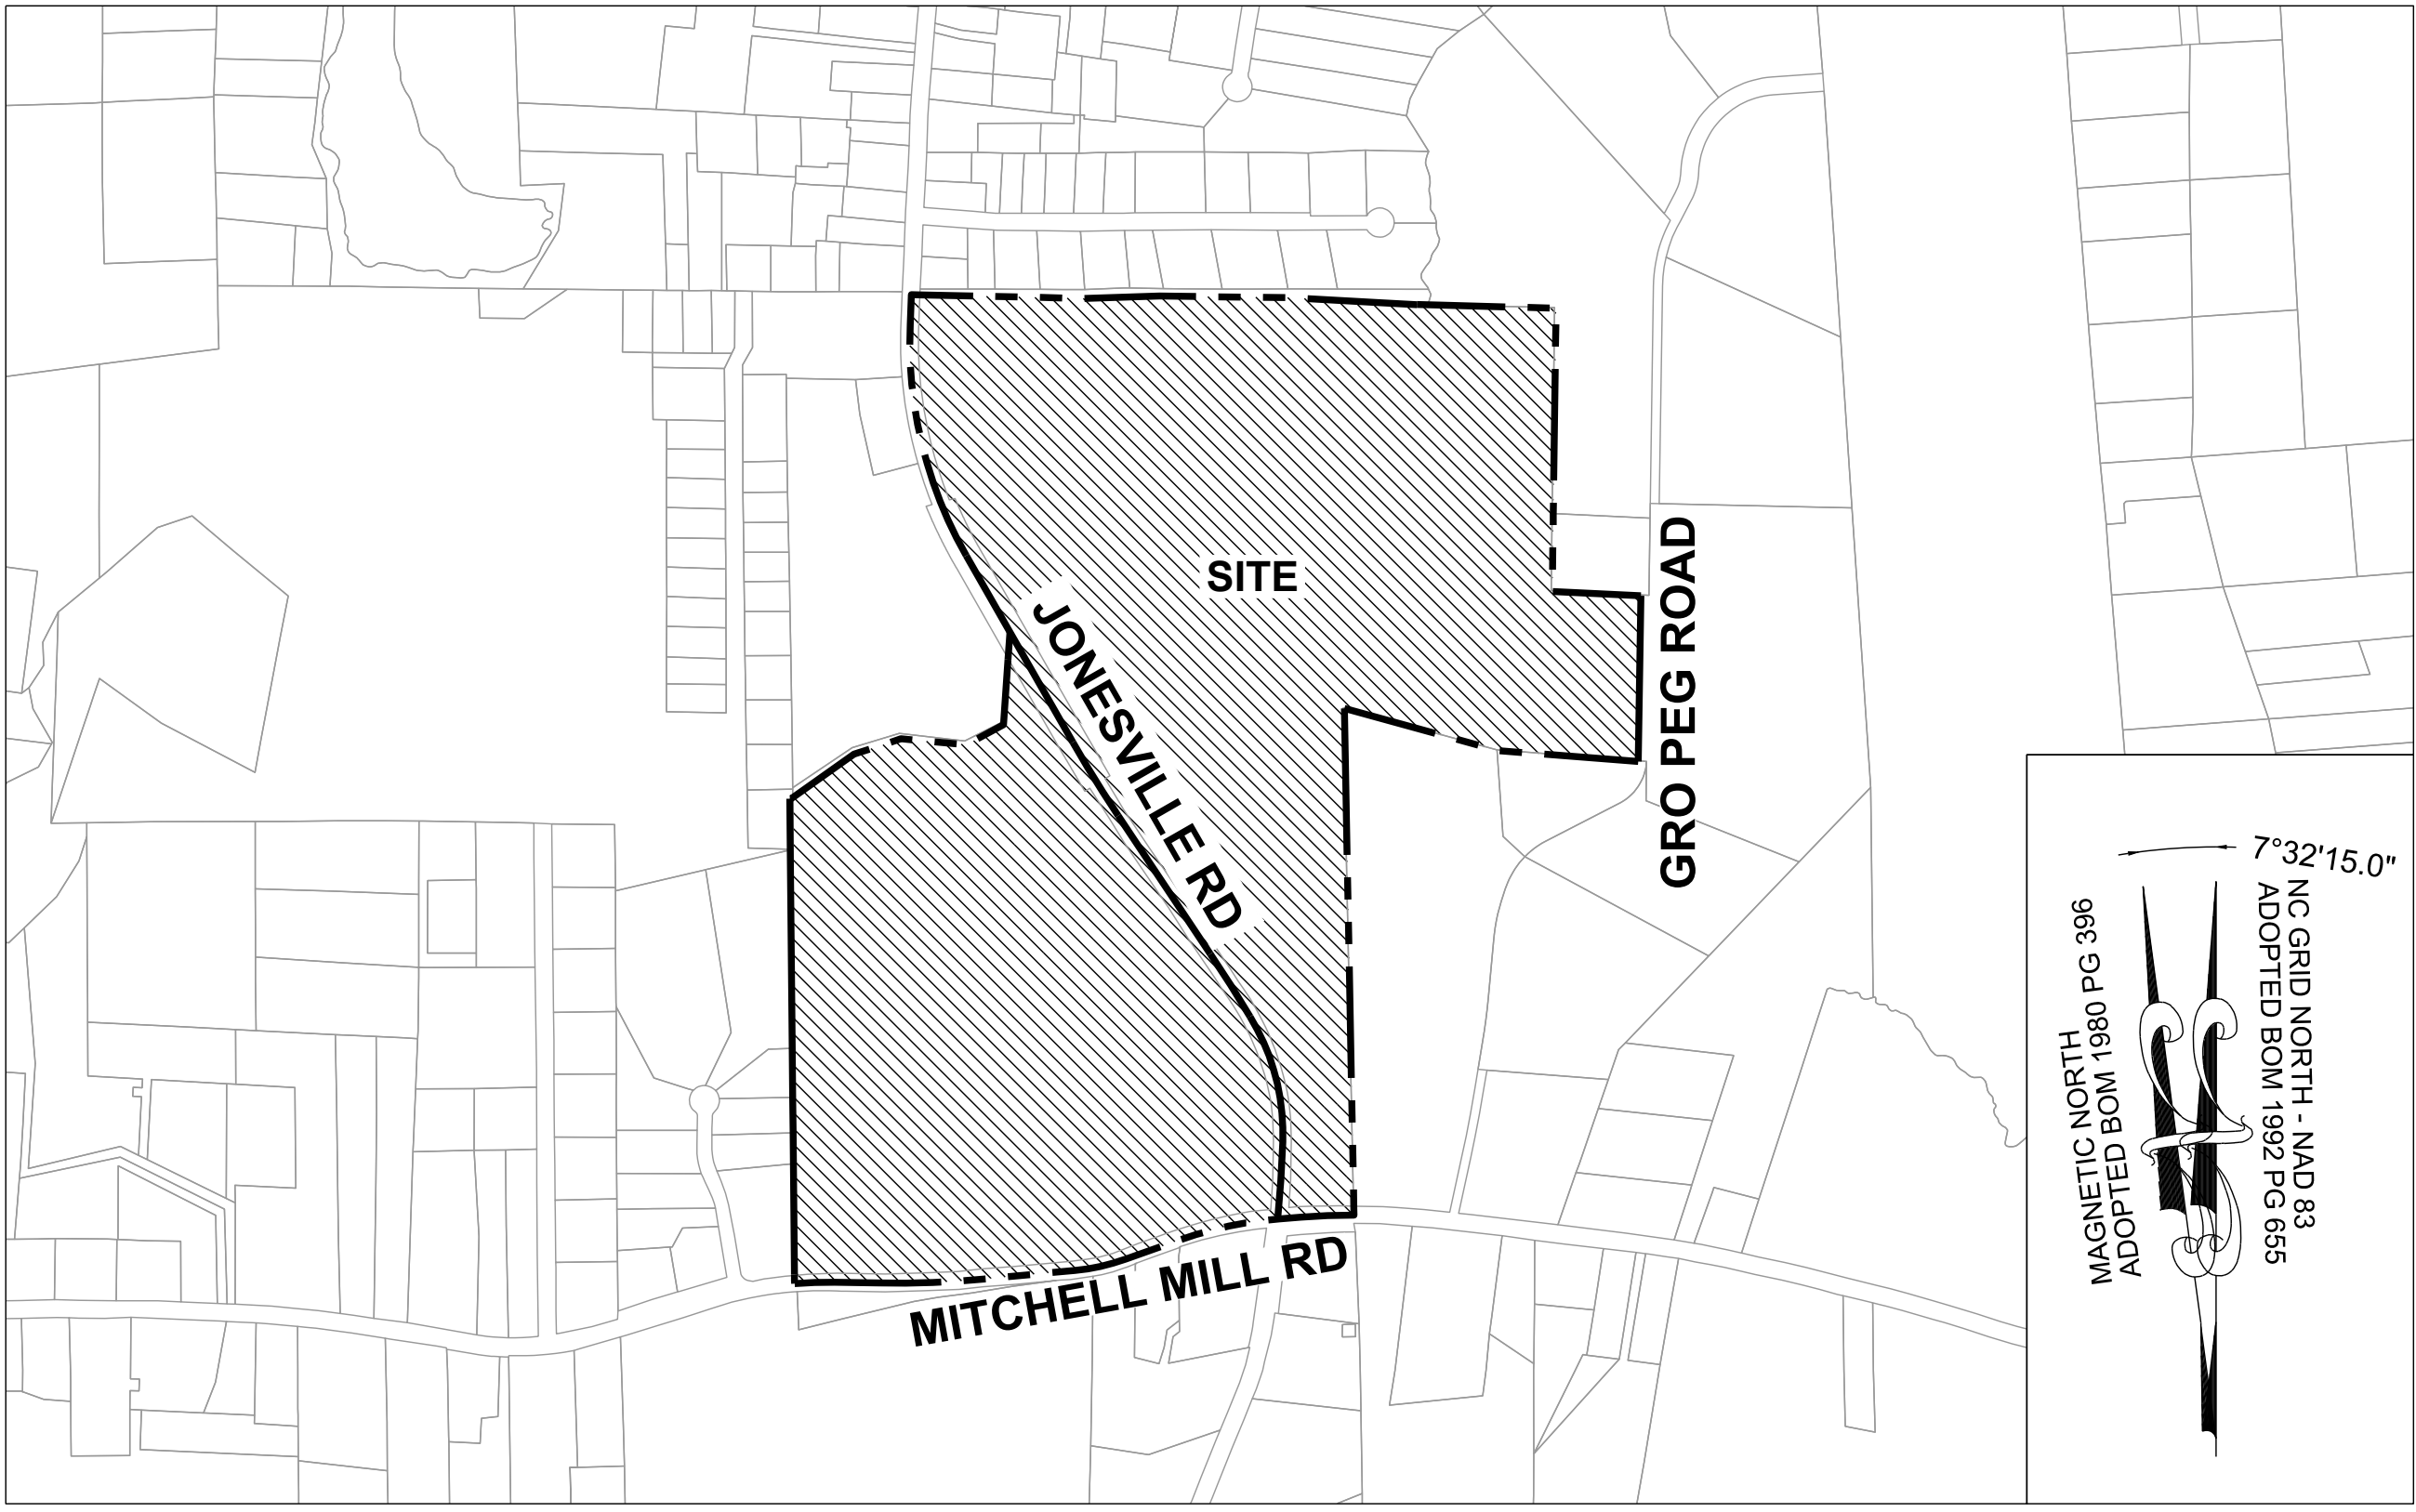

VICINITY MAP

1" = 600'

FRIS MAP # 3720175700K
PANEL # 1757
EFFECTIVE DATE: 07/19/2022

OWNER:

HOPPER COMMUNITIES
CONTACT: BILL HARRELL
BHARRELL@HOPPERCOMMUNITIES.COM

SURVEYOR:

THE TIMMONS GROUP
5410 TRINITY ROAD, Suite 102 | RALEIGH, NC 27607
TEL 919.866.4951

ENVIRONMENTAL CONSULTANT:

SOIL & ENVIRONMENTAL CONSULTANTS
8412 FALLS OF NEUSE RD. SUITE 104
RALEIGH, NC 27615

CIVIL ENGINEERING:

STRONGROCK ENGINEERING GROUP
305 CHURCH AT NORTH HILLS ST, SUITE 1110
RALEIGH, NC 27609
INFORMATION@STRONGROCKGROUP.COM

ATTENTION CONTRACTORS

THE CONTRACTOR RESPONSIBLE FOR THE EXTENSION OF WATER, SEWER, AND/OR REUSE, AS APPROVED IN THESE PLANS, IS RESPONSIBLE FOR CONTACTING THE INFRASTRUCTURE INSPECTIONS DIVISION AND SCHEDULE A PRE-CONSTRUCTION MEETING ON THE DEVELOPMENT PORTAL PRIOR TO BEGINNING ANY CONSTRUCTION. RALEIGH WATER MUST BE CONTACTED AT (919) 996-4540 AT LEAST TWENTY-FOUR HOURS PRIOR TO BEGINNING ANY WORK ACTIVITY AROUND CRITICAL WATER AND SEWER INFRASTRUCTURE.

FAILURE TO NOTIFY CITY DEPARTMENTS IN ADVANCE OF BEGINNING CONSTRUCTION, WILL RESULT IN THE ISSUANCE OF MONETARY FINES, AND REQUIRE REINSTALLATION OF ANY WATER OR SEWER FACILITIES NOT INSPECTED AS A RESULT OF THIS NOTIFICATION FAILURE.

FAILURE TO CALL FOR INSPECTION, INSTALL A DOWNSTREAM PLUG, HAVE PERMITTED PLANS ON THE JOBSITE, OR ANY OTHER VIOLATION OF CITY OF RALEIGH STANDARDS WILL RESULT IN A FINE AND POSSIBLE EXCLUSION FROM FUTURE WORK IN THE CITY OF RALEIGH.

EROSION CONTROL, STORMWATER AND FLOODPLAIN MANAGEMENT

APPROVED
EROSION CONTROL ☐ SEC_
STORMWATER MGMT. ☐ SWF_
FLOOD STUDY ☐ SWF_
DATE _____

ENVIRONMENTAL CONSULTANT SIGNATURE

RALEIGH WATER INSPECTIONS QUANTITIES (SUBDIVISIONS AND SITE PLANS)

PHASE NUMBER(S)	PHASE 1	PHASE 2	PHASE 3	PHASE 4	PHASE 5	PHASE 6
NUMBER OF LOT (S)	63	61	65	0	118	83
NUMBER OF UNITS	63	61	65	0	118	83
PUBLIC WATER (LF)	3,099	3,019	2,733	1,571	3,940	2,781
PUBLIC SEWER (LF)	2,622	2,683	2,706	78	3,253	2,787
PUBLIC FORCE MAIN (LF)	-	-	-	-	-	-
PRIVATE SEWER * (LF)	-	-	-	-	-	-
WATER SERVICE STUBS (QUANTITY)	63	61	65	0	118	83
SEWER SERVICE STUBS (QUANTITY)	63	61	65	0	118	83
AVERAGE DAILY FLOW PER PHASE **	14,175	13,725	14,625	0	26,550	18,675

COMMERCIAL PROJECTS WITH SINGLE WATER AND SEWER SERVICE

FIRE SERVICE (SIZE)					
DOMESTIC METER SIZE					
IRRIGATION METER SIZE					
AVERAGE DAILY FLOW PER PHASE **					

*SEWER MAINS AND MANHOLES AS PART OF A COLLECTION SYSTEM

**ENTIRE PROJECT FLOW, BASED ON 75GPD PER BEDROOM FOR RESIDENTIAL (APARTMENTS, SINGLE FAMILY DWELLING, TOWNHOUSE, CONDOS), OR BASED ON 15A NCAC 027.0114 WASTEWATER DESIGN FLOW RATES FOR COMMERCIAL AND INDUSTRIAL

THE METER SIZE MUST MATCH DOMESTIC SERVICE SIZE (EXEMPTION - 3/4" SERVICE TAP WITH 5/8" METER)

PUBLIC

WATER DISTRIBUTION / EXTENSION SYSTEM

THE CITY OF RALEIGH CONSENTS TO THE CONNECTION AND EXTENSION OF THE CITY'S PUBLIC WATER SYSTEM AS SHOWN ON THIS PLAN. THE MATERIAL AND CONSTRUCTION METHODS USED FOR THIS PROJECT SHALL CONFORM TO THE STANDARDS AND SPECIFICATIONS OF THE CITY'S PUBLIC UTILITIES HANDBOOK.

CITY OF RALEIGH
PUBLIC UTILITIES DEPARTMENT PERMIT # _____

PUBLIC

SEWER COLLECTION / EXTENSION SYSTEM

THE CITY OF RALEIGH CONSENTS TO THE CONNECTION AND EXTENSION OF THE CITY'S PUBLIC SEWER SYSTEM AS SHOWN ON THIS PLAN. THE MATERIAL AND CONSTRUCTION METHODS USED FOR THIS PROJECT SHALL CONFORM TO THE STANDARDS AND SPECIFICATIONS OF THE CITY'S PUBLIC UTILITIES HANDBOOK.

CITY OF RALEIGH
PUBLIC UTILITIES DEPARTMENT PERMIT # _____

SHEET INDEX		
01	C-1.0	COVER SHEET
02	C-1.1	ZONING CONDITION
03	C-2.0	CIVIL NOTES
04	C-3.0	EXISTING CONDITIONS PLAN
05	C-3.1	OVERALL TREE INVENTORY MAP
06 - 12	C-3.2 - C-3.8	PARTIAL TREE INVENTORY MAP I - VII
13	C-3.9	TREE INVENTORY TABLE
14	C-3.10	TREE PROTECTION PLAN
15	C-4.0	DEMOLITION PLAN
16	C-5.0	PHASING PLAN
17	C-5.1	BLOCK AND LOT PLAN
18	C-6.0	OVERALL SITE PLAN
19 - 27	C-6.1 - C-6.9	PARTIAL SITE PLAN I - IX
28	C-6.10	LOT SIZE TABLES
29	C-6.11	SITE TABLES - NC ZONE
30	C-6.12	SITE TABLES - RM ZONE
31	C-7.0	OVERALL OPEN SPACE NC-CZ
32	C-7.1	PASSIVE & ACTIVE OPEN SPACE NC-CZ ZONE
33	C-7.2	OVERALL OPEN SPACE RM-CZ
34	C-7.3	PASSIVE & ACTIVE OPEN SPACE RM-CZ ZONE
35	C-8.0	OVERALL UTILITY PLAN
36 - 44	C-8.1 - C-8.9	PARTIAL UTILITY PLAN I - IX
45	C-8.10	SEWER TABLES
46	C-8.11	OFF-SITE UTILITY PLAN
47	C-9.0	OVERALL GRADING AND DRAINAGE PLAN
48 - 56	C-9.1 - C-9.9	PARTIAL GRADING AND DRAINAGE PLAN I - IX
57 - 58	C-9.10 - C-9.11	STORM DRAINAGE TABLES
59	C-10.0	EROSION CONTROL NOTES
60	C-10.1	EROSION CONTROL PLAN OVERALL PHASE 1 - STAGE 1
61	C-10.2	EROSION CONTROL PLAN OVERALL PHASE 1 - STAGE 1
62	C-10.3	EROSION CONTROL PLAN OVERALL PHASE 1 - STAGE 2
63	C-10.4	EROSION CONTROL PLAN OVERALL PHASE 1 - STAGE 2
64	C-10.5	EROSION CONTROL PLAN OVERALL PHASE 1 - STAGE 3
65	C-10.6	EROSION CONTROL PLAN OVERALL PHASE 1 - STAGE 3
66	C-10.7	EROSION CONTROL PLAN OVERALL PHASE 2 - STAGE 1
67	C-10.8	EROSION CONTROL PLAN OVERALL PHASE 2 - STAGE 1

SHEET INDEX		
68	C-10.9	EROSION CONTROL PLAN OVERALL PHASE 2 - STAGE 2
69	C-10.10	EROSION CONTROL PLAN OVERALL PHASE 2 - STAGE 2
70	C-10.11	EROSION CONTROL PLAN OVERALL PHASE 2 - STAGE 3
71	C-10.12	EROSION CONTROL PLAN OVERALL PHASE 2 - STAGE 3
72	C-10.13	EROSION CONTROL PLAN OVERALL PHASE 3 - STAGE 1
73	C-10.14	EROSION CONTROL PLAN OVERALL PHASE 3 - STAGE 1
74	C-10.15	EROSION CONTROL PLAN OVERALL PHASE 3 - STAGE 2
75	C-10.16	EROSION CONTROL PLAN OVERALL PHASE 3 - STAGE 2
76	C-10.17	EROSION CONTROL PLAN OVERALL PHASE 3 - STAGE 3
77	C-10.18	EROSION CONTROL PLAN OVERALL PHASE 3 - STAGE 3
92	C-10.33	EROSION CONTROL PLAN OVERALL PHASE 6 - STAGE 2
93	C-10.34	EROSION CONTROL PLAN OVERALL PHASE 6 - STAGE 2
94	C-10.35	EROSION CONTROL PLAN OVERALL PHASE 6 - STAGE 3
95	C-10.36	EROSION CONTROL PLAN OVERALL PHASE 6 - STAGE 3
96	C-11.0	PROPOSED PENDULUM STREET - PLAN & PROFILE
97	C-11.1	PROPOSED YELLOW MOON COURT - PLAN & PROFILE
98	C-11.2	PROPOSED EVEN FLOW LANE - PLAN & PROFILE
99 - 100	C-11.3 - C-11.4	PROPOSED OCEANS COURT - PLAN & PROFILE
101	C-11.5	PROPOSED MCCREARY COURT - PLAN & PROFILE
102	C-11.6	PROPOSED VEDDER LANE & BETTERMAN DRIVE - PLAN & PROFILE
103 - 104	C-11.7 - C-11.8	PROPOSED LIGHTING BOLT LANE - PLAN & PROFILE
105	C-11.9	PROPOSED GIGATON STREET - PLAN & PROFILE
106	C-11.10	PROPOSED COUNTER STREET - PLAN & PROFILE
107	C-11.11	PROPOSED UNPLUGGED AVENUE - PLAN & PROFILE
108	C-11.12	PROPOSED SUPERSONIC WAY - PLAN & PROFILE
109	C-11.13	PROPOSED LUKIN LANE - PLAN & PROFILE
110	C-11.14	PROPOSED PARACHUTE PLACE - PLAN & PROFILE
111	C-11.15	PROPOSED CORNELL GARDEN STREET - PLAN & PROFILE
112	C-11.16	PROPOSED FUTURE DAYS WAY - PLAN & PROFILE
113 - 114	C-11.17 - C-11.18	PROPOSED SOUNDGARDEN COURT - PLAN & PROFILE
115	C-11.19	PROPOSED MONKEYWRENCH STREET - PLAN & PROFILE
116	C-11.20	PROPOSED MOOKIE ALLEY - PLAN & PROFILE
117	C-11.21	PROPOSED DARK MATTER ALLEY - PLAN & PROFILE
118	C-11.22	PROPOSED CAMERON SOUND ALLEY - PLAN & PROFILE
119	C-11.23	PROPOSED PEARL JAM ALLEY - PLAN & PROFILE
120	C-11.24	PROPOSED GUARANTEED ALLEY - PLAN & PROFILE
121 - 125	C-11.25 - C-11.29	OFF-SITE JONESVILLE RD - PLAN & PROFILE
126 - 128	C-11.30 - C-11.32	OFF-SITE MITCHELL MILL RD - PLAN & PROFILE
129 - 136	C-11.33 - C-11.40	OFF-SITE WATER MAIN - PLAN & PROFILE
137 - 138	C-11.41 - C-11.42	ON-SITE SANITARY SEWER - PLAN & PROFILE
139	C-11.43	MULTI USE ASPHALT PATH - PLAN & PROFILE
140 - 141	C-11.44 - C-11.45	PROPOSED GREENWAY 1 - PLAN & PROFILE
142 - 143	C-11.46 - C-11.47	PROPOSED GREENWAY 2 - PLAN & PROFILE
144	C-11.48	PROPOSED GREENWAY 2 & 3 - PLAN & PROFILE
145	C-11.49	PROPOSED GREENWAY 4 & 5 - PLAN & PROFILE
146	L-1.0	OVERALL LANDSCAPE PLAN
147 - 155	L-1.1 - L-1.9	PARTIAL LANDSCAPE PLAN I - IX
156	L-2.0	OVERALL AMENITIES PLAN
157	L-2.1	BALLFIELD & SMALL IPMA PLAYGROUND PLAN
158	L-2.2	PRIMITIVE TRAIL
159	L-2.3	POLLINATOR GARDEN
160	L-2.4	GREENWAY PLAN
161	L-2.5	PARKOUR COURSE & GREENWAY PLAN
162	L-2.6	GREENWAY PLAN
163	L-2.7	SMALL IPMA PLAYGROUND PLAN
164	L-2.8	GREENWAY PLAN
165	L-2.9	GREENWAY PLAN
166	L-2.10	BASKETBALL COURT & GREENWAY PLAN
167	L-2.11	POCKET PARK II PLAN
168	L-2.12	POCKET PARK I PLAN
169	L-2.13	NEIGHBOURHOOD PARK PLAN
170	L-2.14	CRICKET PITCH PLAN
171 - 177	L-3.0 - L-3.6	PLANTING SC# 1 - SC#8
178	L-12.0	OVERALL PRESERVATION PLAN
179 - 186	C-12.1 - C-12.8	PRESERVATION PLAN I - VIII
187	C-12.9	PRESERVATION PLAN TABLES
188	C-13.0	OVERALL SIGNAGE & PAVEMENT MARKING PLAN
189 - 197	C-13.1 - C-13.9	PARTIAL SIGNAGE & PAVEMENT MARKING PLAN I - IX
198 - 202	D-1.0 - D-1.4	AMENITIES DETAILS
203 - 206	D-2.0 - D-2.3	SITE DETAILS
207 - 215	D-3.0 - D-3.8	STORMWATER CONTROL MEASURE "1" - "8"
216 - 217	D-3.9 - D-3.10	STORM DRAINAGE DETAILS
218 - 219	D-4.0 - D-4.1	SANITARY SEWER DETAILS
220 - 221	D-5.0 - D-5.1	WATER DETAILS
222 - 227	D-6.0 - D-6.5	EROSION CONTROL PLAN DETAILS

THIS PLANSET AND ANY ASSOCIATED DOCUMENTS ARE PRELIMINARY AND NOT AUTHORIZED FOR CONSTRUCTION UNTIL SIGNED, DATED, AND OFFICIALLY RELEASED FOR CONSTRUCTION BY THE ENGINEER OF RECORD.



Know what's below.
Call before you dig.

CONDITIONS OF APPROVAL:

A WATER MODEL WILL BE REQUIRED TO BE COMPLETED BY THE PROJECT ENGINEER TO DEMONSTRATE THAT THE PROPOSED WATERLINE EXTENSION WILL PROVIDE ADEQUATE FIRE FLOW AND PRESSURE FOR THE PROPOSED DEVELOPMENT.

CONSTRUCTION INFRASTRUCTURE DRAWINGS
CID-24-04

08/04/2024
11/07/2024
02/07/2024
08/02/2025

SRG
SRG
SRG
SRG

01
02
03
04

DATE

REVISIONS

BY

STRONGROCK

ENGINEERING GROUP

STRONG ROCK ENGINEERING GROUP, PLLC | COMPANY LICENSE # P-2766
305 CHURCH AT NORTH HILLS STREET, SUITE 1110 RALEIGH, NC 27609 | INFORMATION@STRONGROCKGROUP.COM

RESERVE @ MITCHELL MILL
TOWN OF ROLESVILLE, WAKE COUNTY, NORTH CAROLINA

CONSTRUCTION PLANS
COVER SHEET

DRAWING SHEET

C-1.0

01 OF 227

EXHIBIT D
MIXED-USE NEIGHBORHOOD CENTER CONDITIONAL
ZONING
DISTRICT (NC-CZ) AND RESIDENTIAL MEDIUM
DENSITY CONDITIONAL ZONING DISTRICT (RM-CZ)
ZONING CONDITIONS

Conditions Applicable to the entire property:

- The subject property shall be developed generally in accordance with the sketch plan attached hereto as **Exhibit 1** and incorporated herein as if fully set out. The approximately 55+ acre portion of the subject property located west of Jonesville Road and further described as Parcel 1 on the attached **Exhibit 2** attached hereto shall be zoned NC-CZ and the approximately 65+ acre portion of the property located east of Jonesville Road and further described as Parcel 2 on **Exhibit 2** attached hereto shall be zoned RM-CZ. The improvements described herein may be developed in phase in accordance with a phasing plan approved by the Town of Rolesville.
- The total number of dwellings on the subject property shall not exceed 395 dwelling units and no more than 134 of these dwelling units shall be permitted to be Dwellings, Single Family, Attached (Townhouse.)
- Mixture of Uses:** At least 50,000 square feet of non-residential building area shall be permitted (issuance of a building permit) prior to permitting (issuance of a building permit) more than 197 dwelling units.
- Additional Donations:**
 - Prior to the issuance of the first building permit for a dwelling unit, the property owner shall donate Sixty Thousand Dollars and No Cents (\$60,000.00) to Homes for Heroes.
 - Prior to the issuance of the 200th building permit, the property owner shall donate one (1) Dwelling, Single Family, Attached (Townhouse) to Passage Homes, CASA, Habitat for Humanity of Wake County or other similar organization providing homes to low-income people.
- Pollinator Plantings:**

At least twenty percent (20%) of the landscaping planted in common areas on the subject property shall utilize plant materials that are listed as Native Pollinator Plants on North Carolina Wildlife Federation (NCWF) or other resources for native plants recommended by the NCWF on their website, currently found at <https://ncwf.org/habitat/native-plant-catalog/>. Where evergreen plantings or street trees are required by the Rolesville Land Development Ordinance as the same may be amended from time to time, pollinator plantings shall not be required. Nothing herein shall be construed to limit the plant materials permitted on individual residential lots. Compliance with this condition shall be demonstrated at construction infrastructure drawings for each phase.
- Recreational Amenities:**

The following recreational amenities shall be provided generally as shown on the attached Exhibit 1 as a part of the development of the subject property and dedicated to the Homeowner's Association except for those areas offered to and accepted by the Town of Rolesville:

 - A swimming pool and cabana, including changing rooms and restrooms shall be constructed prior to the issuance of the 150th building permit for a dwelling unit.
 - At least one fenced playground shall be constructed prior to the issuance of the 150th building permit for a dwelling unit.
 - At least one fenced dog park shall be constructed prior to the issuance of the 150th building permit for a dwelling unit.
 - Public greenway on a greenway easement dedicated to the Town of Rolesville with paved trails at least ten feet wide (10') shall be constructed generally as shown on the attached Exhibit 1.
 - A greenway trail head with at least four (4) parking spaces shall be constructed generally as shown on Exhibit 1 and offered to the Town of Rolesville for use as a greenway trail head prior to the issuance of the 200th building permit for a dwelling unit. The Town of Rolesville may accept or reject the offer of dedication in its sole discretion prior to the issuance of the 250th building permit. If the Town of Rolesville accepts dedication of this trailhead, the area dedicated to the Town of Rolesville shall be conveyed to this project as active open space. If the Town of Rolesville does not accept or reject the dedication of this area in writing prior to issuance of the 250th building permit, it shall be dedicated to the homeowner's association.
 - At least one (1) community garden shall be provided prior to issuance of the 338th building permit for a dwelling unit; and
 - At least one (1) acre of undeveloped land in the area located at the northeast quadrant of the intersection of Jonesville Road and Mitchell Mill Road shall be offered to the Town of Rolesville generally as shown on the attached Exhibit 1 for

- recreational uses prior to the issuance of the 150th building permit for a dwelling unit. The Town of Rolesville may accept or reject the offer of dedication in its sole discretion prior to the issuance of the 200th building permit. If the Town of Rolesville accepts dedication of this property, the area dedicated to the Town of Rolesville shall be conveyed to this project as active open space. If the Town of Rolesville does not accept or reject the dedication of this area in writing prior to the issuance of the 200th building permit, it shall be dedicated to the homeowner's association.
- 7. Additional Driveway Access and Crossover to Commercial Area:**
Prior to the issuance of the first building permit, the property owner shall apply to NCDOT to allow the installation of an additional driveway access and cross-walk across Jonesville Road from the property zoned RM-CZ to the commercial area located in the northwest quadrant of the intersection of Mitchell Mill Road and Jonesville Road, both as generally shown as "Potential Additional Driveway and Cross Walk Connection Per Condition #7 of Zoning Conditions" on Exhibit 1. The application to NCDOT shall include a plan for the driveway connection and crossover drawn by an engineer and an update to the existing traffic impact analysis prepared by a traffic engineer. If NCDOT approves such a crossover and/or driveway access, the property owner shall install them in accordance with the requirements of NCDOT.
- 8. Transportation Improvements:**
To address transportation impacts reasonably expected to be generated by the development, the following road improvements shall be installed in accordance with future phasing plans approved by the Town:
- Jonesville Road:**
 - Widen Jonesville Road along the site frontage between Site Access 1 and Mitchell Mill to the roadway's ultimate cross section per Rolesville Community Transportation Plan, 2 lanes with two-way left turn lanes.
 - Mitchell Mill Road:**
 - Widen one-half section along the site frontage to this roadway's ultimate cross section per the Rolesville Community Transportation Plan, 4-lane median divided.
 - Mitchell Mill Road and Jonesville Road/Pebbles Road:**
 - Provide a southbound (Jonesville Road) left turn lane with at least 100 feet of storage and appropriate decel and taper; and
 - Construct an eastbound (Mitchell Mill Road) left-turn lane with at least 100 feet of storage and appropriate decel and taper.
 - Jonesville Road and Site Access 1:**
 - Construct the westbound approach (Site Access 1) with one ingress lane and one egress lane;
 - Provide stop-control for westbound approach (Site Access 1); and
 - Construct a southbound (Jonesville Road) left-turn lane with at least 100 feet of storage and appropriate decel and taper.
 - Jonesville Road and Site Access 2:**
 - Construct the westbound approach (Site Access 2) with one ingress lane and one egress lane;
 - Provide stop-control for westbound approach (Site Access 2); and
 - Construct a southbound (Jonesville Road) left-turn lane with at least 100 feet of storage and appropriate decel and taper.
 - Jonesville Road and Site Access 3:**
 - Construct the eastbound and westbound approaches (Site Access 3) with one ingress lane and one egress lane;
 - Provide stop-control for eastbound and westbound approach (Site Access 3);
 - Construct northbound (Jonesville Road) left-turn lane with at least 100 feet of storage and appropriate decel and taper;
 - Construct northbound (Jonesville Road) right-turn lane with at least 100 feet of storage and appropriate decel and taper;
 - Construct a southbound (Jonesville Road) left-turn lane with at least 100 feet of storage and appropriate decel and taper; and
 - Construct a southbound (Jonesville Road) right-turn lane with at least 100 feet of storage and appropriate decel and taper.
 - Jonesville Road and Site Access 4:**
 - Construct the eastbound approach (Site Access 4) with one ingress lane and one egress lane;
 - Provide stop-control for eastbound approach (Site Access 4);
 - Provide a northbound (Jonesville Road) left-turn lane with at least 100 feet of storage and appropriate decel and taper; and
 - Provide a southbound (Jonesville Road) right-turn lane with at least 100 feet of storage and appropriate decel and taper.
 - Mitchell Mill and Site Access 5:**
 - Construct the southbound approach (Site Access 5) with one ingress lane and one egress lane;
 - Provide stop-control for southbound approach (Site Access 5) restricted to right in, right-out operations unless left-turn access is approved by NCDOT; and
 - Construct an exclusive westbound (Mitchell Mill Road) right-turn lane with at least 100 feet of storage and appropriate decel and taper.
 - Mitchell Mill and Site Access 6:**
 - Construct the southbound approach (Site Access 6) with one ingress lane and

- one egress lane striped as an exclusive right-turn lane; and
 - Provide stop-control for southbound approach (Site Access 6) restricted to right in, right-out operations.
- l. Mitchell Mill and Site Access 7:**
 - Construct the southbound approach (Site Access 7) with one ingress lane and one egress lane;
 - Provide stop-control for southbound approach (Site Access 7); and
 - Construct an exclusive eastbound (Mitchell Mill Road) left-turn lane with at least 100 feet of storage and appropriate decel and taper.
- k. Mitchell Mill Road and Site Access 8:**
 - Construct the southbound approach (Site Access 8) with one ingress lane and one egress lane striped as an exclusive right-turn lane;
 - Provide stop-control for southbound approach (Site Access 8). This proposed intersection will be restricted to right-in/right-out operations; and
 - Construct an exclusive westbound (Mitchell Mill Road) right-turn lane with at least 100 feet of storage and appropriate decel and taper.
- l. Signal Analysis and Funding:**
 - US 401 Bypass and Jonesville Road:** Conduct a full signal warrant analysis prior to full build-out of the proposed development and install a traffic signal if warranted and approved by the Town and NCDOT. Nothing herein shall prohibit the property owner or developer from entering into cost-sharing agreements with others who may also benefit from a signal at this location.
 - US 401/Bypass and Eastern U-turn Location:** Conduct a full signal warrant analysis prior to full build-out of the proposed development and install a traffic signal if warranted and approved by the Town and NCDOT. Nothing herein shall prohibit the property owner or developer from entering into cost-sharing agreements with others who may also benefit from a signal at this location.
 - Jonesville and Mitchell Mill Road:** Conduct a full signal warrant analysis prior to full build-out of the proposed development and install a traffic signal if warranted and approved by the Town and NCDOT. Nothing herein shall prohibit the property owner or developer from entering into cost-sharing agreements with others who may also benefit from a signal at this location.
 - If no traffic signal has been warranted and approved by the Town and NCDOT at any of the locations identified in Condition 8)(i)-(iii) at full build-out of the proposed development (issuance of certificate of occupancy for the 300th dwelling unit and 50,000 square feet of non-residential uses), the property owner shall contribute Fifty Thousand Dollars (\$50,000.00) to the Town of Rolesville to be used by the Town of Rolesville to install a traffic light at any one of the locations identified in Condition 8)(i)-(iii) above when warranted and approved by NCDOT.

- Conditions Applicable to Dwelling, Single Family, Detached only:
- All homes shall include either crawl space foundations or stem wall foundations. Any stem wall foundations shall be at least eighteen inches (18") in height across the front facade of the home and shall have brick or stone veneer on all sides facing a public street.
 - The minimum building square footage shall be 2,000 square feet.

Conditions Applicable to Dwellings, Single Family, Attached (Townhouse) only:

- No Dwelling, Single Family, Attached (Townhouse) building shall exceed six (6) dwellings.
- The minimum building square footage for townhomes shall be 1,200 square feet.

Conditions Applicable to the NC-CZ District only:

- All uses permitted in the Neighborhood Center Mixed-Use district shall be permitted within the NC-CZ, except Dwellings, Multiple Family (apartments) shall only be permitted in buildings with commercial uses located on the ground floor.

These zoning conditions have been voluntarily offered by the property owner. All property owners must sign each condition page. This page may be photocopied if additional space is needed.

Signature: Print Name: Dana Bright *Dana Bright* 3-7-2024

Date:

Signature: Print Name: Randy Bright *Randy Bright* 3-7-2024

Date: *3-7-24*

Signature: Print Name: Giny Wheeler *Giny Wheeler*

Date: *3/7/2024*

Signature: Print Name: Stephen Wheeler *Stephen Wheeler*

Date: *3/7/2024*

Signature: Print Name: Leigh Fowler *Leigh Fowler*

Date: *3-7-2024*

Signature: Print Name: James Robert Fowler, III *James Robert Fowler, III*

Date: *3-7-24*

CONSTRUCTION INFRASTRUCTURE DRAWINGS				SEAL:	REVISIONS		DATE	BY
01	08/01/2024	SRG	CID-24-04					
02	11/01/2024	SRG	TOWN OF ROLESVILLE CID-24-04 V2					
03	02/01/2024	SRG	TOWN OF ROLESVILLE CID-24-04 V3					
04	08/02/2025	SRG	TOWN OF ROLESVILLE CID-24-04 V4					
No.								



STRONG ROCK ENGINEERING GROUP, PLLC | COMPANY LICENSE # P-2766
305 CHURCH AT NORTH HILLS STREET, SUITE 1110 RALEIGH, NC 27609 | INFORMATION@STRONGROCKGROUP.COM

STRONG ROCK PROJECT PSP-24-03	NOT FOR CONSTRUCTION	SCALE AS SHOWN	DESIGNED BY SRG	DRAWN BY SRG	CHECKED BY SRG
----------------------------------	-------------------------	-------------------	--------------------	-----------------	-------------------

RESERVE @ MITCHELL MILL
TOWN OF ROLESVILLE, WAKE COUNTY, NORTH CAROLINA
CONSTRUCTION PLANS
ZONING CONDITION

DRAWING
SHEET

C-1.1

02 OF 227

GENERAL CONSTRUCTION NOTES:

1. SEE GENERAL NOTES ON SHEET C-6.0.
2. WITHIN ALL NOTES, THE TERM CONTRACTOR WILL MEAN THE GENERAL CONTRACTOR AND ANY SUBCONTRACTORS OR VENDORS PERFORMING WORK ON THE PROJECT.
3. ANY CONTRACTOR SUBMITTING A BID FOR THIS PROJECT SHALL MAKE A SITE VISIT PRIOR TO SUBMITTING BID.
4. BOUNDARY DATA PERFORMED BY TIMMONS GROUP. SEE SURVEY FOR BENCHMARK & TBM INFORMATION. SURVEY IS REFERENCED TO NC GRID NAD 83. REFER TO EXISTING CONDITIONS PLAN
5. ANY RELOCATION OF BENCHMARKS SHALL BE PERFORMED BY A NC LICENSED SURVEYOR.
6. ALL WORK, CONSTRUCTION AND MATERIALS SHALL BE IN ACCORDANCE WITH THE TOWN OF ROLESVILLE, WAKE COUNTY, NCDOT OR & CITY OF RALEIGH STANDARDS AND SPECIFICATIONS, LATEST EDITION.
7. ALL WORK, CONSTRUCTION AND MATERIALS WITHIN NCDOT RIGHT-OF-WAY SHALL BE IN ACCORDANCE WITH THE 2018 NCDOT STANDARDS SPECIFICATIONS FOR ROADS AND STRUCTURES.
8. THE CONTRACTOR SHALL BE RESPONSIBLE FOR ALL WORK ZONE TRAFFIC CONTROL IN OR ADJACENT TO NCDOT RIGHT-OF-WAY. TRAFFIC CONTROL SHALL BE MAINTAINED AT ALL TIMES WITH PROPER SIGNAGE, SIGNALS, LIGHTING, FLAGMEN. ALL SIGNS, PAVEMENT MARKINGS AND OTHER TRAFFIC CONTROL DEVICES SHALL CONFORM TO THE MANUAL ON UNIFORM TRAFFIC CONTROL DEVICES (MUTCD), LATEST EDITION.
9. COPIES OF ALL PERMITS AND APPROVED PLANS MUST BE KEPT ON SITE IN A PERMIT BOX THAT IS CONSPICUOUSLY LOCATED AND EASILY ACCESSIBLE DURING CONSTRUCTION. THIS INCLUDES APPROVED CONSTRUCTION PLANS, APPROVED EROSION CONTROL PLANS, ENCROACHMENT AGREEMENTS, DRIVEWAY PERMITS, WATER/SEWER PERMITS, ETC.
10. LOCATION OF UNDERGROUND UTILITIES ARE APPROXIMATE AND MUST BE FIELD VERIFIED. CONTACT THE NC ONE CALL CENTER AT LEAST 72 HOURS PRIOR TO DIGGING @ 1.800.632.4949. UNDERGROUND LINES SHOWN HEREON ARE APPROXIMATE OR AS REPORTED BY VARIOUS RESPONSIBLE PARTIES. THE SURVEYOR DOES NOT GUARANTEE THAT ANY UNDERGROUND STRUCTURES SUCH AS UTILITIES, TANKS AND PIPES ARE LOCATED HEREON.
11. THE CONTRACTOR SHALL NOTIFY AND COOPERATE WITH ALL UTILITY COMPANIES OR FIRMS HAVING FACILITIES ON OR ADJACENT TO THE SITE BEFORE DISTURBING, ALTERING, REMOVING, RELOCATING, ADJUSTING OR CONNECTING TO SAID FACILITIES.
12. THE CONTRACTOR IS RESPONSIBLE FOR REPAIR OF ANY TOWN, CITY OF RALEIGH OR NCDOT DAMAGED PROPERTY. THE CONTRACTOR SHALL REPAIR THE DAMAGED PROPERTY TO THE LATEST STANDARDS AND SPECIFICATIONS OF THE AGENCY HOLDING JURISDICTION AT NO COST TO THE OWNER.
13. ANY DAMAGE DONE TO PRIVATE PROPERTY OWNERS SIGNS, MAILBOX, DRIVEWAY CULVERTS, LANDSCAPING OR OTHER PROPERTY SHALL BE RESTORED TO ORIGINAL CONDITION. AT NO COST TO OWNER.
14. CONTRACTOR IS RESPONSIBLE FOR FENCING AND SECURITY OF HIS LAYDOWN AND STORAGE AREA.
15. THE CONTRACTOR IS REQUIRED TO MEET ALL APPLICABLE FEDERAL, OSHA, STATE AND LOCAL REGULATIONS CONCERNING PROJECT SAFETY AND ASSUMES FULL RESPONSIBILITY FOR SAFETY ON THE PROJECT.
16. CONTRACTOR SHALL KEEP ALL ROADS FREE OF DIRT AND DEBRIS AT ALL TIMES.
17. CONTRACTOR SHALL PROTECT EXISTING PAVEMENTS AND UTILITIES FROM HEAVY EARTH MOVING EQUIPMENT. PROVIDE TRAFFIC CONTROL AND ADEQUATE PROTECTION METHODS AT ALL EQUIPMENT CROSSINGS.
18. ALL STRUCTURAL FILL MATERIAL SHALL BE FREE OF ALL STICKS, ROCKS, AND CLUMPS OF MUD. ALL ROCKS GREATER THAN 3" DURING EXCAVATION SHALL BE REMOVED.
19. CONCRETE SIDEWALKS THAT ARE TO BE REMOVED SHALL BE CUT BACK TO NEAREST EXPANSION OR CONTROL JOINT AND REPLACED WITH 4-INCH CONCRETE SIDEWALK FINISHED TO MATCH EXISTING SIDEWALKS.
20. CONTRACTOR TO COORDINATE WITH CITY OF RALEIGH FOR TEMPORARY WATER NEEDED DURING CONSTRUCTION. IF PERMITTED TO CONNECT TO EXISTING FIRE HYDRANT A REDUCED PRESSURE ZONE (RPZ) BACKFLOW PREVENTER WILL BE REQUIRED.
21. THE TRANSITION OF PROPOSED ROADWAY TO EXISTING ROADWAY SHALL BE DONE WITH A MINIMUM 8-FT TRANSITION WHERE THE EXISTING PAVEMENT IS MILLED TO A MINIMUM DEPTH OF 1-1/2" AND OVERLAID.
22. ALL PAVEMENT SAW CUTS SHALL BE NEAT, STRAIGHT AND FULL DEPTH.
23. ALL RIP-RAP IS TO BE INSTALLED WITH NON-WOVEN FILTER FABRIC BENEATH (MIRAFI 140N OR APPROVED EQUAL).
24. HDPE PIPE SHALL BE ADS N-12 WT (ASTM D3212) OR APPROVED EQUAL INSTALLED IN STRICT ACCORDANCE WITH MANUFACTURERS REQUIREMENTS AND RECOMMENDATIONS.
25. ALL SITE CONSTRUCTION MUST BE INSPECTED BY THE GEOTECHNICAL ENGINEER AT THE FOLLOWING STAGES:

A. COMPLETION OF GRADING SUBGRADE PRIOR TO PLACING STONE BASE.

B. COMPLETION OF STONE PLACEMENT PRIOR TO PAVING.

C. FINAL INSPECTION WHEN ALL WORK IS COMPLETE.

26. PRIOR TO PLACING CABC STONE BASE, THE CONTRACTOR SHOULD NOTIFY THE GEOTECHNICAL ENGINEER TO INSPECT THE PROOF ROLL OF THE SUBGRADE. ANY STONE PLACED WITHOUT PRIOR APPROVAL WILL BE THE SOLE RESPONSIBILITY OF THE CONTRACTOR AND SUBJECT TO RE-CONSTRUCTION IF SUBGRADE DOES NOT MEET TOWN AND NCDOT STANDARDS & SPECIFICATIONS.
27. ALL UTILITY SERVICES, (POWER, TELEPHONE, CABLE, ETC.) ARE PROPOSED TO BE UNDERGROUND. THE CONTRACTOR SHALL COORDINATE WITH THE PRIVATE UTILITY SERVICE COMPANIES FOR ANY REQUIRED CONDUITS OR POINT OF CONTACT CONDITIONS.
28. ALL PUBLIC UTILITIES THAT REQUIRE AN ENGINEERING CERTIFICATION MUST BE INSPECTED BY A PROFESSIONAL ENGINEER ON A PERIODIC BASIS. THE CONTRACTOR SHALL CONTACT THE PROJECT ENGINEER WHEN INSTALLING UTILITIES FOR PERIODIC INSPECTIONS. THE CONTRACTOR SHALL CONTACT THE PROJECT ENGINEER AT THE TIME OF PRESSURE TESTING AND WATER LINE DISINFECTION. THE CONTRACTOR SHALL SUPPLY THE PROJECT ENGINEER PRESSURE TEST RESULTS.
29. INFORMATION CONCERNING UNDERGROUND UTILITIES WAS OBTAINED FROM AVAILABLE RECORDS AND FIELD CONDITIONS WHEN POSSIBLE, BUT THE CONTRACTOR MUST DETERMINE THE EXACT LOCATION AND ELEVATION OF ALL EXISTING UTILITIES BY DIGGING TEST PITS BY HAND AT ALL UTILITY CROSSINGS WELL IN ADVANCE OF TRENCHING. IF THE CLEARANCES ARE LESS THAN SPECIFIED ON THE PLANS OR 12 INCHES, WHICH EVER IS LESS, CONTACT THE PROJECT ENGINEER PRIOR TO PROCEEDING WITH CONSTRUCTION.
30. THE CONTRACTOR SHALL INCLUDE IN HIS CONTRACT PRICE THE REMOVAL AND DISPOSAL, TO AN APPROVED NCDENR LOCATION, OF ANY EXCESS TOPSOIL OR UNCLASSIFIED EXCAVATION HE DETERMINES IS NOT REQUIRED TO PERFORM THE FINAL GRADING AND LANDSCAPING OPERATION.
31. THE CONTRACTOR SHALL INCLUDE IN THE CONTRACT PRICE DAILY RECORD KEEPING OF THE AS-BUILT CONDITION OF ALL OF THE UNDERGROUND UTILITIES, CONSTRUCTION STAKEOUT ASSOCIATED WITH THE PROJECT. PREPARATION OF THE NECESSARY/REQUIRED AS-BUILT PLANS TO BE SUBMITTED TO TOWN OF ROLESVILLE AND/OR CITY RALEIGH PUBLIC UTILITIES AND/OR ALL OTHER INFORMATION REQUIRED IN CONNECTION WITH RELEASE OF BONDS.
32. THE CONTRACTOR SHALL INCLUDE IN THE PRICE, ANY AND ALL COSTS ASSOCIATED WITH PROVIDING A PROFESSIONAL ENGINEER ON SITE IF REQUIRED, DURING THE CONSTRUCTION OF THE STORMWATER MANAGEMENT FACILITIES, UNDERGROUND UTILITIES, ETC. AS REQUIRED FOR AS-BUILT CERTIFICATION.
33. THE CONTRACTOR IS RESPONSIBLE FOR THE DESIGN AND IMPLEMENTATION OF ALL REQUIRED/NECESSARY SHEETING, SHORING, AND SPECIAL EXCAVATION MEASURES REQUIRED ON THE PROJECT TO MEET OSHA, FEDERAL, STATE AND LOCAL REGULATIONS PURSUANT TO THE INSTALLATION OF THE WORK INDICATED ON THE DRAWINGS. NCDOT, TOWN OF ROLESVILLE, CITY OF RALEIGH, & ENGINEER OF RECORD ACCEPT NO RESPONSIBILITY FOR THE DESIGN TO INSTALL SAID ITEMS.
34. TESTING BY CONTRACTOR: CONTRACTOR SHALL EMPLOY AT HIS EXPENSE AN OUTSIDE INDEPENDENT SOIL TESTING SERVICE (APPROVED BY THE OWNER) TO PERFORM SOIL TESTING AND INSPECTION SERVICE FOR QUALITY CONTROL TESTING DURING EARTHWORK OPERATIONS. COPIES OF RESULTS OF TESTS SHALL BE SUBMITTED BY THE TESTING SERVICE DIRECTLY TO THE CONTRACTOR, THE OWNER, AND THE APPLICABLE APPROVING AGENCY. --THE TESTING SERVICE WILL CLASSIFY PROPOSED ON-SITE AND BORROW SOILS TO VERIFY THAT SOILS COMPLY WITH SPECIFIED REQUIREMENTS AND TO PERFORM REQUIRED FIELD AND LABORATORY TESTING. (MINIMUM REQUIRED SOIL BEARING CAPACITY IS NOTED ON THE STRUCTURAL DRAWINGS). -IN PAVED AND BUILDING SLAB AREAS, THE TESTING SERVICE SHALL MAKE AT LEAST ONE FIELD DENSITY TEST FOR EACH 2000 SQUARE FEET OF FILL IN EACH COMPACTED FILL LAYER. IF A TEST SHOULD FAIL TO MEET REQUIRED DENSITY, THE CONTRACTOR SHALL RE-COMPACT THAT LAYER. THE SOIL TESTING SERVICE SHALL PERFORM ADDITIONAL TESTS AT THE CONTRACTOR'S EXPENSE TO SHOW THAT THE FAILED LAYER HAS REACHED THE REQUIRED COMPACTION. --IN FOUNDATION WALL AREAS, THE TESTING SERVICE SHALL MAKE AT LEAST ONE FIELD DENSITY TEST FOR EACH 100 FEET OR LESS OF WALL LENGTH OF FILL IN EACH COMPACTED FILL LAYER, WITH NO LESS THAN TWO TESTS ALONG A WALL FACE. IF A TEST SHOULD FAIL TO MEET REQUIRED DENSITY, THE CONTRACTOR SHALL RE-COMPACT THAT LAYER. THE SOIL TESTING SERVICE SHALL PERFORM ADDITIONAL TESTS AT THE CONTRACTOR'S EXPENSE TO SHOW THAT THE FAILED LAYER HAS REACHED THE REQUIRED COMPACTION.
35. COMPACTION: COMPACT EACH LAYER OF BACKFILL AND FILL SOIL MATERIALS AND THE TOP 12" OF SUBGRADE IN CUT AREAS TO 98% OF MAXIMUM DENSITY IN ACCORDANCE WITH AASHTO T99 FOR STRUCTURES, SLABS, AND PAVEMENTS AND 95% OF MAXIMUM DENSITY FOR EMBANKMENTS OR UNPAVED AREAS. MAX LIFT THICKNESS FOR FILL AREAS IS 8 INCHES.
36. DESIGN/FIELD CONDITIONS QUITE EASILY MAY VARY FROM THAT REPRESENTED IN THE INITIAL SOILS REPORT AND/OR TOPOGRAPHICAL REPORT. ISOLATED AREAS MAY SHOW UP WEAK AND ADVERSE SOILS OR GROUNDWATER CONDITIONS MAY BE DISCOVERED THAT WERE NOT REVEALED DURING THE INITIAL SOILS INVESTIGATION. THEREFORE, THE OWNER/CLIENT IS TO BE AWARE THAT ENGINEER OF RECORD WILL NOT AND CANNOT BE HELD RESPONSIBLE FOR ANY FAILURES TO EITHER A STREET OR PARKING LOT PAVEMENT DESIGN UNLESS WE CAN BE FULLY AND TOTALLY INVOLVED IN THE CONSTRUCTION PROCESS WHICH MAY INCLUDE, BUT MAY NOT NECESSARILY BE LIMITED TO, TESTING SUBGRADE AND BASE DENSITY, ENGAGING THE GEOTECHNICAL ENGINEER FOR THE EVALUATION OF THE SUBGRADE AND FOR THE OBSERVATION OF PROOF ROLLING SUBGRADE AND BASE AT VARIOUS STEPS OF CONSTRUCTION, OPPORTUNITY FOR THE DESIGN ENGINEER TO CALL IN A GEOTECHNICAL ENGINEER FOR CONSULTATION AND ADVICE, ETC. - STEPS WHICH TAKEN ALTOGETHER WITH THE INITIAL DESIGN SHOWN ON THE PLANS, CONSTITUTE THE COMPLETE DESIGN OF THE ROAD, STREET OF PARKING AREA (PRIVATE OR PUBLIC). THE DESIGN ENGINEER MUST BE GIVEN THE FULL LATITUDE AND OPPORTUNITY TO COMPLETE THE DESIGN BY FULLY PARTICIPATING IN THE CONSTRUCTION PROCESS. PLAN DESIGN IS A SMALL PORTION OF THE DESIGN AND CANNOT BE SEPARATED FROM THE CONSTRUCTION PROCESS IF THE OWNERS/CLIENT'S DESIRE IS TO HAVE THE DESIGN ENGINEER STAND BEHIND THE COMPLETED DESIGNED PROJECT.
37. CONTRACTOR SHALL PROVIDE POSITIVE DRAINAGE AWAY FROM ALL BUILDING PADS.
38. THE SITE PREVIOUSLY CONTAINED RESIDENTIAL / FARM STRUCTURES CONTRACTOR RESPONSIBLE FOR REMOVAL OF ANY FOUNDATIONS AND SEPTIC SYSTEMS PER NCDNR REQUIREMENTS.

GENERAL ABBREVIATIONS:

IDENTIFIER	DESCRIPTION
&	AND
CL	CENTERLINE
Ø	DIAMETER OR ROUND
PL	PROPERTY LINE
ABC	AGGREGATE BASE ASPH ASPHALT
AHJ	AUTHORITY HAVING JURISDICTION
AVE	AVENUE
BLVD	BOULEVARD
BLDG	BUILDING
BOC	BACK OF CURB
BW	BOTTOM OF WALL
CB	CATCH BASIN
CI	CURB INLET
CIP	CAST IRON PIPE
CLS	CLASS
CJ	CONTROL JOINT
CO	CLEANOUT
CONC	CONCRETE
DI	DROP INLET
DIA	DIAMETER
DIP	DUCTILE IRON PIPE
DOM	DOMESTIC
DR	DRIVE
(XX)	EXISTING ELEVATION
E	EAST, EASTING
EL	ELEVATION
EJ	EXPANSION JOINT
EOP	EDGE OF PAVEMENT
E.O.R	ENGINEER OF RECORD
EX	EXISTING
EVAP	EVAPORATIVE
FDC	FIRE DEPARTMENT CONNECTION
FES	FLARED END SECTION
FFE	FINISHED FLOOR ELEVATION
FG	FINISHED GRADE
FHA	FIRE HYDRANT ASSEMBLY
FL	FLOW LINE
FT	FOOT OR FEET
G	GAS
GALV	GALVANIZED
GB	GRADE BREAK
GE	GENERAL ELECTRIC
GR	GRADE
HDPE	HIGH DENSITY POLYETHYLENE
HORIZ	HORIZONTAL
HOV	HIGH OCCUPANCY VEHICLE
HP	HIGH POINT
IAW	IN ACCORDANCE WITH
I.H.	INTERSTATE HIGHWAY
INV	INVERT

GENERAL ABBREVIATIONS:

IDENTIFIER	DESCRIPTION
LEN	LENGTH
LEV	LOW EMISSION VEHICLE
LF	LINEAR FEET
LP	LOW POINT
MAX	MAXIMUM
MH	MANHOLE
MIN	MINIMUM
N	NORTH, NORTHING
NCDENR	NORTH CAROLINA DEPARTMENT OF ENVIRONMENT & NATURAL RESOURCES
NCDOT	NORTH CAROLINA DEPARTMENT OF TRANSPORTATION
NTS	NOT TO SCALE
OH	OVERHEAD
OCB	OFF-SET CATCH BASIN
PCC	PORTLAND CEMENT CONCRETE
PE	POLYETHYLENE
PKWY	PARKWAY
POC	POINT OF CONNECTION
PVC	POLYVINYL CHLORIDE
R	RADIUS
RCP	REINFORCED CONCRETE PIPE
R.O.W	RIGHT OF WAY
RPDA	REDUCED PRESSURE DETECTOR ASSEMBLY
RPZ	REDUCED PRESSURE ZONE
S	SOUTH
SD	STORM DRAIN
SDMH	STORM DRAIN MANHOLE
SDE	SIGHT DISTANCE EASEMENT
SMMH	SANITARY SEWER MANHOLE
SS	SANITARY SEWER
STA	STATION
STD	STANDARD
ST.STL	STAINLESS STEEL
SWPPP	STORMWATER POLLUTION PREVENTION PLAN
TB	THRUST BLOCKING
TC/TOC	TOP OF CURB
TD	TEMPORARY DIVERSION
TH	TEST HEADER
TOP	TOP OF PIPE
TP	TOP OF PAD
TYP	TYPICAL
TW	TOP OF WALL
UG	UNDERGROUND
VEG	VEGETATED
VERT	VERTICAL
W	WEST
WI	WITH
W/O	WITHOUT
YI	YARD INLET

** ALL SYMBOLS & ABBREVIATIONS SHOWN ON THIS SHEET MAY OR MAY NOT BE USED IN THIS DRAWING PACKAGE **

CONSTRUCTION INFRASTRUCTURE DRAWINGS CID-24-04	SREG	08/04/2024	01	02	03	04					No.	REVISIONS	DATE	BY
	SREG	11/01/2024												
	SREG	02/01/2024												
	SREG	08/02/2025												

01	02	03	04											
No.														

SEAL:

STRONGROCK

ENGINEERING GROUP

STRONG ROCK ENGINEERING GROUP, PLLC | COMPANY LICENSE # P-2166

305 CHURCH AT NORTH HILLS STREET, SUITE 1110 RALEIGH, NC 27609 | INFORMATION@STRONGROCKGROUP.COM

STRONG ROCK PROJECT PSP-24-03	NOT FOR CONSTRUCTION	SCALE AS SHOWN	DESIGNED BY SRG	DRAWN BY SRG	CHECKED BY SRG
----------------------------------	-------------------------	-------------------	--------------------	-----------------	-------------------

RESERVE @ MITCHELL MILL
TOWN OF ROLESVILLE, WAKE COUNTY, NORTH CAROLINA

CONSTRUCTION PLANS


CIVIL NOTES

DRAWING
SHEET

C-2.0

03 OF 227

THIS PLANSET AND ANY ASSOCIATED DOCUMENTS ARE PRELIMINARY AND NOT AUTHORIZED FOR CONSTRUCTION UNTIL SIGNED, DATED, AND OFFICIALLY RELEASED FOR CONSTRUCTION BY THE ENGINEER OF RECORD.

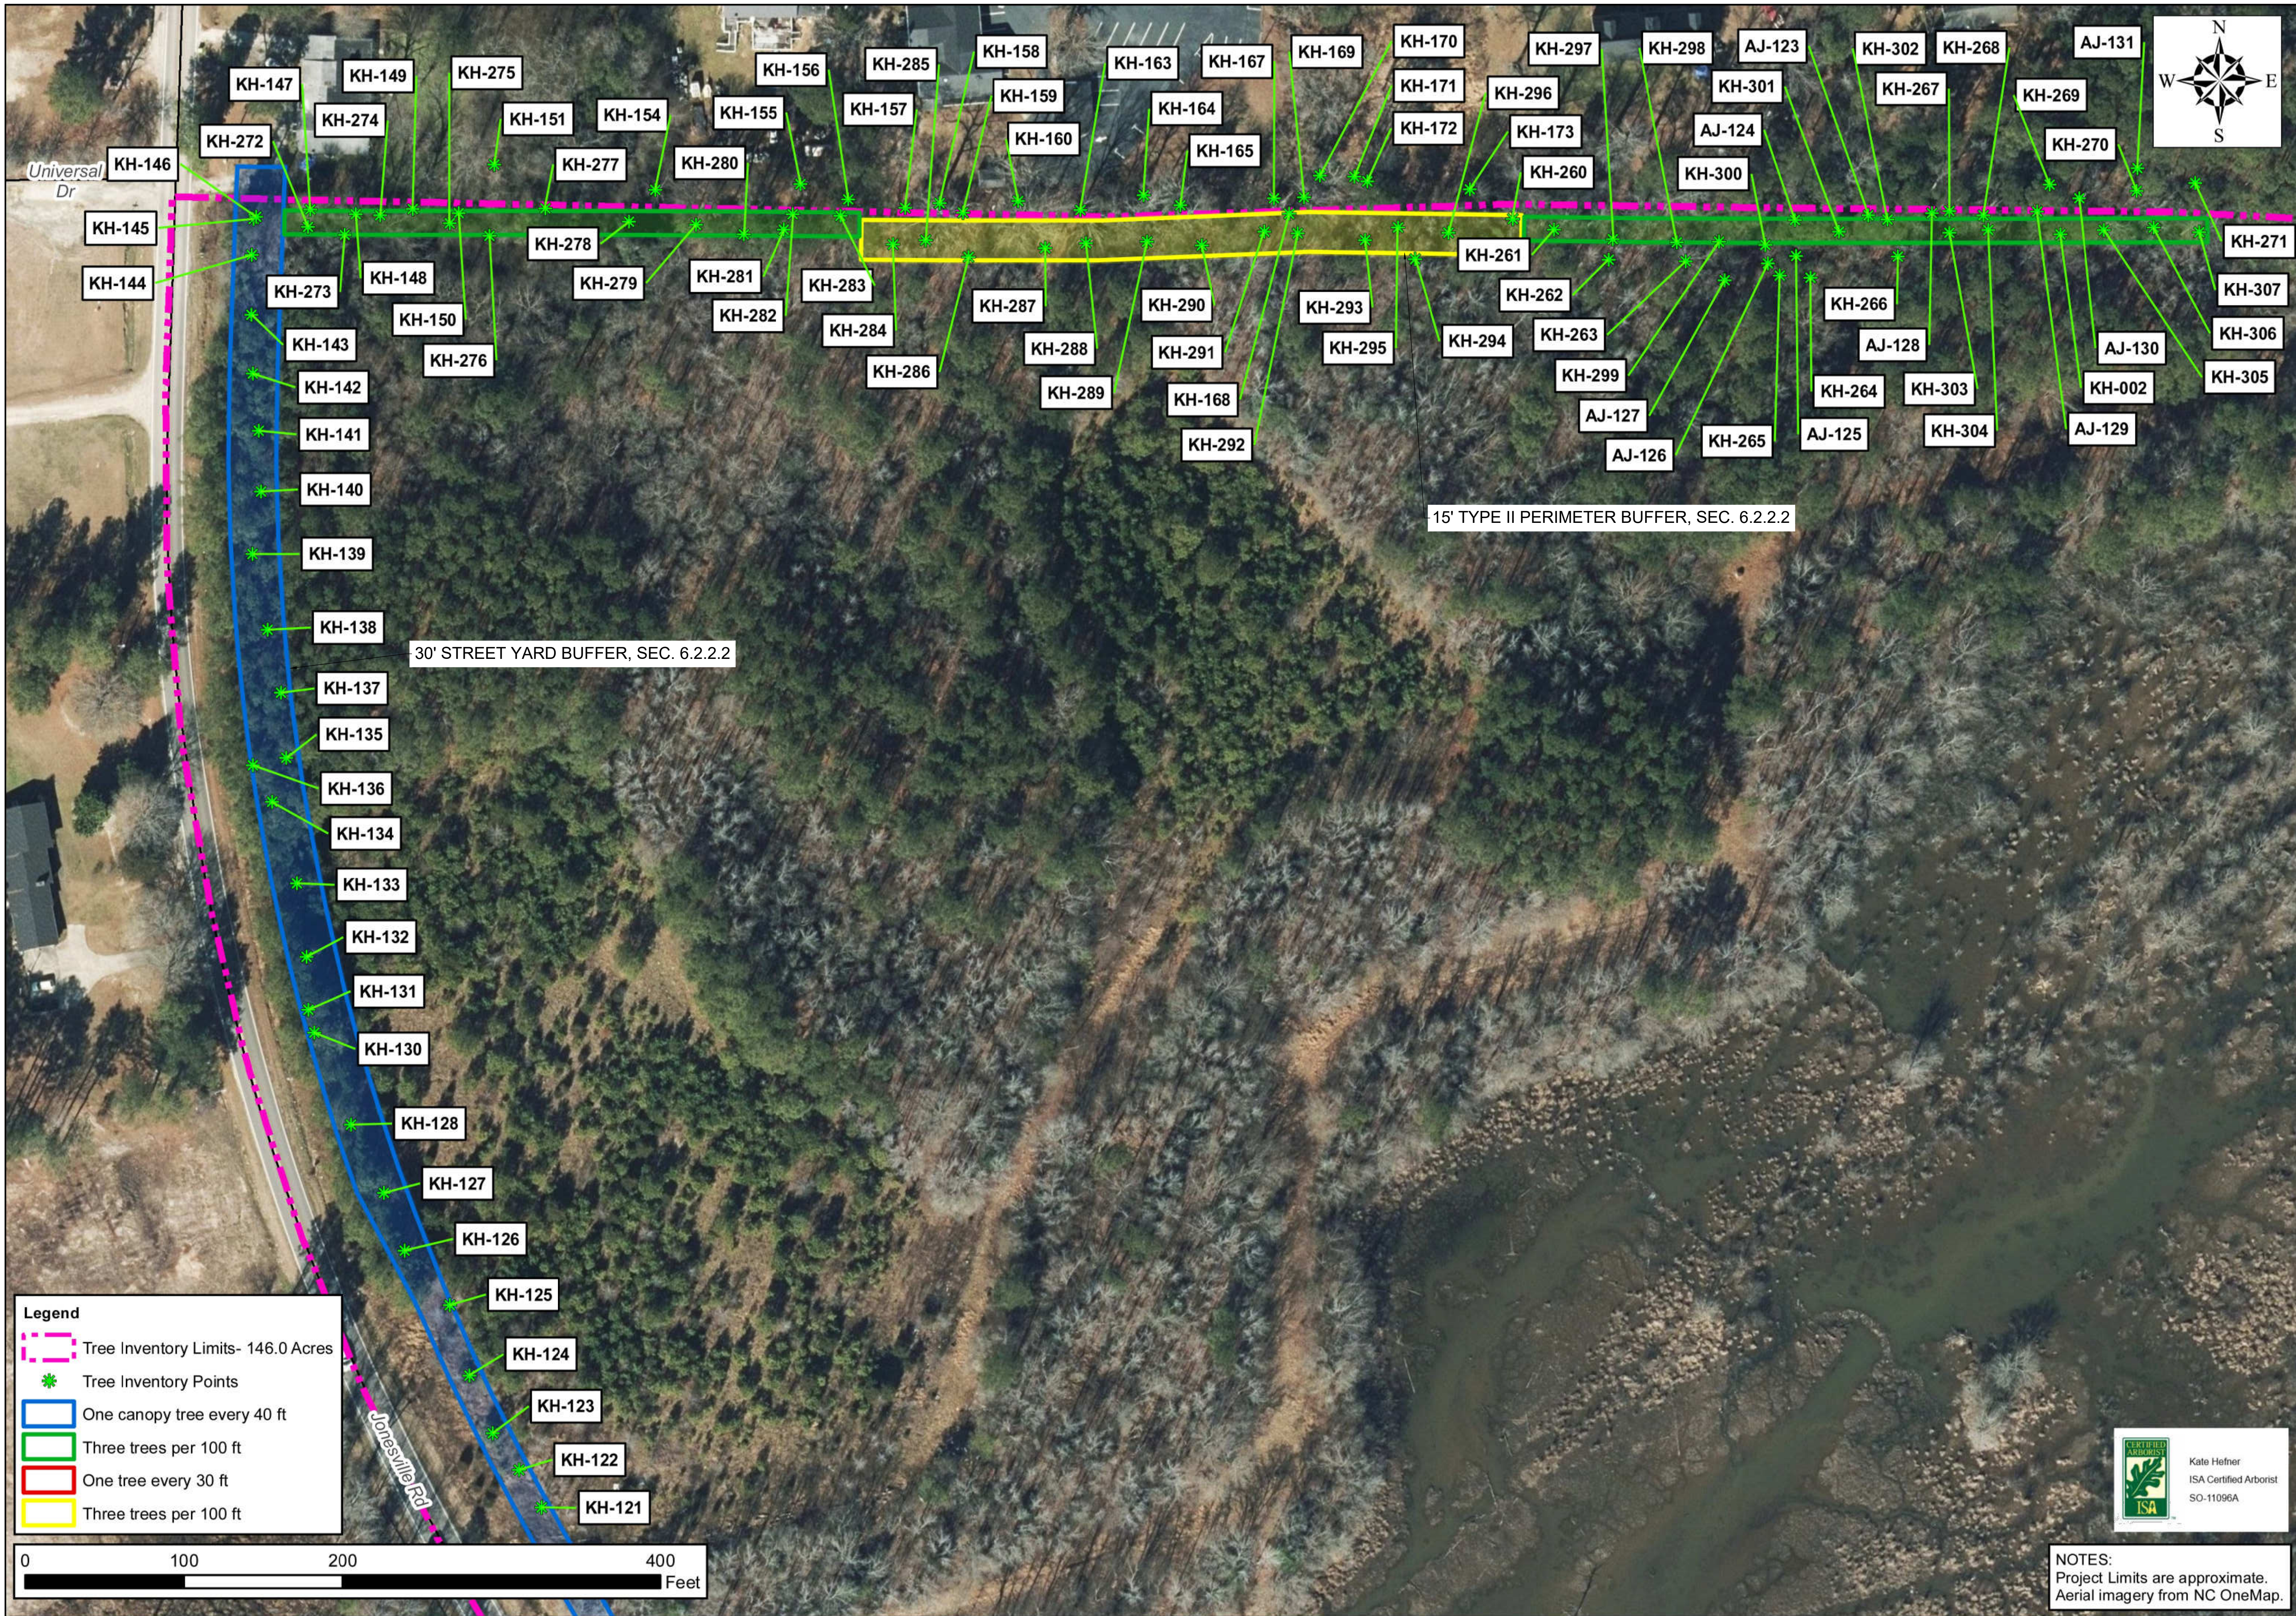

CONSTRUCTION INFRASTRUCTURE DRAWINGS		08/01/2024		SRG	
CID-24-04		11/01/2024		SRG	
TOWN OF ROLESVILLE CID-24-04 V2		02/01/2024		SRG	
TOWN OF ROLESVILLE CID-24-04 V3		08/02/2025		SRG	
TOWN OF ROLESVILLE CID-24-04 V4					
No.		REVISIONS		DATE	
BY					


STRONGROCK
ENGINEERING GROUP
STRONG ROCK ENGINEERING GROUP, PLLC | COMPANY LICENSE # P-2166
305 CHURCH AT NORTH HILLS STREET, SUITE 1110 RALEIGH, NC 27609 | INFORMATION@STRONGROCKGROUP.COM

STRONG ROCK PROJECT	NOT FOR CONSTRUCTION	SCALE	DESIGNED BY	DRAWN BY	CHECKED BY
PSP-24-03	AS SHOWN	SRG	SRG	SRG	SRG

RESERVE @ MITCHELL MILL
TOWN OF ROLESVILLE, WAKE COUNTY, NORTH CAROLINA
CONSTRUCTION PLANS
PARTIAL TREE INVENTORY MAP I

DRAWING SHEET
C-3.2

06 OF 227

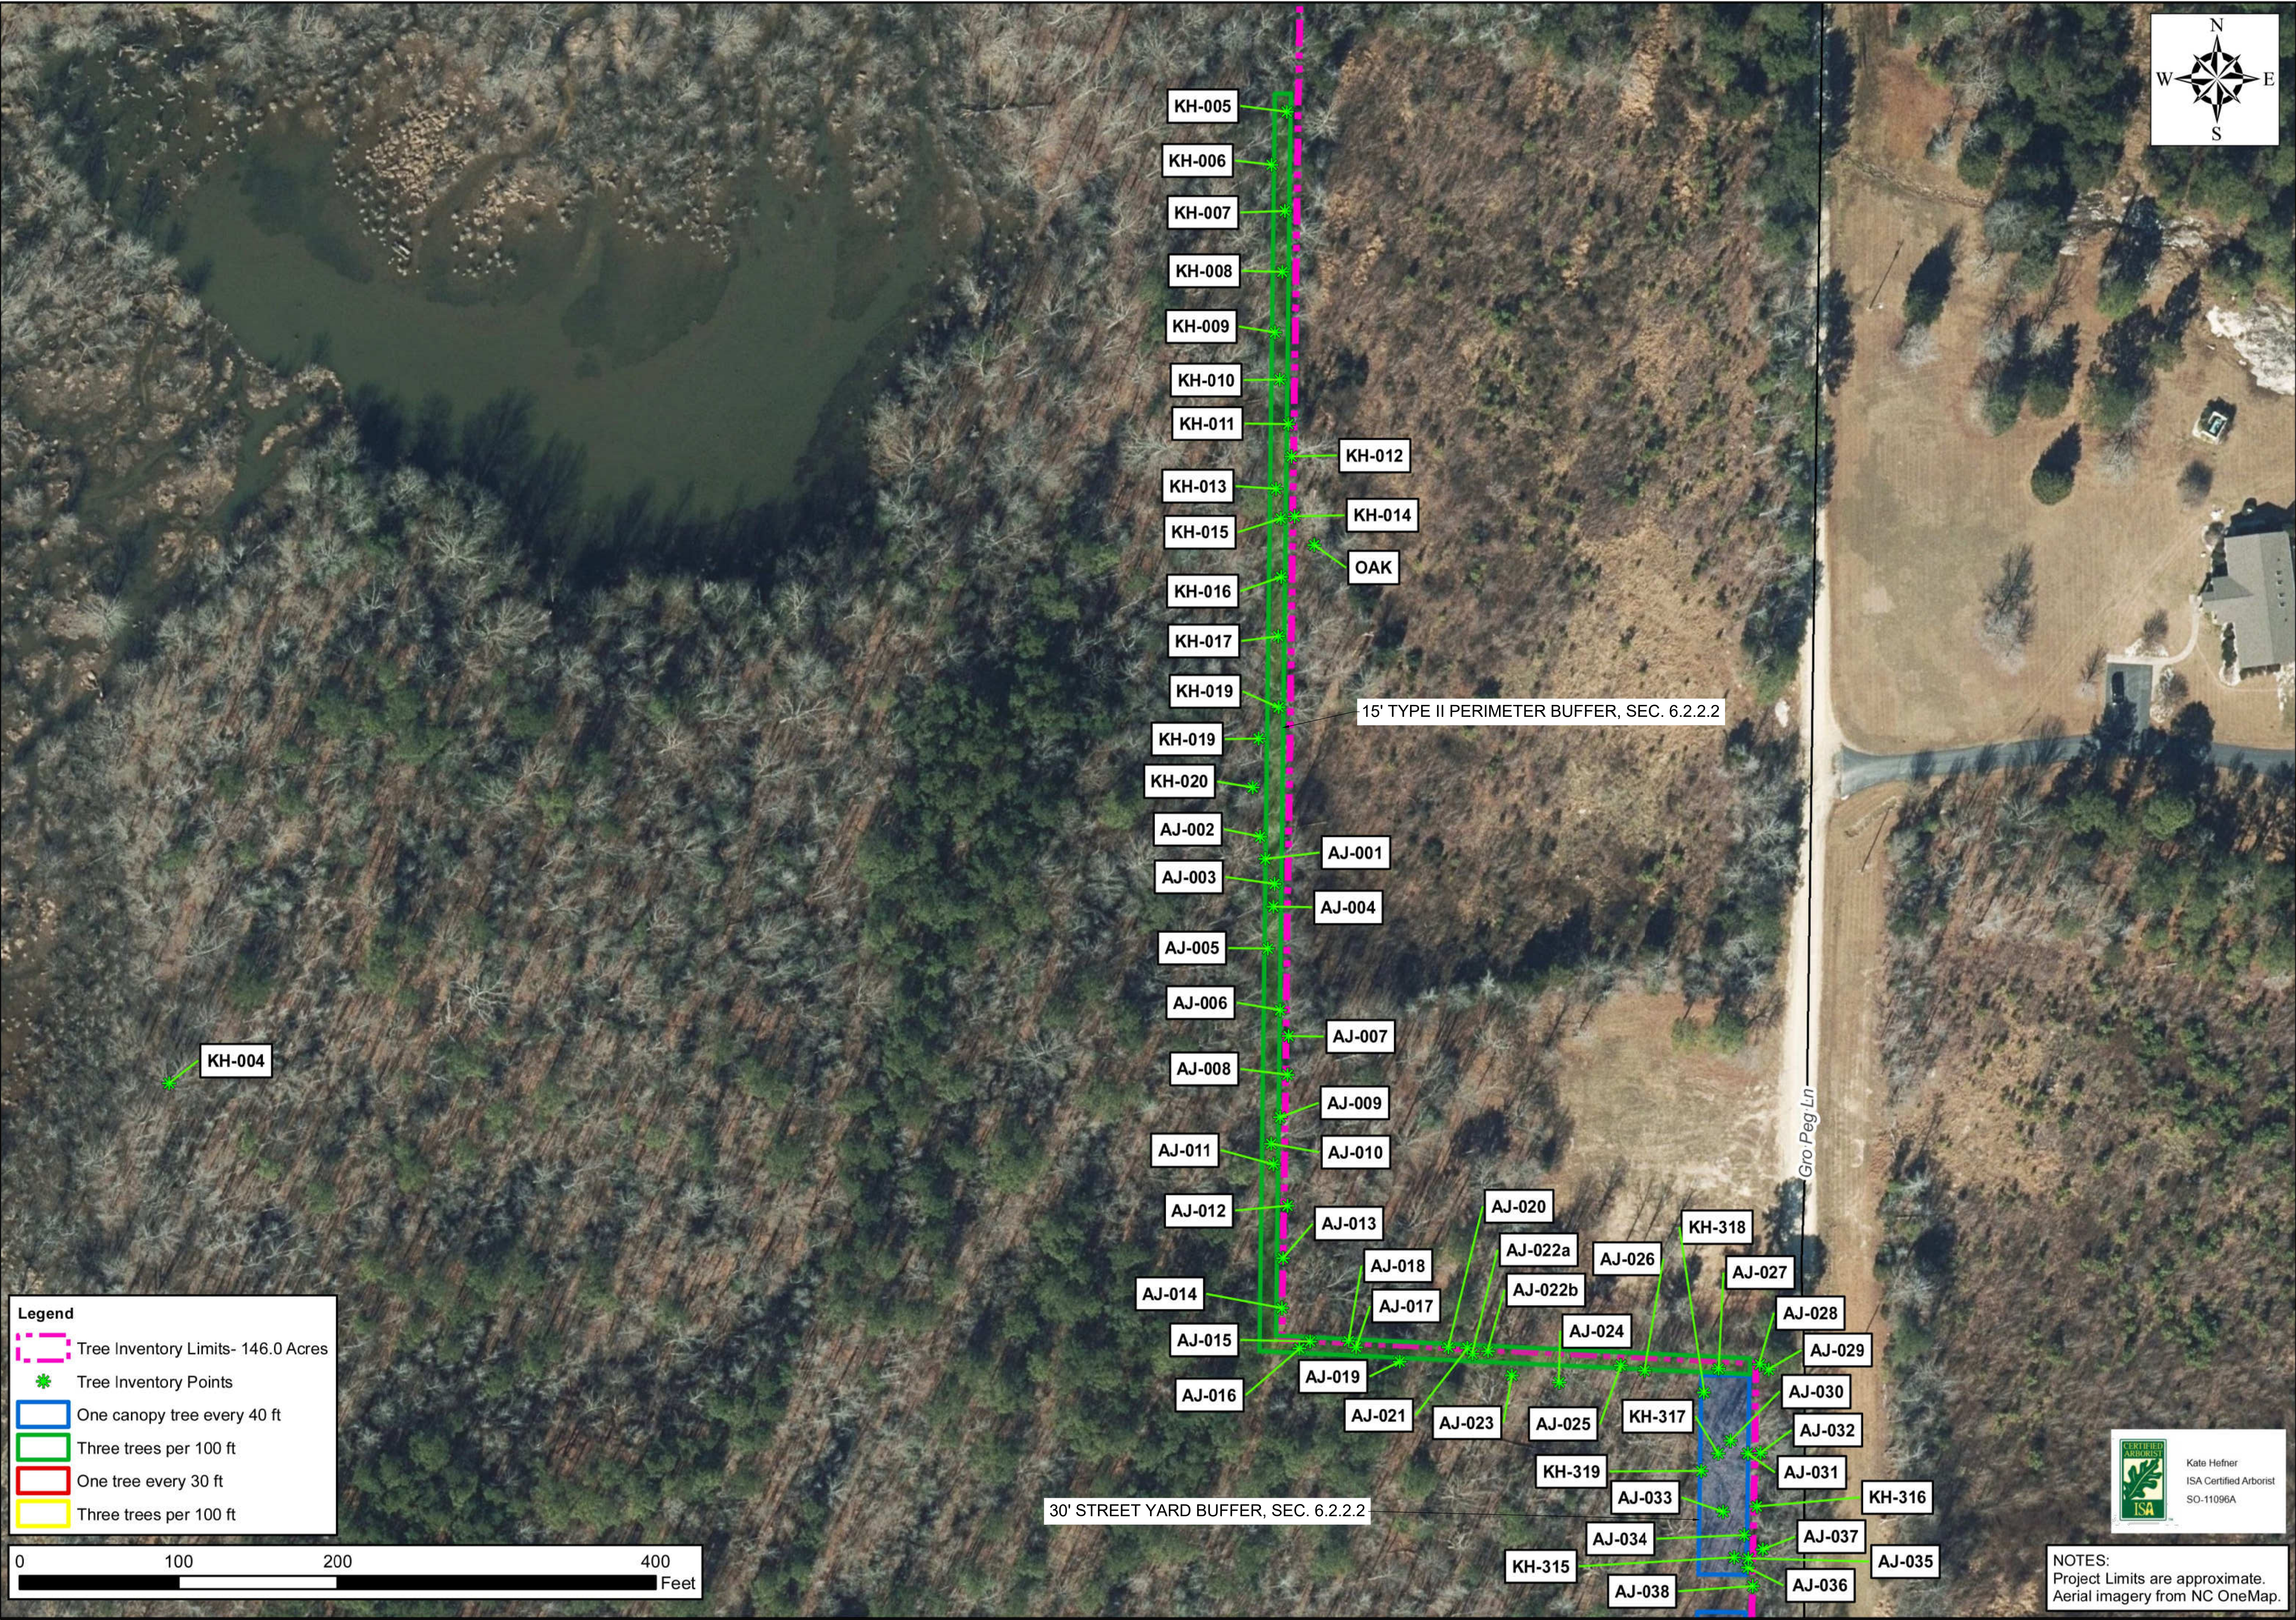

NOTES:
Project Limits are approximate.
Aerial imagery from NC OneMap.

STRONGROCK

ENGINEERING GROUP

STRONG ROCK ENGINEERING GROUP, PLLC | COMPANY LICENSE # P-2166
305 CHURCH AT NORTH HILLS STREET, SUITE 1110 RALEIGH, NC 27609 | INFORMATION@STRONGROCKGROUP.COM

STRONG ROCK PROJECT
PSP-24-03

NOT FOR
CONSTRUCTION

SCALE
AS SHOWN

DESIGNED BY
SRG

DRAWN BY
SRG


CHECKED BY
SRG

RESERVE @ MITCHELL MILL
TOWN OF ROLESVILLE, WAKE COUNTY, NORTH CAROLINA
CONSTRUCTION PLANS
PARTIAL TREE INVENTORY MAP II

DRAWING
SHEET
C-3.3

07 OF 227

CONSTRUCTION INFRASTRUCTURE DRAWINGS		SEAL:		REVISIONS		BY	
No.	DATE	No.	DATE	No.	DATE	No.	DATE
01	08/01/2024	01	08/01/2024				
02	11/01/2024	02	11/01/2024				
03	02/01/2024	03	02/01/2024				
04	08/02/2025	04	08/02/2025				

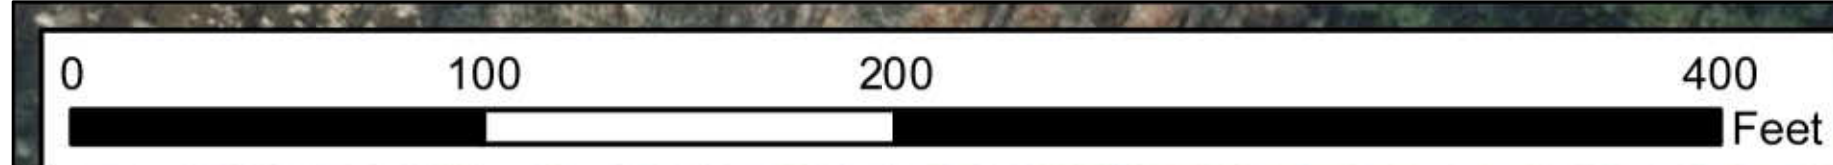

Legend

- Tree Inventory Limits- 146.0 Acres
- Tree Inventory Points
- One canopy tree every 40 ft
- Three trees per 100 ft
- One tree every 30 ft
- Three trees per 100 ft



 Kate Heffner
ISA Certified Arborist
SO-11096A

NOTES:
Project Limits are approximate.
Aerial imagery from NC OneMap.

CONSTRUCTION INFRASTRUCTURE DRAWINGS		DATE	BY
01	CID-24-04	08/04/2024	SRG
02	TOWN OF ROLESVILLE CID-24-04 V2	11/01/2024	SRG
03	TOWN OF ROLESVILLE CID-24-04 V3	02/01/2024	SRG
04	TOWN OF ROLESVILLE CID-24-04 V4	08/02/2025	SRG
REVISIONS		No.	

SEAL:

STRONGROCK
ENGINEERING GROUP

STRONG ROCK ENGINEERING GROUP, PLLC | COMPANY LICENSE # P-2166
305 CHURCH AT NORTH HILLS STREET, SUITE 1110 RALEIGH, NC 27609 | INFORMATION@STRONGROCKGROUP.COM

STRONG ROCK PROJECT	NOT FOR CONSTRUCTION	SCALE	DESIGNED BY	DRAWN BY	CHECKED BY
PSP-24-03	AS SHOWN	SRG	SRG	SRG	SRG

RESERVE @ MITCHELL MILL
TOWN OF ROLESVILLE, WAKE COUNTY, NORTH CAROLINA

CONSTRUCTION PLANS

PARTIAL TREE INVENTORY MAP III

DRAWING SHEET

C-3.4

08 OF 227



RESERVE @ MITCHELL MILL
TOWN OF ROLESVILLE, WAKE COUNTY, NORTH CAROLINA
CONSTRUCTION PLANS

DRAWING
SHEET
C-3.5

THIS PLANSET AND ANY ASSOCIATED DOCUMENTS ARE PRELIMINARY AND NOT AUTHORIZED FOR CONSTRUCTION UNTIL SIGNED, DATED, AND OFFICIALLY RELEASED FOR CONSTRUCTION BY THE ENGINEER OF RECORD.



RESERVE @ MITCHELL MILL TOWN OF ROLESVILLE, WAKE COUNTY, NORTH CAROLINA CONSTRUCTION PLANS PARTIAL TREE INVENTORY MAP V	<u>DRAWING</u> SHEET C-3.6	10 OF 227
---	---	-------------------------



STRONGROCK

ENGINEERING GROUP

STRONG ROCK ENGINEERING GROUP, PLLC | COMPANY LICENSE # P-2166
305 CHURCH AT NORTH HILLS STREET, SUITE 1110 RALEIGH, NC 27609 | INFORMATION@STRONGROCKGROUP.COM

STRONG ROCK PROJECT
PSP-24-03

NOT FOR
CONSTRUCTION

SCALE
AS SHOWN

DESIGNED BY
SRG

DRAWN BY
SRG

CHECKED BY
SRG

RESERVE @ MITCHELL MILL
TOWN OF ROLESVILLE, WAKE COUNTY, NORTH CAROLINA
CONSTRUCTION PLANS
PARTIAL TREE INVENTORY MAP VI

DRAWING
SHEET
C-3.7

11 OF 227

SEAL:

CONSTRUCTION INFRASTRUCTURE DRAWINGS
CID-24-04

01

02

03

140



Tree Code	Botanical Name	DBH	Condition Overall
AJ-001	LITU	19"	Good
AJ-002	CATO	10"	Good
AJ-003	QUAL	10"	Good
AJ-004	JUVI	14"	Good
AJ-005	CATO	13"	Good
AJ-006	QURU	10"	Good
AJ-007	QURU	8"	Good
AJ-008	LIST	18"	Good
AJ-009	QUAL	6"	Good
AJ-010	QURU	14"	Good
AJ-011	QUAL	14"	Good
AJ-012	QUAL	12"	Good
AJ-013	CATO	6"	Good
AJ-014	ACRU	14"	Good
AJ-015	QUNI	5"	Good
AJ-016	LIST	4"	Good
AJ-017	LIST	4"	Good
AJ-018	PITA	16/18"	Good
AJ-019	ACRU	4"	Good
AJ-020	QUNI	10"	Good
AJ-021	LIST	16"	Good
AJ-022a	PITA	20"	Good
AJ-022b	PITA	20"	Good
AJ-023	ACRU	13"	Good
AJ-024	QUST	22"	Fair
AJ-025	LIST	7"	Good
AJ-026	PITA	17"	Good
AJ-027	QUNI	4"	Good
AJ-028	PITA	29"	Good
AJ-029	CATO	9"	Fair
AJ-030	QURU	20"	Good
AJ-031	LIST	19"	Good
AJ-032	CATO	12"	Good
AJ-033	LITU	27"	Good
AJ-034	LIST	18"	Good
AJ-035	LITU	23"	Good
AJ-036	PITA	20"	Good
AJ-037	ULAL	14"	Good
AJ-038	LITU	18"	Good
AJ-039	LIST	36"	Good
AJ-040	ACRU	22"	Good
AJ-041a	ACRU	15"	Good
AJ-041b	ACRU	18"	Good
AJ-042	LITU	12"	Good
AJ-043	LITU	18"	Good
AJ-044	PRSE	19"	Fair
AJ-045	LITU	19"	Good
AJ-046	LITU	17"	Good
AJ-047	QUVE	31"	Fair
AJ-048	LIST	6"	Fair
AJ-049	QUNI	17"	Good
AJ-050	QUAL	12"	Good
AJ-051	QUAL	12"	Good
AJ-052	QURU	12"	Good
AJ-053	QUAL	4"	Good
AJ-054	QUAL	32"	Good
AJ-055	OXAR	6"	Good
AJ-056	QURU	19"	Good
AJ-057	QUAL	13"	Good
AJ-058	LITU	17"	Good
AJ-059	LITU	24"	Good
AJ-060	QURU	32"	Good
AJ-061	ILOP	6"	Good
AJ-062	QURU	20"	Good

Tree Code	Botanical Name	DBH	Condition Overall
AJ-063	LITU	12"	Good
AJ-064	QURU	19"	Good
AJ-065	LITU	16"	Good
AJ-066	OXAF	14"	Good
AJ-067	ACRU	4"	Good
AJ-068	ACRU	5"	Good
AJ-069	ACRU	10"	Good
AJ-070	ACRU	6"	Good
AJ-071	ACRU	6"	Good
AJ-072	PRSE	9"	Good
AJ-073	DIVI	3"	Good
AJ-074	LITU	8"	Fair
AJ-075	ACRU	21"	Good
AJ-076	LITU	13"	Good
AJ-077	LIST	13"	Good
AJ-078	LIST	4"	Good
AJ-079	LITU	18"	Poor
AJ-080	LITU	25"	Good
AJ-081	PRSE	9"	Good
AJ-082	LITU	22"	Good
AJ-083	LITU	21"	Good
AJ-084	PLOC	41"	Good
AJ-086	ACRU	9"	Good
AJ-087	JUVI	30"	Good
AJ-088	LIST	4"	Good
AJ-089	ACRU	18"	Good
AJ-090	ACRU	30"	Good
AJ-091	ACRU	30"	Good
AJ-092	LIST	4"	Good
AJ-093	LIST	9"	Good
AJ-094	FRPE	22"	Good
AJ-095	LIST	21"	Good
AJ-096	LIST	18"	Good
AJ-097	LITU	19"	Good
AJ-098	PRSE	8"	Good
AJ-099	QUNI	4"	Good
AJ-100	ILOP	4"	Good
AJ-101	QUST	29"	Poor
AJ-102	QURU	18"	Good
AJ-103	LIST	6"	Good
AJ-104	QURU	19"	Good
AJ-105	QUNI	17"	Good
AJ-106	LIST	7"	Good
AJ-107	QURU	28"	Good
AJ-108	LIST	5"	Good
AJ-109	QUST	18"	Good
AJ-110	PRSE	6"	Good
AJ-111	LIST	14"	Good
AJ-112	PITA	21"	Good
AJ-113	QUPH	18"	Good
AJ-114	PITA	28"	Good
AJ-115	CACA	5"	Good
AJ-116	QUST	20"	Good
AJ-117	CACA	6"	Good
AJ-117	CACA	7"	Good
AJ-118	QUNI	16"	Good
AJ-123	PITA	23"	Good
AJ-124	PITA	25"	Good
AJ-125	PRSE	6"	Good
AJ-126	QUNI	7"	Good
AJ-127	QUNI	7"	Good
AJ-128	PITA	20"	Good
AJ-129	PITA	20"	Good
AJ-130	LITU	21"	Good
AJ-131	ULRU	8"	Good

Tree Code	Botanical Name	DBH	Condition Overall
KH-002	PITA	30"	Good
KH-003	ACRU	31"	Good
KH-004	LITU	45"	Fair
KH-005	ULRU	7"	Good
KH-006	LIST	10"	Good
KH-007	LIST	6"	Good
KH-008	CATO	5"	Good
KH-009	JUVI	5	Good
KH-010	QURU	4"	Good
KH-011	CATO	6"	Good
KH-012	QUAL	21"	Good
KH-013	CATO	9"	Good
KH-014	QUAL	20"	Good
KH-015	QUPA	15"	Good
KH-016	CATO	10"	Good
KH-017	QUPA	10"	Good
KH-019	QUAL	20"	Good
KH-020	LIST	11"	Good
KH-020	CATO	12"	Good
KH-020	QUNI	12"	Good
KH-021	PITA	40"	Excellent
KH-023	LIST	5"	Good
KH-024	LIST	8"	Good
KH-025	JUVI	30"	Poor
KH-026	PRSE	6"	Good
KH-027	PITA	13"	Good
KH-028	PITA	13"	Good
KH-029	JUVI	8"	Good
KH-030	PRSE	5"	Good
KH-031	PLOR	3"	Fair
KH-032	DIVI	18"	Good
KH-033	PITA	25"	Excellent
KH-034	PITA	18"	Excellent
KH-035	PITA	29"	Good
KH-036	LIST	8"	Good
KH-037	ULRU	14"	Good
KH-038	PITA	17"	Good
KH-039	PITA	13"	Good
KH-040	PITA	16"	Good
KH-041	QUAL	6"	Good
KH-042	PITA	18"	Good
KH-043	ULRU	6"	Good
KH-044	QUNI	5"	Fair
KH-045	QUNI	8"	Good
KH-046	QUNI	6"	Good
KH-047	PITA	21"	Good
KH-048	PITA	21"	Good
KH-049	QUNI	5"	Good
KH-050	PITA	21"	Good
KH-051	QURU	6"	Good
KH-052	LIST	8"	Good
KH-053	QUAL	8"	Good
KH-054	PITA	20"	Good
KH-055	JUVI	6"	Good
KH-056	KOFL	3"	Good
KH-057	QUNI	5"	Good
KH-058	QUAL	10"	Good
KH-059	QUAL	5"	Good
KH-060	LIST	6"	Good
KH-061	QUNI	5"	Good
KH-062	QUAL	8"	Good
KH-063	QUNI	8"	Good
KH-064	QUAL	6"	Good
KH-065	PITA	10"	Good
KH-066	PITA	16"	Good

Tree Code	Botanical Name	DBH	Condition Overall
KH-067	PITA	13"	Good
KH-068	JUVI	9"	Good
KH-069	PITA	27"	Excellent
KH-070	ULRU	8"	Good
KH-071	ULRU	12"	Good
KH-072	LIST	14"	Good
KH-073	PITA	12"	Good
KH-075	QUNI	12"	Good
KH-076	QUAL	8"	Good
KH-077	QUAL	4"	Good
KH-078	QUAL	7"	Good
KH-079	PITA	14"	Good
KH-080	QUAL	7"	Good
KH-081	PITA	10"	Good
KH-082	PLOR	4"	Good
KH-083	PLOR	4"	Good
KH-084	PITA	15"	Good
KH-085	PITA	18"	Good
KH-086	QUNI	8"	Good
KH-087	MORU	4"	Good
KH-088	MORU	5"	Good
KH-089	MORU	5"	Good
KH-090	OXAR	7"	Good
KH-091	PRSE	22/14"	Poor
KH-092	QUNI	19"	Good
KH-093	MORU	6"	Good
KH-094	JUVI	7"	Good
KH-095	PRSE	14/16"	Good
KH-096	PRSE	25"	Good
KH-097	PRSE	4"	Fair
KH-098	PITA	11"	Good
KH-099	ULAL	3"	Good
KH-100	PITA	19"	Good
KH-101	QUNI	3"	Good
KH-102	ULRU	15"	Good
KH-103	ULRU	6"	Good
KH-104	PITA	11"	Good
KH-105	PITA	23"	Good
KH-106	PITA	22"	Good
KH-107	PITA	29"	Good
KH-108	PITA	26"	Good
KH-109	PITA	28"	Good
KH-110	QUNI	11"	Good
KH-111	QUNI	10"	Good
KH-112	QUNI	7"	Good
KH-113	QUNI	11"	Good
KH-114	QURU	11"	Good
KH-115	PRSE	4"	Poor
KH-116	PITA	12"	Good
KH-117	PITA	12"	Good
KH-118	PITA	13/10"	Good
KH-119	PITA	8"	Fair
KH-120	QUAL	11"	Good
KH-121	QURU	27"	Good
KH-121	LIST	7"	Good
KH-122	PRSE	5"	Good
KH-123	PITA	10/5"	Good
KH-124	JUVI	6"	Good
KH-125	LIST	7"	Good
KH-126	LIST	3"	Good
KH-127	PLOC	11"	Good
KH-128	PITA	10"	Good
KH-130	PITA	21"	Good
KH-131	PITA	25"	Good


5109 Mitchell Mill Road – Tree Inventory Species List

- ACRU - Acer rubrum
CACA - Carpinus caroliniana
CATO - Carya tomentosa
COFL - Cornus florida
DIVI - Diospyros virginiana
FRPE - Fraxinus pennsylvanica
ILOP - Ilex opaca
JUVI - Juniperus virginiana
LISI - Ligustrum sinense
LIST - Liquidambar styraciflua
LITU - Liriodendron tulipifera
MORU - Morus rubra
NYSY - Nyssa sylvatica
OXAR - Oxydendrum arboreum
PITA - Pinus taeda
PLOC - Platanus occidentalis
PLOR - Platycladus orientalis
PRSE - Prunus serotina
QUAL - Quercus alba
QUFA - Quercus falcata
QUNI - Quercus nigra
QUPA - Quercus pagoda
QUPH - Quercus phellos
QURU - Quercus rubra
QUST - Quercus stellata
QUVE - Quercus velutina
ULAL - Ulmus alata
ULRU - Ulmus rubra


Tree Code	Botanical Name	DBH	Condition Overall
KH-132	PITA	5"	Good
KH-133	PITA	8"	Good
KH-134	PITA	14"	Good
KH-135	QUNI	7"	Good
KH-136	PITA	29"	Good
KH-137	PITA	11"	Good
KH-138	QUNI	5"	Good
KH-139	QUNI	4"	Fair
KH-140	PITA	8"	Good
KH-141	LIST	5"	Good
KH-142	PITA	14"	Good
KH-143	ULRU	10"	Good
KH-144	QUNI	8"	Good
KH-145	PITA	24"	Good
KH-146	QUNI	7"	Good
KH-147	QUNI	12"	Good
KH-148	QUNI	14"	Good
KH-149	ULRU	7"	Good
KH-150	LISI	3"	Fair
KH-151	ULRU	9"	Good
KH-154	MORU	10"	Good
KH-155	ULRU	13"	Good
KH-156	PITA	31"	Good
KH-157	PRSE	9"	Good
KH-158	QURU	37"	Excellent
KH-159	LIST	6"	Good
KH-160	LITU	34"	Good
KH-163	QUAL	24"	Good
KH-164	QURU	23"	Good
KH-165	ILOP	9"	Good
KH-167	QUAL	21"	Good
KH-168	QUFA	21"	Good
KH-169	QUAL	22"	Good
KH-170	QURU	23"	Good
KH-171	PITA	21"	Good
KH-172	PITA	24"	Good
KH-173	LIST	9/8"	Fair
KH-174	PITA	5"	Good
KH-175	PITA	4"	Good
KH-176	PITA	6"	Good
KH-177	JUVI	8"	Good
KH-178	PITA	15"	Good
KH-179	QUNI	7"	Good
KH-180	QUNI	9"	Good
KH-181	QURU	6"	Good
KH-182	QUAL	8"	Good
KH-183	QUNI	6"	Good
KH-184	QUAL	8"	Good
KH-185	QUAL	8"	Good
KH-186	QUAL	13"	Good
KH-187	QUNI	10"	Good
KH-188	QUNI	5"	Good
KH-189	QUAL	13"	Good
KH-190	QUAL	10"	Good
KH-191	QUAL	14/13/12"	Good
KH-192	QUNI	6"	Good
KH-193	QUAL	4"	Good
KH-194	PRSE	6/5"	Good
KH-195	QUNI	7"	Good
KH-196	PRSE	7"	Good
KH-197	PITA	20"	Good
KH-198	PITA	14"	Good
KH-199	PITA	14"	Good
KH-200	PITA	20"	Good

Tree Code	Botanical Name	DBH	Condition Overall
KH-201	QUNI	4/4"	Fair
KH-202	QUNI	7"	Good
KH-203	QUAL	9"	Good
KH-204	QUNI	8"	Good
KH-205	PITA	20"	Poor
KH-206	PRSE	11"	Fair
KH-207	PITA	20"	Good
KH-208	PITA	12"	Good
KH-209	PITA	15"	Good
KH-210	PITA	13"	Good
KH-211	PITA	12"	Good
KH-212	PITA	12"	Good
KH-213	PITA	16"	Good
KH-214	PITA	10"	Good
KH-216	PITA	14"	Good
KH-217	PITA	14"	Good
KH-218	ULRU	11"	Good
KH-219	QUNI	4"	Good
KH-220	ULRU	15"	Good
KH-221	JUVI	5"	Good
KH-222	QURU	66"	Good
KH-223	QURU	22"	Good
KH-224	QURU	25"	Good
KH-225	ULRU	10"	Good
KH-226	CATO	6"	Good
KH-227	QURU	11"	Good
KH-228	PITA	22"	Good

Project section 2			
Zoning:	NC-CZ		
Total property area:		54.08	
Required tree protection area(AC)		8.11	
Required tree protection zones		Acres	Square Feet
NC-TS 1		5.63	245,051
NC-TS 2		0.78	33,955
NC-TS 3		0.39	16,854
NC-TS 4		0.29	12,690
NC-TS 5		0.17	7,483
NC-TS 6		0.15	6,452
TOTAL		7.40	322,484

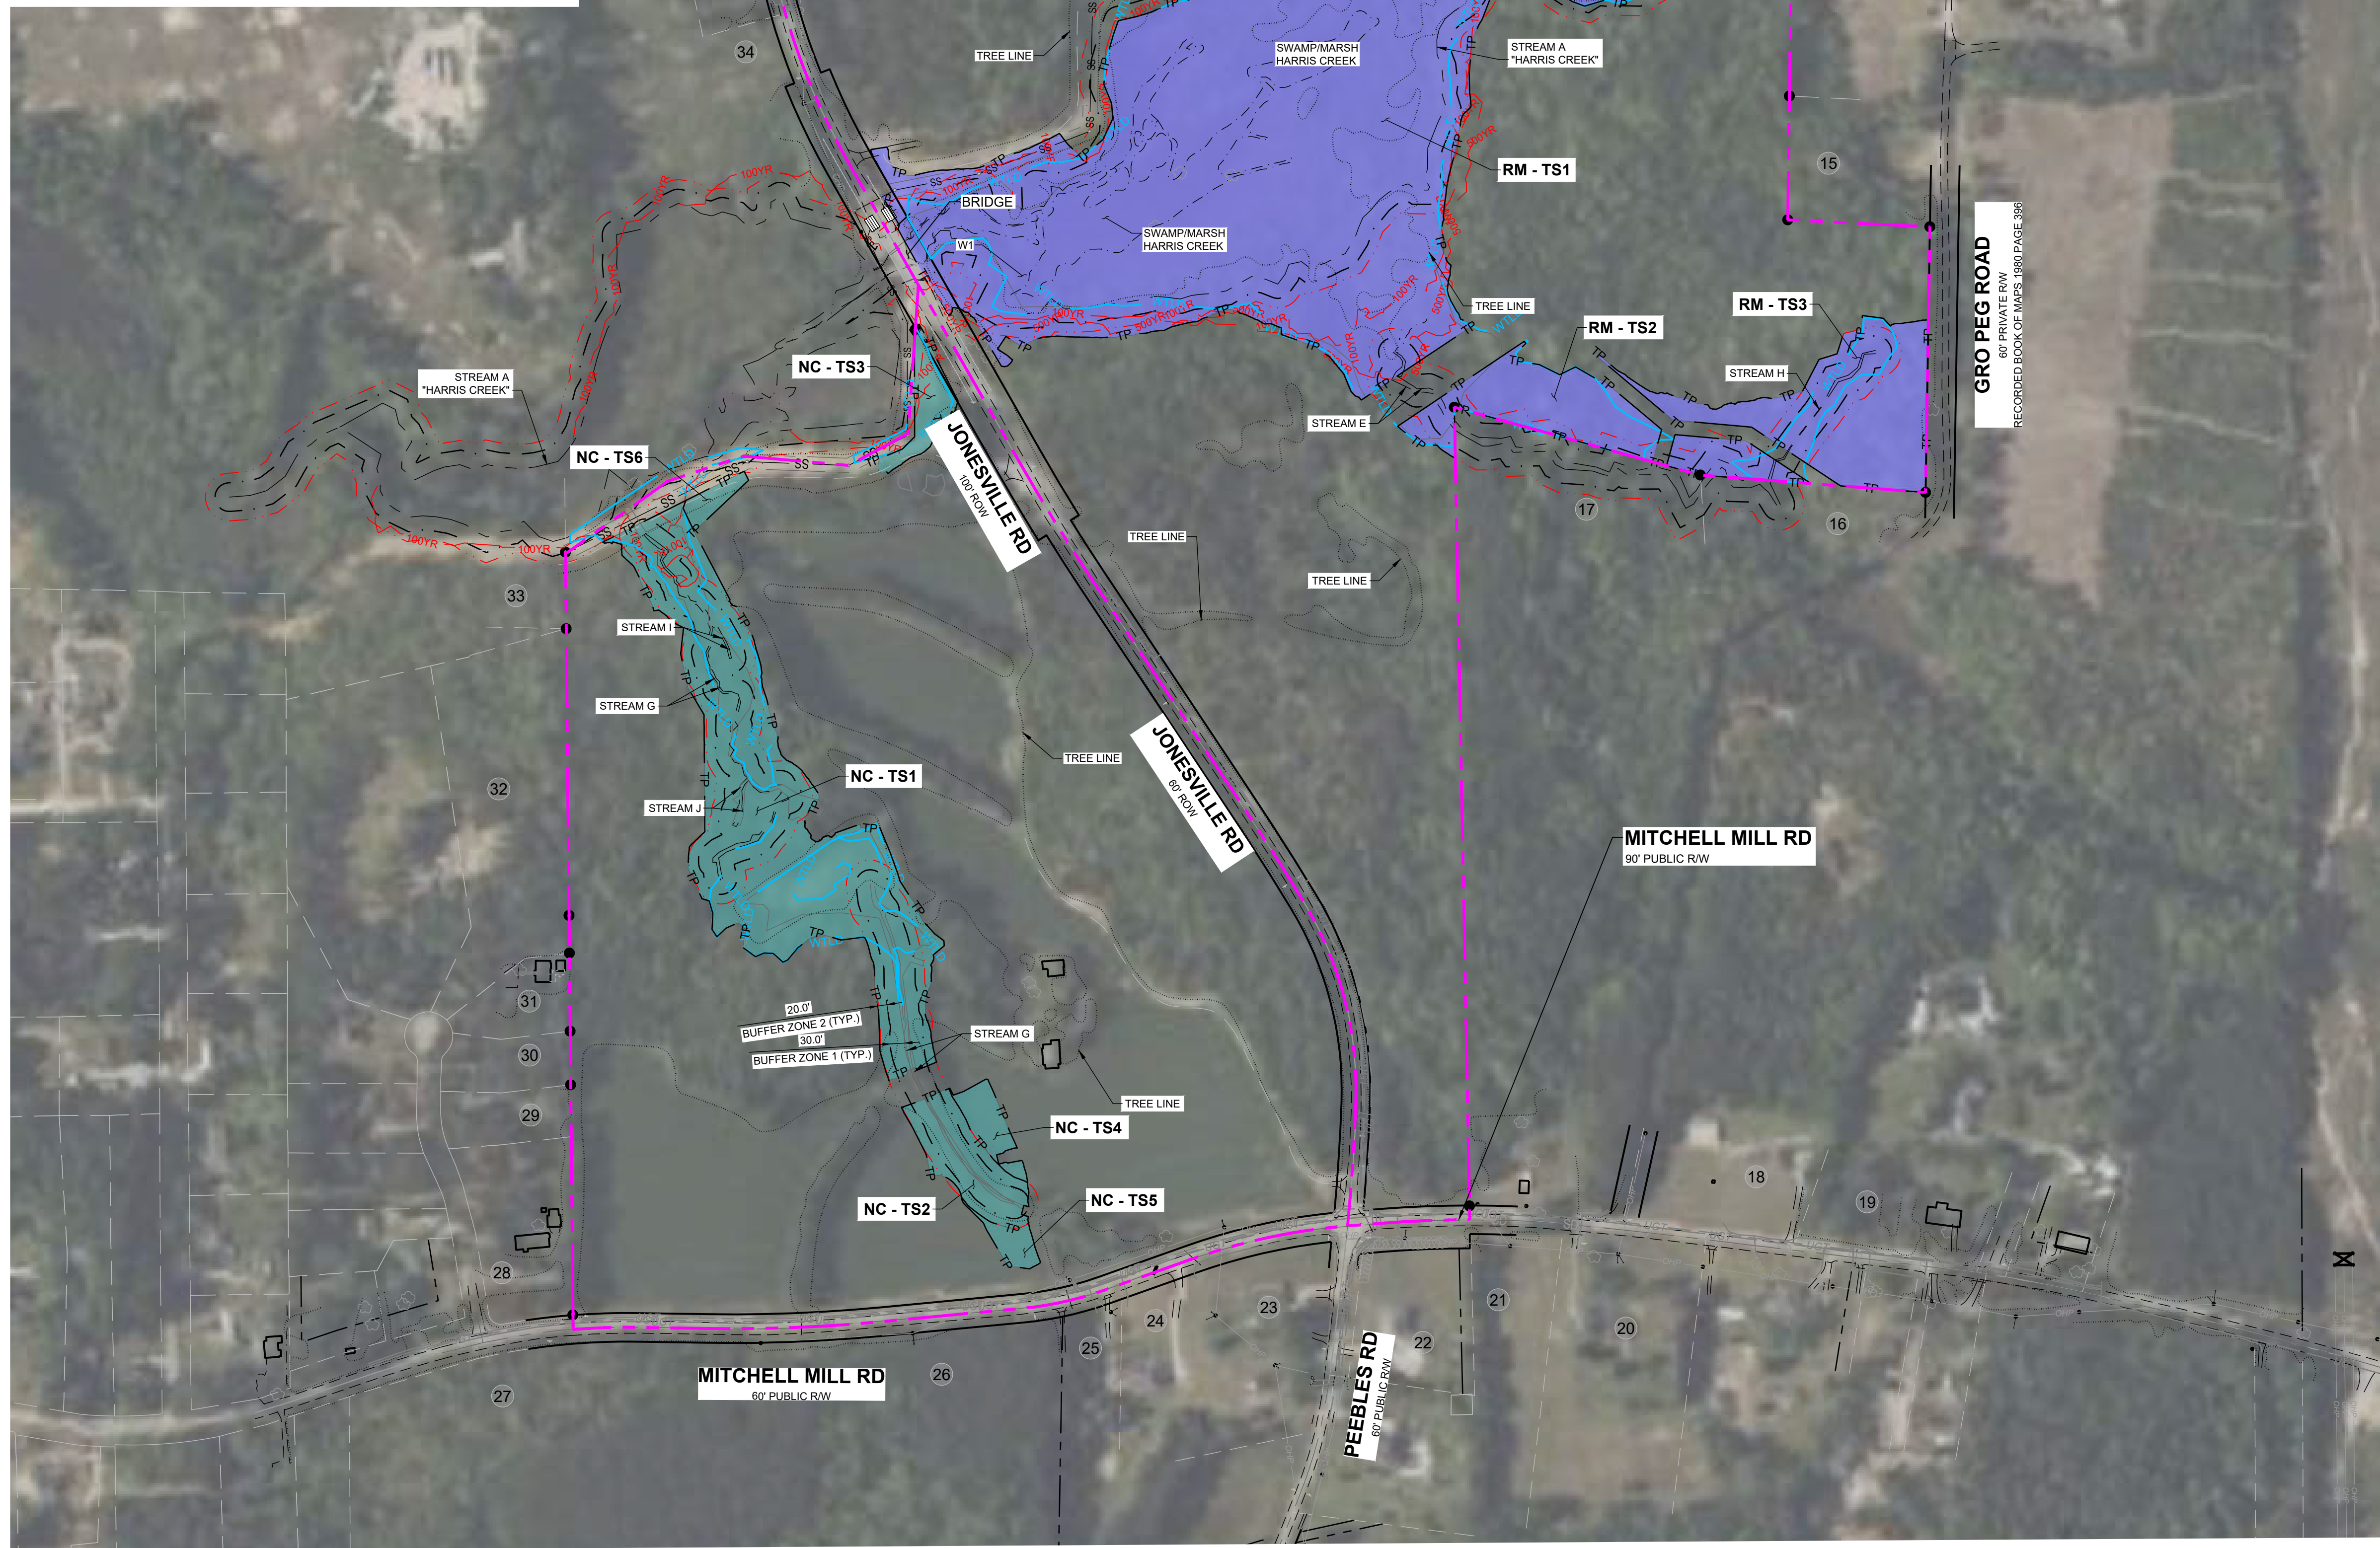

LEGEND:		
		MASTER PLAN BOUNDARY
		EXISTING ADJOINER PROPERTY LINE
		EXISTING INTERMITTENT STREAM
		EXISTING PERENNIAL STREAM
		EXISTING BUFFER ZONE 1
		EXISTING BUFFER ZONE 2
	500YR	500 YEAR FLOOD LINE
	100YR	100 YEAR FLOOD LINE
		SWAMP/MARSH HARRIS CREEK
		EXISTING TREE
		NEW IRON PIPE
		EXISTING IRON PIPE
	WTLD	
	WTLD	EXISTING WETLAND
		TREE PROTECTION AREA - NC ZONE
		TREE PROTECTION AREA - RM ZONE

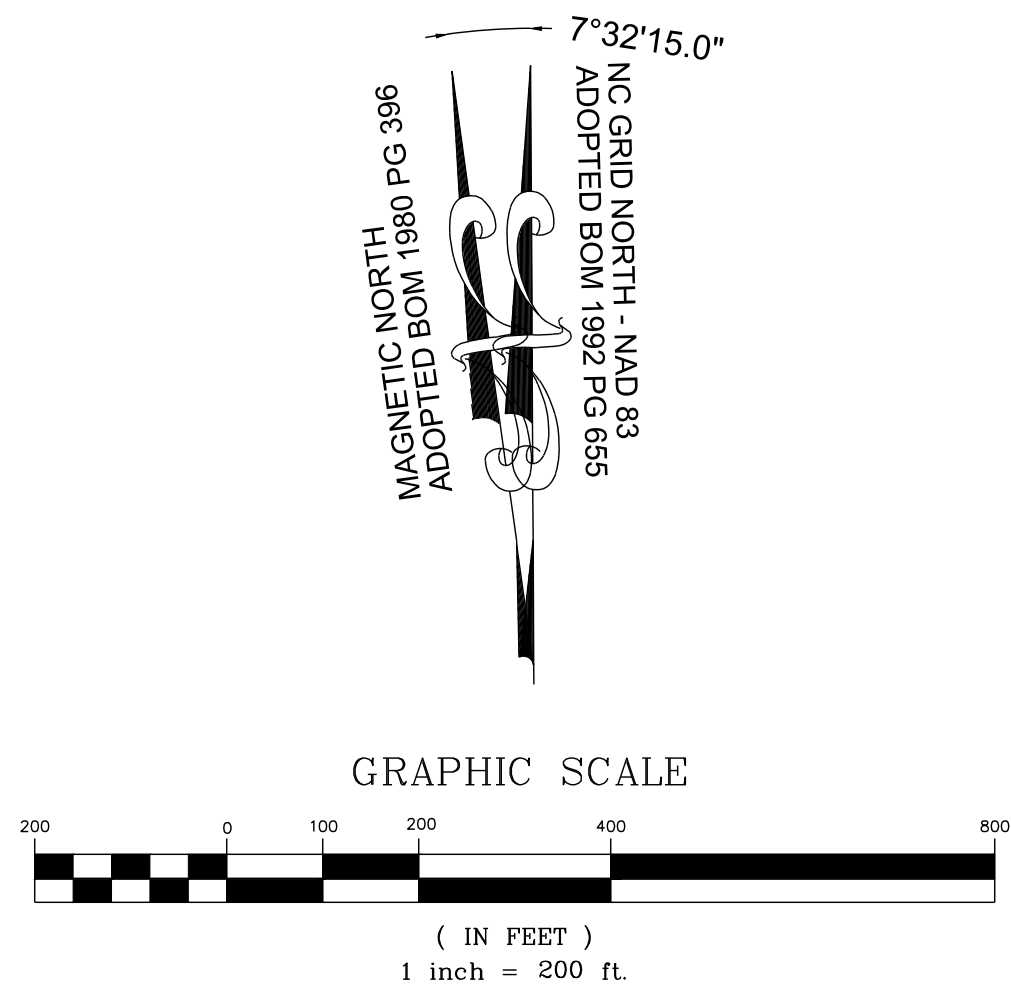

THIS PLANSET AND ANY ASSOCIATED DOCUMENTS ARE PRELIMINARY AND NOT AUTHORIZED FOR CONSTRUCTION UNTIL SIGNED, DATED, AND OFFICIALLY RELEASED FOR CONSTRUCTION BY THE ENGINEER OF RECORD.

01	CONSTRUCTION INFRASTRUCTURE DRAWINGS CID-24-04	06/04/2024	SREG
02	TOWN OF ROLESVILLE CID-24-04 V2	11/01/2024	SREG
03	TOWN OF ROLESVILLE CID-24-04 V3	02/01/2024	SREG
04	TOWN OF ROLESVILLE CID-24-04 V4	06/02/2025	SREG
No.	REVISIONS	DATE	BY

SEAL:

STRONGROCK
E N G I N E E R I N G G R O U P

STRONG ROCK ENGINEERING GROUP, PLLC | COMPANY LICENSE # P-2186
305 CHURCH AT NORTH HILLS STREET, SUITE 1110 RALEIGH, NC 27609 | INFORMATION@STRONGROCKGROUP.COM

STRONG ROCK PROJECT PSP-23-03	NOT FOR CONSTRUCTION	
SCALE	AS SHOWN	
DESIGNED BY	SRG	
DRAWN BY	SRG	
CHECKED BY	SRG	

RESERVE @ MITCHELL MILL
TOWN OF ROLESVILLE, WAKE COUNTY, NORTH CAROLINA

CONSTRUCTION PLANS


TREE PROTECTION PLAN

DRAWING
SHEET

C-3.10

14 OF 227

ADJOINER INFORMATION			
1	CHARLES E. FERRELL AND WIFE GRETTA LOUISE FERRELL PIN: 1757481951 DB 1813 PG 421 ZONING: R-30 (WC) USE: SF	20	CECIL L. GOODNIGHT AND WIFE, JUDY J. GOODNIGHT PIN: 1757050206 DB 5344 PG 819 ZONING: R-30 (WC) USE: SF
2	ABRAHAM T. BURNHAM AND KYLA L. BURNHAM PIN: 1757481832 DB 19140 PG 734 ZONING: R-30 (WC) USE: SF	21	CECIL L. GOODNIGHT AND WIFE, JUDY J. GOODNIGHT PIN: 1757481415 DB 5344 PG 819 ZONING: R-30 (WC) USE: VA
3	JOE L. GREEN PIN: 1757483799 DB 15-E PG 2691 ZONING: R-30 (WC) USE: SF	22	CHRISTOPHER GHOLSON AND WIFE, KELLY GATHER GHOLSON PIN: 1757556361 DB 17855 PG 457 LOT 4 - BM 2018 PG 1333 ZONING: R-30 (WC) USE: SF
4	CHARLES ALFONSA JONES AND WIFE ALLIE V. JONES PIN: 1757484609 DB 2306 PG 673 ZONING: R-30 (WC) USE: SF	23	ABAHOR ELIAS AND SPOUSE, SUSAN ELIAS PIN: 1757553215 DB 17220 PG 2509 LOT 3 - BM 2018 PG 1333 ZONING: R-30 (WC) USE: SF
5	BENJAMIN FERRELL PIN: 1757485713 DB 1697 PG 465 ZONING: R-30 (WC) USE: SF	24	TODD KENDALL HONEYCUTT PIN: 1757551202 DB 13474 PG 1974 LOT 2 - BM 2018 PG 1333 ZONING: R-30 (WC) USE: SF
6	ALESHIA FERRELL & ARRON WALKER PIN: 1757486733 DB 6374 PG 89 BM 1996 PG 00524 ZONING: R-30 (WC) USE: SF	25	CURTIS L. HONEYCUTT AND WIFE TODD KENDALL WALKER PIN: 1757540996 DB 19269 PG 2474 LOT 1 - BM 2018 PG 1333 ZONING: R-30 (WC) USE: SF
7	CHRIST HOLINESS CHURCH #1 PIN: 1757487783 DB 4926 PG 328 ZONING: R-30 (WC) USE: CH	26	PHETIS JONES BRADSHER PIN: 1757349473 DB 15208 PG 2320 BM 2013 PG 868 ZONING: R-30 (WC) USE: FO
8	CHRIST HOLINESS CHURCH #1 PIN: 1757489733 DB 4321 PG 788 ZONING: R-30 (WC) USE: VA	27	PHETIS JONES BRADSHER PIN: 1757349473 DB 15208 PG 2320 ZONING: R-30 (WC) USE: FO
9	CHRIST HOLINESS CHURCH #1 PIN: 1757580764 DB 9467 PG 430 ZONING: R-30 (WC) USE: VA	28	PERRY Y. ELWOOD RYAN PIN: 1757357582 DB 19292 PG 2780 ZONING: R-30 (WC) USE: MO
10	ALICIA BROWN & CARL T. JONES PIN: 1757582714 DB 16128 PG 183 ZONING: R-30 (WC) USE: SF	29	TOUTLOFF, KENNETH S. TOUTLOFF, BILLIE ANNE PIN: 1757357764 DB 9236 PG 2229 LOT 3 - BM 1990 PG 956 ZONING: R-30 (WC) USE: SF
11	RS RENTAL II LLC PIN: 1757584724 DB 18703 PG 2414 BM 1981 PG 894 ZONING: R-30 (WC) USE: SF	30	BERNARD MILLER PIN: 1757357865 DB 15416 PG 1651 LOT 4 - BM 1990 PG 956 ZONING: R-30 (WC) USE: SF
12	KAREN E. BASS PIN: 1757586704 DB 12560 PG 1626 BM 1984 PG 943 ZONING: R-30 (WC) USE: SF	31	MARJORIE L. HOLDEN PIN: 1757358908 DB 15599 PG 1003 LOT 5 - BM 1990 PG 956 ZONING: R-30 (WC) USE: SF
13	JAMES K. WILLIAMS PIN: 1757588784 DB 16784 PG 1013 BM 1989 PG 01474 ZONING: R-30 (WC) USE: VA	32	MEGAN KULAWIAK PIN: 1757367367 DB 16226 PG 1133 LOT 6 BM 1990 PG 00387 ZONING: R-30 (WC) USE: VA
14	GRO PEG PROPERTIES LLC PIN: 1757684897 DB 18359 PG 1707 LOT 5 - BM 1980 PG 00396 ZONING: R-30 (WC) USE: VA	33	KENNETH INVESTMENT LLC PIN: 1757368816 DB 19248 PG 1884 ZONING: R-30 (WC) USE: VA
15	SCOTT & THERESA CARLE PIN: 1757675786 DB 14863 PG 2493 LOT 4A - BM 1980 PG 00396 ZONING: R-30 (WC) USE: VA	34	KENNETH INVESTMENT LLC PIN: 1757471559 DB 19248 PG 1884 LOT - BM 2007 PG 01224 ZONING: R-30 (WC) USE: VA
16	GRO PEG PROPERTIES PIN: 175764956 DB 19081 PG 2786 LOT 2A - BM 1982 PG 00581 ZONING: R-30 (WC) USE: VA	35	HENRY ALSTON PIN: 1757481376 DB 19248 PG 964 BM 1982 PG 721 ZONING: R-30 (WC) USE: SF
17	MT. CALVARY HOLINESS CHURCH OF WAKE CO. INC PIN: 1757660324 DB 10124 PG 2778 LOT 1 - BM 2002 PG 991 ZONING: R-30 (WC) USE: VA	36	UNIVERSAL CHURCH OF PRAYER PIN: 1757388408 DB 19559 PG 1723 LOT - BM 2002 PG 00667 ZONING: R-30 (WC) USE: CH
18	G. ARCHIE UNDERHILL, JR. AND WIFE, TERESSA C. UNDERHILL PIN: 1757653765 DB 8443 PG 2129 BM 1999 PG 1357 ZONING: R-30 (WC) USE: SF	37	ROZELIA J. HARTSFIELD HEIRS PIN: 1757481740 DB 10-E PG 1220 ZONING: R-30 (WC) USE: VA
19	GENADIUS MAC PREDDY AND WIFE, MATTIE F. PREDDY PIN: 1757656586 DB 1882 PG 342 ZONING: R-30 (WC) USE: SF		

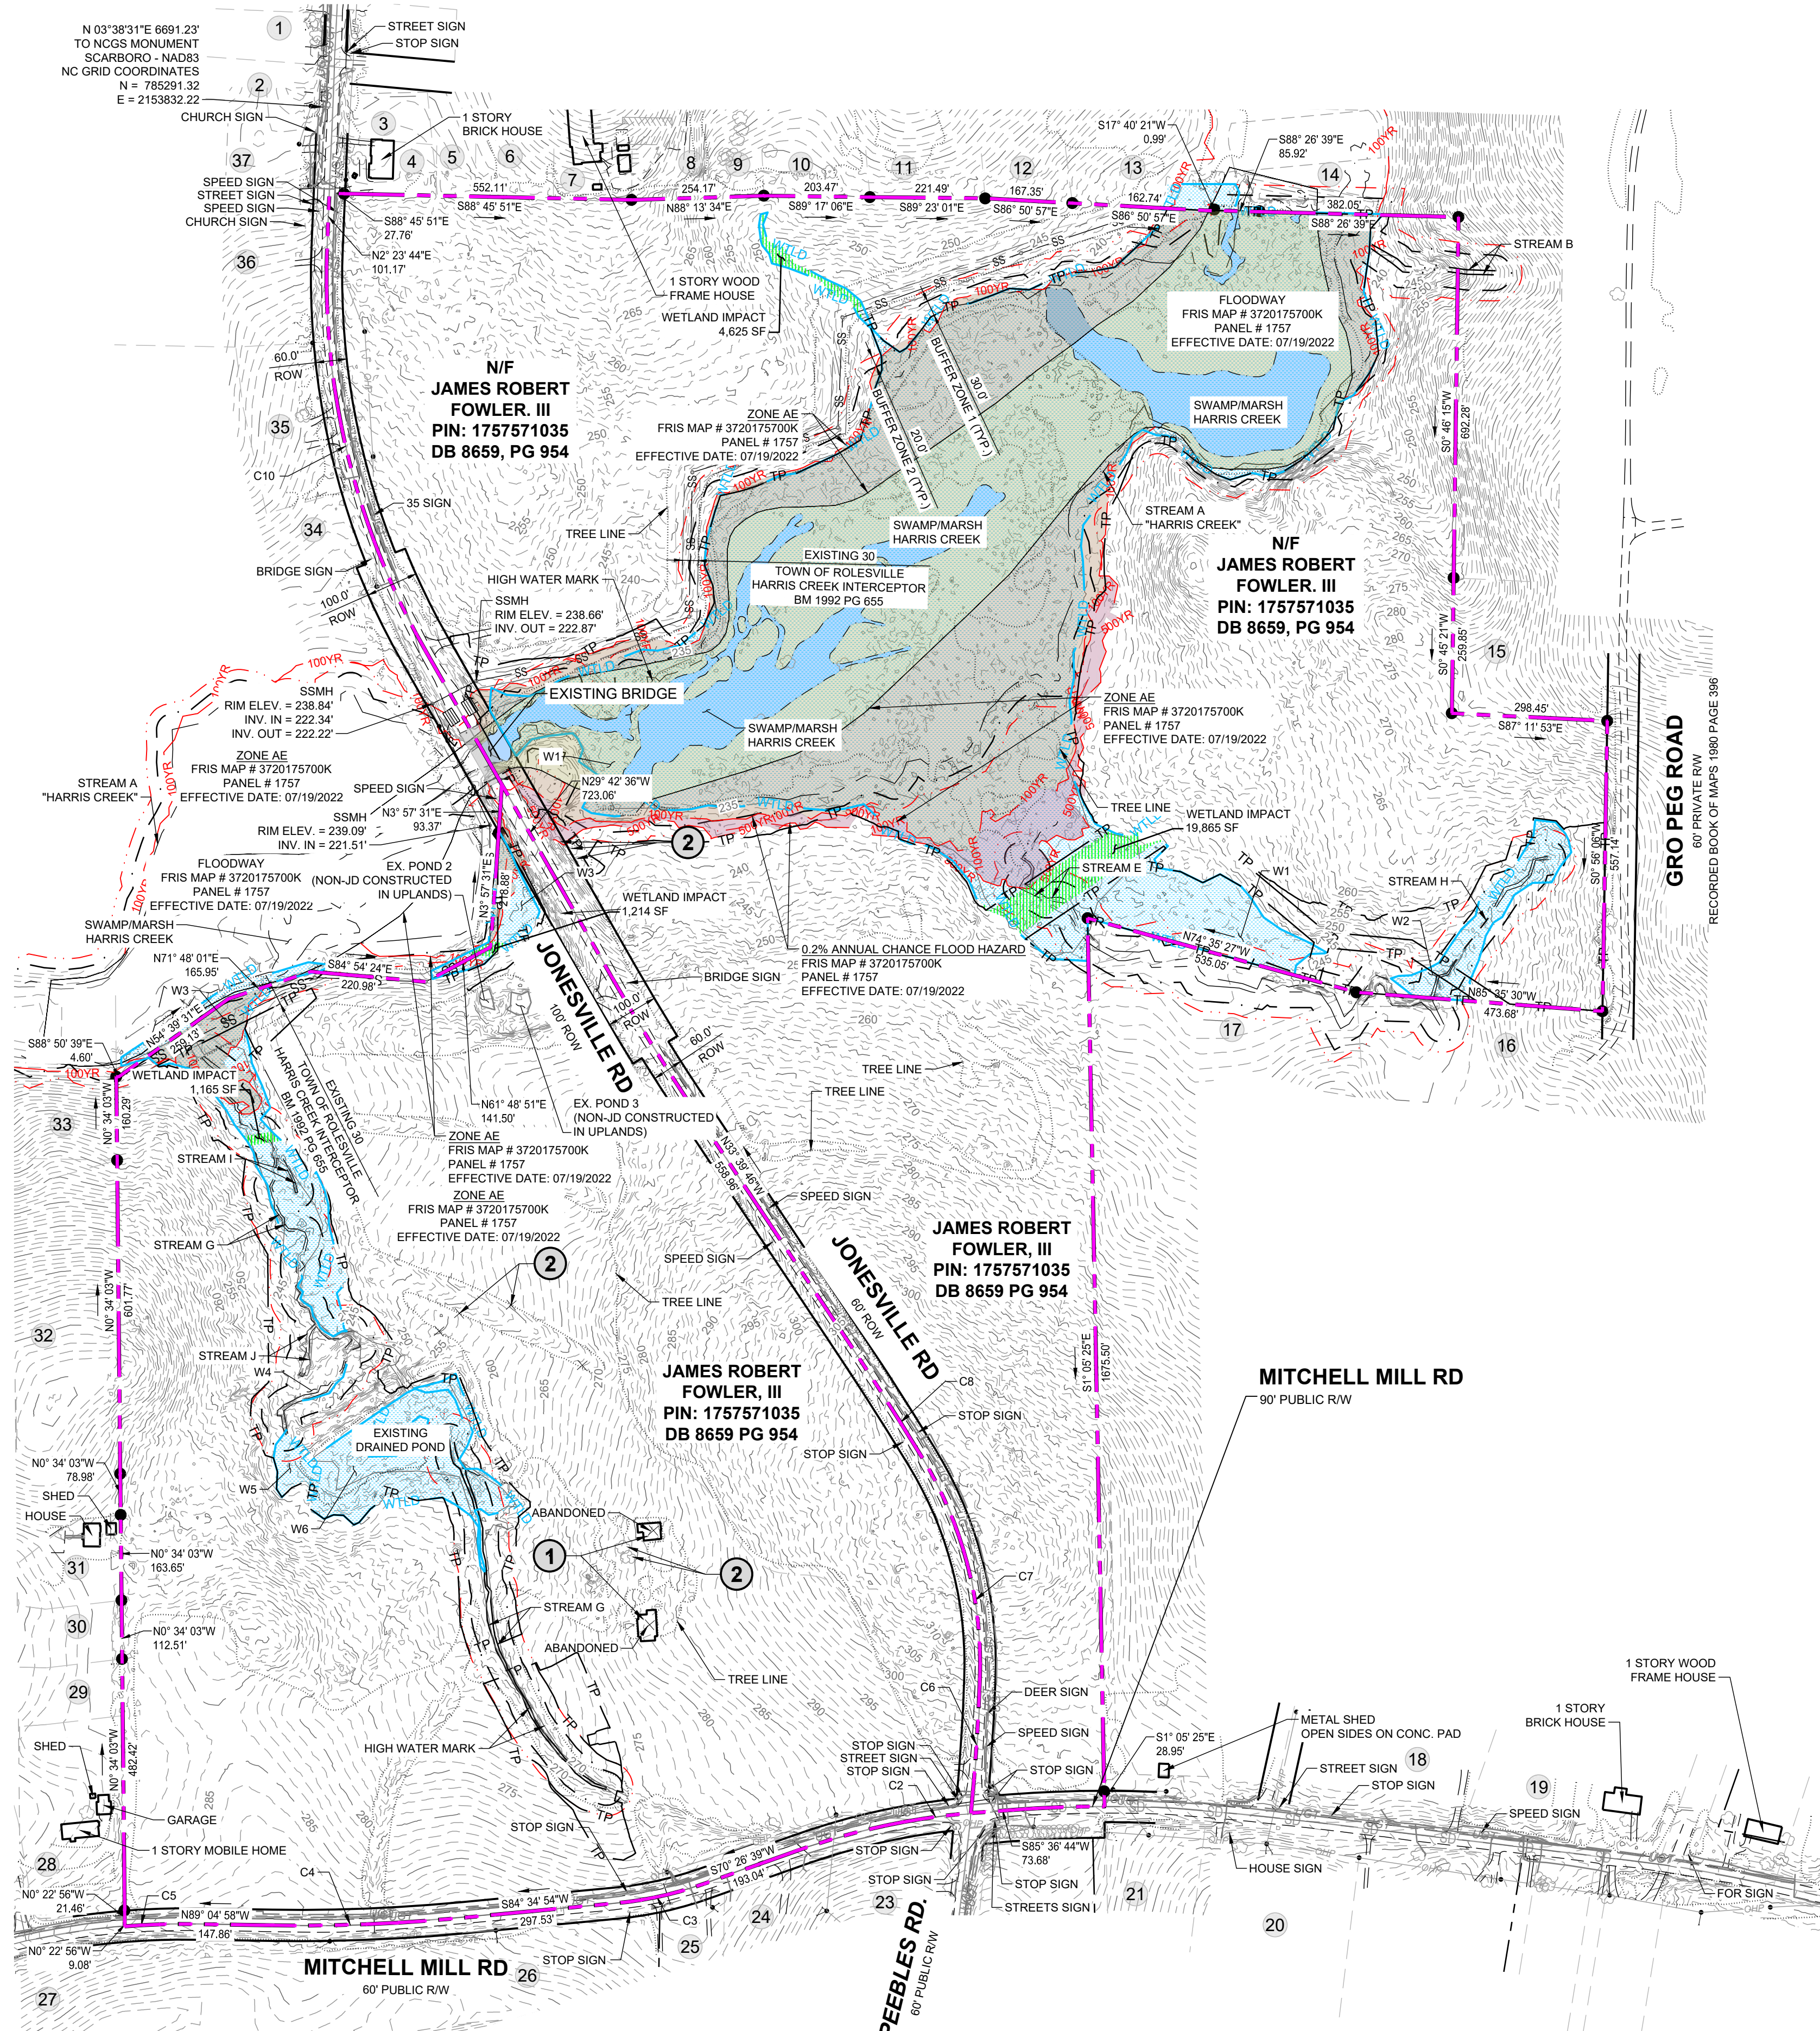



DEMOLITION KEYNOTES:

- 1 EXISTING BUILDING TO BE REMOVED.
- 2 EXISTING TREES TO BE REMOVED.

LEGEND:

- MASTER PLAN BOUNDARY
- EXISTING ADJOINER PROPERTY LINE
- 5' CONTOUR
- 1' CONTOUR
- EXISTING INTERMITTENT STREAM
- EXISTING PERENNIAL STREAM
- EXISTING BUFFER ZONE 1
- EXISTING BUFFER ZONE 2
- 500 YEAR FLOOD LINE
- 100 YEAR FLOOD LINE
- EXISTING TREE
- NEW IRON PIPE
- EXISTING IRON PIPE
- EXISTING WETLAND
- FLOOD HAZARD
- FLOODZONE AE
- FLOODWAY
- SWAMP/MARSH HARRIS CREEK
- WETLAND IMPACTS

PARCEL CURVE TABLE					
CURVE	RADIUS	LENGTH	CHORD	BEARING	
C1	2310.00'	177.66'	177.62'	S 85°36'44" W	
C2	1293.60'	342.46'	341.46'	S 70°26'39" W	
C3	713.00'	175.93'	175.49'	S 84°34'54" W	
C4	3289.02'	363.69'	363.50'	N 89°04'58" W	
C5	1415.00'	134.86'	134.81'	N 85°27'24" W	
C6	4219.80'	258.16'	259.12'	N 02°03'26" E	
C7	760.57'	443.75'	437.48'	N 31°22'17" W	
C8	5980.51'	247.98'	249.97'	N 33°39'46" W	
C9	4196.85'	289.52'	289.47'	N 29°42'36" W	
C10	1444.00'	809.14'	798.60'	N 02°23'44" E	

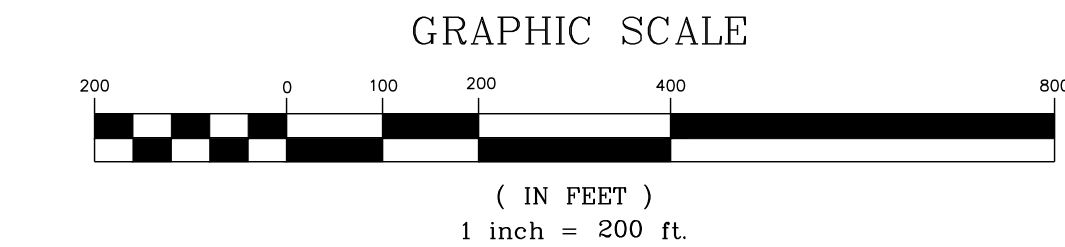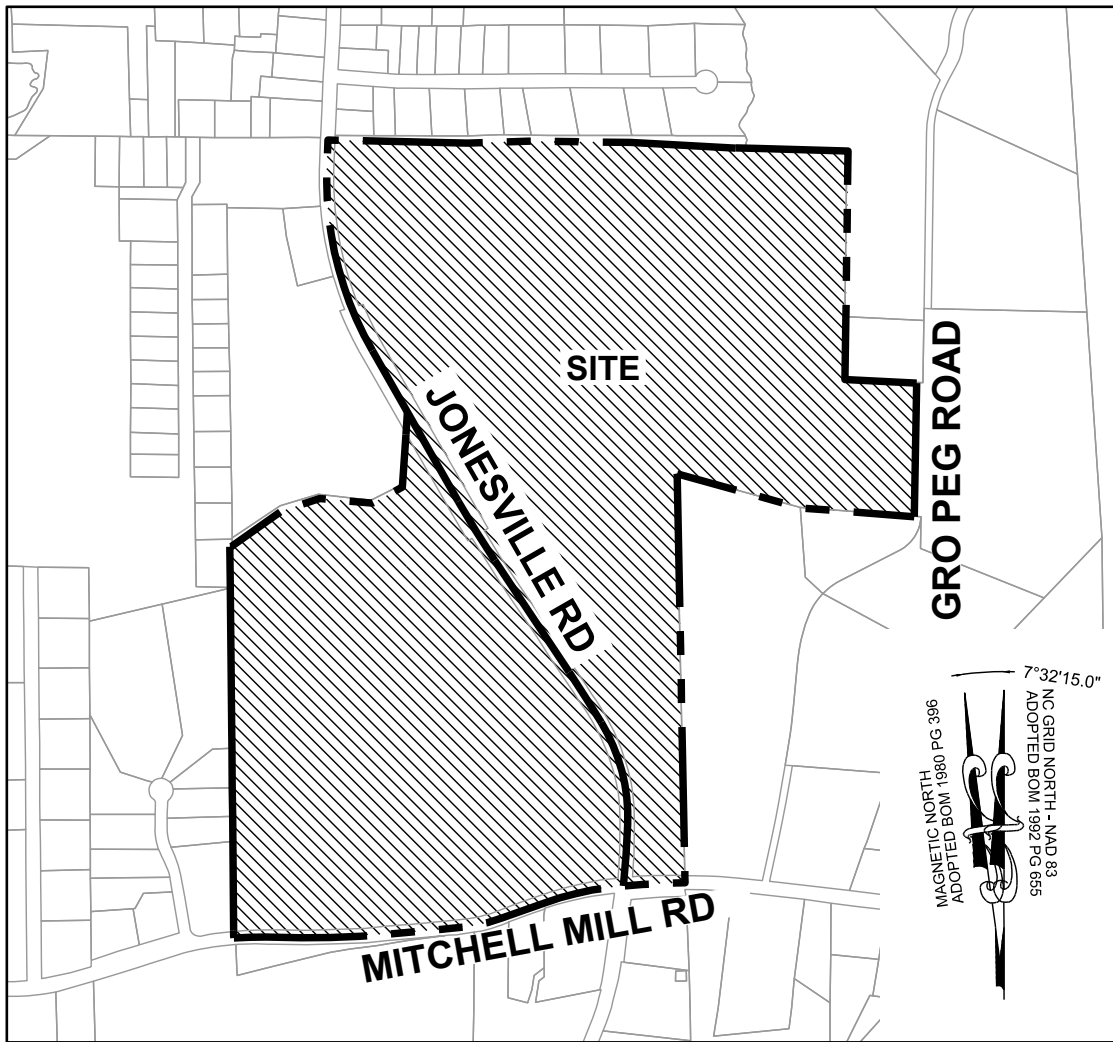

THIS PLANSET AND ANY ASSOCIATED DOCUMENTS ARE PRELIMINARY AND NOT AUTHORIZED FOR CONSTRUCTION UNTIL SIGNED, DATED, AND OFFICIALLY RELEASED FOR CONSTRUCTION BY THE ENGINEER OF RECORD.

STRONGROCK

ENGINEERING GROUP

STRONG ROCK ENGINEERING GROUP, PLLC | COMPANY LICENSE # P-2166
305 CHURCH AT NORTH HILLS STREET, SUITE 1110 RALEIGH, NC 27609 | INFORMATION@STRONGROCKGROUP.COM

STRONG ROCK PROJECT PSP-24-03	NOT FOR CONSTRUCTION	SCALE AS SHOWN	DESIGNED BY SRG	DRAWN BY SRG	CHECKED BY SRG
RESERVE @ MITCHELL MILL TOWN OF ROLESVILLE, WAKE COUNTY, NORTH CAROLINA CONSTRUCTION PLANS DEMOLITION PLAN					
DRAWING SHEET C-4.0					
15 OF 227					

SEAL:

01/01/2024
CID-24-04

02/01/2024
CID-24-04 V2

03/01/2024
CID-24-04 V3

04/01/2024
CID-24-04 V4

05/01/2024
CID-24-04 V5

06/01/2024
CID-24-04 V6

07/01/2024
CID-24-04 V7

08/01/2024
CID-24-04 V8

09/01/2024
CID-24-04 V9

10/01/2024
CID-24-04 V10

11/01/2024
CID-24-04 V11

12/01/2024
CID-24-04 V12

01/01/2025
CID-24-04 V13

02/01/2025
CID-24-04 V14

03/01/2025
CID-24-04 V15

04/01/2025
CID-24-04 V16

05/01/2025
CID-24-04 V17

06/01/2025
CID-24-04 V18

07/01/2025
CID-24-04 V19

08/01/2025
CID-24-04 V20

09/01/2025
CID-24-04 V21

10/01/2025
CID-24-04 V22

11/01/2025
CID-24-04 V23

12/01/2025
CID-24-04 V24

01/01/2026
CID-24-04 V25

02/01/2026
CID-24-04 V26

03/01/2026
CID-24-04 V27

04/01/2026
CID-24-04 V28

05/01/2026
CID-24-04 V29

06/01/2026
CID-24-04 V30

07/01/2026
CID-24-04 V31

08/01/2026
CID-24-04 V32

09/01/2026
CID-24-04 V33

10/01/2026
CID-24-04 V34

11/01/2026
CID-24-04 V35

12/01/2026
CID-24-04 V36

01/01/2027
CID-24-04 V37

02/01/2027
CID-24-04 V250

11/01/2044
CID-24-04 V251

12/01/2044
CID-24-04 V252

01/01/2045
CID-24-04 V253

02/01/2045
CID-24-04 V254

03/01/2045
CID-24-04 V255

04/01/2045
CID-24-04 V256

05/01/2045
CID-24-04 V257

06/01/2045
CID-24-04 V258

07/01/2045
CID-24-04 V259

08/01/2045
CID-24-04 V260

09/01/2045
CID-24-04 V261

10/01/2045
CID-24-04 V262

11/01/2045
CID-24-04 V263

12/01/2045
CID-24-04 V264

01/01/2046
CID-24-04 V265


02/01/2046
CID-24-04 V266

03/01/2046
CID-24-04 V267

04/01/2046
CID-24-04 V268


05/01/2046
CID-24-04 V269

06/01/

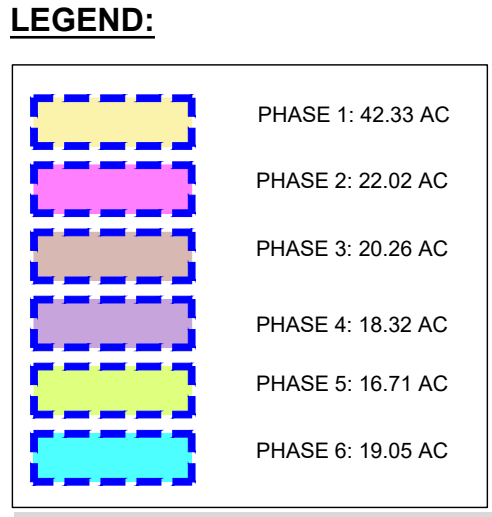

NOTES:
SEE COVER SHEET FOR ALL SETBACK REQUIREMENTS
SEE SHEET C-3.0 FOR ADJACENT PROPERTY DETAILS
SEE SHEETS C-6 FOR OPEN SPACE INFORMATION

TOWNHOME NOTES:
STATES INTERNAL TOWNHOME DRIVEWAYS ARE PRIVATE EASEMENTS AS PER CITY OF RALEIGH PUBLIC UTILITIES DEPARTMENT

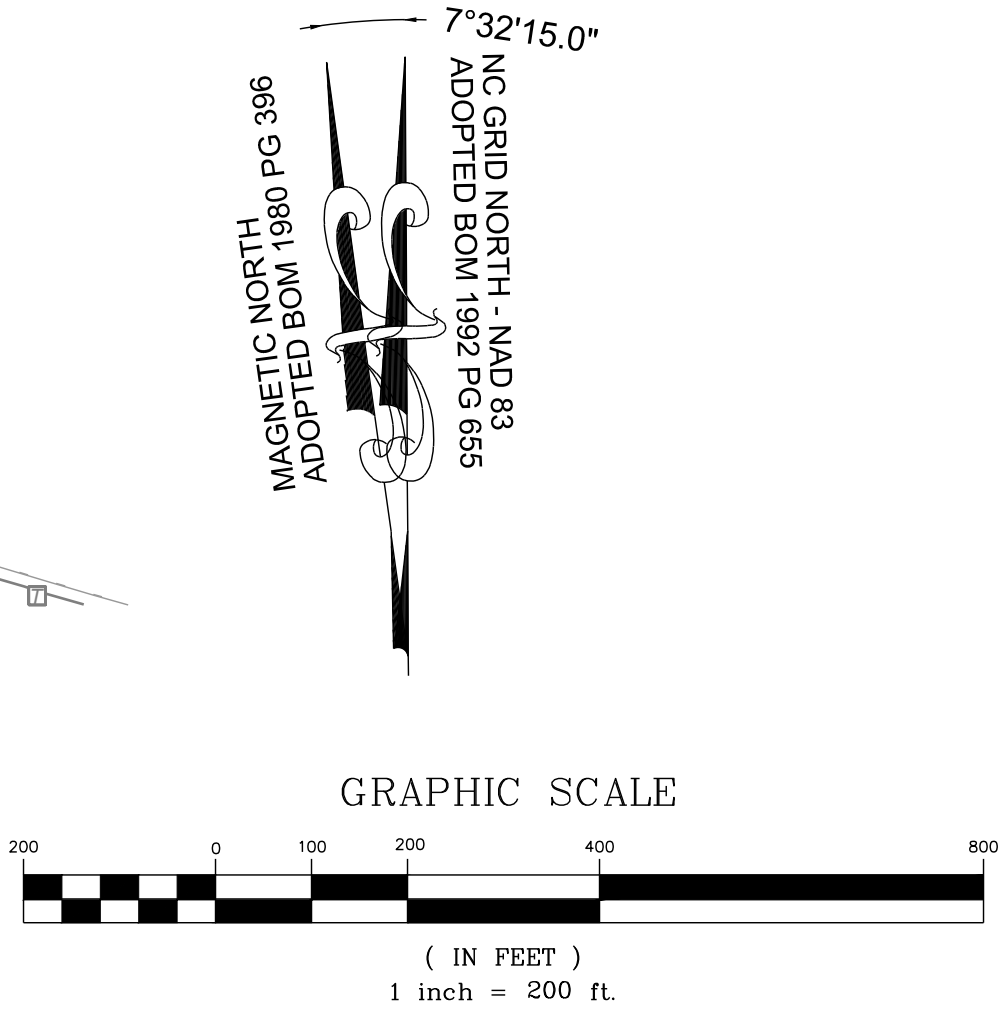

THIS PLANSET AND ANY ASSOCIATED DOCUMENTS ARE PRELIMINARY AND NOT AUTHORIZED FOR CONSTRUCTION UNTIL SIGNED, DATED, AND OFFICIALLY RELEASED FOR CONSTRUCTION BY THE ENGINEER OF RECORD.

STRONGROCK

ENGINEERING GROUP

STRONG ROCK ENGINEERING GROUP, PLLC | COMPANY LICENSE # P-2166
305 CHURCH AT NORTH HILLS STREET, SUITE 1110 RALEIGH, NC 27609 | INFORMATION@STRONGROCKGROUP.COM

STRONG ROCK PROJECT
PSP-24-03

NOT FOR
CONSTRUCTION

SCALE AS SHOWN

DESIGNED BY SRG

DRAWN BY SRG

CHECKED BY SRG

RESERVE @ MITCHELL MILL
TOWN OF ROLESVILLE, WAKE COUNTY, NORTH CAROLINA
CONSTRUCTION PLANS
PHASING PLAN

DRAWING
SHEET
C-5.0

16 OF 227

SEAL:

CONSTRUCTION INFRASTRUCTURE DRAWINGS
CID-24-04

01

02

03

04

No.

REVISIONS

DATE

BY

01	CONSTRUCTION INFRASTRUCTURE DRAWINGS CID-24-04	08/04/2024	SRG
02	TOWN OF ROLESVILLE CID-24-04 V2	11/07/2024	SRG
03	TOWN OF ROLESVILLE CID-24-04 V3	02/07/2024	SRG
04	TOWN OF ROLESVILLE CID-24-04 V4	08/02/2025	SRG
No.	REVISIONS	DATE	BY



LEGEND:


	BLOCK A		BLOCK T
	BLOCK B		BLOCK U
	BLOCK C		BLOCK V
	BLOCK D		BLOCK W
	BLOCK E		BLOCK X
	BLOCK F		BLOCK Y
	BLOCK G		BLOCK Z
	BLOCK H		BLOCK AA
	BLOCK I		BLOCK AB
	BLOCK J		BLOCK AC
	BLOCK K		BLOCK AD
	BLOCK L		BLOCK AE
	BLOCK M		BLOCK AF
	BLOCK N		BLOCK AG
	BLOCK O		BLOCK AH
	BLOCK P		BLOCK AI
	BLOCK Q		
	BLOCK R		
	BLOCK S		

TOWNHOME NOTES:


STATES INTERNAL TOWNHOME DRIVEWAYS ARE PRIVATE EASEMENTS AS PER CITY OF RALEIGH PUBLIC UTILITIES DEPARTMENT

NOTES:

SEE COVER SHEET FOR ALL SETBACK REQUIREMENTS
SEE SHEET C-3.0 FOR ADJACENT PROPERTY DETAILS

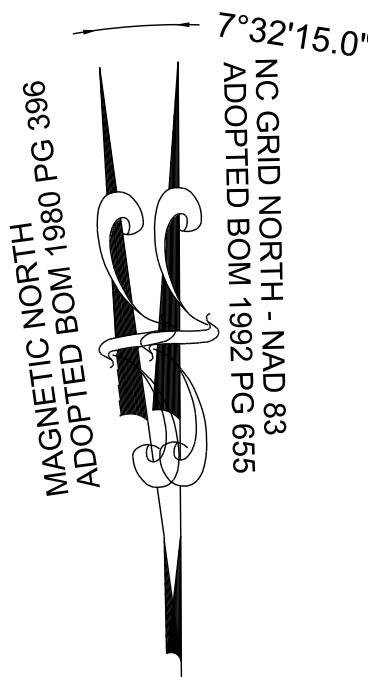

GRAPHIC SCALE

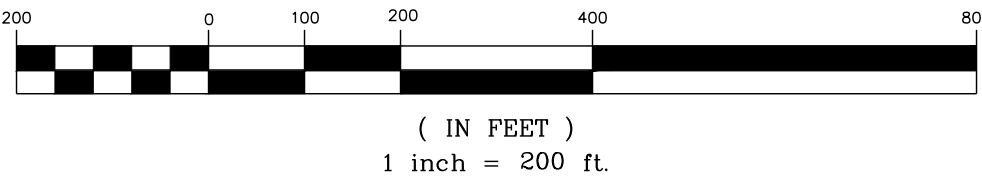

THIS PLANSET AND ANY ASSOCIATED DOCUMENTS ARE PRELIMINARY AND NOT AUTHORIZED FOR CONSTRUCTION UNTIL SIGNED, DATED, AND OFFICIALLY RELEASED FOR CONSTRUCTION BY THE ENGINEER OF RECORD.

STRONGROCK

ENGINEERING GROUP

STRONG ROCK ENGINEERING GROUP, PLLC | COMPANY LICENSE # P-2166
305 CHURCH AT NORTH HILLS STREET, SUITE 1110 RALEIGH, NC 27609 | INFORMATION@STRONGROCKGROUP.COM

STRONG ROCK PROJECT
PSP-24-03

NOT FOR
CONSTRUCTION

SCALE
AS SHOWN

DESIGNED BY
SRG

DRAWN BY
SRG

CHECKED BY
SRG

RESERVE @ MITCHELL MILL
TOWN OF ROLESVILLE, WAKE COUNTY, NORTH CAROLINA

CONSTRUCTION PLANS

BLOCK AND LOT PLAN

DRAWING
SHEET

C-5.1

17 OF 227

CONSTRUCTION INFRASTRUCTURE DRAWINGS	08/04/2024	SRG	BY
CID-24-04			DATE
TOWN OF ROLESVILLE CID-24-04 V2	11/07/2024	SRG	
TOWN OF ROLESVILLE CID-24-04 V3	02/07/2024	SRG	
TOWN OF ROLESVILLE CID-24-04 V4	08/02/2025	SRG	
No.			
REVISIONS			

LINE TABLE					
NAME	ROADWAY	LENGTH	DIRECTION	BEGIN STATION	END STATION
L1	SOUNDGARDEN COURT	729.66'	N89°58'55"E	10+00.00	17+29.66
L2	SOUNDGARDEN COURT	211.22'	N70°13'32"E	20+27.63	22+38.85
L3	SOUNDGARDEN COURT	28.00'	N19°46'28"W	22+38.85	22+66.85
L4	CORNELL GARDEN STREET	491.62'	N65°38'58"E	10+00.00	14+91.62
L5	CORNELL GARDEN STREET	15.79'	N0°01'05"W	19+50.07	19+65.85
L6	LIGHTNING BOLT LANE	1222.94'	N56°12'22"E	10+00.00	22+22.94
L7	LIGHTNING BOLT LANE	451.93'	S87°11'53"E	25+42.30	29+94.22
L8	UNPLUGGED AVENUE	176.90'	N33°46'39"W	10+00.00	11+76.90
L9	UNPLUGGED AVENUE	348.89'	N56°12'22"E	11+76.90	15+25.79
L10	UNPLUGGED AVENUE	28.00'	N33°47'38"W	15+25.79	15+53.79
L11	GIGATON STREET	175.00'	S33°46'39"E	10+00.00	11+75.00
L12	GIGATON STREET	70.05'	S32°03'33"E	12+05.00	12+75.05
L13	GIGATON STREET	406.86'	S33°46'39"E	13+05.04	17+11.90
L14	GIGATON STREET	68.95'	S1°05'25"E	18+43.12	19+12.07
L15	COUNTER STREET	103.46'	S33°47'38"E	10+00.00	11+03.46
L16	COUNTER STREET	530.88'	S1°05'25"E	12+34.74	17+65.61
L17	MONKEYWRENCH STREET	85.37'	S88°54'35"W	10+00.00	10+85.37
L18	MONKEYWRENCH STREET	2.12'	S56°13'21"W	12+16.59	12+18.71
L19	SUPERSONIC WAY	11.85'	N28°40'28"W	10+00.00	10+11.85
L20	SUPERSONIC WAY	264.97'	N0°41'10"E	11+29.71	13+94.68
L21	SUPERSONIC WAY	258.23'	S89°18'50"E	13+94.68	16+52.91
L22	PARACHUTE PLACE	61.73'	S28°40'26"E	10+00.00	10+61.73
L23	PARACHUTE PLACE	2.61'	N59°15'52"E	14+31.29	14+33.90
L24	PARACHUTE PLACE	4.68'	N2°48'07"E	16+60.56	16+65.24
L25	LUKIN LANE	434.34'	N0°41'10"E	10+00.00	14+34.34
L26	MCCREADY COURT	116.47'	S56°12'22"W	10+00.00	11+16.47
L27	MCCREADY COURT	351.71'	S79°05'59"W	12+40.34	15+92.05
L28	OCEANS COURT	115.42'	N14°39'30"W	10+00.00	11+15.42
L29	OCEANS COURT	17.18'	N2°10'11"W	11+91.71	12+08.88
L30	OCEANS COURT	288.95'	N23°37'43"W	13+24.99	16+13.93

LINE TABLE					
NAME	ROADWAY	LENGTH	DIRECTION	BEGIN STATION	END STATION
L31	OCEANS COURT	76.14'	N8°29'13"W	17+46.08	18+22.21
L32	OCEANS COURT	274.64'	N33°36'56"W	19+58.17	22+32.81
L33	OCEANS COURT	56.04'	N10°59'05"W	23+55.26	24+11.30
L34	OCEANS COURT	103.92'	N10°59'05"W	24+11.31	25+15.22
L35	OCEANS COURT	30.91'	N10°59'05"W	25+15.22	25+46.13
L36	BETTERMAN DRIVE	205.88'	S56°21'23"W	10+00.00	12+05.88
L37	BETTERMAN DRIVE	298.92'	S81°30'47"W	13+59.56	16+58.48
L38	VEDDER LANE	7.54'	N12°48'44"W	10+00.00	10+07.54
L39	VEDDER LANE	169.36'	N33°39'46"W	10+91.24	12+60.59
L40	EVEN FLOW LANE	398.73'	N90°00'00"E	10+00.00	13+98.73
L41	EVEN FLOW LANE	167.06'	N66°21'40"E	16+05.02	17+72.08
L42	YELLOW MOON COURT	282.58'	N89°38'34"E	10+00.00	12+82.58
L43	YELLOW MOON COURT	269.10'	N85°56'51"E	13+46.50	16+15.59
L44	YELLOW MOON COURT	28.00'	N4°03'09"W	16+15.60	16+43.59
L45	PENDULUM STREET	1364.52'	N0°23'26"W	10+00.00	23+64.52
L46	PENDULUM STREET	145.41'	S89°38'32"W	23+64.53	25+09.93
L47	MOOKIE ALLEY	22.33'	S12°40'02"E	10+00.00	10+22.33
L48	MOOKIE ALLEY	341.67'	S33°36'56"E	10+77.18	14+18.84
L49	MOOKIE ALLEY	125.34'	S23°26'24"E	14+45.48	15+70.82
L50	CAMERON SOUND ALLEY	20.01'	N56°23'04"E	10+00.00	10+20.01
L51	CAMERON SOUND ALLEY	225.68'	N81°30'47"E	10+85.80	13+11.48
L52	CAMERON SOUND ALLEY	163.72'	N56°21'23"E	13+77.34	15+41.05
L53	DARK MATTER ALLEY	16.09'	N56°23'04"E	10+00.00	10+16.09
L54	DARK MATTER ALLEY	303.00'	N79°05'59"E	10+75.57	13+78.57
L55	DARK MATTER ALLEY	111.56'	N56°23'04"E	14+38.04	15+49.60
L56	GUARANTEED ALLEY	120.13'	N79°05'59"E	10+00.00	11+20.13
L57	GUARANTEED ALLEY	355.03'	N58°06'55"E	11+75.08	15+30.10
L58	PEARL JAM ALLEY	22.86'	N33°38'37"W	10+00.00	10+22.86
L59	PEARL JAM ALLEY	32.89'	N25°36'48"W	10+43.89	10+76.78
L60	PEARL JAM ALLEY	192.60'	N33°36'56"W	10+97.73	12+90.33

CURVE TABLE					
NAME	ROADWAY	RADIUS	ARC LENGTH	CHORD LENGTH	CHORD DIRECTION
C1	SOUNDGARDEN COURT	230.00'	109.33'	108.30'	S76°24'01"E
C2	SOUNDGARDEN COURT	230.00'	188.64'	183.39'	S86°16'43"E
C3	FUTURE DAYS WAY	1250.00'	518.68'	514.96'	S11°25'57"E
C4	CORNELL GARDEN STREET	400.00'	458.45'	433.76'	N32°48'56"E
C5	LIGHTNING BOLT LANE	500.00'	319.36'	313.96'	N74°30'15"E
C6	GIGATON STREET	1000.00'	29.99'	29.99'	S32°55'06"E
C7	GIGATON STREET	1000.00'	29.99'	29.99'	S32°55'06"E
C8	GIGATON STREET	230.00'	131.21'	129.44'	S17°26'02"E
C9	COUNTER STREET	230.00'	131.28'	129.51'	S17°26'31"E
C10	MONKEYWRENCH STREET	230.00'	131.21'	129.44'	S72°33'58"W
C11	SUPERSONIC WAY	230.00'	117.86'	116.57'	N13°59'38"W
C12	PARACHUTE PLACE	230.00'	369.56'	331.07'	S74°42'17"E
C13	PARACHUTE PLACE	230.00'	226.68'	217.60'	N31°02'00"E
C14	MCCREADY COURT	310.00'	123.87'	123.04'	S67°39'11"W
C15	OCEANS COURT	350.00'	76.29'	76.14'	N8°24'51"W
C16	OCEANS COURT	310.00'	116.10'	115.43'	N12°53'57"W
C17	OCEANS COURT	500.00'	132.14'	131.75'	N16°03'28"W
C18	OCEANS COURT	310.00'	135.96'	134.87'	N21°03'04"W
C19	OCEANS COURT	310.00'	122.44'	121.65'	N22°18'00"W
C20	BETTERMAN DRIVE	350.00'	153.67'	152.44'	S68°56'05"W
C21	VEDDER LANE	230.00'	83.70'	83.24'	N23°14'15"W
C22	EVEN FLOW LANE	500.00'	206.29'	204.83'	N78°10'50"E
C23	YELLOW MOON COURT	1000.00'	63.91'	63.90'	N87°46'43"E
C24	MOOKIE ALLEY	150.00'	54.84'	54.54'	S23°08'29"W
C25	MOOKIE ALLEY	150.00'	26.64'	26.60'	S28°31'40"E



TOWNHOME NOTES:
STATES INTERNAL TOWNHOME DRIVEWAYS ARE PRIVATE EASEMENTS AS PER CITY OF RALEIGH PUBLIC UTILITIES DEPARTMENT


NOTES:
SEE COVER SHEET FOR ALL SETBACK REQUIREMENTS
SEE SHEET C-3.0 FOR ADJACENT PROPERTY DETAILS

CURVE TABLE					
NAME	ROADWAY	RADIUS	ARC LENGTH	CHORD LENGTH	CHORD DIRECTION
C26	CAMERON SOUND ALLEY	150.00'	65.79'	65.26'	N68°56'56"E
C27	CAMERON SOUND ALLEY	150.00'	65.86'	65.33'	N68°56'05"E
C28	DARK MATTER ALLEY	150.00'	59.47'	59.08'	N67°44'32"E
C29	DARK MATTER ALLEY	150.00'	59.47'	59.08'	N67°44'32"E
C30	GUARANTEED ALLEY	150.00'	54.94'	54.63'	N68°36'27"E
C31	PEARL JAM ALLEY	150.00'	21.02'	21.01'	N29°37'42"W
C32	PEARL JAM ALLEY	150.00'	20.95'	20.93'	N29°36'52"W

- GENERAL NOTES:**
- ALL CONSTRUCTION SHALL CONFORM TO TOWN OF ROLESVILLE AND CITY OF RALEIGH STANDARDS AND SPECIFICATIONS.
 - ROADS AND DRIVEWAYS SHALL COMPLY WITH NCDOT AND TOWN OF ROLESVILLE STANDARDS.
 - SIGN PERMITS SHALL BE REQUIRED FOR ANY ENTRANCE SIGNAGE. PERMITS SHALL BE REQUIRED PRIOR TO FABRICATION OR INSTALLATION OF SIGNS. SIGNAGE SHALL BE RESTRICTED TO AN ON-SITE LOCATION.
 - THE WATER AND SEWER SYSTEMS SHALL COMPLY WITH CITY OF RALEIGH STANDARDS.
 - ALL DESIGN AND CONSTRUCTION METHODS SHALL COMPLY WITH WAKE COUNTY'S SEDIMENTATION AND EROSION CONTROL REGULATIONS. AN EROSION CONTROL PLAN SHALL BE APPROVED BY TOWN OF ROLESVILLE PRIOR TO ANY GRADING.
 - CONSTRUCTION DRAWINGS SHALL BE SUBMITTED AND APPROVED BY TOWN OF ROLESVILLE AND CITY OF RALEIGH PRIOR TO CONSTRUCTION.
 - ALL STREETS WITHIN THE SUBDIVISION WILL HAVE A POSTED SPEED LIMIT OF 25 MPH.
 - RESTRICTIVE COVENANTS SHALL BE APPROVED AND RECORDED PRIOR TO RECORDING OF FINAL PLAT.
 - STORMWATER CONTROL MEASURES SHALL BE CONTAINED IN AND ACCESSED VIA OPEN SPACE MAINTAINED AND OWNED BY THE HOMEOWNER'S ASSOCIATION. A MAINTENANCE PLAN MUST BE DEVELOPED TO ADDRESS THE STORMWATER CONTROL MEASURES AND APPROVED BY TOWN OF ROLESVILLE.
 - PRIVATE STORM DRAINAGE EASEMENTS SHALL BE MAINTAINED BY THE HOA.
 - SUBDIVISION LOTS MUST BE LOTS OF RECORD PRIOR TO RECEIVING A BUILDING PERMIT.
 - ALL RETAINING WALLS TO BE DESIGNED BY OTHERS.
 - DETAILED DRAWINGS OF EACH AMENITY, THAT SHOWS COMPLIANCE WITH 6.2.1.G.5 AND 6.2.1.G.6, WILL BE PROVIDED IN A SUBSEQUENT SITE PLAN SUBMITTAL.
 - DETAILED DRAWINGS OF THE COMMERCIAL AREA WILL BE PROVIDED IN A SUBSEQUENT SITE PLAN SUBMITTAL.

LEGEND:

- EXISTING PROPERTY LINE
- 500YR FLOOD LINE
- 100YR FLOOD LINE
- SIGN
- STOP BAR
- ROADWAY CENTER LINE
- PROPOSED PROPERTY LINE
- ROLESVILLE STANDARD VALLEY CURB
- STANDARD CURB & GUTTER
- GREENWAY
- CONCRETE SIDEWALK
- ASPHALT PAVEMENT
- POLLINATOR GARDEN
- ACTIVE & PASSIVE OPEN SPACE
- 30' STREET YARD BUFFER
- 15' TYPE II PERIMETER BUFFER
- OPEN SPACE
- EXISTING WETLAND
- FLOOD HAZARD
- FLOODZONE AE
- FLOODWAY
- SWAMP/MARSH HARRIS CREEK
- TREE PROTECTION FENCE
- GENERIC WOODEN PRIVACY FENCE
- FENCE PICKET FLAT-TOP FENCING

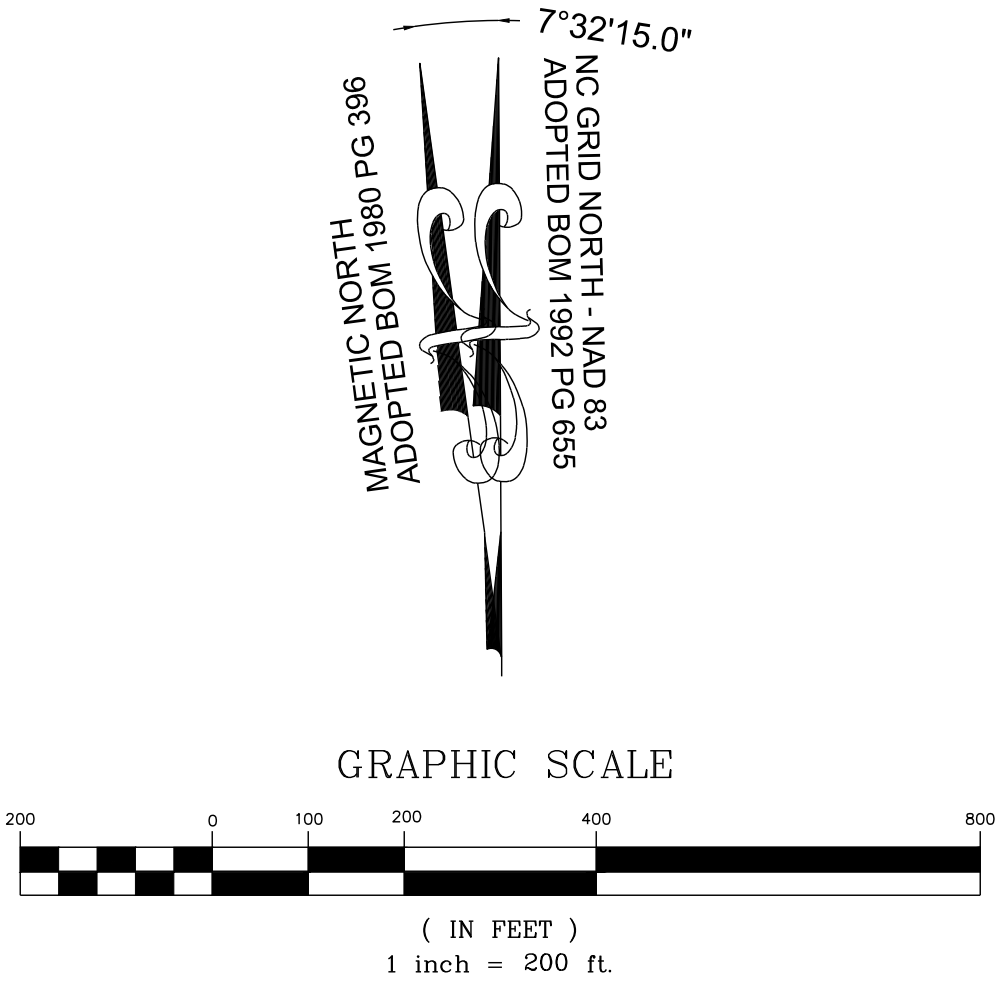

THIS PLANSET AND ANY ASSOCIATED DOCUMENTS ARE PRELIMINARY AND NOT AUTHORIZED FOR CONSTRUCTION UNTIL SIGNED, DATED, AND OFFICIALLY RELEASED FOR CONSTRUCTION BY THE ENGINEER OF RECORD.

STRONGROCK
ENGINEERING GROUP




STRONG ROCK ENGINEERING GROUP, PLLC | COMPANY LICENSE # P-2766
305 CHURCH AT NORTH HILLS STREET, SUITE 1110 RALEIGH, NC 27609 | INFORMATION@STRONGROCKGROUP.COM

RESERVE @ MITCHELL MILL
TOWN OF ROLESVILLE, WAKE COUNTY, NORTH CAROLINA
CONSTRUCTION PLANS
OVERALL SITE PLAN

DRAWING SHEET
C-6.0

18 OF 227

CONSTRUCTION INFRASTRUCTURE DRAWINGS	01	02	03	04	NO.	REVISIONS	DATE
STRONG ROCK PROJECT							
PSP-24-03							
NOT FOR CONSTRUCTION							
SCALE							
AS SHOWN							
SRG							
DESIGNED BY							
SRG							
DRAWN BY							
CHECKED BY							
SRG							

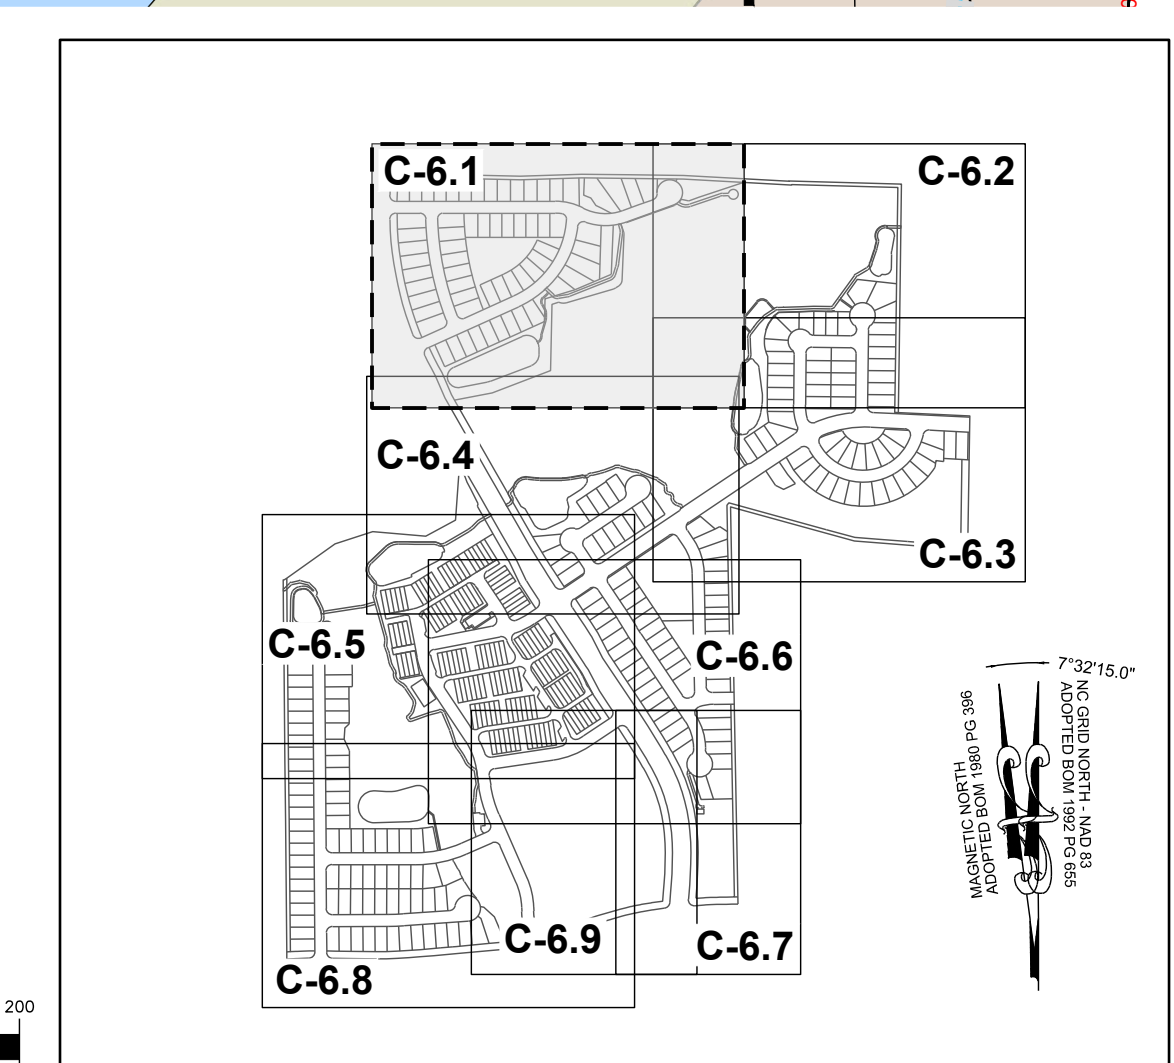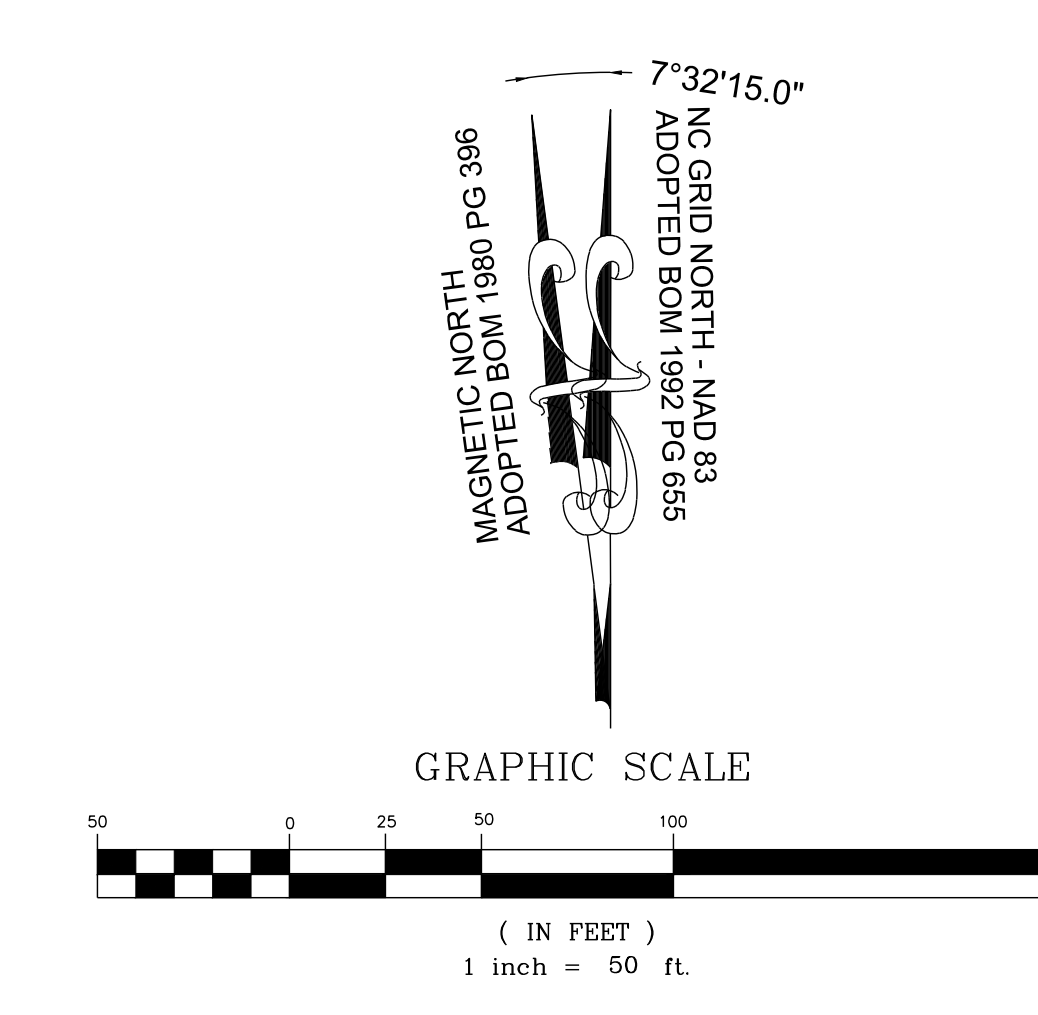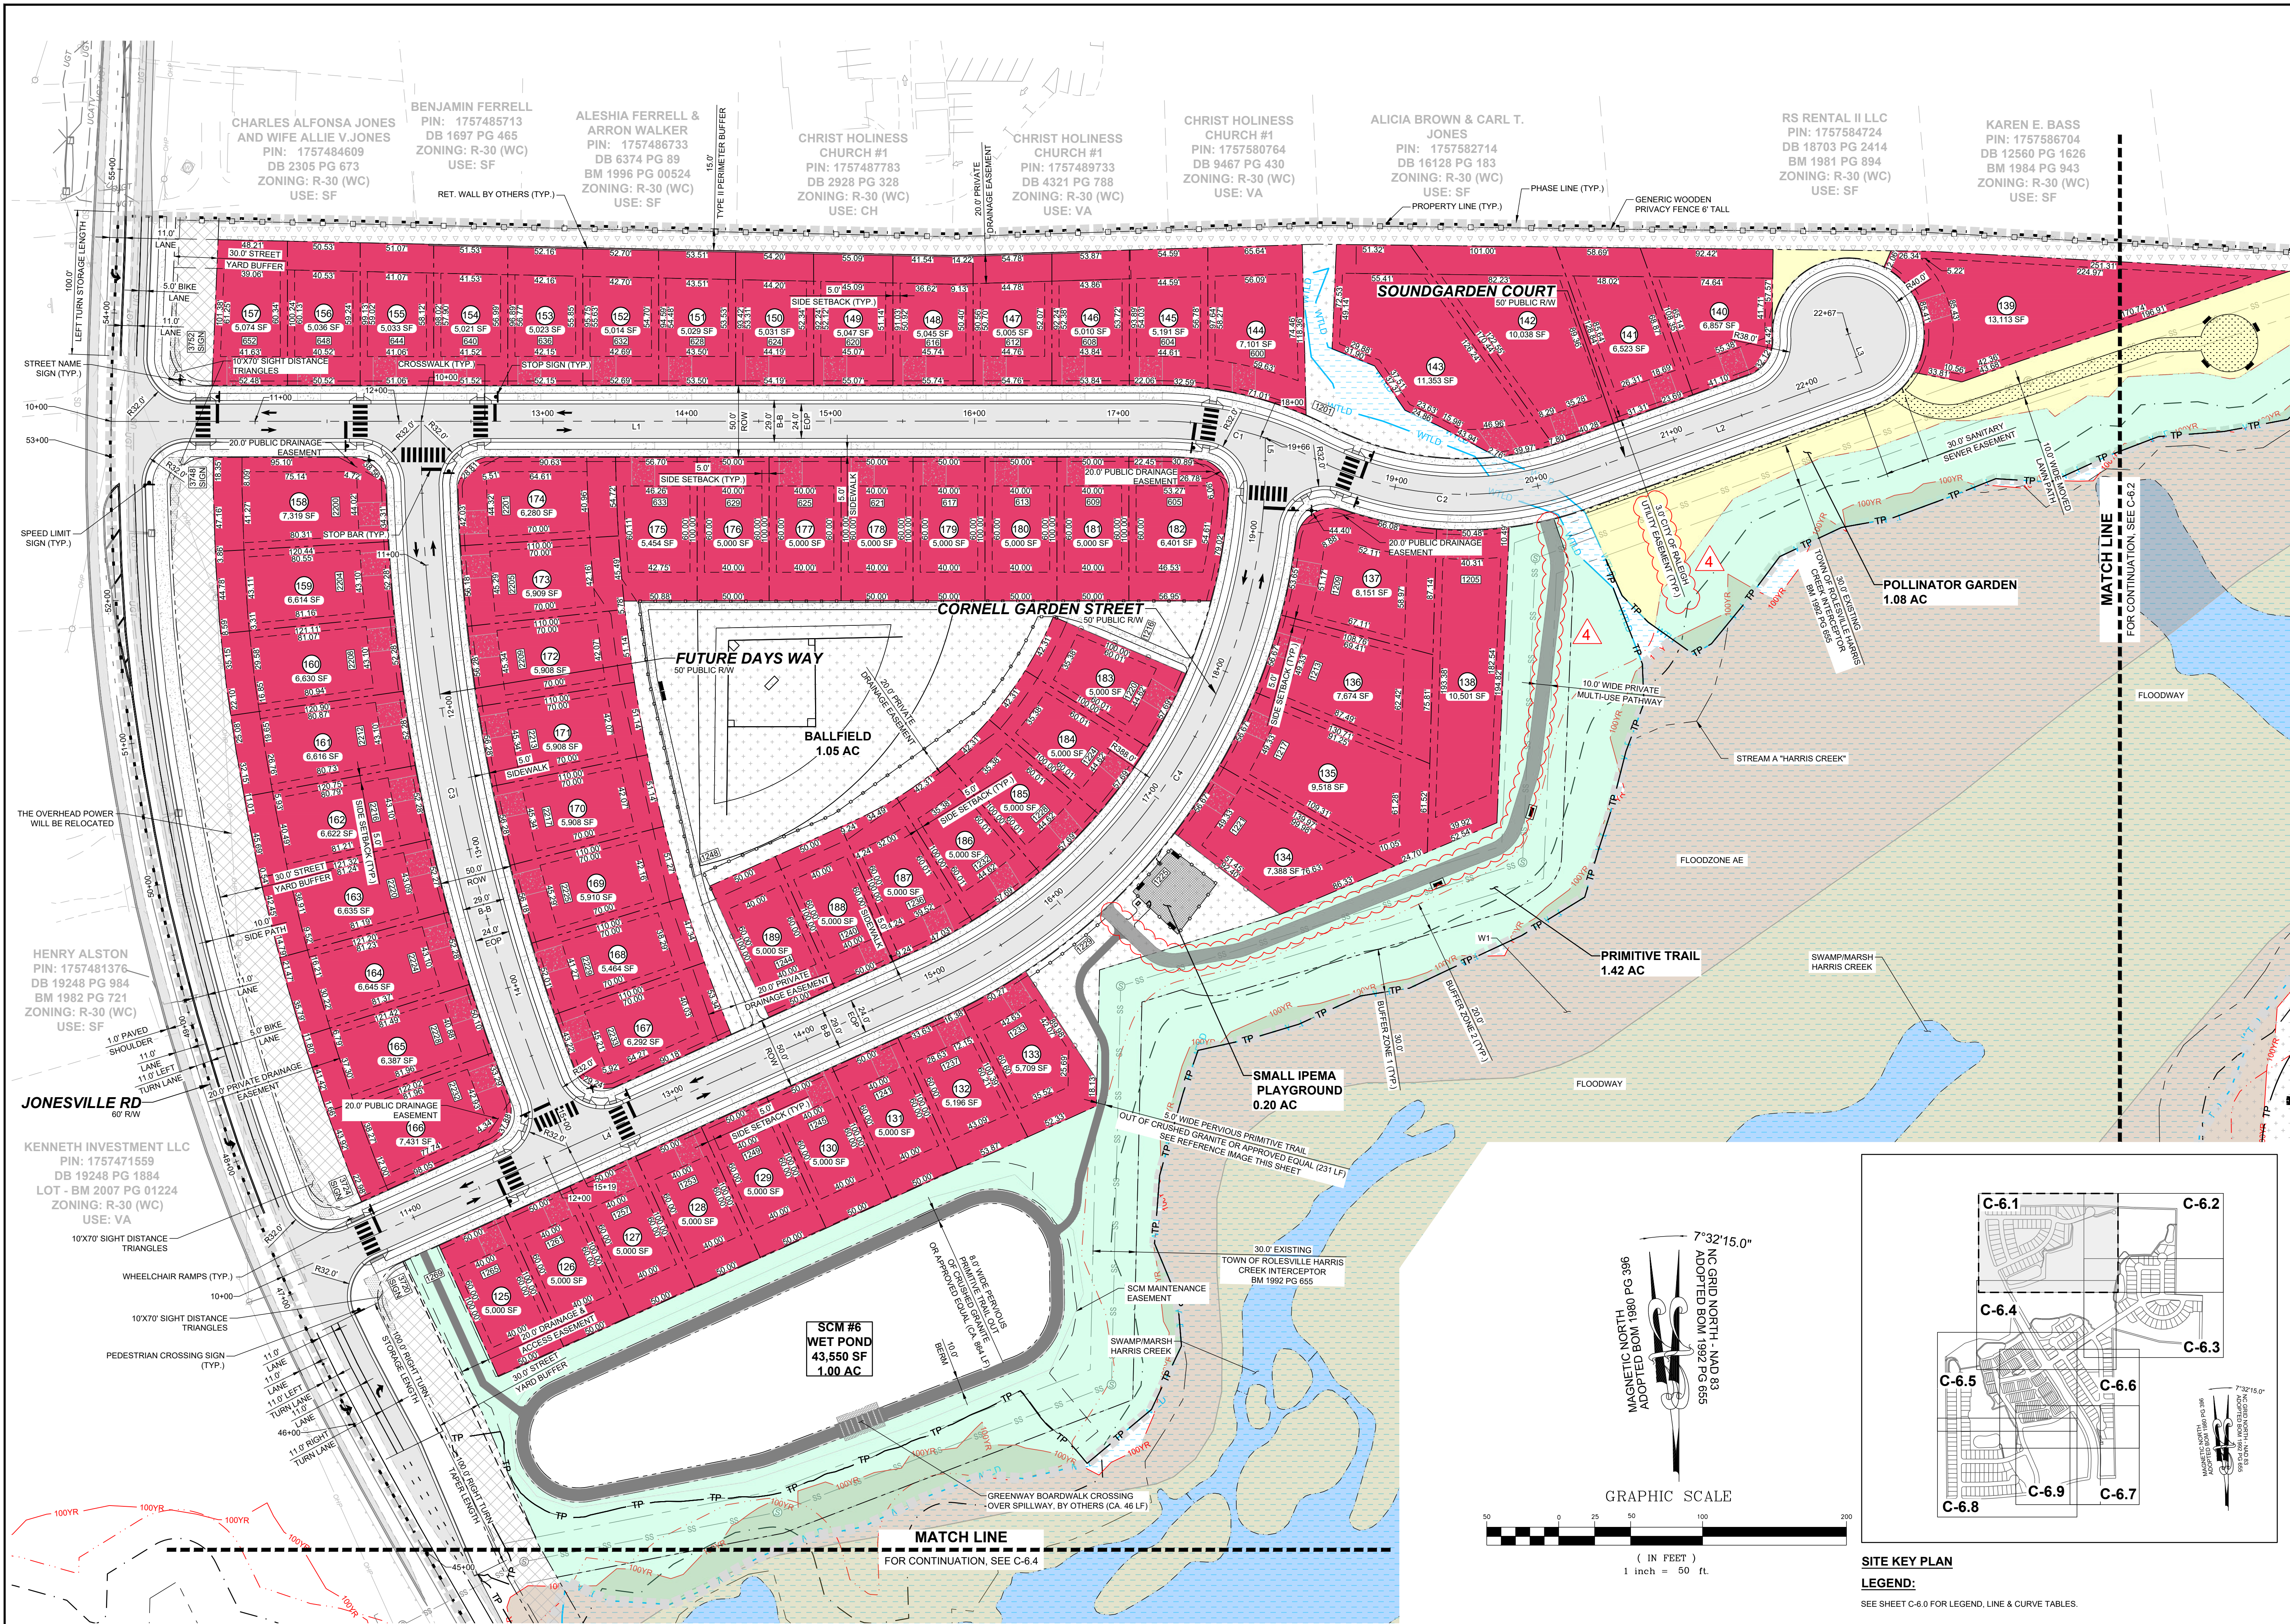

STRONGROCK

ENGINEERING GROUP

STRONG ROCK ENGINEERING GROUP, PLLC | COMPANY LICENSE # P-2166
305 CHURCH AT NORTH HILLS STREET, SUITE 1110 RALEIGH, NC 27609 | INFORMATION@STRONGROCKGROUP.COM

CONSTRUCTION INFRASTRUCTURE DRAWINGS

CID-24-04

01

02

03



1450

1451



1452

1453

1454

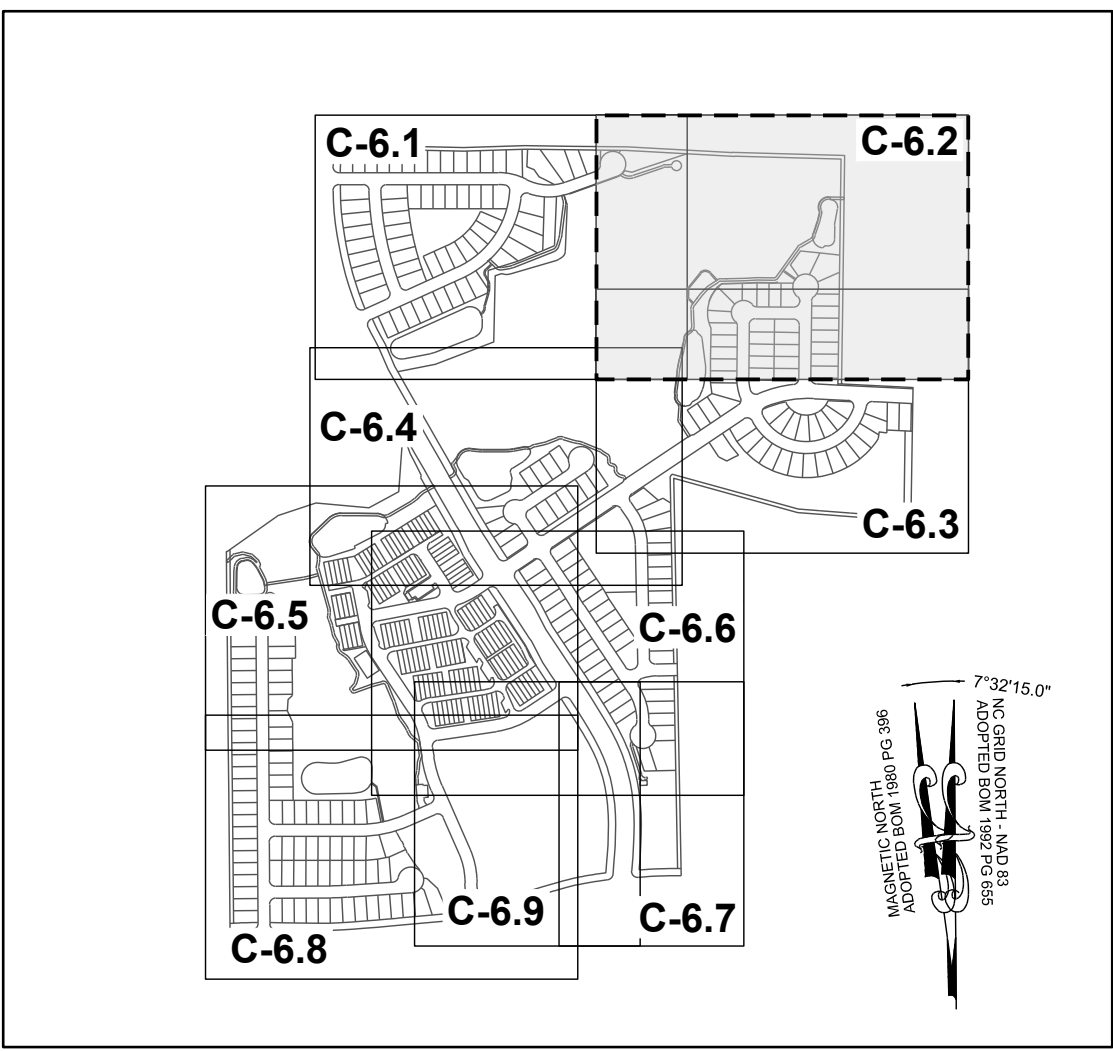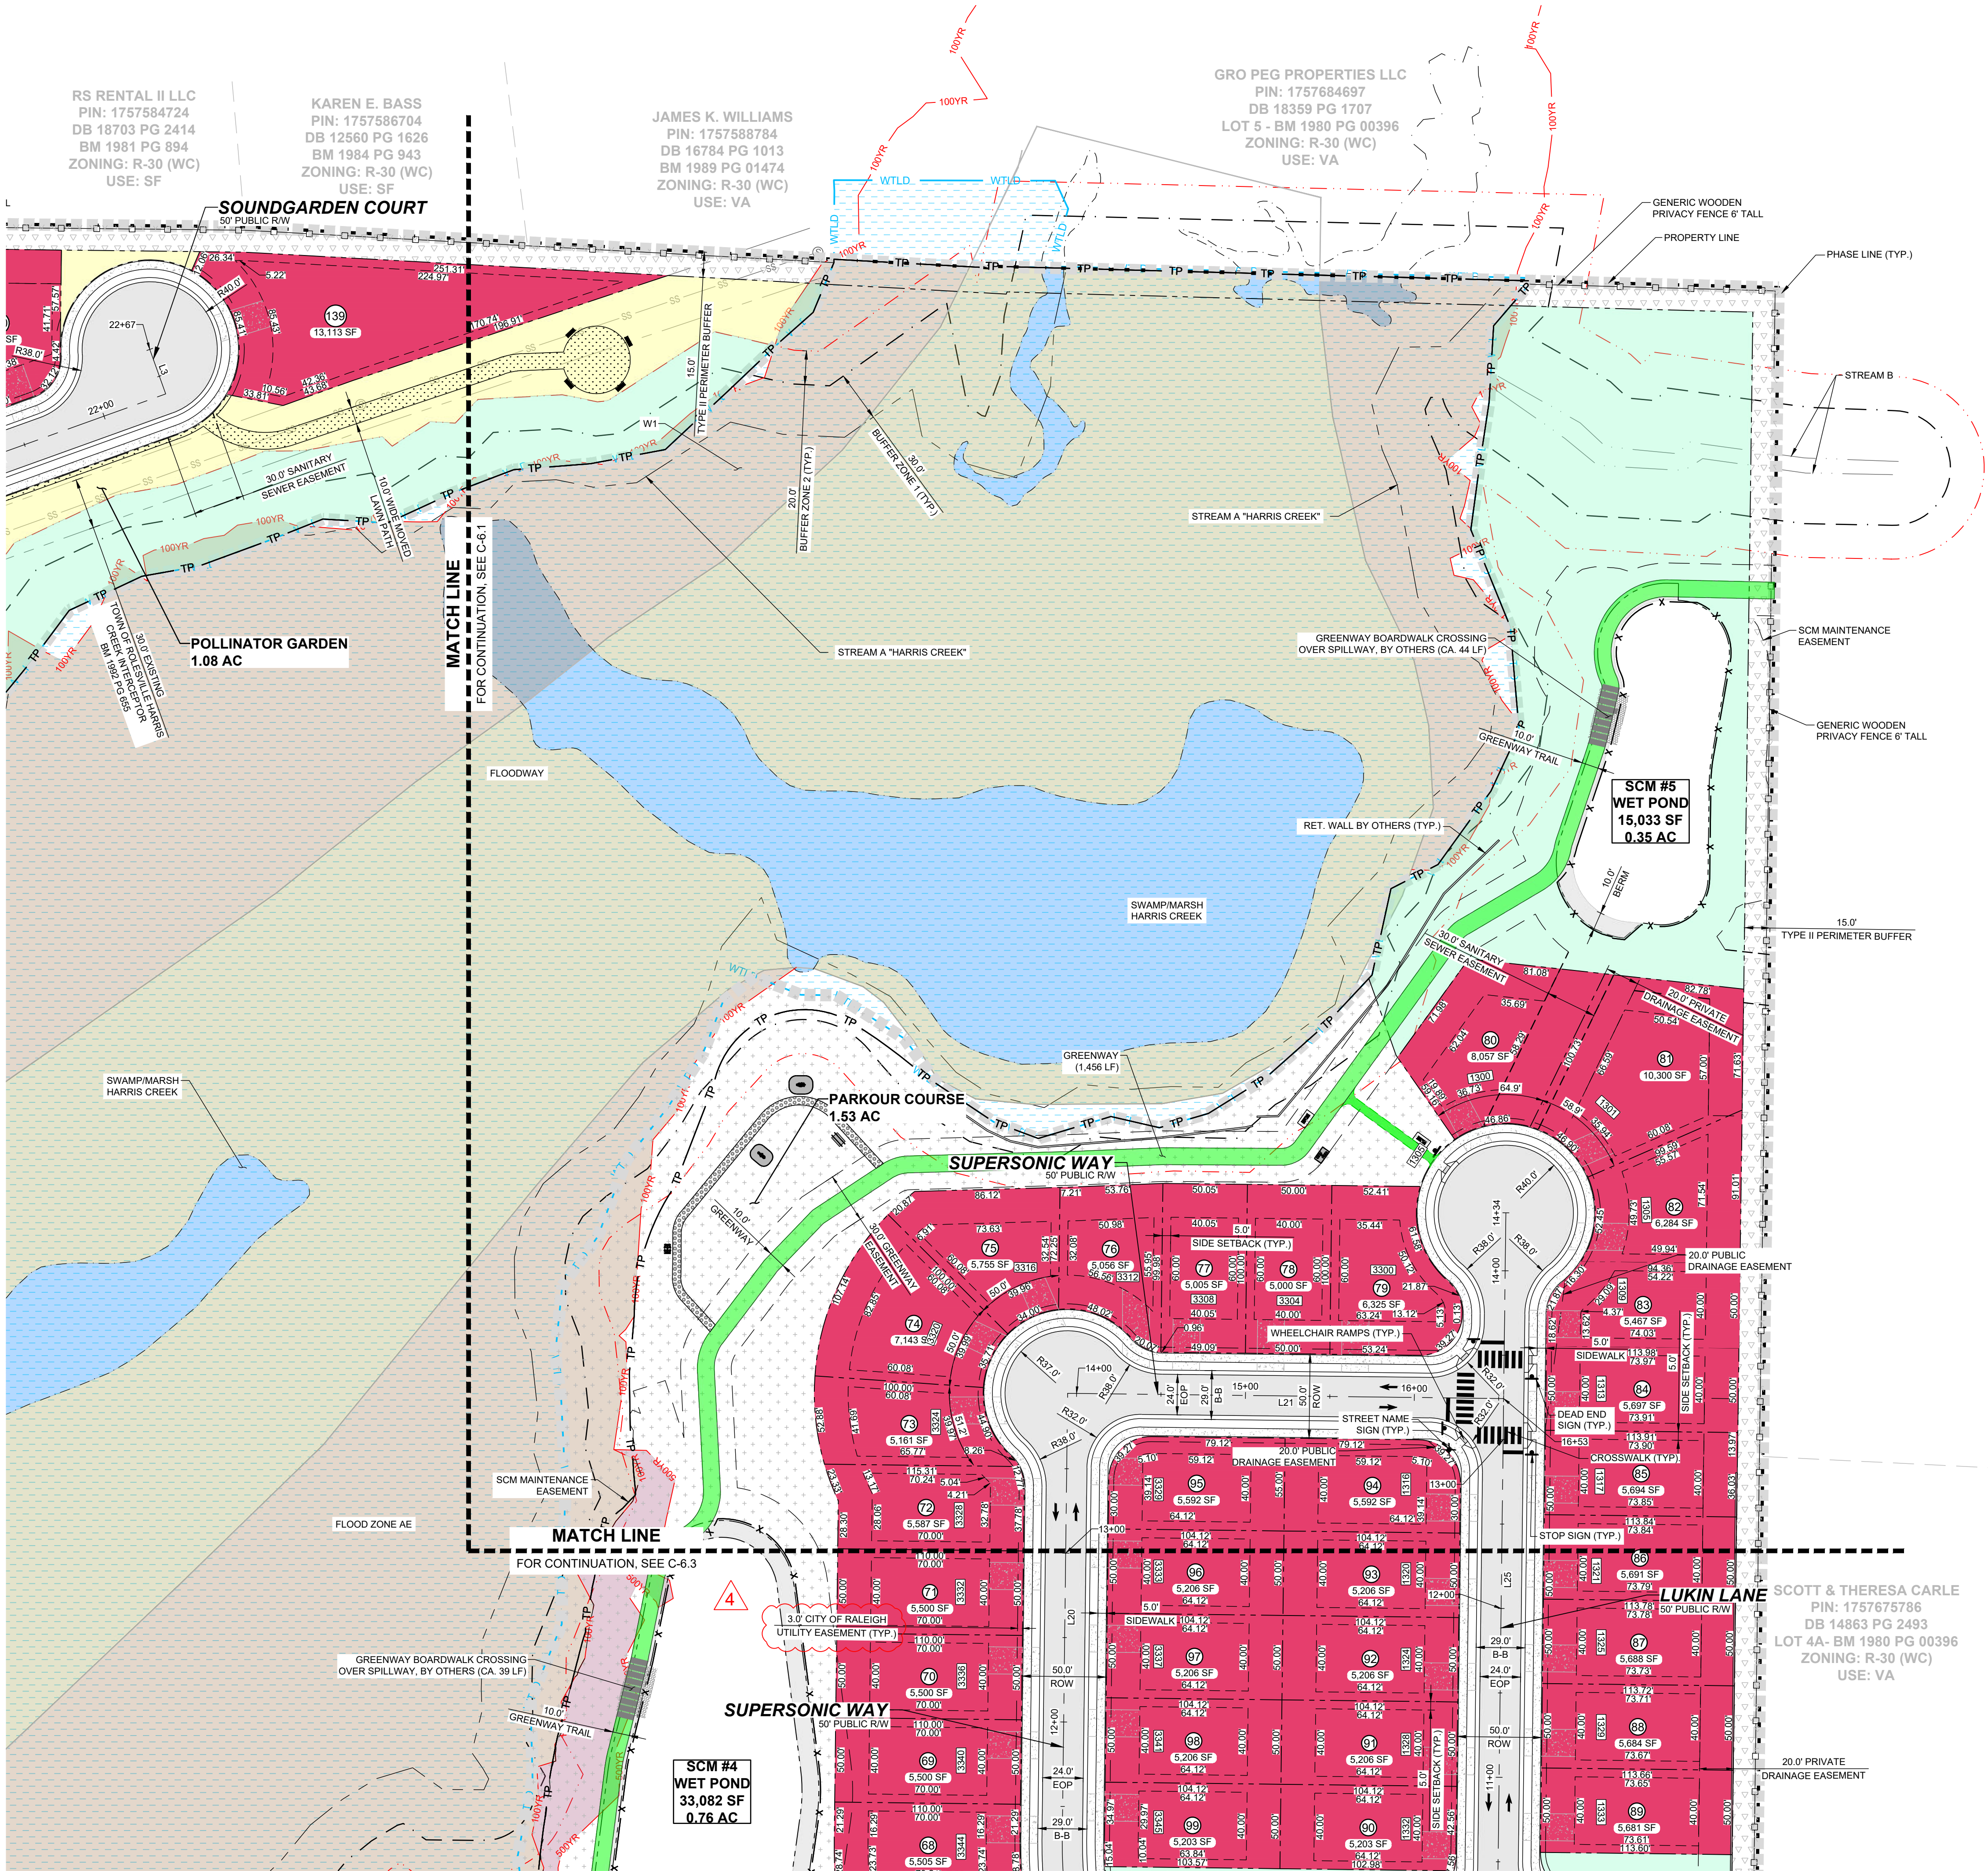

SITE KEY PLAN
LEGEND:
SEE SHEET C-6.0 FOR LEGEND, LINE & CURVE TABLES.

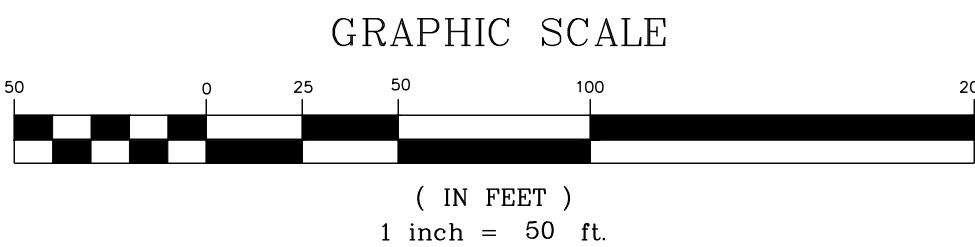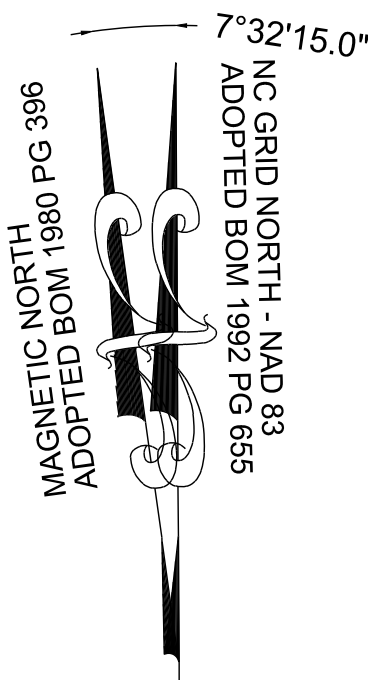

THIS PLANSET AND ANY ASSOCIATED DOCUMENTS ARE PRELIMINARY AND NOT AUTHORIZED FOR CONSTRUCTION UNTIL SIGNED, DATED, AND OFFICIALLY RELEASED FOR CONSTRUCTION BY THE ENGINEER OF RECORD.

CONSTRUCTION INFRASTRUCTURE DRAWINGS				REVISIONS		DATE	BY
NO.	DESCRIPTION	DATE	BY	NO.	DESCRIPTION		
01	CID-24-04	08/04/2024	SRG				
02	TOWN OF ROLESVILLE CID-24-04 V2	11/07/2024	SRG				
03	TOWN OF ROLESVILLE CID-24-04 V3	02/07/2024	SRG				
04	TOWN OF ROLESVILLE CID-24-04 V4	08/02/2025	SRG				

STRONGROCK

ENGINEERING GROUP

STRONG ROCK ENGINEERING GROUP, PLLC | COMPANY LICENSE # P-2166



305 CHURCH AT NORTH HILLS STREET, SUITE 1110 RALEIGH, NC 27609 | INFORMATION@STRONGROCKGROUP.COM

STRONG ROCK PROJECT	NOT FOR CONSTRUCTION	SCALE	AS SHOWN	DESIGNED BY	SRG	DRAWN BY	SRG	CHECKED BY	SRG
---------------------	----------------------	-------	----------	-------------	-----	----------	-----	------------	-----

RESERVE @ MITCHELL MILL
TOWN OF ROLESVILLE, WAKE COUNTY, NORTH CAROLINA
CONSTRUCTION PLANS
PARTIAL SITE PLAN II

DRAWING SHEET

C-6.2

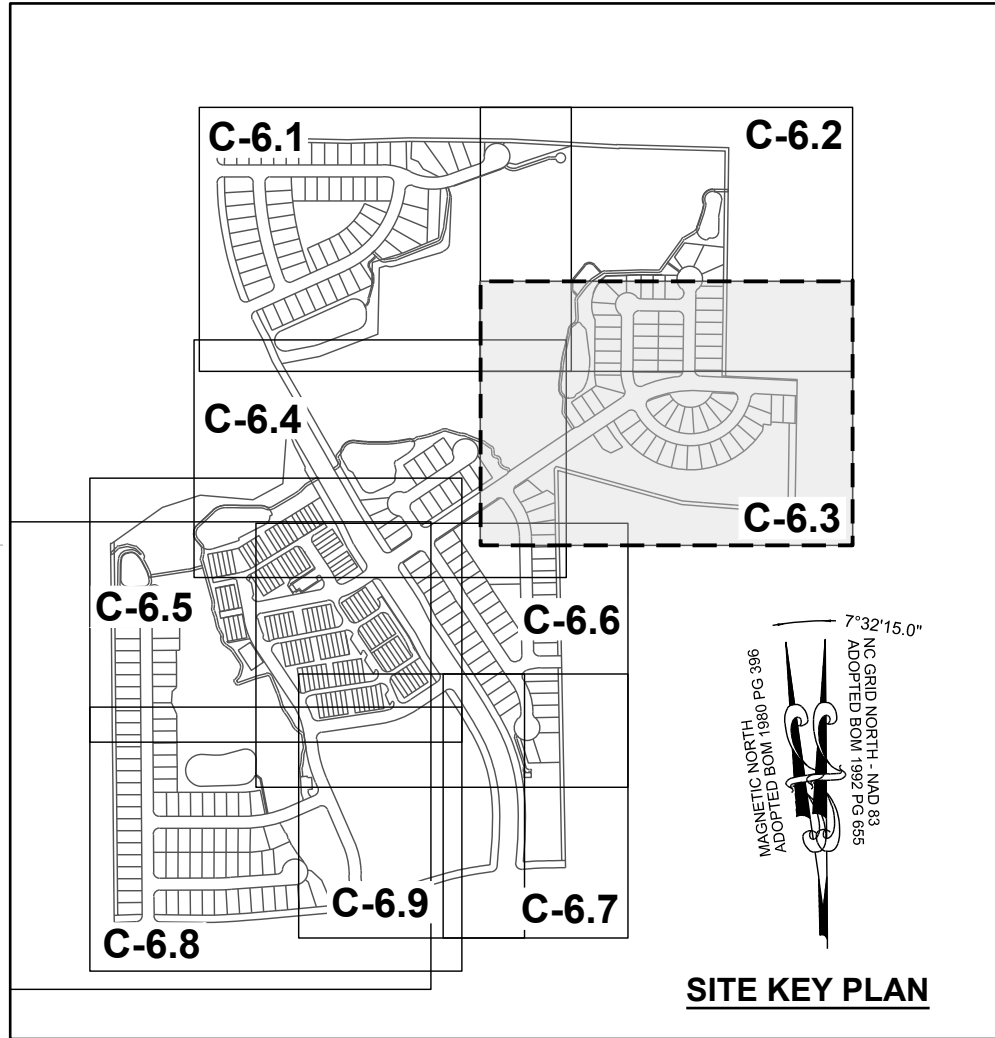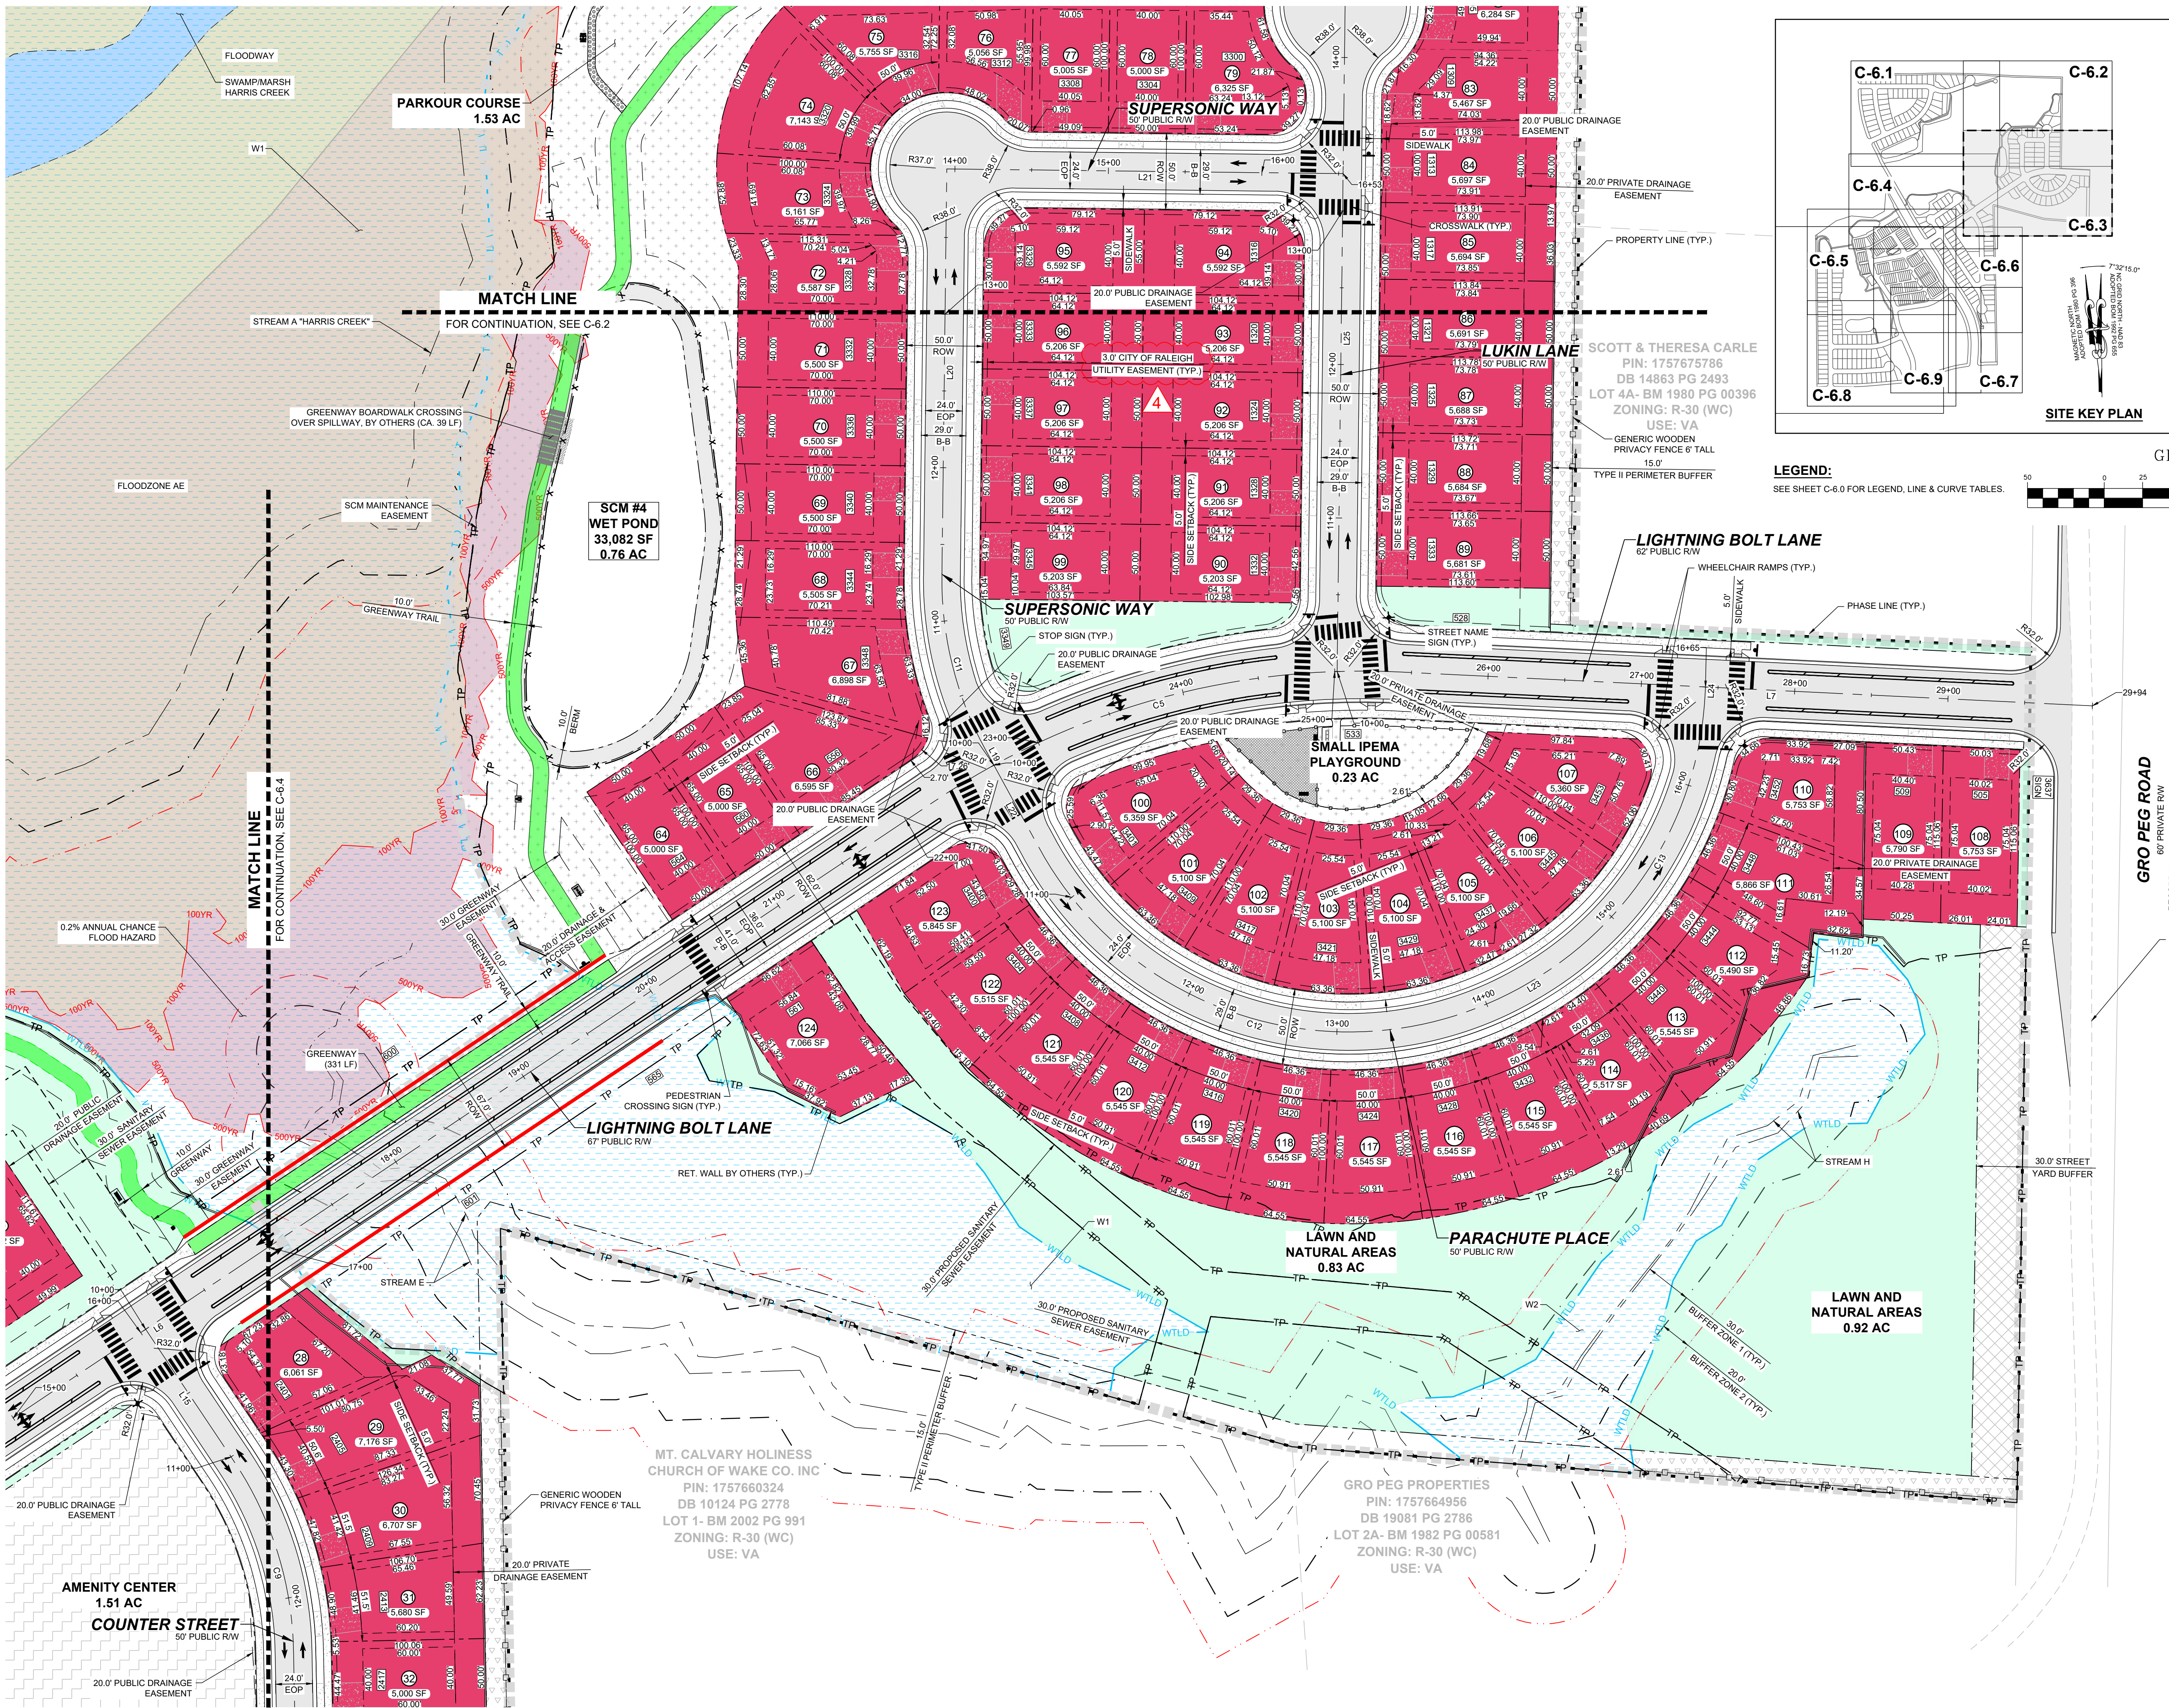

CONSTRUCTION INFRASTRUCTURE DRAWINGS				REVISIONS		BY
NO.	DATE	DESCRIPTION	BY	DATE	DESCRIPTION	BY
01	08/04/2024	CD-24-04	SRG			
02	11/07/2024	TOWN OF ROLESVILLE CID-24-04 V2	SRG			
03	02/07/2024	TOWN OF ROLESVILLE CID-24-04 V3	SRG			
04	08/02/2025	TOWN OF ROLESVILLE CID-24-04 V4	SRG			

STRONGROCK
ENGINEERING GROUP

STRONG ROCK ENGINEERING GROUP, PLLC | COMPANY LICENSE # P-2166
305 CHURCH AT NORTH HILLS STREET, SUITE 1110 RALEIGH, NC 27609 | INFORMATION@STRONGROCKGROUP.COM

STRONG ROCK PROJECT	NOT FOR CONSTRUCTION	SCALE	AS SHOWN	SRG	SRG	SRG
PSP-24-03						
DESIGNED BY						
DRAWN BY						
CHECKED BY						




RESERVE @ MITCHELL MILL
TOWN OF ROLESVILLE, WAKE COUNTY, NORTH CAROLINA
CONSTRUCTION PLANS
PARTIAL SITE PLAN III

DRAWING SHEET
C-6.3

21 OF 227

TOWNHOME NOTES:


STATES INTERNAL TOWNHOME DRIVEWAYS ARE PRIVATE EASEMENTS AS PER CITY OF RALEIGH PUBLIC UTILITIES DEPARTMENT

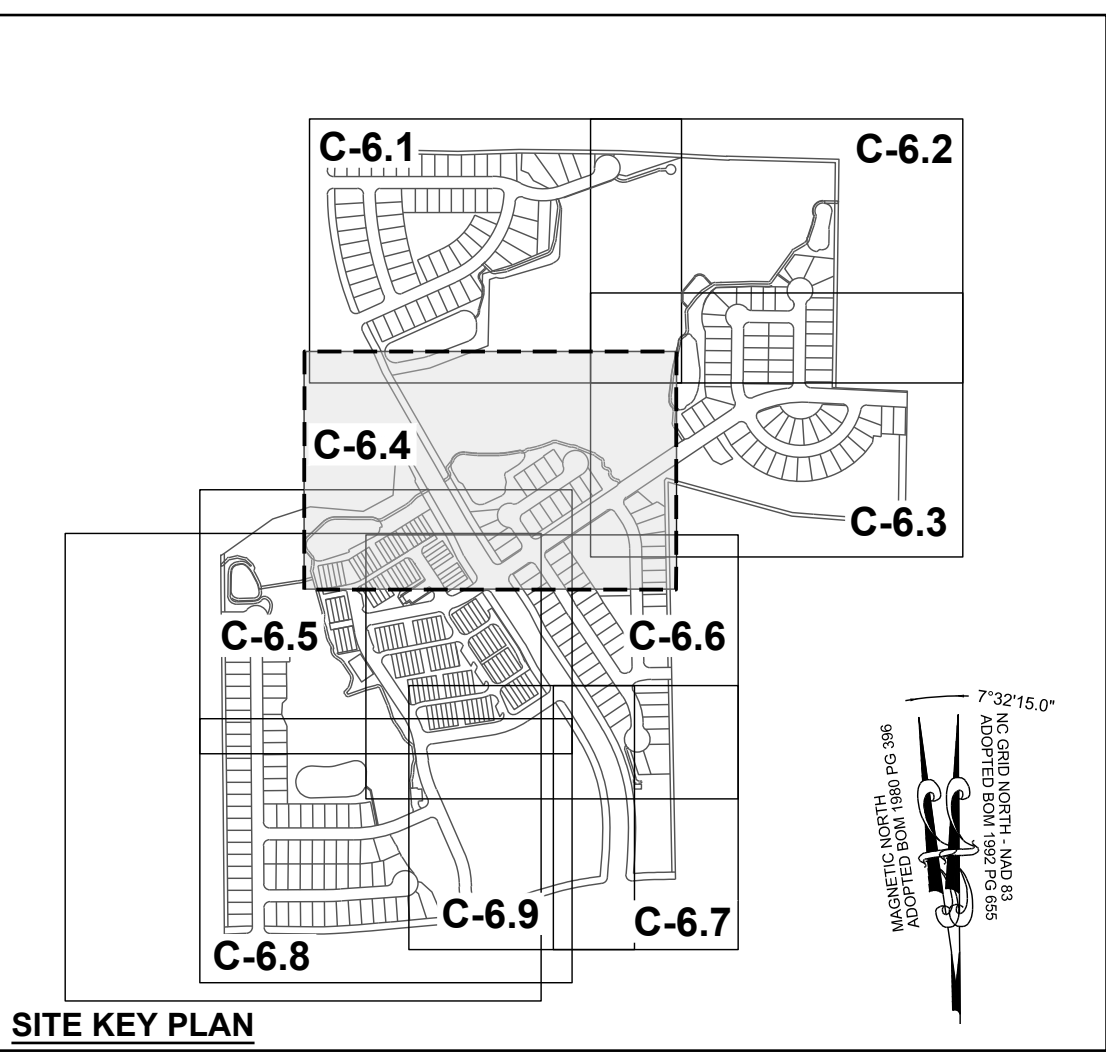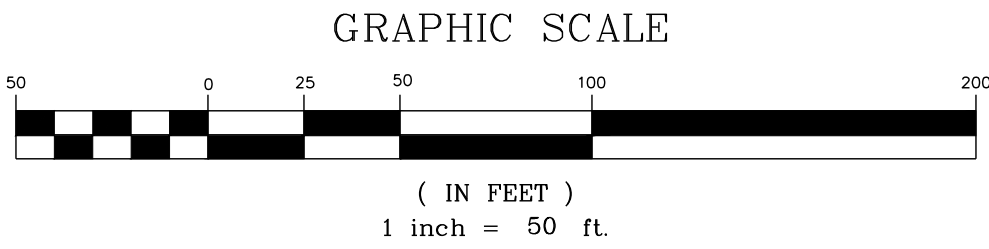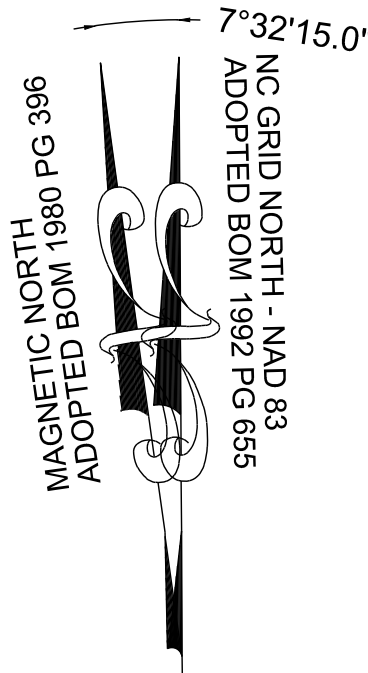

SITE KEY PLAN

LEGEND:

SEE SHEET C-6.0 FOR LEGEND, LINE & CURVE TABLES.

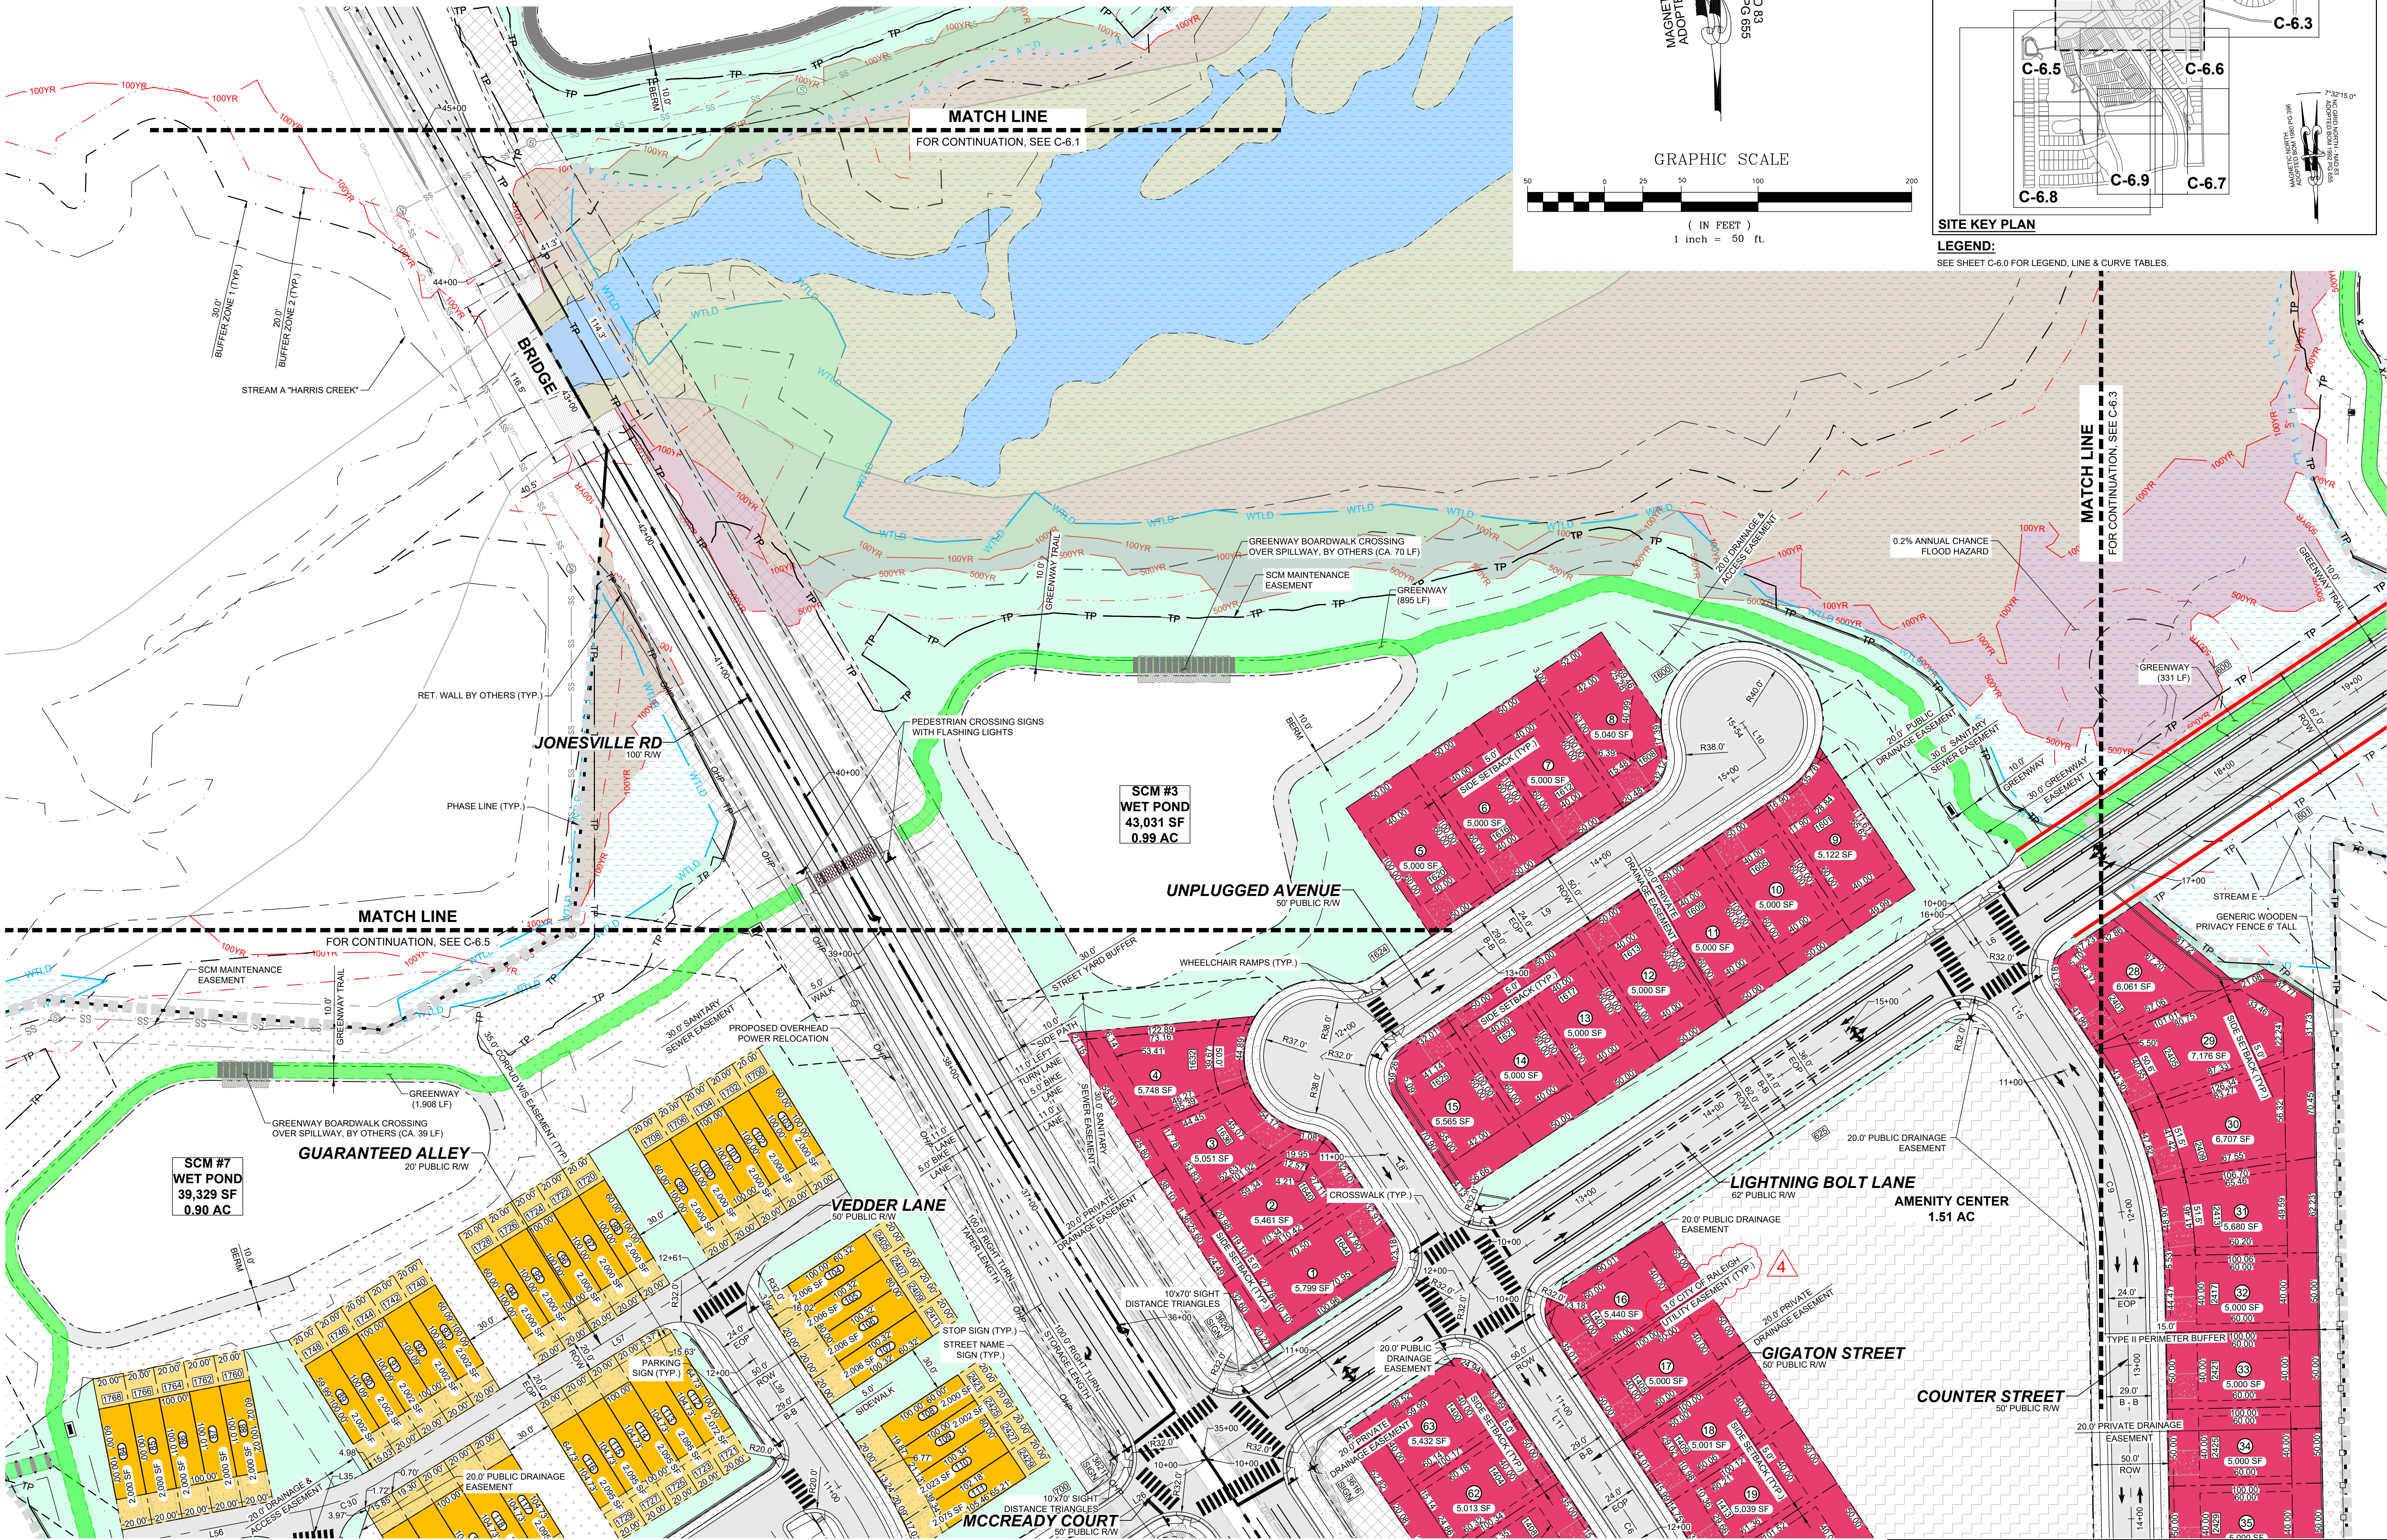

STRONGROCK
ENGINEERING GROUP


STRONG ROCK ENGINEERING GROUP, PLLC | COMPANY LICENSE # P-2166
305 CHURCH AT NORTH HILLS STREET, SUITE 1110 RALEIGH, NC 27609 | INFORMATION@STRONGROCKGROUP.COM

RESERVE @ MITCHELL MILL
TOWN OF ROLESVILLE, WAKE COUNTY, NORTH CAROLINA
CONSTRUCTION PLANS
PARTIAL SITE PLAN IV

DRAWING
SHEET
C-6.4

CONSTRUCTION INFRASTRUCTURE DRAWINGS		REVISIONS		DATE	BY
NO.	DESCRIPTION	NO.	DESCRIPTION		
01	08/04/2024	01			
02	11/07/2024	02			
03	02/07/2024	03			
04	08/02/2025	04			

SEAL:

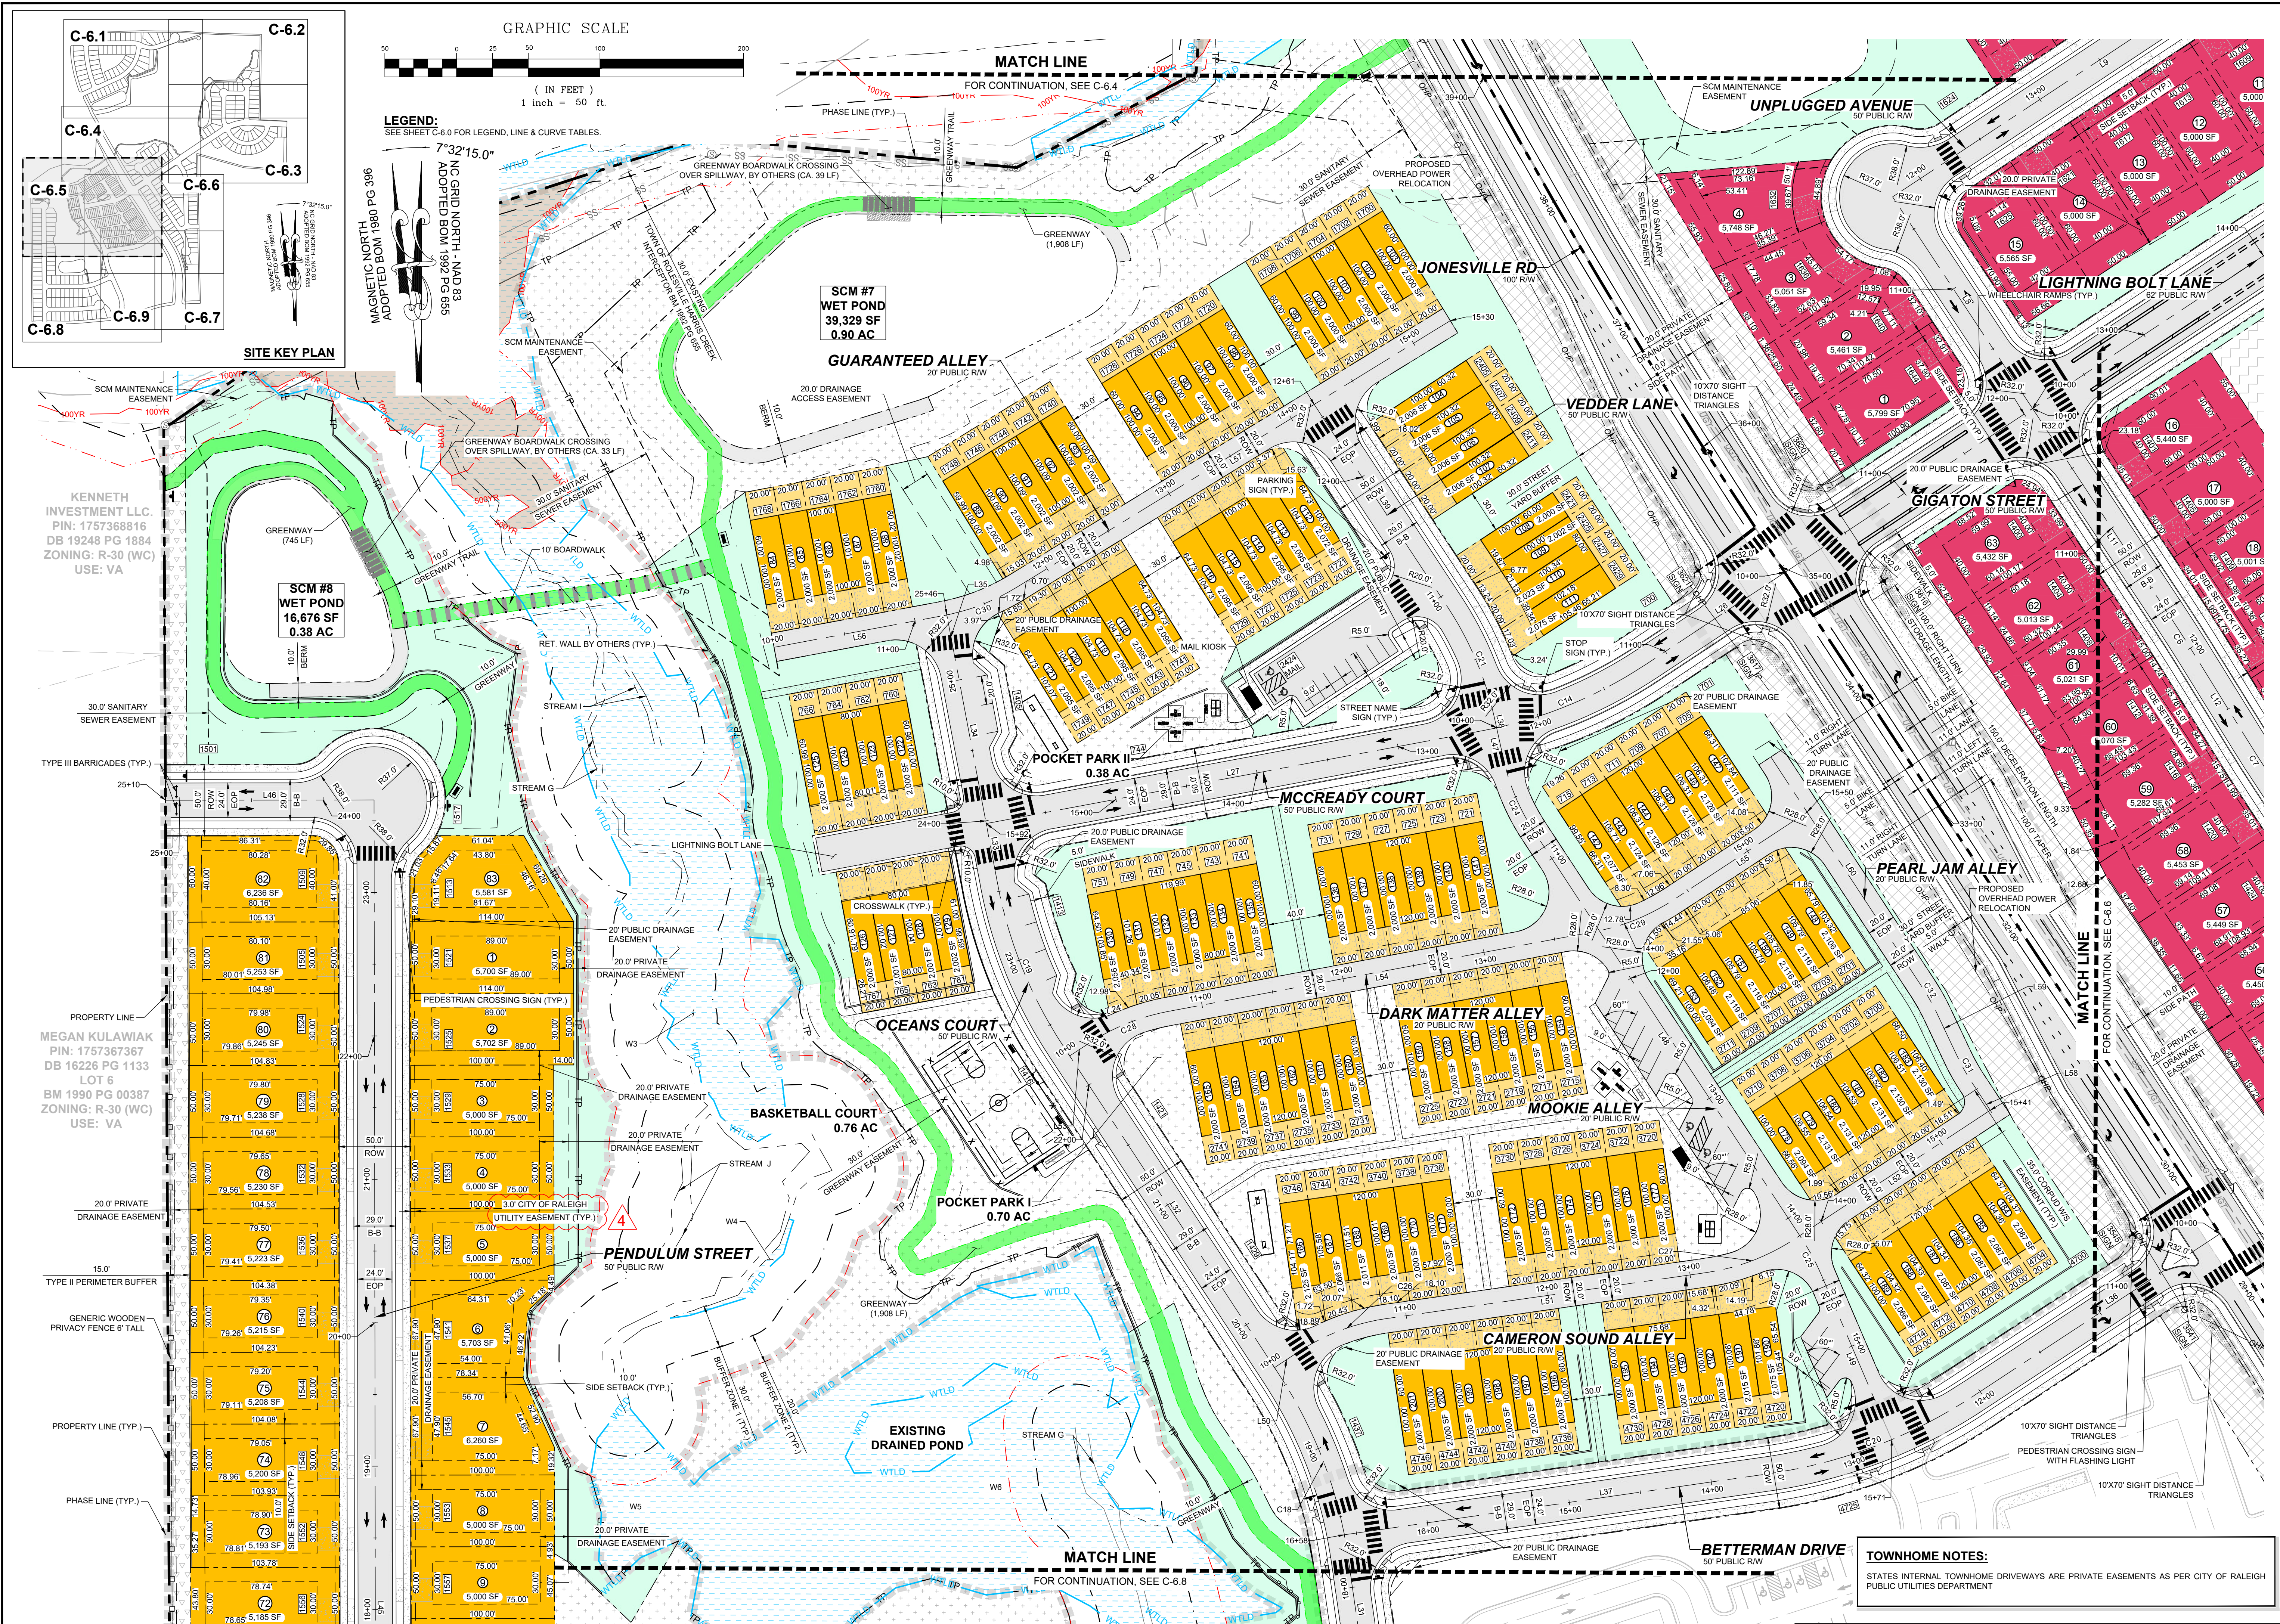

STRONGROCK

ENGINEERING GROUP

RESERVE @ MITCHELL MILL

TOWN OF ROLESVILLE, WAKE COUNTY, NORTH CAROLINA

CONSTRUCTION PLANS

PARTIAL SITE PLAN V

DRAWING SHEET

C-6.5

23 OF 227

CONSTRUCTION INFRASTRUCTURE DRAWINGS

01

02

03



1450

1451

1452

1453

<

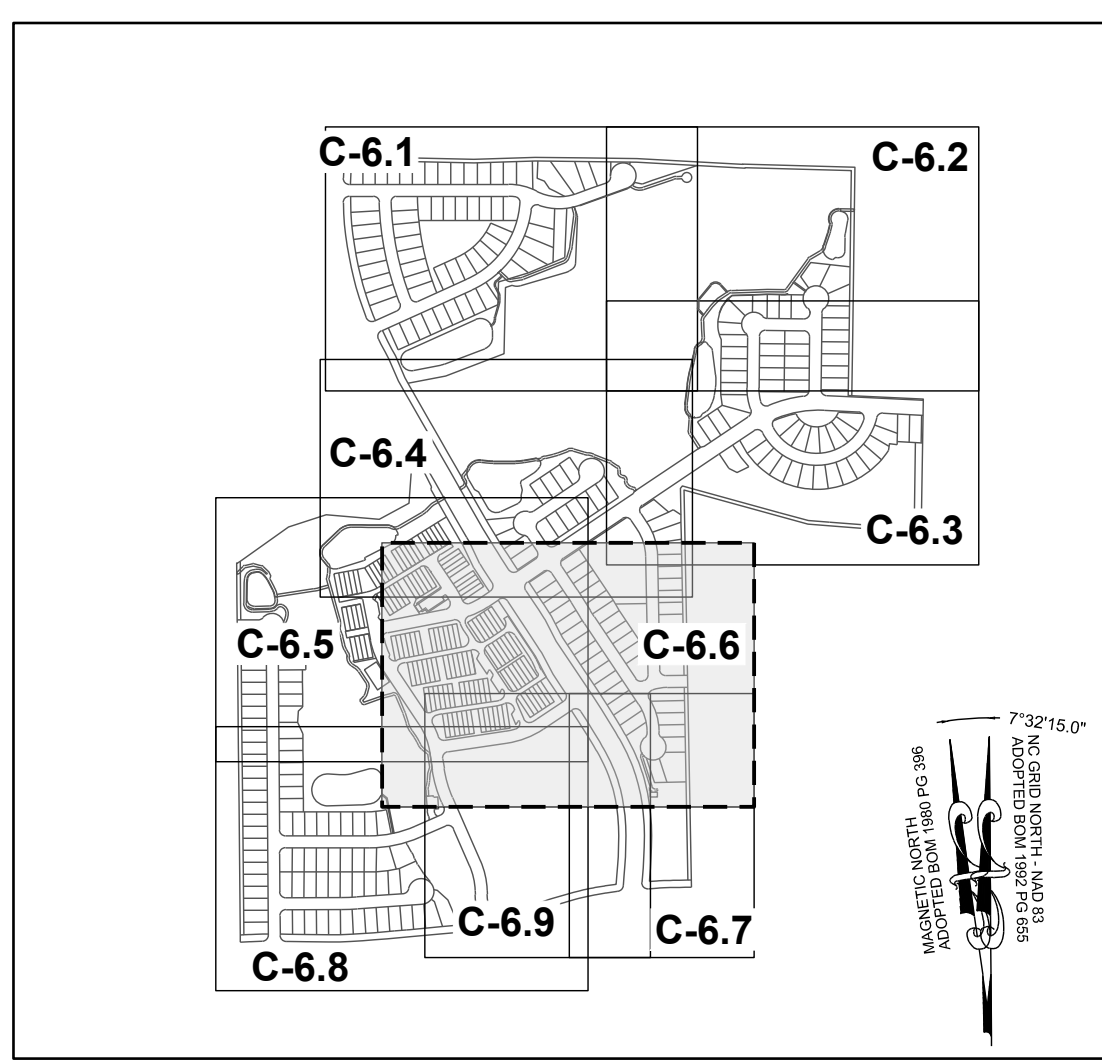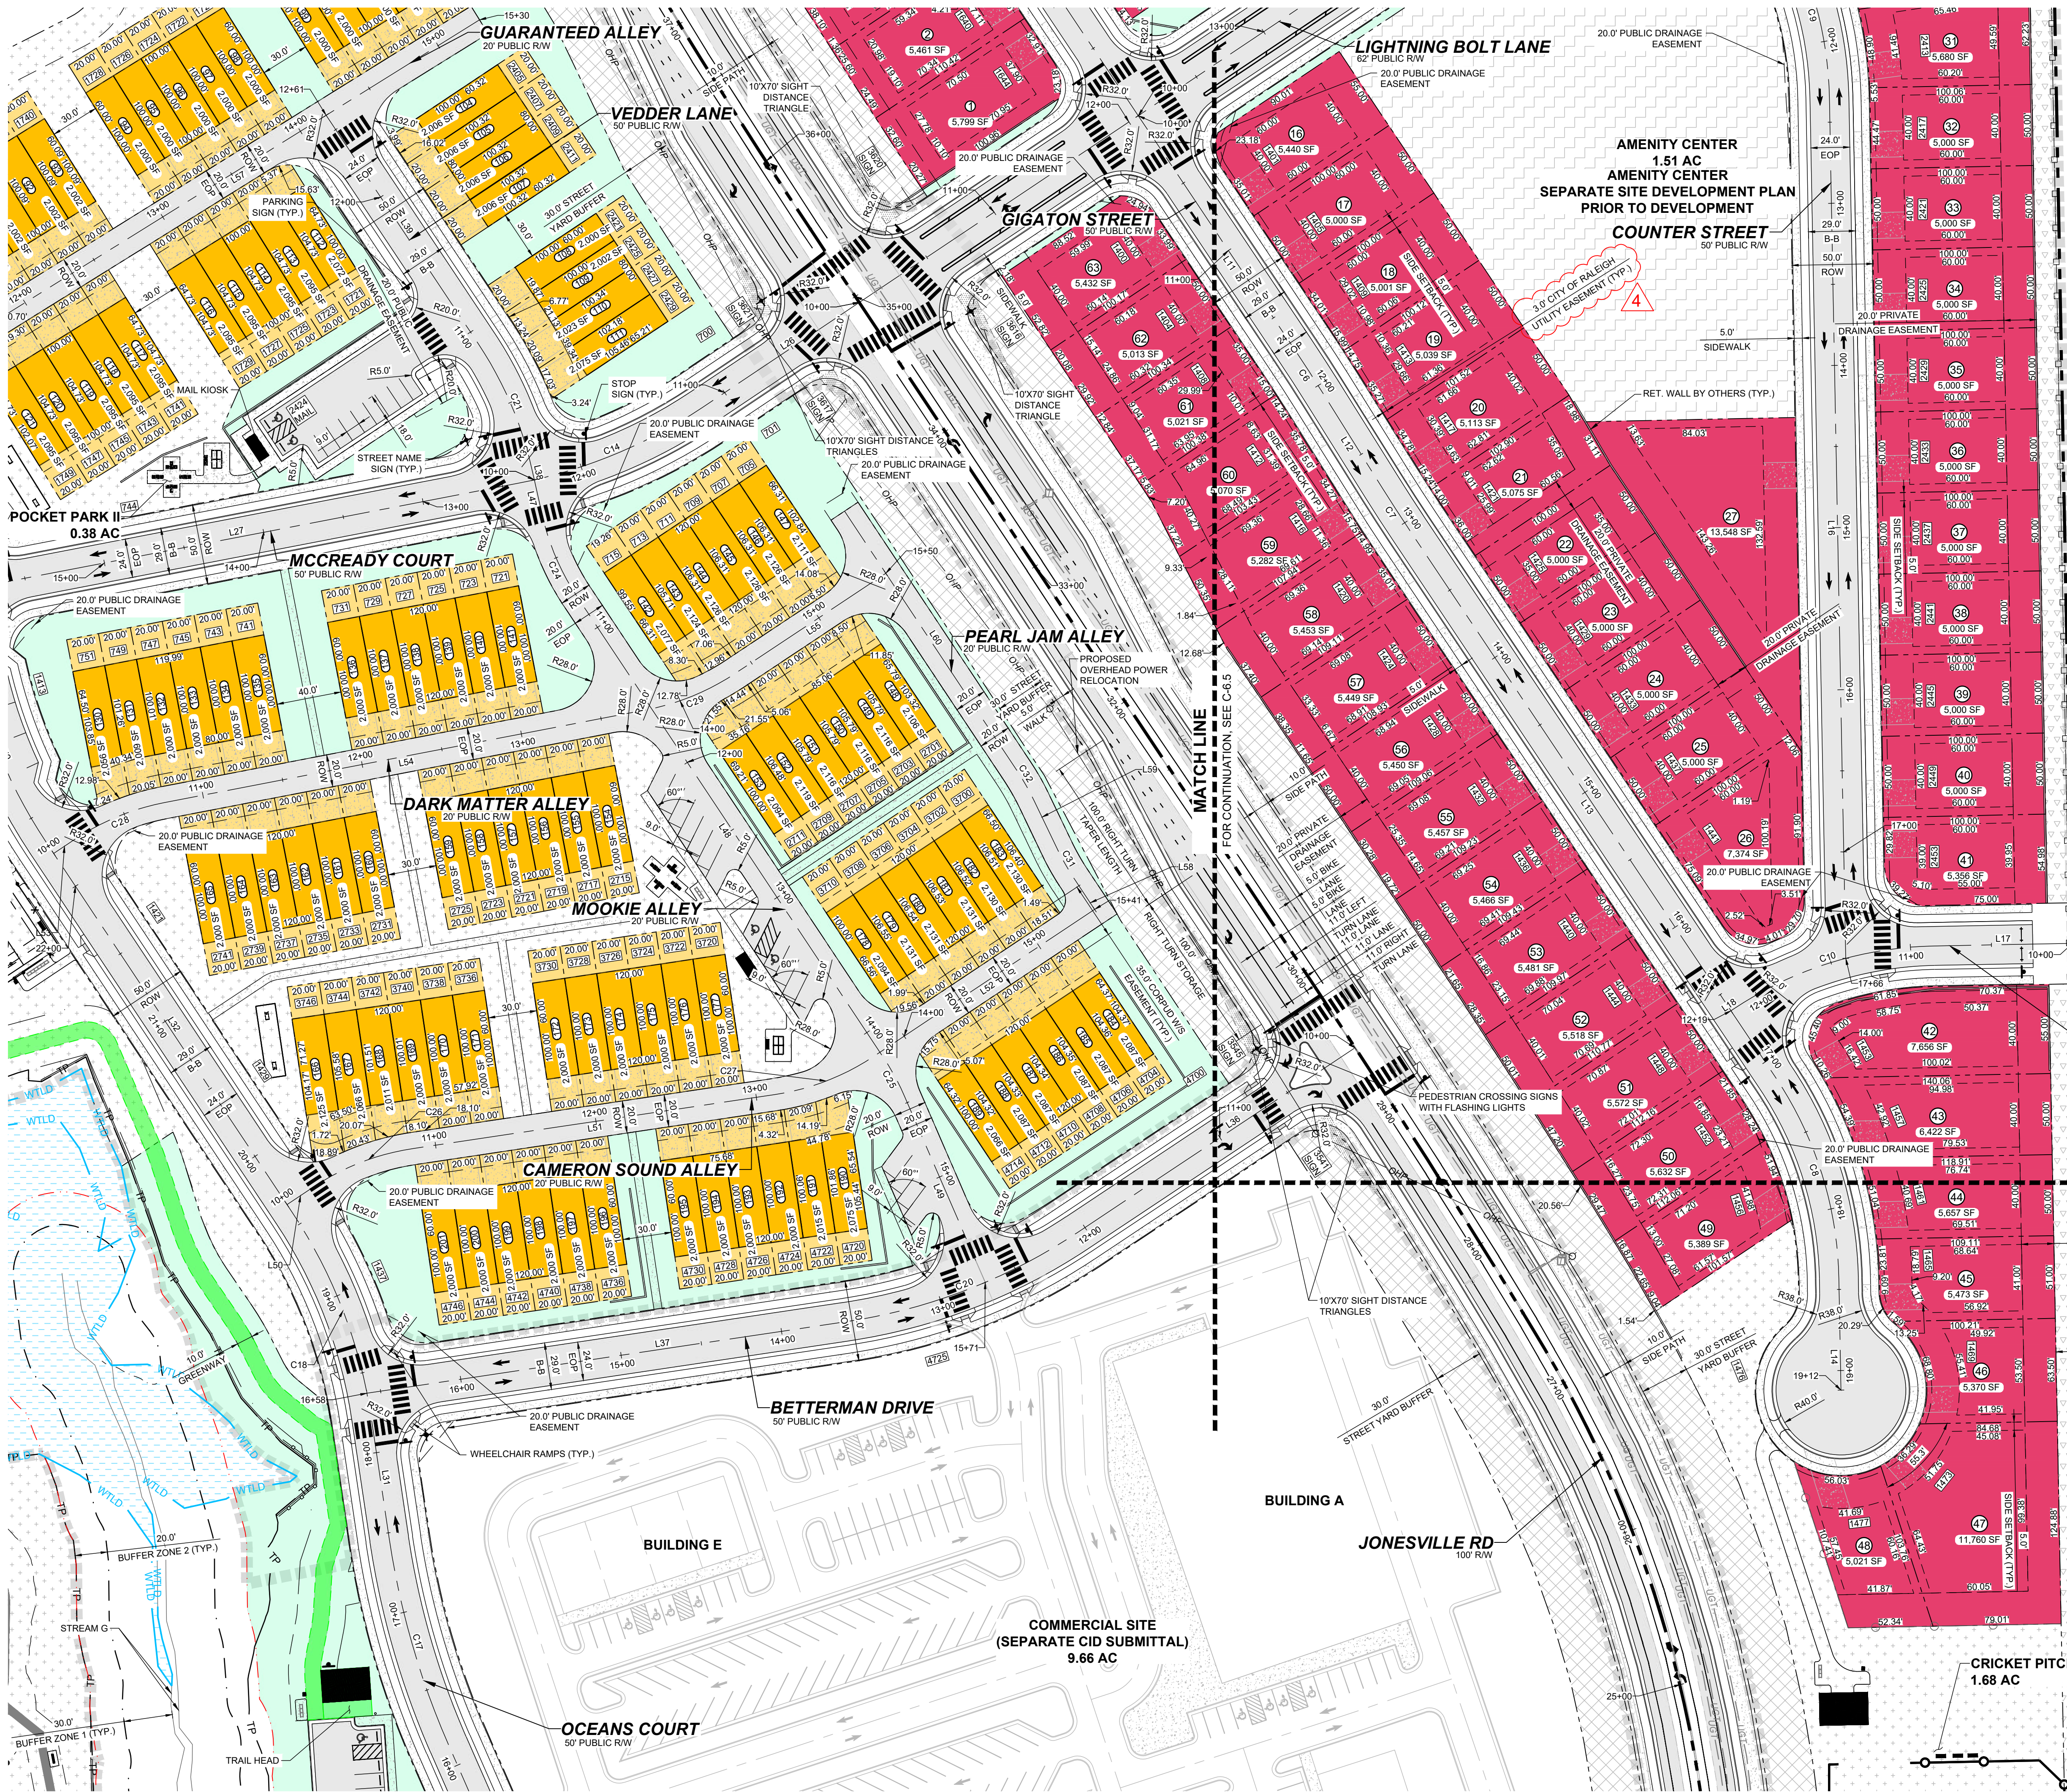


SITE KEY PLAN

LEGEND:
SEE SHEET C-6.0 FOR LEGEND, LINE & CURVE TABLES.

TOWNHOME NOTES:

STATES INTERNAL TOWNHOME DRIVEWAYS ARE PRIVATE EASEMENTS AS PER CITY OF RALEIGH PUBLIC UTILITIES DEPARTMENT

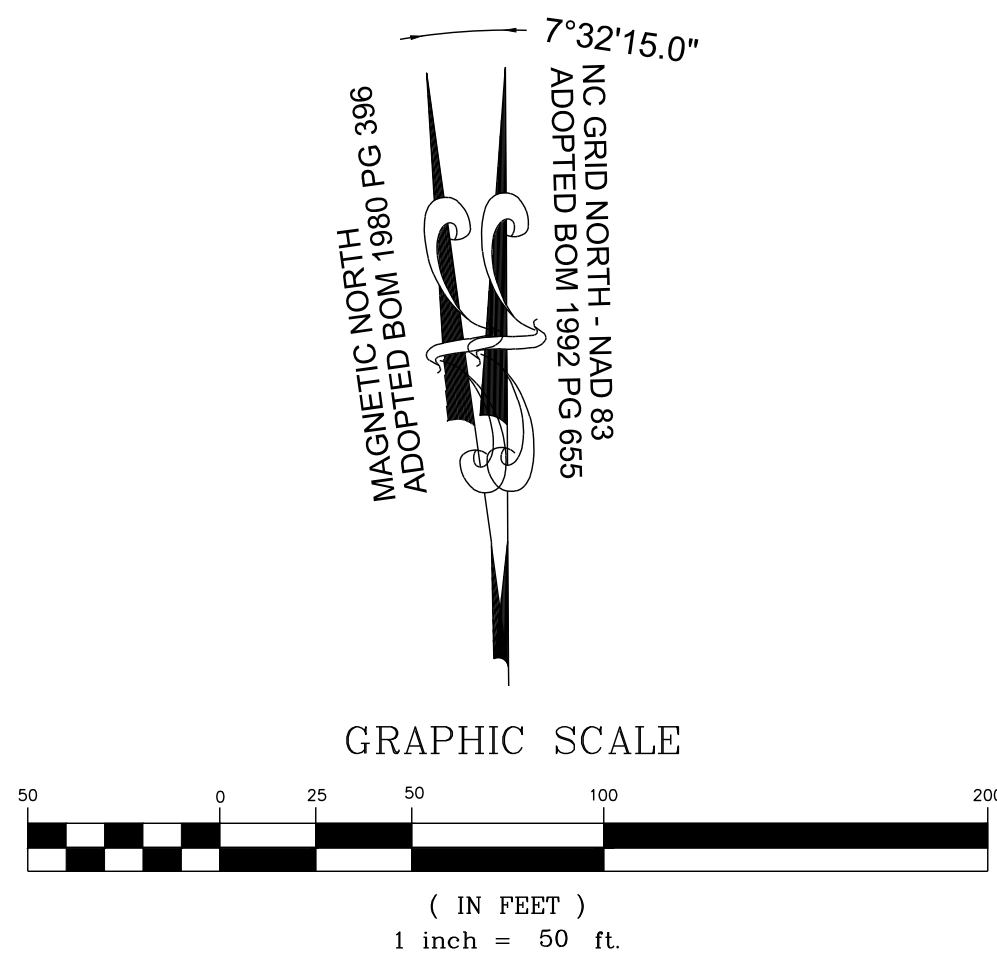

MONKEYWRENCH STREET
50' PUBLIC R/W

MATCH LINE

FOR CONTINUATION, SEE C-6.7

20.0' PRIVATE DRAINAGE EASEMENT

15.0' TYPE II PERIMETER BUFFER

GENERIC WOODEN PRIVACY FENCE 6' TALL

PROPERTY LINE (TYP.)

PHASE LINE (TYP.)

THIS PLANSET AND ANY ASSOCIATED DOCUMENTS ARE PRELIMINARY AND NOT AUTHORIZED FOR CONSTRUCTION UNTIL SIGNED, DATED, AND OFFICIALLY RELEASED FOR CONSTRUCTION BY THE ENGINEER OF RECORD.

STRONGROCK

ENGINEERING GROUP

RESERVE @ MITCHELL MILL

TOWN OF ROLESVILLE, WAKE COUNTY, NORTH CAROLINA

CONSTRUCTION PLANS

PARTIAL SITE PLAN VI

DRAWING SHEET

C-6.6

24 OF 227

SEAL:

01

08/04/2024

SRG

CONSTRUCTION INFRASTRUCTURE DRAWINGS

CID-24-04

02

11/01/2024

SRG

TOWN OF ROLESVILLE CID-24-04 V2

03

02/01/2025

SRG

TOWN OF ROLESVILLE CID-24-04 V3

04

08/02/2025

SRG

TOWN OF ROLESVILLE CID-24-04 V4

No.

REVISIONS

DATE

BY

STRONG ROCK PROJECT

PSP-24-03

NOT FOR CONSTRUCTION

SCALE AS SHOWN




DESIGNED BY SRG

DRAWN BY SRG

CHECKED BY SRG

STRONG ROCK ENGINEERING GROUP, PLLC | COMPANY LICENSE # P-2166

305 CHURCH AT NORTH HILLS STREET, SUITE 1110 RALEIGH, NC 27609 | INFORMATION@STRONGROCKGROUP.COM

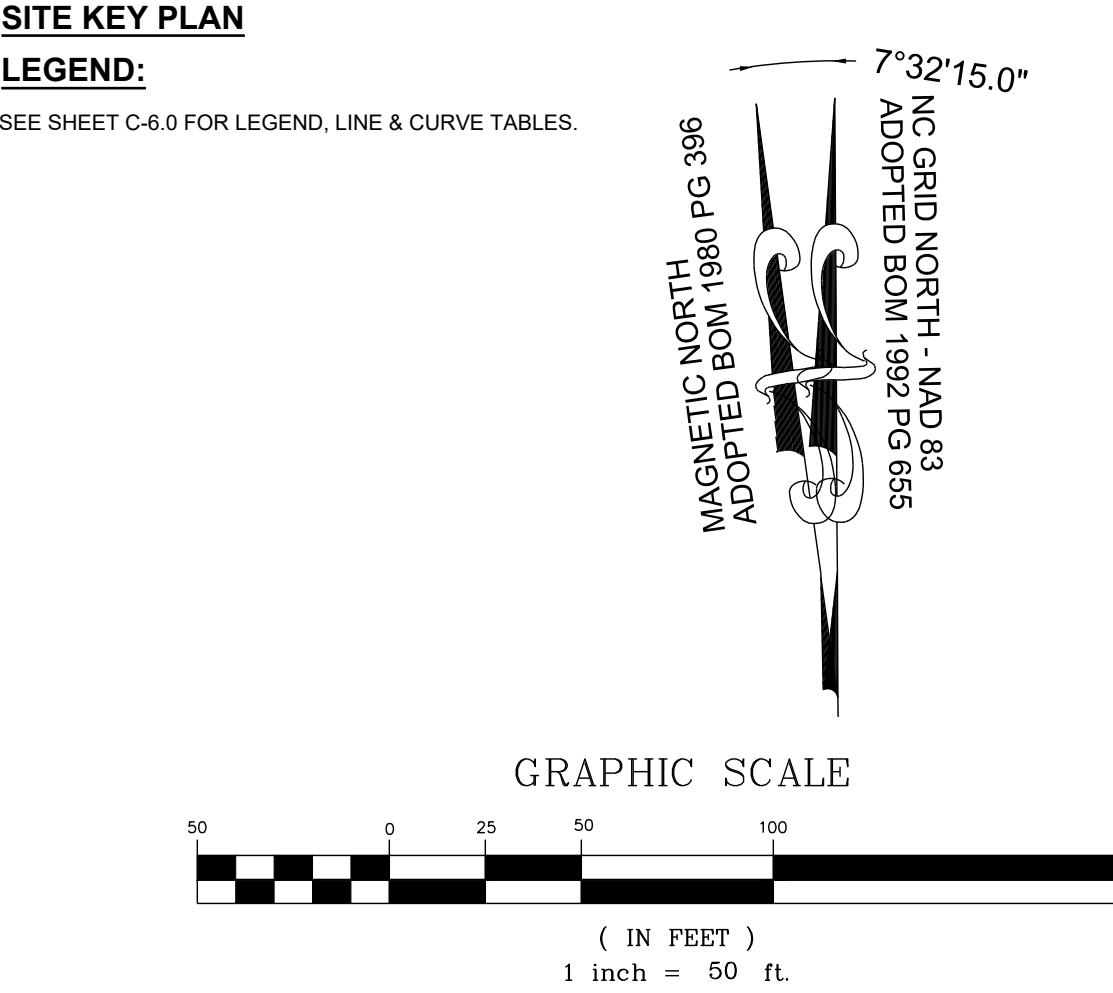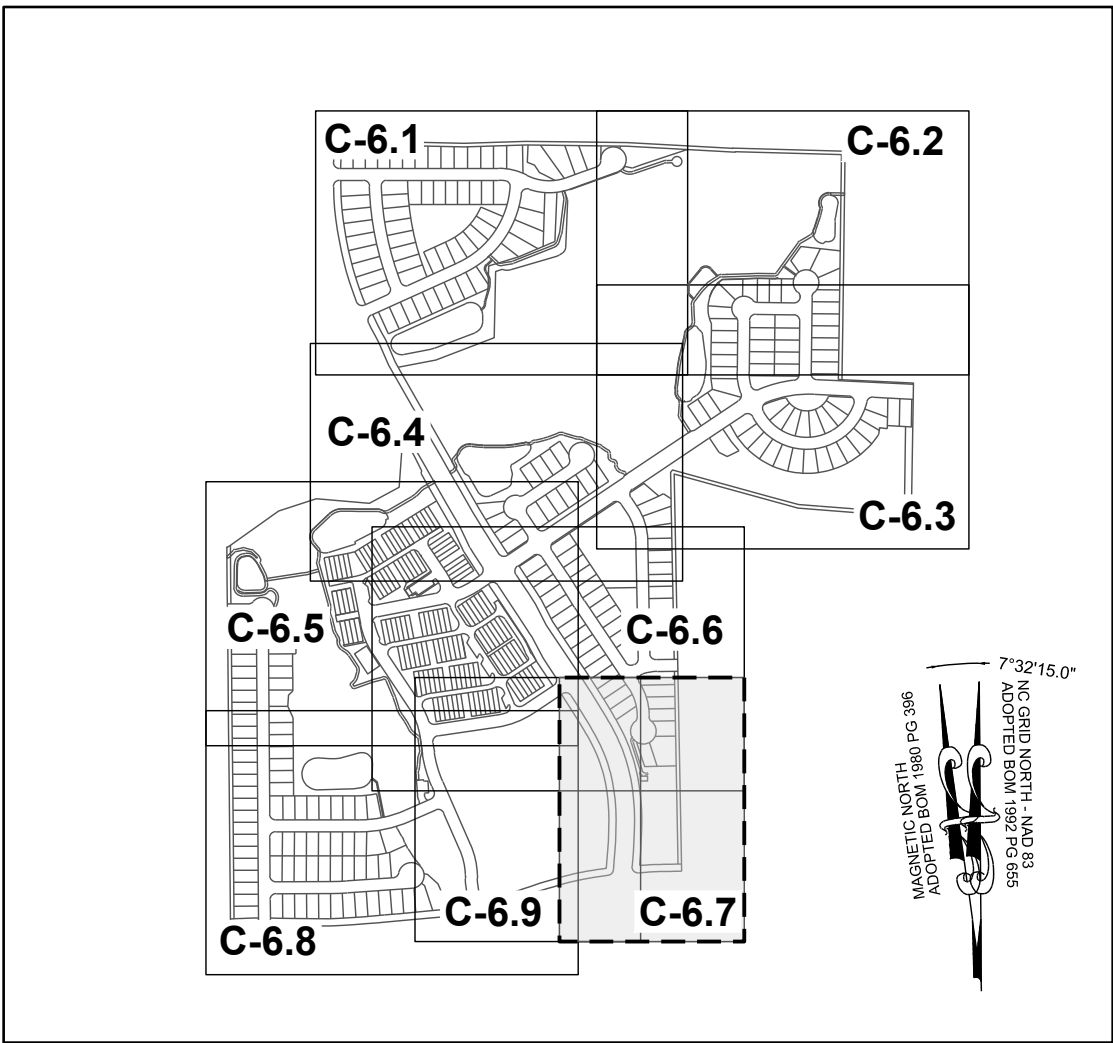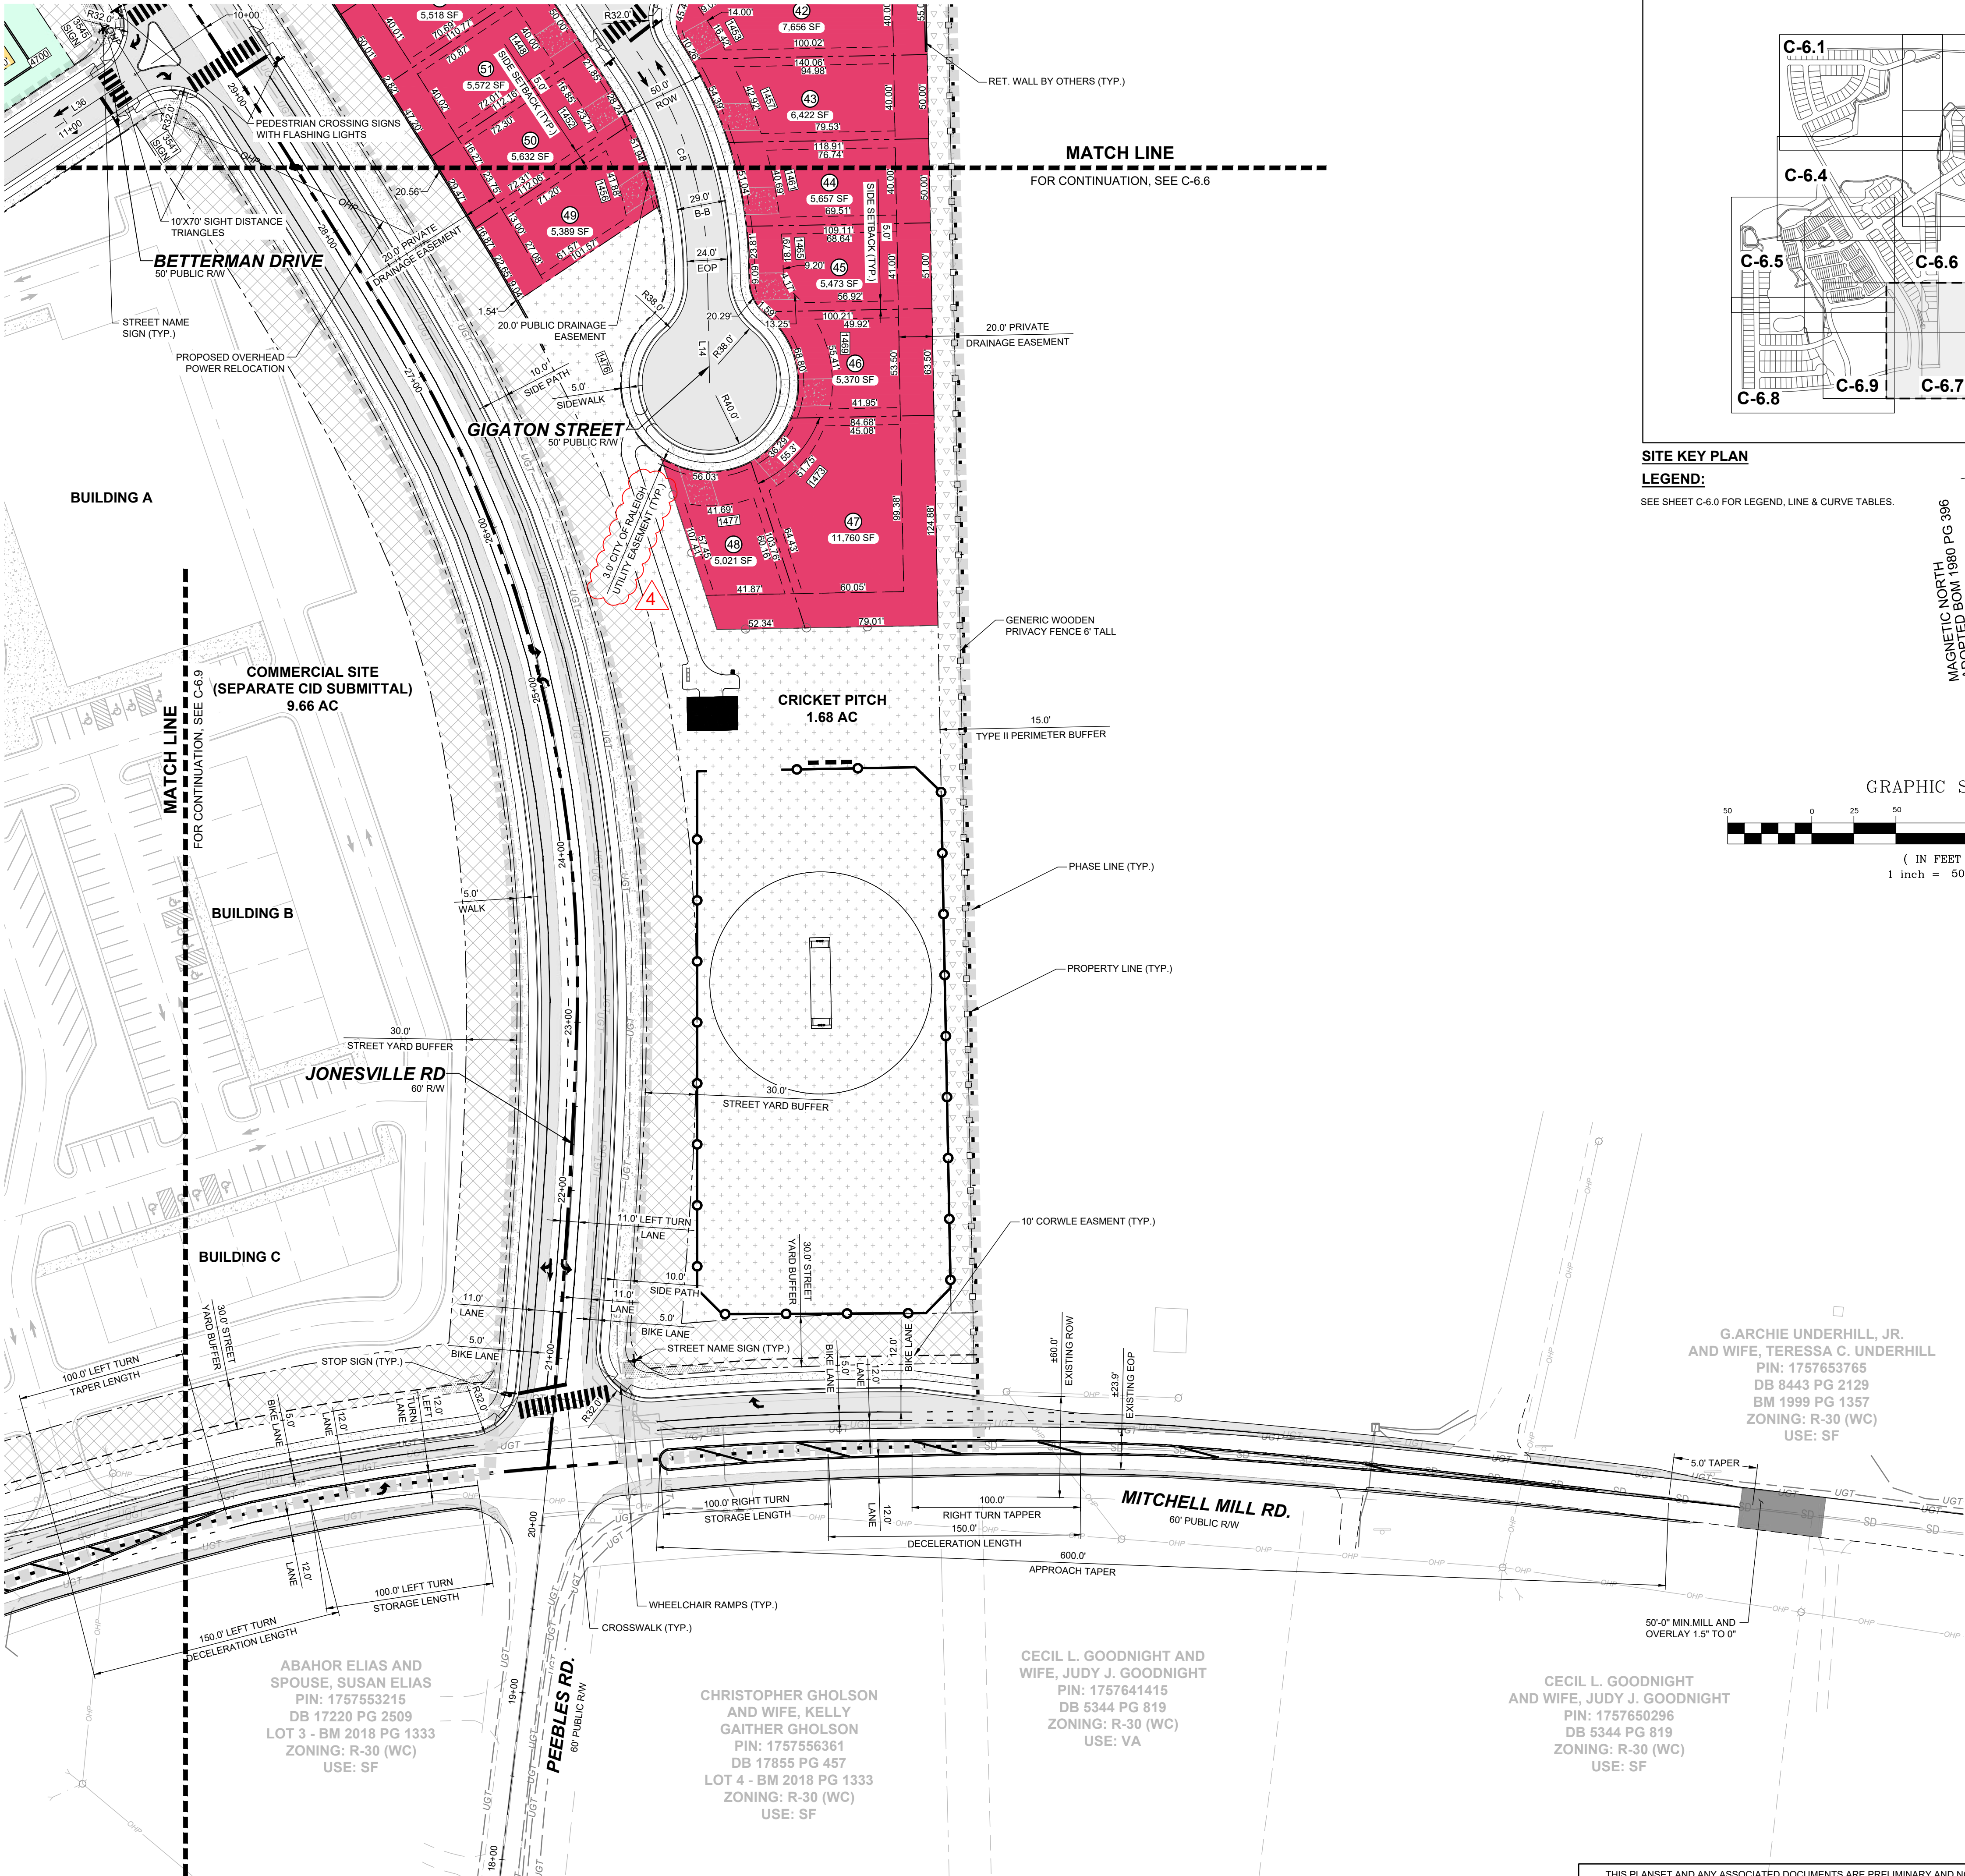


G. ARCHIE UNDERHILL, JR.
AND WIFE, TERESSA C. UNDERHILL
PIN: 1757653765
DB 8443 PG 2129
BM 1999 PG 1357
ZONING: R-30 (WC)
USE: SF

CECIL L. GOODNIGHT
AND WIFE, JUDY J. GOODNIGHT
PIN: 1757641415
DB 5344 PG 819
ZONING: R-30 (WC)
USE: VA

CHRISTOPHER GHOLSON
AND WIFE, KELLY
GAITHER GHOLSON
PIN: 1757556361
DB 17855 PG 457
LOT 4 - BM 2018 PG 1333
ZONING: R-30 (WC)
USE: SF

ABAHOR ELIAS AND
SPOUSE, SUSAN ELIAS
PIN: 1757553215
DB 17220 PG 2509
LOT 3 - BM 2018 PG 1333
ZONING: R-30 (WC)
USE: SF

CONSTRUCTION INFRASTRUCTURE DRAWINGS				REVISIONS		DATE	BY
01	08/04/2024	SRG	CID-24-04	No.			
02	11/07/2024	SRG	TOWN OF ROLESVILLE CID-24-04 V2				
03	02/07/2024	SRG	TOWN OF ROLESVILLE CID-24-04 V3				
04	08/02/2025	SRG	TOWN OF ROLESVILLE CID-24-04 V4				
SEAL:							
STRONG ROCK							
ENGINEERING GROUP							
STRONG ROCK ENGINEERING GROUP, PLLC COMPANY LICENSE # P-2166							
305 CHURCH AT NORTH HILLS STREET, SUITE 1110 RALEIGH, NC 27609 INFORMATION@STRONGROCKGROUP.COM							
STRONG ROCK PROJECT P-24-03							
NOT FOR CONSTRUCTION							
SCALE AS SHOWN							
DESIGNED BY SRG							
DRAWN BY SRG							
CHECKED BY SRG							
RESERVE @ MITCHELL MILL							
TOWN OF ROLESVILLE, WAKE COUNTY, NORTH CAROLINA							
CONSTRUCTION PLANS							
PARTIAL SITE PLAN VII							
DRAWING SHEET							
C-6.7							
25 OF 227							

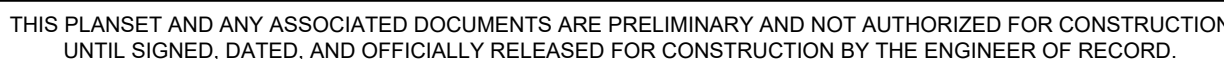

STRONG ROCK PROJECT PSP-23-03	NOT FOR CONSTRUCTION	SCALE	AS SHOWN	DESIGNED BY	SRG	DRAWN BY	SRG	CHECKED BY	SRG
----------------------------------	-------------------------	-------	----------	-------------	-----	----------	-----	------------	-----

RESERVE @ MITCHELL MILL
TOWN OF ROLESVILLE, WAKE COUNTY, NORTH CAROLINA


CONSTRUCTION PLANS

PARTIAL SITE PLAN VIII

DRAWING
SHEET

C-6.8

26 OF 227

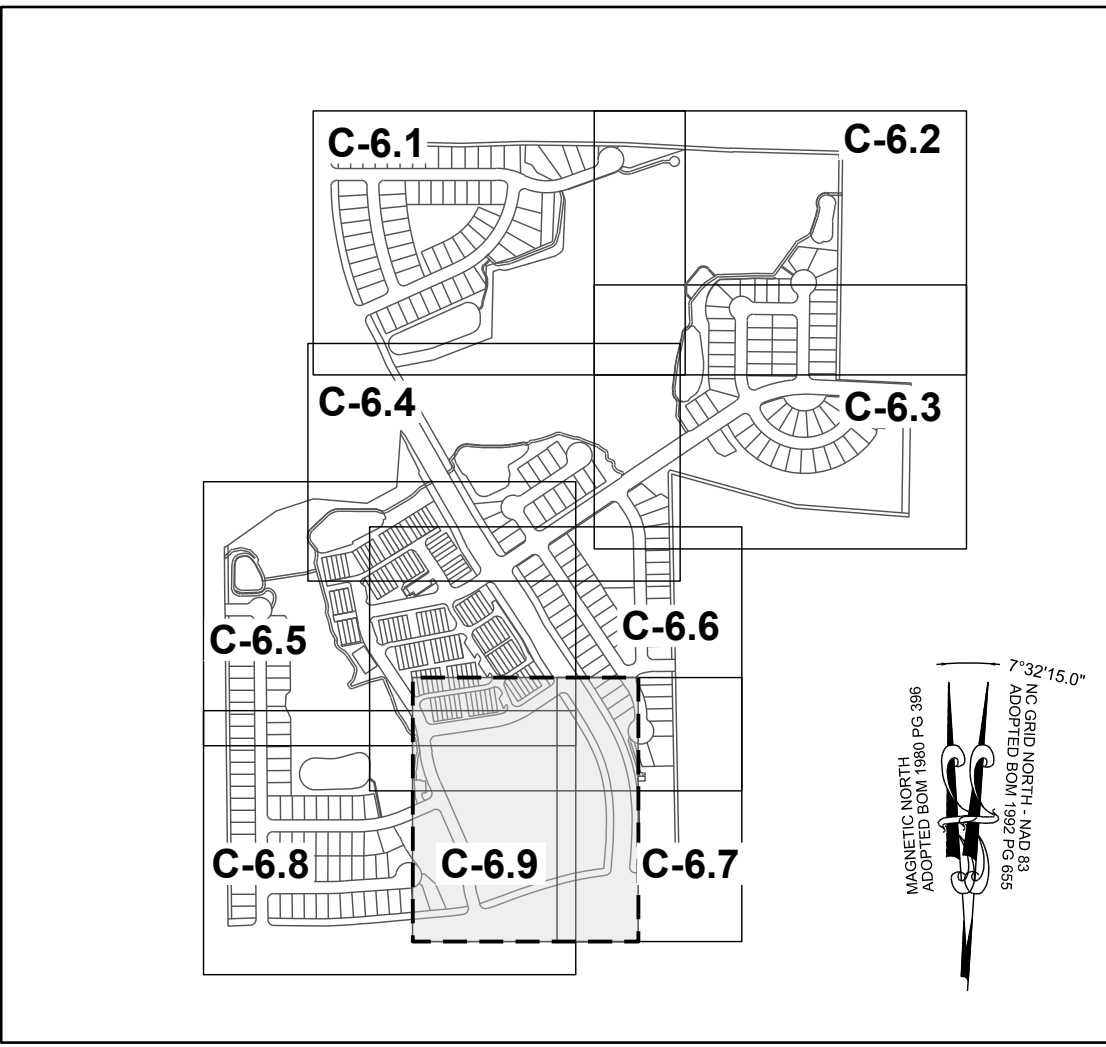



SITE KEY PLAN

LEGEND:

SEE SHEET C-6.0 FOR LEGEND, LINE & CURVE TABLES.

TOWNHOME NOTES:

STATES INTERNAL TOWNHOME DRIVEWAYS ARE PRIVATE EASEMENTS AS PER CITY OF RALEIGH PUBLIC UTILITIES DEPARTMENT

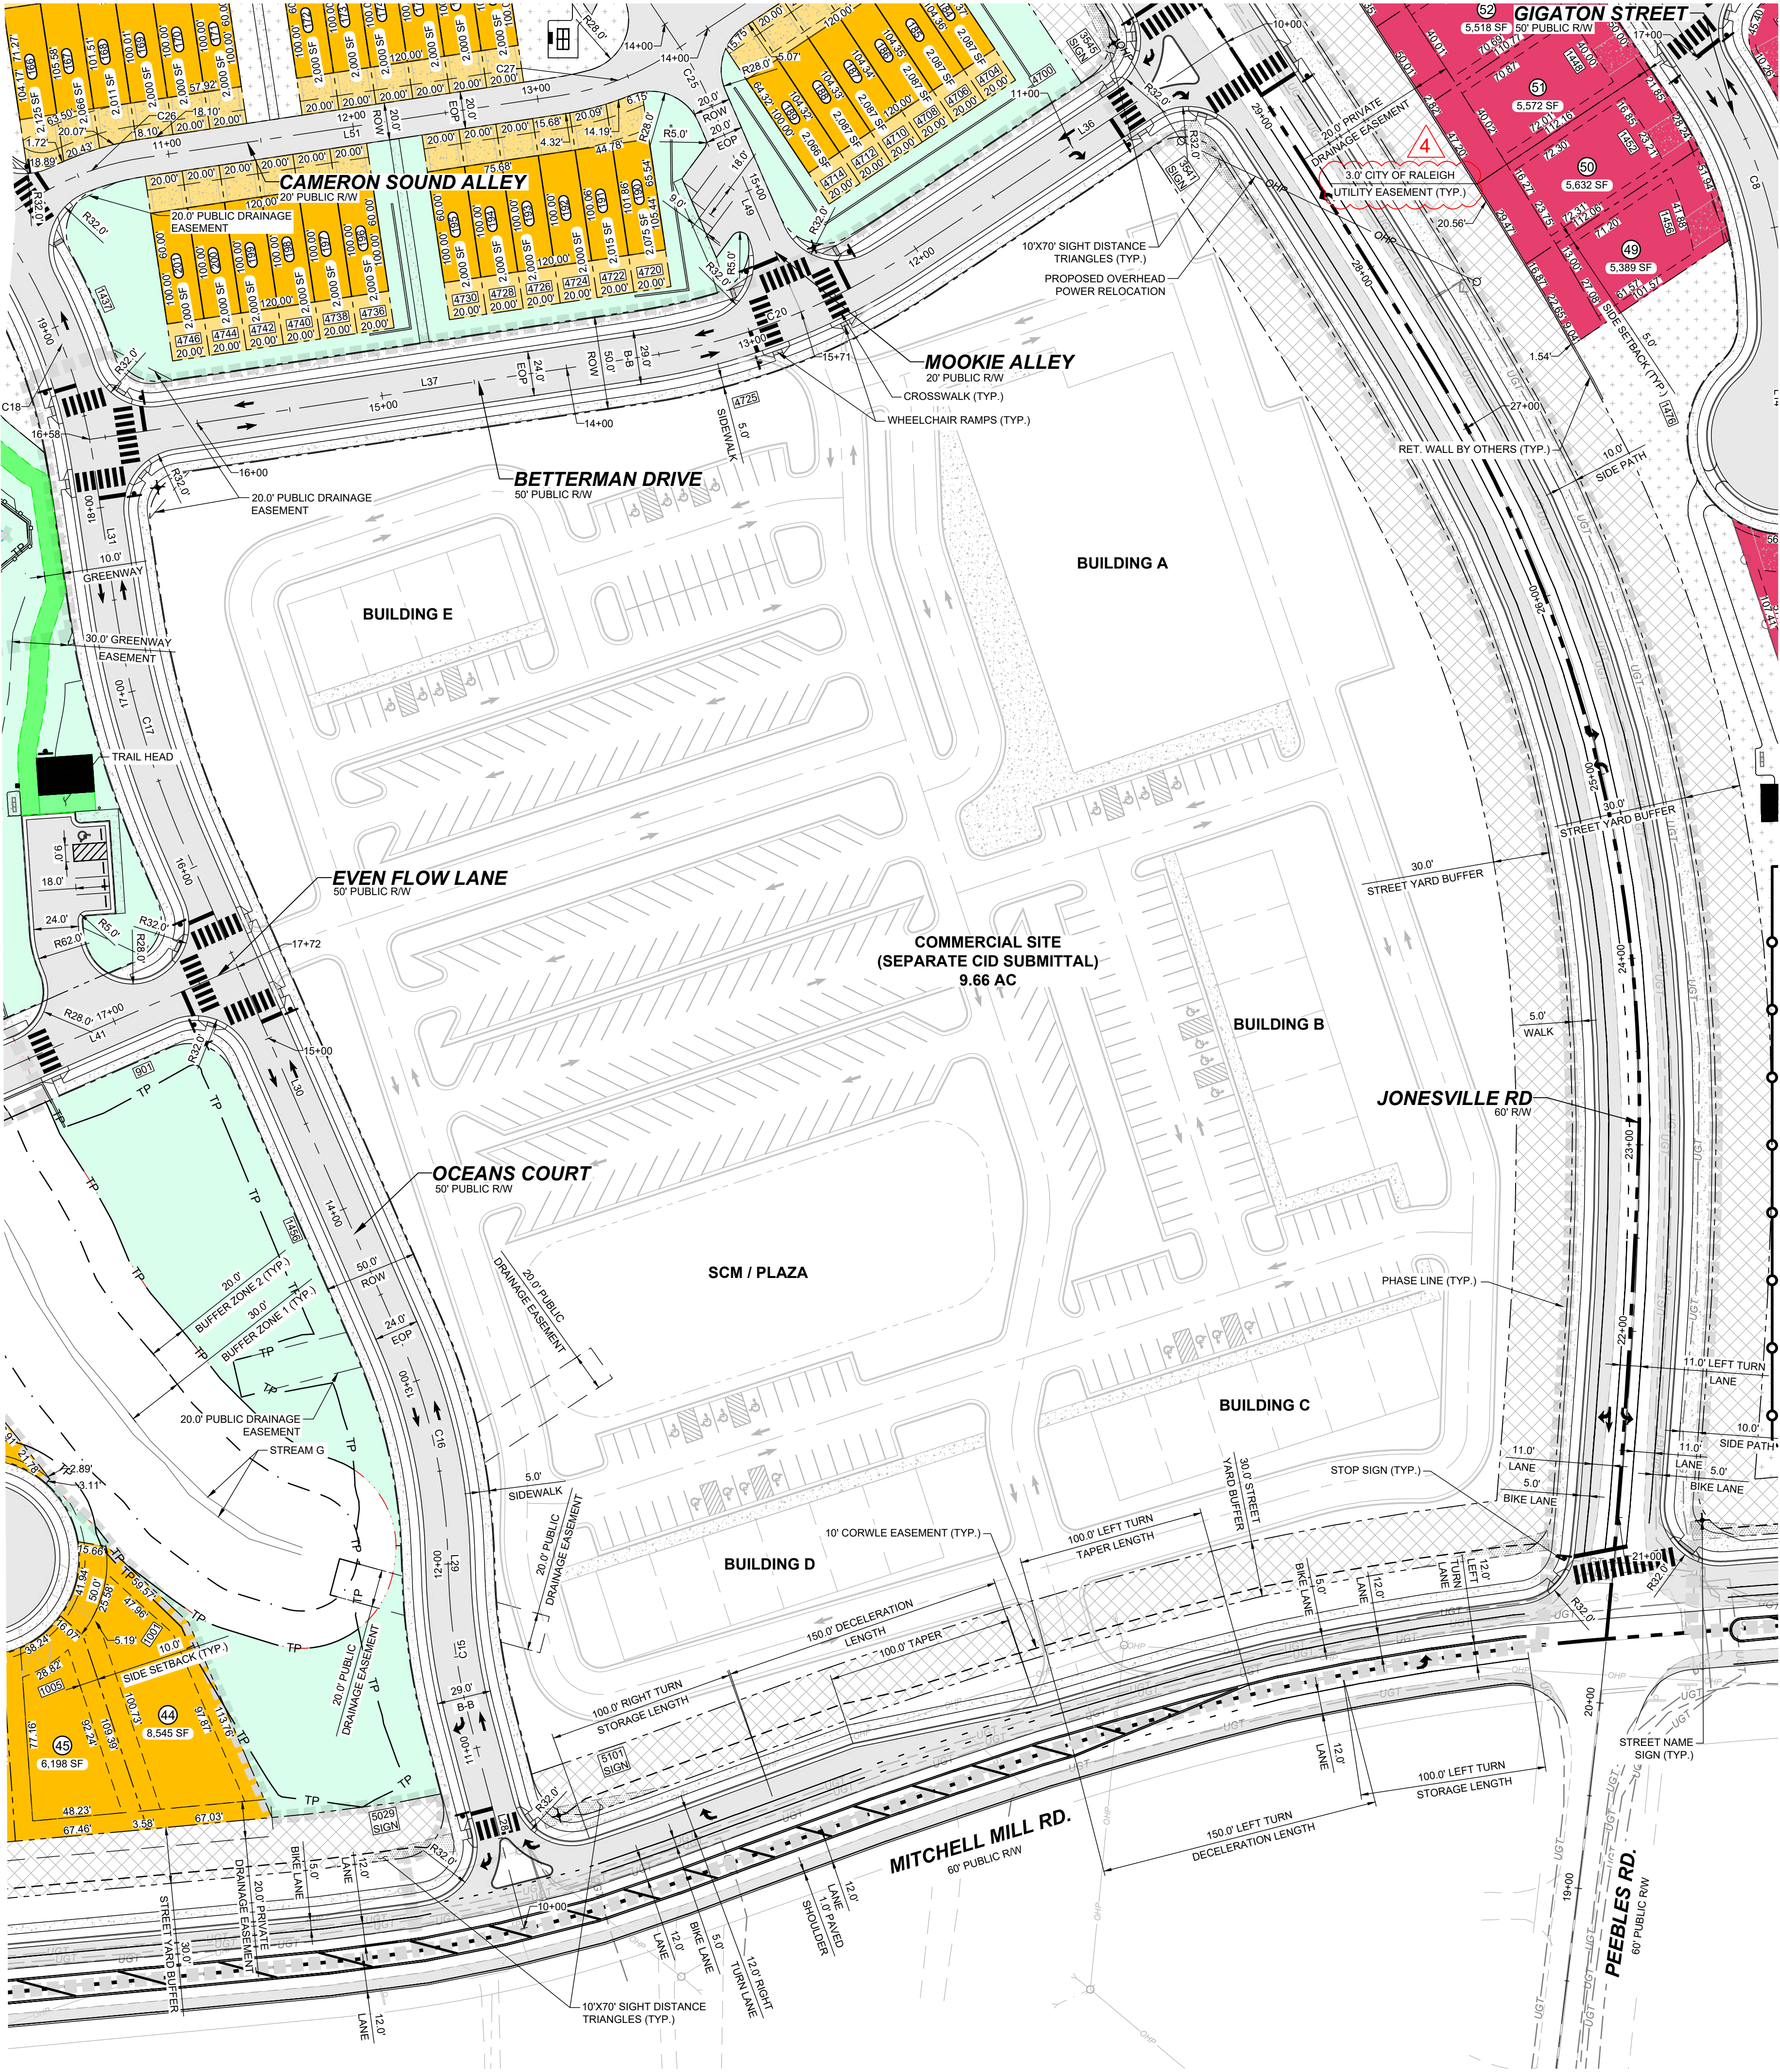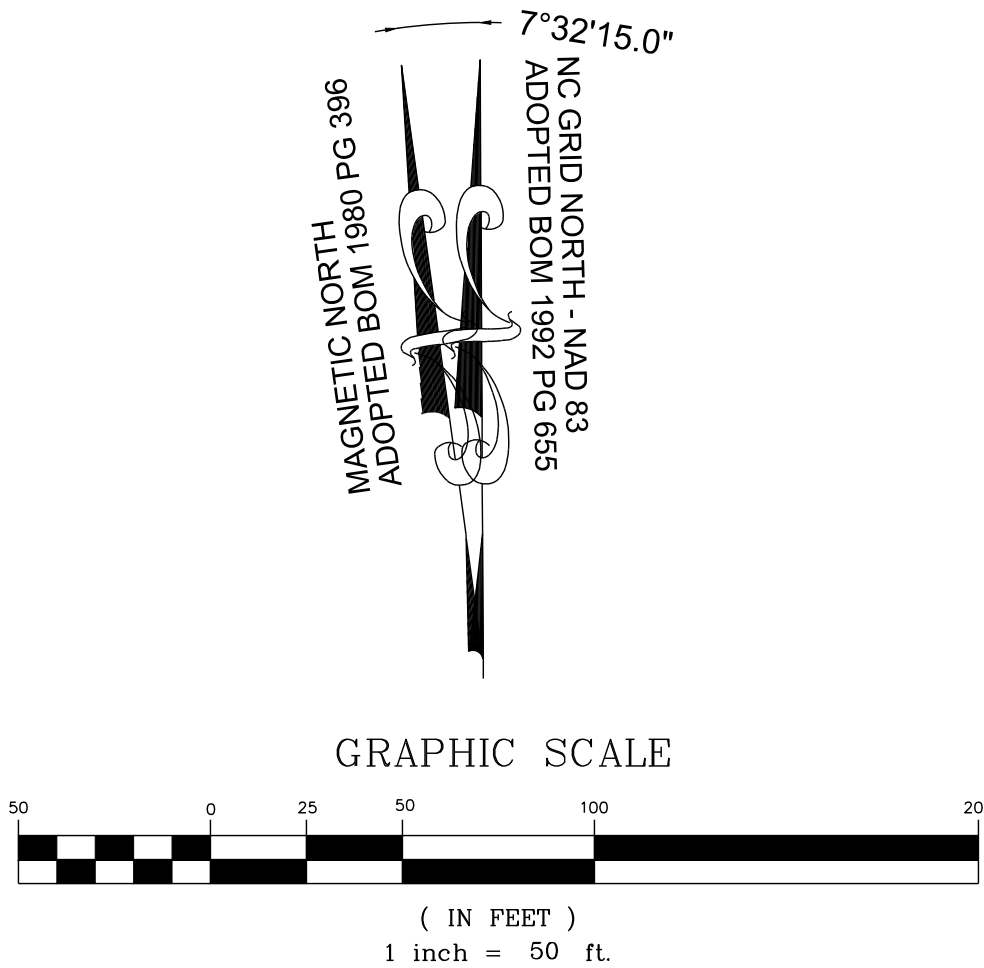

THIS PLANSET AND ANY ASSOCIATED DOCUMENTS ARE PRELIMINARY AND NOT AUTHORIZED FOR CONSTRUCTION UNTIL SIGNED, DATED, AND OFFICIALLY RELEASED FOR CONSTRUCTION BY THE ENGINEER OF RECORD.

STRONGROCK

ENGINEERING GROUP

STRONG ROCK PROJECT
PSP-24-03

NOT FOR
CONSTRUCTION

SCALE
AS SHOWN

DESIGNED BY
SRG

DRAWN BY
SRG

CHECKED BY
SRG

RESERVE @ MITCHELL MILL
TOWN OF ROLESVILLE, WAKE COUNTY, NORTH CAROLINA
CONSTRUCTION PLANS
PARTIAL SITE PLAN IX

DRAWING
SHEET
C-6.9

27 OF 227

SEAL:

CONSTRUCTION INFRASTRUCTURE DRAWINGS
CID-24-04

01

02

03

04

No.

REVISIONS

DATE

BY

08/04/2024

SRREG

11/07/2024

SRREG

02/07/2024

SRREG

08/02/2025

SRREG

305 CHURCH AT NORTH HILLS STREET, SUITE 1110 RALEIGH, NC 27609 | INFORMATION@STRONGROCKGROUP.COM

STRONG ROCK ENGINEERING GROUP, PLLC | COMPANY LICENSE # P-2166

DSF LOT SIZE TABLE - NC ZONE		
LOT NUMBER	AREA (SF)	DIMENSION (LF)
4	5,000	FRONT: 50' DEPTH: 100'
5	5,000	FRONT: 50' DEPTH: 100'
6	5,703	FRONT: 68' DEPTH: 100'
7	6,260	FRONT: 68' DEPTH: 100'
9	5,000	FRONT: 50' DEPTH: 100'
10	5,000	FRONT: 50' DEPTH: 100'
11	5,000	FRONT: 50' DEPTH: 100'
12	5,000	FRONT: 50' DEPTH: 100'
13	5,534	FRONT: 55' DEPTH: 100'
14	5,368	FRONT: 53' DEPTH: 100'
15	5,000	FRONT: 50' DEPTH: 100'
23	7,499	FRONT: 74' DEPTH: 100'
24	6,904	FRONT: 58' DEPTH: 101'
25	5,067	FRONT: 51' DEPTH: 101'
26	5,000	FRONT: 50' DEPTH: 100'
27	5,000	FRONT: 50' DEPTH: 100'
28	5,000	FRONT: 50' DEPTH: 100'
29	5,000	FRONT: 50' DEPTH: 100'
30	5,000	FRONT: 50' DEPTH: 100'
31	5,000	FRONT: 50' DEPTH: 100'
32	5,072	FRONT: 50' DEPTH: 100'
33	5,362	FRONT: 50' DEPTH: 108'
34	5,402	FRONT: 50' DEPTH: 108'
35	5,385	FRONT: 50' DEPTH: 108'
36	5,368	FRONT: 50' DEPTH: 107'
37	5,351	FRONT: 50' DEPTH: 107'
38	5,321	FRONT: 50' DEPTH: 106'
39	5,199	FRONT: 50' DEPTH: 106'
40	5,023	FRONT: 50' DEPTH: 102'
41	5,099	FRONT: 53' DEPTH: 100'
42	5,117	FRONT: 51' DEPTH: 105'
43	8,310	FRONT: 132' DEPTH: 105'
44	8,545	FRONT: 50' DEPTH: 174'
45	6,198	FRONT: 50' DEPTH: 125'
47	5,070	FRONT: 50' DEPTH: 102'
48	5,115	FRONT: 50' DEPTH: 103'
49	5,156	FRONT: 50' DEPTH: 103'
50	5,185	FRONT: 50' DEPTH: 104'
51	5,268	FRONT: 50' DEPTH: 104'
52	5,361	FRONT: 50' DEPTH: 105'
53	5,257	FRONT: 50' DEPTH: 105'
54	5,230	FRONT: 50' DEPTH: 105'

DSF LOT SIZE TABLE - NC ZONE		
LOT NUMBER	AREA (SF)	DIMENSION (LF)
55	5,184	FRONT: 50' DEPTH: 104'
56	5,127	FRONT: 50' DEPTH: 103'
57	5,060	FRONT: 51' DEPTH: 102'
58	5,115	FRONT: 50' DEPTH: 102'
59	5,051	FRONT: 50' DEPTH: 102'
60	5,092	FRONT: 50' DEPTH: 102'
61	5,100	FRONT: 50' DEPTH: 102'
62	5,108	FRONT: 50' DEPTH: 102'
63	5,115	FRONT: 50' DEPTH: 102'
64	5,123	FRONT: 50' DEPTH: 103'

DSF LOT SIZE TABLE - RM ZONE		
LOT NUMBER	AREA (SF)	DIMENSION (LF)
9	5,122	FRONT: 51' DEPTH: 112'
10	5,000	FRONT: 50' DEPTH: 100'
11	5,000	FRONT: 50' DEPTH: 100'
12	5,000	FRONT: 50' DEPTH: 100'
13	5,000	FRONT: 50' DEPTH: 100'
14	5,000	FRONT: 50' DEPTH: 100'
15	5,565	FRONT: 59' DEPTH: 100'
17	5,000	FRONT: 50' DEPTH: 100'
18	5,001	FRONT: 50' DEPTH: 100'
19	5,039	FRONT: 50' DEPTH: 102'
20	5,113	FRONT: 50' DEPTH: 103'
21	5,075	FRONT: 50' DEPTH: 103'
22	5,000	FRONT: 50' DEPTH: 100'
23	5,000	FRONT: 50' DEPTH: 100'
24	5,000	FRONT: 50' DEPTH: 100'
25	5,000	FRONT: 50' DEPTH: 100'
26	7,374	FRONT: 99' DEPTH: 100'
27	13,548	FRONT: 175' DEPTH: 130'
28	6,061	FRONT: 65' DEPTH: 101'
29	7,176	FRONT: 51' DEPTH: 126'
30	6,707	FRONT: 51' DEPTH: 126'
31	5,680	FRONT: 51' DEPTH: 107'
32	5,000	FRONT: 50' DEPTH: 100'
33	5,000	FRONT: 50' DEPTH: 100'
34	5,000	FRONT: 50' DEPTH: 100'
35	5,000	FRONT: 50' DEPTH: 100'
36	5,000	FRONT: 50' DEPTH: 100'
37	5,000	FRONT: 50' DEPTH: 100'
38	5,000	FRONT: 50' DEPTH: 100'
39	5,000	FRONT: 50' DEPTH: 100'
40	5,000	FRONT: 50' DEPTH: 100'
41	5,356	FRONT: 54' DEPTH: 100'
42	7,656	FRONT: 46' DEPTH: 140'
43	6,422	FRONT: 54' DEPTH: 140'
44	5,657	FRONT: 51' DEPTH: 119'
45	5,473	FRONT: 56' DEPTH: 109'
46	5,370	FRONT: 66' DEPTH: 100'
47	11,760	FRONT: 62' DEPTH: 104'
48	5,021	FRONT: 53' DEPTH: 107'
66	6,595	FRONT: 92' DEPTH: 124'
67	6,898	FRONT: 75' DEPTH: 124'
68	5,505	FRONT: 50' DEPTH: 110'

DSF LOT SIZE TABLE - RM ZONE		
LOT NUMBER	AREA (SF)	DIMENSION (LF)
69	5,500	FRONT: 50' DEPTH: 110'
70	5,500	FRONT: 50' DEPTH: 110'
71	5,500	FRONT: 50' DEPTH: 110'
72	5,587	FRONT: 50' DEPTH: 115'
73	5,161	FRONT: 51' DEPTH: 115'
74	7,143	FRONT: 50' DEPTH: 100'
76	5,056	FRONT: 69' DEPTH: 100'
77	5,005	FRONT: 50' DEPTH: 100'
78	5,000	FRONT: 50' DEPTH: 100'
79	6,325	FRONT: 78' DEPTH: 100'
80	8,057	FRONT: 68' DEPTH: 101'
82	6,284	FRONT: 60' DEPTH: 100'
84	5,697	FRONT: 50' DEPTH: 114'
85	5,694	FRONT: 50' DEPTH: 114'
86	5,691	FRONT: 50' DEPTH: 114'
87	5,688	FRONT: 50' DEPTH: 114'
88	5,684	FRONT: 50' DEPTH: 114'
89	5,681	FRONT: 50' DEPTH: 114'
95	5,592	FRONT: 54' DEPTH: 104'
96	5,206	FRONT: 50' DEPTH: 104'
97	5,206	FRONT: 50' DEPTH: 104'
98	5,206	FRONT: 50' DEPTH: 104'
99	5,203	FRONT: 50' DEPTH: 104'
101	5,100	FRONT: 57' DEPTH: 110'
102	5,100	FRONT: 57' DEPTH: 110'
103	5,100	FRONT: 57' DEPTH: 110'
108	5,753	FRONT: 50' DEPTH: 115'
109	5,790	FRONT: 50' DEPTH: 115'
110	5,753	FRONT: 53' DEPTH: 100'
111	5,866	FRONT: 50' DEPTH: 100'
112	5,490	FRONT: 50' DEPTH: 100'
113	5,545	FRONT: 50' DEPTH: 100'
114	5,517	FRONT: 50' DEPTH: 100'
115	5,545	FRONT: 50' DEPTH: 100'
116	5,545	FRONT: 50' DEPTH: 100'
117	5,545	FRONT: 50' DEPTH: 100'
118	5,545	FRONT: 50' DEPTH: 100'
119	5,545	FRONT: 50' DEPTH: 100'
120	5,545	FRONT: 50' DEPTH: 100'
121	5,545	FRONT: 50' DEPTH: 100'
122	5,515	FRONT: 50' DEPTH: 100'
123	5,845	FRONT: 59' DEPTH: 100'

DSF LOT SIZE TABLE - RM ZONE		
LOT NUMBER	AREA (SF)	DIMENSION (LF)
124	7,066	FRONT: 52' DEPTH: 110'
125	5,000	FRONT: 50' DEPTH: 100'
126	5,000	FRONT: 50' DEPTH: 100'
127	5,000	FRONT: 50' DEPTH: 100'
128	5,000	FRONT: 50' DEPTH: 100'
129	5,000	FRONT: 50' DEPTH: 100'
130	5,000	FRONT: 50' DEPTH: 100'
131	5,000	FRONT: 50' DEPTH: 100'
132	5,196	FRONT: 50' DEPTH: 100'
133	5,709	FRONT: 50' DEPTH: 100'
134	7,388	FRONT: 59' DEPTH: 102'
135	9,518	FRONT: 59' DEPTH: 152'
136	7,674	FRONT: 59' DEPTH: 131'
137	8,151	FRONT: 81' DEPTH: 109'
138	10,501	FRONT: 50' DEPTH: 236'
139	13,113	FRONT: 90' DEPTH: 277'
140	6,857	FRONT: 66' DEPTH: 108'
141	6,523	FRONT: 55' DEPTH: 129'
142	10,038	FRONT: 54' DEPTH: 170'
143	11,353	FRONT: 64' DEPTH: 170'
144	7,101	FRONT: 70' DEPTH: 118'
157	5,074	FRONT: 52' DEPTH: 101'
158	7,319	FRONT: 59' DEPTH: 120'
167	6,292	FRONT: 61' DEPTH: 110'
168	5,464	FRONT: 51' DEPTH: 110'
169	5,910	FRONT: 55' DEPTH: 100'
170	5,908	FRONT: 55' DEPTH: 100'
171	5,908	FRONT: 55' DEPTH: 100'
172	5,908	FRONT: 55' DEPTH: 100'
173	5,909	FRONT: 55' DEPTH: 100'
174	6,280	FRONT: 60' DEPTH: 110'
175	5,454	FRONT: 56' DEPTH: 101'
176	5,000	FRONT: 50' DEPTH: 100'
177	5,000	FRONT: 50' DEPTH: 100'
178	5,000	FRONT: 50' DEPTH: 100'
179	5,000	FRONT: 50' DEPTH: 100'
180	5,000	FRONT: 50' DEPTH: 100'
181	5,000	FRONT: 50' DEPTH: 100'
182	6,401	FRONT: 69' DEPTH: 100'

STRONGROCK
ENGINEERING GROUP

STRONG ROCK ENGINEERING GROUP, PLLC | COMPANY LICENSE # P-2166
305 CHURCH AT NORTH HILLS STREET, SUITE 1110 RALEIGH, NC 27609 | INFORMATION@STRONGROCKGROUP.COM

STRONG ROCK PROJECT
PSP-24-03

NOT FOR
CONSTRUCTION

SCALE
AS SHOWN

DESIGNED BY
SRG

DRAWN BY
SRG

CHECKED BY
SRG

RESERVE @ MITCHELL MILL
TOWN OF ROLESVILLE, WAKE COUNTY, NORTH CAROLINA
CONSTRUCTION PLANS
LOT SIZE TABLES

DRAWING
SHEET
C-6.10

28 OF 227

CONSTRUCTION INFRASTRUCTURE DRAWINGS
CID-24-04

01

02

03

04

No.

SEAL:

08/04/2024
SRG

11/07/2024
SRG

02/07/2024
SRG

08/02/2025
SRG

DATE

BY

REVISIONS

THIS PLANSET AND ANY ASSOCIATED DOCUMENTS ARE PRELIMINARY AND NOT AUTHORIZED FOR CONSTRUCTION UNTIL SIGNED, DATED, AND OFFICIALLY RELEASED FOR CONSTRUCTION BY THE ENGINEER OF RECORD.



NC-CZ OPEN SPACE BREAKDOWN						
				ACTUAL		
TOTAL PROPERTY AREA				SF	AC	
		PHASE 4		797,972	18.32	
		PHASE 5		727,802	16.71	
		PHASE 6		829,951	19.05	
		TOTAL NC-CZ AREA		2,355,725	54.08	
			REQUIRED	PROPOSED		
OPEN SPACE	SECTION 6.2.1.D.2	PHASE 4	119,696	2.75	344,530	7.91
		PHASE 5	109,170	2.51	344,217	7.90
		PHASE 6	124,493	2.86	193,330	4.44
		TOTAL	353,359	8.11 (15%)	882,078	20.25 (37.44%)


STRONGROCK
ENGINEERING GROUP

STRONG ROCK PROJECT PSP-23-03	NOT FOR CONSTRUCTION	SCALE	AS SHOWN	DESIGNED BY	SRG	DRAWN BY	SRG	CHECKED BY	SRG
----------------------------------	-------------------------	-------	----------	-------------	-----	----------	-----	------------	-----

31 OF 227

THIS PLANSET AND ANY ASSOCIATED DOCUMENTS ARE PRELIMINARY AND NOT AUTHORIZED FOR CONSTRUCTION UNTIL SIGNED, DATED, AND OFFICIALLY RELEASED FOR CONSTRUCTION BY THE ENGINEER OF RECORD.

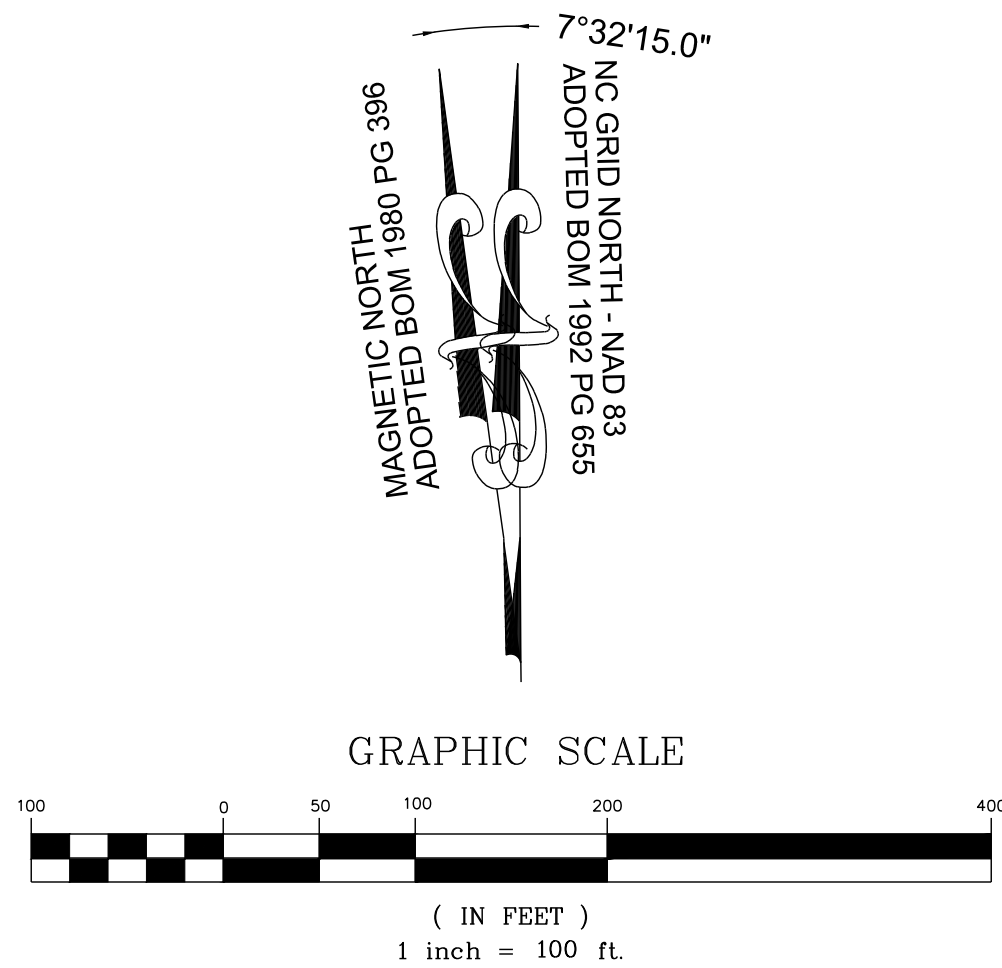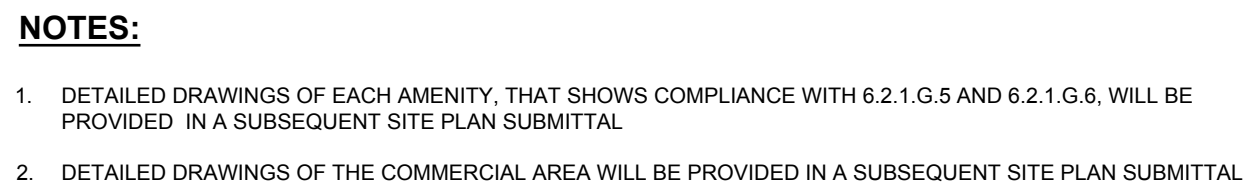

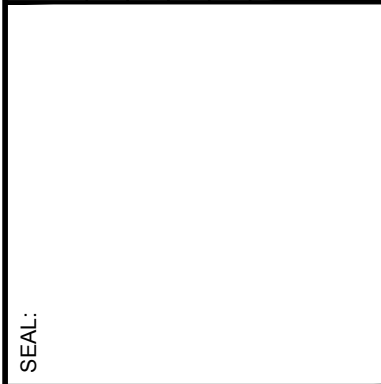

STRONGROCK
ENGINEERING GROUP

STRONG ROCK ENGINEERING GROUP, PLLC | COMPANY LICENSE # P-2166
305 CHURCH AT NORTH HILLS STREET, SUITE 1110 RALEIGH, NC 27609 | INFORMATION@STRONGROCKGROUP.COM

STRONG ROCK PROJECT PSP-23-03	NOT FOR CONSTRUCTION	SCALE	AS SHOWN	DESIGNED BY	SRG	DRAWN BY	SRG	CHECKED BY	SRG
----------------------------------	-------------------------	-------	----------	-------------	-----	----------	-----	------------	-----

RESERVE @ MITCHELL MILL
TOWN OF ROLESVILLE, WAKE COUNTY, NORTH CAROLINA
CONSTRUCTION PLANS

PASSIVE & ACTIVE OPEN SPACE
NC-CZ ZONE

DRAWING SHEET

C-7.1

THIS PLANSET AND ANY ASSOCIATED DOCUMENTS ARE PRELIMINARY AND NOT AUTHORIZED FOR CONSTRUCTION
UNTIL SIGNED, DATED, AND OFFICIALLY RELEASED FOR CONSTRUCTION BY THE ENGINEER OF RECORD.

RM-CZ LAND USE CHART			
	UDO SECTION	PROPOSED	
		SF	AC
TOTAL AREA		3,685,612	84.61
40% OPTION REQUIREMENT	3.1.B.1	1,474,245	33.84 (40.0%)
PROPOSED OPEN SPACE		2,107,864	48.39 (67.2%)

NOTES:

1. DETAILED DRAWINGS OF EACH AMENITY, THAT SHOWS COMPLIANCE WITH SUBSECTIONS 5 AND 6, WILL BE PROVIDED IN A LATER CD SUBMITTAL
2. ALL PROPOSED OPEN SPACE SHALL BE OWNED BY THE HOA
3. IT IS INCLUDED AS A PORTION OF ALL THE THREE PHASES OF DEVELOPMENT YET AS OPEN SPACE IS NOT DEVELOPED DURING THE THAT SPECIFIC PHASE

VEDDER LANE
50' PUBLIC R/W

MCCREARY COURT
50' PUBLIC R/W

DARK MATTER ALLEY
20' PUBLIC R/W

CAMERON SOUND ALLEY
20' PUBLIC R/W

OCEANS COURT
50' PUBLIC R/W

EVEN FLOW LANE
50' PUBLIC R/W

YELLOW MOON COURT
50' PUBLIC R/W

PEARL JAM ALLEY
20' PUBLIC R/W

MOOKIE ALLEY
20' PUBLIC R/W

BETTERMAN DRIVE
50' PUBLIC R/W

JONESVILLE RD
60' R/W

PEBBLES RD
60' PUBLIC R/W

COUNTER STREET
50' PUBLIC R/W

MONKEYWRENCH STREET
50' PUBLIC R/W

GIGATON STREET
50' PUBLIC R/W

PENDULUM STREET
50' PUBLIC R/W

MITCHELL MILL RD.
60' PUBLIC R/W

SCM #1 WET POND

SCM #7 WET POND

SCM #8 WET POND

WET POND

GRAPHIC SCALE
(IN FEET)
1 inch = 200 ft.



MAGNETIC NORTH
ADOPTED BOM 1980 PG 396
NC GRID NORTH - NAD 83
ADOPTED BOM 1992 PG 655
7°32'15.0"

RM-CZ PASSIVE AND ACTIVE OPEN SPACE CALCULATIONS						
TOTAL PROPERTY AREA	PHASE	REQUIRED			PROPOSED	
		SF	AC	PERCENT	SF	AC
					1,990,258	45.69
					899,949	20.66
	TOTAL RM-CZ AREA				3,685,612	84.61
OPEN SPACE	PASSIVE	6.2.1.D.1	442,273.44	10.15	12%	
	ACTIVE	6.2.1.G.12	221,136.72	5.08	6%	
PASSIVE OPEN SPACE PER PHASE "POS"						
PHASE 1						
POS 1	GREENWAY				26,869	0.62 (0.7%)
POS 2	NATURAL AREAS				1,163,923	26.72 (31.6%)
PHASE 2						
POS 3	GREENWAY				45,020	1.03 (1.2%)
POS 4	LAWN AND NATURAL AREA				39,881	0.92 (1.1%)
POS 5	LAWN AND NATURAL AREA				36,042	0.83 (1.0%)
PHASE 3						
POS 6	POLLINATOR GARDEN				47,045	1.08 (1.3%)
POS 7	PRIMITIVE TRAIL				60,548	1.39 (1.6%)
TOTAL PROPOSED PASSIVE OPEN SPACE		SECTION 6.2.1.D.1	442,273.00	10.15	12%	1,419,329 32.58 (38.5%)
ACTIVE OPEN SPACE "AS"						
PHASE 1						
AS 1	CRICKET PITCH				73,374	1.68 (2.0%)
AS 2	AMENITY CENTER				65,780	1.51 (1.8%)
PHASE 2						
AS 3	SMALL IPEMA PLAYGROUND				9,855	0.23 (0.3%)
AS 4	PARKOUR COURSE				74,931	1.71 (2.0%)
PHASE 3						
AS 5	SMALL IPEMA PLAYGROUND				8,742	0.20 (0.2%)
AS 6	BALLFIELD				45,842	1.05 (1.2%)
TOTALS PHASES 1,2 & 3		SECTION 6.2.1.G.12	221,173.00	5.08	6%	278,524 6.39 (7.6%)

"POS": PASSIVE OPEN SPACE
"AS": ACTIVE (OPEN) SPACE

LEGEND:	
	MASTER PLAN BOUNDARY
	EXISTING ADJOINER PROPERTY LINE
	EXISTING INTERMITTENT STREAM
	EXISTING PERENNIAL STREAM
	EXISTING BUFFER ZONE 1
	EXISTING BUFFER ZONE 2
	500 YEAR FLOOD LINE
	100 YEAR FLOOD LINE
	ACTIVE OPEN SPACE
	PASSIVE OPEN SPACE
	EXISTING WETLAND

NOTES:
* DETAILED DRAWINGS OF EACH AMENITY, THAT SHOWS COMPLIANCE WITH SUBSECTIONS 5 AND 6, WILL BE PROVIDED IN A LATER CD SUBMITTAL.

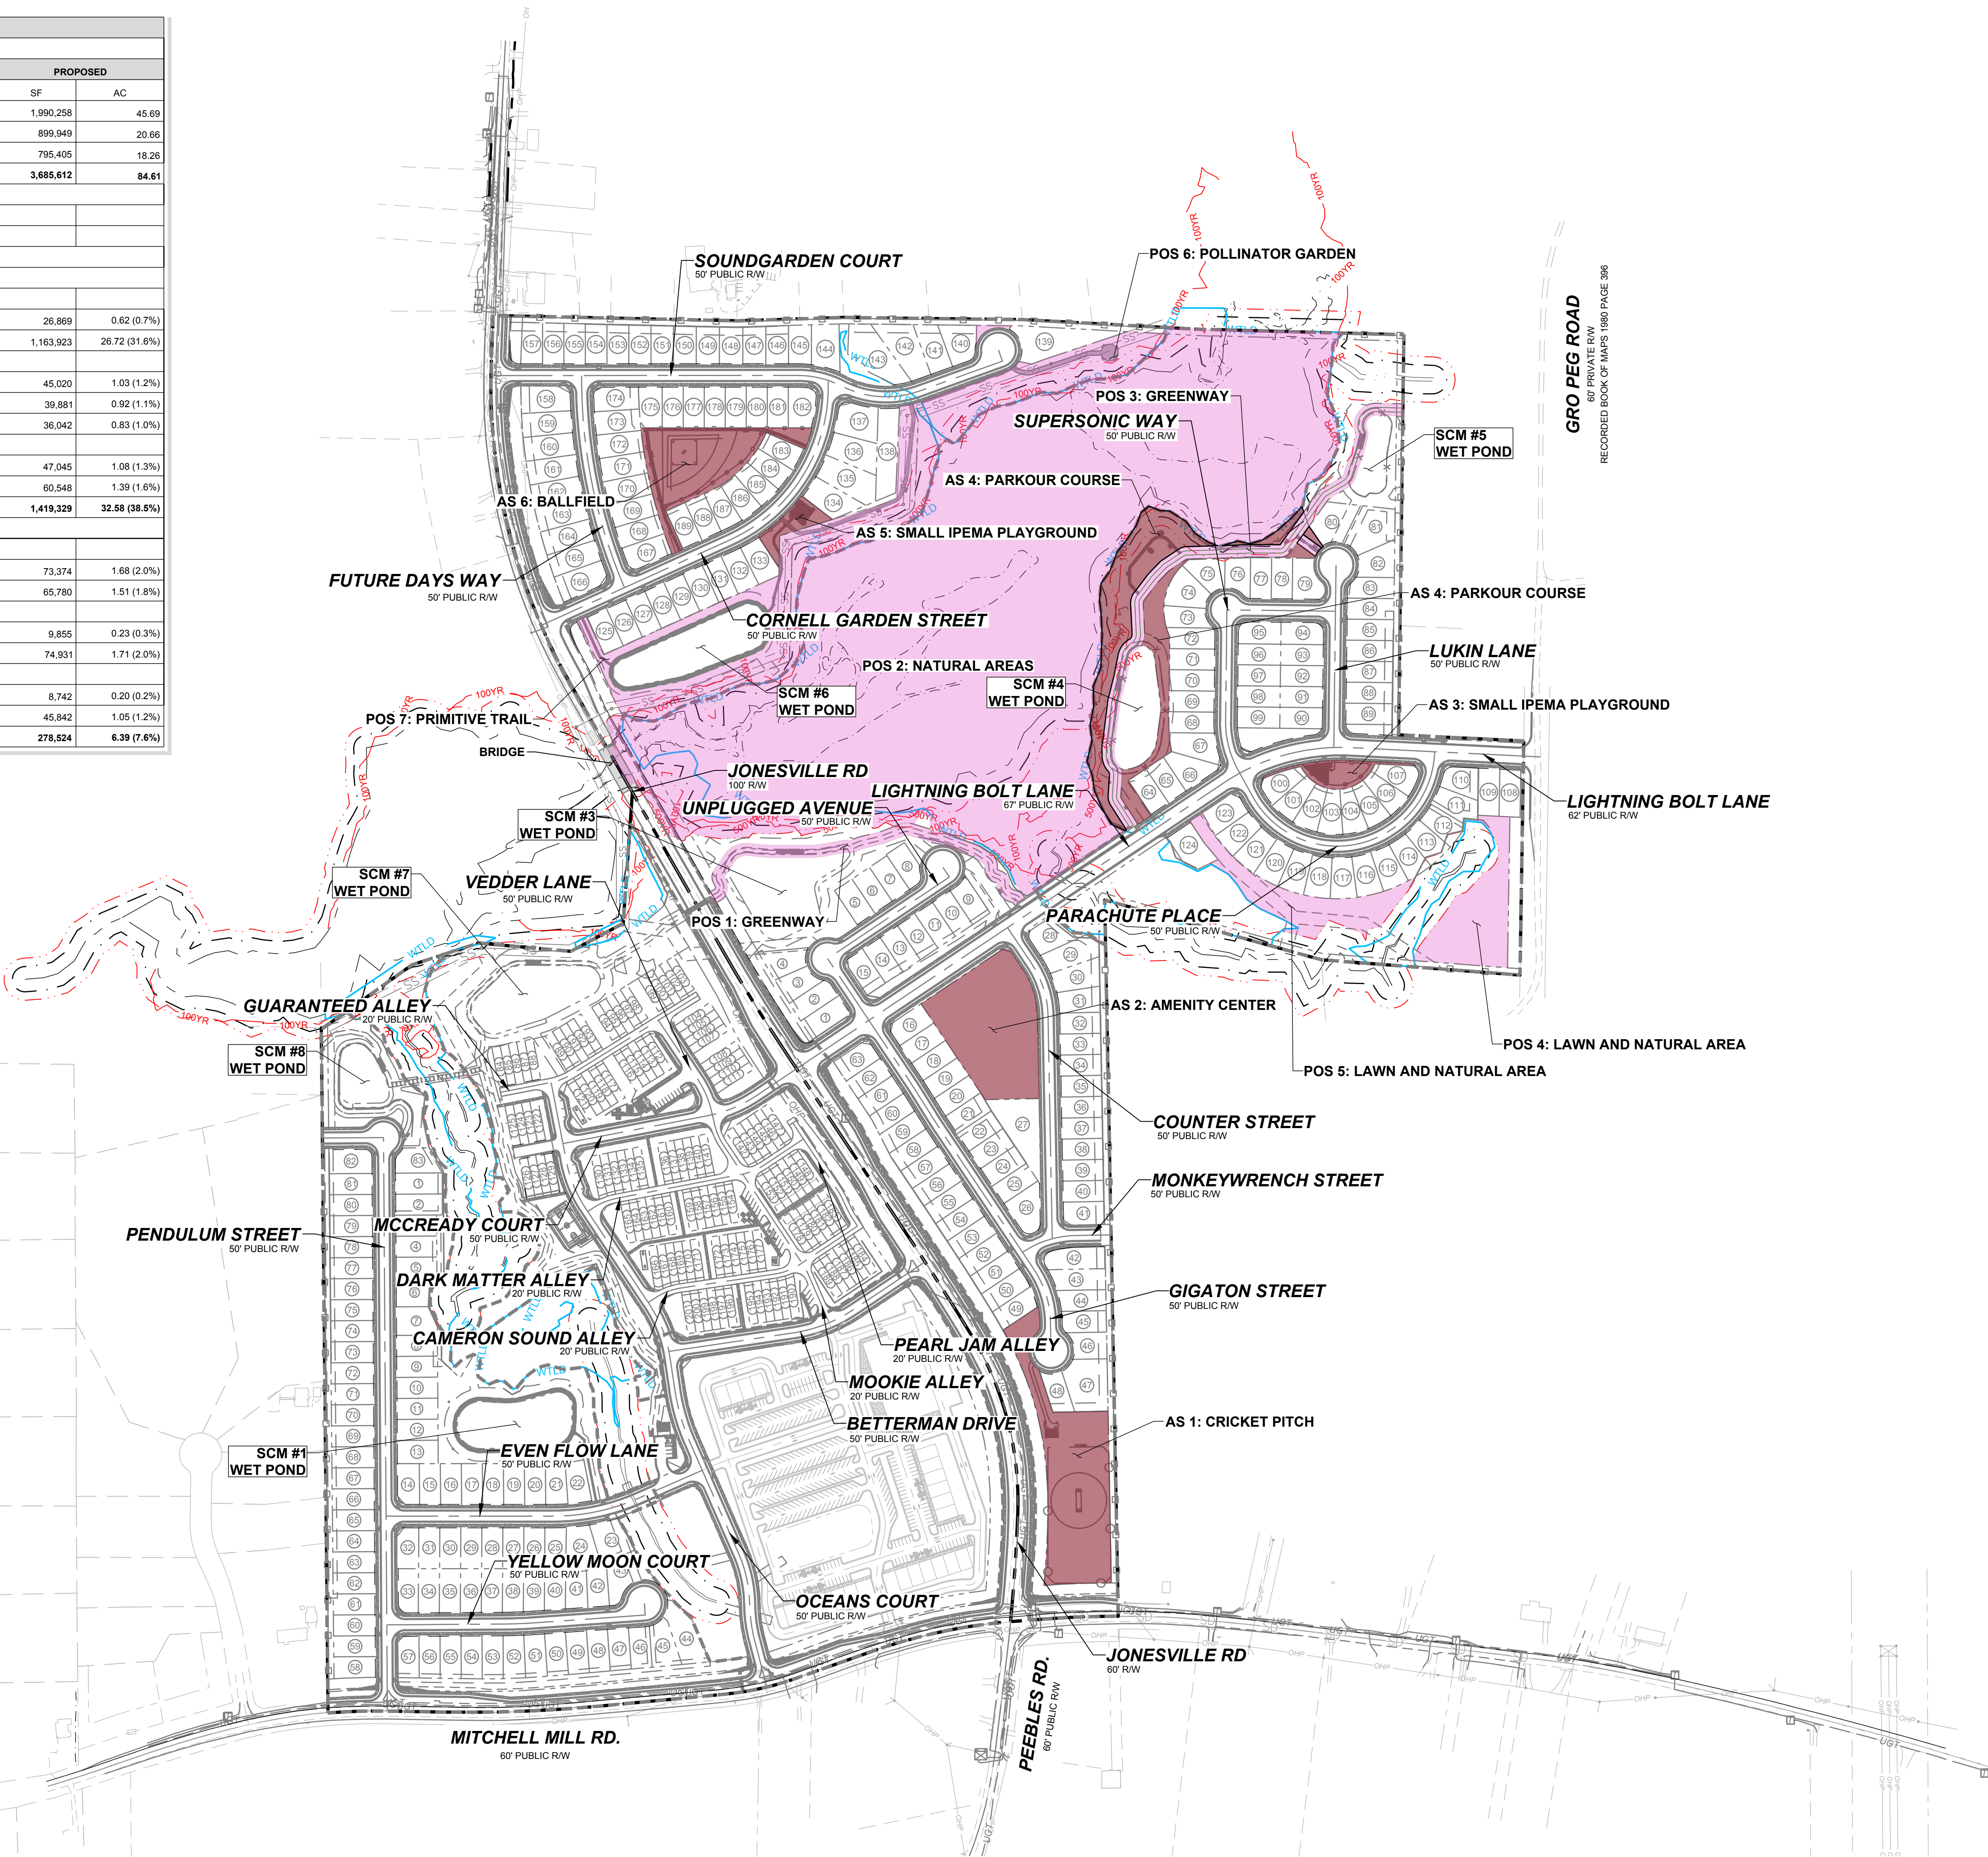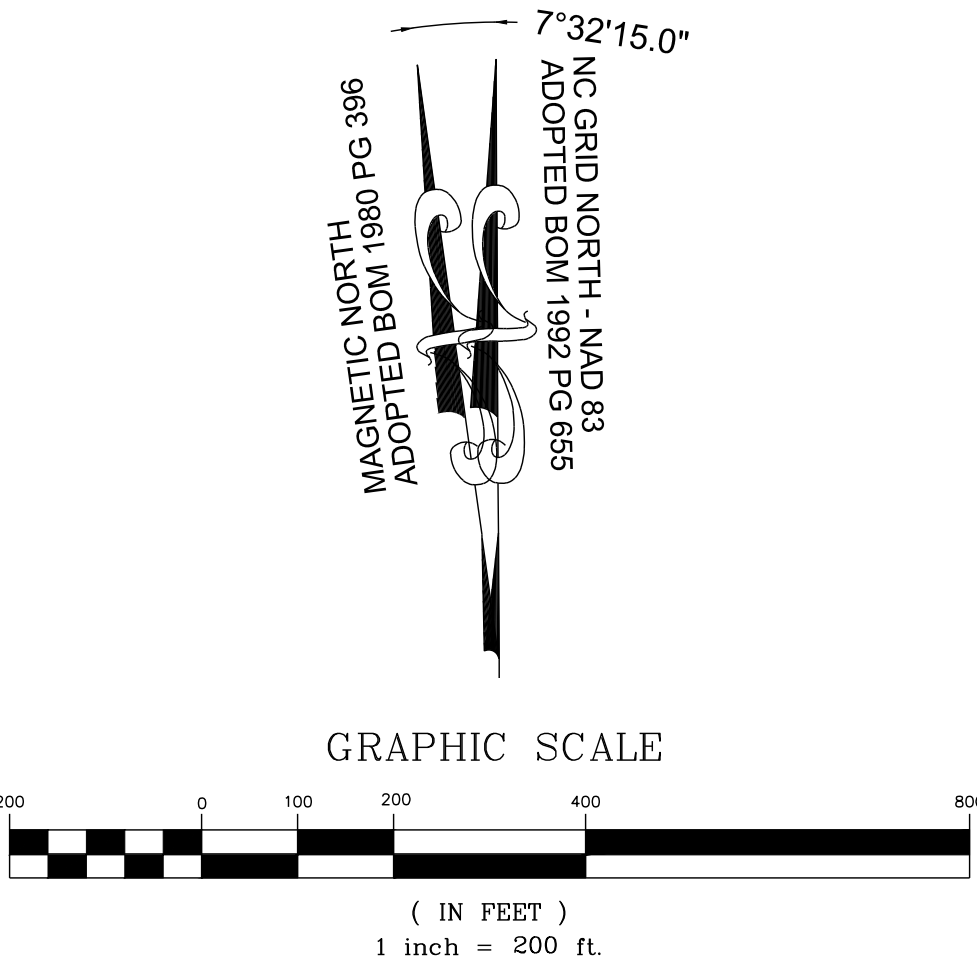

THIS PLANSET AND ANY ASSOCIATED DOCUMENTS ARE PRELIMINARY AND NOT AUTHORIZED FOR CONSTRUCTION UNTIL SIGNED, DATED, AND OFFICIALLY RELEASED FOR CONSTRUCTION BY THE ENGINEER OF RECORD.

STRONGROCK

ENGINEERING GROUP

STRONG ROCK ENGINEERING GROUP, PLLC | COMPANY LICENSE # P-2766
305 CHURCH AT NORTH HILLS STREET, SUITE 1110 RALEIGH, NC 27609 | INFORMATION@STRONGROCKGROUP.COM

CONSTRUCTION PROJECT
PSP-24-03

NOT FOR
CONSTRUCTION

SCALE
AS SHOWN

DESIGNED BY
SRG

DRAWN BY
SRG

CHECKED BY
SRG

RESERVE @ MITCHELL MILL
TOWN OF ROLESVILLE, WAKE COUNTY, NORTH CAROLINA

CONSTRUCTION PLANS

PASSIVE & ACTIVE OPEN SPACE
RM-CZ ZONE

DRAWING
SHEET

C-7.3

34 OF 227

CONSTRUCTION INFRASTRUCTURE DRAWINGS
CID-24-04

01

02

03

04

No.

REVISIONS

DATE

BY

SEAL:

08/04/2024
SRG

11/07/2024
SRG

02/07/2024
SRG

08/02/2025
SRG

01

02

03


04

No.

REVISIONS

DATE

BY

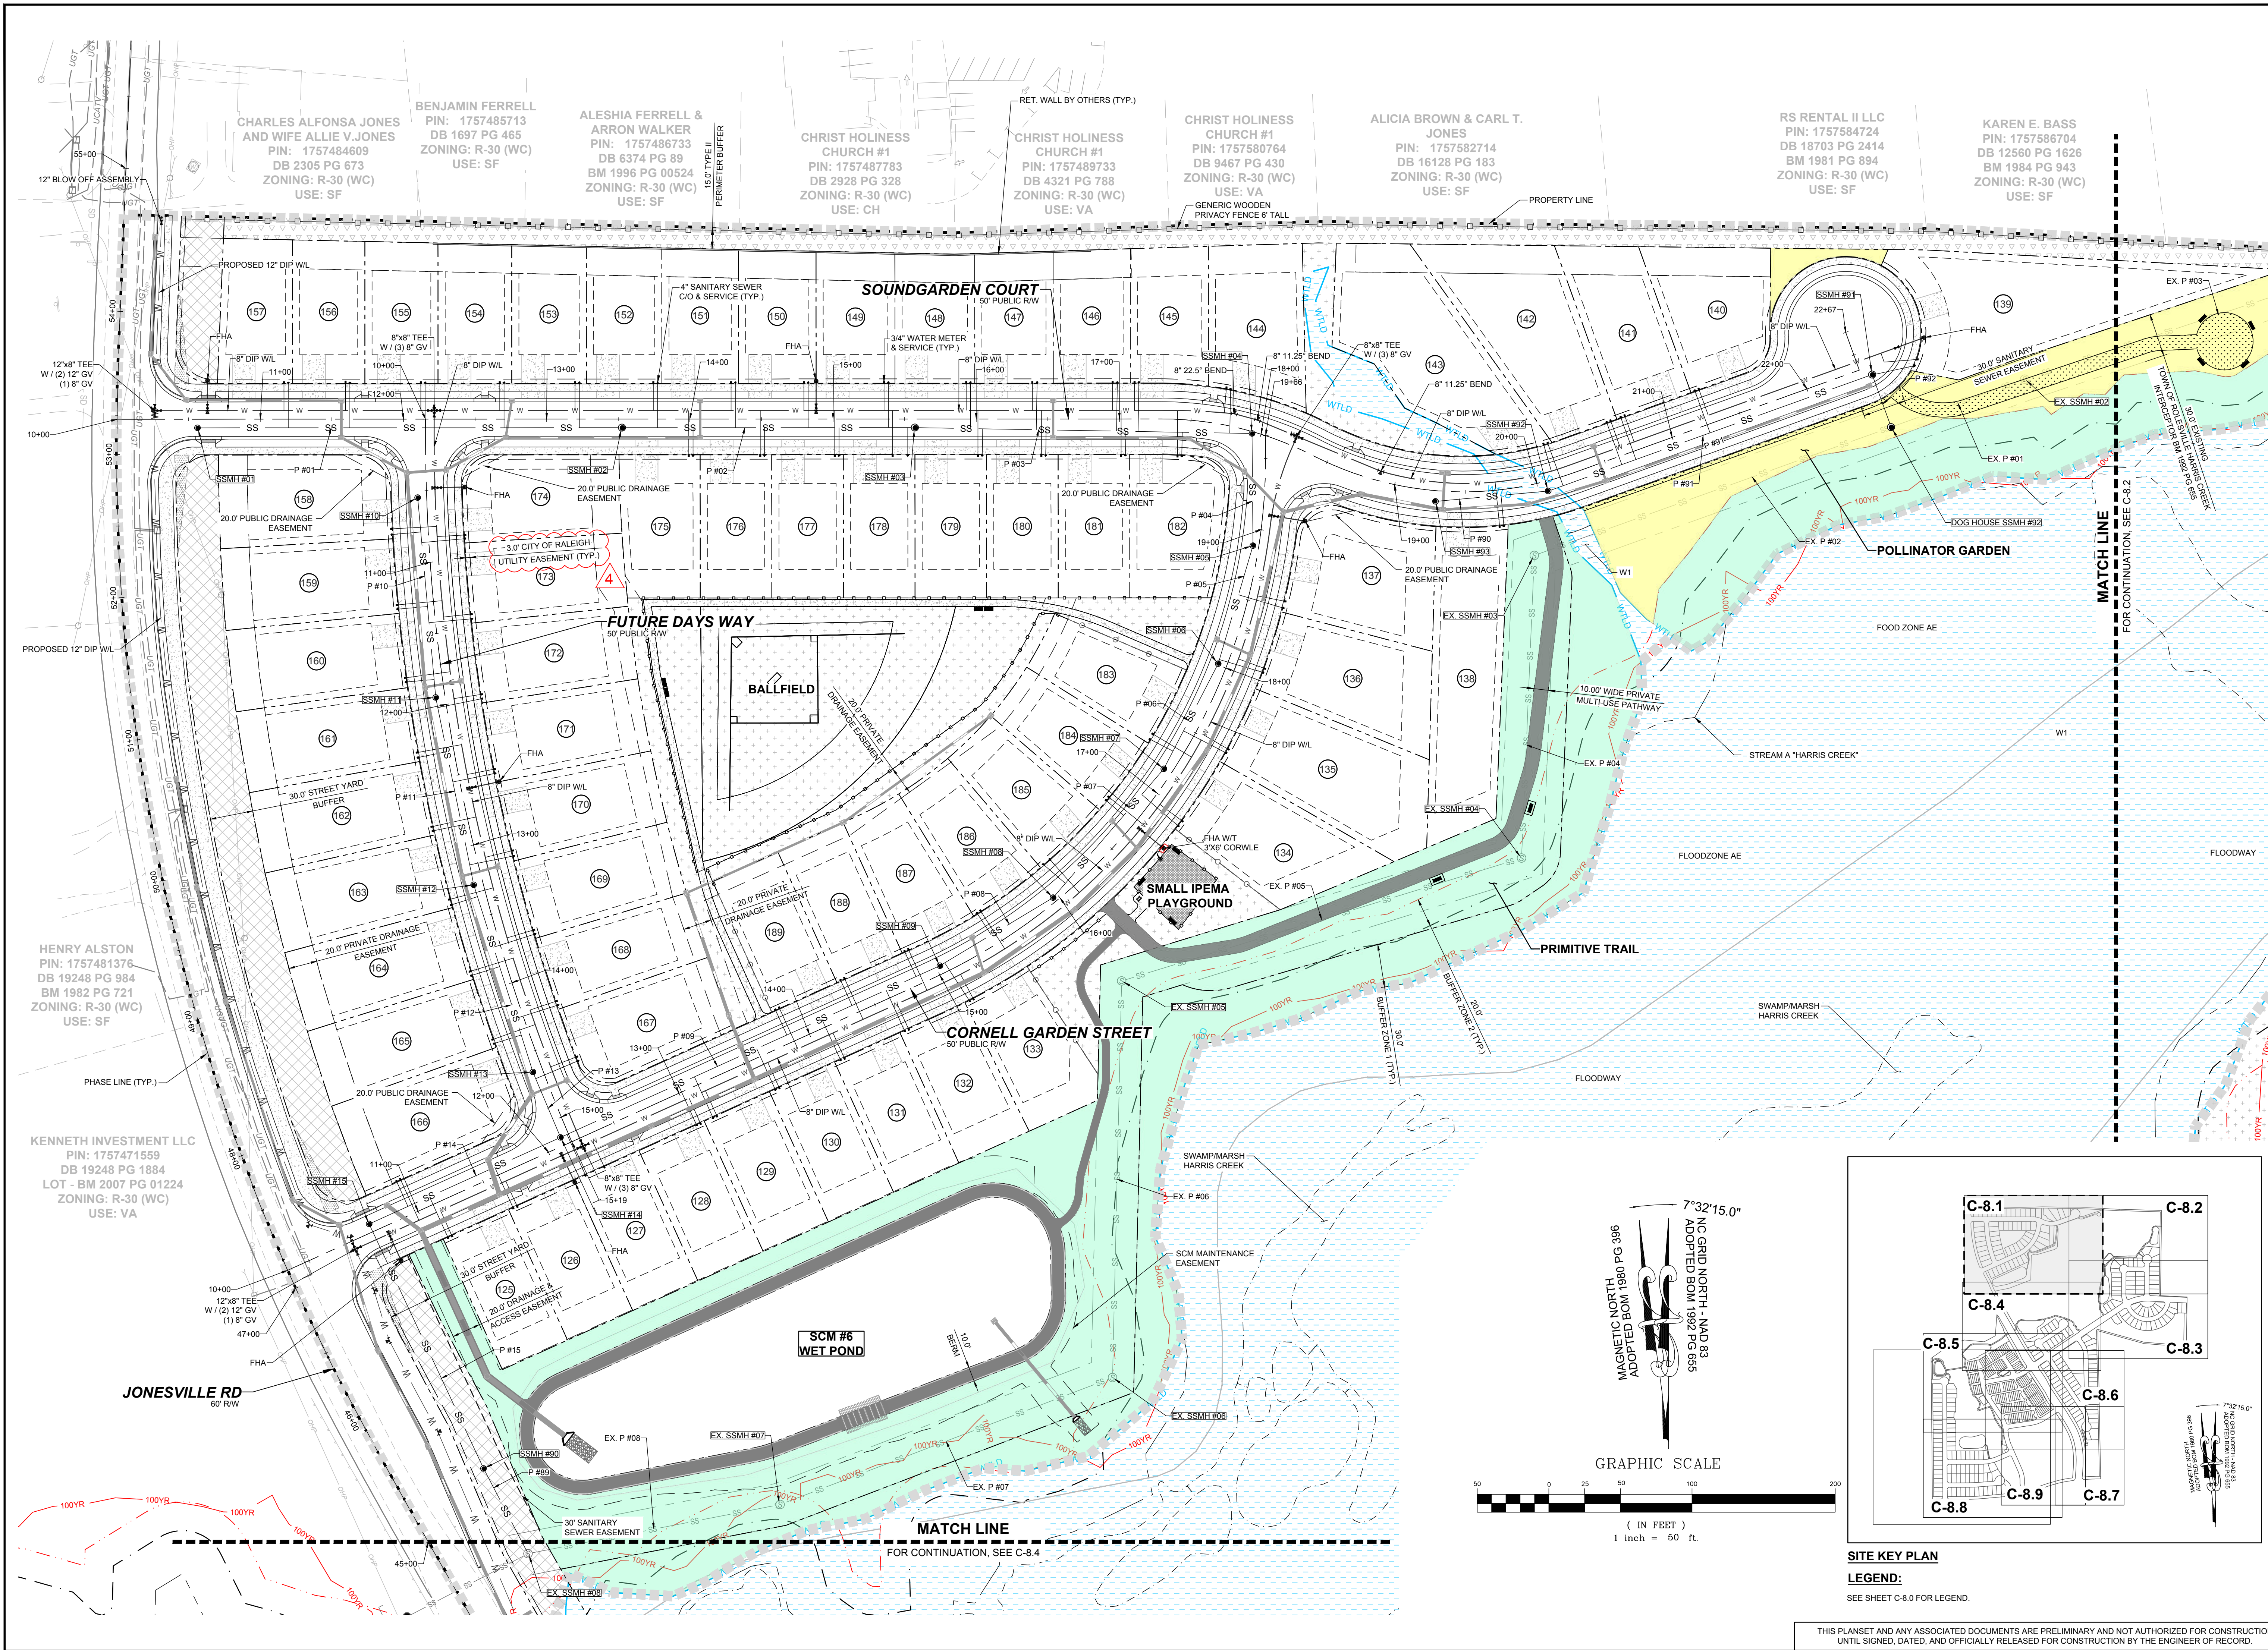

STRONGROCK

ENGINEERING GROUP

STRONG ROCK ENGINEERING GROUP, PLLC | COMPANY LICENSE # P-2166

305 CHURCH AT NORTH HILLS STREET, SUITE 1110 RALEIGH, NC 27609 | INFORMATION@STRONGROCKGROUP.COM

RESERVE @ MITCHELL MILL

TOWN OF ROLESVILLE, WAKE COUNTY, NORTH CAROLINA

CONSTRUCTION PLANS

PARTIAL UTILITY PLAN I

DRAWING SHEET

C-8.1

36 OF 227

CONSTRUCTION INFRASTRUCTURE DRAWINGS		SEAL:		REVISIONS		BY	
NO.	DATE	NO.	DATE	NO.	DATE	NO.	DATE
01	08/04/2024	01	08/04/2024				
02	11/07/2024	02	11/07/2024				
03	02/07/2024	03	02/07/2024				
04	08/02/2025	04	08/02/2025				

STRONG ROCK PROJECT P-21-03

NOT FOR CONSTRUCTION



SCALE AS SHOWN

DESIGNED BY SRG


DRAWN BY SRG

CHECKED BY SRG

THIS PLANSET AND ANY ASSOCIATED DOCUMENTS ARE PRELIMINARY AND NOT AUTHORIZED FOR CONSTRUCTION UNTIL SIGNED, DATED, AND OFFICIALLY RELEASED FOR CONSTRUCTION BY THE ENGINEER OF RECORD.

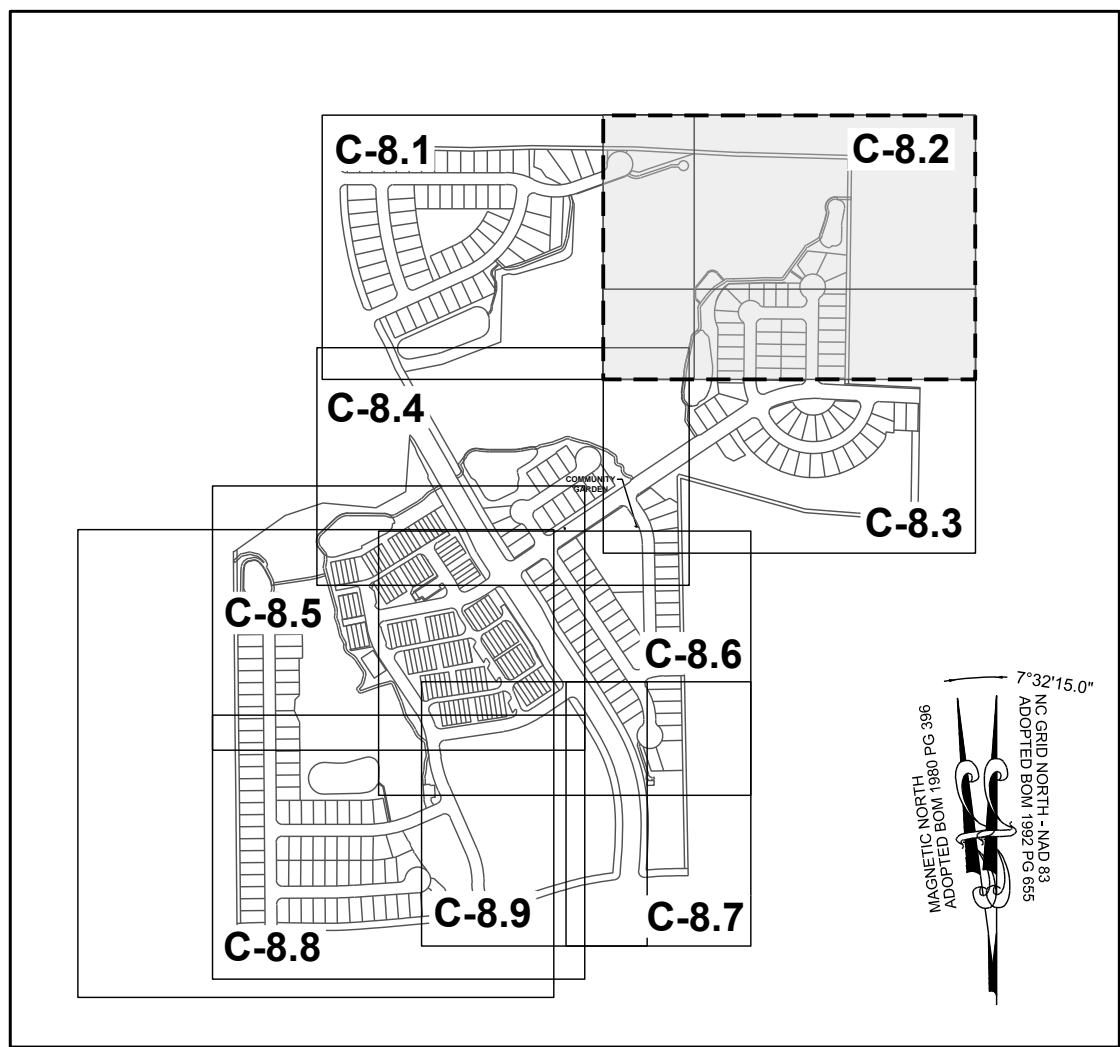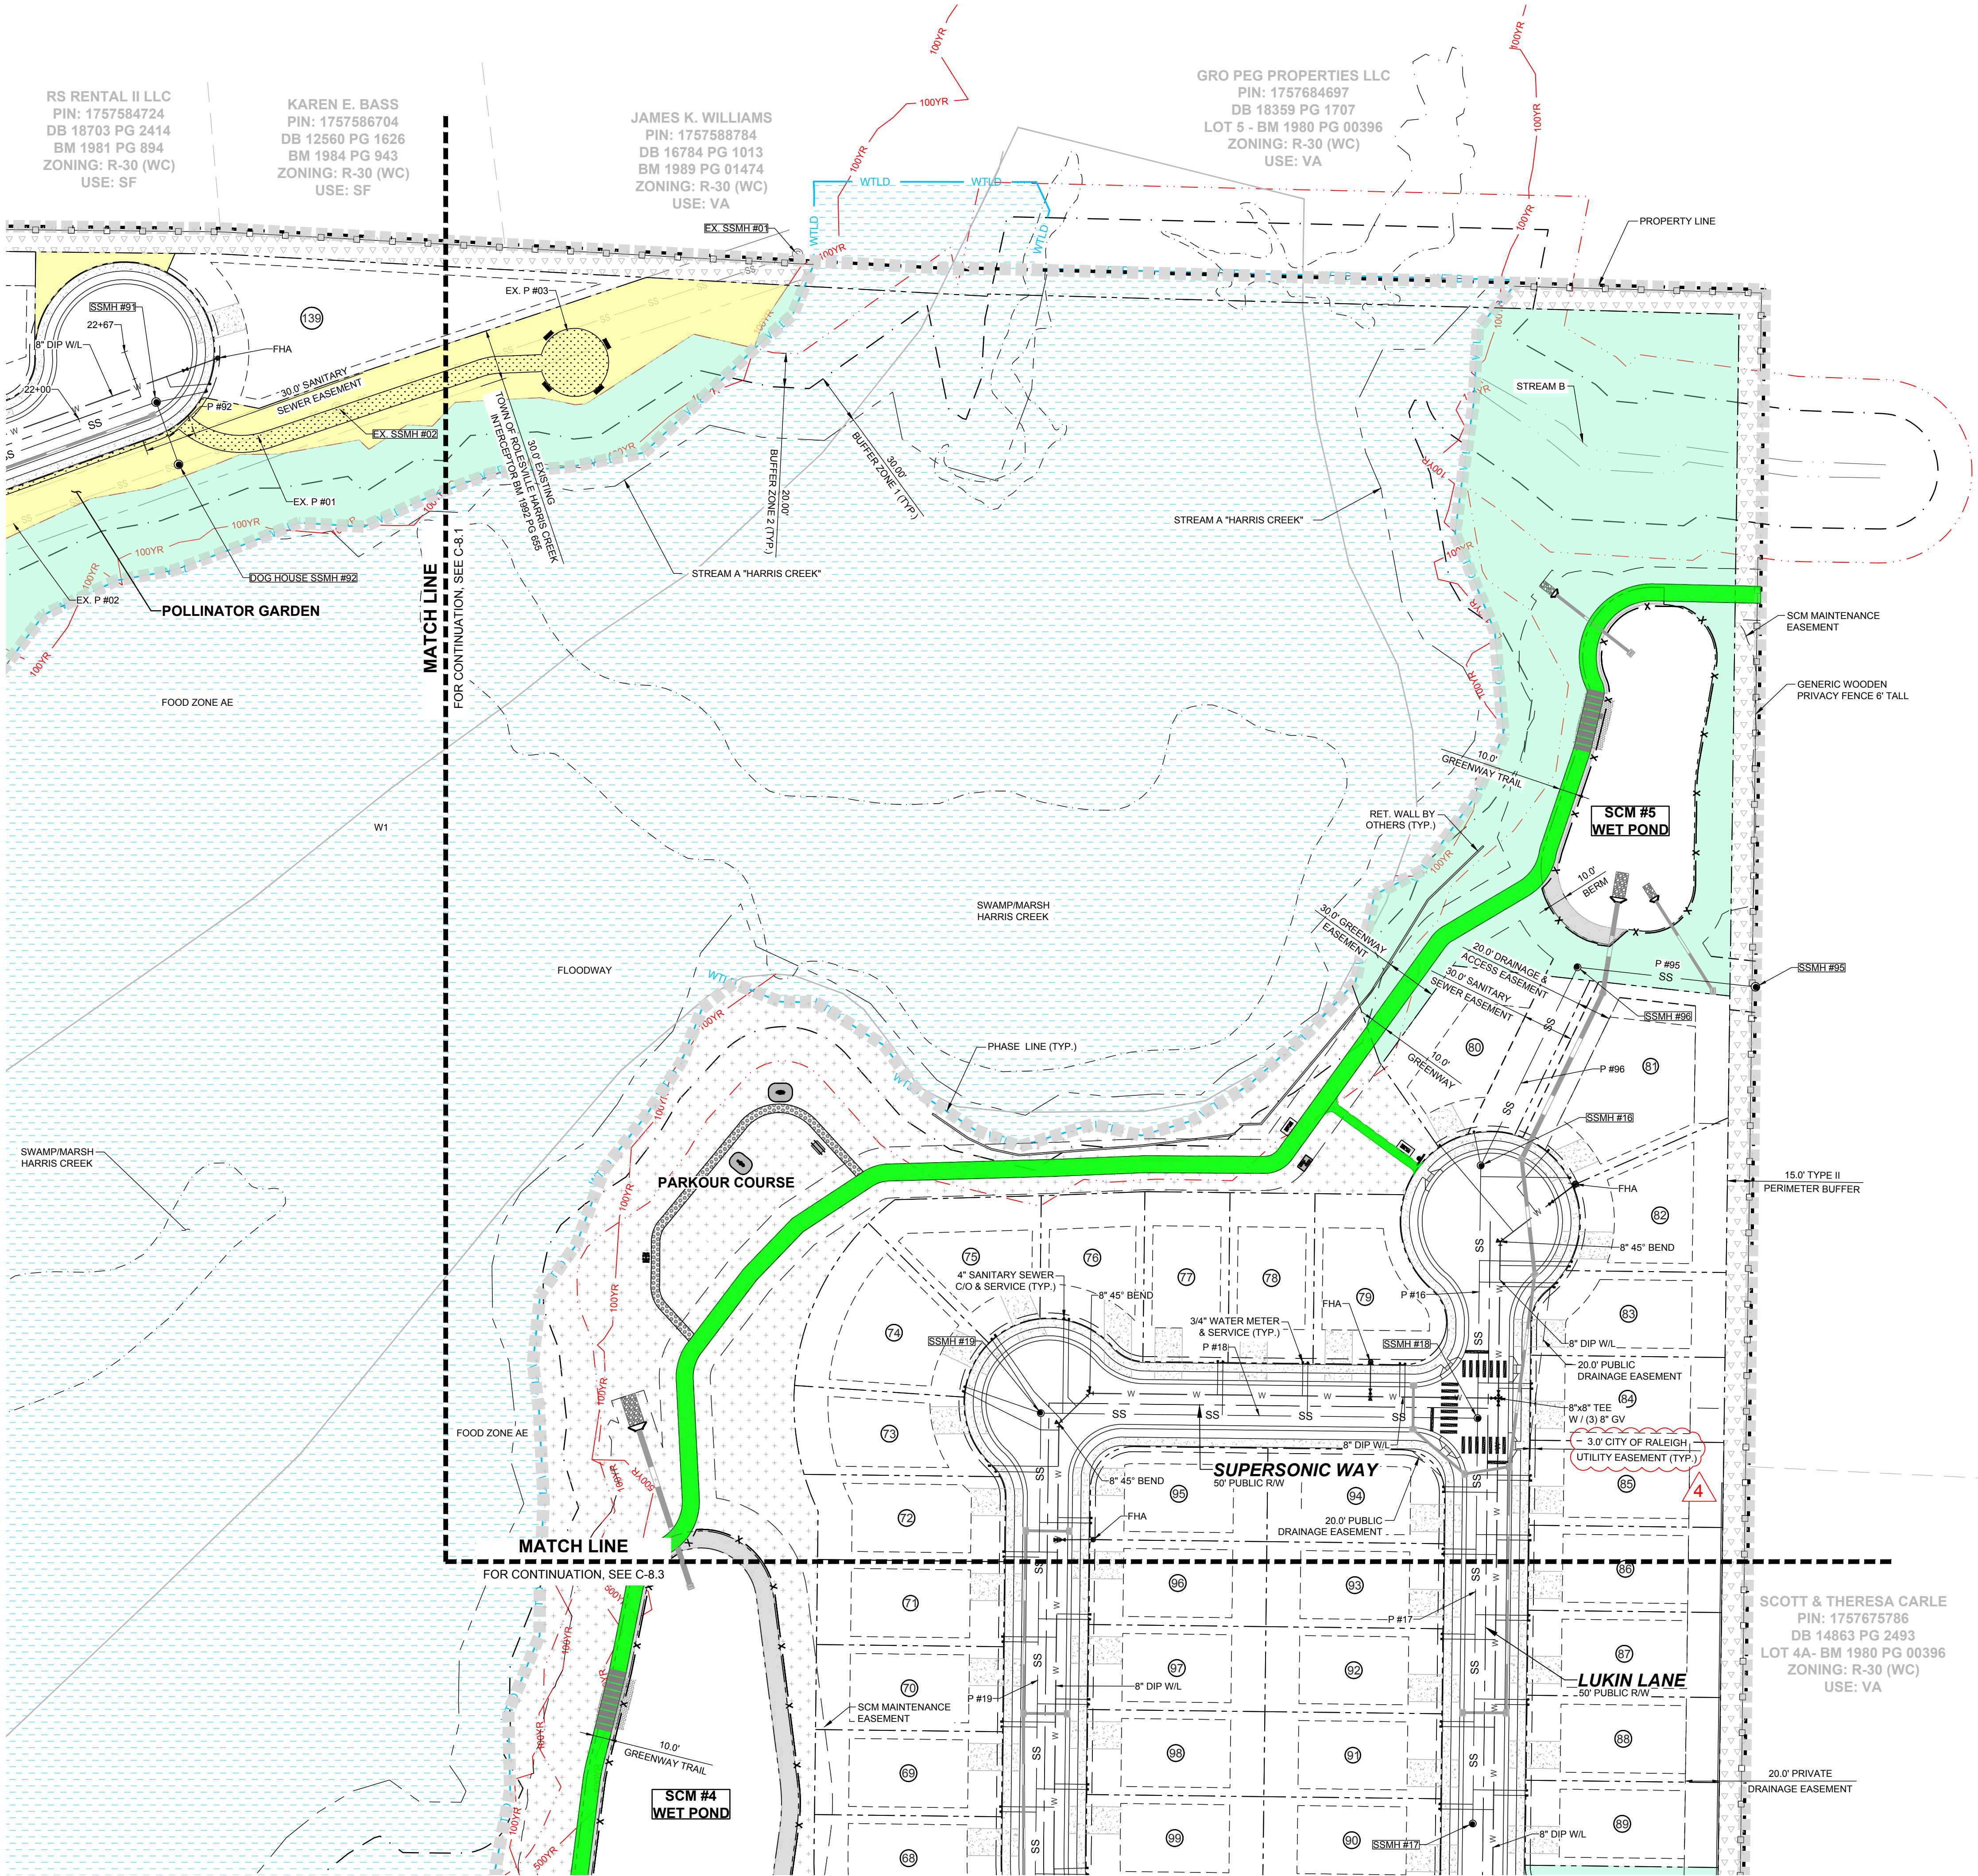

SITE KEY PLAN
LEGEND:
SEE SHEET C-8.0 FOR LEGEND.

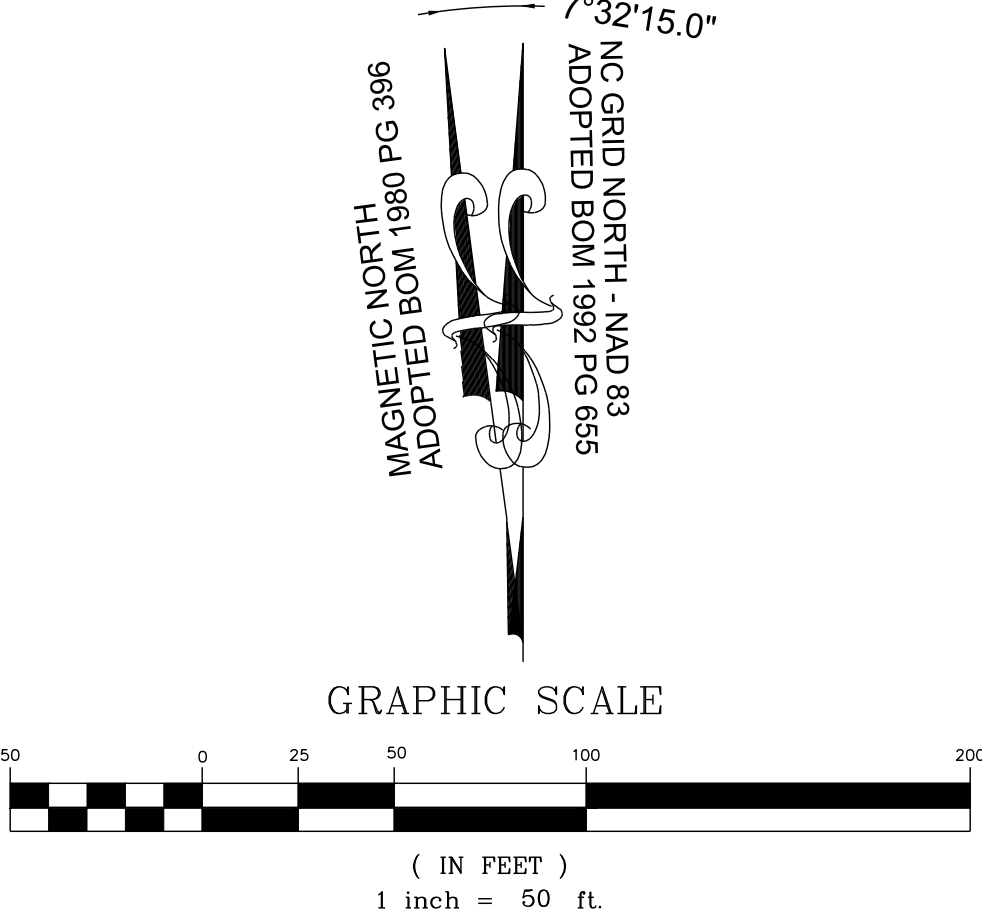

GRO PEG RD
60' PRIVATE R/W
RECORDED BOOK OF MAPS
1980 PAGE 396

CONSTRUCTION INFRASTRUCTURE DRAWINGS				REVISIONS		DATE	BY
NO.	DESCRIPTION	DATE	BY	NO.	DESCRIPTION	DATE	BY
01	CID-24-04	08/04/2024	SREG				
02	TOWN OF ROLESVILLE CID-24-04 V2	11/07/2024	SREG				
03	TOWN OF ROLESVILLE CID-24-04 V3	02/07/2024	SREG				
04	TOWN OF ROLESVILLE CID-24-04 V4	08/02/2025	SREG				

STRONGROCK

ENGINEERING GROUP

STRONG ROCK ENGINEERING GROUP, PLLC | COMPANY LICENSE # P-2166
305 CHURCH AT NORTH HILLS STREET, SUITE 1110 RALEIGH, NC 27609 | INFORMATION@STRONGROCKGROUP.COM


STRONG ROCK PROJECT PSP-24-03	NOT FOR CONSTRUCTION	SCALE AS SHOWN	SRG	SRG	SRG
DESIGNED BY	DRAWN BY	CHECKED BY			

RESERVE @ MITCHELL MILL
TOWN OF ROLESVILLE, WAKE COUNTY, NORTH CAROLINA
CONSTRUCTION PLANS
PARTIAL UTILITY PLAN II


DRAWING
SHEET
C-8.2

37 OF 227

THIS PLANSET AND ANY ASSOCIATED DOCUMENTS ARE PRELIMINARY AND NOT AUTHORIZED FOR CONSTRUCTION UNTIL SIGNED, DATED, AND OFFICIALLY RELEASED FOR CONSTRUCTION BY THE ENGINEER OF RECORD.

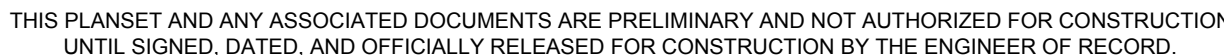

7°32'15.0
NC GRID NORTH + M4D 83
ADOPTED BOM 1992 PG 655

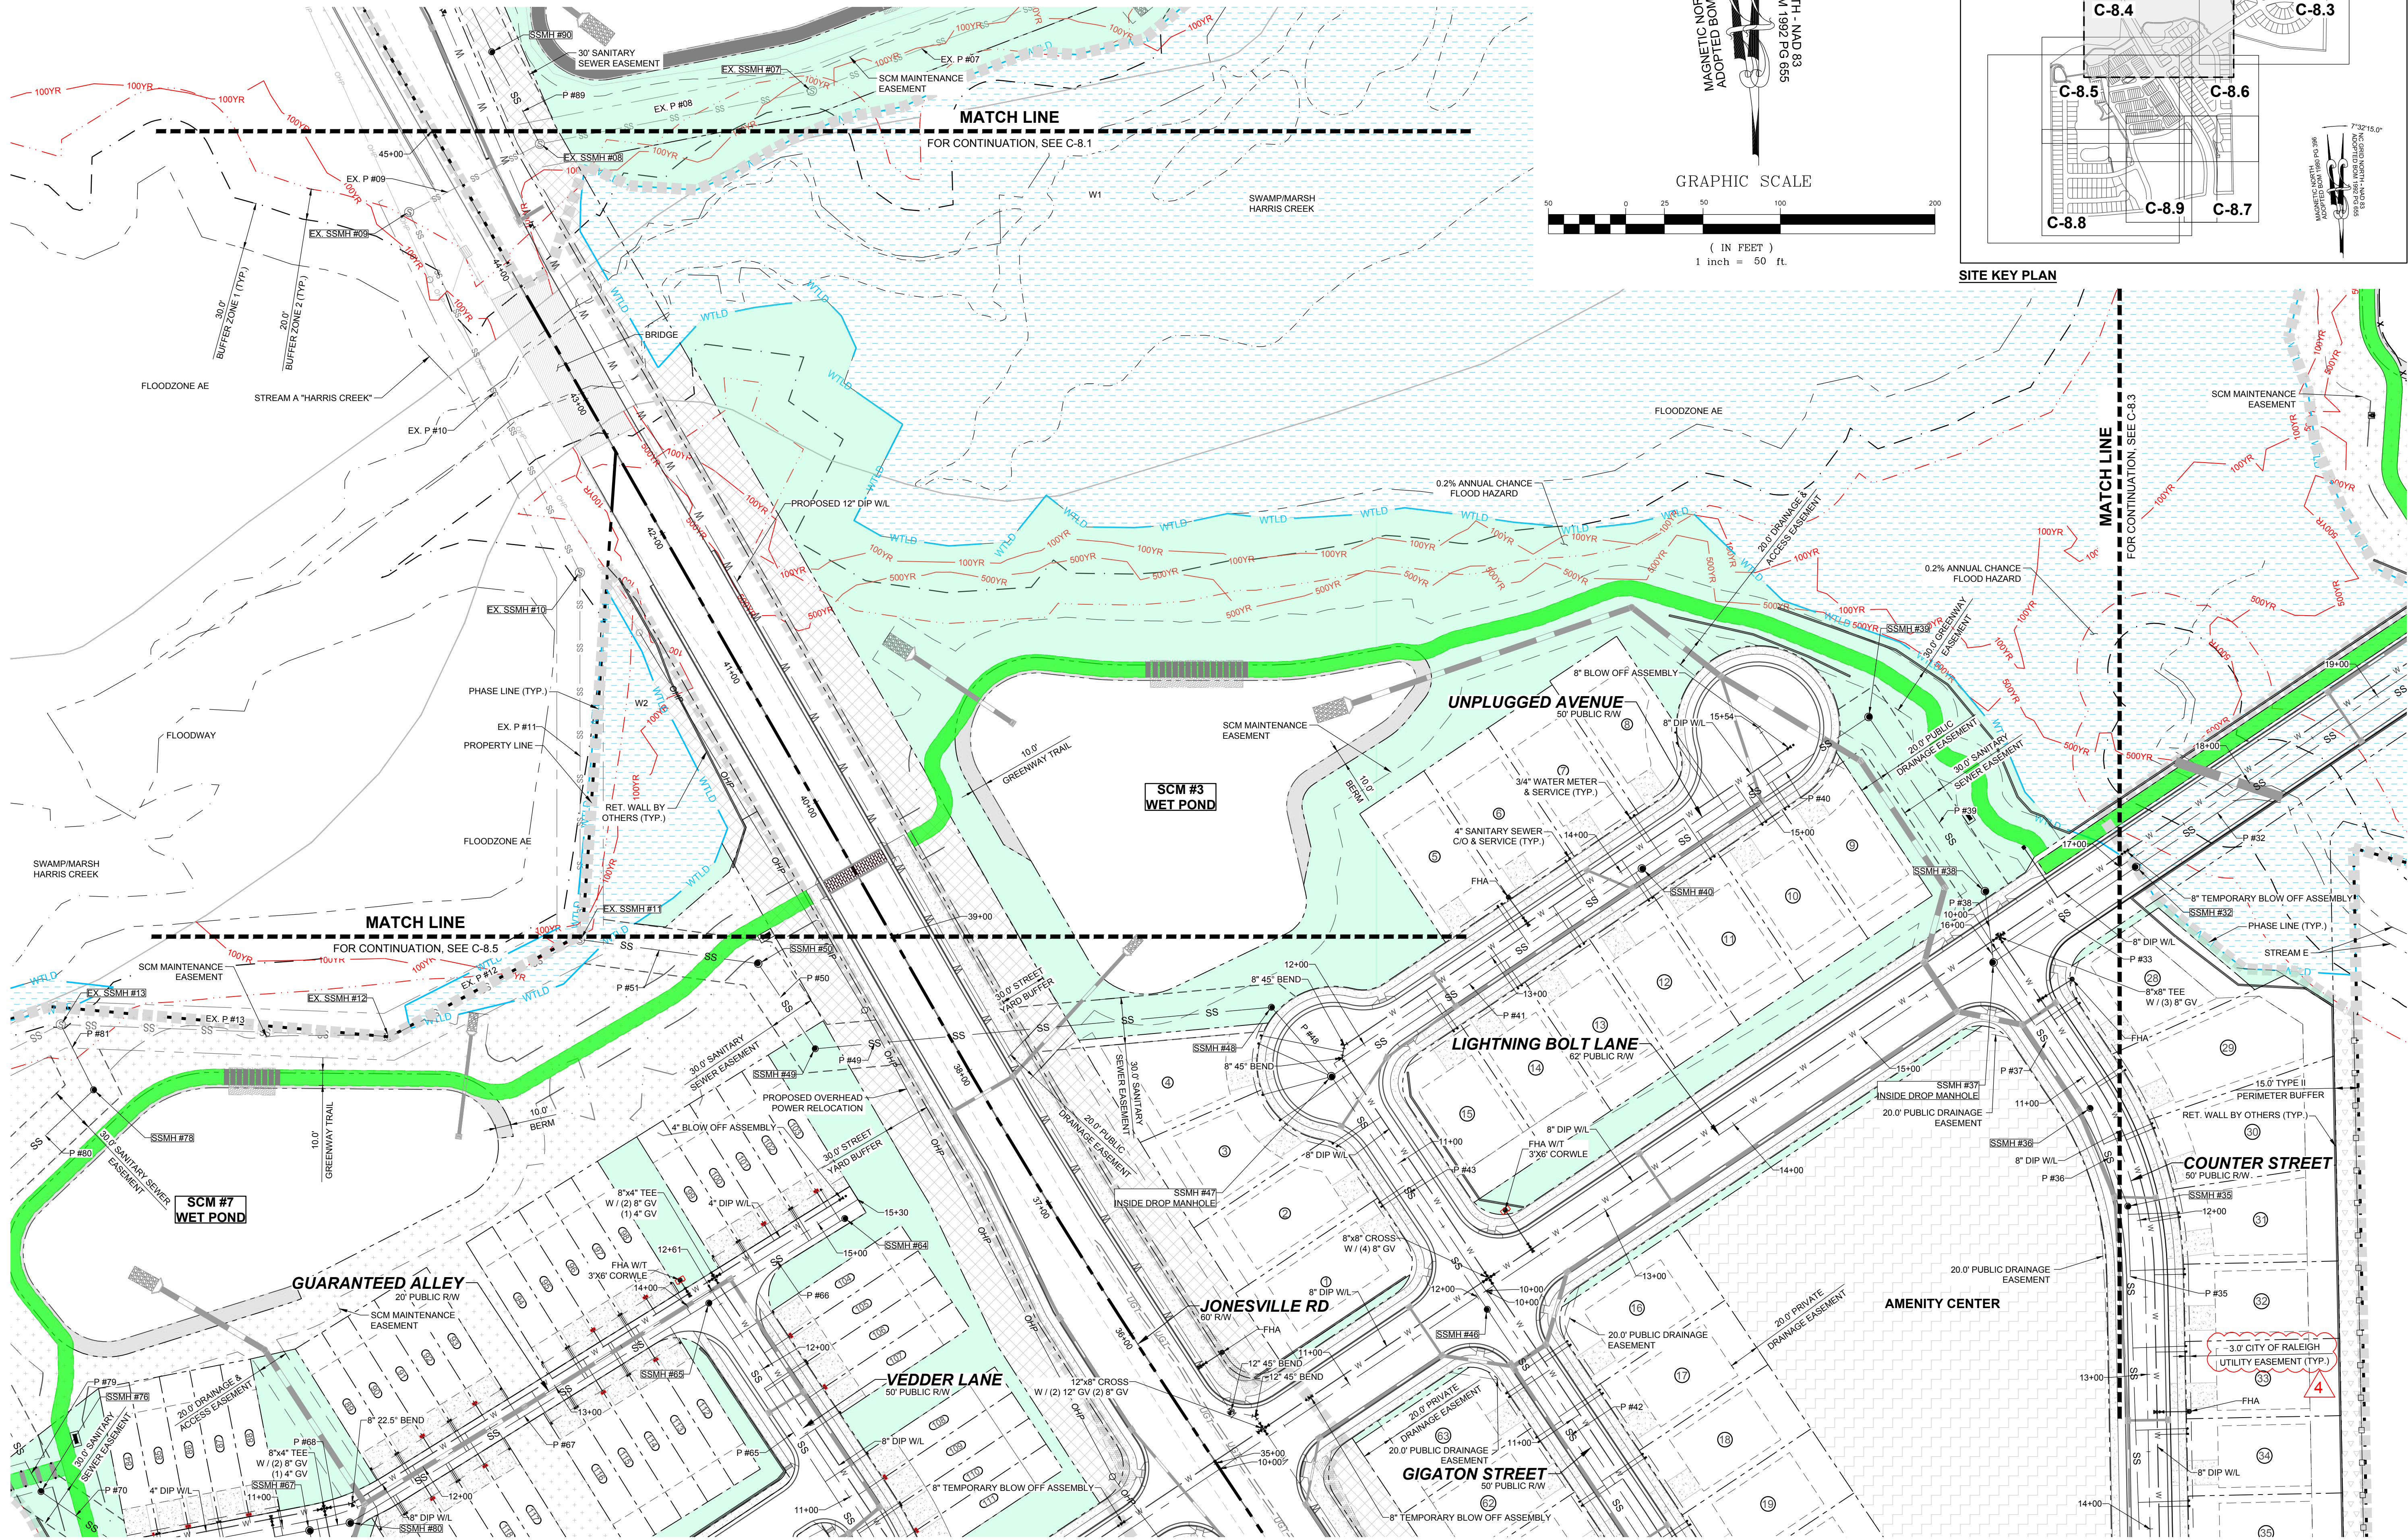

STRONGROCK
E N G I N E E R I N G G R O U P

STRONG ROCK ENGINEERING GROUP, PLLC | COMPANY LICENSE # P-2166
3005 CHURCH AT NORTH HILLS STREET, SUITE 1110 RALEIGH, NC 27609 | INFO@STRONGROCKGROUP.COM

**RESERVE @ MITCHELL MILL
TOWN OF ROLESVILLE, WAKE COUNTY, NORTH CAROLINA
CONSTRUCTION PLANS
PARTIAL UTILITY PLAN VI**

C-8.4


TOWNHOME NOTES:

STATES INTERNAL TOWNHOME DRIVEWAYS ARE PRIVATE EASEMENTS AS PER CITY OF RALEIGH PUBLIC UTILITIES DEPARTMENT

KENNETH INVESTMENT LLC
PIN: 1757368816
DB 19248 PG 1884
ZONING: R-30 (WC)
USE: VA

MEGAN KULAWIAK
PIN: 1757367367
DB 16226 PG 1133
LOT 6
BM 1990 PG 00387
ZONING: R-30 (WC)
USE: VA

LEGEND:
SEE SHEET C-8.0 FOR LEGEND.

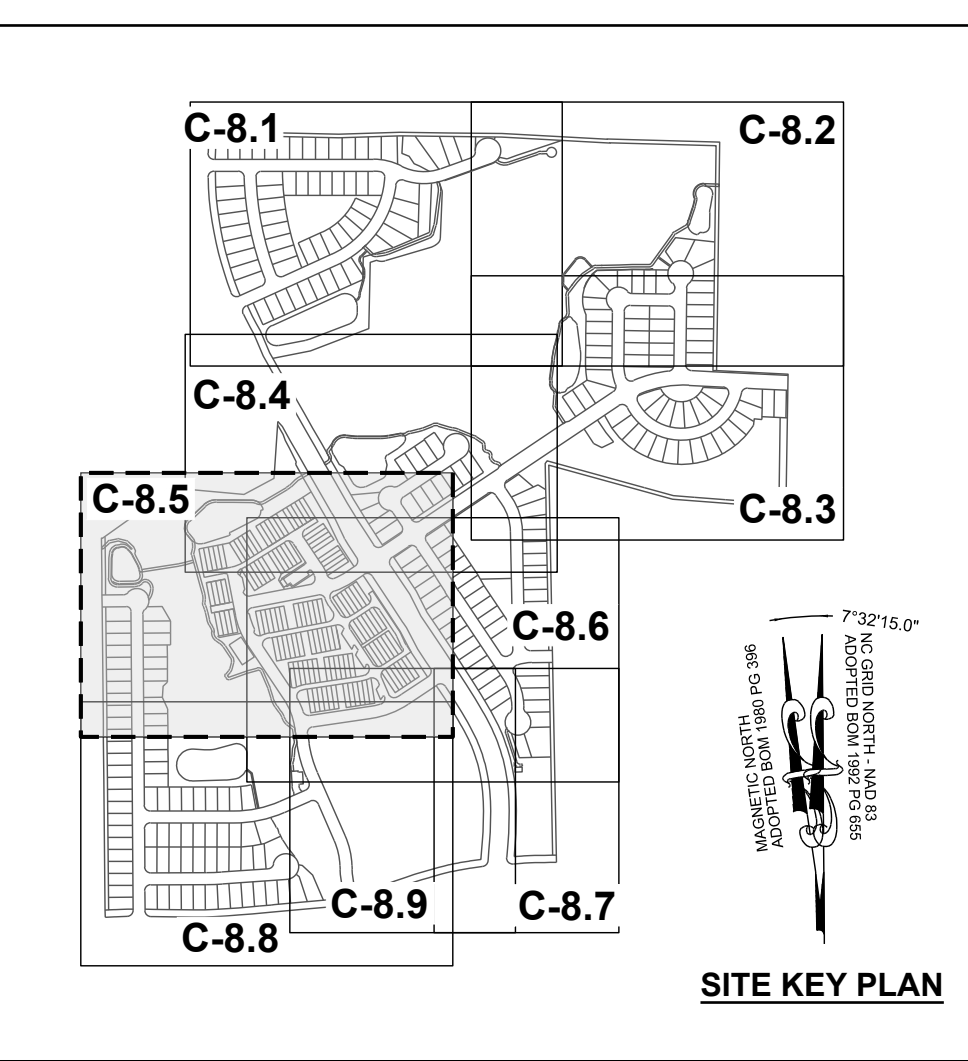

CONSTRUCTION INFRASTRUCTURE DRAWINGS		DATE
01	08/04/2024	SRG
02	11/07/2024	SRG
03	02/07/2024	SRG
04	08/02/2025	SRG
NO.		REVISIONS
		BY

STRONGROCK
ENGINEERING GROUP


STRONG ROCK ENGINEERING GROUP, PLLC | COMPANY LICENSE # P-2166
305 CHURCH AT NORTH HILLS STREET, SUITE 1110 RALEIGH, NC 27609 | INFORMATION@STRONGROCKGROUP.COM

STRONG ROCK PROJECT PSP-23-03	NOT FOR CONSTRUCTION	SCALE	AS SHOWN	DESIGNED BY SRG	DRAWN BY SRG	CHECKED BY SRG
----------------------------------	-------------------------	-------	----------	--------------------	-----------------	-------------------

RESERVE @ MITCHELL MILL
TOWN OF ROLESVILLE, WAKE COUNTY, NORTH CAROLINA
CONSTRUCTION PLANS
PARTIAL UTILITY PLAN V

DRAWING SHEET
C-8.5


THIS PLANSET AND ANY ASSOCIATED DOCUMENTS ARE PRELIMINARY AND NOT AUTHORIZED FOR CONSTRUCTION UNTIL SIGNED, DATED, AND OFFICIALLY RELEASED FOR CONSTRUCTION BY THE ENGINEER OF RECORD.

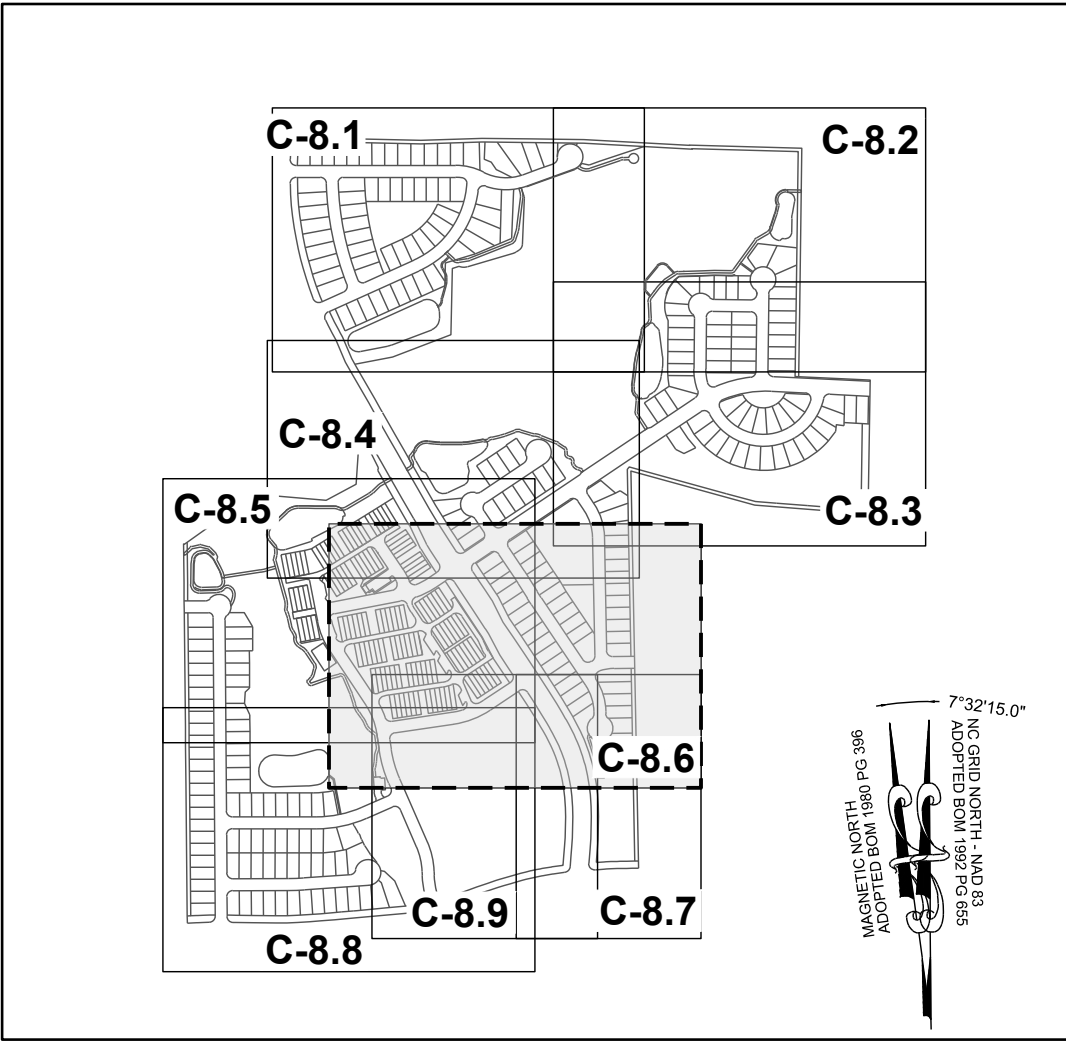

TOWNHOME NOTES:
STATES INTERNAL TOWNHOME DRIVEWAYS ARE PRIVATE EASEMENTS AS PER CITY OF RALEIGH PUBLIC UTILITIES DEPARTMENT

SITE KEY PLAN
LEGEND:
SEE SHEET C-8.0 FOR LEGEND.

MATCH LINE
FOR CONTINUATION, SEE C-8.7

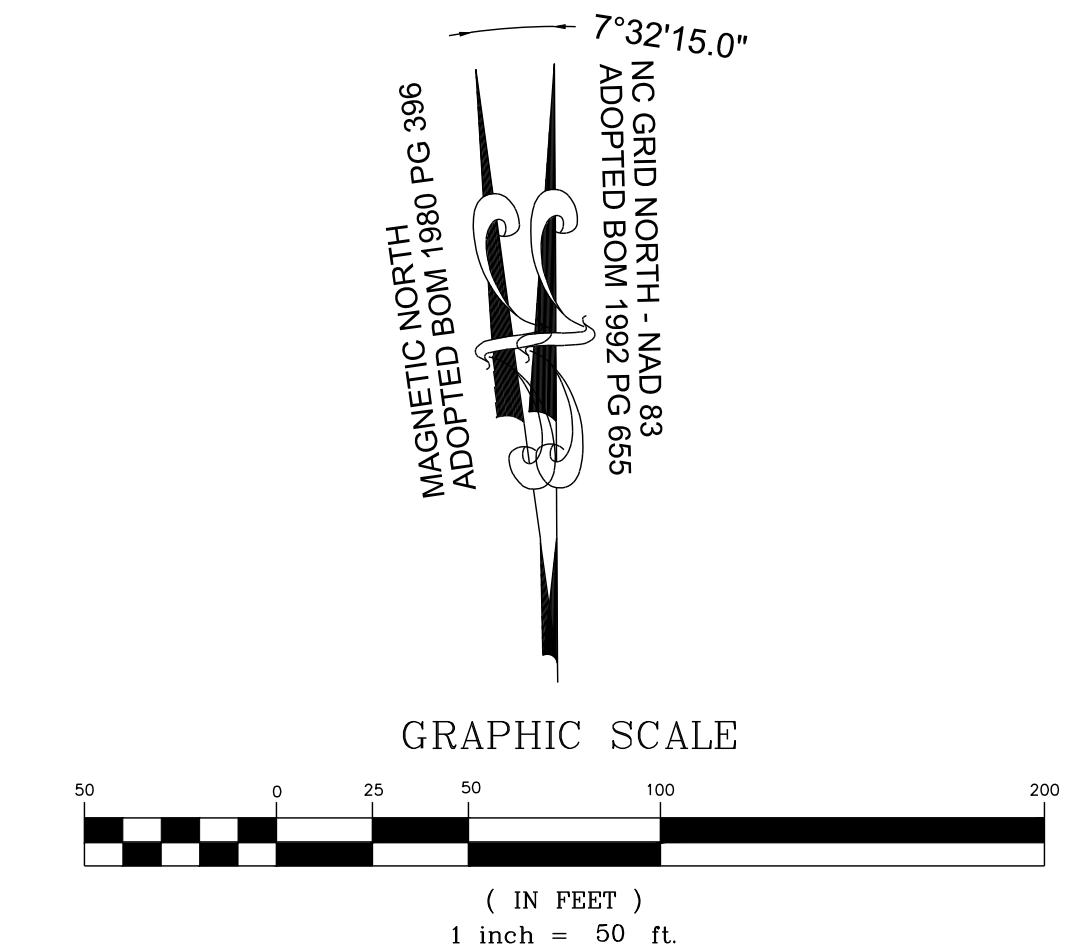

THIS PLANSET AND ANY ASSOCIATED DOCUMENTS ARE PRELIMINARY AND NOT AUTHORIZED FOR CONSTRUCTION UNTIL SIGNED, DATED, AND OFFICIALLY RELEASED FOR CONSTRUCTION BY THE ENGINEER OF RECORD.

SEAL:

01

02

03

04

No.

DATE

CONSTRUCTION INFRASTRUCTURE DRAWINGS

CID-24-04

TOWN OF ROLESVILLE CID-24-04 V2

TOWN OF ROLESVILLE CID-24-04 V3

TOWN OF ROLESVILLE CID-24-04 V4

08/04/2024

11/01/2024

02/01/2024

08/02/2025

SREG

SREG

SREG

SREG

RESERVE @ MITCHELL MILL

TOWN OF ROLESVILLE, WAKE COUNTY, NORTH CAROLINA

CONSTRUCTION PLANS

PARTIAL UTILITY PLAN VI

DRAWING SHEET

C-8.6

41 OF 227

STRONGROCK

ENGINEERING GROUP

STRONG ROCK ENGINEERING GROUP, PLLC | COMPANY LICENSE # P-2166

305 CHURCH AT NORTH HILLS STREET, SUITE 1110 RALEIGH, NC 27609 | INFORMATION@STRONGROCKGROUP.COM

STRONG ROCK PROJECT

NOT FOR CONSTRUCTION

SCALE

DESIGNED BY

DRAWN BY



CHECKED BY

SRG

SRG


SRG

SEE SHEET C-8.0 FOR LEGEND.

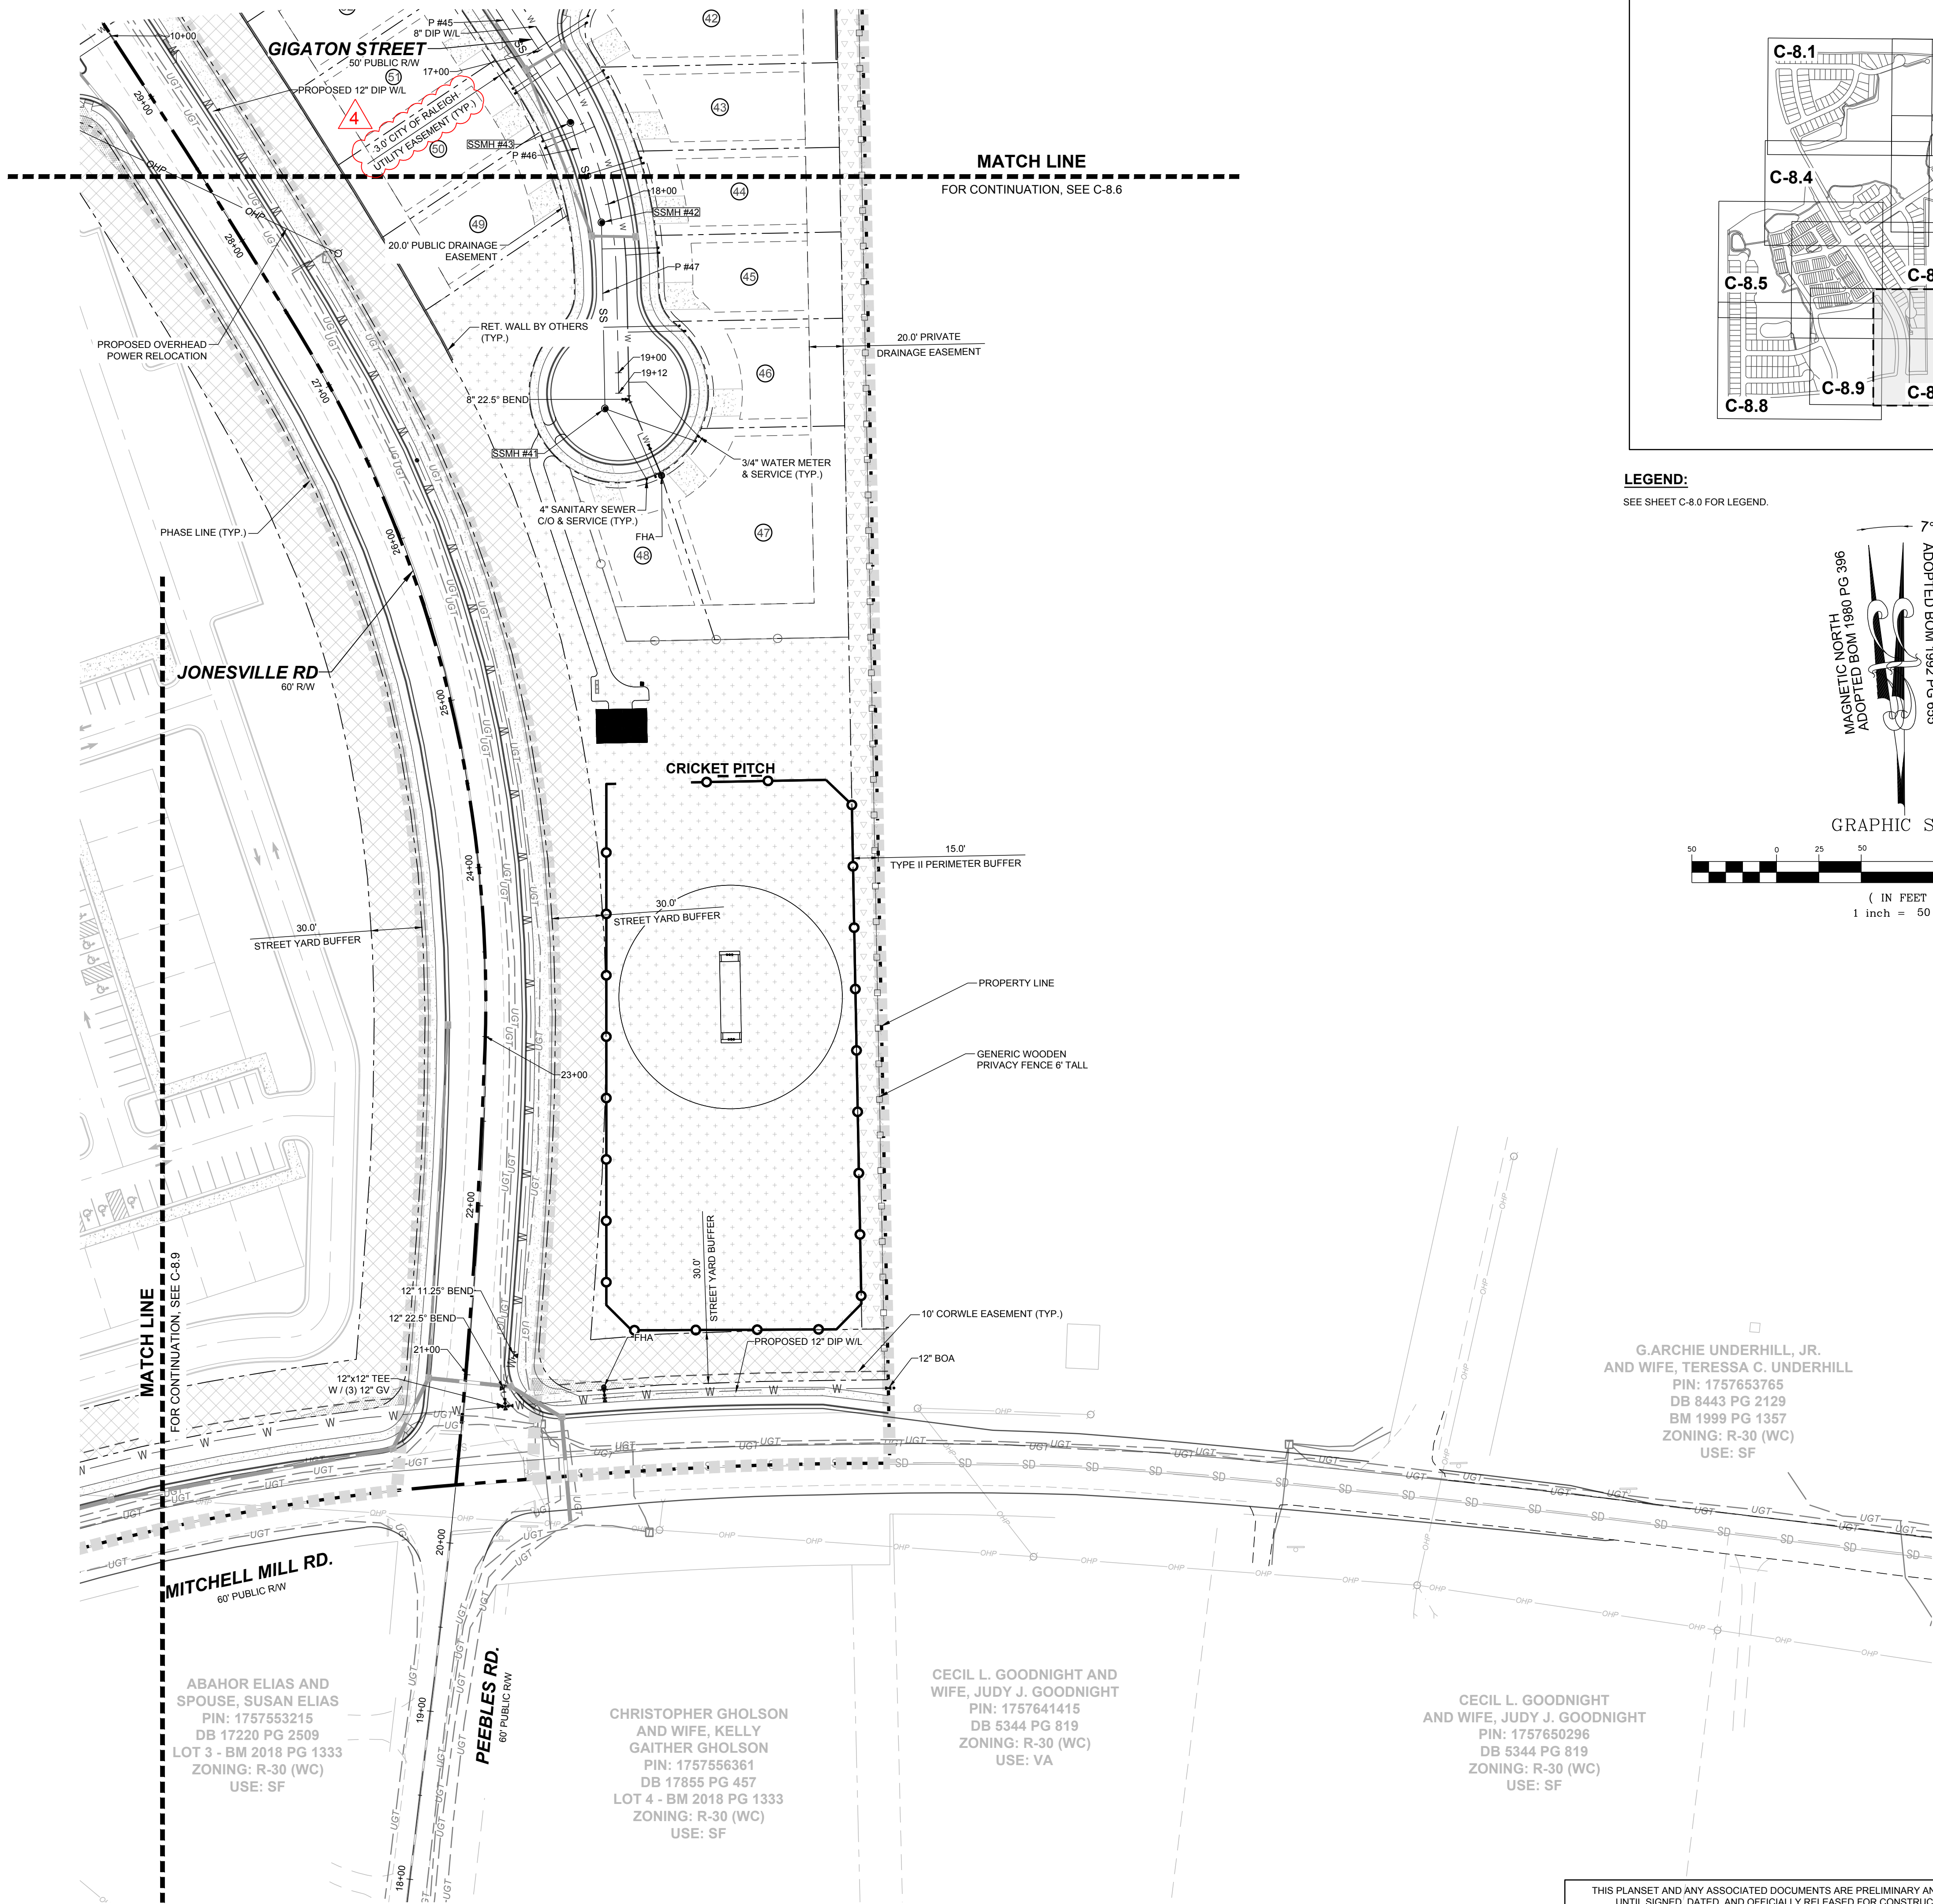
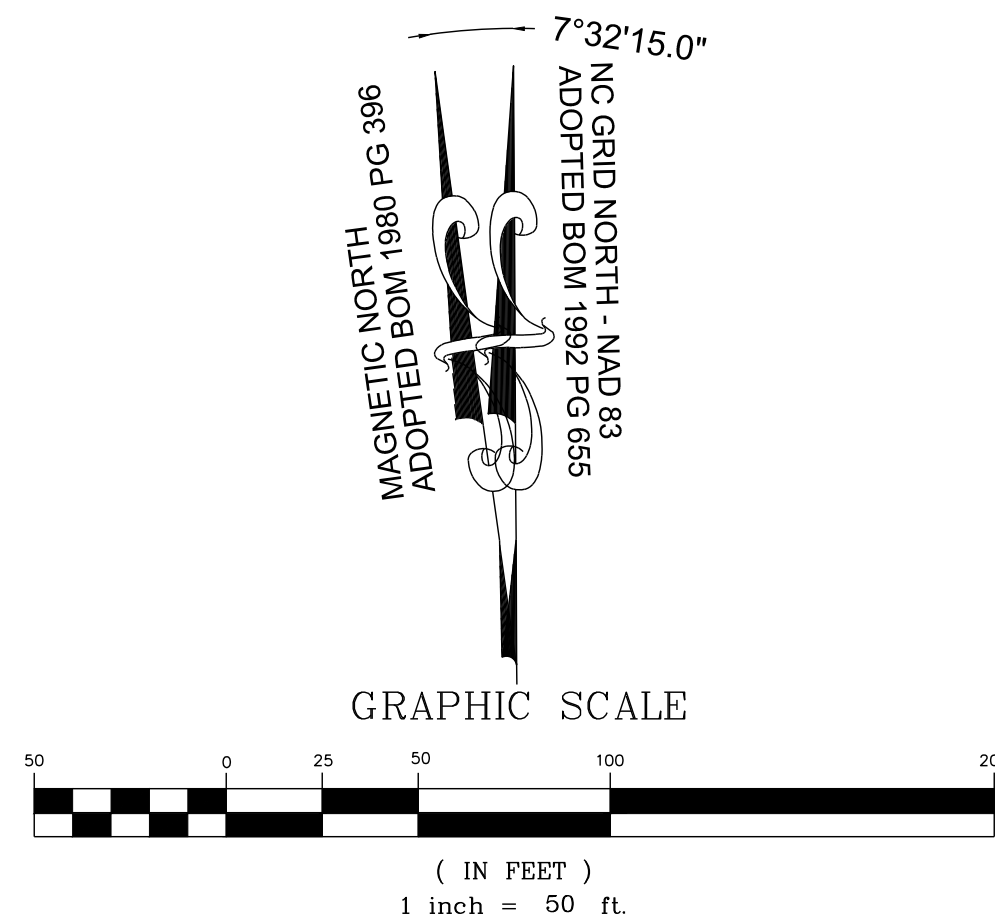


THIS PLANSET AND ANY ASSOCIATED DOCUMENTS ARE PRELIMINARY AND NOT AUTHORIZED FOR CONSTRUCTION UNTIL SIGNED, DATED, AND OFFICIALLY RELEASED FOR CONSTRUCTION BY THE ENGINEER OF RECORD.

42 OF 227	C-8.7	DRAWING SHEET	RESERVE @ MITCHELL MILL TOWN OF ROLESVILLE, WAKE COUNTY, NORTH CAROLINA CONSTRUCTION PLANS PARTIAL UTILITY PLAN VII	STRONG ROCK ENGINEERING GROUP  STRONGROCK ENGINEERING GROUP STRONG ROCK ENGINEERING GROUP, PLLC COMPANY LICENSE # P-2166 305 CHURCH AT NORTH HILLS STREET, SUITE 110 RALEIGH, NC 27609 INFORMATION@STRONGROCKGROUP.COM	SEAL: 01 CONSTRUCTION INFRASTRUCTURE DRAWINGS CIP-24-04 SRGG 06/04/2024 02 TOWN OF ROLESVILLE CIP-24-04 V2 SRGG 11/01/2024 03 TOWN OF ROLESVILLE CIP-24-04 V3 SRGG 03/01/2024 04 TOWN OF ROLESVILLE CIP-24-04 V4 SRGG 08/02/2025	No. DATE BY REVISIONS
------------------	--------------	------------------	--	---	---	--------------------------------

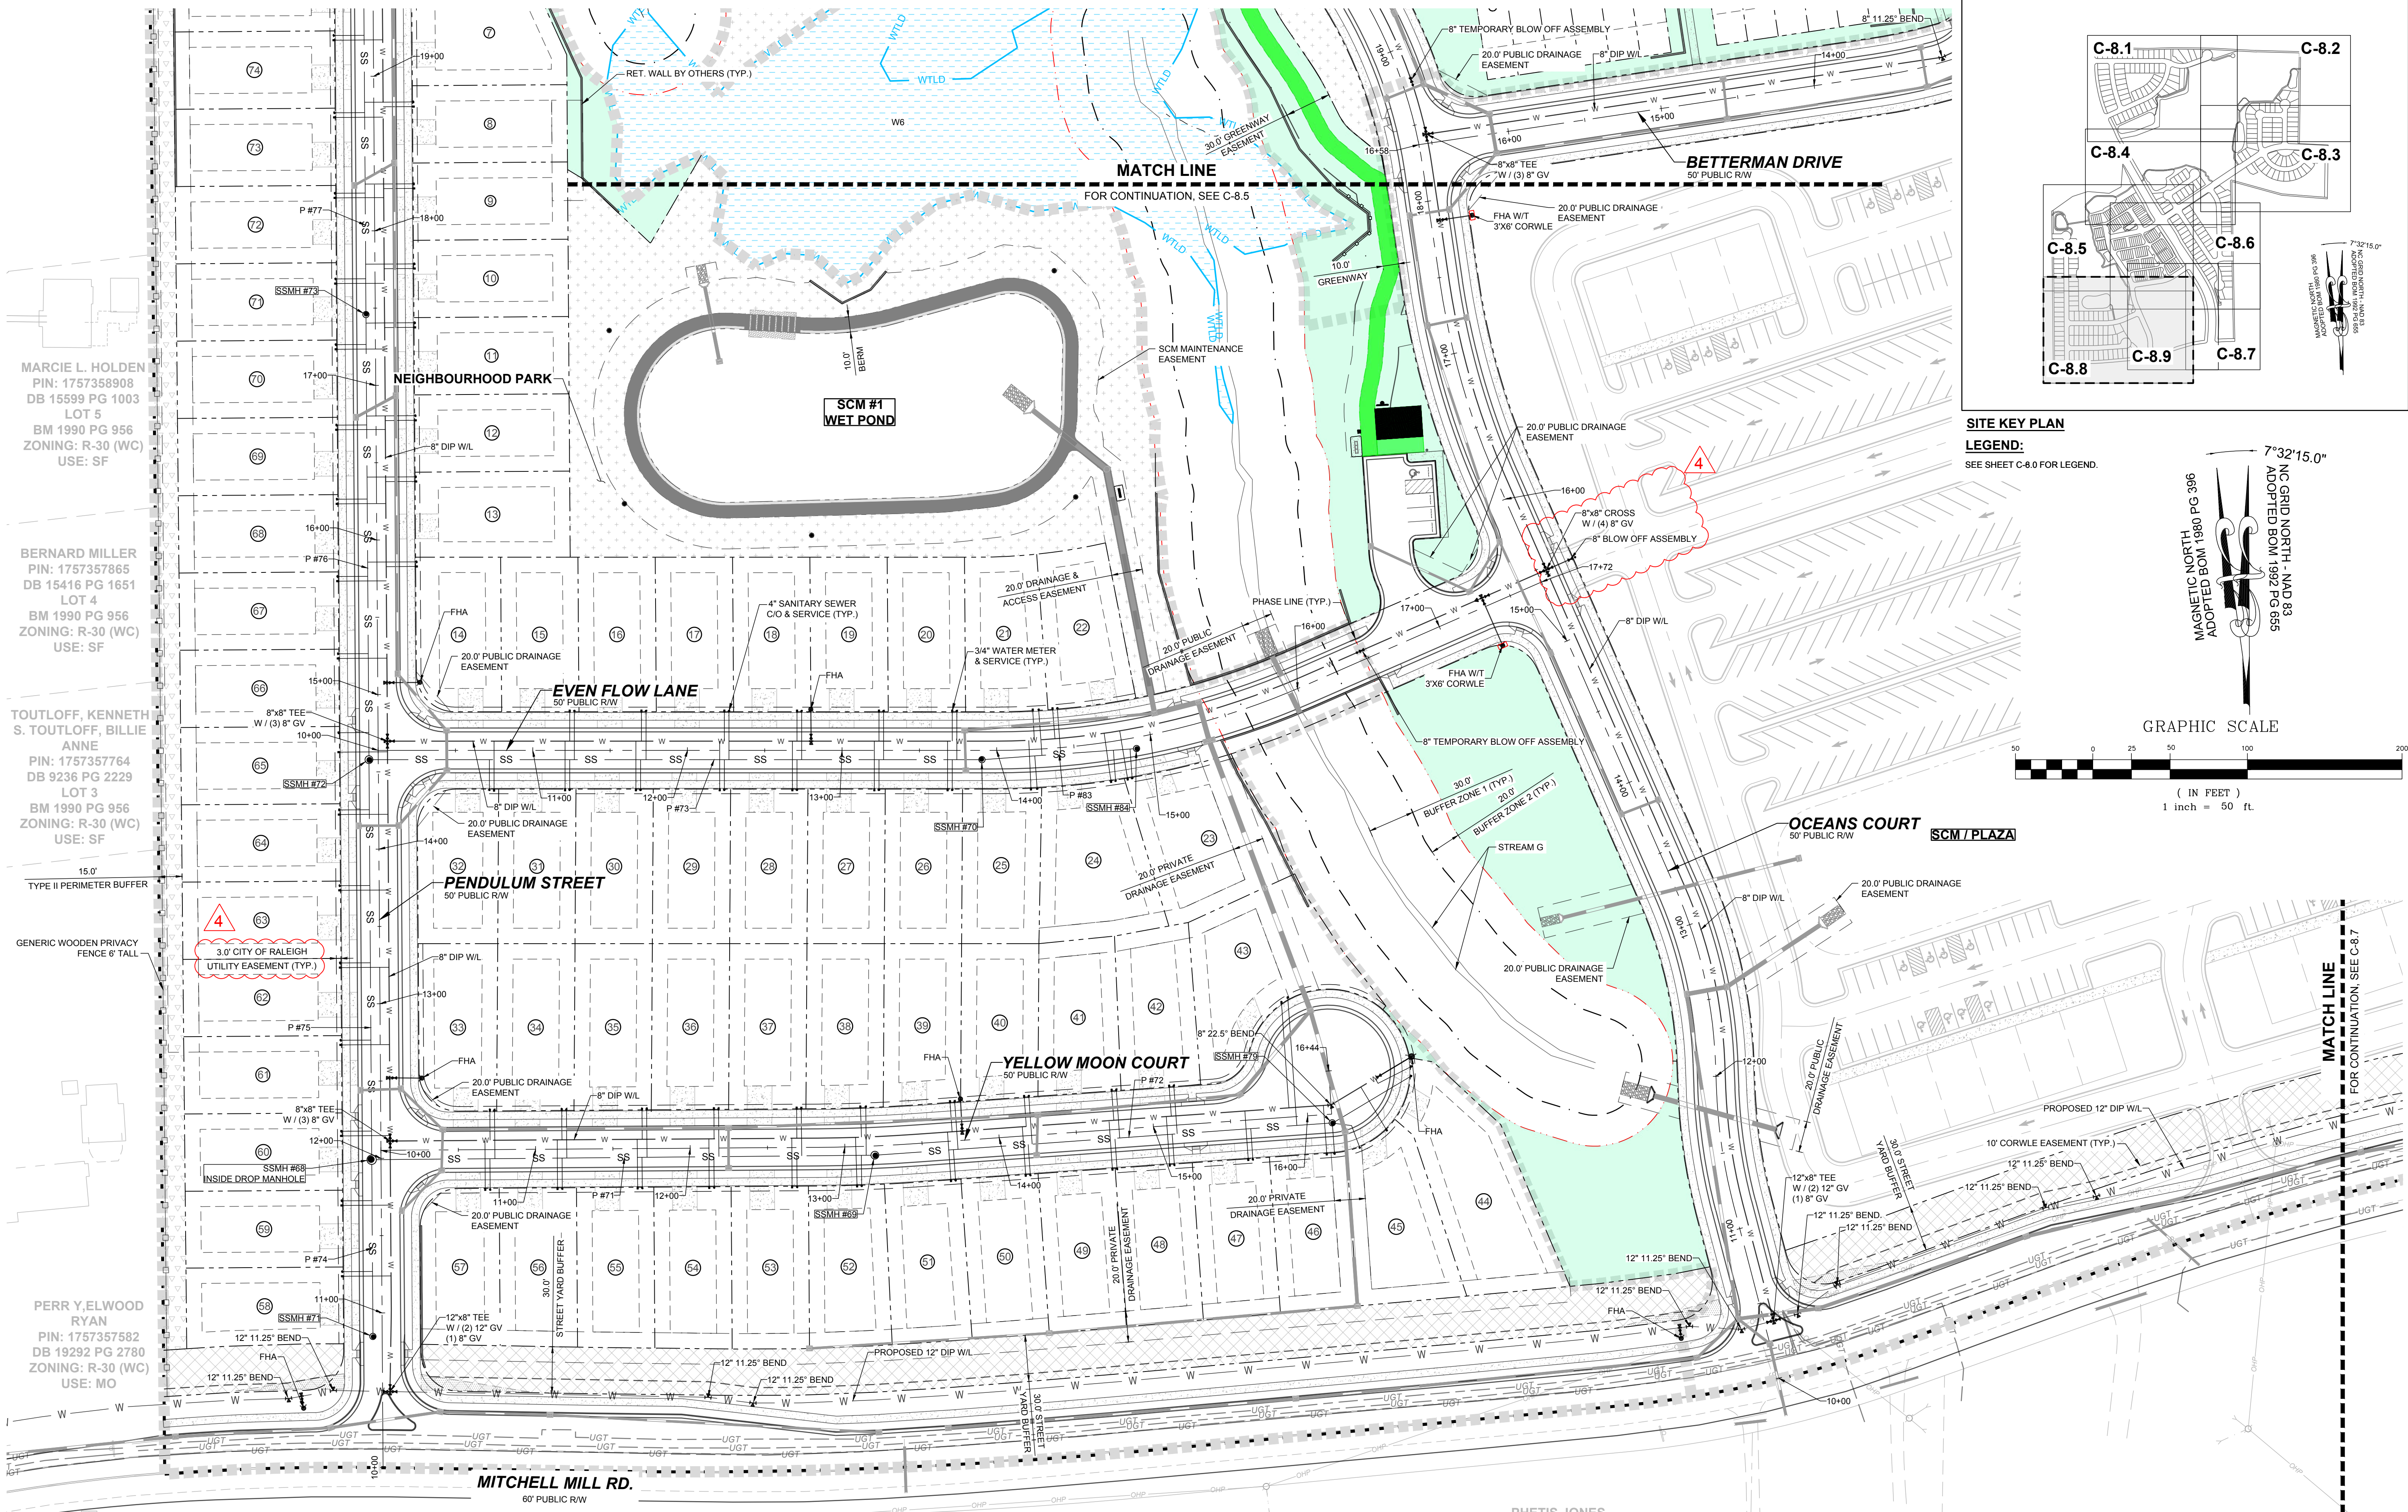

SITE KEY PLAN
LEGEND:
SEE SHEET C-8.0 FOR LEGEND.

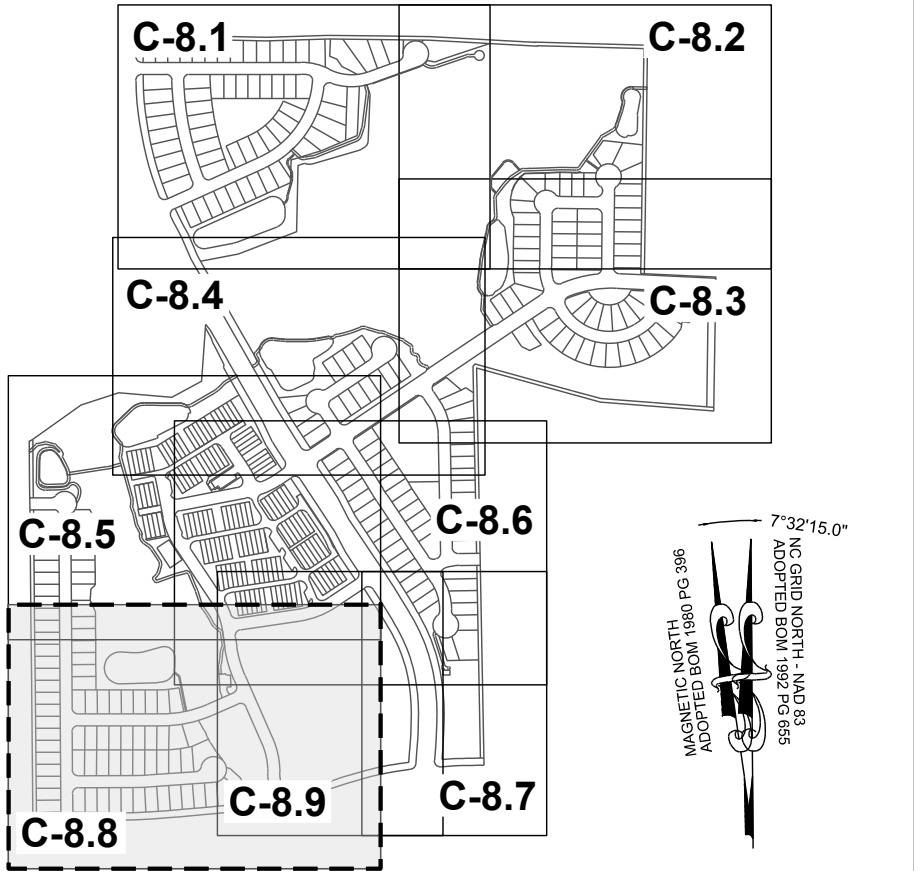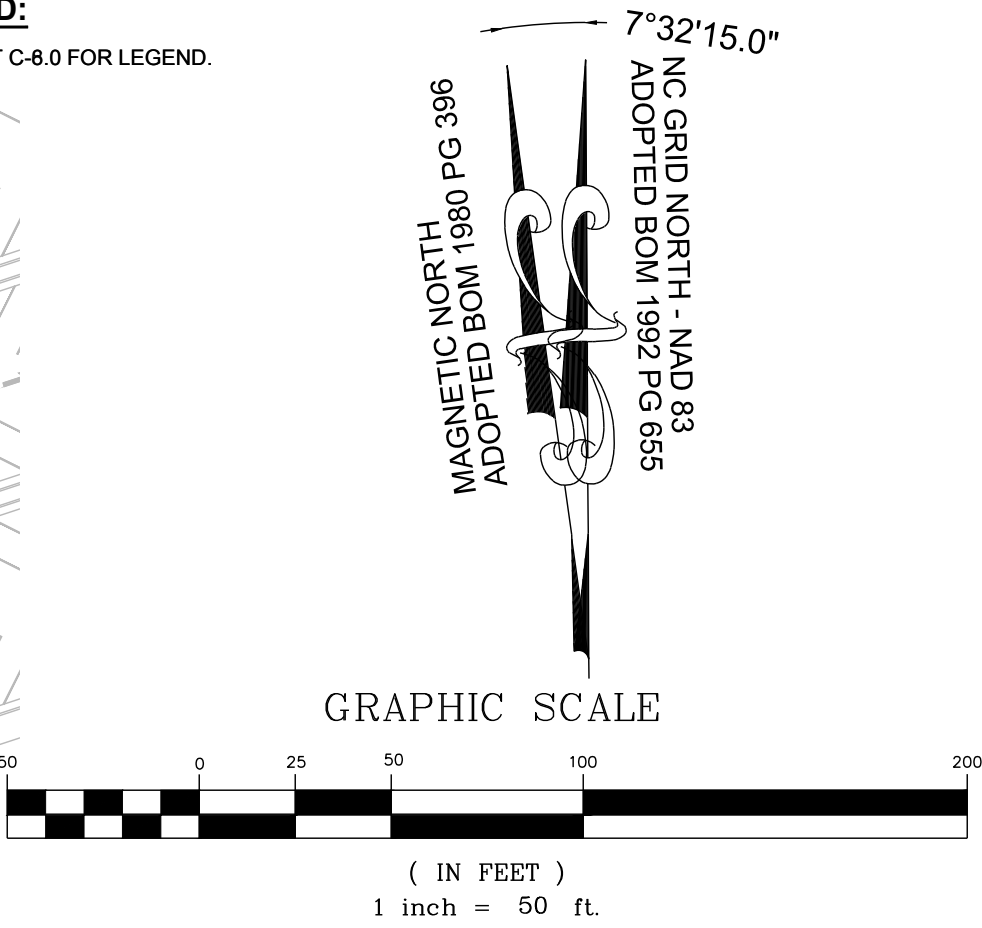

MARCI L. HOLDEN
PIN: 1757358908
DB 15599 PG 1003
LOT 5
BM 1990 PG 956
ZONING: R-30 (WC)
USE: SF

BERNARD MILLER
PIN: 1757357865
DB 15416 PG 1651
LOT 4
BM 1990 PG 956
ZONING: R-30 (WC)
USE: SF

TOUTLOFF, KENNETH
S. TOUTLOFF, BILLIE
ANNE
PIN: 1757357764
DB 9236 PG 2229
LOT 3
BM 1990 PG 956
ZONING: R-30 (WC)
USE: SF

15.0'
TYPE II PERIMETER BUFFER

GENERIC WOODEN PRIVACY
FENCE 6' TALL

PERR Y. ELWOOD
RYAN
PIN: 1757357582
DB 19292 PG 2780
ZONING: R-30 (WC)
USE: MO

PHETIS JONES
BRADSHAW
PIN: 1757349473
DB 15208 PG 2320
BM 2013 PG 868
ZONING: R-30 (WC)
USE: FO

CURTIS L. HONEYCUTT
AND WIFE TODD
KENDALL
PIN: 1757540996
DB 19269 PG 2474
LOT 1 - BM 2018 PG 1333
ZONING: R-30 (WC)
USE: SF

TODD KENDALL
HONEYCUTT
PIN: 1757551202
DB 13474 PG 1974
LOT 2 - BM 2018 PG 1333
ZONING: R-30 (WC)
USE: SF

CONSTRUCTION INFRASTRUCTURE DRAWINGS		REVISIONS		DATE	BY
NO.	DESCRIPTION	NO.	DESCRIPTION		
01	08/04/2024 SREG CID-24-04				
02	11/07/2024 SREG TOWN OF ROLESVILLE CID-24-04 V2				
03	02/07/2024 SREG TOWN OF ROLESVILLE CID-24-04 V3				
04	08/02/2025 SREG TOWN OF ROLESVILLE CID-24-04 V4				


STRONGROCK
ENGINEERING GROUP

STRONG ROCK ENGINEERING GROUP, PLLC | COMPANY LICENSE # P-2166
305 CHURCH AT NORTH HILLS STREET, SUITE 1110 RALEIGH, NC 27609 | INFORMATION@STRONGROCKGROUP.COM

STRONG ROCK PROJECT	NOT FOR CONSTRUCTION	SCALE	DESIGNED BY	SRG	DRAWN BY	SRG	CHECKED BY	SRG
PSP-23-03		AS SHOWN						

RESERVE @ MITCHELL MILL
TOWN OF ROLESVILLE, WAKE COUNTY, NORTH CAROLINA
CONSTRUCTION PLANS
PARTIAL UTILITY PLAN VIII

DRAWING SHEET
C-8.8

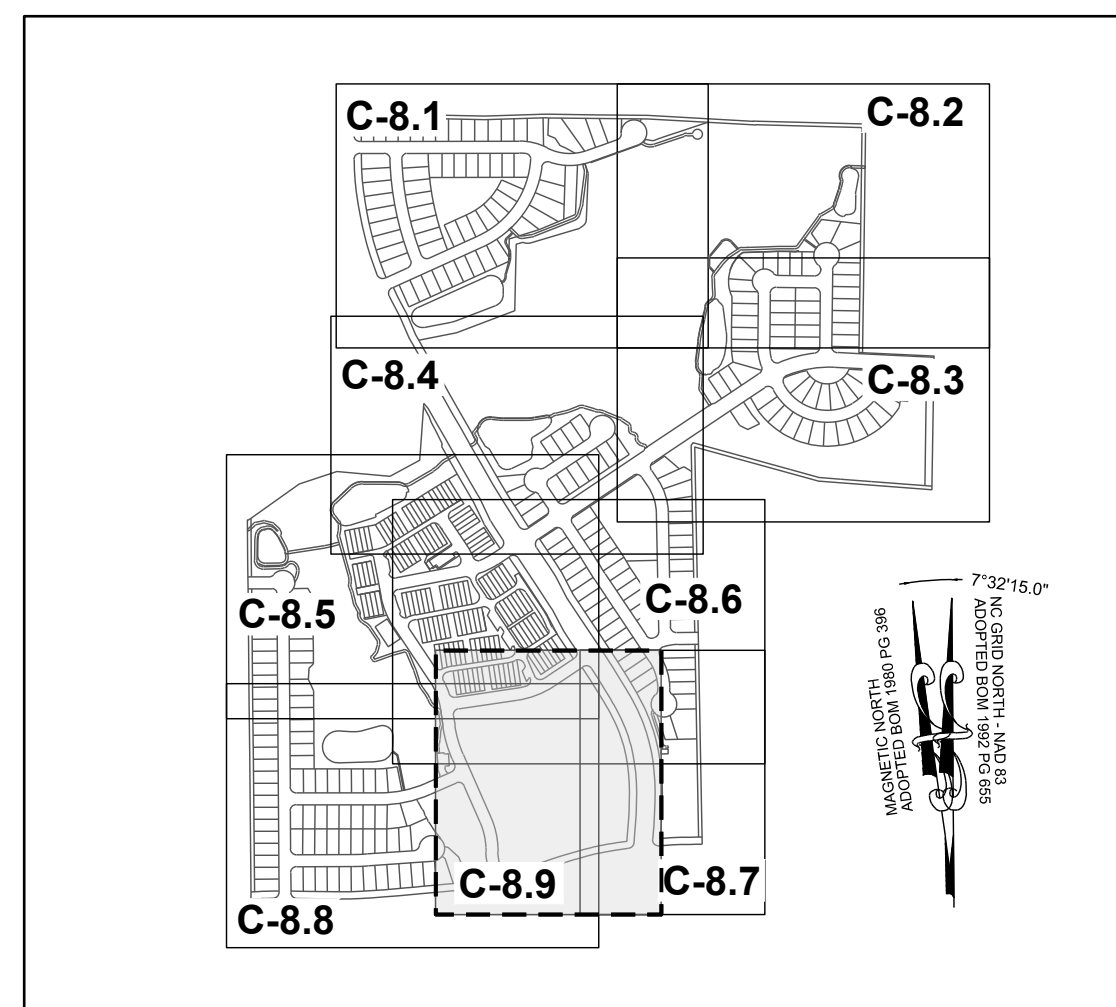



SITE KEY PLAN

LEGEND:

SEE SHEET C-8.0 FOR LEGEND.

TOWNHOME NOTES:

STATES INTERNAL TOWNHOME DRIVEWAYS ARE PRIVATE EASEMENTS AS PER CITY OF RALEIGH PUBLIC UTILITIES DEPARTMENT

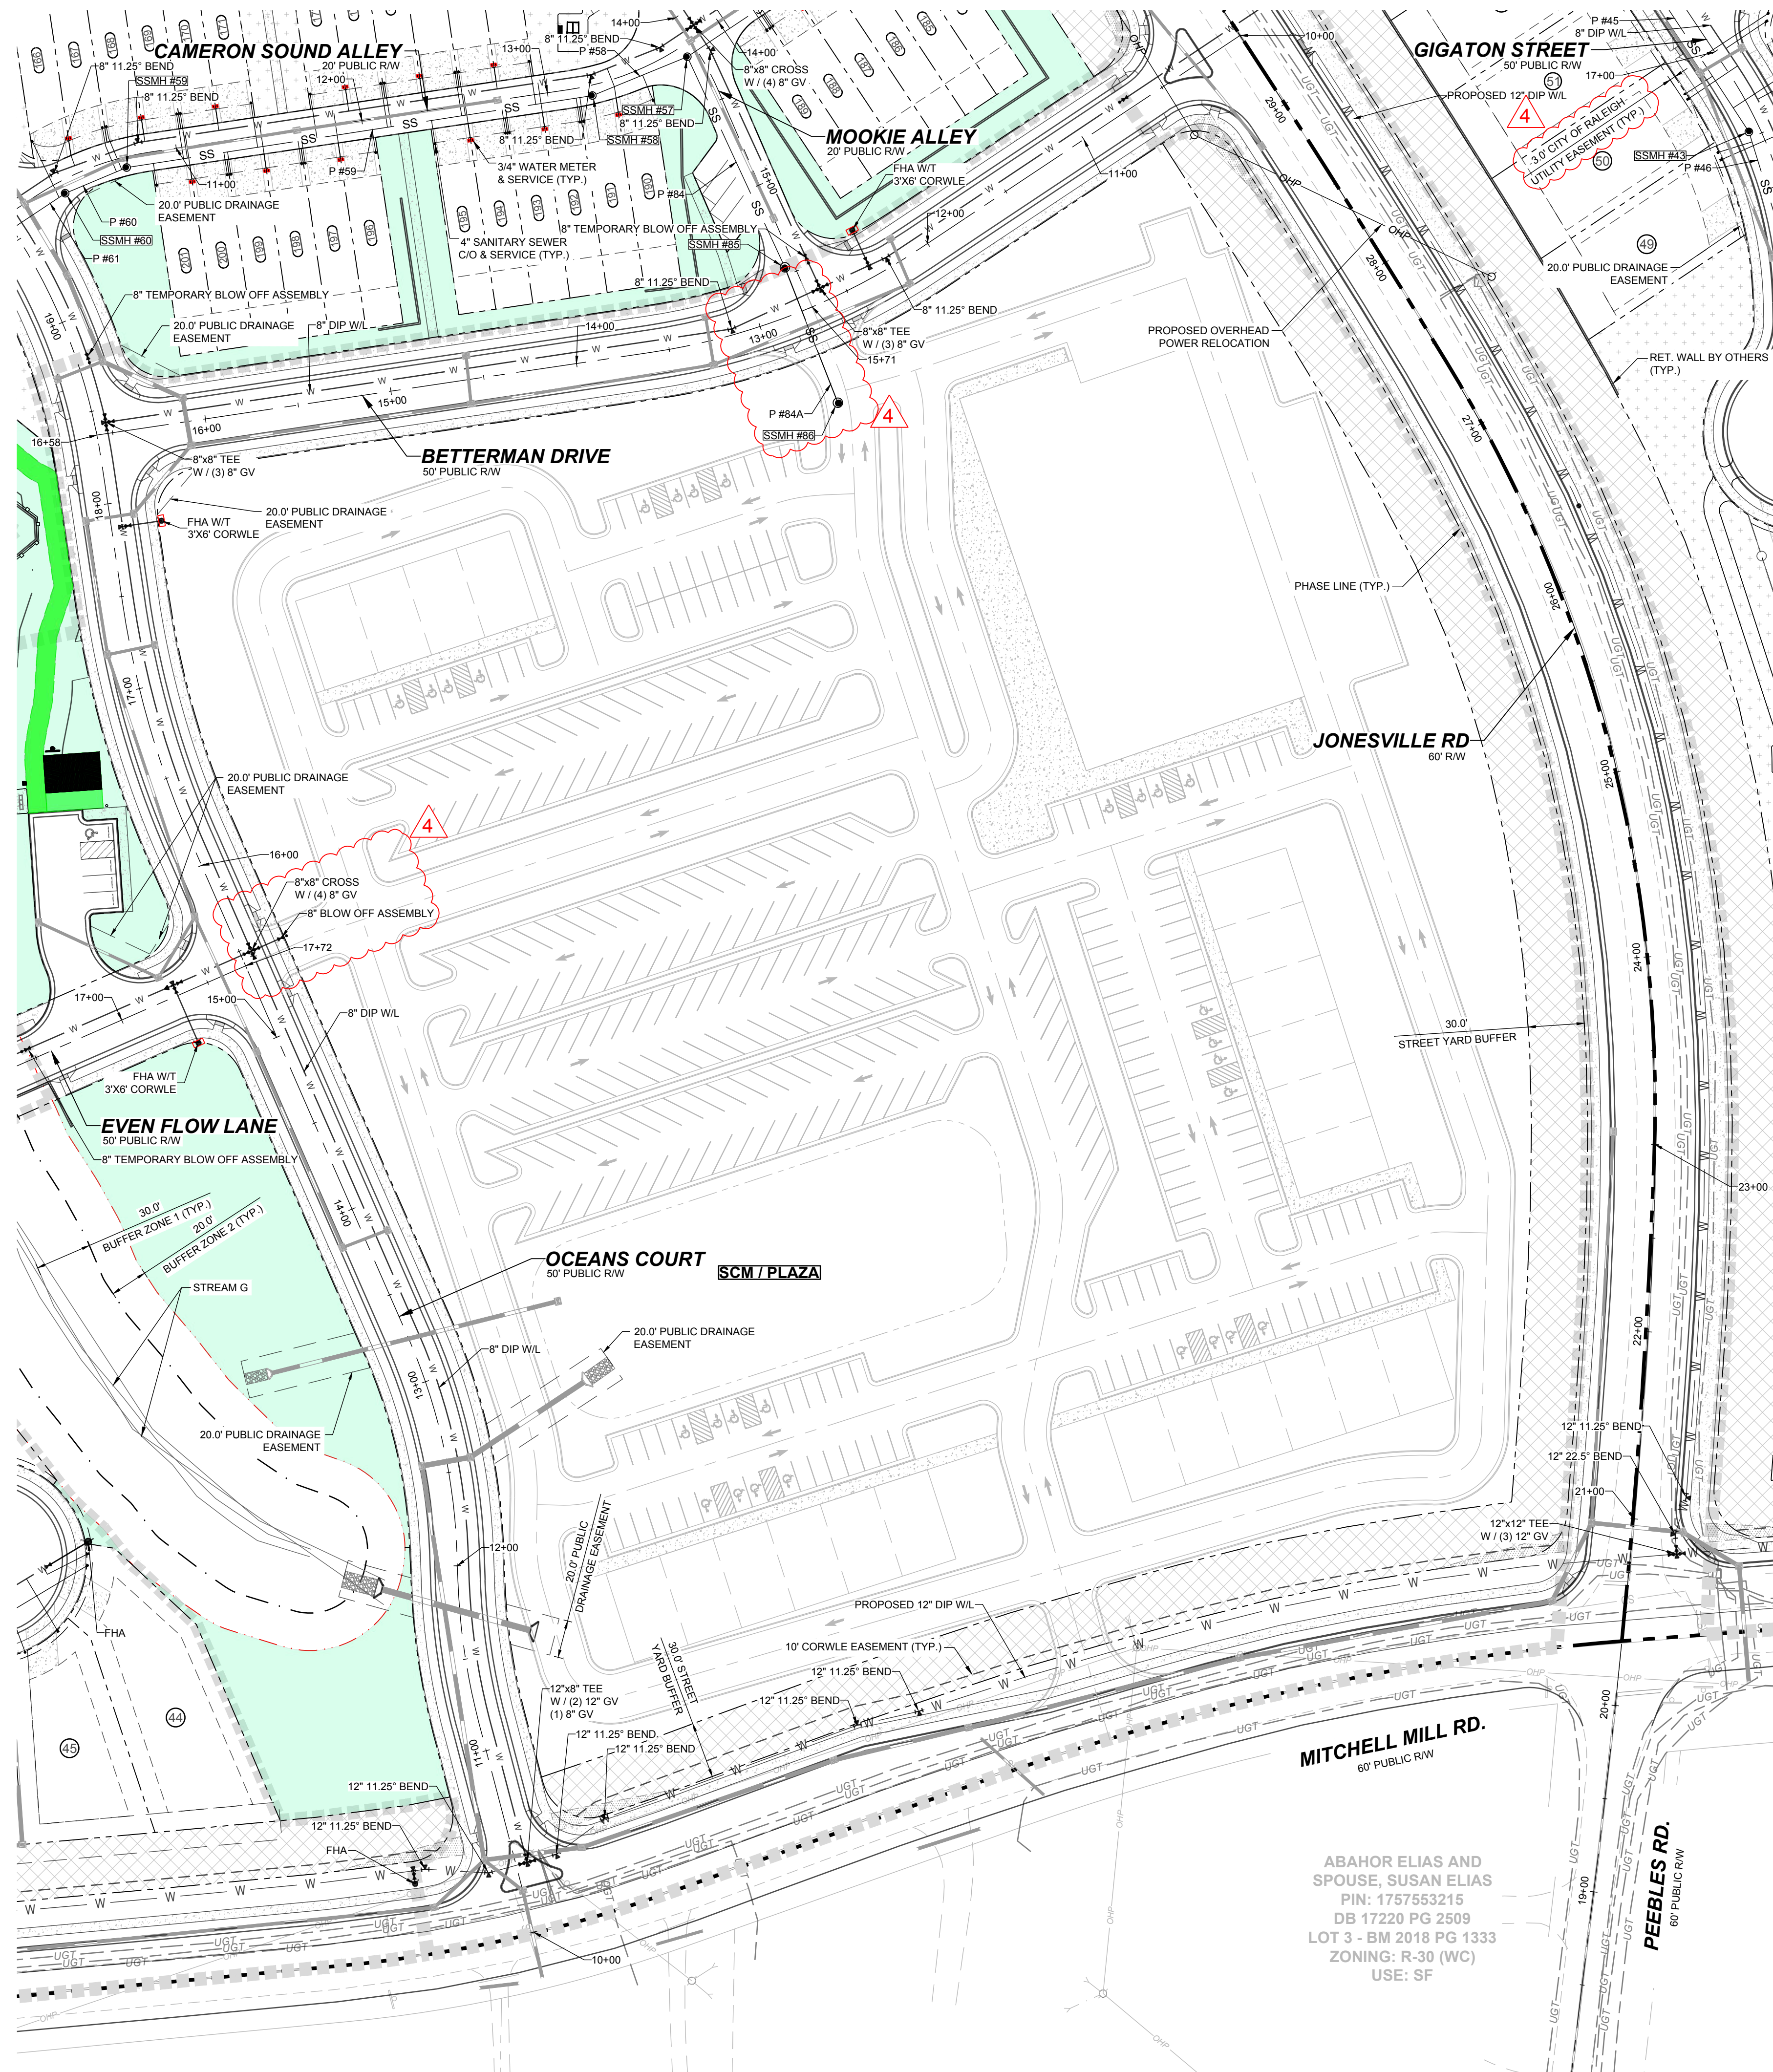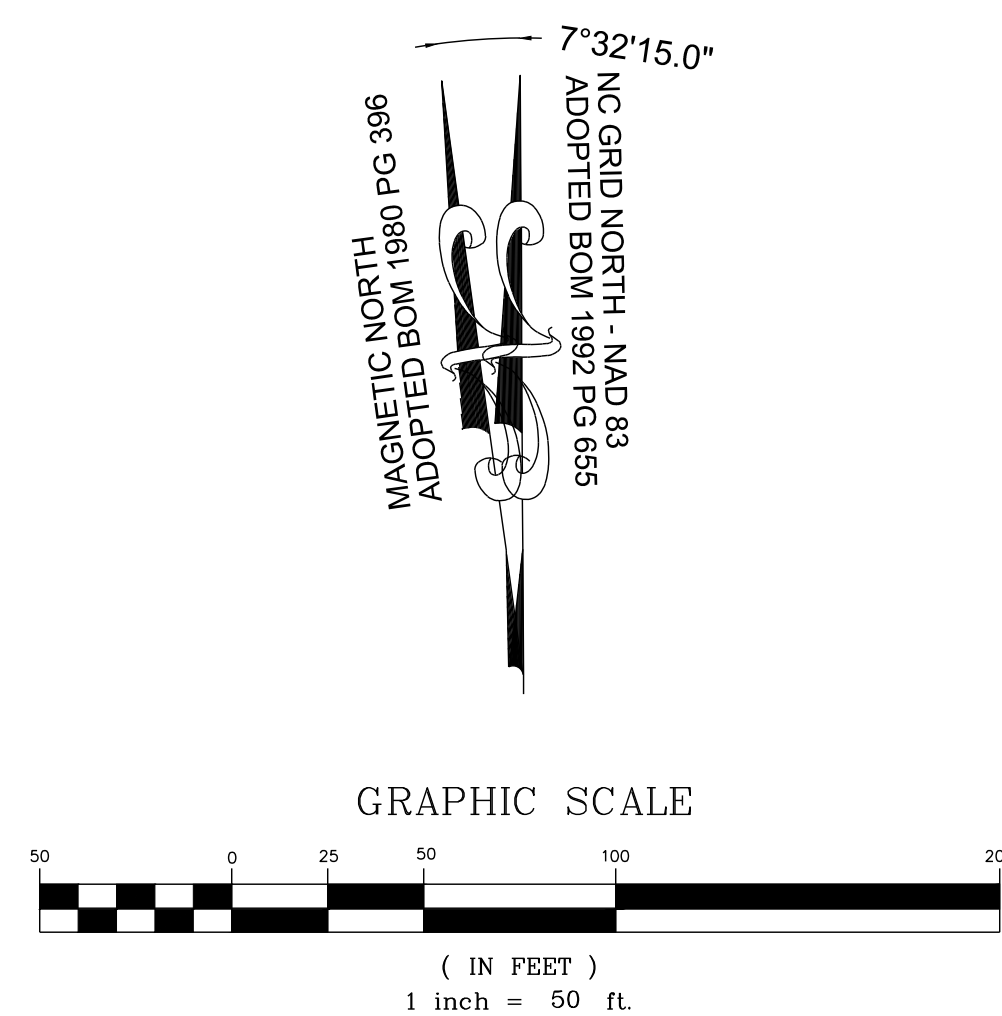

ABAHOR ELIAS AND
SPOUSE, SUSAN ELIAS
PIN: 1757553215
DB 17220 PG 2509
LOT 3 - BM 2018 PG 1333
ZONING: R-30 (WC)
USE: SF

THIS PLANSET AND ANY ASSOCIATED DOCUMENTS ARE PRELIMINARY AND NOT AUTHORIZED FOR CONSTRUCTION
UNTIL SIGNED, DATED, AND OFFICIALLY RELEASED FOR CONSTRUCTION BY THE ENGINEER OF RECORD.

C-8.9	DRAWING SHEET	RESERVE @ MITCHELL MILL TOWN OF ROLESVILLE, WAKE COUNTY, NORTH CAROLINA CONSTRUCTION PLANS PARTIAL UTILITY PLAN IX	STRONG ROCK PROJECT PSP-23-03 NOT FOR CONSTRUCTION SCALE AS SHOWN DESIGNED BY SRG DRAWN BY SRG CHECKED BY SRG	STRONGROCK ENGINEERING GROUP STRONG ROCK ENGINEERING GROUP, PLLC COMPANY LICENSE # P-2166 305 CHURCH AT NORTH HILLS STREET, SUITE 1110 RALEIGH, NC 27609 INFORMATION@STRONGROCKGROUP.COM	SFALL	01 CONSTRUCTION INFRASTRUCTURE DRAWINGS CID-24-04 SREG 06/04/2024 02 TOWN OF ROLESVILLE CID-24-04 V2 SREG 11/01/2024 03 TOWN OF ROLESVILLE CID-24-04 V3 SREG 02/07/2024 04 TOWN OF ROLESVILLE CID-24-04 V4 SREG 06/02/2025	No.	REVISIONS	DATE	BY
--------------	------------------	--	--	--	-------	---	-----	-----------	------	----

PIPE TABLE						
PIPE NO	TYPE	SIZE	LF	INV. IN	INV. OUT	GRADE
P #01	PVC - SDR 26	8"	296	249.97	248.49	0.50%
P #02	PVC - SDR 26	8"	205	248.29	247.26	0.50%
P #03	PVC - SDR 26	8"	235	247.06	245.33	0.74%
P #04	PVC - SDR 26	8"	78	245.13	242.01	3.99%
P #05	PVC - SDR 26	8"	86	241.81	241.38	0.50%
P #06	PVC - SDR 26	8"	83	241.18	240.76	0.50%
P #07	PVC - SDR 26	8"	119	240.56	239.97	0.50%
P #08	PVC - SDR 26	8"	92	239.77	239.31	0.50%
P #09	PVC - SDR 26	8"	291	237.87	236.42	0.50%
P #10	PVC - SDR 26	8"	140	250.07	243.42	4.74%
P #11	PVC - SDR 26	8"	134	243.22	238.69	3.39%
P #12	PVC - SDR 26	8"	137	238.49	237.81	0.50%
P #13	PVC - SDR 26	8"	50	237.61	236.60	2.03%
P #14	PVC - SDR 26	8"	147	236.22	232.44	2.58%
P #15	PVC - SDR 26	8"	189	232.24	231.29	0.50%
P #16	PVC - SDR 26	8"	149	252.30	251.55	0.50%
P #17	PVC - SDR 26	8"	238	257.50	251.55	2.49%
P #18	PVC - SDR 26	8"	257	251.35	250.07	0.50%
P #19	PVC - SDR 26	8"	290	249.87	245.97	1.34%
P #20	PVC - SDR 26	8"	58	245.77	243.82	3.37%

PIPE TABLE						
PIPE NO	TYPE	SIZE	LF	INV. IN	INV. OUT	GRADE
P #21	PVC - SDR 26	8"	50	243.62	241.49	4.27%
P #22	PVC - SDR 26	8"	162	279.88	273.53	3.93%
P #23	PVC - SDR 26	8"	86	273.33	270.73	3.02%
P #24	PVC - SDR 26	8"	73	270.53	265.53	6.85%
P #25	PVC - SDR 26	8"	78	265.33	260.33	6.38%
P #26	PVC - SDR 26	8"	87	260.13	256.87	3.75%
P #27	PVC - SDR 26	8"	87	256.67	249.70	8.00%
P #28	PVC - SDR 26	8"	100	249.50	247.20	2.29%
P #29	PVC - SDR 26	8"	87	247.00	243.53	3.98%
P #30	PVC - SDR 26	8"	64	243.33	241.49	2.87%
P #31	PVC - SDR 26	8"	141	241.29	237.20	2.90%
P #32	PVC - SDR 26	8"	411	237.00	234.94	0.50%
P #33	PVC - SDR 26	8"	111	234.74	234.19	0.50%
P #34	PVC - SDR 26	8"	302	278.91	264.13	4.89%
P #35	PVC - SDR 26	8"	272	263.93	246.77	6.32%
P #36	PVC - SDR 26	8"	68	246.57	245.20	2.02%
P #37	PVC - SDR 26	8"	113	245.00	243.11	1.68%
P #38	PVC - SDR 26	8"	46	233.99	233.76	0.50%
P #39	PVC - SDR 26	8"	136	233.56	232.88	0.50%
P #40	PVC - SDR 26	8"	176	232.68	231.80	0.50%

PIPE TABLE						
PIPE NO	TYPE	SIZE	LF	INV. IN	INV. OUT	GRADE
P #41	DIP	8"	242	231.60	230.39	0.50%
P #42	PVC - SDR 26	8"	195	265.53	256.73	4.51%
P #43	PVC - SDR 26	8"	181	256.53	251.33	2.87%
P #44	PVC - SDR 26	8"	268	278.89	267.25	4.35%
P #45	PVC - SDR 26	8"	272	291.38	279.09	4.52%
P #46	PVC - SDR 26	8"	62	293.84	291.58	3.66%
P #47	PVC - SDR 26	8"	110	300.67	294.04	6.04%
P #48	DIP	8"	59	230.19	229.89	0.50%
P #49	DIP	8"	296	229.69	228.21	0.50%
P #50	DIP	8"	66	228.01	227.68	0.50%
P #51	DIP	8"	116	227.48	226.90	0.50%
P #52	PVC - SDR 26	8"	106	276.30	267.79	8.00%
P #53	PVC - SDR 26	8"	44	267.59	266.02	3.61%
P #54	PVC - SDR 26	8"	317	265.82	248.77	5.38%
P #55	PVC - SDR 26	8"	35	248.57	246.61	5.59%
P #56	PVC - SDR 26	8"	30	246.41	246.26	0.50%
P #57	PVC - SDR 26	8"	150	283.63	277.83	3.87%
P #58	PVC - SDR 26	8"	55	277.63	277.36	0.50%
P #59	PVC - SDR 26	8"	251	277.16	261.79	6.12%
P #60	PVC - SDR 26	8"	35	261.59	259.36	6.28%

PIPE TABLE						
PIPE NO	TYPE	SIZE	LF	INV. IN	INV. OUT	GRADE
P #61	PVC - SDR 26	8"	40	259.16	258.96	0.50%
P #62	PVC - SDR 26	8"	261	258.76	248.56	3.90%
P #63	PVC - SDR 26	8"	84	246.06	245.64	0.50%
P #64	PVC - SDR 26	8"	92	245.44	241.63	4.12%
P #65	PVC - SDR 26	8"	223	259.28	247.76	5.16%
P #66	PVC - SDR 26	8"	104	249.62	245.46	4.02%
P #67	PVC - SDR 26	8"	272	245.26	240.01	1.93%
P #68	PVC - SDR 26	8"	27	239.81	239.67	0.50%
P #69	PVC - SDR 26	8"	110	239.47	238.93	0.50%
P #70	PVC - SDR 26	8"	80	238.73	235.52	3.99%
P #71	PVC - SDR 26	8"	325	266.82	265.19	0.50%
P #72	DIP	8"	297	268.50	267.02	0.50%
P #73	PVC - SDR 26	8"	396	267.04	264.94	0.53%
P #74	PVC - SDR 26	8"	114	280.33	270.04	9.00%
P #75	PVC - SDR 26	8"	259	264.99	263.70	0.50%
P #76	PVC - SDR 26	8"	288	263.50	262.06	0.50%
P #77	PVC - SDR 26	8"	223	261.86	256.83	2.26%
P #78	PVC - SDR 26	8"	390	254.33	249.00	1.37%
P #79	PVC - SDR 35	8"	172	235.32	231.63	2.14%
P #80	PVC - SDR 35	8"	157	231.43	230.65	0.50%

PIPE TABLE						
PIPE NO	TYPE	SIZE	LF	INV. IN	INV. OUT	GRADE
P #81	PVC - SDR 35	8"	47	230.45	230.21	0.50%
P #82	PVC - SDR 26	8"	124	248.80	248.18	0.50%
P #83	PVC - SDR 26	8"	100	267.75	267.24	0.50%
P #84	PVC - SDR 26	8"	124	281.82	280.13	1.37%
P #84A	PVC - SDR 26	8"	78	282.41	282.02	0.50%
P #85	PVC - SDR 26	8"	226	247.98	230.01	7.95%
P #86	PVC - SDR 35	8"	44	229.81	225.98	8.74%
P #87	PVC - SDR 26	8"	148	241.43	240.69	0.50%
P #88	PVC - SDR 26	8"	107	242.16	241.63	0.50%
P #89	PVC - SDR 26	8"	67	231.09	230.76	0.50%
P #90	PVC - SDR 26	8"	79	242.99	242.59	0.50%
P #91	PVC - SDR 26	8"	240	242.39	237.48	2.04%
P #92	PVC - SDR 26	8"	39	237.28	233.77	9.00%
P #93	PVC - SDR 26	8"	29	280.93	280.08	2.95%
P #95	PVC - SDR 35	8"	105	253.87	253.35	0.50%
P #96	PVC - SDR 35	8"	130	253.15	252.50	0.50%

SSMH TABLE					
SSMH NO	SIZE	TOP	INV. IN	INV. OUT	DEPTH
SSMH #01	4'	259.87		249.97 E	9.90
SSMH #02	5'	262.93	248.49 W	248.29 E	14.64
SSMH #03	5'	263.93	247.26 W	247.06 E	16.86
SSMH #04	4'	254.43	245.33 W	245.13 S	9.30
SSMH #05	4'	250.77	242.01 N	241.81 S	8.97
SSMH #06	4'	248.87	241.38 N	241.18 SW	7.69
SSMH #07	4'	248.43	240.76 NE	240.56 SW	7.87
SSMH #08	4'	247.89	239.97 NE	239.77 SW	8.12
SSMH #09	4'	247.37	239.31 NE	237.87 SW	9.50
SSMH #10	4'	259.15		250.07 S	9.11
SSMH #11	4'	252.27	243.42 N	243.22 S	9.07
SSMH #12	4'	247.16	238.69 N	238.49 S	8.67
SSMH #13	4'	246.15	237.81 N	237.61 SE	8.54
SSMH #14	4'	246.05	236.42 NE 236.60 NW	236.22 SW	9.83
SSMH #15	4'	242.06	232.44 NE	232.24 SE	9.83
SSMH #16	4'	260.64	252.50 NE	252.30 S	8.37
SSMH #17	4'	264.63		257.50 N	7.15
SSMH #18	4'	262.22	251.55 N 251.55 S	251.35 W	10.89
SSMH #19	4'	260.40	250.07 E	249.87 S	10.53
SSMH #20	4'	253.92	245.97 N	245.77 S	8.14


SSMH TABLE					
SSMH NO	SIZE	TOP	INV. IN	INV. OUT	DEPTH
SSMH #21	4'	253.00	243.82 N	243.62 SE	9.38
SSMH #22	4'	286.97	280.08 N	279.88 W	7.09
SSMH #23	4'	281.12	273.53 E	273.33 S	7.78
SSMH #24	4'	276.42	270.73 N	270.53 SW	5.89
SSMH #25	4'	268.23	260.33 NE	260.13 W	8.10
SSMH #26	4'	263.50	256.87 E	256.67 W	6.83
SSMH #27	4'	258.75	249.70 E	249.50 NW	9.25
SSMH #28	4'	254.85	247.20 SE	247.00 NW	7.85
SSMH #29	4'	253.48	243.53 SE	243.33 NW	10.15
SSMH #30	4'	252.82	241.49 SE 241.49 NW	241.29 SW	11.55
SSMH #31	5'	249.56	237.20 NE 237.20 SE	237.00 SW	13.06
SSMH #32	5'	250.01	234.94 NE	234.74 SW	15.29
SSMH #33	5'	292.53		278.91 N	13.65
SSMH #34	4'	272.81	264.13 S	263.93 N	8.88
SSMH #35	4'	255.52	246.77 S	246.57 N	8.97
SSMH #36	4'	253.06	245.20 S	245.00 NW	8.06
SSMH #37 INSIDE DROP MANHOLE	6'	251.46	234.19 NE 243.11 SE	233.99 N	17.47
SSMH #38	5'	251.44	233.76 S	233.56 NW	17.90
SSMH #39	5'	248.80	232.88 SE	232.68 SW	16.12
SSMH #41	4'	307.13		300.67 N	6.45

SSMH TABLE					
SSMH NO	SIZE	TOP	INV. IN	INV. OUT	DEPTH
SSMH #42	4'	302.03	294.04 S	293.84 N	8.20
SSMH #43	4'	299.18	291.58 S	291.38 NW	7.82
SSMH #44	4'	286.87	279.09 SE	278.89 NW	7.99
SSMH #45	4'	273.75	267.25 SE	265.53 NW	8.24
SSMH #46	4'	266.80	256.73 SE	256.53 NW	10.29
SSMH #47 INSIDE DROP MANHOLE	6'	258.46	251.33 SE 230.39 NE	230.19 NW	28.27
SSMH #50	6'	249.24	227.68 SE	227.48 W	21.76
SSMH #51	4'	284.10		276.30 SW	7.80
SSMH #52	4'	277.48	267.79 NE	267.59 W	9.89
SSMH #53	4'	275.80	266.02 E	265.82 W	9.99
SSMH #54	4'	269.01	248.77 E	248.57 SW	11.03
SSMH #55	5'	258.93	246.61 NE	246.41 SW	12.52
SSMH #56	4'	290.90		283.63 SW	7.27
SSMH #57	4'	289.04	277.83 NE 280.13 SE	277.63 W	11.44
SSMH #58	4'	286.95	277.36 E	277.16 W	9.80
SSMH #59	4'	270.20	261.79 E	261.59 SW	8.61
SSMH #60	4'	268.56	259.36 NE	259.16 SW	9.39
SSMH #61	4'	267.51	258.96 NE	258.76 NW	8.74
SSMH #62	5'	258.51	246.26 NE 248.56 SE	246.06 NW	12.45
SSMH #63	4'	269.95		259.28 NW	10.67

SSMH TABLE					
SSMH NO	SIZE	TOP	INV. IN	INV. OUT	DEPTH
SSMH #64	4'	258.00		249.62 SW	8.38
SSMH #65	4'	257.19	247.76 SE 245.46 NE	245.26 SW	11.93
SSMH #66	5'	253.09	238.93 E	238.73 NW	14.36
SSMH #68 INSIDE DROP MANHOLE	6'	283.69	265.19 E 270.04 S	264.99 N	18.73
SSMH #69	5'	277.86	267.02 E	266.82 W	11.04
SSMH #70	4'	275.31	267.24 E	267.04 W	8.26
SSMH #71	4'	289.78		280.33 N	9.47
SSMH #72	5'	275.55	263.70 S 264.94 E	263.50 N	12.08
SSMH #73	4'	272.67	262.06 S	261.86 N	10.81
SSMH #74	5'	269.01	256.83 S	254.33 N	14.67
SSMH #75	4'	260.03	249.00 S	248.80 W	11.25
SSMH #76	4'	241.30	235.52 SE	235.32 NW	5.99
SSMH #77	4'	236.45	231.63 SE	231.45 NE	5.01
SSMH #78	4'	240.05	230.65 SW	230.45 NW	9.60
SSMH #79	4'	273.14		268.50 W	4.64
SSMH #80	5'	252.38	240.01 NE	239.81 W	12.58
SSMH #81	4'	255.20	245.64 SE	245.44 N	9.78
SSMH #82	5'	264.91	248.18 E	247.98 N	16.93
SSMH #83	4'	240.25	230.01 S	229.81 N	10.44
SSMH #84	4'	273.44		267.75 W	5.69

STATES INTERNAL TOWNHOME DRIVEWAYS ARE PRIVATE EASEMENTS AS
PER CITY OF RALEIGH PUBLIC UTILITIES DEPARTMENT

LEGEND:

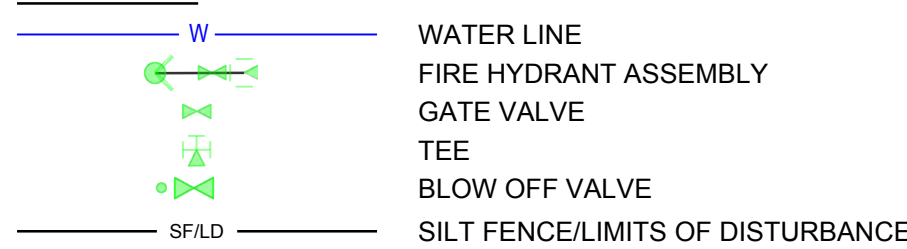

GRO PEG ROAD

60 PRIVATE RW
RECORDED BOOK OF MAPS 1980 PAGE 396

STRONGROCK

ENGINEERING GROUP

STRONG ROCK ENGINEERING GROUP, PLLC | COMPANY LICENSE # P-2166

STRONG ROCK ENGINEERING GROUP, PLLC | COMPANY LICENSE # P-2166
305 CHURCH AT NORTH HILLS STREET, SUITE 1110 RALEIGH, NC 27609 | INFORMATION@STRONGROCKGROUP.COM

RESERVE @ MITCHELL MILL
TOWN OF ROLESVILLE, WAKE COUNTY, NORTH CAROLINA
CONSTRUCTION PLANS

CONSTRUCTION PLANS

OFF-SITE UTILITY PLAN

DRAWING
SHEET

C-8.11

46 OF 227

THIS PLANSET AND ANY ASSOCIATED DOCUMENTS ARE PRELIMINARY AND NOT AUTHORIZED FOR CONSTRUCTION UNTIL SIGNED, DATED, AND OFFICIALLY RELEASED FOR CONSTRUCTION BY THE ENGINEER OF RECORD.




NOTES:
SEE SHEET C-3.0 FOR ADJACENT PROPERTY DETAILS

TOWNHOME NOTES:
STATES INTERNAL TOWNHOME DRIVEWAYS ARE PRIVATE EASEMENTS AS PER CITY OF RALEIGH PUBLIC UTILITIES DEPARTMENT

LEGEND:

	STORM DRAIN LINE
	FLARED END SECTION
	CATCH BASIN
	STORM DRAIN MANHOLE
	EX. MAJOR CONTOURS
	EX. MINOR CONTOURS
	PROP. MAJOR CONTOURS
	PROP. MINOR CONTOURS

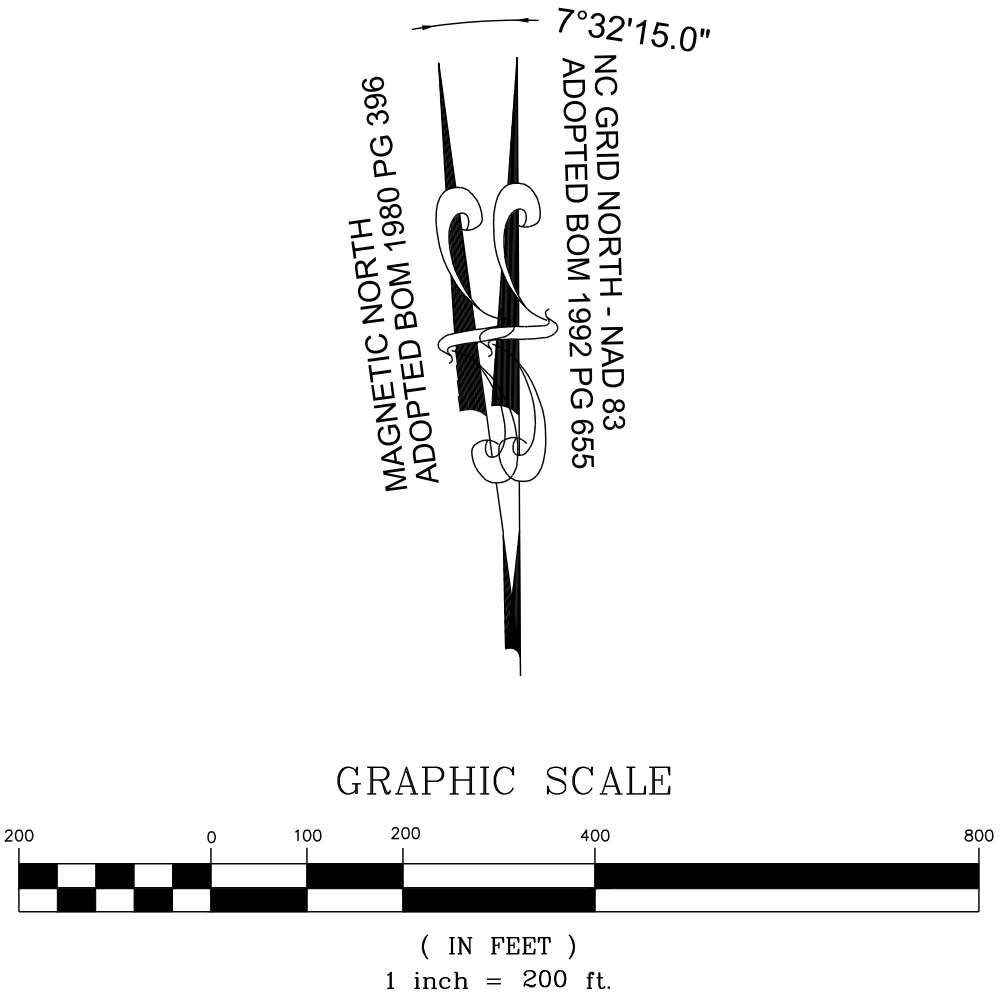

THIS PLANSET AND ANY ASSOCIATED DOCUMENTS ARE PRELIMINARY AND NOT AUTHORIZED FOR CONSTRUCTION UNTIL SIGNED, DATED, AND OFFICIALLY RELEASED FOR CONSTRUCTION BY THE ENGINEER OF RECORD.

STRONGROCK

ENGINEERING GROUP

STRONG ROCK ENGINEERING GROUP, PLLC | COMPANY LICENSE # P-2166
305 CHURCH AT NORTH HILLS STREET, SUITE 1110 RALEIGH, NC 27609 | INFORMATION@STRONGROCKGROUP.COM

STRONG ROCK PROJECT
PSP-24-03

NOT FOR CONSTRUCTION

SCALE AS SHOWN

DESIGNED BY SRG

DRAWN BY SRG

CHECKED BY SRG

RESERVE @ MITCHELL MILL
TOWN OF ROLESVILLE, WAKE COUNTY, NORTH CAROLINA

CONSTRUCTION PLANS

OVERALL GRADING AND DRAINAGE PLAN

DRAWING SHEET

C-9.0

47 OF 227

CONSTRUCTION INFRASTRUCTURE DRAWINGS
CID-24-04

08/04/2024

SRG

TOWN OF ROLESVILLE CID-24-04 V2

11/07/2024

SRG

TOWN OF ROLESVILLE CID-24-04 V3

02/07/2024

SRG

TOWN OF ROLESVILLE CID-24-04 V4

08/02/2025

SRG

01

02

03

04

01

02


03

04

REVISIONS

DATE

BY

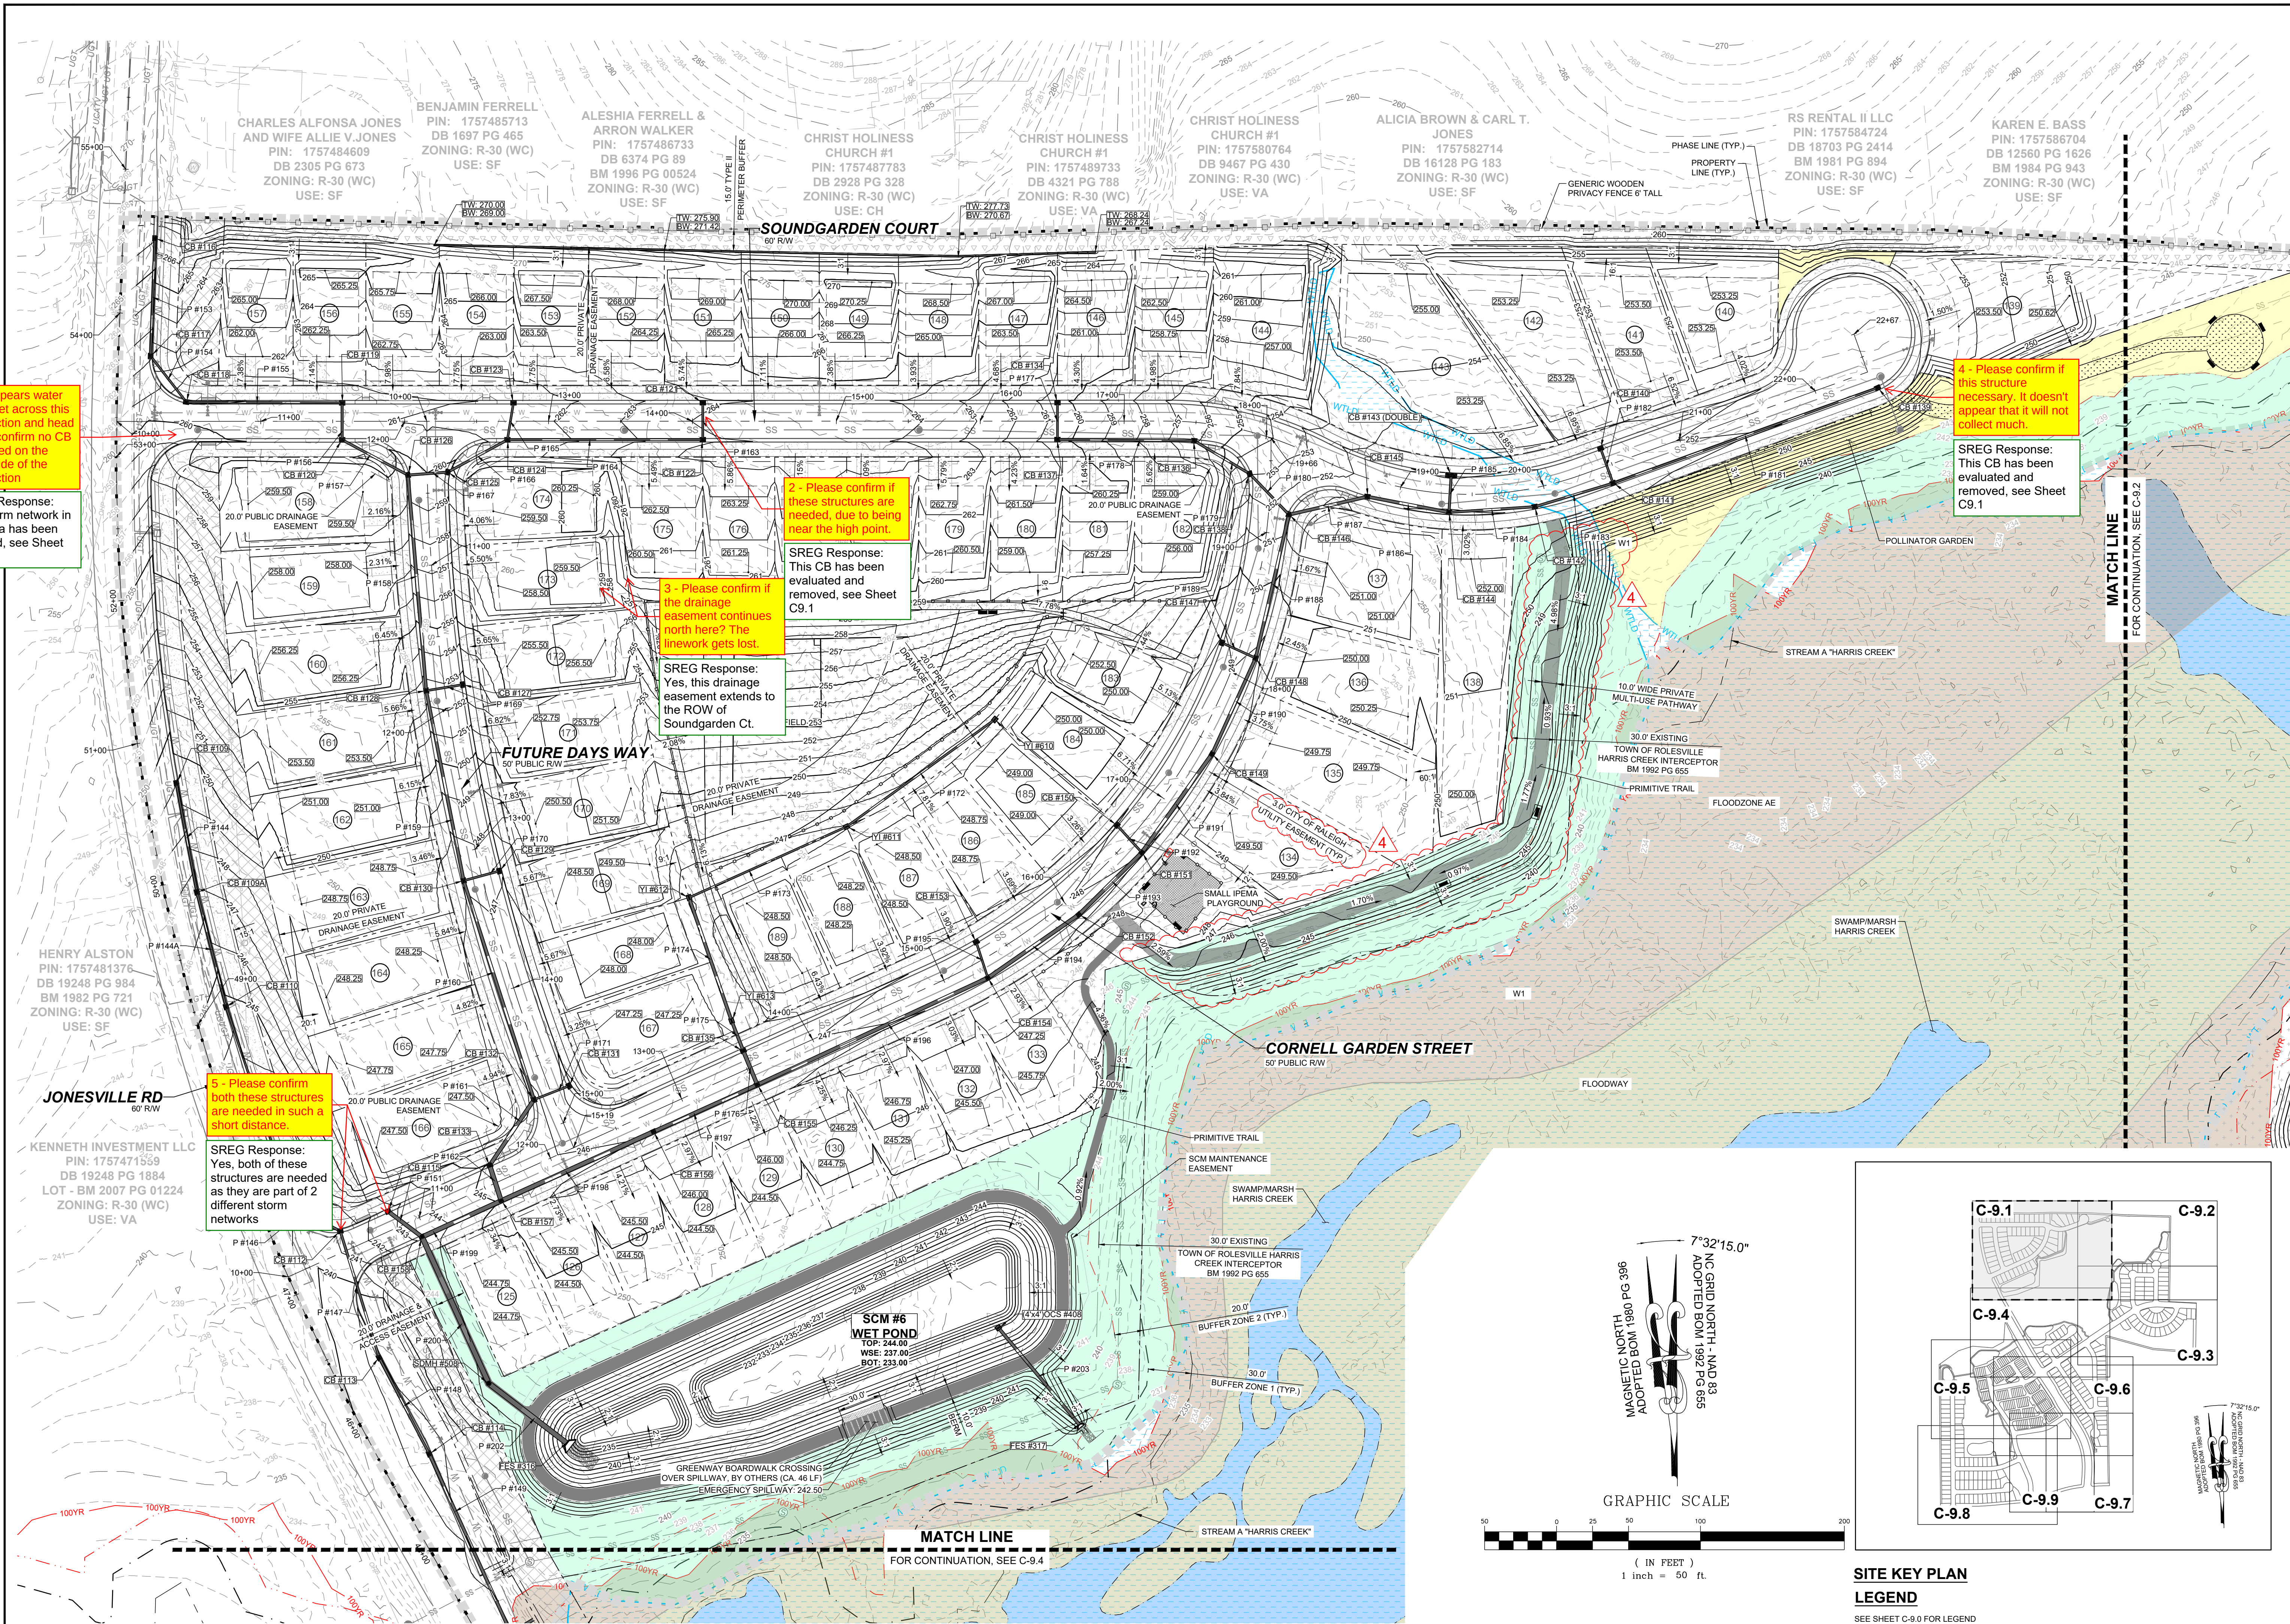

1 - It appears water will sheet across this intersection and head south; confirm no CB is needed on the south side of the intersection

SREG Response: The storm network in this area has been updated, see Sheet C9.1

2 - Please confirm if these structures are needed, due to being near the high point.

SREG Response: This CB has been evaluated and removed, see Sheet C9.1

3 - Please confirm if the drainage easement continues north here? The linework gets lost.



SREG Response: Yes, this drainage easement extends to the ROW of Soundgarden Ct.

4 - Please confirm if this structure necessary. It doesn't appear that it will not collect much.

SREG Response: This CB has been evaluated and removed, see Sheet C9.1

5 - Please confirm both these structures are needed in such a short distance.

SREG Response: Yes, both of these structures are needed as they are part of 2 different storm networks

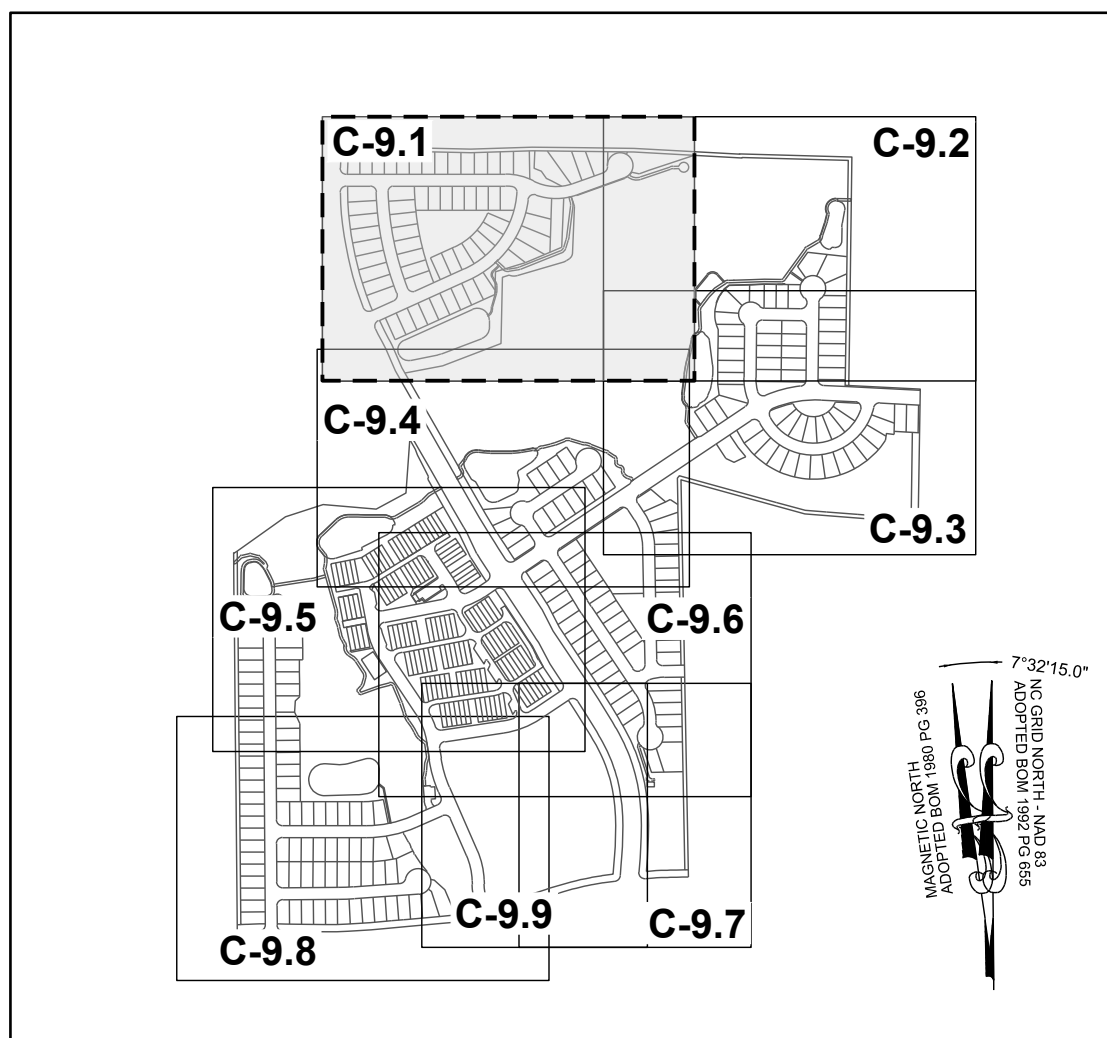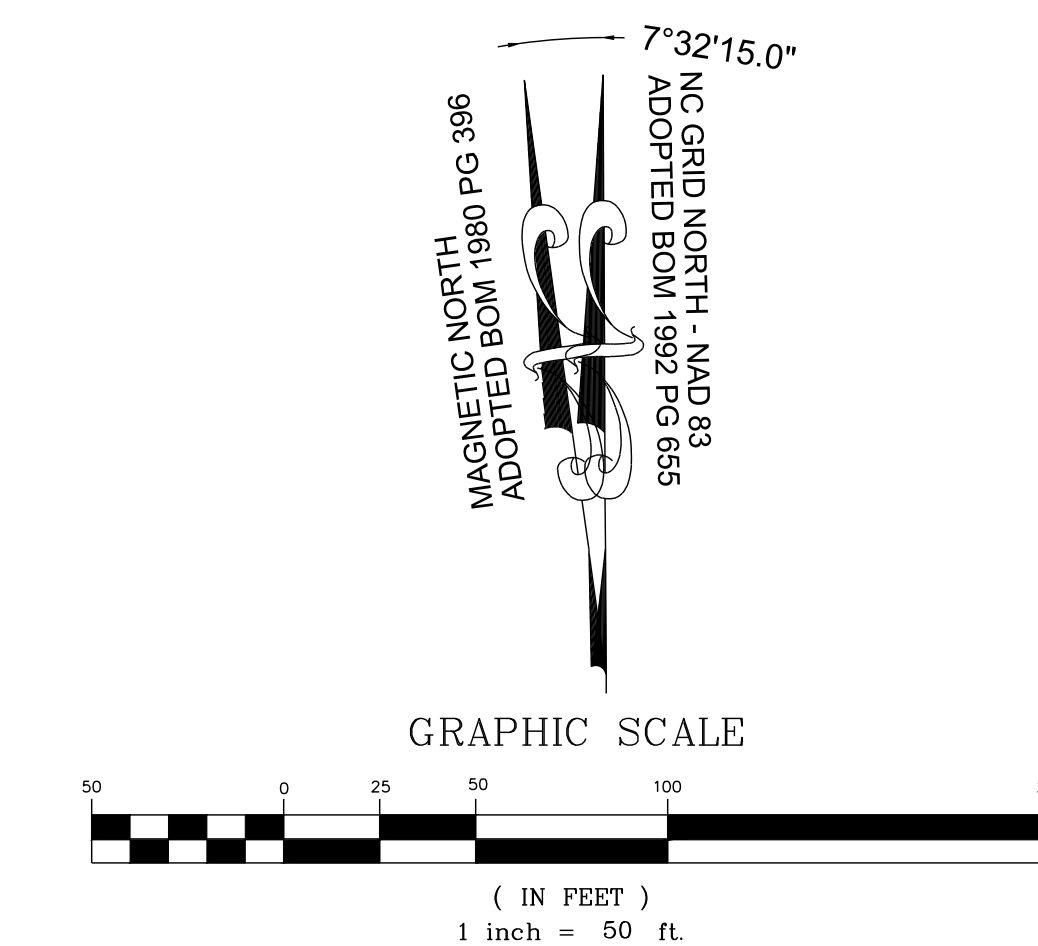

SITE KEY PLAN
LEGEND

THIS PLANSET AND ANY ASSOCIATED DOCUMENTS ARE PRELIMINARY AND NOT AUTHORIZED FOR CONSTRUCTION UNTIL SIGNED, DATED, AND OFFICIALLY RELEASED FOR CONSTRUCTION BY THE ENGINEER OF RECORD.

SEAL:

CONSTRUCTION INFRASTRUCTURE DRAWINGS
CID-34-04

01

02

03

CONSTRUCTION INFRASTRUCTURE DRAWINGS
CID-34-04

01

02

03



455

456


457

458

459

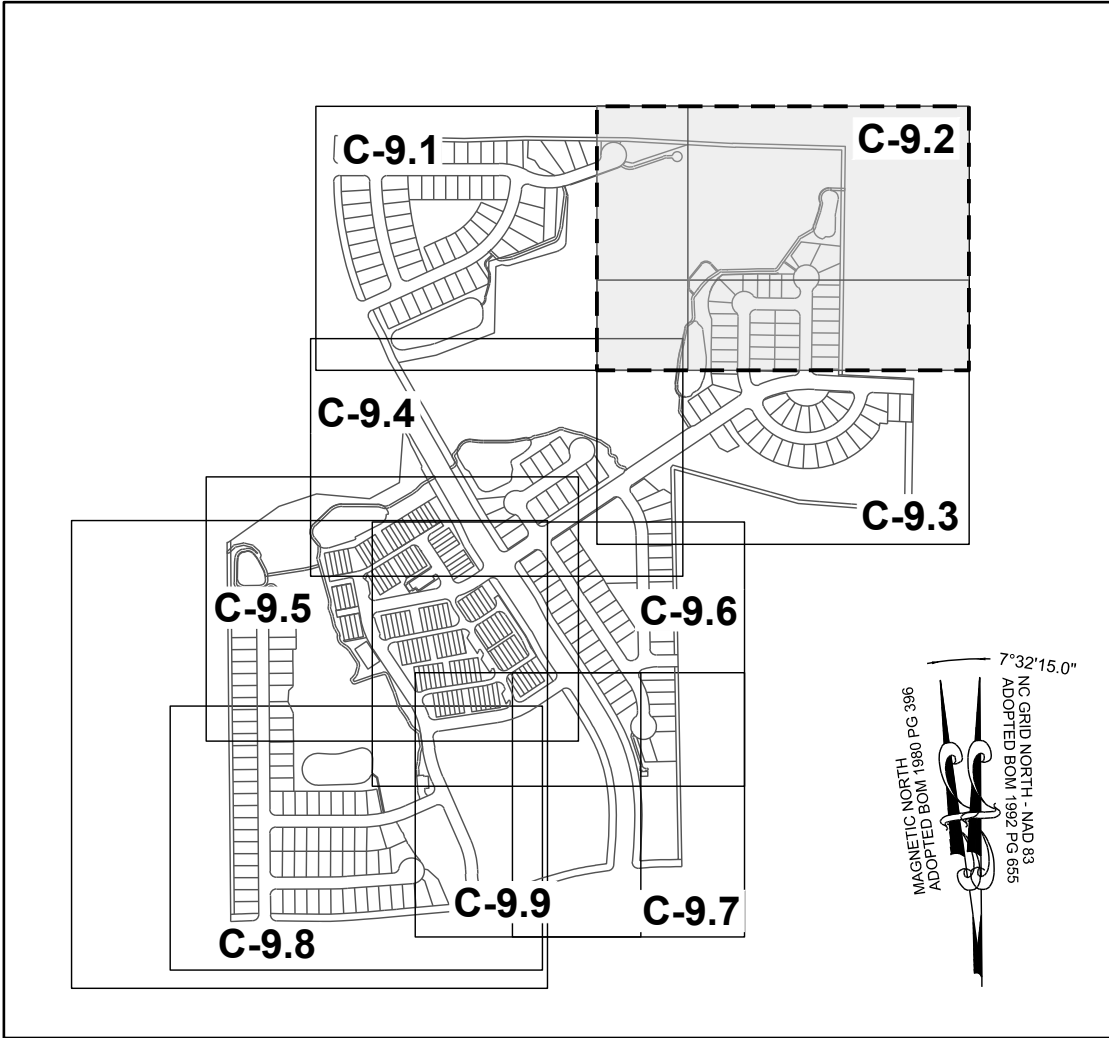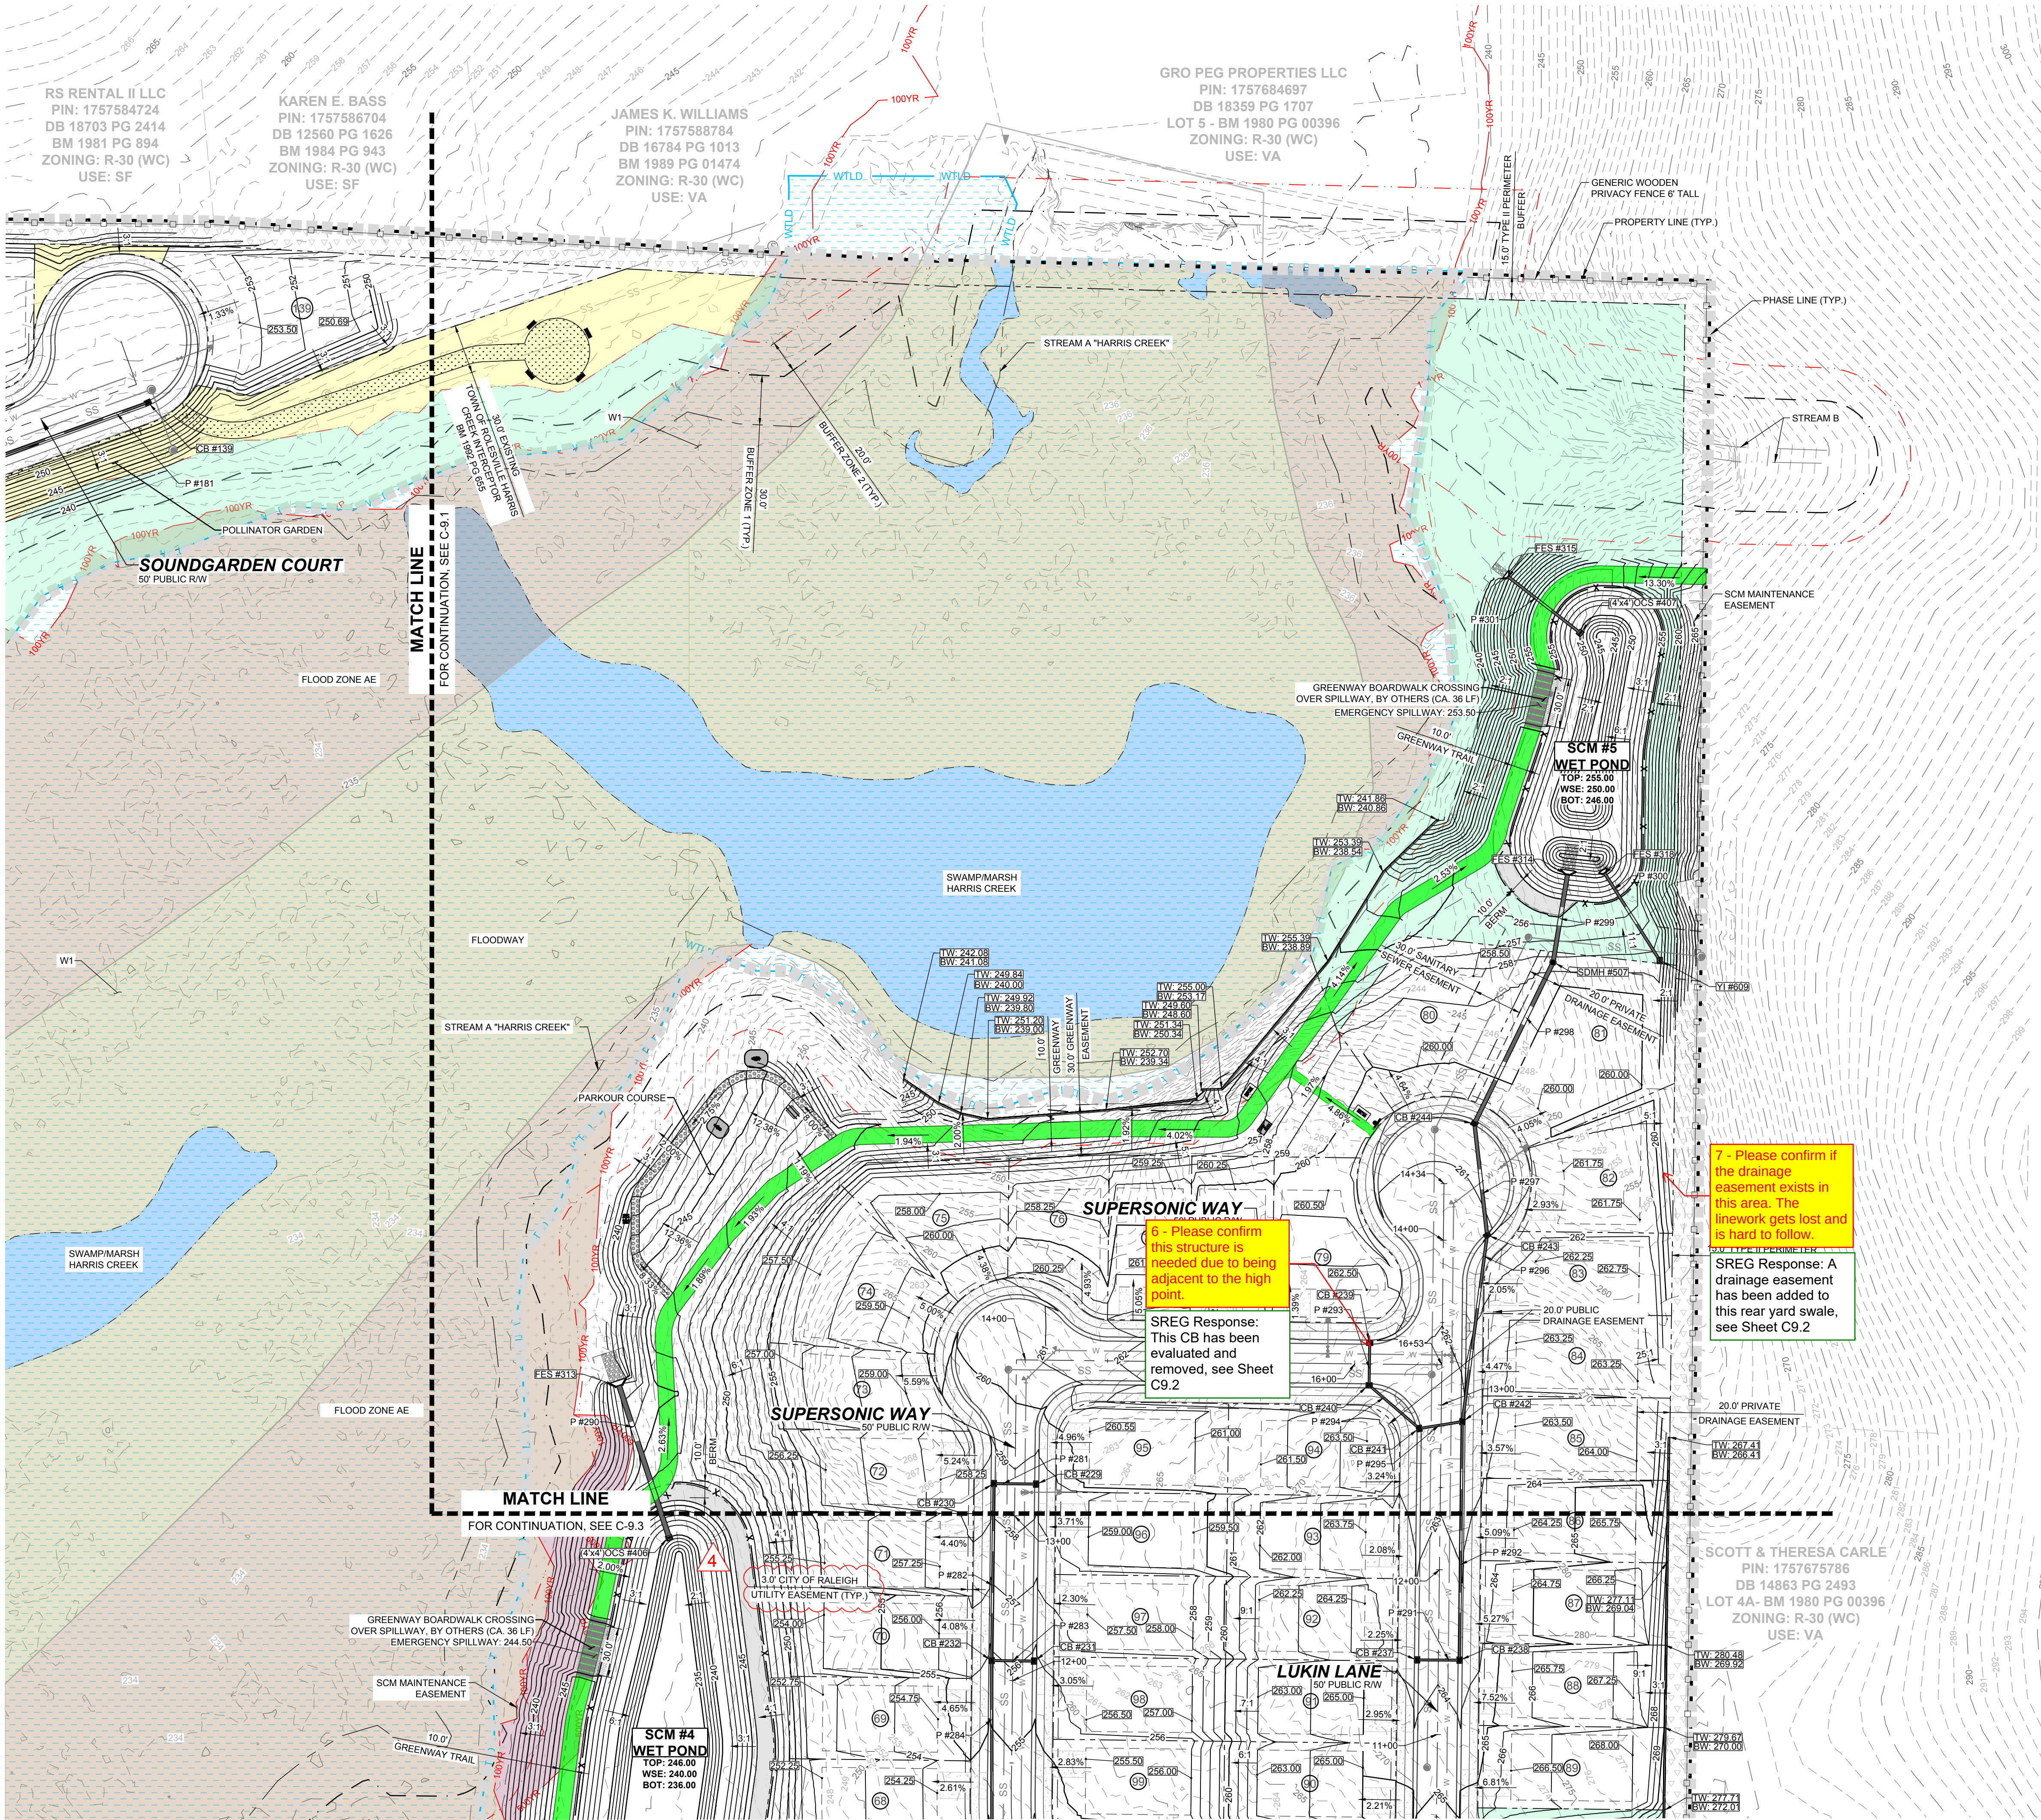

SITE KEY PLAN
LEGEND
SEE SHEET C-9.0 FOR LEGEND

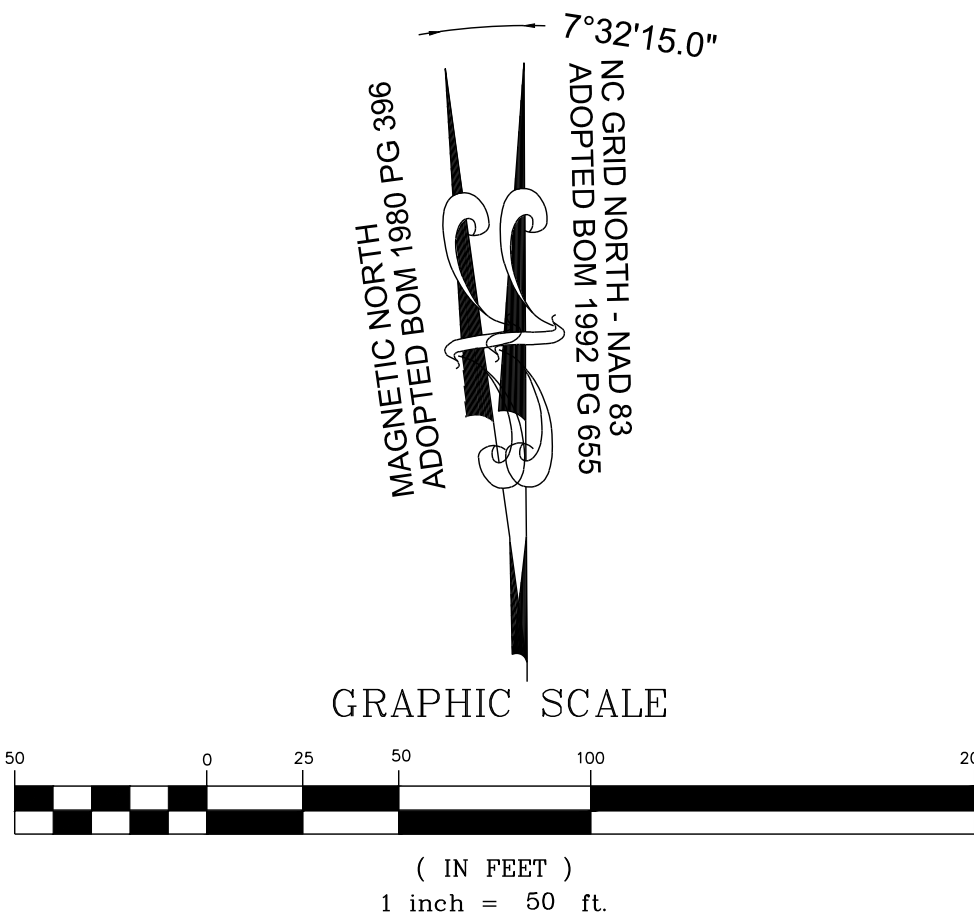

THIS PLANSET AND ANY ASSOCIATED DOCUMENTS ARE PRELIMINARY AND NOT AUTHORIZED FOR CONSTRUCTION UNTIL SIGNED, DATED, AND OFFICIALLY RELEASED FOR CONSTRUCTION BY THE ENGINEER OF RECORD.

STRONGROCK

ENGINEERING GROUP

STRONG ROCK ENGINEERING GROUP, PLLC | COMPANY LICENSE # P-2166
305 CHURCH AT NORTH HILLS STREET, SUITE 1110 RALEIGH, NC 27609 | INFORMATION@STRONGROCKGROUP.COM

STRONG ROCK PROJECT
PSP-24-03

NOT FOR CONSTRUCTION

SCALE AS SHOWN

DESIGNED BY SRG

DRAWN BY SRG

CHECKED BY SRG

RESERVE @ MITCHELL MILL
TOWN OF ROLESVILLE, WAKE COUNTY, NORTH CAROLINA

CONSTRUCTION PLANS
PARTIAL GRADING AND DRAINAGE PLAN II

DRAWING SHEET
C-9.2

49 OF 227

CONSTRUCTION INFRASTRUCTURE DRAWINGS
CID-24-04

TOWN OF ROLESVILLE CID-24-04 V2
11/07/2024

TOWN OF ROLESVILLE CID-24-04 V3
02/07/2024

TOWN OF ROLESVILLE CID-24-04 V4
08/02/2025

SEAL:

01

02

03



04

NO.



REVISIONS

DATE

BY

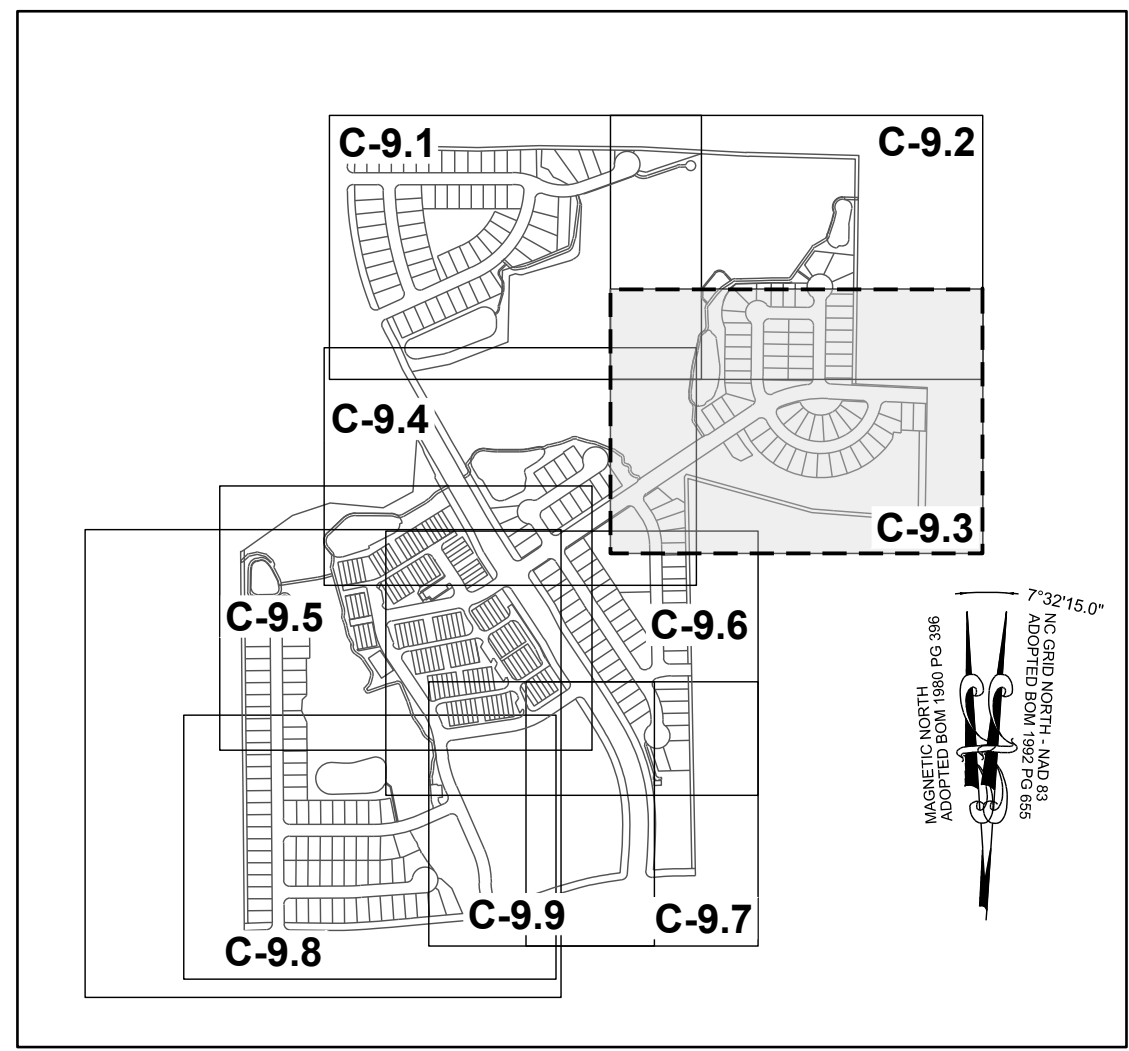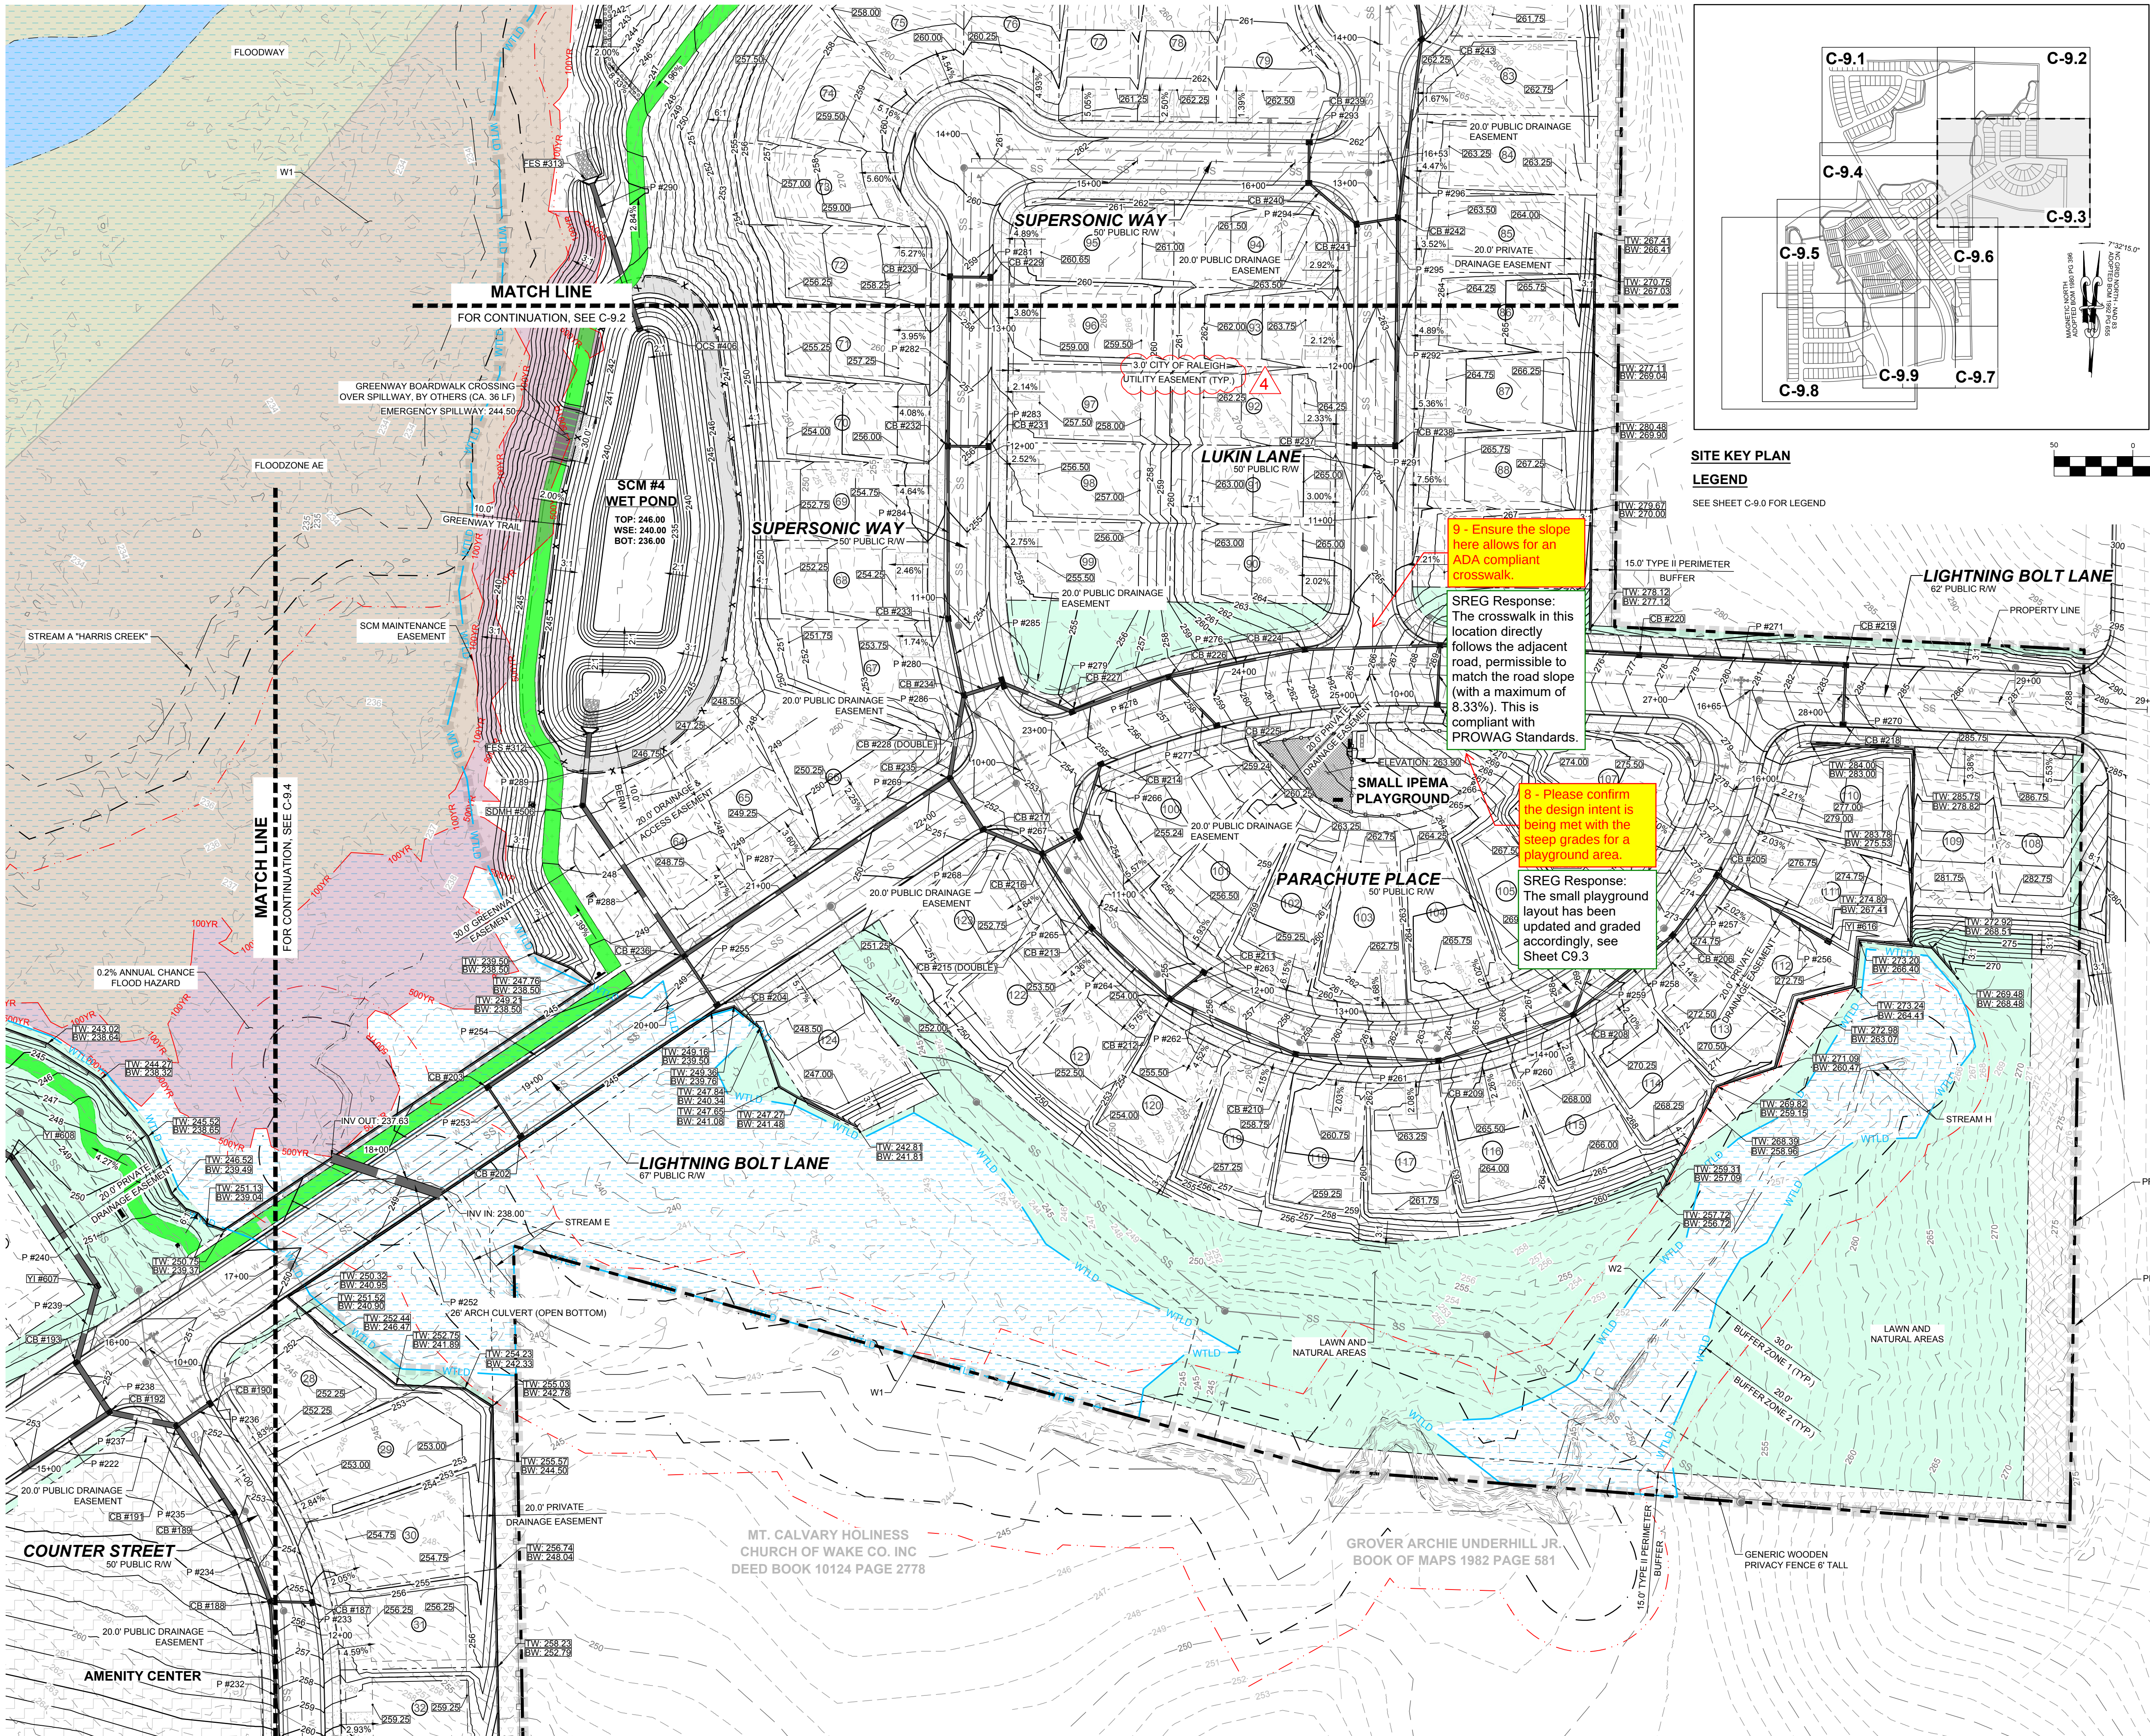

SITE KEY PLAN
LEGEND
SEE SHEET C-9.0 FOR LEGEND

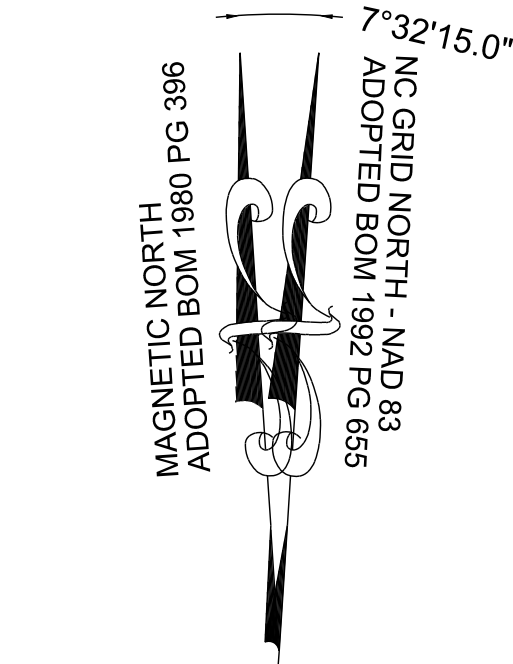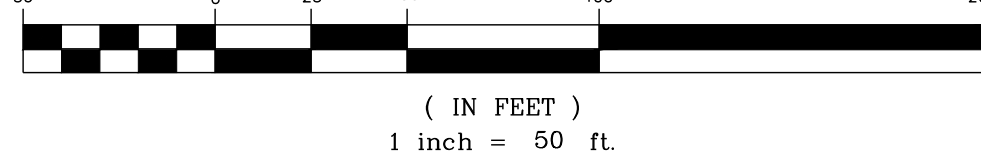

GRAPHIC SCALE

9 - Ensure the slope here allows for an ADA compliant crosswalk.

SREG Response: The crosswalk in this location directly follows the adjacent road, permissible to match the road slope (with a maximum of 8.33%). This is compliant with PROWAG Standards.

8 - Please confirm the design intent is being met with the steep grades for a playground area.

SREG Response: The small playground layout has been updated and graded accordingly, see Sheet C9.3

STRONGROCK

ENGINEERING GROUP

RESERVE @ MITCHELL MILL

TOWN OF ROLESVILLE, WAKE COUNTY, NORTH CAROLINA

CONSTRUCTION PLANS

PARTIAL GRADING AND DRAINAGE PLAN III

DRAWING SHEET

C-9.3

50 OF 227

CONSTRUCTION INFRASTRUCTURE DRAWINGS

01

02

03



1393

1394

1395

1396

STATES INTERNAL TOWNHOME DRIVEWAYS ARE PRIVATE EASEMENTS AS PER CITY OF RALEIGH
PUBLIC UTILITIES DEPARTMENT

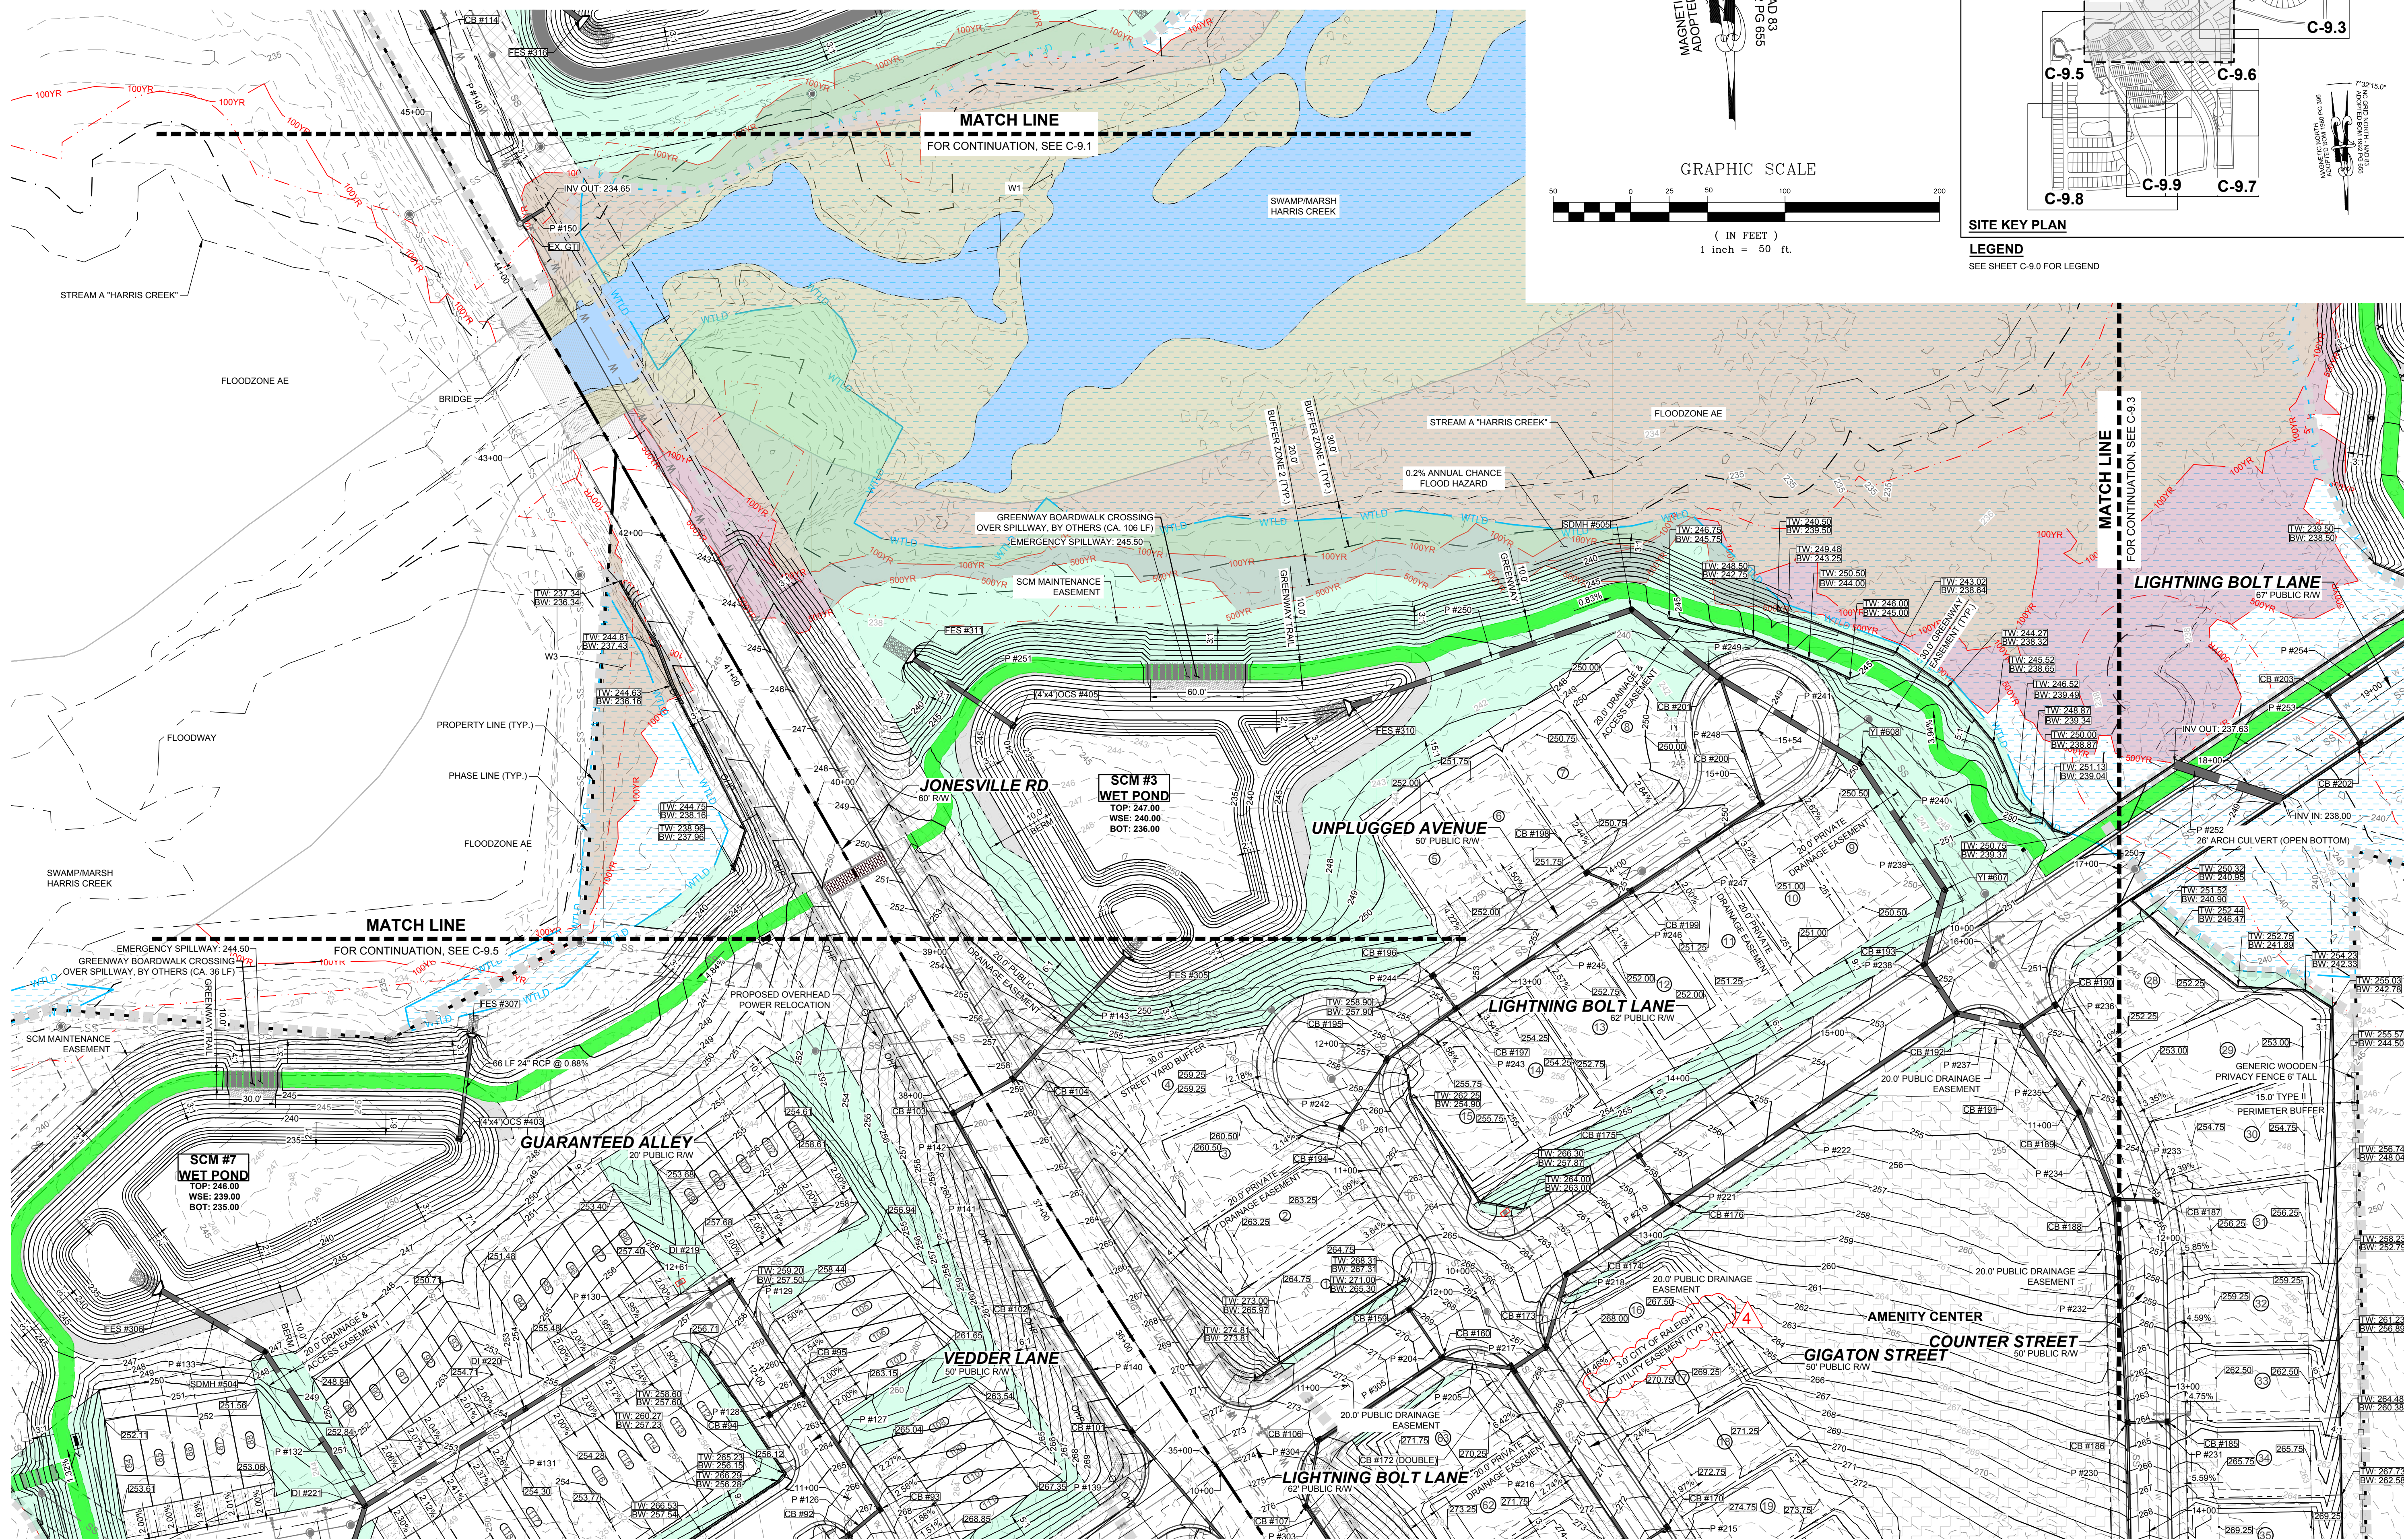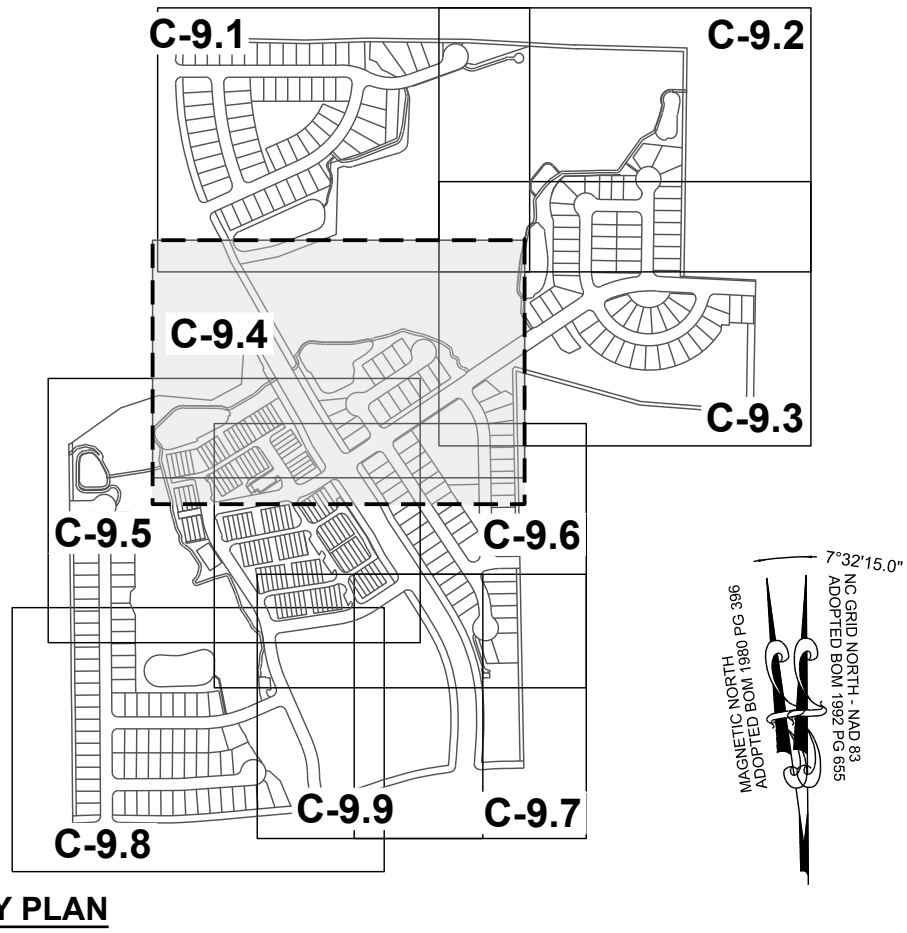

THIS PLANSET AND ANY ASSOCIATED DOCUMENTS ARE PRELIMINARY AND NOT AUTHORIZED FOR CONSTRUCTION UNTIL SIGNED, DATED, AND OFFICIALLY RELEASED FOR CONSTRUCTION BY THE ENGINEER OF RECORD.


STRONGROCK
ENGINEERING GROUP

STRONG ROCK ENGINEERING GROUP, PLLC | COMPANY LICENSE # P-2186
35 CHURCH AT NORTH HILLS STREET, SUITE 110 RALEIGH, NC 27609 | INFORMATION@STRONGROCKGROUP.COM

**RESERVE @ MITCHELL MILL
TOWN OF ROLESVILLE, WAKE COUNTY, NORTH CAROLINA
CONSTRUCTION PLANS
PARTIAL GRADING AND
DRAINAGE PLAN IV**

DRAWING
SHEET

C-9.4

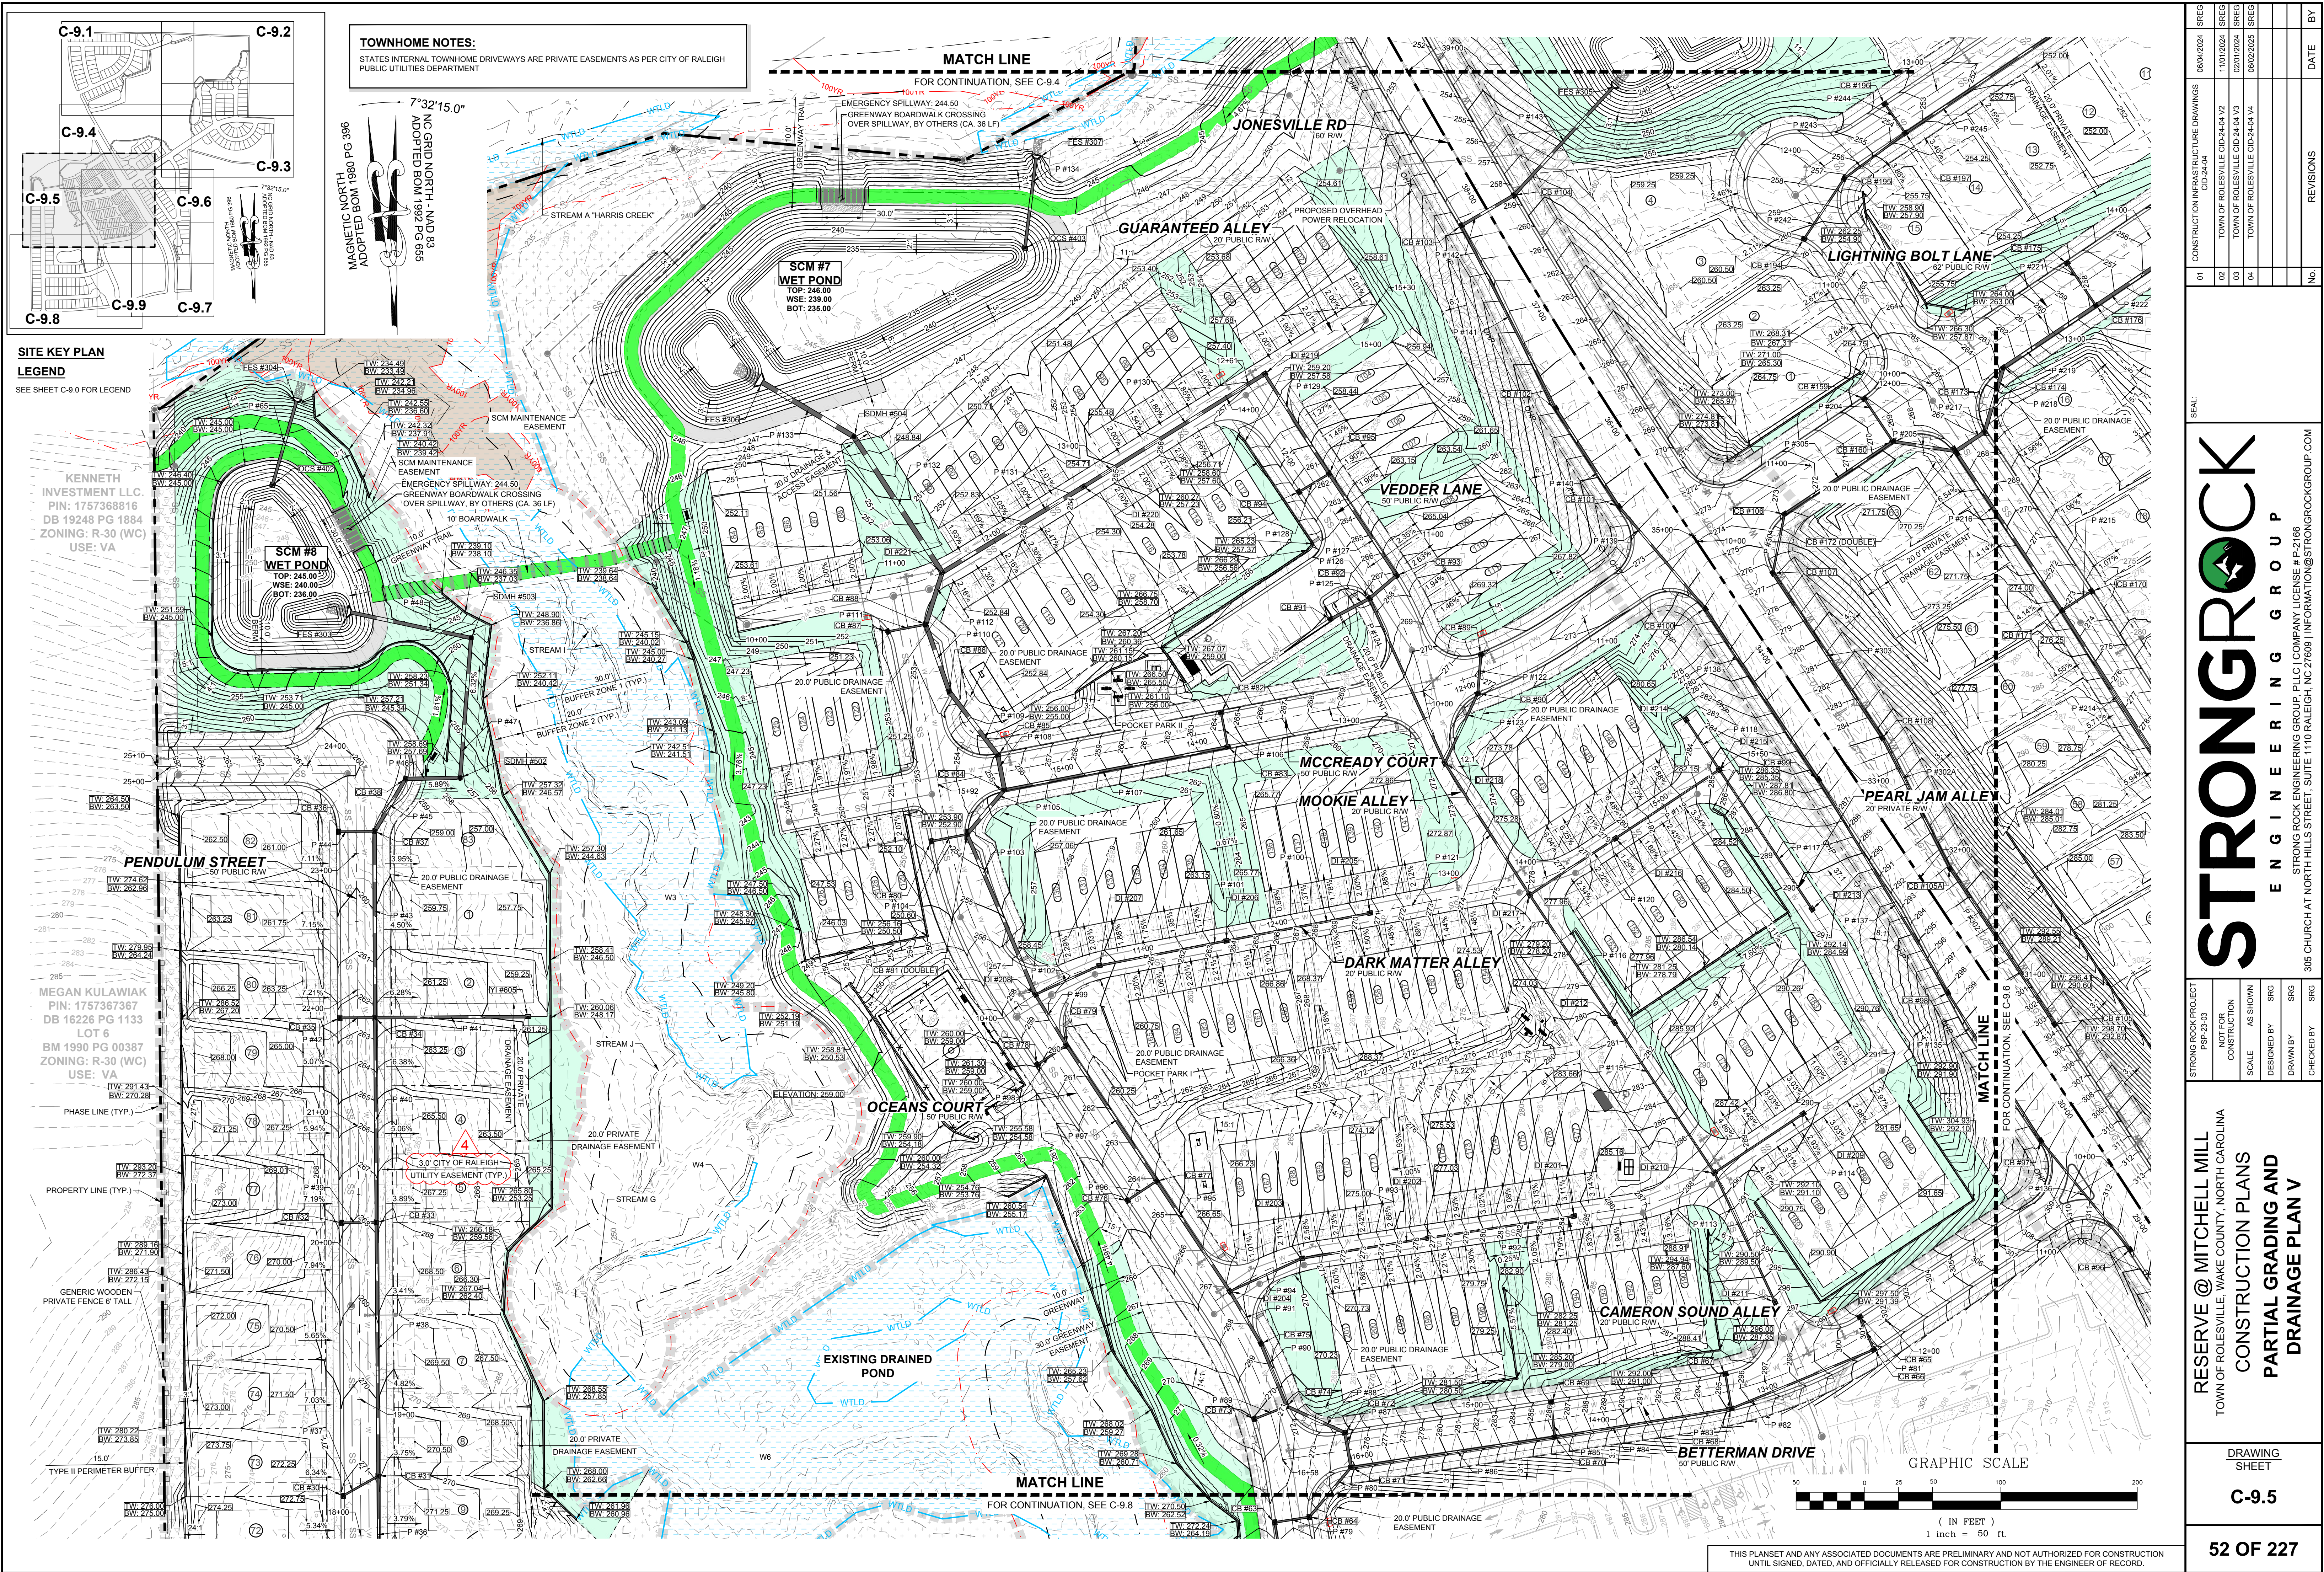



TOWNHOME NOTES:
STATES INTERNAL TOWNHOME DRIVEWAYS ARE PRIVATE EASEMENTS AS PER CITY OF RALEIGH PUBLIC UTILITIES DEPARTMENT

SITE KEY PLAN
LEGEND
SEE SHEET C-9.0 FOR LEGEND

MAGNETIC NORTH 1980 PG 396
ADOPTED BOM 1992 PG 655

7°32'15.0"

GRAPHIC SCALE
1 inch = 50 ft.

MATCH LINE
FOR CONTINUATION, SEE C-9.8

MATCH LINE
FOR CONTINUATION, SEE C-9.7

GENERIC WOODEN PRIVATE FENCE 6' TALL

15.0' TYPE II PERIMETER BUFFER

PROPERTY LINE (TYP.)

PHASE LINE (TYP.)

CRICKET PITCH

STRONGROCK
ENGINEERING GROUP

STRONG ROCK ENGINEERING GROUP, PLLC | COMPANY LICENSE # P-2766
305 CHURCH AT NORTH HILLS STREET, SUITE 1110 RALEIGH, NC 27609 | INFORMATION@STRONGROCKGROUP.COM



STRONG ROCK PROJECT	NOT FOR CONSTRUCTION	SCALE AS SHOWN	DESIGNED BY	DRAWN BY	CHECKED BY
PSP-23-03			SRG	SRG	SRG

RESERVE @ MITCHELL MILL
TOWN OF ROLESVILLE, WAKE COUNTY, NORTH CAROLINA
CONSTRUCTION PLANS
PARTIAL GRADING AND DRAINAGE PLAN VI


DRAWING SHEET
C-9.6

53 OF 227

CONSTRUCTION INFRASTRUCTURE DRAWINGS	01	02	03	04	NO.	REVISIONS	DATE	BY
SRG								
SRG								
SRG								
SRG								

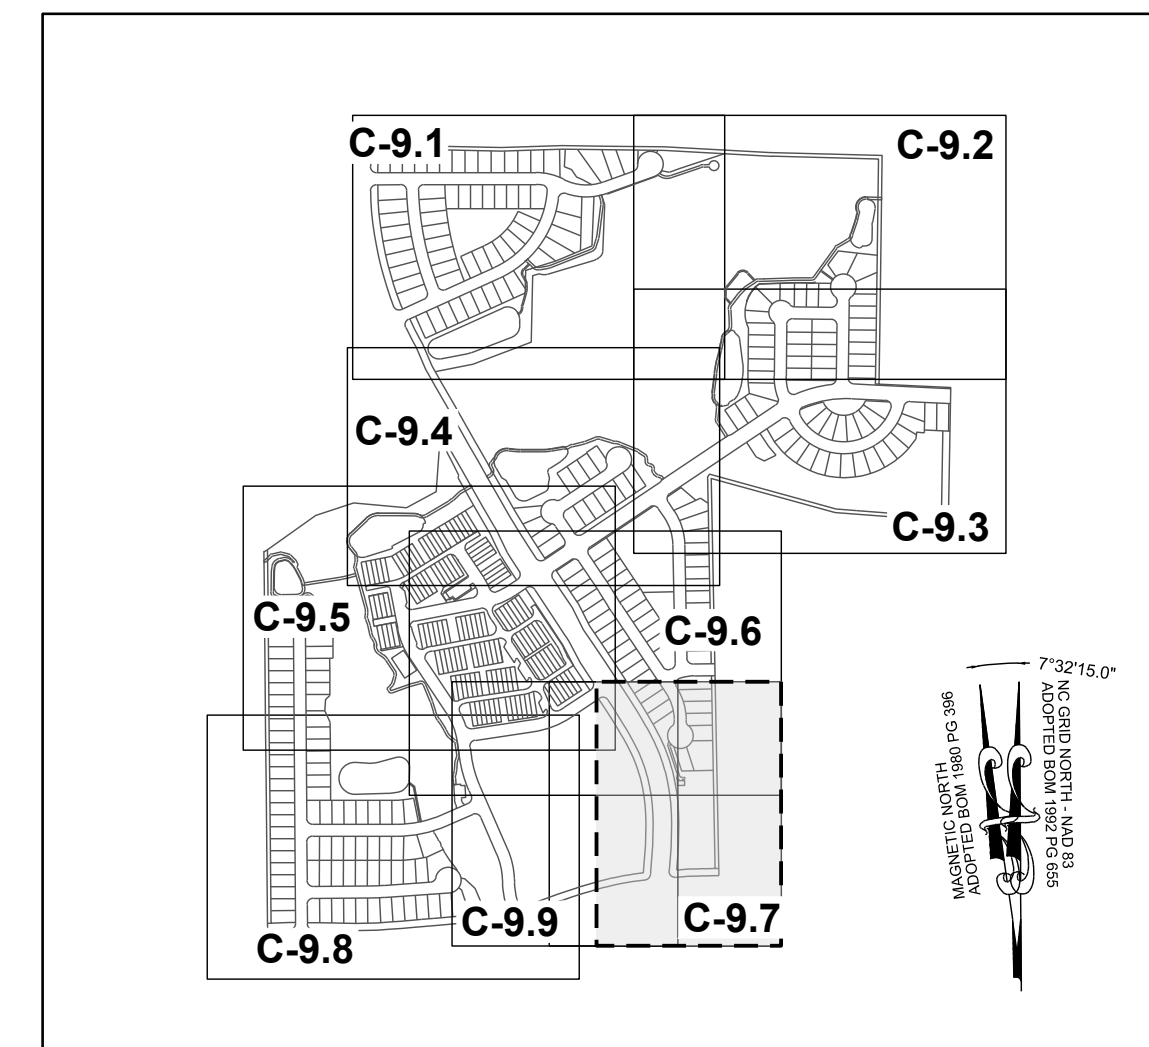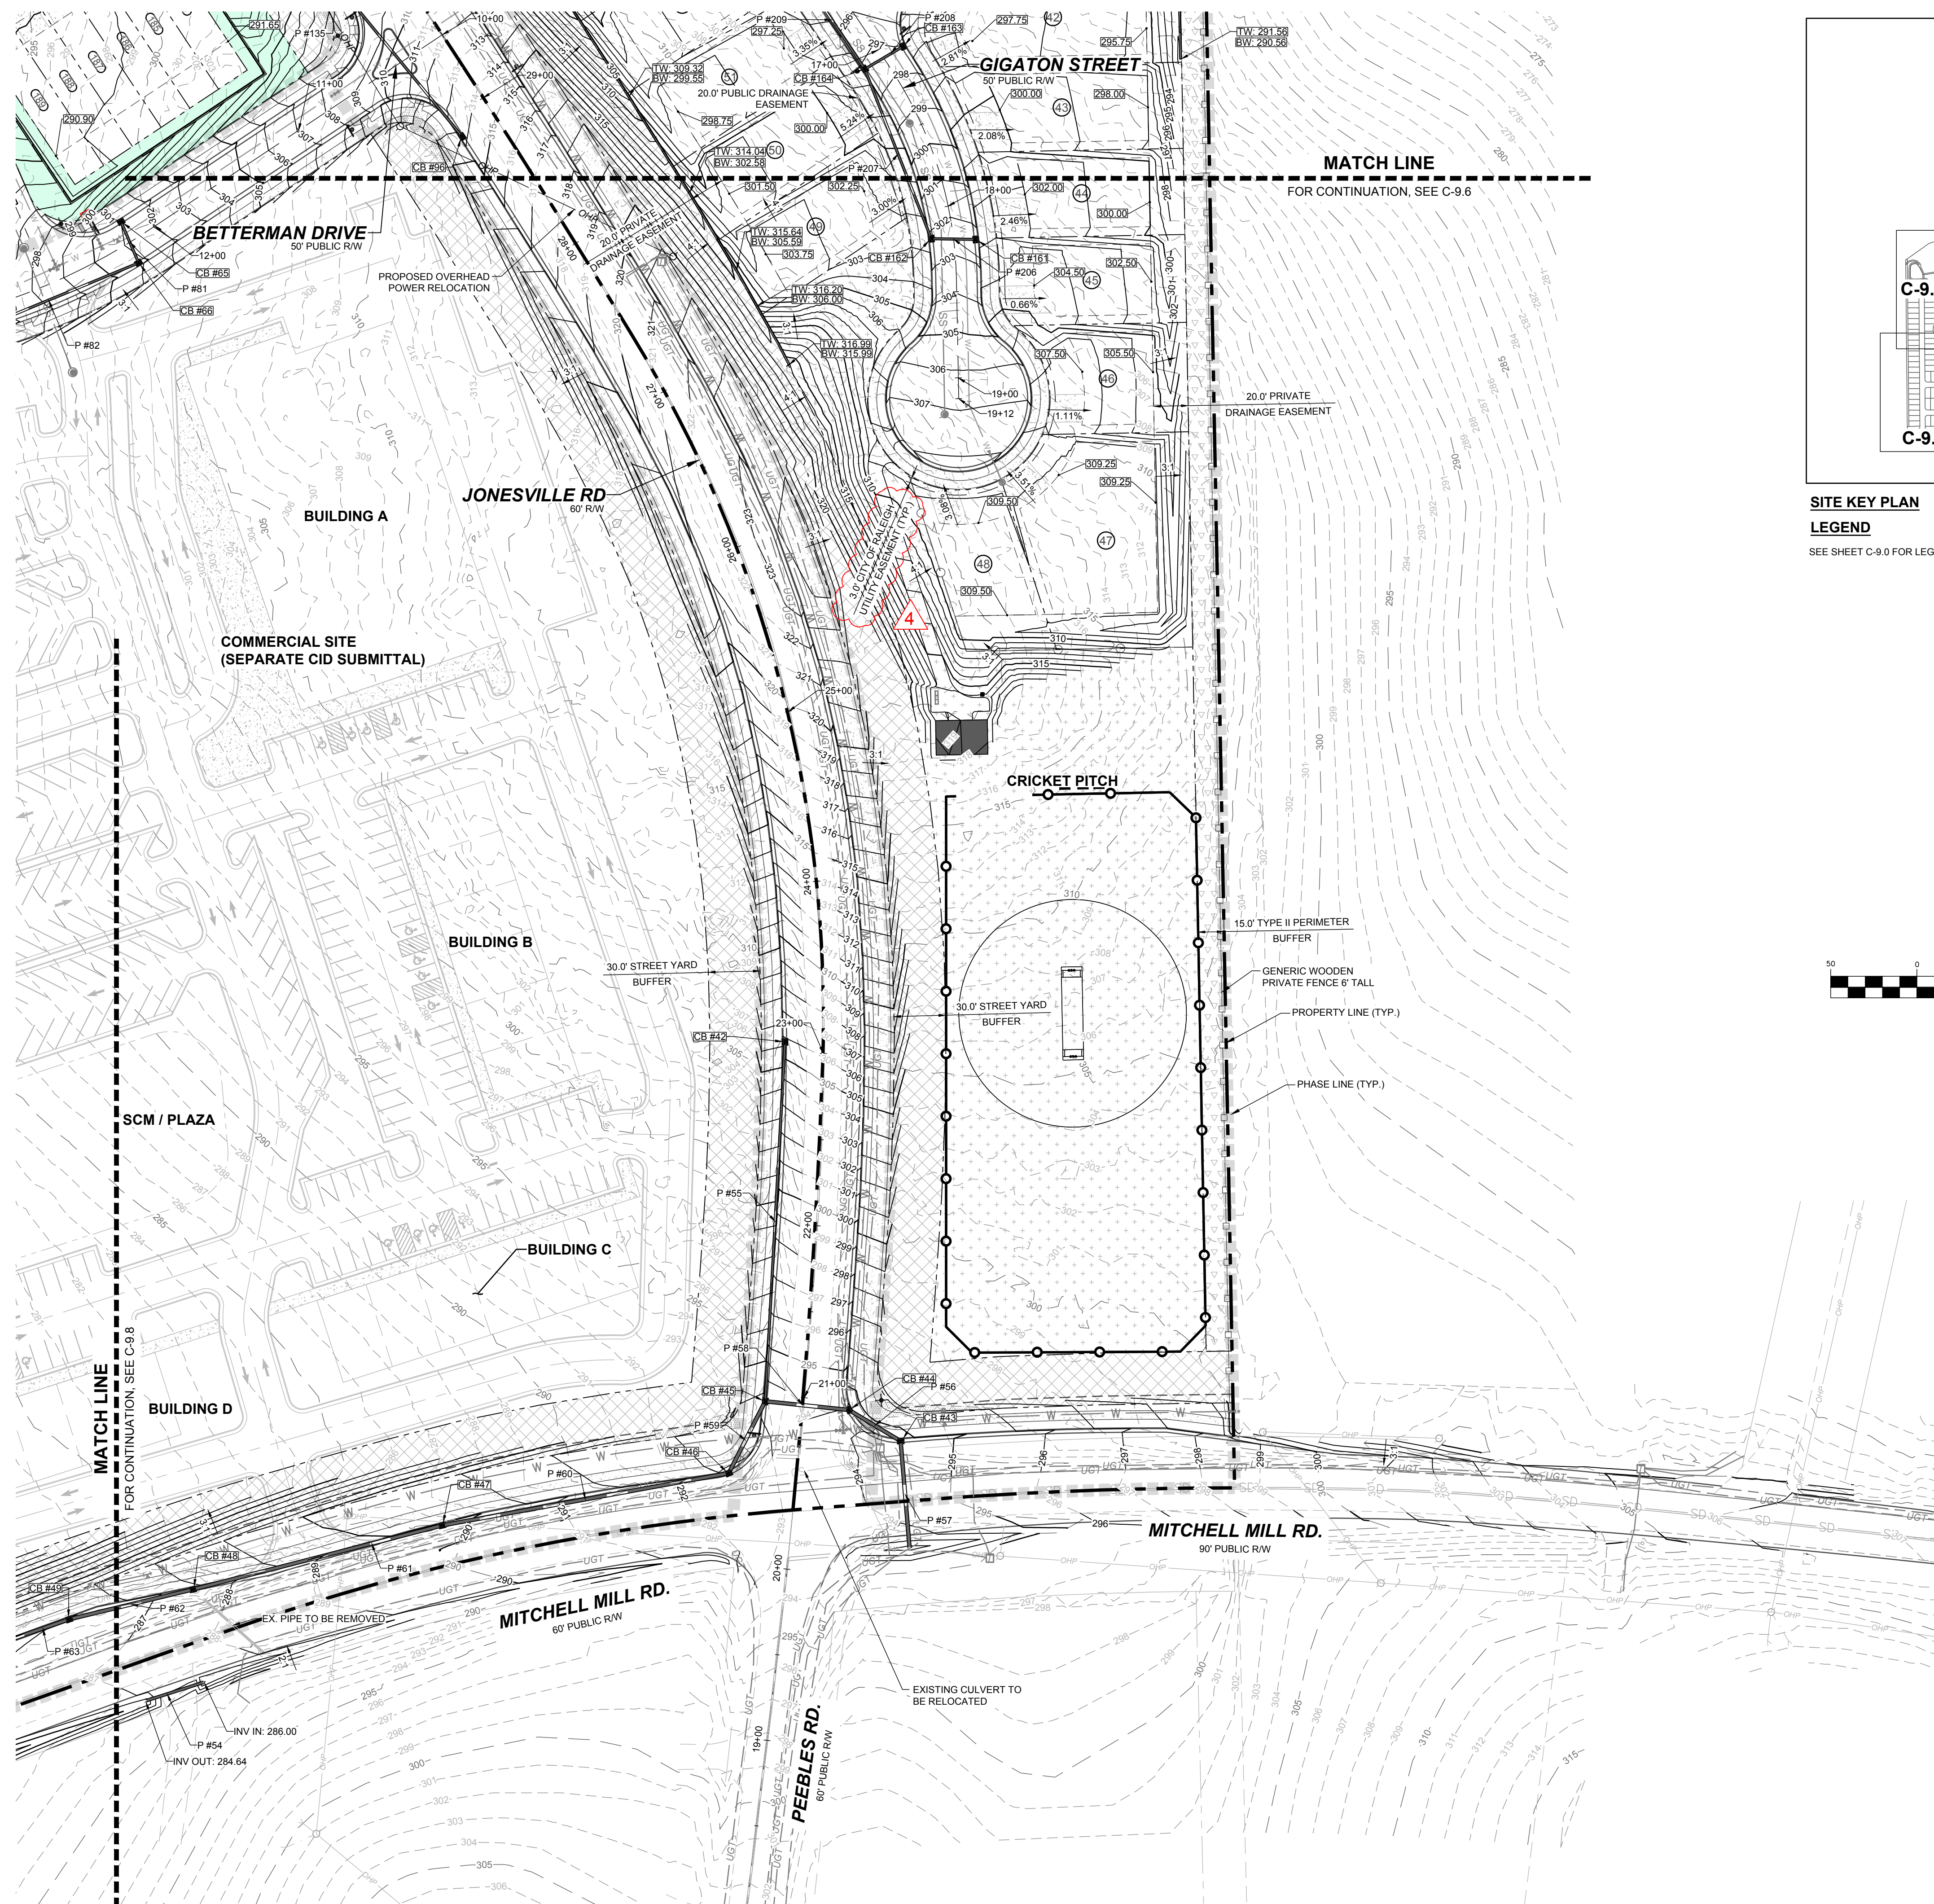

SITE KEY PLAN
LEGEND
SEE SHEET C-9.0 FOR LEGEND

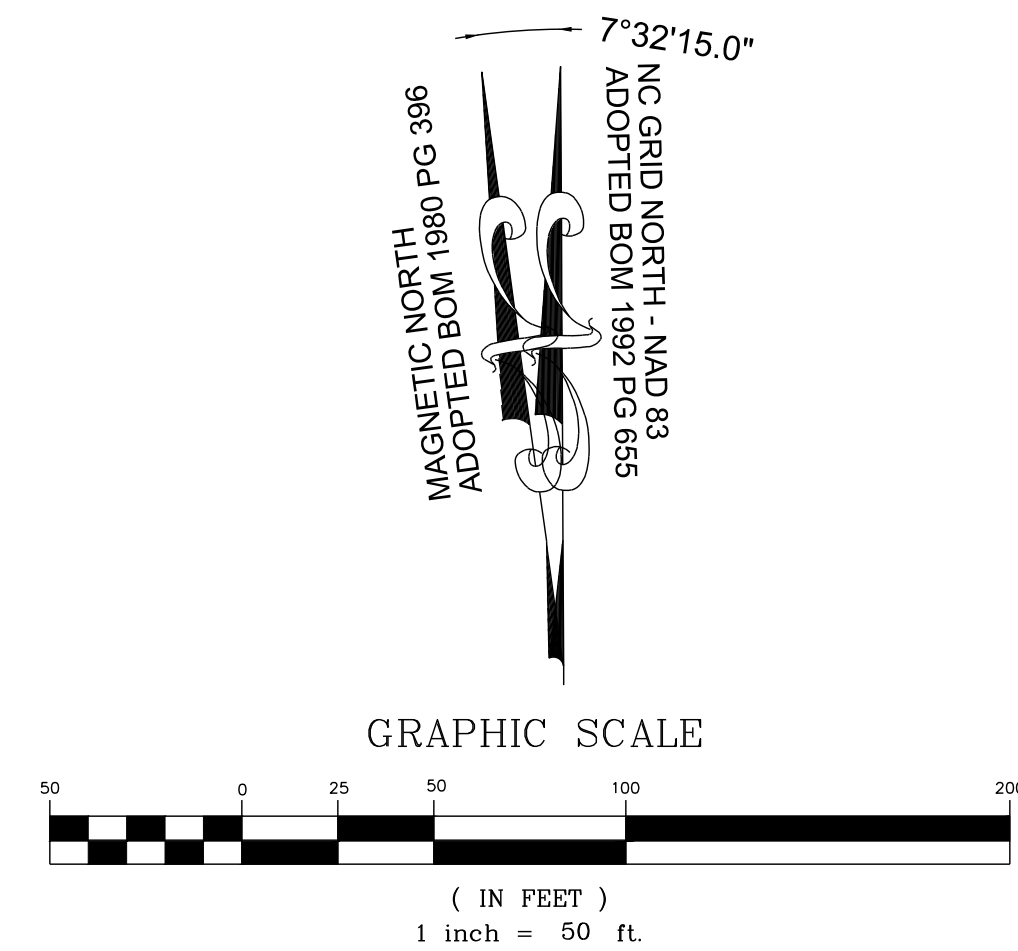

54 OF 227		C-9.7		DRAWING SHEET		RESERVE @ MITCHELL MILL TOWN OF ROLESVILLE, WAKE COUNTY, NORTH CAROLINA CONSTRUCTION PLANS PARTIAL GRADING AND DRAINAGE PLAN VII		STRONG PROJECT PSP-23-03 NOT FOR CONSTRUCTION SCALE AS SHOWN DESIGNED BY SRG DRAWN BY SRG CHECKED BY SRG STRONG ROCK ENGINEERING GROUP STRONG ROCK ENGINEERING GROUP, PLLC COMPANY LICENSE # P-2166 305 CHURCH AT NORTH HILLS STREET, SUITE 1110 RALEIGH, NC 27609 INFORMATION@STRONGROCKGROUP.COM SEAL: <table><tr><td>01</td><td>CONSTRUCTION INFRASTRUCTURE DRAWINGS CID-24-04</td><td>SRG</td><td>06/04/2024</td></tr><tr><td>02</td><td>TOWN OF ROLESVILLE CID-24-04 V2</td><td>SRG</td><td>11/01/2024</td></tr><tr><td>03</td><td>TOWN OF ROLESVILLE CID-24-04 V3</td><td>SRG</td><td>02/01/2024</td></tr><tr><td>04</td><td>TOWN OF ROLESVILLE CID-24-04 V4</td><td>SRG</td><td>06/02/2025</td></tr><tr><td></td><td></td><td></td><td></td></tr><tr><td></td><td></td><td></td><td></td></tr><tr><td>No.</td><td>REVISIONS</td><td>DATE</td><td>BY</td></tr></table>		01	CONSTRUCTION INFRASTRUCTURE DRAWINGS CID-24-04	SRG	06/04/2024	02	TOWN OF ROLESVILLE CID-24-04 V2	SRG	11/01/2024	03	TOWN OF ROLESVILLE CID-24-04 V3	SRG	02/01/2024	04	TOWN OF ROLESVILLE CID-24-04 V4	SRG	06/02/2025									No.	REVISIONS	DATE	BY
01	CONSTRUCTION INFRASTRUCTURE DRAWINGS CID-24-04	SRG	06/04/2024																																		
02	TOWN OF ROLESVILLE CID-24-04 V2	SRG	11/01/2024																																		
03	TOWN OF ROLESVILLE CID-24-04 V3	SRG	02/01/2024																																		
04	TOWN OF ROLESVILLE CID-24-04 V4	SRG	06/02/2025																																		
No.	REVISIONS	DATE	BY																																		

10 - Please confirm this drainage easement is still required.

SREG Response: This drainage easement has been removed, see Sheet C9.8

USE: SF

BERNARD MILLER
PIN: 1757357865
DB 15416 PG 1651
LOT 4
BM 1990 PG 956
ZONING: R-30 (WC)
USE: SF

TOUTLOFF, KENNETH
S. TOUTLOFF, BILLIE ANNE
PIN: 1757357764
DB 9236 PG 2229
LOT 3
BM 1990 PG 956
ZONING: R-30 (WC)
USE: SF

GENERIC WOODEN
PRIVATE FENCE 6' TALL

PROPERTY LINE (TYP.)

PHASE LINE (TYP.)

PERR Y,ELWOOD
RYAN
PIN: 1757357582
DB 19292 PG 2780
ZONING: R-30 (WC)
USE: MO

PHETIS JONES BRADSHER
PIN: 1757349473
DB 15208 PG 2320
ZONING: R-30 (WC)
USE: FO

MITCHELL MILL RD.
60' PUBLIC R/W

PHETIS JONES
BRADSHER
PIN: 1757349473
DB 15208 PG 2320
BM 2013 PG 868
ZONING: R-30 (WC)
USE: FO


MAGNETIC NORTH
ADOPED BOM 1980 PG 396
NC GRID NORTH - NAD 83
ADOPED BOM 1992 PG 655

GRAPHIC SCALE



(IN FEET)
1 inch = 50 ft.

THIS PLANSET AND ANY ASSOCIATED DOCUMENTS ARE PRELIMINARY AND NOT AUTHORIZED FOR CONSTRUCTION UNTIL SIGNED, DATED, AND OFFICIALLY RELEASED FOR CONSTRUCTION BY THE ENGINEER OF RECORD.

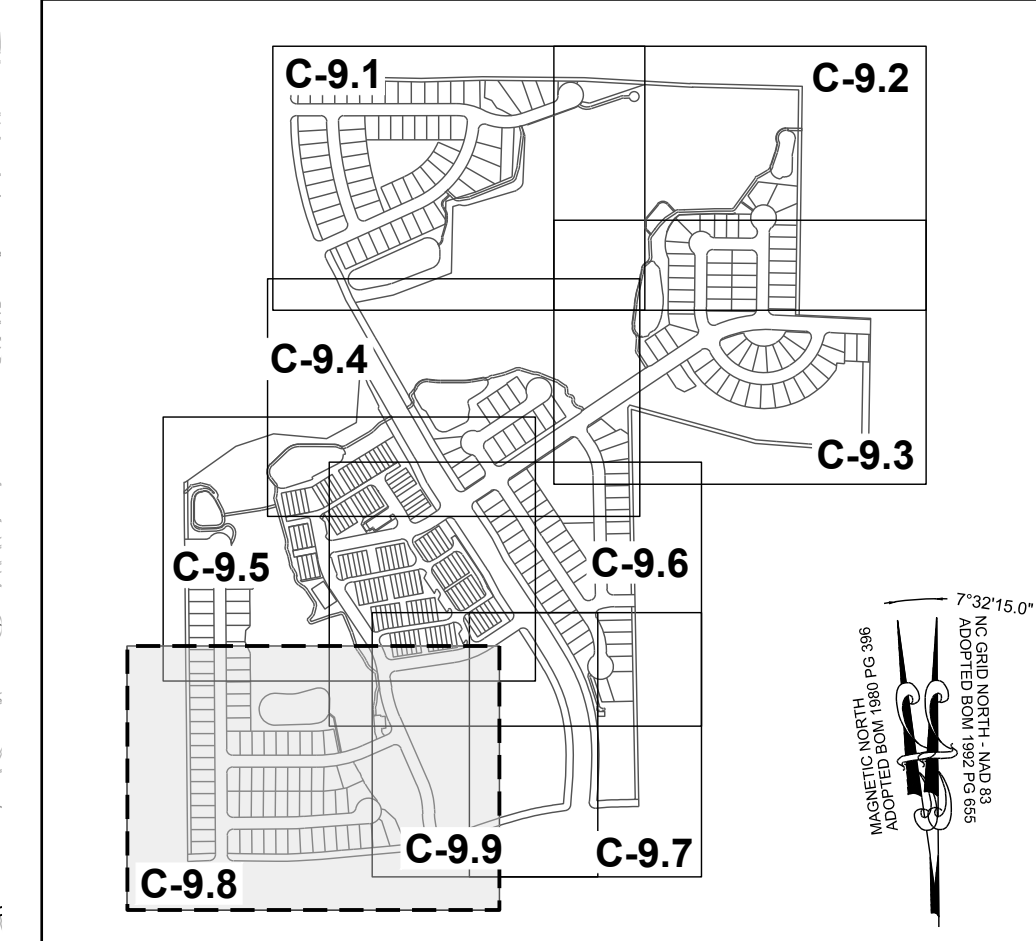

SITE KEY PLAN
LEGEND

SEE SHEET C-9.0 FOR LEGEND

MATCH LINE
FOR CONTINUATION, SEE C-8.7

CONSTRUCTION INFRASTRUCTURE DRAWINGS	DATE	BY
01	08/04/2024	SREG
02	11/01/2024	SREG
03	02/01/2024	SREG
04	08/02/2025	SREG

SEAL:

STRONGROCK
ENGINEERING GROUP

STRONG ROCK ENGINEERING GROUP, PLLC | COMPANY LICENSE # P-2166
305 CHURCH AT NORTH HILLS STREET, SUITE 1110 RALEIGH, NC 27609 | INFORMATION@STRONGROCKGROUP.COM

STRONG ROCK PROJECT	NOT FOR CONSTRUCTION	SCALE	AS SHOWN	SRG	SRG	SRG
PSP-24-03						

RESERVE @ MITCHELL MILL
TOWN OF ROLESVILLE, WAKE COUNTY, NORTH CAROLINA
CONSTRUCTION PLANS
PARTIAL GRADING AND
DRAINAGE PLAN VIII


DRAWING
SHEET

C-9.8



TOWNHOME NOTES:


STATES INTERNAL TOWNHOME DRIVEWAYS ARE PRIVATE EASEMENTS AS PER CITY OF RALEIGH
PUBLIC UTILITIES DEPARTMENT

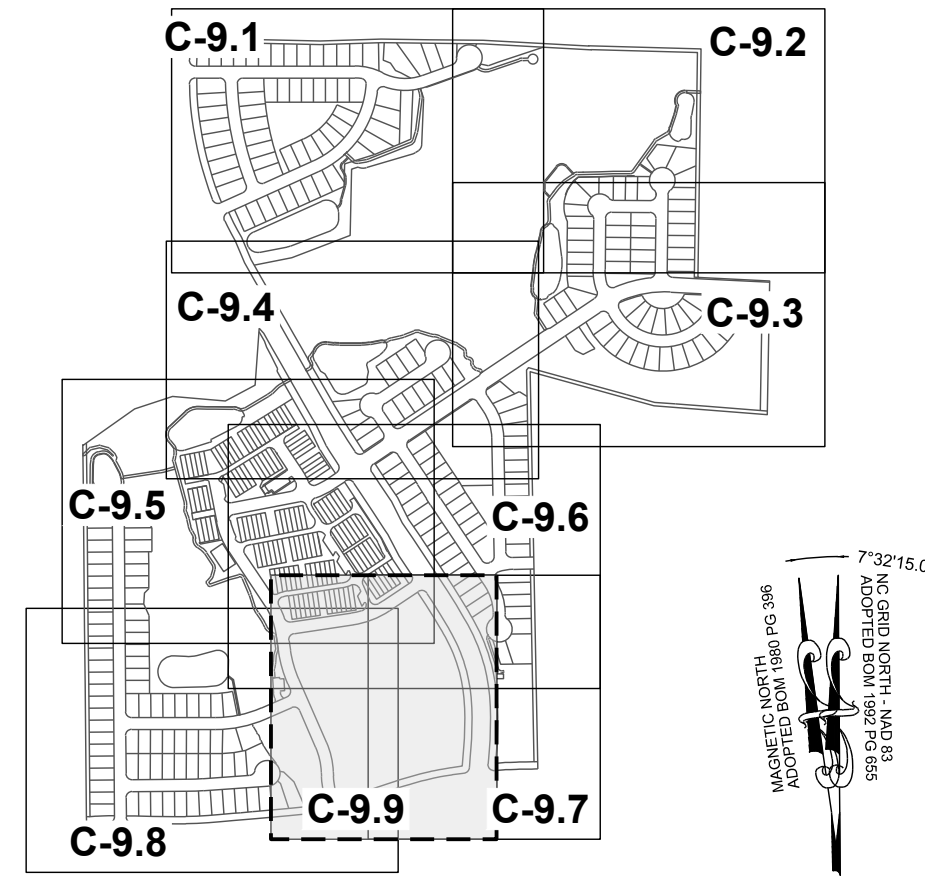

SITE KEY PLAN

LEGEND

SEE SHEET C-9.0 FOR LEGEND

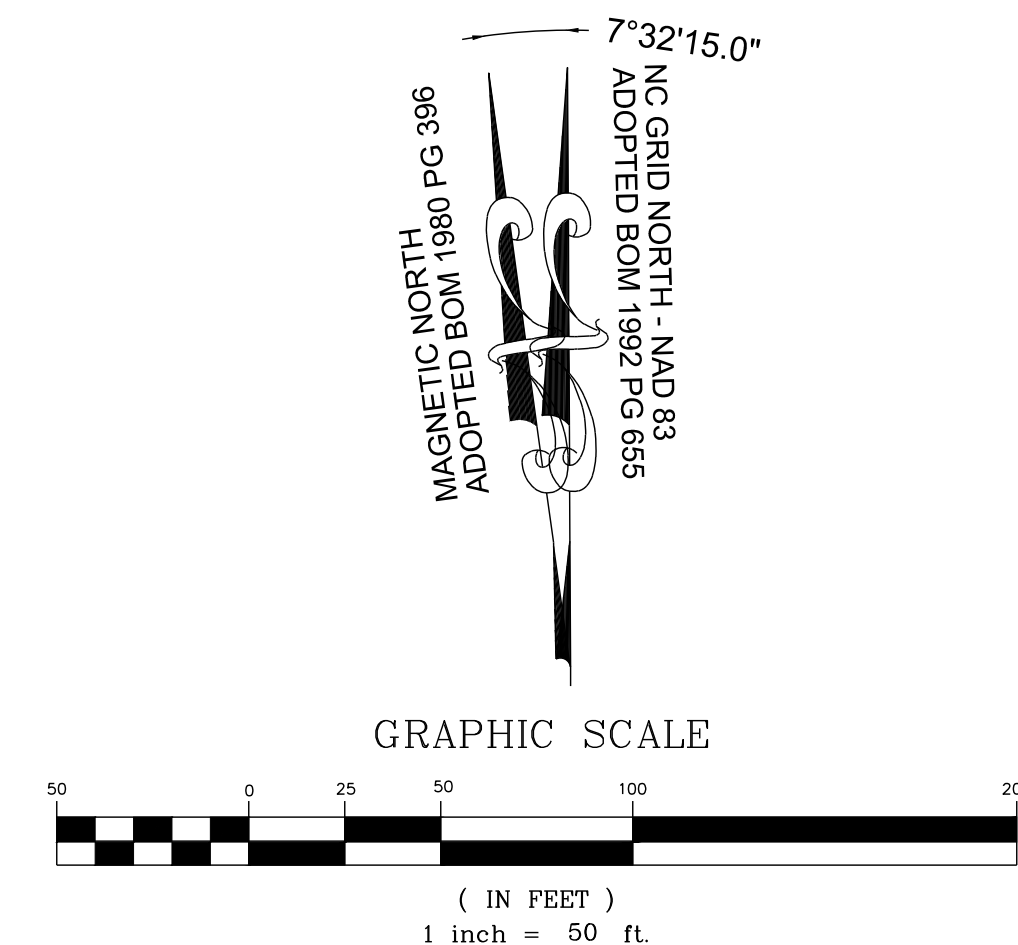

THIS PLANSET AND ANY ASSOCIATED DOCUMENTS ARE PRELIMINARY AND NOT AUTHORIZED FOR CONSTRUCTION UNTIL SIGNED, DATED, AND OFFICIALLY RELEASED FOR CONSTRUCTION BY THE ENGINEER OF RECORD.

		CONSTRUCTION INFRASTRUCTURE DRAWINGS CID-24-04	06/04/2024	\$REG
01				
02		TOWN OF ROLESVILLE CID-24-04 V2	11/01/2024	\$REG
03		TOWN OF ROLESVILLE CID-24-04 V3	02/01/2024	\$REG
04		TOWN OF ROLESVILLE CID-24-04 V4	06/02/2025	\$REG
No.		REVISIONS	DATE	BY

SEAL:

STRONGROCK
ENGINEERING GROUP
STRONG ROCK ENGINEERING GROUP, PLLC | COMPANY LICENSE # P-2166

STRONG ROCK ENGINEERING GROUP, PLLC | COMPANY LICENSE # P-2166

305 CHURCH AT NORTH HILLS STREET, SUITE 1110 RALEIGH, NC 27609 | INFORMATION@STRONGROCKGROUP.COM

STRONG ROCK PROJECT PSP-23-03	NOT FOR CONSTRUCTION	
SCALE	AS SHOWN	
DESIGNED BY	SRG	
DRAWN BY	SRG	
CHECKED BY	SRG	

RESERVE @ MITCHELL MILL
TOWN OF ROLESVILLE, WAKE COUNTY, NORTH CAROLINA

CONSTRUCTION PLANS
PARTIAL GRADING AND
DRAINAGE PLAN IX

DRAWING SHEET

C-9.9

56 OF 227

PIPE TABLE						
PIPE NO	TYPE	SIZE	LF	INV. IN	INV. OUT	GRADE
P #01	CLASS IV RCP	15"	213	287.77	286.71	0.50%
P #02	RCP	15"	71	286.51	286.15	0.50%
P #03	RCP	18"	71	285.95	285.60	0.50%
P #04	CLASS IV RCP	18"	101	285.40	284.33	1.06%
P #05	CLASS IV RCP	18"	128	284.13	283.49	0.50%
P #06	RCP	15"	37	280.95	278.16	7.63%
P #07	RCP	15"	26	277.96	276.11	7.00%
P #08	RCP	15"	26	276.33	276.20	0.50%
P #09	RCP	15"	38	276.00	275.81	0.50%
P #10	RCP	18"	185	275.61	274.57	0.56%
P #11	RCP	15"	26	274.85	274.57	1.06%
P #12	RCP	18"	200	274.34	271.08	1.63%
P #13	RCP	15"	26	271.48	271.08	1.54%
P #14	RCP	18"	131	270.88	268.11	2.11%
P #15	RCP	24"	71	267.91	266.10	2.55%
P #16	RCP	15"	155	273.46	271.48	1.27%
P #17	RCP	18"	200	271.28	268.64	1.32%
P #18	RCP	24"	113	268.44	267.29	1.01%
P #19	RCP	30"	82	267.09	266.10	1.21%
P #20	RCP	36"	85	265.90	265.48	0.50%

PIPE TABLE						
PIPE NO	TYPE	SIZE	LF	INV. IN	INV. OUT	GRADE
P #21	RCP	36"	102	265.28	264.62	0.65%
P #22	RCP	36"	26	264.42	264.29	0.50%
P #23	RCP	36"	29	264.09	263.94	0.50%
P #24	RCP	15"	26	270.89	270.76	0.50%
P #25	RCP	18"	123	270.56	264.74	4.72%
P #26	RCP	36"	161	263.74	262.67	0.67%
P #27	RCP	36"	61	262.47	262.00	0.77%
P #28	RCP	24"	49	262.00	261.54	0.94%
P #29	RCP	36"	42	261.61	261.40	0.50%
P #30	RCP	15"	26	271.15	271.02	0.50%
P #31	RCP	18"	47	270.81	270.57	0.50%
P #32	RCP	18"	26	270.37	270.24	0.50%
P #33	RCP	18"	48	270.04	269.80	0.50%
P #34	RCP	18"	180	269.60	268.65	0.53%
P #35	RCP	18"	29	268.87	268.65	0.76%
P #36	RCP	18"	151	268.45	264.65	2.52%
P #37	RCP	15"	29	265.80	264.65	3.92%
P #38	RCP	24"	186	264.45	262.56	1.02%
P #39	RCP	15"	26	263.37	262.56	3.15%
P #40	RCP	24"	150	262.36	256.00	4.24%

PIPE TABLE						
PIPE NO	TYPE	SIZE	LF	INV. IN	INV. OUT	GRADE
P #41	RCP	24"	112	254.76	254.20	0.50%
P #42	RCP	18"	26	254.43	254.20	0.89%
P #43	RCP	30"	136	254.00	253.32	0.50%
P #44	RCP	15"	26	254.92	254.72	0.77%
P #45	RCP	30"	45	253.12	251.04	4.66%
P #46	RCP	30"	40	250.84	248.04	7.00%
P #47	RCP	30"	103	247.84	240.65	7.00%
P #48	RCP	30"	90	240.45	240.00	0.50%
P #50	CLASS IV RCP	18"	226	286.44	284.19	1.00%
P #51	CLASS IV RCP	18"	261	283.83	281.22	1.00%
P #52	CLASS IV RCP	18"	37	281.02	280.31	1.94%
P #53	RCP	18"	26	279.97	279.70	1.00%
P #54	CLASS IV RCP	18"	36	286.00	284.64	3.83%
P #55	CLASS IV RCP	15"	209	300.49	289.12	5.44%
P #56	CLASS IV RCP	24"	35	289.53	289.24	0.83%
P #57	CLASS IV RCP	24"	62	291.58	289.73	2.98%
P #58	CLASS IV RCP	24"	49	289.04	288.79	0.50%
P #59	CLASS IV RCP	24"	47	288.12	287.82	0.64%
P #60	CLASS IV RCP	24"	169	287.36	285.46	1.12%
P #61	CLASS IV RCP	24"	149	285.26	283.20	1.38%

PIPE TABLE						
PIPE NO	TYPE	SIZE	LF	INV. IN	INV. OUT	GRADE
P #62	CLASS IV RCP	24"	74	282.79	281.66	1.53%
P #63	CLASS IV RCP	24"	142	281.46	280.75	0.50%
P #64	CLASS IV RCP	24"	52	280.55	279.78	1.46%
P #65	RCP	24"	63	237.00	234.19	4.44%
P #66	CLASS IV RCP	24"	213	279.13	275.58	1.67%
P #67	CLASS IV RCP	30"	26	274.54	274.40	0.50%
P #68	RCP	30"	72	274.20	273.00	1.66%
P #69	RCP	36"	83	272.77	271.02	2.12%
P #70	RCP	24"	157	273.00	271.98	0.65%
P #71	RCP	15"	26	273.34	273.21	0.50%
P #72	RCP	15"	114	272.52	269.60	2.57%
P #73	RCP	15"	79	269.40	269.00	0.50%
P #74	RCP	15"	70	271.03	270.67	0.50%
P #75	RCP	15"	38	270.47	270.29	0.50%
P #76	RCP	15"	147	268.80	268.07	0.50%
P #77	RCP	15"	26	270.09	269.96	0.50%
P #78	RCP	15"	72	267.87	266.72	1.58%
P #79	RCP	15"	26	266.52	266.39	0.50%
P #80	RCP	18"	48	266.19	265.96	0.50%
P #81	RCP	15"	26	296.53	296.34	0.73%

PIPE TABLE						
PIPE NO	TYPE	SIZE	LF	INV. IN	INV. OUT	GRADE
P #82	RCP	15"	113	296.14	290.65	4.86%
P #83	RCP	15"	26	290.78	290.65	0.50%
P #84	RCP	15"	131	290.45	280.53	7.57%
P #85	RCP	15"	26	280.66	280.53	0.50%
P #86	RCP	15"	151	280.33	268.26	8.00%
P #87	RCP	24"	26	265.76	265.63	0.50%
P #88	RCP	24"	47	265.43	265.04	0.83%
P #89	RCP	15"	26	265.47	265.04	1.68%
P #90	RCP	24"	50	264.84	263.06	3.58%
P #91	RCP	24"	45	262.86	261.93	2.10%
P #92	RCP	15"	108	280.03	272.06	7.37%
P #93	RCP	15"	93	271.86	265.43	6.89%
P #94	RCP	15"	58	265.23	261.93	5.67%
P #95	RCP	24"	97	261.73	258.68	3.15%
P #96	RCP	15"	25	259.59	258.68	3.67%
P #97	RCP	24"	119	258.48	254.63	3.22%
P #98	RCP	15"	26	255.44	254.63	3.12%
P #99	RCP	24"	44	254.43	251.46	6.81%
P #100	RCP	15"	107	266.17	258.26	7.38%
P #101	RCP	15"	95	258.06	254.71	3.54%

PIPE TABLE						
PIPE NO	TYPE	SIZE	LF	INV. IN	INV. OUT	GRADE
P #102	RCP	15"	52	254.51	251.46	5.90%
P #103	RCP	30"	128	251.26	247.03	3.32%
P #104	RCP	15"	27	249.04	248.53	1.92%
P #105	RCP	30"	43	246.83	245.59	2.92%
P #106	RCP	15"	26	259.78	259.33	1.74%
P #107	RCP	18"	167	259.13	247.89	6.75%
P #108	RCP	36"	26	245.39	244.98	1.59%
P #109	RCP	36"	59	244.78	244.48	0.50%
P #110	RCP	36"	52	244.28	244.02	0.50%
P #111	RCP	15"	28	245.92	245.15	2.71%
P #112	RCP	36"	40	243.82	243.16	1.65%
P #113	RCP	15"	105	291.78	283.16	8.23%
P #114	RCP	15"	78	285.39	283.32	2.65%
P #115	RCP	15"	132	282.96	275.48	5.66%
P #116	RCP	15"	112	275.28	271.34	3.51%
P #117	RCP	15"	123	286.06	278.58	6.09%
P #118	RCP	15"	44	278.80	278.58	0.50%
P #119	RCP	15"	91	278.38	274.38	4.38%
P #120	RCP	15"	75	274.18	271.34	3.78%
P #121	RCP	18"	115	271.14	266.51	4.03%

PIPE TABLE						
PIPE NO	TYPE	SIZE	LF	INV. IN	INV. OUT	GRADE
P #122	RCP	18"	29	267.14	267.00	0.50%
P #123	RCP	18"	56	266.80	266.51	0.50%
P #124	RCP	18"	133	266.31	260.97	4.03%
P #125	RCP	24"	32	260.52	260.36	0.50%
P #126	RCP	24"	26	260.16	259.54	2.39%
P #127	RCP	24"	89	259.34	255.96	3.78%
P #128	RCP	15"	26	257.04	255.96	4.23%
P #129	RCP	24"	87	255.76	251.50	4.89%
P #130	RCP	30"	157	251.30	248.47	1.81%
P #131	RCP	36"	121	247.65	243.16	3.71%
P #132	RCP	42"	119	242.96	240.10	2.41%
P #133	RCP	42"	78	239.54	239.00	0.69%
P #134	RCP	24"	66	239.00	238.42	0.88%
P #135	RCP	15"	128	302.18	293.73	6.60%
P #136	RCP	15"	103	309.08	302.38	6.50%
P #137	RCP	15"	183	293.53	280.02	7.40%
P #138	RCP	15"	150	279.82	270.99	5.87%
P #139	RCP	18"	98	270.79	265.64	5.27%
P #140	RCP	18"	86	265.44	259.32	7.13%
P #141	RCP	18"	150	259.12	252.01	4.72%

PIPE TABLE						
PIPE NO	TYPE	SIZE	LF	INV. IN	INV. OUT	GRADE
P #142	RCP	24"	45	251.21	247.95	7.30%
P #143	RCP	24"	107	247.75	240.00	7.23%
P #144	RCP	15"	77	244.55	242.06	3.24%
P #144A	RCP	15"	82	241.86	239.92	2.36%
P #145	CLASS IV RCP	15"	146	239.72	237.50	1.51%
P #146	CLASS IV RCP	18"	37	237.30	237.12	0.50%
P #147	CLASS IV RCP	18"	92	236.92	236.46	0.50%
P #148	CLASS IV RCP	18"	75	236.26	235.88	0.50%
P #149	CLASS IV RCP	24"	137	235.68	235.00	0.50%
P #150	CLASS IV RCP	24"	19	234.80	234.65	0.78%
P #151	CLASS IV RCP	30"	30	238.45	238.30	0.50%
P #153	RCP	15"	82	261.43	257.68	4.59%
P #154	RCP	15"	40	257.48	255.43	5.09%
P #155	RCP	15"	108	255.23	252.82	2.22%
P #156	RCP	18"	26	252.62	252.49	0.50%
P #157	RCP	18"	52	252.29	252.03	0.50%
P #158	RCP	24"	150	251.83	246.83	3.33%
P #159	RCP	24"	135	246.63	241.45	3.85%
P #160	RCP	24"	160	241.25	240.18	0.67%
P #161	RCP	30"	55	239.98	239.21	1.40%

PIPE TABLE						
PIPE NO	TYPE	SIZE	LF	INV. IN	INV. OUT	GRADE
P #162	CLASS IV RCP	36"	26	238.93	238.80	0.50%
P #163	RCP	15"	26	259.37	259.16	0.82%
P #164	RCP	15"	136	258.96	256.70	1.67%
P #165	RCP	15"	26	256.83	256.70	0.50%
P #166	RCP	18"	47	256.50	254.92	3.35%
P #167	RCP	18"	28	254.72	252.88	6.63%
P #169	RCP	15"	26	248.13	246.83	5.06%
P #170	RCP	15"	26	242.72	242.20	2.04%
P #171	RCP	15"	26	241.31	241.17	0.50%
P #172	RCP	15"	127	242.94	242.30	0.50%
P #173	RCP	15"	120	242.10	241.50	0.50%
P #174	RCP	24"	91	241.30	240.85	0.50%
P #175	RCP	24"	22	240.65	240.54	0.50%
P #176	RCP	30"	26	240.34	240.21	0.50%
P #177	RCP	15"	26	255.98	255.85	0.50%
P #178	RCP	15"	95	255.65	251.44	4.44%
P #179	RCP	18"	45	251.24	248.20	6.73%
P #180	RCP	18"	39	248.00	244.93	7.84%
P #181	RCP	15"	195	248.00	246.99	0.52%
P #182	RCP	15"	26	247.01	246.88	0.50%

CATCH BASIN TABLE				
CB NO	SIZE	TOP	INV. IN	INV. OUT
CB #01	2' X 3'	290.24		287.77 W
CB #02	2' X 3'	292.07	286.71 E	286.51 W
CB #03	2' X 3'	291.90	286.15 E	285.95 W
CB #04	2' X 3'	290.71	285.60 E	285.40 W
CB #05	2' X 3'	288.14	284.33 E	284.13 W
CB #06	2' X 3'	285.49		280.95 NE
CB #07	2' X 3'	282.70	278.16 SW	277.96 N
CB #08	2' X 3'	280.77		276.33 E
CB #09	2' X 3'	280.68	276.20 W	276.00 SE
CB #10	2' X 3'	282.20	275.81 NW 276.11 S	275.61 E
CB #11	2' X 3'	279.29		274.85 N
CB #12	2' X 3'	279.28	274.57 S 274.57 W	274.34 E
CB #13	2' X 3'	275.92		271.48 N
CB #14	2' X 3'	275.87	271.08 S 271.08 W	270.88 E
CB #15	2' X 3'	273.37	268.11 W	267.91 NE
CB #16	2' X 3'	273.22	267.29 S	267.09 N
CB #17	2' X 3'	272.30	266.10 SW 266.10 S	265.90 N
CB #18 (DOUBLE)	2' X 3'	272.97	264.62 S	264.42 N

CATCH BASIN TABLE				
CB NO	SIZE	TOP	INV. IN	INV. OUT
CB #19	2' X 3'	272.95	264.29 S	264.09 W
CB #20	2' X 3'	275.32		270.89 N
CB #21	2' X 3'	275.34	270.76 S	270.56 E
CB #22	2' X 3'	273.10	264.74 W 263.94 E	263.74 N
CB #23	2' X 3'	275.59		271.15 E
CB #24	2' X 3'	275.59	271.02 W	270.81 NE
CB #25	2' X 3'	276.27	270.57 SW	270.37 N
CB #26	2' X 3'	276.12	270.24 S	270.04 NW
CB #27	2' X 3'	275.10	269.80 SE	269.60 N
CB #28	2' X 3'	273.58		268.87 NE
CB #29	2' X 3'	273.36	268.65 S 268.65 SW	268.45 N
CB #30	2' X 3'	271.12		265.80 NE
CB #31	2' X 3'	270.88	264.65 S 264.65 SW	264.45 N
CB #32	2' X 3'	267.81		263.37 E
CB #33	2' X 3'	267.81	262.56 S 262.56 W	262.36 N
CB #34	2' X 3'	262.31	256.00 S 254.20 W 254.20 E	254.00 N
CB #35	2' X 3'	262.31		254.43 E
CB #36	2' X 3'	260.03		254.92 E

CATCH BASIN TABLE				
CB NO	SIZE	TOP	INV. IN	INV. OUT
CB #37	2' X 3'	259.29	253.32 S 254.72 W	253.12 NE
CB #38	2' X 3'	258.76	251.04 SW	250.84 E
CB #39	2' X 3'	290.19		286.44 E
CB #40	2' X 3'	288.98	284.19 W	283.83 E
CB #41	2' X 3'	285.22	281.22 W	281.02 NE
CB #42	2' X 3'	305.80		300.49 S
CB #43	2' X 3'	294.44	289.73 S	289.53 NW
CB #44	2' X 3'	293.89	289.24 SE	289.04 W
CB #45	2' X 3'	293.41	288.79 E 289.12 N	288.12 SW
CB #46	2' X 3'	292.33	287.82 NE	287.36 W
CB #47	2' X 3'	289.80	285.46 E	285.26 W
CB #48	2' X 3'	287.47	283.20 E	282.79 W
CB #49	2' X 3'	286.03	281.66 E	281.46 W
CB #50	2' X 3'	285.01	280.75 E	280.55 W
CB #51	2' X 3'	283.99	279.70 SE 280.31 SW 279.78 E	279.13 N
CB #52	2' X 3'	285.43	280.17 S	279.97 NW
CB #53	2' X 3'	279.94	275.58 S	274.54 E
CB #54	2' X 3'	279.99	274.40 W	274.20 NE

CATCH BASIN TABLE				
CB NO	SIZE	TOP	INV. IN	INV. OUT
CB #55	2' X 3'	277.77		273.34 W
CB #56	2' X 3'	277.77	273.21 E	272.52 NW
CB #57	2' X 3'	277.10	269.60 SE	269.40 NW
CB #58	2' X 3'	275.69		271.03 SE
CB #59	2' X 3'	275.98	270.67 NW	270.47 NE
CB #60	2' X 3'	276.48	270.29 SW 269.00 SE	268.80 N
CB #61	2' X 3'	274.66		270.09 W
CB #62	2' X 3'	274.68	269.96 E 268.07 S	267.87 N
CB #63	2' X 3'	272.51	266.72 S	266.52 E
CB #64	2' X 3'	272.51	266.39 W	266.19 NE
CB #65	2' X 3'	300.97		296.53 SE
CB #66	2' X 3'	300.78	296.34 NW	296.14 W
CB #67	2' X 3'	295.22		290.78 S
CB #68	2' X 3'	295.12	290.65 E 290.65 N	290.45 W
CB #69	2' X 3'	286.02		280.66 S
CB #70	2' X 3'	285.92	280.53 N 280.53 E	280.33 W
CB #71	2' X 3'	274.74	265.96 SW 268.26 E	265.76 N
CB #72	2' X 3'	274.59	265.63 S	265.43 NW

CATCH BASIN TABLE				
CB NO	SIZE	TOP	INV. IN	INV. OUT
CB #73	2' X 3'	270.01		265.47 E
CB #74	2' X 3'	271.18	265.04 SE 265.04 W	264.84 N
CB #75	2' X 3'	268.45	263.06 S	262.86 NW
CB #76	2' X 3'	264.03		259.59 NE
CB #77	2' X 3'	264.03	258.68 SE 258.68 SW	258.48 NW
CB #78	2' X 3'	259.87		255.44 NE
CB #79	2' X 3'	259.98	254.63 SW 254.63 SE	254.43 NW
CB #80	2' X 3'	253.46		249.04 E
CB #81 (DOUBLE)	2' X 3'	253.45	247.03 SE 248.53 W	246.83 NE
CB #82	2' X 3'	264.22		259.78 S
CB #84	2' X 3'	255.07	245.59 SW 247.89 E	245.39 N
CB #85	2' X 3'	255.07	244.98 S	244.78 NW
CB #86	2' X 3'	252.67	244.48 SE	244.28 N
CB #87	2' X 3'	252.75		245.92 E
CB #88	2' X 3'	252.65	244.02 S 245.15 W	243.82 N
CB #89	2' X 3'	271.91		267.14 S
CB #90	2' X 3'	271.77	267.00 N	266.80 SW
CB #91	2' X 3'	264.85		260.52 NE

CATCH BASIN TABLE				
CB NO	SIZE	TOP	INV. IN	INV. OUT
CB #92	2' X 3'	267.26	260.36 SW 260.97 SE	260.16 NE
CB #93	2' X 3'	267.11	259.54 SW	259.34 NW
CB #94	2' X 3'	261.48		257.04 NE
CB #95	2' X 3'	261.55	255.96 SE 255.96 SW	255.76 NW
CB #96	2' X 3'	313.77		309.08 NW
CB #97	2' X 3'	307.40	302.38 SE	302.18 NW
CB #98	2' X 3'	298.16	293.73 SE	293.53 NW
CB #99	2' X 3'	285.15	280.02 SE	279.82 NW
CB #100	2' X 3'	276.03	270.99 SE	270.79 NW
CB #101	2' X 3'	270.89	265.64 SE	265.44 NW
CB #102	2' X 3'	266.43	259.32 SE	259.12 NW
CB #103	2' X 3'	259.30	252.01 SE	251.21 NE
CB #104	2' X 3'	258.53	247.95 SW	247.75 NE
CB #105	2' X 3'	303.55		299.10 NW
CB #105A	2' X 3'	293.11	288.34 SE	288.14 NW
CB #106	2' X 3'	272.71	268.46 S	268.00 NE
CB #107	2' X 3'	276.42	271.94 SE	271.74 N
CB #108	2' X 3'	285.05	280.61 SE	280.41 NW

CATCH BASIN TABLE				
CB NO	SIZE	TOP	INV. IN	INV. OUT
CB #109	2' X 3'	248.99		244.55 S
CB #109A	2' X 3'	246.50	242.06 N	241.86 S
CB #110	2' X 3'	244.36	239.92 N	239.72 S
CB #111	2' X 3'	241.03	237.50 N	237.30 SE
CB #112	2' X 3'	241.10	237.12 NW	236.92 S
CB #113	2' X 3'	238.60	236.46 N	236.26 SE
CB #114	2' X 3'	238.38	235.88 NW	235.68 SE
CB #115	2' X 3'	242.65		238.45 SE
CB #116	2' X 3'	266.07		261.43 S
CB #117	2' X 3'	262.12	257.68 N	257.48 SE
CB #118	2' X 3'	259.95	255.43 NW	255.23 E
CB #119	2' X 3'	260.48	252.82 W	252.62 S
CB #120	2' X 3'	260.46	252.49 N	252.29 SE
CB #121	2' X 3'	263.81		259.37 S
CB #122	2' X 3'	263.81	259.16 N	258.96 W
CB #123	2' X 3'	261.26		256.83 S
CB #124	2' X 3'	261.23	256.70 E 256.70 N	256.50 SW
CB #125	2' X 3'	259.72	254.92 NE	254.72 W

CATCH BASIN TABLE				
CB NO	SIZE	TOP	INV. IN	INV. OUT
CB #126	2' X 3'	259.47	252.88 E 252.03 NW	251.83 S
CB #127	2' X 3'	252.57		248.13 W
CB #128	2' X 3'	252.53	246.83 E 246.83 N	246.63 S
CB #129	2' X 3'	247.16		242.72 W
CB #130	2' X 3'	247.15	242.20 E 241.45 N	241.25 S
CB #131	2' X 3'	245.74		241.31 W
CB #132	2' X 3'	245.81	241.17 E 240.18 N	239.98 SW
CB #133	2' X 3'	245.08	239.21 NE	238.93 S
CB #134	2' X 3'	260.42		255.98 S
CB #135	2' X 3'	246.44	240.54 N	240.34 S
CB #136	2' X 3'	256.14	251.44 W	251.24 SE
CB #137	2' X 3'	260.42	255.85 N	255.65 E
CB #138	2' X 3'	253.01	248.20 NW	248.00 SE
CB #139	2' X 3'	252.45		248.00 W
CB #140	2' X 3'	251.44		247.01 S
CB #141	2' X 3'	251.44	246.88 N 246.99 E	246.68 W
CB #142	2' X 3'	251.17	246.39 E	246.19 W
CB #143 (DOUBLE)	2' X 3'	250.92		246.21 S

CATCH BASIN TABLE				
CB NO	SIZE	TOP	INV. IN	INV. OUT
CB #144	2' X 3'	250.92	245.89 E 246.08 N	245.69 W
CB #145	2' X 3'	251.46	245.41 E	245.21 W
CB #146	2' X 3'	251.28	244.93 NW 244.93 E	244.73 S
CB #147	2' X 3'	248.87		244.43 SE
CB #148	2' X 3'	248.84	243.61 N 244.22 NW	243.41 SW
CB #149	2' X 3'	248.38	243.00 NE	242.80 SW
CB #150	2' X 3'	248.00		243.56 SE
CB #151	2' X 3'	247.98	242.38 NE 243.19 NW	242.18 SW
CB #152	2' X 3'	247.68	241.88 NE	241.68 SW
CB #153	2' X 3'	247.34		242.90 S
CB #154	2' X 3'	247.31	241.29 NE 242.59 N	241.09 SW
CB #155	2' X 3'	246.44	240.21 NE 240.21 N	240.01 SW
CB #156	2' X 3'	246.06	239.61 NE	239.41 SW
CB #157	2' X 3'	245.03	238.80 N 238.80 NE	238.60 SW
CB #159	2' X 3'	269.05		264.61 SE
CB #160	2' X 3'	269.07	263.73 NW 264.36 SW	263.53 E
CB #161	2' X 3'	302.36		297.92 W
CB #162	2' X 3'	302.20	297.76 E	297.47 N

CATCH BASIN TABLE				
CB NO	SIZE	TOP	INV. IN	INV. OUT
CB #163	2' X 3'	297.00		292.57 SW
CB #164	2' X 3'	297.13	292.44 NE 292.44 S	292.24 NW
CB #165	2' X 3'	291.92	287.49 SE	287.29 NW
CB #166	2' X 3'	287.47		283.04 SW
CB #167	2' X 3'	287.47	282.91 SE 282.91 NE	282.71 NW
CB #168	2' X 3'	280.18	269.80 NE	269.45 SW
CB #169	2' X 3'	280.14	269.32 NE 271.62 SE	269.12 NW
CB #170	2' X 3'	272.92		268.52 SW
CB #171	2' X 3'	272.95	267.94 NE 267.75 SE	267.55 NW
CB #172 (DOUBLE)	2' X 3'	267.62	262.03 SE 262.03 W	261.83 NE
CB #173	2' X 3'	266.76	261.11 SW	260.77 N
CB #174	2' X 3'	262.74	256.72 S	256.52 NE
CB #175	2' X 3'	257.74		253.31 SE
CB #176	2' X 3'	257.73	251.25 SW 253.03 NW	250.53 NE
CB #177	2' X 3'	285.94		281.55 N
CB #178	2' X 3'	285.94	281.43 S	281.23 W
CB #179	2' X 3'	289.74	280.90 E	280.70 NW
CB #180	2' X 3'	289.80	280.51 SE	280.31 W

CATCH BASIN TABLE				
CB NO	SIZE	TOP	INV. IN	INV. OUT
CB #181	2' X 3'	292.77		285.50 N
CB #182	2' X 3'	289.88	280.17 E 282.47 S	279.97 N
CB #183	2' X 3'	277.06		272.10 W
CB #184	2' X 3'	277.02	271.97 E 271.97 S	271.77 N
CB #185	2' X 3'	263.88		258.91 W
CB #186	2' X 3'	263.89	258.78 E 256.48 S	256.28 N
CB #187	2' X 3'	255.29		250.85 W
CB #188	2' X 3'	254.98	248.98 S 249.88 E	248.38 N
CB #189	2' X 3'	252.83	246.86 S	246.66 NW
CB #190	2' X 3'	251.46		246.85 SW
CB #191	2' X 3'	251.46	246.72 NE 245.68 SE	245.28 W
CB #192	2' X 3'	251.78	245.06 E 245.66 SW	244.86 NW
CB #193	2' X 3'	251.77	244.68 SE	244.48 N
CB #194	2' X 3'	260.39		255.95 NE
CB #195	2' X 3'	257.19	252.75 SW	252.55 NE
CB #196	2' X 3'	253.50		249.07 SE
CB #197	2' X 3'	253.47	248.23 SW 248.93 NW	248.03 NE
CB #198	2' X 3'	251.05		246.61 E