

This Exhibit per SUP
21-02 revises the Phasing
Plan of PR 20-03



PHASING DATA

- Phase 1: 122 Lots
- Phase 1A: 41 Lots
- Phase 1B: 58 Lots
- Phase 1C: 23 Lots

- Phase 2: 34 Lots


- Phase 3: 59 Lots

- Total: 215 Lots

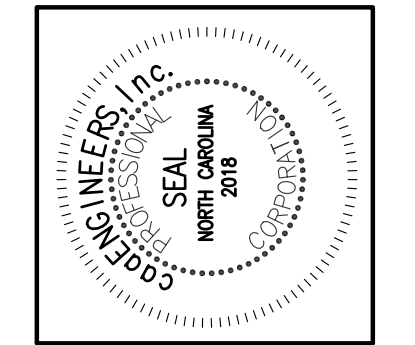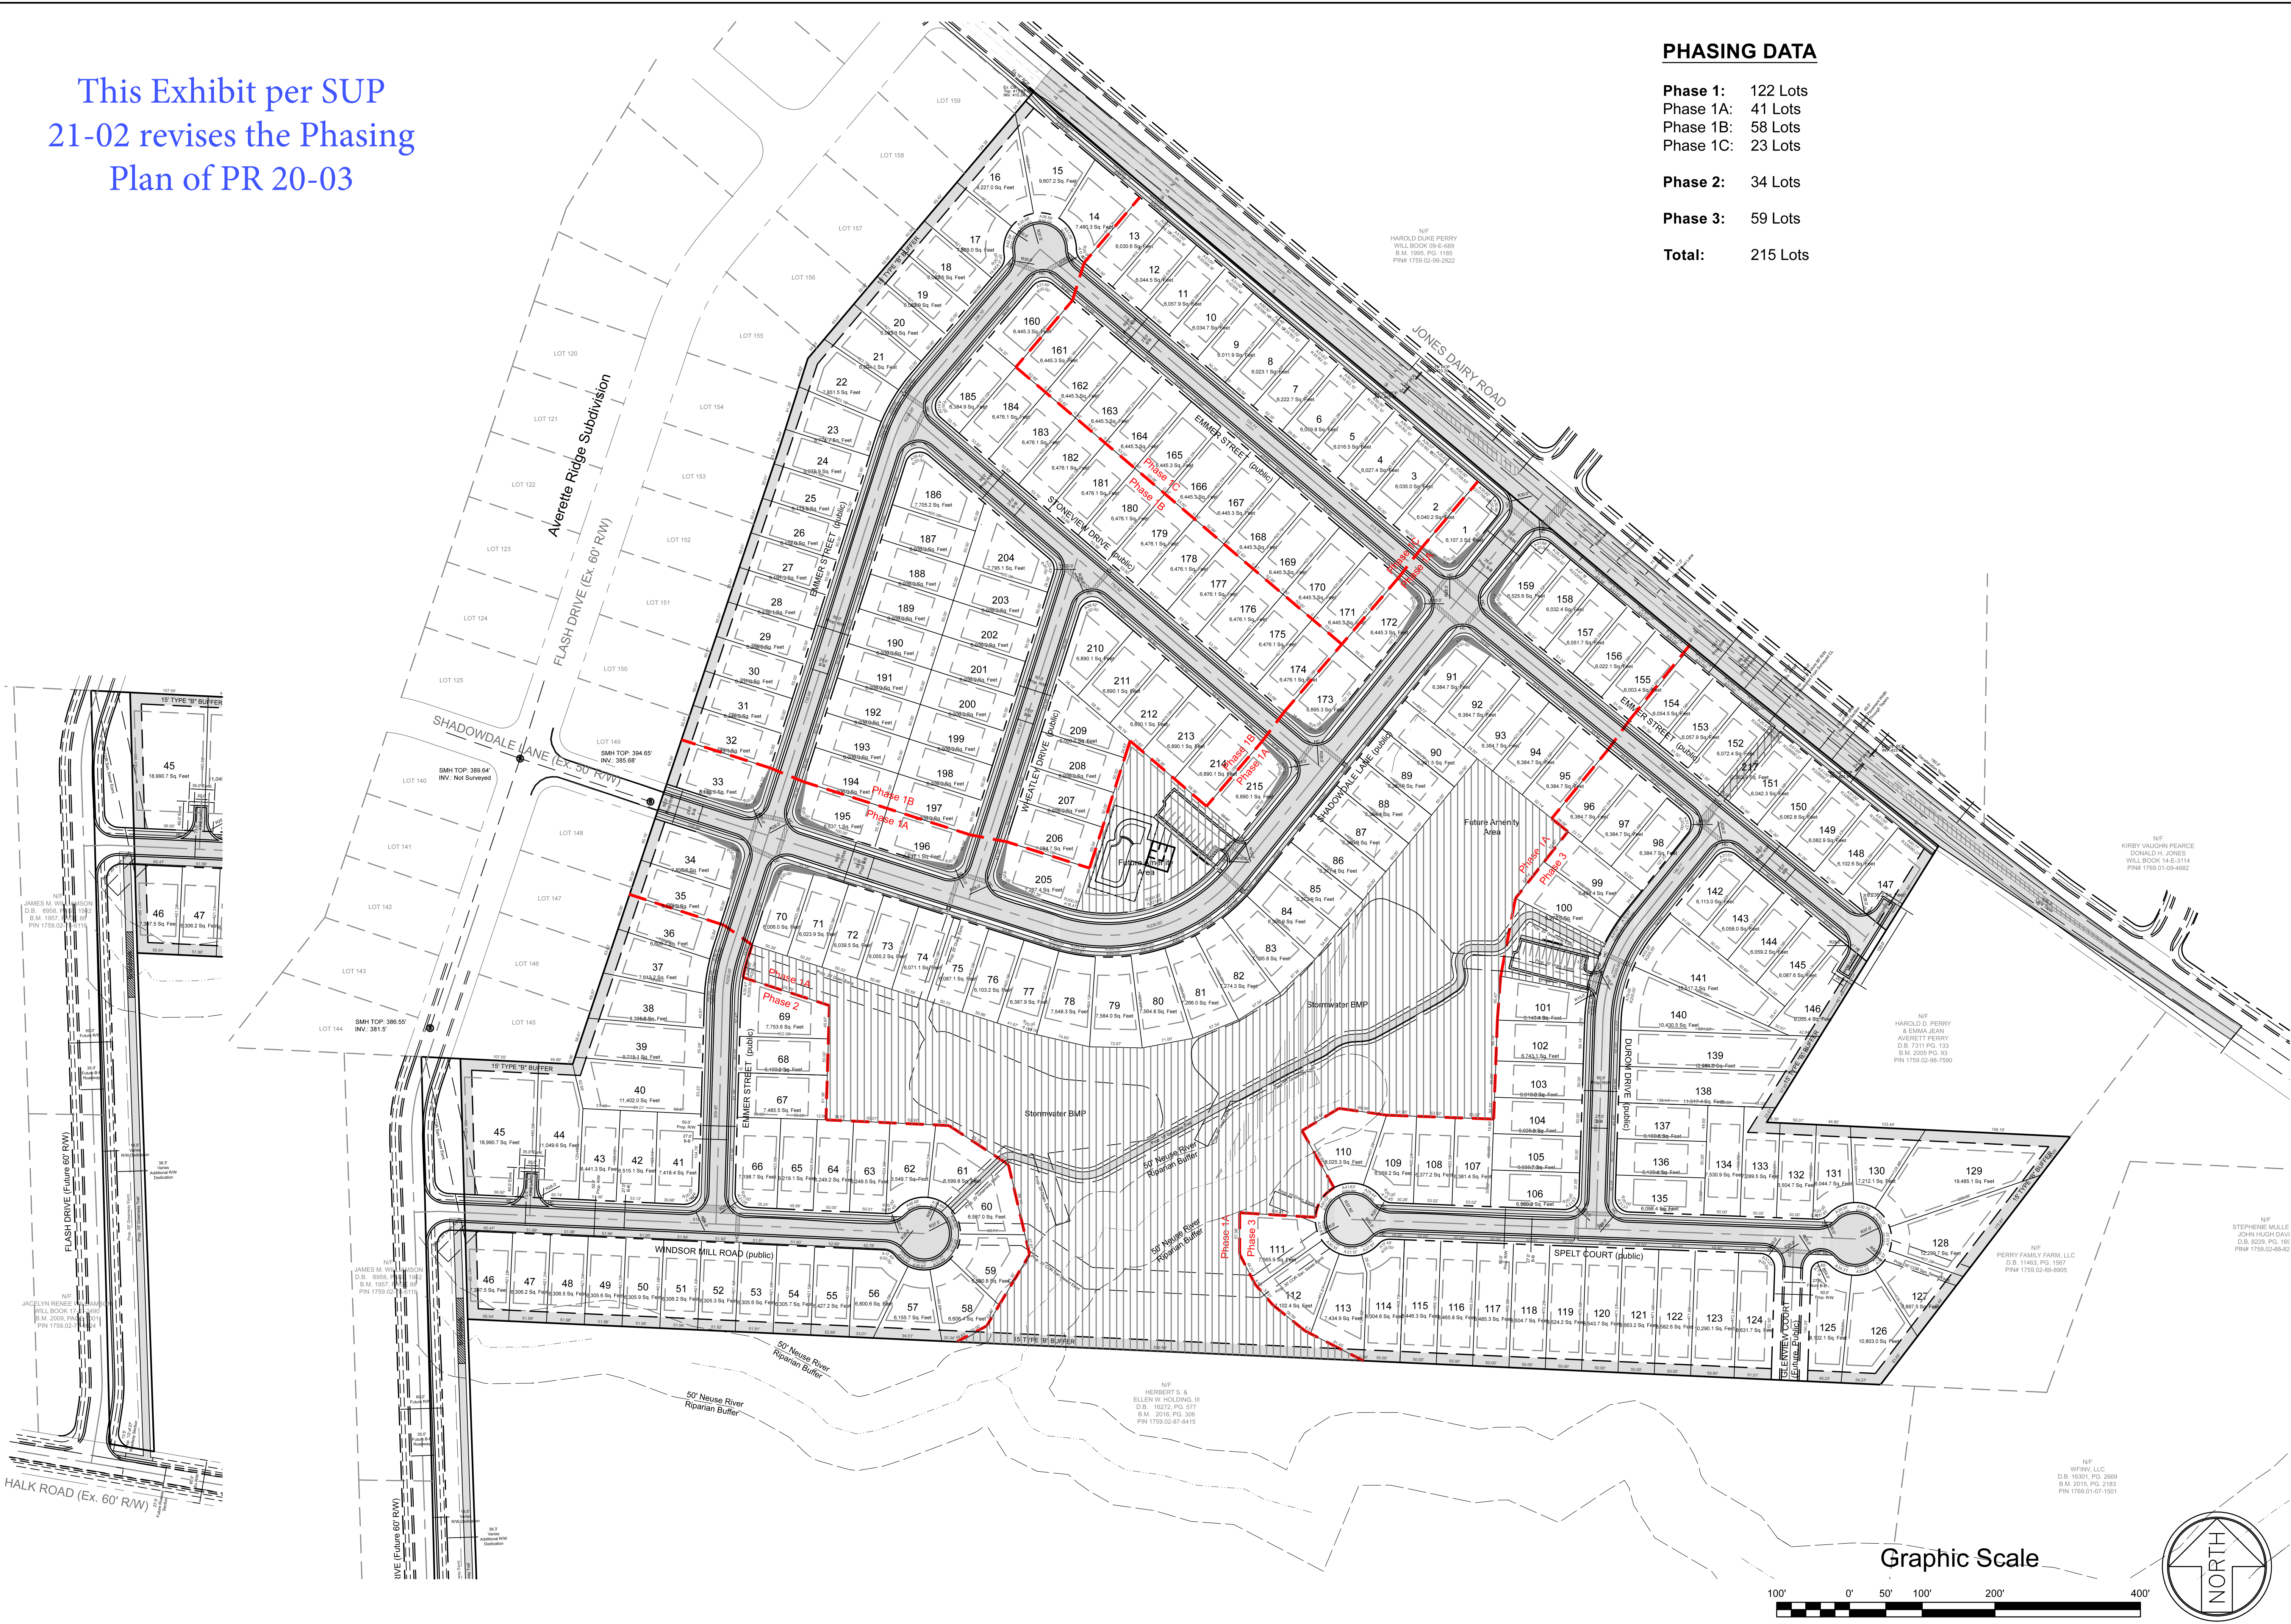

caaENGINEERS, Inc.
McIntyre, Gettle, Crowley
PROFESSIONAL ENGINEERS
1233 Heritage Links Drive, Wake Forest, North Carolina 27587
4926 Windy Hill Road, North Carolina 27609
(819) 824-7135
C-2151 © caaENGINEERS, Inc. All Rights Reserved


NO.	DATE	REVISION DESCRIPTION	BY
1	05/09/2020	Preliminary Construction Plans	MAC
2	10/23/2020	Revised per 1st review comments	MAC
3	11/25/2020	Town, Raleigh Comments	MAC
4	01/11/2021	Town Comments	MAC
5	02/12/2021	Issued for signature approval	By
6	Date	Comment	By
7	Date	Comment	By
8	Date	Comment	By

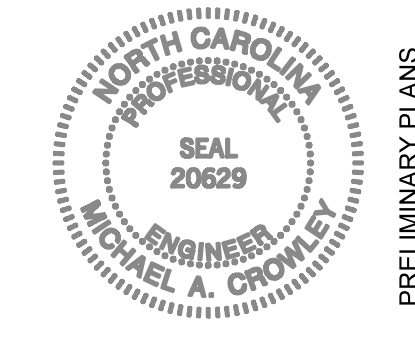

Phasing Plan
Preserve at Jones Dairy, South
Preserve at Jones Dairy, LLC
Rolesville, Wake County, North Carolina

Job No. JDF
Dwg No. **C1**

Graphic Scale

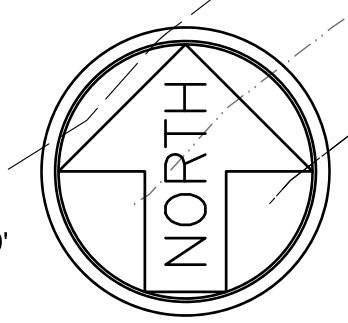

PRELIMINARY PLANS
NOT FOR CONSTRUCTION