


K:\DUR\_Roadway\013829007 - Parker Ridge OS\Plan\Plan\_Sheets\013829007\_psh\_4.dgn

6/23/2023

**LIMITS OF MILL AND OVERLAY**

- GENERAL SHEET NOTES:**
1. RADI DIMENSIONS ARE TO THE EDGE OF PAVEMENT UNLESS OTHERWISE NOTED (APPLIES TO ALL SHEETS)
  2. ALL DRIVEWAYS SHALL BE CONSTRUCTED PER NCDOT STD. 848.02.
  3. MAINTAIN ACCESS TO ALL DRIVEWAYS AND MAILBOXES AT ALL TIMES.

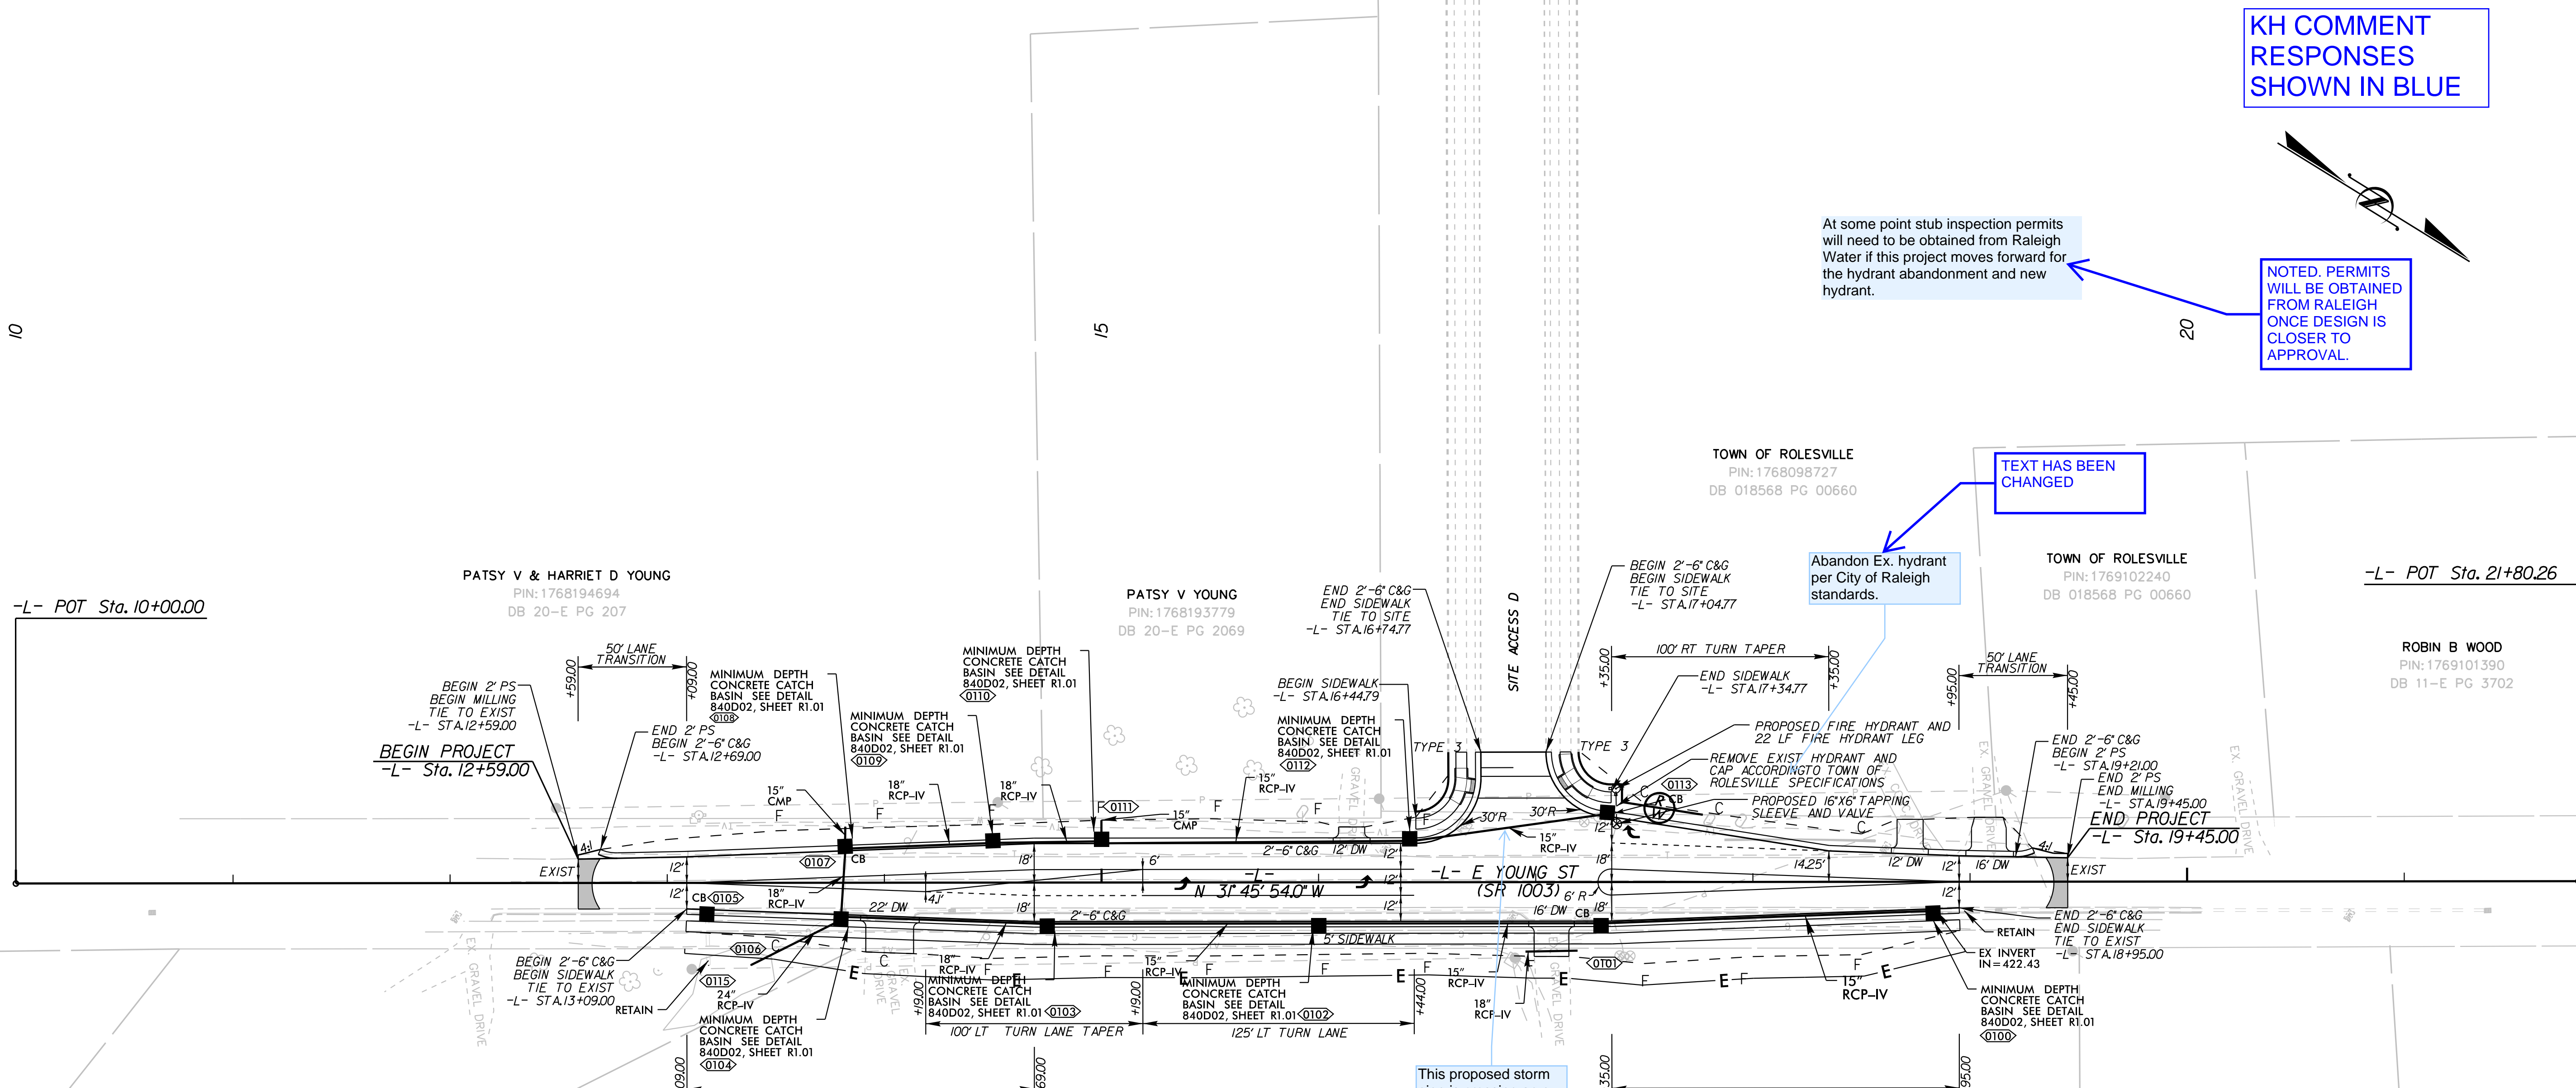

**KH COMMENT  
RESPONSES  
SHOWN IN BLUE**

At some point stub inspection permits will need to be obtained from Raleigh Water if this project moves forward for the hydrant abandonment and new hydrant.

**NOTED. PERMITS WILL BE OBTAINED FROM RALEIGH ONCE DESIGN IS CLOSER TO APPROVAL.**

**TEXT HAS BEEN CHANGED**

Abandon Ex. hydrant per City of Raleigh standards.

This proposed storm pipe is crossing an ex. waterline and possibly an ex. SS force main because there is one in this R/W. You'll need to demonstrate min separate with inverts of the outside of the pipe, cross section detail of the crossings or provide a plan/profile sheet.

**DESIGN HAS BEEN REVISED TO AVOID CROSSING OF WATERLINE AND FORCE MAIN AT THIS LOCATION.**

**CITY OF RALEIGH - PLANS AUTHORIZED FOR CONSTRUCTION**


Plans for the proposed use have been reviewed for general compliance with applicable codes. This limited review, and authorization for construction is not to be considered to represent total compliance with all legal requirements for development and construction. The property owner, design consultants, and contractors are each responsible for compliance with all applicable City, State and Federal laws. This specific authorization below is not a permit, nor shall it be construed to permit any violation of City, State or Federal Law. All Construction must be in accordance with all Local, State, and Federal Rules and Regulations. This approval of this electronic document is only valid if the document has not been modified and the digital signature below is valid:

City of Raleigh Development Approval \_\_\_\_\_

NO.	REVISIONS	DATE	BY

**Kimley»Horn**

© 2023  
300 MORRIS STREET, DURHAM, NC 27701, SUITE 200  
PHONE: 919-682-3553  
WWW.KIMLEY-HORN.COM  
NC LICENSE # F-0102

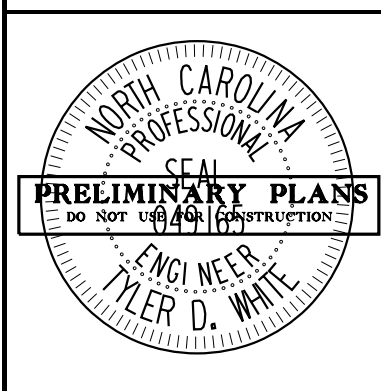

KHA PROJECT	013829007
DATE	6/23/2023
SCALE	1" = 40'
DESIGNED BY:	TOW
DRAWN BY:	JRV
CHECKED BY:	TOW

**PLAN VIEW**

**PARKER RIDGE  
OFFSITE  
IMPROVEMENTS**  
NORTH CAROLINA

SHEET NUMBER  
**R2.00**