

PRELIMINARY

FOR INFORMATION, ONLY

SITE INFORMATION	
OWNER	HOLLINGSWORTH, W.C., JR. AND HOLLINGSWORTH, LAURA W. P.O. BOX 61 LOUISBURG NC 27549-0061 AND MOODY, BENNY LAWRENCE AND MOODY, JEFFREY LYNN 1716 ROLESVILLE RD, WAKE FOREST NC 27587-9677
REAL ESTATE ID	0048383 AND 0048422
PIN NUMBERS	1767284925 AND 1767284304
DEED BOOK	DB:017552 PG:02100 AND DB:014297 PG:01583
DEEDED ACREAGE	51.78 AC
EXISTING ZONING	R-30
TOTAL PROJECT ACREAGE	49.92 AC
GOVERNMENTAL USE	0.48 AC
AREA IN LOTS	24.38 AC
AREA IN ROW	6.54 AC
EXISTING ROW	0.27 AC
DEDICATED ROW	0.14 AC
TOTAL LOTS	82
MIN LOT SIZE	10,000 SF
MIN LOT WIDTH	65'
FRONT SETBACK	25'
REAR SETBACK	25'
SIDE SETBACK	10'
CORNER SETBACK	25'
DENSITY	1.6 UNIT/AC.
OPEN SPACE REQ.	10% / 5 AC.
OPEN SPACE PROVIDED	37% / 18.81 AC
ACTIVE REQUIRED	2.5 AC (50% OF 5 AC)
ACTIVE SHOWN	2.7 AC
LF OF PUBLIC STREETS	5,531 LF

- NOTES
- EXISTING BUILDINGS TO BE REMOVED
 - SCM'S ARE SHOWN FOR LOCATION ONLY. FINAL EROSION CONTROL PLAN WILL CALCULATE CORRECT SCM SIZES
 - SEWER ACCESS FROM ADJACENT DEVELOPMENT TO BE DETERMINED UPON FINAL LAYOUT
 - ALL EXISTING PONDS ARE TO BE REMOVED

SITE LEGEND	
	OPEN SPACE
	EXISTING WETLANDS
	10' GREENWAY TRAIL
	MAIL KIOSK
	LOT LINES
	PROPOSED ROW
	PROPOSED EDP
	PROPOSED CENTERLINE
	PROPOSED BACK OF CURB
	50' NEUSE RIPARIAN BUFFER
	BUFFER ZONE 1 AND 2
	TOP OF CREEK
	PROPOSED SCM
	PROPOSED FENCE
	SIGHT TRIANGLE

STIPULATION FOR REUSE

THIS DRAWING WAS PREPARED FOR USE ON THE SPECIFIC SITE, NAMED HEREON, CONTEMPORANEOUSLY WITH ITS ISSUE DATE AS LISTED, HEREON, AND IT IS NOT SUITABLE FOR USE ON A DIFFERENT PROJECT SITE OR AT A LATER TIME. USE OF THIS DRAWING FOR REFERENCE OR EXAMPLE ON ANOTHER PROJECT REQUIRES THE SERVICES OF PROPERLY LICENSED ARCHITECTS AND ENGINEERS. REPRODUCTION OF THIS DRAWING FOR REUSE ON ANOTHER PROJECT IS NOT AUTHORIZED AND MAY BE CONTRARY TO THE LAW.

THE PRESERVE AT MOODY FARM
ROLESVILLE ROAD
WAKE COUNTY, NC

JOB NUMBER:
CHECKED BY:
DRAWN BY:
DATE:
SHEET TITLE:
OVERALL SITE PLAN
SHEET NO.:
2.0

The callout has been updated

COMMENT #28 - Please expand narrative for 6' Solid Board Fence to include "Per MA 21-05 Condition #4, 6' solid board fence shall be erected prior to completion of the on-site greenway"

COMMENT #10 - Per MA 21-05, the Zoning is R-3-CZ under the UDO - please revise the 'R-30'.

This has been corrected



This has been corrected

8' is being proposed here for environmental reasons

COMMENT #27 - This street is not Woodlyn, it is Mulberry Tree - revise. Defer to Parks Director on the proposed width of 8'



COMMENT #26 - MA 21-05 Condition #3 states "...construction of a 10' off-site multi-use path along Woodlyn Park Drive, ..." - The call-out here states "Proposed 8' roadway trail along Woodlyn". Please explain the discrepancy in width (8' vs. 10') or revise accordingly to comply with Condition.




An 8' trail is being proposed to ensure no revisions will be needed on the environmental permits for Kalas. 10' Trail is being proposed onsite for the Preservations at Moody Farm leading up to Woodlyn Park Drive

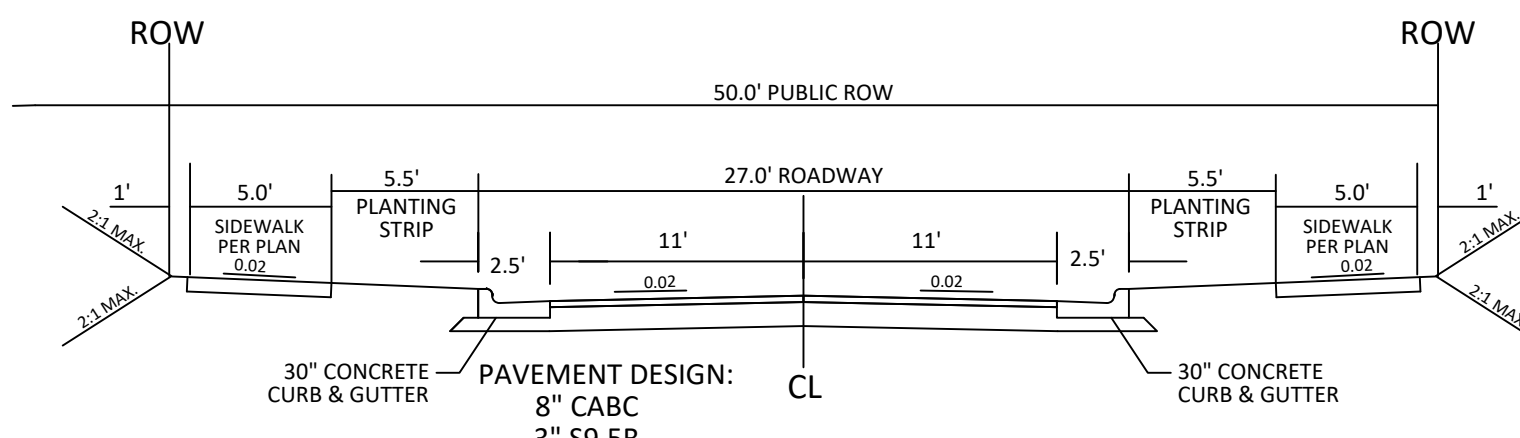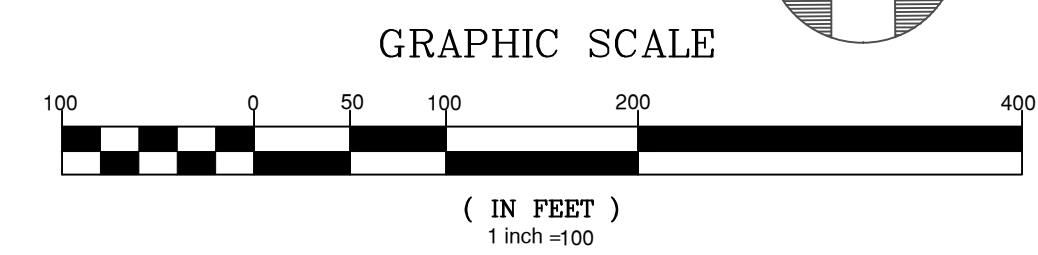

NOTE:
1. NORMAL CROWN OF 0.02 UNLESS OTHERWISE DIRECTED BY TOWN ENGINEER.
2. ASPHALT WILL BE INSTALLED AT A MIN. 1.5" LIFTS.

27' B-B ON A 50' R/W
TYPICAL SECTION

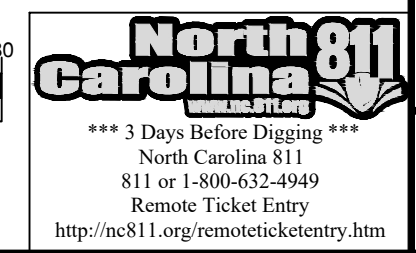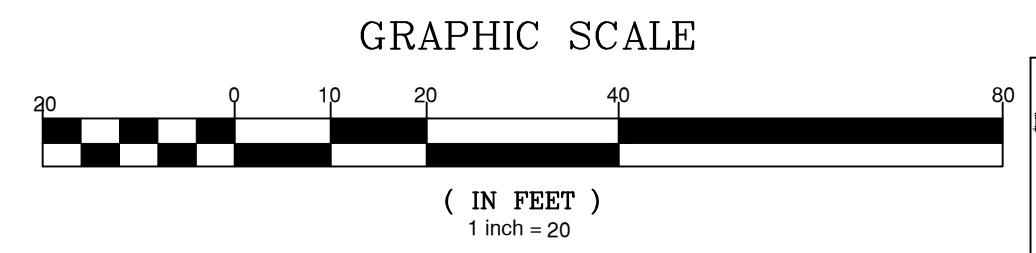

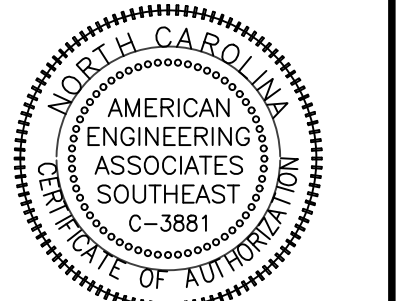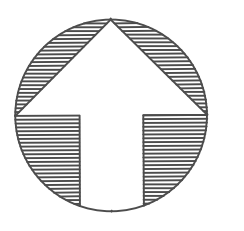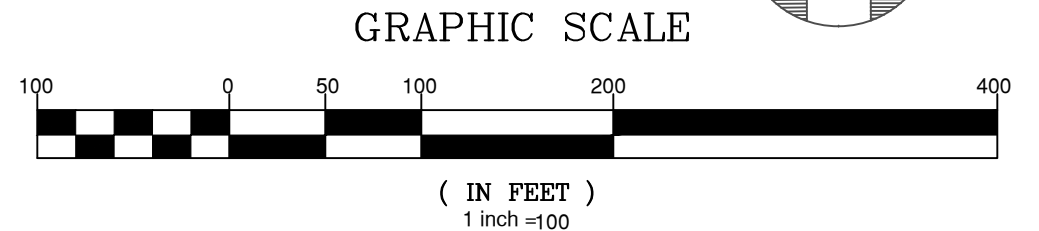

PRELIMINARY

FOR INFORMATION, ONLY

NO.	DATE	REVISION

STIPULATION FOR REUSE
 THIS DRAWING WAS PREPARED FOR USE ON THE SPECIFIC SITE, NAMED HEREON, CONTEMPORANEOUSLY WITH ITS ISSUE DATE AS LISTED, HEREON, AND IT IS NOT SUITABLE FOR USE ON A DIFFERENT PROJECT SITE OR AT A LATER TIME. USE OF THIS DRAWING FOR REFERENCE OR EXAMPLE ON ANOTHER PROJECT REQUIRES THE SERVICES OF PROPERLY LICENSED ARCHITECTS AND ENGINEERS. REPRODUCTION OF THIS DRAWING FOR REUSE ON ANOTHER PROJECT IS NOT AUTHORIZED AND MAY BE CONTRARY TO THE LAW.

**THE PRESERVE AT
 MOODY FARM
 ROLESVILLE ROAD
 WAKE COUNTY, NC**

JOB NUMBER:
 CHECKED BY:
 DRAWN BY:
 DATE:
 SHEET TITLE:
LANDSCAPE PLAN

SHEET NO.:
L1



2:\job\311\MOODY\MOODY_Development_Trial\02100001\Draw\Working\Draw\landscape\plan.dwg December 12, 2011

