


Standard Electric Luminaire Schedule

Symbol	Qty	Label	Arrangement	[MANUFAC]	Description	Total Lumens	Total Wattage	LLF	BUG Rating	Mounting Height
→	5	C1	Single	LiteLine	SLIMPRO6-40K-BK	950	11.2	0.980	B1-U2-G0	10
○	9	P	Single	PROGRESS	P5644-31-30K P860047	3731	60	0.980	B1-U5-G1	7
□	3	S1	Single	Lithonia Lighting	DSX1 LED P7 40K BLC MVOLT	16997	183	0.980	B2-U0-G3	25
⊥	3	WP1	Single	RAB LIGHTING INC.	SLIM37N	3873	34.6	0.950	B1-U2-G1	8

Calculation Summary

Label	CalcType	Max	Min	Avg	Avg/Min	Max/Min	Units
Entire Site	Illuminance	23.7	0.0	2.07	N.A.	N.A.	Fc
Trash Enclosure	Illuminance	24.9	4.4	12.18	2.77	5.66	Fc

Rev. #	Description	Rev. #	Description
R1		R2	
R3		R4	
R5		R5	

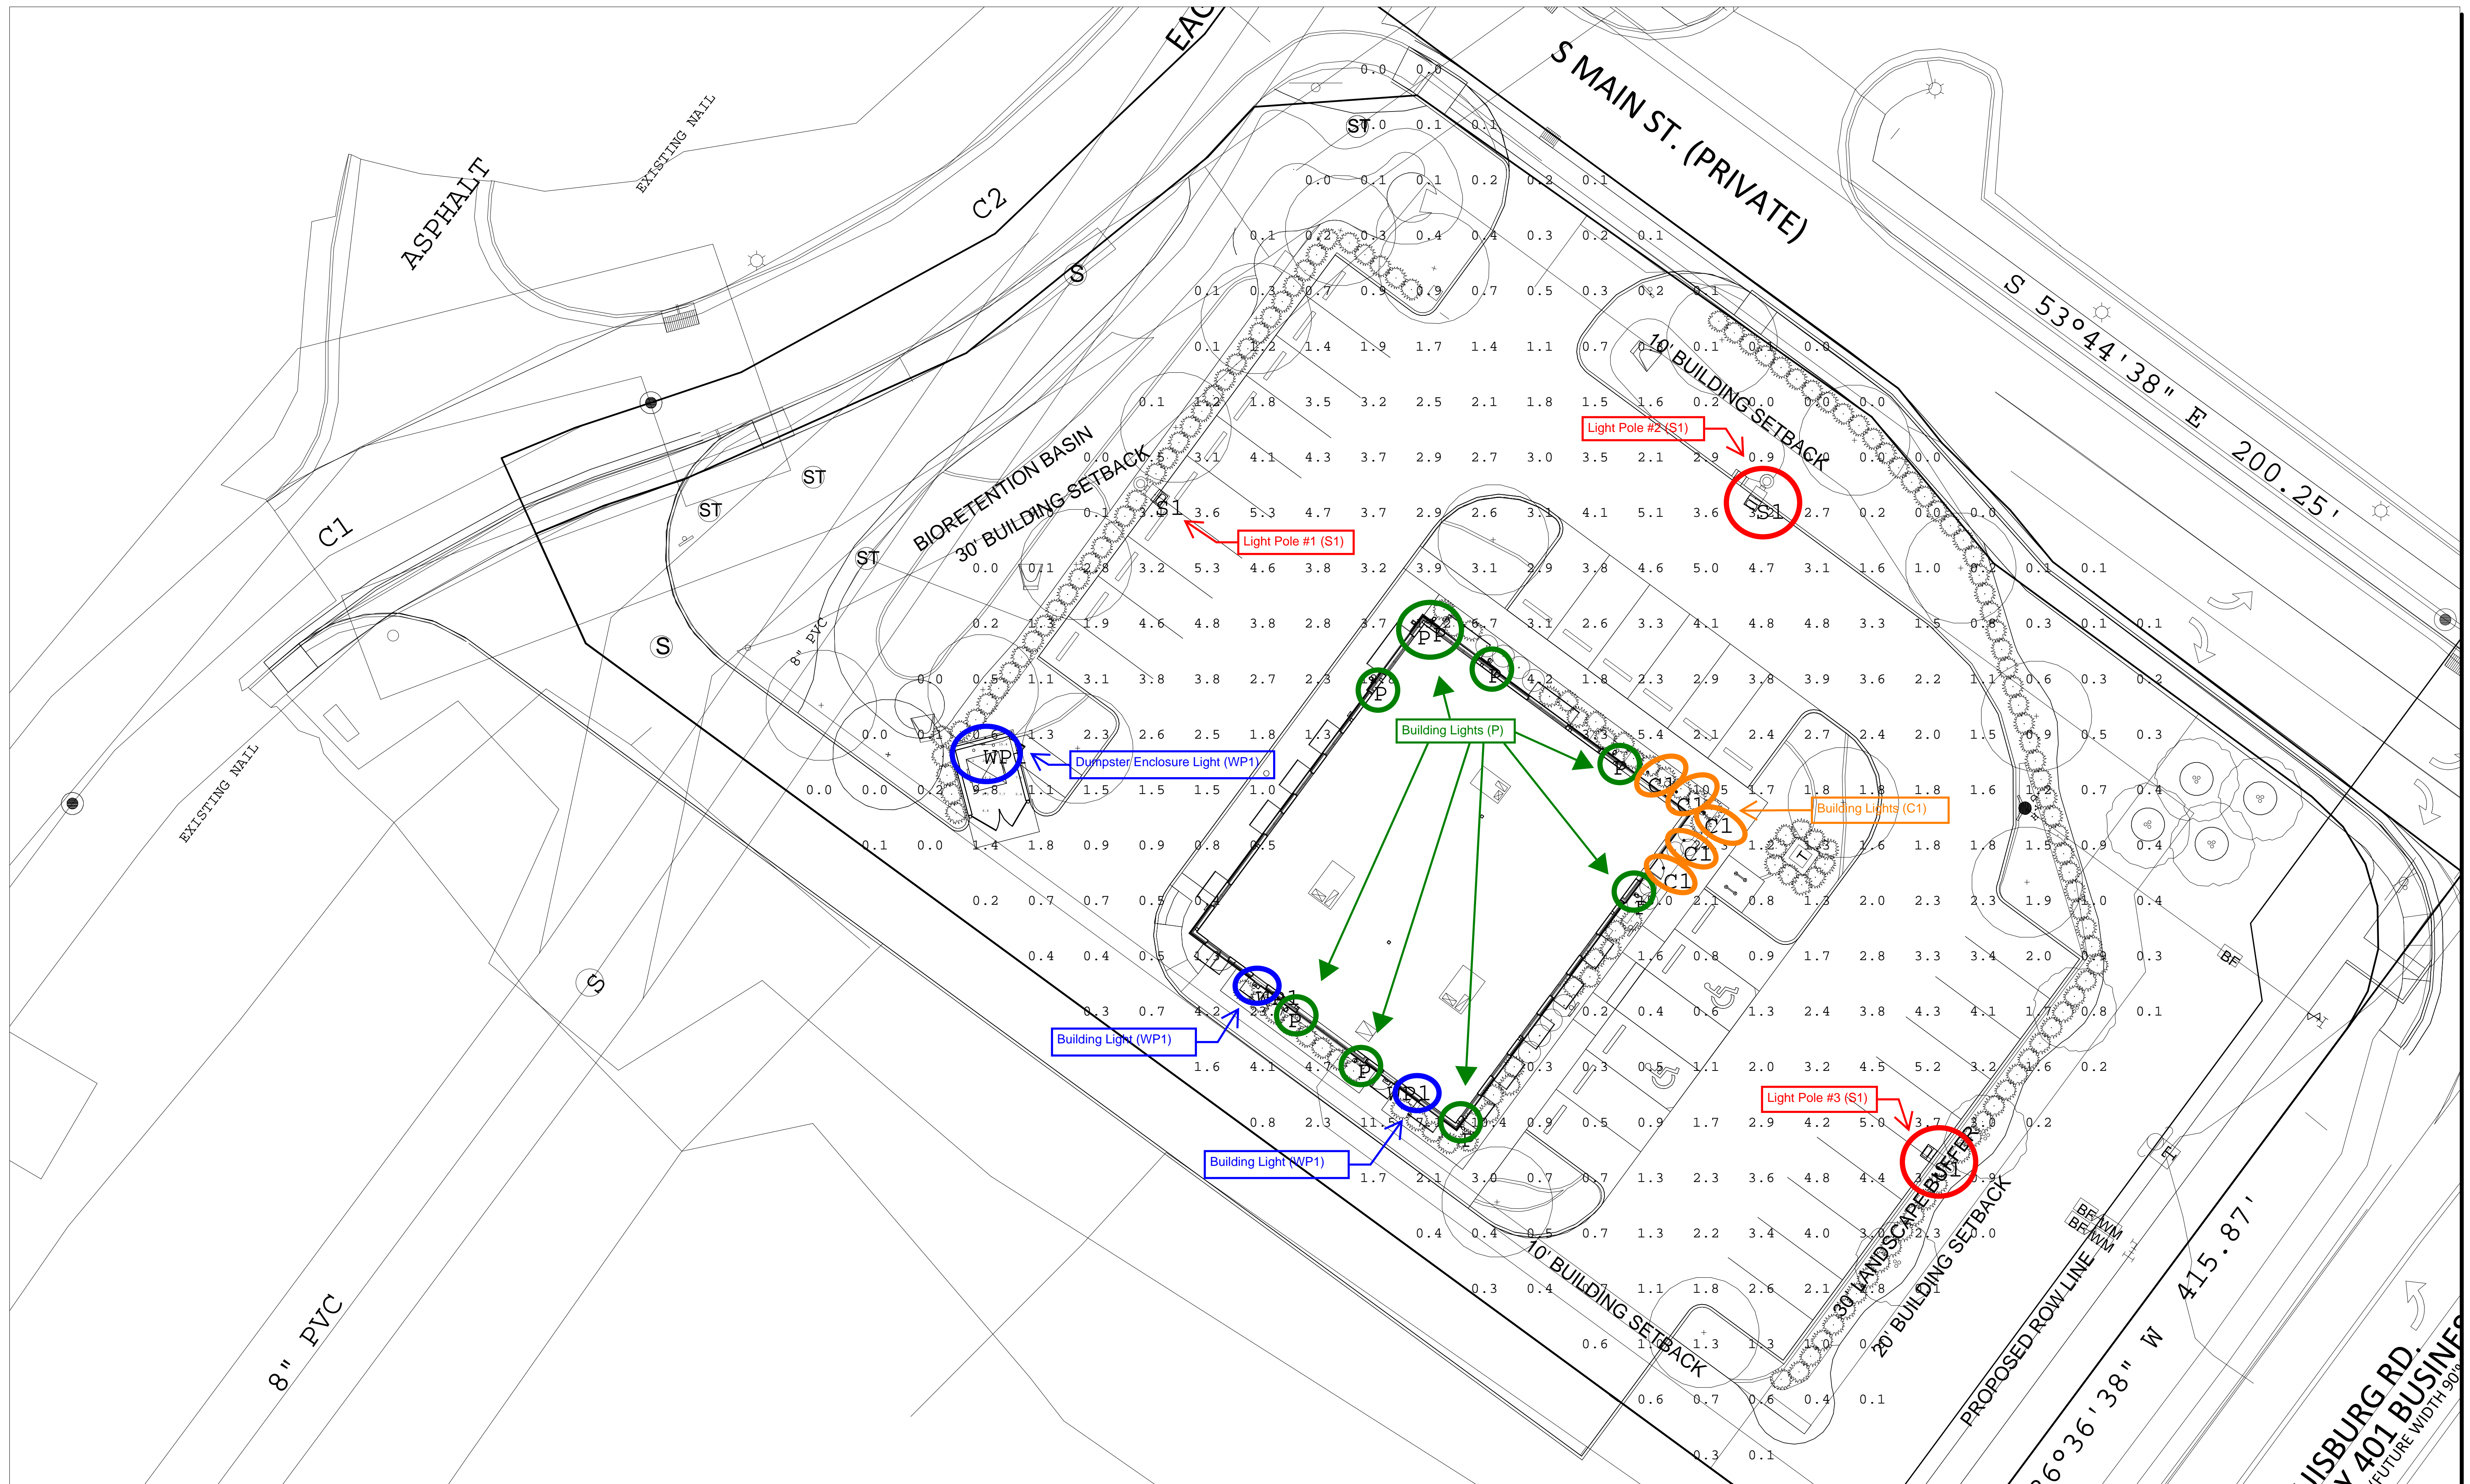

Disclaimer:
 This drawing is based on information provided to Standard Electric. Actual or measured values may differ from those shown due to tolerances in calculation methods, lighting fixture output, or site conditions such as, but not limited to, site layout, topography, atmospheric conditions, and fixture placement. Standard Electric is not responsible for any lighting conditions that may occur in the field. Please refer to the manufacturer's specifications for the lighting fixtures used in this drawing.

Project: WMG Development
 Heartland Dental Site Lighting
 Rolesville, NC

Date: 8/11/2022
Revision #: XX
Page #: Page 1 of 1

Project #: 13-1977
Created By: Ryan Hunt

Size: ARCH D

STANDARD ELECTRIC
 14 Lewis Drive
 Wilmington, MA 01897
 www.standardelectric.com
 978-661-1854

SE NATIONAL
 NATIONAL

24"x 36"