




V2 SUBMITTAL REVIEW _ Comments 07/03/2023

PSP 23-02 and CID 23-06

- 1.) The Town would prefer the Greenway to be as close to the sidepath on Street H as possible. As shown currently on the concept plan, greenway users will have to cross the street twice to get onto the sidepath and ideally there is only one road crossing. Please revise the greenway that runs along the north side of the pond towards Long Melford Drive to align with the sidepath on Street H. It does look like there is a structure there (see Green highlighter circle below), is there any way to route the Greenway around this?

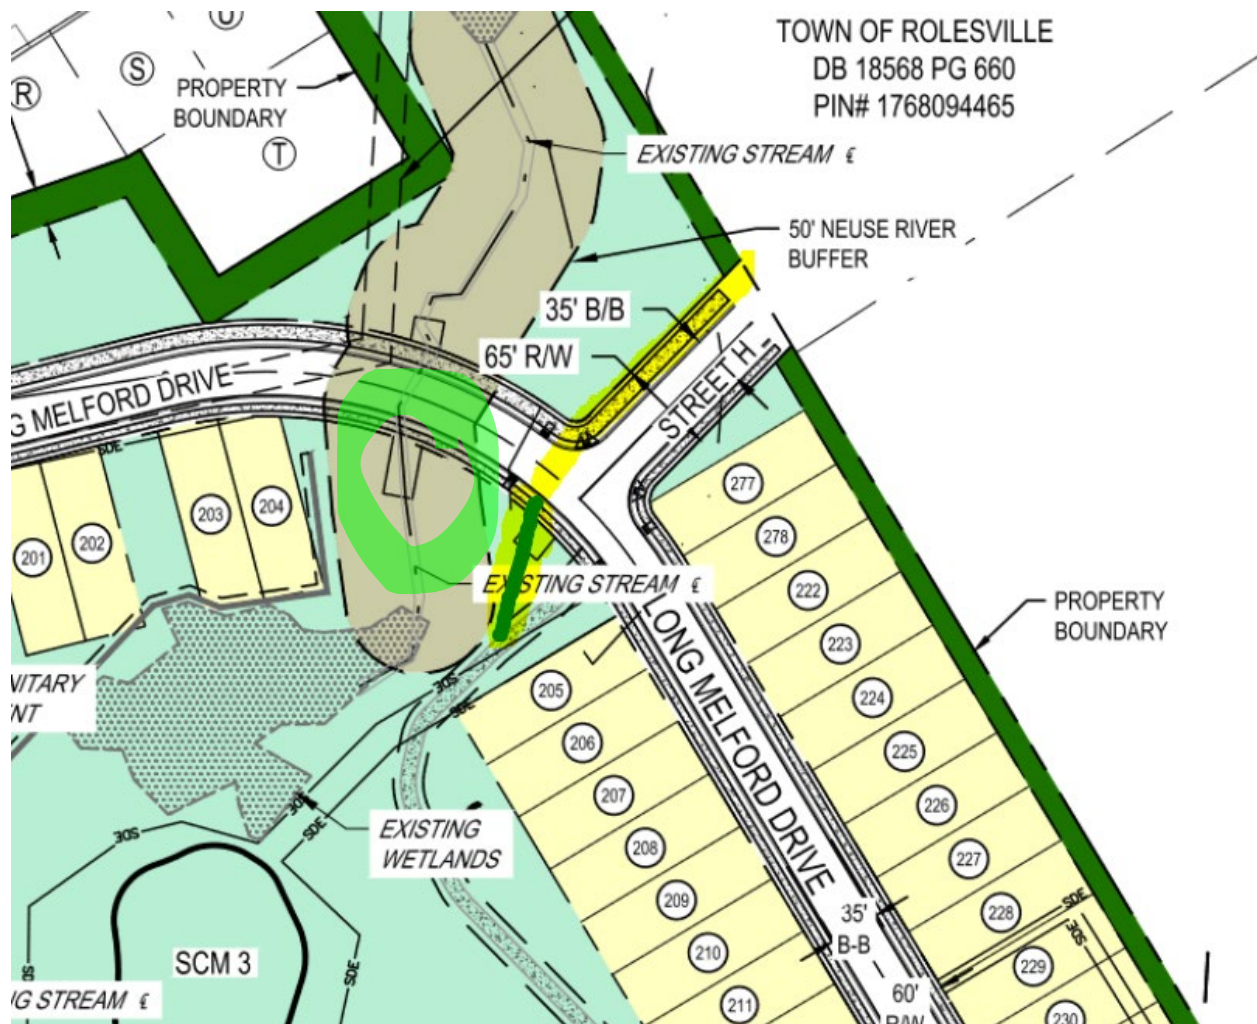

- 2.) The Town's Greenway Plan shows that a greenway or sidepath continues north on this property towards Main Street. Please revise to show the sidepath continuing along Redford Place Drive until the property line.

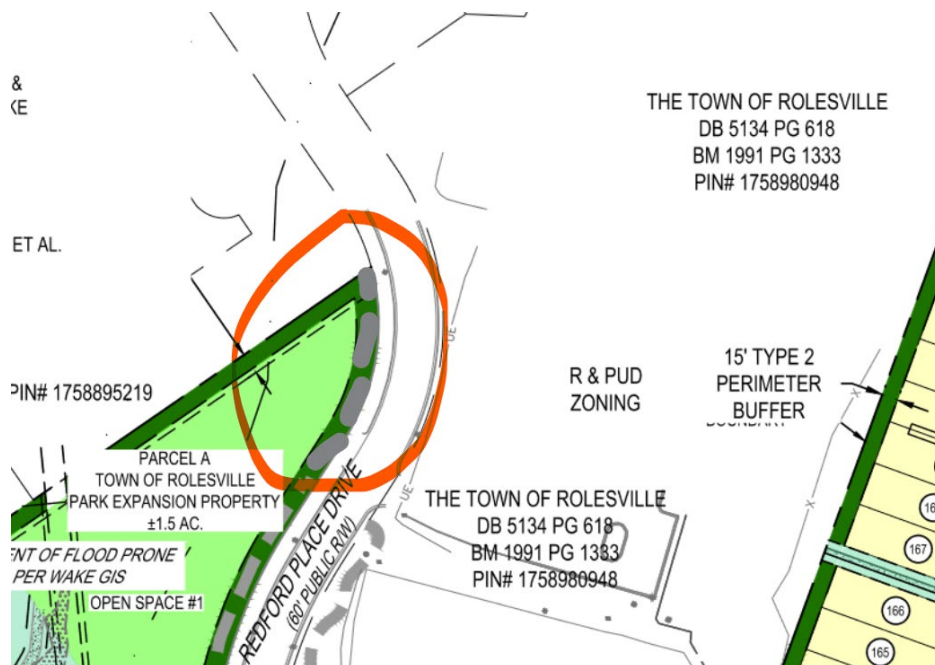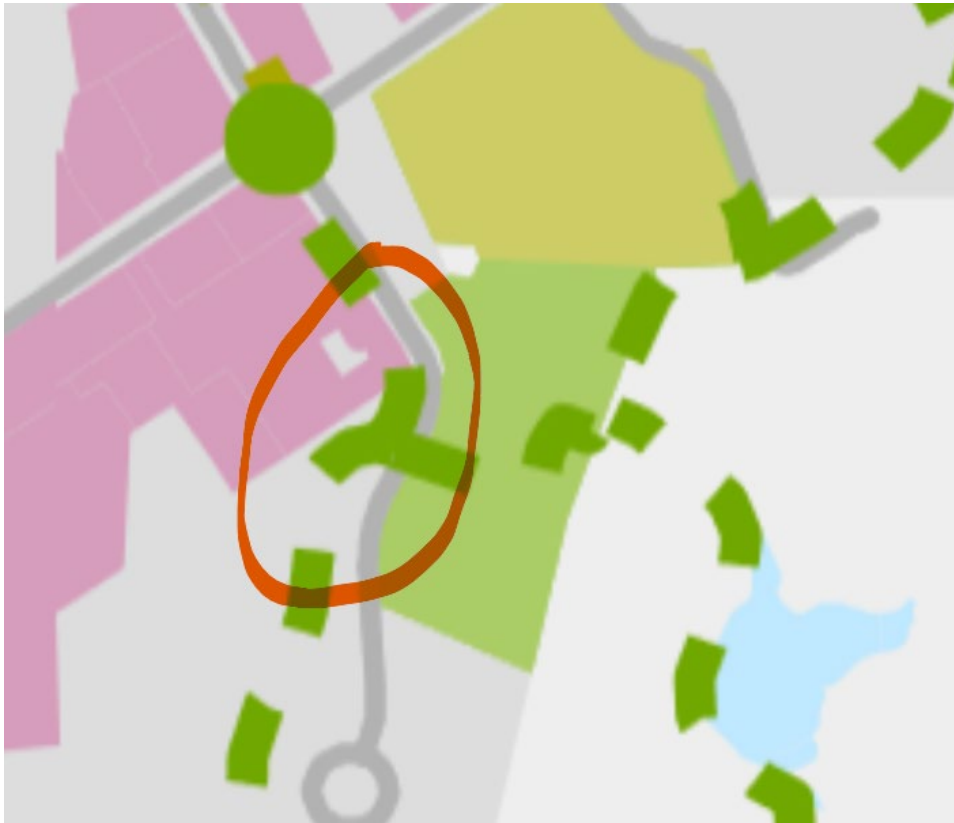

- 3.) The Town's Greenway Plan shows the greenway on the west side of Redford Place Drive going through the property and connecting to Redford Place Drive. Please revise to show this greenway continuing to the road. The Town does **not** want a greenway to stub at to the future park property, but continue to the road.

